


Project No. 24-010.00

March 6, 2025

ADDENDUM NO. 1
TO THE
DRAWINGS AND PROJECT MANUAL
FOR
**COOK-LABAY-TRUITT MS RENOVATIONS
CYPRESS-FAIRBANKS INDEPENDENT SCHOOL DISTRICT
HOUSTON, TEXAS**

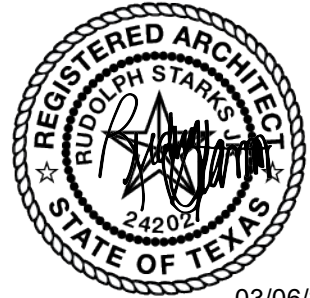

03/06/2025

VLK
20445 State Highway 249, Suite 350
Houston, TX 77070
281.671.2300 voice
vlkarchitects.com

1.1 GENERAL

- A. This addendum modifies the drawings and project manual, dated February 24, 2025, as noted within and shall become part of the Contract Documents.
- B. Each holder of proposal documents registered with the Architect will receive a copy of the addendum. Each prime proposer is responsible for distribution of information conveyed by this addendum to its sub-proposers and suppliers.
- C. Proposers shall acknowledge receipt of this addendum in the space provided on the proposal form. Failure to do so may subject proposer to disqualification.
- D. A pre-proposal conference was held at 10:00 a.m., local time, Wednesday, March 5, 2025 in the Cypress-Fairbanks Independent School Facilities & Construction Conference Room. Attached to this addendum is an Attendance Register from that conference.
- E. **Pre-Proposal Agenda and other documents may have included scope items that were highlighted in purple. Please note that those items are removed from the scope of this project as they were complete or scheduled to be completed under a separate project.**
- F. Site walks are scheduled for Tuesday, March 11, 2025 at the campuses beginning with:
 - 1. Cook MS – 9111 Wheatland, Houston, TX 77064
 - 2. Labay MS – 15435 Willow River, Houston, TX 77095
 - 3. Truitt MS – 6600 Addicks Satsuma RD, Houston, TX 77084.Site walks will begin at Cook MS at 9:00 AM and progress from there. Walk will begin at the main entrance.

VOLUME 1

1.2 DOCUMENT 00 01 10 - TABLE OF CONTENTS

- A. Page 00 01 10 – 3, Add the following: “07 41 20 - Prefinished Metal Roof Panels”

1.3 DOCUMENT AC - BASE PROPOSAL AND ALTERNATE PROPOSAL

- A. Delete this document in its entirety and insert attached revised document.

1.4 SECTION 01 22 00 – UNIT PRICES

- A. Delete this section in its entirety and insert attached revised section.

VOLUME 2

1.5 DOCUMENT 00 01 10 - TABLE OF CONTENTS

- A. Page 00 01 10 – 3, Add the following: “07 41 20 - Prefinished Metal Roof Panels”

1.6 SECTION 07 41 20 - PREFINISHED METAL ROOF PANELS

- A. This section, attached hereto, is entirely new and is hereby made a part of this Addendum.

1.7 SECTION 07 59 00 - ROOFING REPAIR

- A. Delete this section in its entirety and insert attached revised section.

1.8 SECTION 08 71 00 - DOOR HARDWARE – COOK MIDDLE SCHOOL

- A. Delete this section in its entirety and insert attached revised section.

1.9 SECTION 08 71 01 - DOOR HARDWARE – LABAY MIDDLE SCHOOL

- A. Delete this section in its entirety and insert attached revised section.

1.10SECTION 08 71 02 - DOOR HARDWARE – TRUITT MIDDLE SCHOOL

- A. Delete this section in its entirety and insert attached revised section.

1.11SECTION 08 80 00 - GLAZING

- A. Delete this section in its entirety and insert attached revised section.

1.12SECTION 13 34 19 – METAL BUILDING SYSTEMS

- A. Page 13 34 19 – 3 Paragraph 2.1, A add new paragraph to read as follows:
“Double-Loc Panels/PBR Panels; Red Dot Buildings
(phone 800.790.8564, website:www.reddotbuildings.com)”

1.13 CIVIL ADDENDUM ITEMS

- A. Attached document by Brooks & Sparks, Inc. shall hereby become a part of this addendum.

1.14 REVISED DRAWINGS

- A. Sheet Nos. G10.01, G10.02, G20.01, G30.01, CODE1.3, CODE2.3, C11.03, C12.01, C15.01, C21.02, C22.01, C23.01, C25.01, A12.01, A12.01A, A12.11, A12.11A, A12.11C, A12.11D.2, A12.21, A13.11, A13.31, A14.32, A15.01, A16.01, A16.20, A17.01, A17.11, A18.01, A19.02, A19.11D.2, A21.11, A21.21, A22.01A, A22.11A, A22.11C, A22.11D.1, A22.21, A23.31, A25.01, A26.20, A26.21, A27.01, A27.11, A28.01, A29.01, A29.02, A32.01, A32.01A, A32.01D.1, A32.11A, A32.11C, A32.11D.1, A32.21, A33.31, A36.01, A36.20, A37.01, A37.11, A38.01, A39.01, A39.02, A39.11A, A39.11C, A39.11D.1, A39.11D.2, S10.40, S14.10, S20.40, S30.40, S33.10, M10.03, M12.03, E10.03, E12.01, E12.03, E13.04, T11.00, T12.02, and T31.00, dated March 6, 2025 and attached hereto, are revised drawings and are hereby made a part of this addendum.

1.15 NEW DRAWINGS

- A. Sheets No. A12.01B, A12.11B, A19.20, A29.20, A39.20, dated March 6, 2025, attached hereto, are new drawings and are hereby made a part of this addendum.

1.16 ASBESTOS DRAWINGS

- A. Sheet Nos. ABT1.D.2, ABT2.R, ABT3.D.1, ABT4.D.2, ABT5.A, ABT6.R, ABT7.A, and ABT8.D.1, provided by efi global, are attached for reference.

END OF ADDENDUM NO. 1



ATTENDANCE REGISTER

Reference: 2024 Cook, Labay & Truitt MS Renovations
Cypress-Fairbanks ISD
24-02-5744-R-RFP

Date: March 05, 2025

Type of Meeting: Pre-Proposal Meeting

Architect's Project No.: 24-010.00

Name (Please print)	Company Title	Phone	Email
RUDY STARKS	VLK	281 671 2300	rstarkrks@vlkarchitects.com
Kristina McKillop Seft Schuster	VLK	281 355 5151	Kmckillop@vlkarchitects.com bids@iciconstructioninc.com
Tessa Montes Ryland Parker Charles Amador	Millennium Project Solutions Prime Contractors, Inc. SALAS DESIGN	281-328-7200 281-999-0875 281-664-1900	estimating@mps-team.com estimating@primecontractorsinc.com CARLOS.AMADOR@SALASDESIGN.COM
BOBBY GALVAN Michelle Freck Brandon Watson DAN GROSS	CFISD CFISD Division One CFISD	713 851 5914 713 688 7330	michelle.freck@cfisd.net bided@construction.com
AMY HAYES KAY AARCON Mark Koehler OSCAR PACAS Janie Maldonado James B. Scoz SHANNON THOMPSON	CFISD CFISD Siplast, Inc. SIPLAST GCS CFISD CFISD	281-897-4780 713-302-6036 346-275-8916 8326134611	kay.aarcon@cfisp.net Mark.Koehler@Siplast.com OSCAR.PACAS@SIPLAST.COM Janie@geshtx.com james.briscoe@CFISD.NET

FORM AC
COMPETITIVE SEALED PROPOSAL FORM - BASE PROPOSAL

2024 Cook, Labay & Truitt MS Renovations
Cypress-Fairbanks Independent School District
Cypress-Fairbanks I.S.D. Proposal Number: 24-02-5744-R-RFP
Attn: Mr. Jesse Clayburn, Asst. Superintendent of Facilities & Construction

Submitted by: _____

Date: _____ Phone No.: _____

To: Board of Trustees
Cypress-Fairbanks Independent School District
Facilities and Construction
11430-B Perry Road
Houston, Texas 77064

Having examined Proposal and Contract Documents prepared by **VLK Architect** dated **February 24, 2025**, and having examined site conditions, the undersigned proposes to furnish all labor, equipment and materials and perform all work for the completion of the above-named project for the sum indicated below.

In submitting his Proposal, the undersigned agrees to the following:

1. Hold Base Proposal open for acceptance sixty (60) days.
2. Accept right of Owner to reject any or all proposals, to waive formalities and to accept proposal which Owner considers most advantageous.
3. Enter into and execute the contract, if awarded, for the Base Proposal and accepted Alternate Proposals.
4. Complete work in accordance with the Contract Documents within the stipulated contract time.
5. By signing, the undersigned affirms that, to the best of his knowledge, the Proposals have been arrived at independently and is submitted without collusion with anyone to obtain information or gain any favoritism that would in any way limit competition or give an unfair advantage over respondents in the award of this proposal.

I. BASE PROPOSAL

A. Undersigned agrees to complete the Work for the lump sum amount of:

_____ Dollars \$ _____
(Amount written in words governs) (Amount in figures)

II. ALLOWANCES

Undersigned certifies that the allowances specified in Section 01 21 00 are included in the Base Proposal and agrees that unexpended balance of allowance sums will revert to Owner in the final settlement of the contract.

III. CONTRACT TIME

By submittal of this proposal, the undersigned stipulates that the Base Proposal includes all costs necessary to attain Substantial Completion of the Work on or before the date stipulated in AIA Document A101™-2017.

THIS PAGE OF PROPOSAL FORM MUST BE SUBMITTED BY 2:00 PM, March 20, 2025
COMPETITIVE SEALED PROPOSAL FORM - BASE PROPOSAL

IV. ADDENDA

Undersigned acknowledges receipt of Addenda Nos. _____ dated
_____, _____.

V. CHANGES IN THE WORK

Undersigned understands that changes in the work shall be performed in accordance with the Supplementary Conditions.

VI. LIQUIDATED DAMAGES

By submittal of this proposal, the undersigned stipulates an agreement that if Substantial Completion of the Work is not attained on or before the date stipulated in AIA Document A101™-2017, the undersigned and his Surety shall be liable for and shall pay the Owner the sums stipulated as Liquidated Damages as defined in AIA Document A201™-2017.

It is understood that the right is reserved by the Owner to reject any or all proposals, or waive any informalities in the proposal process.

Authorized Signature

Printed Name

Title

(Seal, if a Corporation)
State whether Corporation,
Partnership or Individual

Name of Contracting Firm

Address

Telephone

Date

THIS PAGE OF PROPOSAL FORM MUST BE SUBMITTED BY 2:00 PM, March 20, 2025
COMPETITIVE SEALED PROPOSAL FORM - BASE PROPOSAL

FORM AC
COMPETITIVE SEALED PROPOSAL FORM - ALTERNATE PROPOSALS

2024 Cook, Labay & Truitt MS Renovations
Cypress-Fairbanks Independent School District
Cypress-Fairbanks I.S.D. Proposal Number: 24-02-5744-R-RFP
Attn: Mr. Jesse Clayburn, Asst. Superintendent of Facilities & Construction

Submitted by: _____

Date: _____ Phone No.: _____

To: Board of Trustees
Cypress-Fairbanks Independent School District
Facilities and Construction
11430-B Perry Road
Houston, Texas 77064

Having examined Proposal and Contract Documents prepared by VLK Architect, dated **February 24, 2025**, and having examined site conditions, the undersigned proposes to furnish all labor, equipment and materials and perform all work for the completion of the above-named project for the sum indicated below.

In submitting his Proposal, the undersigned agrees to the following:

1. Hold Alternate Proposal open for acceptance one hundred twenty (120) days.
2. Accept right of Owner to reject any or all proposals, to waive formalities and to accept proposal which Owner considers most advantageous.
3. Enter into and execute the contract, if awarded, for the Base Proposal and accepted Alternate Proposals.
4. Complete work in accordance with the Contract Documents within the stipulated contract time.
5. By signing, the undersigned affirms that, to the best of his knowledge, the Proposals have been arrived at independently and is submitted without collusion with anyone to obtain information or gain any favoritism that would in any way limit competition or give an unfair advantage over respondents in the award of this proposal.

I. ALTERNATES

If the Owner accepts any or all of the Alternates, the undersigned agrees to modify the Base Proposal as stipulated below:

A. Alternate Number 1 – **Base Bid Adjustment**

ADD/DEDUCT _____	Dollars \$ _____
(Amount written in words governs)	(Amount in figures)

II. UNIT PRICES

If the Owner accepts any or all of the Alternates, the undersigned agrees to add or subtract the following units of work:

UNIT PRICE 1: ELECTRICAL DUPLEX RECEPTACLE \$ _____ each

UNIT PRICE 2: DATA DROP \$ _____ each

UNIT PRICE 3: VOICE DROP \$ _____ each

THIS PAGE OF PROPOSAL FORM MUST BE SUBMITTED BY 3:00 PM, March 20,2025
COMPETITIVE SEALED PROPOSAL FORM - ALTERNATE PROPOSAL

UNIT PRICE 4: DATA CABLING TO TEACHER STATION \$ _____ each

UNIT PRICE 5: 4 ½” THICK CONCRETE WALK PER SQUARE FOOT \$ _____ SF

UNIT PRICE 6: 6” THICK CONCRETE DRIVE PER SQUARE FOOT \$ _____ SF

UNIT PRICE 7: 7” THICK CONCRETE DRIVE PER SQUARE FOOT \$ _____ SF

UNIT PRICE 8: LIFE SAFETY DEVICES (including all associated cabling and programming)

1. Exterior Horn to Speaker \$ _____ each
2. Interior Horn to Speaker \$ _____ each
3. Interior Visual Strobe \$ _____ each
4. Interior Speaker/Visual Strobe \$ _____ each
5. Smoke Detector \$ _____ each
6. Heat Detector \$ _____ each
7. Manual Pull Station \$ _____ each
8. Stopper 2 Pull Station Cover \$ _____ each
9. Annunciator Panel \$ _____ each
10. Duct Detector \$ _____ each
11. Relay \$ _____ each
12. Supervisory \$ _____ each
13. Waterflow \$ _____ each
14. Amplifier \$ _____ each
15. Remote Power Supply \$ _____ each

UNIT PRICE 9: GRAPHIC SIGNS

1. Sign Type A \$ _____ / each
2. Sign Type B \$ _____ / each
3. Sign Type C \$ _____ / each

UNIT PRICE 10: EXIT SIGN \$ _____ each

UNIT PRICE 11: ROOF SHEATHING \$ _____ 4x8 sheet

UNIT PRICE 12: IR FILM \$ _____ /SF

UNIT PRICE 13: CEILING TILE REPLACEMENT \$ _____ 4SF

THIS PAGE OF PROPOSAL FORM MUST BE SUBMITTED BY 3:00 PM, March 20,2025
COMPETITIVE SEALED PROPOSAL FORM - ALTERNATE PROPOSAL

UNIT PRICE 14: ASBESTOS ABATEMENT COMPONENTS

Identified ACBM at Cook, Labay, and Truitt Middle School Package

No.	Unit Price Description	Add (\$/Figures)	Deduct (\$/Figures)	Unit of Measure
ASB-1	Price per square foot for the proper removal, transportation, and disposal of interior ACBM black damp proofing mastic behind brick veneer . All work to be completed in compliance with AHERA and TAHPR regulations. – Full Containment	_____	_____	Square Foot
ASB-2	Price per square foot for the proper removal, transportation, and disposal of exterior ACBM through-wall flashing with black damp proofing mastic behind brick veneer . All work to be completed in compliance with NESHAP regulations.	_____	_____	Square Foot
ASB-3	Price per square foot for the proper removal, transportation, and disposal of exterior ACBM black damp proofing mastic behind brick veneer . All work to be completed in compliance with NESHAP regulations.	_____	_____	Square Foot
ASB-4	Price per linear foot for the proper removal, transportation, and disposal of ACBM pipe insulation with mastic coating via glovebag removal method including all necessary regulated work area <u>preparation and PPE</u>	_____	_____	Linear Foot
ASB-5	Price per linear foot for the proper removal, transportation, and disposal of ACBM pipe insulation with mastic coating . All work to be completed in compliance with AHERA and TAHPR regulations. – Full Containment	_____	_____	Linear Foot
ASB-6	Price per square foot for the proper removal, transportation, and disposal of ACBM black mirror mastic . All work to be completed in compliance with AHERA and TAHPR regulations.	_____	_____	Square Foot
ASB-7	Price per square foot for the proper removal, transportation, and disposal of exterior ACBM black glazing putty around windows . All work to be completed in compliance with NESHAP regulations.	_____	_____	Square Foot
ASB-8	Price per square foot for the proper removal, transportation, and disposal of ACBM vinyl floor tile and/or black mastic . All work to be completed in compliance with AHERA and TAHPR regulations. – Full Containment	_____	_____	Square Foot
ASB-9	Price per unit for the proper removal, transportation, and disposal of assumed ACBM fire doors . All work to be completed in compliance with AHERA and TAHPR regulations. (Component Removal)	_____	_____	Unit

III. CONTRACTOR’S PROJECT TEAM MEMBERS

The undersigned proposes the following project team members (include resumes):

Project Manager _____

Superintendent _____

Asst. Superintendent(s) _____

Project Engineer _____

THIS PAGE OF PROPOSAL FORM MUST BE SUBMITTED BY 3:00 PM, March 20,2025
COMPETITIVE SEALED PROPOSAL FORM - ALTERNATE PROPOSAL

III. PROPOSED SUBCONTRACTORS

The undersigned proposes the following subcontractors. Note – Not all trades listed below will apply to every project.

Paving: _____

Abatement: _____

Dampproofing/insulator: _____

Masonry: _____

Roofing: _____

Drywall: _____

Casework: _____

Concrete: _____

Plumbing: _____

Mechanical: _____

Electrical: _____

Fire Alarm: _____

Sprinkler: _____

Low Voltage/Security: _____

Site Utilities: _____

Earthwork/Site Prep: _____

Fencing: _____

Pre-Engineered Metal Building: _____

Glazing: _____

THIS PAGE OF PROPOSAL FORM MUST BE SUBMITTED BY 3:00 PM, March 20,2025
COMPETITIVE SEALED PROPOSAL FORM - ALTERNATE PROPOSAL

It is understood that the right is reserved by the Owner to reject any or all proposals, or waive any informalities in proposal process.

(Seal, if a Corporation)
State whether Corporation,
Partnership or Individual

Authorized Signature

Printed Name

Title

Name of Contracting Firm

Address

Telephone

Date

END OF FORM

THIS PAGE OF PROPOSAL FORM MUST BE SUBMITTED BY 3:00 PM, March 20,2025

COMPETITIVE SEALED PROPOSAL FORM - ALTERNATE PROPOSAL

SECTION 01 22 00

MEASUREMENT AND PAYMENT (UNIT PRICES)

CONDITIONS OF THE CONTRACT AND DIVISION 1, as applicable, apply to this Section.

PART 1 - GENERAL

Refer to Document AB for Substitutions of Materials and Equipment

1.1 SECTION INCLUDES

- A. Measurement and payment criteria applicable to portions of the Work performed under a unit price payment method.
- B. Defect assessment and non-payment for rejected work.

1.2 AUTHORITY

- A. Measurement methods delineated in the individual specification sections complement the criteria of this Section. In the event of conflict, the requirements of the individual specification section govern.
- B. Take all measurements and compute quantities. The Architect will verify measurements and quantities.

1.3 UNIT QUANTITIES SPECIFIED

- A. Quantities indicated in the Contract Documents are for bidding and contract purposes only. Quantities and measurements supplied or placed in the Work and verified by the Architect determine payment.
- B. If the actual Work requires more or fewer quantities than those quantities indicated, provide the required quantities at the unit sum/prices contracted.

1.4 MEASUREMENT OF QUANTITIES

- A. Measurement Devices:
 - 1. Weigh Scales: Inspected, tested, and certified by the applicable State Weights and Measures Department within the past year.
 - 2. Platform Scales: Of sufficient size and capacity to accommodate the conveying vehicle.
 - 3. Metering Devices: Inspected, tested, and certified by the applicable State department within the past year.
- B. Measurement by Weight: Concrete reinforcing steel, rolled or formed steel or other metal shapes will be measured by handbook weights. Welded assemblies will be measured by handbook or scale weight.
- C. Measurement by Volume: Measured by cubic dimension using mean length, width and height or thickness.
- D. Measurement by Area: Measured by square dimension using mean length and width or radius.
- E. Linear Measurement: Measured by linear dimension, at the item centerline or mean chord.
- F. Stipulated Sum/Price Measurement: Items measured by weight, volume, area, or linear means or combination, as appropriate, as a completed item or unit of the Work.

1.5 PAYMENT

- A. Payment Includes: Full compensation for all required labor, labor burden, products, tools, equipment, plant, transportation, services and incidentals; erection, application or installation of an item of the Work; overhead and profit.
- B. Final payment for Work governed by unit prices will be made on the basis of the actual measurements and quantities confirmed and accepted by the Architect multiplied by the unit/sum price for work which is incorporated in or made necessary by the Work.

1.6 DEFECT ASSESSMENT

- A. Replace the Work, or portions of the Work, not conforming to specified requirements.
- B. The individual specification sections may modify these options or may identify a specific formula or percentage sum/price reduction.
- C. The authority of the Architect to assess the defect and identify payment adjustment is final.

1.7 NON-PAYMENT FOR REJECTED PRODUCTS

- A. Payment will not be made for any:
 - 1. Products wasted or disposed of in a manner that is not acceptable.
 - 2. Products determined as unacceptable before or after placement.
 - 3. Products not completely unloaded from the transporting vehicle.
 - 4. Products placed beyond the lines and levels of the required work.
 - 5. Products remaining on hand after completion of the work.
 - 6. Loading, hauling and disposing of rejected Products.

PART 2 – DESCRIPTION OF UNIT PRICES

2.1 GENERAL

- A. For the work described unit pricing shall be used to determine the additional cost or credit to the contract amount or added to or deducted from the Owner’s contingency for changes in the scope of work made during the progress of the work as directed by Architect.
- B. The same price shall be used for adding or deducting from the scope of work. No exceptions.
- C. The following unit prices shall be included in the proposal form and shall be included in the Owner-Contractor agreement.

PART 3 - EXECUTION

3.1 SCHEDULE OF UNIT PRICES

- A. Unit Prices shall be used, where applicable, to make adjustments to the cost of the work due to changes. All Unit Prices submitted shall be complete “turnkey” prices for fully functioning systems, and shall include all costs for overhead, profit, labor, labor burden, material, equipment, and any other incidentals related to the completion of the Work and shall remain firm for the duration of the contract. Unit prices listed are for additive and/or deductive work.

UNIT PRICE 1: ELECTRICAL DUPLEX RECEPTACLE

Provide unit price for a new 20A, 120V duplex electrical receptacle and cover plate, flush mounted in a CMU, metal stud, or demountable wall construction, circuited to an existing electrical panel within 150 feet of the outlet using a branch circuit consisting of 2 #10 AWG and 1 #10 AWG ground in 3/4-inch EMT conduit. All conduits to be concealed in wall construction. Unit price shall include a 20-amp circuit breaker to be installed in existing panel space.

UNIT PRICE 2: DATA DROP

Provide unit price for a data drop, flush mounted in a CMU, metal stud or demountable wall construction., wired to an IDF/MDF Room. The data drop shall consist of a single gang wall box, cabling wiring device, cover plate, 3/4-inch conduit from outlet to above accessible ceiling, plenum-rated cabling routed above accessible ceiling to the nearest MDF or IDF location within 250 feet of the outlet. Termination and testing to be included in the unit price.

UNIT PRICE 3: VOICE DROP

Provide unit price for a voice drop, flush mounted in a CMU, metal stud or demountable wall construction., wired to the telecommunications/MDF room. The voice drop shall consist of a single gang wall box, voice jack, cover plate, 3/4-inch conduit from outlet to above accessible ceiling, plenum-rated voice cable routed above accessible ceiling to telecommunication head end equipment. Termination and testing to be included in the unit price.

UNIT PRICE 4: DATA CABLING TO TEACHER STATION

Provide one data drop, including data jack, faceplate, and CAT 6 cable home run to nearest IDF or MDF data rack. Assume length less than 300 FT. Include J-box and conduit from data outlet to ceiling cavity in this unit price.

UNIT PRICE 5: 4 ½” THICK CONCRETE WALK PER SQUARE FOOT

This unit cost shall establish the amount to the contract price for the Contractor to add or deduct 4 ½” thick concrete walk (minimum 100 SF) per Square Foot.

UNIT PRICE 6: 6” THICK CONCRETE DRIVE PER SQUARE FOOT

This unit cost shall establish the amount to the contract price for the Contractor to add or deduct 6” thick concrete drive (minimum 100 SF) per Square Foot.

UNIT PRICE 7: 7” THICK CONCRETE DRIVE PER SQUARE FOOT

This unit cost shall establish the amount to the contract price for the Contractor to add or deduct 7” thick concrete drive (minimum 100 SF) per Square Foot.

UNIT PRICE 8: LIFE SAFETY DEVICES (including all associated cabling and programming)

This unit cost shall establish the amount to be added or deducted from the contract price for the Contractor to add /deduct Fire Alarm devices.

1.	Exterior Horn to Speaker	\$ _____	each
2.	Interior Horn to Speaker	\$ _____	each
3.	Interior Visual Strobe	\$ _____	each
4.	Interior Speaker/Visual Strobe	\$ _____	each
5.	Smoke Detector	\$ _____	each
6.	Heat Detector	\$ _____	each
7.	Manual Pull Station	\$ _____	each

8.	Stopper 2 Pull Station Cover	\$ _____	each
9.	Annunciator Panel	\$ _____	each
10	Duct Detector	\$ _____	each
11	Relay	\$ _____	each
12	Supervisory	\$ _____	each
13	Waterflow	\$ _____	each
14	Amplifier	\$ _____	each
15	Remote Power Supply	\$ _____	each

UNIT PRICE 9: GRAPHIC SIGNS

This unit cost shall establish the amount to be added or deducted to the contract price for the Contractor to remove existing signage and install new as described below:

1.	Sign Type A	\$ _____ /	each
2.	Sign Type B	\$ _____ /	each
3.	Sign Type C	\$ _____ /	each

UNIT PRICE 10: EXIT SIGN

This unit cost shall establish the amount to be added to the contract price to provide and install one (1) exit sign. Price shall include wiring to nearest available emergency circuit, up to 200 feet.

UNIT PRICE 11: ROOF SHEATHING

This unit cost shall establish the amount to be added to the contract price to provide and install 4x8 Roof Sheathing up to and including 3/4". Price shall include removing existing rotted or damaged sheathing and replacing with new and prepart area for new metal roofing as called for in the drawings.

UNIT PRICE 12: IR FILM

This unit cost shall establish the amount to be added to the contract price to provide and install one 23MIL Armoured One film and structural glazing on existing glazing.

UNIT PRICE 13: CEILING TILE REPLACEMENT


This unit cost shall establish the amount to be added to the contract price to provide and install ceiling tile to match existing. Price shall include removing existing ceiling tile and replacing with new as directed.

UNIT PRICE 14: ASBESTOS ABATEMENT COMPONENTS

This unit cost shall establish the amount to be added or deducted to the contract price for the Contractor to add/deduct asbestos abatement components as described below:

Identified ACBM at Cook, Labay, and Truitt Middle School Package				
No.	Unit Price Description	Add (\$/Figures)	Deduct (\$/Figures)	Unit of Measure
ASB-1	Price per square foot for the proper removal, transportation, and disposal of interior ACBM black damp proofing mastic behind brick veneer . All work to be completed in compliance with AHERA and TAHPR regulations. – Full Containment	_____	_____	Square Foot
ASB-2	Price per square foot for the proper removal, transportation, and disposal of exterior ACBM through-wall flashing with black damp proofing mastic behind brick veneer . All work to be completed in compliance with NESHAP regulations.	_____	_____	Square Foot
ASB-3	Price per square foot for the proper removal, transportation, and disposal of exterior ACBM black damp proofing mastic behind brick veneer . All work to be completed in compliance with NESHAP regulations.	_____	_____	Square Foot
ASB-4	Price per linear foot for the proper removal, transportation, and disposal of ACBM pipe insulation with mastic coating via glovebag removal method including all necessary regulated work area <u>preparation and PPE</u>	_____	_____	Linear Foot
ASB-5	Price per linear foot for the proper removal, transportation, and disposal of ACBM pipe insulation with mastic coating . All work to be completed in compliance with AHERA and TAHPR regulations. – Full Containment	_____	_____	Linear Foot
ASB-6	Price per square foot for the proper removal, transportation, and disposal of ACBM black mirror mastic . All work to be completed in compliance with AHERA and TAHPR regulations.	_____	_____	Square Foot
ASB-7	Price per square foot for the proper removal, transportation, and disposal of exterior ACBM black glazing putty around windows . All work to be completed in compliance with NESHAP regulations.	_____	_____	Square Foot
ASB-8	Price per square foot for the proper removal, transportation, and disposal of ACBM vinyl floor tile and/or black mastic . All work to be completed in compliance with AHERA and TAHPR regulations. – Full Containment	_____	_____	Square Foot
ASB-9	Price per unit for the proper removal, transportation, and disposal of assumed ACBM fire doors . All work to be completed in compliance with AHERA and TAHPR regulations. (Component Removal)	_____	_____	Unit

END OF SECTION

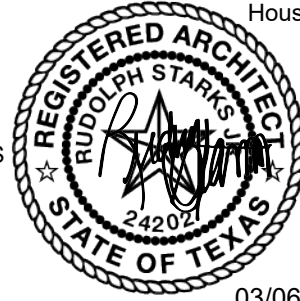

SECTION 07 41 20

PREFINISHED METAL ROOF PANELS

PART 1 - GENERAL

1.1 SUMMARY

- A. Section Includes: Prefinished metal roof panels and soffit panels, including related insulation, underlayments, flashing, trim and accessories.
- B. Related Sections:
 - 1. Section 06 10 00 - Rough Carpentry.
 - 2. Section 07 62 00 - Sheet Metal Flashing and Trim.
 - 3. Section 07 72 13 - Manufactured Roof Curbs and Portals.
 - 4. Section 07 92 00 - Joint Sealants.

03/06/2025

1.2 SYSTEM REQUIREMENTS

- A. Performance Requirements
 - 1. Uplift resistance: UL Class 90 wind uplift resistance.
 - 2. Design and install system to accommodate thermal expansion, thermal contraction and building movement.

1.3 SUBMITTALS

- A. Submit in accordance with SECTION 01 33 23 - SHOP DRAWINGS, PRODUCT DATA AND SAMPLES.
- B. Shop Drawings: Drawings shall indicate type of roof panels, gage of metal, finish and shape and size of flashing and accessories.
- C. Product Data: Submit manufacturer's technical literature indicating properties of materials, finishes and performance capabilities.
- D. Samples
 - 1. Submit 2' x 4' section of roof and soffit panel system(s), complete with flashings and attachment devices.
 - 2. Upon selection of colors by Architect, submit 12" x 12" finish samples representing color and finish.
 - 3. Submit 6" x 6" sample of self-adhering sheet underlayment.
- E. Color Charts: Submit samples of manufacturer's full range of standard colors. Submit actual color chips, not photo reproductions.
- F. Qualification Data
 - 1. Submit installer qualifications verifying years of experience; include list of completed projects having similar scope of work identified by name, location, date, reference name and phone number.
 - 2. Submit letter certifying manufacturer's approval for installation of system.
 - 3. On-site or field manufactured panels are not acceptable, unless approved in writing. Field curving of pre-manufactured panels is acceptable. If on site roll-forming is approved, submit documentation on roll-forming equipment which will be used to roll-form roofing panels on site. Provide copy of UL certificate, including certification report identifying Make and Model No., Serial No. of roll-forming machine, panel specification and expiration date of certificate.
- G. Manufacturer's Instructions: Submit written installation instructions indicating method and sequence of installation. Provide for roofing system and self-adhering sheet underlayment.

- H. Warranty: Submit signed and dated copies of warranties.

1.4 QUALITY ASSURANCE

- A. Applicator Qualifications: This work shall be performed by an experienced applicator who has successfully installed the materials under similar conditions over a period of at least 10 years.

- B. Cover self-adhering sheet underlayment within 14 days of underlayment installation.

1.5 DELIVERY, STORAGE, AND HANDLING

- A. Deliver preformed metal roof panels and trim items to the project site with no dents, scratches, or abraded areas. Deliver in manufacturer's standard bundles, securely bound and store at the project site raised above slab or ground level on pallets.

1.6 WARRANTY

- A. Submit manufacturer's standard 20-year warranty against fading or visible (noticeable) chalking, checking, crazing or peeling of the exterior finish when exposed to natural sunlight for a period of 20 years.
- B. Submit manufacturer's 20-year "No-Dollar-Limit" Complete System panel and trim weathertightness warranty.
- C. Submit applicator's 2-year weathertightness warranty.

PART 2 - PRODUCTS

2.1 MATERIALS

- A. Roof Panels: Basis of Design shall be Double Lock Zee-Lock Panels as manufactured by Berridge. Metal panels shall be zinc coated steel complying with ASTM A 653, and ASTM A792-AZ55 Galvalume®, Grade A; with ASTM A 653 G90 hot-dip coating, 24 gage minimum thickness, with striations, for roof panels. Seam spacing shall be 16" o.c. with 2" high standing rolled seams and all panels having the same spacing. Panels shall be single pieces with no joints. Provide specified panel or approved equivalent product of one of the following:
 - Peterson Aluminum Corp.
 - MBCI
 - Merchant & Evans, Inc.
- B. Finish: Metal roof panels, and all exposed trim items, shall receive fluorocarbon polymeric coating containing 70% PVDF Hylar 5000 or Kynar 500 finish. Color shall be as selected by Architect from manufacturer's complete color line.
- C. Flashing and all trim items which are contiguous to roof panels shall be of the same metal and finish as roof panels.
- D. Fasteners: Provide manufacturer's standard zinc coated self-tapping screws meeting UL 90 requirements.
- E. Isocyanurate Insulation: Reinforced isocyanurate foam core faced both sides with non-asphaltic glass fibers chemically bonded in the manufacturing process. Insulation shall meet the requirements of Factory Mutual Class 1 Roofs. Insulation shall have a minimum of 2 layers with a total thickness, using R-5.0 per inch per NRCA, to meet the R-Value as shown on the Building Assembly Types Sheet on the drawings.
- F. Self-adhering Sheet Underlayment (High Temperature): 30 to 40 mils thick minimum, consisting of slip-resisting, polyethylene-film top surface laminated to layer of butyl or SBS-modified asphalt adhesive, with release-paper backing; cold applied. Provide primer when recommended by underlayment manufacturer.
 - 1. Thermal Stability: Stable after testing at 240 degrees F; ASTM D 1970.
 - 2. Low-Temperature Flexibility: Passes after testing at minus 20 deg F (29 deg C); ASTM D 1970.
 - 3. Products: Subject to compliance with requirements, provide one of the following:
 - Carlisle Coatings & Waterproofing Inc., Div. of Carlisle Companies Inc.; CCW WIP 300HT.
 - Grace Construction Products; a unit of Grace, W. R. & Co.; Ultra.
 - Henry Company; Blueskin PE200 HT.
 - Metal-Fab Manufacturing, LLC; MetShield.
- G. Mechanical Fasteners and Bearing Plates: Provide U.L. listed (standard) clip designed to allow panels to expand and contract. Steel deck fasteners shall be UL listed and shall be approved by roofing manufacturer for compliance with UL-90 uplift requirements.
- H. Sealants and Gaskets: Manufacturer's standard type suitable for use with installation of metal roofing; non-staining; skinning, non-shrinking and non-sagging; ultra-violet and ozone resistant for exterior applications; colors to match exposed metal.

- I. Internal and External Corners: Same materials, gage and finish as panels; profile to suit system; brake formed to required angles. Mitered internal corners, back braced with sheet stock, to maintain continuity of profile.
- J. Expansion Joints: Same material and where exposed, finish as panels, manufacturer's standard type, of profile to suit system. Exposed fasteners same finish as panels.
- K. Trim, Closure Pieces, Cap, Fascias, Infills, Flashings and Accessories: Same material, gage and where exposed, of same finish as metal panels, brake formed to required profiles.
- L. Touch-Up Paint: As recommended by manufacturer.

2.2 FABRICATION

- A. Comply with dimensions, profile, gages and fabrication details shown and if not shown, provide manufacturer's standard product fabrication.
- B. Fabricate components of the system at the factory, ready for field assembly.
- C. Fabrication of component profiles on site not permitted.
- D. Apply finish coatings prior to roll forming.
- E. Fabricate continuous panels only. No field joints allowed.

PART 3 - EXECUTION

3.1 INSPECTION

- A. Examine supporting members and areas to receive prefinished metal roof panels, flashing and trim items for conditions that will adversely affect the execution and quality of work. Do not start this work until unsatisfactory conditions are corrected.

3.2 INSTALLATION

- A. General: Install prefinished metal roof panels and related items in strict compliance with manufacturer's recommendations.
- B. Install insulation over metal deck per UL-90. End joints shall occur over solid supports. Stagger end joints of insulation in adjacent rows.
 - 1. Mechanically fasten first layer to the roof deck.
 - 2. Apply second layer over first layer in broken joint pattern so that each layer breaks joints both ways with the preceding layer.
 - 3. Apply insulation with long joints continuous and short joints staggered.
 - 4. Bring insulation panels into moderate contact with each other and cope to fit neatly around projections.
 - 5. Joints parallel to ribs on steel deck installation shall be located over solid bearing.
 - 6. Mechanically fasten first layer to the roof deck throughout. Spacing and number of fasteners shall meet current building code requirements and per UL-90. Adhere second layer of insulation to the first layer.
 - 7. Do not install more insulation at one time than the amount which can be covered with roofing the same day.
 - 8. At the end of each day's work and after any other work stoppage, apply temporary water cutoffs in accordance with metal roof manufacturer's approval.
- C. Self-adhering Sheet Underlayment: Apply primer if required by manufacturer. Comply with temperature restrictions of underlayment manufacturer for installation. Apply over insulation at entire roof area, wrinkle free, in shingle fashion to shed water, and with end laps of not less than 6 inches staggered 24 inches between courses. Overlap side edges not less than 3-1/2 inches. Extend underlayment into gutter trough. Roll laps with roller. Do not install underlayment perpendicular to roof slope except at locations specifically required for watertightness.
 - 1. Cover underlayment within 14 days. If underlayment cannot be covered within that time period, install an additional layer of underlayment as described above immediately prior to roof installation.
 - 2. Install underlayment in accordance with underlayment manufacturer's written instructions.

- D. Metal roofing installation shall be installed so that entire metal roof system meets UL Windstorm Resistance Classification 90 and meets 1-hour fire-resistance requirements as indicated on the drawings.
- E. Continuous full length pans shall be fabricated by factory roll forming in power equipment capable of producing metal roofing pans to the required lengths. End laps are not allowed.
- F. Anchor components parts of the prefinished roof panels securely in place, providing for necessary thermal and structural movement.
- G. Install and securely anchor metal flashing, trim and related items to provide a weathertight enclosure.
- H. Install trim, closures, caps and accessories as indicated or required for complete weathertight installation.
- I. Provide a concealed fasteners installation system with no fasteners exposed on the exterior face of the work.
- J. Seal prefinished roof panels as required for weathertightness.
- K. Tolerances:
 - 1. Maximum Offset from True Alignment Between Adjacent Members Butting or in line: 1/16".
 - 2. Maximum Variation from Plane or Location Indicated on Drawings: 1/8".

3.3 TOUCH-UP AND CLEAN

- A. Touch-up:
 - 1. Defective materials shall be replaced with new materials.
 - 2. Field touch-up of scratches or defaced finish will be permitted only if approved by Architect.
- B. Cleaning: Clean exposed surfaces; leave free of soil and imperfections.

END OF SECTION

SECTION 07 59 00

ROOFING REPAIR

PART 1 - GENERAL

1.1 SUMMARY

- A. Section Includes: Modified Bitumen Roof repair work as a result of penetrations made or damage occurring to the roof membrane and flashings as part of the work of this contract.
 - 1. In order to maintain the existing warranty where new roofing will be tied into existing roofing, the Contractor shall obtain written approval from the existing roof manufacturer.
 - a. Confirm manufacturer of, and warranties applicable to, modified bitumen roof to be repaired as part of the work of this section.
- B. Related Sections:
 - 1. Section 07 55 52 - Modified Bituminous Membrane Roofing.
 - 2. Section 07 62 00 - Sheet Metal Flashing and Trim.
 - 3. Section 07 72 13 - Manufactured Roof Curbs and Portals.
 - 4. Section 07 72 33 - Roof Hatches.
 - 5. Division 22 - Plumbing.
 - 6. Division 23 - Heating, Ventilating and Air Conditioning.
 - 7. Division 26 - Electrical.

1.2 SYSTEM PERFORMANCE

- A. Flash, seal, counterflash and otherwise make watertight all roof membrane penetrations and repair all damages leaving membrane and flashings in a watertight condition.

1.3 SUBMITTALS

- A. General: Submit under provisions of SECTION 01 33 23 - SHOP DRAWINGS, PRODUCT DATA AND SAMPLES.
- B. Shop Drawings: Indicate layout, details, dimensions and interface with adjoining work.
- C. Product Data:
 - 1. Submit all data concerning each roof to be repaired.
 - 2. Submit written approval from the existing roof manufacturer that warranty shall be maintained.

1.4 QUALITY ASSURANCE

- A. Installer: Company specializing in roofing flashing and repair work with minimum 3 years experience. Use recommended detailing as indicated in NRCA Roofing Manual.

1.5 ENVIRONMENTAL REQUIREMENTS

- A. Do not apply materials during inclement weather or when temperatures are below 40°F.

1.6 COORDINATION

- A. Coordinate placement of curbs for roof mounted equipment with new openings cut into roof structure.

1.7 WARRANTY

- A. Maintain existing warranties.
- B. Provide a 2-year watertightness warranty from date of substantial completion for work of this section.

PART 2 - PRODUCTS

2.1 MANUFACTURERS AND PRODUCTS

- A. Utilize identical sheet, fluid-applied and bituminous materials, flashings, roof surfacing, fasteners, adhesives and accessories as original installation. On pipe penetrations, use flashing materials and techniques as recommended by NRCA utilizing portals mounted to curbs.

2.2 PERFORMANCE/DESIGN CRITERIA

- A. Wind Up-lift Requirements: Provide a roofing system that is identical to systems that have been successfully tested by a qualified testing and inspecting agency to resist wind uplift pressures calculated according to ASCE-7. Wind uplift pressures for this area, based on a 3-second gust shall be per structural notes and drawings.

2.3 ASPHALT FUME CONTROL

- A. It is essential that the fumes resulting from the execution of this work be prohibited from entering any of the existing buildings on campus and minimized in the atmosphere around the campus in the exterior.
- B. Contractor may elect any means of his choice to reduce the presence of asphaltic fumes, but the following are the minimum requirements:
 1. Conventional kettle application with approved fume recovery system.
 2. Enclosed tanker application with internal heating element and recycle fume recovery system.
 3. Extension of all existing air intake devices in affected areas to an upwind position.
 4. Providing emergency ventilation of any areas which become areas of complaints by the Owner.

2.4 COOK MIDDLE SCHOOL

- A. Existing assembly: Paradiene 2030 IH-T roof membrane system over a ½ wood fiber cover board and 1.0" Paratherm Polyisocyanurate insulation mopped with hot asphalt, over a mechanically fastened Parabase FS base sheet. (Siplast Guarantee No 25350). Heat and remove the foil of the Veral Aluminum base flashings at all of the mechanical curbs, expansion joints, and wall flashing conditions. Remove any wet/damaged/deteriorated membrane plies and repair any blisters with compatible materials, bringing them back to a level with surrounding surfaces and into a watertight condition. Replace all sheet metal components including gravel guard edge details and raised edge details, expansion joints, mechanical curbs, and walls. Metal gauge and finish should follow Cy-Fair I.S.D. guidelines; 0.040 Prefinished Aluminum.
- B. Internal Drain: Remove the lead and existing flashing plies 4 feet in each direction from the drains.
- C. Substrate preparation: Fastener withdrawal tests must be conducted prior to application to confirm what fastener is approved. Mechanically fasten the Paradiene 20/30 FR roof system through the rigid insulation and lightweight insulating concrete and anchor into the slotted galvanized metal deck. Please note that a moisture scan will be required on all membrane overlayers where the existing roof assembly has rigid insulation under the membrane.
 1. A copy of the report must be sent to Siplast Technical and Design Support for evaluation.

2.5 LABAY MIDDLE SCHOOL

- A. Existing assembly: Paradiene 2030 CBA-T roof membrane system over a mechanically fastened Parabase Plus base sheet. (Siplast Guarantee No 25392). Heat and remove the foil of the Veral Aluminum base flashings at all of the mechanical curbs, expansion joints, and wall flashing conditions. Remove any wet/damaged/deteriorated membrane plies and repair any blisters with compatible materials, bringing them back to a level with surrounding surfaces and into a watertight condition. Replace all sheet metal components including gravel guard edge details and raised edge details, expansion joints, mechanical curbs, and walls. Metal gauge and finish should follow Cy-Fair I.S.D. guidelines; 0.040 Prefinished Aluminum.
- B. Internal Drain: Remove the lead and existing flashing plies 4 feet in each direction from the drains.
- C. Substrate preparation: Fastener withdrawal tests must be conducted prior to application to confirm what fastener is approved. Mechanically fasten the Paradiene 20/30 FR roof system through the lightweight insulating concrete and anchor into the slotted galvanized metal deck.

PART 3 - EXECUTION

3.1 PROTECTION

- A. Protect existing building surfaces against damage from roofing installation.

3.2 PREPARATION

A. General

1. Prepare roof surfaces as recommended by manufacturer of original installation.
2. Sweep or vacuum all surfaces, removing all loose aggregate and foreign substances prior to commencement of roofing.

B. Remove All Existing:

1. Loose granules
2. Edge metal
3. Flanged metal flashings

- C. Wet Areas: Remove any areas of the existing assembly where moisture is present and replace with compatible materials, bringing the areas back to level with surrounding surfaces. Apply a layer of the specified stripping ply over all repaired areas prior to application of the finish ply.

- D. Walkpads: Remove any protective walk pads over the existing roof surface. Replace areas damaged during removal with additional layers of the specified stripping ply, applied in the specified adhesive, bringing the areas back to level with surrounding surfaces prior to application of the specified finish ply. Upon completion of the finish ply, install the new specified walk pads to replace the existing, at all access points and around all serviceable equipment.

- E. Preparation of the Existing Paradiene 30 FR Finish Ply: Sweep loose granules and remove blisters, buckles and surface irregularities. Patch all such areas; bringing them back level with surrounding surfaces using the specified membrane materials.

- F. Metal Edge: Remove and dispose of edge metal and flanged metal flashings. Apply the specified stripping ply at the roof edge, lapping a minimum of 18 inches over the prepared surface of the existing roof system. Turn the stripping ply past the roof edge and over the nailer.

- G. Flanged Metal Flashings: Cut the flanged metal flashings at roof level and remove/dispose of the materials/flashings that are not sandwiched between roofing plies.

- H. Roof Drains: Remove the strainers and clamping rings from the drain assemblies.

- I. Preparation Of The Existing Veral Aluminum Flashing Sheets: Apply a torch to the foil-faced surfaces of the existing flashing sheets and remove the foil surfacing. Score the foil surfaces at the laps of the sheets to facilitate removal. Care must be taken while scoring the foil surfacing to prevent cutting the underlying reinforcement.

- J. Cook Middle School - Reattachment of the existing roof system (Assembly 1): Mechanically fasten the Paradiene 20/30 FR roof system through the existing lightweight insulating deck and anchor into the metal deck using Parafast Fasteners at a specified length with 3-inch plates. Fasten each sheet every 24 inches through the laps and stagger fasten the remainder of the sheet in 1 row with fasteners on 24-inch centers.

- K. Labay Middle School - Reattachment of the existing roof system: Mechanically fasten the Paradiene 20/30 FR roof system through the existing lightweight insulating deck and anchor into the metal deck using Parafast Fasteners at a specified length with 3-inch plates. Fasten each sheet every 24 inches through the laps and stagger fasten the remainder of the sheet in 1 row with fasteners on 24-inch centers.

3.3 COOK MIDDLE SCHOOL - INSTALLATION SHEATHING PANEL

- A. Sheathing Panel (Assembly 2): Install the sheathing panel in an application of the specified insulation adhesive in 3/4- to 1-inch wide beads spaced 12 inches on center in the field of the roof, 6 inches on center at the perimeter of the roof, and 4 inches on center in the corners of the roof. Panels may be affected by post-growth of the insulation adhesive. Continuous walking in of the panels is recommended particularly in perimeter/corner areas with reduced bead spacing. Follow the requirements and guidelines of the insulation adhesive manufacturer/supplier. Stagger the panel joints between insulation layers.

3.4 ROOF MEMBRANE INSTALLATION – GENERAL

- A. Membrane Application: Apply roofing in accordance with the roofing system manufacturer's instructions and the following requirements. Application of roofing membrane components shall immediately follow application of base sheet and/or insulation as a continuous operation.
- B. Aesthetic Considerations: An aesthetically pleasing overall appearance of the finished roof application is a standard requirement for this project. Make necessary preparations, utilize recommended application techniques, apply the specified materials (i.e. granules, etc.), and exercise care in ensuring that the finished application is acceptable to the Owner.
- C. Membrane Adhesive Application: Apply cold adhesive in a smooth, even, continuous layer without breaks or voids at the rate of 1 1/2 to 2 1/2 gallons per square.
- D. Bitumen Consistency: Cutting or alteration of bitumen, primer, and sealants will not be permitted.
- E. Roofing Application: Apply all layers of roofing free of wrinkles, creases or fishmouths. Exert sufficient pressure on the roll during application to ensure prevention of air pockets.
 - 1. Apply all layers of roofing perpendicular to the slope of the deck.
 - 2. Fully bond the base ply to the prepared substrate, utilizing minimum 3 inch side and end laps. Apply each sheet directly behind the cold adhesive or torch applicator. Cut a dog ear angle at the end laps on overlapping selvage edges. Using a clean trowel, apply top pressure to top seal T-laps immediately following sheet application. Stagger end laps a minimum of 3 feet.
 - 3. Fully bond the finish ply to the base ply, utilizing minimum 3 inch side and end laps. Apply each sheet directly behind the cold adhesive or torch applicator. Stagger end laps of the finish ply a minimum 3 feet. Cut a dog ear angle at the end laps on overlapping selvage edges. Using a clean trowel, apply top pressure to top seal T-laps immediately following sheet application. Stagger side laps of the finish ply a minimum 12 inches from side laps in the underlying base ply. Stagger end laps of the finish ply a minimum 3 feet from end laps in the underlying base ply.
 - 4. Heat weld all side and end laps of the modified bitumen plies during each day's application in areas where standing water accumulates.
- F. Granule Embedment: Broadcast mineral granules over all bitumen/adhesive overruns on the finish ply surface to ensure a monolithic surface color.
- G. Flashing Application: Flash masonry parapet walls and curbs using the metal foil flashing membrane. After the finish ply has been applied to the top of the cant, prepare the surface area that is to receive flashing coverage by torch heating granular surfaces or by application of asphalt primer; allowing the primer to dry thoroughly. Torch apply the metal foil-faced flashing into place using three foot widths (cut off the end of roll) , always lapping the factory selvage edge. Extend the flashing sheet a minimum of 6 inches beyond the toe of the cant over the prepared surface of the finish ply and up the wall to the desired flashing height. Stagger the laps of the metal foil flashing layer from lap seams in the finish ply layer. Exert pressure on the flashing sheet during application to ensure complete contact with the prepared wall/roof surfaces, preventing air pockets; this can be accomplished by using a damp sponge or shop rag. Check and seal all loose laps and edges. Nail the top edge of the flashing on 9 inch centers.
- H. Water Cut-Off: At end of day's work, or when precipitation is imminent, construct a water cut-off at all open edges. Cut-offs can be built using asphalt or plastic cement and roofing felts, constructed to withstand protracted periods of service. Cut-offs must be completely removed prior to the resumption of roofing.

3.5 RELATED COMPONENTS – INSTALLATION

- A. Flashing And Repair Work
 - 1. General: Perform work in strict accordance with instructions and recommendations of the manufacturer of original installation materials.
 - 2. Cut holes for penetrations.
 - 3. Lay base flashing and seal down to membrane and penetration.
 - 4. Strip in flashing with multiple layers of felt and bitumen on built-up systems and with one layer of sheet material on single-ply systems.
 - 5. Counterflash as required to make watertight.

- B. Edge Metal: Completely prime metal flanges and allow to dry prior to installation. After the stripping ply of Paradiene 20 has been applied at the perimeter and the continuous cleat has been installed, set the edge metal flange in mastic and stagger nail every 3 inches on center. Strip-in the flange using the stripping-ply material, extending a minimum of 4 inches beyond the edge of the flange. Terminate the Paradiene 30 FR BW finish ply at the gravel-stop rise of the edge metal.

- C. Lead Pipe Flashings: Completely prime the lead flanges and allow to dry prior to installation. Set the flange in mastic around the penetration, and strip-in the flange using the stripping-ply material, extending a minimum of 4 inches beyond the edge of the flange. Terminate the finish ply at the flange-sleeve juncture of the pipe flashing.

- D. Flanged Metal Flashings: Set the flange of the new metal flashings in a full bed of PA-1021 Plastic Cement and secure the flange. Strip-in the flange using Paradiene 20, extending a minimum of 4 inches beyond the edge of the flange. Terminate the Paradiene 40 FR finish ply at the flange-sleeve juncture of the pipe flashing.

- E. Roof Drains: Install the Paradiene 30 FR BW finish ply to extend beneath the clamping ring seal, setting the finish ply in a full bed of PA-1021 Plastic Cement 6 inches beyond the perimeter of the drain bowl. Reinstall the clamping rings and strainers, ensuring that the clamping ring is secured using the torque specified by the drain manufacturer.

3.6 SPECIAL CONDITIONS

- A. Site Condition: Leave all areas around the job site free of debris, roofing materials, equipment and related items after completion of job.

- B. Notification Of Completion: Notify the manufacturer by means of manufacturer's printed Notification of Completion form of job completion in order to schedule a final inspection date.

- C. Final Inspection
 - 1. Post-Installation Meeting: Hold a meeting at the completion of the project, attended by all parties that were present at the pre-job conference. A punch list of items required for completion shall be compiled by the Contractor and the manufacturer's representative. Complete, sign, and mail the punch list form to the manufacturer's headquarters.

END OF SECTION

--- THIS PAGE INTENTIONALLY BLANK ---

SECTION 08 71 00

DOOR HARDWARE – COOK MIDDLE SCHOOL

PART 1 - GENERAL

1.1 RELATED DOCUMENTS

- A. Drawings and general provisions of the Contract, including General and Supplementary Conditions and Division 1 Specification Sections, apply to this Section.

1.2 SUMMARY

- A. This Section includes commercial door hardware for the following:
1. Swinging doors.
 2. Other doors to the extent indicated.
- B. Door hardware includes, but is not necessarily limited to, the following:
1. Mechanical door hardware.
 2. Electromechanical door hardware.
 3. Cylinders specified for doors in other sections.
- C. Related Sections:
1. Division 08 Section "Door Hardware Schedule".
 2. Division 08 Section "Hollow Metal Doors and Frames".
 3. Division 08 Section "Interior Aluminum Doors and Frames".
 4. Division 08 Section "Plastic Laminate Faced Wood Doors".
- D. Codes and References: Comply with the version year adopted by the Authority Having Jurisdiction.
1. ANSI A117.1 - Accessible and Usable Buildings and Facilities.
 2. ICC/IBC - International Building Code.
 3. NFPA 70 - National Electrical Code.
 4. NFPA 80 - Fire Doors and Windows.
 5. NFPA 101 - Life Safety Code.
 6. NFPA 105 - Installation of Smoke Door Assemblies.
 7. State Building Codes, Local Amendments.
- E. Standards: All hardware specified herein shall comply with the following industry standards:
1. ANSI/BHMA Certified Product Standards - A156 Series
 2. UL10C – Positive Pressure Fire Tests of Door Assemblies

1.3 SUBMITTALS

- A. Product Data: Manufacturer's product data sheets including installation details, material descriptions, dimensions of individual components and profiles, operational descriptions and finishes.

- B. Door Hardware Schedule: Prepared by or under the supervision of supplier, detailing fabrication and assembly of door hardware, as well as procedures and diagrams. Coordinate the final Door Hardware Schedule with doors, frames, and related work to ensure proper size, thickness, hand, function, and finish of door hardware.
1. Format: Comply with scheduling sequence and vertical format in DHI's "Sequence and Format for the Hardware Schedule."
 2. Organization: Organize the Door Hardware Schedule into door hardware sets indicating complete designations of every item required for each door or opening. Organize door hardware sets in same order as in the Door Hardware Sets at the end of Part 3. Submittals that do not follow the same format and order as the Door Hardware Sets will be rejected and subject to resubmission.
 3. Content: Include the following information:
 - a. Type, style, function, size, label, hand, and finish of each door hardware item.
 - b. Manufacturer of each item.
 - c. Fastenings and other pertinent information.
 - d. Location of door hardware set, cross-referenced to Drawings, both on floor plans and in door and frame schedule.
 - e. Explanation of abbreviations, symbols, and codes contained in schedule.
 - f. Mounting locations for door hardware.
 - g. Door and frame sizes and materials.
 - h. Warranty information for each product.
 4. Submittal Sequence: Submit the final Door Hardware Schedule at earliest possible date, particularly where approval of the Door Hardware Schedule must precede fabrication of other work that is critical in the Project construction schedule. Include Product Data, Samples, Shop Drawings of other work affected by door hardware, and other information essential to the coordinated review of the Door Hardware Schedule.
- C. Shop Drawings: Details of electrified access control hardware indicating the following:
1. Wiring Diagrams: Upon receipt of approved schedules, submit detailed system wiring diagrams for power, signaling, monitoring, communication, and control of the access control system electrified hardware. Differentiate between manufacturer-installed and field-installed wiring. Include the following:
 - a. Elevation diagram of each unique access controlled opening showing location and interconnection of major system components with respect to their placement in the respective door openings.
 - b. Complete (risers, point-to-point) access control system block wiring diagrams.
 - c. Wiring instructions for each electronic component scheduled herein.
 2. Electrical Coordination: Coordinate with related sections the voltages and wiring details required at electrically controlled and operated hardware openings.
- D. Proof of Certification: Provide copy of manufacturer(s) official certification or accreditation document indicating proof of status as a qualified installer of Windstorm assemblies.
- E. Keying Schedule: After a keying meeting with the owner has taken place prepare a separate keying schedule detailing final instructions. Submit the keying schedule in electronic format. Include keying system explanation, door numbers, key set symbols, hardware set numbers and special instructions. Owner must approve submitted keying schedule prior to the ordering of permanent cylinders/cores.

F. Informational Submittals:

1. Product Test Reports: Indicating compliance with cycle testing requirements, based on evaluation of comprehensive tests performed by manufacturer and witnessed by a qualified independent testing agency.

G. Operating and Maintenance Manuals: Provide manufacturers operating and maintenance manuals for each item comprising the complete door hardware installation in quantity as required in Division 01, Closeout Submittals.

1.4 QUALITY ASSURANCE

A. Manufacturers Qualifications: Engage qualified manufacturers with a minimum 5 years of documented experience in producing hardware and equipment similar to that indicated for this Project and that have a proven record of successful in-service performance.

B. Installer Qualifications: A minimum 3 years documented experience hardware similar in material, design, and extent to that indicated for this Project and whose work has resulted in construction with a record of successful in-service performance.

C. Door Hardware Supplier Qualifications: Experienced commercial door hardware distributors with a minimum 5 years documented experience supplying hardware installations comparable in material, design, and extent to that indicated for this Project. Supplier recognized as a factory direct distributor by the manufacturers of the primary materials with a warehousing facility in Project's vicinity. Supplier to have on staff a certified Architectural Hardware Consultant (AHC) available during the course of the Work to consult with Contractor, Architect, and Owner concerning both standard and electromechanical door hardware and keying.

D. Integrated Wiegand, Wireless, and IP-Enabled Access Control Products Supplier Qualifications: Integrated access control products and accessories are required to be supplied and installed through current members of the ASSA ABLOY "Authorized Channel Partner" (ACP) and "Certified Integrator" (CI) programs. Suppliers are to be factory trained, certified prior to project bid, and a direct purchaser of the specified product. Installers are to be factory trained, certified prior to project bid, and are responsible for commissioning, servicing, and warranting the installed equipment specified for the project.

E. Source Limitations: Obtain each type and variety of door hardware specified in this section from a single source unless otherwise indicated.

1. Electrified modifications or enhancements made to a source manufacturer's product line by a secondary or third party source will not be accepted.
2. Provide electromechanical door hardware from the same manufacturer as mechanical door hardware, unless otherwise indicated

F. Each unit to bear third party permanent label demonstrating compliance with the referenced standards.

G. Keying Conference: Conduct conference to comply with requirements in Division 01 Section "Project Meetings." Keying conference to incorporate the following criteria into the final keying schedule document:

1. Function of building, purpose of each area and degree of security required.
2. Plans for existing and future key system expansion.
3. Requirements for key control storage and software.
4. Installation of permanent keys, cylinder cores and software.
5. Address and requirements for delivery of keys.

- H. Pre-Submittal Conference: Conduct coordination conference in compliance with requirements in Division 01 Section "Project Meetings" with attendance by representatives of Supplier(s), Installer(s), and Contractor(s) to review proper methods and the procedures for receiving, handling, and installing door hardware.
 - 1. Prior to installation of door hardware, conduct a project specific training meeting to instruct the installing contractors' personnel on the proper installation and adjustment of their respective products. Product training to be attended by installers of door hardware (including electromechanical hardware) for aluminum, hollow metal and wood doors. Training will include the use of installation manuals, hardware schedules, templates and physical product samples as required.
 - 2. Inspect and discuss electrical roughing-in, power supply connections, and other preparatory work performed by other trades.
 - 3. Review sequence of operation narratives for each unique access controlled opening.
 - 4. Review and finalize construction schedule and verify availability of materials.
 - 5. Review the required inspecting, testing, commissioning, and demonstration procedures
- I. At completion of installation, provide written documentation that components were applied to manufacturer's instructions and recommendations and according to approved schedule.

1.5 DELIVERY, STORAGE, AND HANDLING

- A. Inventory door hardware on receipt and provide secure lock-up and shelving for door hardware delivered to Project site.
- B. Tag each item or package separately with identification related to the final Door Hardware Schedule, and include basic installation instructions with each item or package.
- C. Deliver, as applicable, permanent keys, cylinders, cores and related accessories directly to Owner via registered mail or overnight package service. Instructions for delivery to the Owner shall be established at the "Keying Conference".

1.6 COORDINATION

- A. Templates: Obtain and distribute to the parties involved templates for doors, frames, and other work specified to be factory prepared for installing hardware. Check Shop Drawings of other work to confirm that adequate provisions are made for locating and installing hardware to comply with indicated requirements.
- B. Door Hardware and Electrical Connections: Coordinate the layout and installation of scheduled electrified door hardware and related access control equipment with required connections to source power junction boxes, low voltage power supplies, detection and monitoring hardware, and fire and detection alarm systems.
- C. Door and Frame Preparation: Doors and corresponding frames are to be prepared, reinforced and pre-wired (if applicable) to receive the installation of the specified electrified, monitoring, signaling and access control system hardware without additional in-field modifications.

1.7 WARRANTY

- A. General Warranty: Reference Division 01, General Requirements. Special warranties specified in this Article shall not deprive Owner of other rights Owner may have under other provisions of the Contract Documents and shall be in addition to, and run concurrent with, other warranties made by Contractor under requirements of the Contract Documents.

- B. Warranty Period: Written warranty, executed by manufacturer(s), agreeing to repair or replace components of standard and electrified door hardware that fails in materials or workmanship within specified warranty period after final acceptance by the Owner. Failures include, but are not limited to, the following:
 - 1. Structural failures including excessive deflection, cracking, or breakage.
 - 2. Faulty operation of the hardware.
 - 3. Deterioration of metals, metal finishes, and other materials beyond normal weathering.
 - 4. Electrical component defects and failures within the systems operation.
- C. Standard Warranty Period: One year from date of Substantial Completion, unless otherwise indicated.
- D. Special Warranty Periods:
 - 1. Lifetime for mortise locks and latches.
 - 2. Five years for exit hardware.
 - 3. Ten years for electric latch retraction exit motors
 - 4. Twenty-five years for manual surface door closer bodies.
 - 5. Two years for electromechanical door hardware.
 - 6. Lifetime for SN200 readers.

1.8 MAINTENANCE SERVICE

- A. Maintenance Tools and Instructions: Furnish a complete set of specialized tools and maintenance instructions as needed for Owner's continued adjustment, maintenance, and removal and replacement of door hardware.

1.9 OWNER STOCK – See Attic Stock at the end of Hardware Schedule.

PART 2 - PRODUCTS

2.1 SCHEDULED DOOR HARDWARE

- A. General: Provide door hardware for each door to comply with requirements in Door Hardware Sets and each referenced section that products are to be supplied under.
- B. Designations: Requirements for quantity, item, size, finish or color, grade, function, and other distinctive qualities of each type of door hardware are indicated in the Door Hardware Sets at the end of Part 3. Products are identified by using door hardware designations, as follows:
- C. Named Manufacturer's Products: Product designation and manufacturer are listed for each door hardware type required for the purpose of establishing requirements. Manufacturers' names are abbreviated in the Door Hardware Schedule.
- D. Substitutions: Requests for substitution and product approval for inclusive mechanical and electromechanical door hardware in compliance with the specifications must be submitted in writing and in accordance with the procedures and time frames outlined in Division 01, Substitution Procedures. Approval of requests is at the discretion of the architect, owner, and their designated consultants.

2.2 HANGING DEVICES

- A. Hinges: ANSI/BHMA A156.1 certified butt hinges with number of hinge knuckles as specified in the Door Hardware Sets.
1. Quantity: Provide the following hinge quantity, unless otherwise indicated:
 - a. Two Hinges: For doors with heights up to 60 inches.
 - b. Three Hinges: For doors with heights 61 to 90 inches.
 - c. Four Hinges: For doors with heights 91 to 120 inches.
 - d. For doors with heights more than 120 inches, provide 4 hinges, plus 1 hinge for every 30 inches of door height greater than 120 inches.
 2. Hinge Size: Provide the following, unless otherwise indicated, with hinge widths sized for door thickness and clearances required:
 - a. Widths up to 3'0": 4-1/2" standard or heavy weight as specified.
 - b. Sizes from 3'1" to 4'0": 5" standard or heavy weight as specified.
 3. Hinge Weight and Base Material: Unless otherwise indicated, provide the following:
 - a. Exterior Doors: Heavy weight, non-ferrous, ball bearing or oil impregnated bearing hinges unless Hardware Sets indicate standard weight.
 - b. Interior Doors: Standard weight, steel, ball bearing or oil impregnated bearing hinges unless Hardware Sets indicate heavy weight.
 4. Hinge Options: Comply with the following where indicated in the Hardware Sets or on Drawings:
 - a. Non-removable Pins: Provide set screw in hinge barrel that, when tightened into a groove in hinge pin, prevents removal of pin while door is closed; for the all out-swinging lockable doors.
 5. Acceptable Manufacturers:
 - a. Hager Companies (HA).
 - b. McKinney Products (MK).
 - c. Stanley Hardware (ST).
- B. Continuous Geared Hinges: ANSI/BHMA A156.26 Grade 1-600 certified continuous geared hinge. with minimum 0.120-inch thick extruded 6060 T6 aluminum alloy hinge leaves and a minimum overall width of 4 inches. Hinges are non-handed, reversible and fabricated to template screw locations. Factory trim hinges to suit door height and prepare for electrical cut-outs.
1. Acceptable Manufacturers:
 - a. McKinney Products (MK).
 - b. Pemko Manufacturing (PE).
 - c. Stanley Hardware (ST).

2.3 POWER TRANSFER DEVICES

- A. Concealed Quick Connect Electric Power Transfers: Provide concealed wiring pathway housing mortised into the door and frame for low voltage electrified door hardware. Furnish with Molex™ standardized plug connectors and sufficient number of concealed wires (up to 12) to accommodate the electrified functions specified in the Door Hardware Sets. Connectors plug directly to through-door wiring harnesses for connection to electric locking devices and power supplies. Wire nut connections are not acceptable.
1. Acceptable Manufacturers:
 - a. Pemko Manufacturing (PE) – EL-CEPT Series.
 - b. Securitron (SU) - EL-CEPT Series.
 - c. Stanley Hardware (ST) EPT-12C Series.
- B. Electric Door Wire Harnesses: Provide electric/data transfer wiring harnesses with standardized plug connectors to accommodate up to twelve (12) wires. Connectors plug directly to through-door wiring harnesses for connection to electric locking devices and power supplies. Provide sufficient number and type of concealed wires to accommodate electric function of specified hardware. Provide a connector for through-door electronic locking devices and from hinge to junction box above the opening. Wire nut connections are not acceptable. Determine the length required for each electrified hardware component for the door type, size and construction, minimum of two per electrified opening.
1. Provide one each of the following tools as part of the base bid contract:
 - a. McKinney Products (MK) - Electrical Connecting Kit: QC-R001.
 - b. McKinney Products (MK) - Connector Hand Tool: QC-R003.

2.4 DOOR OPERATING TRIM

- A. Flush Bolts and Surface Bolts: ANSI/BHMA A156.3 and A156.16, Grade 1, certified.
1. Manual flush bolts to be furnished with top rod of sufficient length to allow bolt location approximately six feet from the floor.
 2. Furnish dust proof strikes for bottom bolts.
 3. Surface bolts to be minimum 8" in length and U.L. listed for labeled fire doors and U.L. listed for windstorm components where applicable.
 4. Provide related accessories (mounting brackets, strikes, coordinators, etc.) as required for appropriate installation and operation.
 5. Acceptable Manufacturers:
 - a. Ives (IV).
 - b. Rockwood Manufacturing (RO).
 - c. Trimco (TC).
- B. Door Push Plates and Pulls: ANS/BHMA A156.6 certified door pushes and pulls of type and design specified in the Hardware Sets. Coordinate and provide proper width and height as required where conflicting hardware dictates.
1. Push/Pull Plates: Minimum .050 inch thick, size as indicated in hardware sets, with beveled edges, secured with exposed screws unless otherwise indicated.
 2. Door Pull and Push Bar Design: Size, shape, and material as indicated in the hardware sets. Minimum clearance of 2 1/2-inches from face of door unless otherwise indicated.
 3. Offset Pull Design: Size, shape, and material as indicated in the hardware sets. Minimum clearance of 2 1/2-inches from face of door and offset of 90 degrees unless otherwise indicated.
 4. Fasteners: Provide manufacturer's designated fastener type as indicated in Hardware Sets.

5. Acceptable Manufacturers:
 - a. Ives (IV).
 - b. Rockwood Manufacturing (RO).
 - c. Trimco (TC).

2.5 CYLINDERS AND KEYING

- A. General: Cylinder manufacturer to have minimum (10) years experience designing secured master key systems and have on record a published security keying system policy.
- B. Source Limitations: Obtain each type of keyed cylinder and keys from the same source manufacturer as locksets and exit devices, unless otherwise indicated.
 1. Acceptable Manufacturers:
 - a. Stanley Best (BE).
 - b. Sargent Cylinder Housings
 - c. No Substitution.
- C. Cylinders: Original manufacturer cylinders complying with the following:
 1. Mortise Type: Threaded cylinders with rings and cams to suit hardware application.
 2. Rim Type: Cylinders with back plate, flat-type vertical or horizontal tailpiece, and raised trim ring.
 3. Bored-Lock Type: Cylinders with tailpieces to suit locks.
 4. Mortise and rim cylinder collars to be solid and recessed to allow the cylinder face to be flush and be free spinning with matching finishes.
 5. Keyway: Match Facility Standard.
- D. Keying System: Each type of lock and cylinders to be factory keyed.
 1. Conduct specified "Keying Conference" to define and document keying system instructions and requirements.
 2. Furnish factory cut, nickel-silver large bow permanently inscribed with a visual key control number as directed by Owner.
 3. Existing System: Key locks to Owner's existing system.
- E. Key Quantity: Provide the following minimum number of keys:
 1. Change Keys per Cylinder: Two (2)
 2. Twenty construction cores
 3. 50 Key Blanks – Best "A" Keyway
- F. Construction Keying: Provide temporary keyed construction cores. Green Best Cores No Substitution . All Best temporary cores to be returned to the district at the end of the project.
- G. Key Registration List (Bitting List):
 1. Provide keying transcript list to Owner's representative in the proper format for importing into key control software.
 2. Provide transcript list in writing or electronic file as directed by the Owner.

- H. Key Control Cabinet: Provide a key control system including envelopes, labels, and tags with self-locking key clips, receipt forms, 3-way visible card index, temporary markers, permanent markers, and standard metal cabinet. Key control cabinet shall have expansion capacity of 150% of the number of locks required for the project. Provide a new cabinet to all new construction projects. Use Lund 1205-B as a basis of design.

1. Acceptable Manufacturers:

- a. Lund Equipment (LU).
- b. MMF Industries (MM).
- c. Telkee (TK).

2.6 MECHANICAL LOCKS AND LATCHING DEVICES

- A. Mortise Locksets, Grade 1 (Heavy Duty): ANSI/BHMA A156.13. Locksets are to be manufactured with a corrosion resistant steel case and be field-reversible for handing without disassembly of the lock body.

1. Acceptable Manufacturers

- a. Sargent Manufacturing (SA) 8200 Series – No substitutions
- b. Sargent Manufacturing (SA) 10X Series - No substitutions
 - 1) Use at student restrooms or as directed by Cy Fair ISD

2.7 AUXILIARY LOCKS

- A. Tubular Deadlocks: Deadlocks to be products of the same source manufacturer and keyway as other specified locksets.

1. Acceptable Manufacturers:

- a. Marks (MX) - 130 Series.
- b. Sargent Manufacturing (SA) – 480 Series.

2.8 LOCK AND LATCH STRIKES

- A. Strikes: Provide manufacturer's standard strike with strike box for each latch or lock bolt, with curved lip extended to protect frame, finished to match door hardware set, unless otherwise indicated, and as follows:

1. Flat-Lip Strikes: For locks with three-piece antifriction latchbolts, as recommended by manufacturer.
2. Aluminum-Frame Strike Box: Provide manufacturer's special strike box fabricated for aluminum framing.

- B. Standards: Comply with the following:

1. Strikes for Mortise Locks and Latches: BHMA A156.13.
2. Strikes for Auxiliary Deadlocks: BHMA A156.5.
3. Dustproof Strikes: BHMA A156.16.

2.9 CONVENTIONAL EXIT DEVICES

A. General Requirements: All exit devices specified herein shall meet or exceed the following criteria:

1. At doors not requiring a fire rating, provide devices complying with NFPA 101 and listed and labeled for "Panic Hardware" according to UL305. Provide proper fasteners as required by manufacturer including sex nuts and bolts at openings specified in the Hardware Sets.
2. Where exit devices are required on fire rated doors, provide devices complying with NFPA 80 and with UL labeling indicating "Fire Exit Hardware". Provide devices with the proper fasteners for installation as tested and listed by UL. Consult manufacturer's catalog and template book for specific requirements.
3. Except on fire rated doors, provide exit devices with hex key dogging device to hold the pushbar and latch in a retracted position. Provide optional keyed cylinder dogging on devices where specified in Hardware Sets.
4. Devices must fit flat against the door face with no gap that permits unauthorized dogging of the push bar. The addition of filler strips is required in any case where the door light extends behind the device as in a full glass configuration.
5. Lever Operating Trim: Where exit devices require lever trim, furnish manufacturer's heavy duty escutcheon trim with threaded studs for thru-bolts.
 - a. Lock Trim Design: As indicated in Hardware Sets, provide finishes and designs to match that of the specified locksets.
 - b. Where function of exit device requires a cylinder, provide a cylinder (Rim or Mortise) as specified in Hardware Sets.
6. Rail Sizing: Provide exit device rails factory sized for proper door width application.
7. Through Bolt Installation: For exit devices and trim as indicated (TB) in Door Hardware Sets.
8. Provide Less Dogging (LD) at all exit devices.
9. Add 31- Prefix to all exit devices being provided at two inch aluminum doors.
10. No self-tapping screws allowed.

B. Conventional Push Rail Exit Devices (Heavy Duty): ANSI/BHMA A156.3, Grade 1 certified panic and fire exit hardware devices furnished in the functions specified in the Hardware Sets. Exit device latch to be stainless steel, pullman type, with deadlock feature.

1. Acceptable Manufacturers:
 - a. Sargent Manufacturing (SA) - 80 Series.
 - b. No Substitution.

C. Tube Steel Removable Mullions: ANSI/BHMA A156.3 removable steel mullions with malleable-iron top and bottom retainers and a primed paint finish.

1. Provide keyed removable feature where specified in the Hardware Sets.
2. Provide stabilizers and mounting brackets as required.
3. Provide electrical quick connection wiring options as specified in the hardware sets.

4. Acceptable Manufacturers:
 - a. Stanley Precision (PR) - 822 Series.
 - b. No Substitution.

2.10 INTEGRATED WIEGAND OUTPUT ACCESS CONTROL EXIT DEVICES

- A. Wiegand Output Integrated Card Reader Exit Hardware: Wiegand output ANSI 156.3 Grade 1 rim, mortise, and vertical rod exit device hardware with integrated proximity card reader, latchbolt and touchbar monitoring, and request-to-exit signaling, in one complete unit. Hard wired, solenoid driven locking/unlocking control of the lever handle exit trim with 3/4" throw latch bolt. U.L listed and labeled for either panic or "fire exit hardware" for use on up to 3 hour fire rated openings. Available with or without keyed high security cylinder override.
 1. Open architecture, hard wired platform supports centralized control of locking units with new or existing Wiegand compatible access control systems. Inside push bar (request-to-exit) signaling and door position (open/closed status) monitoring (via separately connected DPS).
 2. Reader supports either HID 125 kHz proximity (up to 39 bits, including Corporate 1000) or 13.56 MHz (2K-32K) iClass® credentials.
 3. 12VDC external power supply required for reader, with optional 24VDC operation available with iClass® reader (125 kHz reader is always 12VDC). 24VDC required for solenoid operated exit trim (12VDC if applicable). Fail safe or fail secure options.
 4. Installation requires only one cable run from the exit hardware to the access control panel without requirements for additional proprietary lock panel interface boards or modules.
 5. Acceptable Manufacturers:
 - a. Sargent Manufacturing (SA) - SN – 56-SN20080 Series Exits. x SPAR04867
 - b. Sargent Manufacturing (SA) - SN – SN2008200 Series Locks.
 - c. No Substitution.

2.11 DOOR CLOSERS

- A. All door closers specified herein shall meet or exceed the following criteria:
 1. General: Door closers to be from one manufacturer, matching in design and style, with the same type door preparations and templates regardless of application or spring size. Closers to be non-handed with full sized covers including installation and adjusting information on inside of cover.
 2. Standards: Closers to comply with UL-10C for Positive Pressure Fire Test and be U.L. listed for use of fire rated doors.
 3. Cycle Testing: Provide closers which have surpassed 15 million cycles in a test witnessed and verified by UL.
 4. Size of Units: Comply with manufacturer's written recommendations for sizing of door closers depending on size of door, exposure to weather, and anticipated frequency of use. Where closers are indicated for doors required to be accessible to the physically handicapped, provide units complying with ANSI ICC/A117.1.
 5. Closer Arms: Provide heavy duty, forged steel closer arms unless otherwise indicated in Hardware Sets.
 6. Closers shall not be installed on exterior or corridor side of doors; where possible install closers on door for optimum aesthetics.

7. Closer Accessories: Provide door closer accessories including custom templates, special mounting brackets, spacers and drop plates, and through-bolt and security type fasteners as required for proper installation.
 8. Through Bolt Installation: All door closers are to be installed with (TB) through bolting as indicated in Door Hardware Sets.
 9. No self-tapping screws allowed.
- B. Door Closers, Surface Mounted (Heavy Duty): ANSI/BHMA A156.4, Grade 1 surface mounted, heavy duty door closers with complete spring power adjustment, sizes 1 thru 6; and fully operational adjustable according to door size, frequency of use, and opening force. Closers to be rack and pinion type, one piece cast iron or aluminum alloy body construction, with adjustable backcheck and separate non-critical valves for closing sweep and latch speed control. Provide non-handed units standard.
1. Acceptable Manufacturers:
 - a. Sargent Manufacturing (SA) – TB 351 Series.

2.12 SURFACE MOUNTED CLOSER HOLDERS

- A. Electromagnetic Door Holders: Certified ANSI A156.15 electromagnetic door holder/releases with a minimum 20 to 40 pounds holding power and single coil construction able to accommodate 12VDC, 24VAC, 24VDC and 120VAC. Coils to be independently wound, employing an integral fuse and armatures to include a positive release button.
1. Acceptable Manufacturers:
 - a. LCN Door Closers (LC) - SEM7800 Series.
 - b. Rixson (RF) - 980/990 Series.
 - c. Sargent Manufacturing (SA) - 1560 Series.

2.13 ARCHITECTURAL TRIM

- A. Door Protective Trim
1. General: Door protective trim units to be of type and design as specified below or in the Hardware Sets.
 2. Size: Fabricate protection plates (kick, armor, or mop) not more than 2" less than door width (LDW) on stop side of single doors and 1" LDW on stop side of pairs of doors, and not more than 1" less than door width on pull side. Coordinate and provide proper width and height as required where conflicting hardware dictates. Height to be as specified in the Hardware Sets.
 3. Protection Plates: ANSI/BHMA A156.6 certified protection plates (kick, armor, or mop), fabricated from the following:
 - a. Stainless Steel: 300 grade, 050-inch thick.
 4. Options and fasteners: Provide manufacturer's designated fastener type as specified in the Hardware Sets. Provide countersunk screw holes.

5. Acceptable Manufacturers:

- a. Ives (IV).
- b. Rockwood Manufacturing (RO).
- c. Trimco (TC).

2.14 DOOR STOPS AND HOLDERS

A. General: Door stops and holders to be of type and design as specified below or in the Hardware Sets.

B. Door Stops and Bumpers: ANSI/BHMA A156.16, Grade 1 certified door stops and wall bumpers. Provide wall bumpers, either convex or concave types with anchorage as indicated, unless floor or other types of door stops are specified in Hardware Sets. Do not mount floor stops where they will impede traffic. Where floor or wall bumpers are not appropriate, provide overhead type stops and holders.

1. Acceptable Manufacturers:

- a. Ives (IV).
- b. Rockwood Manufacturing (RO).
- c. Trimco (TC).

C. Overhead Door Stops and Holders: ANSI/BHMA A156.6, Grade 1 certified overhead stops and holders to be surface or concealed types as indicated in Hardware Sets. Track, slide, arm and jamb bracket to be constructed of extruded bronze and shock absorber spring of heavy tempered steel. Provide non-handed design with mounting brackets as required for proper operation and function.

1. Acceptable Manufacturers:

- a. Do not use overhead stops/holders

2.15 ARCHITECTURAL SEALS

A. General: Thresholds, weatherstripping, and gasket seals to be of type and design as specified below or in the Hardware Sets. Provide continuous weatherstrip gasketing on exterior doors and provide smoke, light, or sound gasketing on interior doors where indicated. At exterior applications provide non-corrosive fasteners and elsewhere where indicated.

B. Smoke Labeled Gasketing: Assemblies complying with NFPA 105 that are listed and labeled by a testing and inspecting agency acceptable to authorities having jurisdiction, for smoke control ratings indicated, based on testing according to UL 1784.

1. Provide smoke labeled perimeter gasketing at all smoke labeled openings.

C. Fire Labeled Gasketing: Assemblies complying with NFPA 80 that are listed and labeled by a testing and inspecting agency acceptable to authorities having jurisdiction, for fire ratings indicated, based on testing according to UL-10C.

1. Provide intumescent seals as indicated to meet UL10C Standard for Positive Pressure Fire Tests of Door Assemblies, and UBC 7-2, Fire Tests of Door Assemblies.

D. No Replaceable Seal Strips allowed: Provide only those units where they can be screw applied..

E. Acceptable Manufacturers:

1. National Guard Products (NG).

2. Pemko Manufacturing (PE).
3. Reese Enterprises, Inc. (RE).

2.16 ELECTRONIC ACCESSORIES

- A. Door Position Switches: Door position magnetic reed contact switches specifically designed for use in commercial door applications. On recessed models the contact and magnetic housing snap-lock into a 1" diameter hole. Surface mounted models include wide gap distance design complete with armored flex cabling. Provide SPDT, N/O switches with optional Rare Earth Magnet installation on steel doors with flush top channels.

1. Acceptable Manufacturers:

- a. Provided by Security

- B. Switching Power Supplies: Provide UL listed or recognized filtered and regulated power supplies. Provide single, dual, or multi-voltage units as shown in the hardware sets. Units must be expandable up to eight Class 2 power limited outputs. Units must include the capability to incorporate a battery backup option with integral battery charging capability in addition to operating the DC load in event of line voltage failure. Provide the least number of units, at the appropriate amperage level, sufficient to exceed the required total draw for the specified electrified hardware and access control equipment.

1. Acceptable Manufacturers:

- a. Provided by Security

2.17 FABRICATION

- A. Fasteners: Provide door hardware manufactured to comply with published templates generally prepared for machine, wood, and sheet metal screws. Provide screws according to manufacturers recognized installation standards for application intended.

2.18 FINISHES

- A. Standard: Designations used in the Hardware Sets and elsewhere indicate hardware finishes complying with ANSI/BHMA A156.18, including coordination with traditional U.S. finishes indicated by certain manufacturers for their products.
- B. Provide quality of finish, including thickness of plating or coating (if any), composition, hardness, and other qualities complying with manufacturer's standards, but in no case less than specified by referenced standards for the applicable units of hardware.
- C. Protect mechanical finishes on exposed surfaces from damage by applying a strippable, temporary protective covering before shipping.

PART 3 - EXECUTION

3.1 EXAMINATION

- A. Examine scheduled openings, with Installer present, for compliance with requirements for installation tolerances, labeled fire door assembly construction, wall and floor construction, and other conditions affecting performance.

- B. Notify architect of any discrepancies or conflicts between the door schedule, door types, drawings and scheduled hardware. Proceed only after such discrepancies or conflicts have been resolved in writing.

3.2 PREPARATION

- A. Hollow Metal Doors and Frames: Comply with ANSI/DHI A115 series.
- B. Wood Doors: Comply with ANSI/DHI A115-W series.

3.3 INSTALLATION

- A. Install each item of mechanical and electromechanical hardware and access control equipment to comply with manufacturer's written instructions and according to specifications.
 - 1. Installers are to be trained and certified by the manufacturer on the proper installation and adjustment of fire, life safety, and security products including: hanging devices; locking devices; closing devices; and seals.
- B. Mounting Heights: Mount door hardware units at heights indicated in following applicable publications, unless specifically indicated or required to comply with governing regulations:
 - 1. Standard Steel Doors and Frames: DHI's "Recommended Locations for Architectural Hardware for Standard Steel Doors and Frames."
 - 2. Wood Doors: DHI WDHS.3, "Recommended Locations for Architectural Hardware for Wood Flush Doors."
 - 3. Where indicated to comply with accessibility requirements, comply with ANSI A117.1 "Accessibility Guidelines for Buildings and Facilities."
 - 4. Provide blocking in drywall partitions where wall stops or other wall mounted hardware is located.
- C. Integrated Wiegand access control products are required to be installed through current members of the ASSA ABLOY "Certified Integrator" (CI) program.
- D. Retrofitting: Install door hardware to comply with manufacturer's published templates and written instructions. Where cutting and fitting are required to install door hardware onto or into surfaces that are later to be painted or finished in another way, coordinate removal, storage, and reinstallation of surface protective trim units with finishing work specified in Division 9 Sections. Do not install surface-mounted items until finishes have been completed on substrates involved.
- E. Thresholds: Set thresholds for exterior and acoustical doors in full bed of sealant complying with requirements specified in Division 7 Section "Joint Sealants."
- F. Storage: Provide a secure lock up for hardware delivered to the project but not yet installed. Control the handling and installation of hardware items so that the completion of the work will not be delayed by hardware losses before and after installation.
- G. No self-tapping screws allowed.

3.4 FIELD QUALITY CONTROL

- A. Field Inspection: Supplier will perform a final inspection of installed door hardware and state in report whether work complies with or deviates from requirements, including whether door hardware is properly installed, operating and adjusted.

3.5 ADJUSTING

- A. Initial Adjustment: Adjust and check each operating item of door hardware and each door to ensure proper operation or function of every unit. Replace units that cannot be adjusted to operate as intended. Adjust door control devices to compensate for final operation of heating and ventilating equipment and to comply with referenced accessibility requirements.
- B. Final Adjustment: Installer shall return and make final adjustment of all hardware once all air conditioning test and balance is complete. Final adjustment shall be made while air conditioner system is operating. Coordinate with General Contractor and Owner.

3.6 CLEANING AND PROTECTION

- A. Protect all hardware stored on construction site in a covered and dry place. Protect exposed hardware installed on doors during the construction phase. Install any and all hardware at the latest possible time frame.
- B. Clean adjacent surfaces soiled by door hardware installation.
- C. Clean operating items as necessary to restore proper finish. Provide final protection and maintain conditions that ensure door hardware is without damage or deterioration at time of owner occupancy.

3.7 DEMONSTRATION

- A. Instruct Owner's maintenance personnel to adjust, operate, and maintain mechanical and electromechanical door hardware.

3.8 DOOR HARDWARE SETS

The hardware sets represent the design intent and direction of the owner and architect. They are a guideline only and should not be considered a detailed hardware schedule. Discrepancies, conflicting hardware and missing items should be brought to the attention of the architect with corrections made prior to the bidding process. Omitted items not included in a hardware set should be scheduled with the appropriate additional hardware required for proper application and functionality.

- A. Manufacturer's Abbreviations:

- 1. MK - McKinney
- 2. OT - OTHER
- 3. PE - Pemko
- 4. RO - Rockwood
- 5. PR - Precision
- 6. MX - Marks
- 7. SA - Sargent
- 8. AD - Adams Rite
- 9. BE - Best Access Systems
- 10. RF - Rixson
- 11. AK - Alarm Controls

Hardware Sets

Set: 1.0

Door: 19
Description: Add SN200 reader and 2 door viewers

1	SN200 Reader	52 6027 (Exit / Lock)	26D	SA
2	Viewer	622	CRM	RO
1	Balance of hardware	Existing to remain		OT

Set: 2.0

Doors: 10, 15
Description: Replace 462 stop pair

2	Door Stop	462	US2C	RO
1	Balance of hardware	Existing to remain		OT

Set: 2.1

Doors: 13, 14, 25, 28
Description: Replace 462 stop

1	Door Stop	462	US2C	RO
1	Balance of hardware	Existing to remain		OT

Set: 3.0

Doors: 22
Description: Replace new 351 closers

2	Surface Closer	TB 351 PS	EN	SA
1	Balance of hardware	Existing to remain		OT

Set: 4.0

Doors: 20
Description: New 56-8804 exit, 2N station, loop, gasketing, 462 stop

1	Continuous Hinge	CFM HD1 x Dr. Ht.		PE
1	Rim Exit Device, Storeroom	LD 19 TB 43 56 70 8804 Less Pull	US32D	SA
1	Vandal Resistant Trim	826	US32D	SA
1	Door Stop	462	US2C	RO
1	Gasketing	2891APK (head & jambs)		PE
1	Rain Guard	346C x Frame Width		PE
1	Sweep	345ANB x Dr. Width		PE
1	Threshold	2005AT MSES25SS X Opening Width		PE
1	Card Reader	by security		OT
1	ElectroLynx Harness	QC-C1500P		MK
1	ElectroLynx Harness	QC-C***P (length as req'd)		MK
1	Door Loop	DL-2		AK

Cook-Labay-Truitt MS Renovations
 Cypress-Fairbanks Independent School District
 Houston, Texas

1	Door Position Switch	By Security.		OT
1	Power Supply	Provided by security		SU

Notes: New 2N station

Set: 5.0

Doors: 1

Description: Existing add 8804 exit and 8810 exit, 462 stop

1	Rim Exit Device, Storeroom	LD 19 TB 43 70 8804 Less Pull	US32D	SA
1	Rim Exit Device, Exit Only	LD 19 TB 43 8810 EO	US32D	SA
2	Door Stop	462	US2C	RO
1	Balance of hardware	Existing to remain		OT

Set: 6.0

Doors: 26, 27

Description: Existing add SN200 exit, gasketing, loop, 462 stop

1	Rim Exit x SPAR04867/NC-E11	19 LD TB 43 70 56-SN200-8804	US32D	SA
1	Interchangeable Core	I/CK-7	626	BE
1	Const. Core	7190224	Green	BE
1	Door Stop	462	US2C	RO
1	Gasketing	2891APK (head & jambs)		PE
1	ElectroLynx Harness	QC-C1500P		MK
1	ElectroLynx Harness	QC-C***P (length as req'd)		MK
1	Door Loop	DL-2		AK
1	Balance of hardware	Existing to remain		OT

Set: 6.1

Doors: 11, 12, 17, 21, 5, 6, 7, 8, 9

Description: Existing add SN200 exit, gasketing, loop, 462 stop

1	Rim Exit x SPAR04867/NC-E11	19 LD TB 43 70 56-SN200-8804	US32D	SA
1	Interchangeable Core	I/CK-7	626	BE
1	Const. Core	7190224	Green	BE
1	Door Stop	462	US2C	RO
1	Gasketing	2891APK (head & jambs)		PE
1	ElectroLynx Harness	QC-C1500P		MK
1	ElectroLynx Harness	QC-C***P (length as req'd)		MK
1	Door Loop	DL-2		AK
2	Viewer	622	CRM	RO
1	Balance of hardware	Existing to remain		OT

Set: 7.0

Doors: 3

Description: New SN200 exit, gasketing, 462 stop

1	Continuous Hinge	CFM HD1 PT x Dr. Ht.		PE
1	Electric Power Transfer	EPT		SU
1	Rim Exit x SPAR04867/NC-E11	19 LD TB 43 70 56-SN200-8804	US32D	SA
1	Vandal Resistant Trim	826	US32D	SA
1	Interchangeable Core	I/CK-7	626	BE
1	Const. Core	7190224	Green	BE
1	Surface Closer	TB 351 PS	EN	SA
1	Door Stop	462	US2C	RO
1	Gasketing	2891APK (head & jambs)		PE
1	Rain Guard	346C x Frame Width		PE
1	Sweep	345ANB x Dr. Width		PE
1	Threshold	2005AT MSES25SS X Opening Width		PE
1	ElectroLynx Harness	QC-C1500P		MK
1	ElectroLynx Harness	QC-C***P (length as req'd)		MK
1	Door Position Switch	By Security.		OT
1	Power Supply	Provided by security		SU

Set: 8.0

Doors: 29, 30

Description: Existing add SN200 exit, loop. gasketing, sweep, 462 stop

1	Rim Exit x SPAR04867/NC-E11	19 LD TB 43 70 56-SN200-8804	US32D	SA
1	Door Stop	462	US2C	RO
1	Gasketing	2891APK (head & jambs)		PE
1	Sweep IDF/MDF/Alum	18061CNB x Dr. Width		PE
1	ElectroLynx Harness	QC-C1500P		MK
1	ElectroLynx Harness	QC-C***P (length as req'd)		MK
1	Door Loop	DL-2		AK
1	Balance of hardware	Existing to remain		OT

Set: 9.0

Doors: 510

Description: Existing add 8816 exit, 491S stop

1	Rim Exit Device	LD 19 TB 43 49 70 8816 ETL	US32D	SA
2	Interchangeable Core	I/CK-7	626	BE
2	Const. Core	7190224	Green	BE
1	Door Stop & Holder	491S	US26D	RO
1	Balance of hardware	Existing to remain		OT

Set: 10.0

Doors: 100, 101, 102, 104, 106, 114, 116, 117, 120, 121, 125, 126, 127, 128, 133, 134, 139, 141, 142, 143, 144, 200, 203, 204, 206, 209, 211, 216, 218, 219, 220, 221, 224, 229, 232, 233, 234, 235, 238, 239, 244, 245, 249, 251, 252, 254

Description: New closer

1	Surface Closer	351 O / P9 (type as required)	EN	SA
1	Balance of hardware	Existing to remain		OT

Set: 11.0

Doors: 111, 112, 135, 136, 205, 207, 217, 222, 223, 230, 231, 237, 246, 247, 253

Description: Existing add new closer and 481 stop

1	Surface Closer	351 O / P9 (type as required)	EN	SA
1	Door Stop	481H	US26D	RO
1	Balance of hardware	Existing to remain		OT

Set: 12.0

Doors: 2

Description: New 2N station

1	All hardware	Existing to remain		OT
---	--------------	--------------------	--	----

Notes: Add new 2N station

Set: 13.0

Doors: 107, 118, 129, 411.2, 423.1, 403, 404, 411, 411.1

Description: Replace thumbturn

1	130KB	Thumbturn Kit	26D	SA
1	Balance of hardware	Existing to remain		OT

Set: 13.1

Doors: 316.1, 623.1

Description: Existing add 8204

1	Storeroom/Closet Lock	70 8204 LL	US26D	SA
1	Interchangeable Core	I/CK-7	626	BE
1	Const. Core	7190224	Green	BE
1	Balance of hardware	Existing to remain		OT

Set: 14.0

Doors: 301, 500, 520, 520.1, 530, 604, 608A, 617

Description: Existing add 491 stop

1	Door Stop & Holder	491S	US26D	RO
1	Balance of hardware	Existing to remain		OT

Set: 15.0

Doors: 613, 614

Description: Existing add 491 stop pair of doors

1	Door Stop & Holder	491S	US26D	RO
1	Balance of hardware	Existing to remain		OT

Set: 16.0

Doors: 422, 423

Description: Replace thumbturn and add 491 stop

1	130KB	Thumbturn Kit	26D	SA
1	Door Stop & Holder	491S	US26D	RO
1	Balance of hardware	Existing to remain		OT

Set: 17.0

Doors: 115.3

Description: Existing add 481 stops pair of doors

2	Door Stop	481H	US26D	RO
1	Balance of hardware	Existing to remain		OT

Set: 18.0

Doors: 316.2, 317, 318, 531, 532, 533

Description: New office/storage

4	Hinge, Full Mortise	TA2714	US26D	MK
1	Classroom Lock	70 8237 LL	US26D	SA
1	Interchangeable Core	I/CK-7	626	BE
1	Const. Core	7190224	Green	BE
1	Door Stop	462	US2C	RO
3	Silencer	608		RO

Set: 19.0

Doors: 534

Description: New storage pair

6	Hinge, Full Mortise	TA2714	US26D	MK
1	Surface Bolt	580-12	US26D	RO
1	Storeroom/Closet Lock	70 8204 LL	US26D	SA
1	Interchangeable Core	I/CK-7	626	BE
1	Const. Core	7190224	Green	BE
1	Surface Closer	351 O / P9 (type as required)	EN	SA
1	Door Stop	462	US2C	RO
3	Silencer	608		RO

Set: 20.0

Doors: MISC

Description: **Attic Stock - EVERY CAMPUS

1	Hydraulic Gate Closer & Hinge	MAMMOTH-180-HD	9005	OT
5	Quick Fix Bolts	MAMMOTH-P00006000		OT
5	Mullion Lock	98-2520		SA
5	Mullion Lock	98-2518		SA
5	8205 thumbturn kit	130KB	26D	SA
5	Classroom Security Intruder Lock Body	8238	US26D	SA
50	Interchangeable Core	I/CK-7	626	BE
50	Key Blanks	Best "A" Keyway		BE
12	Regular Hold Open Arm	25-H	EN	SA
12	Parallel Hold Open Arm	25-PSH	EN	SA
4	Electromagnetic Holder	994M 24VAC	689	RF
5	994M Magnetic Parts	Door Armature 994510M	689	RF
5	994M Magnetic Parts	Screw & Backplate 998300	689	RF
5	994M Magnetic Parts	Swivel Armature 900-3	689	RF
5	994M Magnetic Parts	Magnet Assembly 998369-3V	689	RF
5	994M Magnetic Parts	Wall Cover 998315M	689	RF
4	SN200 Reader	52 6027 (Exit / Lock)	26D	SA

Notes: All attic stock ships direct to
 Director of Technical Services
 Cy Fair ISD Lockshop
 11430 Perry Road
 Houston, Texas 77064

SECTION 08 71 01

DOOR HARDWARE – LABAY MIDDLE SCHOOL

PART 1 - GENERAL

1.1 RELATED DOCUMENTS

- A. Drawings and general provisions of the Contract, including General and Supplementary Conditions and Division 1 Specification Sections, apply to this Section.

1.2 SUMMARY

- A. This Section includes commercial door hardware for the following:
 - 1. Swinging doors.
 - 2. Other doors to the extent indicated.
- B. Door hardware includes, but is not necessarily limited to, the following:
 - 1. Mechanical door hardware.
 - 2. Electromechanical door hardware.
 - 3. Cylinders specified for doors in other sections.
- C. Related Sections:
 - 1. Division 08 Section "Door Hardware Schedule".
 - 2. Division 08 Section "Hollow Metal Doors and Frames".
 - 3. Division 08 Section "Interior Aluminum Doors and Frames".
 - 4. Division 08 Section "Plastic Laminate Faced Wood Doors".
- D. Codes and References: Comply with the version year adopted by the Authority Having Jurisdiction.
 - 1. ANSI A117.1 - Accessible and Usable Buildings and Facilities.
 - 2. ICC/IBC - International Building Code.
 - 3. NFPA 70 - National Electrical Code.
 - 4. NFPA 80 - Fire Doors and Windows.
 - 5. NFPA 101 - Life Safety Code.
 - 6. NFPA 105 - Installation of Smoke Door Assemblies.
 - 7. State Building Codes, Local Amendments.
- E. Standards: All hardware specified herein shall comply with the following industry standards:
 - 1. ANSI/BHMA Certified Product Standards - A156 Series
 - 2. UL10C – Positive Pressure Fire Tests of Door Assemblies

1.3 SUBMITTALS

- A. Product Data: Manufacturer's product data sheets including installation details, material descriptions, dimensions of individual components and profiles, operational descriptions and finishes.

- B. Door Hardware Schedule: Prepared by or under the supervision of supplier, detailing fabrication and assembly of door hardware, as well as procedures and diagrams. Coordinate the final Door Hardware Schedule with doors, frames, and related work to ensure proper size, thickness, hand, function, and finish of door hardware.
1. Format: Comply with scheduling sequence and vertical format in DHI's "Sequence and Format for the Hardware Schedule."
 2. Organization: Organize the Door Hardware Schedule into door hardware sets indicating complete designations of every item required for each door or opening. Organize door hardware sets in same order as in the Door Hardware Sets at the end of Part 3. Submittals that do not follow the same format and order as the Door Hardware Sets will be rejected and subject to resubmission.
 3. Content: Include the following information:
 - a. Type, style, function, size, label, hand, and finish of each door hardware item.
 - b. Manufacturer of each item.
 - c. Fastenings and other pertinent information.
 - d. Location of door hardware set, cross-referenced to Drawings, both on floor plans and in door and frame schedule.
 - e. Explanation of abbreviations, symbols, and codes contained in schedule.
 - f. Mounting locations for door hardware.
 - g. Door and frame sizes and materials.
 - h. Warranty information for each product.
 4. Submittal Sequence: Submit the final Door Hardware Schedule at earliest possible date, particularly where approval of the Door Hardware Schedule must precede fabrication of other work that is critical in the Project construction schedule. Include Product Data, Samples, Shop Drawings of other work affected by door hardware, and other information essential to the coordinated review of the Door Hardware Schedule.
- C. Shop Drawings: Details of electrified access control hardware indicating the following:
1. Wiring Diagrams: Upon receipt of approved schedules, submit detailed system wiring diagrams for power, signaling, monitoring, communication, and control of the access control system electrified hardware. Differentiate between manufacturer-installed and field-installed wiring. Include the following:
 - a. Elevation diagram of each unique access controlled opening showing location and interconnection of major system components with respect to their placement in the respective door openings.
 - b. Complete (risers, point-to-point) access control system block wiring diagrams.
 - c. Wiring instructions for each electronic component scheduled herein.
 2. Electrical Coordination: Coordinate with related sections the voltages and wiring details required at electrically controlled and operated hardware openings.
- D. Proof of Certification: Provide copy of manufacturer(s) official certification or accreditation document indicating proof of status as a qualified installer of Windstorm assemblies.
- E. Keying Schedule: After a keying meeting with the owner has taken place prepare a separate keying schedule detailing final instructions. Submit the keying schedule in electronic format. Include keying system explanation, door numbers, key set symbols, hardware set numbers and special instructions. Owner must approve submitted keying schedule prior to the ordering of permanent cylinders/cores.

F. Informational Submittals:

1. Product Test Reports: Indicating compliance with cycle testing requirements, based on evaluation of comprehensive tests performed by manufacturer and witnessed by a qualified independent testing agency.

G. Operating and Maintenance Manuals: Provide manufacturers operating and maintenance manuals for each item comprising the complete door hardware installation in quantity as required in Division 01, Closeout Submittals.

1.4 QUALITY ASSURANCE

A. Manufacturers Qualifications: Engage qualified manufacturers with a minimum 5 years of documented experience in producing hardware and equipment similar to that indicated for this Project and that have a proven record of successful in-service performance.

B. Installer Qualifications: A minimum 3 years documented experience hardware similar in material, design, and extent to that indicated for this Project and whose work has resulted in construction with a record of successful in-service performance.

C. Door Hardware Supplier Qualifications: Experienced commercial door hardware distributors with a minimum 5 years documented experience supplying hardware installations comparable in material, design, and extent to that indicated for this Project. Supplier recognized as a factory direct distributor by the manufacturers of the primary materials with a warehousing facility in Project's vicinity. Supplier to have on staff a certified Architectural Hardware Consultant (AHC) available during the course of the Work to consult with Contractor, Architect, and Owner concerning both standard and electromechanical door hardware and keying.

D. Integrated Wiegand, Wireless, and IP-Enabled Access Control Products Supplier Qualifications: Integrated access control products and accessories are required to be supplied and installed through current members of the ASSA ABLOY "Authorized Channel Partner" (ACP) and "Certified Integrator" (CI) programs. Suppliers are to be factory trained, certified prior to project bid, and a direct purchaser of the specified product. Installers are to be factory trained, certified prior to project bid, and are responsible for commissioning, servicing, and warranting the installed equipment specified for the project.

E. Source Limitations: Obtain each type and variety of door hardware specified in this section from a single source unless otherwise indicated.

1. Electrified modifications or enhancements made to a source manufacturer's product line by a secondary or third party source will not be accepted.
2. Provide electromechanical door hardware from the same manufacturer as mechanical door hardware, unless otherwise indicated

F. Each unit to bear third party permanent label demonstrating compliance with the referenced standards.

G. Keying Conference: Conduct conference to comply with requirements in Division 01 Section "Project Meetings." Keying conference to incorporate the following criteria into the final keying schedule document:

1. Function of building, purpose of each area and degree of security required.
2. Plans for existing and future key system expansion.
3. Requirements for key control storage and software.
4. Installation of permanent keys, cylinder cores and software.
5. Address and requirements for delivery of keys.

- H. Pre-Submittal Conference: Conduct coordination conference in compliance with requirements in Division 01 Section "Project Meetings" with attendance by representatives of Supplier(s), Installer(s), and Contractor(s) to review proper methods and the procedures for receiving, handling, and installing door hardware.
 - 1. Prior to installation of door hardware, conduct a project specific training meeting to instruct the installing contractors' personnel on the proper installation and adjustment of their respective products. Product training to be attended by installers of door hardware (including electromechanical hardware) for aluminum, hollow metal and wood doors. Training will include the use of installation manuals, hardware schedules, templates and physical product samples as required.
 - 2. Inspect and discuss electrical roughing-in, power supply connections, and other preparatory work performed by other trades.
 - 3. Review sequence of operation narratives for each unique access controlled opening.
 - 4. Review and finalize construction schedule and verify availability of materials.
 - 5. Review the required inspecting, testing, commissioning, and demonstration procedures
- I. At completion of installation, provide written documentation that components were applied to manufacturer's instructions and recommendations and according to approved schedule.

1.5 DELIVERY, STORAGE, AND HANDLING

- A. Inventory door hardware on receipt and provide secure lock-up and shelving for door hardware delivered to Project site.
- B. Tag each item or package separately with identification related to the final Door Hardware Schedule, and include basic installation instructions with each item or package.
- C. Deliver, as applicable, permanent keys, cylinders, cores and related accessories directly to Owner via registered mail or overnight package service. Instructions for delivery to the Owner shall be established at the "Keying Conference".

1.6 COORDINATION

- A. Templates: Obtain and distribute to the parties involved templates for doors, frames, and other work specified to be factory prepared for installing hardware. Check Shop Drawings of other work to confirm that adequate provisions are made for locating and installing hardware to comply with indicated requirements.
- B. Door Hardware and Electrical Connections: Coordinate the layout and installation of scheduled electrified door hardware and related access control equipment with required connections to source power junction boxes, low voltage power supplies, detection and monitoring hardware, and fire and detection alarm systems.
- C. Door and Frame Preparation: Doors and corresponding frames are to be prepared, reinforced and pre-wired (if applicable) to receive the installation of the specified electrified, monitoring, signaling and access control system hardware without additional in-field modifications.

1.7 WARRANTY

- A. General Warranty: Reference Division 01, General Requirements. Special warranties specified in this Article shall not deprive Owner of other rights Owner may have under other provisions of the Contract Documents and shall be in addition to, and run concurrent with, other warranties made by Contractor under requirements of the Contract Documents.

- B. Warranty Period: Written warranty, executed by manufacturer(s), agreeing to repair or replace components of standard and electrified door hardware that fails in materials or workmanship within specified warranty period after final acceptance by the Owner. Failures include, but are not limited to, the following:
 - 1. Structural failures including excessive deflection, cracking, or breakage.
 - 2. Faulty operation of the hardware.
 - 3. Deterioration of metals, metal finishes, and other materials beyond normal weathering.
 - 4. Electrical component defects and failures within the systems operation.
- C. Standard Warranty Period: One year from date of Substantial Completion, unless otherwise indicated.
- D. Special Warranty Periods:
 - 1. Lifetime for mortise locks and latches.
 - 2. Five years for exit hardware.
 - 3. Ten years for electric latch retraction exit motors
 - 4. Twenty-five years for manual surface door closer bodies.
 - 5. Two years for electromechanical door hardware.
 - 6. Lifetime for SN200 readers.

1.8 MAINTENANCE SERVICE

- A. Maintenance Tools and Instructions: Furnish a complete set of specialized tools and maintenance instructions as needed for Owner's continued adjustment, maintenance, and removal and replacement of door hardware.

1.9 OWNER STOCK – See Attic Stock at the end of Hardware Schedule.

PART 2 - PRODUCTS

2.1 SCHEDULED DOOR HARDWARE

- A. General: Provide door hardware for each door to comply with requirements in Door Hardware Sets and each referenced section that products are to be supplied under.
- B. Designations: Requirements for quantity, item, size, finish or color, grade, function, and other distinctive qualities of each type of door hardware are indicated in the Door Hardware Sets at the end of Part 3. Products are identified by using door hardware designations, as follows:
- C. Named Manufacturer's Products: Product designation and manufacturer are listed for each door hardware type required for the purpose of establishing requirements. Manufacturers' names are abbreviated in the Door Hardware Schedule.
- D. Substitutions: Requests for substitution and product approval for inclusive mechanical and electromechanical door hardware in compliance with the specifications must be submitted in writing and in accordance with the procedures and time frames outlined in Division 01, Substitution Procedures. Approval of requests is at the discretion of the architect, owner, and their designated consultants.

2.2 HANGING DEVICES

- A. Hinges: ANSI/BHMA A156.1 certified butt hinges with number of hinge knuckles as specified in the Door Hardware Sets.
1. Quantity: Provide the following hinge quantity, unless otherwise indicated:
 - a. Two Hinges: For doors with heights up to 60 inches.
 - b. Three Hinges: For doors with heights 61 to 90 inches.
 - c. Four Hinges: For doors with heights 91 to 120 inches.
 - d. For doors with heights more than 120 inches, provide 4 hinges, plus 1 hinge for every 30 inches of door height greater than 120 inches.
 2. Hinge Size: Provide the following, unless otherwise indicated, with hinge widths sized for door thickness and clearances required:
 - a. Widths up to 3'0": 4-1/2" standard or heavy weight as specified.
 - b. Sizes from 3'1" to 4'0": 5" standard or heavy weight as specified.
 3. Hinge Weight and Base Material: Unless otherwise indicated, provide the following:
 - a. Exterior Doors: Heavy weight, non-ferrous, ball bearing or oil impregnated bearing hinges unless Hardware Sets indicate standard weight.
 - b. Interior Doors: Standard weight, steel, ball bearing or oil impregnated bearing hinges unless Hardware Sets indicate heavy weight.
 4. Hinge Options: Comply with the following where indicated in the Hardware Sets or on Drawings:
 - a. Non-removable Pins: Provide set screw in hinge barrel that, when tightened into a groove in hinge pin, prevents removal of pin while door is closed; for the all out-swinging lockable doors.
 5. Acceptable Manufacturers:
 - a. Hager Companies (HA).
 - b. McKinney Products (MK).
 - c. Stanley Hardware (ST).
- B. Continuous Geared Hinges: ANSI/BHMA A156.26 Grade 1-600 certified continuous geared hinge. with minimum 0.120-inch thick extruded 6060 T6 aluminum alloy hinge leaves and a minimum overall width of 4 inches. Hinges are non-handed, reversible and fabricated to template screw locations. Factory trim hinges to suit door height and prepare for electrical cut-outs.
1. Acceptable Manufacturers:
 - a. McKinney Products (MK).
 - b. Pemko Manufacturing (PE).
 - c. Stanley Hardware (ST).

2.3 POWER TRANSFER DEVICES

- A. Concealed Quick Connect Electric Power Transfers: Provide concealed wiring pathway housing mortised into the door and frame for low voltage electrified door hardware. Furnish with Molex™ standardized plug connectors and sufficient number of concealed wires (up to 12) to accommodate the electrified functions specified in the Door Hardware Sets. Connectors plug directly to through-door wiring harnesses for connection to electric locking devices and power supplies. Wire nut connections are not acceptable.
1. Acceptable Manufacturers:
 - a. Pemko Manufacturing (PE) – EL-CEPT Series.
 - b. Securitron (SU) - EL-CEPT Series.
 - c. Stanley Hardware (ST) EPT-12C Series.
- B. Electric Door Wire Harnesses: Provide electric/data transfer wiring harnesses with standardized plug connectors to accommodate up to twelve (12) wires. Connectors plug directly to through-door wiring harnesses for connection to electric locking devices and power supplies. Provide sufficient number and type of concealed wires to accommodate electric function of specified hardware. Provide a connector for through-door electronic locking devices and from hinge to junction box above the opening. Wire nut connections are not acceptable. Determine the length required for each electrified hardware component for the door type, size and construction, minimum of two per electrified opening.
1. Provide one each of the following tools as part of the base bid contract:
 - a. McKinney Products (MK) - Electrical Connecting Kit: QC-R001.
 - b. McKinney Products (MK) - Connector Hand Tool: QC-R003.

2.4 DOOR OPERATING TRIM

- A. Flush Bolts and Surface Bolts: ANSI/BHMA A156.3 and A156.16, Grade 1, certified.
1. Manual flush bolts to be furnished with top rod of sufficient length to allow bolt location approximately six feet from the floor.
 2. Furnish dust proof strikes for bottom bolts.
 3. Surface bolts to be minimum 8" in length and U.L. listed for labeled fire doors and U.L. listed for windstorm components where applicable.
 4. Provide related accessories (mounting brackets, strikes, coordinators, etc.) as required for appropriate installation and operation.
 5. Acceptable Manufacturers:
 - a. Ives (IV).
 - b. Rockwood Manufacturing (RO).
 - c. Trimco (TC).
- B. Door Push Plates and Pulls: ANS/BHMA A156.6 certified door pushes and pulls of type and design specified in the Hardware Sets. Coordinate and provide proper width and height as required where conflicting hardware dictates.
1. Push/Pull Plates: Minimum .050 inch thick, size as indicated in hardware sets, with beveled edges, secured with exposed screws unless otherwise indicated.
 2. Door Pull and Push Bar Design: Size, shape, and material as indicated in the hardware sets. Minimum clearance of 2 1/2-inches from face of door unless otherwise indicated.
 3. Offset Pull Design: Size, shape, and material as indicated in the hardware sets. Minimum clearance of 2 1/2-inches from face of door and offset of 90 degrees unless otherwise indicated.
 4. Fasteners: Provide manufacturer's designated fastener type as indicated in Hardware Sets.

5. Acceptable Manufacturers:

- a. Ives (IV).
- b. Rockwood Manufacturing (RO).
- c. Trimco (TC).

2.5 CYLINDERS AND KEYING

- A. General: Cylinder manufacturer to have minimum (10) years experience designing secured master key systems and have on record a published security keying system policy.
- B. Source Limitations: Obtain each type of keyed cylinder and keys from the same source manufacturer as locksets and exit devices, unless otherwise indicated.
 1. Acceptable Manufacturers:
 - a. Stanley Best (BE).
 - b. Sargent Cylinder Housings
 - c. No Substitution.
- C. Cylinders: Original manufacturer cylinders complying with the following:
 1. Mortise Type: Threaded cylinders with rings and cams to suit hardware application.
 2. Rim Type: Cylinders with back plate, flat-type vertical or horizontal tailpiece, and raised trim ring.
 3. Bored-Lock Type: Cylinders with tailpieces to suit locks.
 4. Mortise and rim cylinder collars to be solid and recessed to allow the cylinder face to be flush and be free spinning with matching finishes.
 5. Keyway: Match Facility Standard.
- D. Keying System: Each type of lock and cylinders to be factory keyed.
 1. Conduct specified "Keying Conference" to define and document keying system instructions and requirements.
 2. Furnish factory cut, nickel-silver large bow permanently inscribed with a visual key control number as directed by Owner.
 3. Existing System: Key locks to Owner's existing system.
- E. Key Quantity: Provide the following minimum number of keys:
 1. Change Keys per Cylinder: Two (2)
 2. Twenty construction cores
 3. 50 Key Blanks – Best "A" Keyway
- F. Construction Keying: Provide temporary keyed construction cores. Green Best Cores No Substitution . All Best temporary cores to be returned to the district at the end of the project.
- G. Key Registration List (Bitting List):
 1. Provide keying transcript list to Owner's representative in the proper format for importing into key control software.
 2. Provide transcript list in writing or electronic file as directed by the Owner.

- H. Key Control Cabinet: Provide a key control system including envelopes, labels, and tags with self-locking key clips, receipt forms, 3-way visible card index, temporary markers, permanent markers, and standard metal cabinet. Key control cabinet shall have expansion capacity of 150% of the number of locks required for the project. Provide a new cabinet to all new construction projects. Use Lund 1205-B as a basis of design.

1. Acceptable Manufacturers:

- a. Lund Equipment (LU).
- b. MMF Industries (MM).
- c. Telkee (TK).

2.6 MECHANICAL LOCKS AND LATCHING DEVICES

- A. Mortise Locksets, Grade 1 (Heavy Duty): ANSI/BHMA A156.13. Locksets are to be manufactured with a corrosion resistant steel case and be field-reversible for handing without disassembly of the lock body.

1. Acceptable Manufacturers

- a. Sargent Manufacturing (SA) 8200 Series – No substitutions
- b. Sargent Manufacturing (SA) 10X Series - No substitutions
 - 1) Use at student restrooms or as directed by Cy Fair ISD

2.7 AUXILIARY LOCKS

- A. Tubular Deadlocks: Deadlocks to be products of the same source manufacturer and keyway as other specified locksets.

1. Acceptable Manufacturers:

- a. Marks (MX) - 130 Series.
- b. Sargent Manufacturing (SA) – 480 Series.

2.8 LOCK AND LATCH STRIKES

- A. Strikes: Provide manufacturer's standard strike with strike box for each latch or lock bolt, with curved lip extended to protect frame, finished to match door hardware set, unless otherwise indicated, and as follows:

1. Flat-Lip Strikes: For locks with three-piece antifriction latchbolts, as recommended by manufacturer.
2. Aluminum-Frame Strike Box: Provide manufacturer's special strike box fabricated for aluminum framing.

- B. Standards: Comply with the following:

1. Strikes for Mortise Locks and Latches: BHMA A156.13.
2. Strikes for Auxiliary Deadlocks: BHMA A156.5.
3. Dustproof Strikes: BHMA A156.16.

2.9 CONVENTIONAL EXIT DEVICES

A. General Requirements: All exit devices specified herein shall meet or exceed the following criteria:

1. At doors not requiring a fire rating, provide devices complying with NFPA 101 and listed and labeled for "Panic Hardware" according to UL305. Provide proper fasteners as required by manufacturer including sex nuts and bolts at openings specified in the Hardware Sets.
2. Where exit devices are required on fire rated doors, provide devices complying with NFPA 80 and with UL labeling indicating "Fire Exit Hardware". Provide devices with the proper fasteners for installation as tested and listed by UL. Consult manufacturer's catalog and template book for specific requirements.
3. Except on fire rated doors, provide exit devices with hex key dogging device to hold the pushbar and latch in a retracted position. Provide optional keyed cylinder dogging on devices where specified in Hardware Sets.
4. Devices must fit flat against the door face with no gap that permits unauthorized dogging of the push bar. The addition of filler strips is required in any case where the door light extends behind the device as in a full glass configuration.
5. Lever Operating Trim: Where exit devices require lever trim, furnish manufacturer's heavy duty escutcheon trim with threaded studs for thru-bolts.
 - a. Lock Trim Design: As indicated in Hardware Sets, provide finishes and designs to match that of the specified locksets.
 - b. Where function of exit device requires a cylinder, provide a cylinder (Rim or Mortise) as specified in Hardware Sets.
6. Rail Sizing: Provide exit device rails factory sized for proper door width application.
7. Through Bolt Installation: For exit devices and trim as indicated (TB) in Door Hardware Sets.
8. Provide Less Dogging (LD) at all exit devices.
9. Add 31- Prefix to all exit devices being provided at two inch aluminum doors.
10. No self-tapping screws allowed.

B. Conventional Push Rail Exit Devices (Heavy Duty): ANSI/BHMA A156.3, Grade 1 certified panic and fire exit hardware devices furnished in the functions specified in the Hardware Sets. Exit device latch to be stainless steel, pullman type, with deadlock feature.

1. Acceptable Manufacturers:
 - a. Sargent Manufacturing (SA) - 80 Series.
 - b. No Substitution.

C. Tube Steel Removable Mullions: ANSI/BHMA A156.3 removable steel mullions with malleable-iron top and bottom retainers and a primed paint finish.

1. Provide keyed removable feature where specified in the Hardware Sets.
2. Provide stabilizers and mounting brackets as required.
3. Provide electrical quick connection wiring options as specified in the hardware sets.

4. Acceptable Manufacturers:
 - a. Stanley Precision (PR) - 822 Series.
 - b. No Substitution.

2.10 INTEGRATED WIEGAND OUTPUT ACCESS CONTROL EXIT DEVICES

- A. Wiegand Output Integrated Card Reader Exit Hardware: Wiegand output ANSI 156.3 Grade 1 rim, mortise, and vertical rod exit device hardware with integrated proximity card reader, latchbolt and touchbar monitoring, and request-to-exit signaling, in one complete unit. Hard wired, solenoid driven locking/unlocking control of the lever handle exit trim with 3/4" throw latch bolt. U.L listed and labeled for either panic or "fire exit hardware" for use on up to 3 hour fire rated openings. Available with or without keyed high security cylinder override.
 1. Open architecture, hard wired platform supports centralized control of locking units with new or existing Wiegand compatible access control systems. Inside push bar (request-to-exit) signaling and door position (open/closed status) monitoring (via separately connected DPS).
 2. Reader supports either HID 125 kHz proximity (up to 39 bits, including Corporate 1000) or 13.56 MHz (2K-32K) iClass® credentials.
 3. 12VDC external power supply required for reader, with optional 24VDC operation available with iClass® reader (125 kHz reader is always 12VDC). 24VDC required for solenoid operated exit trim (12VDC if applicable). Fail safe or fail secure options.
 4. Installation requires only one cable run from the exit hardware to the access control panel without requirements for additional proprietary lock panel interface boards or modules.
 5. Acceptable Manufacturers:
 - a. Sargent Manufacturing (SA) - SN – 56-SN20080 Series Exits. x SPAR04867
 - b. Sargent Manufacturing (SA) - SN – SN2008200 Series Locks.
 - c. No Substitution.

2.11 DOOR CLOSERS

- A. All door closers specified herein shall meet or exceed the following criteria:
 1. General: Door closers to be from one manufacturer, matching in design and style, with the same type door preparations and templates regardless of application or spring size. Closers to be non-handed with full sized covers including installation and adjusting information on inside of cover.
 2. Standards: Closers to comply with UL-10C for Positive Pressure Fire Test and be U.L. listed for use of fire rated doors.
 3. Cycle Testing: Provide closers which have surpassed 15 million cycles in a test witnessed and verified by UL.
 4. Size of Units: Comply with manufacturer's written recommendations for sizing of door closers depending on size of door, exposure to weather, and anticipated frequency of use. Where closers are indicated for doors required to be accessible to the physically handicapped, provide units complying with ANSI ICC/A117.1.
 5. Closer Arms: Provide heavy duty, forged steel closer arms unless otherwise indicated in Hardware Sets.
 6. Closers shall not be installed on exterior or corridor side of doors; where possible install closers on door for optimum aesthetics.

7. Closer Accessories: Provide door closer accessories including custom templates, special mounting brackets, spacers and drop plates, and through-bolt and security type fasteners as required for proper installation.
 8. Through Bolt Installation: All door closers are to be installed with (TB) through bolting as indicated in Door Hardware Sets.
 9. No self-tapping screws allowed.
- B. Door Closers, Surface Mounted (Heavy Duty): ANSI/BHMA A156.4, Grade 1 surface mounted, heavy duty door closers with complete spring power adjustment, sizes 1 thru 6; and fully operational adjustable according to door size, frequency of use, and opening force. Closers to be rack and pinion type, one piece cast iron or aluminum alloy body construction, with adjustable backcheck and separate non-critical valves for closing sweep and latch speed control. Provide non-handed units standard.
1. Acceptable Manufacturers:
 - a. Sargent Manufacturing (SA) – TB 351 Series.

2.12 SURFACE MOUNTED CLOSER HOLDERS

- A. Electromagnetic Door Holders: Certified ANSI A156.15 electromagnetic door holder/releases with a minimum 20 to 40 pounds holding power and single coil construction able to accommodate 12VDC, 24VAC, 24VDC and 120VAC. Coils to be independently wound, employing an integral fuse and armatures to include a positive release button.
1. Acceptable Manufacturers:
 - a. LCN Door Closers (LC) - SEM7800 Series.
 - b. Rixson (RF) - 980/990 Series.
 - c. Sargent Manufacturing (SA) - 1560 Series.

2.13 ARCHITECTURAL TRIM

- A. Door Protective Trim
1. General: Door protective trim units to be of type and design as specified below or in the Hardware Sets.
 2. Size: Fabricate protection plates (kick, armor, or mop) not more than 2" less than door width (LDW) on stop side of single doors and 1" LDW on stop side of pairs of doors, and not more than 1" less than door width on pull side. Coordinate and provide proper width and height as required where conflicting hardware dictates. Height to be as specified in the Hardware Sets.
 3. Protection Plates: ANSI/BHMA A156.6 certified protection plates (kick, armor, or mop), fabricated from the following:
 - a. Stainless Steel: 300 grade, 050-inch thick.
 4. Options and fasteners: Provide manufacturer's designated fastener type as specified in the Hardware Sets. Provide countersunk screw holes.

5. Acceptable Manufacturers:

- a. Ives (IV).
- b. Rockwood Manufacturing (RO).
- c. Trimco (TC).

2.14 DOOR STOPS AND HOLDERS

A. General: Door stops and holders to be of type and design as specified below or in the Hardware Sets.

B. Door Stops and Bumpers: ANSI/BHMA A156.16, Grade 1 certified door stops and wall bumpers. Provide wall bumpers, either convex or concave types with anchorage as indicated, unless floor or other types of door stops are specified in Hardware Sets. Do not mount floor stops where they will impede traffic. Where floor or wall bumpers are not appropriate, provide overhead type stops and holders.

1. Acceptable Manufacturers:

- a. Ives (IV).
- b. Rockwood Manufacturing (RO).
- c. Trimco (TC).

C. Overhead Door Stops and Holders: ANSI/BHMA A156.6, Grade 1 certified overhead stops and holders to be surface or concealed types as indicated in Hardware Sets. Track, slide, arm and jamb bracket to be constructed of extruded bronze and shock absorber spring of heavy tempered steel. Provide non-handed design with mounting brackets as required for proper operation and function.

1. Acceptable Manufacturers:

- a. Do not use overhead stops/holders

2.15 ARCHITECTURAL SEALS

A. General: Thresholds, weatherstripping, and gasket seals to be of type and design as specified below or in the Hardware Sets. Provide continuous weatherstrip gasketing on exterior doors and provide smoke, light, or sound gasketing on interior doors where indicated. At exterior applications provide non-corrosive fasteners and elsewhere where indicated.

B. Smoke Labeled Gasketing: Assemblies complying with NFPA 105 that are listed and labeled by a testing and inspecting agency acceptable to authorities having jurisdiction, for smoke control ratings indicated, based on testing according to UL 1784.

1. Provide smoke labeled perimeter gasketing at all smoke labeled openings.

C. Fire Labeled Gasketing: Assemblies complying with NFPA 80 that are listed and labeled by a testing and inspecting agency acceptable to authorities having jurisdiction, for fire ratings indicated, based on testing according to UL-10C.

1. Provide intumescent seals as indicated to meet UL10C Standard for Positive Pressure Fire Tests of Door Assemblies, and UBC 7-2, Fire Tests of Door Assemblies.

D. No Replaceable Seal Strips allowed: Provide only those units where they can be screw applied..

E. Acceptable Manufacturers:

1. National Guard Products (NG).

2. Pemko Manufacturing (PE).
3. Reese Enterprises, Inc. (RE).

2.16 ELECTRONIC ACCESSORIES

- A. Door Position Switches: Door position magnetic reed contact switches specifically designed for use in commercial door applications. On recessed models the contact and magnetic housing snap-lock into a 1" diameter hole. Surface mounted models include wide gap distance design complete with armored flex cabling. Provide SPDT, N/O switches with optional Rare Earth Magnet installation on steel doors with flush top channels.

1. Acceptable Manufacturers:

- a. Provided by Security

- B. Switching Power Supplies: Provide UL listed or recognized filtered and regulated power supplies. Provide single, dual, or multi-voltage units as shown in the hardware sets. Units must be expandable up to eight Class 2 power limited outputs. Units must include the capability to incorporate a battery backup option with integral battery charging capability in addition to operating the DC load in event of line voltage failure. Provide the least number of units, at the appropriate amperage level, sufficient to exceed the required total draw for the specified electrified hardware and access control equipment.

1. Acceptable Manufacturers:

- a. Provided by Security

2.17 FABRICATION

- A. Fasteners: Provide door hardware manufactured to comply with published templates generally prepared for machine, wood, and sheet metal screws. Provide screws according to manufacturers recognized installation standards for application intended.

2.18 FINISHES

- A. Standard: Designations used in the Hardware Sets and elsewhere indicate hardware finishes complying with ANSI/BHMA A156.18, including coordination with traditional U.S. finishes indicated by certain manufacturers for their products.
- B. Provide quality of finish, including thickness of plating or coating (if any), composition, hardness, and other qualities complying with manufacturer's standards, but in no case less than specified by referenced standards for the applicable units of hardware.
- C. Protect mechanical finishes on exposed surfaces from damage by applying a strippable, temporary protective covering before shipping.

PART 3 - EXECUTION

3.1 EXAMINATION

- A. Examine scheduled openings, with Installer present, for compliance with requirements for installation tolerances, labeled fire door assembly construction, wall and floor construction, and other conditions affecting performance.

- B. Notify architect of any discrepancies or conflicts between the door schedule, door types, drawings and scheduled hardware. Proceed only after such discrepancies or conflicts have been resolved in writing.

3.2 PREPARATION

- A. Hollow Metal Doors and Frames: Comply with ANSI/DHI A115 series.
- B. Wood Doors: Comply with ANSI/DHI A115-W series.

3.3 INSTALLATION

- A. Install each item of mechanical and electromechanical hardware and access control equipment to comply with manufacturer's written instructions and according to specifications.
 - 1. Installers are to be trained and certified by the manufacturer on the proper installation and adjustment of fire, life safety, and security products including: hanging devices; locking devices; closing devices; and seals.
- B. Mounting Heights: Mount door hardware units at heights indicated in following applicable publications, unless specifically indicated or required to comply with governing regulations:
 - 1. Standard Steel Doors and Frames: DHI's "Recommended Locations for Architectural Hardware for Standard Steel Doors and Frames."
 - 2. Wood Doors: DHI WDHS.3, "Recommended Locations for Architectural Hardware for Wood Flush Doors."
 - 3. Where indicated to comply with accessibility requirements, comply with ANSI A117.1 "Accessibility Guidelines for Buildings and Facilities."
 - 4. Provide blocking in drywall partitions where wall stops or other wall mounted hardware is located.
- C. Integrated Wiegand access control products are required to be installed through current members of the ASSA ABLOY "Certified Integrator" (CI) program.
- D. Retrofitting: Install door hardware to comply with manufacturer's published templates and written instructions. Where cutting and fitting are required to install door hardware onto or into surfaces that are later to be painted or finished in another way, coordinate removal, storage, and reinstallation of surface protective trim units with finishing work specified in Division 9 Sections. Do not install surface-mounted items until finishes have been completed on substrates involved.
- E. Thresholds: Set thresholds for exterior and acoustical doors in full bed of sealant complying with requirements specified in Division 7 Section "Joint Sealants."
- F. Storage: Provide a secure lock up for hardware delivered to the project but not yet installed. Control the handling and installation of hardware items so that the completion of the work will not be delayed by hardware losses before and after installation.
- G. No self-tapping screws allowed.

3.4 FIELD QUALITY CONTROL

- A. Field Inspection: Supplier will perform a final inspection of installed door hardware and state in report whether work complies with or deviates from requirements, including whether door hardware is properly installed, operating and adjusted.

3.5 ADJUSTING

- A. Initial Adjustment: Adjust and check each operating item of door hardware and each door to ensure proper operation or function of every unit. Replace units that cannot be adjusted to operate as intended. Adjust door control devices to compensate for final operation of heating and ventilating equipment and to comply with referenced accessibility requirements.
- B. Final Adjustment: Installer shall return and make final adjustment of all hardware once all air conditioning test and balance is complete. Final adjustment shall be made while air conditioner system is operating. Coordinate with General Contractor and Owner.

3.6 CLEANING AND PROTECTION

- A. Protect all hardware stored on construction site in a covered and dry place. Protect exposed hardware installed on doors during the construction phase. Install any and all hardware at the latest possible time frame.
- B. Clean adjacent surfaces soiled by door hardware installation.
- C. Clean operating items as necessary to restore proper finish. Provide final protection and maintain conditions that ensure door hardware is without damage or deterioration at time of owner occupancy.

3.7 DEMONSTRATION

- A. Instruct Owner's maintenance personnel to adjust, operate, and maintain mechanical and electromechanical door hardware.

3.8 DOOR HARDWARE SETS

The hardware sets represent the design intent and direction of the owner and architect. They are a guideline only and should not be considered a detailed hardware schedule. Discrepancies, conflicting hardware and missing items should be brought to the attention of the architect with corrections made prior to the bidding process. Omitted items not included in a hardware set should be scheduled with the appropriate additional hardware required for proper application and functionality.

- A. Manufacturer's Abbreviations:
 - 1. MK - McKinney
 - 2. OT - OTHER
 - 3. PE - Pemko
 - 4. RO - Rockwood
 - 5. PR - Precision
 - 6. MX - Marks
 - 7. SA - Sargent
 - 8. AD - Adams Rite
 - 9. BE - Best Access Systems
 - 10. RF - Rixson
 - 11. AK - Alarm Controls

Hardware Sets

Set: 1.0

Doors: 2

Description: Existing add 2N station

1	Balance of hardware	Existing to remain		OT
1	2N Station	2N Station		OT

Set: 2.0

Doors: 14

Description: Existing add SN200 PSB exit, loop, 462 stop

1	Rim Exit x SPAR04867/NC-E11	19 LD TB 43 70 56-SN200-8804 PSB	US32D	SA
1	Door Stop	462	US2C	RO
1	Door Loop	DL-2		AK
1	Balance of hardware	Existing to remain		OT

Set: 3.0

Doors: 1

Description: Existing add SN200 exit, 8810, loop, 462 stops

1	Rim Exit x SPAR04867/NC-E11	19 LD TB 43 70 56-SN200-8804	US32D	SA
1	Rim Exit Device, Exit Only	LD 19 TB 43 8810 EO	US32D	SA
2	Door Stop	462	US2C	RO
1	ElectroLynx Harness	QC-C1500P		MK
1	ElectroLynx Harness	QC-C***P (length as req'd)		MK
1	Door Loop	DL-2		AK
2	Door Position Switch	By Security.		OT
1	Power Supply	Provided by security		SU
1	Balance of hardware	Existing to remain		OT

Set: 4.0

Doors: 3

Description: Existing add SN200 and 8810 exits, 462 stops

1	Rim Exit x SPAR04867/NC-E11	19 LD TB 43 70 56-SN200-8804	US32D	SA
1	Rim Exit Device, Exit Only	LD 19 TB 43 8810 EO	US32D	SA
2	Door Stop	462	US2C	RO
1	ElectroLynx Harness	QC-C1500P		MK
1	ElectroLynx Harness	QC-C***P (length as req'd)		MK
1	Door Loop	DL-2		AK
2	Door Position Switch	By Security.		OT
1	Power Supply	Provided by security		SU
1	Balance of hardware	Existing to remain		OT

Set: 5.0

Doors: 23

Description: Existing exit pair

1	Rim Exit Device, Exit Only	LD 19 TB 43 8810 EO	US32D	SA
1	Rim Exit Device, Storeroom	LD 19 TB 43 70 8804 Less Pull	US32D	SA
1	Interchangeable Core	I/CK-7	626	BE
1	Const. Core	7190224	Green	BE
2	Door Stop	462	US2C	RO
1	Balance of hardware	Existing to remain		OT

Set: 6.0

Doors: 11, 5

Description: Existing add 8804 and 8810 exits, 2891, 462 stops

1	Rim Exit Device, Exit Only	LD 19 TB 43 8810 EO	US32D	SA
1	Rim Exit Device, Storeroom	LD 19 TB 43 70 8804 Less Pull	US32D	SA
1	Interchangeable Core	I/CK-7	626	BE
1	Const. Core	7190224	Green	BE
2	Door Stop	462	US2C	RO
1	Gasketing	2891APK (head & jambs)		PE
1	Balance of hardware	Existing to remain		OT

Set: 7.0

Doors: 10, 6, 7, 8, 9

Description: **Sgl - ExT -HM - Exit- SN200 - Closer /Stop- Access Control

1	Continuous Hinge	CFM HD1 x Dr. Ht.		PE
1	Rim Exit x SPAR04867/NC-E11	19 LD TB 43 70 56-SN200-8804 PSB	US32D	SA
1	Interchangeable Core	I/CK-7	626	BE
1	Const. Core	7190224	Green	BE
1	Door Closer	TB 351 O/P9 (type as required)	EN	SA
1	Armor Plate	K1050 36" CSK BEV	US32D	RO
1	Door Stop	462	US2C	RO
1	Gasketing	2891APK (head & jambs)		PE
1	Rain Guard	346C x Frame Width		PE
1	Sweep	345ANB x Dr. Width		PE
1	Threshold	2005AT MSES25SS X Opening Width		PE
1	ElectroLynx Harness	QC-C1500P		MK
1	ElectroLynx Harness	QC-C***P (length as req'd)		MK
1	Door Loop	DL-2		AK
1	Door Position Switch	By Security.		OT
1	Power Supply	Provided by security		SU
2	Viewer	622	CRM	RO

Notes: Doors are normally closed and secure. Presentation of valid credential will allow entry by pull. Upon loss of power, doors will remain secure. Free egress at all times. Install armor plate on interior of door.

Set: 8.0

Doors: 4

Description: Existing add PSB exit, 2891, 462 stop

1	Rim Exit Device, Storeroom	LD 19 43 56 70 8804 PSB	US32D	SA
1	Interchangeable Core	I/CK-7	626	BE
1	Const. Core	7190224	Green	BE
1	Door Stop	462	US2C	RO
1	Gasketing	2891APK (head & jambs)		PE
1	Balance of hardware	Existing to remain		OT

Set: 9.0

Doors: 16

Description: **Pr - EXT -HM - Exit- SN200 - Closer /Stop- Access Control

2	Continuous Hinge	CFM HD1 x Dr. Ht.		PE
1	Mullion	KR822 (FLK as req)	600	PR
1	Mullion Lock	98-2520		SA
1	Stabilizer	ST989	Dull Black	PR
1	Rim Exit x SPAR04867/NC-E11	19 LD TB 43 70 56-SN200-8804 PSB	US32D	SA
1	Rim Exit Device, Dummy	LD 19 43 8810 PSB	US32D	SA
2	Interchangeable Core	I/CK-7	626	BE
2	Const. Core	7190224	Green	BE
2	Door Closer	TB 351 O/P9 (type as required)	EN	SA
2	Armor Plate	K1050 36" CSK BEV	US32D	RO
2	Door Stop	462	US2C	RO
1	Gasketing	2891APK (head & jambs)		PE
1	Rain Guard	346C x Frame Width		PE
2	Sweep	345ANB x Dr. Width		PE
1	Threshold	2005AT MSES25SS X Opening Width		PE
1	ElectroLynx Harness	QC-C1500P		MK
1	ElectroLynx Harness	QC-C***P (length as req'd)		MK
1	Door Loop	DL-2		AK
1	Door Position Switch	By Security.		OT
1	Power Supply	Provided by security		SU

Notes: Doors are normally closed and secure. Presentation of valid credential will allow entry by pull. Upon loss of power, doors will remain secure. Free egress at all times.

Set: 10.0

Doors: 19

Description: Existing add 56 8804 exit, 2N station, loop, 2891, 462 stops

1	Rim Exit 2N SPAR04867/NC-E11	LD 19 TB 43 56 70 8804 ETL	US32D	SA
1	Interchangeable Core	I/CK-7	626	BE
1	Const. Core	7190224	Green	BE
1	Parallel Hold Open Arm	25-PSH	EN	SA
1	Door Stop	462	US2C	RO
1	Gasketing	2891APK (head & jambs)		PE
1	Door Loop	DL-2		AK
2	Viewer	622	CRM	RO
1	Balance of hardware	Existing to remain		OT
1	2N Station	2N Station		OT

Set: 10.1

Doors: 20

Description: Existing add 56 8804 exit, 2N station, loop, 2891, 462 stops

1	Rim Exit 2N SPAR04867/NC-E11	LD 19 TB 43 56 70 8804 ETL	US32D	SA
1	Interchangeable Core	I/CK-7	626	BE
1	Const. Core	7190224	Green	BE
1	Door Stop	462	US2C	RO
1	Gasketing	2891APK (head & jambs)		PE
1	Door Loop	DL-2		AK
2	Viewer	622	CRM	RO
1	Balance of hardware	Existing to remain		OT
1	2N Station	2N Station		OT

Set: 11.0

Doors: 12, 13

Description: Existing SN200 PSB exit, 2891, loop, 462 stops

1	Rim Exit x SPAR04867/NC-E11	19 LD TB 43 70 56-SN200-8804 PSB	US32D	SA
2	Door Stop	462	US2C	RO
1	Gasketing	2891APK (head & jambs)		PE
1	Door Loop	DL-2		AK
2	Viewer	622	CRM	RO
1	Balance of hardware	Existing to remain		OT

Set: 12.0

Doors: 17

Description: Existing SN200 and 8810 PSB exits, 2891, 462 stops

1	Rim Exit x SPAR04867/NC-E11	19 LD TB 43 70 56-SN200-8804 PSB	US32D	SA
1	Rim Exit Device, Dummy	LD 19 43 8810 PSB	US32D	SA
2	Door Stop	462	US2C	RO
1	Gasketing	2891APK (head & jambs)		PE
2	Viewer	622	CRM	RO
1	Balance of hardware	Existing to remain		OT

Set: 13.0

Doors: 24, 25, 26, 27, 28, 29

Description: Existing add SN200 PSB exit, ept, 462 stop

1	Electric Power Transfer	EL-CEPT	630	SU
1	Rim Exit x SPAR04867/NC-E11	19 LD TB 43 70 56-SN200-8804 PSB	US32D	SA
1	Door Stop	462	US2C	RO
1	Balance of hardware	Existing to remain		OT

Set: 14.0

Doors: 400.3

Description: Existing add SN200 reader

1	SN200 Reader	52 6027 (Exit / Lock)	26D	SA
1	Balance of hardware	Existing to remain		OT

Notes: reader for 400.3 to be installed on corridor side. Field verify if existing SN200 reader can be reused or not.

Set: 15.0

Doors: 114

Description: Existing add 8816 exit

1	Rim Exit STC Sec CR x SPAR#NC-E11	LD 19 31 43 49 70 8816 ETL	US32D	SA
2	Interchangeable Core	I/CK-7	626	BE
2	Const. Core	7190224	Green	BE
1	Balance of hardware	Existing to remain		OT

Set: 16.0

Doors: 114.1, 114.2

Description: Existing 8816 and 8804 exits, 481H stops

1	Rim Exit SPAR NC-E11	LD 19 TB 43 70 8804 ETL	US32D	SA
1	Rim Exit Device	LD 19 TB 43 49 70 8816 ETL	US32D	SA
3	Interchangeable Core	I/CK-7	626	BE
3	Const. Core	7190224	Green	BE
2	Door Stop	481H	US26D	RO
1	Balance of hardware	Existing to remain		OT

Set: 17.0

Doors: 500, 520, 520.1, 530

Description: Existing add 462 stop

1	Door Stop	462	US2C	RO
1	Balance of hardware	Existing to remain		OT

Set: 18.0

Doors: 600.1, 600.2, 601

Description: Existing add 8816 and 8804, 351 PS, 481H

1	Rim Exit Sec CR x SPAR#NC-E11	19 LD 43 49 70 8816 ETL	US32D	SA
1	Rim Exit SPAR NC-E11	LD 19 TB 43 70 8804 ETL	US32D	SA
3	Interchangeable Core	I/CK-7	626	BE
3	Const. Core	7190224	Green	BE
2	Surface Closer	TB 351 PS	EN	SA
2	Door Stop	481H	US26D	RO
1	Balance of hardware	Existing to remain		OT

Set: 19.0

Doors: 605, 608, 615

Description: Existing add 8816 exit, 351 PSH

1	Rim Exit Device	LD 19 TB 43 49 70 8816 ETL	US32D	SA
2	Interchangeable Core	I/CK-7	626	BE
2	Const. Core	7190224	Green	BE
1	Surface Closer	TB 351 PSH	EN	SA
1	Balance of hardware	Existing to remain		OT

Set: 20.0

Doors: 107, 128, 212, 224, 232, 236, 400.4, 421, 424

Description: Existing add 8205

1	Office/Entry Lock	70 8205 LL	US26D	SA
1	Interchangeable Core	I/CK-7	626	BE
1	Const. Core	7190224	Green	BE
1	Balance of hardware	Existing to remain		OT

Set: 21.0

Doors: 124

Description: Existing add 351PSH

1	Surface Closer	TB 351 PSH	EN	SA
1	Balance of hardware	Existing to remain		OT

Set: 22.0

Doors: 301A, 317A, 531A

Description: New storage

4	Hinge, Full Mortise	TA2714	US26D	MK
1	Storeroom/Closet Lock	70 8204 LL	US26D	SA
1	Interchangeable Core	I/CK-7	626	BE
1	Const. Core	7190224	Green	BE
1	Door Closer	TB 351 O/P9 (type as required)	EN	SA
1	Door Stop	462	US2C	RO
3	Silencer	608		RO

Set: 22.1

Doors: 406A

Description: Existing storage

1	Storeroom/Closet Lock	70 8204 LL	US26D	SA
1	Interchangeable Core	I/CK-7	626	BE
1	Const. Core	7190224	Green	BE
1	Balance of hardware	Existing to remain		OT

Set: 23.0

Doors: 316

Description: New classroom

4	Hinge, Full Mortise	TA2714	US26D	MK
1	Classroom Lock	70 8237 LL	US26D	SA
1	Interchangeable Core	I/CK-7	626	BE
1	Const. Core	7190224	Green	BE
1	Regular Hold Open Arm	25-H	EN	SA
1	Door Closer	TB 351 O/P9 (type as required)	EN	SA
1	Door Stop	462	US2C	RO
3	Silencer	608		RO

Set: 24.0

Doors: 401, 403, 404, 405, 406, 407.1, 407.2, 407.3, 408.1, 408.2, 409, 410, 411.1, 412, 413, 414, 415, 416, 417, 418

Description: New office

4	Hinge, Full Mortise	TA2714	US26D	MK
1	Office/Entry Lock	70 8205 LL	US26D	SA
1	Interchangeable Core	I/CK-7	626	BE
1	Const. Core	7190224	Green	BE
1	Door Stop	462	US2C	RO
1	Gasketing	S88BL		PE

Set: 24.1

Doors: 314, 317, 533

Description: New classroom lock

4	Hinge, Full Mortise	TA2714	US26D	MK
1	Classroom Lock	70 8237 LL	US26D	SA
1	Interchangeable Core	I/CK-7	626	BE
1	Const. Core	7190224	Green	BE
1	Door Stop	462	US2C	RO
1	Gasketing	S88BL		PE

Set: 24.2

Doors: 532

Description: New classroom lock

3	Hinge, Full Mortise	TA2714	US26D	MK
1	Classroom Lock	70 8237 LL	US26D	SA
1	Interchangeable Core	I/CK-7	626	BE
1	Const. Core	7190224	Green	BE
1	Door Stop	462	US2C	RO
1	Gasketing	S88BL		PE

Set: 25.0

Doors: MISC

Description: **Attic Stock - EVERY CAMPUS

5	Mullion Lock	98-2520		SA
5	Mullion Lock	98-2518		SA
5	Classroom Security Intruder Lock Body	8238	US26D	SA
5	130KB	Thumbturn Kit	26D	SA
50	Interchangeable Core	I/CK-7	626	BE
50	Key Blanks	Best "A" Keyway		BE
12	Regular Hold Open Arm	25-H	EN	SA
12	Parallel Hold Open Arm	25-PSH	EN	SA
4	SN200 Reader	52 6027 (Exit / Lock)	26D	SA

Notes: All attic stock ships direct to
Director of Technical Services
Cy Fair ISD Lockshop
11430 Perry Road
Houston, Texas 77064
All attic stock to ship directly to Cy Fair.
DO NOT ship to jobsite.

SECTION 08 71 02

DOOR HARDWARE – TRUITT MIDDLE SCHOOL

PART 1 - GENERAL

1.1 RELATED DOCUMENTS

- A. Drawings and general provisions of the Contract, including General and Supplementary Conditions and Division 1 Specification Sections, apply to this Section.

1.2 SUMMARY

- A. This Section includes commercial door hardware for the following:
1. Swinging doors.
 2. Other doors to the extent indicated.
- B. Door hardware includes, but is not necessarily limited to, the following:
1. Mechanical door hardware.
 2. Electromechanical door hardware.
 3. Cylinders specified for doors in other sections.
- C. Related Sections:
1. Division 08 Section "Door Hardware Schedule".
 2. Division 08 Section "Hollow Metal Doors and Frames".
 3. Division 08 Section "Interior Aluminum Doors and Frames".
 4. Division 08 Section "Plastic Laminate Faced Wood Doors".
- D. Codes and References: Comply with the version year adopted by the Authority Having Jurisdiction.
1. ANSI A117.1 - Accessible and Usable Buildings and Facilities.
 2. ICC/IBC - International Building Code.
 3. NFPA 70 - National Electrical Code.
 4. NFPA 80 - Fire Doors and Windows.
 5. NFPA 101 - Life Safety Code.
 6. NFPA 105 - Installation of Smoke Door Assemblies.
 7. State Building Codes, Local Amendments.
- E. Standards: All hardware specified herein shall comply with the following industry standards:
1. ANSI/BHMA Certified Product Standards - A156 Series
 2. UL10C – Positive Pressure Fire Tests of Door Assemblies

1.3 SUBMITTALS

- A. Product Data: Manufacturer's product data sheets including installation details, material descriptions, dimensions of individual components and profiles, operational descriptions and finishes.

- B. Door Hardware Schedule: Prepared by or under the supervision of supplier, detailing fabrication and assembly of door hardware, as well as procedures and diagrams. Coordinate the final Door Hardware Schedule with doors, frames, and related work to ensure proper size, thickness, hand, function, and finish of door hardware.
1. Format: Comply with scheduling sequence and vertical format in DHI's "Sequence and Format for the Hardware Schedule."
 2. Organization: Organize the Door Hardware Schedule into door hardware sets indicating complete designations of every item required for each door or opening. Organize door hardware sets in same order as in the Door Hardware Sets at the end of Part 3. Submittals that do not follow the same format and order as the Door Hardware Sets will be rejected and subject to resubmission.
 3. Content: Include the following information:
 - a. Type, style, function, size, label, hand, and finish of each door hardware item.
 - b. Manufacturer of each item.
 - c. Fastenings and other pertinent information.
 - d. Location of door hardware set, cross-referenced to Drawings, both on floor plans and in door and frame schedule.
 - e. Explanation of abbreviations, symbols, and codes contained in schedule.
 - f. Mounting locations for door hardware.
 - g. Door and frame sizes and materials.
 - h. Warranty information for each product.
 4. Submittal Sequence: Submit the final Door Hardware Schedule at earliest possible date, particularly where approval of the Door Hardware Schedule must precede fabrication of other work that is critical in the Project construction schedule. Include Product Data, Samples, Shop Drawings of other work affected by door hardware, and other information essential to the coordinated review of the Door Hardware Schedule.
- C. Shop Drawings: Details of electrified access control hardware indicating the following:
1. Wiring Diagrams: Upon receipt of approved schedules, submit detailed system wiring diagrams for power, signaling, monitoring, communication, and control of the access control system electrified hardware. Differentiate between manufacturer-installed and field-installed wiring. Include the following:
 - a. Elevation diagram of each unique access controlled opening showing location and interconnection of major system components with respect to their placement in the respective door openings.
 - b. Complete (risers, point-to-point) access control system block wiring diagrams.
 - c. Wiring instructions for each electronic component scheduled herein.
 2. Electrical Coordination: Coordinate with related sections the voltages and wiring details required at electrically controlled and operated hardware openings.
- D. Proof of Certification: Provide copy of manufacturer(s) official certification or accreditation document indicating proof of status as a qualified installer of Windstorm assemblies.
- E. Keying Schedule: After a keying meeting with the owner has taken place prepare a separate keying schedule detailing final instructions. Submit the keying schedule in electronic format. Include keying system explanation, door numbers, key set symbols, hardware set numbers and special instructions. Owner must approve submitted keying schedule prior to the ordering of permanent cylinders/cores.

F. Informational Submittals:

1. Product Test Reports: Indicating compliance with cycle testing requirements, based on evaluation of comprehensive tests performed by manufacturer and witnessed by a qualified independent testing agency.

G. Operating and Maintenance Manuals: Provide manufacturers operating and maintenance manuals for each item comprising the complete door hardware installation in quantity as required in Division 01, Closeout Submittals.

1.4 QUALITY ASSURANCE

A. Manufacturers Qualifications: Engage qualified manufacturers with a minimum 5 years of documented experience in producing hardware and equipment similar to that indicated for this Project and that have a proven record of successful in-service performance.

B. Installer Qualifications: A minimum 3 years documented experience hardware similar in material, design, and extent to that indicated for this Project and whose work has resulted in construction with a record of successful in-service performance.

C. Door Hardware Supplier Qualifications: Experienced commercial door hardware distributors with a minimum 5 years documented experience supplying hardware installations comparable in material, design, and extent to that indicated for this Project. Supplier recognized as a factory direct distributor by the manufacturers of the primary materials with a warehousing facility in Project's vicinity. Supplier to have on staff a certified Architectural Hardware Consultant (AHC) available during the course of the Work to consult with Contractor, Architect, and Owner concerning both standard and electromechanical door hardware and keying.

D. Integrated Wiegand, Wireless, and IP-Enabled Access Control Products Supplier Qualifications: Integrated access control products and accessories are required to be supplied and installed through current members of the ASSA ABLOY "Authorized Channel Partner" (ACP) and "Certified Integrator" (CI) programs. Suppliers are to be factory trained, certified prior to project bid, and a direct purchaser of the specified product. Installers are to be factory trained, certified prior to project bid, and are responsible for commissioning, servicing, and warranting the installed equipment specified for the project.

E. Source Limitations: Obtain each type and variety of door hardware specified in this section from a single source unless otherwise indicated.

1. Electrified modifications or enhancements made to a source manufacturer's product line by a secondary or third party source will not be accepted.
2. Provide electromechanical door hardware from the same manufacturer as mechanical door hardware, unless otherwise indicated

F. Each unit to bear third party permanent label demonstrating compliance with the referenced standards.

G. Keying Conference: Conduct conference to comply with requirements in Division 01 Section "Project Meetings." Keying conference to incorporate the following criteria into the final keying schedule document:

1. Function of building, purpose of each area and degree of security required.
2. Plans for existing and future key system expansion.
3. Requirements for key control storage and software.
4. Installation of permanent keys, cylinder cores and software.
5. Address and requirements for delivery of keys.

- H. Pre-Submittal Conference: Conduct coordination conference in compliance with requirements in Division 01 Section "Project Meetings" with attendance by representatives of Supplier(s), Installer(s), and Contractor(s) to review proper methods and the procedures for receiving, handling, and installing door hardware.
 - 1. Prior to installation of door hardware, conduct a project specific training meeting to instruct the installing contractors' personnel on the proper installation and adjustment of their respective products. Product training to be attended by installers of door hardware (including electromechanical hardware) for aluminum, hollow metal and wood doors. Training will include the use of installation manuals, hardware schedules, templates and physical product samples as required.
 - 2. Inspect and discuss electrical roughing-in, power supply connections, and other preparatory work performed by other trades.
 - 3. Review sequence of operation narratives for each unique access controlled opening.
 - 4. Review and finalize construction schedule and verify availability of materials.
 - 5. Review the required inspecting, testing, commissioning, and demonstration procedures
- I. At completion of installation, provide written documentation that components were applied to manufacturer's instructions and recommendations and according to approved schedule.

1.5 DELIVERY, STORAGE, AND HANDLING

- A. Inventory door hardware on receipt and provide secure lock-up and shelving for door hardware delivered to Project site.
- B. Tag each item or package separately with identification related to the final Door Hardware Schedule, and include basic installation instructions with each item or package.
- C. Deliver, as applicable, permanent keys, cylinders, cores and related accessories directly to Owner via registered mail or overnight package service. Instructions for delivery to the Owner shall be established at the "Keying Conference".

1.6 COORDINATION

- A. Templates: Obtain and distribute to the parties involved templates for doors, frames, and other work specified to be factory prepared for installing hardware. Check Shop Drawings of other work to confirm that adequate provisions are made for locating and installing hardware to comply with indicated requirements.
- B. Door Hardware and Electrical Connections: Coordinate the layout and installation of scheduled electrified door hardware and related access control equipment with required connections to source power junction boxes, low voltage power supplies, detection and monitoring hardware, and fire and detection alarm systems.
- C. Door and Frame Preparation: Doors and corresponding frames are to be prepared, reinforced and pre-wired (if applicable) to receive the installation of the specified electrified, monitoring, signaling and access control system hardware without additional in-field modifications.

1.7 WARRANTY

- A. General Warranty: Reference Division 01, General Requirements. Special warranties specified in this Article shall not deprive Owner of other rights Owner may have under other provisions of the Contract Documents and shall be in addition to, and run concurrent with, other warranties made by Contractor under requirements of the Contract Documents.

- B. Warranty Period: Written warranty, executed by manufacturer(s), agreeing to repair or replace components of standard and electrified door hardware that fails in materials or workmanship within specified warranty period after final acceptance by the Owner. Failures include, but are not limited to, the following:
 - 1. Structural failures including excessive deflection, cracking, or breakage.
 - 2. Faulty operation of the hardware.
 - 3. Deterioration of metals, metal finishes, and other materials beyond normal weathering.
 - 4. Electrical component defects and failures within the systems operation.
- C. Standard Warranty Period: One year from date of Substantial Completion, unless otherwise indicated.
- D. Special Warranty Periods:
 - 1. Lifetime for mortise locks and latches.
 - 2. Five years for exit hardware.
 - 3. Ten years for electric latch retraction exit motors
 - 4. Twenty-five years for manual surface door closer bodies.
 - 5. Two years for electromechanical door hardware.
 - 6. Lifetime for SN200 readers.

1.8 MAINTENANCE SERVICE

- A. Maintenance Tools and Instructions: Furnish a complete set of specialized tools and maintenance instructions as needed for Owner's continued adjustment, maintenance, and removal and replacement of door hardware.

1.9 OWNER STOCK – See Attic Stock at the end of Hardware Schedule.

PART 2 - PRODUCTS

2.1 SCHEDULED DOOR HARDWARE

- A. General: Provide door hardware for each door to comply with requirements in Door Hardware Sets and each referenced section that products are to be supplied under.
- B. Designations: Requirements for quantity, item, size, finish or color, grade, function, and other distinctive qualities of each type of door hardware are indicated in the Door Hardware Sets at the end of Part 3. Products are identified by using door hardware designations, as follows:
- C. Named Manufacturer's Products: Product designation and manufacturer are listed for each door hardware type required for the purpose of establishing requirements. Manufacturers' names are abbreviated in the Door Hardware Schedule.
- D. Substitutions: Requests for substitution and product approval for inclusive mechanical and electromechanical door hardware in compliance with the specifications must be submitted in writing and in accordance with the procedures and time frames outlined in Division 01, Substitution Procedures. Approval of requests is at the discretion of the architect, owner, and their designated consultants.

2.2 HANGING DEVICES

- A. Hinges: ANSI/BHMA A156.1 certified butt hinges with number of hinge knuckles as specified in the Door Hardware Sets.
1. Quantity: Provide the following hinge quantity, unless otherwise indicated:
 - a. Two Hinges: For doors with heights up to 60 inches.
 - b. Three Hinges: For doors with heights 61 to 90 inches.
 - c. Four Hinges: For doors with heights 91 to 120 inches.
 - d. For doors with heights more than 120 inches, provide 4 hinges, plus 1 hinge for every 30 inches of door height greater than 120 inches.
 2. Hinge Size: Provide the following, unless otherwise indicated, with hinge widths sized for door thickness and clearances required:
 - a. Widths up to 3'0": 4-1/2" standard or heavy weight as specified.
 - b. Sizes from 3'1" to 4'0": 5" standard or heavy weight as specified.
 3. Hinge Weight and Base Material: Unless otherwise indicated, provide the following:
 - a. Exterior Doors: Heavy weight, non-ferrous, ball bearing or oil impregnated bearing hinges unless Hardware Sets indicate standard weight.
 - b. Interior Doors: Standard weight, steel, ball bearing or oil impregnated bearing hinges unless Hardware Sets indicate heavy weight.
 4. Hinge Options: Comply with the following where indicated in the Hardware Sets or on Drawings:
 - a. Non-removable Pins: Provide set screw in hinge barrel that, when tightened into a groove in hinge pin, prevents removal of pin while door is closed; for the all out-swinging lockable doors.
 5. Acceptable Manufacturers:
 - a. Hager Companies (HA).
 - b. McKinney Products (MK).
 - c. Stanley Hardware (ST).
- B. Continuous Geared Hinges: ANSI/BHMA A156.26 Grade 1-600 certified continuous geared hinge. with minimum 0.120-inch thick extruded 6060 T6 aluminum alloy hinge leaves and a minimum overall width of 4 inches. Hinges are non-handed, reversible and fabricated to template screw locations. Factory trim hinges to suit door height and prepare for electrical cut-outs.
1. Acceptable Manufacturers:
 - a. McKinney Products (MK).
 - b. Pemko Manufacturing (PE).
 - c. Stanley Hardware (ST).

2.3 POWER TRANSFER DEVICES

- A. Concealed Quick Connect Electric Power Transfers: Provide concealed wiring pathway housing mortised into the door and frame for low voltage electrified door hardware. Furnish with Molex™ standardized plug connectors and sufficient number of concealed wires (up to 12) to accommodate the electrified functions specified in the Door Hardware Sets. Connectors plug directly to through-door wiring harnesses for connection to electric locking devices and power supplies. Wire nut connections are not acceptable.
1. Acceptable Manufacturers:
 - a. Pemko Manufacturing (PE) – EL-CEPT Series.
 - b. Securitron (SU) - EL-CEPT Series.
 - c. Stanley Hardware (ST) EPT-12C Series.
- B. Electric Door Wire Harnesses: Provide electric/data transfer wiring harnesses with standardized plug connectors to accommodate up to twelve (12) wires. Connectors plug directly to through-door wiring harnesses for connection to electric locking devices and power supplies. Provide sufficient number and type of concealed wires to accommodate electric function of specified hardware. Provide a connector for through-door electronic locking devices and from hinge to junction box above the opening. Wire nut connections are not acceptable. Determine the length required for each electrified hardware component for the door type, size and construction, minimum of two per electrified opening.
1. Provide one each of the following tools as part of the base bid contract:
 - a. McKinney Products (MK) - Electrical Connecting Kit: QC-R001.
 - b. McKinney Products (MK) - Connector Hand Tool: QC-R003.

2.4 DOOR OPERATING TRIM

- A. Flush Bolts and Surface Bolts: ANSI/BHMA A156.3 and A156.16, Grade 1, certified.
1. Manual flush bolts to be furnished with top rod of sufficient length to allow bolt location approximately six feet from the floor.
 2. Furnish dust proof strikes for bottom bolts.
 3. Surface bolts to be minimum 8" in length and U.L. listed for labeled fire doors and U.L. listed for windstorm components where applicable.
 4. Provide related accessories (mounting brackets, strikes, coordinators, etc.) as required for appropriate installation and operation.
 5. Acceptable Manufacturers:
 - a. Ives (IV).
 - b. Rockwood Manufacturing (RO).
 - c. Trimco (TC).
- B. Door Push Plates and Pulls: ANS/BHMA A156.6 certified door pushes and pulls of type and design specified in the Hardware Sets. Coordinate and provide proper width and height as required where conflicting hardware dictates.
1. Push/Pull Plates: Minimum .050 inch thick, size as indicated in hardware sets, with beveled edges, secured with exposed screws unless otherwise indicated.
 2. Door Pull and Push Bar Design: Size, shape, and material as indicated in the hardware sets. Minimum clearance of 2 1/2-inches from face of door unless otherwise indicated.
 3. Offset Pull Design: Size, shape, and material as indicated in the hardware sets. Minimum clearance of 2 1/2-inches from face of door and offset of 90 degrees unless otherwise indicated.
 4. Fasteners: Provide manufacturer's designated fastener type as indicated in Hardware Sets.

5. Acceptable Manufacturers:
 - a. Ives (IV).
 - b. Rockwood Manufacturing (RO).
 - c. Trimco (TC).

2.5 CYLINDERS AND KEYING

- A. General: Cylinder manufacturer to have minimum (10) years experience designing secured master key systems and have on record a published security keying system policy.
- B. Source Limitations: Obtain each type of keyed cylinder and keys from the same source manufacturer as locksets and exit devices, unless otherwise indicated.
 1. Acceptable Manufacturers:
 - a. Stanley Best (BE).
 - b. Sargent Cylinder Housings
 - c. No Substitution.
- C. Cylinders: Original manufacturer cylinders complying with the following:
 1. Mortise Type: Threaded cylinders with rings and cams to suit hardware application.
 2. Rim Type: Cylinders with back plate, flat-type vertical or horizontal tailpiece, and raised trim ring.
 3. Bored-Lock Type: Cylinders with tailpieces to suit locks.
 4. Mortise and rim cylinder collars to be solid and recessed to allow the cylinder face to be flush and be free spinning with matching finishes.
 5. Keyway: Match Facility Standard.
- D. Keying System: Each type of lock and cylinders to be factory keyed.
 1. Conduct specified "Keying Conference" to define and document keying system instructions and requirements.
 2. Furnish factory cut, nickel-silver large bow permanently inscribed with a visual key control number as directed by Owner.
 3. Existing System: Key locks to Owner's existing system.
- E. Key Quantity: Provide the following minimum number of keys:
 1. Change Keys per Cylinder: Two (2)
 2. Twenty construction cores
 3. 50 Key Blanks – Best "A" Keyway
- F. Construction Keying: Provide temporary keyed construction cores. Green Best Cores No Substitution . All Best temporary cores to be returned to the district at the end of the project.
- G. Key Registration List (Bitting List):
 1. Provide keying transcript list to Owner's representative in the proper format for importing into key control software.
 2. Provide transcript list in writing or electronic file as directed by the Owner.

- H. Key Control Cabinet: Provide a key control system including envelopes, labels, and tags with self-locking key clips, receipt forms, 3-way visible card index, temporary markers, permanent markers, and standard metal cabinet. Key control cabinet shall have expansion capacity of 150% of the number of locks required for the project. Provide a new cabinet to all new construction projects. Use Lund 1205-B as a basis of design.

1. Acceptable Manufacturers:

- a. Lund Equipment (LU).
- b. MMF Industries (MM).
- c. Telkee (TK).

2.6 MECHANICAL LOCKS AND LATCHING DEVICES

- A. Mortise Locksets, Grade 1 (Heavy Duty): ANSI/BHMA A156.13. Locksets are to be manufactured with a corrosion resistant steel case and be field-reversible for handing without disassembly of the lock body.

1. Acceptable Manufacturers

- a. Sargent Manufacturing (SA) 8200 Series – No substitutions
- b. Sargent Manufacturing (SA) 10X Series - No substitutions
 - 1) Use at student restrooms or as directed by Cy Fair ISD

2.7 AUXILIARY LOCKS

- A. Tubular Deadlocks: Deadlocks to be products of the same source manufacturer and keyway as other specified locksets.

1. Acceptable Manufacturers:

- a. Marks (MX) - 130 Series.
- b. Sargent Manufacturing (SA) – 480 Series.

2.8 LOCK AND LATCH STRIKES

- A. Strikes: Provide manufacturer's standard strike with strike box for each latch or lock bolt, with curved lip extended to protect frame, finished to match door hardware set, unless otherwise indicated, and as follows:

1. Flat-Lip Strikes: For locks with three-piece antifriction latchbolts, as recommended by manufacturer.
2. Aluminum-Frame Strike Box: Provide manufacturer's special strike box fabricated for aluminum framing.

- B. Standards: Comply with the following:

1. Strikes for Mortise Locks and Latches: BHMA A156.13.
2. Strikes for Auxiliary Deadlocks: BHMA A156.5.
3. Dustproof Strikes: BHMA A156.16.

2.9 CONVENTIONAL EXIT DEVICES

A. General Requirements: All exit devices specified herein shall meet or exceed the following criteria:

1. At doors not requiring a fire rating, provide devices complying with NFPA 101 and listed and labeled for "Panic Hardware" according to UL305. Provide proper fasteners as required by manufacturer including sex nuts and bolts at openings specified in the Hardware Sets.
2. Where exit devices are required on fire rated doors, provide devices complying with NFPA 80 and with UL labeling indicating "Fire Exit Hardware". Provide devices with the proper fasteners for installation as tested and listed by UL. Consult manufacturer's catalog and template book for specific requirements.
3. Except on fire rated doors, provide exit devices with hex key dogging device to hold the pushbar and latch in a retracted position. Provide optional keyed cylinder dogging on devices where specified in Hardware Sets.
4. Devices must fit flat against the door face with no gap that permits unauthorized dogging of the push bar. The addition of filler strips is required in any case where the door light extends behind the device as in a full glass configuration.
5. Lever Operating Trim: Where exit devices require lever trim, furnish manufacturer's heavy duty escutcheon trim with threaded studs for thru-bolts.
 - a. Lock Trim Design: As indicated in Hardware Sets, provide finishes and designs to match that of the specified locksets.
 - b. Where function of exit device requires a cylinder, provide a cylinder (Rim or Mortise) as specified in Hardware Sets.
6. Rail Sizing: Provide exit device rails factory sized for proper door width application.
7. Through Bolt Installation: For exit devices and trim as indicated (TB) in Door Hardware Sets.
8. Provide Less Dogging (LD) at all exit devices.
9. Add 31- Prefix to all exit devices being provided at two inch aluminum doors.
10. No self-tapping screws allowed.

B. Conventional Push Rail Exit Devices (Heavy Duty): ANSI/BHMA A156.3, Grade 1 certified panic and fire exit hardware devices furnished in the functions specified in the Hardware Sets. Exit device latch to be stainless steel, pullman type, with deadlock feature.

1. Acceptable Manufacturers:
 - a. Sargent Manufacturing (SA) - 80 Series.
 - b. No Substitution.

C. Tube Steel Removable Mullions: ANSI/BHMA A156.3 removable steel mullions with malleable-iron top and bottom retainers and a primed paint finish.

1. Provide keyed removable feature where specified in the Hardware Sets.
2. Provide stabilizers and mounting brackets as required.
3. Provide electrical quick connection wiring options as specified in the hardware sets.

4. Acceptable Manufacturers:
 - a. Stanley Precision (PR) - 822 Series.
 - b. No Substitution.

2.10 INTEGRATED WIEGAND OUTPUT ACCESS CONTROL EXIT DEVICES

- A. Wiegand Output Integrated Card Reader Exit Hardware: Wiegand output ANSI 156.3 Grade 1 rim, mortise, and vertical rod exit device hardware with integrated proximity card reader, latchbolt and touchbar monitoring, and request-to-exit signaling, in one complete unit. Hard wired, solenoid driven locking/unlocking control of the lever handle exit trim with 3/4" throw latch bolt. U.L listed and labeled for either panic or "fire exit hardware" for use on up to 3 hour fire rated openings. Available with or without keyed high security cylinder override.
 1. Open architecture, hard wired platform supports centralized control of locking units with new or existing Wiegand compatible access control systems. Inside push bar (request-to-exit) signaling and door position (open/closed status) monitoring (via separately connected DPS).
 2. Reader supports either HID 125 kHz proximity (up to 39 bits, including Corporate 1000) or 13.56 MHz (2K-32K) iClass® credentials.
 3. 12VDC external power supply required for reader, with optional 24VDC operation available with iClass® reader (125 kHz reader is always 12VDC). 24VDC required for solenoid operated exit trim (12VDC if applicable). Fail safe or fail secure options.
 4. Installation requires only one cable run from the exit hardware to the access control panel without requirements for additional proprietary lock panel interface boards or modules.
 5. Acceptable Manufacturers:
 - a. Sargent Manufacturing (SA) - SN – 56-SN20080 Series Exits. x SPAR04867
 - b. Sargent Manufacturing (SA) - SN – SN2008200 Series Locks.
 - c. No Substitution.

2.11 DOOR CLOSERS

- A. All door closers specified herein shall meet or exceed the following criteria:
 1. General: Door closers to be from one manufacturer, matching in design and style, with the same type door preparations and templates regardless of application or spring size. Closers to be non-handed with full sized covers including installation and adjusting information on inside of cover.
 2. Standards: Closers to comply with UL-10C for Positive Pressure Fire Test and be U.L. listed for use of fire rated doors.
 3. Cycle Testing: Provide closers which have surpassed 15 million cycles in a test witnessed and verified by UL.
 4. Size of Units: Comply with manufacturer's written recommendations for sizing of door closers depending on size of door, exposure to weather, and anticipated frequency of use. Where closers are indicated for doors required to be accessible to the physically handicapped, provide units complying with ANSI ICC/A117.1.
 5. Closer Arms: Provide heavy duty, forged steel closer arms unless otherwise indicated in Hardware Sets.
 6. Closers shall not be installed on exterior or corridor side of doors; where possible install closers on door for optimum aesthetics.

7. Closer Accessories: Provide door closer accessories including custom templates, special mounting brackets, spacers and drop plates, and through-bolt and security type fasteners as required for proper installation.
 8. Through Bolt Installation: All door closers are to be installed with (TB) through bolting as indicated in Door Hardware Sets.
 9. No self-tapping screws allowed.
- B. Door Closers, Surface Mounted (Heavy Duty): ANSI/BHMA A156.4, Grade 1 surface mounted, heavy duty door closers with complete spring power adjustment, sizes 1 thru 6; and fully operational adjustable according to door size, frequency of use, and opening force. Closers to be rack and pinion type, one piece cast iron or aluminum alloy body construction, with adjustable backcheck and separate non-critical valves for closing sweep and latch speed control. Provide non-handed units standard.
1. Acceptable Manufacturers:
 - a. Sargent Manufacturing (SA) – TB 351 Series.

2.12 SURFACE MOUNTED CLOSER HOLDERS

- A. Electromagnetic Door Holders: Certified ANSI A156.15 electromagnetic door holder/releases with a minimum 20 to 40 pounds holding power and single coil construction able to accommodate 12VDC, 24VAC, 24VDC and 120VAC. Coils to be independently wound, employing an integral fuse and armatures to include a positive release button.
1. Acceptable Manufacturers:
 - a. LCN Door Closers (LC) - SEM7800 Series.
 - b. Rixson (RF) - 980/990 Series.
 - c. Sargent Manufacturing (SA) - 1560 Series.

2.13 ARCHITECTURAL TRIM

- A. Door Protective Trim
1. General: Door protective trim units to be of type and design as specified below or in the Hardware Sets.
 2. Size: Fabricate protection plates (kick, armor, or mop) not more than 2" less than door width (LDW) on stop side of single doors and 1" LDW on stop side of pairs of doors, and not more than 1" less than door width on pull side. Coordinate and provide proper width and height as required where conflicting hardware dictates. Height to be as specified in the Hardware Sets.
 3. Protection Plates: ANSI/BHMA A156.6 certified protection plates (kick, armor, or mop), fabricated from the following:
 - a. Stainless Steel: 300 grade, 050-inch thick.
 4. Options and fasteners: Provide manufacturer's designated fastener type as specified in the Hardware Sets. Provide countersunk screw holes.

5. Acceptable Manufacturers:

- a. Ives (IV).
- b. Rockwood Manufacturing (RO).
- c. Trimco (TC).

2.14 DOOR STOPS AND HOLDERS

A. General: Door stops and holders to be of type and design as specified below or in the Hardware Sets.

B. Door Stops and Bumpers: ANSI/BHMA A156.16, Grade 1 certified door stops and wall bumpers. Provide wall bumpers, either convex or concave types with anchorage as indicated, unless floor or other types of door stops are specified in Hardware Sets. Do not mount floor stops where they will impede traffic. Where floor or wall bumpers are not appropriate, provide overhead type stops and holders.

1. Acceptable Manufacturers:

- a. Ives (IV).
- b. Rockwood Manufacturing (RO).
- c. Trimco (TC).

C. Overhead Door Stops and Holders: ANSI/BHMA A156.6, Grade 1 certified overhead stops and holders to be surface or concealed types as indicated in Hardware Sets. Track, slide, arm and jamb bracket to be constructed of extruded bronze and shock absorber spring of heavy tempered steel. Provide non-handed design with mounting brackets as required for proper operation and function.

1. Acceptable Manufacturers:

- a. Do not use overhead stops/holders

2.15 ARCHITECTURAL SEALS

A. General: Thresholds, weatherstripping, and gasket seals to be of type and design as specified below or in the Hardware Sets. Provide continuous weatherstrip gasketing on exterior doors and provide smoke, light, or sound gasketing on interior doors where indicated. At exterior applications provide non-corrosive fasteners and elsewhere where indicated.

B. Smoke Labeled Gasketing: Assemblies complying with NFPA 105 that are listed and labeled by a testing and inspecting agency acceptable to authorities having jurisdiction, for smoke control ratings indicated, based on testing according to UL 1784.

1. Provide smoke labeled perimeter gasketing at all smoke labeled openings.

C. Fire Labeled Gasketing: Assemblies complying with NFPA 80 that are listed and labeled by a testing and inspecting agency acceptable to authorities having jurisdiction, for fire ratings indicated, based on testing according to UL-10C.

1. Provide intumescent seals as indicated to meet UL10C Standard for Positive Pressure Fire Tests of Door Assemblies, and UBC 7-2, Fire Tests of Door Assemblies.

D. No Replaceable Seal Strips allowed: Provide only those units where they can be screw applied..

E. Acceptable Manufacturers:

1. National Guard Products (NG).

2. Pemko Manufacturing (PE).
3. Reese Enterprises, Inc. (RE).

2.16 ELECTRONIC ACCESSORIES

- A. Door Position Switches: Door position magnetic reed contact switches specifically designed for use in commercial door applications. On recessed models the contact and magnetic housing snap-lock into a 1" diameter hole. Surface mounted models include wide gap distance design complete with armored flex cabling. Provide SPDT, N/O switches with optional Rare Earth Magnet installation on steel doors with flush top channels.

1. Acceptable Manufacturers:

- a. Provided by Security

- B. Switching Power Supplies: Provide UL listed or recognized filtered and regulated power supplies. Provide single, dual, or multi-voltage units as shown in the hardware sets. Units must be expandable up to eight Class 2 power limited outputs. Units must include the capability to incorporate a battery backup option with integral battery charging capability in addition to operating the DC load in event of line voltage failure. Provide the least number of units, at the appropriate amperage level, sufficient to exceed the required total draw for the specified electrified hardware and access control equipment.

1. Acceptable Manufacturers:

- a. Provided by Security

2.17 FABRICATION

- A. Fasteners: Provide door hardware manufactured to comply with published templates generally prepared for machine, wood, and sheet metal screws. Provide screws according to manufacturers recognized installation standards for application intended.

2.18 FINISHES

- A. Standard: Designations used in the Hardware Sets and elsewhere indicate hardware finishes complying with ANSI/BHMA A156.18, including coordination with traditional U.S. finishes indicated by certain manufacturers for their products.
- B. Provide quality of finish, including thickness of plating or coating (if any), composition, hardness, and other qualities complying with manufacturer's standards, but in no case less than specified by referenced standards for the applicable units of hardware.
- C. Protect mechanical finishes on exposed surfaces from damage by applying a strippable, temporary protective covering before shipping.

PART 3 - EXECUTION

3.1 EXAMINATION

- A. Examine scheduled openings, with Installer present, for compliance with requirements for installation tolerances, labeled fire door assembly construction, wall and floor construction, and other conditions affecting performance.

- B. Notify architect of any discrepancies or conflicts between the door schedule, door types, drawings and scheduled hardware. Proceed only after such discrepancies or conflicts have been resolved in writing.

3.2 PREPARATION

- A. Hollow Metal Doors and Frames: Comply with ANSI/DHI A115 series.
- B. Wood Doors: Comply with ANSI/DHI A115-W series.

3.3 INSTALLATION

- A. Install each item of mechanical and electromechanical hardware and access control equipment to comply with manufacturer's written instructions and according to specifications.
 - 1. Installers are to be trained and certified by the manufacturer on the proper installation and adjustment of fire, life safety, and security products including: hanging devices; locking devices; closing devices; and seals.
- B. Mounting Heights: Mount door hardware units at heights indicated in following applicable publications, unless specifically indicated or required to comply with governing regulations:
 - 1. Standard Steel Doors and Frames: DHI's "Recommended Locations for Architectural Hardware for Standard Steel Doors and Frames."
 - 2. Wood Doors: DHI WDHS.3, "Recommended Locations for Architectural Hardware for Wood Flush Doors."
 - 3. Where indicated to comply with accessibility requirements, comply with ANSI A117.1 "Accessibility Guidelines for Buildings and Facilities."
 - 4. Provide blocking in drywall partitions where wall stops or other wall mounted hardware is located.
- C. Integrated Wiegand access control products are required to be installed through current members of the ASSA ABLOY "Certified Integrator" (CI) program.
- D. Retrofitting: Install door hardware to comply with manufacturer's published templates and written instructions. Where cutting and fitting are required to install door hardware onto or into surfaces that are later to be painted or finished in another way, coordinate removal, storage, and reinstallation of surface protective trim units with finishing work specified in Division 9 Sections. Do not install surface-mounted items until finishes have been completed on substrates involved.
- E. Thresholds: Set thresholds for exterior and acoustical doors in full bed of sealant complying with requirements specified in Division 7 Section "Joint Sealants."
- F. Storage: Provide a secure lock up for hardware delivered to the project but not yet installed. Control the handling and installation of hardware items so that the completion of the work will not be delayed by hardware losses before and after installation.
- G. No self-tapping screws allowed.

3.4 FIELD QUALITY CONTROL

- A. Field Inspection: Supplier will perform a final inspection of installed door hardware and state in report whether work complies with or deviates from requirements, including whether door hardware is properly installed, operating and adjusted.

3.5 ADJUSTING

- A. Initial Adjustment: Adjust and check each operating item of door hardware and each door to ensure proper operation or function of every unit. Replace units that cannot be adjusted to operate as intended. Adjust door control devices to compensate for final operation of heating and ventilating equipment and to comply with referenced accessibility requirements.
- B. Final Adjustment: Installer shall return and make final adjustment of all hardware once all air conditioning test and balance is complete. Final adjustment shall be made while air conditioner system is operating. Coordinate with General Contractor and Owner.

3.6 CLEANING AND PROTECTION

- A. Protect all hardware stored on construction site in a covered and dry place. Protect exposed hardware installed on doors during the construction phase. Install any and all hardware at the latest possible time frame.
- B. Clean adjacent surfaces soiled by door hardware installation.
- C. Clean operating items as necessary to restore proper finish. Provide final protection and maintain conditions that ensure door hardware is without damage or deterioration at time of owner occupancy.

3.7 DEMONSTRATION

- A. Instruct Owner's maintenance personnel to adjust, operate, and maintain mechanical and electromechanical door hardware.

3.8 DOOR HARDWARE SETS

The hardware sets represent the design intent and direction of the owner and architect. They are a guideline only and should not be considered a detailed hardware schedule. Discrepancies, conflicting hardware and missing items should be brought to the attention of the architect with corrections made prior to the bidding process. Omitted items not included in a hardware set should be scheduled with the appropriate additional hardware required for proper application and functionality.

Manufacturer Abbreviations

- 1. MK - McKinney
- 2. PE - Pemko
- 3. SA - SARGENT
- 4. BE - BEST Locks & Closers
- 5. RO - Rockwood
- 6. AK - Alarm Controls
- 7. OT - Other

Hardware Sets

Set: 1.0

Doors: 18

Description: Sgle - exterior SN200 exit

1	Continuous Hinge	CFM HD1 x Dr. Ht.		PE
1	Rim Exit Device, Storeroom	LD 19 TB 43 56 70 SN200 8804 826	US32D	SA
1	Interchangeable Core	I/CK-7	626	BE
1	Const. Core	7190224	Green	BE
1	Door Closer	TB 351 O/P9 (type as required)	EN	SA
1	Door Stop	462	US2C	RO
1	Gasketing	2891APK (head & jambs)		PE
1	Rain Guard	346C x Frame Width		PE
1	Sweep	345ANB x Dr. Width		PE
1	Threshold	2005AT MSES25SS X Opening Width		PE
1	Door Loop	DL-2		AK
2	Viewer	622	CRM	RO

Set: 2.0

Doors: 2

Description: Existing add 2N station

1	Balance of hardware	Existing to remain		OT
1	2N Station	2N Station		OT

Set: 3.0

Doors: 5

Description: Existing add 8804 exit, 2891, 262 stop

1	Rim Exit Device, Storeroom	LD 19 TB 43 70 8804	US32D	SA
1	Interchangeable Core	I/CK-7	626	BE
1	Const. Core	7190224	Green	BE
1	Door Stop	462	US2C	RO
1	Gasketing	2891APK (head & jambs)		PE
1	Balance of hardware	Existing to remain		OT

Set: 4.0

Doors: 17, 6

Description: Existing add SN200 8504 and 8510, mullion, 462 stops

1 Mullion	L980A	US28	SA
1 Rim Exit Device, Storeroom	LD 19 TB 43 56 70 SN200 8504	US32D	SA
1 Rim Exit Device, Exit Only	LD 19 TB 43 8510 EO	US32D	SA
2 Interchangeable Core	I/CK-7	626	BE
2 Const. Core	7190224	Green	BE
1 Door Loop	DL-2		AK
1 Balance of hardware	Existing to remain		OT

Notes: modify strike to work with exit.

Set: 5.0

Doors: 19

Description: Existing add 2N station, 2891, 462 stop

1 Door Stop	462	US2C	RO
1 Gasketing	2891APK (head & jambs)		PE
1 Balance of hardware	Existing to remain		OT
1 2N Station	2N Station		OT

Set: 6.0

Doors: 20

Description: Existing add 2N station, 56-8804 exit, 2891, 462 stop

1 Rim Exit Device, Storeroom	LD 19 TB 43 56 70 8804	US32D	SA
1 Door Stop	462	US2C	RO
1 Gasketing	2891APK (head & jambs)		PE
1 Balance of hardware	Existing to remain		OT
1 2N Station	2N Station		OT

Set: 7.0

Doors: 24, 25, 26

Description: Existing add SN200 8500 exit, 462 stop

1 Rim Exit Device, Storeroom	LD 19 TB 43 56 70 SN200 8504	US32D	SA
1 Interchangeable Core	I/CK-7	626	BE
1 Const. Core	7190224	Green	BE
1 Door Stop	462	US2C	RO
1 Door Loop	DL-2		AK
1 Balance of hardware	Existing to remain		OT

Notes: Field verify that these existing doors have card readers.

Set: 7.1

Doors: 15, 16, 22, 23

Description: Existing add 8500 exit, 462 stop

1	Rim Exit Device, Storeroom	LD 19 TB 43 70 8504	US32D	SA
1	Interchangeable Core	I/CK-7	626	BE
1	Const. Core	7190224	Green	BE
1	Door Stop	462	US2C	RO
1	Balance of hardware	Existing to remain		OT

Set: 8.0

Doors: 1

Description: Existing add SN200 and 8810 exits, 462 stops

1	Rim Exit x SPAR04867/NC-E11	19 LD TB 43 70 56-SN200-8804	US32D	SA
1	Rim Exit Device, Exit Only	19 TB 43 8810 EO	US32D	SA
2	Door Stop	462	US2C	RO
1	Balance of hardware	Existing to remain		OT

Set: 9.0

Doors: 10, 11, 7, 8

Description: Existing SN200 exit, loop, 2891, 462 stops, anchor hinge

1	Anchor Hinge	TA392	US32D	MK
1	Rim Exit x SPAR04867/NC-E11	19 LD TB 43 70 56-SN200-8804	US32D	SA
1	Interchangeable Core	I/CK-7	626	BE
1	Const. Core	7190224	Green	BE
1	Door Stop	462	US2C	RO
1	Gasketing	2891APK (head & jambs)		PE
1	Door Loop	DL-2		AK
2	Viewer	622	CRM	RO
1	Balance of hardware	Existing to remain		OT

Set: 10.0

Doors: 13, 14

Description: Existing add SN200 exit, loop, 2891, 462 stops

1	Rim Exit x SPAR04867/NC-E11	19 LD TB 43 70 56-SN200-8804	US32D	SA
1	Interchangeable Core	I/CK-7	626	BE
1	Const. Core	7190224	Green	BE
2	Door Stop	462	US2C	RO
1	Gasketing	2891APK (head & jambs)		PE
1	Door Loop	DL-2		AK
4	Viewer	622	CRM	RO
1	Balance of hardware	Existing to remain		OT

Set: 11.0

Doors: 21.2

Description: Existing add 8500 exit only, mullion

1	Mullion Lock	98-2520		SA
1	Mullion	L980S	PC	SA
1	Rim Exit Device, Exit Only	LD 19 TB 43 8510 EO	US32D	SA
1	Balance of hardware	Existing to remain		OT

Set: 11.1

Doors: 21.1

Description: Existing add SN200 8500 exit, slider

1	Rim Exit Device, Storeroom	LD 19 TB 43 56 70 SN200 8504	US32D	SA
1	68-1375 8500	Mounting Rail Insert		SA
1	Interchangeable Core	I/CK-7	626	BE
1	Const. Core	7190224	Green	BE
1	Balance of hardware	Existing to remain		OT

Set: 12.0

Description: Existing add SN200 reader (NOT USED)

1	SN200 Reader	52 6027 (Exit / Lock)	26D	SA
1	Balance of hardware	Existing to remain		OT

Notes: reader for 400.3 to be installed on corridor side.

Set: 13.0

Doors: 27

Description: Existing add 462 stop

1	Door Stop	462	US2C	RO
1	Balance of hardware	Existing to remain		OT

Notes: Replace jamb reader with SN200 reader.

Set: 14.0

Doors: 130, 209, 220, 235, 401, 403, 409, 410, 421

Description: Existing add thumb turn

1	130KB	Thumbturn Kit	26D	SA
1	Balance of hardware	Existing to remain		OT

Set: 15.0

Doors: 420.1

Description: Existing add thumbturn kits, 491S

1	130KB	Thumbturn Kit	26D	SA
1	Door Stop & Holder	491S	US26D	RO
1	Balance of hardware	Existing to remain		OT

Set: 16.0

Doors: 115.3, 115.4

Description: Existing add 704 exit trim

1	Exit Trim	70-704 ETL	US32D	SA
1	Interchangeable Core	I/CK-7	626	BE
1	Const. Core	7190224	Green	BE
1	Balance of hardware	Existing to remain		OT

Set: 17.0

Doors: 105, 138, 207, 243

Description: Existing add brushed astragal

1	Astragal	354CP x Dr. Height		PE
1	Balance of hardware	Existing to remain		OT

Set: 18.0

Doors: 351, 613, 614, 623

Description: Existing add 491 stop

1	Door Stop & Holder	491-RKW	US26D	RO
1	Balance of hardware	Existing to remain		OT

Set: 19.0

Doors: 301

Description: New Classroom

4	Hinge, Full Mortise	TA2714	US26D	MK
1	Classroom Security Intruder Lock	V01 EMB 70 8238 VN1L 90-3/8" Collar	US26D	SA
2	Interchangeable Core	I/CK-7	626	BE
2	Const. Core	7190224	Green	BE
1	Door Closer	TB 351 O/P9 (type as required)	EN	SA
1	Door Stop	462	US2C	RO
3	Silencer	608		RO

Set: 20.0

Doors: 100, 101, 102, 104, 106, 111, 112, 114, 116, 117, 120, 121, 122, 123, 124, 125, 126, 127, 128, 129, 134, 135, 136, 137, 140, 141, 142, 143, 144, 145, 200, 201, 202, 203, 204, 206, 208, 213, 214, 215, 216, 217, 218, 219, 224, 225, 226, 227, 228, 229, 231, 232, 233, 234, 239, 240, 241, 242, 244, 246, 247, 248, 249, 250, 254, 255, 310, 312

Description: Existing add 351 PS closer

1	Surface Closer	TB 351 PS	EN	SA
1	Balance of hardware	Existing to remain		OT

Set: 21.0

Doors: 316

Description: Existing add 351 PSH closer

1	Surface Closer	TB 351 PSH	EN	SA
1	Balance of hardware	Existing to remain		OT

Set: 22.0

Doors: 600, 600.1, 601

Description: Existing add 351 PSH and anchor hinge

2	Anchor Hinge	TA392	US32D	MK
2	Surface Closer	TB 351 PSH	EN	SA
1	Balance of hardware	Existing to remain		OT

Set: 23.0

Doors: 314.1

Description: Existing add 8238 and 351 PSH

1	Classroom Security Intruder Lock	V01 EMB 70 8238 VN1L 90-3/8" Collar	US26D	SA
2	Interchangeable Core	I/CK-7	626	BE
2	Const. Core	7190224	Green	BE
1	Surface Closer	TB 351 PSH	EN	SA
1	Balance of hardware	Existing to remain		OT

Set: 24.0

Doors: 301A, 303A, 331A, 512A

Description: New storage

4	Hinge, Full Mortise	TA2714	US26D	MK
1	Storeroom/Closet Lock	70 8204 LL	US26D	SA
1	Interchangeable Core	I/CK-7	626	BE
1	Const. Core	7190224	Green	BE
1	Door Stop	481H	US26D	RO
3	Silencer	608		RO

Set: 25.0

Doors: 500, 520

Description: New classroom w/ gasketing

4	Hinge, Full Mortise	TA2714	US26D	MK
1	Classroom Security Intruder Lock	V01 EMB 70 8238 VN1L 90-3/8" Collar	US26D	SA
2	Interchangeable Core	I/CK-7	626	BE
2	Const. Core	7190224	Green	BE
1	Door Closer	TB 351 O/P9 (type as required)	EN	SA
1	Door Stop	462	US2C	RO
1	Gasketing	S88BL		PE

Set: 26.0

Doors: 512, 513

Description: New office

4	Hinge, Full Mortise	TA2714	US26D	MK
1	Classroom Lock	70 8237 LL	US26D	SA
1	Interchangeable Core	I/CK-7	626	BE
1	Const. Core	7190224	Green	BE
1	Door Stop	462	US2C	RO
1	Gasketing	S88BL		PE

Set: 27.0

Description: New overhead door (NOT USED)

1	Mortise Cylinder	as required	US32D	SA
1	Interchangeable Core	I/CK-7	626	BE
1	Const. Core	7190224	Green	BE

Notes: Hardware by overhead door manufacturer. Verify cylinder requirements, if any.

Cook-Labay-Truitt MS Renovations
Cypress-Fairbanks Independent School District
Houston, Texas

Set: 28.0

Description: **Attic Stock - EVERY CAMPUS

5	Mullion Lock	98-2520		SA
5	Mullion Lock	98-2518		SA
5	Classroom Security Intruder Lock Body	8238	US26D	SA
5	130KB	Thumbturn Kit	26D	SA
50	Interchangeable Core	I/CK-7	626	BE
50	Key Blanks	Best "A" Keyway		BE
12	Regular Hold Open Arm	25-H	EN	SA
12	Parallel Hold Open Arm	25-PSH	EN	SA
4	SN200 Reader	52 6027 (Exit / Lock)	26D	SA

Notes: All attic stock ships direct to
Director of Technical Services
Cy Fair ISD Lockshop
11430 Perry Road
Houston, Texas 77064
All attic stock to ship directly to Cy Fair.
DO NOT ship to jobsite.

SECTION 08 80 00

GLAZING

PART 1 - GENERAL

1.1 SUMMARY

- A. Section Includes: Glass and glazing accessories.
- B. Related Sections:
 - 1. Section 06 40 00 - Architectural Woodwork; display case glass, track, and hardware.
 - 2. Section 07 92 00 - Joint Sealants
 - 3. Section 08 11 00 - Hollow Metal Doors and Frames.
 - 4. Section 08 14 23 - Plastic-laminate-faced Wood Doors.
 - 5. Section 08 41 13 - Aluminum-framed Entrances and Storefronts.
 - 6. Section 08 44 13 - Glazed Aluminum Curtain Walls.

1.2 PERFORMANCE REQUIREMENTS

- A. Glass and glazing materials of this section shall provide continuity of building enclosure vapor and air barrier
 - 1. In conjunction with materials described in SECTION 07 92 00 - JOINT SEALANTS.
 - 2. Maintain continuous air and vapor barrier throughout glazed assembly from glass pane to heel bead of glazing sealant.
- B. Design and size glass to withstand dead loads and live loads caused by pressure and suction of wind as calculated in accordance with building code, and measured in accordance with ASTM E 330.
- C. Limit glass deflection to $l/200$ or flexure limit of glass with full recovery of glazing materials, whichever is less.

1.3 SUBMITTALS

- A. Submit product data and samples under provisions of SECTION 01 33 23 - SHOP DRAWINGS, PRODUCT DATA AND SAMPLES.
- B. Provide structural, physical and environmental characteristics, size limitations, special handling or installation requirements.
- C. Provide data on glazing sealant. Identify colors available.
- D. Samples:
 - 1. Submit 2 samples of each type of glass (except clear glass), 12" x 12" in size, illustrating glass unit, coloration, design.
 - 2. Submit 4" long bead of glazing sealant in color selected.

1.4 QUALITY ASSURANCE

- A. Glazing Standards: Comply with recommendations of Glass Association of North America (GANA) "Glazing Manual."
- B. Source Quality Control: Glass shall be identified by the manufacturer's labels of grade and quality. Temporary labels shall not be removed until final cleaning. Permanent labels on tempered glass shall not be removed.
 - 1. Safety Glazing Labeling: Where safety glazing is indicated, permanently mark glazing with certification label of the SGCC or another certification agency acceptable to authorities having jurisdiction. Label shall indicate manufacturer's name, type of glass, thickness, and safety glazing standard with which glass complies.
 - 2. Insulating-Glass Certification Program: Permanently marked either on spacers or on at least one component lite of units with appropriate certification label of the IGCC.
- C. Safety Glazing Standard: Where safety glass is indicated or required, provide type of products indicated which comply with ANSI Z97.1 and testing requirements of CPSC 16 CFR Part 1201 for Category II materials.

- D. Fire-Rated Door Assemblies: Assemblies complying with NFPA 80 that are listed and labeled by a testing and inspecting agency acceptable to authorities having jurisdiction, for fire ratings indicated, based on testing according to NFPA 252.
- E. Fire-Rated Window Assemblies: Assemblies complying with NFPA 80 that are listed and labeled by a testing and inspecting agency acceptable to authorities having jurisdiction, for fire ratings indicated, based on testing according to NFPA 257.
- F. Security Glazing Film (-FM)
 - 1. Manufacturer Qualifications: Security glazing film manufacturer specializing in manufacture of security glazing films with minimum 5 years successful experience with the exact product specified.
 - 2. Installer Qualifications: Direct employees of security glazing film manufacturer trained in all aspects of film installation.
- G. Security Glazing Film (-FM) Field Mockup: Install security glazing film on one lite of glazing. Approved mockup will serve as standard for installation. Approved mockup may be included in finished Work.

1.5 DELIVERY, STORAGE, AND HANDLING

- A. Protect glass and glazing materials during delivery, storage, and handling as required to prevent edge damage to glass, and damage to glass and glazing materials from effects of moisture including condensation, or temperature changes, and other causes.

1.6 WARRANTY

- A. Provide written 10-year warranty signed by manufacturer of insulating glass agreeing to furnish replacements for those insulating glass units developing manufacturing defects. Manufacturing defects are defined as failure of hermetic seal of air space (beyond that due to glass breakage) as evidenced by intrusion of dirt or moisture, internal condensation or fogging, and other visual indications of seal failure or performance.
- B. Provide written 5-year warranty signed by manufacturer of spandrel glass agreeing to furnish replacements for those spandrel glass units developing defects of ceramic frit. Warranty covers deterioration due to normal conditions of use.
- C. Provide written 10-year warranty signed by manufacturer of polycarbonate sheets against breakage, yellowing, hazing, abrasion resistance, loss of light transmission, and coating failure of polycarbonate sheets.

PART 2 - PRODUCTS

2.1 ACCEPTABLE MANUFACTURERS

- A. Basis of Design products are Vitro Architectural Glass (PPG): Provide glass as manufactured by one of the following:
 - AGC Glass North America
 - Guardian Industries Corp.
 - Technical Glass Products
 - Oldcastle Building Envelope
 - Pilkington North America, Inc. (NSG Group)
 - Vitro Architectural Glass (formerly PPG Glass)
- B. Basis of Design Tinted, Low-E glass: Confirm match of specified tinted Low-E glazing with existing tinted Low-E glazing to remain in place. Notify Architect of discrepancies before procuring glazing.

2.2 GLASS

- A. (TT1) Tinted, Tempered, Insulating Low-E Glass: Manufacturer's standard 1" thick pre-assembled units consisting of 2 sheets of tempered glass, ASTM C 1048, enclosing a hermetically sealed dehydrated air space; with spacers, sealant, and without protective edge banding. Metal spacers shall be finished to match finish of aluminum storefronts.
 - 1. Interior Pane: Type I, Class 1 (Clear), Quality q3 (Glazing select), Kind FT - Fully Tempered, Condition A - Uncoated surfaces; 1/4" thickness.
 - 2. Air Space Thickness: 1/2".

3. Exterior Pane: Type I, Class 2 - Vitro Solargray tint (Tinted Heat-Absorbing and Light-Reducing), Quality q3 (Glazing select), Kind FT - Fully Tempered, Condition C - Other coated surfaces with low-emissivity Vitro Solarban 70 coating on second surface; 1/4" thickness.
 4. Performance Characteristics: Low-E insulating glass shall comply with the following:
 - a. Solar Heat Gain Coefficient: 0.19
 - b. Winter U-value: 0.28.
 - c. Visible Transmittance: 32%
- B. (TT-IR) Tinted, Impact-Resistant, Insulated Low-E Glass Units: 1-inch thick pre-assembled units consisting of 2 sheets of glazing as specified, enclosing a hermetically sealed dehydrated air space; with spacers, sealant, and without protective edge banding. Metal spacers shall be finished to match finish of aluminum frame systems.
1. Exterior Pane: ASTM C 1048, Type I, Class 2 (Tinted Heat-Absorbing and Light-Reducing) - Vitro Architectural Glass (formerly PPG Industries, Glass Group): Solargray tint, Quality q3 (Glazing select), Kind FT - Fully Tempered, 3/8-inch thick, Condition C (other coated surfaces).
 - a. Low-E Coating: Vitro Architectural Glass (formerly PPG Industries, Glass Group): Solarban 70 low-emissivity (sputtered) coating on 2nd surface.
 2. Air Space-thick: 3/8-inch.
 3. Interior Pane: Impact-resistant laminated safety glazing with proprietary layup, clear, Condition A (uncoated surfaces), 3/8-inch thick; compliant with ASTM F1233 Level 1.3.
 - a. Product: Global Security Glazing: Childgard Security Glazing SG4 attack resistant.
 4. Performance Characteristics: Low-E insulating glass shall comply with the following:
 - a. Visible Light Transmittance: 62%
 - b. Winter U-value: 0.28
 - c. Shading Coefficient: 0.31
 - d. Solar Heat Gain Coefficient 0.27
- C. (CT4) Clear, Tempered Glass: ASTM C 1048, Type I, Class 1 (Clear), Quality q3 (Glazing select). Kind FT - Fully Tempered, Condition A - Uncoated surfaces, 1/4" thickness.
- D. (CI2) Clear, Impact-Resistant, Laminated Glass: Provide Laminated Glass, two panes of Class 1 (Clear) float glass (ASTM C 1036) of equal thickness, laminated together with not less than 0.09" thick polyvinyl butyl plastic interlayer to provide an overall thickness of 9/16" at interior vestibule. Fabricate laminated glass using laminator's standard heat- plus-pressure process to produce glass free from foreign substances and air/glass pockets.
1. 9/16" thick Monolithic Laminated Glass at Vestibule Interior Storefront:
 - a. Interior Pane: Type I, Class 1 (Clear), Quality q3 (Glazing select), Kind FT - Fully Tempered, Condition A - Uncoated surfaces, 1/4" thick.
 - b. Laminated inner layer of 0.09" thick clear polyvinyl butyl plastic manufactured by Solutia Saflex; Eastman Chemical Co. or Trosifol; Kuraray.
 - c. Exterior Pane: Type I, Class 1 (Clear), Quality q3 (Glazing select), Kind FT - Fully Tempered, Condition A - Uncoated surfaces, 1/4" thick.
- E. (CI3) Impact-Resistant, Laminated Clear Glass with proprietary layup at locations indicated, clear, Condition A (uncoated surfaces); 3/8-inch thick; compliant with ASTM F1233 Level 1.3.
1. Product: Global Security Glazing: Childgard Security Glazing.
- F. (-F) Glazing Film Glass and plastic finishes field-applied application to glass or plastic material as visual opaque or decorative film.
1. Film: Polyester
 2. Decorative Pattern: Printed, to be selected by Architect from manufacturer's complete range.
 3. Adhesive: Acrylic, Pressure Sensitive, Permanent
 4. Liner: Silicone-coated Polyester
 5. Thickness (Average) (Film and Adhesive without Liner): 3.2 mils
 6. Fire Performance: Surface burning characteristics when tested in accordance with ASTM E84: Class A
 - a. Flame Spread: 25 maximum.
 - b. Smoke Developed: 450 maximum
- G. Clear Glass Mirrors, Unframed: ASTM C 1503, Mirror Select.
1. Nominal thickness 1/4". Backs shall have two coats of silver hermetically sealed, complying with GS-27, with an impervious protective coating of copper deposited over silver by electrolysis, and finished with a special composition hard, mirror-backing paint. Mirrors shall bear manufacturer's labels. Mirrors shall have ground and polished edges.
 2. Mirror Back Safety Tape: ANSI Z97.1.

3. J-Molds: Provide stainless steel continuous "J" clip at bottom and "J" clips around perimeter of mirror to anchor mirror to wall (Approx. Size: 3/8" x 3/8").
- H. (-FM) Security Glazing Film
 1. Product: 23 Mil Film as manufactured by Armoured One LLC, Syracuse, NY; website: www.armouredone.com; phone: (315) 720-4186.
 2. Security Glazing Film: Single thickness of 23 mil (0.023 inch) thick clear, UV stable, optically transparent, polyester film with pressure-sensitive adhesive backing for permanent bonding to glass.
 - a. Installation of multiple layers of thinner film to accomplish the required thickness is not acceptable.
 - b. Certification: F TD SA – Standard for Shooter Attack certification, Class 1 (tested on 1/4" tempered glass).
 - c. Surface Burning Characteristics: (ASTM E84): Flame spread index of 25 maximum, and smoke developed index of 450 maximum.
 3. Anchoring System:
 - a. Sealant: Dow 995 Structural Silicone or approved equivalent; color matched to frame.
 - b. Mechanical anchoring system as recommended by film manufacturer.

2.3 GLAZING MATERIALS

- A. Glazing Compound: Comply with ASTM C 1311 or FS TT-S-00230, one-part, non-sag acrylic polymeric sealant. Product/manufacturer; one of the following:
Acryl-R Acrylic Sealant; Schnee-Moorehead, Inc.
Mono 555; Tremco
- B. Channel Glazing Strips; Hollow Metal Doors and Frames: Provide black vinyl channel glazing strips, Glazing Vinyl for 990 Sliders Part #6062-01 as manufactured by Kawneer.
- C. Glazing Compound for Fire-Rated Glazing Materials:
 1. Glazing Tape: Closed cell polyvinyl chloride (PVC) foam, coiled on release paper over adhesive on two sides, maximum water absorption by volume of 2 percent. Glass panels that exceed 1,393 sq.-inches for 90-minute ratings must be glazed with fire-rated glazing tape supplied by manufacturer.
 2. Glazing Compound: DAP 33 putty.
 3. Setting Blocks: Neoprene, EPDM,; tested for compatibility with glazing compound; of 70 to 90 Shore A hardness.
 4. Cleaners, Primers, and Sealers: Type recommended by manufacturer of glass and gaskets.
- D. Mirror Mastic: Combination of asphaltic bitumens, fibers and mineral spirits. Product/manufacturer; one of the following:
Gunther Pro®; Gunther Mirror Mastics
7HR4 Mirror Tac®; Pecora Corp.
Mirro-Mastic; Palmer Products Corporation.
- E. Accessories: Setting blocks, tape, vinyl gaskets and spacer strips as required for a complete installation.

PART 3 - EXECUTION

3.1 INSPECTION

- A. Examine areas to receive glass for conditions that will adversely affect the execution and quality of work. Do not start this work until unsatisfactory conditions are corrected.
 1. Confirm fit of specified glazing and glazing units into glazing pocket of existing-to-remain frames and new frames to receive new glazing. Notify Architect of unsatisfactory conditions.

3.2 INSTALLATION

- A. Setting Glass: Glazing shall be done at the site by skilled glaziers in conformance with the general conditions governing glazing in the GANA Glazing Manual.
 1. Glazing of aluminum windows and storefront shall be done in conformance with the methods recommended by the manufacturer of the aluminum items. Beads or stops furnished with the items to be glazed shall be used to secure the glass in place.
 2. For interior hollow metal door and frame glazing, install channel glazing strips and place glass within glazing strips. Install the removable stop and position the channel glazing strip to seal completely the void around the glass.


3. Verify glass sizes for required edge clearances by measuring the openings. Cut each piece accurately and fit to its particular position. Center glass in the opening vertically and horizontally. Use edge blocks in vertical jambs to prevent lateral "walking" of the glass.
 4. Glass shall have clean cut edges. Do not seam, nip, stone or strike edges, or scarf corners, and do not install glass with flared edges at the bottom. Do not bump, drag, or rest the edge of a glass light against metal or other hard objects.
 5. Set tempered glass with tong marks completely concealed or in as inconspicuous a location as possible.
- B. Application of Window Film:
1. Refer to the applicable 3M Installation Guide for specific application instructions.
 2. Do not proceed with installation until all finishing work has been completed in and around the work area.
 3. Comply with manufacturer's application instructions applicable to products and applications indicated, except where more stringent requirements apply.
 4. Remove the film liner and wet the adhesive prior to installation.
 5. Form smooth, wrinkle-free, bubble-free surface for finished installation.
 6. Remove air bubbles, wrinkles, blisters and other defects. Use manufacturer-approved procedures to prevent the formation of air bubbles, wrinkles, blisters and other defects.
 7. Residual water may cause small water bubbles or clouding in the film that will disappear as the water evaporates.
- C. Application of Security Glazing Film (-FM):
1. General:
 - a. Retrofit existing glazing assemblies to provide impact resistance and forced/attack resistance complying with FTD-SA-C1, ANSI Z97. I and CPSC 16 CFR 1201 Category II.
 2. Examination
 - a. Field-Applied Film: Examine glass and frames to ensure that existing conditions are acceptable for proper application and performance of security glazing film.
 - 1) Confirm that substrate to receive security glazing film is glass, and that glass is not cracked, chipped, broken, or damaged.
 - 2) Verify that frames are securely anchored and free of defects.
 3. Preparation
 - a. Clean glass of dust, dirt, paint, oil, grease, mildew, mold, and other contaminants that would inhibit adhesion.
 - b. Immediately prior to applying security glazing film, thoroughly wash glass with neutral cleaning solution.
 - c. Protect adjacent surfaces.
 - d. Do not begin installation until substrates have been properly prepared.
 - e. Commencement of application of security glazing film specified in this section constitutes acceptance of conditions and substrates to which security glazing film will be applied.
 4. Installation
 - a. Install in accordance with manufacturer's instructions, without air bubbles, wrinkles, streaks, bands, thin spots, pinholes, or gaps, as required to achieve specified performance.
 - b. Seams. Seam film only as required to accommodate material sizes; seam without overlaps. Bring to the attention of the architect and owner prior to proceeding where seams are required.
 - c. Apply bead of structural sealant overlapping 3/4 inch of the exposed edge of security glazing film and overlapping 3/4 inch of glazing system frame. Allow to cure.
 - d. Install mechanical anchoring system where recommended by security glazing film manufacturer.
 - e. Clean glass and excess structural sealants from finished surfaces
 - f. Remove any labels or protective covers.
 5. Film Verification
 - a. Awarded contractor will be required to verify that installed security glazing film meets the requirements highlighted in this bid. By submitting a bid, Contractor understands that three pieces of glass, chosen at random will be removed and film applied will be measured to verify that film installed meets specifications as requested. Film may need to be removed as part of the verification process.
- D. Glass Mirrors:
1. Apply one additional coat of moisture-resistant paint, type recommended by manufacturer, to back of mirror.
 2. Allow to dry.
 3. Apply safety tape to back of mirror in strips leaving 25% of surface free for application of mastic.
 4. Apply mirror mastic to cover not more than 25% of back mirror, 1/8" to 1/2" thickness of setting bed.
 5. Set mirror on concealed shelf angle.
 6. Press mirror against substrate to bond.
 7. Leave open ventilation space, 1/8" minimum between mirror and substrate.
 8. Do not seal off ventilation space at edge of mirror.

3.3 CLEANING


- A. Upon completion of glazing, clean glass on both sides and remove labels and other defacement. Replace damaged glass with new.

- B. Applied Window Film:
 - 1. Use cleaning methods recommended by window film manufacturer for applicable environment.
 - 2. Protect completed glass finish during remainder of construction period.


END OF SECTION

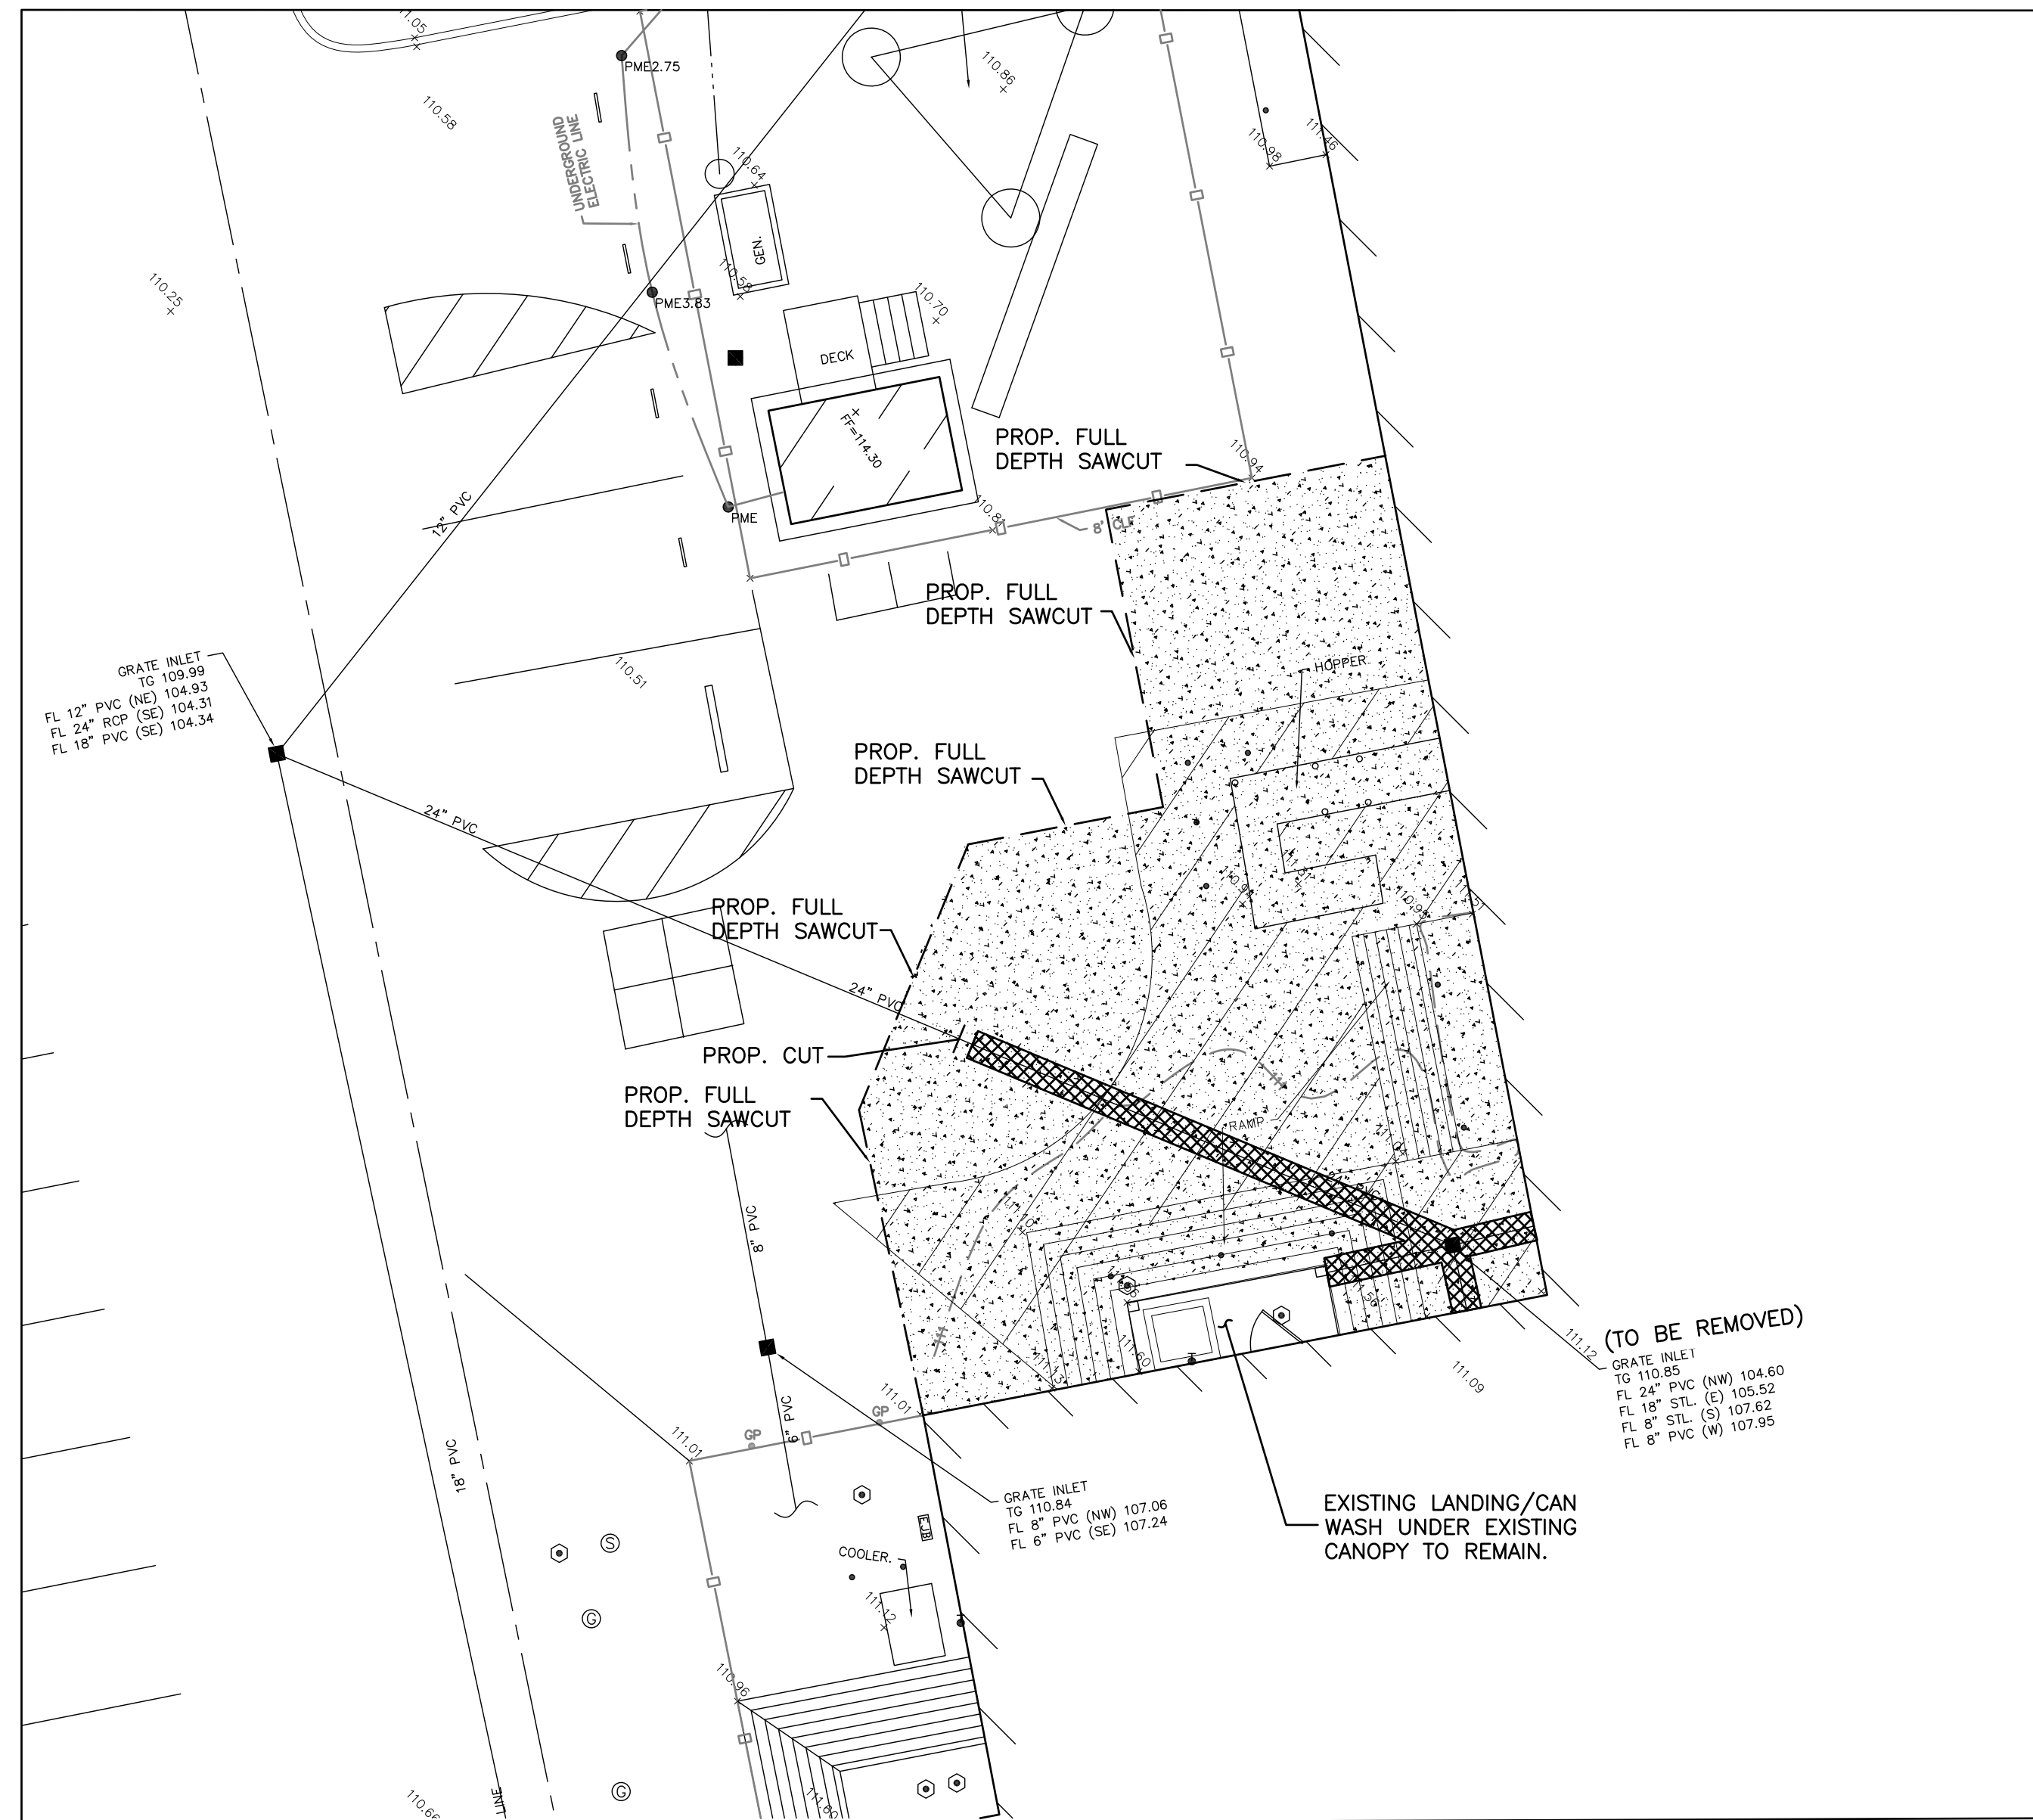


SHOP ADDITION

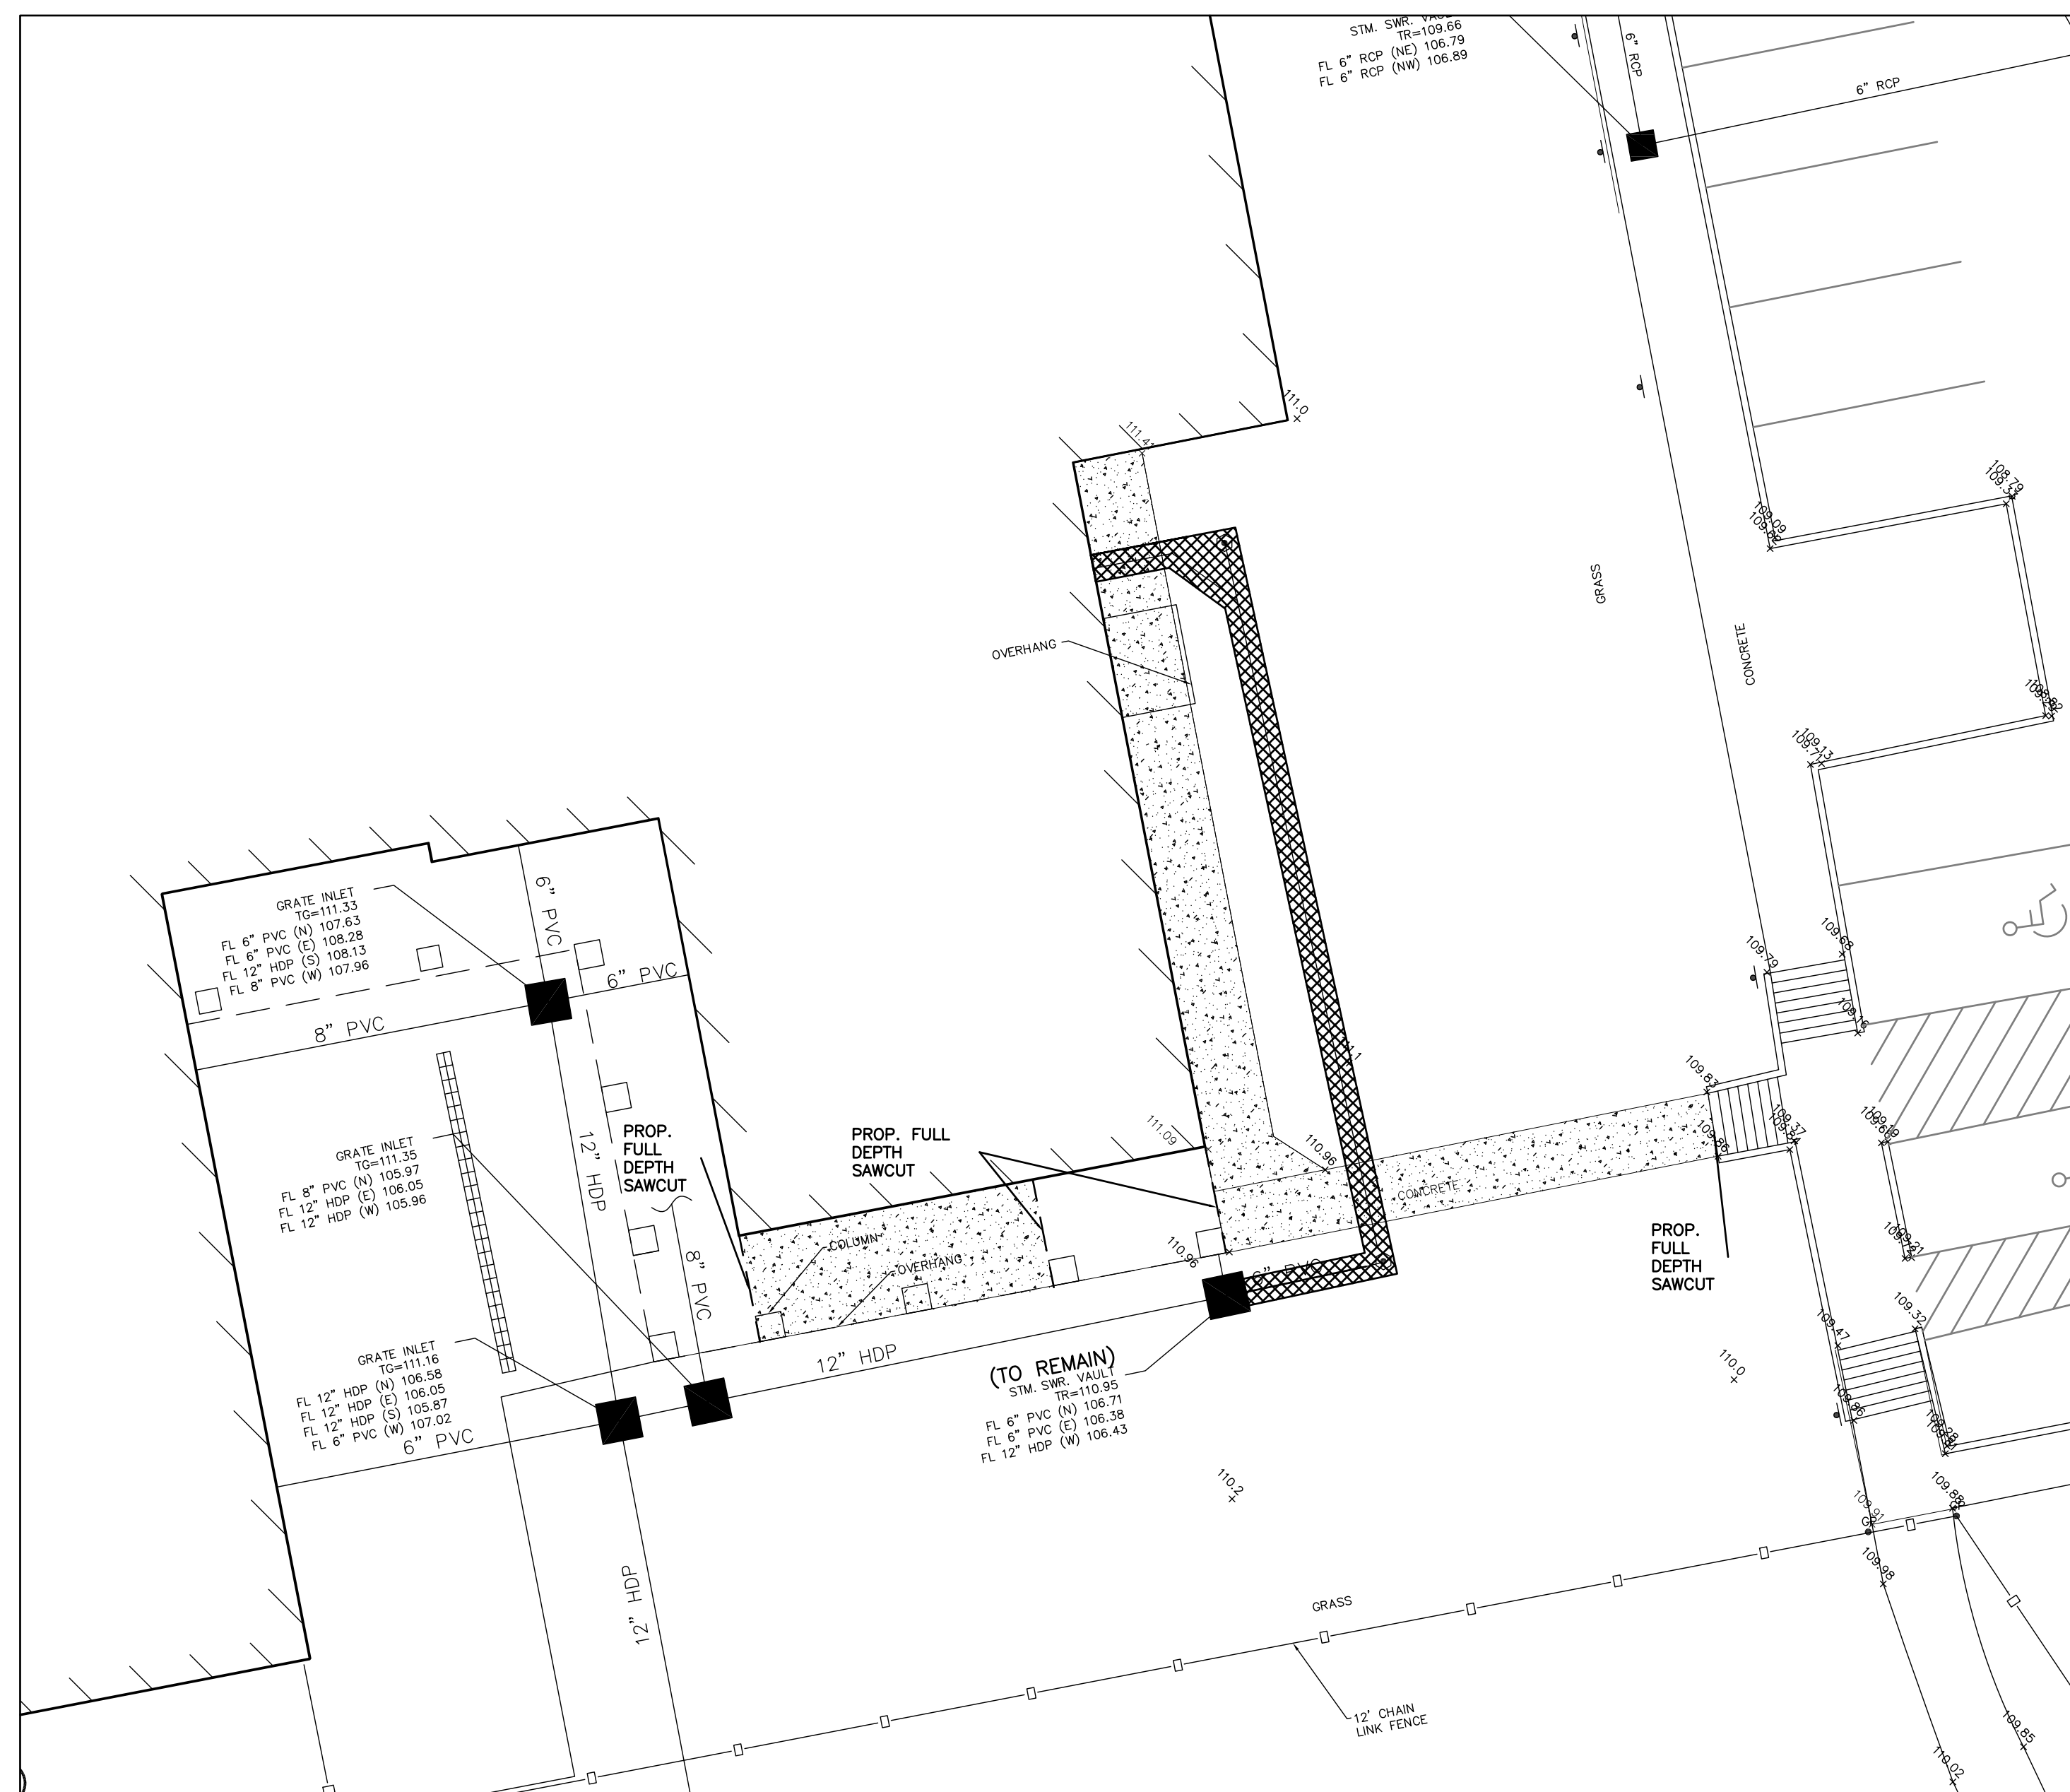


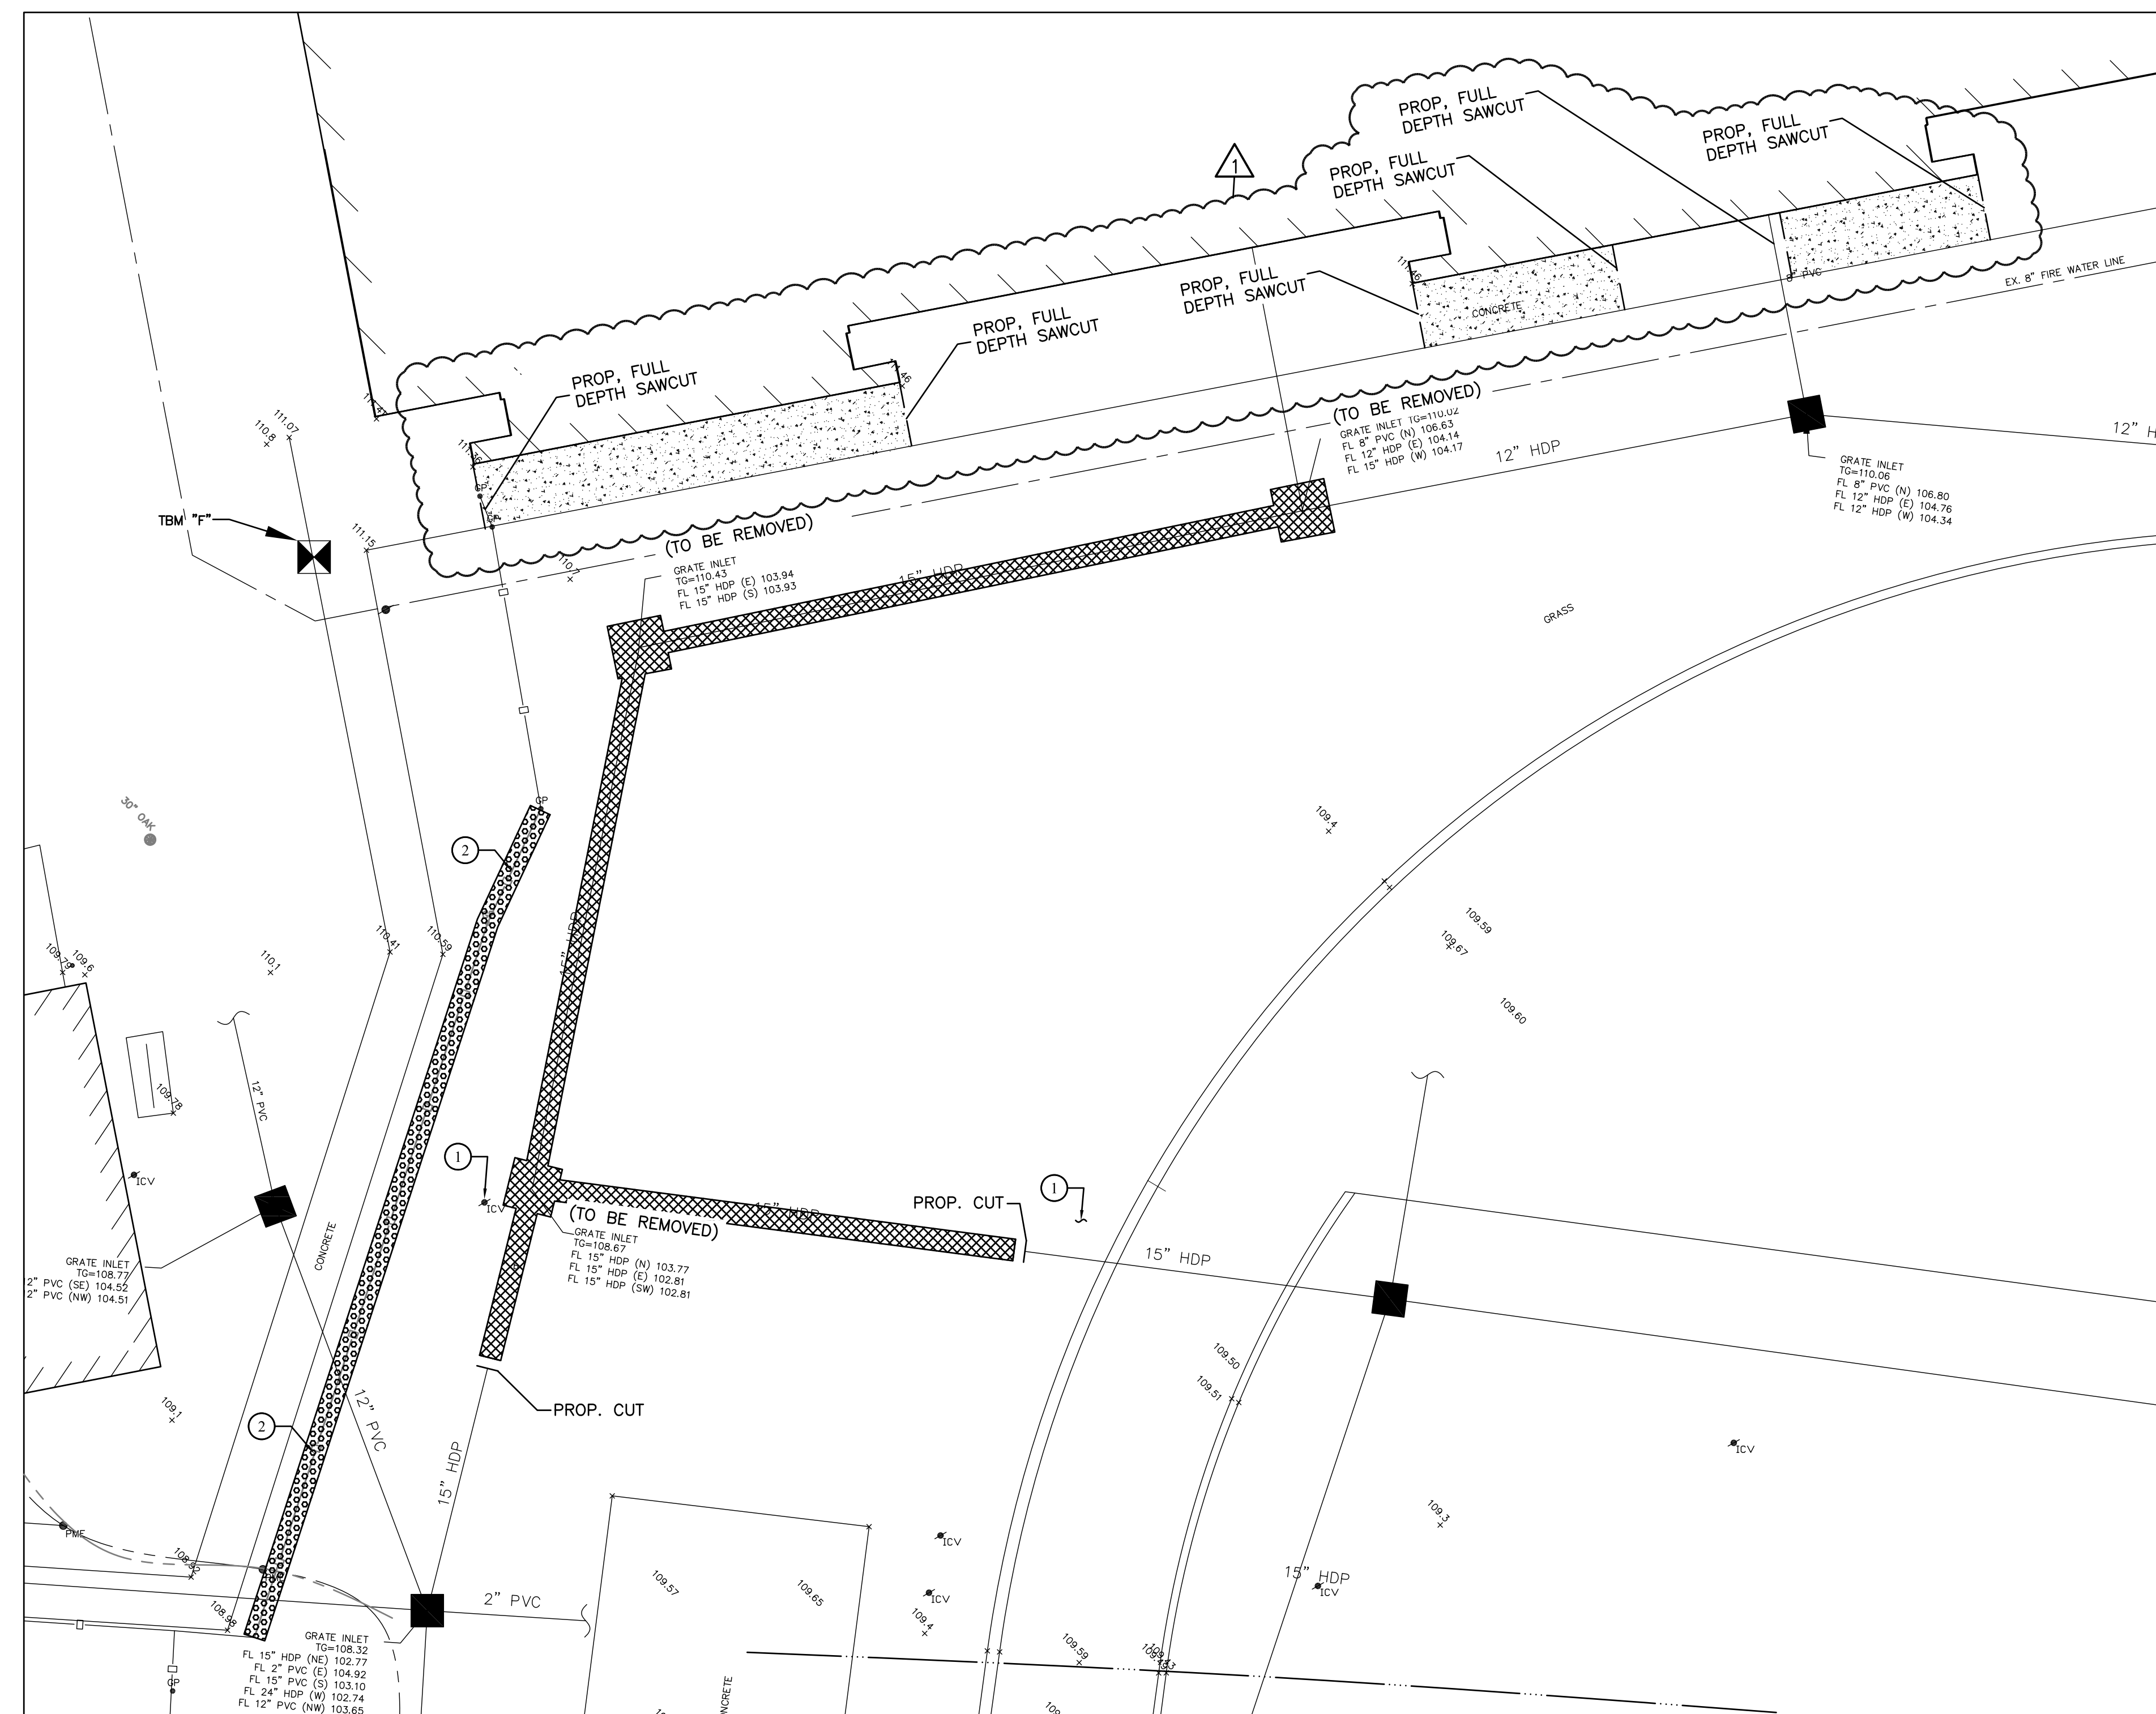


ORCHESTRA ADDITION

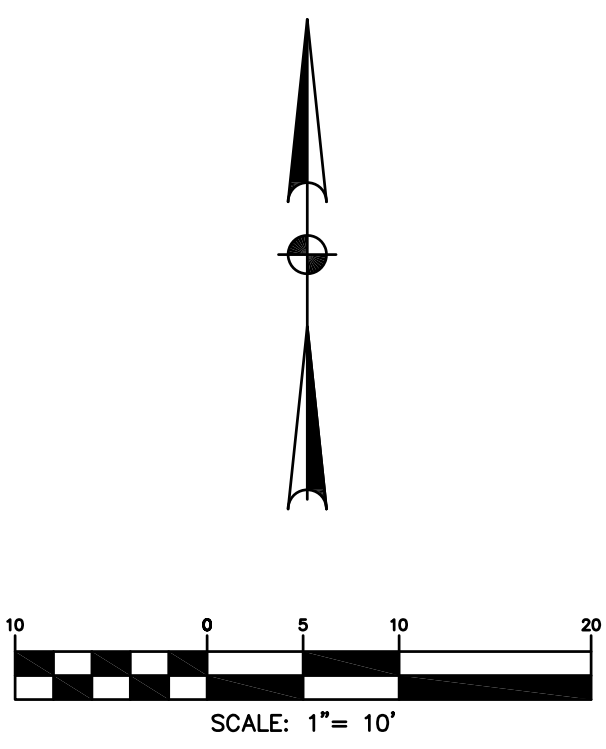

ATHLETIC STORAGE BUILDING ADDITION

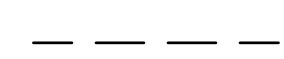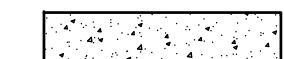

LEGEND:

-  PROP. FULL DEPTH SAWCUT
-  EXISTING CONCRETE PAVEMENT, CURB, SIDEWALK AND SLAB TO BE REMOVED.
-  EXISTING UTILITIES TO BE REMOVED.
-  EXISTING MISCELLANEOUS EQUIPMENT/FENCING TO BE REMOVED.

KEY NOTES:

- 1 CONTRACTOR TO REFER TO IRRIGATION CONSULTANT PLANS FOR REMOVAL AND REPLACEMENT OF EXISTING IRRIGATION WATER LINES, HEADS, AND ASSOCIATED CONTROL WIRING.
- 2 EXISTING FENCE TO BE REMOVED. CONTRACTOR TO REFER TO ARCHITECTURAL PLANS FOR FENCE REPLACEMENT AND FENCE DETAILS



VLK Architects
 20445 State Hwy 249, Suite 350
 Houston, Texas 77070
 Main Phone: 281.671.2300
 www.vlkarchitects.com

Brooks & Sparks, Inc.
 21020 Park Row Dr.
 Katy, Texas 77449
 Main Phone: 281.578.9595
 www.brooksandsparks.com

Issue for Proposal



ISSUED: February 24, 2025

Revision No.
 1 Addendum#1 03-08-25

Director Drawn By
 DIR Quality Control
 Designer DSN QC
 Proj. Arch. PA

2901.00


DEMOLITION PLAN

C11.03

CYPRESS-FAIRBANKS INDEPENDENT SCHOOL DISTRICT HOUSTON, TEXAS

2024 Cook, Labay & Truitt MS Renovations

06 Mar 2025 7:46AM Greg
 F:\project\BROOK_SPA\VLK\B550053 Cook Middle School\C11.03 8550053 DEM.dwg
 Includes Xref(s): X-Topo.dwg; X-CR.dwg; X-TB.dwg; X-Util.dwg; EM092324.dwg; X-Seal.dwg; X-Site.dwg

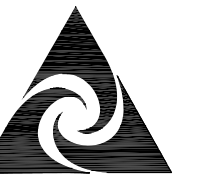

VLK ARCHITECTS


VLK Architects
20445 State Hwy 249, Suite 350
Houston, Texas 77070
Main Phone: 281.671.2300
www.vlkarchitects.com

Brooks & Sparks, Inc.
21020 Park Row Dr.
Katy, Texas 77449
Main Phone: 281.578.9595
www.brooksandsparks.com

CYPRESS-FAIRBANKS INDEPENDENT SCHOOL DISTRICT
HOUSTON, TEXAS

2024 Cook, Labay & Truitt MS Renovations

Issue for Proposal

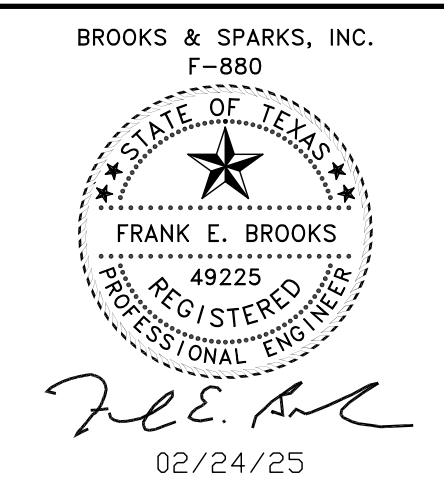

ISSUED: February 24, 2025

Revision No.
1 Addendum#1 03-06-25



Director DIR
Designer DSN
Proj. Arch. PA

Drawn By
Quality Control QC

2901.00

GRADING PLAN
(SHEET 1 OF 3)

C12.01

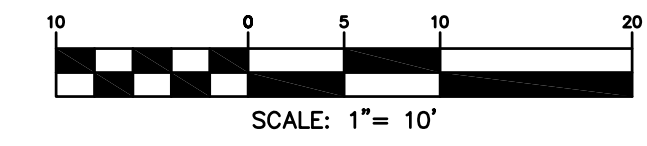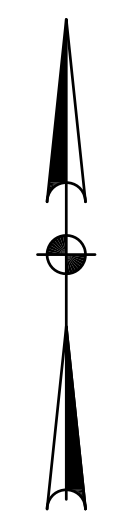


LEGEND:


- PROPOSED GRATE/CURB INLET
- PROPOSED STORM SEWER MANHOLE WITH GRATE TOP
- Tc[150.20] PROPOSED TOP OF CURB ELEV.
- Tp[150.20] PROPOSED TOP OF PAVEMENT ELEV.
- Tw[153.00] PROPOSED TOP OF WALK ELEV.
- F[149.50] PROPOSED FLOWLINE ELEV.
- Fg[149.50] PROPOSED FINISHED GRADE ELEV.
- Tg[149.60] PROPOSED TOP OF GRATE ELEV.
- [150.00] PROPOSED CONTOUR
- [M.E.C.] MATCH EXIST. CURB & GUTTER
- [M.E.P.] MATCH EXIST. PAVEMENT
- [M.E.W.] MATCH EXIST. WALK
- DIRECTION OF FLOW
- [Dotted Pattern] PROPOSED LIMITS OF SOLID SOD ON 2" OF TOPSOIL
- [Stippled Pattern] PROPOSED LIMITS OF HYDRO-MULCH ON 4" TOP SOIL. (CONTRACTOR RESPONSIBLE TO IRRIGATE, FERTILIZE, MOW, AND WEED UNTIL 85% OF GRASS IS ESTABLISHED AND BEFORE FINAL ACCEPTANCE).

KEY NOTES:


- 1 CONTRACTOR TO ADJUST EXISTING CLEAN-OUT TOP TO MATCH FINISHED GRADE ELEVATION.
- 2 CONTRACTOR TO SLOPE PROPOSED CONCRETE CURB DOWN WITH PROPOSED RAMP.
- 3 PROPOSED BOLLARD (SEE SHEET C17.00 FOR DETAILS).

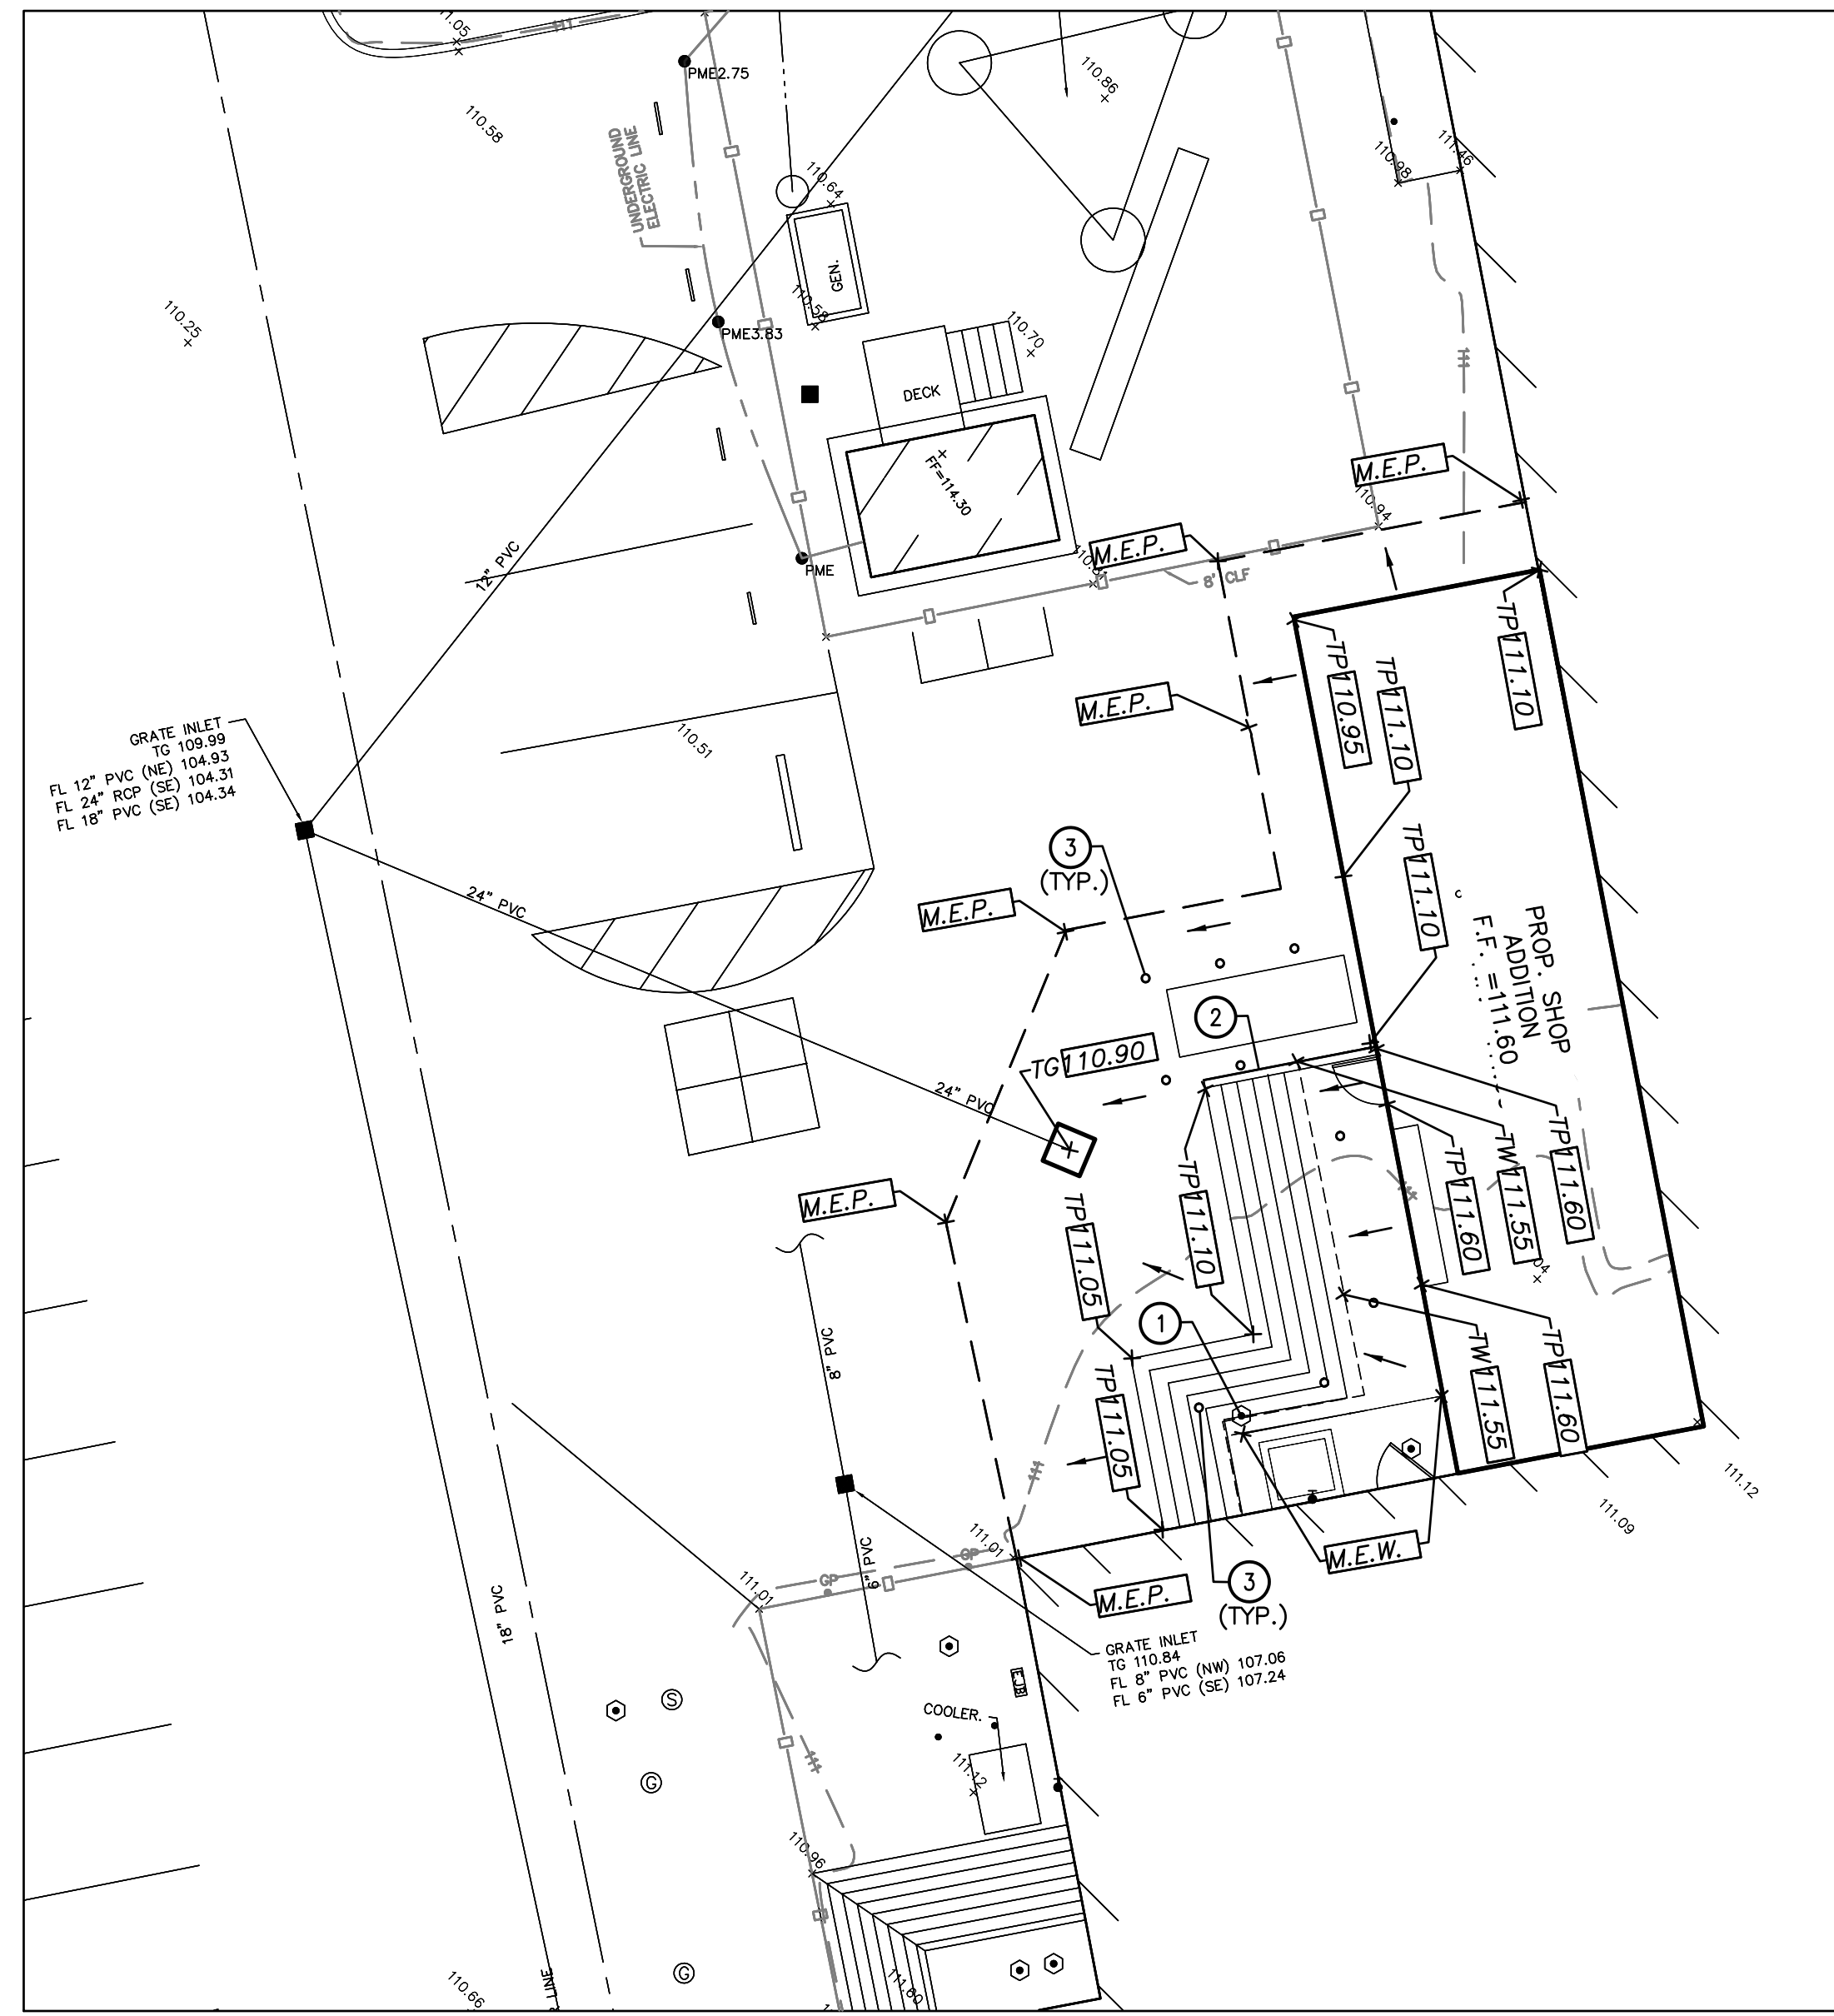

SHOP ADDITION

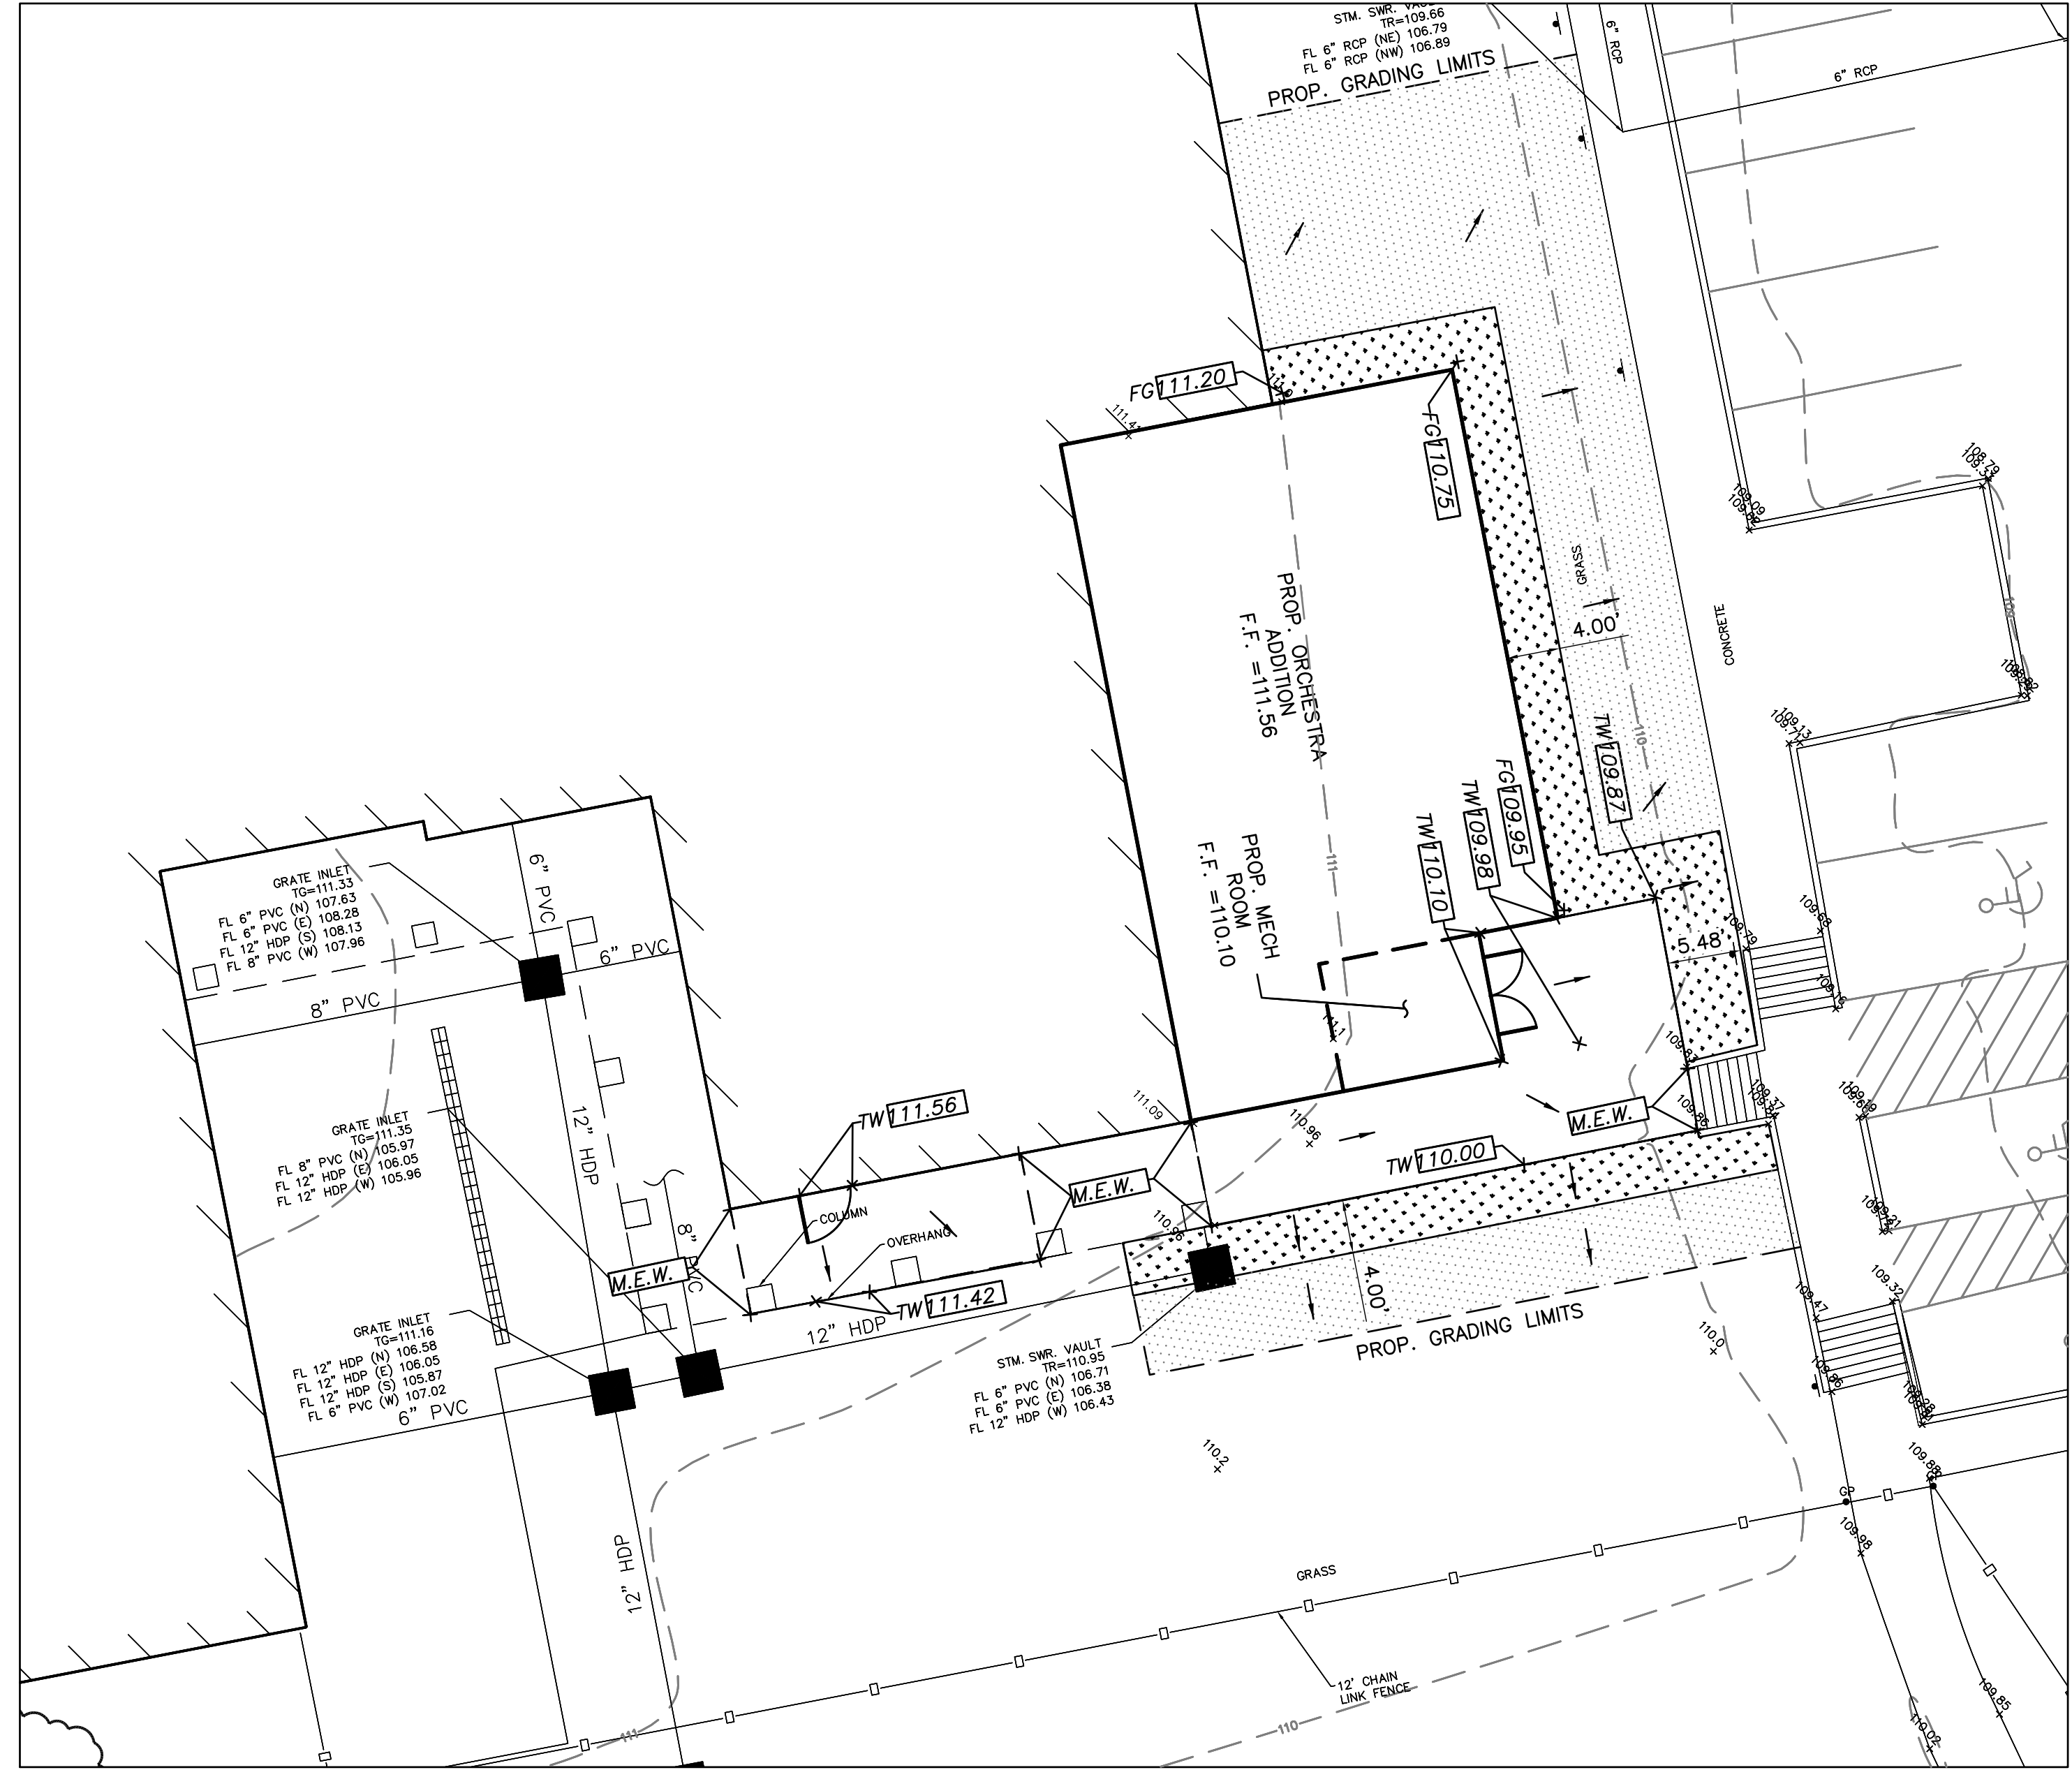


ORCHESTRA ADDITION

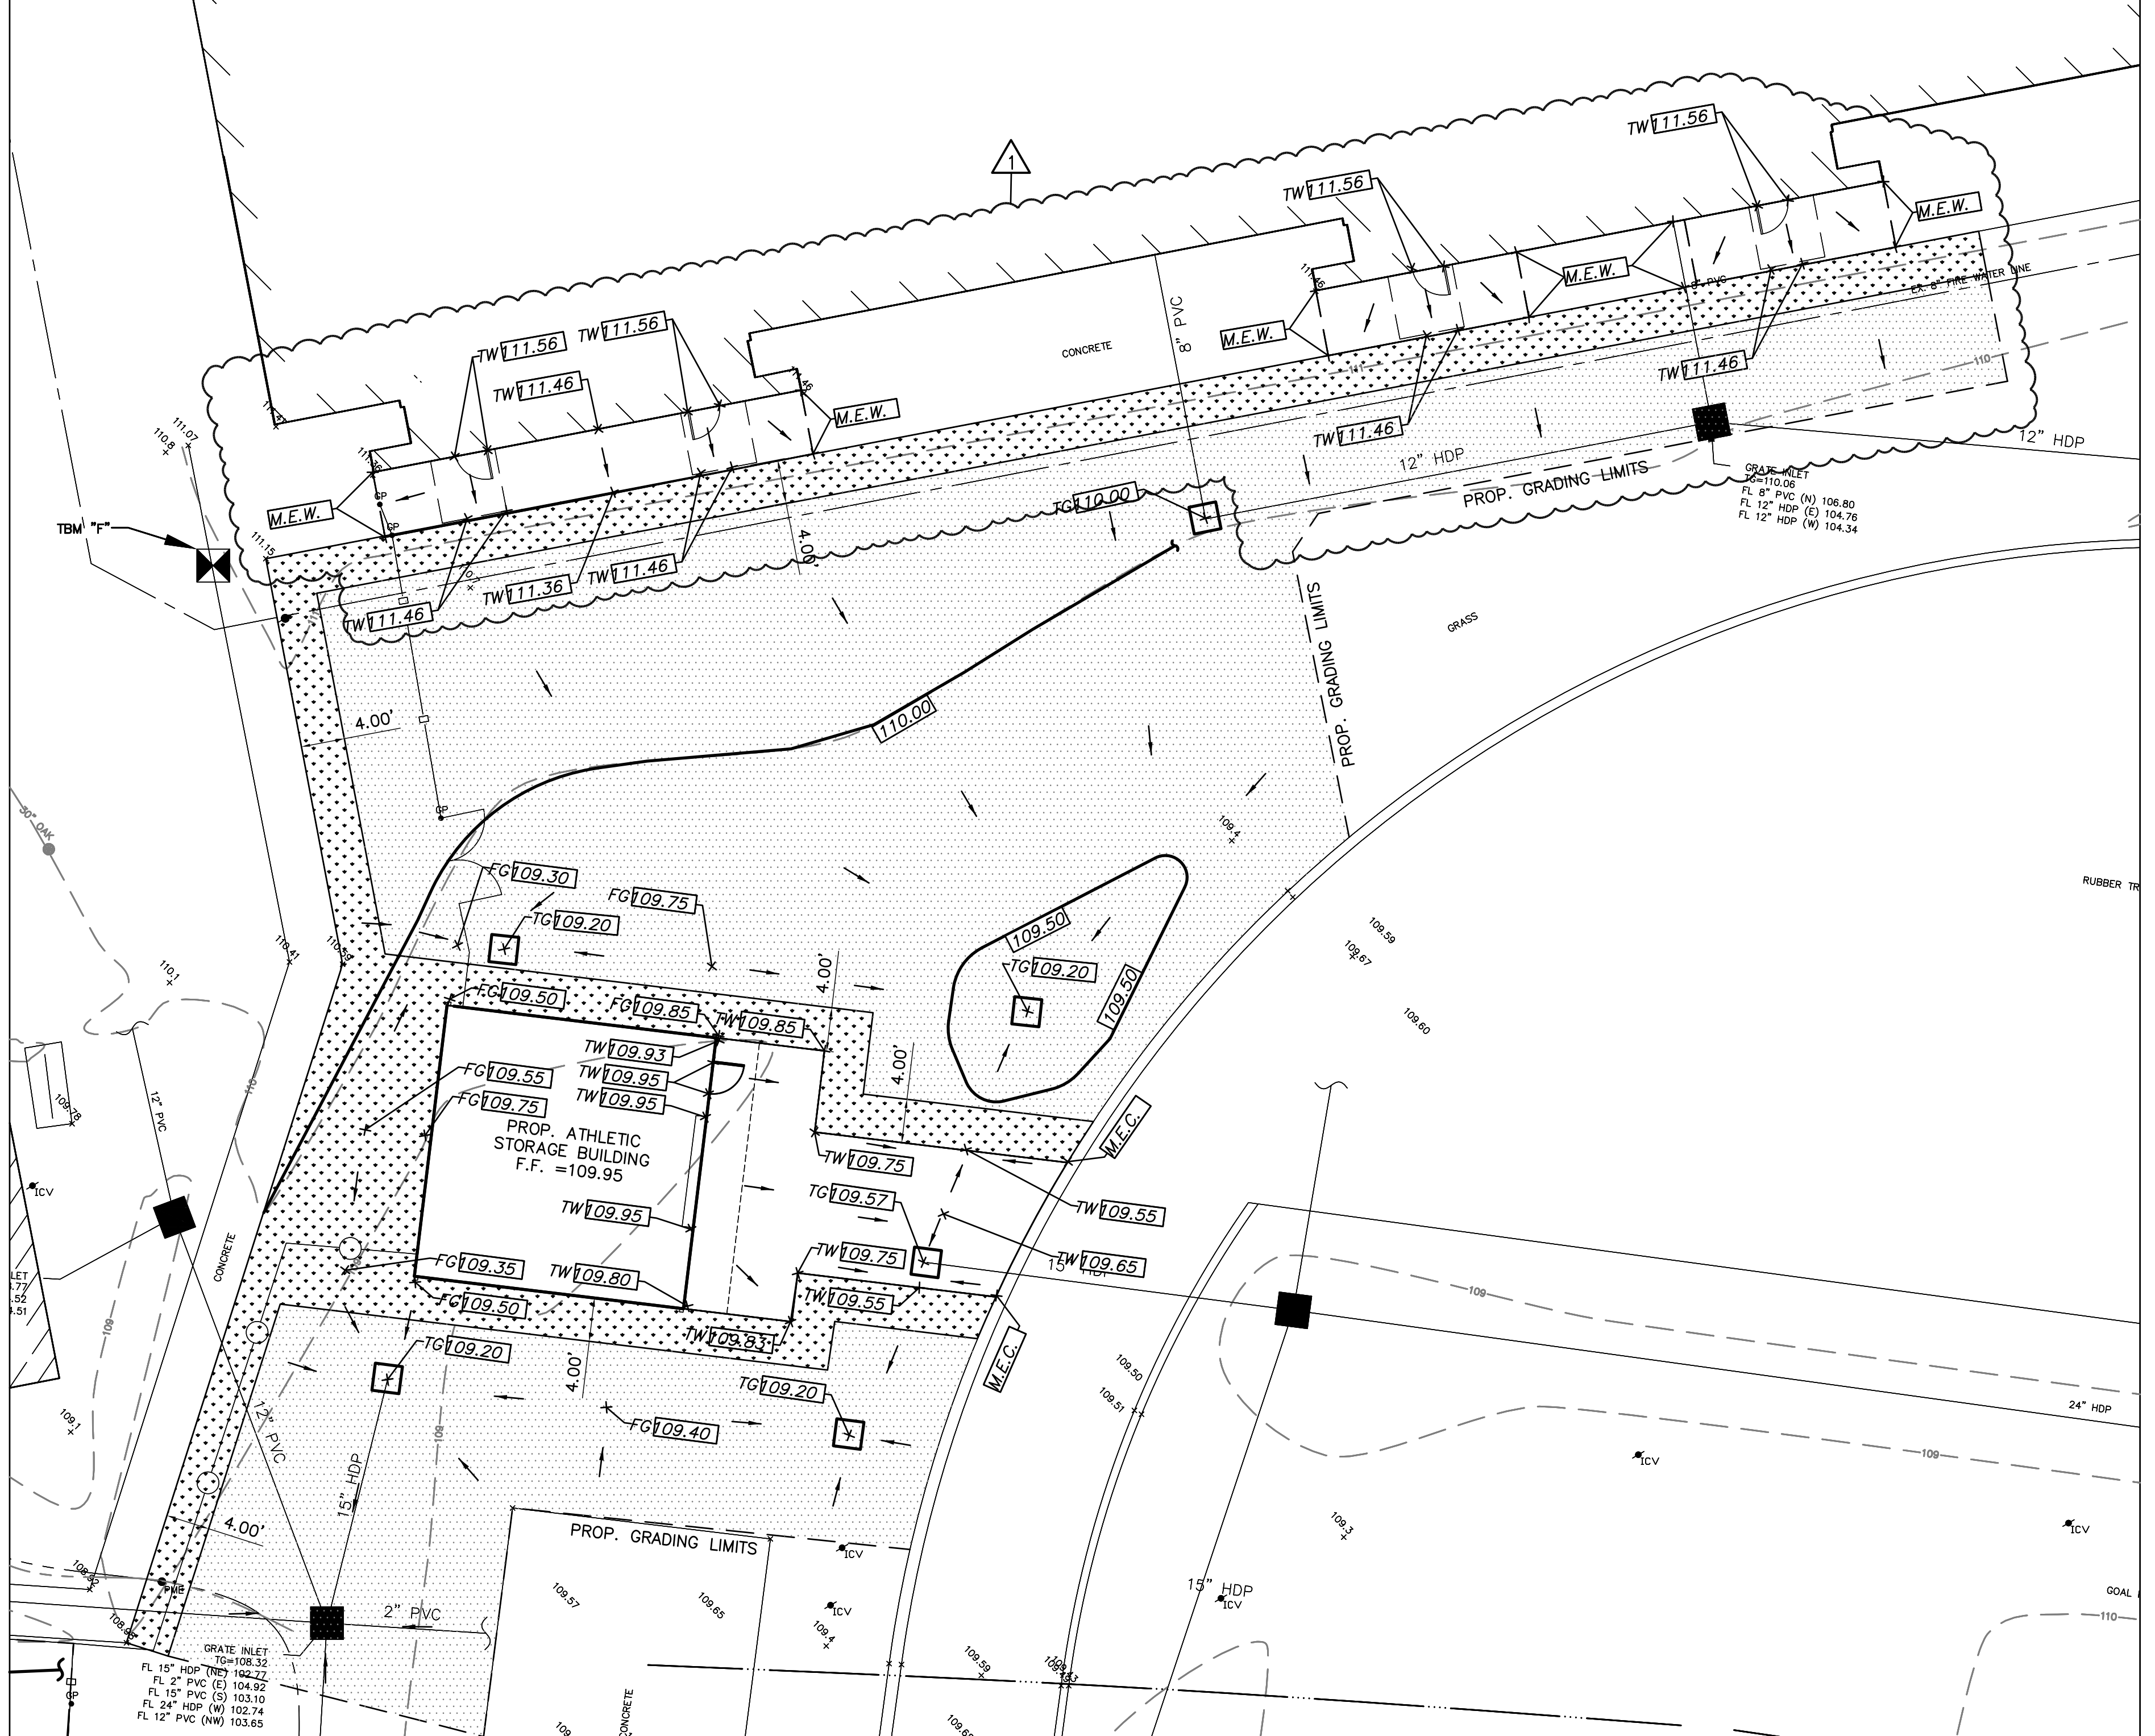


ATHLETIC STORAGE BUILDING ADDITION


06 Mar 2025 8:23AM Greg
F:\projects\BROOK_SPA\VLK\8550053 Cook Middle School\C12.01 8550053 Grading Plan 1.dwg
Includes Xref(s): X-Topo.dwg; X-Site.dwg; X-GR.dwg; X-Util.dwg; EMO92324.dwg; X-Seal.dwg

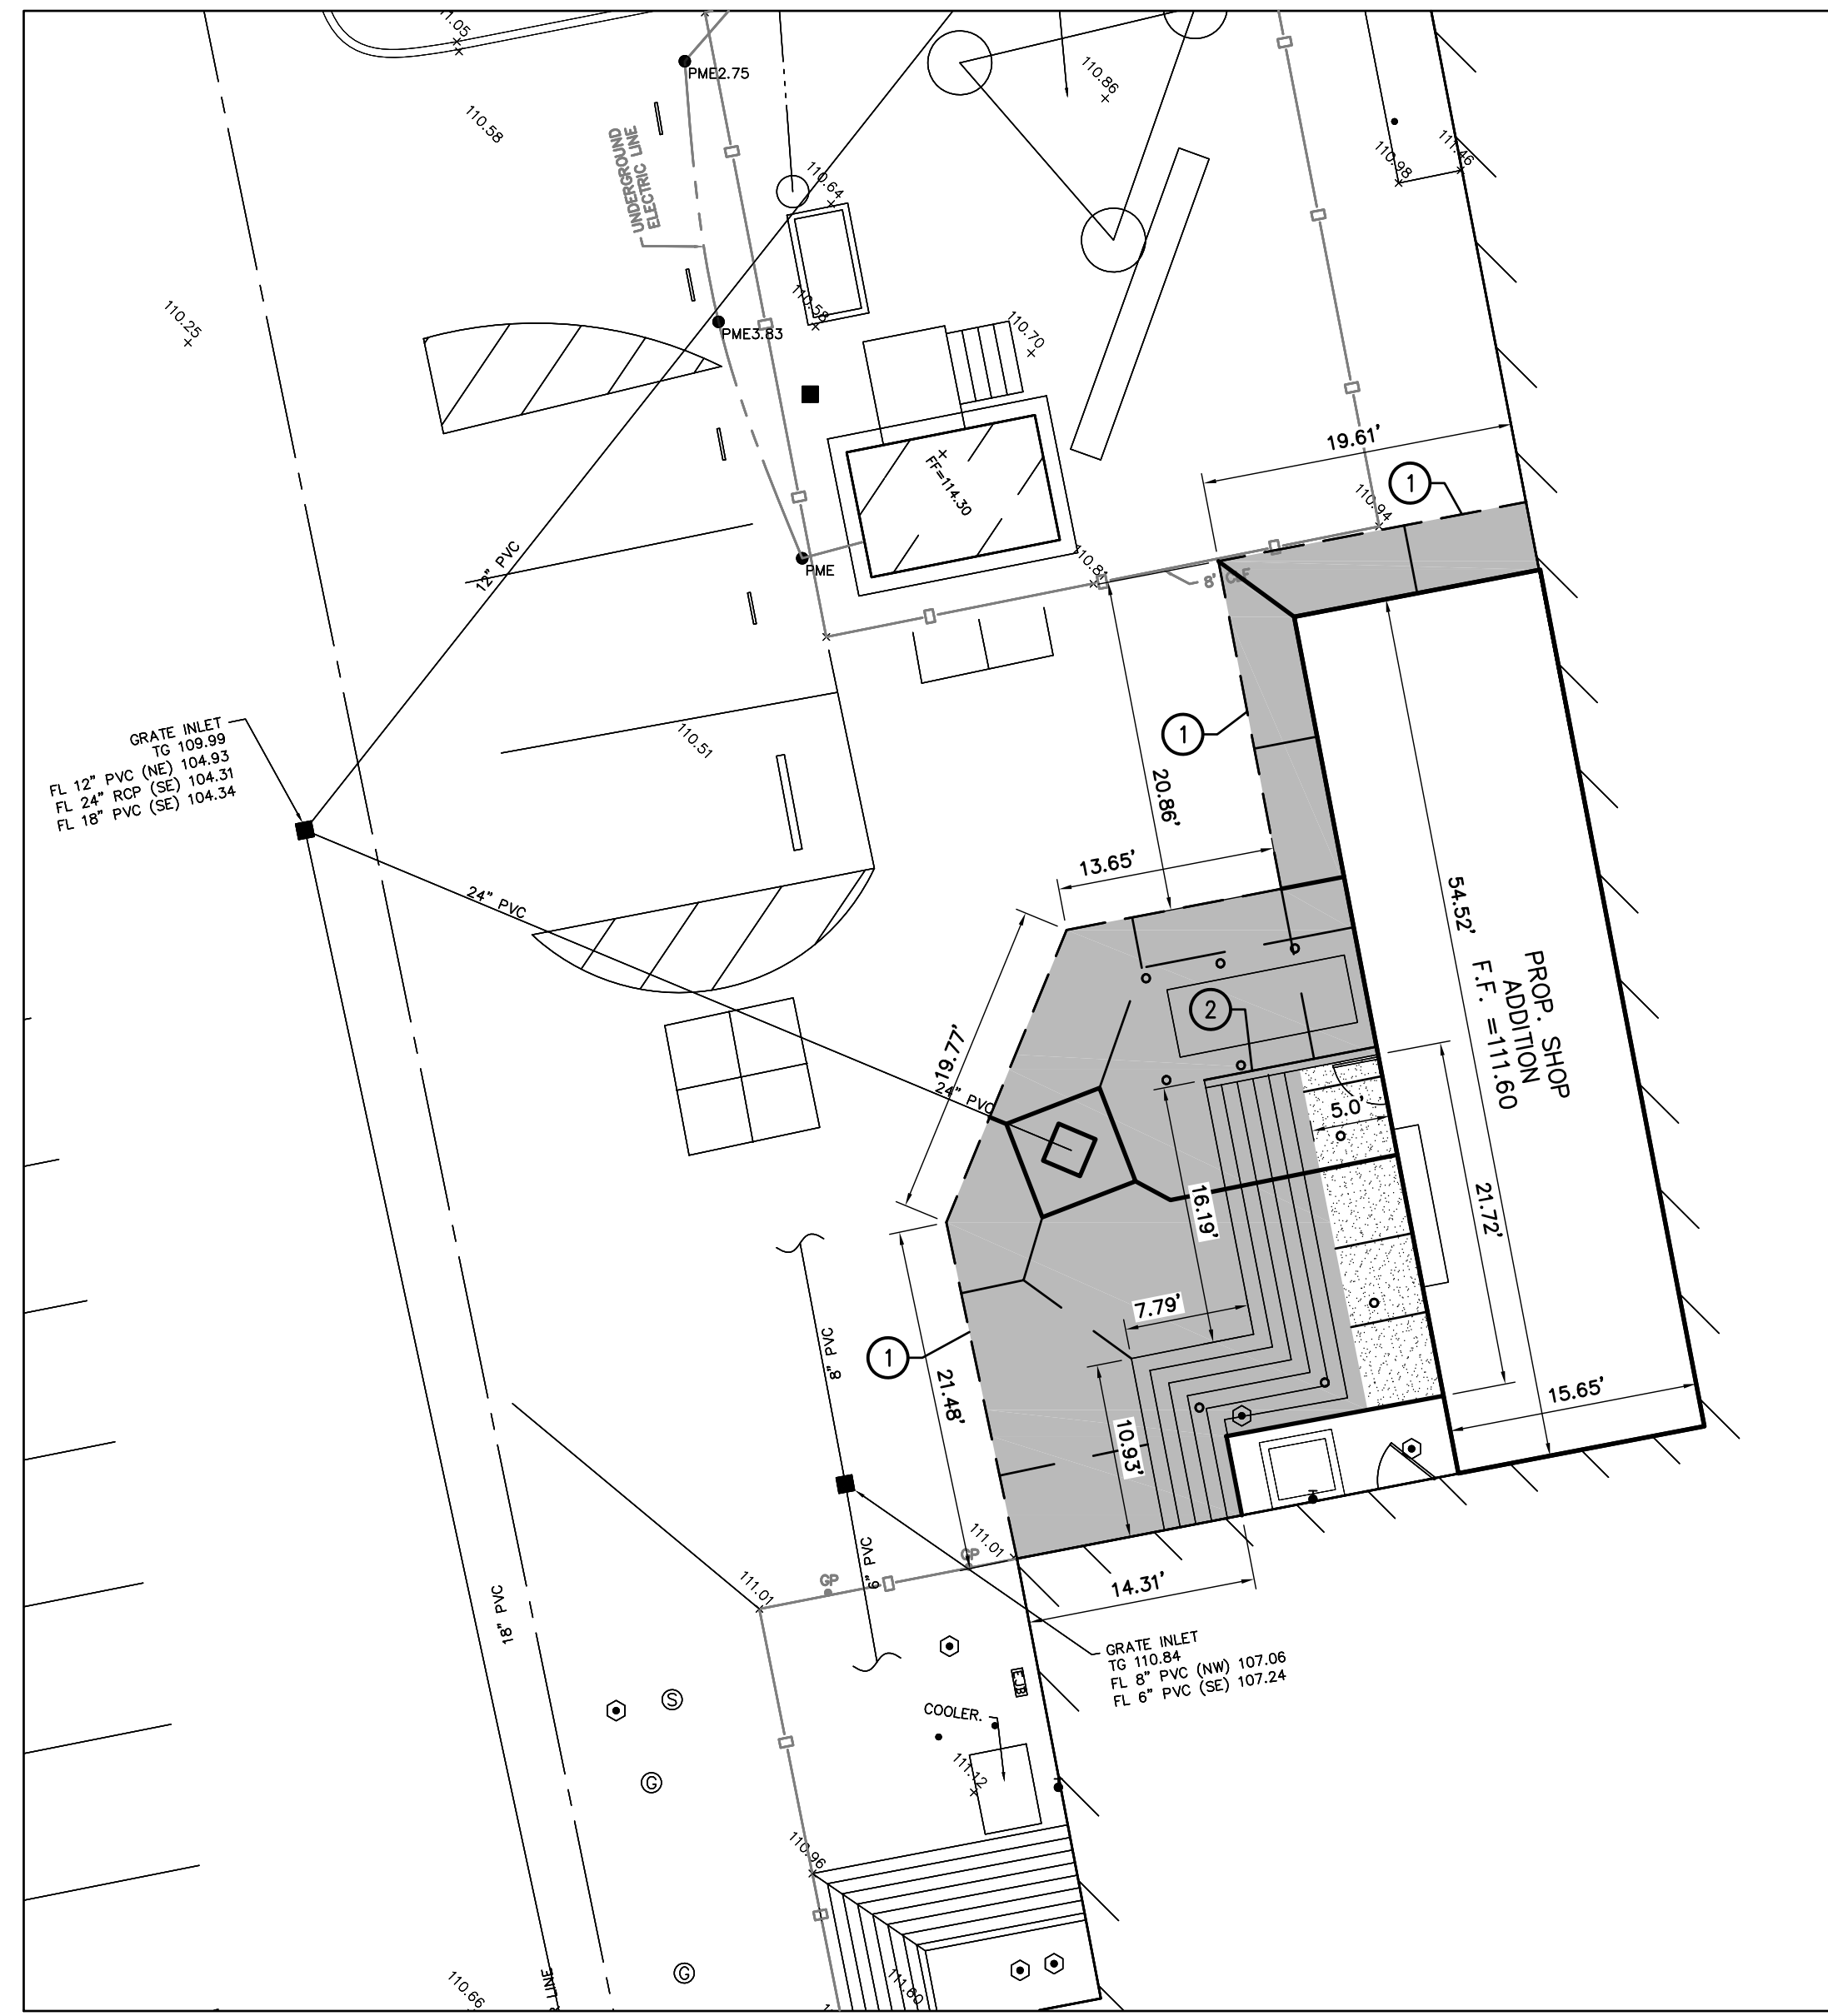

SHOP ADDITION

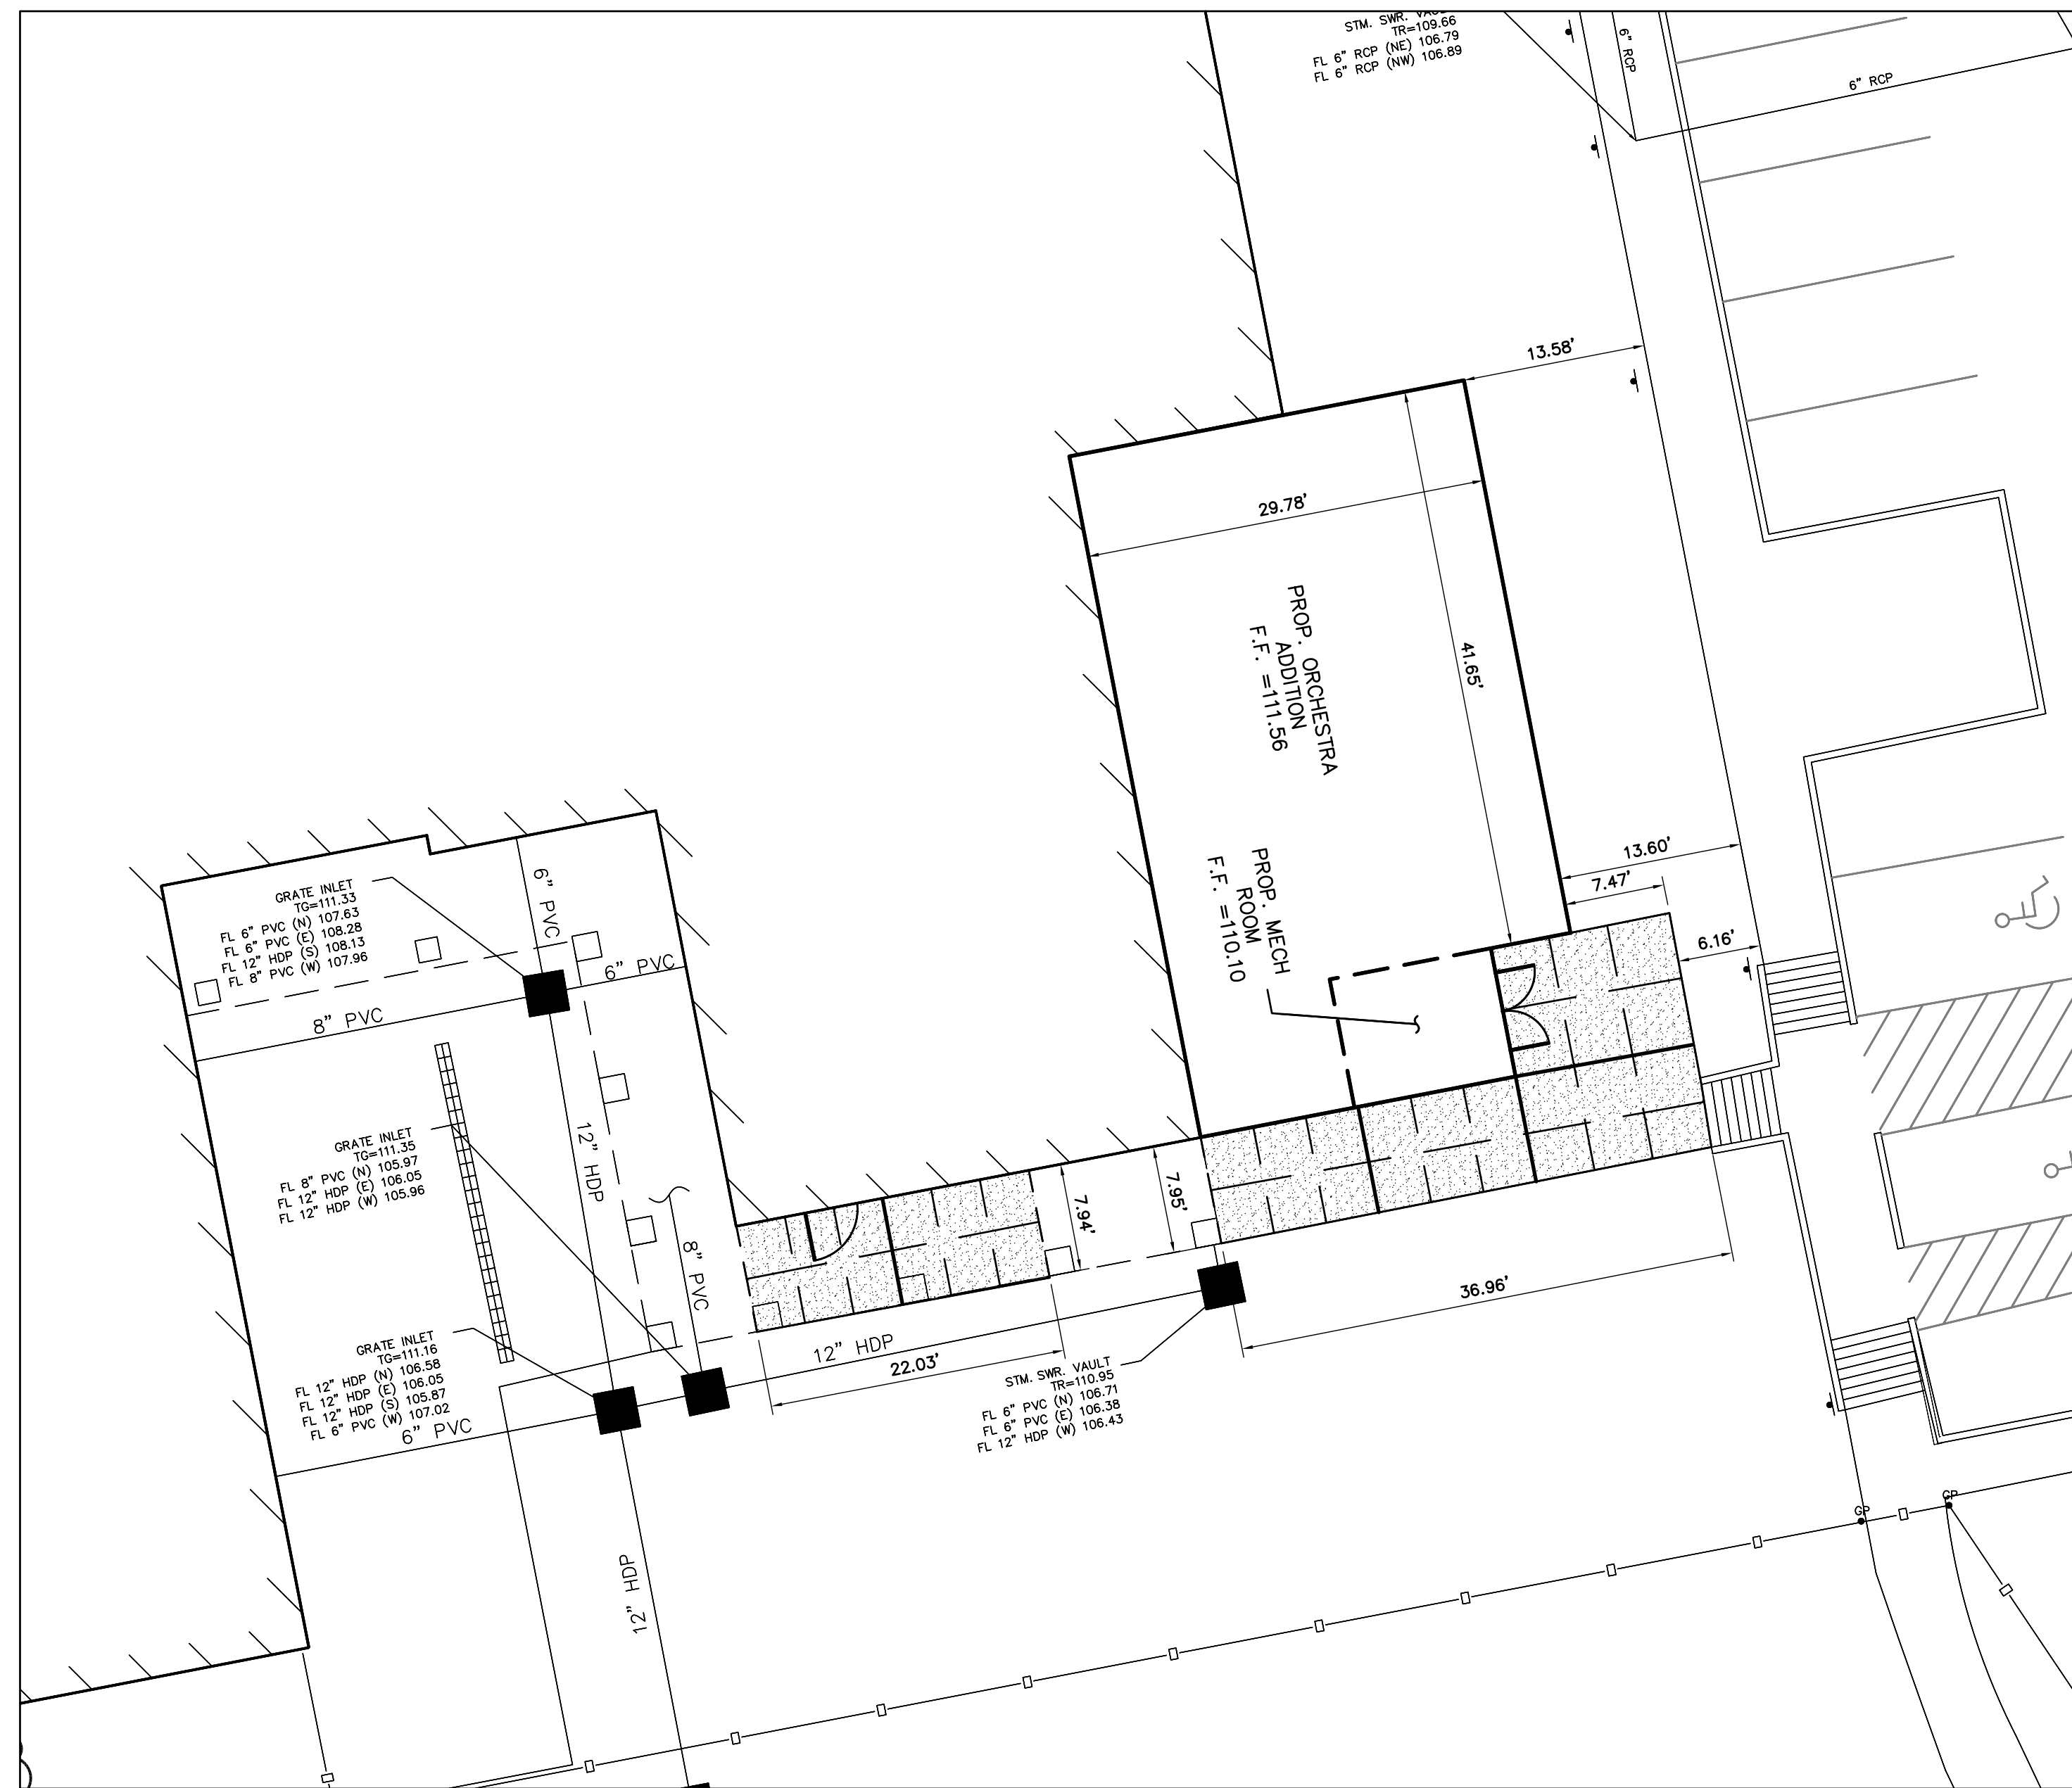

ORCHESTRA ADDITION

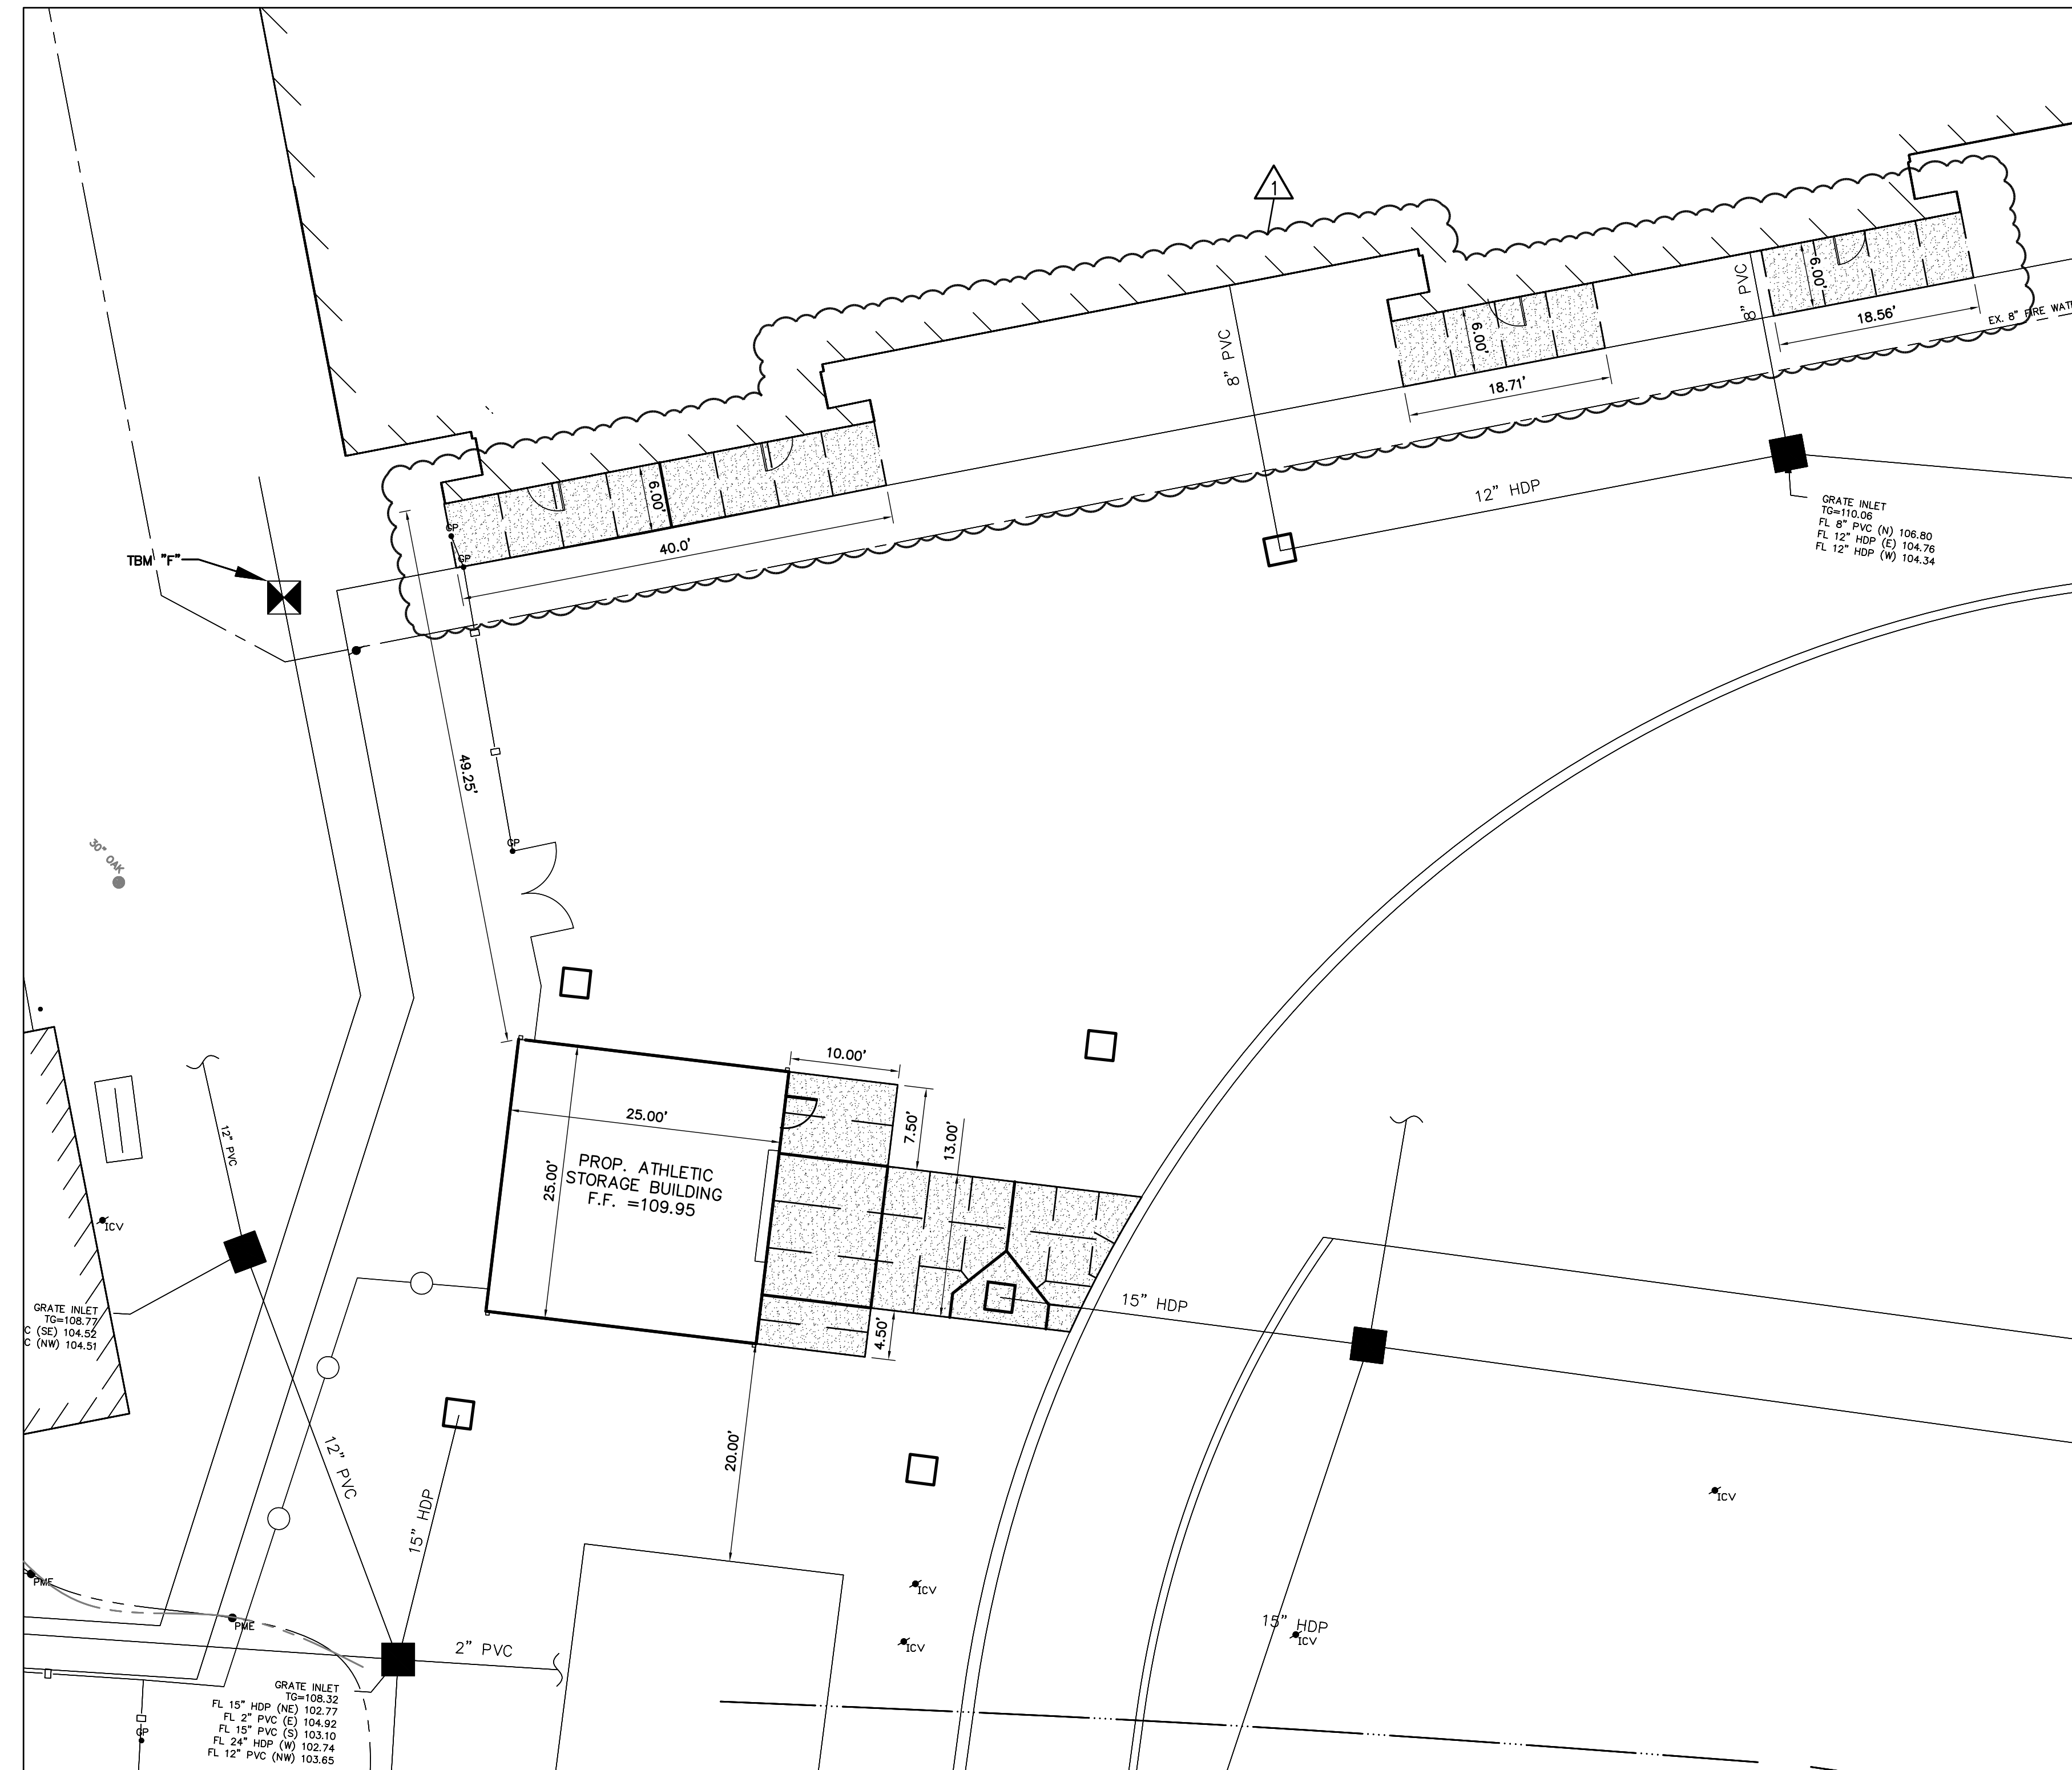

ATHLETIC STORAGE BUILDING ADDITION

KEY NOTES:


- ① CONTRACTOR TO DRILL 9" INTO EXISTING CONCRETE AND EMBED 18" LONG #5 BAR @ 18" (EPOXIED IN PLACE) LEAVING 9" OF EXPOSED #5 BAR TO FACILITATE THE CONNECTION TO NEW PAVEMENT.
- ② CONTRACTOR TO TRANSITION PROPOSED CONCRETE CURB TO MATCH SLOPE OF PROPOSED RAMP DOWN TO PROPOSED PAVEMENT ELEVATION.

LEGEND:

- SAWED JOINT
- EXPANSION JOINT
- 7" REINFORCED CONCRETE PAVEMENT
- 4 1/2" REINFORCED CONCRETE SIDEWALK PAVEMENT

NOTES:

- 1. LOCATE EXPANSION JOINTS AS SHOWN. SAWED JOINTS SHALL BE SPACED EVENLY BETWEEN EXPANSION JOINTS AT 15' MAXIMUM SPACING.
- 2. ALL CURBS TO BE 6" UNLESS OTHERWISE NOTED.
- 3. LINE UP JOINTS IN SIDEWALK W/ JOINTS IN PARKING LOT.
- 4. INSTALL EXPANSION JOINTS IN ALL DRIVEWAYS AT ROW LINE.
- 5. SEE ARCHITECT'S PLANS FOR WHEELSTOP LOCATIONS AND SIDEWALK JOINTING.

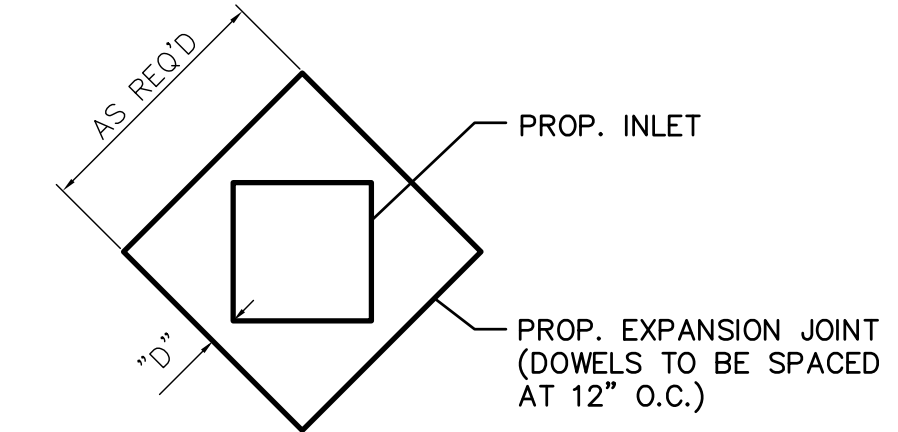


D = 24" FOR MANHOLES & GRATE INLETS
D = 12" FOR AREA INLETS & AREA DRAINS

**STORM SEWER INLET
W/ EXPANSION JOINT**
N.T.S.

VLK Architects
20445 State Hwy 249, Suite 350
Houston, Texas 77070
Main Phone: 281.671.2300
www.vlkarchitects.com

Brooks & Sparks, Inc.
21020 Park Row Dr.
Katy, Texas 77449
Main Phone: 281.578.9595
www.brooksandsparks.com

Issue for Proposal

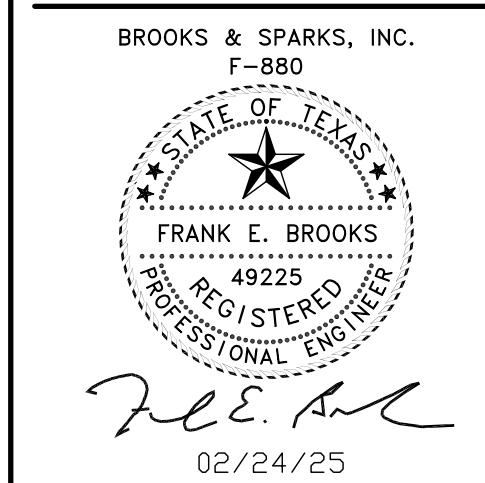

ISSUED: February 24, 2025

Revision No.
1 Addendum#1 03-06-25

Director DIR
Designer DSN
Proj. Arch. PA

Drawn By
Quality Control QC

2901.00


PAVING AND JOINTING PLAN

C15.01

2024 Cook, Labay & Truitt MS Renovations

CYPRESS-FAIRBANKS INDEPENDENT SCHOOL DISTRICT HOUSTON, TEXAS


06 Mar 2025 8:51AM GregL
F:\projects\BROOK_SPA\VLK\B550053 Cook Middle School\Civil\C15.01 B550053 JT.dwg
Includes Xref(s): X-Topo.dwg; X-Site.dwg; X-TB.dwg; X-UTI.dwg; EM092324.dwg; X-Seal.dwg

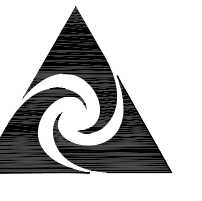

VLK ARCHITECTS

VLK Architects
20445 State Hwy 249, Suite 350
Houston, Texas 77070
Main Phone: 281.671.2300
www.vlkarchitects.com

Brooks & Sparks, Inc.
21020 Park Row Dr.
Katy, Texas 77449
Main Phone: 281.578.9595
www.brooksandsparks.com

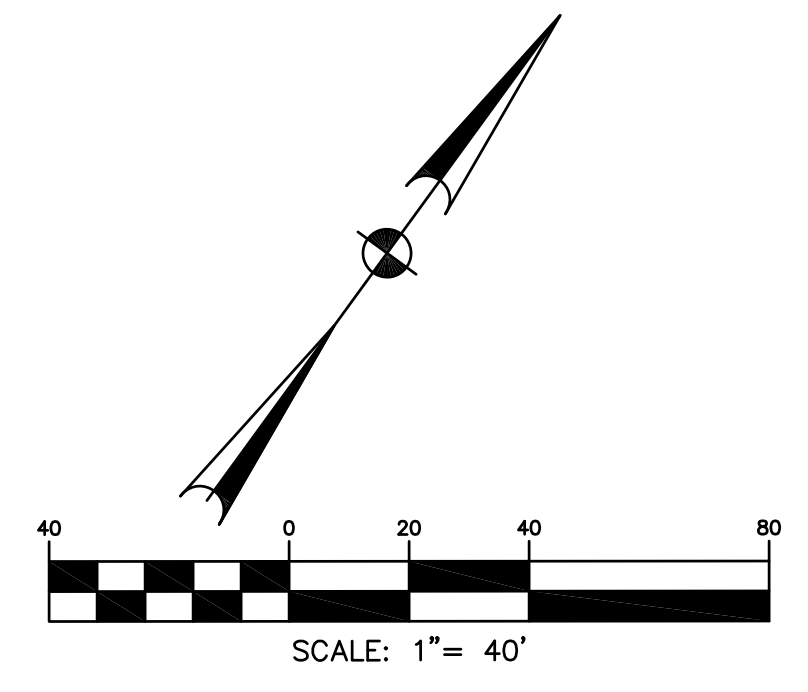


FLOODPLAIN:
ACCORDING TO F.I.R.M. MAP NO. 48201C0420P (COMMUNITY-PANEL NO. 4802870420P), MAP REVISED DATE: NOVEMBER 15, 2019. THE SUBJECT PROPERTY LIES WITHIN THE AREAS DESIGNATED AS ZONE "X" UNSHADED. DETERMINED TO BE OUTSIDE THE 0.2% ANNUAL CHANCE FLOOD. ZONE "X" SHADED. AREAS OF 0.2% ANNUAL CHANCE FLOOD; AREAS OF 1% ANNUAL CHANCE FLOOD WITH AVERAGE DEPTHS OF LESS THAN 1 FOOT OR WITH DRAINAGE AREAS LESS THAN 1 SQUARE MILE; AREAS PROTECTED BY LEVEES FROM 1% ANNUAL CHANCE FLOOD. AND ZONE "AE". BASE FLOOD ELEVATIONS DETERMINED.

REFERENCE BENCHMARK:
RM 200250 - BRASS DISK STAMPED "U106 BMO4" ON DOWNSTREAM SIDE OF BRIDGE ON STATE HIGHWAY 6 OVER HORSEPEN CREEK AT STREAM CENTERLINE IN THE ADDICKS RESERVOIR WATERSHED IN KEY MAP 408J NEAR STREAM U106-00-00. ELEVATION = 122.07' (NAVD 88, 2001 ADJ.)

TEMPORARY BENCHMARKS:
TBM "B" - BOX CUT ON CONCRETE BASE OF LIGHT STANDARD LOCATED IN THE MEDIAN OF THE PARKING LOT TO THE MAIN ENTRANCE OF THE SCHOOL BUILDING ±48' SOUTHWEST OF THE SOUTHWESTERLY R.O.W. LINE OF WILLOW RIVER DRIVE. ELEVATION = 125.70'
TBM "D" - COTTON SPINDLE WITH SHINER STAMPED "WEST BELT SURVEYING" IN POWER POLE LOCATED ±32' SOUTH OF THE SOUTH CORNER OF THE BRICK BUILDING AT THE NORTHERLY END OF THE FOOTBALL FIELD. ELEVATION = 124.23'
TBM "E" - BOX CUT ON CONCRETE LIGHT STANDARD BASE LOCATED ±175' SOUTHWEST FROM THE INTERSECTION OF WILLOW RIVER DRIVE AND NORTHWESTERLY ENTRANCE TO SITE. ELEVATION=126.88'
TBM "G" - BOX CUT ON CONCRETE BASE OF LIGHT STANDARD LOCATED AT THE NORTHWESTERLY END OF THE DIRT TRACK. ELEVATION = 124.03'
TBM "H" - BOX CUT ON CONCRETE BASE OF LIGHT STANDARD LOCATED ±48' NORTHWEST FROM THE NORTHWEST CORNER OF PRESS BOX. ELEVATION=124.03'
TBM "I" - BOX CUT ON SOUTH CORNER OF CONCRETE SIDEWALK ON THE SOUTHWEST SIDE OF TRACK. ELEVATION=123.42'

LEGEND:

OFFSITE SHEET FLOW

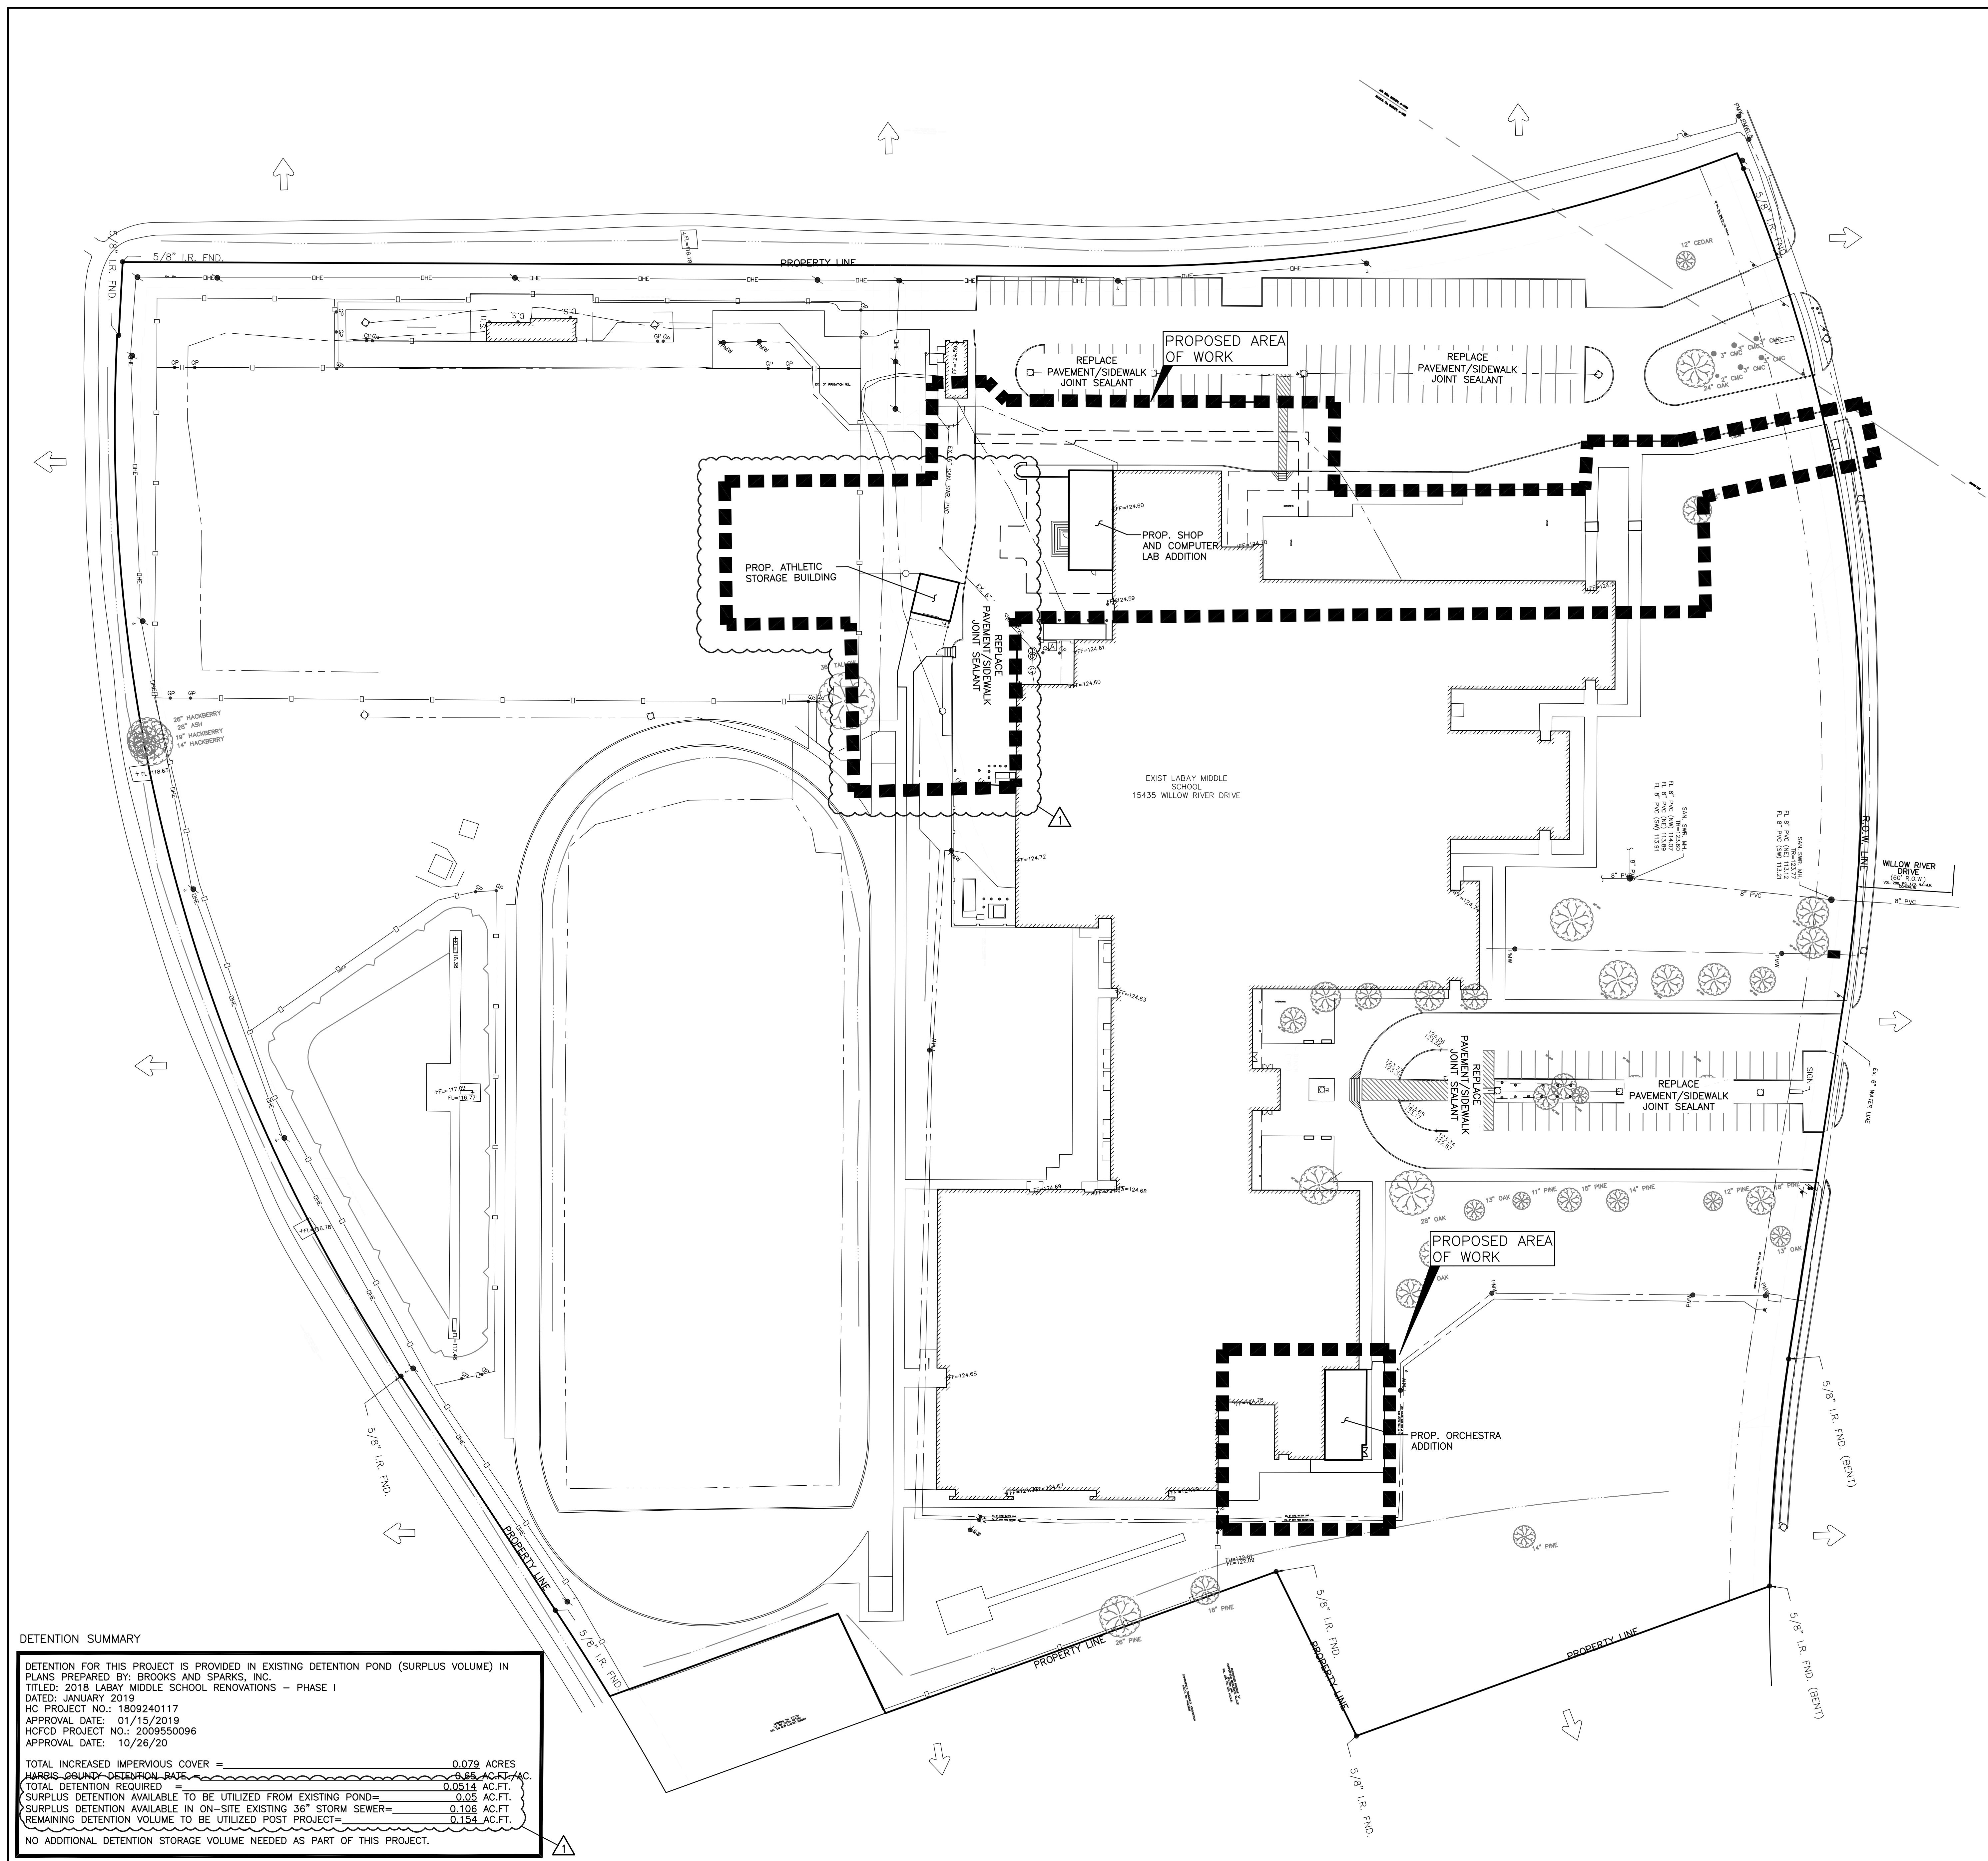

DETENTION SUMMARY

DETENTION FOR THIS PROJECT IS PROVIDED IN EXISTING DETENTION POND (SURPLUS VOLUME) IN PLANS PREPARED BY: BROOKS AND SPARKS, INC.
 TITLED: 2018 LABAY MIDDLE SCHOOL RENOVATIONS - PHASE 1
 DATED: JANUARY 2019
 HC PROJECT NO.: 1809240117
 APPROVAL DATE: 01/15/2019
 HGCD PROJECT NO.: 2009550096
 APPROVAL DATE: 10/26/20

TOTAL INCREASED IMPERVIOUS COVER =	0.079 ACRES
HARRIS COUNTY DETENTION RATE =	0.88 AC-FT/AC
TOTAL DETENTION REQUIRED =	0.0514 AC-FT
SURPLUS DETENTION AVAILABLE TO BE UTILIZED FROM EXISTING POND =	0.05 AC-FT
SURPLUS DETENTION AVAILABLE IN ON-SITE EXISTING 36" STORM SEWER =	0.106 AC-FT
REMAINING DETENTION VOLUME TO BE UTILIZED POST PROJECT =	0.154 AC-FT


NO ADDITIONAL DETENTION STORAGE VOLUME NEEDED AS PART OF THIS PROJECT.

NOTES TO CONTRACTOR:


- ALL UNDERGROUND UTILITIES SHOWN ARE NOT GUARANTEED TO BE COMPLETE OR DEFINITE, BUT WERE OBTAINED FROM THE BEST INFORMATION AVAILABLE.
- THE LOCATION OF ALL UNDERGROUND UTILITIES PRESENTED ON THESE DRAWINGS ARE SHOWN IN AN APPROXIMATE WAY ONLY. THE CONTRACTOR SHALL DETERMINE THE EXACT LOCATION BEFORE COMMENCING ANY WORK. CONTRACTOR IS FULLY RESPONSIBLE FOR ANY AND ALL DAMAGES CAUSED BY HIS FAILURE TO EXACTLY LOCATE AND PRESERVE THESE UNDERGROUND UTILITIES (SEE NOTE 6 GENERAL CONSTRUCTION NOTES).
- CONTRACTOR SHALL VERIFY ALL UNDERGROUND UTILITIES (PRIVATE OR PUBLIC) IN THE FIELD PRIOR TO CONSTRUCTION. IF A CONFLICT IS DISCOVERED, CONTRACTOR SHALL NOTIFY THE ENGINEER IMMEDIATELY.

UTILITY ONE CALL

CONTRACTOR TO CALL BEFORE DIGGING !!!
PHONE:
HOUSTON (713) 223-4567
(STATESIDE OUTSIDE HOUSTON)
1-800-545-6005

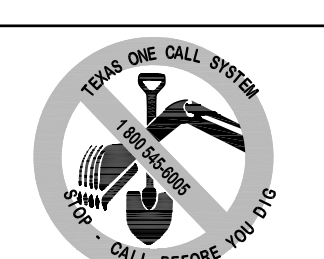

Issue for Proposal

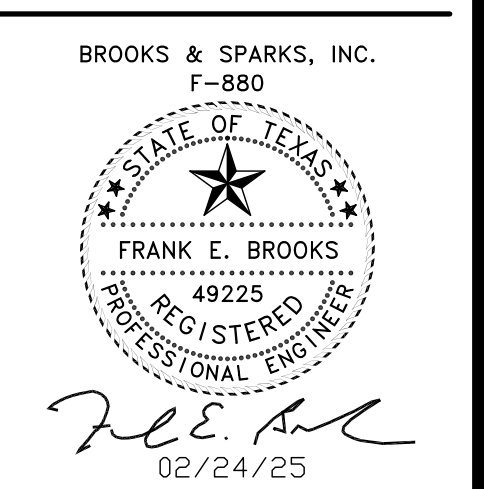

ISSUED: February 24, 2025

Revision No.
1 Addendum#1 03-06-25


Director Drawn By
Designer Quality Control
JW GL
Proj. Arch.

2901.00

CIVIL
SITE PLAN

C21.02

2024 Cook, Labay & Truitt MS Renovations
CYPRUS-FAIRBANKS INDEPENDENT SCHOOL DISTRICT
HOUSTON, TEXAS

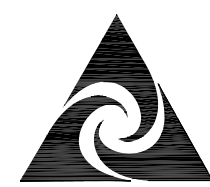


VLK ARCHITECTS

VLK Architects
20445 State Hwy 249, Suite 350
Houston, Texas 77070
Main Phone: 281.671.2300
www.vlkarchitects.com

Brooks & Sparks, Inc.
21020 Park Row Dr.
Katy, Texas 77449
Main Phone: 281.578.9595
www.brooksandsparks.com

CYPRESS-FAIRBANKS INDEPENDENT SCHOOL DISTRICT
HOUSTON, TEXAS

2024 Cook, Labay & Truitt MS Renovations

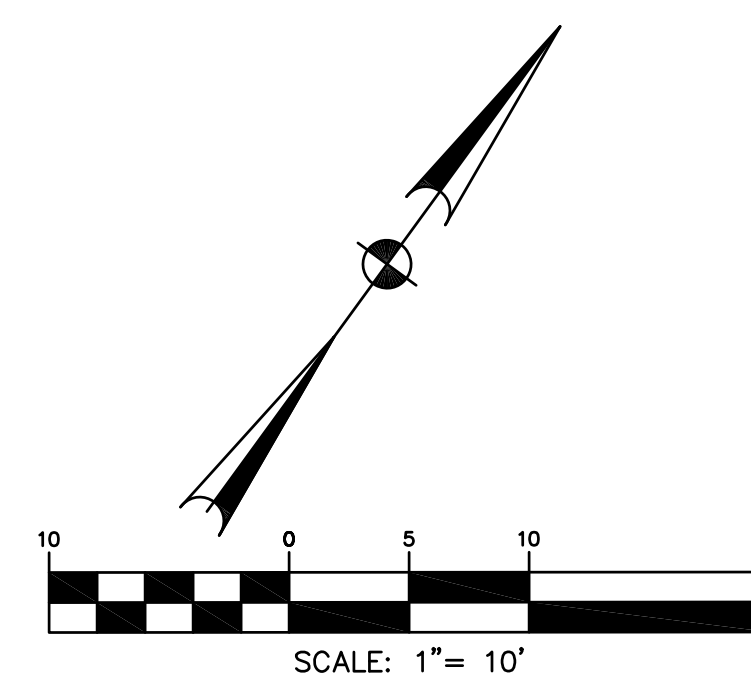

FLOODPLAIN:
ACCORDING TO F.I.R.M. MAP NO. 48201C0420P (COMMUNITY-PANEL NO. 4802870420P), MAP REVISED DATE: NOVEMBER 15, 2019. THE SUBJECT PROPERTY LIES WITHIN THE AREAS DESIGNATED AS ZONE "X" UNSHADED. DETERMINED TO BE OUTSIDE THE 0.2% ANNUAL CHANCE FLOOD. ZONE "X" SHADED. AREAS OF 0.2% ANNUAL CHANCE FLOOD; AREAS OF 1% ANNUAL CHANCE FLOOD WITH AVERAGE DEPTHS OF LESS THAN 1 FOOT OR WITH DRAINAGE AREAS LESS THAN 1 SQUARE MILE; AREAS PROTECTED BY LEVEES FROM 1% ANNUAL CHANCE FLOOD. AND ZONE "AE". BASE FLOOD ELEVATIONS DETERMINED.

REFERENCE BENCHMARK:
RM 200250 - BRASS DISK STAMPED "U106 BMO4" ON DOWNSTREAM SIDE OF BRIDGE ON STATE HIGHWAY 6 OVER HORSEPEN CREEK AT STREAM CENTERLINE IN THE ADDICKS RESERVOIR WATERSHED IN KEY MAP 408J NEAR STREAM U106-00-00.
ELEVATION = 122.07' (NAVD 88, 2001 ADJ.)

TEMPORARY BENCHMARKS:
TBM "B" - BOX CUT ON CONCRETE BASE OF LIGHT STANDARD LOCATED IN THE MEDIAN OF THE PARKING LOT TO THE MAIN ENTRANCE OF THE SCHOOL BUILDING ±48' SOUTHWEST OF THE SOUTHWESTERLY R.O.W. LINE OF WILLOW RIVER DRIVE.
ELEVATION = 125.70'
TBM "D" - COTTON SPINDLE WITH SHINER STAMPED "WEST BELT SURVEYING" IN POWER POLE LOCATED ±32' SOUTH OF THE SOUTH CORNER OF THE BRICK BUILDING AT THE NORTHERLY END OF THE FOOTBALL FIELD.
ELEVATION = 124.23'
TBM "E" - BOX CUT ON CONCRETE LIGHT STANDARD BASE LOCATED ±175' SOUTHWEST FROM THE INTERSECTION OF WILLOW RIVER DRIVE AND NORTHWESTERLY ENTRANCE TO SITE.
ELEVATION=126.88'
TBM "G" - BOX CUT ON CONCRETE BASE OF LIGHT STANDARD LOCATED AT THE NORTHWESTERLY END OF THE DIRT TRACK.
ELEVATION = 124.03'
TBM "H" - BOX CUT ON CONCRETE BASE OF LIGHT STANDARD LOCATED ±48' NORTHWEST FROM THE NORTHWEST CORNER OF PRESS BOX.
ELEVATION=124.03'
TBM "I" - BOX CUT ON SOUTH CORNER OF CONCRETE SIDEWALK ON THE SOUTHWEST SIDE OF TRACK.
ELEVATION=123.42'

LEGEND:



- PROPOSED GRATE/CURB INLET
- PROPOSED STORM SEWER MANHOLE WITH GRATE TOP
- TC [24.50] PROPOSED TOP OF CURB ELEV.
- TP [24.00] PROPOSED TOP OF PAVEMENT ELEV.
- TP [24.25] PROPOSED TOP OF WALK ELEV.
- FL [20.00] PROPOSED FLOWLINE ELEV.
- FG [23.50] PROPOSED FINISHED GRADE ELEV.
- TG [23.50] PROPOSED TOP OF GRATE ELEV.
- [24.00] PROPOSED CONTOUR
- M.E.C. MATCH EXIST. CURB & GUTTER
- M.E.P. MATCH EXIST. PAVEMENT
- M.E.W. MATCH EXIST. WALK
- DIRECTION OF FLOW

NOTES TO CONTRACTOR:


1. ALL UNDERGROUND UTILITIES SHOWN ARE NOT GUARANTEED TO BE COMPLETE OR DEFINITE, BUT WERE OBTAINED FROM THE BEST INFORMATION AVAILABLE.
2. THE LOCATION OF ALL UNDERGROUND UTILITIES PRESENTED ON THESE DRAWINGS ARE SHOWN IN AN APPROXIMATE WAY ONLY. THE CONTRACTOR SHALL DETERMINE THE EXACT LOCATION BEFORE COMMENCING ANY WORK. CONTRACTOR IS FULLY RESPONSIBLE FOR ANY AND ALL DAMAGES CAUSED BY HIS FAILURE TO EXACTLY LOCATE AND PRESERVE THESE UNDERGROUND UTILITIES (SEE NOTE 6 GENERAL CONSTRUCTION NOTES).
3. CONTRACTOR SHALL VERIFY ALL UNDERGROUND UTILITIES (PRIVATE OR PUBLIC) IN THE FIELD PRIOR TO CONSTRUCTION. IF A CONFLICT IS DISCOVERED, CONTRACTOR SHALL NOTIFY THE ENGINEER IMMEDIATELY.

UTILITY ONE CALL


CONTRACTOR TO CALL BEFORE DIGGING !!!
PHONE:
HOUSTON (713) 223-4567
(STATESIDE, OUTSIDE HOUSTON)
1-(800)-545-6005

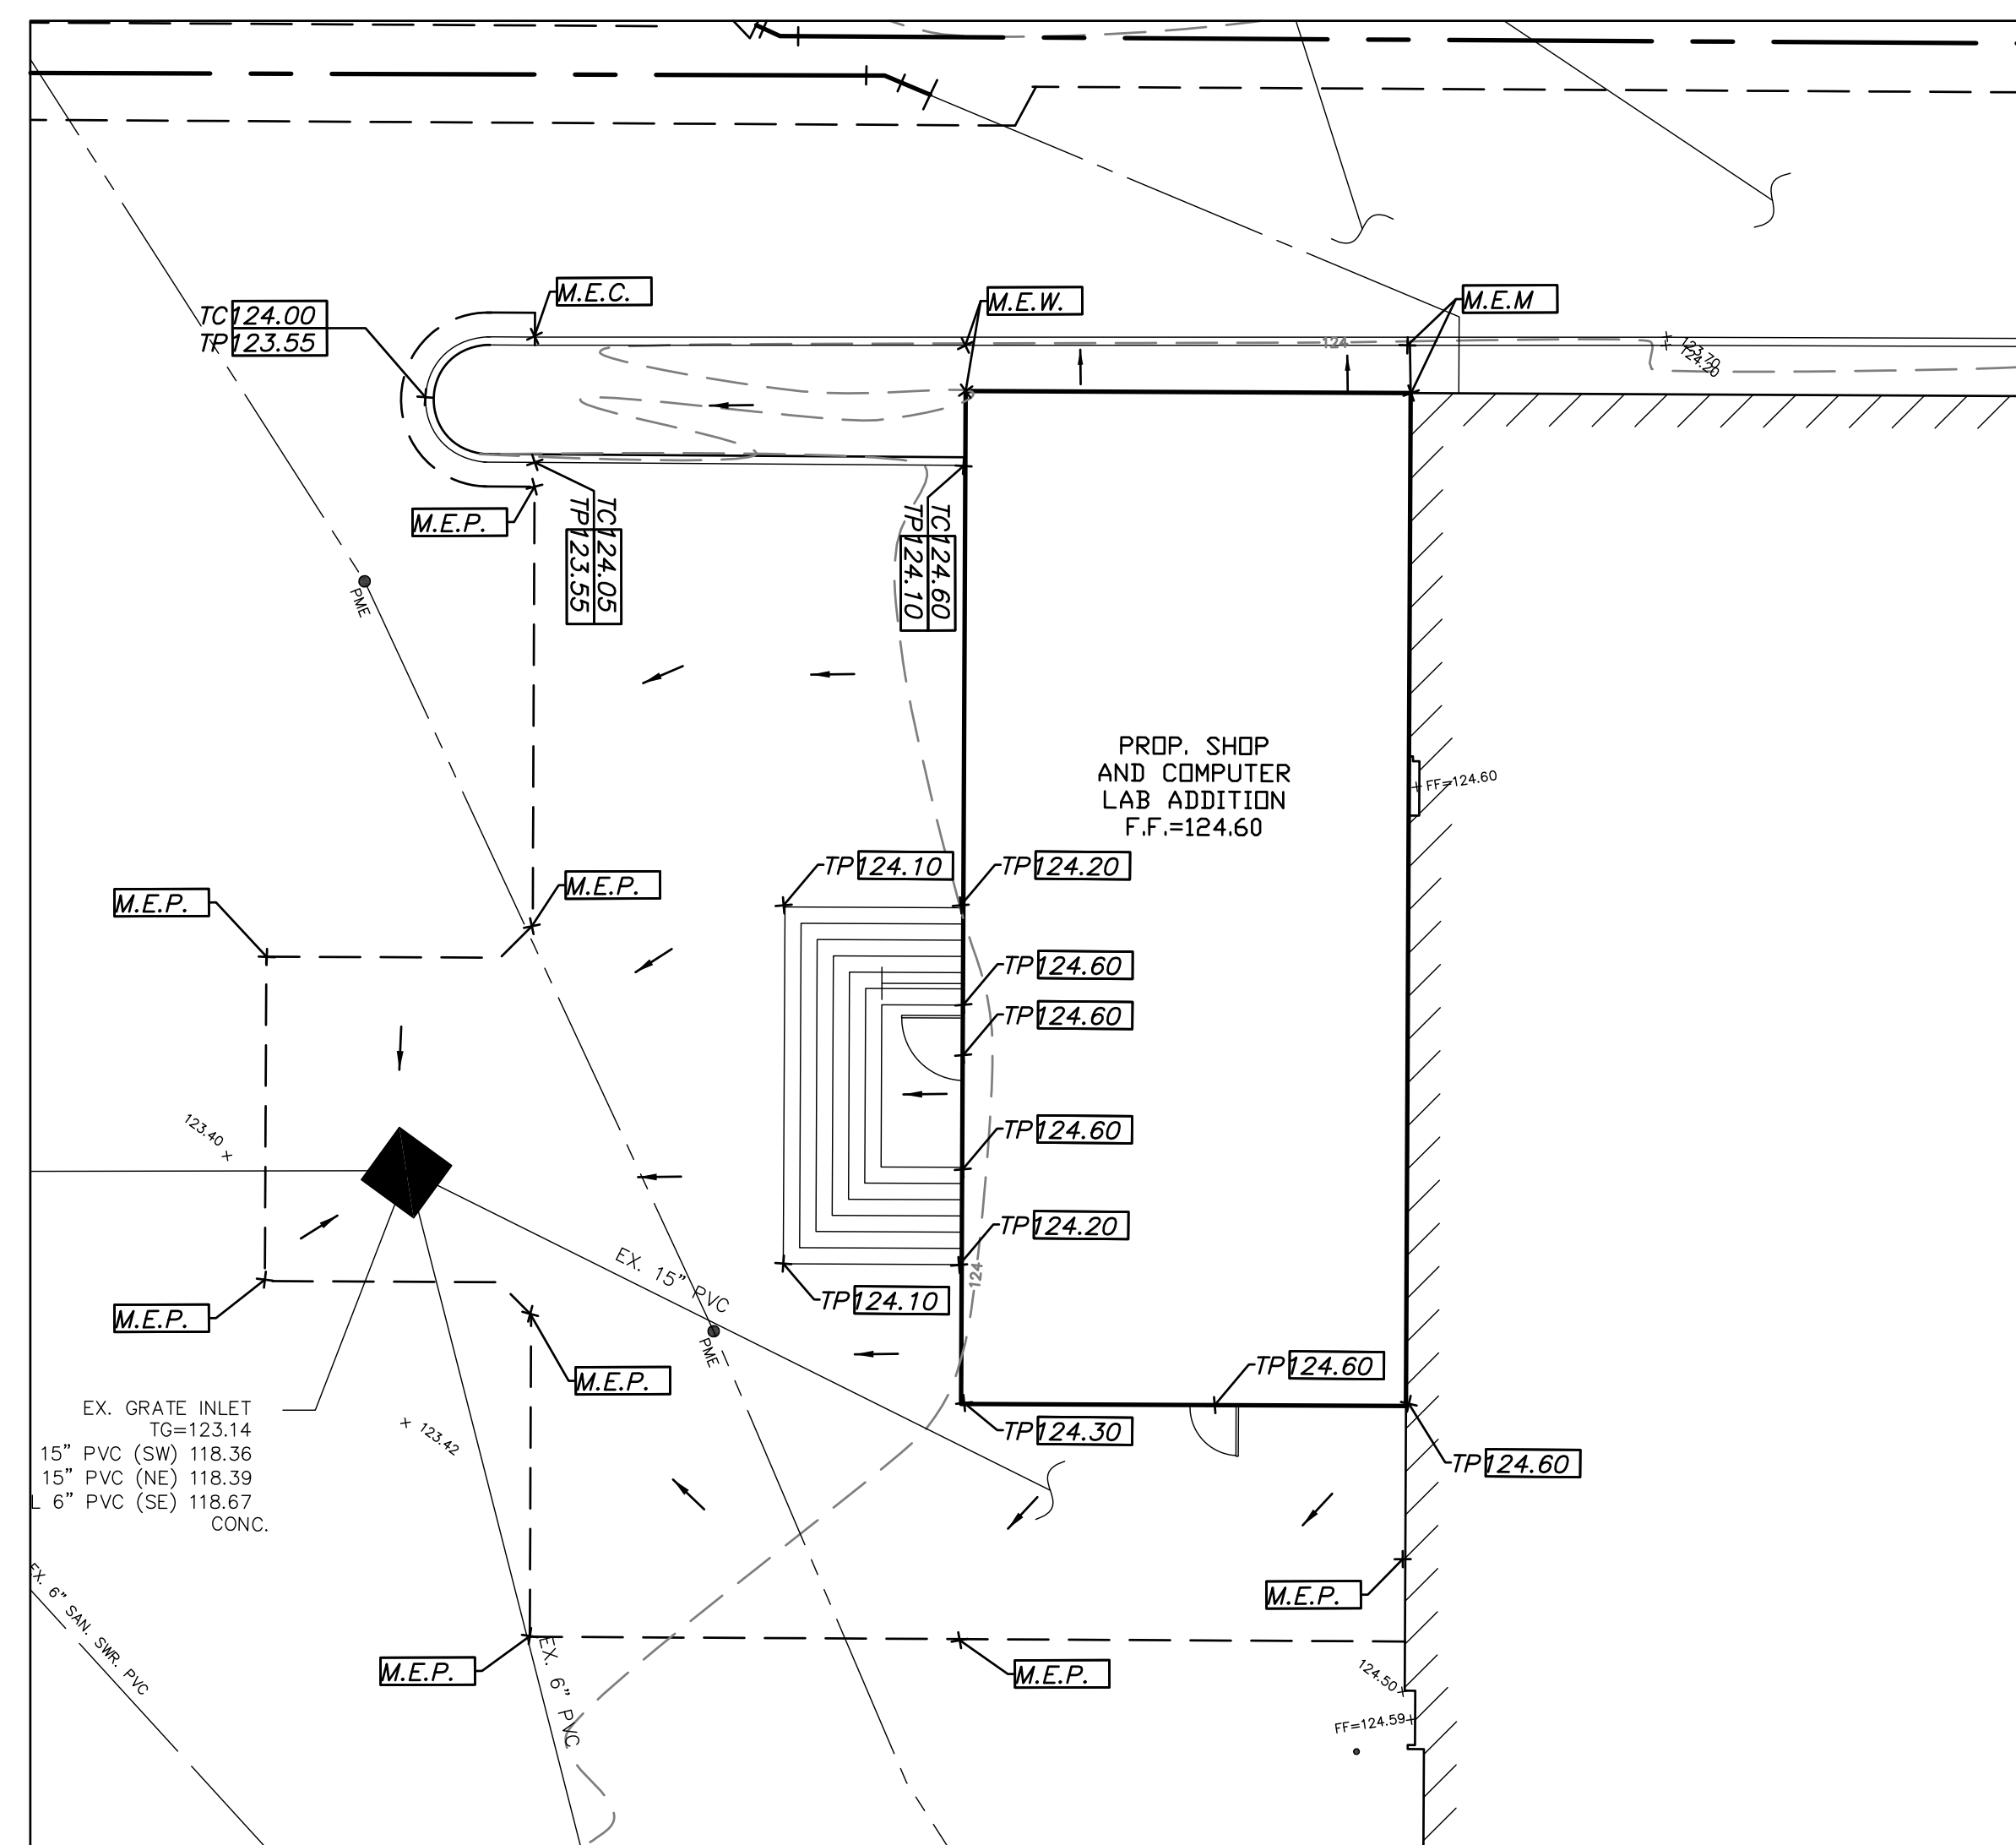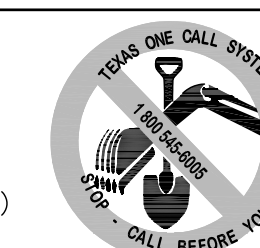

SHOP AND COMPUTER LAB ADDITION

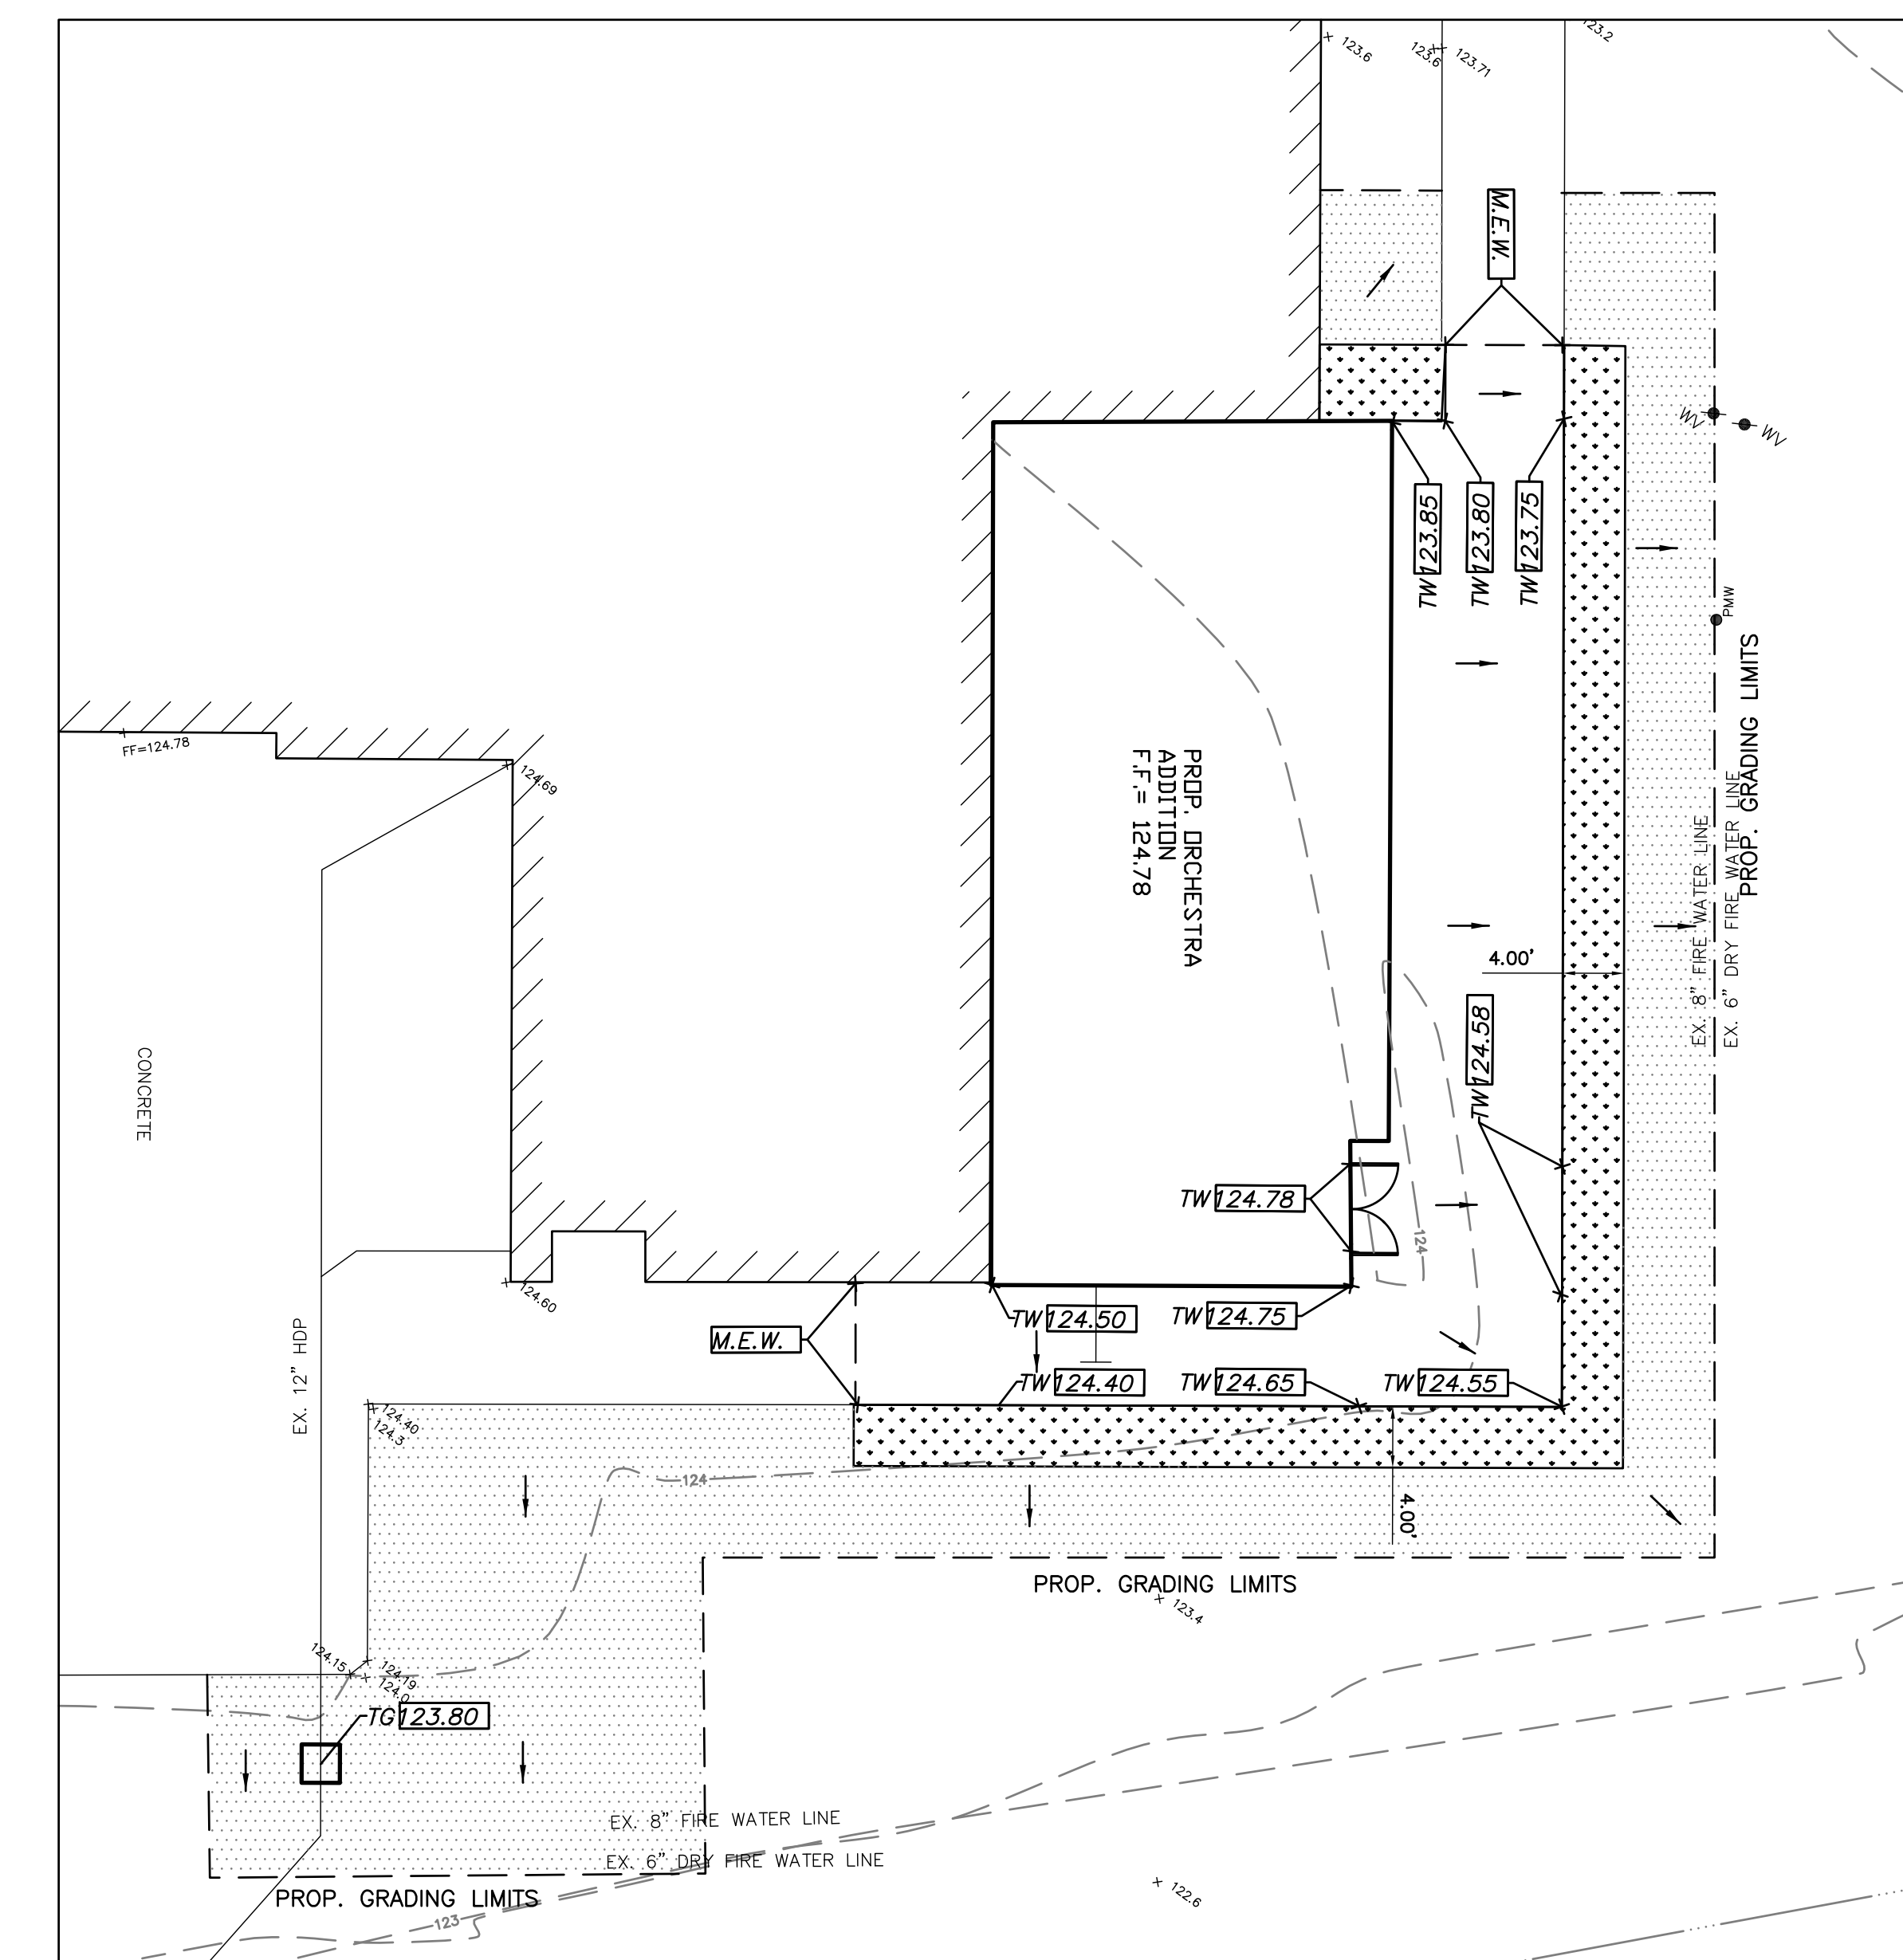


ORCHESTRA ADDITION

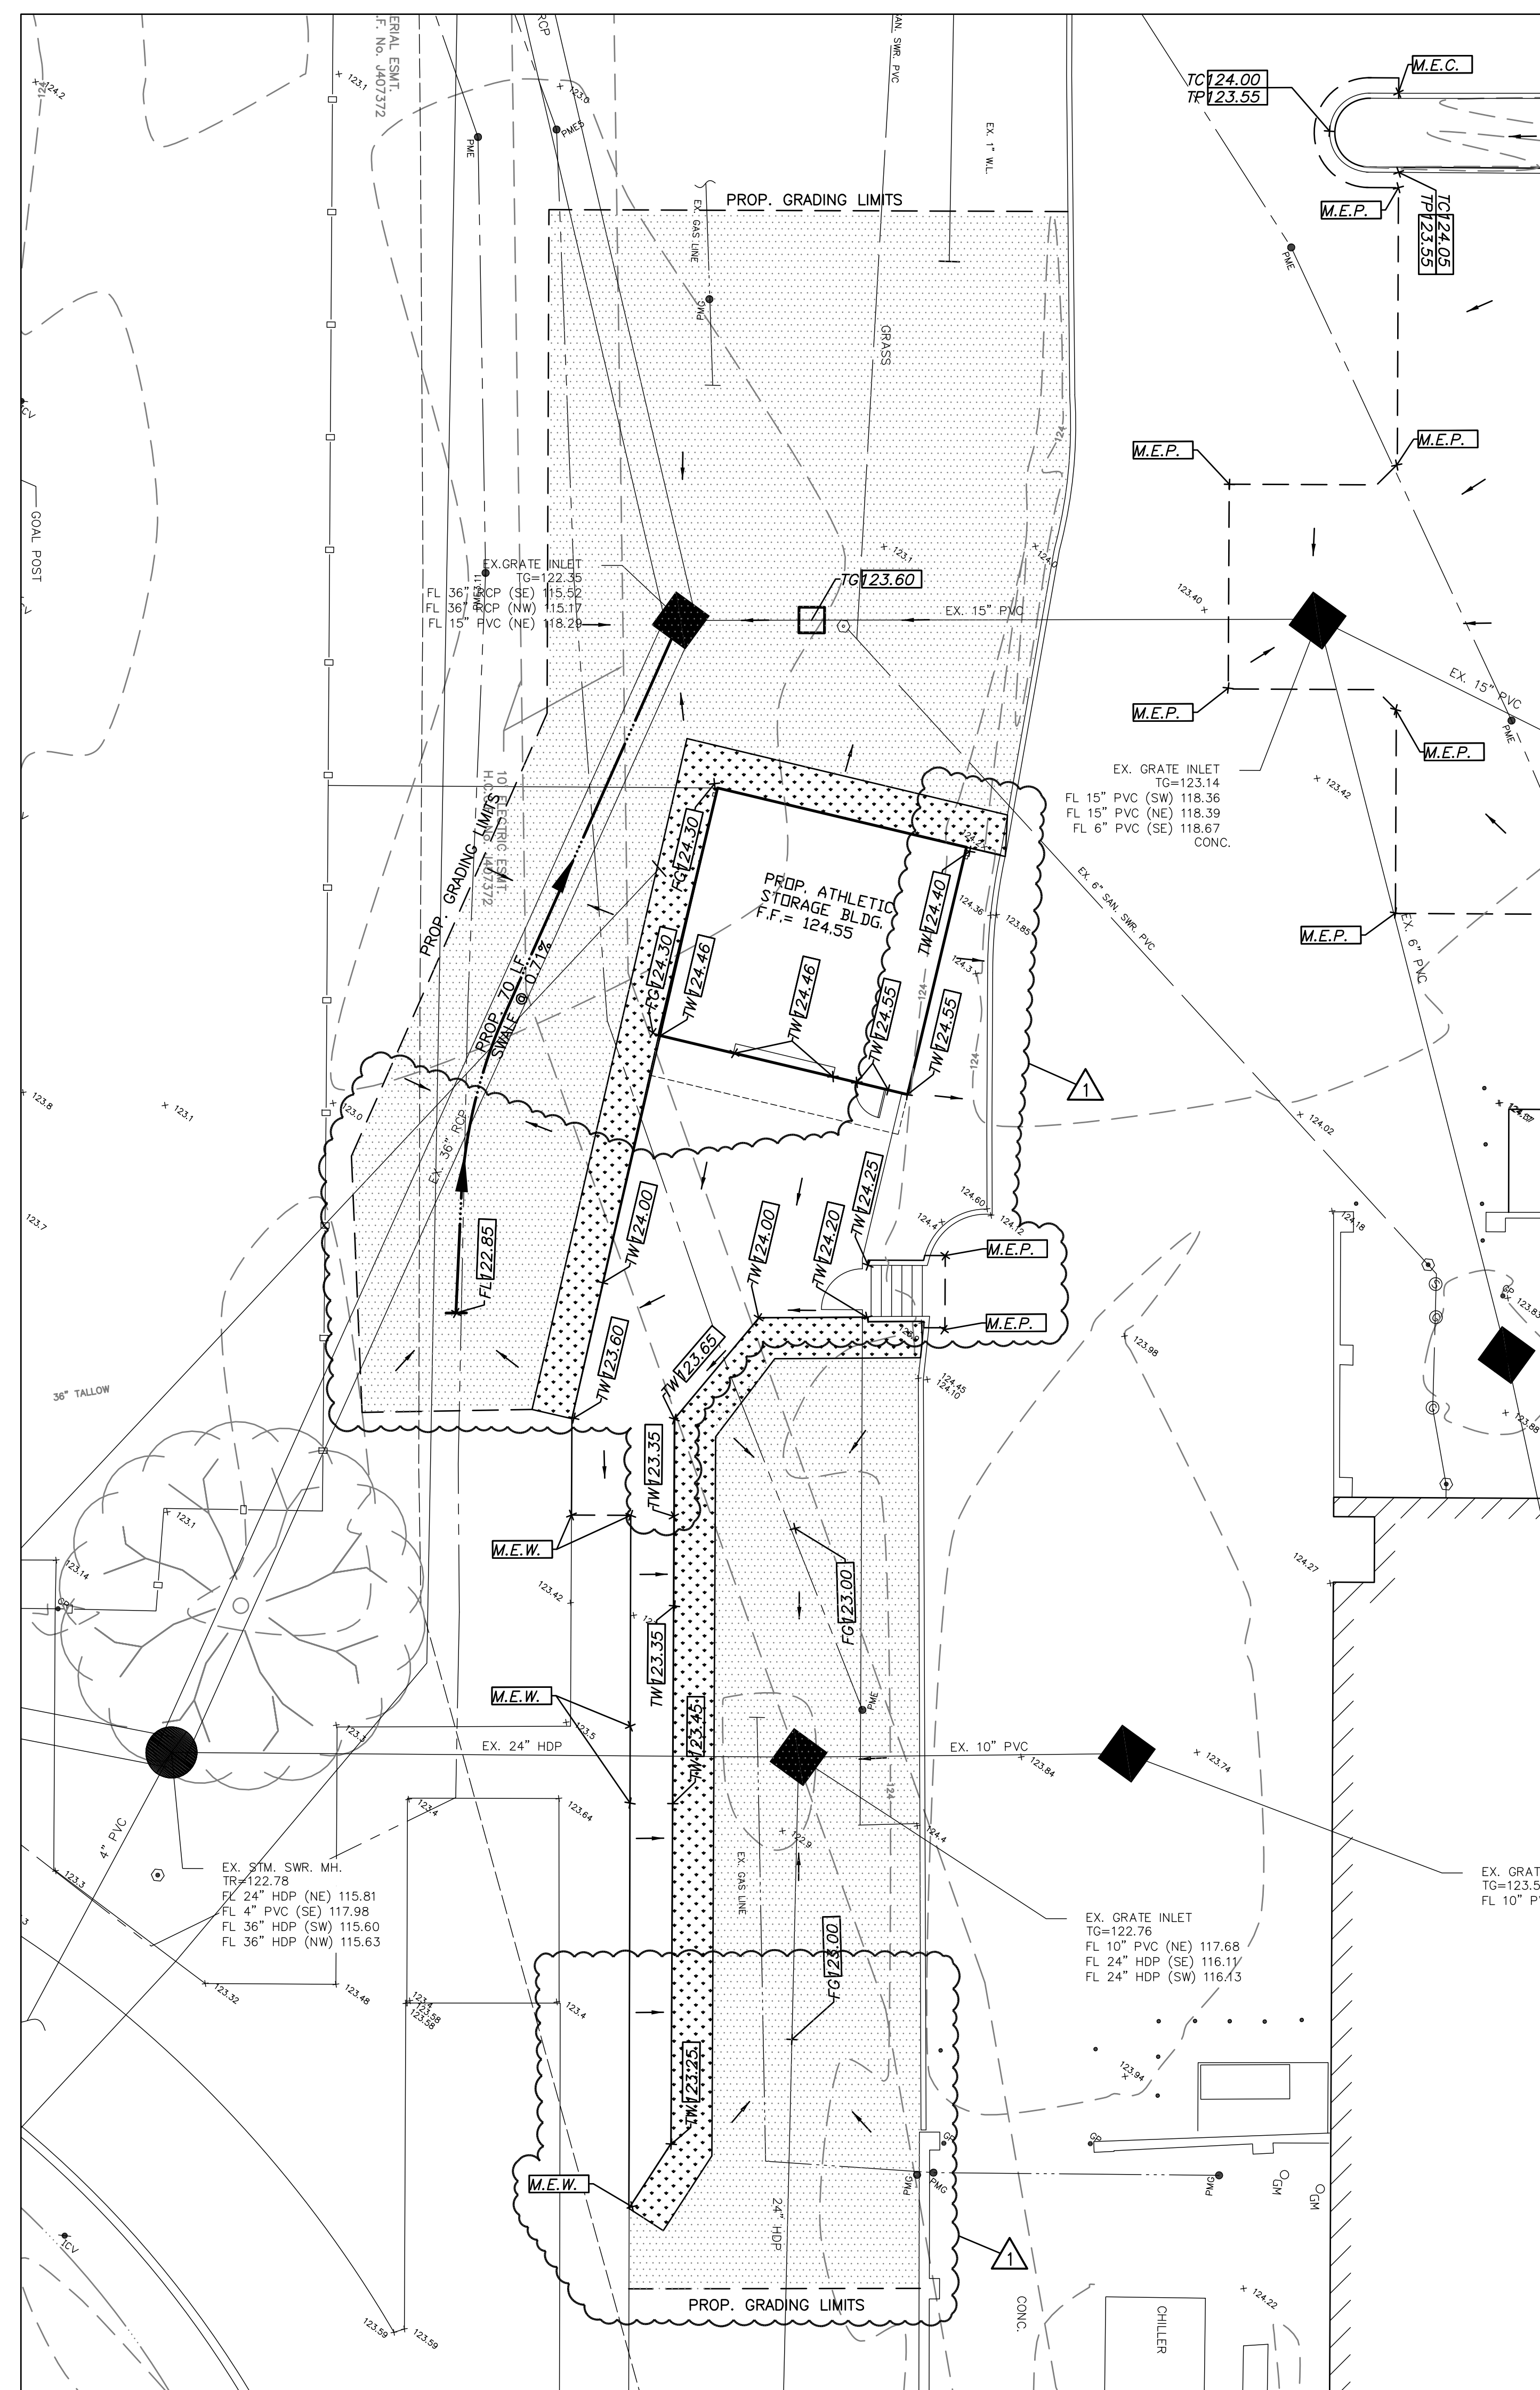

ATHLETIC STORAGE BUILDING ADDITION

Issue for Proposal

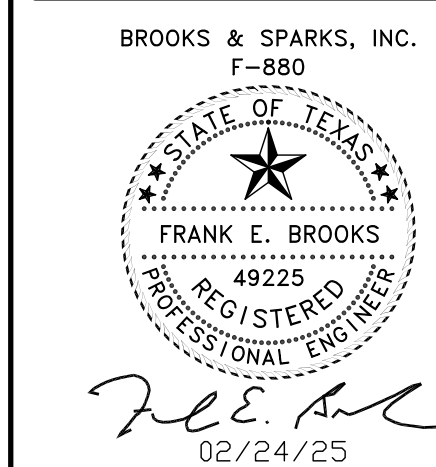

ISSUED: February 24, 2025

Revision No. _____


1 Addendum#1 03-06-25

Director Drawn By
Designer Quality Control
JW GL
Proj. Arch.


2901.00

GRADING
PLAN


C22.01

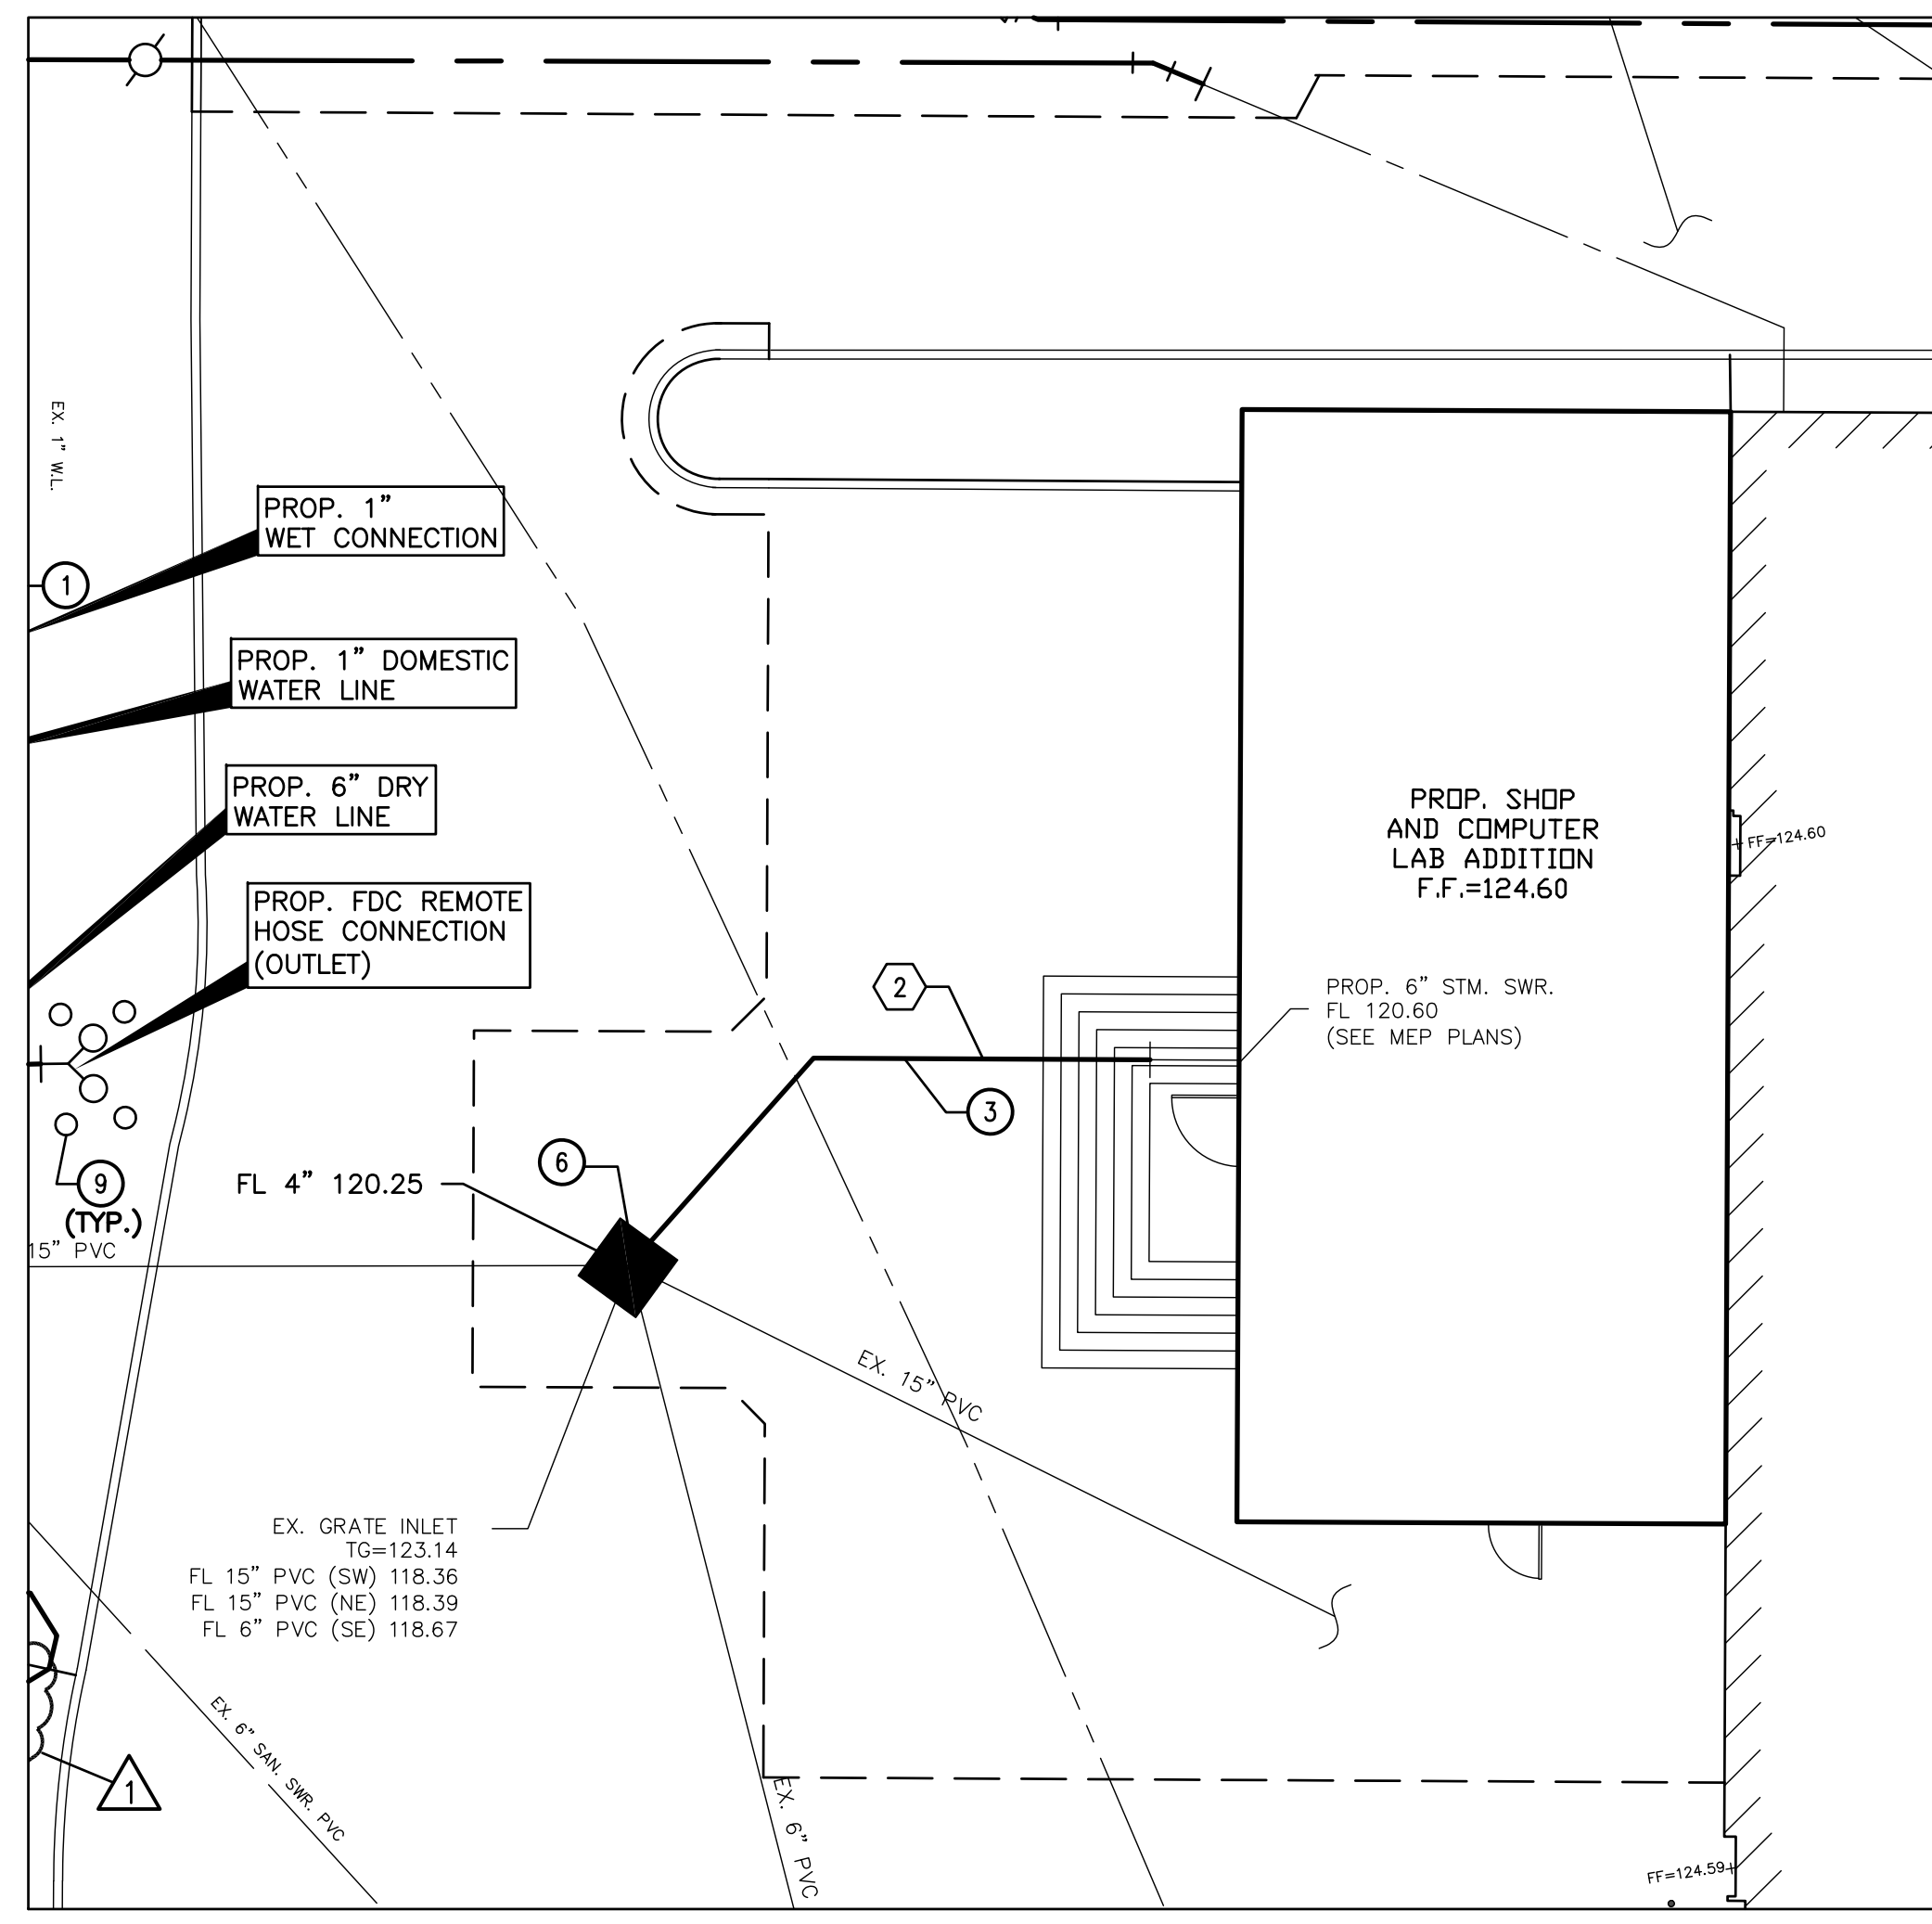

SHOP AND COMPUTER LAB ADDITION

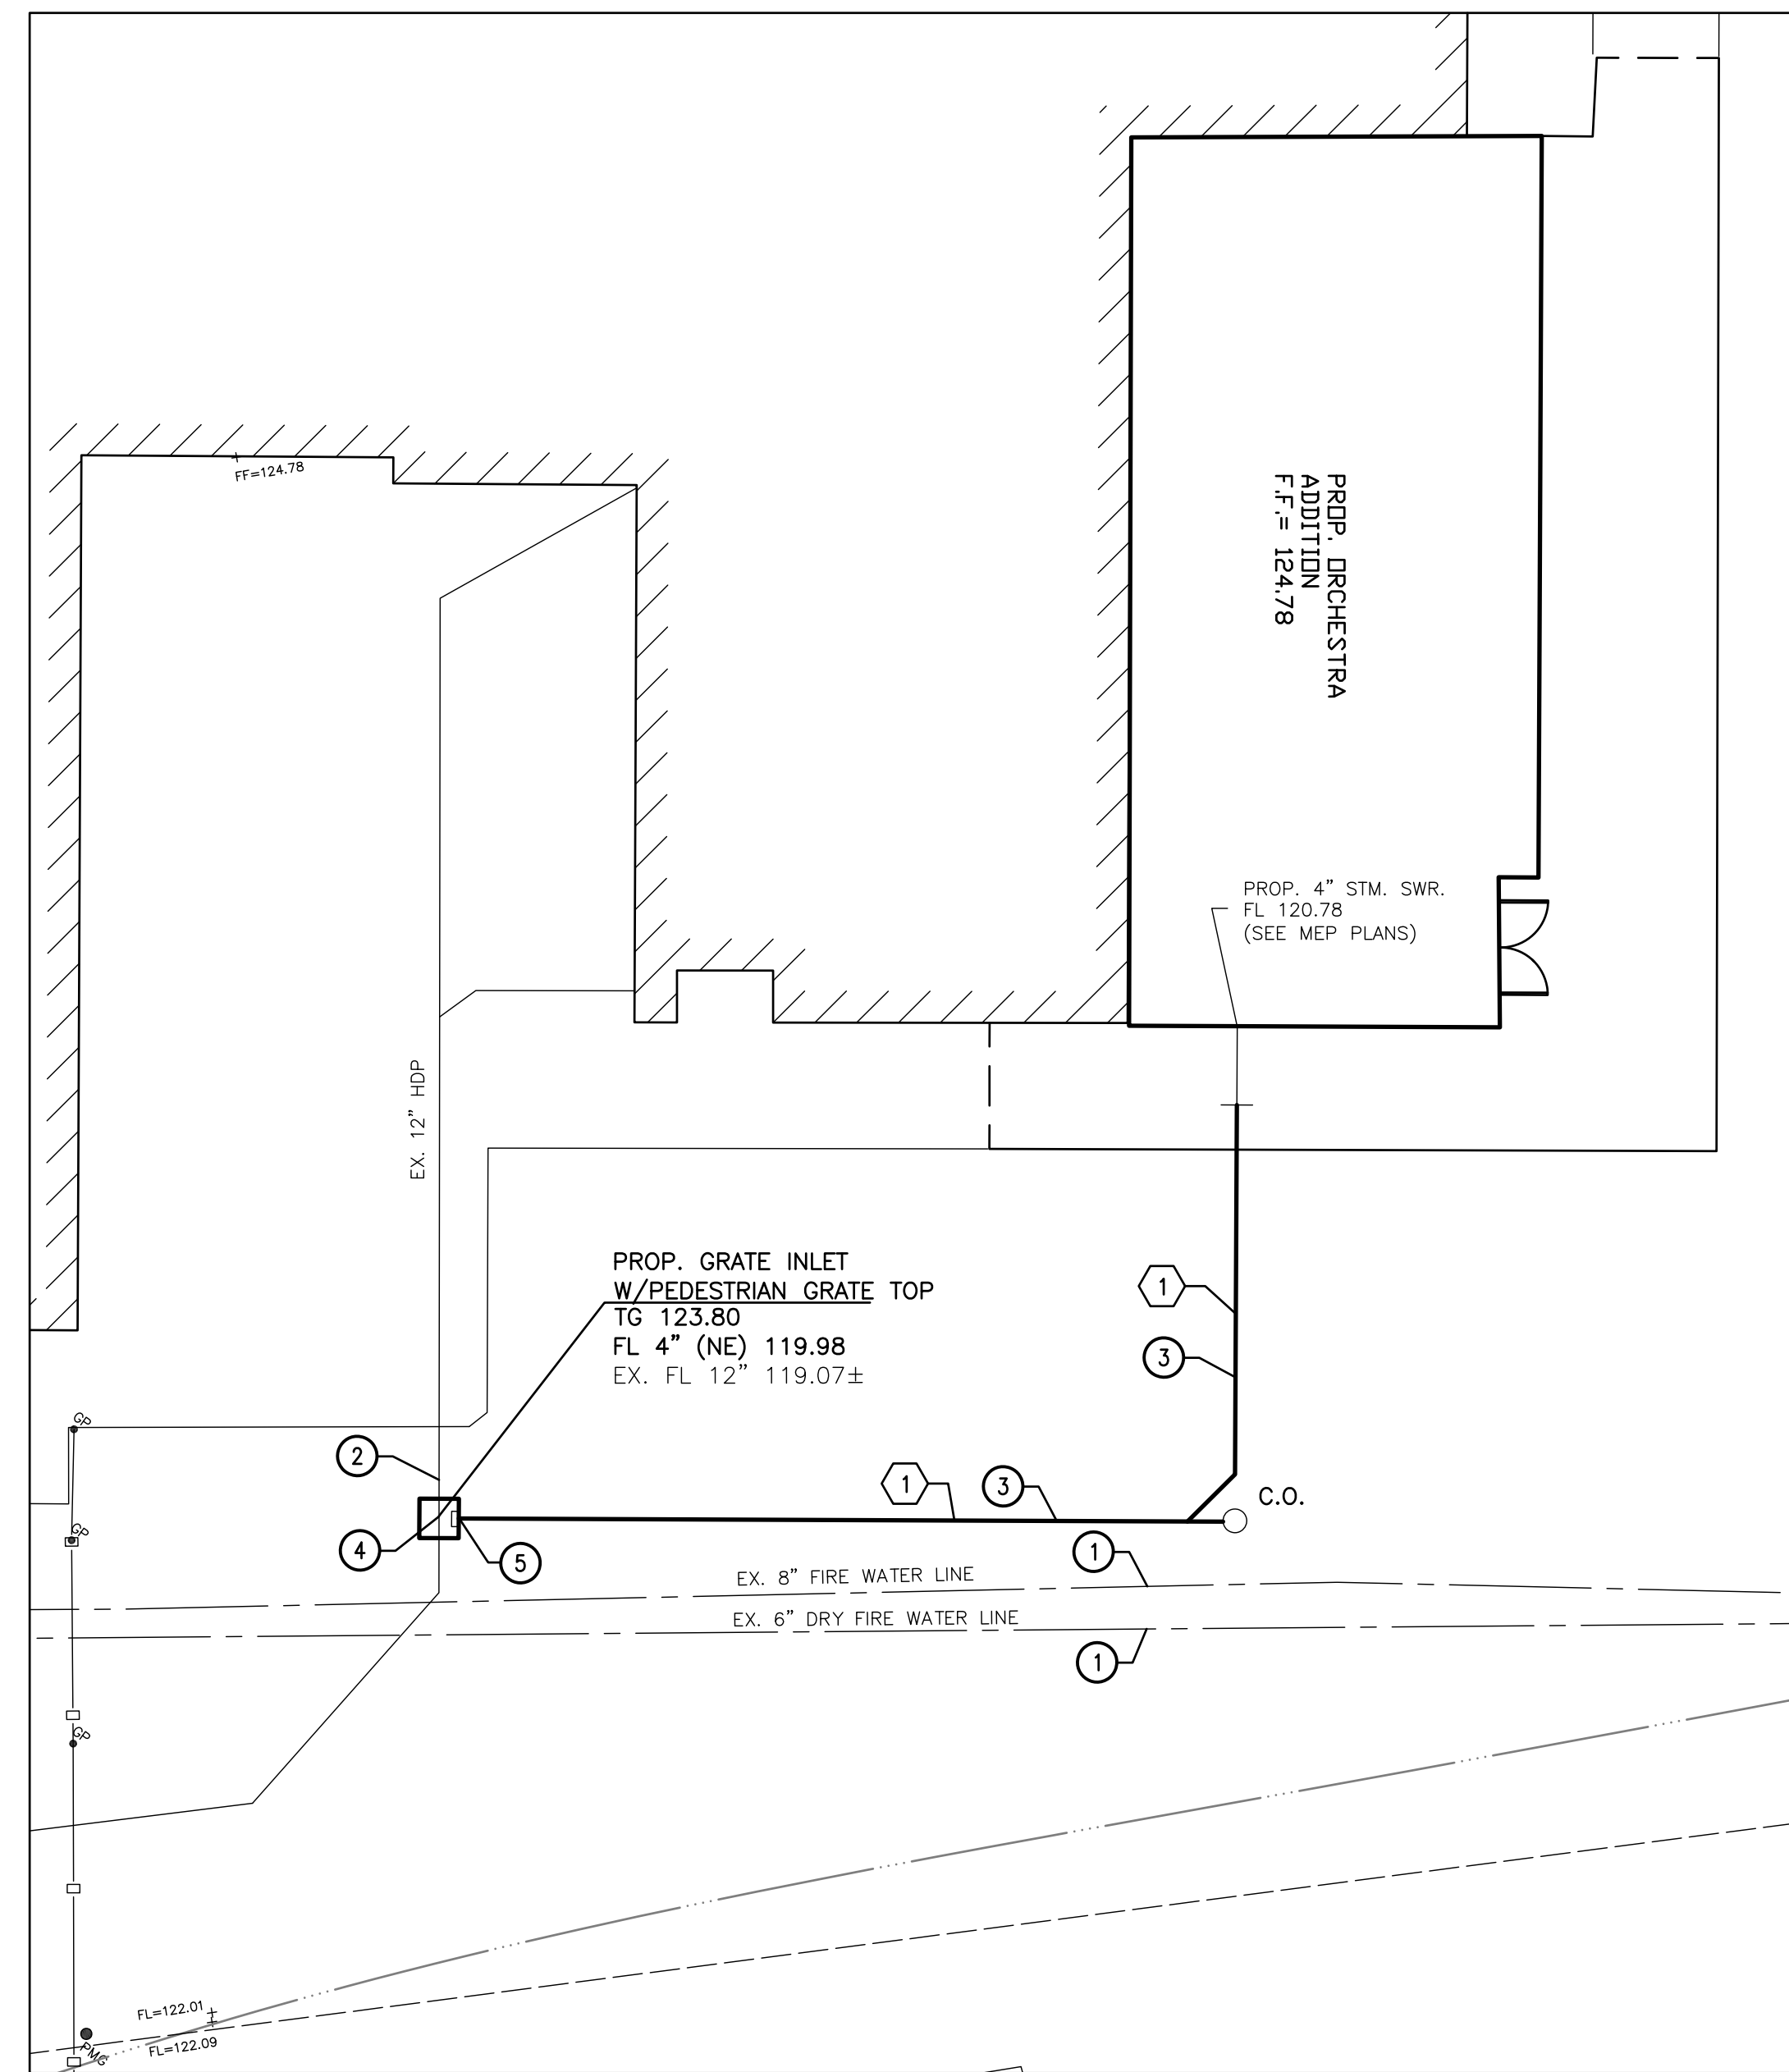



ORCHESTRA ADDITION

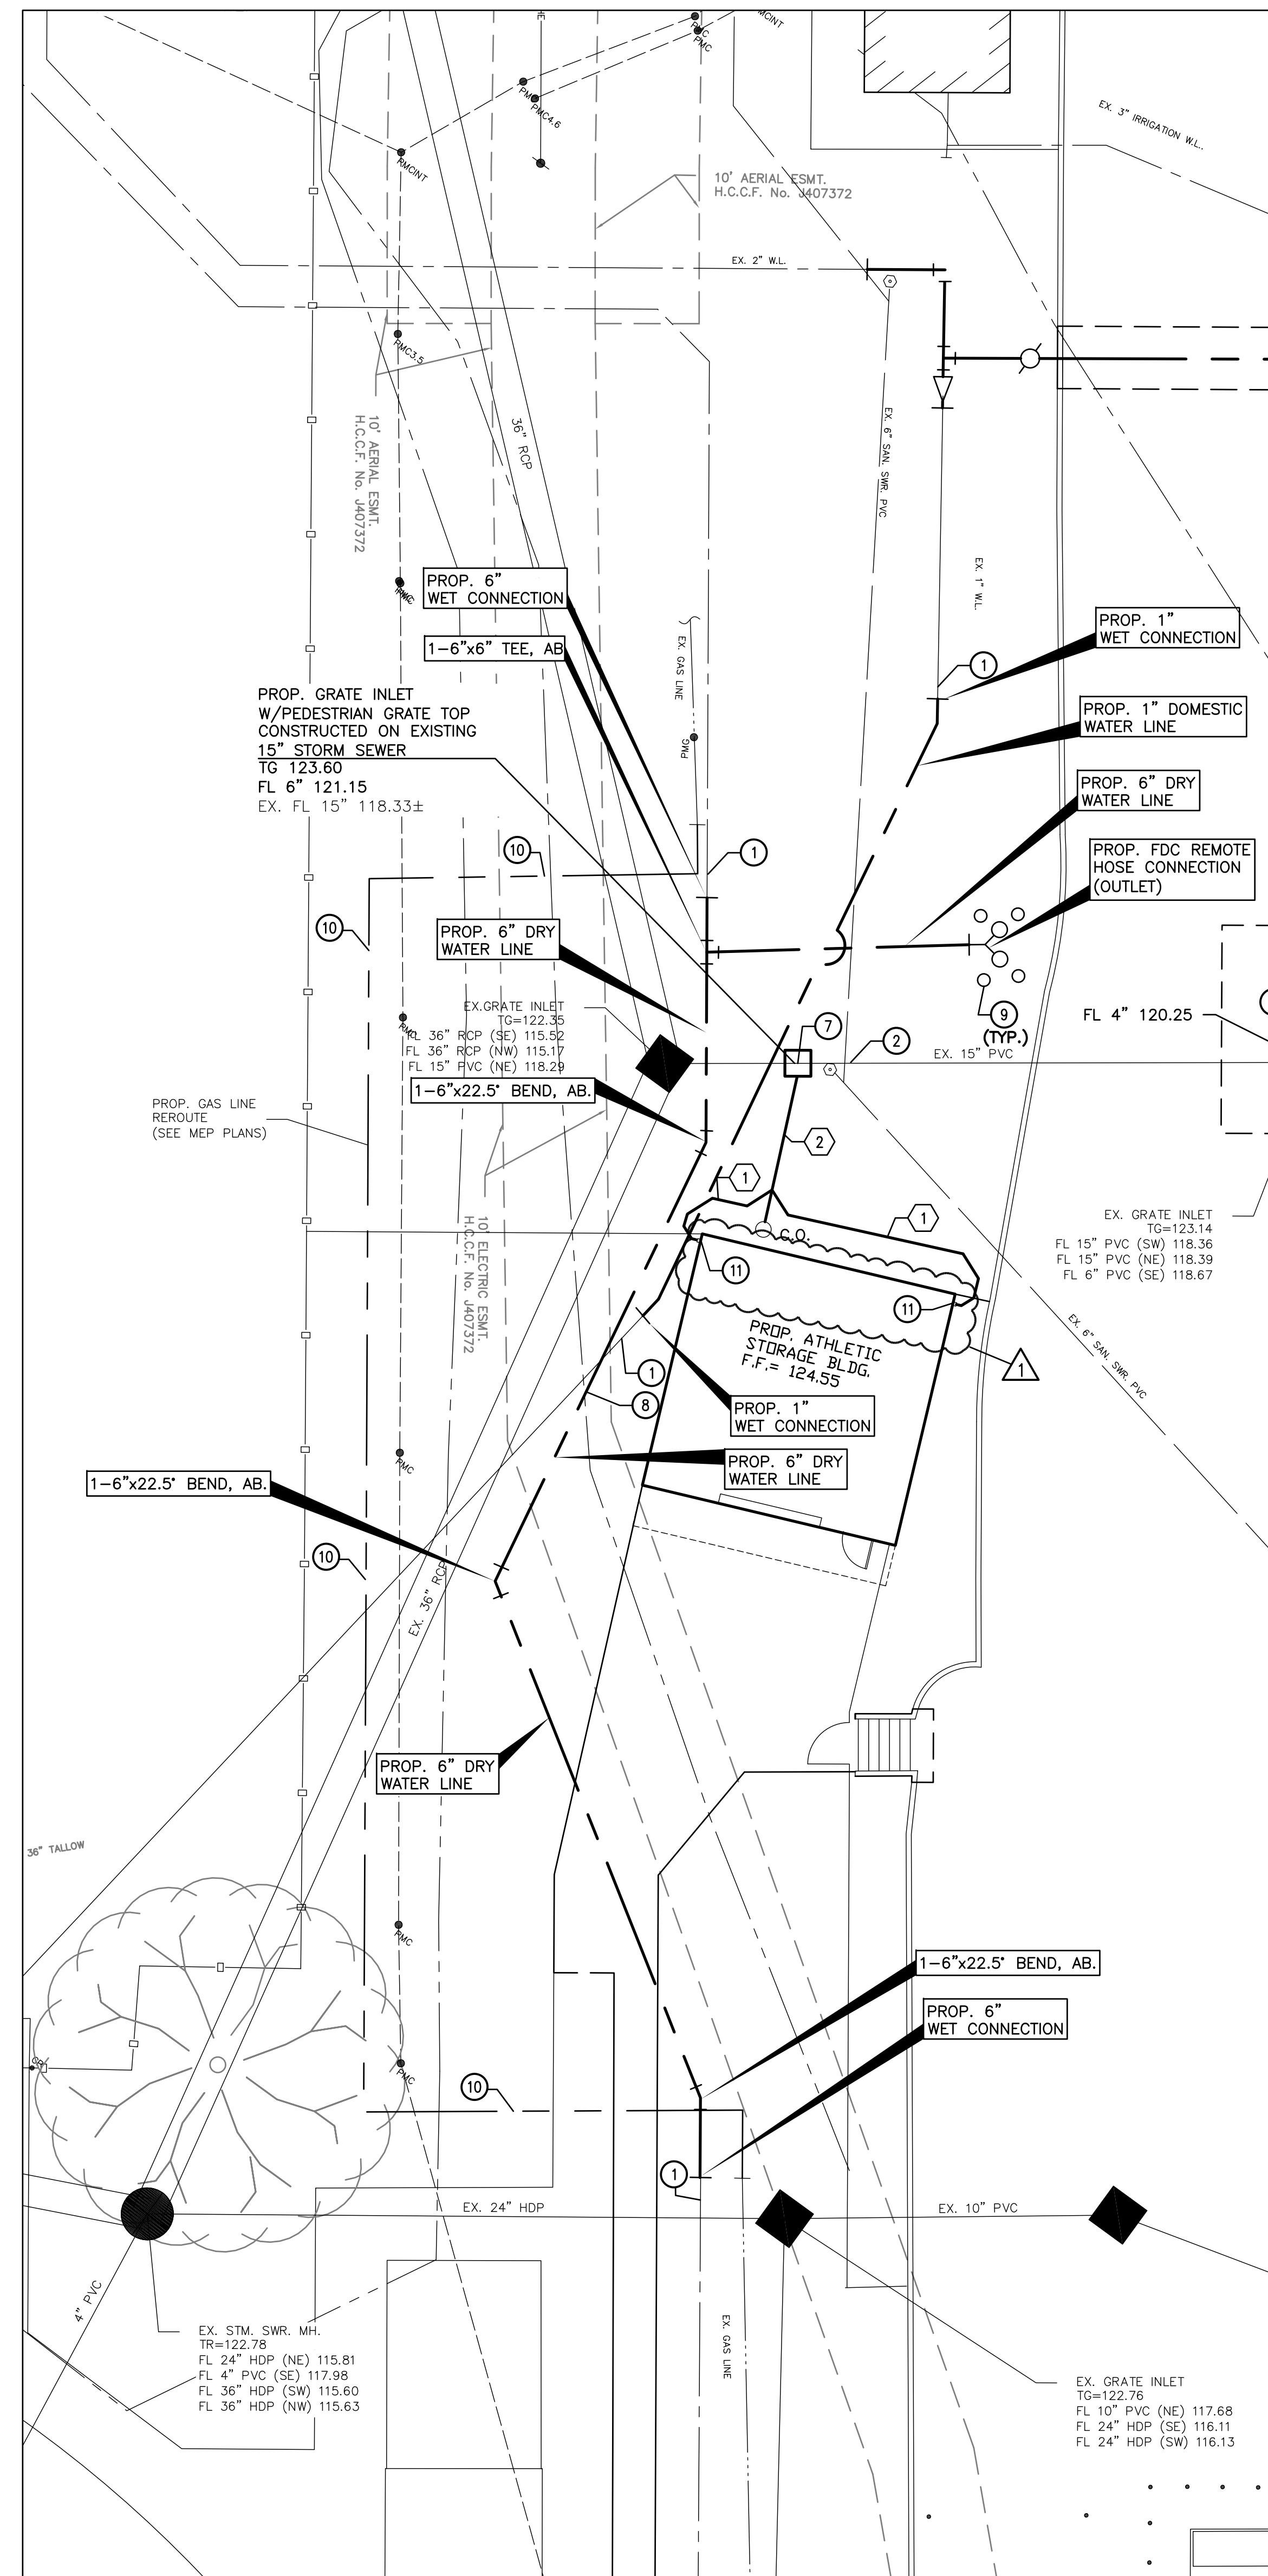

ATHLETIC STORAGE BUILDING ADDITION

KEY NOTES:

- 1 PRIOR TO CONSTRUCTION CONTRACTOR TO FIELD VERIFY HORIZONTAL AND VERTICAL LOCATION OF EXISTING WATER LINE. IF CONFLICT ARISES CONTRACTOR TO CONTACT ENGINEER.
- 2 PRIOR TO CONSTRUCTION CONTRACTOR TO FIELD VERIFY HORIZONTAL AND VERTICAL LOCATION OF EXISTING STORM SEWER. IF CONFLICT ARISES CONTRACTOR TO CONTACT ENGINEER.
- 3 CONTRACTOR TO MATCH SIZE AND MATERIAL OF MEP STUB TO FIRST INLET STRUCTURE (NO FERNOCO COUPLERS ALLOWED).
- 4 CONTRACTOR TO CONSTRUCT PROPOSED GRATE INLET ON EXISTING 12" STORM SEWER WITH WATER TIGHT CONNECTIONS.
- 5 CONTRACTOR TO INSTALL JAY R. SMITH 4" BACKWATER VALVE (OR APPROVED EQUAL) WITHIN PROPOSED GRATE INLET TO PREVENT BACKFLOW ON CONDENSATE LINE INTERIOR TO BUILDING (SEE DETAIL THIS SHEET).
- 6 CONTRACTOR IN CONNECT PROPOSED STORM SEWER TO EXISTING GRATE INLET WITH WATER TIGHT CONNECTION.
- 7 CONTRACTOR TO CONSTRUCT PROPOSED GRATE INLET ON EXISTING 15" STORM SEWER WITH WATER TIGHT CONNECTIONS.
- 8 CONTRACTOR TO OFFSET PROPOSED DRY FIRE WATER LINE UNDER EXISTING ELECTRICAL CONDUIT BANK MAINTAINING MINIMUM 12" VERTICAL CLEARANCE.
- 9 PROPOSED BOLLARD. CONTRACTOR TO REFER TO HARRIS COUNTY HOSE CONNECTION DETAIL ON SHEET C21.04.
- 10 POTENTIAL GAS LINE REROUTE. CONTRACTOR TO COORDINATE FINAL ROUTING AND INSTALLATION WITH MEP AND GAS PROVIDER.
- 11 CONTRACTOR TO REFER TO ARCHITECTURAL PLANS FOR DOWNSPOUT BOOT DETAILS.

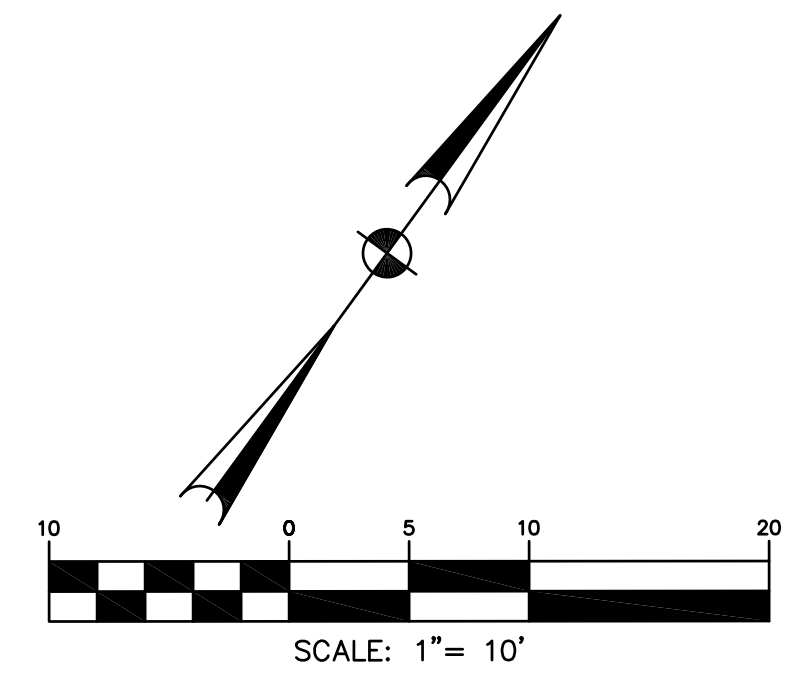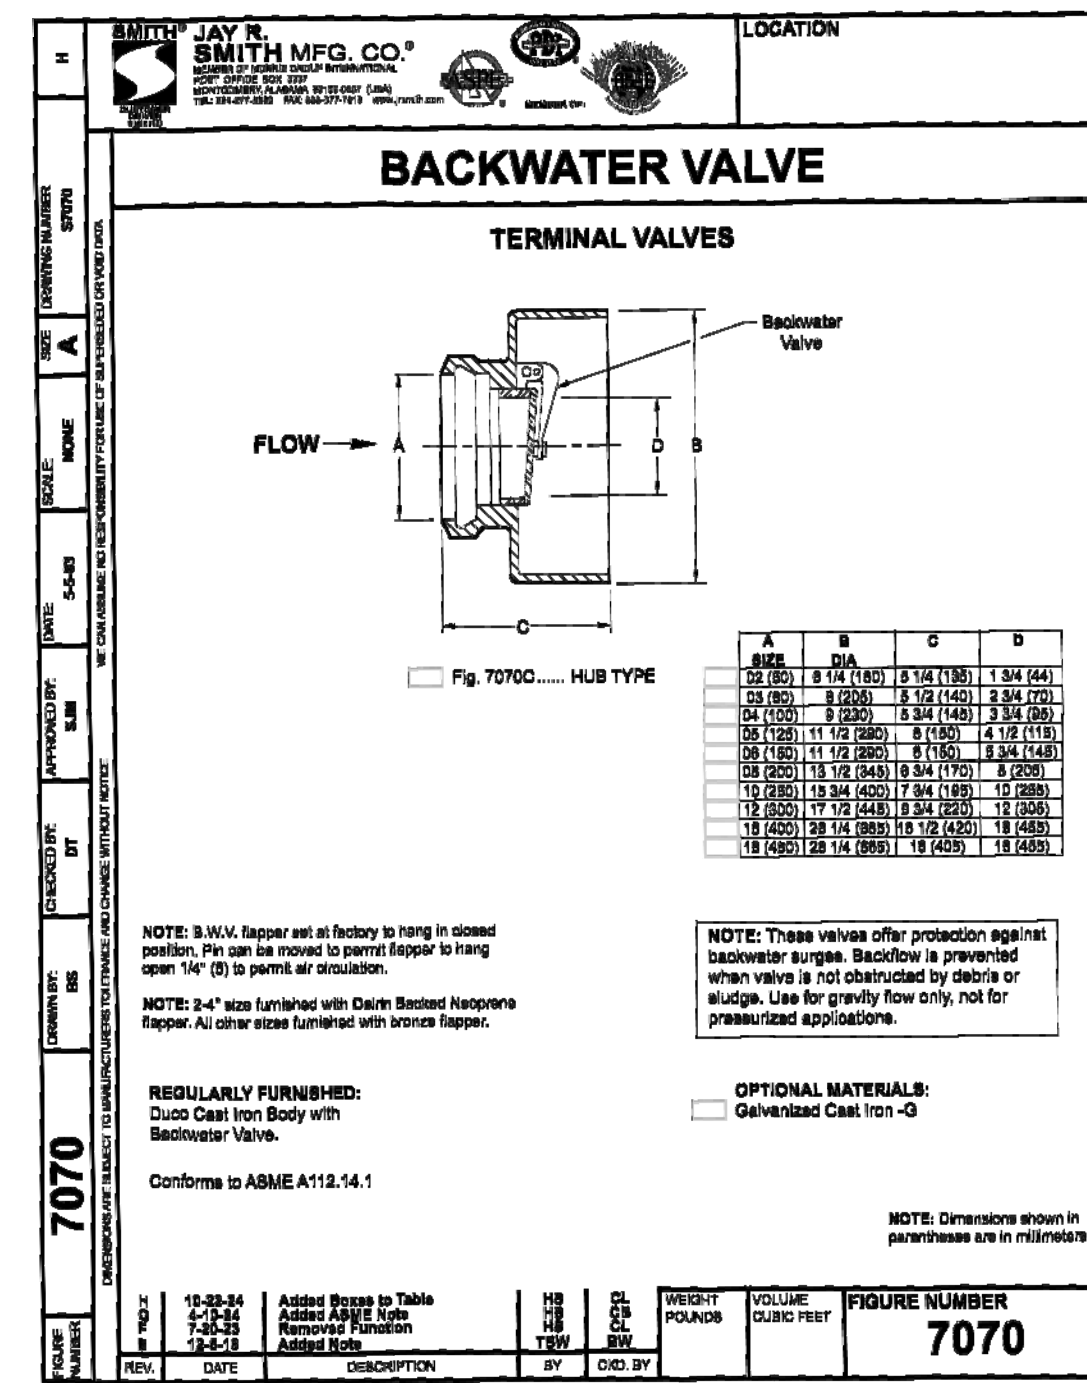

FLOODPLAIN:
 ACCORDING TO F.I.R.M. MAP NO. 48201C0420P (COMMUNITY-PANEL NO. 4802870420P), MAP REVISED DATE: NOVEMBER 15, 2019. THE SUBJECT PROPERTY LIES WITHIN THE AREAS DESIGNATED AS ZONE "X" UNSHADED. DETERMINED TO BE OUTSIDE THE 0.2% ANNUAL CHANCE FLOOD. ZONE "X" SHADED. AREAS OF 0.2% ANNUAL CHANCE FLOOD; AREAS OF 1% ANNUAL CHANCE FLOOD WITH AVERAGE DEPTHS OF LESS THAN 1 FOOT OR WITH DRAINAGE AREAS LESS THAN 1 SQUARE MILE; AREAS PROTECTED BY LEVEES FROM 1% ANNUAL CHANCE FLOOD. AND ZONE "AE". BASE FLOOD ELEVATIONS DETERMINED.

REFERENCE BENCHMARK:
 RM 200250 - BRASS DISK STAMPED "U106 BMO4" ON DOWNSTREAM SIDE OF BRIDGE ON STATE HIGHWAY 6 OVER HORSEPEN CREEK AT STREAM CENTERLINE IN THE ADDICKS RESERVOIR WATERSHED IN KEY MAP 408J NEAR STREAM U106-00-00.
 ELEVATION = 122.07' (NAVD 88, 2001 ADJ.)

TEMPORARY BENCHMARKS:
 TBM "B" - BOX CUT ON CONCRETE BASE OF LIGHT STANDARD LOCATED IN THE MEDIAN OF THE PARKING LOT TO THE MAIN ENTRANCE OF THE SCHOOL BUILDING ±48' SOUTHWEST OF THE SOUTHWESTERLY R.O.W. LINE OF WILLOW RIVER DRIVE.
 ELEVATION = 125.70'
 TBM "D" - COTTON SPINDLE WITH SHINER STAMPED "WEST BELT SURVEYING" IN POWER POLE LOCATED ±32' SOUTH OF THE SOUTH CORNER OF THE BRICK BUILDING AT THE NORTHERLY END OF THE FOOTBALL FIELD.
 ELEVATION = 124.23'
 TBM "E" - BOX CUT ON CONCRETE LIGHT STANDARD BASE LOCATED ±175' SOUTHWEST FROM THE INTERSECTION OF WILLOW RIVER DRIVE AND NORTHWESTERLY ENTRANCE TO SITE.
 ELEVATION=126.88'
 TBM "G" - BOX CUT ON CONCRETE BASE OF LIGHT STANDARD LOCATED AT THE NORTHWESTERLY END OF THE DIRT TRACK.
 ELEVATION = 124.03'
 TBM "H" - BOX CUT ON CONCRETE BASE OF LIGHT STANDARD LOCATED ±48' NORTHWEST FROM THE NORTHWEST CORNER OF PRESS BOX.
 ELEVATION=124.03'
 TBM "I" - BOX CUT ON SOUTH CORNER OF CONCRETE SIDEWALK ON THE SOUTHWEST SIDE OF TRACK.
 ELEVATION=123.42'

- LEGEND:**
- PROPOSED MANHOLE
 - PROPOSED MANHOLE W/GRATE TOP
 - PROPOSED GRATE/CURB INLET
 - DIRECTION OF FLOW
 - FL FLOW LINE
 - C.O. PROPOSED CLEANOUT
 - ① PROP. 4" STM. SWR. @ 1.00% MIN.
 - ② PROP. 6" STM. SWR. @ 1.00% MIN.

NOTES TO CONTRACTOR:

1. ALL UNDERGROUND UTILITIES SHOWN ARE NOT GUARANTEED TO BE COMPLETE OR DEFINITE, BUT WERE OBTAINED FROM THE BEST INFORMATION AVAILABLE.
2. THE LOCATION OF ALL UNDERGROUND UTILITIES PRESENTED ON THESE DRAWINGS ARE SHOWN IN AN APPROXIMATE WAY ONLY. THE CONTRACTOR SHALL DETERMINE THE EXACT LOCATION BEFORE COMMENCING ANY WORK. CONTRACTOR IS FULLY RESPONSIBLE FOR ANY AND ALL DAMAGES CAUSED BY HIS FAILURE TO EXACTLY LOCATE AND PRESERVE THESE UNDERGROUND UTILITIES (SEE NOTE 6 GENERAL CONSTRUCTION NOTES).
3. CONTRACTOR SHALL VERIFY ALL UNDERGROUND UTILITIES (PRIVATE OR PUBLIC) IN THE FIELD PRIOR TO CONSTRUCTION. IF A CONFLICT IS DISCOVERED, CONTRACTOR SHALL NOTIFY THE ENGINEER IMMEDIATELY.


UTILITY ONE CALL
 CONTRACTOR TO CALL BEFORE DIGGING !!!
 PHONE: HOUSTON (713) 223-4567 (STATENWIDE OUTSIDE HOUSTON) 1-800-545-6000



VLK Architects
 20445 State Hwy 249, Suite 350
 Houston, Texas 77070
 Main Phone: 281.671.2300
 www.vlkarchitects.com

Brooks & Sparks, Inc.
 21020 Park Row Dr.
 Katy, Texas 77449
 Main Phone: 281.578.9595
 www.brooksandsparks.com

Issue for Proposal

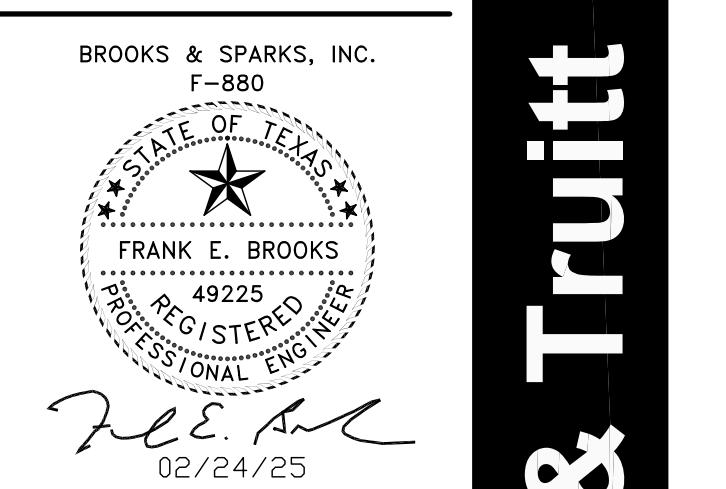

ISSUED: February 24, 2025

Revision No. 1 Addendum#1 03-06-25

Director Drawn By
 Designer Quality Control
 JW GL
 Proj. Arch.

2901.00

GRADING PLAN (SHEET 1 OF 2)

C23.01

2024 Cook, Labay & Truitt MS Renovations

CYPRUS-FAIRBANKS INDEPENDENT SCHOOL DISTRICT HOUSTON, TEXAS



VLK ARCHITECTS

VLK Architects
20445 State Hwy 249, Suite 350
Houston, Texas 77070
Main Phone: 281.671.2300
www.vlkarchitects.com

Brooks & Sparks, Inc.
21020 Park Row Dr.
Katy, Texas 77449
Main Phone: 281.578.9595
www.brooksandsparks.com

FLOODPLAIN:
ACCORDING TO F.I.R.M. MAP NO. 48201C0420P (COMMUNITY-PANEL NO. 4802870420P), MAP REVISED DATE: NOVEMBER 15, 2019, THE SUBJECT PROPERTY LIES WITHIN THE AREAS DESIGNATED AS ZONE "X" UNSHADED. DETERMINED TO BE OUTSIDE THE 0.2% ANNUAL CHANCE FLOOD, ZONE "X" SHADED, AREAS OF 0.2% ANNUAL CHANCE FLOOD; AREAS OF 1% ANNUAL CHANCE FLOOD WITH AVERAGE DEPTHS OF LESS THAN 1 FOOT OR WITH DRAINAGE AREAS LESS THAN 1 SQUARE MILE; AREAS PROTECTED BY LEVEES FROM 1% ANNUAL CHANCE FLOOD, AND ZONE "AE". BASE FLOOD ELEVATIONS DETERMINED.

REFERENCE BENCHMARK:
RM 200250 - BRASS DISK STAMPED "U106 8M04" ON DOWNSTREAM SIDE OF BRIDGE ON STATE HIGHWAY 6 OVER HORSEPEN CREEK AT STREAM CENTERLINE IN THE ADDICKS RESERVOIR WATERSHED IN KEY MAP 405J NEAR STREAM U106-00-00.
ELEVATION = 122.07' (NAVD 88, 2001 ADJ.)

TEMPORARY BENCHMARKS:
TBM "B" - BOX CUT ON CONCRETE BASE OF LIGHT STANDARD LOCATED IN THE MEDIAN OF THE PARKING LOT TO THE MAIN ENTRANCE OF THE SCHOOL BUILDING ±48' SOUTHWEST OF THE SOUTHWESTERLY R.O.W. LINE OF WILLOW RIVER DRIVE.
ELEVATION = 125.70'
TBM "D" - COTTON SPINDLE WITH SHINER STAMPED "WEST BELT SURVEYING" IN POWER POLE LOCATED ±32' SOUTH OF THE SOUTH CORNER OF THE BRICK BUILDING AT THE NORTHERLY END OF THE FOOTBALL FIELD.
ELEVATION = 124.23'

TBM "E" - BOX CUT ON CONCRETE LIGHT STANDARD BASE LOCATED ±175' SOUTHWEST FROM THE INTERSECTION OF WILLOW RIVER DRIVE AND NORTHWESTERLY ENTRANCE TO SITE.
ELEVATION = 126.85'

TBM "G" - BOX CUT ON CONCRETE BASE OF LIGHT STANDARD LOCATED AT THE NORTHWESTERLY END OF THE DIRT TRACK.
ELEVATION = 124.03'

TBM "H" - BOX CUT ON CONCRETE BASE OF LIGHT STANDARD LOCATED ±48' NORTHWEST FROM THE NORTHWEST CORNER OF PRESS BOX.
ELEVATION = 124.03'

TBM "I" - BOX CUT ON SOUTH CORNER OF CONCRETE SIDEWALK ON THE SOUTHWEST SIDE OF TRACK.
ELEVATION = 123.42'

LEGEND:

- SAWED JOINT
- EXPANSION JOINT
- AREA OF PROPOSED PAVEMENT AND SIDEWALK JOINT SEALANT REPLACEMENT
- 7" REINFORCED CONCRETE PAVEMENT
- 4 1/2" REINFORCED CONCRETE SIDEWALK

NOTES:

- LOCATE EXPANSION JOINTS AS SHOWN. SAWED JOINTS SHALL BE SPACED EVENLY BETWEEN EXPANSION JOINTS AT 15' MAXIMUM SPACING.
- ALL CURBS TO BE 6" UNLESS OTHERWISE NOTED.
- LINE UP JOINTS IN SIDEWALK W/ JOINTS IN PARKING LOT.
- INSTALL EXPANSION JOINTS IN ALL DRIVEWAYS AT ROW LINE.
- SEE ARCHITECT'S PLANS FOR WHEELSTOP LOCATIONS AND SIDEWALK JOINTING.

KEY NOTES:

- CONTRACTOR TO REMOVE AND REPLACE EXISTING JOINT SEALANT THROUGHOUT SITE (PAVEMENT AND SIDEWALK). IN AREAS WHERE EXPANSION JOINT IS ROTTED OUT CONTRACTOR TO PROVIDE BACKER ROD PRIOR TO JOINT SEALANT REPLACEMENT (SEE DETAIL THIS SHEET).
- CONTRACTOR TO DRILL 9" INTO EXISTING CONCRETE AND EMBED 18" LONG #5 BAR @ 18" (EPOXYED IN PLACE) LEAVING 9" OF EXPOSED #5 BAR TO FACILITATE THE CONNECTION TO NEW PAVEMENT.
- CONTRACTOR TO INSTALL 6" REINFORCED CONCRETE PAVEMENT AT BASE OF BOTTOM OF PROPOSED RAMP WITHIN EXISTING CONCRETE DRIVE.

NOTES TO CONTRACTOR:

- ALL UNDERGROUND UTILITIES SHOWN ARE NOT GUARANTEED TO BE COMPLETE OR DEFINITE, BUT WERE OBTAINED FROM THE BEST INFORMATION AVAILABLE.
- THE LOCATION OF ALL UNDERGROUND UTILITIES PRESENTED ON THESE DRAWINGS ARE SHOWN IN AN APPROXIMATE WAY ONLY. THE CONTRACTOR SHALL DETERMINE THE EXACT LOCATION BEFORE COMMENCING ANY WORK. CONTRACTOR IS FULLY RESPONSIBLE FOR ANY AND ALL DAMAGES CAUSED BY HIS FAILURE TO EXACTLY LOCATE AND PRESERVE THESE UNDERGROUND UTILITIES (SEE NOTE 6 GENERAL CONSTRUCTION NOTES).
- CONTRACTOR SHALL VERIFY ALL UNDERGROUND UTILITIES (PRIVATE OR PUBLIC) IN THE FIELD PRIOR TO CONSTRUCTION. IF A CONFLICT IS DISCOVERED, CONTRACTOR SHALL NOTIFY THE ENGINEER IMMEDIATELY.

UTILITY ONE CALL

CONTRACTOR TO CALL BEFORE DIGGING !!!
PHONE: HOUSTON (713) 223-4567 (STATEWIDE OUTSIDE HOUSTON) 1-(800)-545-6005



Issue for Proposal

BROOKS & SPARKS, INC.
F-880



ISSUED: February 24, 2025

Revision No. 1 Addendum#1 03-06-25



Director Drawn By
Designer Quality Control
JW GL
Proj. Arch.

2901.00


PAVING AND JOINT PLAN

C25.01

2024 Cook, Labay & Truitt MS Renovations

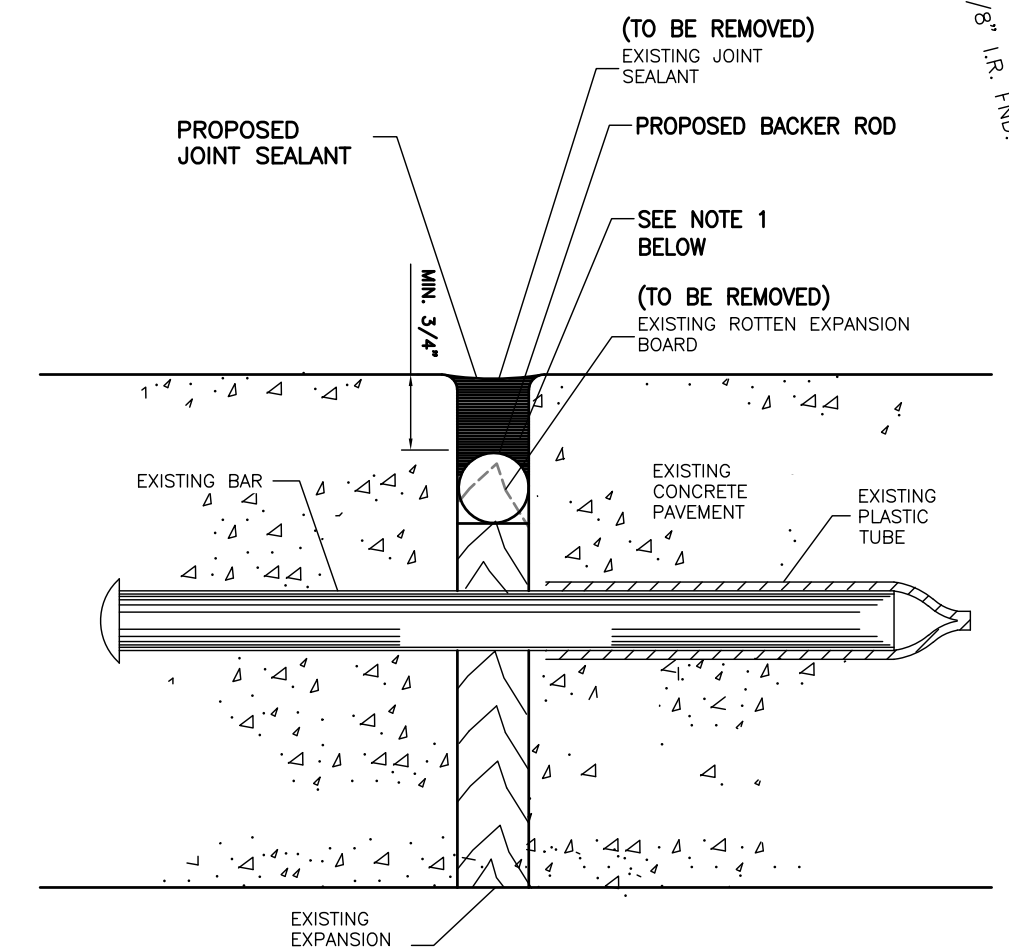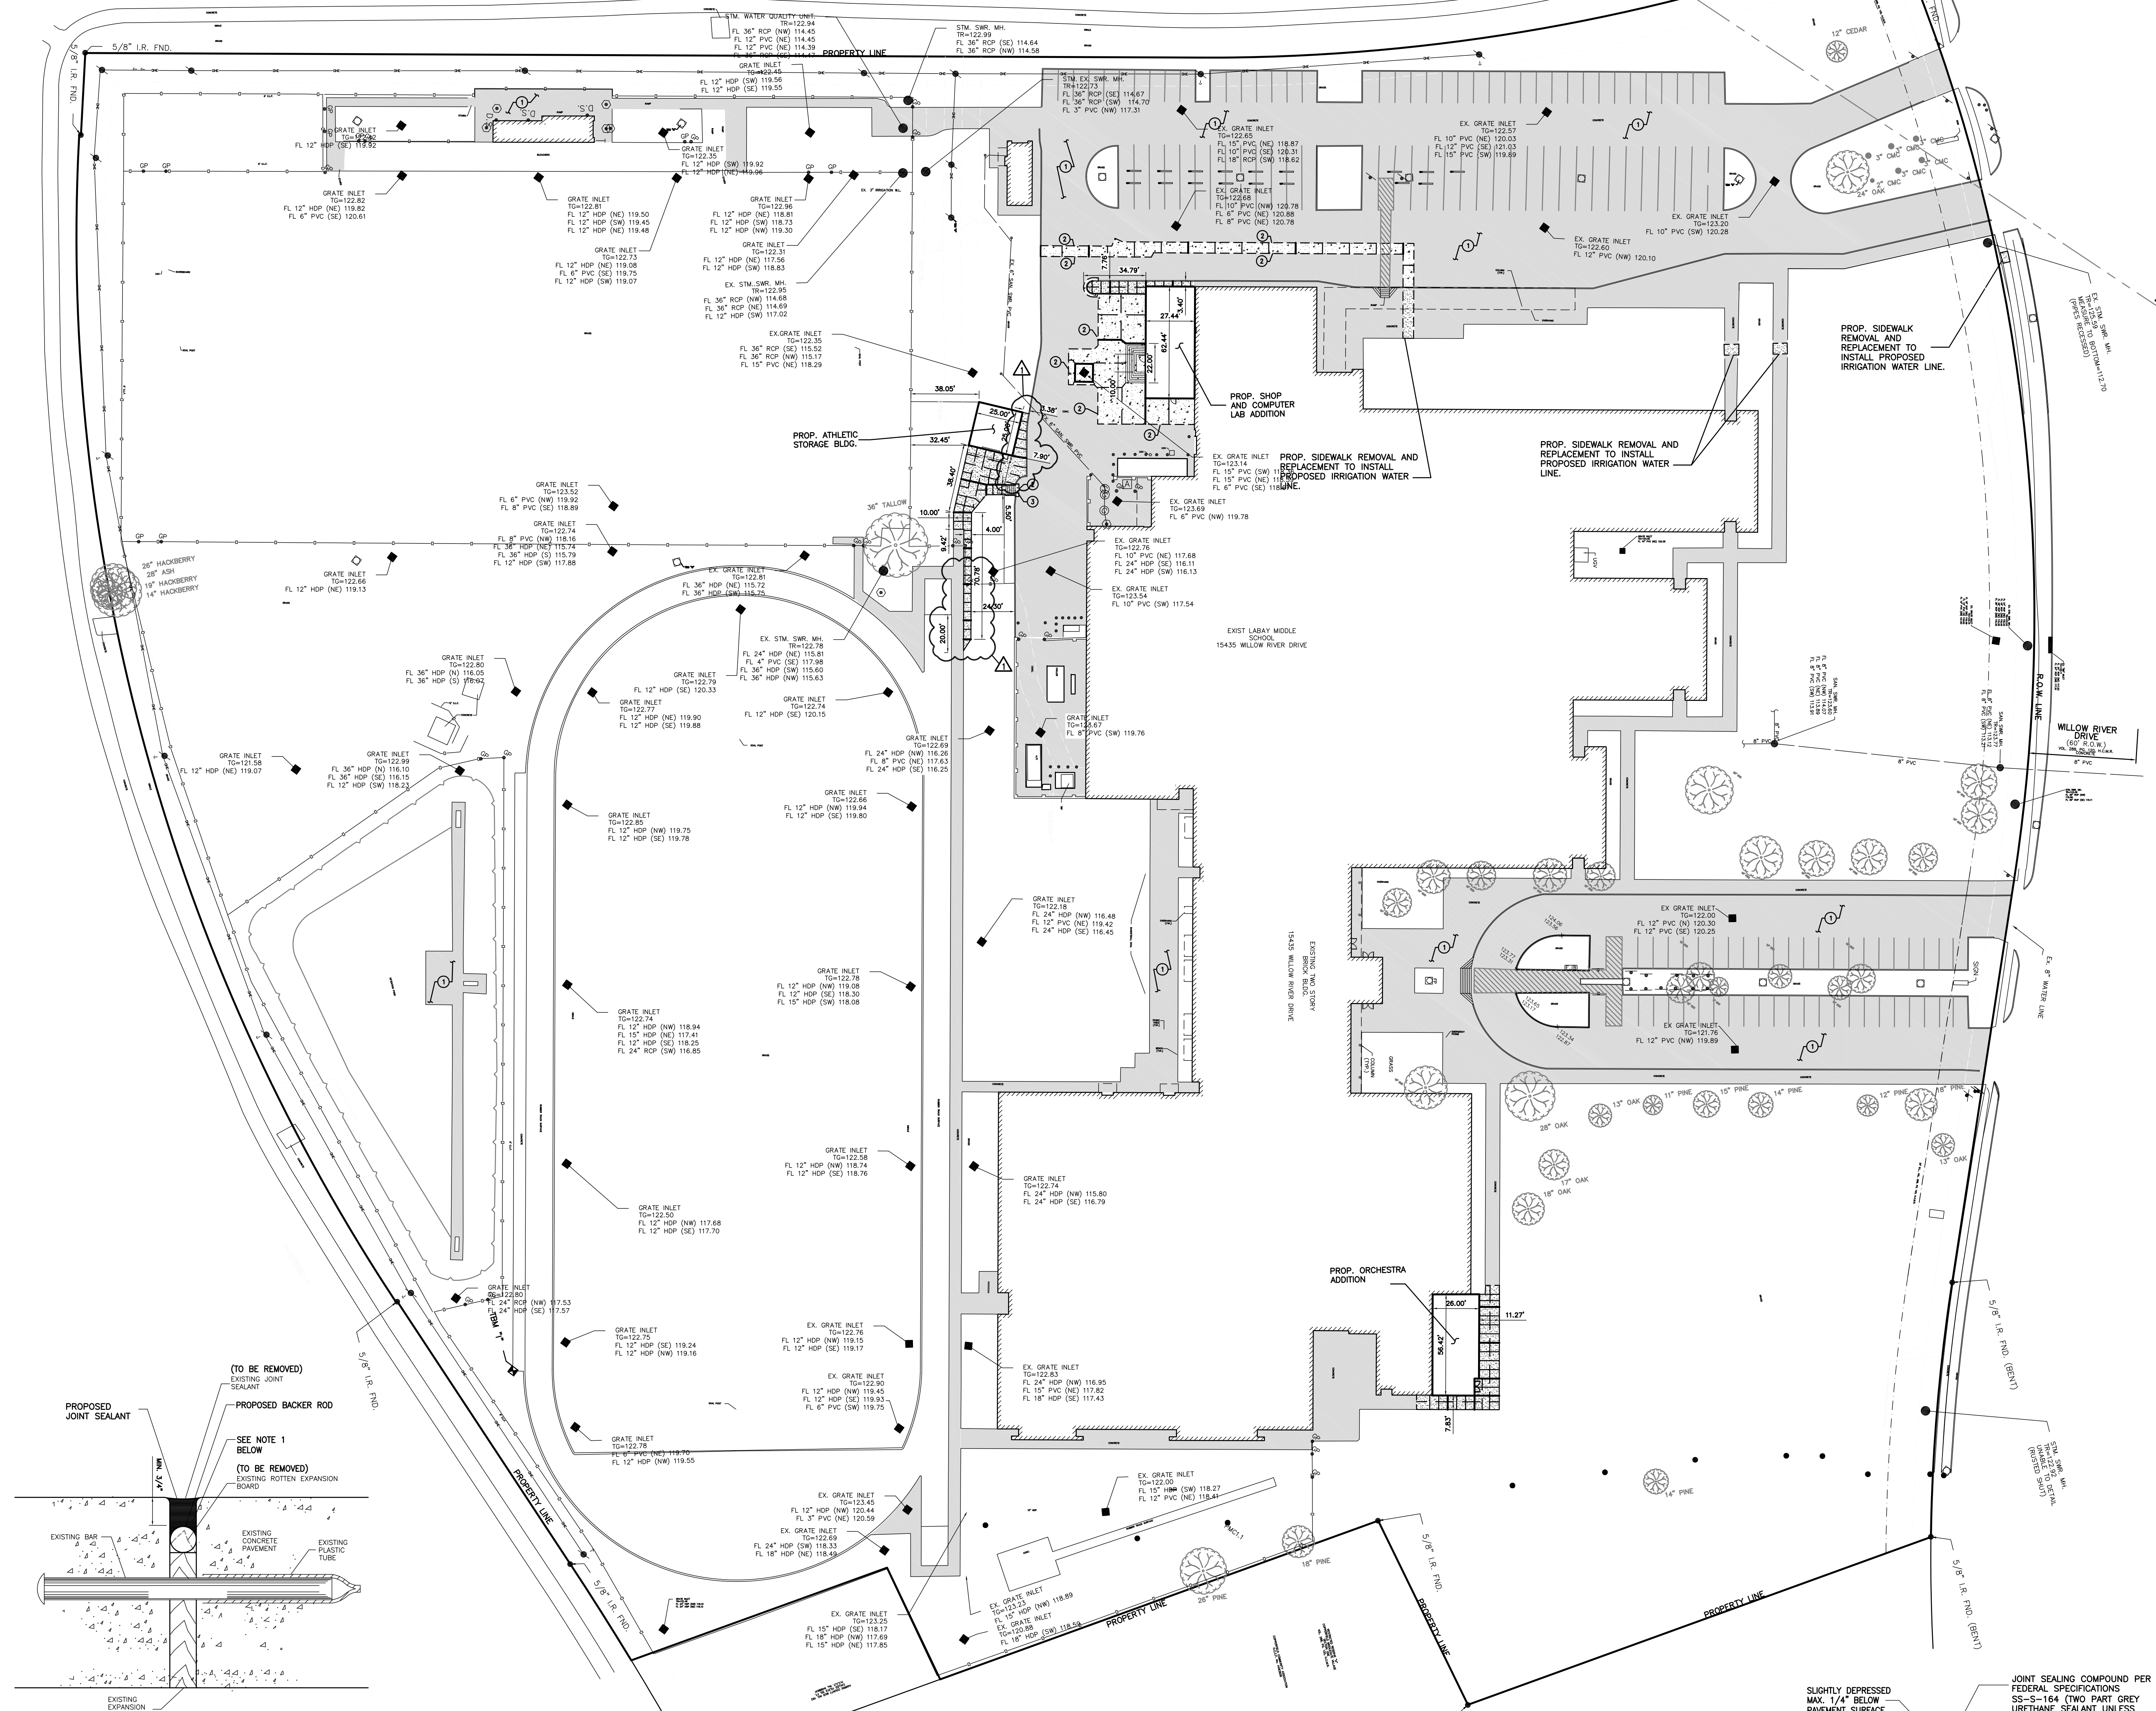

PAVING JOINT SEALANT REPLACEMENT AT EXISTING EXPANSION JOINTS
N.T.S.

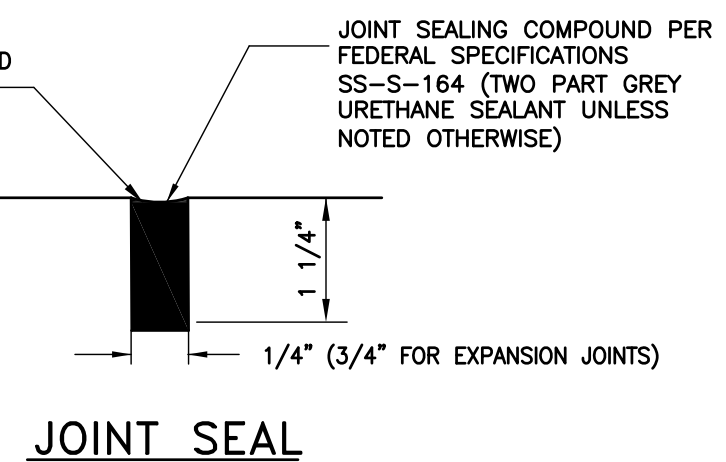


04 Mar 2025 3:25PM Greg
F:\project\BROOK_SP_VLK\8550054 Labay Middle School\G\1\25.01_8550054_PAVING_JOINT_PLAN.dwg
Includes Xref(s): XTDP.dwg; Xst.dwg; X-TB.dwg; Xuti.dwg; X-Seal.dwg

2024 Cook, Labay & Truitt MS Renovations

CYPRESS-FAIRBANKS INDEPENDENT SCHOOL DISTRICT

HOUSTON, TEXAS

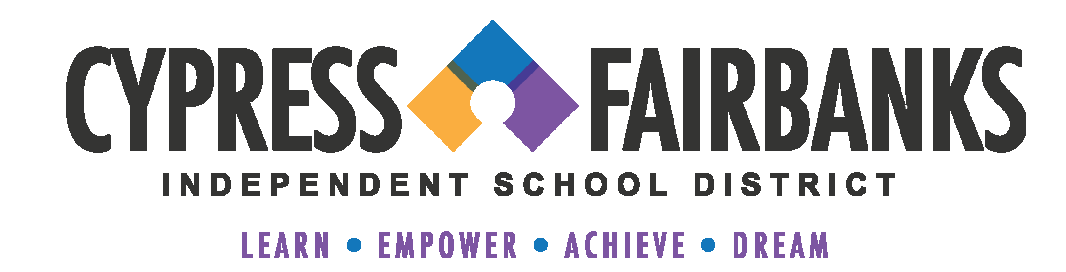

CYPRESS-FAIRBANKS INDEPENDENT SCHOOL DISTRICT HOUSTON, TEXAS

ARCHITECT

VLK Architects
20445 State Hwy 249, Suite 350
Houston, Texas 77070
Main Phone: 281.671.2300
www.vlkarchitects.com

CIVIL ENGINEER

Brooks & Sparks, Inc.
21020 Plank Row Blvd.
Katy, TX 77449
Main Phone: 281.578.9595
www.brooksandsparks.com

LANDSCAPE / IRRIGATION

Westwood
20329 State Hwy 249, #350
Houston, TX 77070
Main Phone: (281) 883-0103
www.westwoodps.com

STRUCTURAL ENGINEER

Dunaway
3200 Wilcrest Dr. Ste 4400
Houston, TX 77042
Main Phone: 512.306.8252
www.dunaway.com

M.E.P. ENGINEER

Salas O'Brien
10930 W Sam Houston Pkwy N #900
Houston, TX 77064
Main Phone: 281.664.1900
www.salasobrien.com

ACOUSTICAL / THEATRICAL

W.J.H.W.
3424 Midcourt Rd. Suite 124
Carrollton, TX 75006
Main Phone: 210.561.9800
www.wjhw.com



ISSUED: February 24, 2025

REVISIONS

Revision No.	Revision Date
1 Addendum 1	03-06-2025

Director	Drawn By
RSJ	-
Designer	Quality Control
-	-
Proj. Arch.	
RS	

PROJECT NO.

24-010.00

SHEET TITLE

COVER - COOK MS

SHEET NO.

G10.01

2024 Cook, Labay & Truitt MS Renovations

VOLUME 1

COOK MIDDLE SCHOOL

BOARD OF TRUSTEES

SCOTT HENRY	PRESIDENT
DR. NATALIE BLASINGAME	VICE PRESIDENT
JUSTIN RAY	SECRETARY
TODD LECOMPTE	TRUSTEE
JULIE HINAMAN	TRUSTEE
CHRISTINE KALMBACH	TRUSTEE
LUCAS H. SCANLON	TRUSTEE

ADMINISTRATION

DOUGLAS KILLIAN, ED.D.	SUPERINTENDENT OF SCHOOLS
TERESA HULL	CHIEF OF STAFF
MATT MORGAN	CHIEF OF OPERATION OFFICER
LINDA MACIAS, ED.D.	CHIEF ACADEMIC OFFICER
DEBORAH STEWART, ED.D.	CHIEF OF EMPLOYEE & STUDENT SERVICES
KAREN SMITH	CHIEF FINANCIAL OFFICER
CHRISTINA COLE	CHIEF OFFICER FOR SCHOOL LEADERSHIP
MARNEY COLLINS-SIMS	GENERAL COUNCIL
JESSE CLAYBURN	ASSISTANT SUPERINTENDENT, FACILITIES AND CONSTRUCTION
DAN GROSZ	DIRECTOR OF DESIGN AND FACILITIES PLANNING
SHANNON THOMPSON	DIRECTOR OF PROJECT MANAGEMENT
STEVEN BRYAN	DIRECTOR OF CONSTRUCTION FIELD SERVICES
AMY HAYES	DIRECTOR OF CONTRACT MANAGEMENT

SCOPE OF WORK

SCOPE #	DESCRIPTION
1	Replace paint booth to meet district standards.
2	Renovate shop area with Classroom Addition.
3	Add 1,000 total to orchestra for the following: (1) Increase main classroom size to 1,600 SF (2) Add one Ensemble room 500 SF (3) Add one Practice room 100 SF.
4	Provide outside storage for football and track equipment.
5	Replace deteriorated sills (throughout school).
7	Strip, regrade, and resod existing competition football field with TIF-419 Bermuda.
8	Remove and replace all existing thru-wall with stainless steel (throughout school). Notable locations: Library and Reception area.
9	Provide handicap accessible exterior doors (throughout school).
10	Provide new cap sheet to existing MOD. BIT. roofing membrane.
11	Provide generator backed power for all racks in all telecommunications rooms.
12	Update cafeteria stage lighting, sound, A/V equipment and drapery packages.
13	Replace fire alarm (throughout school).
14	Provide sub-metering for kitchen cooling/heating and water usage.
15	Add dedicated HVAC unit to secondary telecommunications rooms (IDF).
18	Repair gas piping on roof. Remove surface rust and paint. Replace all gas valves on roof.
19	Replace all existing data cables to CAT 6A.
20	Additional card readers on exterior doors (throughout school).
21	Harden main front desk.
24	Additional lockdown buttons (throughout school).
25	Enhanced video intercoms.
26	Exterior window and door numbering.
29	Impact resistant glass on doors and high-traffic areas.
30	Upgrade classroom and exterior door hardware.

2024 Cook, Labay & Truitt MS Renovations

CYPRESS-FAIRBANKS INDEPENDENT SCHOOL DISTRICT

HOUSTON, TEXAS



ARCHITECT

VLK Architects
20445 State Hwy 249, Suite 350
Houston, Texas 77070
Main Phone: 281.671.2300
www.vlkarchitects.com

CIVIL ENGINEER

Brooks & Sparks, Inc.
21020 Park Row Blvd.
Katy, TX 77449
Main Phone: 281.578.9595
www.brooksandsparks.com

LANDSCAPE / IRRIGATION

Westwood
20529 State Hwy 249, #350
Houston, TX 77070
Main Phone: (281) 883-0103
www.westwoodps.com

STRUCTURAL ENGINEER

Dunaway
3200 Wilcrest Dr. Ste 4400
Houston, TX 77042
Main Phone: 512.306.8252
www.dunaway.com

M.E.P. ENGINEER

Salas O'Brien
10930 W Sam Houston Pkwy N #900
Houston, TX 77064
Main Phone: 281.664.1900
www.salasobrien.com

ACOUSTICAL / THEATRICAL

W.J.H.W.
3424 Midcourt Rd. Suite 124
Carrollton, TX 75006
Main Phone: 210.561.9800
www.wjhw.com

CYPRESS-FAIRBANKS INDEPENDENT SCHOOL DISTRICT HOUSTON, TEXAS

2024 Cook, Labay & Truitt MS Renovations



ISSUED: February 24, 2025

REVISIONS

Revision No.	Revision Date
1 Addendum 1	03-06-2025

Director
TL

Drawn By
STH

Designer
Quality Control

Proj. Arch.
RS

PROJECT NO.

24-010.00

SHEET TITLE

G10.02

PROJECT INFORMATION,
GENERAL NOTES,
ABBREVIATIONS, INDEX

SHEET NO.

G10.02

ABBREVIATIONS

ABBREVIATIONS	M (CONT.)
A ABOVE FINISH FLOOR	MOD BIT MODIFIED BITUMEN
A.C.T. ACOUSTICAL CEILING TILE	MULL. MULLION
ADDL. ADDITIONAL	M.E.P. MECHANICAL-ELECTRICAL-PLUMBING
A.B. AIR BARRIER	M.C.M. METAL COMPOSITE MATERIAL
A.C.M. ALUMINUM COMPOSITE PANEL	MIN. MINIMUM
A.D.A. AMERICANS WITH DISABILITIES ACT	MISC. MISCELLANEOUS
AL/ALUM. ALUMINUM	
APPROX. APPROXIMATE OR APPROXIMATELY	
ARCH. ARCHITECT OR ARCHITECTURAL	
B BOARD	
B.O.W. BOTTOM OF WALL	
B.U.R. BUILT-UP ROOFING	
BLDG. BUILDING	
C CENTER LINE	
C.R. CLASSROOM	
C.F.S. COLD-FORMED STEEL	
CONC. CONCRETE	
CMU CONCRETE MASONRY UNIT	
C.M. CONSTRUCTION MANAGER	
CONT. CONTINUOUS	
C.I. CONTINUOUS INSULATION	
C.J. CONTROL JOINT	
COORD. COORDINATE	
CORR. CORRIDOR	
D DIA. DIAMETER	
D.O. DOOR OPENING	
DN. DOWN	
DS. DOWNSPOUT	
E EA. EACH	
E.W. EACH WAY	
ELEC. ELECTRICAL	
E.W.C. ELECTRIC WATER COOLER	
ELEV. ELEVATION	
EQ. EQUAL	
EQUIP. EQUIPMENT	
EXIST. EXISTING	
E.J. EXPANSION JOINT	
EXT. EXTERIOR	
EIFS EXTERIOR INSULATION & FINISH SYSTEM	
F FT. FEET or FOOT	
F.R.P. FIBERGLASS REINFORCED PLASTIC	
F.V. FIELD-VERIFY	
FIN. FINISH	
F.F. FINISH FLOOR	
F.E. FIRE EXTINGUISHER	
F.E.C. FIRE EXTINGUISHER & CABINET	
F.H.C. FIRE HOSE CABINET	
F.H.C.S. FLAT-HEAD COUNTERSUNK	
FLR. FLOOR	
F.D. FLOOR DRAIN	
FLUOR. FLUORESCENT	
G/H GALV. GALVANIZED	
GA. GAGE	
G.C. GENERAL CONTRACTOR	
G.O. GLAZED OPENING	
GYP. GYPSUM	
HT. HEIGHT	
H.P. HIGH POINT	
H.M. HOLLOW METAL	
HORIZ. HORIZONTAL	
H.B. HORIZONTAL BLINDS	
H.D.G. HOT-DIP GALVANIZED	
HR. HOUR	
I/J/K I.D. INSIDE DIAMETER	
INSUL. INSULATION	
INT. INTERIOR	
I.B.C. INTERNATIONAL BUILDING CODE	
L LAVATORY	
L.L.V. LONG LEG HORIZONTAL	
L.L.V. LONG LEG VERTICAL	
L.P. LOW POINT	
L.V.T. LUXURY VINYL TILE	
M MFR. MANUFACTURER	
MFG. MANUFACTURING	
M.B. MARKER BOARD	
M.O. MASONRY OPENING	
MAX. MAXIMUM	
MECH. MECHANICAL	

MATERIAL INDICATIONS

EARTH	CERAMIC TILE
POROUS FILL	GLASS (LARGE SCALE)
CONCRETE/ GROUT	INSULATION (RIGID FOAM BOARD)
BRICK	INSULATION (EPS FOAM BOARD)
CMU (LARGE SCALE)	INSULATION (BATT/ BLANKET)
MARBLE	INSULATION (SEMI-RIGID BOARD)
METAL (LARGE SCALE)	WOOD, ROUGH (CONTINUOUS)
METAL (SMALL SCALE)	WOOD, FINISH (BLOCKING)
RESILIENT FLOORING	WOOD, FINISH
ACOUSTICAL TILE	PLYWOOD (LARGE SCALE)
TERRAZZO	FIBER CEMENT PANEL
PLASTER, SAND, GROUT	METAL LATH
	GYPSUM BOARD

SYMBOLS LEGEND

CLASSROOM ROOM NAME & NUMBER	LOUVER
DOOR NUMBER	KEYED NOTE
ALUMINUM-FRAMED GLAZED OPENING SYSTEM	NORTH ARROW
HOLLOW METAL-FRAMED GLAZED OPENING SYSTEM	HORIZONTAL BLINDS
PARTITION TYPE	INTERIOR ELEVATION
BUILDING ASSEMBLY TYPE	SECTION DETAIL
BUILDING ELEVATION	ACCESS CONTROL
BUILDING SECTION	DATUM ELEVATION
WALL SECTION	

INDEX OF DRAWINGS

GENERAL	LANDSCAPE - GENERAL	LANDSCAPE - COOK	CIVIL	ARCHITECTURAL - COOK
G10.01 COVER - COOK MS	L0.00 IRRIGATION NOTES	L1.00 COOK OVERALL IRRIGATION PLAN	Sv01 TOPOGRAPHIC SURVEY	A10.00 COOK - PROJECT PHASING
G10.02 PROJECT INFORMATION, GENERAL NOTES, ABBREVIATIONS, INDEX	L0.01 IRRIGATION DETAILS	L1.01 COOK IRRIGATION PLAN - BASE BID	C11.01 GENERAL NOTES	A10.01 COOK - LIFE SAFETY - LEVEL ONE
			C11.02 CIVIL SITE PLAN	A10.02 COOK - LIFE SAFETY - LEVEL TWO
			C11.03 DEMOLITION PLAN	A11.01 COOK - DEMOLITION SITE PLAN
			C11.04 FIRE ACCESS LINE LAYOUT	A11.11 COOK - ARCHITECTURAL SITE PLAN
			C12.01 GRADING PLAN (SHEET 1 OF 3)	A11.21 COOK - ENLARGED ARCHITECTURAL SITE PLANS & ACCESSORY BUILDING PLANS
			C12.02 GRADING PLAN (SHEET 2 OF 3)	A11.31 COOK - ARCHITECTURAL SITE PLAN DETAILS
			C12.03 GRADING PLAN (SHEET 3 OF 3)	A12.01 COOK - UNIT A DEMOLITION PLAN - LEVEL ONE
			C13.01 UTILITY PLAN (SHEET 1 OF 3)	A12.01B COOK - UNIT B DEMOLITION PLAN - LEVEL ONE
			C13.02 UTILITY PLAN (SHEET 2 OF 3)	A12.01C COOK - UNIT C DEMOLITION PLAN - LEVEL ONE
			C13.03 UTILITY PLAN (SHEET 3 OF 3)	A12.01D COOK - UNIT D DEMOLITION PLAN - LEVEL ONE
			C13.04 STORM WATER POLLUTION PREVENTION PLAN	A12.01D.1 COOK - UNIT D.1 DEMOLITION PLAN - LEVEL ONE
			C13.05 MITIGATION PLAN	A12.01D.2 COOK - UNIT D.2 DEMOLITION PLAN - LEVEL ONE
			C15.01 PAVING AND JOINTING PLAN	A12.02 COOK - ORIENTATION DEMOLITION PLAN - LEVEL TWO
			C17.00 PAVING DETAILS	A12.11 COOK - ORIENTATION FLOOR PLAN - LEVEL ONE
			C17.01 STORM SEWER DETAILS	A12.11A COOK - UNIT A FLOOR PLAN - LEVEL ONE
			C17.02 WATER LINE DETAILS	A12.11B COOK - UNIT B FLOOR PLAN - LEVEL ONE
			C17.03 STORM WATER POLLUTION PREVENTION DETAILS	A12.11C COOK - UNIT C FLOOR PLAN - LEVEL ONE
			C17.04 COMPETITION FIELD DETAILS	A12.11D COOK - UNIT D FLOOR PLAN - LEVEL ONE
			C17.05 STORM WATER QUALITY DETAIL	A12.12 COOK - ORIENTATION FLOOR PLAN - LEVEL TWO
				A12.21 COOK - PARTITION TYPES
				A12.22 COOK - PARTITION DETAILS
				A13.11 COOK - EXTERIOR ELEVATIONS & DETAILS
				A13.31 COOK - INTERIOR ELEVATIONS
				A14.10 COOK - BUILDING SECTIONS
				A14.20 COOK - WALL SECTIONS
				A14.30 COOK - BUILDING ASSEMBLY TYPES
				A14.31 COOK - BUILDING ASSEMBLY DETAILS
				A14.32 COOK - BUILDING ASSEMBLY DETAILS
				A15.01 COOK - ROOF DEMO PLAN


GENERAL NOTES

- Refer to the CODE-series sheets for Code Information, Design Criteria and Fire Protection Requirements.
- Verify and document existing dimensions and conditions at the site before beginning construction. Notify the Architect of conflicts or variations prior to commencement of construction.
- Based on the applicable design criteria, submit Shop Drawings of the proposed pattern of control joints in masonry veneer, CMU, gypsum board, plaster and stucco to the Architect for review and approval prior to construction.
- In case of discrepancies in or between the Contract Documents, the greater quantity or better quality shall be bid. Clarifications regarding the discrepancies shall be requested from the Architect prior to construction, and the resulting interpretations implemented in accordance with the Contract Documents.

PROJECT INFORMATION | COOK MS

PROJECT IDENTIFICATION	
PROJECT:	2024 COOK MS RENOVATIONS
OWNER:	CYPRESS-FAIRBANKS INDEPENDENT SCHOOL DISTRICT
PROJECT LOCATION: 9211 WHEATLAND DRIVE, HOUSTON, TX 77064	
LEGAL DESCRIPTION: TRS 1A 1A-13 & 3B WINSHESTER COUNTRY SCHOOL 10 ABST. 246 J. D. EGBERT	
VLK PROJECT NUMBER:	24-010.00
TDLR PROJECT REGISTRATION NUMBER:	TABS
APPROXIMATE BUILDING AREAS	
BUILDING DATA:	
Existing Building (Renovation):	199,947 sq. ft.
Building Addition:	2,548 sq. ft.
Grand Total Area of Work:	202,495 sq. ft.
BUILDING CONSTRUCTION INFORMATION	
TYPE OF CONSTRUCTION (TABLE 601 - IBC):	TYPE II-B
FIRE PROTECTION SYSTEM:	AUTOMATIC SPRINKLER SYSTEM THROUGHOUT

SITE LOCATION MAP

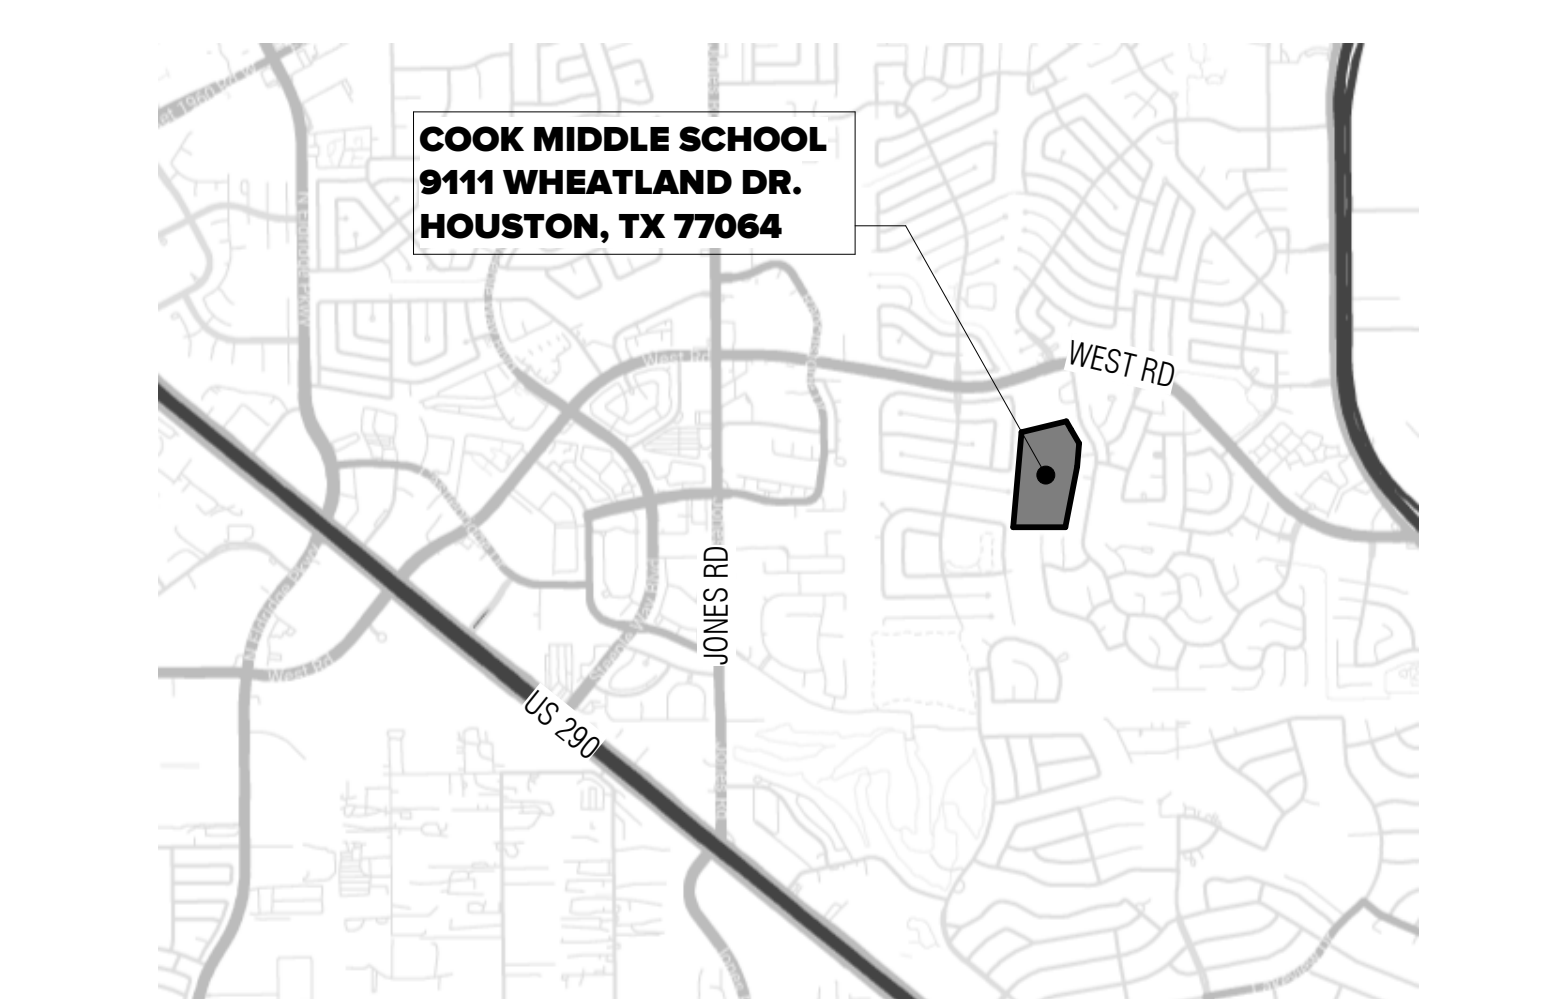

Theater - Cook	AV00.01 GENERAL NOTES AND LEGENDS
	AV00.91 AUDIO-VIDEO EQUIPMENT DETAILS
	AV12.11D.1 UNIT D.1 RENOVATION PLAN - LEVEL ONE
	AV16.11D.1 UNIT D.1 RENOVATION REFLECTED CEILING PLAN - LEVEL ONE
	AV17.01 ELEVATIONS
	AV111.00 AUDIO-VIDEO FUNCTIONAL LEGEND AND STANDARD DETAILS
	AV111.11 AUDIO-VIDEO FUNCTIONAL DIAGRAMS
	AV111.12 CAFETERIA DETAILS
	TL00.01 GENERAL NOTES AND LEGENDS
	TL12.11D.1 UNIT D.1 RENOVATION PLAN - LEVEL ONE
	TL12.12D.2 UNIT D.2 RENOVATION PLAN - LEVEL TWO
	TL16.00 CONTROL DETAILS & SCHEDULE
	TL16.01 DISTRIBUTION DETAILS & SCHEDULE
	TL116.01 THEATRICAL LIGHTING CONTROL RISER
	TR00.01 GENERAL NOTES AND LEGENDS
	TR12.11D.1 UNIT D.1 RENOVATION PLAN - LEVEL ONE
	TR17.00 SECTION
	TR17.01 SECTIONS
	TR117.01 THEATRICAL RIGGING RISER AND LOADING DIAGRAM

Professional seal and stamp area for the architect, including the State of Texas seal and project information.

1 BUILDING PLANNING & DESCRIPTION

Form for Building Planning & Description, including occupancy type (Single/Mixed), construction details, valuation, and permit information.

2 OCCUPANCY TYPE AND LOAD

Table showing Break Down Areas and Occupant Loads per Floor, with columns for Area Specific Use, Gross SF, Net SF, SF per Occ., and Design Occ.

3 MEANS OF EGRESS

Form for Means of Egress, including exit counts, stairway details, and travel distances.

4 FIRE PROTECTION & LIFE SAFETY SYS.

Form for Fire Protection & Life Safety Systems, covering fire alarm, extinguishing, and detection systems.

5 FIRE-RESISTANCE RATE CONSTRUCTION

Table for Fire-Resistance Rate Construction, detailing building elements, hours required, and UL or IBC standard used.

6 WATER SUPPLY (FOR FIREFIGHTING)

Form for Water Supply, including hydrant counts, flow rates, and water source information.

7 FIRE LANE ACCESS

Form for Fire Lane Access, detailing layout plans and access road specifications.

8 INTERIOR FINISH

Table for Interior Finish, showing occupancy groups, exit enclosures, and room specifications.

9 STORAGE: STANDARD

Form for Standard Storage, detailing product storage, shelving, and height requirements.

10 STORAGE: HIGH PILED

Form for High Piled Storage, including product types and storage methods.

11 HAZARDOUS MATERIALS

Form for Hazardous Materials, detailing material use, storage, and reporting requirements.

12 SPECIAL CONDITIONS

Form for Special Conditions, listing various building-specific requirements and approvals.

COMMENTS & NOTES

Section for project comments and notes.

A COPY OF THESE APPROVED CONSTRUCTION PLANS MUST BE KEPT AT PROJECT SITE FOR THE FINAL INSPECTION OF THE BUILDING

Form for Project Known As, including project name and acceptance information.

Reviewer's Signature Block and Certification section, including signatures and dates.

Form for Project Certification, including reviewer and engineer signatures.



HARRIS COUNTY (IFC & IBC 2021) FIRE CODE DESIGN AND COMPLIANCE REVIEW SHEET VERSION 9.0 (JAN 2025)

Table for Revisions and Fire Code Review, including columns for date, sheet number, description, and reviewer.

ARCHITECT

VLK Architects
 20445 State Hwy 249, Suite 350
 Houston, Texas 77070
 Main Phone: 281.671.2300
 www.vlkarhitects.com

CYPRESS-FAIRBANKS INDEPENDENT SCHOOL DISTRICT
 HOUSTON, TEXAS

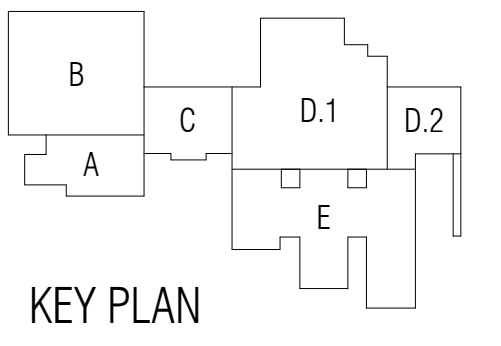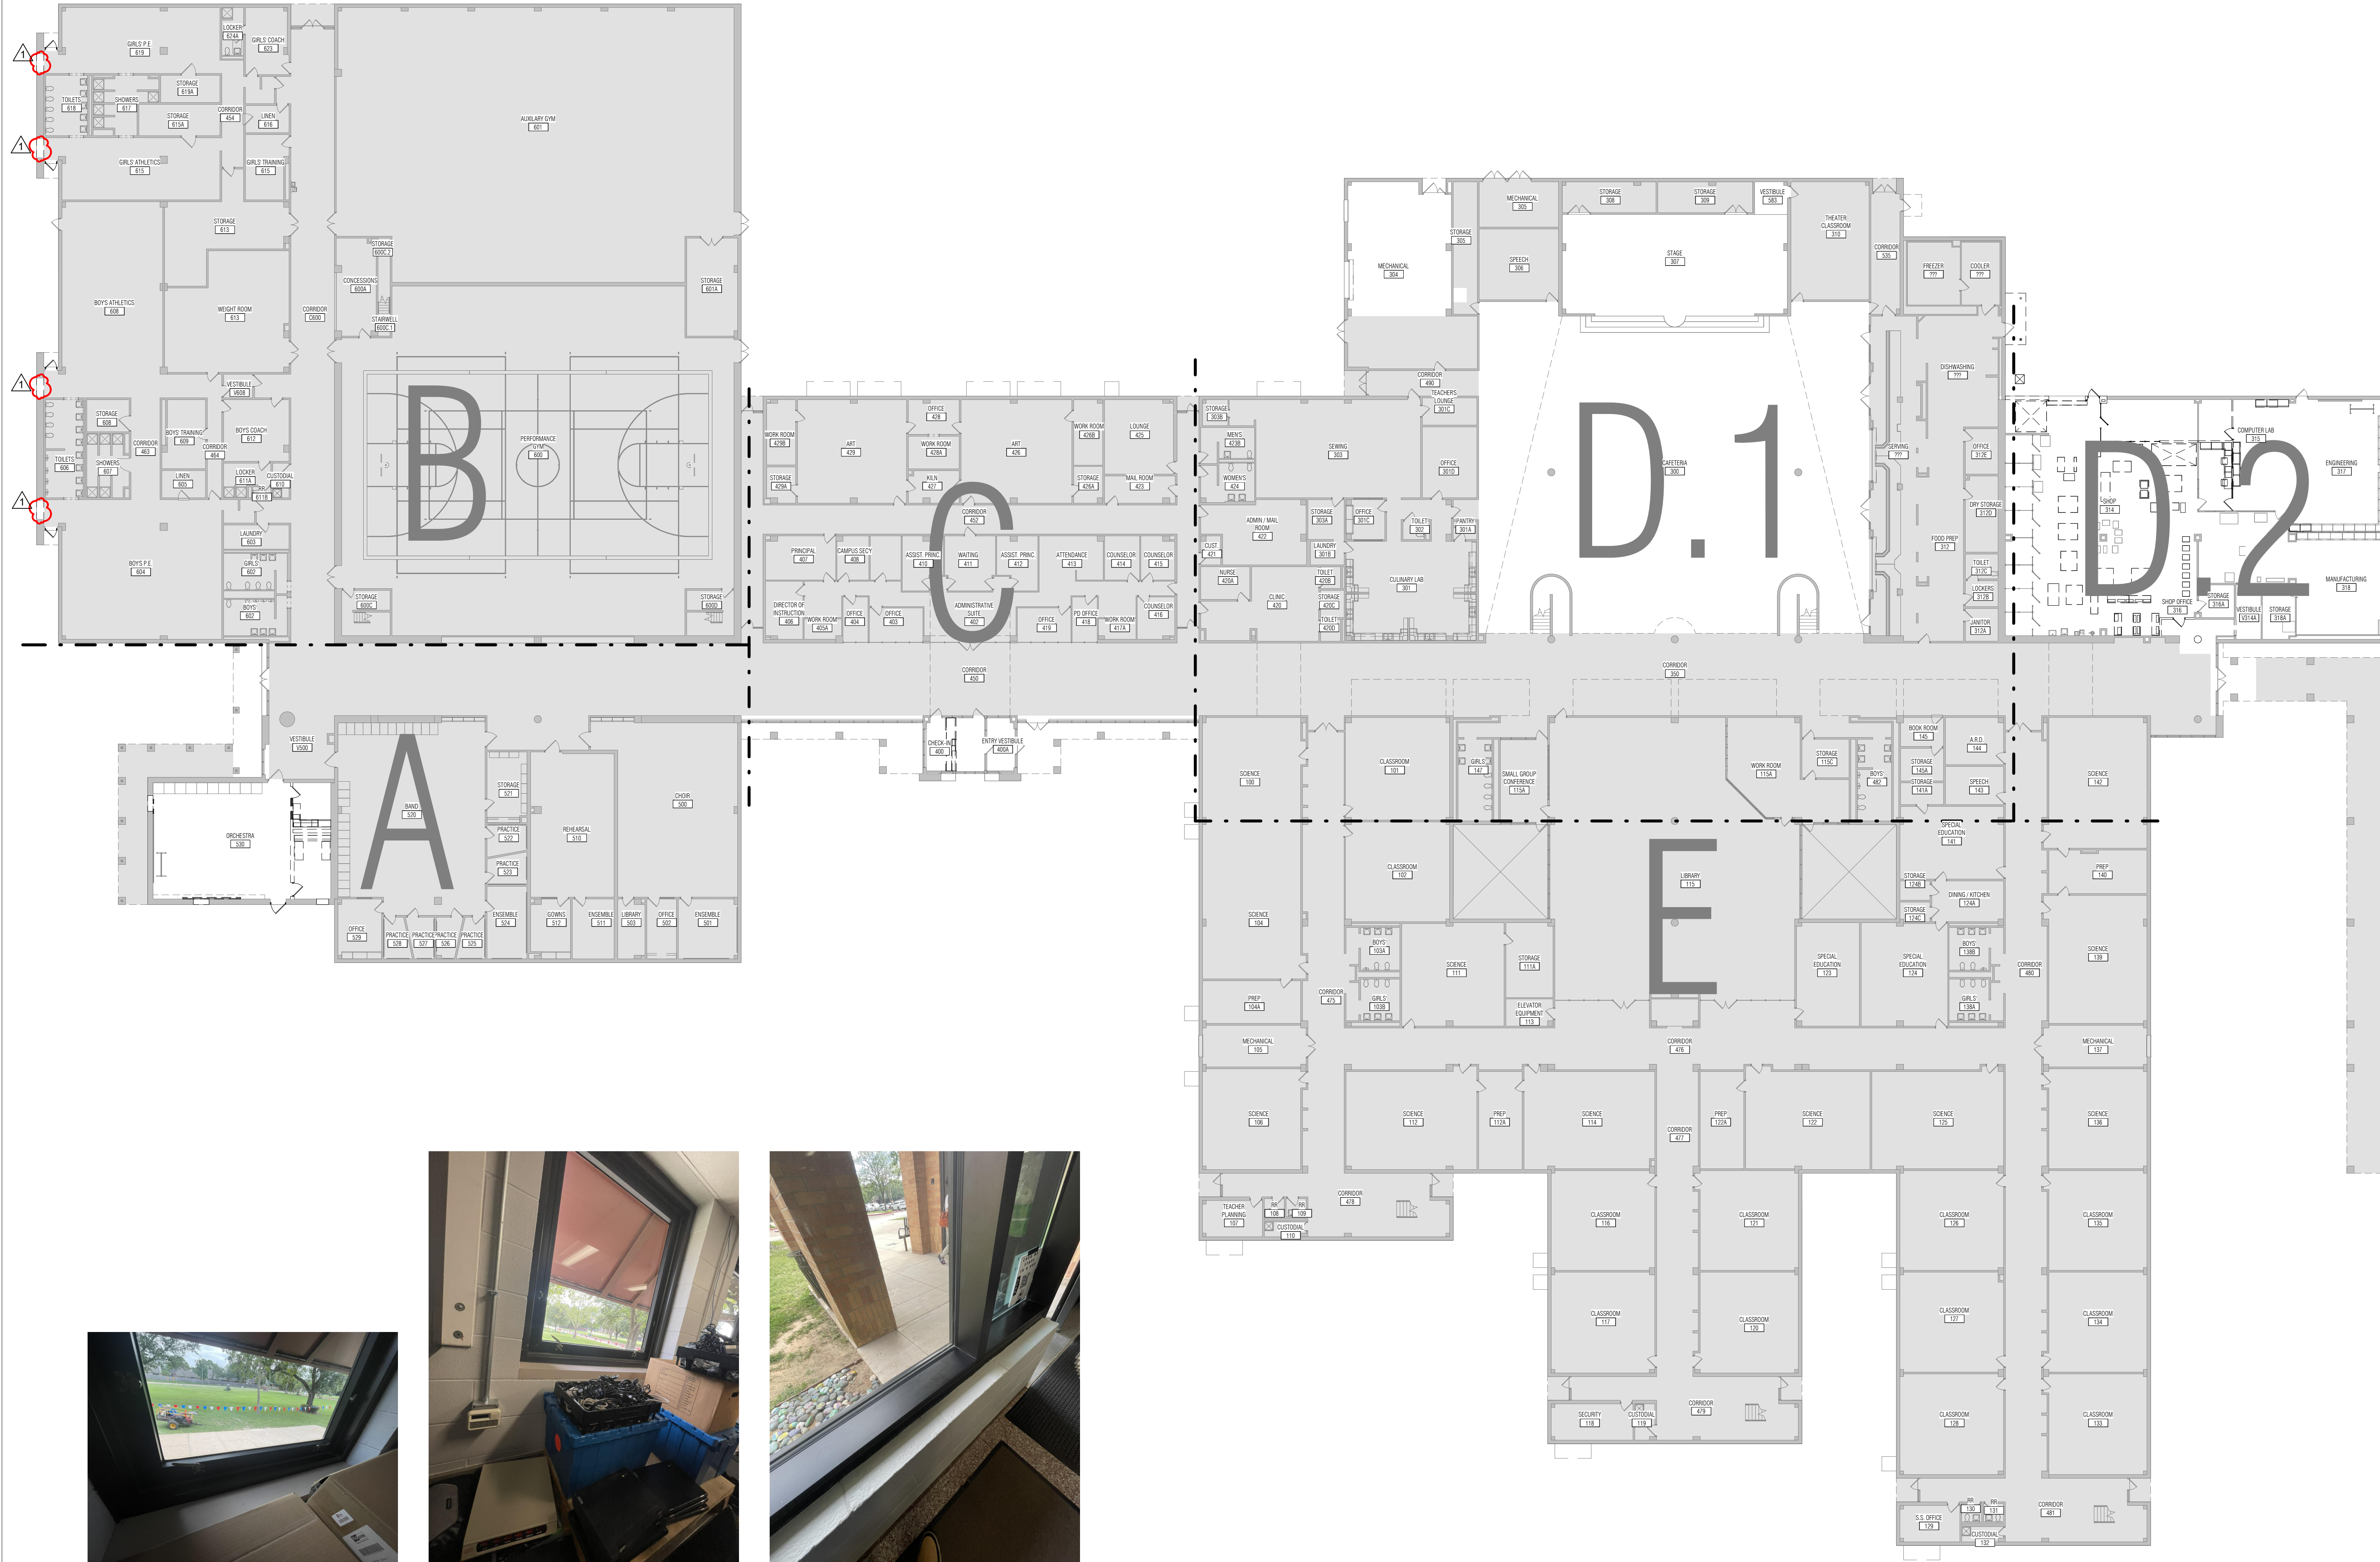

KEY PLAN



ISSUED: February 24, 2025

REVISIONS

Revision No.	Revision Date
1 Addendum 1	03-06-2025

Director: RSJ
 Designer: RSJ
 Drawn By: STH, KM
 Quality Control: STH, KM

Proj. Arch.: TQ

PROJECT NO.

24-010.00


SHEET TITLE

COOK - ORIENTATION
 DEMOLITION PLAN - LEVEL ONE


SHEET NO.

A12.01

2024 Cook, Labay & Truitt MS Renovations

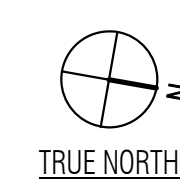

1 ORIENTATION DEMOLITION PLAN - LEVEL ONE
 SCALE: 3/64" = 1'-0"

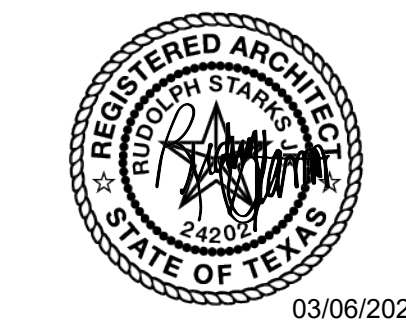

ISSUED: February 24, 2025

REVISIONS	
Revision No.	Revision Date
1 Addendum 1	03-06-2025

Director
 Approver
 Designer
 Designer
 Proj. Arch.
 Checker

Drawn By
 STH, KM
 Quality Control

PROJECT NO.
24-010.00

SHEET TITLE

COOK - UNIT A
 DEMOLITION PLAN - LEVEL ONE

SHEET NO.

A12.01A

GENERAL DEMOLITION NOTES


- Drawings show the general extent of demolition work, however it is impractical to indicate or note every item of demolition. Any items shown dashed are to be removed to make way for new construction, unless noted otherwise. Contractor shall notify Architect of any discrepancies between demolition and construction drawings prior to demolition.
- Removal of any asbestos containing materials within the area of work shall be included in the Contractor's scope. Refer to asbestos abatement report and requirements.
- Contractor shall protect existing items to remain from damage throughout all phases of the project. Contractor shall repair, at no cost to the owner, any damages they incur on the existing building and site not scheduled for alteration, as a result of construction activities. Contractor shall provide video documentation of existing conditions prior to start of construction and provide video to Architect.
- Contractor to notify Architect if items shown as existing to remain need to be removed to make way for new work. Contractor is responsible for removing said items, unless noted otherwise, including but not limited to: furniture, equipment, shelving, fixtures, utilities, etc. Contractor shall carefully remove, protect, and reinstall items back to their original positions and make all original connections, when work in the affected area is complete. Any item damaged as a result of construction activity shall be replaced at Contractor's expense. This note shall apply to all areas with construction activity.
- Refer to Civil, MEPT, and Structural drawings for additional demolition scope.
- Patch/repair ceilings, walls, and flooring to match existing at all removed or demolished doors, windows, walls, millwork, lockers, and similar items. Refer to SECTION 01 36 13 for additional information regarding patch and repair.

DEMOLITION LEGEND


- == == ITEMS TO BE DEMOLISHED
- Existing to remain with limited or no architectural work required in this area. Refer to civil, MEPT and structural drawings for any additional work in area.
- Major architectural work required in this area.

KEYNOTE LEGEND

- DD1 REMOVE AND PROPERLY DISPOSE OF DOOR, HARDWARE, AND FRAME. PREPARE AREA TO RECEIVE NEW CONSTRUCTION.
- DD4 CAREFULLY REMOVE AND PROTECT DOOR LEAF AND HARDWARE TO BE MOVED TO NEW LOCATION. PRESERVE EXISTING ROUGH OPENING TO RECEIVE NEW DOOR.
- MD1 REMOVE AND PROPERLY DISPOSE SHELF AND RODS. PREPARE AREA TO RECEIVE NEW CONSTRUCTIONS.
- MD2 REMOVE AND PROPERLY DISPOSE CASEWORK. PREPARE AREA FOR NEW CONSTRUCTION.
- MD5 REMOVE AND PROTECT INSTRUMENT STORAGE RACK. PREPARE FOR RELOCATION. RE: RESPECTIVE UNIT RENOVATION PLAN FOR NEW LOCATION.
- MD9 REMOVE AND PROTECT EXISTING MARKERBOARD/TACKBOARD PRIOR TO START OF CONSTRUCTION. RE: RESPECTIVE UNIT RENOVATION PLAN FOR NEW LOCATION.
- MD10 REMOVE AND PROPERLY DISPOSE OF EXISTING TROPHY SHELF. CLEAN PATCH AND PREPARE SURFACE FOR NEW CONSTRUCTION.
- MD11 REMOVE BOTTOM TWO ACOUSTIC PANELS IN PREPARATION FOR NEW DOOR IN THIS LOCATION.
- MD13 PROTECT EXISTING CASEWORK TO REMAIN. RE: GENERAL NOTE.
- MD19 CAREFULLY REMOVE STORE AND PROTECT ACOUSTIC PANELS. PREPARE AREA FOR NEW CONSTRUCTION.
- WD1 CAREFULLY REMOVE AND PROPERLY DISPOSE OF WALL AS SHOWN IN DASHED LINES. CLEAN AND PREPARE AREA FOR NEW CONSTRUCTION. CAP AND ABANDON ALL EXISTING UTILITIES IN WALL. RE: MEP DRAWINGS FOR ADDITIONAL INFORMATION.
- WD2 CAREFULLY REMOVE AND PROPERLY DISPOSE OF STOREFRONT SYSTEM. CLEAN AND PREPARE AREA FOR NEW CONSTRUCTION.
- WD7 PROTECT REMAINING WALL IN PLACE THROUGHOUT CONSTRUCTION. PATCH AND REPAIR TO LIKE NEW CONDITION.
- WD8 RELOCATE ALL UTILITIES IN THE AREA OF THE PROPOSED OPENINGS OR WALL REMOVAL AS IT APPLIES TO COMPLETE WORK. REF: MEP DRAWINGS FOR UTILITIES NOT SCHEDULED FOR REUSE.

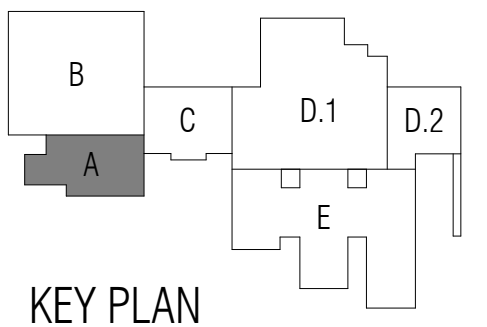

KEY PLAN

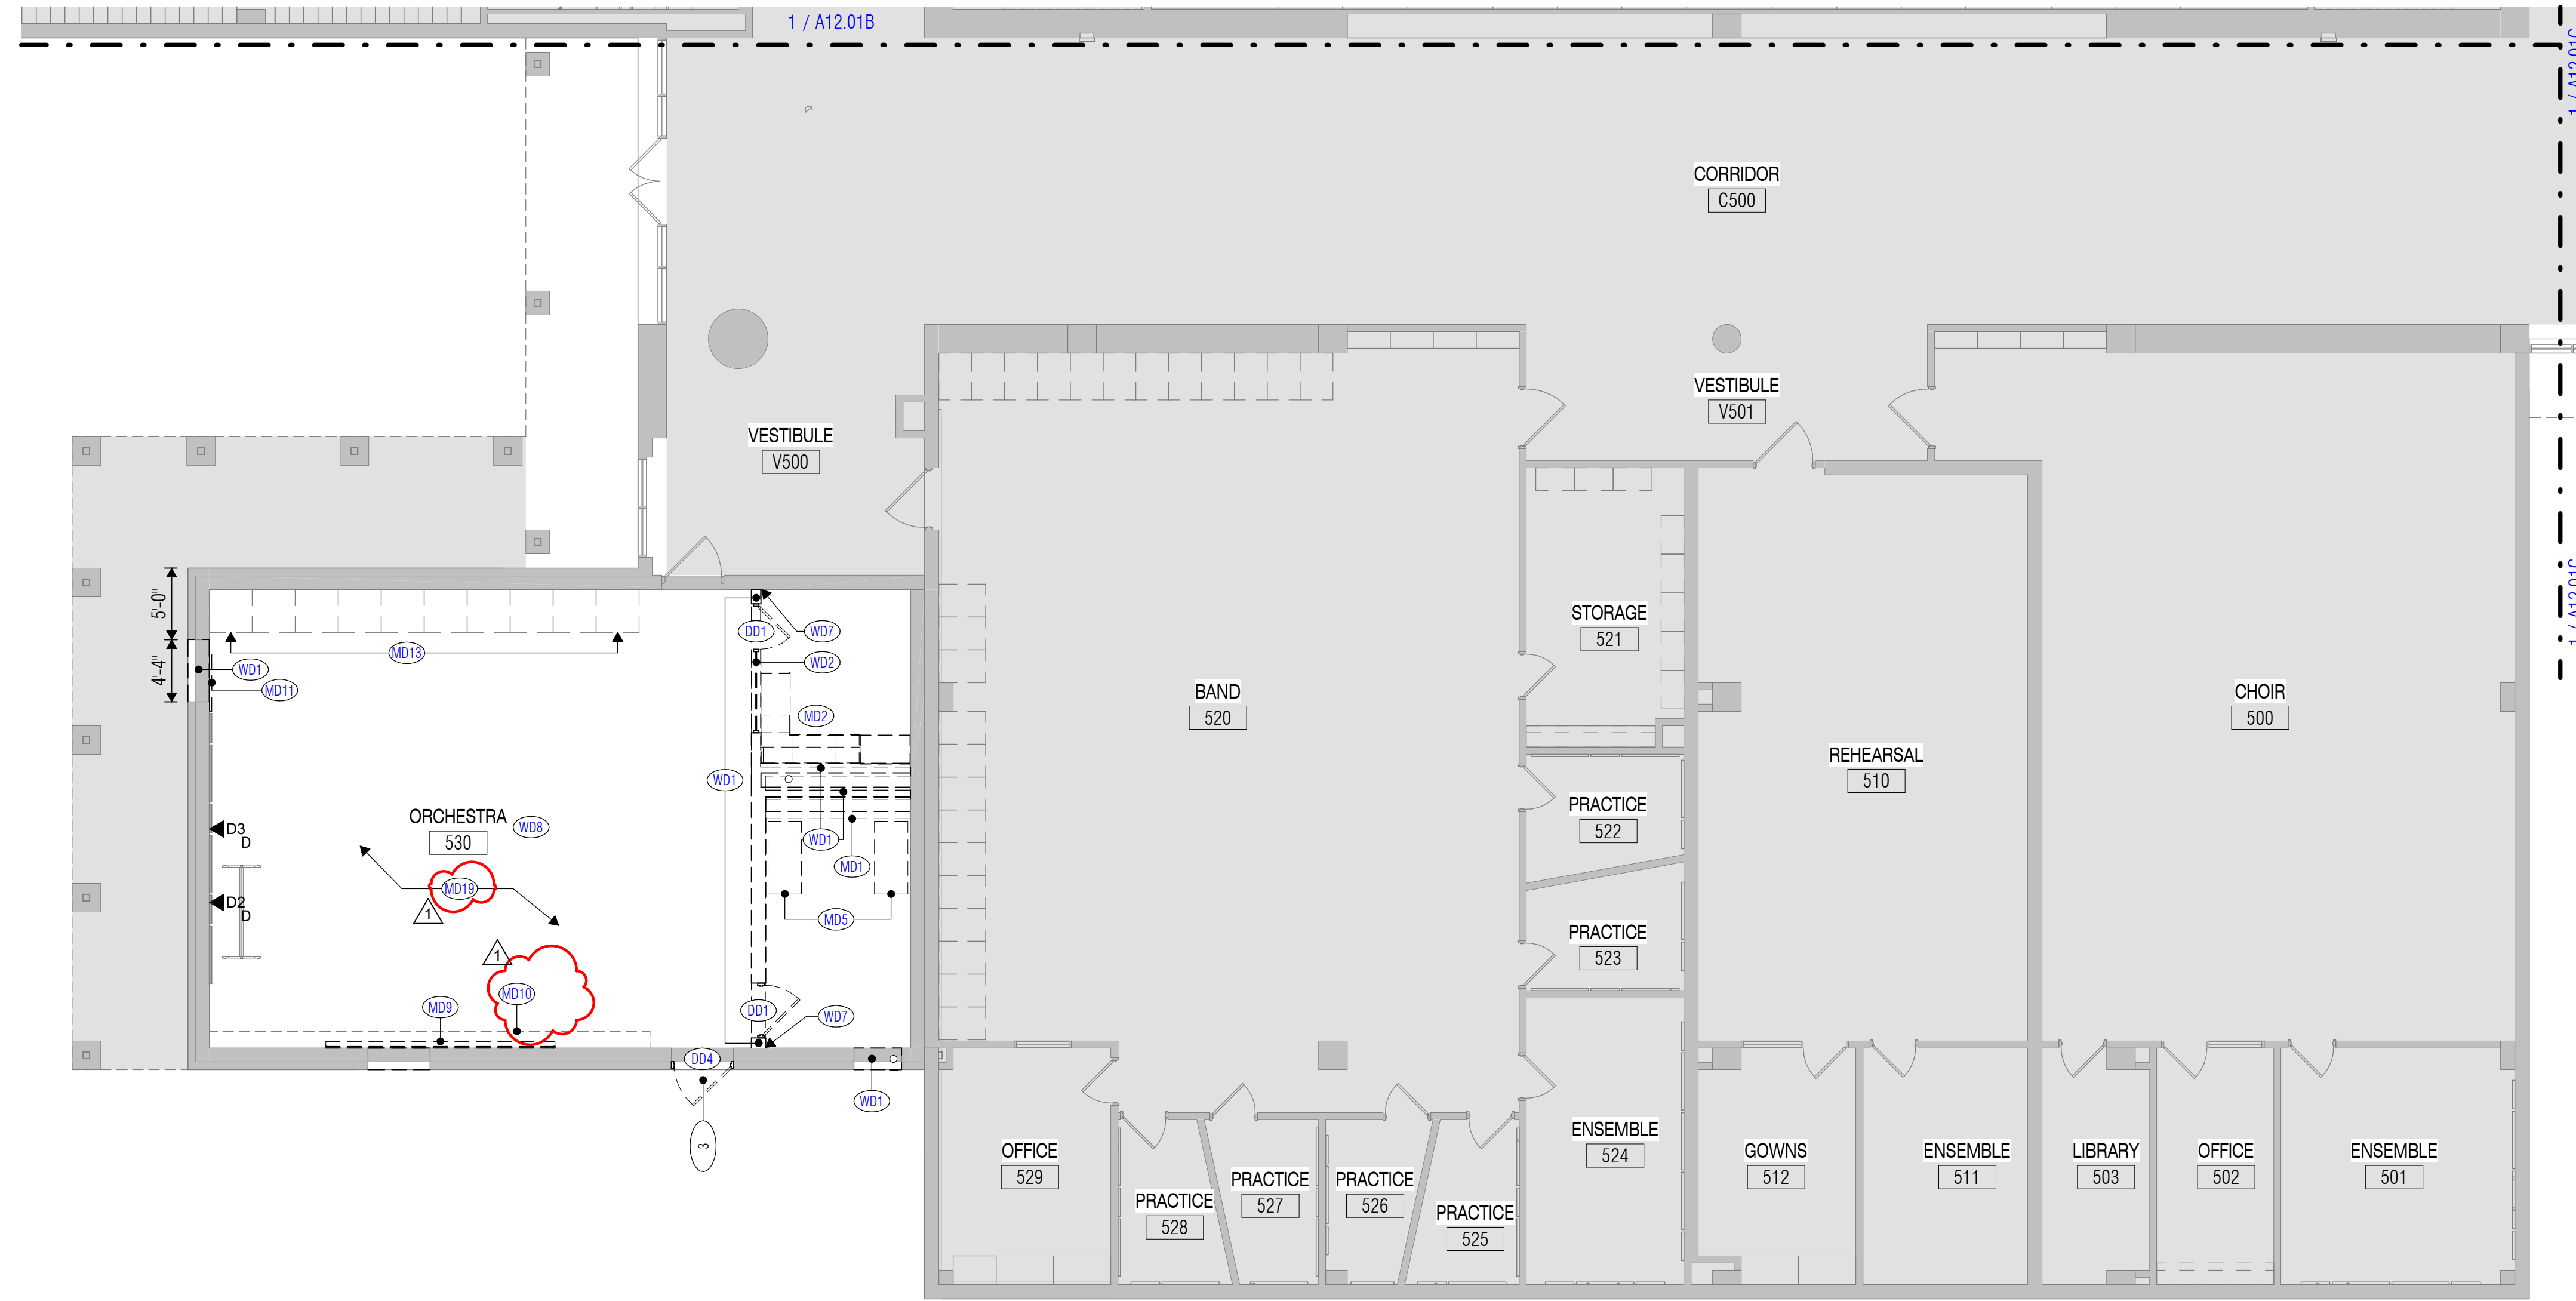

1 UNIT "A" DEMOLITION PLAN - LEVEL ONE
 SCALE: 1/8" = 1'-0"

GENERAL DEMOLITION NOTES



- Drawings show the general extent of demolition work, however it is impractical to indicate or note every item of demolition. Any items shown dashed are to be removed to make way for new construction, unless noted otherwise. Contractor shall notify Architect of any discrepancies between demolition and construction drawings prior to demolition.
- Removal of any asbestos containing materials within the area of work shall be included in the Contractor's scope. Refer to asbestos abatement report and requirements.
- Contractor shall protect existing items to remain from damage throughout all phases of the project. Contractor shall repair, at no cost to the owner, any damages they incur on the existing building and site not scheduled for alteration, as a result of construction activities. Contractor shall provide video documentation of existing conditions prior to start of construction and provide video to Architect.
- Contractor to notify Architect if items shown as existing to remain need to be removed to make way for new work. Contractor is responsible for removing said items, unless noted otherwise, including but not limited to: furniture, equipment, shelving, fixtures, utilities, etc. Contractor shall carefully remove, protect, and reinstall items back to their original positions and make all original connections, when work in the affected area is complete. Any item damaged as a result of construction activity shall be replaced at Contractor's expense. This note shall apply to all areas with construction activity.
- Refer to Civil, MEPT, and Structural drawings for additional demolition scope.
- Patch/repair ceilings, walls, and flooring to match existing at all removed or demolished doors, windows, walls, millwork, lockers, and similar items. Refer to SECTION 01 36 13 for additional information regarding patch and repair.

DEMOLITION LEGEND

- ITEMS TO BE DEMOLISHED
- EXISTING TO REMAIN WITH LIMITED OR NO ARCHITECTURAL WORK REQUIRED IN THIS AREA. REFER TO CIVIL, MEPT AND STRUCTURAL DRAWINGS FOR ANY ADDITIONAL WORK IN AREA.
- MAJOR ARCHITECTURAL WORK REQUIRED IN THIS AREA.

KEYNOTE LEGEND

DD1	REMOVE AND PROPERLY DISPOSE OF DOOR, HARDWARE, AND FRAME. PREPARE AREA TO RECEIVE NEW CONSTRUCTION.
WD9	CAREFULLY REMOVE AND PROPERLY DISPOSE OF WALL AS SHOWN IN DASHED LINES. CLEAN AND PREPARE AREA FOR NEW CONSTRUCTION.

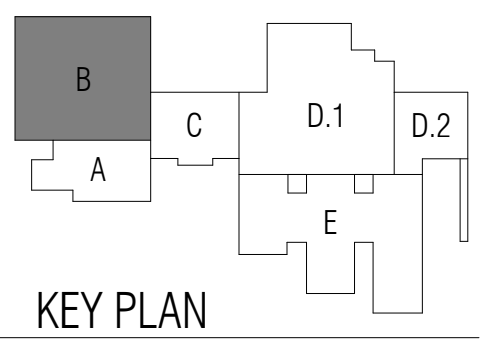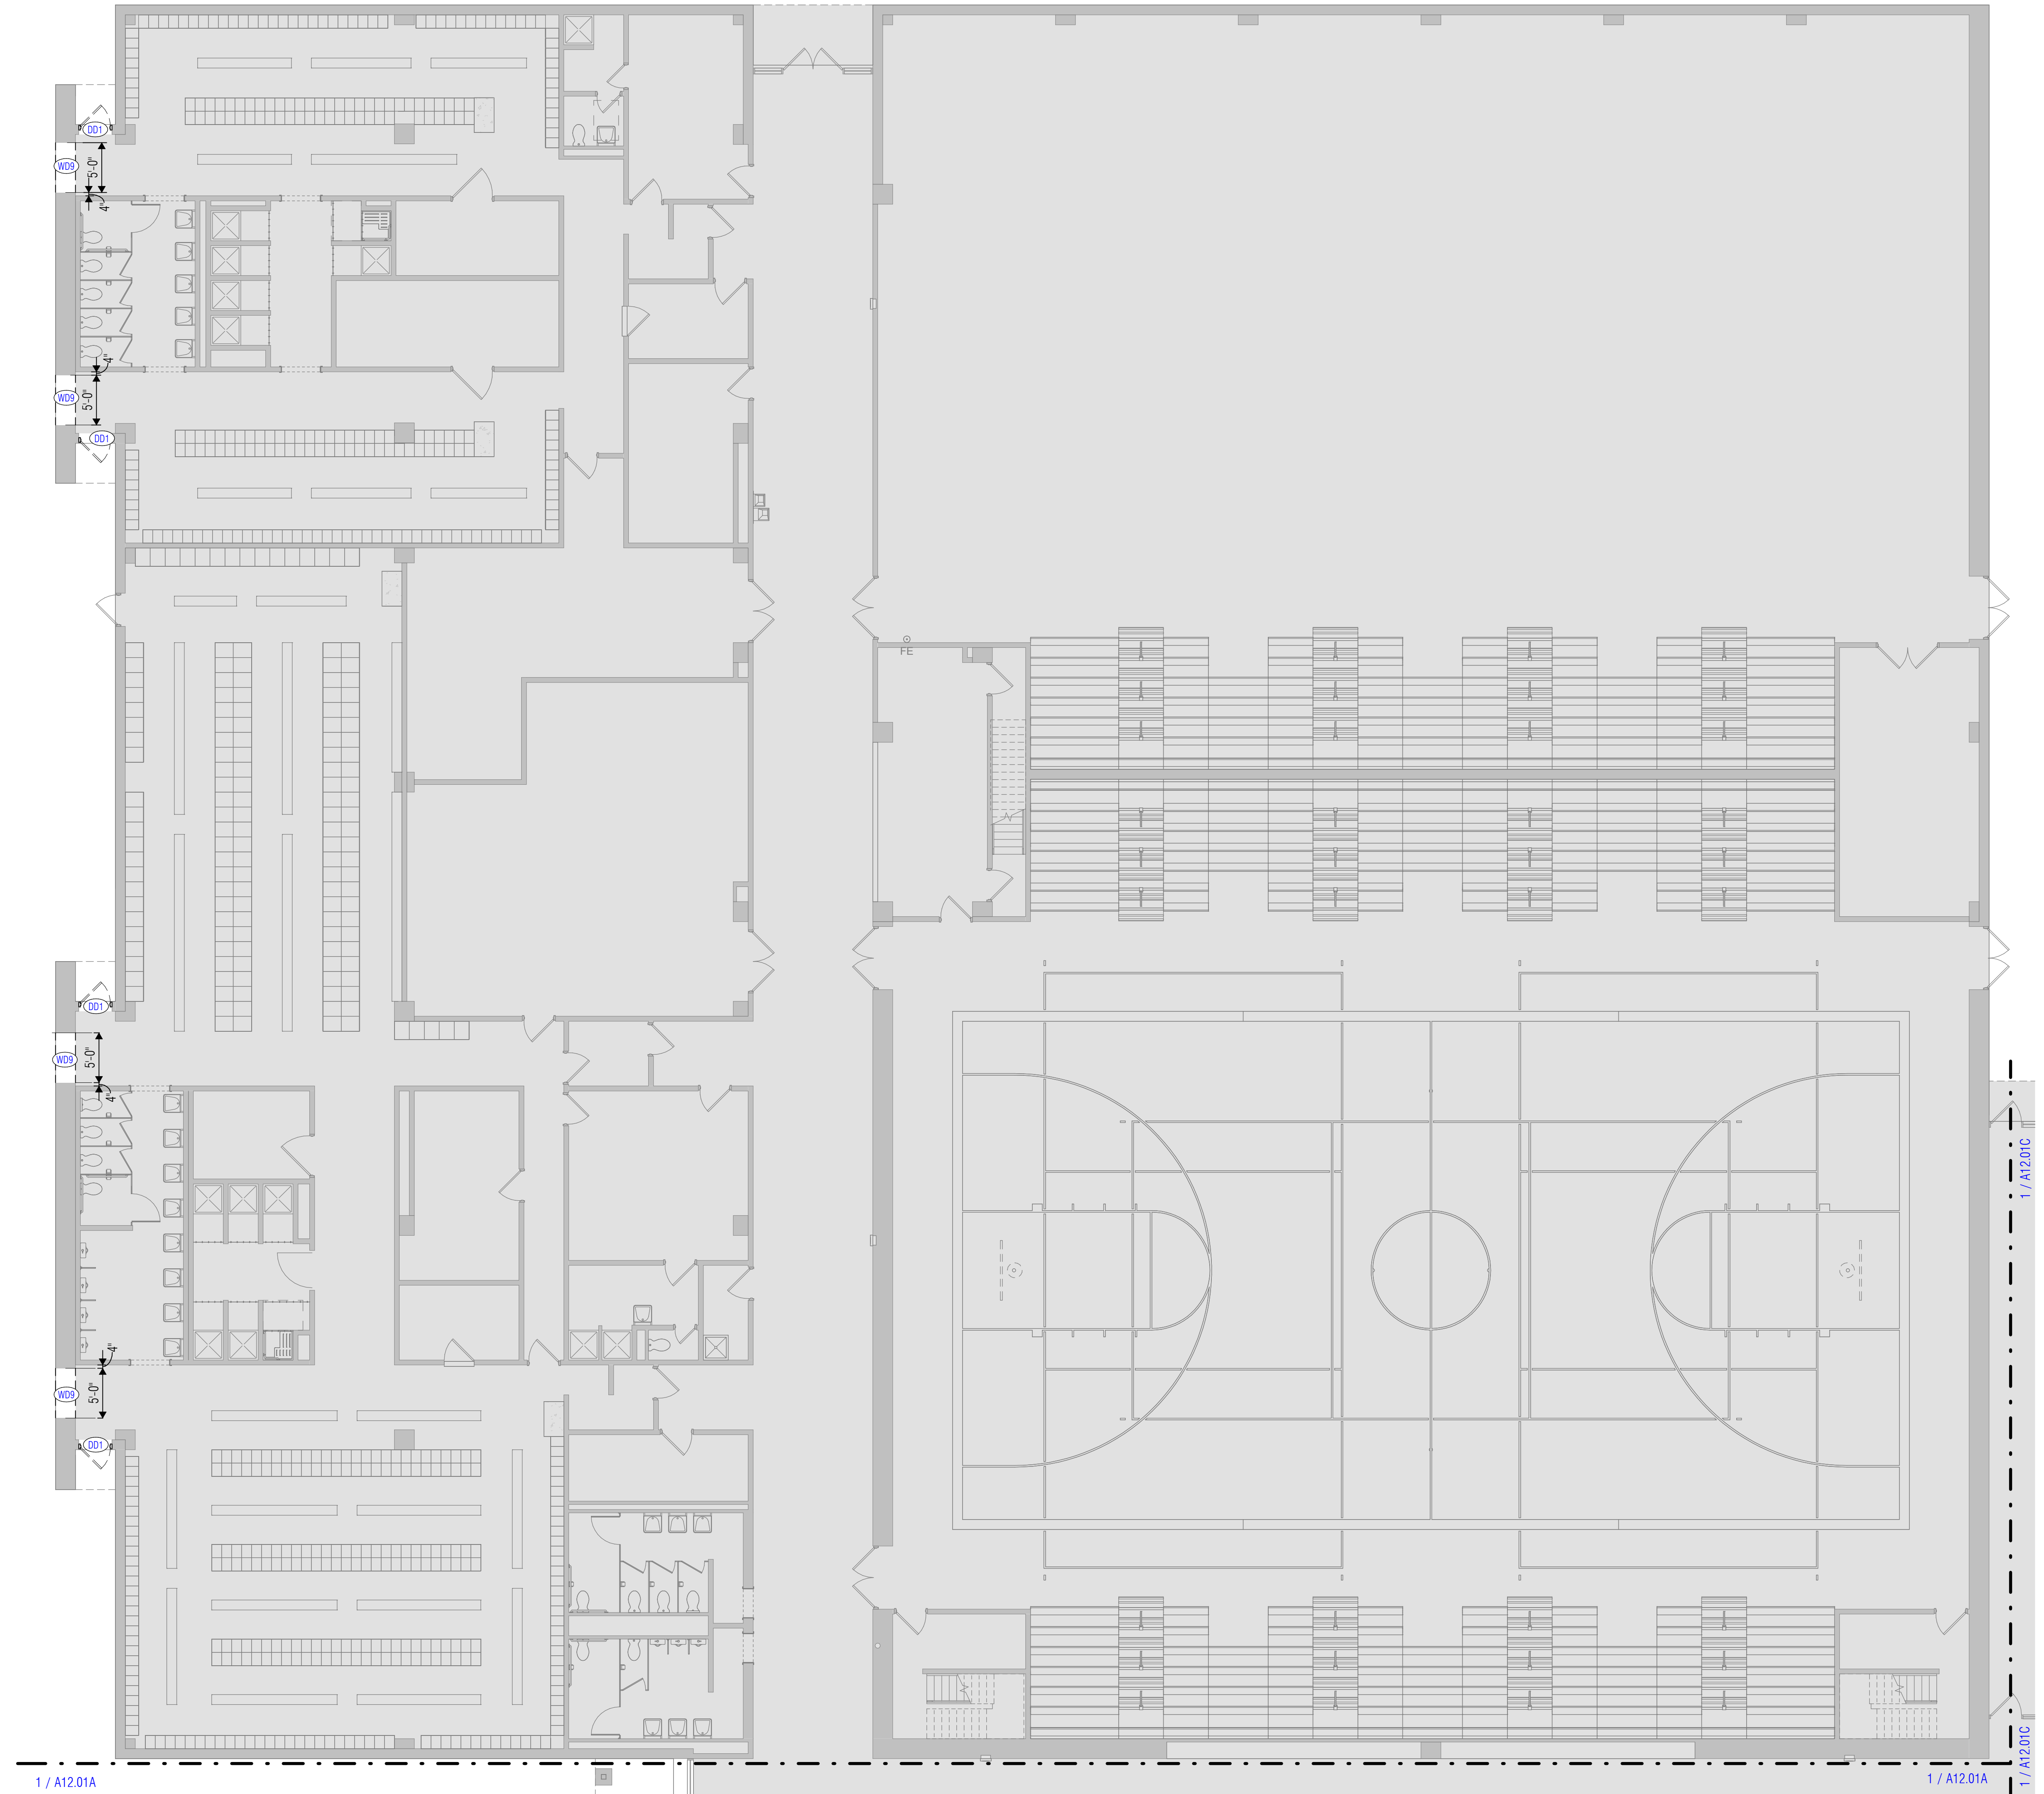

ISSUED: 03/06/25

REVISIONS

Revision No.	Revision Date

Director	Drawn By
Approver	STH, KM
Designer	Quality Control
Designer	
Proj. Arch.	
Checker	

PROJECT NO.
24-010.00

SHEET TITLE

COOK - UNIT B
 DEMOLITION PLAN - LEVEL ONE

SHEET NO.



A12.01B

① UNIT "B" DEMOLITION PLAN - LEVEL ONE
 SCALE: 1/8" = 1'-0"

ARCHITECT

VLK Architects
 20445 State Hwy 249, Suite 350
 Houston, Texas 77070
 Main Phone: 281.671.2300
 www.vlkarhitects.com

CYPRESS-FAIRBANKS INDEPENDENT SCHOOL DISTRICT
 HOUSTON, TEXAS

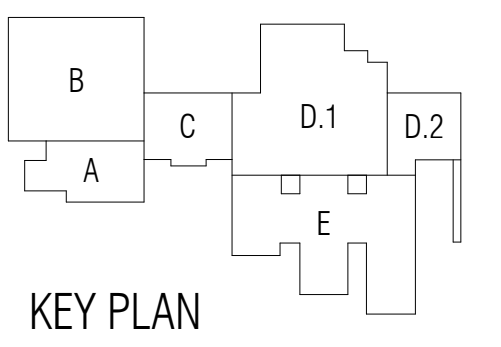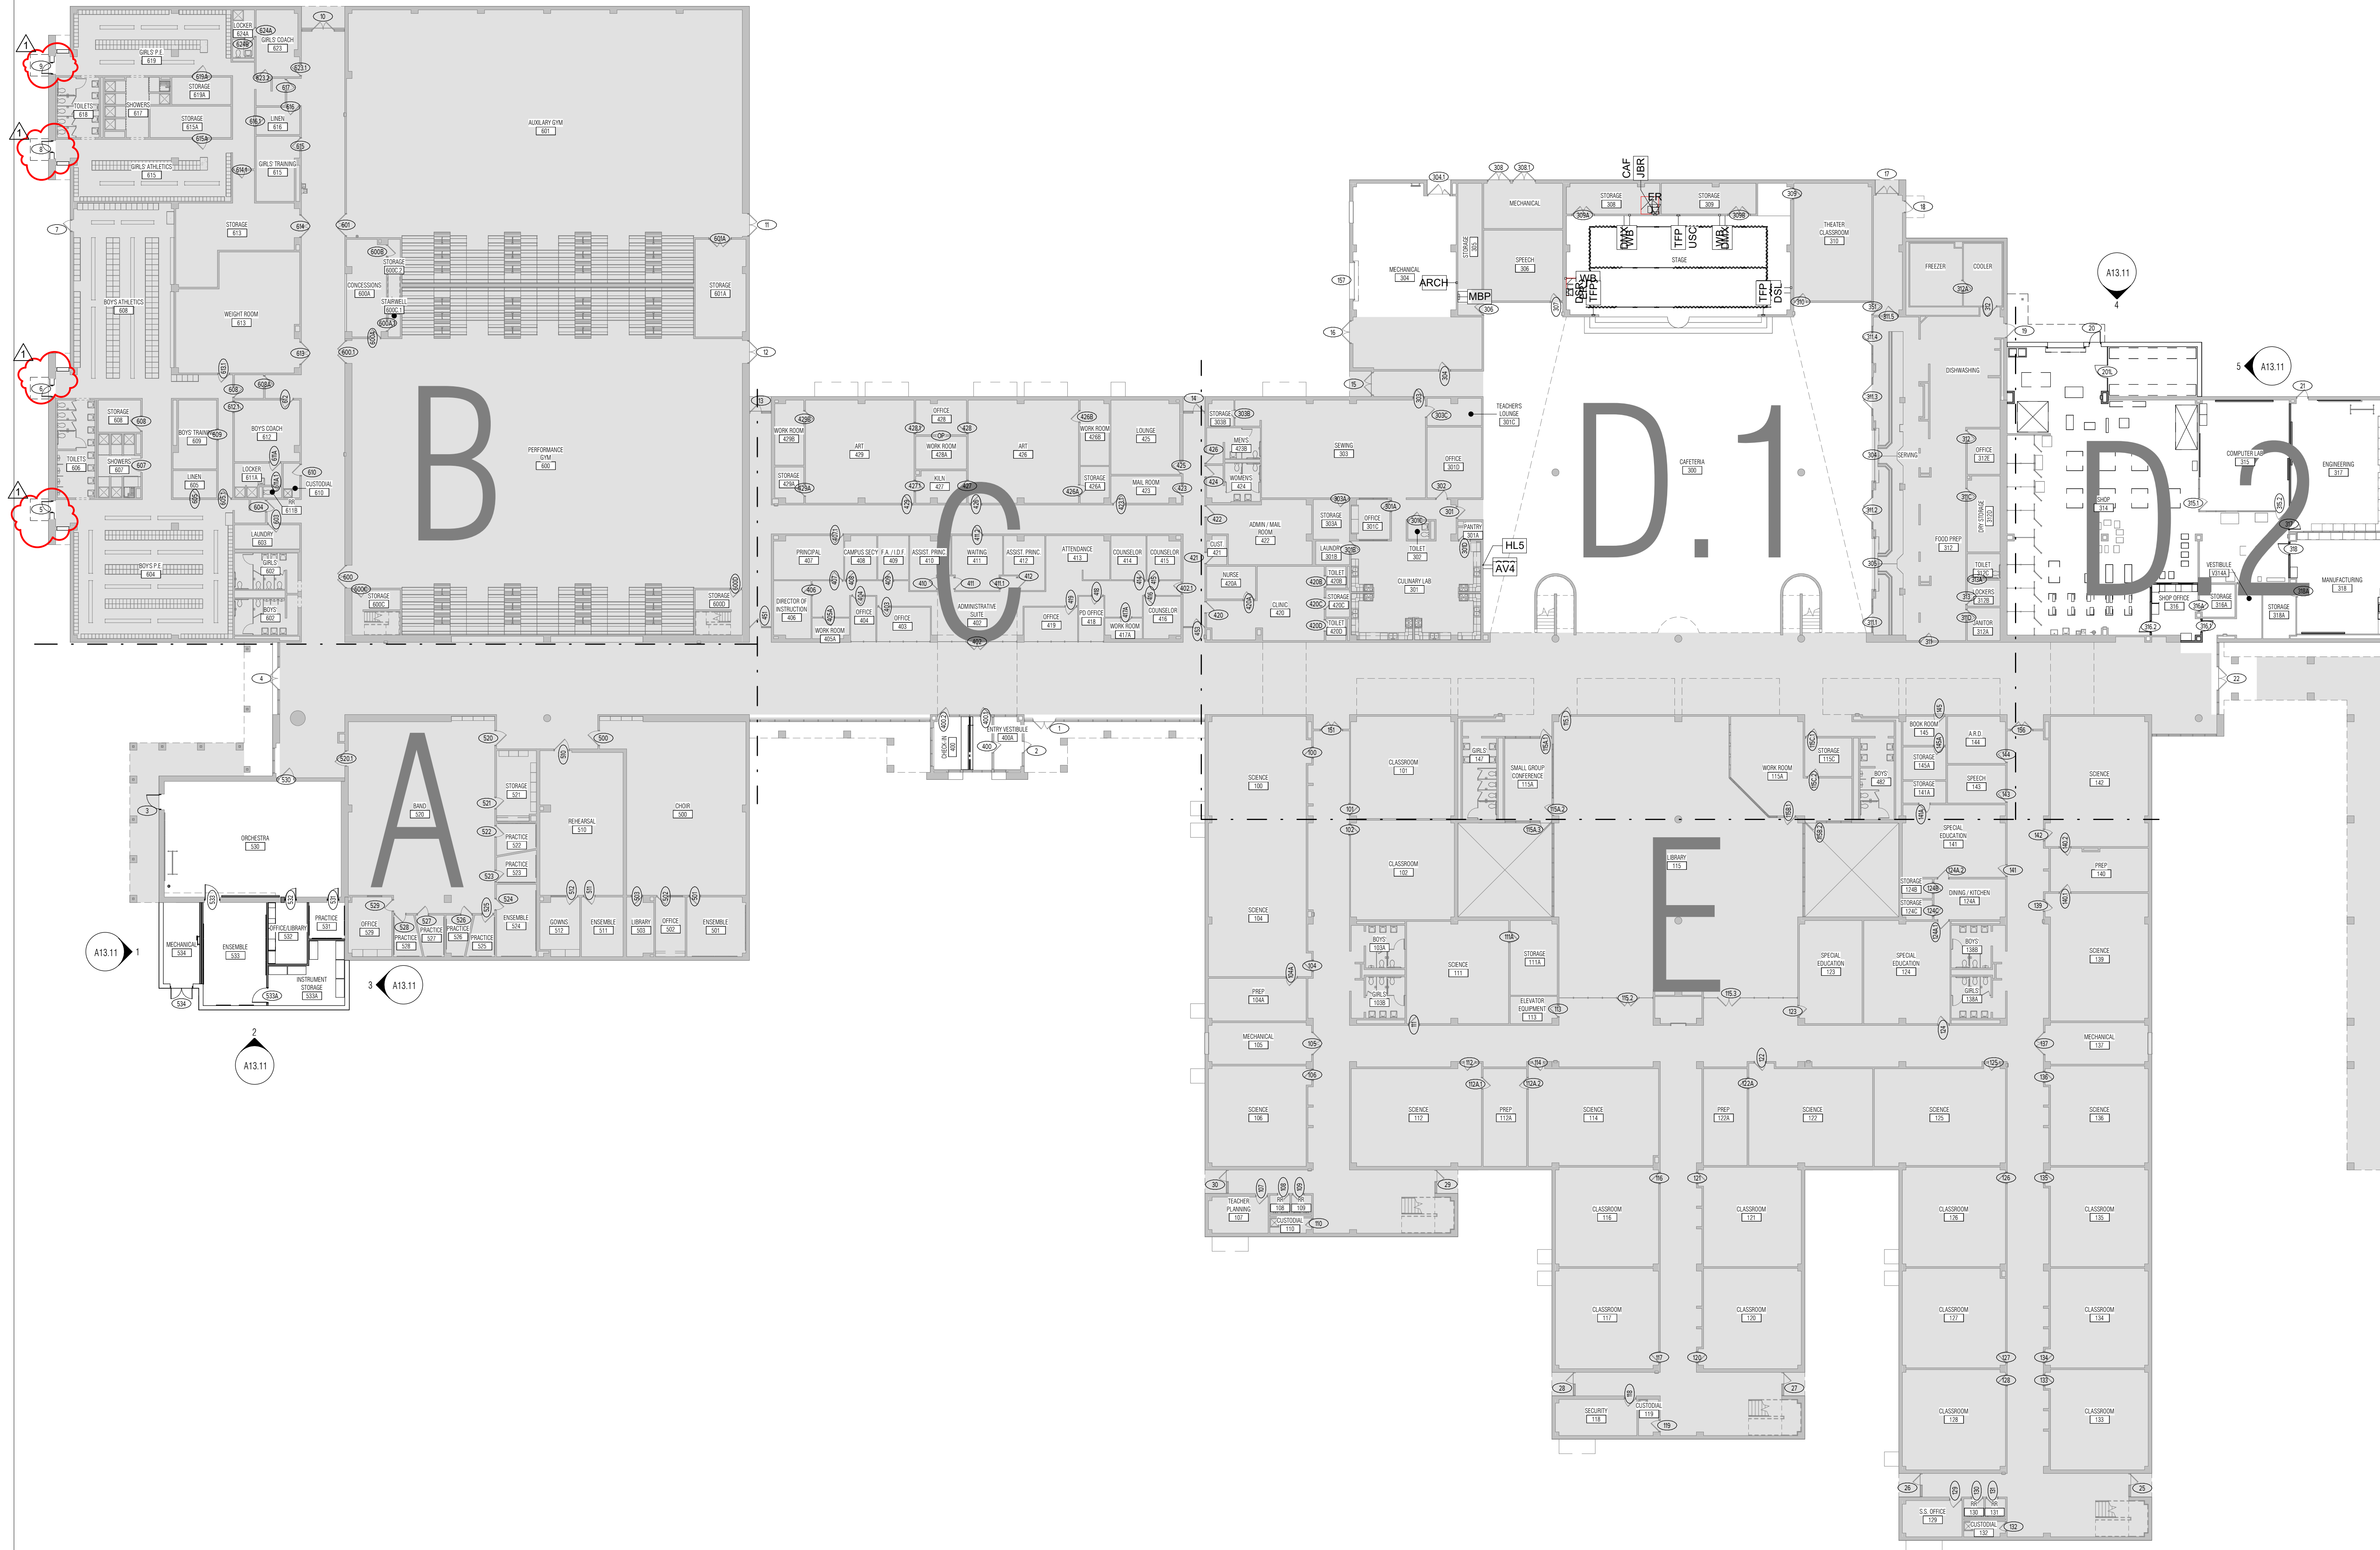

KEY PLAN



ISSUED: February 24, 2025

REVISIONS

Revision No.	Revision Date
1 Addendum 1	03-06-2025

Director: RSJ
 Designer: RSJ
 Drawn By: STH, KM
 Quality Control: STH, KM

Proj. Arch. TQ

PROJECT NO.


24-010.00

SHEET TITLE

COOK - ORIENTATION FLOOR PLAN - LEVEL ONE

SHEET NO.

A12.11

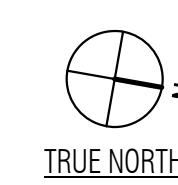


TRUE NORTH

1 ORIENTATION RENOVATION PLAN - LEVEL ONE

SCALE: 3/64" = 1'-0"

2024 Cook, Labay & Truitt MS Renovations

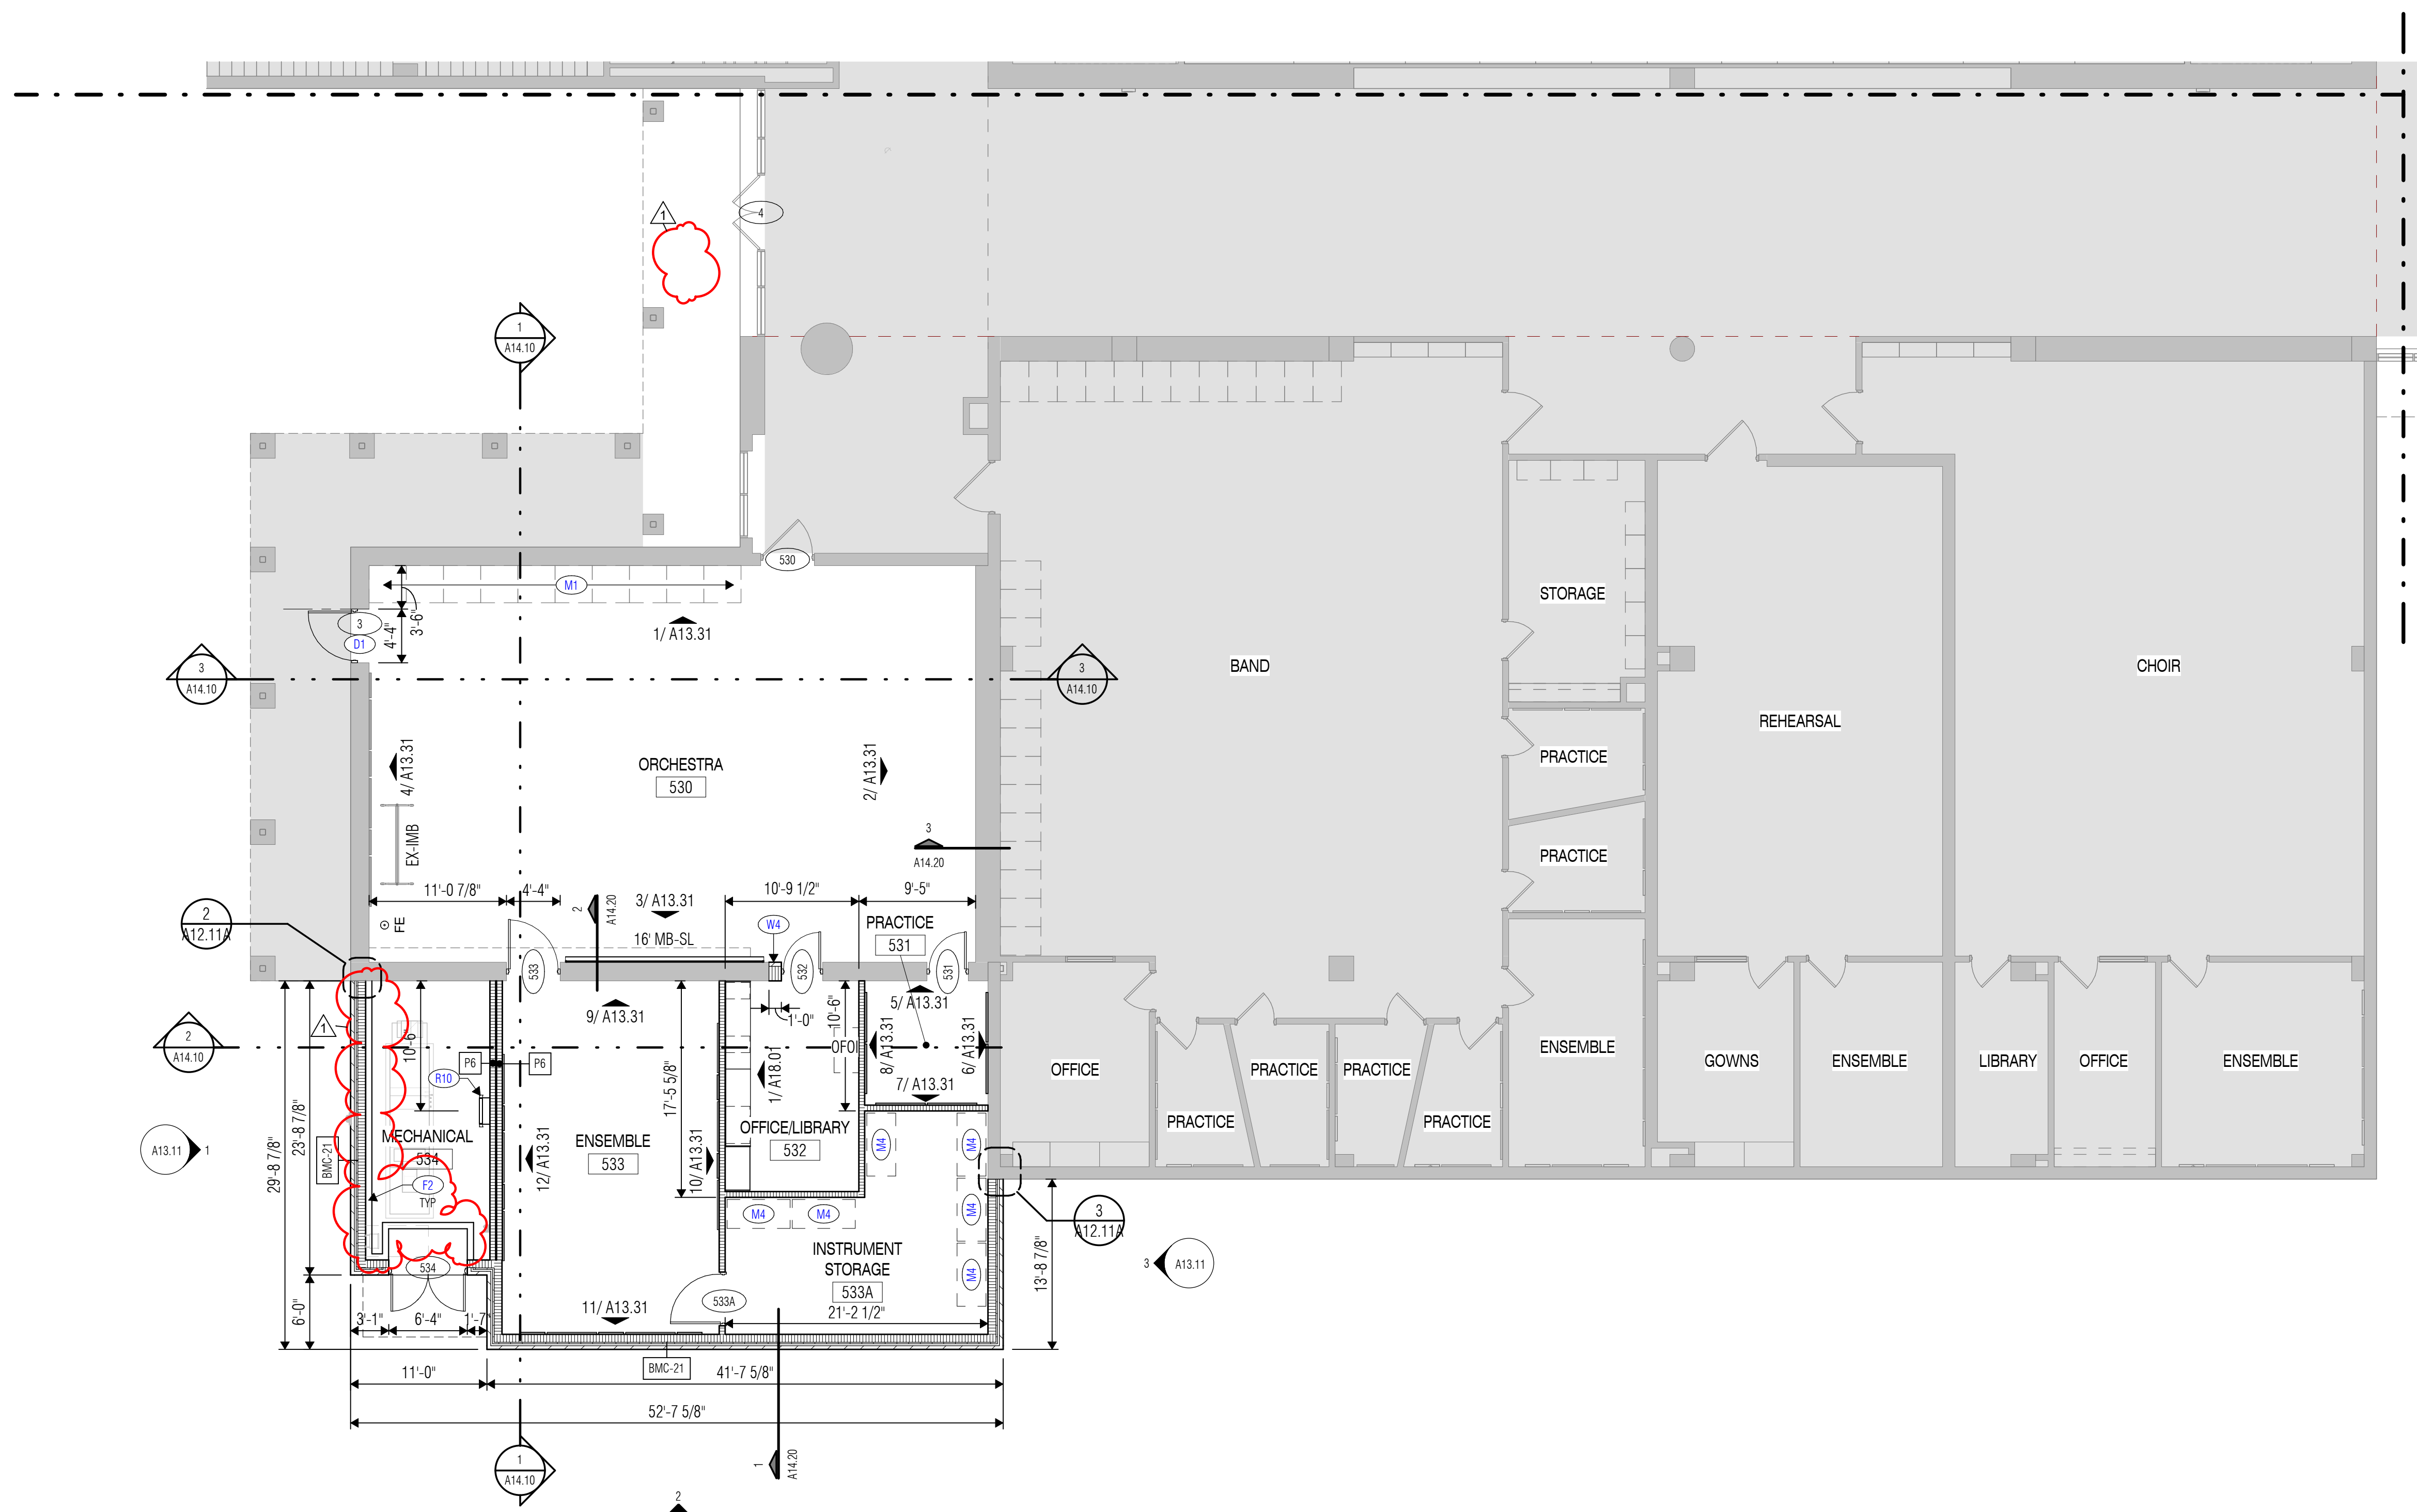

1 UNIT "A" PLAN - LEVEL ONE
SCALE: 1/8" = 1'-0"

- ### FLOOR PLAN NOTES
- Refer to Civil Grading drawings for Primary Ground Level floor elevation relative to Mean Sea Level. Architectural Finish Floor (100'-0" datum) is equal to Civil FFE.
 - Dimensions on Floor Plans are to face of stud or CMU unless noted otherwise.
 - Coordinate the location of electrical devices with casework, millwork, lockers, etc. Any electrical device that is not properly coordinated shall be relocated at no additional cost.
 - Exterior wall construction is identified on the Wall Sections. Refer to the A' 4-series sheets for Wall Sections, and to A14.30, A24.30, A34.30 for Exterior Wall Assemblies.
 - Refer to Exterior Elevation Notes for control joint requirements at all inside corners of masonry veneer.
 - Refer to PARTITION TYPES (A12.21, A22.21, A32.21) for Partition Types Legend.
 - Interior partitions are Type "P6" unless noted otherwise.
 - Refer to Detail 4/A0.31 for Typical Door Maneuvering Clearances. All new doors shall meet the requirements of that detail. If any door is found that does not comply with these requirements, request clarification from the Architect prior to construction.
 - Refer to PARTITION DETAILS sheets for Typical Partition Penetration Details, including pipe, conduit and ductwork penetrations.
 - Refer to PARTITION DETAILS sheets for Typical Bracing at Non-Loadbearing CMU Partitions.
 - Refer to Exterior Elevations for exact locations of downspouts.
 - Provide factory bullnose units at all interior exposed vertical edges of CMU, except at starter course with applied base material where square-edge units shall be provided in lieu of bullnose units.
 - Provide 4" starter courses at all CMU walls and partitions unless noted otherwise.
 - Provide steel or masonry lintels over all openings in CMU walls, including those required for mechanical ductwork and dampers, whether specifically indicated on the drawings or not.
 - Provide minimum 20 gage light-gage steel studs at all interior partitions scheduled to receive ceramic tile or plaster.
 - Provide minimum 18 gage cold-formed steel studs at all interior partitions scheduled to receive anchored masonry or stone veneer as well as interior partitions with steel plate or steel sheet X-bracing.
 - Provide minimum 18 gage cold-formed steel studs as designed by stud engineer for all interior partitions scheduled to receive adhered masonry or stone veneer.
 - At light-gage steel stud partitions that extend above the ceiling, provide diagonal 20 gage stud braces at 4'-0" o.c. to structure above (not to steel deck) as required to provide rigid anchorage and support of partitions.
 - Provide minimum 2 X 6 fire-retardant treated wood blocking in both new and existing stud walls and partitions, at mounting locations for wall-mounted accessories, handrails, casework, markerboards, tackboards, folding partitions, toilet partitions, and all other wall-mounted items. Refer to CASEWORK ELEVATIONS & DETAILS sheets for typical blocking requirements at various conditions.
 - At Mechanical, Electrical and Boiler Room partitions, seal tightly around all penetrations. Utilize fire rating material at rated partitions.
 - Provide sealant and/or fire rating at all floor penetrations, as applicable.
 - Existing equipment to remain U.N.O. Contractor to relocate equipment as needed to complete new construction. Contractor shall reinstall equipment upon completion of construction. All equipment to be in as good or better working condition as prior to the start of construction.


- ### FLOOR PLAN LEGEND
- METAL STUD PARTITION. Extend 4" above highest ceiling plane and brace to structure above as noted in Floor Plan Notes. Refer to Reflected Ceiling Plan for fire, smoke and sound-conditioned partitions that extend to deck above.
 - CMU PARTITION. Extend 4" above highest ceiling plane and brace to structure above as detailed. Refer to Reflected Ceiling Plan for fire, smoke and sound-conditioned partitions that extend to deck above.
 - EXISTING WALL TO REMAIN.
 - MOVABLE METAL SHELVING. Depth and Width dimensions match that of this legend, unless otherwise noted.
 - FURNITURE, FIXTURE OR EQUIPMENT BY OWNER. Coordinate with adjacent electrical devices, casework, etc.
- | | |
|-----|---|
| MB | MARKERBOARD. Preceding number is length, in feet. |
| SL | TACKBOARD. Preceding number is length, in feet. |
| TB | TACK STRIP. Preceding number is length, in feet. |
| IM | INTERACTIVE MARKERBOARD |
| EX | EXISTING |
| IFP | INTERACTIVE FLAT PANEL |
| FEC | FIRE EXTINGUISHER WITH CABINET AND BRACKET |
| FE | FIRE EXTINGUISHER WITH BRACKET |
| FHC | FIRE HOSE CABINET |
| HB | HORIZONTAL BLINDS |
| RS | ROLLING WINDOW SHADES |
| DS | DOWNSPOUT |



ARCHITECT
VLK Architects
 20445 State Hwy 249, Suite 350
 Houston, Texas 77070
 Main Phone: 281.671.2300
 www.vlkarchitects.com


KEY PLAN

2024 Cook, Labay & Truitt MS Renovations
 CYPRESS-FAIRBANKS INDEPENDENT SCHOOL DISTRICT
 HOUSTON, TEXAS

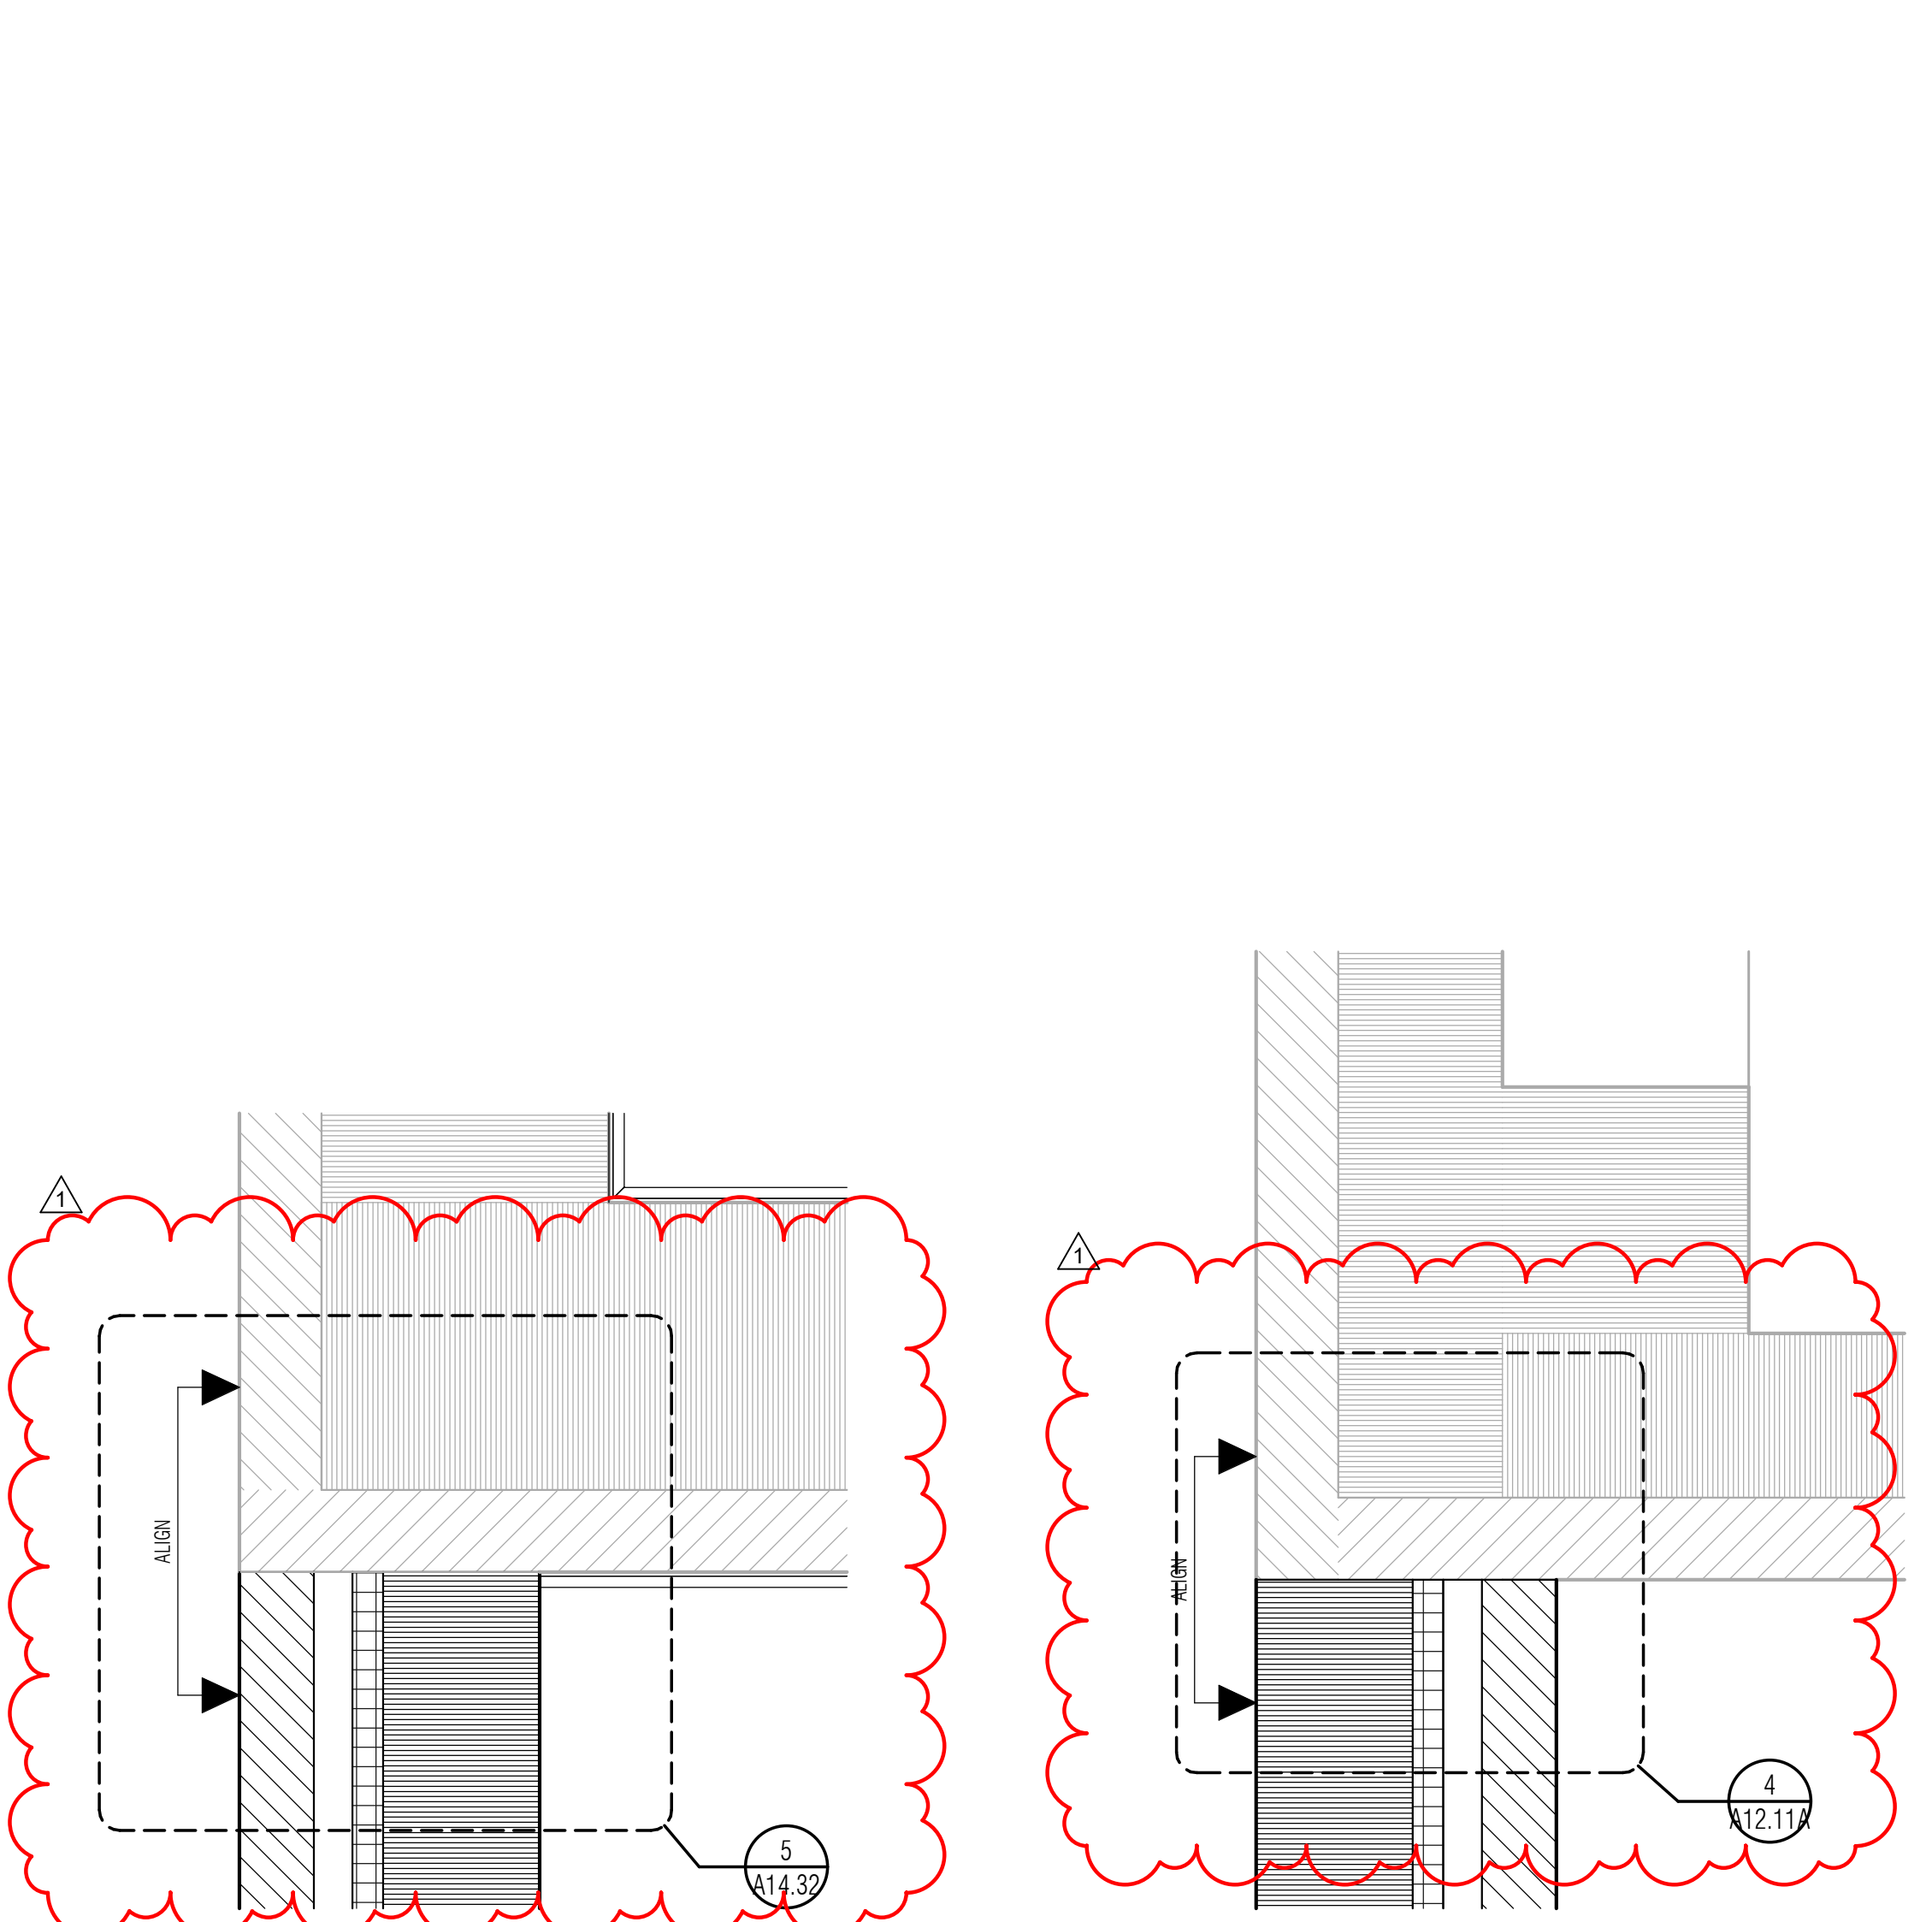

2 PLAN DETAIL
SCALE: 1 1/2" = 1'-0"

3 PLAN DETAIL
SCALE: 1 1/2" = 1'-0"

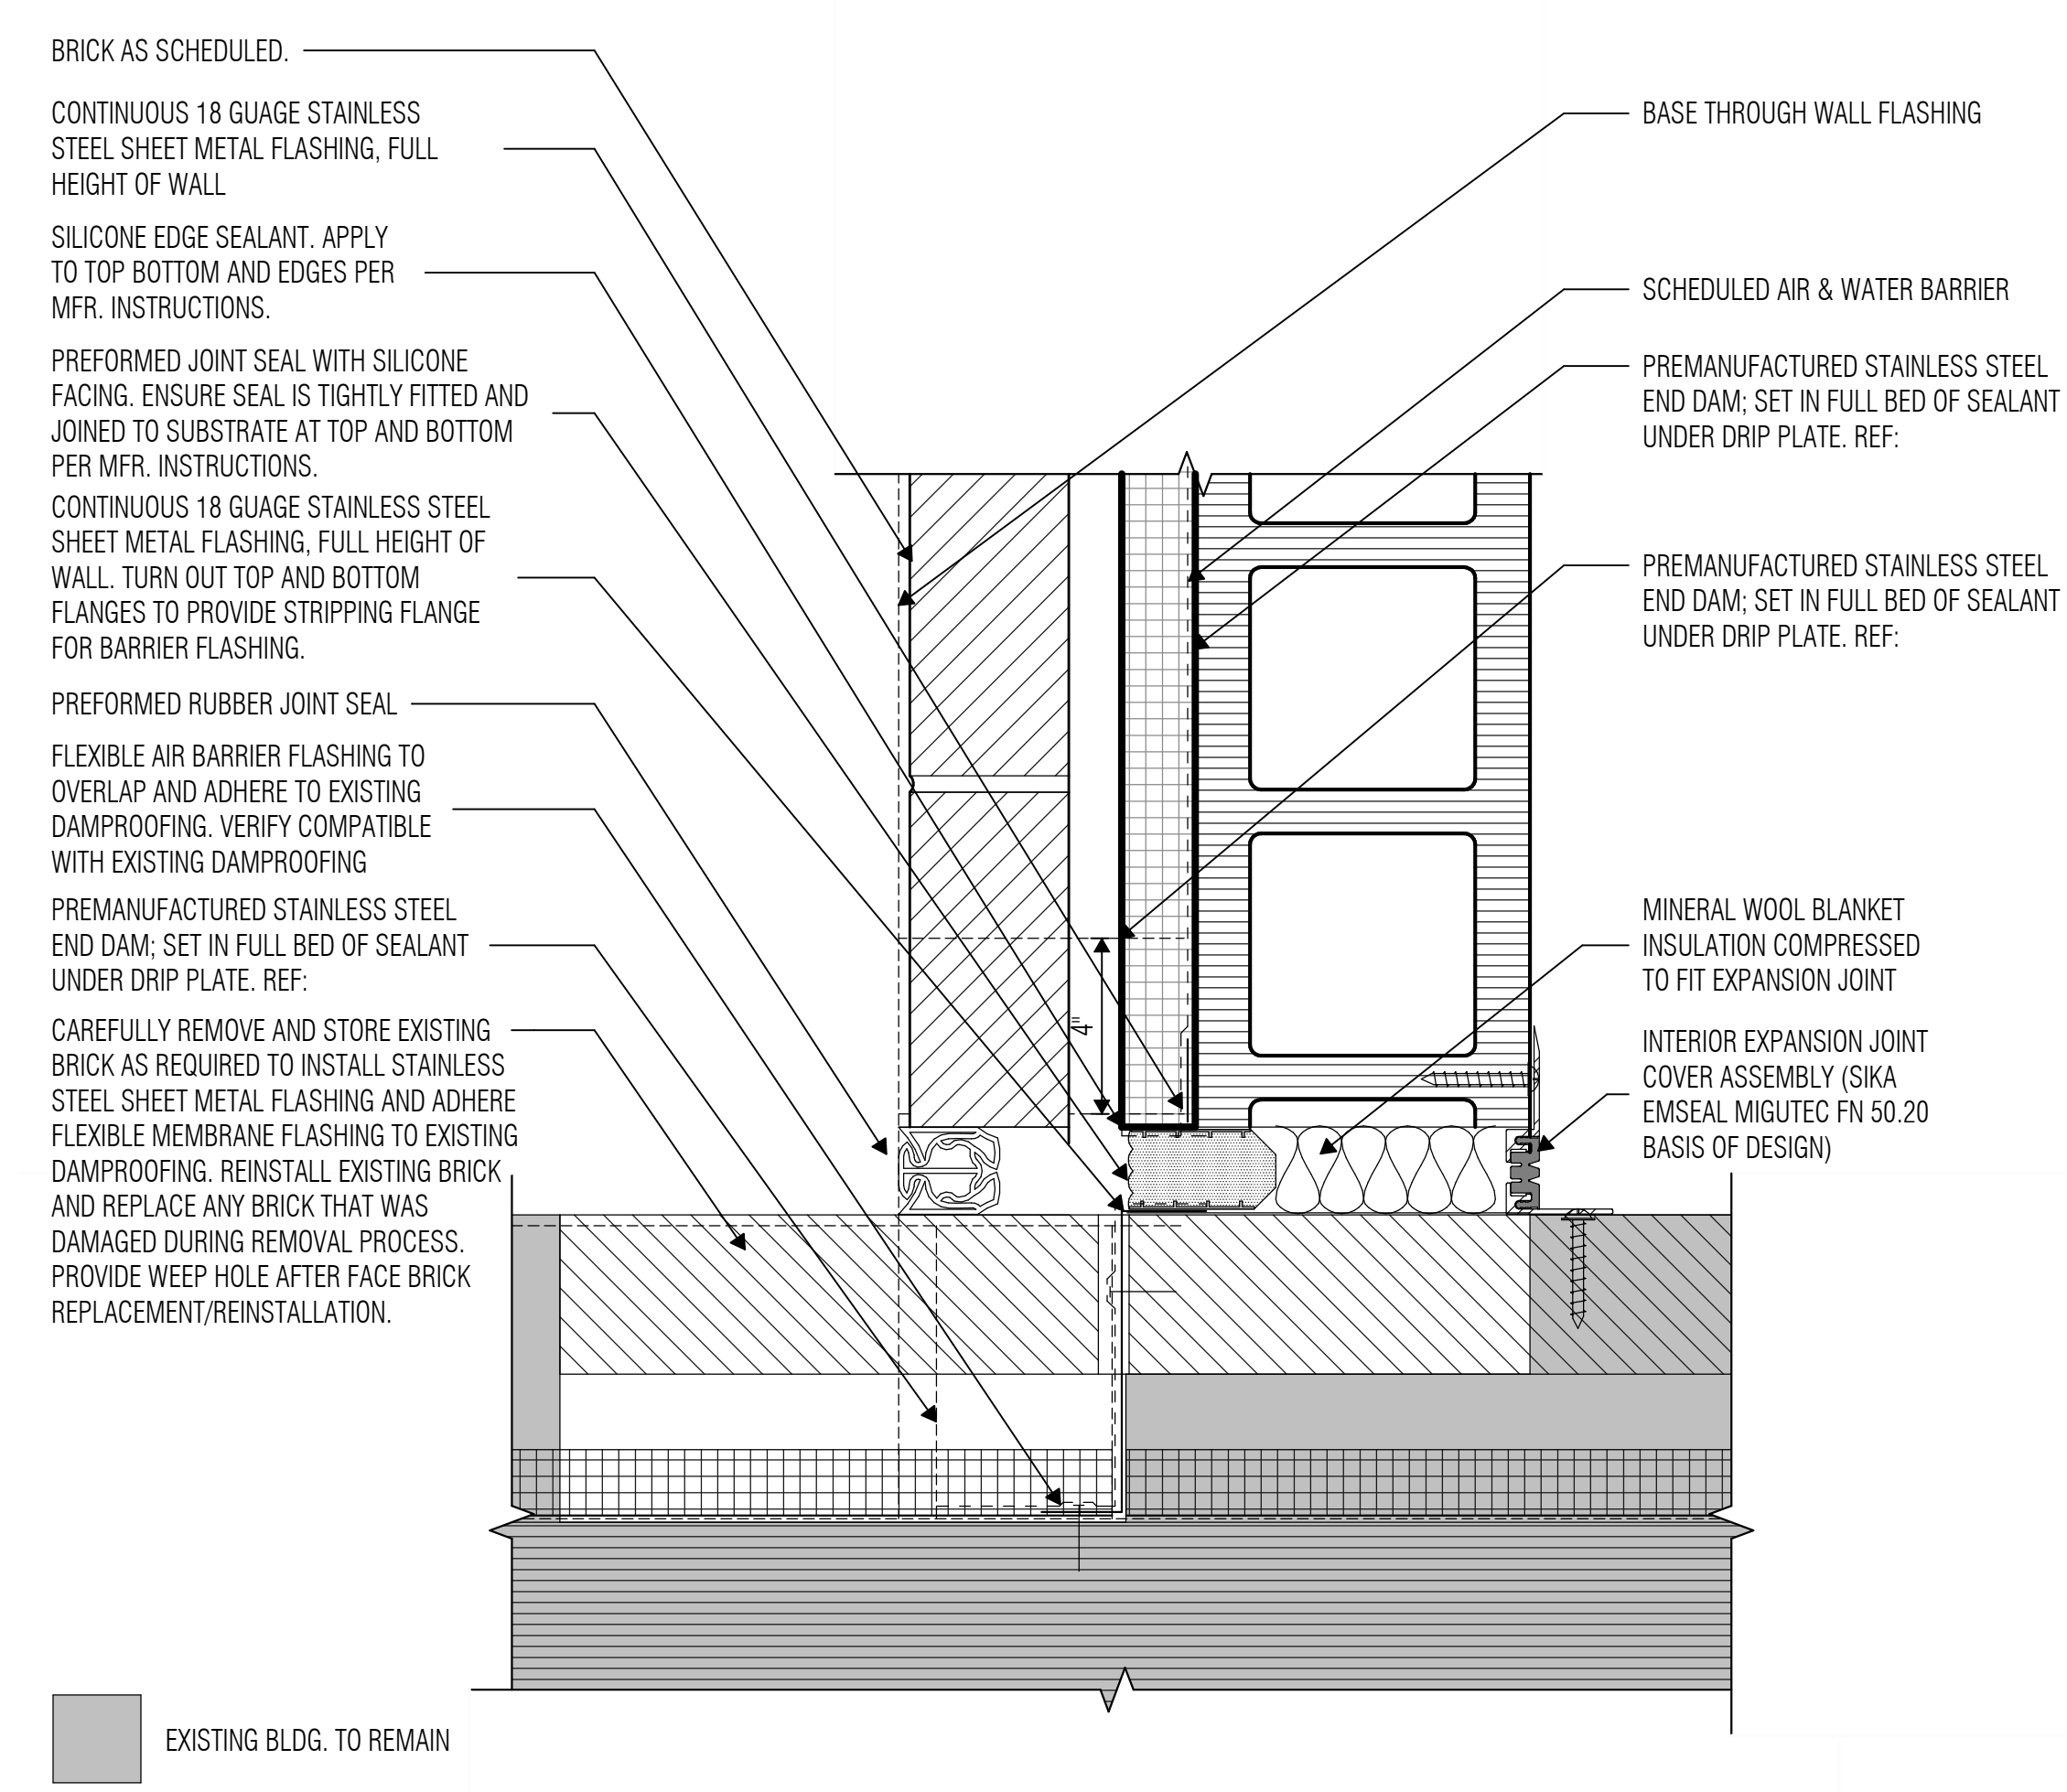

4 EXPANSION JOINT @ EXTERIOR WALL TYP.
SCALE: 3" = 1'-0"

- ### KEYNOTE LEGEND
- D1 RELOCATED DOOR
 - F2 CONTINUE CURB AROUND MECH ROOM DOOR. SIZE OF CURB TO MATCH ADJACENT PARTITION CURB. RE-STRUC.
 - M1 CASEWORK EXISTING TO REMAIN. PROTECT THROUGHOUT CONSTRUCTION PHASES. CONTRACTOR TO REPAIR ANY DAMAGE INCURRED DURING CONSTRUCTION.
 - M4 RELOCATED INSTRUMENT STORAGE RACK.
 - R10 WALL-MOUNTED ROOF LADDER WITH SAFETY POST.
 - W4 INFILL OPENING TO MATCH EXISTING WALL DEPTH AND CONSTRUCTION.



03/06/2025

ISSUED: February 24, 2025

REVISIONS

Revision No.	Revision Date
1 Addendum 1	03-06-2025

Director: RSJ
 Designer: STH, KM
 Quality Control: TQ

Proj. Arch. TQ

PROJECT NO.

24-010.00


SHEET TITLE

COOK - UNIT A FLOOR PLAN - LEVEL ONE

SHEET NO.

A12.11A

COPYRIGHT © 2025 VLK ARCHITECTS

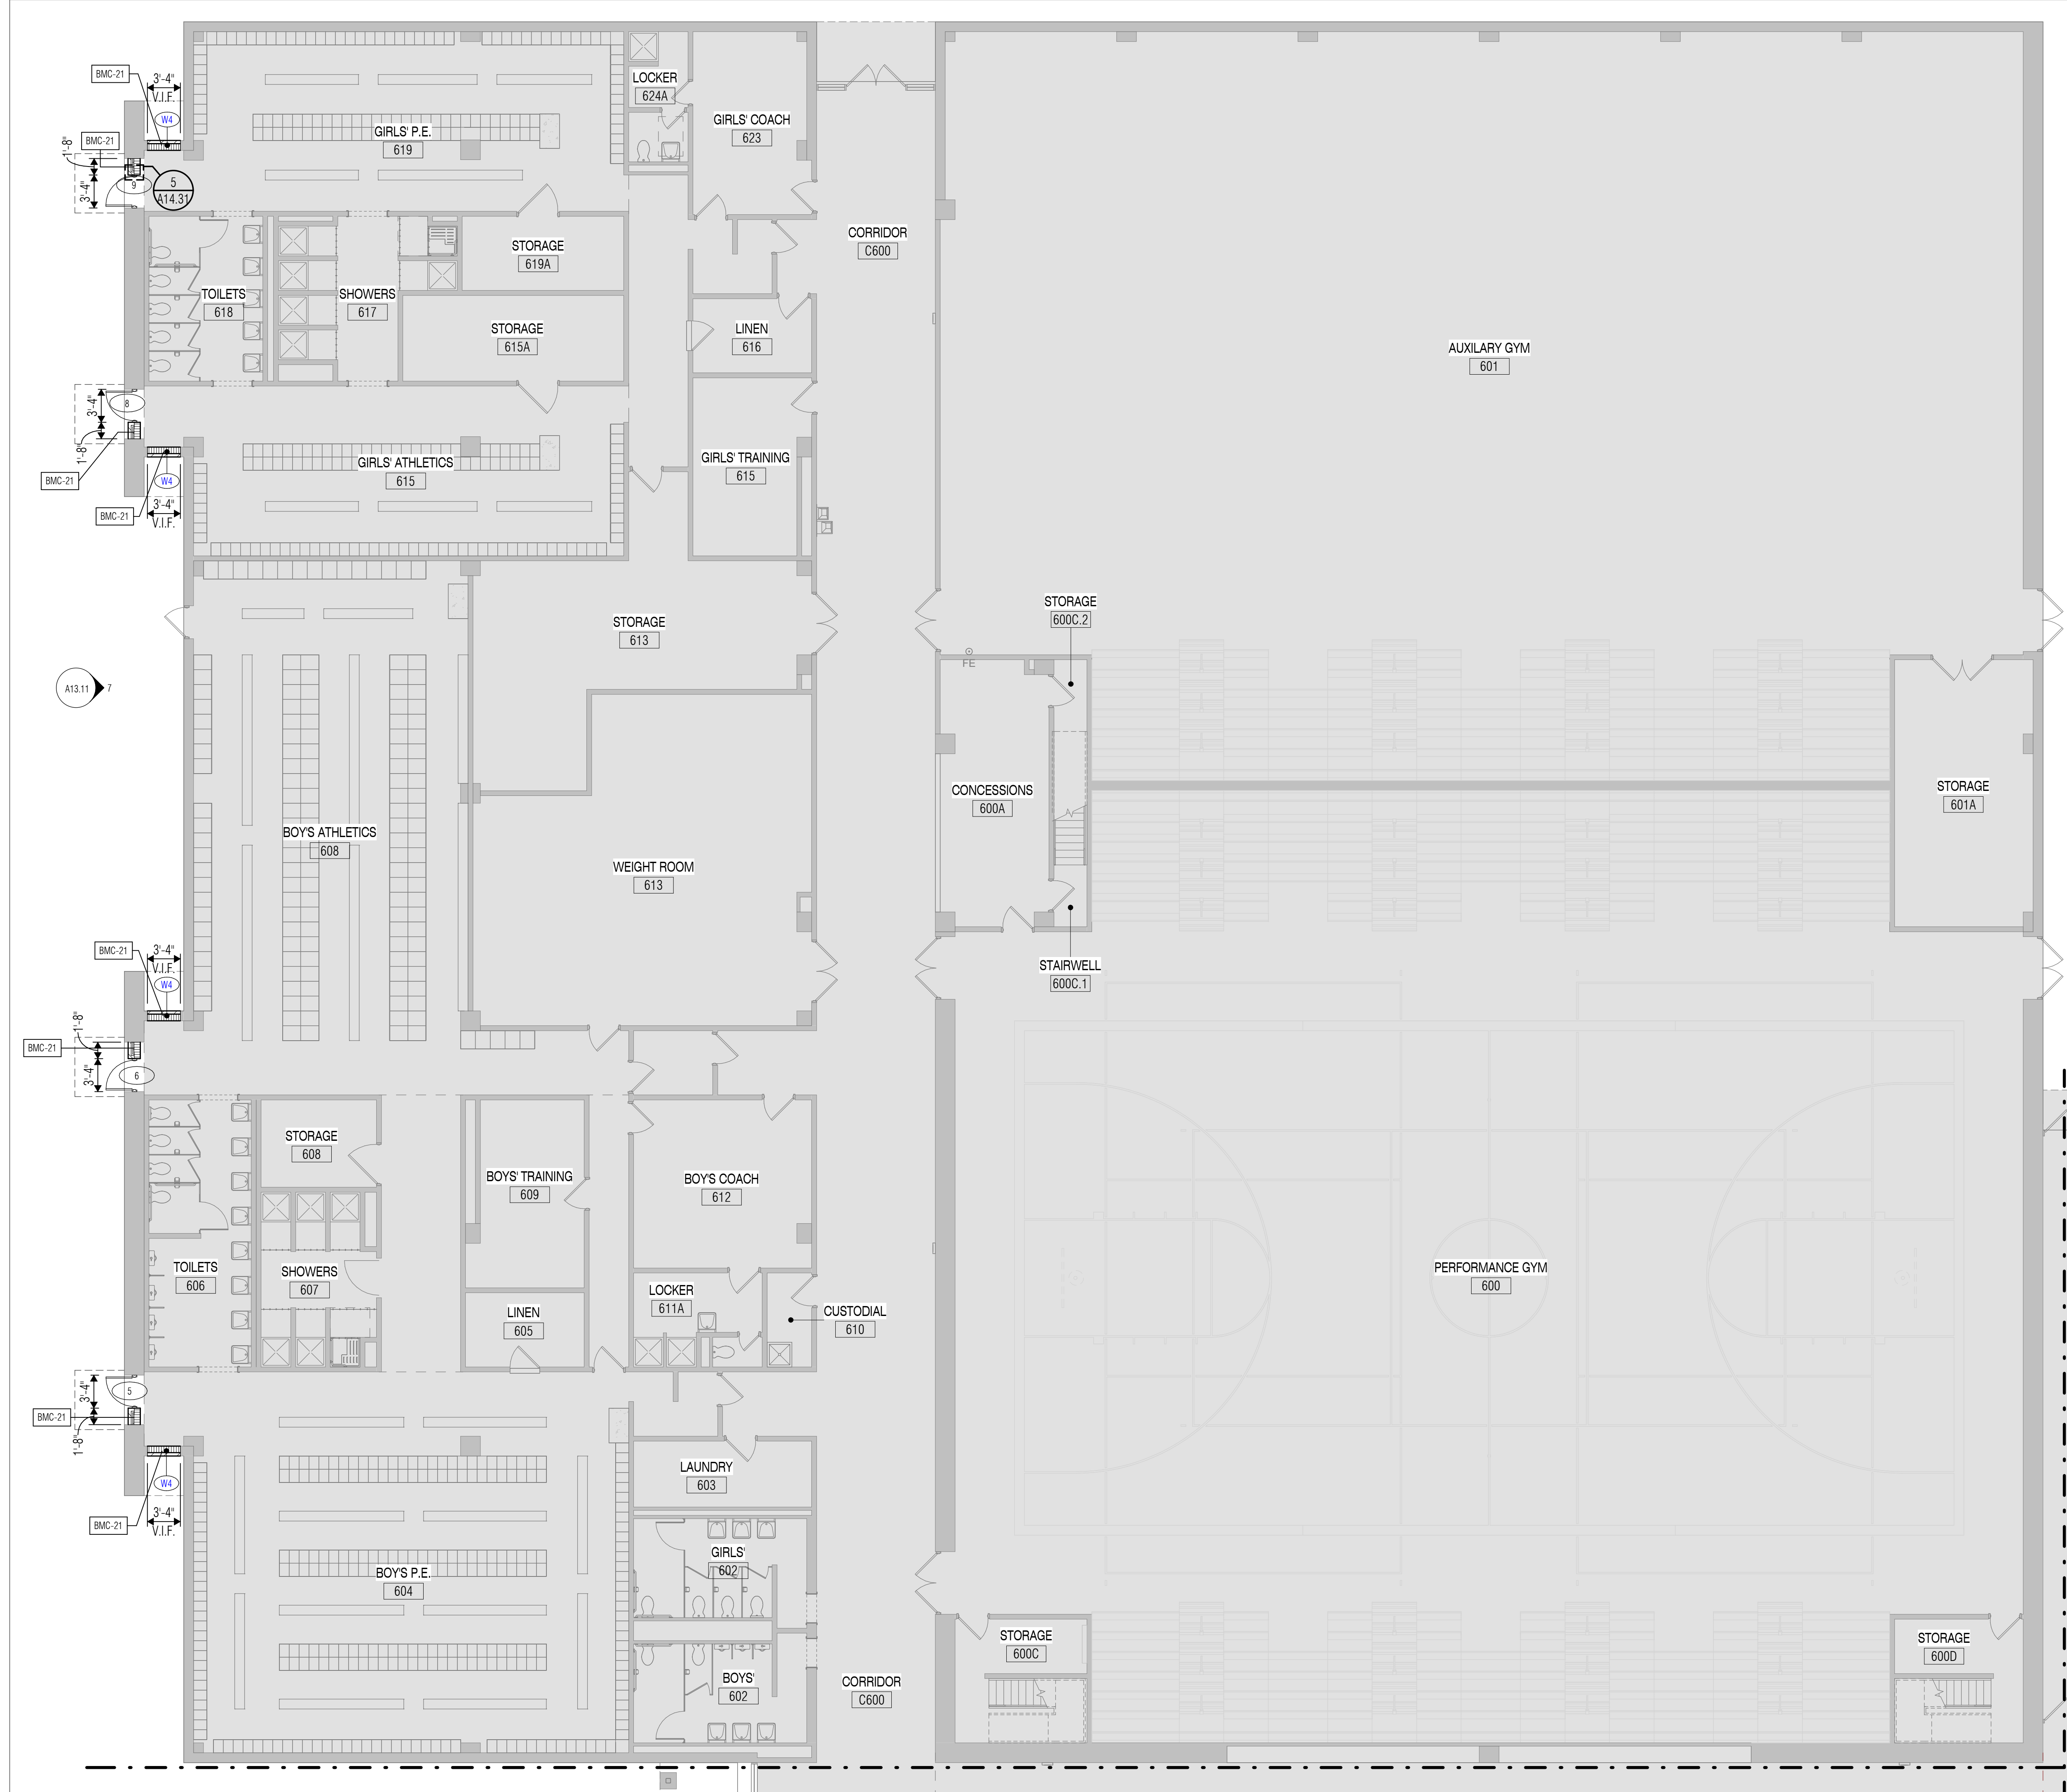

① UNIT "B" PLAN - LEVEL ONE
SCALE: 1/8" = 1'-0"

FLOOR PLAN NOTES

- Refer to Civil Grading drawings for Primary Ground Level floor elevation relative to Mean Sea Level. Architectural Finish Floor (100'-0" datum) is equal to Civil FFE.
- Dimensions on Floor Plans are to face of stud or CMU unless noted otherwise.
- Coordinate the location of electrical devices with casework, millwork, lockers, etc. Any electrical device that is not properly coordinated shall be relocated at no additional cost.
- Exterior wall construction is identified on the Wall Sections. Refer to the A' 4-series sheets for Wall Sections, and to A14.30, A24.30, A34.30 for Exterior Wall Assemblies.
- Refer to Exterior Elevation Notes for control joint requirements at all inside corners of masonry veneer.
- Refer to PARTITION TYPES (A12.21, A22.21, A32.21) for Partition Types Legend.
- Interior partitions are Type "P6" unless noted otherwise.
- Refer to Detail 4/A0.31 for Typical Door Maneuvering Clearances. All new doors shall meet the requirements of that detail. If any door is found that does not comply with these requirements, request clarification from the Architect prior to construction.
- Refer to PARTITION DETAILS sheets for Typical Partition Penetration Details, including pipe, conduit and ductwork penetrations.
- Refer to PARTITION DETAILS sheets for Typical Bracing at Non-Loadbearing CMU Partitions.
- Refer to Exterior Elevations for exact locations of downspouts.
- Provide factory bullnose units at all interior exposed vertical edges of CMU, except at starter course with applied base material where square-edge units shall be provided in lieu of bullnose units.
- Provide 4" starter courses at all CMU walls and partitions unless noted otherwise.
- Provide steel or masonry lintels over all openings in CMU walls, including those required for mechanical ductwork and dampers, whether specifically indicated on the drawings or not.
- Provide minimum 20 gage light-gage steel studs at all interior partitions scheduled to receive ceramic tile or plaster.
- Provide minimum 18 gage cold-formed steel studs at all interior partitions scheduled to receive anchored masonry or stone veneer as well as interior partitions with steel plate or steel sheet X-bracing.
- Provide minimum 18 gage cold-formed steel studs as designed by stud engineer for all interior partitions scheduled to receive adhered masonry or stone veneer.
- At light-gage steel stud partitions that extend above the ceiling, provide diagonal 20 gage stud braces at 4'-0" o.c. to structure above (not to steel deck) as required to provide rigid anchorage and support of partitions.
- Provide minimum 2 X 6 fire-retardant treated wood blocking in both new and existing stud walls and partitions, at mounting locations for wall-mounted accessories, handrails, casework, markerboards, tackboards, folding partitions, toilet partitions, and all other wall-mounted items. Refer to CASEWORK ELEVATIONS & DETAILS sheets for typical blocking requirements at various conditions.
- At Mechanical, Electrical and Boiler Room partitions, seal tightly around all penetrations. Utilize fire safing material at rated partitions.
- Provide sealant and/or fire safing at all floor penetrations, as applicable.
- Existing equipment to remain U.N.O. Contractor to relocate equipment as needed to complete new construction. Contractor shall reinstall equipment upon completion of construction. All equipment to be in as good or better working condition as prior to the start of construction.

FLOOR PLAN LEGEND

- METAL STUD PARTITION. Extend 4" above highest ceiling plane and brace to structure above as noted in Floor Plan Notes. Refer to Reflected Ceiling Plan for fire, smoke and sound-conditioned partitions that extend to deck above.
- CMU PARTITION. Extend 4" above highest ceiling plane and brace to structure above as detailed. Refer to Reflected Ceiling Plan for fire, smoke and sound-conditioned partitions that extend to deck above.
- EXISTING WALL TO REMAIN.
- MOVEABLE METAL SHELVING. Depth and Width dimensions match that of this legend, unless otherwise noted.
- FURNITURE, FIXTURE OR EQUIPMENT BY OWNER. Coordinate with adjacent electrical devices, casework, etc.
- MB MARKERBOARD. Preceding number is length, in feet.
- SL WITH HALF STAFF LINES
- TB TACKBOARD. Preceding number is length, in feet.
- TS TACK STRIP. Preceding number is length, in feet.
- IM INTERACTIVE MARKERBOARD
- EX- EXISTING
- IFP INTERACTIVE FLAT PANEL
- FEC FIRE EXTINGUISHER WITH CABINET AND BRACKET
- FE FIRE EXTINGUISHER WITH BRACKET
- FHC FIRE HOSE CABINET
- HB HORIZONTAL BLINDS
- RS ROLLING WINDOW SHADES
- DS DOWNSPOUT

KEYNOTE LEGEND


- W4 INFILL OPENING TO MATCH EXISTING WALL DEPTH AND CONSTRUCTION.



ARCHITECT

VLK Architects, Inc.
20445 State Hwy 249, Suite 350
Houston, Texas 77070
Main Phone: 281.671.2300
www.vlkarchitects.com

CYPRESS-FAIRBANKS INDEPENDENT HOUSTON, TEXAS

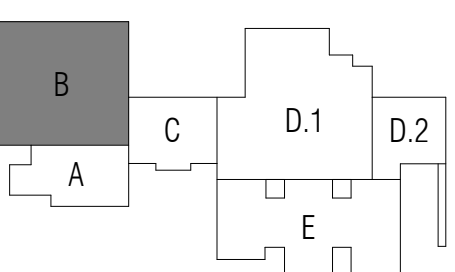

KEY PLAN



ISSUED: 03/06/25

REVISIONS	
Revision No.	Revision Date

Director: RSJ
Designer: TQ

Drawn By: STH, KM
Quality Control: TQ

PROJECT NO.

24-010.00


SHEET TITLE

COOK - UNIT B FLOOR PLAN - LEVEL ONE

SHEET NO.

A12.11B

2024 Cook, Labay & Truitt MS Renovations

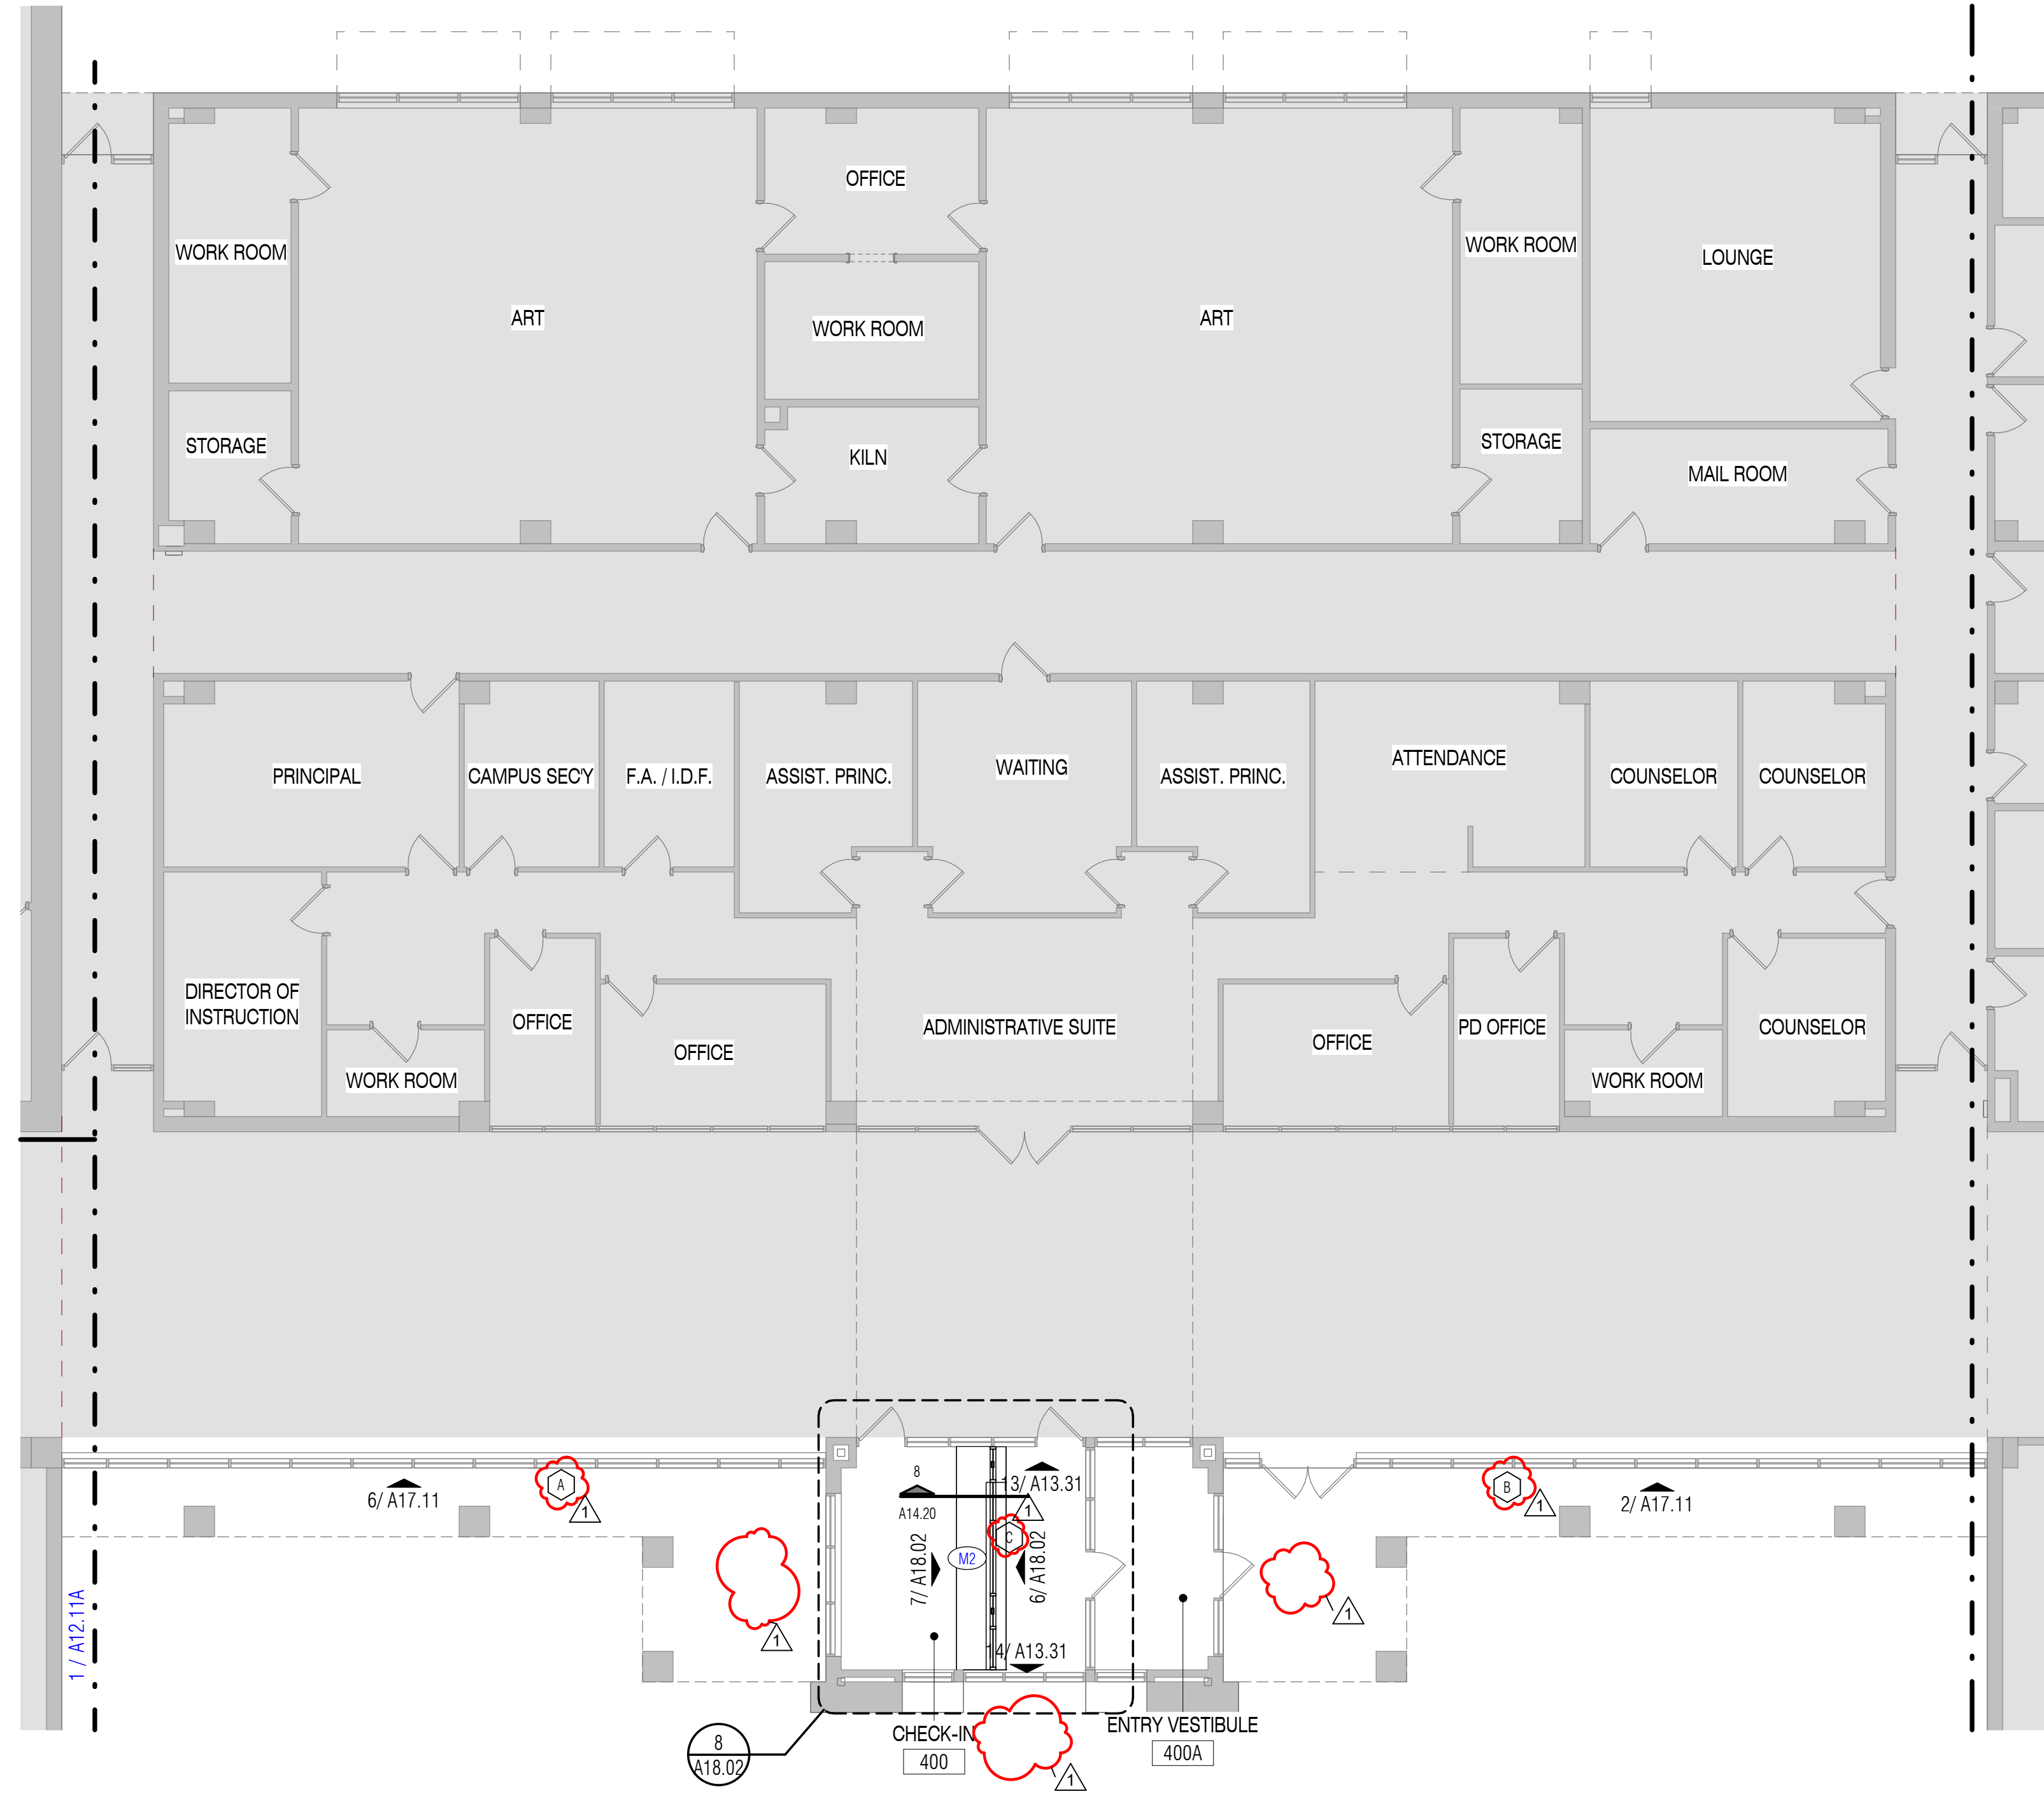

1 UNIT "C" PLAN - LEVEL ONE
SCALE: 1/8" = 1'-0"


- ### FLOOR PLAN NOTES
- Refer to Civil Grading drawings for Primary Ground Level floor elevation relative to Mean Sea Level. Architectural Finish Floor (100'-0" datum) is equal to Civil FFE.
 - Dimensions on Floor Plans are to face of stud or CMU unless noted otherwise.
 - Coordinate the location of electrical devices with casework, millwork, lockers, etc. Any electrical device that is not properly coordinated shall be relocated at no additional cost.
 - Exterior wall construction is identified on the Wall Sections. Refer to the A' 4-series sheets for Wall Sections, and to A14.30, A24.30, A34.30 for Exterior Wall Assemblies.
 - Refer to Exterior Elevation Notes for control joint requirements at all inside corners of masonry veneer.
 - Refer to PARTITION TYPES (A12.21, A22.21, A32.21) for Partition Types Legend.
 - Interior partitions are Type "P6" unless noted otherwise.
 - Refer to Detail 4/A0.31 for Typical Door Maneuvering Clearances. All new doors shall meet the requirements of that detail. If any door is found that does not comply with these requirements, request clarification from the Architect prior to construction.
 - Refer to PARTITION DETAILS sheets for Typical Partition Penetration Details, including pipe, conduit and ductwork penetrations.
 - Refer to PARTITION DETAILS sheets for Typical Bracing at Non-Loadbearing CMU Partitions.
 - Refer to Exterior Elevations for exact locations of downspouts.
 - Provide factory bullnose units at all interior exposed vertical edges of CMU, except at starter course with applied base material where square-edge units shall be provided in lieu of bullnose units.
 - Provide 4" starter courses at all CMU walls and partitions unless noted otherwise.
 - Provide steel or masonry lintels over all openings in CMU walls, including those required for mechanical ductwork and dampers, whether specifically indicated on the drawings or not.
 - Provide minimum 20 gage light-gage steel studs at all interior partitions scheduled to receive ceramic tile or plaster.
 - Provide minimum 18 gage cold-formed steel studs at all interior partitions scheduled to receive anchored masonry or stone veneer as well as interior partitions with steel plate or steel sheet X-bracing.
 - Provide minimum 18 gage cold-formed steel studs as designed by stud engineer for all interior partitions scheduled to receive adhered masonry or stone veneer.
 - At light-gage steel stud partitions that extend above the ceiling, provide diagonal 20 gage stud braces at 4'-0" o.c. to structure above (not to steel deck) as required to provide rigid anchorage and support of partitions.
 - Provide minimum 2 X 6 fire-retardant treated wood blocking in both new and existing stud walls and partitions, at mounting locations for wall-mounted accessories, handrails, casework, markerboards, tackboards, folding partitions, toilet partitions, and all other wall-mounted items. Refer to CASEWORK ELEVATIONS & DETAILS sheets for typical blocking requirements at various conditions.
 - At Mechanical, Electrical and Boiler Room partitions, seal tightly around all penetrations. Utilize fire safing material at rated partitions, as applicable.
 - Provide sealant and/or fire safing at all floor penetrations, as applicable.
 - Existing equipment to remain U.N.O. Contractor to relocate equipment as needed to complete new construction. Contractor shall reinstall equipment upon completion of construction. All equipment to be in as good or better working condition as prior to the start of construction.

- ### FLOOR PLAN LEGEND
- METAL STUD PARTITION. Extend 4" above highest ceiling plane and brace to structure above as noted in Floor Plan Notes. Refer to Reflected Ceiling Plan for fire, smoke and sound-conditioned partitions that extend to deck above.
 - CMU PARTITION. Extend 4" above highest ceiling plane and brace to structure above as detailed. Refer to Reflected Ceiling Plan for fire, smoke and sound-conditioned partitions that extend to deck above.
 - EXISTING WALL TO REMAIN.
 - MOVABLE METAL SHELVING. Depth and Width dimensions match that of this legend, unless otherwise noted.
 - FURNITURE, FIXTURE OR EQUIPMENT BY OWNER. Coordinate with adjacent electrical devices, casework, etc.
 - MB MARKERBOARD. Preceding number is length, in feet.
 - SL WITH HALF STAFF LINES
 - TB TACKBOARD. Preceding number is length, in feet.
 - TS TACK STRIP. Preceding number is length, in feet.
 - IM INTERACTIVE MARKERBOARD
 - EX EXISTING
 - IFP INTERACTIVE FLAT PANEL
 - IFF FIRE EXTINGUISHER WITH CABINET AND BRACKET
 - FEC FIRE EXTINGUISHER WITH BRACKET
 - FE FIRE EXTINGUISHER WITH BRACKET
 - FHC FIRE HOSE CABINET
 - HB HORIZONTAL BLINDS
 - RS ROLLING WINDOW SHADES
 - DS DOWNSPOUT

- ### KEYNOTE LEGEND
- M2 NEW CASEWORK AND STOREFRONT ASSEMBLY.



ARCHITECT
VLK Architects
 20445 State Hwy 249, Suite 350
 Houston, Texas 77070
 Main Phone: 281.671.2300
 www.vlkarchitects.com

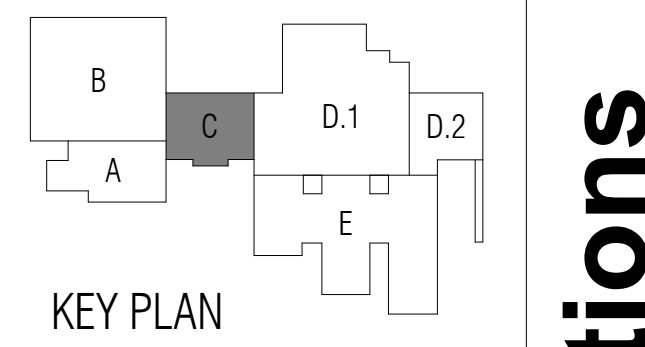

ISSUED: February 24, 2025

Revision No.	Revision Date
1 Addendum 1	03-06-2025

Director: RSJ
 Drawn By: STH, KM
 Designer: Quality Control

Proj. Arch.: TQ

PROJECT NO.
24-010.00

SHEET TITLE
COOK - UNIT C FLOOR PLAN - LEVEL ONE

SHEET NO.


A12.11C

CYPRESS-FAIRBANKS INDEPENDENT SCHOOL DISTRICT
 HOUSTON, TEXAS


2024 Cook, Labay & Truitt MS Renovations

SHOP EQUIPMENT - COOK	
MARK	EQUIPMENT
A1	TABLE
A2	TABLE (BUTCHERBLOCK ON LOCKERS)
A3	GLUE-UP TABLE
B	DRILL PRESS
C1	LATHE (FLOOR)
C2	LATHE (TABLE)
D	SCROLL SAW
E	BAND SAW
F	SANDBLASTER
G1	SPINDLE SANDER
G2	SANDER
H	JOINTER
J	PLANER
K	HEAT TREAT OVEN
L	DRUM SANDER
M	TABLE SAW
N	SQUARING SHEARS
P	METAL MITER SAW
Q	CNC
R	LASER CUTTER
S1	METAL STORAGE RACK
S2	STORAGE CAGE (WELDING MASKS)
S3	CABINET
T	METAL BRAKE
U	CUTTING BLOCK


- ### FLOOR PLAN NOTES
- Refer to Civil Grading drawings for Primary Ground Level floor elevation relative to Mean Sea Level. Architectural Finish Floor (100'-0" datum) is equal to Civil FFE.
 - Dimensions on Floor Plans are to face of stud or CMU unless noted otherwise.
 - Coordinate the location of electrical devices with casework, millwork, lockers, etc. Any electrical device that is not properly coordinated shall be relocated at no additional cost.
 - Exterior wall construction is identified on the Wall Sections. Refer to the A' 4-series sheets for Wall Sections, and to A14.30, A24.30, A34.30 for Exterior Wall Assemblies.
 - Refer to Exterior Elevation Notes for control joint requirements at all inside corners of masonry veneer.
 - Refer to PARTITION TYPES (A12.21, A22.21, A32.21) for Partition Types Legend.
 - Interior partitions are Type "P6" unless noted otherwise.
 - Refer to Detail 4/A0.31 for Typical Door Maneuvering Clearances. All new doors shall meet the requirements of that detail. If any door is found that does not comply with these requirements, request clarification from the Architect prior to construction.
 - Refer to PARTITION DETAILS sheets for Typical Partition Penetration Details, including pipe, conduit and ductwork penetrations.
 - Refer to PARTITION DETAILS sheets for Typical Bracing at Non-Loadbearing CMU Partitions.
 - Refer to Exterior Elevations for exact locations of downspouts.
 - Provide factory bullnose units at all interior exposed vertical edges of CMU, except at starter course with applied base material where square-edge units shall be provided in lieu of bullnose units.
 - Provide 4" starter courses at all CMU walls and partitions unless noted otherwise.
 - Provide steel or masonry lintels over all openings in CMU walls, including those required for mechanical ductwork and dampers, whether specifically indicated on the drawings or not.
 - Provide minimum 20 gage light-gage steel studs at all interior partitions scheduled to receive ceramic tile or plaster.
 - Provide minimum 18 gage cold-formed steel studs at all interior partitions scheduled to receive anchored masonry or stone veneer as well as interior partitions with steel plate or steel sheet X-bracing.
 - Provide minimum 18 gage cold-formed steel studs as designed by stud engineer for all interior partitions scheduled to receive adhered masonry or stone veneer.
 - At light-gage steel stud partitions that extend above the ceiling, provide diagonal 20 gage stud braces at 4'-0" o.c. to structure above (not to steel deck) as required to provide rigid anchorage and support of partitions.
 - Provide minimum 2 X 6 fire-retardant treated wood blocking in both new and existing stud walls and partitions, at mounting locations for wall-mounted accessories, handrails, casework, markerboards, tackboards, folding partitions, toilet partitions, and all other wall-mounted items. Refer to CASEWORK ELEVATIONS & DETAILS sheets for typical blocking requirements at various conditions.
 - At Mechanical, Electrical and Boiler Room partitions, seal tightly around all penetrations. Utilize fire sating material at rated partitions.
 - Provide sealant and/or fire sating at all floor penetrations, as applicable.
 - Existing equipment to remain U.N.O. Contractor to relocate equipment as needed to complete new construction. Contractor shall reinstall equipment upon completion of construction. All equipment to be in as good or better working condition as prior to the start of construction.

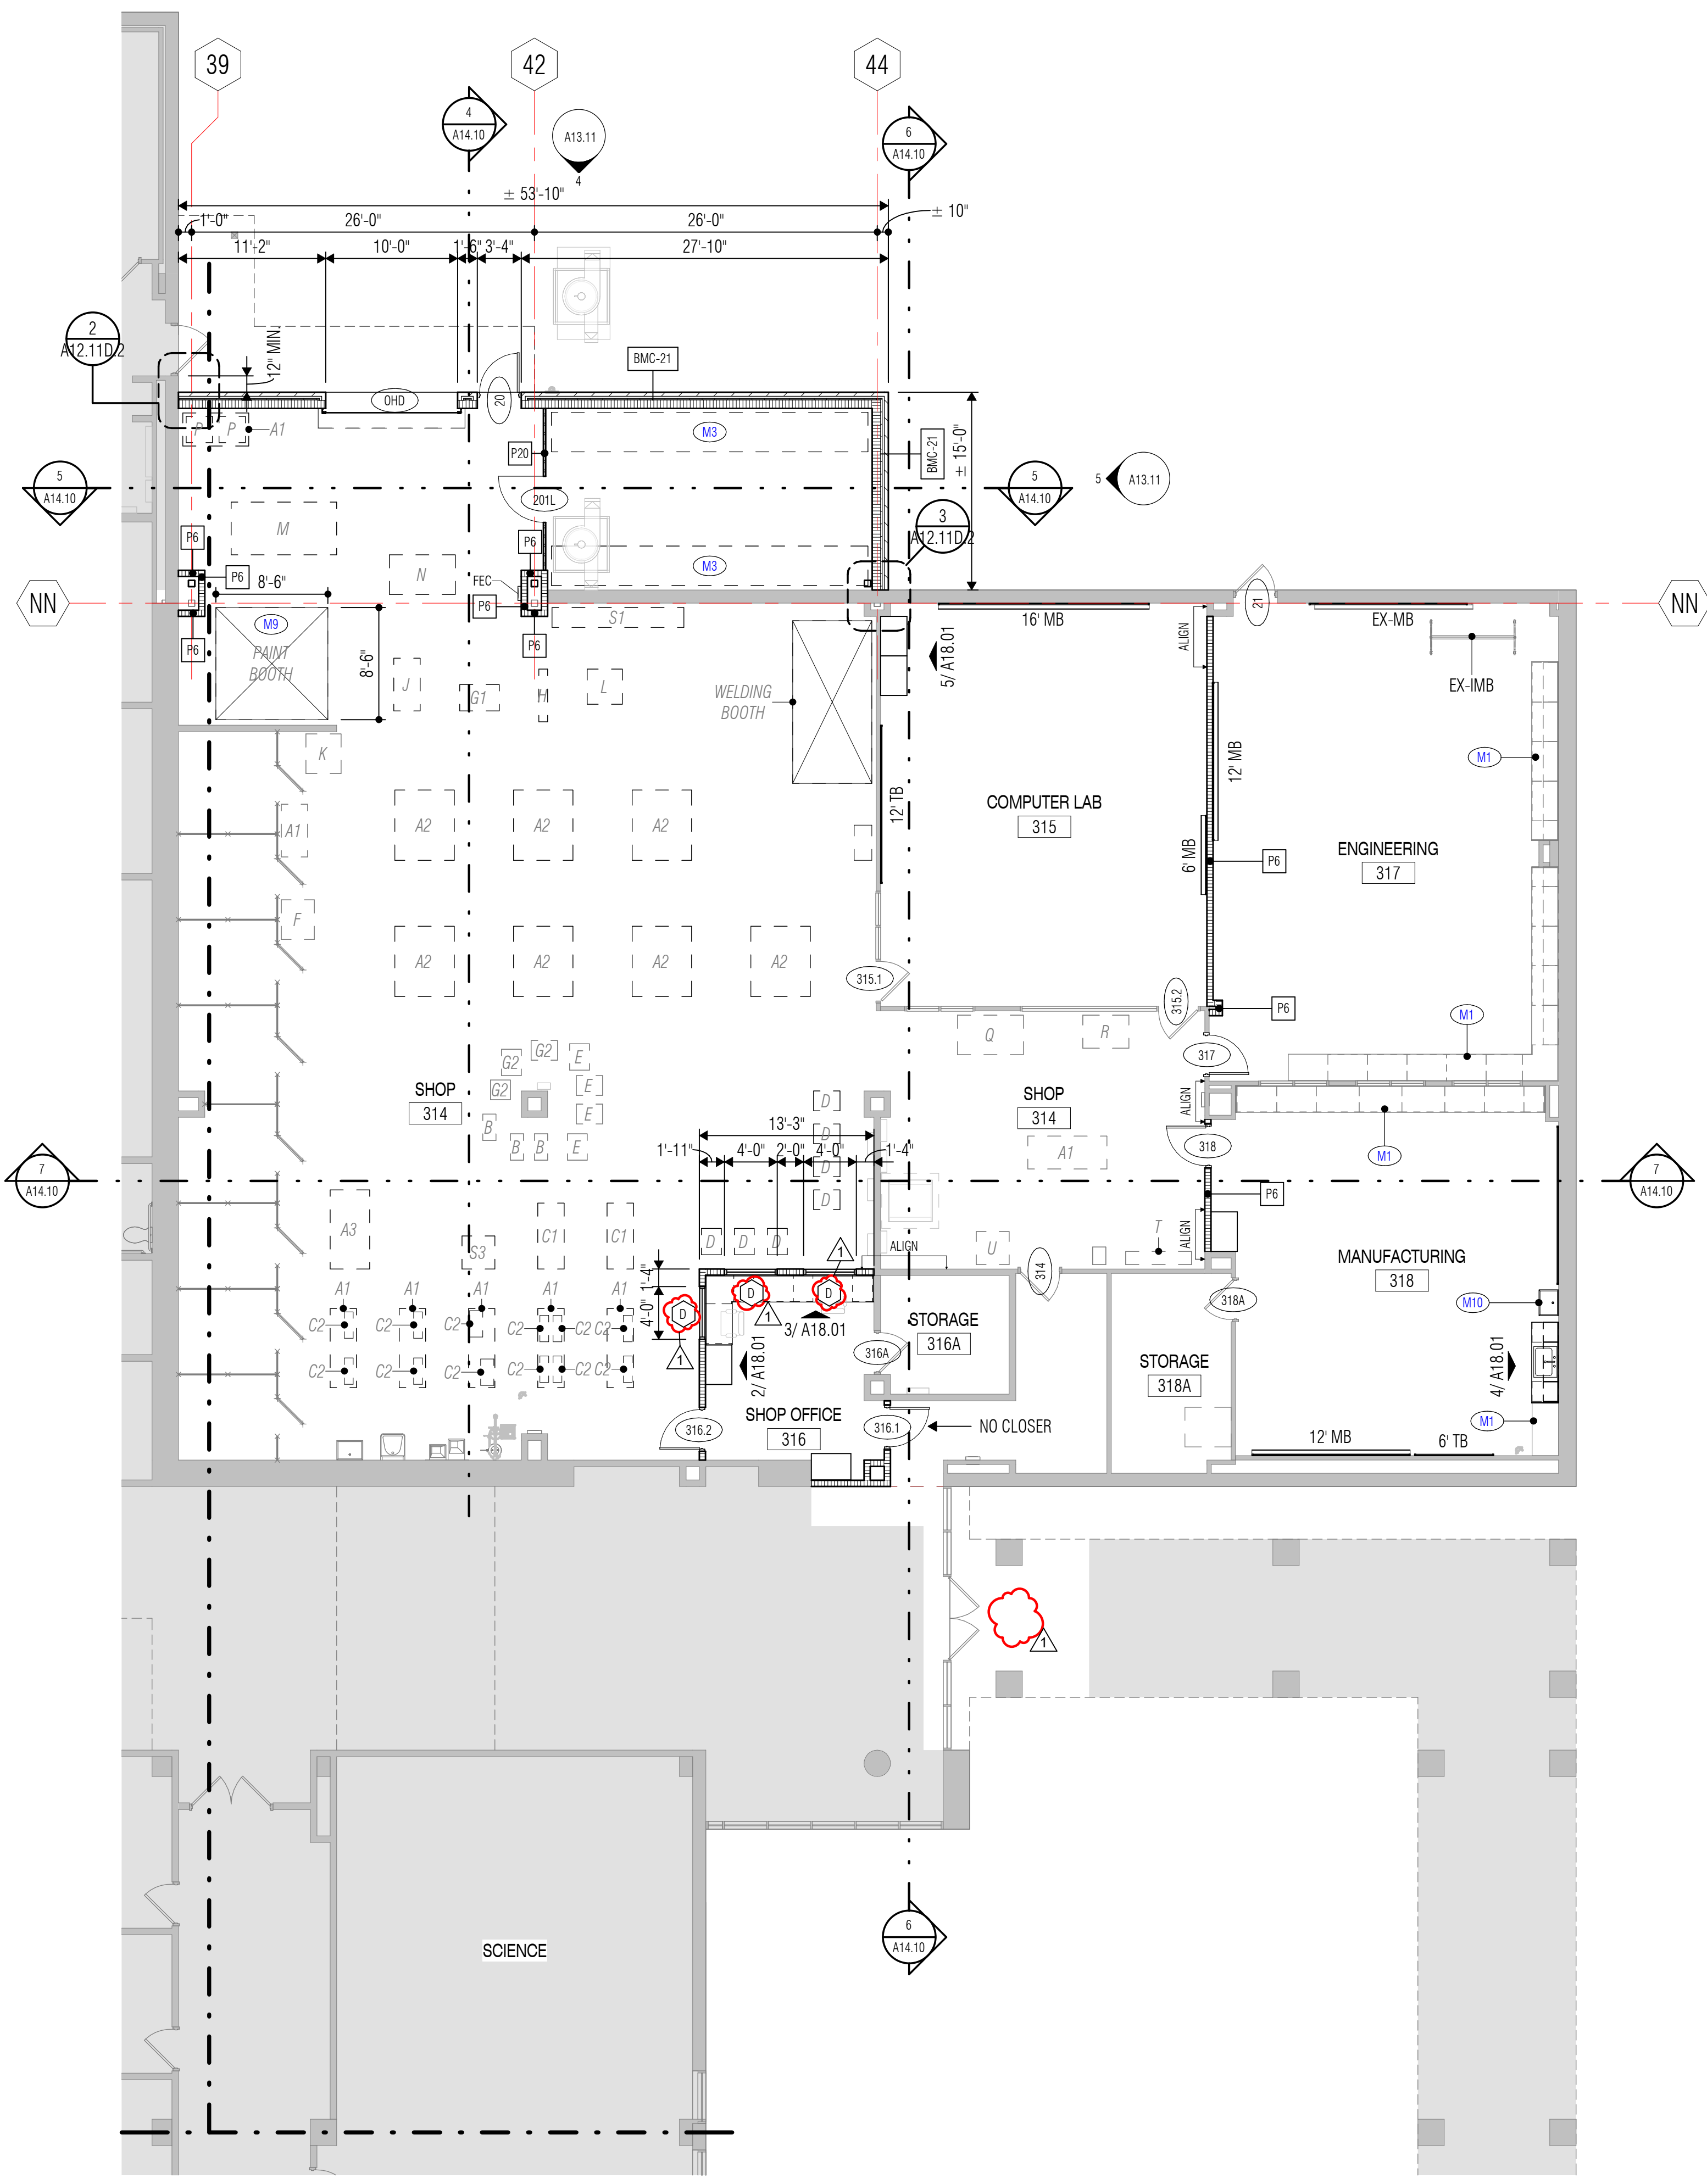

1 UNIT "D.2" PLAN - LEVEL ONE
SCALE: 1/8" = 1'-0"

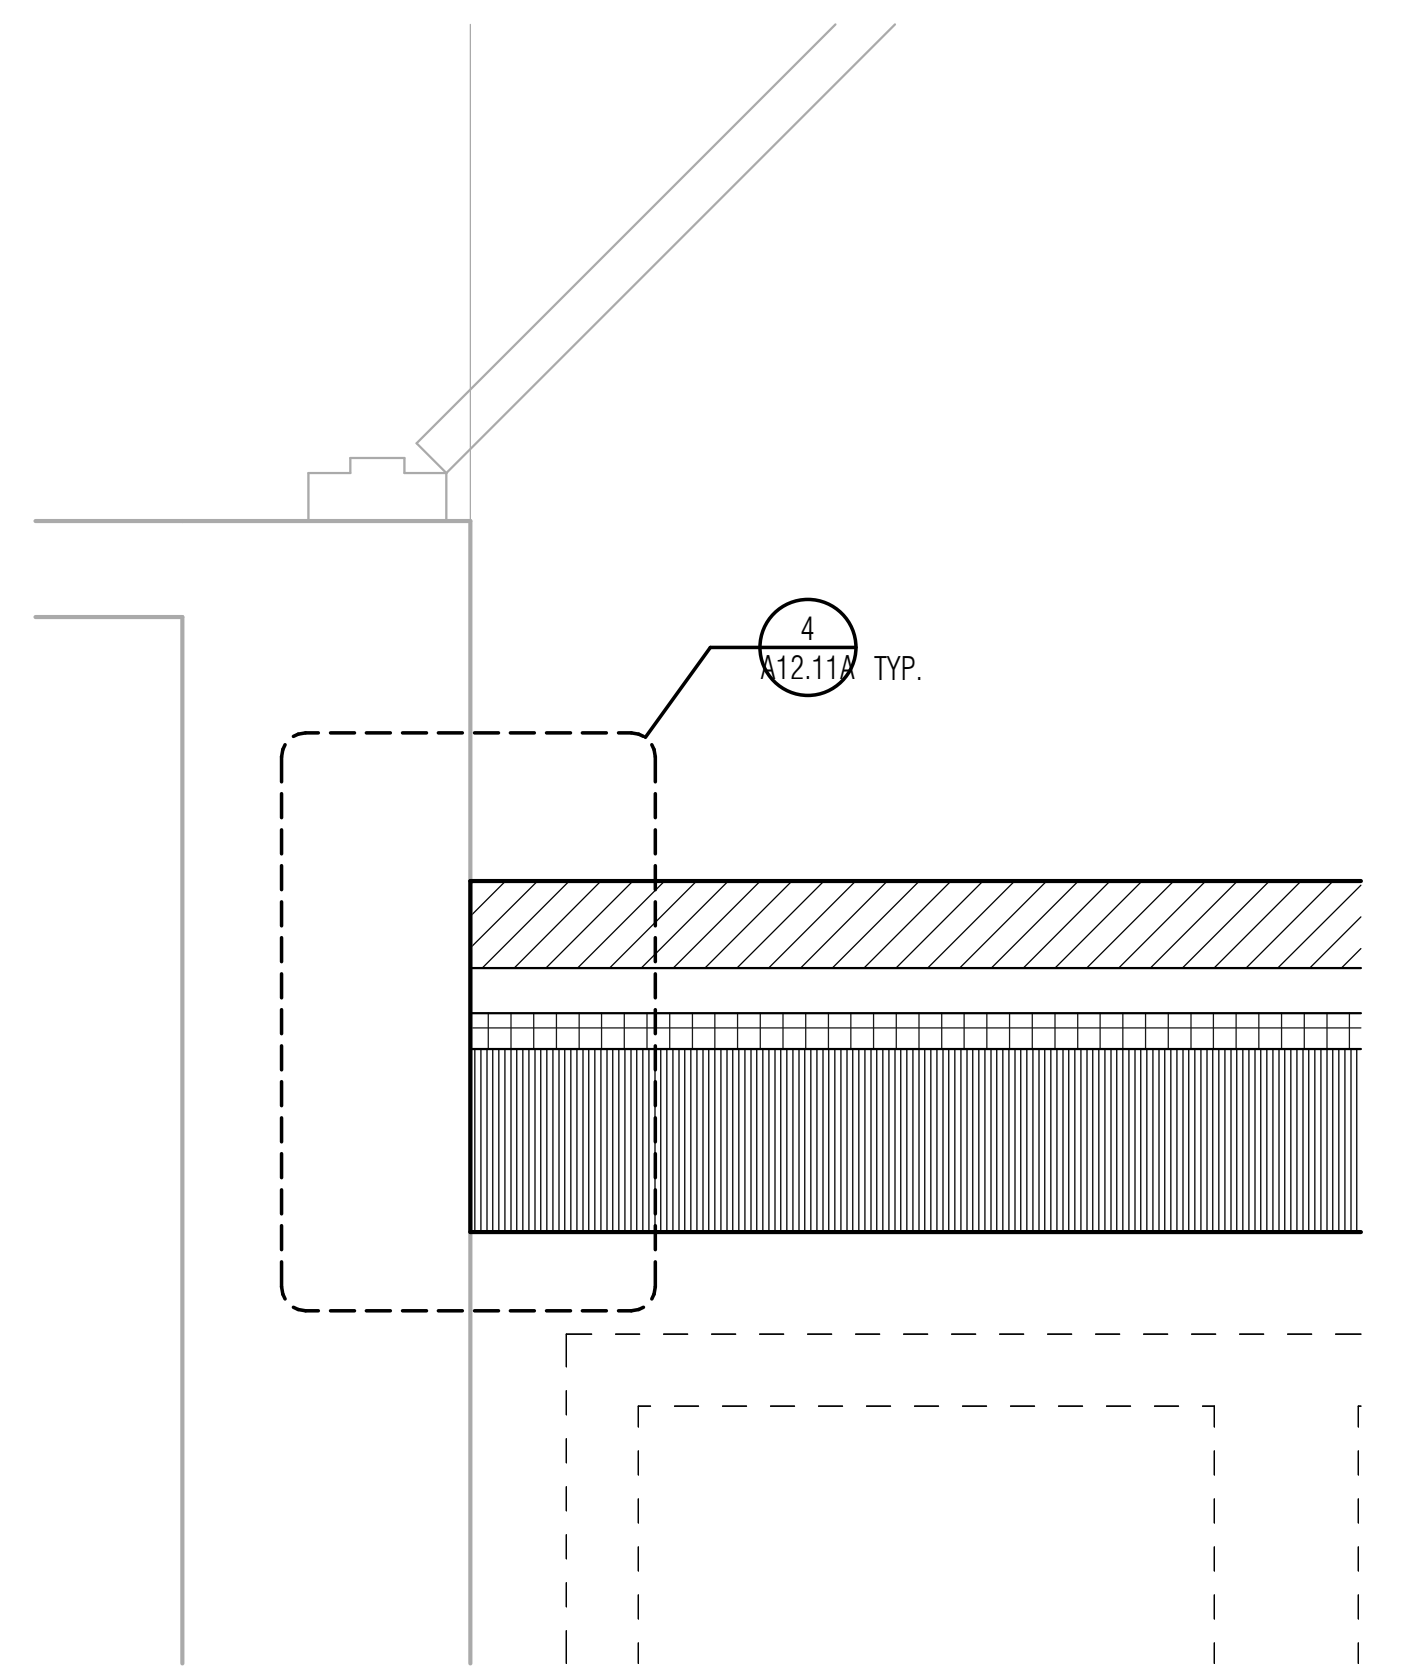

2 PLAN DETAIL
SCALE: 1 1/2" = 1'-0"

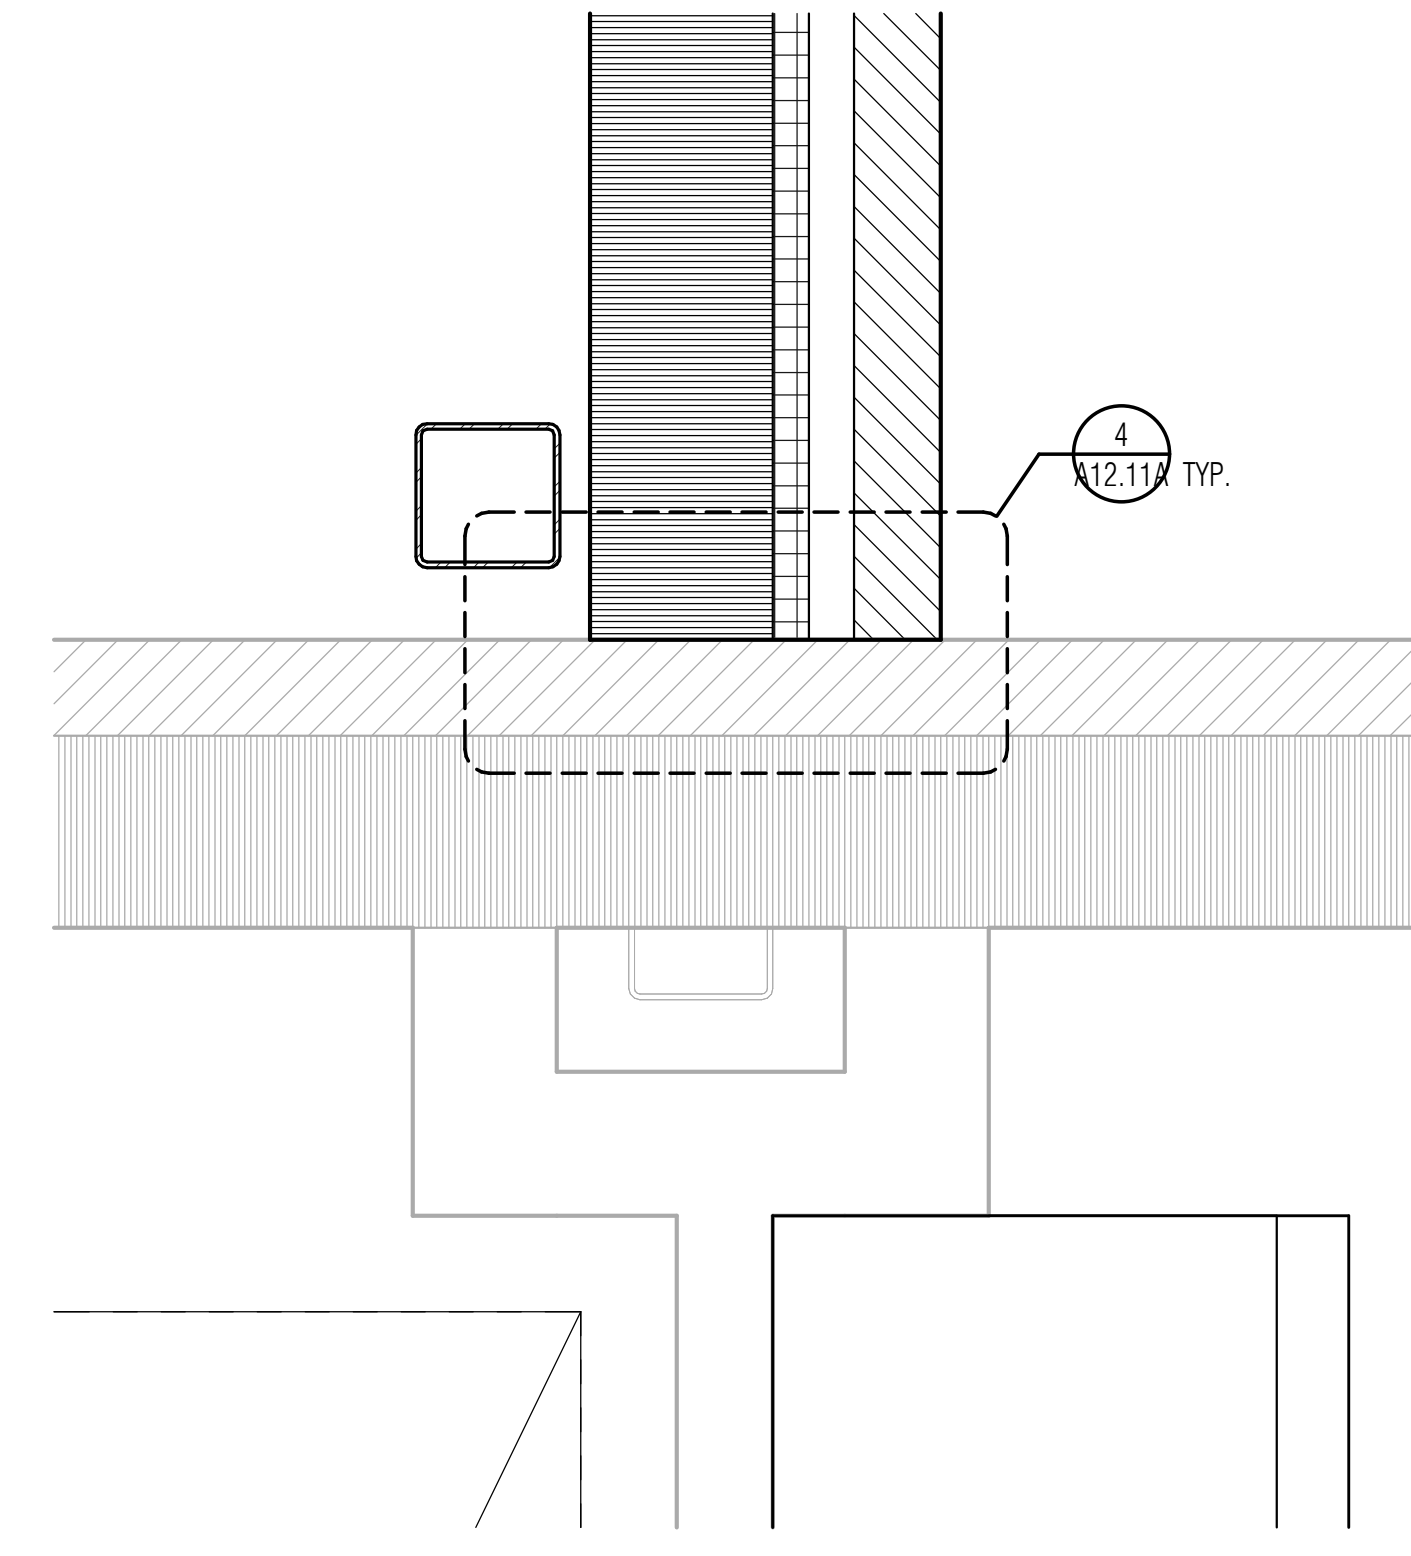

3 PLAN DETAIL
SCALE: 1 1/2" = 1'-0"


FLOOR PLAN LEGEND

- METAL STUD PARTITION. Extend 4" above highest ceiling plane and brace to structure above as noted in Floor Plan Notes. Refer to Reflected Ceiling Plan for fire, smoke and sound-conditioned partitions that extend to deck above.
- CMU PARTITION. Extend 4" above highest ceiling plane and brace to structure above as detailed. Refer to Reflected Ceiling Plan for fire, smoke and sound-conditioned partitions that extend to deck above.
- EXISTING WALL TO REMAIN.
- MOVABLE METAL SHELVING. Depth and Width dimensions match that of this legend, unless otherwise noted.
- FURNITURE, FIXTURE OR EQUIPMENT BY OWNER. Coordinate with adjacent electrical devices, casework, etc.

MB	MARKERBOARD. Preceding number is length, in feet.
SL	WITH HALF STAFF LINES
TB	TACKBOARD. Preceding number is length, in feet.
TS	TACK STRIP. Preceding number is length, in feet.
IM	INTERACTIVE MARKERBOARD
EX	EXISTING
IFP	INTERACTIVE FLAT PANEL
FEC	FIRE EXTINGUISHER WITH CABINET AND BRACKET
FE	FIRE EXTINGUISHER WITH BRACKET
FHC	FIRE HOSE CABINET
HB	HORIZONTAL BLINDS
RS	ROLLING WINDOW SHADES
DS	DOWNSPOUT

KEYNOTE LEGEND

M1	CASEWORK EXISTING TO REMAIN. PROTECT THROUGHOUT CONSTRUCTION PHASES. CONTRACTOR TO REPAIR ANY DAMAGE INCURRED DURING CONSTRUCTION.
M3	RELOCATED EXISTING MATERIAL STORAGE RACKS.
M9	NEW PAINT BOOTH AND EXHAUST SYSTEM. REF: MEP DWGS.
M10	NEW UTILITY SINK.

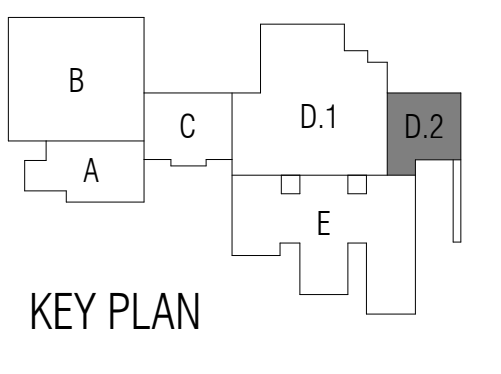

ISSUED: February 24, 2025

REVISIONS	
Revision No.	Revision Date
1 Addendum 1	03-06-2025

Director: RSJ
Designer: STH, KM

Drawn By: STH, KM
Quality Control: TQ

PROJECT NO.
24-010.00

SHEET TITLE
COOK - UNIT D.2 FLOOR PLAN - LEVEL ONE

SHEET NO.

A12.11D.2


PARTITION NOTES

- Refer to Floor Plan Notes for additional metal stud requirements at Ceramic Tile, Plaster, Anchored Masonry or Stone Veneer, and Adhered Masonry or Stone Veneer.
- Refer to Floor Plan Notes for CMU starter course requirements.
- Refer to Sheet A' 2.22 for typical partition details.
- Refer to Reflected Ceiling Plans for location of fire rated partitions.
- Refer to Reflected Ceiling Plans for location of non-rated partitions that extend to the structural deck above.
- Provide firestopping as required to achieve the fire-resistive rating at all penetrations, gaps and other openings through or around rated floors, roofs, walls and partitions.
- At all rated and acoustical partitions that extend to structural deck above, seal to the floor below and to the structure above. Provide firestopping at rated partitions, and acoustical sealant at acoustical and sound conditioned other partitions.
- At all partitions that extend to structural deck above, provide gypsum board enclosure around beams, joists, ducts, etc. as required to maintain fire-resistive ratings and acoustical requirements.
- Typical CMU notes, unless otherwise noted on structural drawings:
 - Provide steel bracing as shown on Sheet A' 2.2
 - Provide continuous bond beam with (2) #4 reinforcing bars at top course of all 6" and 8" CMU partitions, whether indicated or not.
- 4" CMU shall not be used for interior partitions, except at chase walls where specifically indicated.


STUD PARTITION SIZING SCHEDULE

STUD DEPTH	STUD SPACING	STUD GAGE	EQ STUD	MAX LENGTH	MAX LENGTH (at Tile/Plaster)
3-5/8"	16" O.C	25 (18 mils)	25EQ	15'-6"	N/A
3-5/8"	16" O.C	20 (30 mils)	20EQ	16'-0"	14'-0"
6"	16" O.C	25 (18 mils)	25EQ	21'-6"	N/A
6"	16" O.C	20 (30 mils)	20EQ	22'-6"	19'-6"

- NOTES:**
- All doors shall have a minimum of 20 gage framing where required by specifications.
 - See Floor Plan Notes and Partition Notes for additional metal stud requirements at ceramic tile, plaster, anchored masonry/stone veneer, or adhered masonry/stone veneer.
 - Max. Lengths assume both sides of studs braced full-height of partition.
 - Max. Lengths are based on 5 psf lateral loading and L/240 deflection (L/360 at tile/plaster).
 - Equivalent (EQ) studs are not allowable at abuse-resistant or impact-resistant gyp board. Provide true 20 gage studs with minimum 0.0312 inches design thickness at these locations.

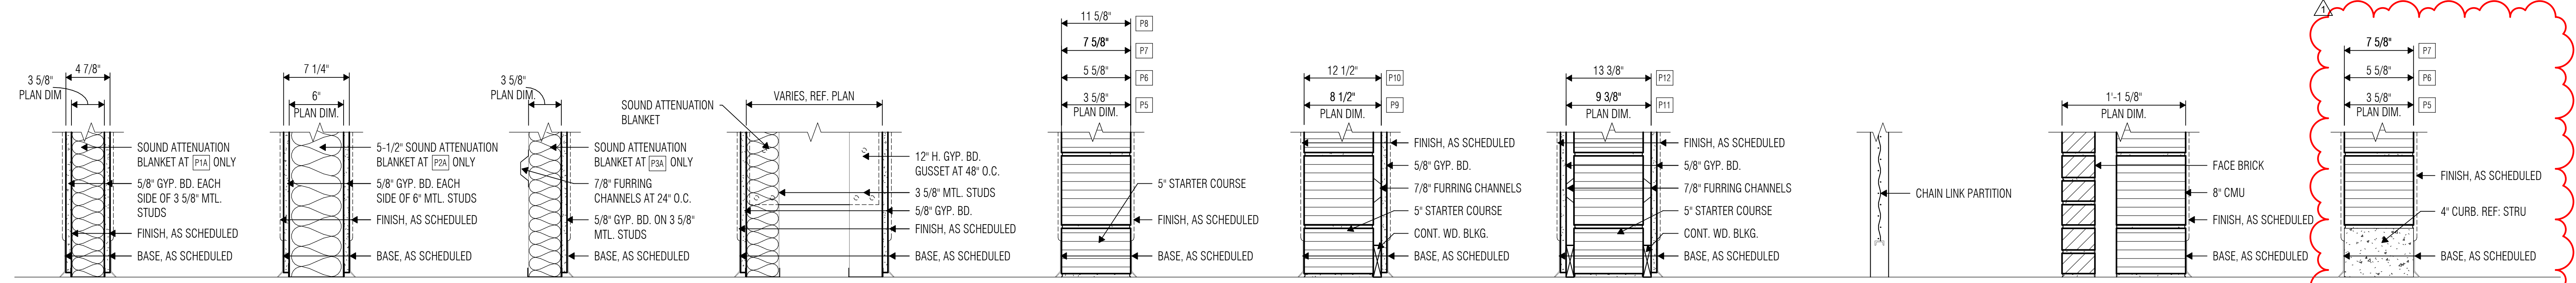

- P1 U.L. DESIGN #U423 or #U425 - ONE HOUR RATED WHERE INDICATED ON REFLECTED CEILING PLANS
- P2 U.L. DESIGN #U423 or #U425 - ONE HOUR RATED WHERE INDICATED ON REFLECTED CEILING PLANS
- P3 U.L. DESIGN #U423 or #U425 - ONE HOUR RATED WHERE INDICATED ON REFLECTED CEILING PLANS
- P4 U.L. DESIGN #U423 or #U425 - ONE HOUR RATED WHERE INDICATED ON REFLECTED CEILING PLANS
- P5 4" CMU
- P6 6" CMU
- P6S 6" CMU - GROUT FILLED
- P6A 6" CMU - U.L. #U906 - Up to 2 HR
- P7 8" CMU
- P7S 8" CMU - GROUT FILLED
- P7A 8" CMU - U.L. #U907 - Up to 4 HR (Nonbearing)
- P7B 8" CMU - U.L. #U901 - Up to 4 HR (Bearing)
- P8 12" CMU
- P8S 12" CMU - GROUT FILLED
- P8A 12" CMU - U.L. #U901 - Up to 4 HR
- P9 8" CMU
- P9S 8" CMU - GROUT FILLED
- P9A 8" CMU - U.L. #U907 - Up to 4 HR (Nonbearing)
- P9B 8" CMU - U.L. #U901 - Up to 4 HR (Bearing)
- P10 12" CMU
- P10S 12" CMU - GROUT FILLED
- P10A 12" CMU - U.L. #U901 - Up to 4 HR (Bearing)
- P11 8" CMU
- P11S 8" CMU - GROUT FILLED
- P11A 8" CMU - U.L. #U907 - Up to 4 HR (Nonbearing)
- P11B 8" CMU - U.L. #U901 - Up to 4 HR (Bearing)
- P12 12" CMU
- P12S 12" CMU - GROUT FILLED
- P12A 12" CMU - U.L. #U901 - Up to 4 HR (Bearing)
- P20 CHAIN LINK PARTITION
- P21 FACE BRICK
- P21S GROUT FILLED
- P5C 4" CMU W/ CURB
- P6C 6" CMU W/ CURB
- P7C 8" CMU W/ CURB

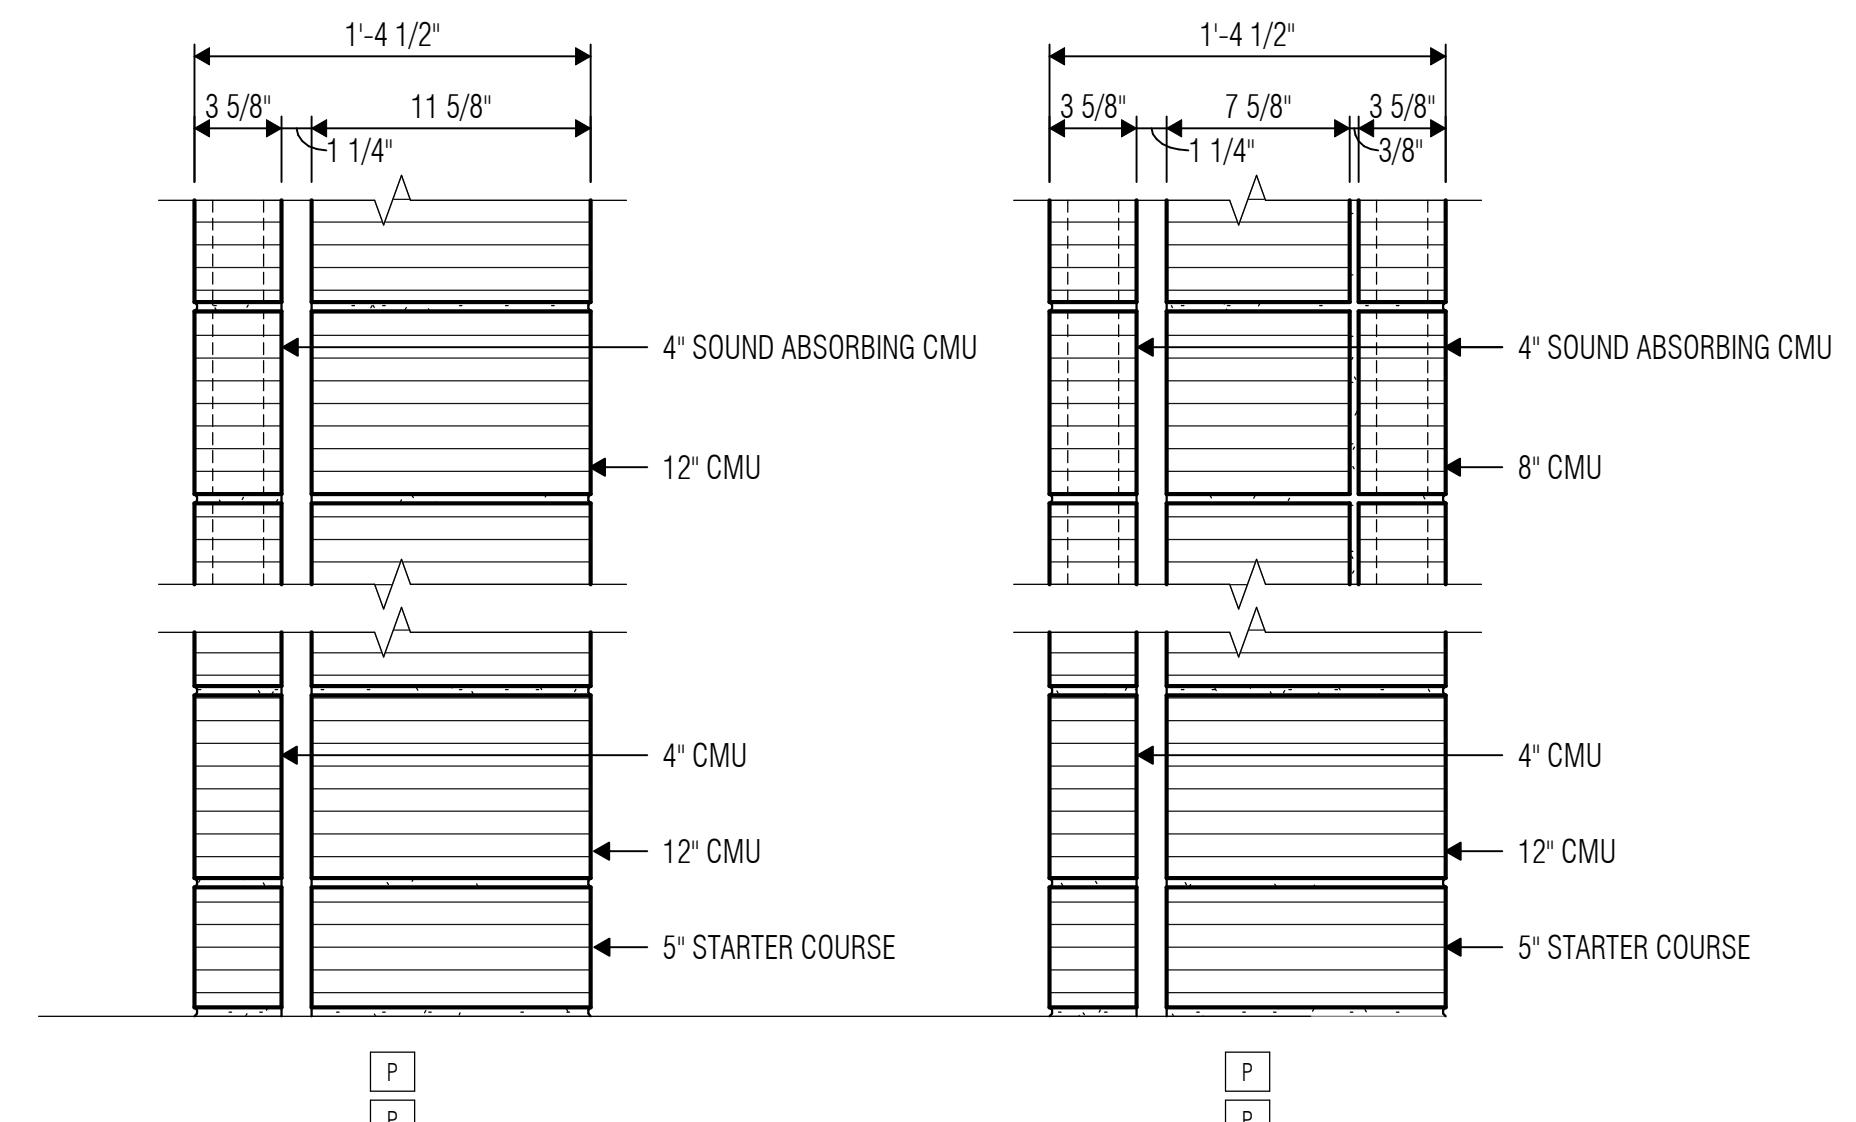

PARTITION TYPES
 SCALE: 1 1/2" = 1'-0"



ISSUED: February 24, 2025

REVISIONS

Revision No.	Revision Date
1 Addendum 1	03-06-2025


Director: RSJ
 Designer: TQ
 Drawn By: STH, KM
 Quality Control:

PROJECT NO.
24-010.00


SHEET TITLE
COOK - PARTITION TYPES

SHEET NO.


A12.21

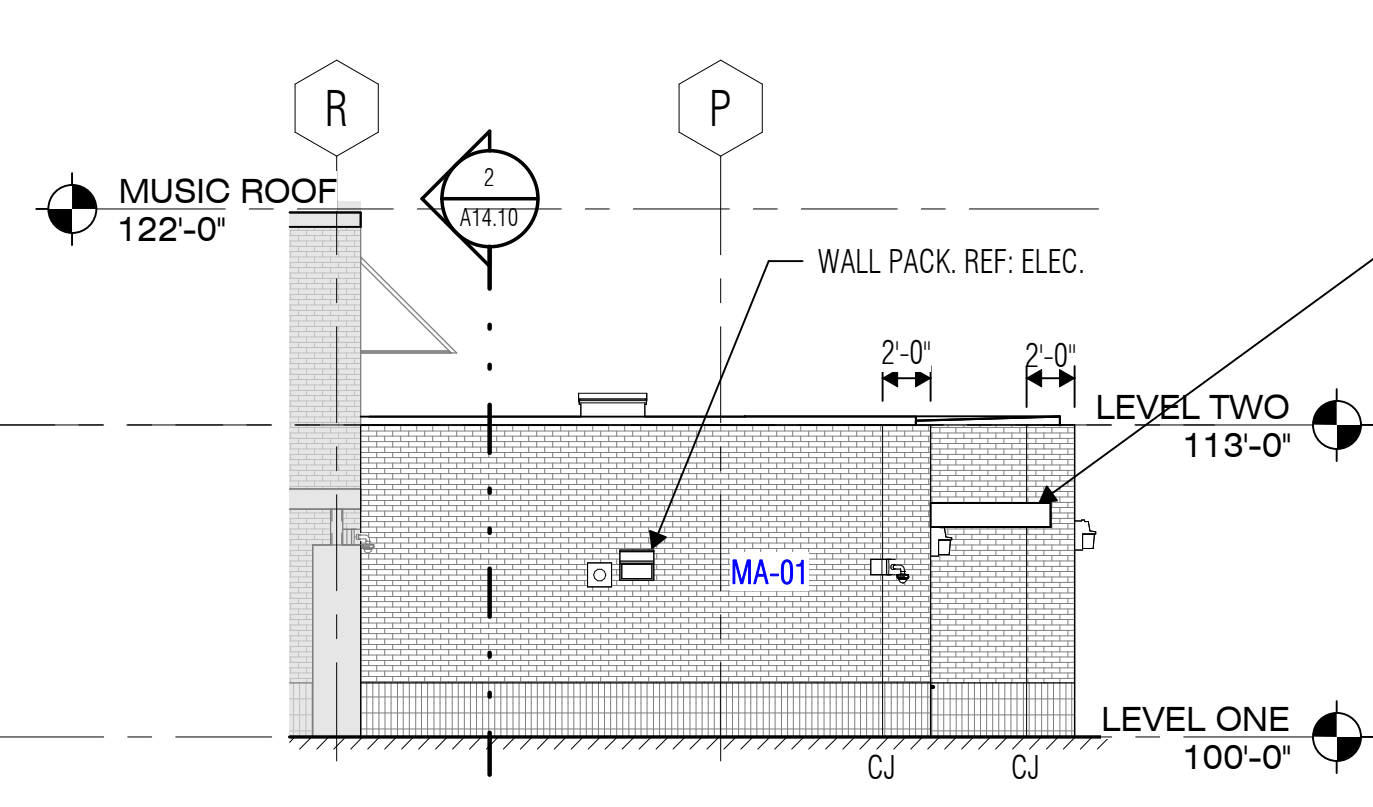


1 ORCH. ADDITION - SOUTH ELEVATION
SCALE: 1/8" = 1'-0"

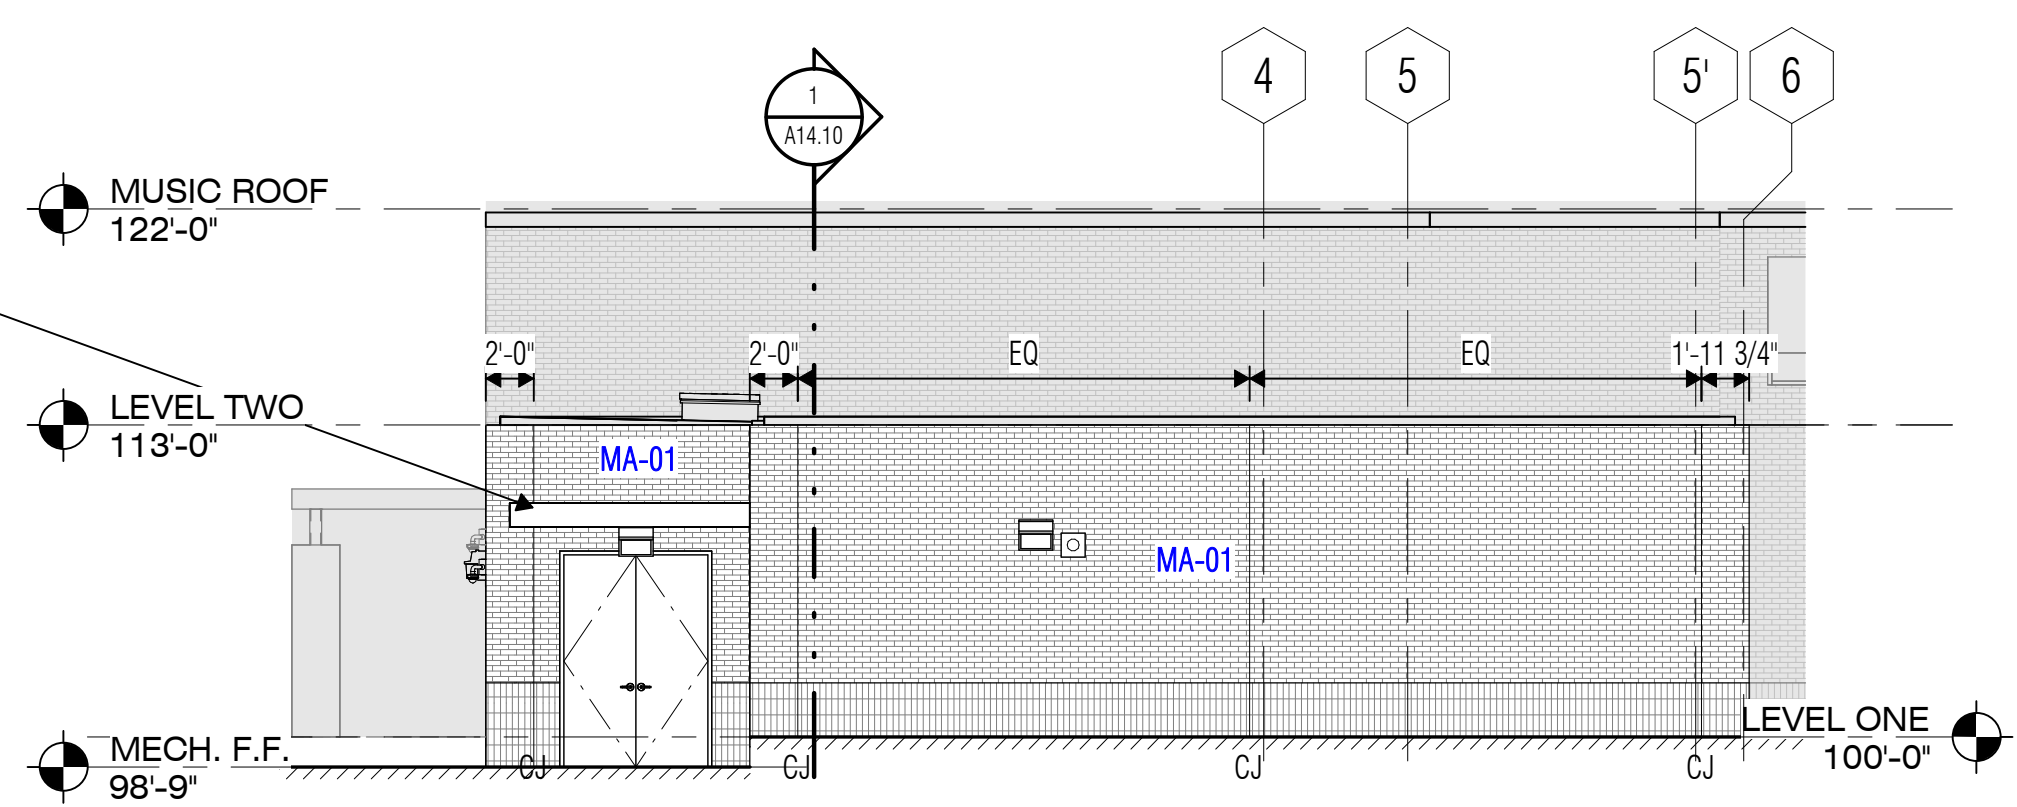


2 ORCH. ADDITION - EAST ELEVATION
SCALE: 1/8" = 1'-0"

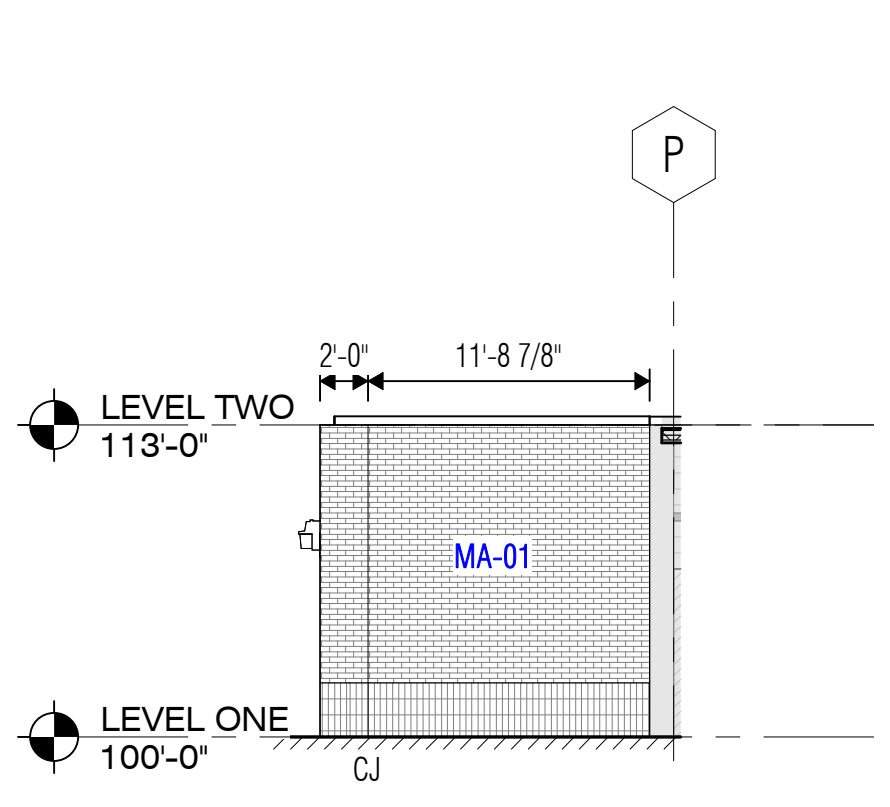


3 ORCH. ADDITION - NORTH ELEVATION
SCALE: 1/8" = 1'-0"

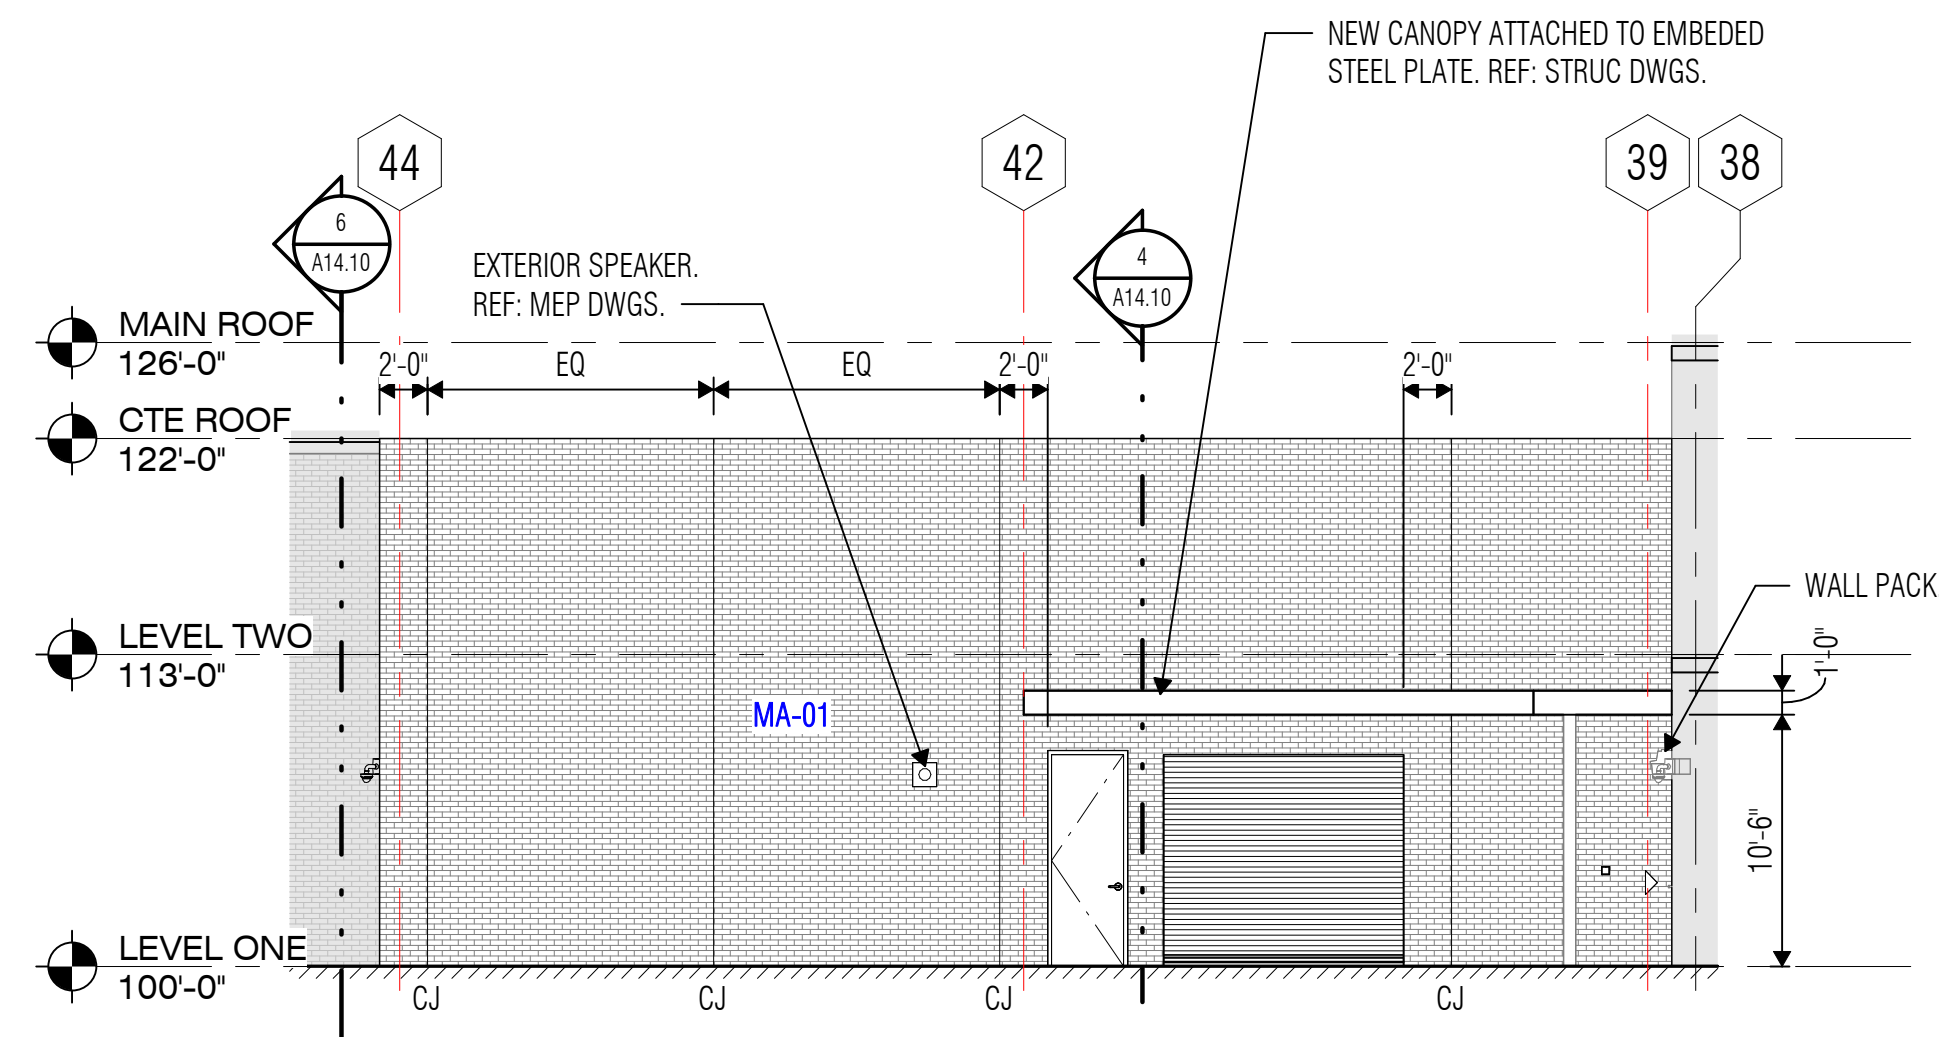


4 CTE ADDITION - WEST ELEVATION
SCALE: 1/8" = 1'-0"

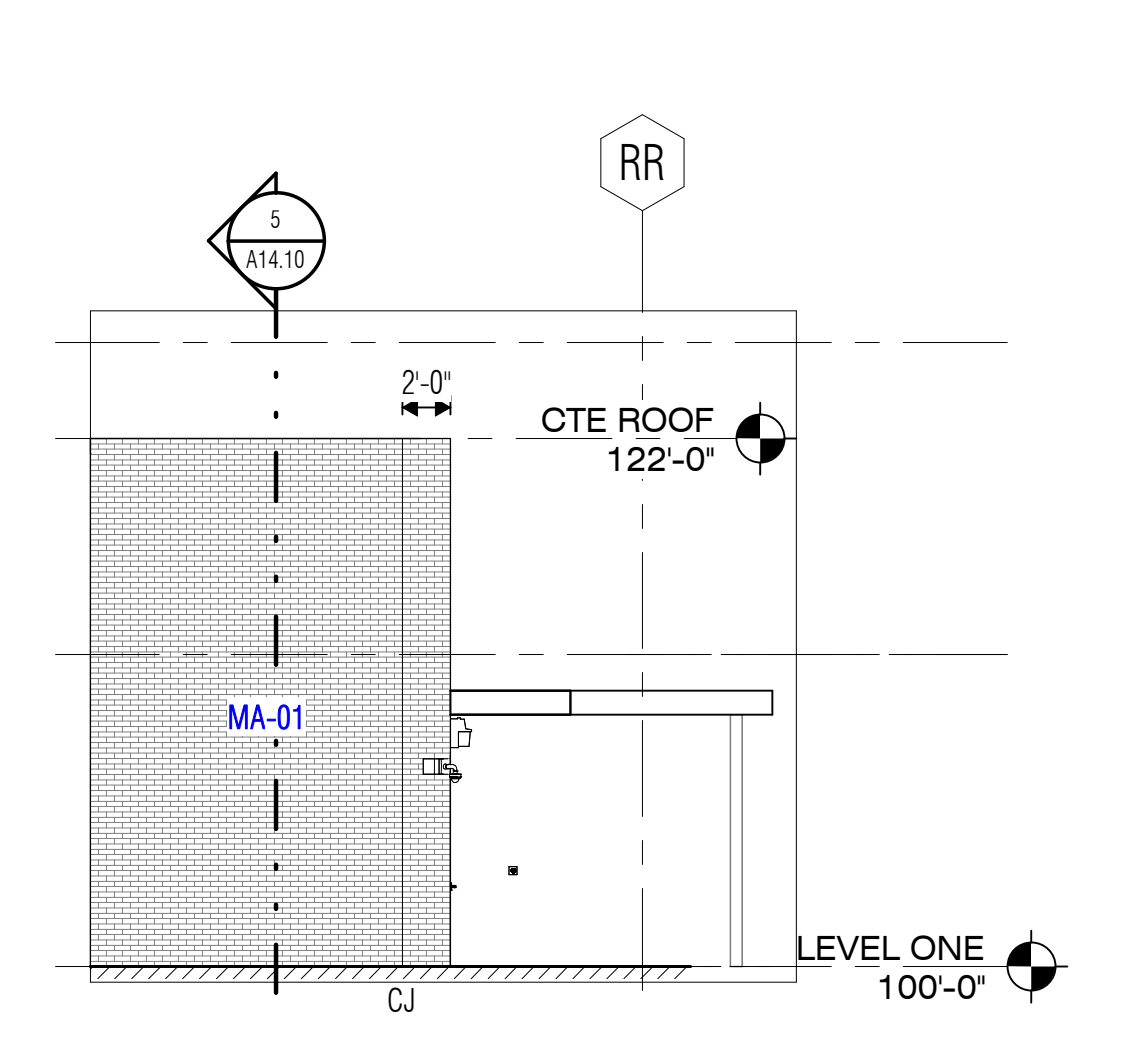


5 CTE ADDITION - NORTH ELEVATION
SCALE: 1/8" = 1'-0"

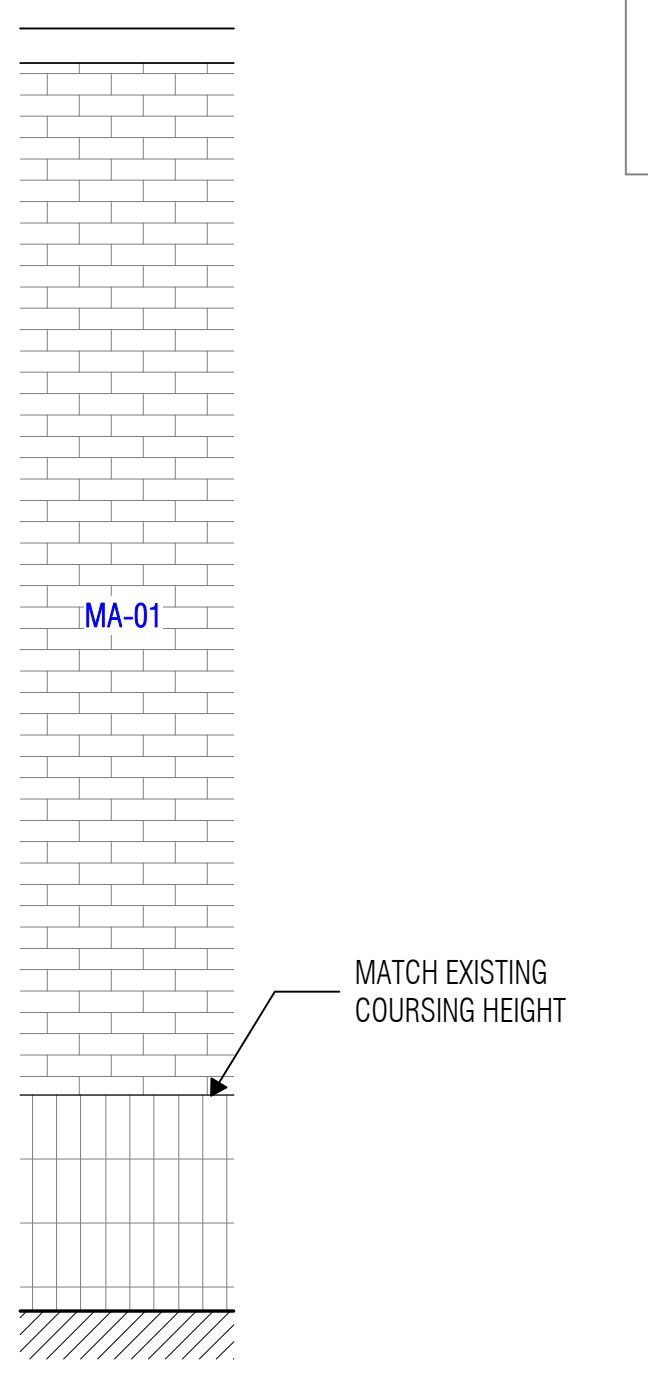


6 TYPICAL COURSING ELEVATION
SCALE: 1/2" = 1'-0"

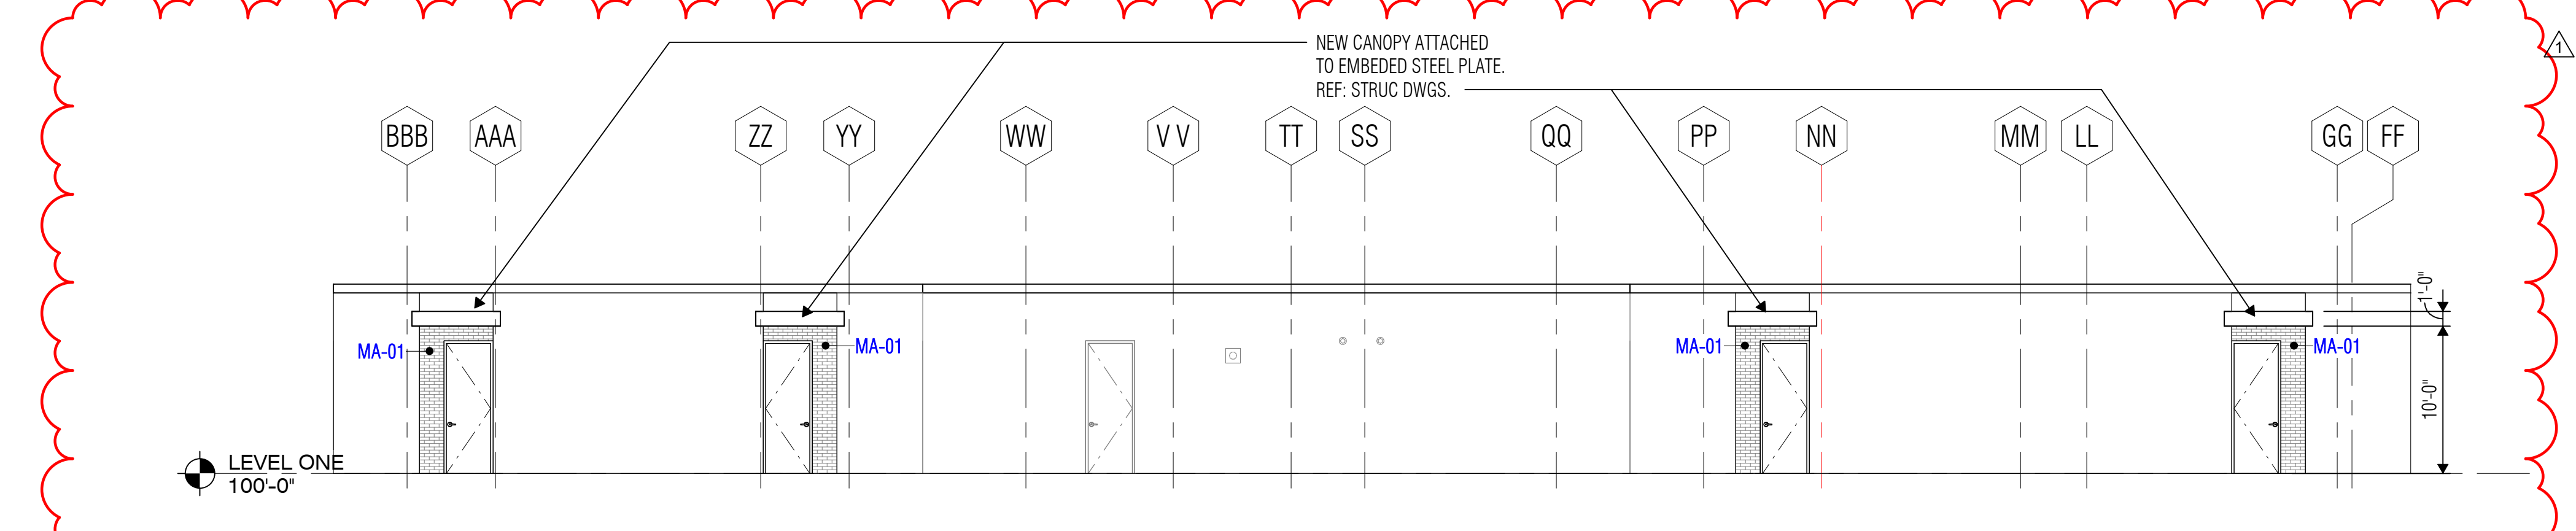


7 ATHLETICS - SOUTH ELEVATION
SCALE: 1/8" = 1'-0"

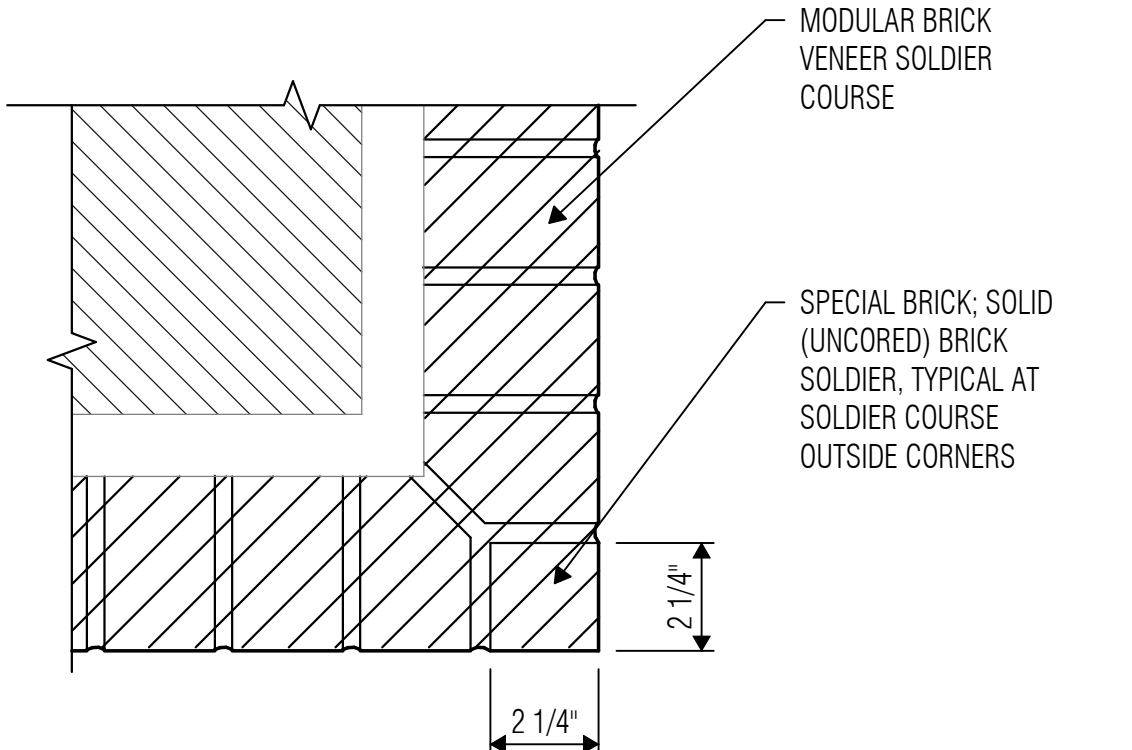


10 SOLDIER COURSE SPECIAL BRICK @ OUTSIDE CORNER
SCALE: 3" = 1'-0"

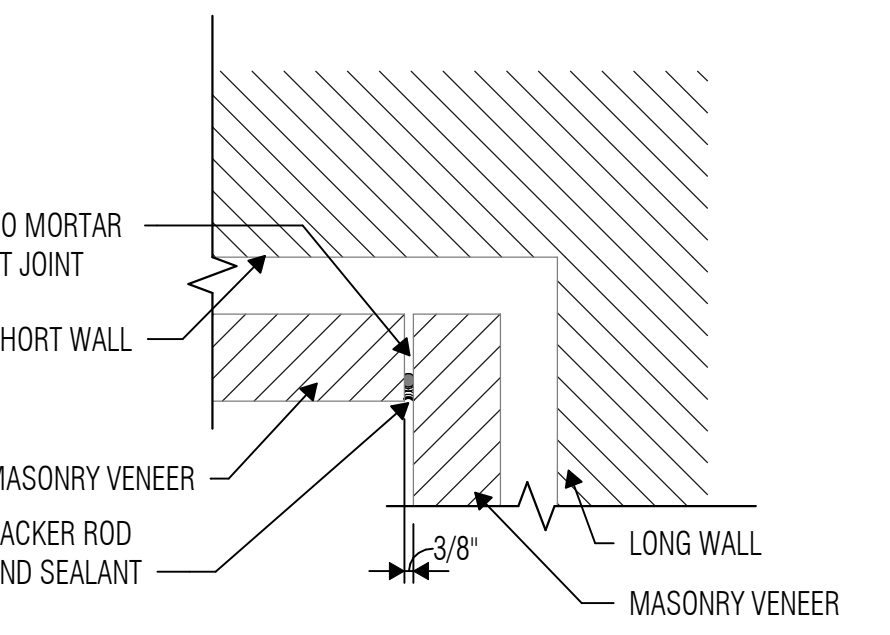


11 MASONRY VENEER CONTROL JOINT INSIDE CORNER
SCALE: 1 1/2" = 1'-0"

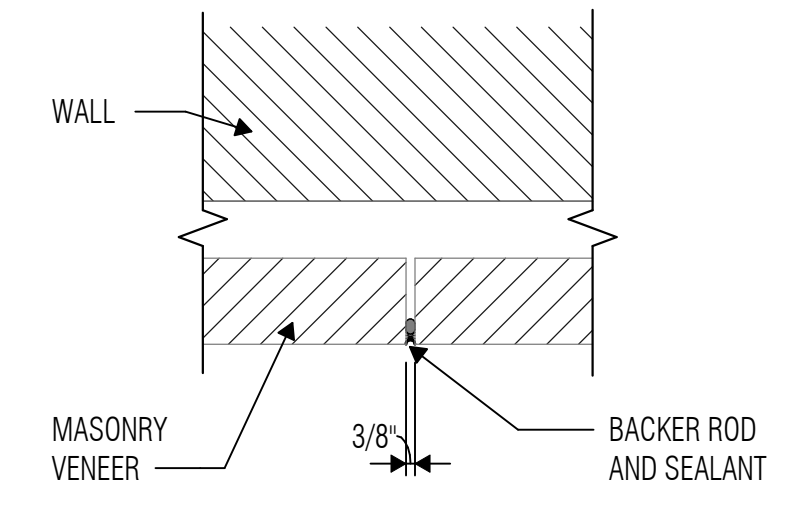


12 EXT. CONTROL JOINT
SCALE: 1 1/2" = 1'-0"

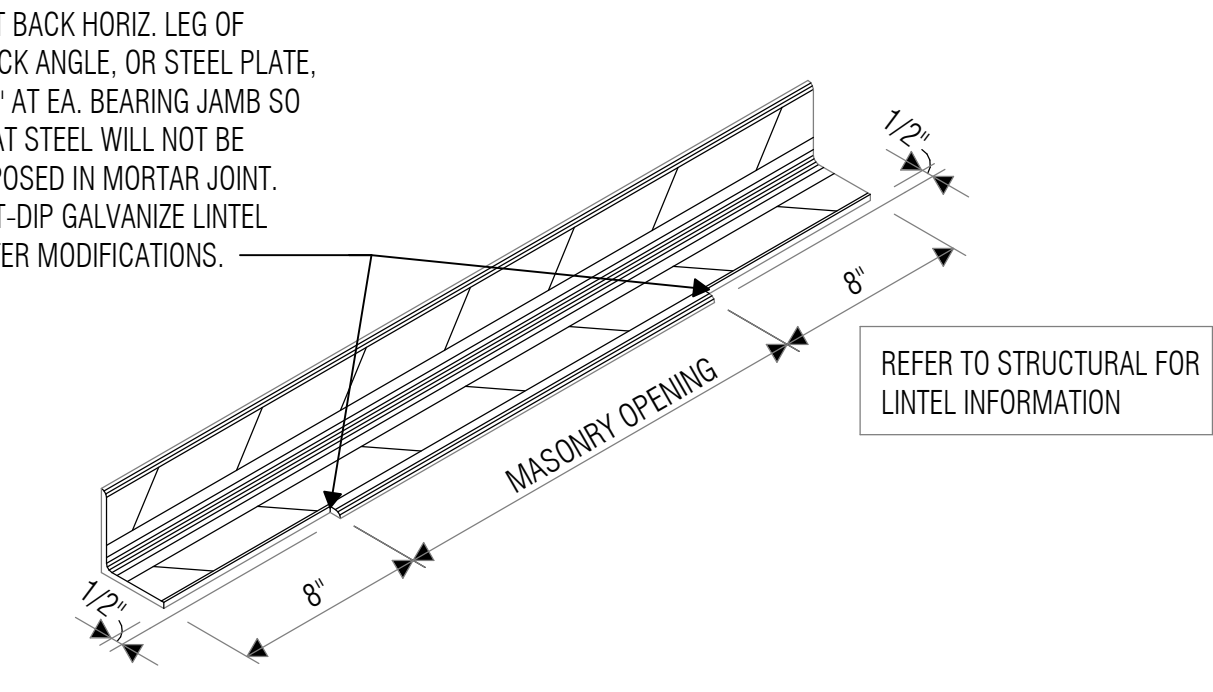

13 LOOSE LINTEL DETAIL, TYP.
SCALE: 1 1/2" = 1'-0"

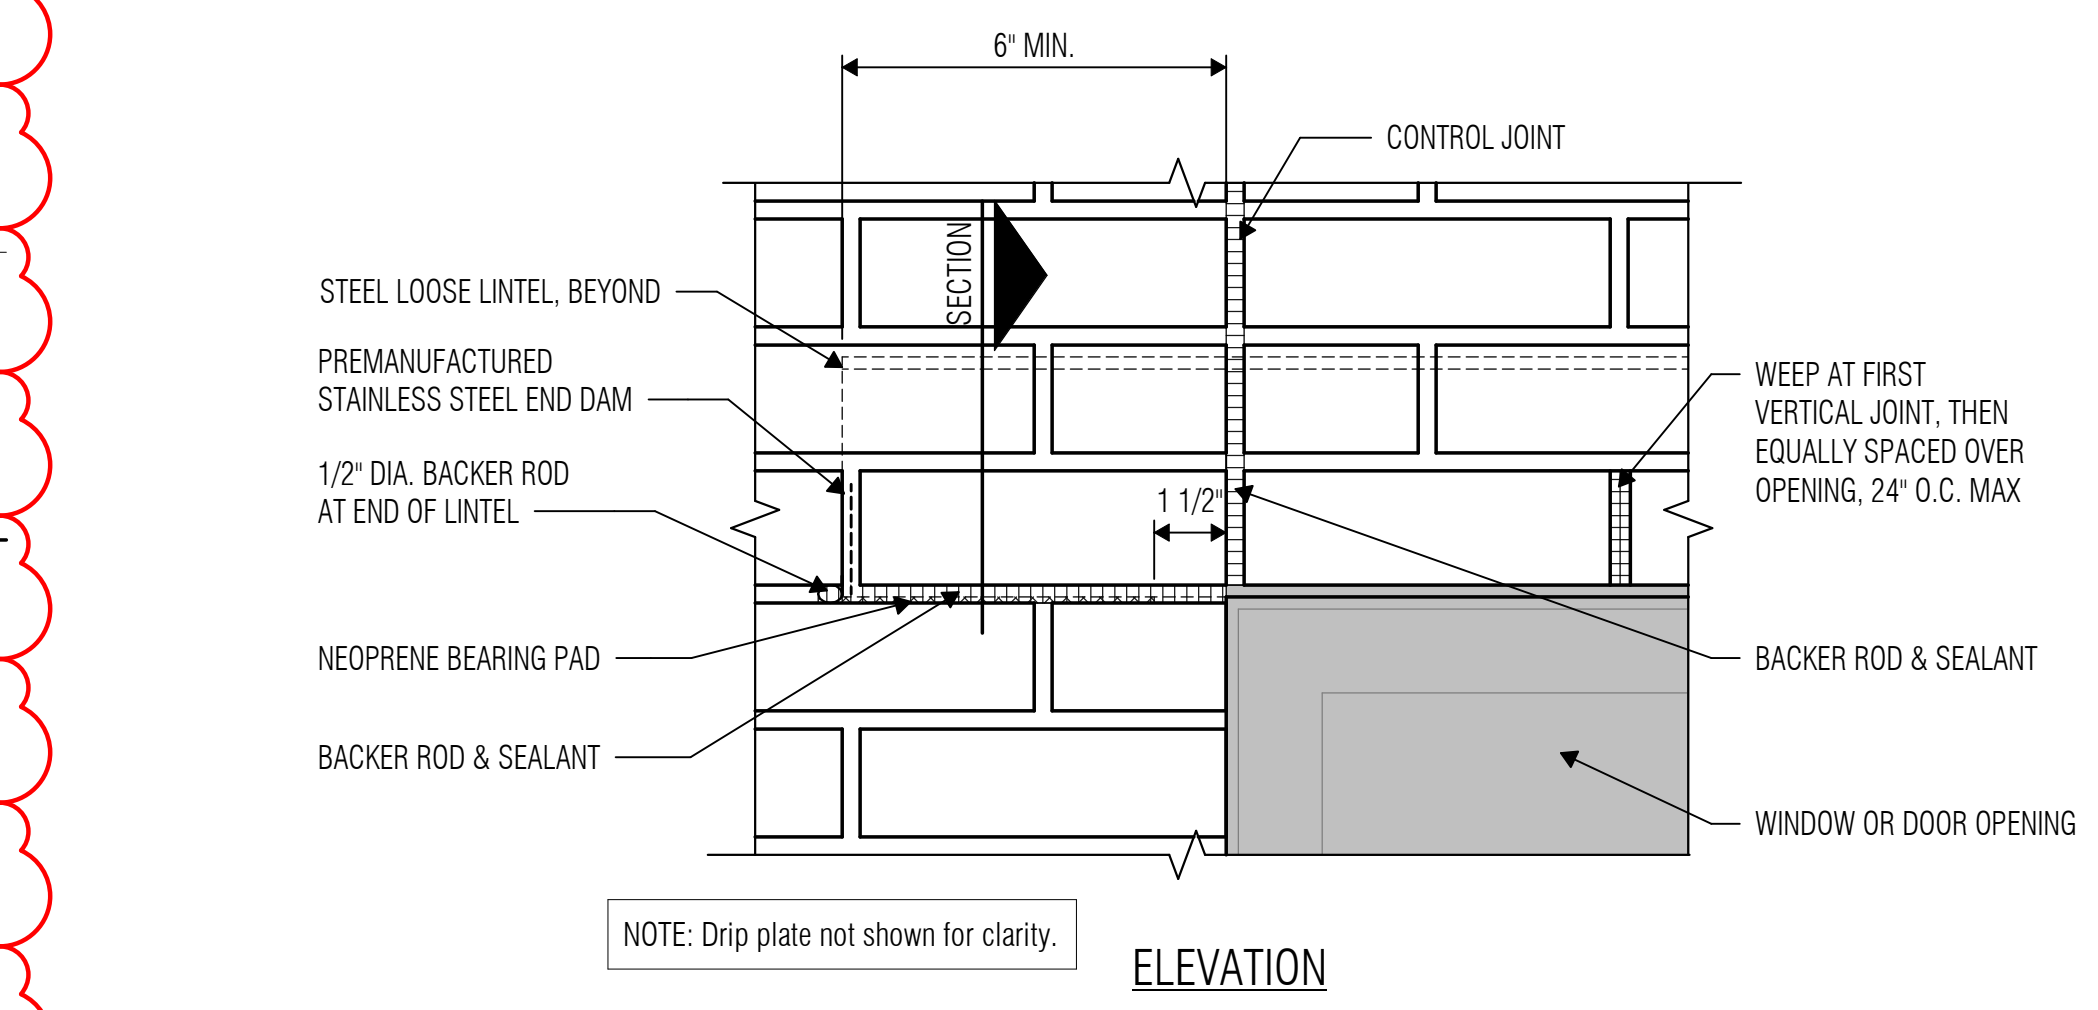

14 MASONRY VENEER CONTROL JOINT AT LOOSE LINTEL
SCALE: 3" = 1'-0"

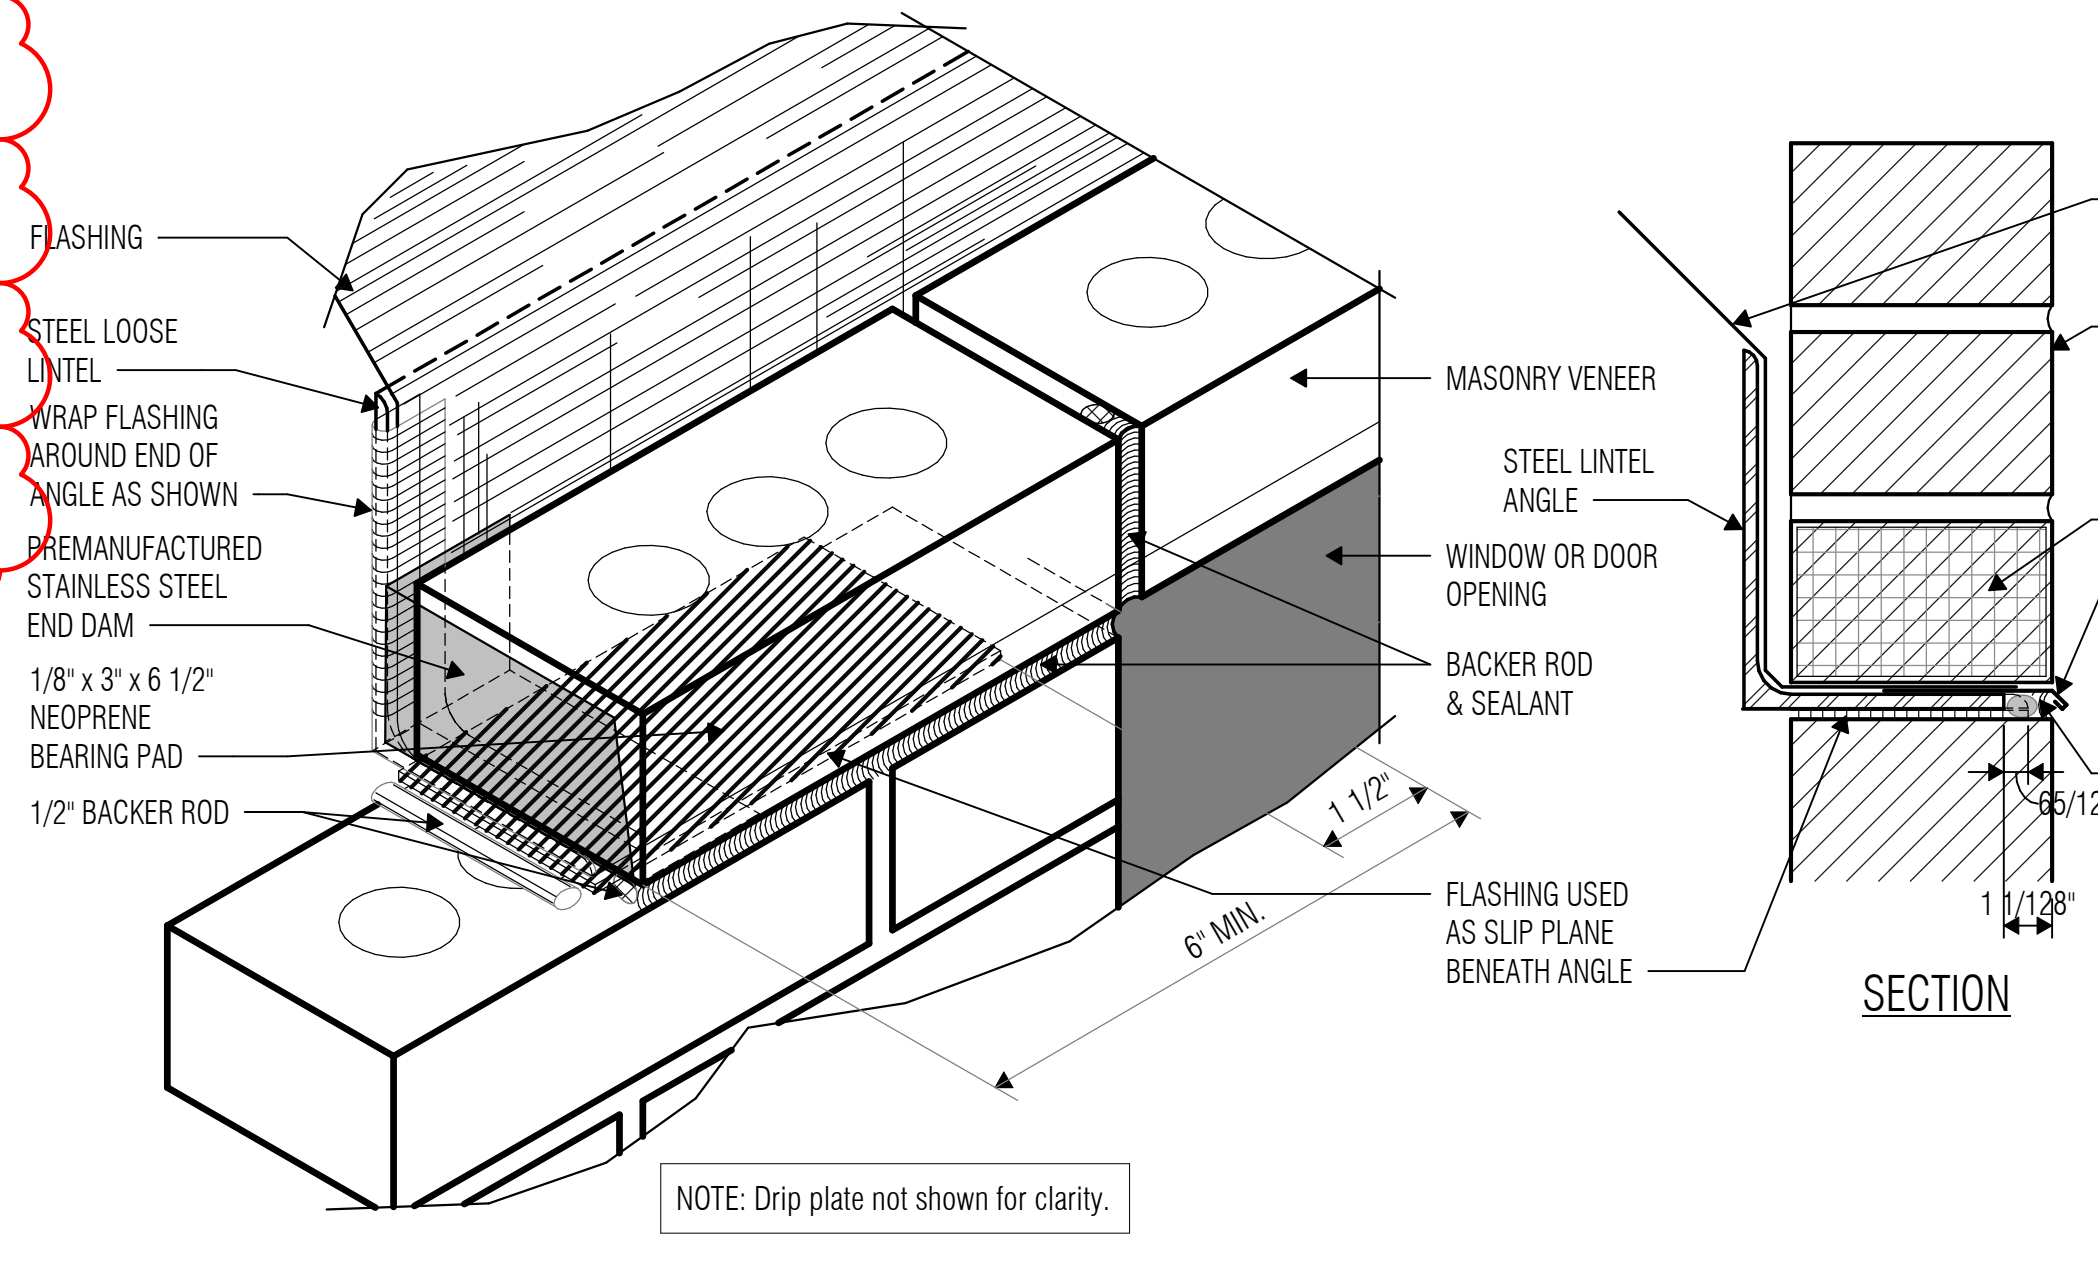

EXTERIOR ELEVATION NOTES

- Refer to Building Assembly Details Sheets for Typical Control Joint and Building Expansion Joint Details.
- Based on the applicable design criteria, submit the proposed pattern of control joints in masonry veneer, CMU and stucco/cement plaster to the Architect for review and approval prior to construction.
- Verify mounting heights of all Electrical and Mechanical items on the exterior of the building prior to construction, whether specifically indicated on the Exterior Elevations or not.
- Install cast stone in accordance with the recommendations of the Cast Stone Institute, unless specifically noted or detailed otherwise.
- Refer to Building Assembly Details Sheet for Loose Lintel Details. Refer to Structural Drawings for maximum span and bearing requirements.
- Terminate recessed and projected masonry veneer courses at 4" from intersecting window frames, door frames, sloping roofs, etc., unless noted otherwise.
- Provide solid bricks for soldier courses at exterior corners (do not miter). Refer to Building Assembly Details sheets.
- All blue exterior panels on the building will be removed and replaced even if not shown on the documents.

EXTERIOR ELEVATION LEGEND

- A BRICK VENEER, TYPE 'A'
 - B BRICK VENEER, TYPE 'B'
 - DS DOWNSPOUT
 - DSC DOWNSPOUT W/ SCUPPER & CONDUCTOR HEAD
 - OS OVERFLOW SCUPPER, REF. _JA_
 - CJ CONTROL JOINT, REF. _JA_
 - EJ EXPANSION JOINT, REF. _JA_
 - SXX ALUMINUM STOREFRONT, REF. SHEET A7.11
- EXISTING TO REMAIN WITH LIMITED OR NO ARCHITECTURAL WORK REQUIRED IN THIS AREA. REFER TO CIVIL, MEET AND STRUCTURAL DRAWINGS FOR ANY ADDITIONAL WORK IN AREA.



ARCHITECT
VLK Architects
20445 State Hwy 249, Suite 350
Houston, Texas 77070
Main Phone: 281.671.2300
www.vlkarchitects.com



ISSUED: February 24, 2025
REVISIONS
Revision No. Revision Date
1 Addendum 1 03-06-2025

Director Drawn By
RSJ STH, KM
Designer Quality Control

PROJECT NO.
24-010.00
SHEET TITLE
COOK - EXTERIOR ELEVATIONS & DETAILS
SHEET NO.

A13.11



ISSUED: February 24, 2025

REVISIONS

Revision No.	Revision Date
1 Addendum 1	03-06-2025

Director: RSJ
 Drawn By: STH, KM
 Designer: TQ
 Quality Control:

PROJECT NO.


24-010.00

SHEET TITLE


COOK - INTERIOR ELEVATIONS

SHEET NO.


A13.31

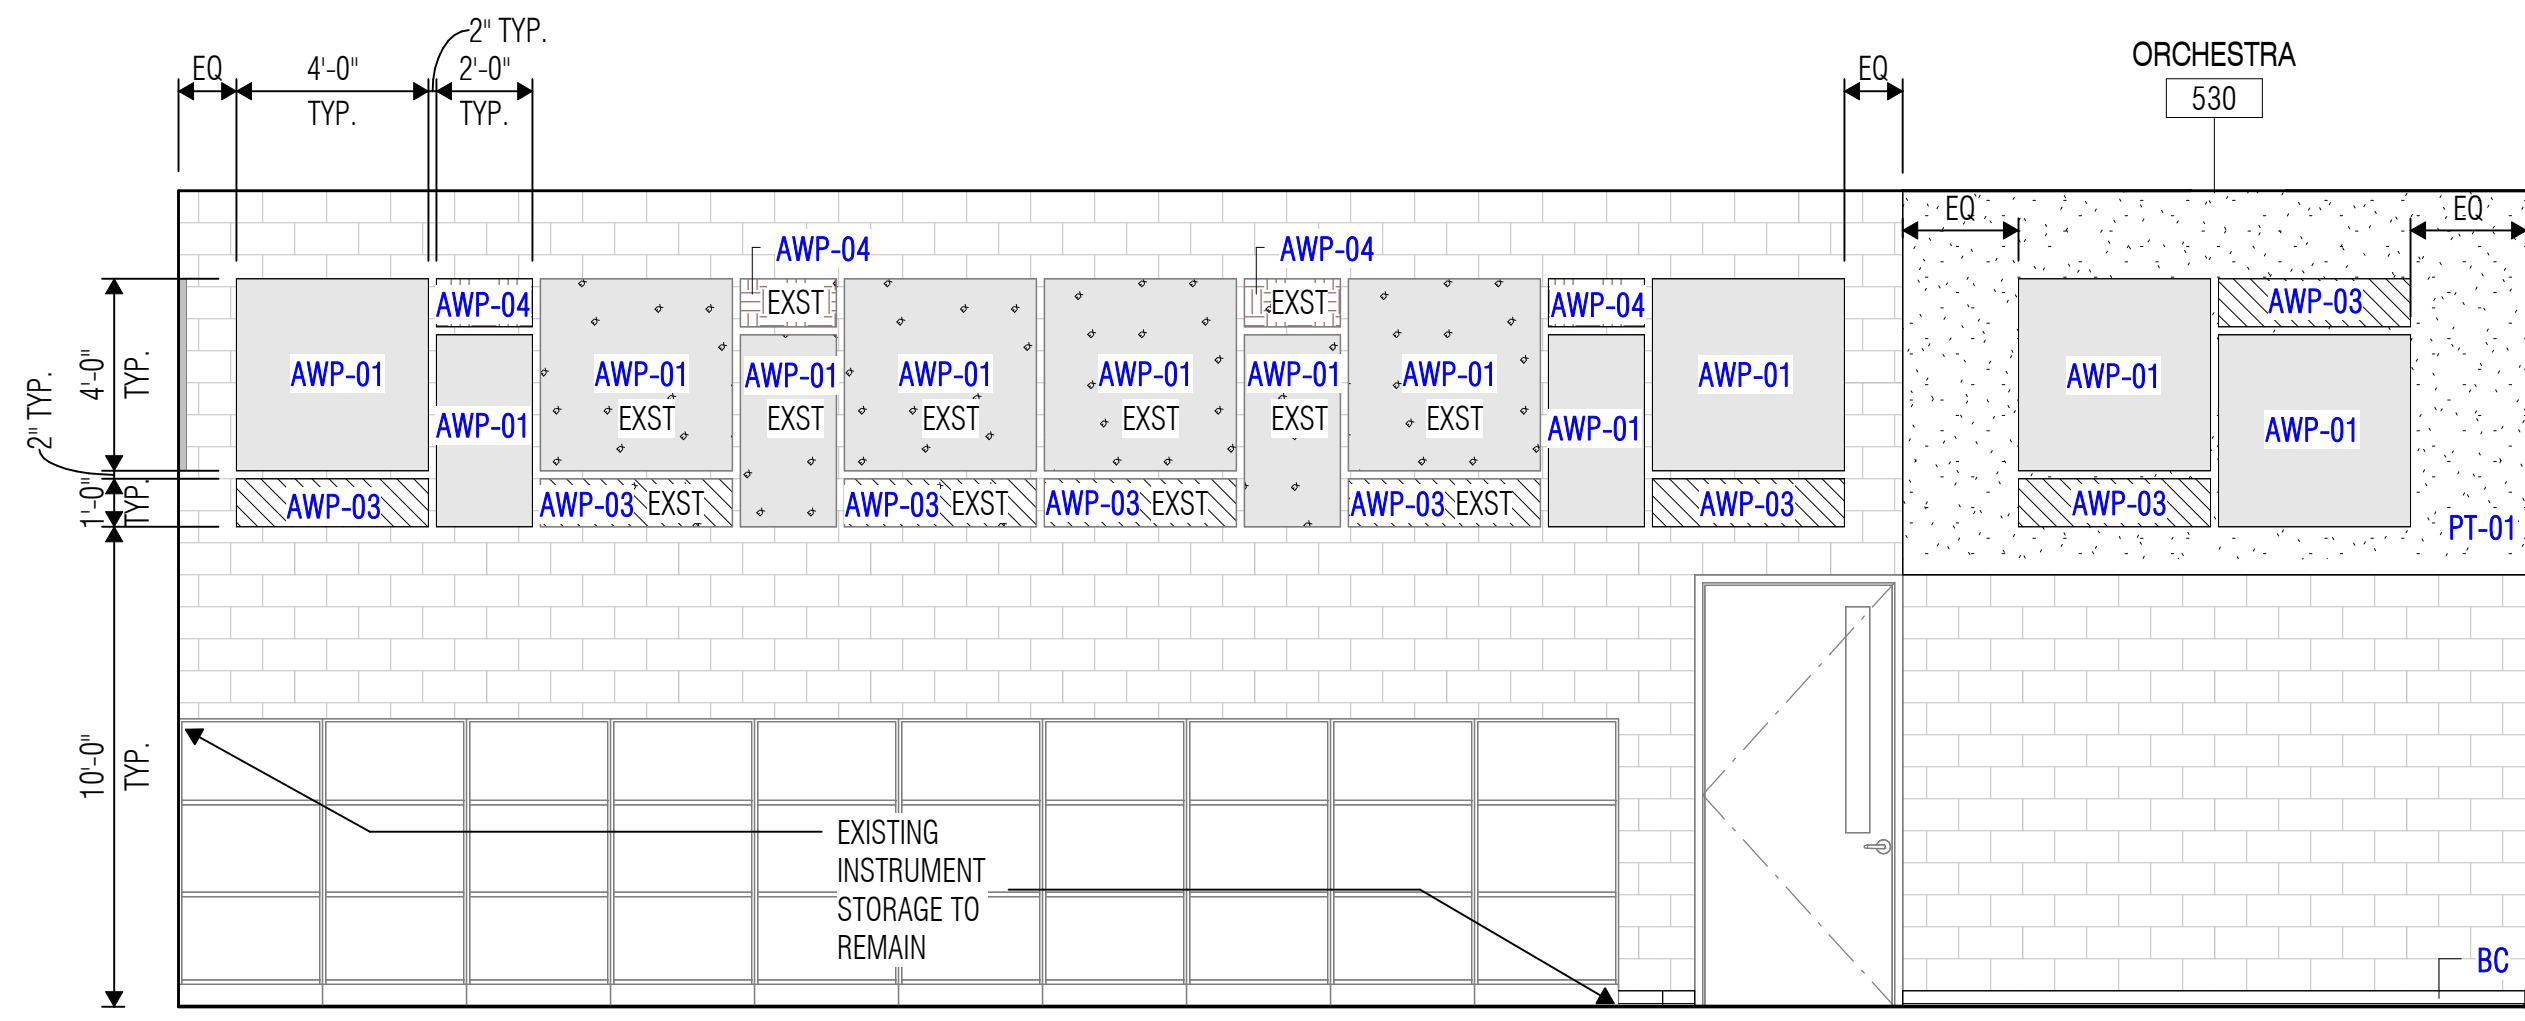


1 INTERIOR ELEVATION
 SCALE: 1/4" = 1'-0"

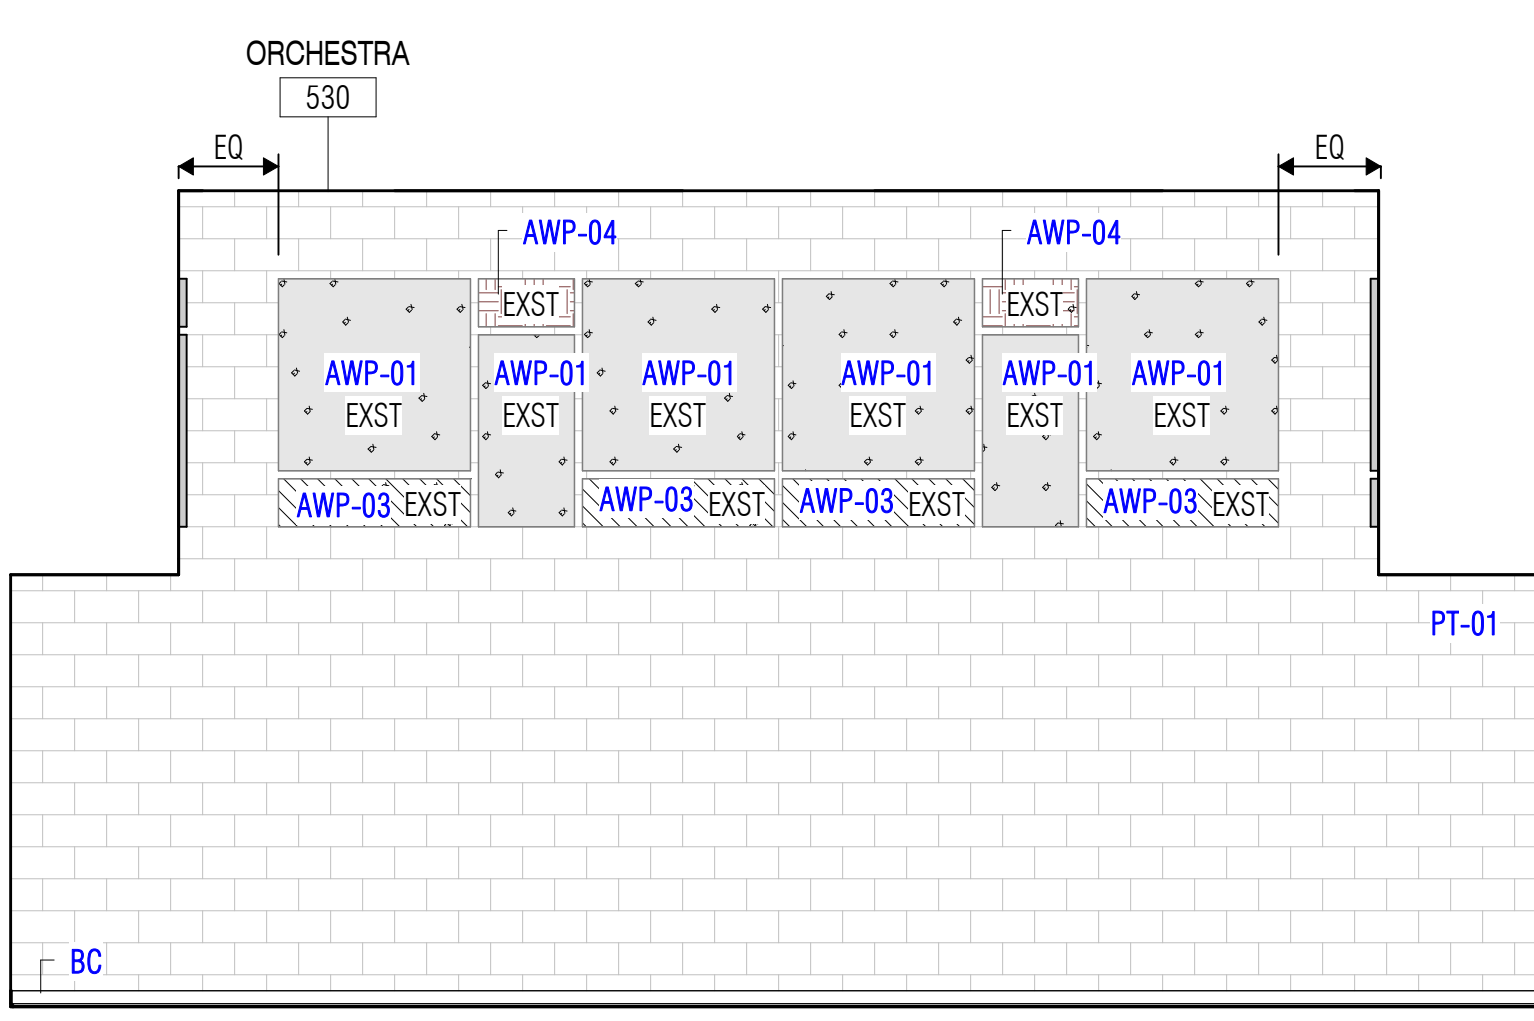


2 INTERIOR ELEVATION
 SCALE: 1/4" = 1'-0"

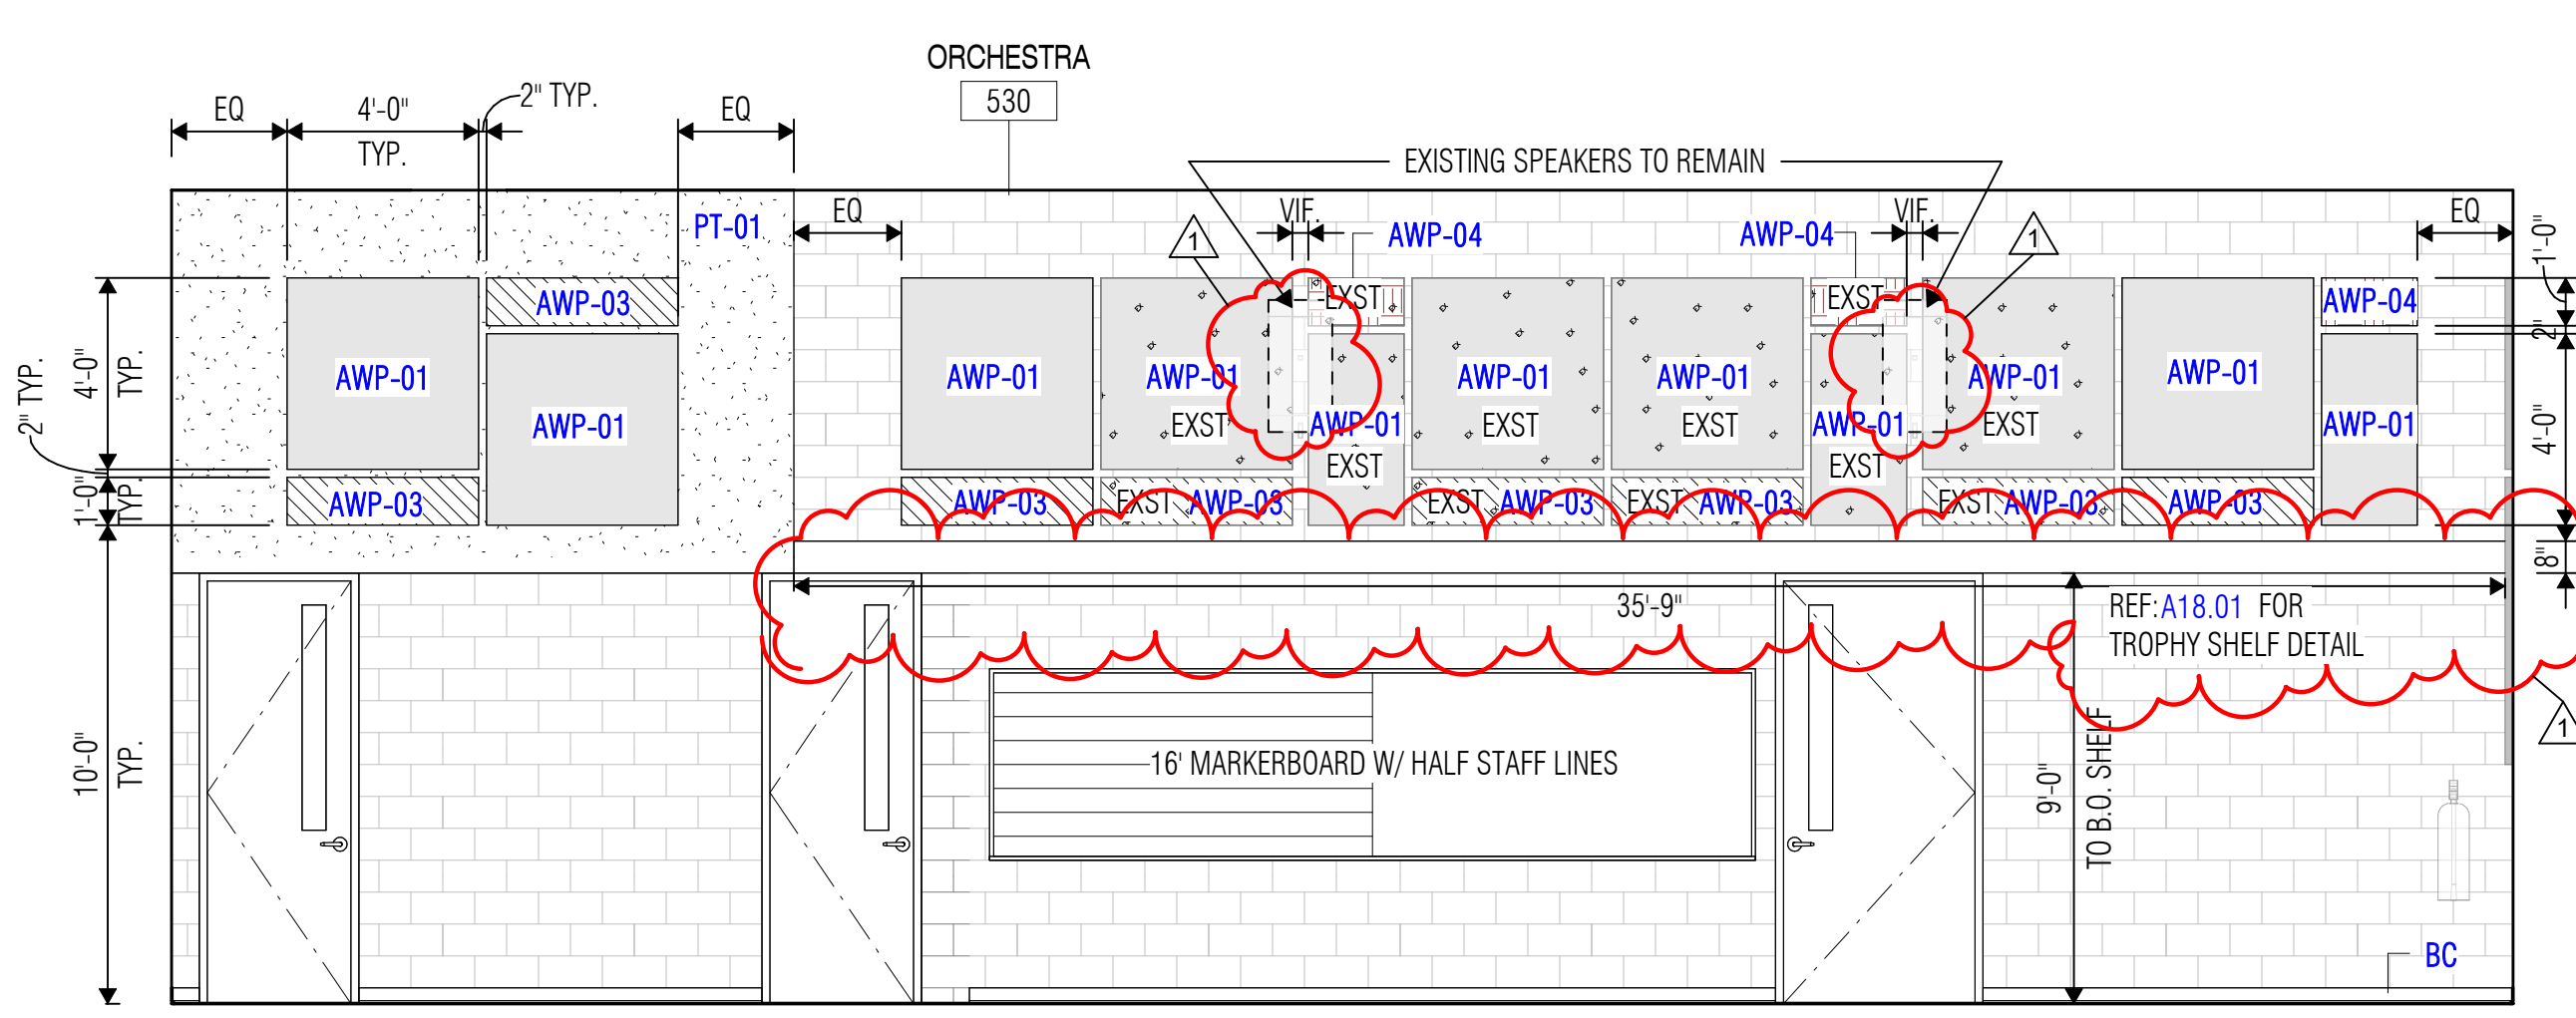


3 INTERIOR ELEVATION
 SCALE: 1/4" = 1'-0"

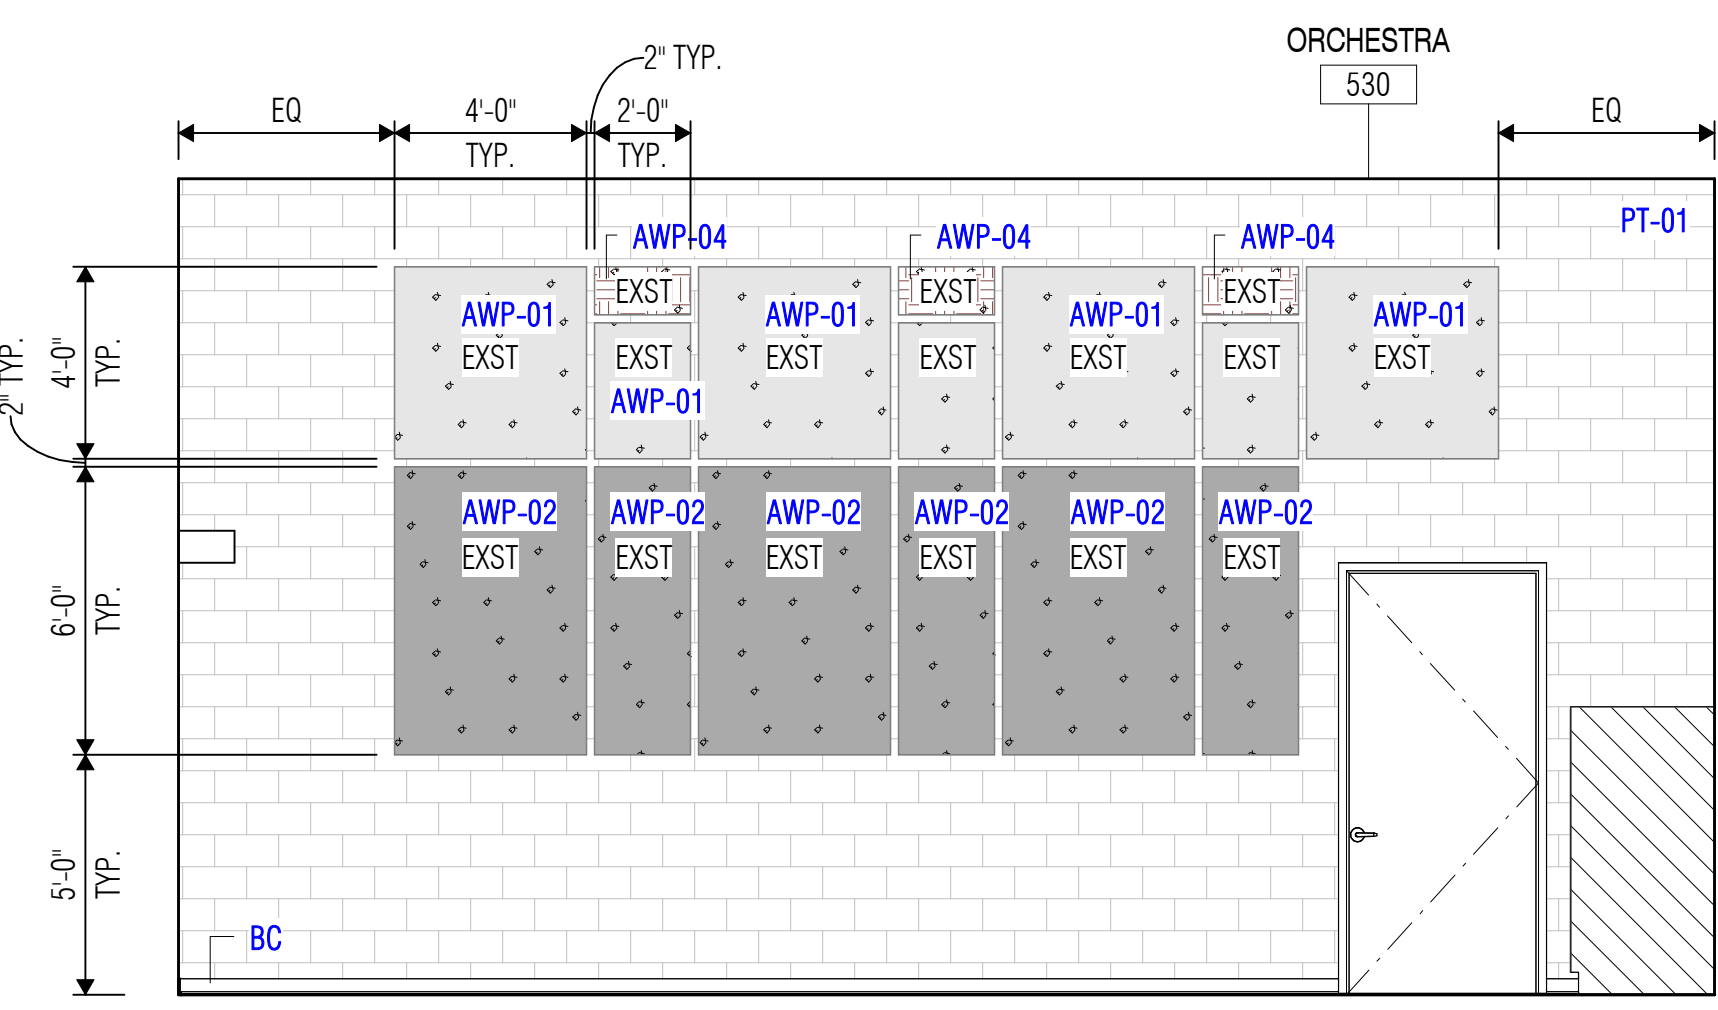


4 INTERIOR ELEVATION
 SCALE: 1/4" = 1'-0"

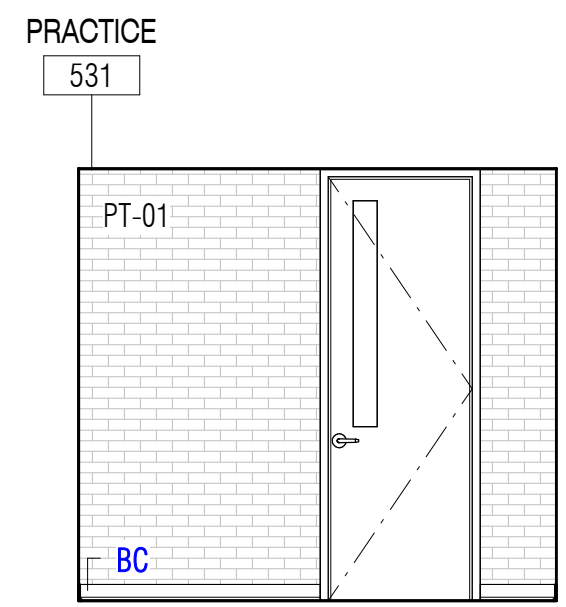


5 INTERIOR ELEVATION
 SCALE: 1/4" = 1'-0"

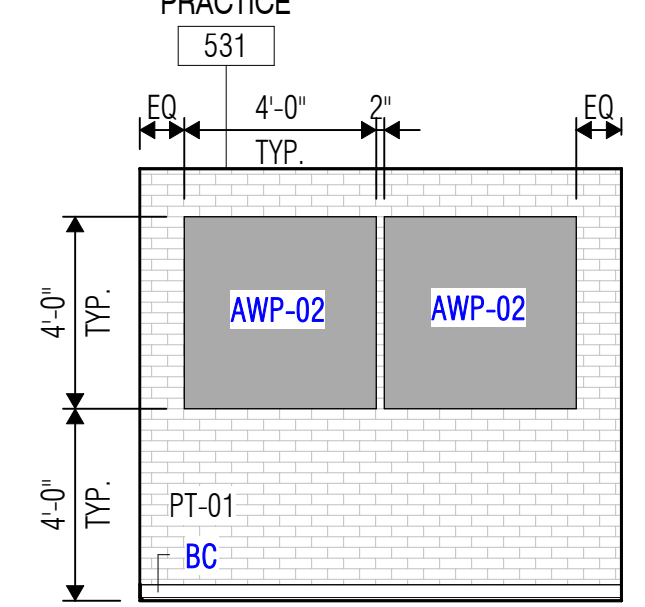


6 INTERIOR ELEVATION
 SCALE: 1/4" = 1'-0"

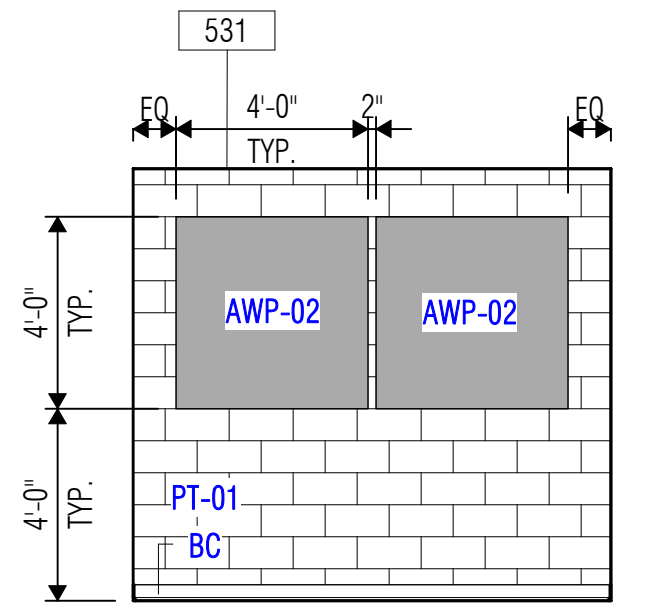


7 INTERIOR ELEVATION
 SCALE: 1/4" = 1'-0"

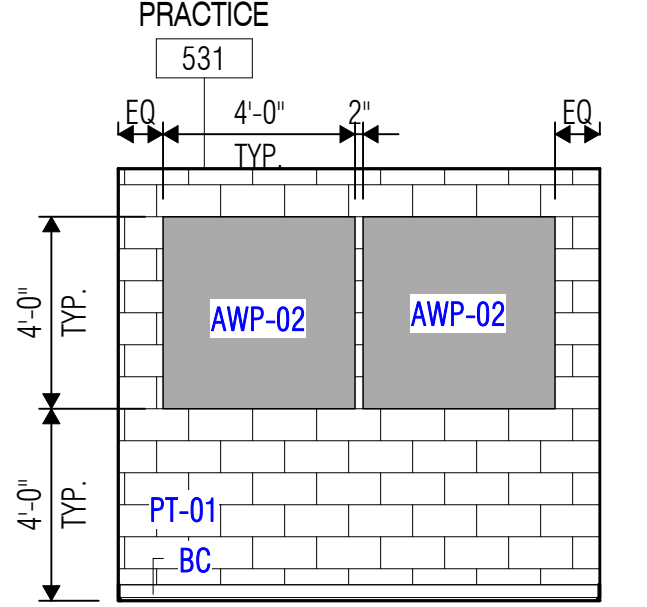


8 INTERIOR ELEVATION
 SCALE: 1/4" = 1'-0"

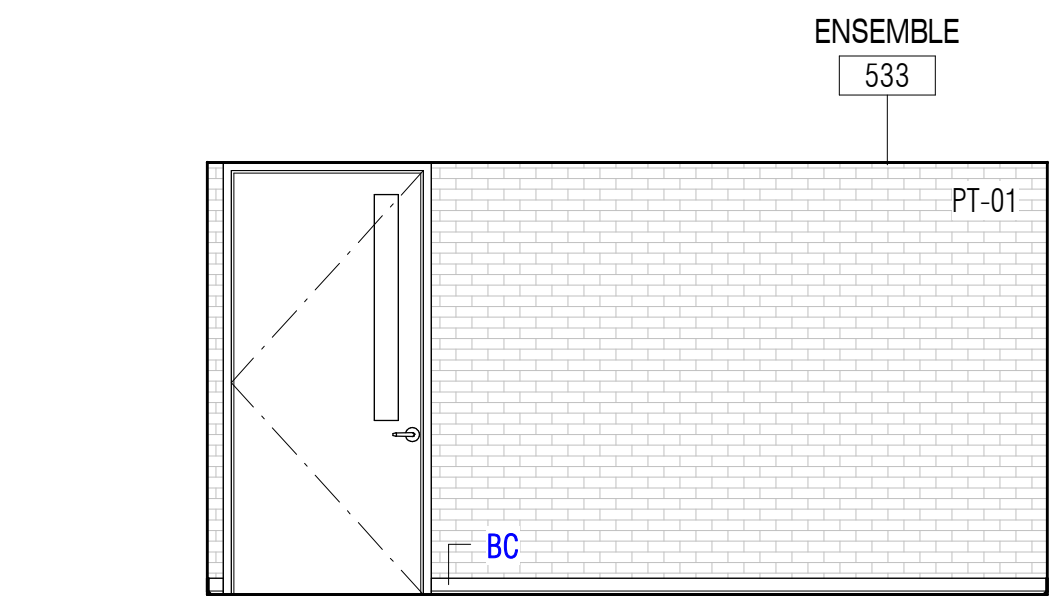


9 INTERIOR ELEVATION
 SCALE: 1/4" = 1'-0"

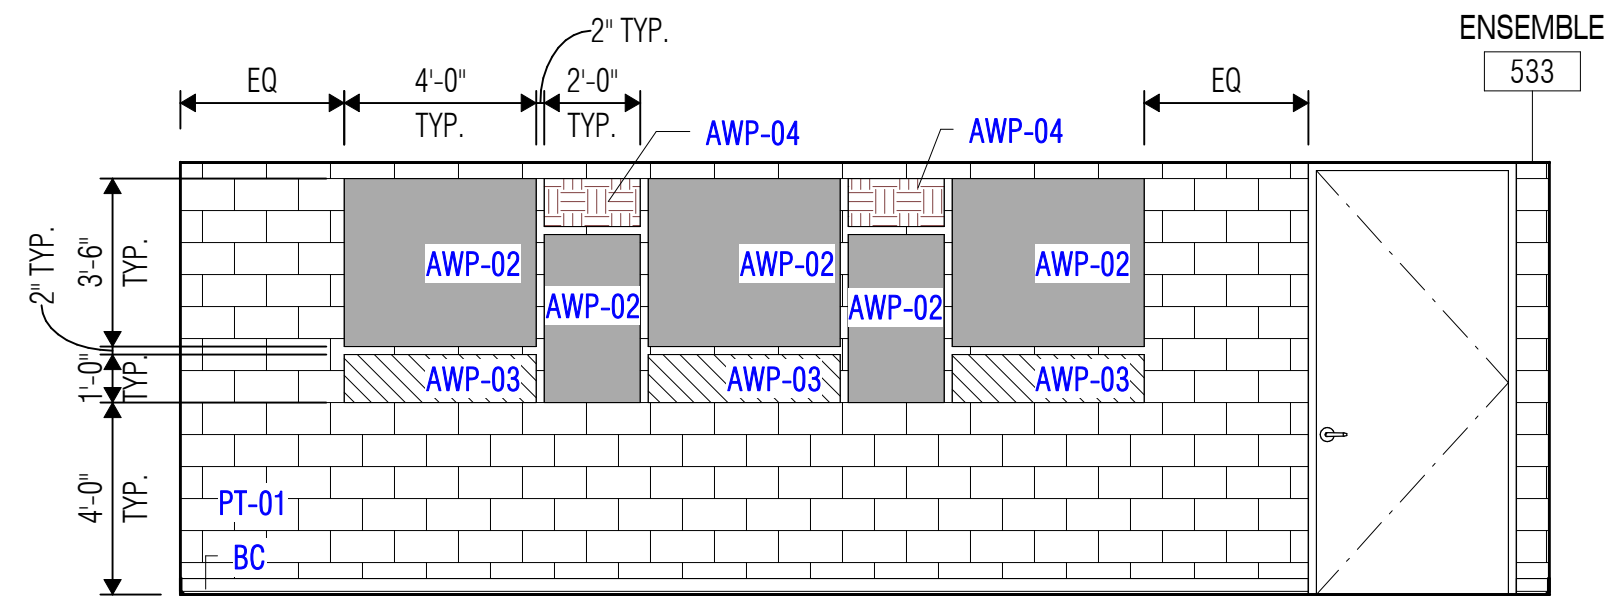


10 INTERIOR ELEVATION
 SCALE: 1/4" = 1'-0"

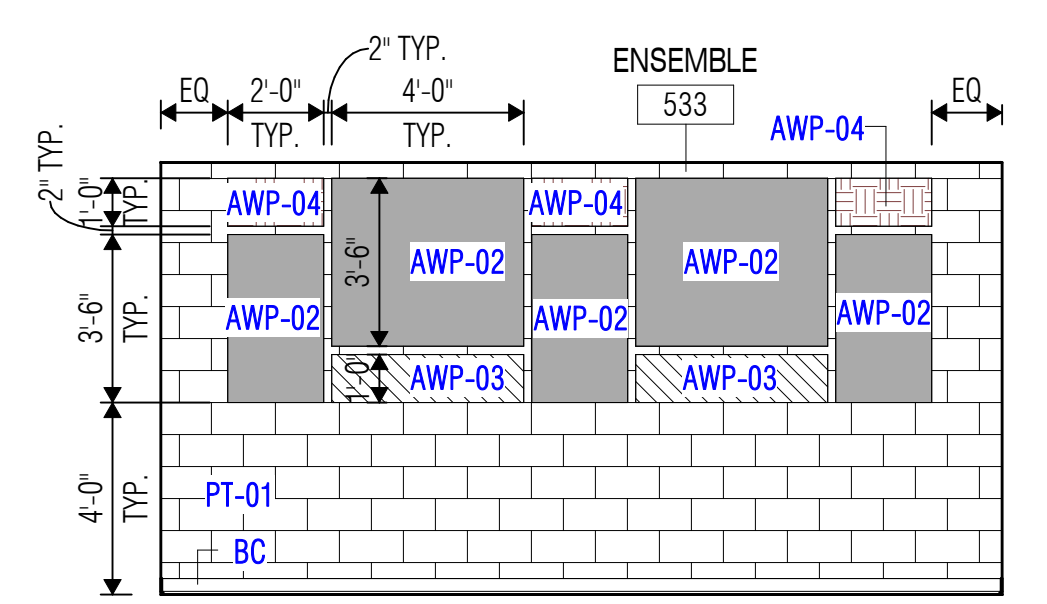


11 INTERIOR ELEVATION
 SCALE: 1/4" = 1'-0"

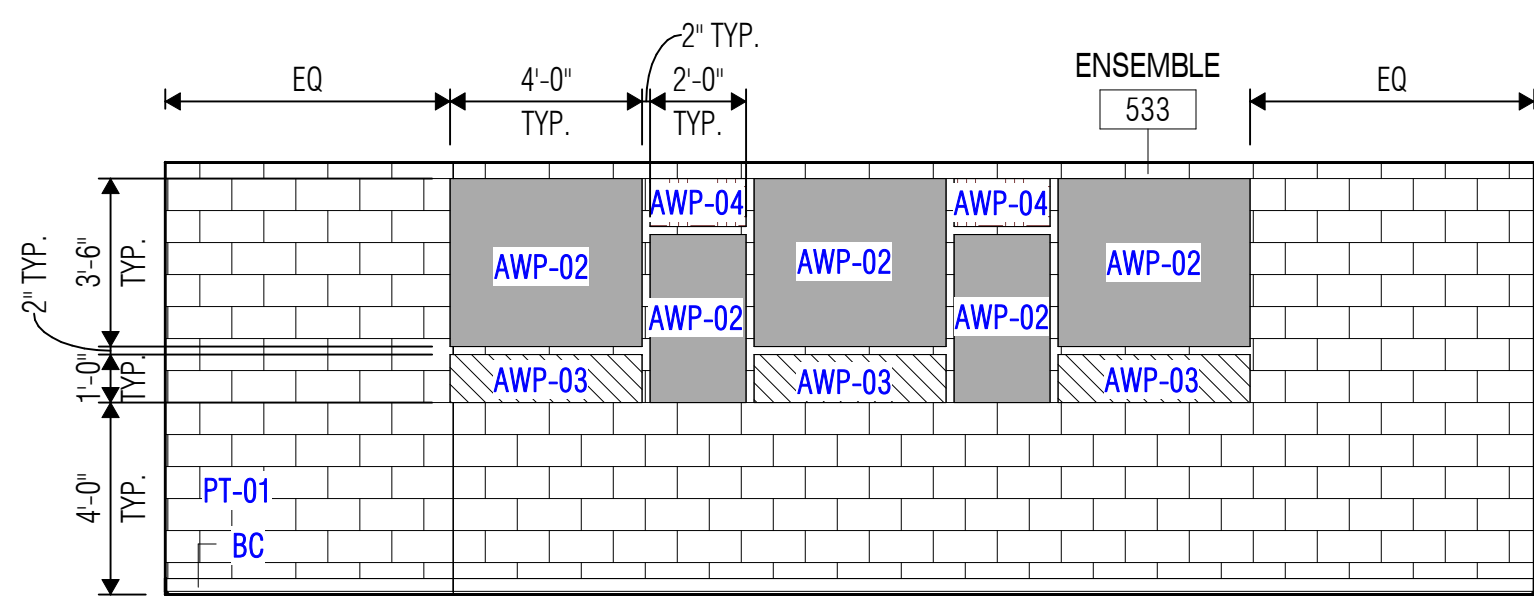

12 INTERIOR ELEVATION
 SCALE: 1/4" = 1'-0"

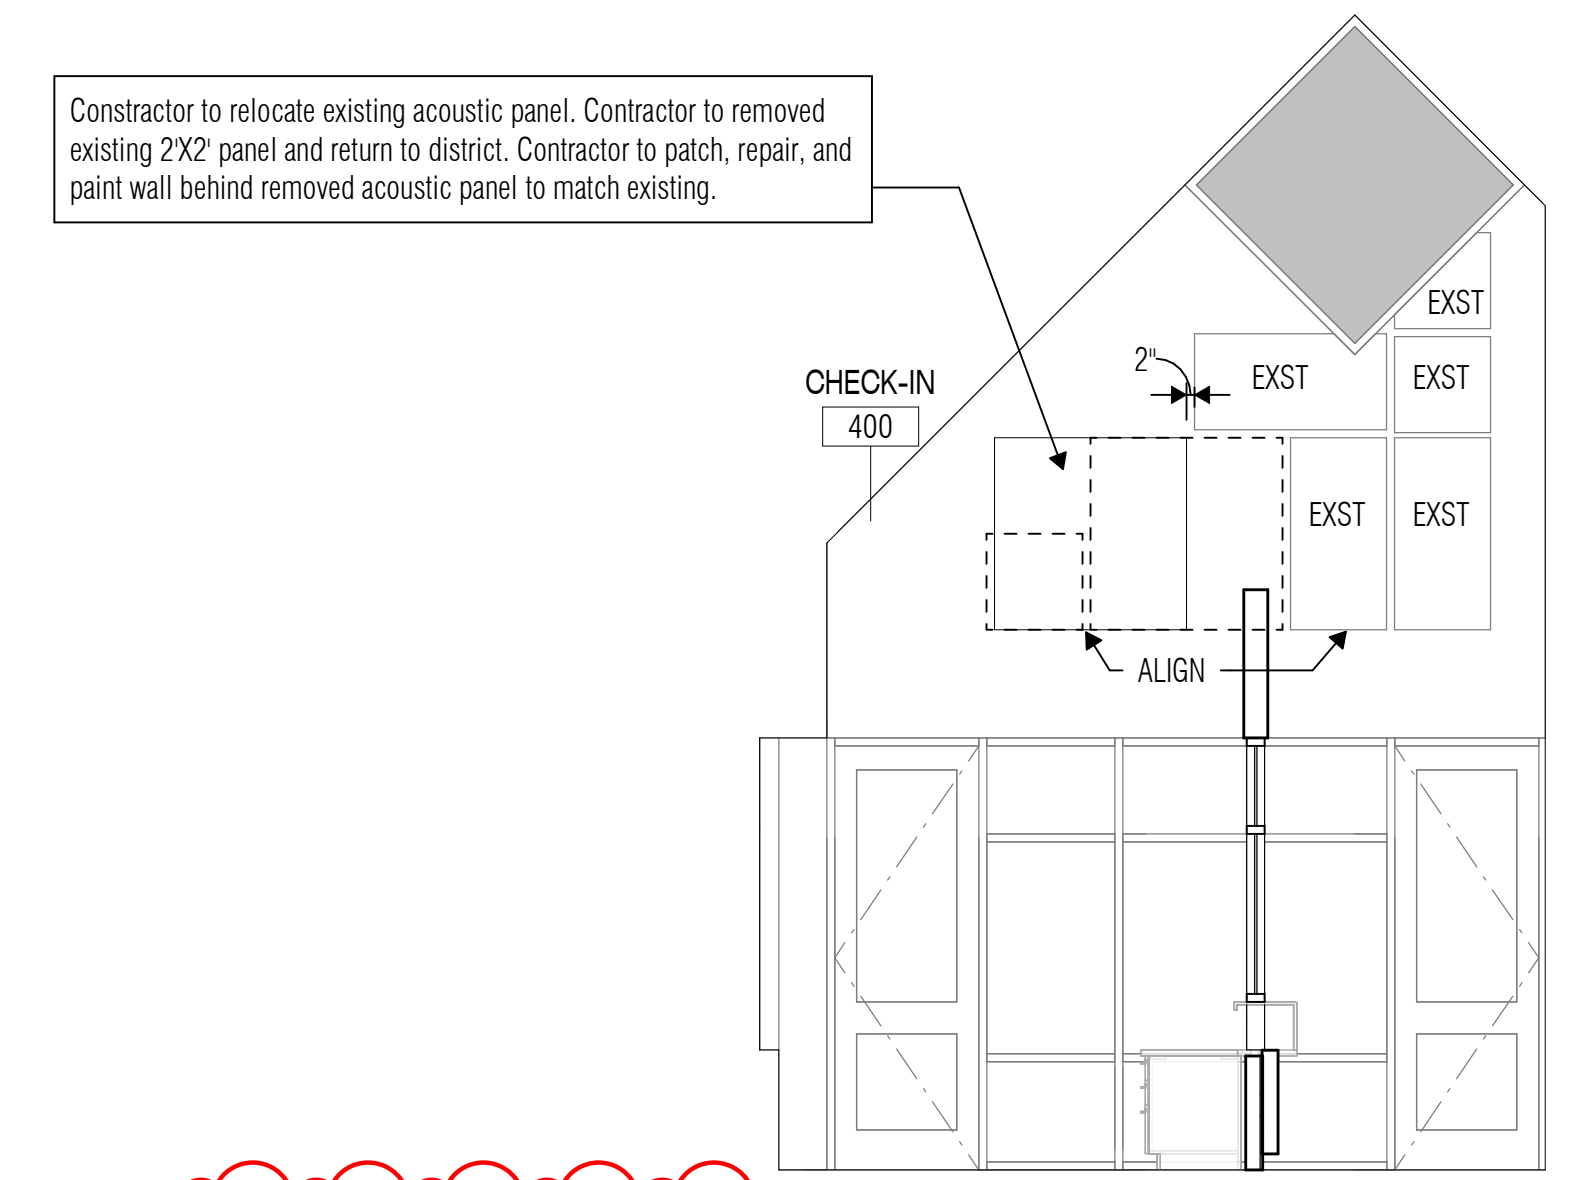


13 INTERIOR ELEVATION
 SCALE: 1/4" = 1'-0"

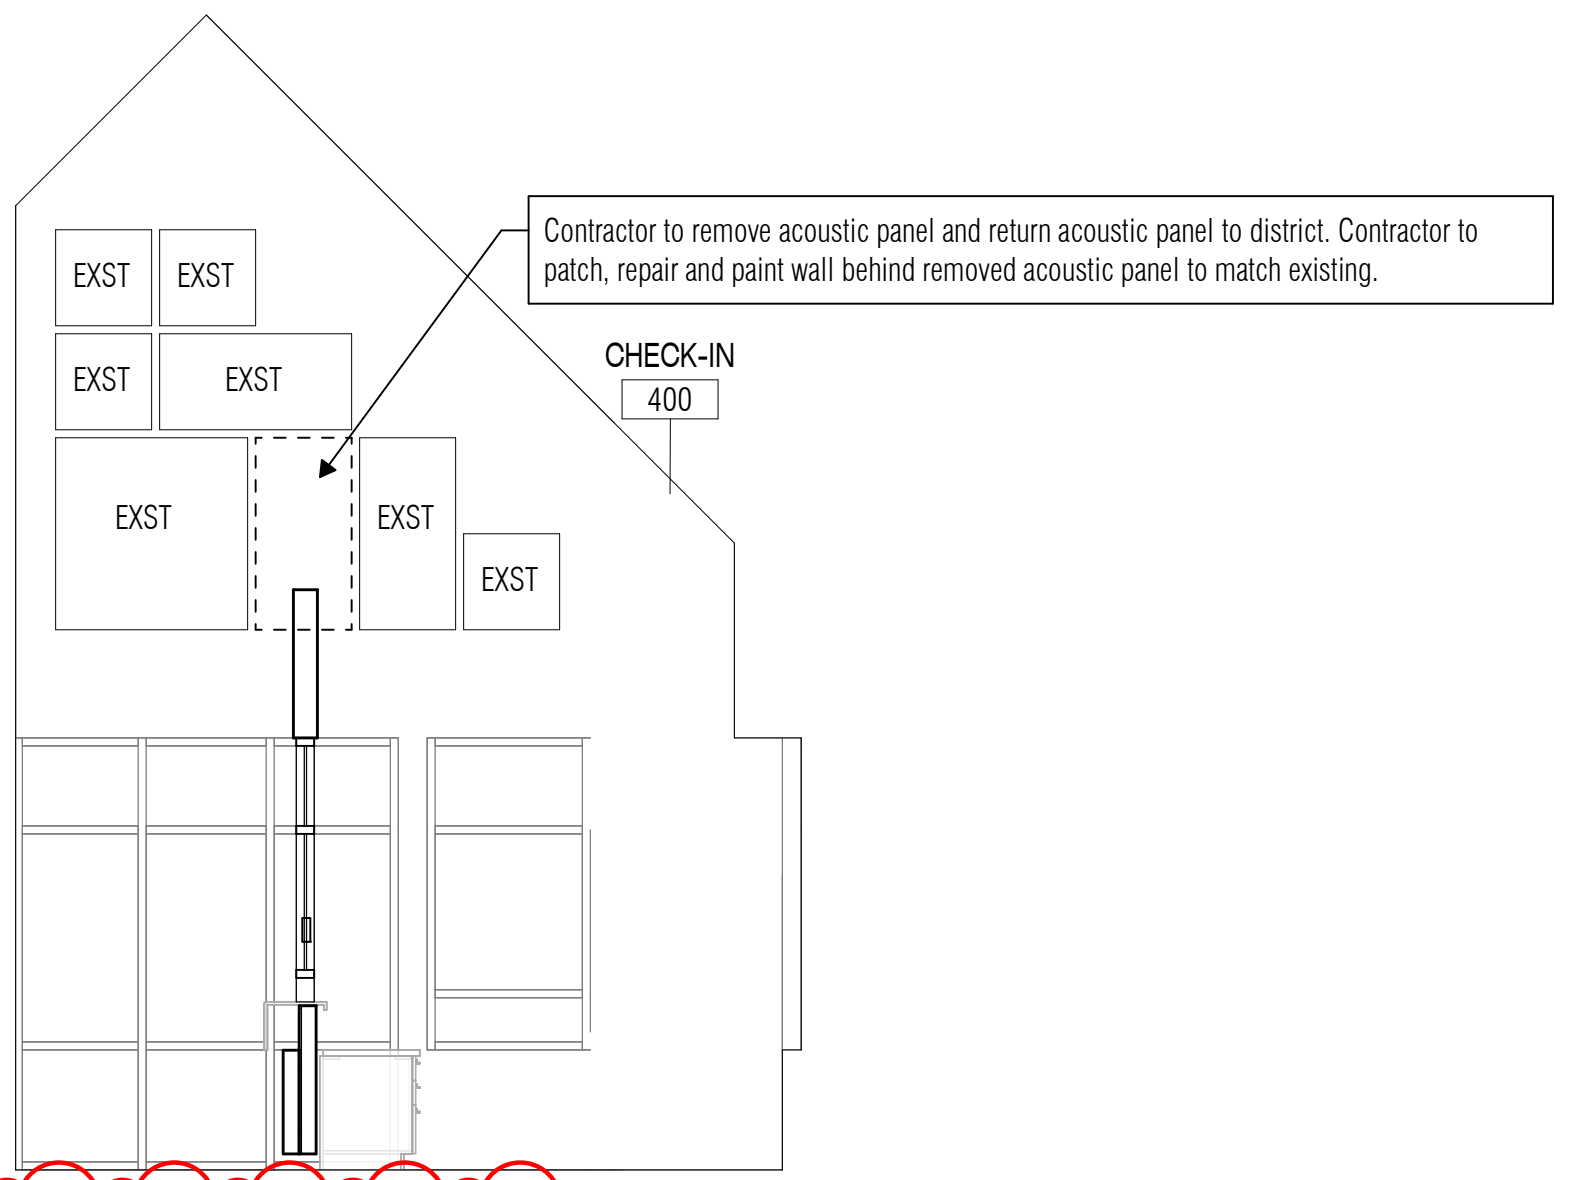


14 INTERIOR ELEVATION
 SCALE: 1/4" = 1'-0"

ARCHITECT


VLK Architects
 20445 State Hwy 249, Suite 350
 Houston, Texas 77070
 Main Phone: 281.671.2300
 www.vlkarhitects.com

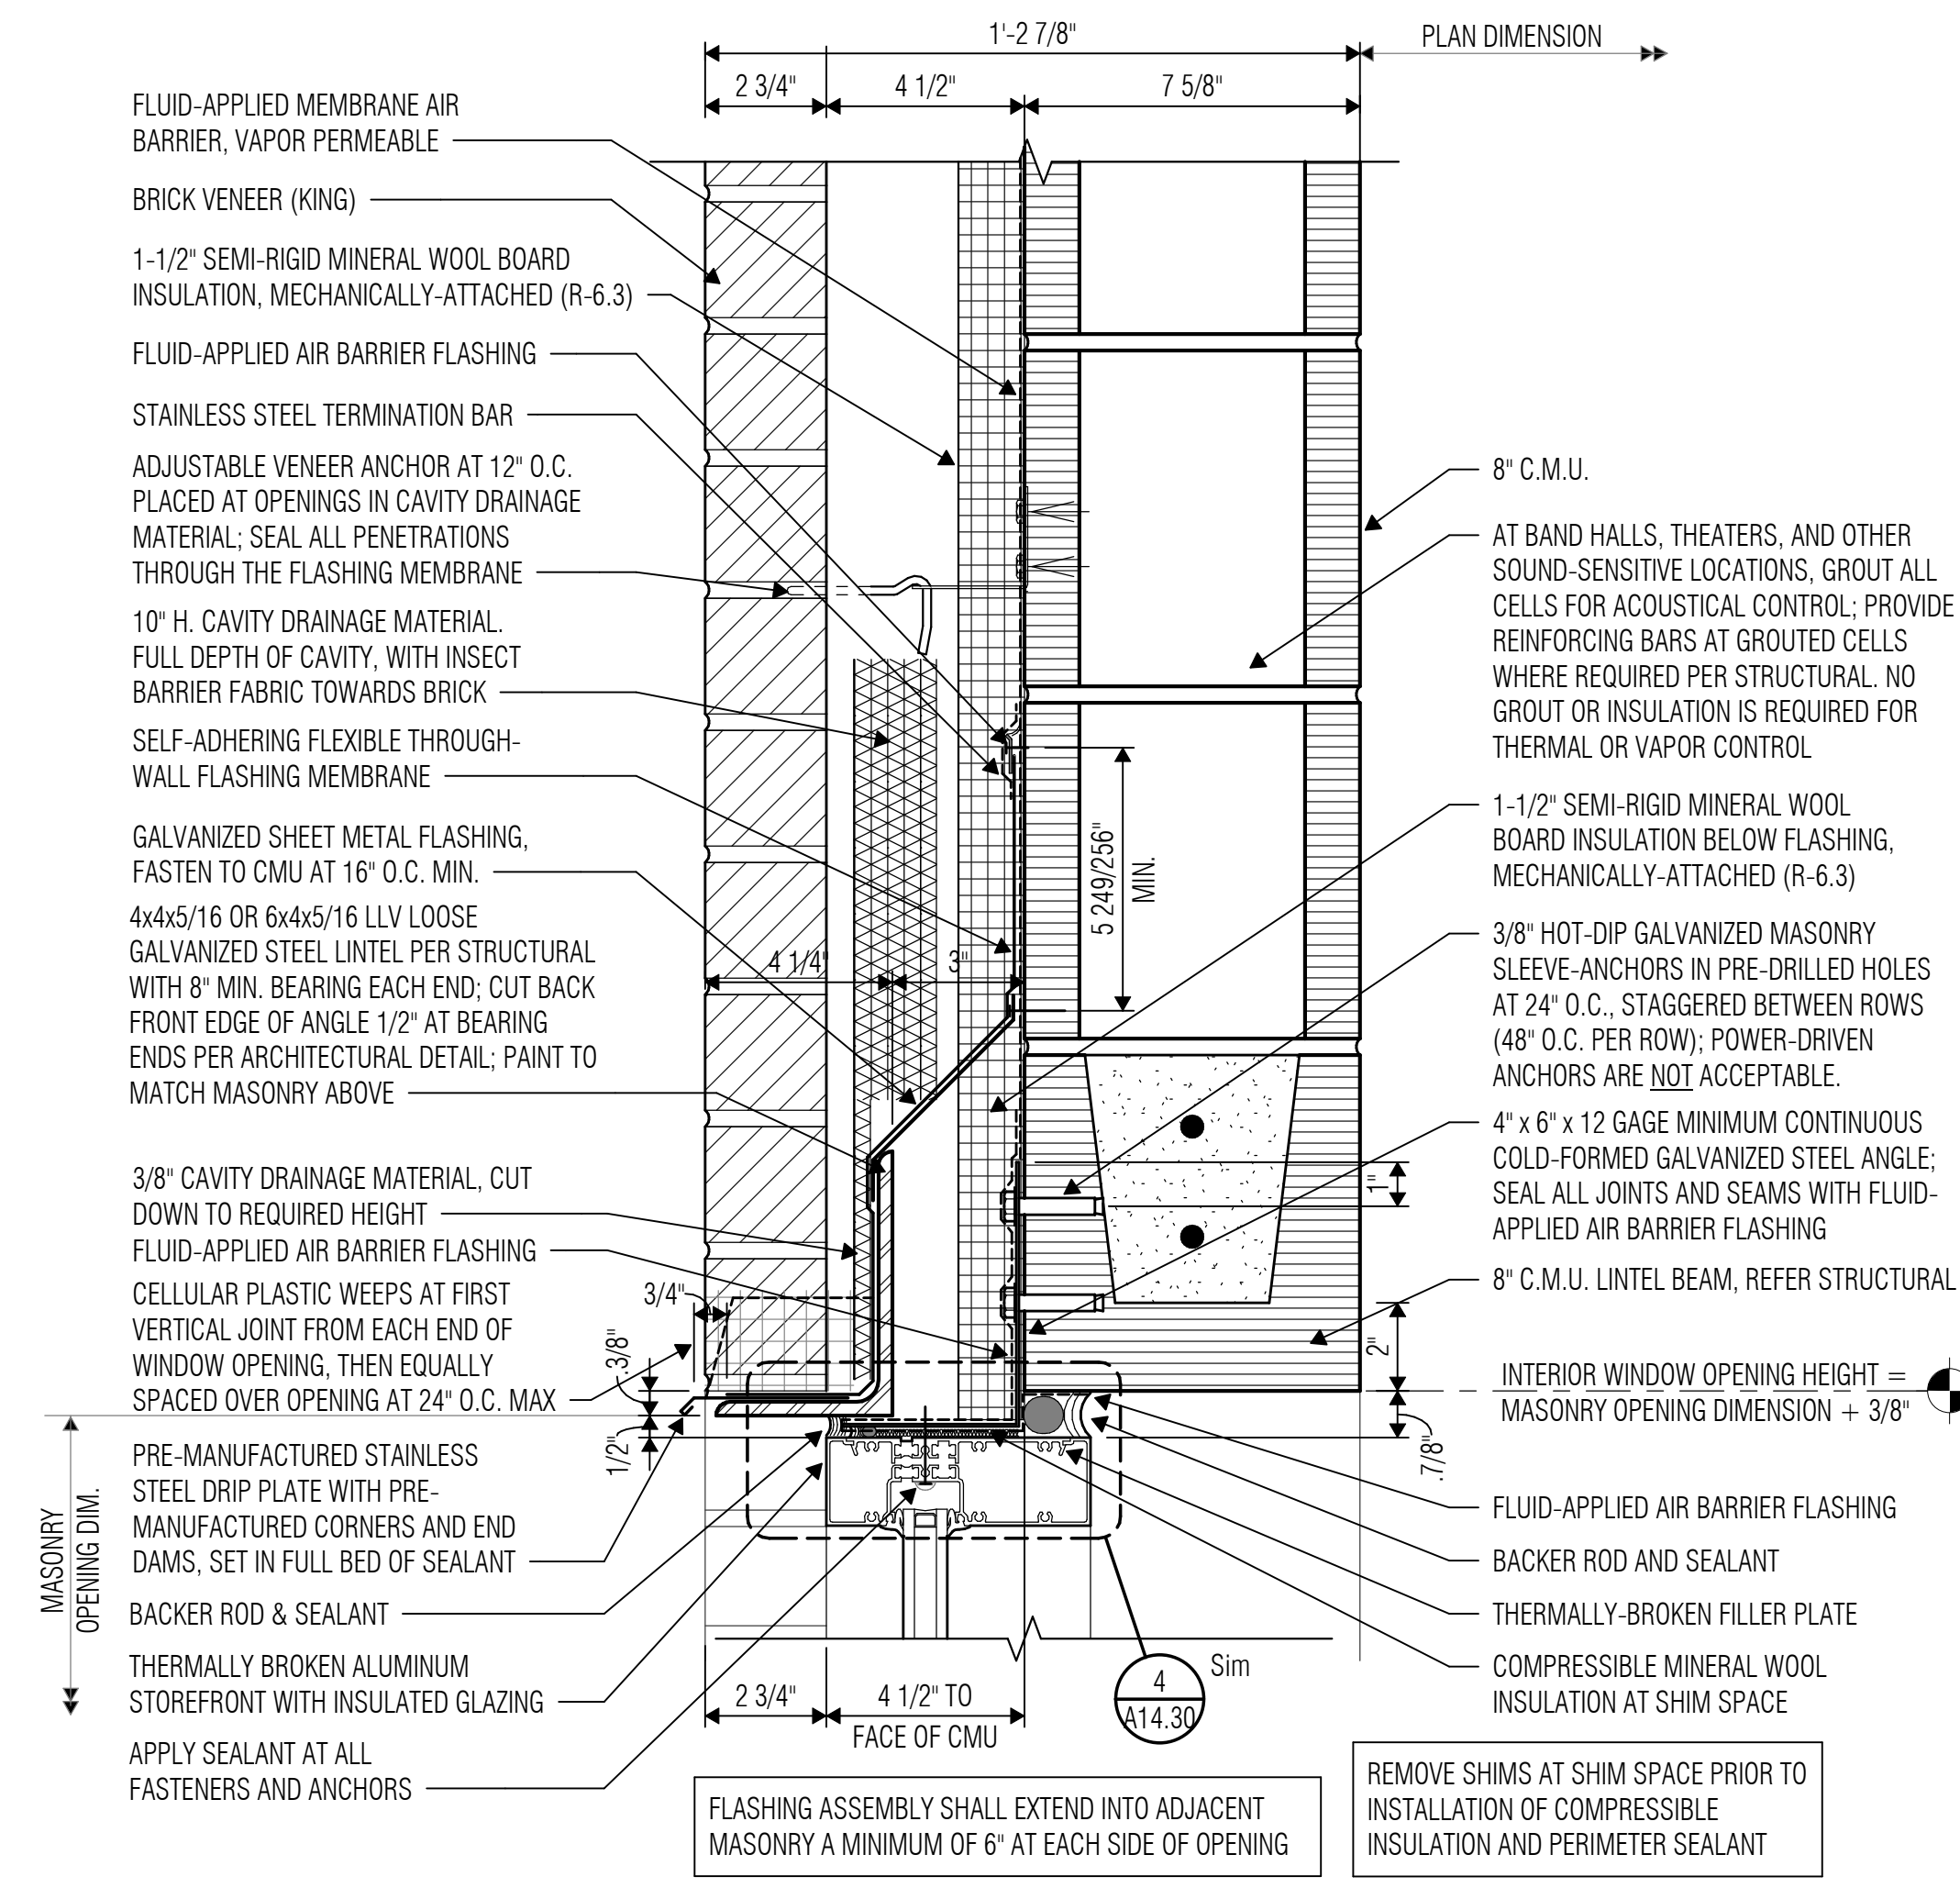


1 KING BRICK/CMU AT CLASSROOM STOREFRONT WINDOW
 SCALE: 3" = 1'-0"

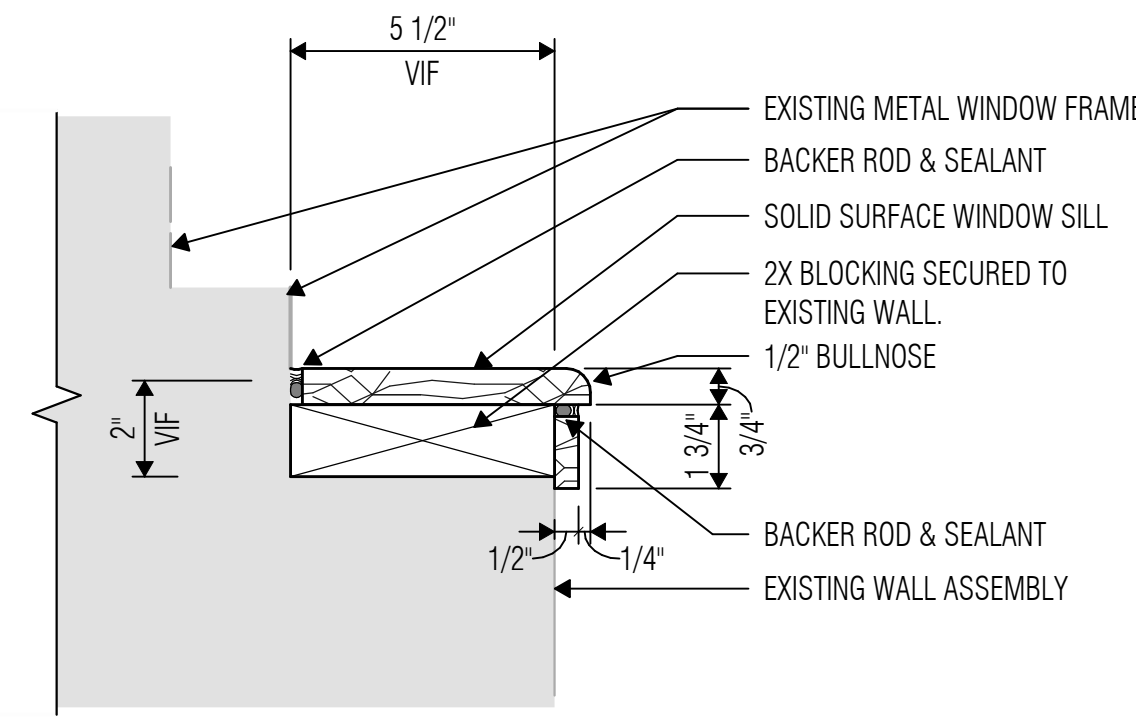


2 EXISTING WINDOW SILL REPLACEMENT
 SCALE: 3" = 1'-0"

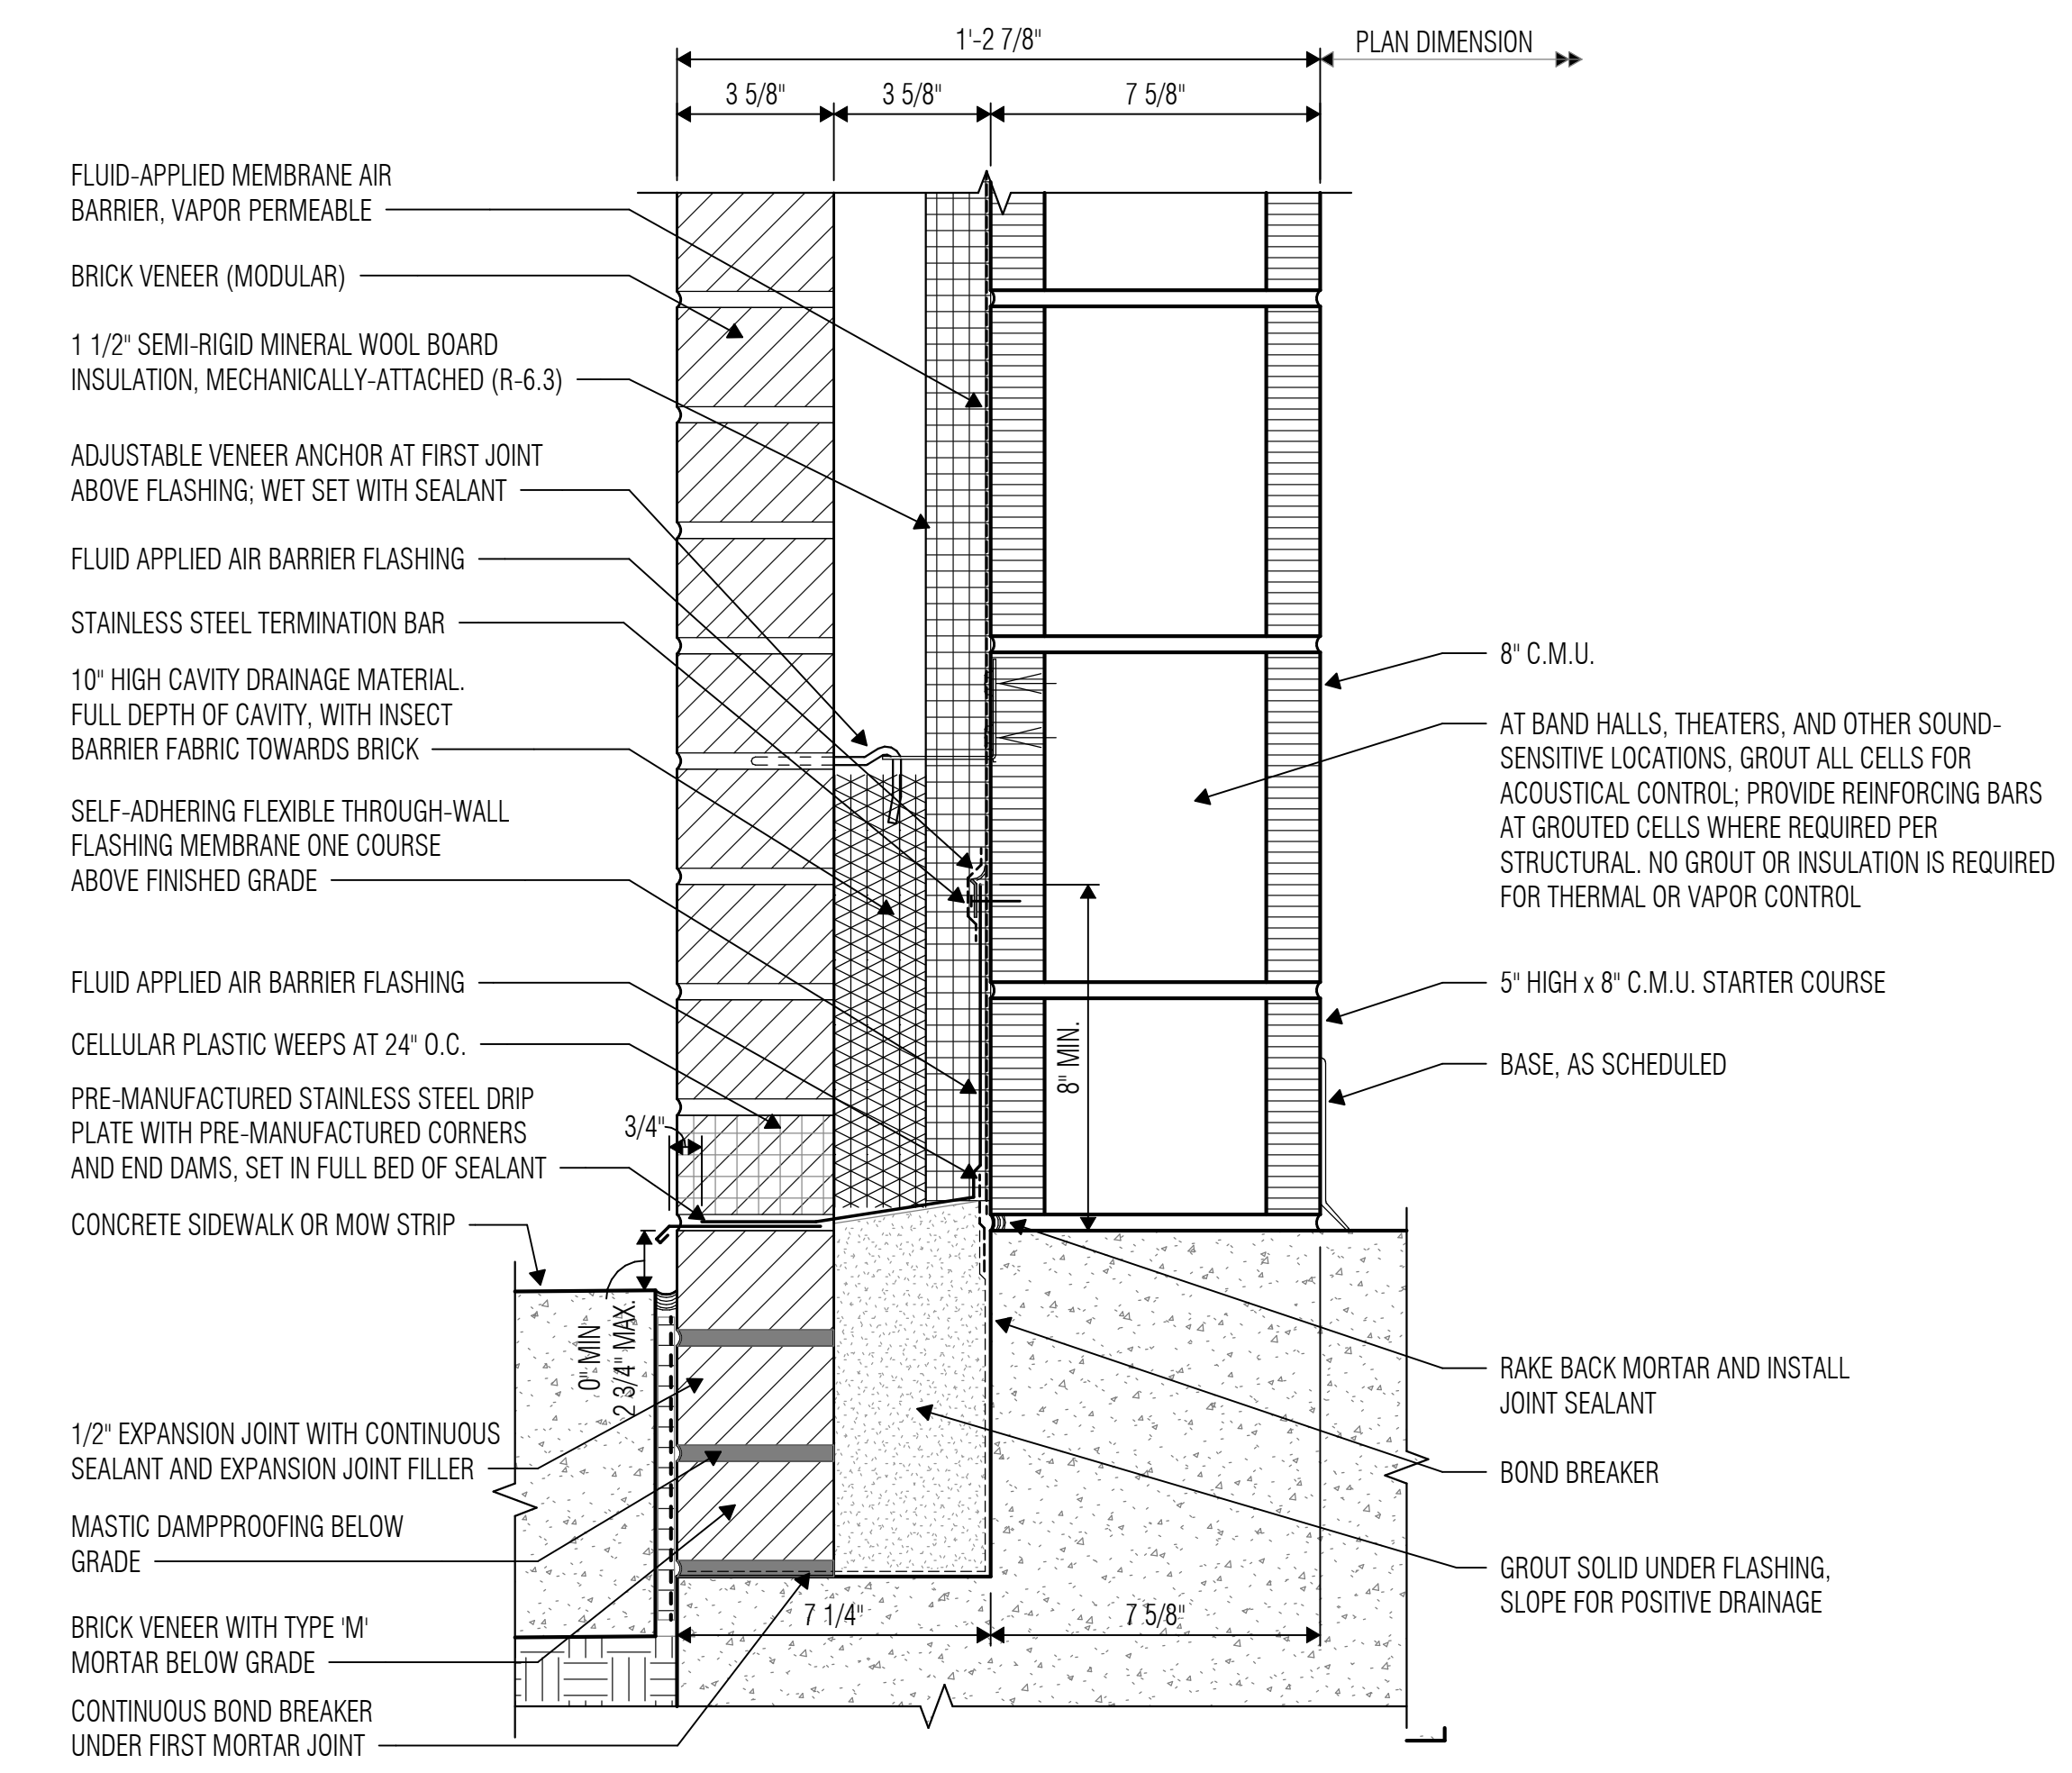

3 MODULAR BRICK / CMU WALL AT SIDEWALK
 SCALE: 3" = 1'-0"

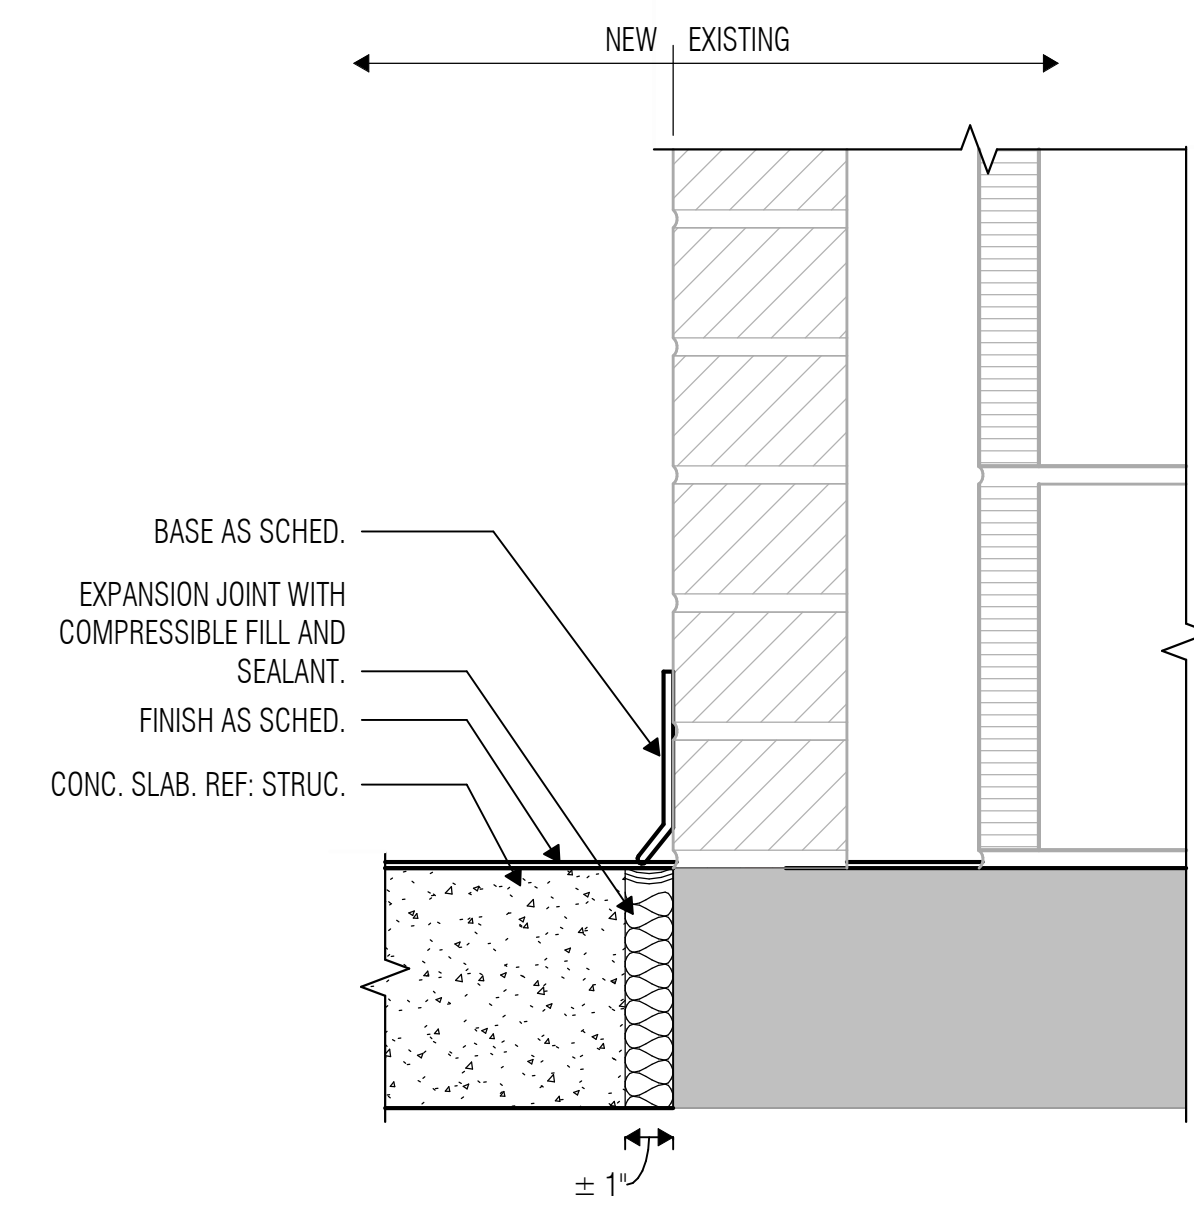

4 DETAIL AT EXISTING SLAB EDGE CONNECTION
 SCALE: 3" = 1'-0"

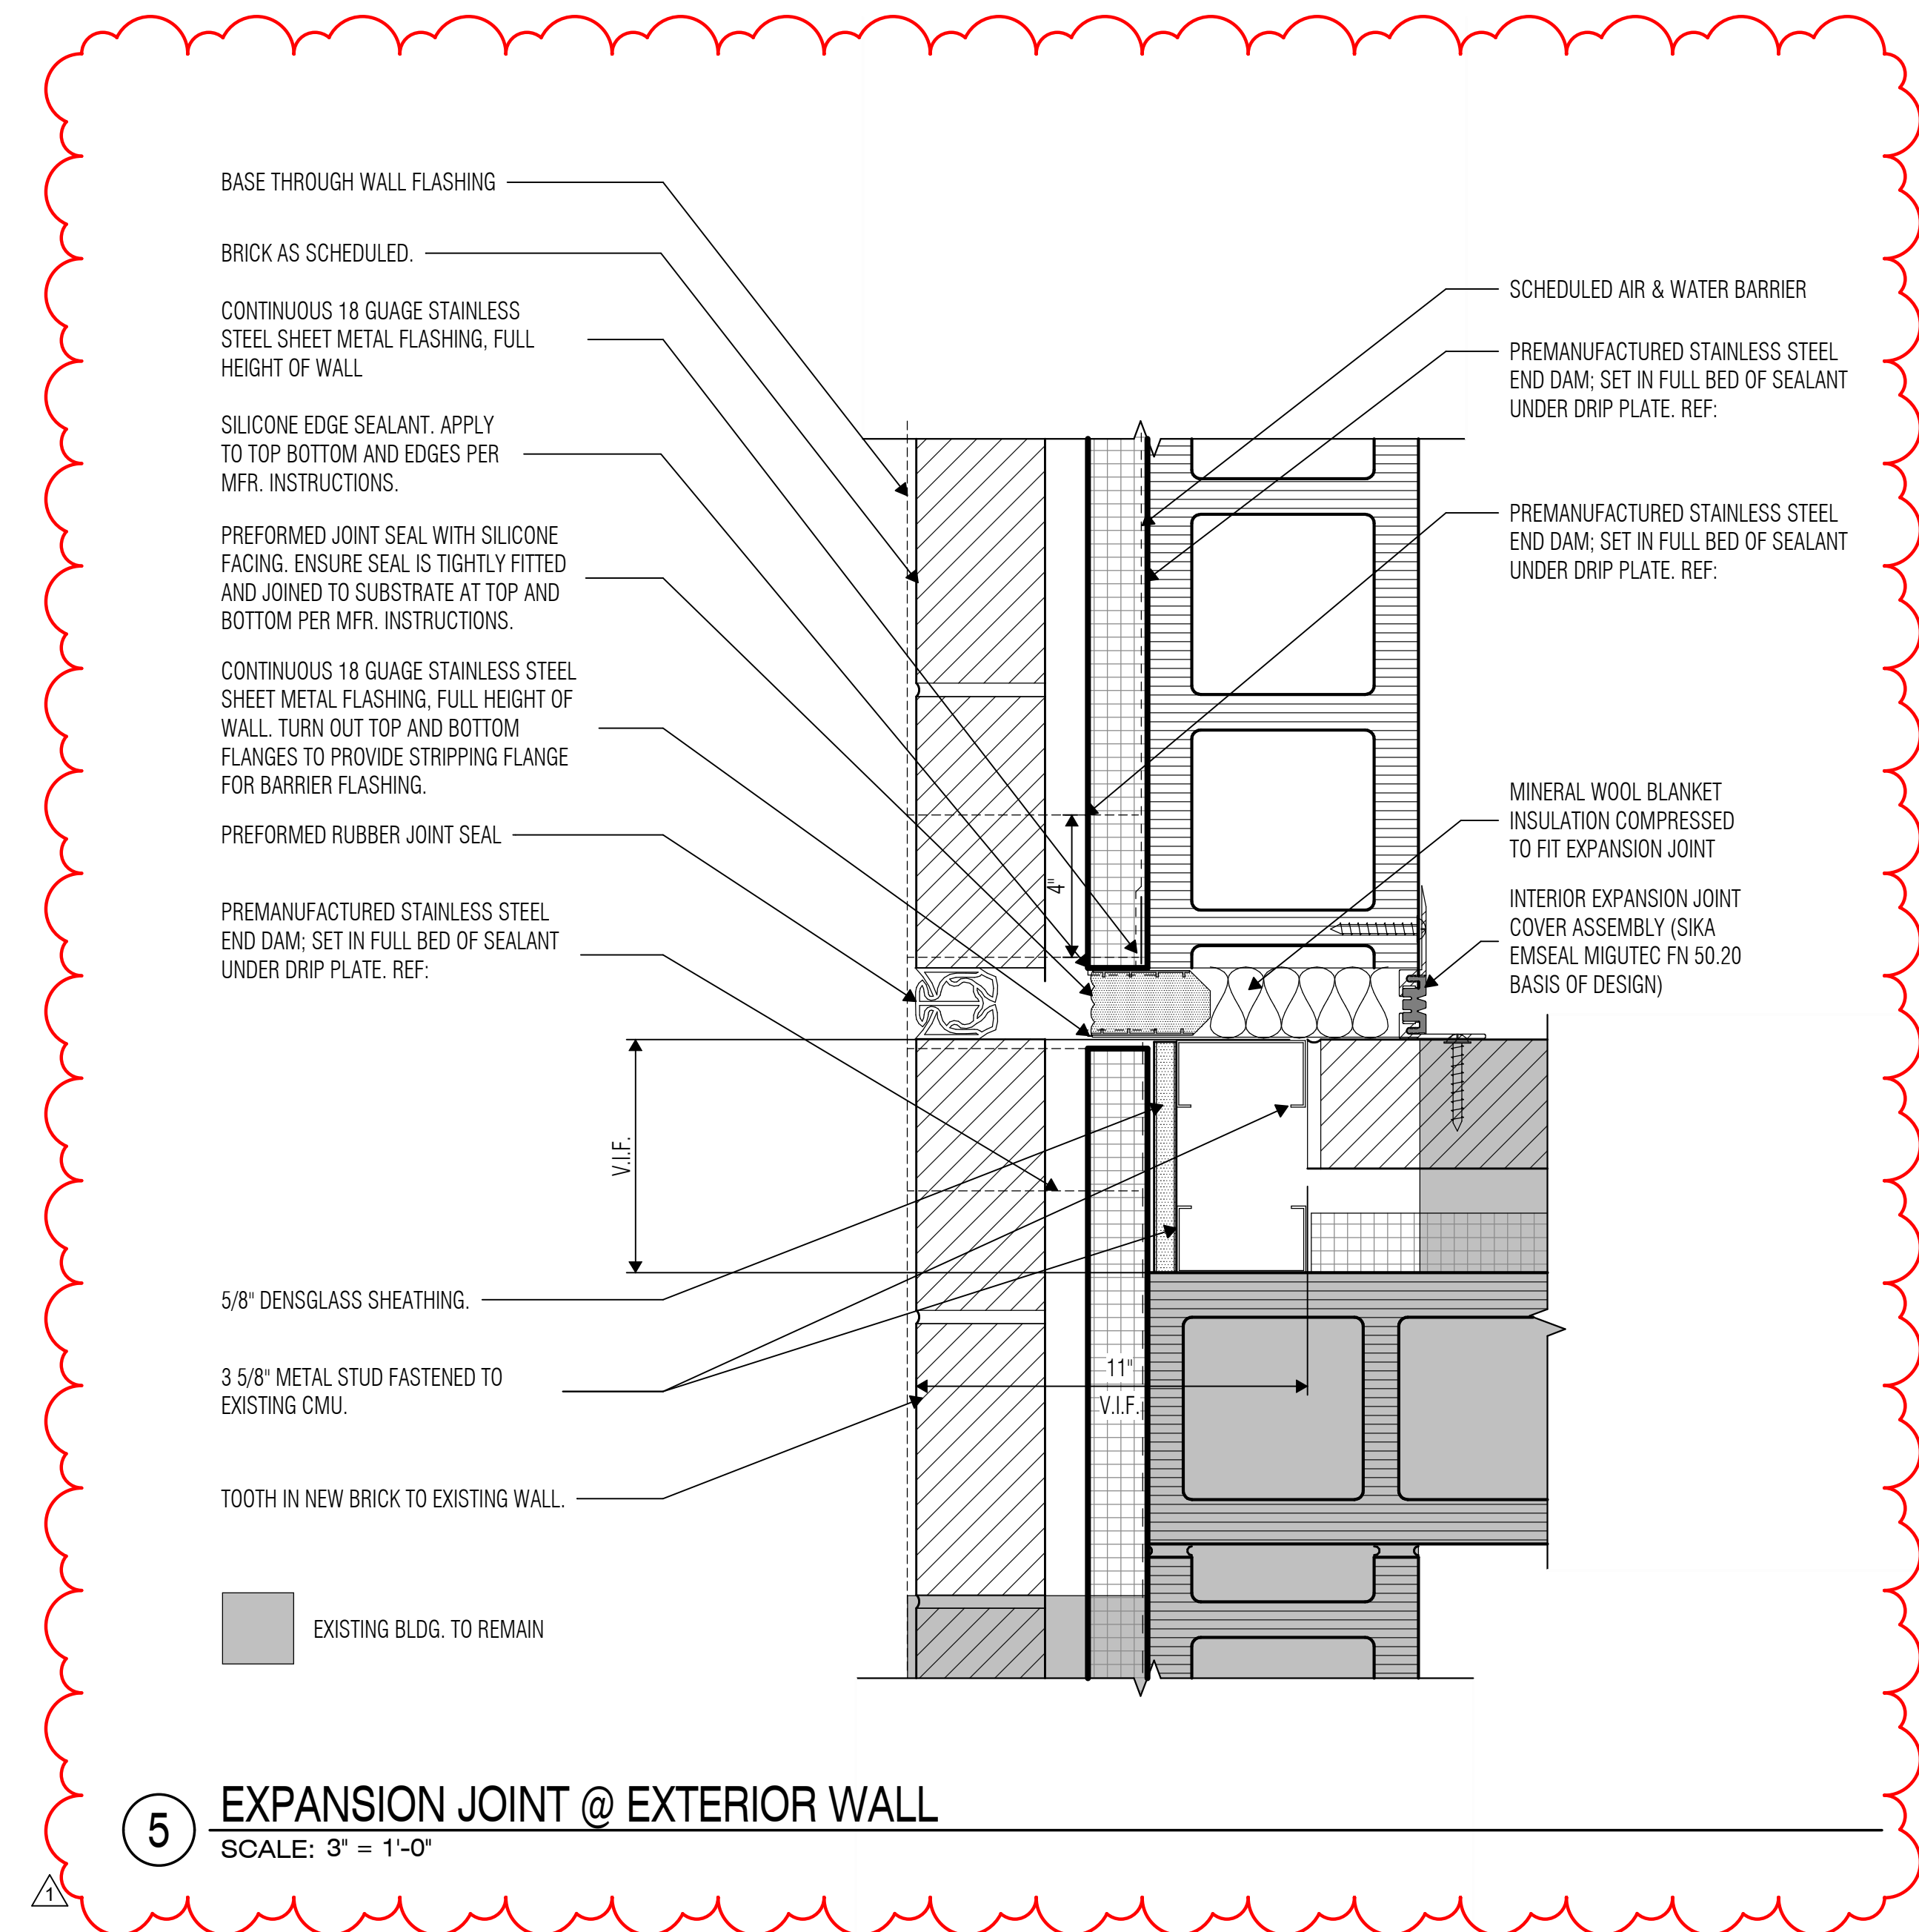

5 EXPANSION JOINT @ EXTERIOR WALL
 SCALE: 3" = 1'-0"



ISSUED: February 24, 2025

REVISIONS

Revision No.	Revision Date
1 Addendum 1	03-06-2025

Director: RSJ
 Drawn By: STH, KM
 Designer: TQ
 Quality Control:

PROJECT NO.


24-010.00

SHEET TITLE

COOK - BUILDING ASSEMBLY DETAILS

SHEET NO.

A14.32

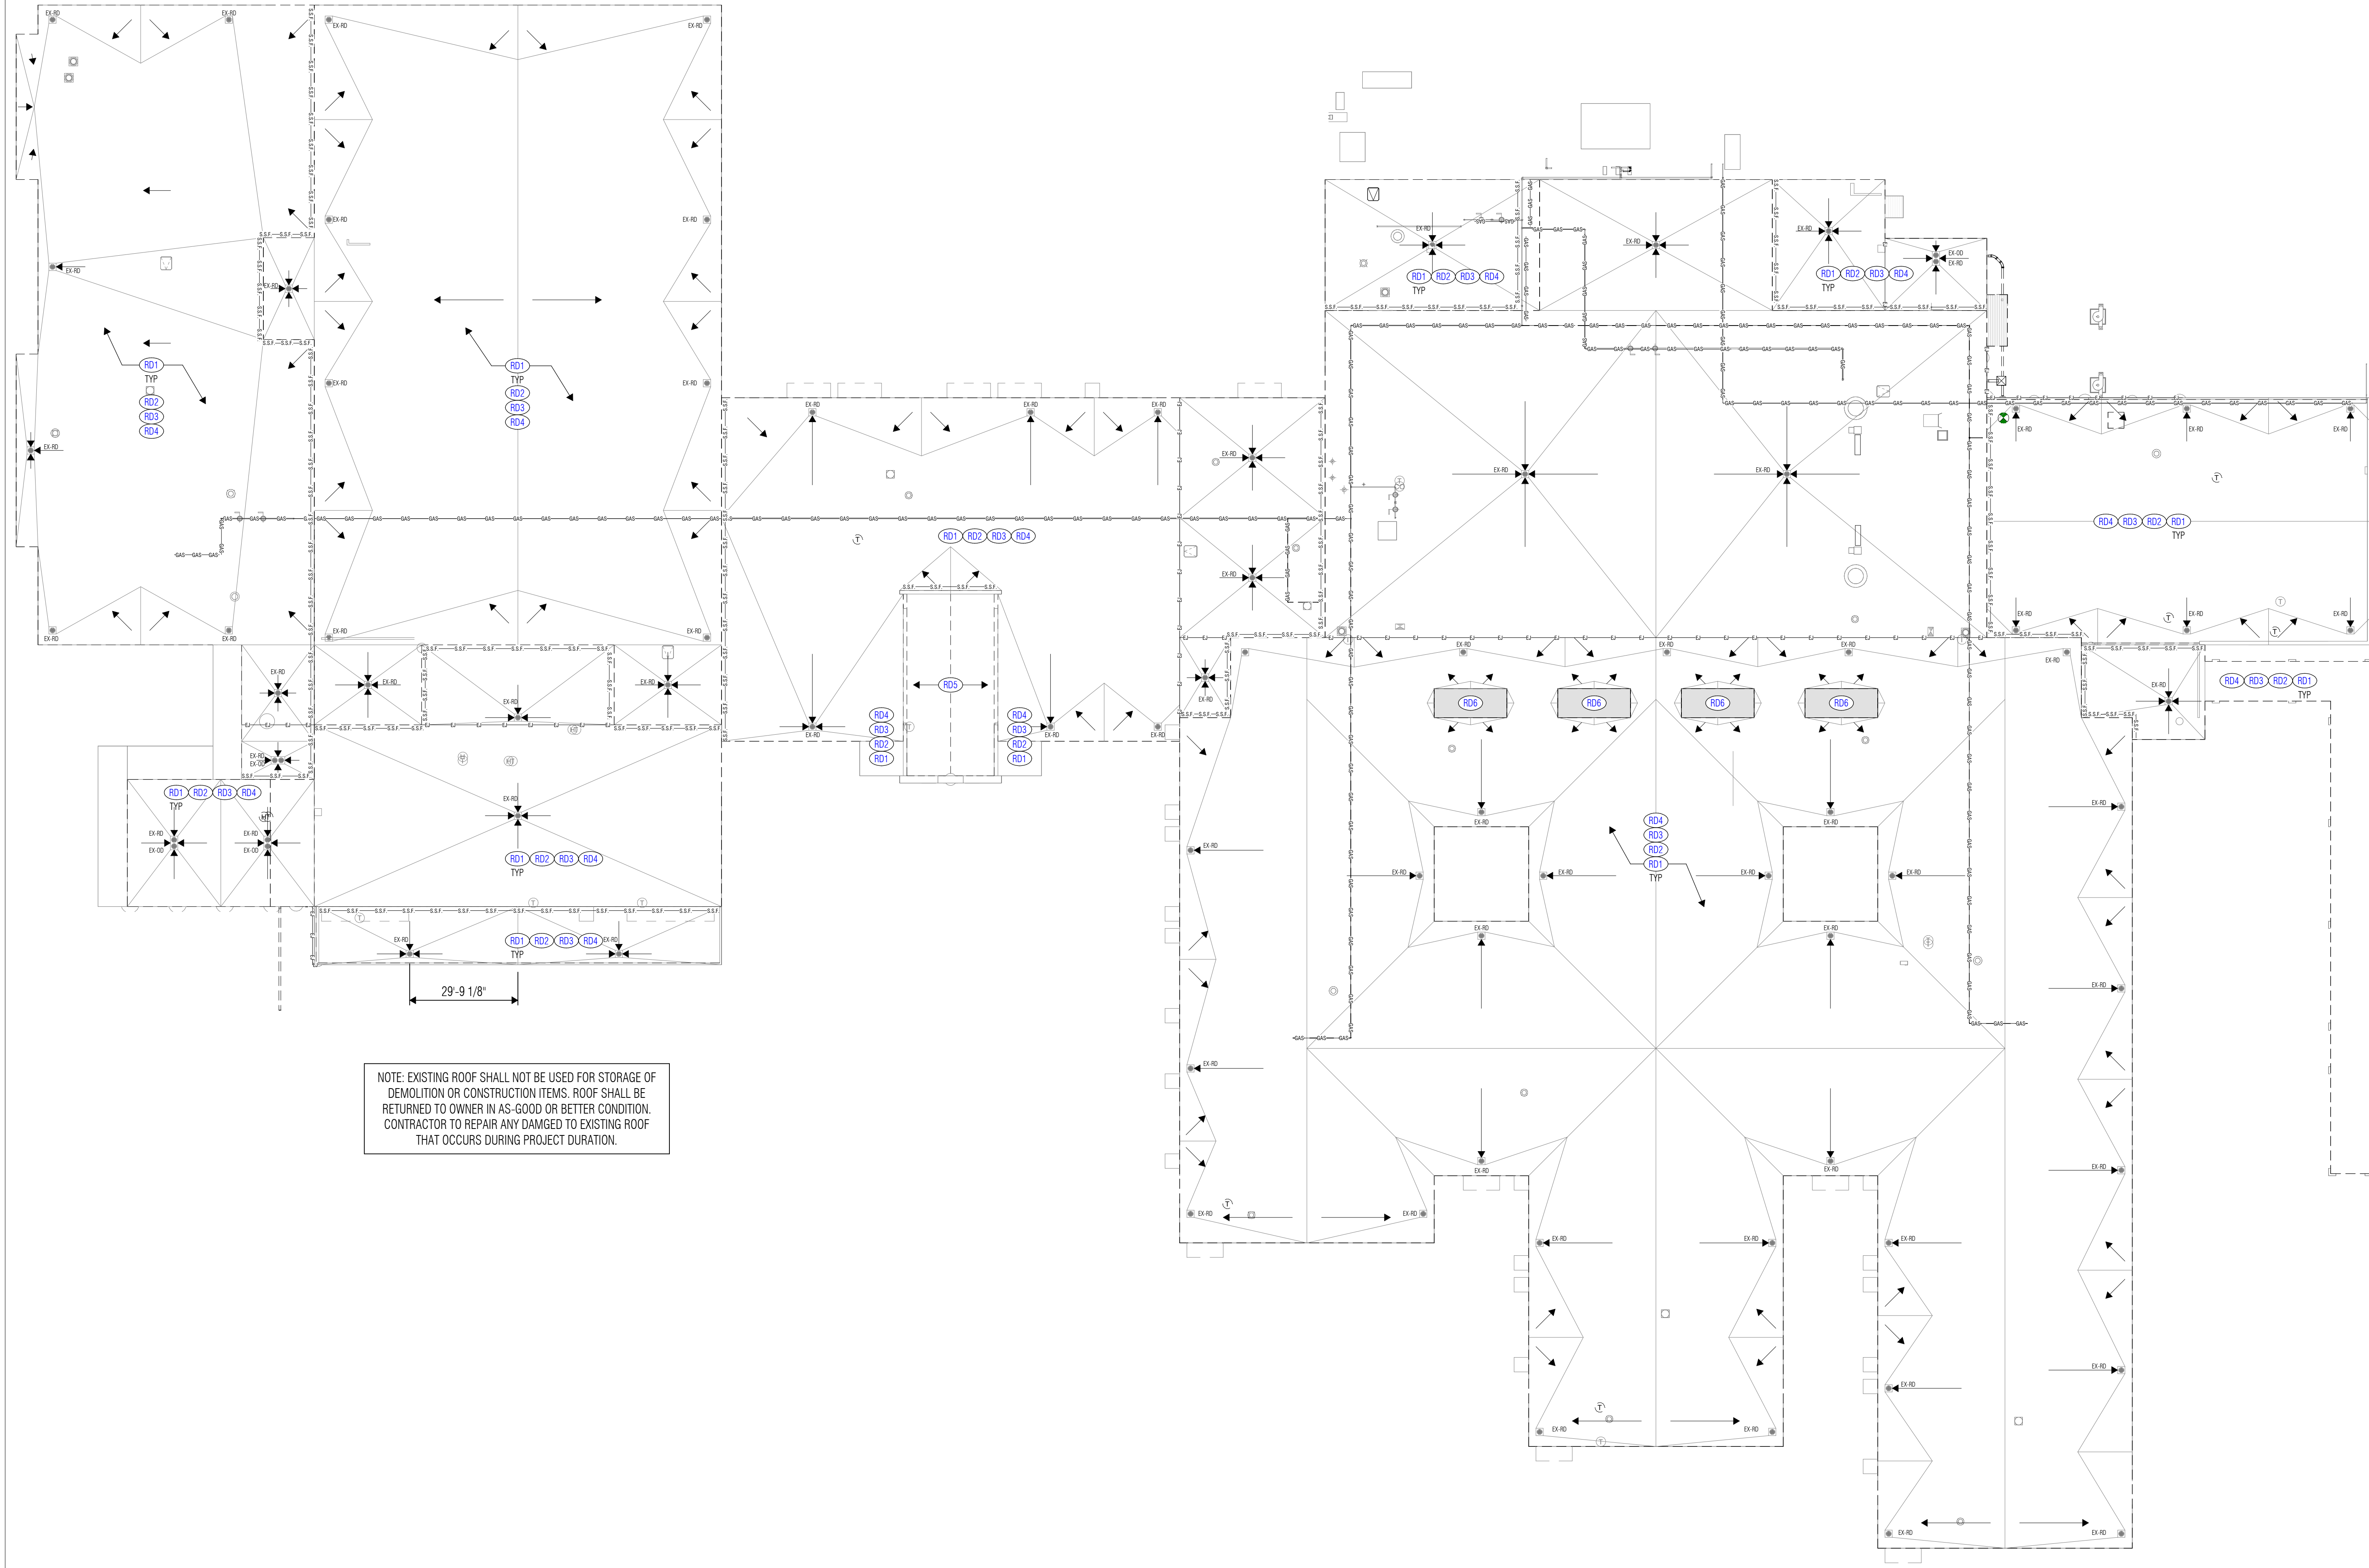

1 OVERALL ROOF DEMO PLAN
SCALE: 3/64" = 1'-0"

- ### ROOF PLAN NOTES
- Provide tapered insulation crickets at the high side of all rooftop curbs, mounting rails, and other miscellaneous roof penetrations as required to shed water around them and to ensure positive roof drainage, whether indicated on the drawings or not.
 - Crickets shall slope 1/2" per foot, unless noted otherwise.
 - Locate overflow scuppers per Building Elevations. If conflicts occur, contact Architect prior to construction.
 - Provide roof walkway protection at base of all roof ladders, around all sides of roof hatches, on all sides of rooftop units and condensing units, and on paths leading from roof access points to rooftop units and condensing units, whether indicated on drawings or not.
 - Provide layer of roof walkway protection under all pipe and conduit supports, fully-adhered to roof membrane.
 - Provide additional layer of single-ply roof membrane at the discharge point of downspouts, where splash pans are not provided.
 - Provide metal end closure at the ends of expansion joints, flashings and counterflashings.
 - Paint all exposed galvanized metal flashings, miscellaneous steel, piping, conduits, etc. that are not pre-finished.
 - Clean and paint strainer baskets.
 - All sheet metal fascia, gutters and downspouts shall be pre-finished aluminum. All metal flashings embedded in roof membrane and in through-wall conditions shall be stainless steel.
- ### ROOF PLAN LEGEND
- NEW ROOF ASSEMBLY
 - EX-RD EXISTING ROOF DRAIN
 - EX-OD EXISTING OVERFLOW PLAN
 - CTES-TCT EXISTING COAL-TAR PITCH ELASTOMERIC SHEET ROOFING OVER EXISTING TECTUM PANEL DECKING
 - CTES-LW EXISTING COAL-TAR PITCH ELASTOMERIC SHEET ROOFING OVER EXISTING TECTUM PANEL DECKING
 - CTES-STRLW EXISTING COAL-TAR PITCH ELASTOMERIC SHEET ROOFING OVER EXISTING LIGHT WEIGHT CONCRETE DECKING
 - EXISTING EXPANSION JOINT
 - NEW STAINLESS STEEL THROUGH WALL FLASHING
 - EXISTING FIRE HATCH
 - EXISTING MECHANICAL, ELECTRICAL, PLUMBING UNITS
 - DEMOLISHED ITEMS

- ### ROOF PLAN LEGEND
- BUR BUILT-UP BITUMINOUS ROOFING
 - MBM MODIFIED BITUMINOUS MEMBRANE ROOFING
 - CTES COAL-TAR PITCH ELASTOMERIC SHEET ROOFING
 - T.O.M. TOP OF MASONRY ELEVATION
 - T.O.D. TOP OF DECK ELEVATION
 - T.O.S. TOP OF STEEL ELEVATION
 - RD ROOF DRAIN, REF.
 - OD OVERFLOW DRAIN WITH DOWNSPOUT NOZZLE, REF.
 - OS OVERFLOW SCUPPER, REF. /A
 - DS DOWNSPOUT, REF. /A
 - DSC DOWNSPOUT WITH SCUPPER AND CONDUCTOR HEAD, REF. /A
 - SB SPLASH BLOCK, CONCRETE, REF. /A
 - SP SPLASH PAN, REF. /A
 - MC MANUFACTURED COPING, REF. /A
 - RH ROOF HATCH, REF.
 - RL ROOF LADDER, REF. /A
 - RTU ROOFTOP UNIT, REF. MECHANICAL & /A
 - CU CONDENSING UNIT, REF. FOOD SERVICE, M.E.P. & /A
 - GP GAS PIPE PENETRATION, REF.
 - RV RELIEF VENT, REF. M.E.P.
 - EF EXHAUST FAN, REF. M.E.P.

DEMO KEYED NOTES

RD1	CLEAN AND PREPARE ROOF TO RECEIVE NEW CAP SHEET. CUT OUT AND REPAIR ANY DEFORMATIONS OR BUBBLES IN THE EXISTING ROOF LAYERS.
RD2	CAREFULLY REMOVE ALL EXISTING ROOF COPING AND FLASHING. EXISTING BLOCKING TO REMAIN, U.N.O. REMOVE AND REPLACE ANY DETERIORATED BLOCKING. PREPARE AREA FOR NEW CONSTRUCTION.
RD3	EXISTING ROOF TOP UNITS TO REMAIN, U.N.O. PROTECT IN PLACE. GC TO WALK WITH OWNER REPS TO VERIFY UNITS' FUNCTIONALITY. REF: MEP
RD4	REMOVE AND PROPERLY DISPOSE OF ABANDONED EQUIPMENT AND ASSOCIATED ITEMS ON EXISTING ROOF. COORDINATE WITH OWNER FOR REMOVAL.
RD5	REMOVE AND PROPERLY DISPOSE OF ROOF SHINGLES AND WATERPROOFING. SHEATHING AND INSULATION TO REMAIN. REPLACE ANY DAMAGED SHEATHING. CLEAN AND PREPARE FOR NEW CONSTRUCTION.
RD6	EXISTING SKYLIGHT TO REMAIN. PROTECT IN PLACE. CONTRACTOR TO REPAIR ANY DAMAGE CAUSED AS A RESULT OF CONSTRUCTION ACTIVITIES.

ARCHITECT

VLK Architects
20445 State Hwy 249, Suite 350
Houston, Texas 77070
Main Phone: 281.671.2300
www.vlkarchitects.com

CYPRESS-FAIRBANKS INDEPENDENT SCHOOL DISTRICT
HOUSTON, TEXAS

2024 Cook, Labay & Truitt MS Renovations

ISSUED: February 24, 2025

REVISIONS	
Revision No.	Revision Date
1 Addendum 1	03-06-2025

Director
RSJ
Designer

Proj. Arch.
TQ

Drawn By
STH, KM
Quality Control

PROJECT NO.
24-010.00

SHEET TITLE
COOK - ROOF DEMO PLAN

SHEET NO.
A15.01



COPYRIGHT © 2025 VLK ARCHITECTS

KEYNOTE LEGEND
 MD19 CAREFULLY REMOVE STORE AND PROTECT ACOUSTIC PANELS. PREPARE AREA FOR NEW CONSTRUCTION.



ARCHITECT
VLK Architects
 20445 State Hwy 249, Suite 350
 Houston, Texas 77070
 Main Phone: 281.671.2300
 www.vlkarchitects.com

CYPRESS-FAIRBANKS INDEPENDENT SCHOOL DISTRICT
 HOUSTON, TEXAS

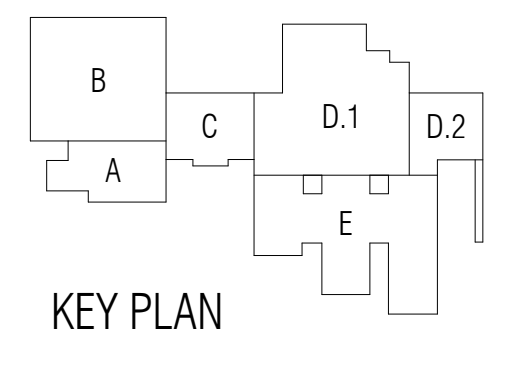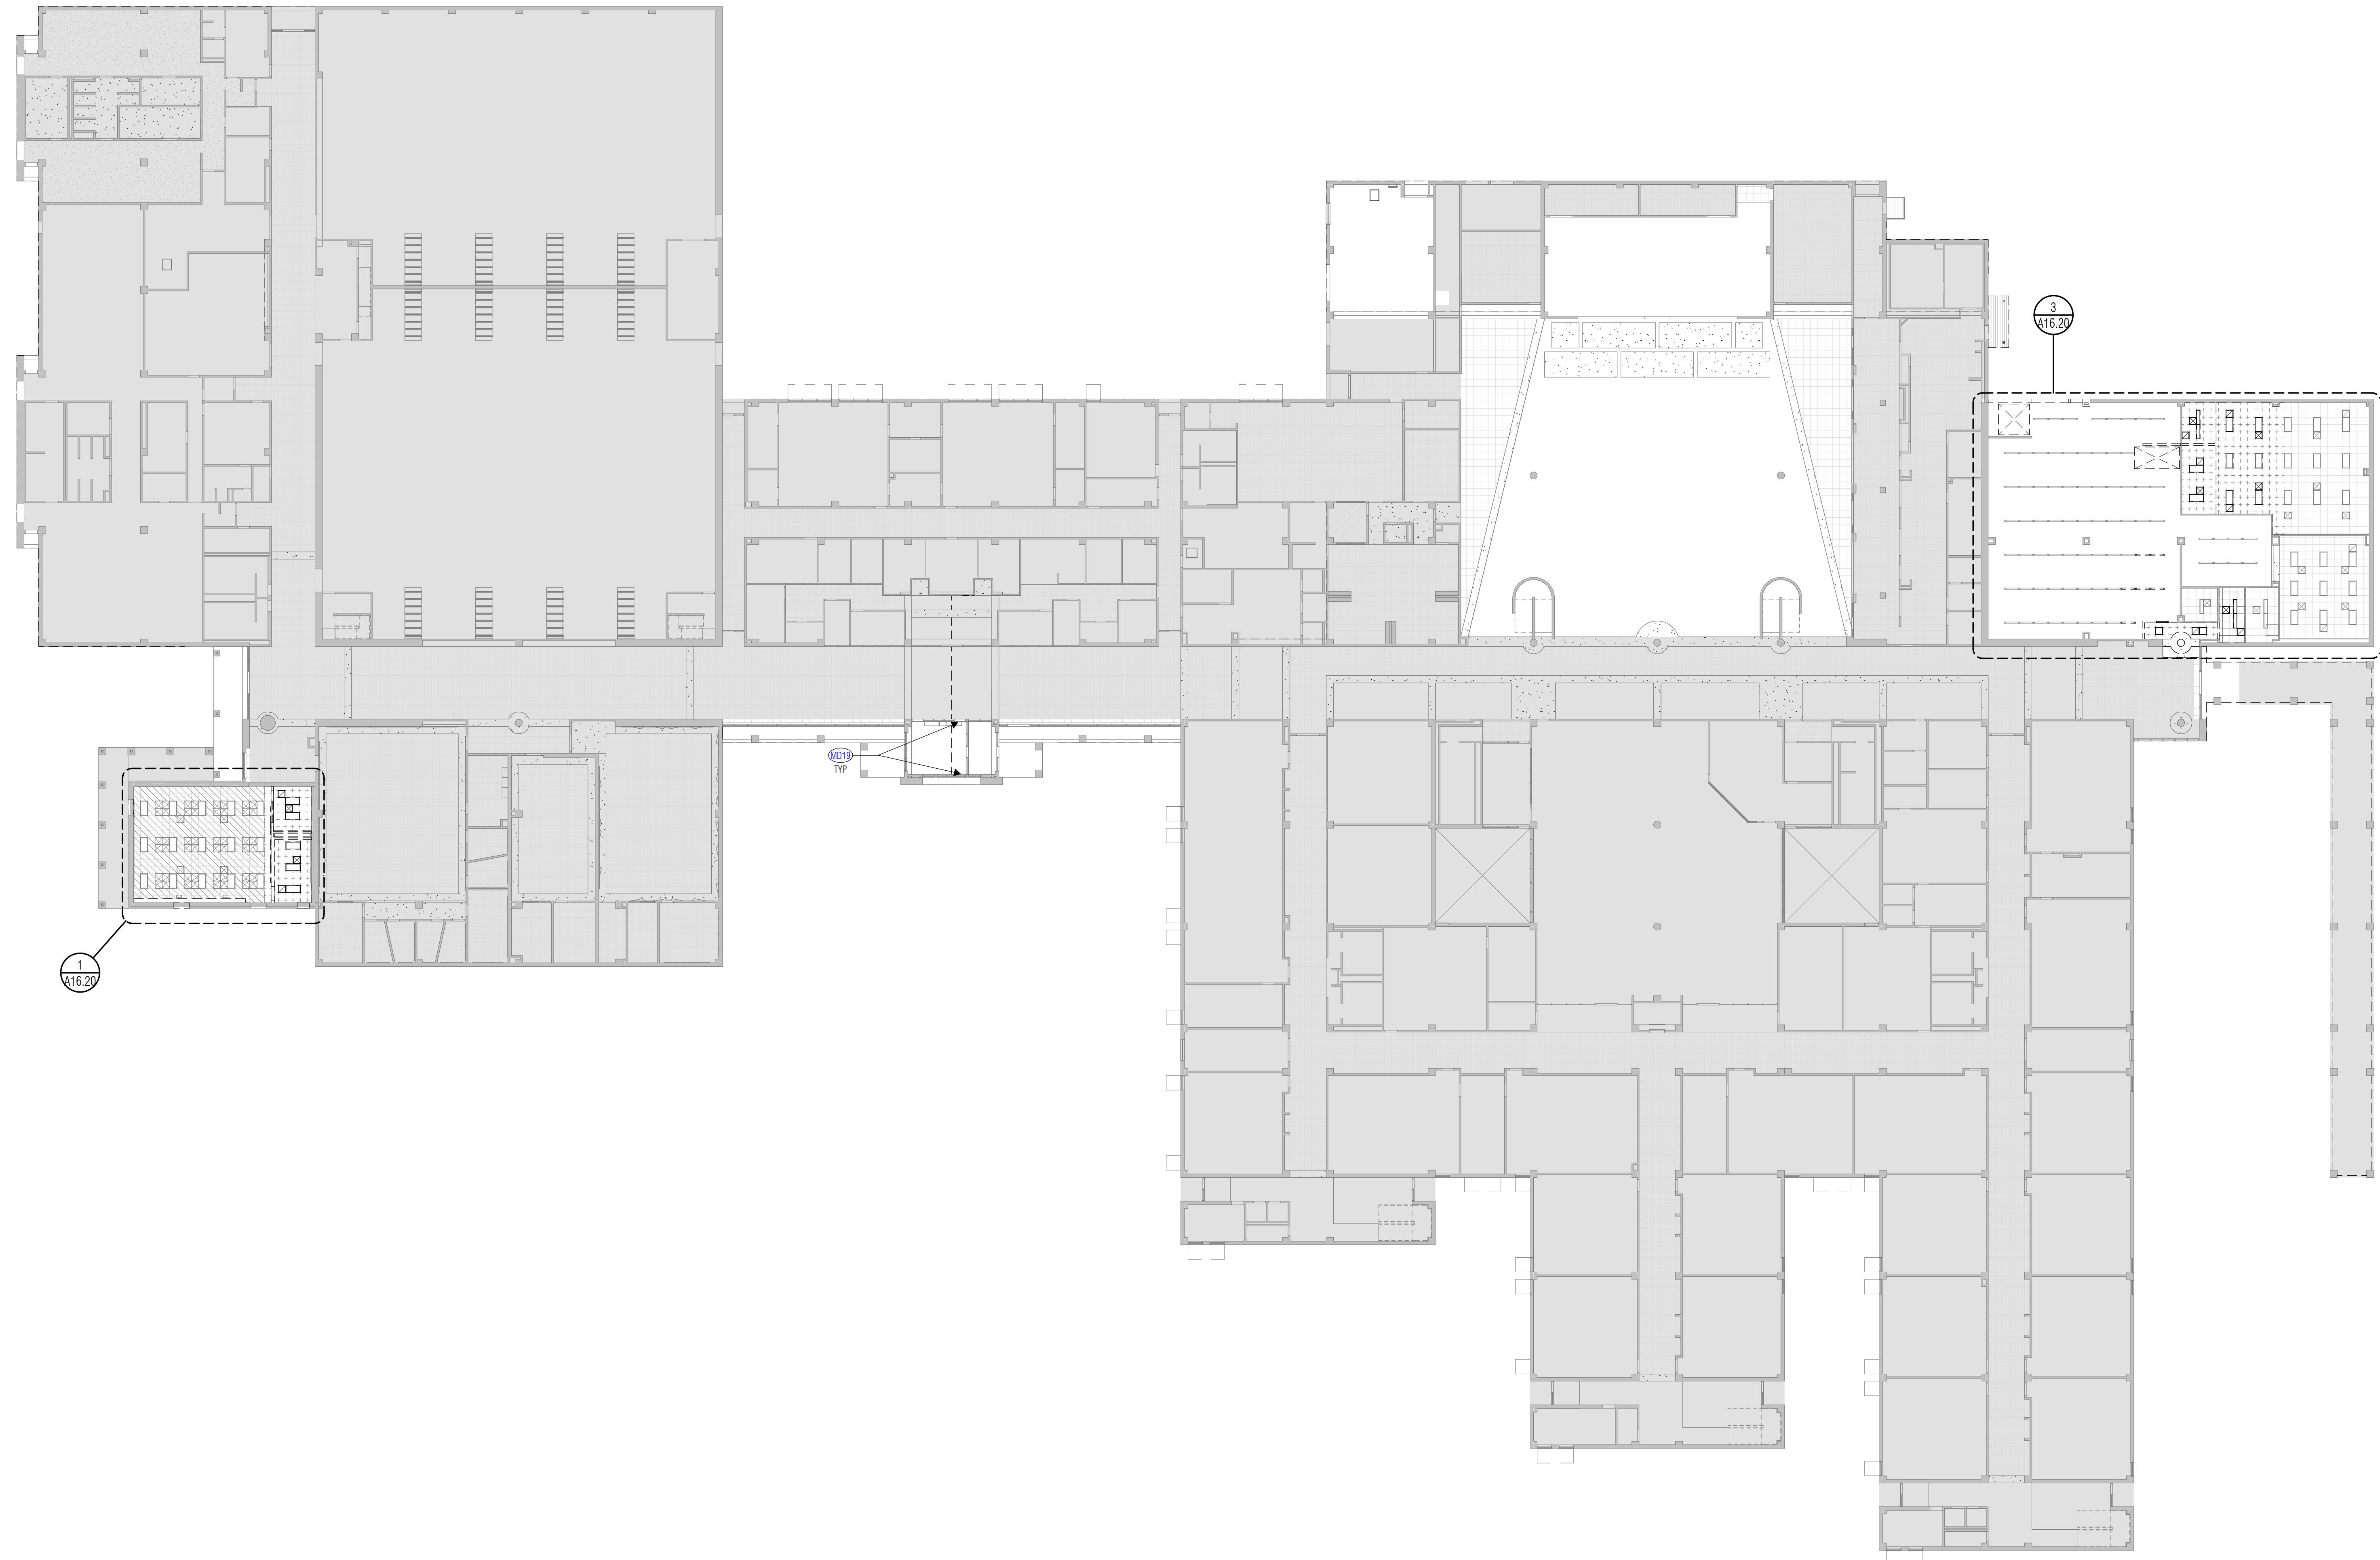

ISSUED: February 24, 2025

REVISIONS	
Revision No.	Revision Date
1 Addendum 1	03-06-2025

Director: RSJ
 Designer: RSJ
 Drawn By: STH, KM
 Quality Control: STH, KM

Proj. Arch.: TQ

PROJECT NO.
24-010.00


SHEET TITLE
COOK - DEMOLITION REFLECTED CEILING PLAN - LEVEL ONE

SHEET NO.

A16.01


1 DEMOLITION REFLECTED CEILING PLAN - LEVEL ONE
 SCALE: 3/64" = 1'-0"

2024 Cook, Labay & Truitt MS Renovations

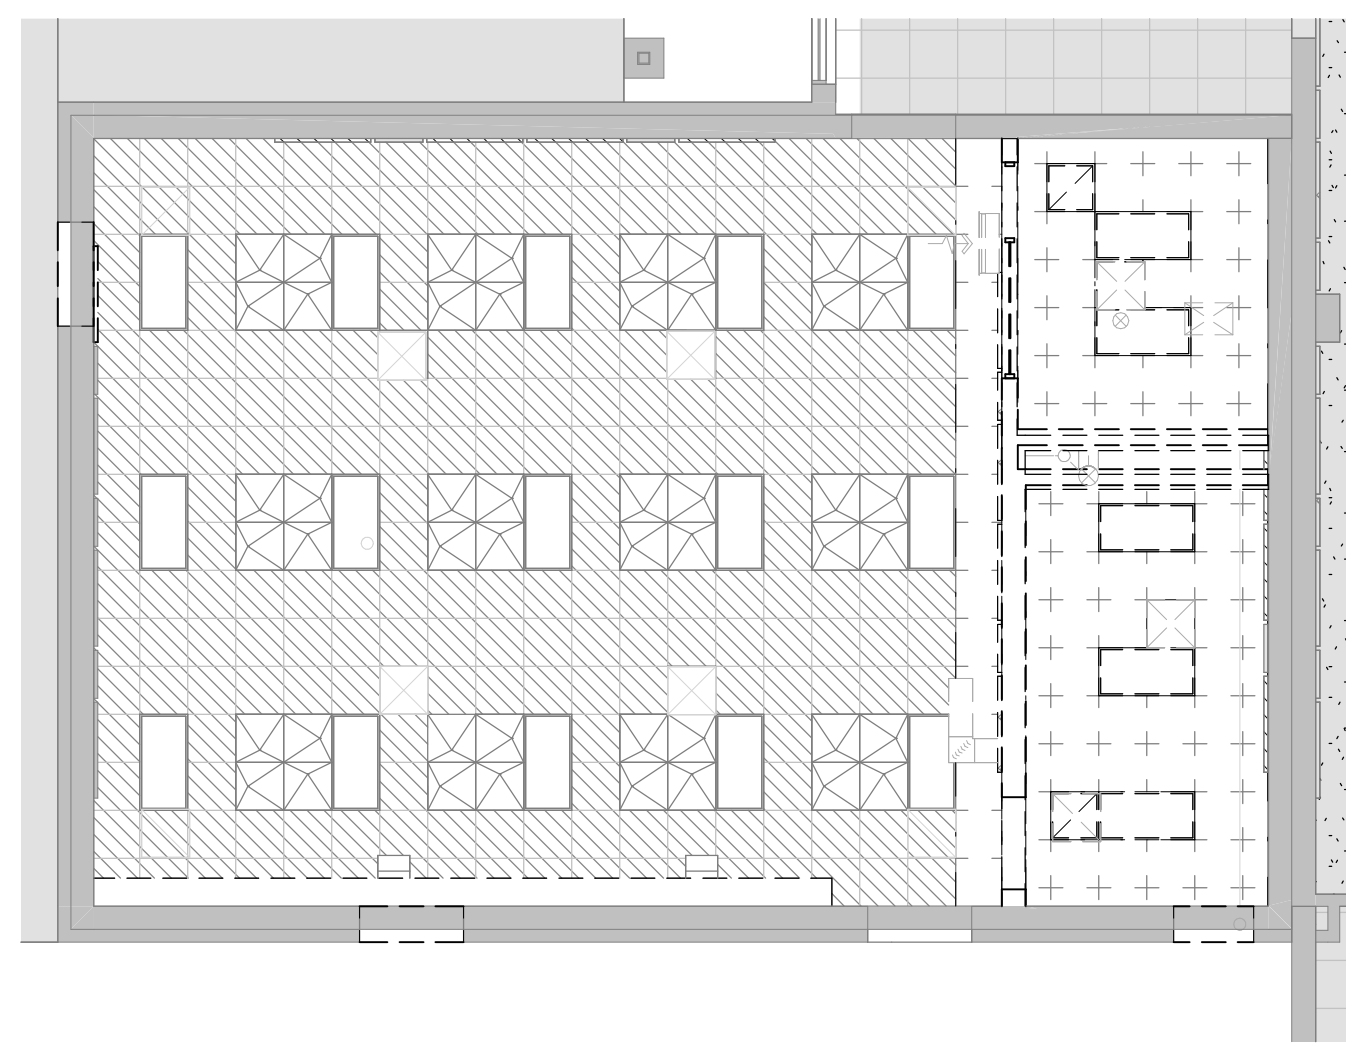


CONTRACTOR MAY RELOCATE ACOUSTIC CEILING TILES RECOVERED FROM ORCHESTRA 530 IN PRACTICE 531, OFFICE LIBRARY 532, AND/OR INSTRUMENT STORAGE 533A IN LIEU OF NEW TILES, ONLY WHERE AN ENTIRE ROOM WOULD BE COMPOSED OF REUSED ACOUSTIC CEILING TILES.


1 ORCHESTRA ADDITION ENLARGED DEMOLITION RCP
SCALE: 1/8" = 1'-0"

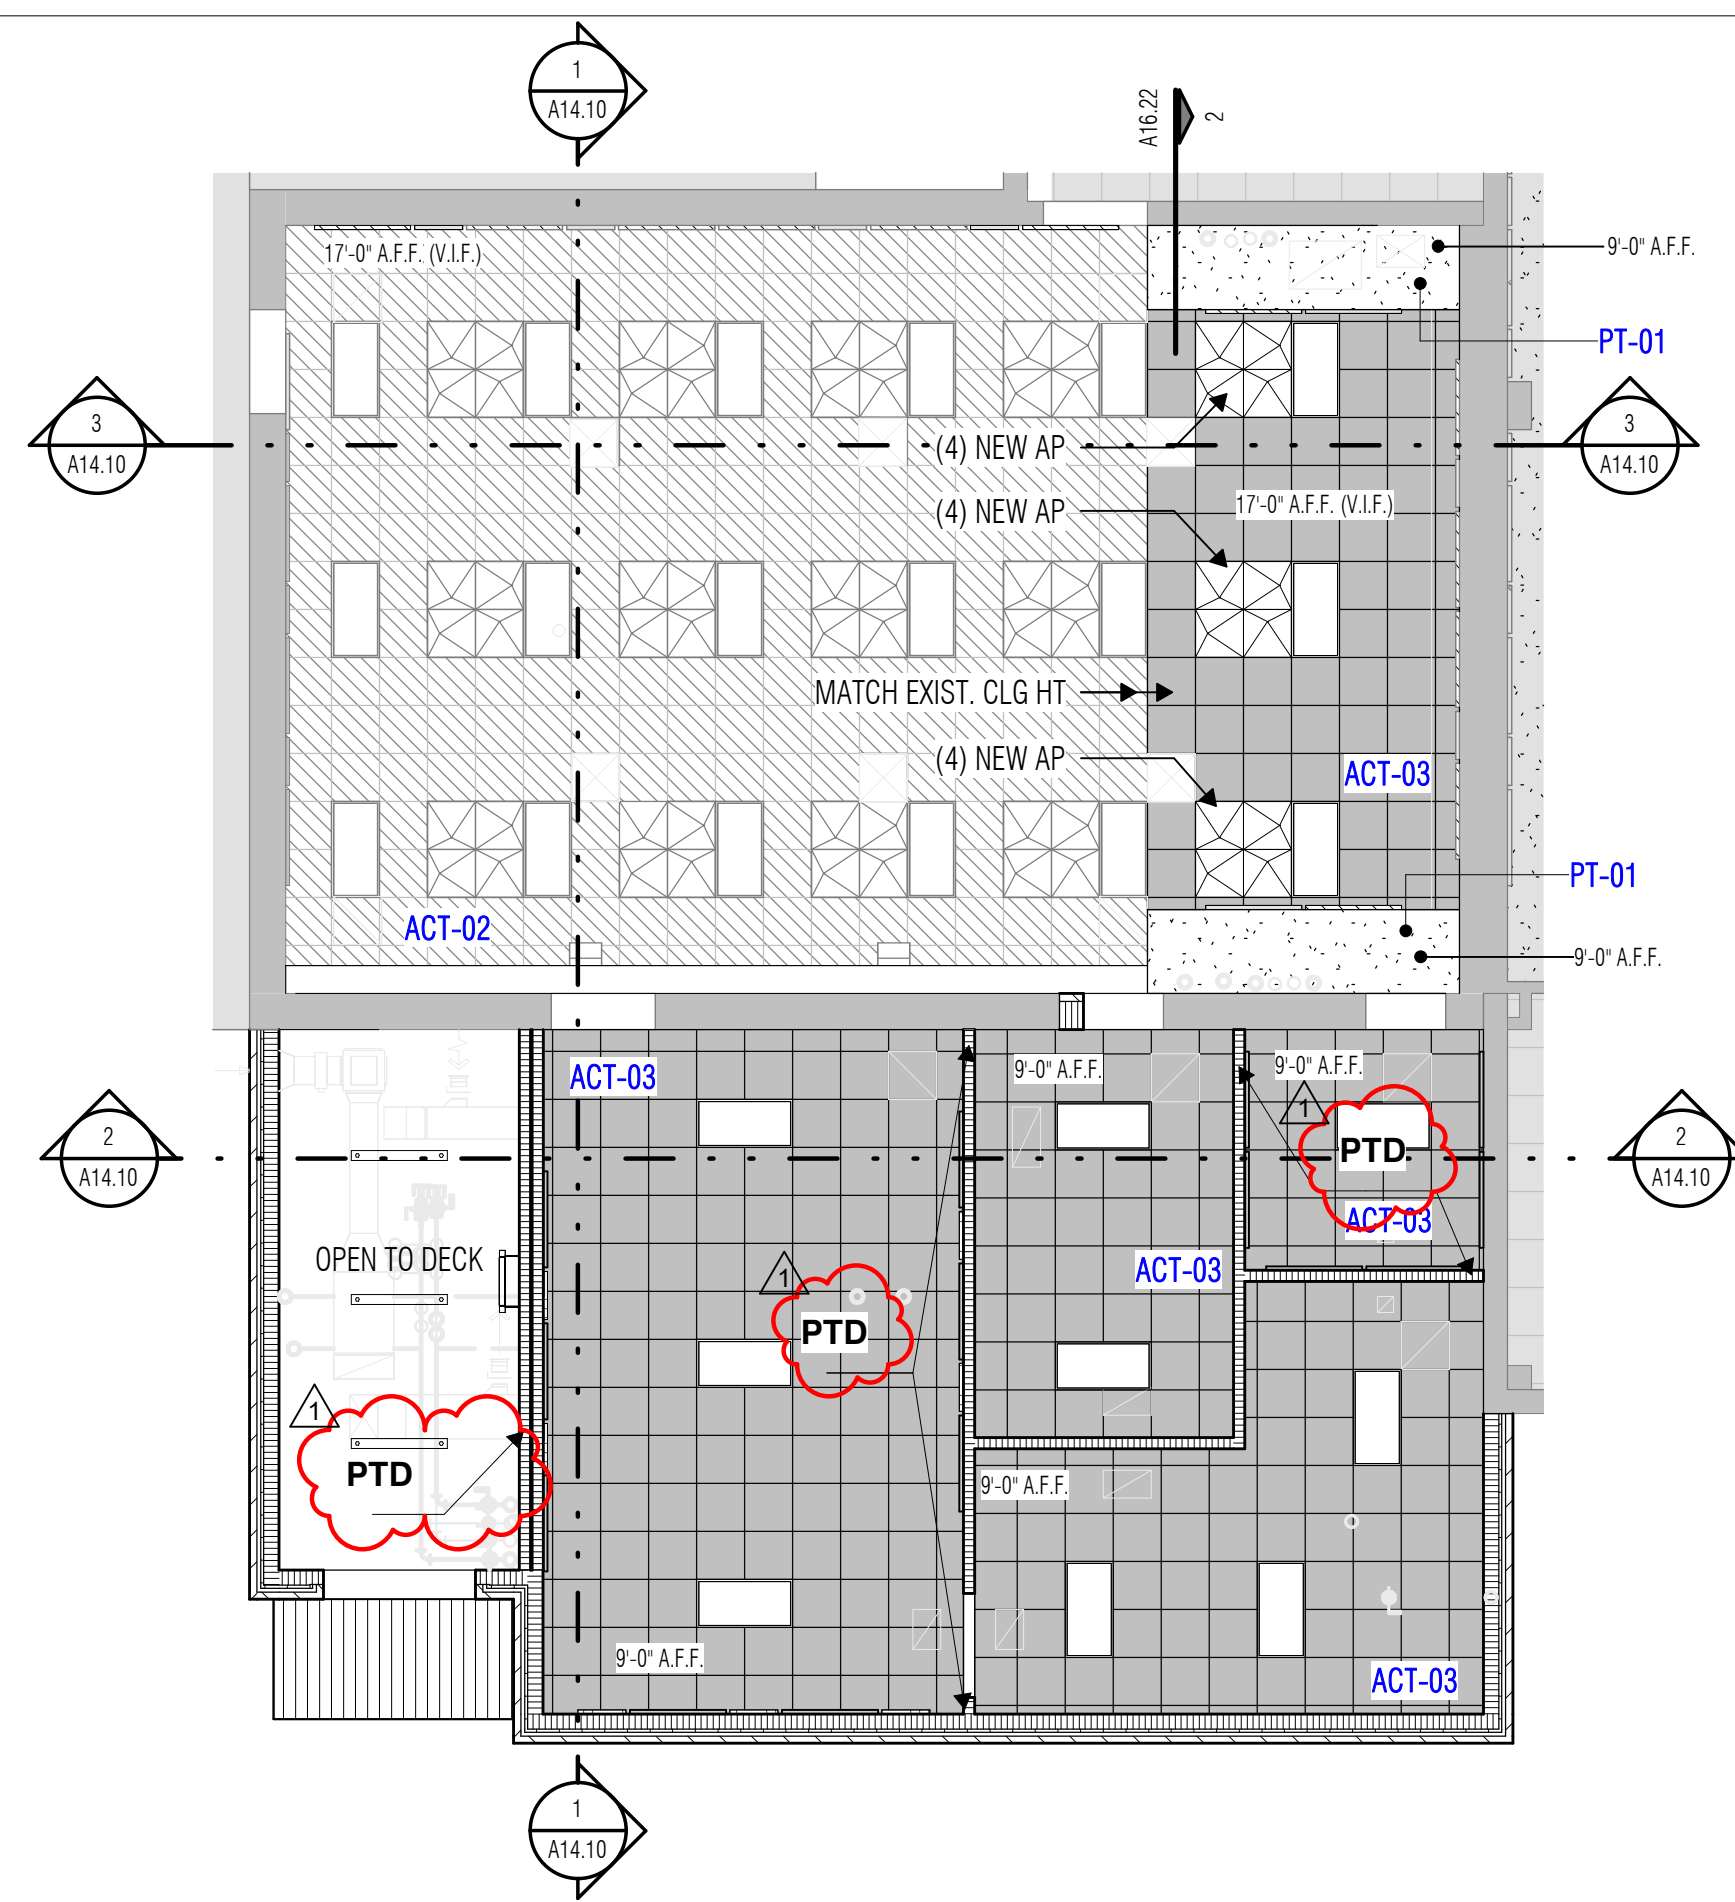

2 ORCHESTRA ADDITION ENLARGED RCP
SCALE: 1/8" = 1'-0"

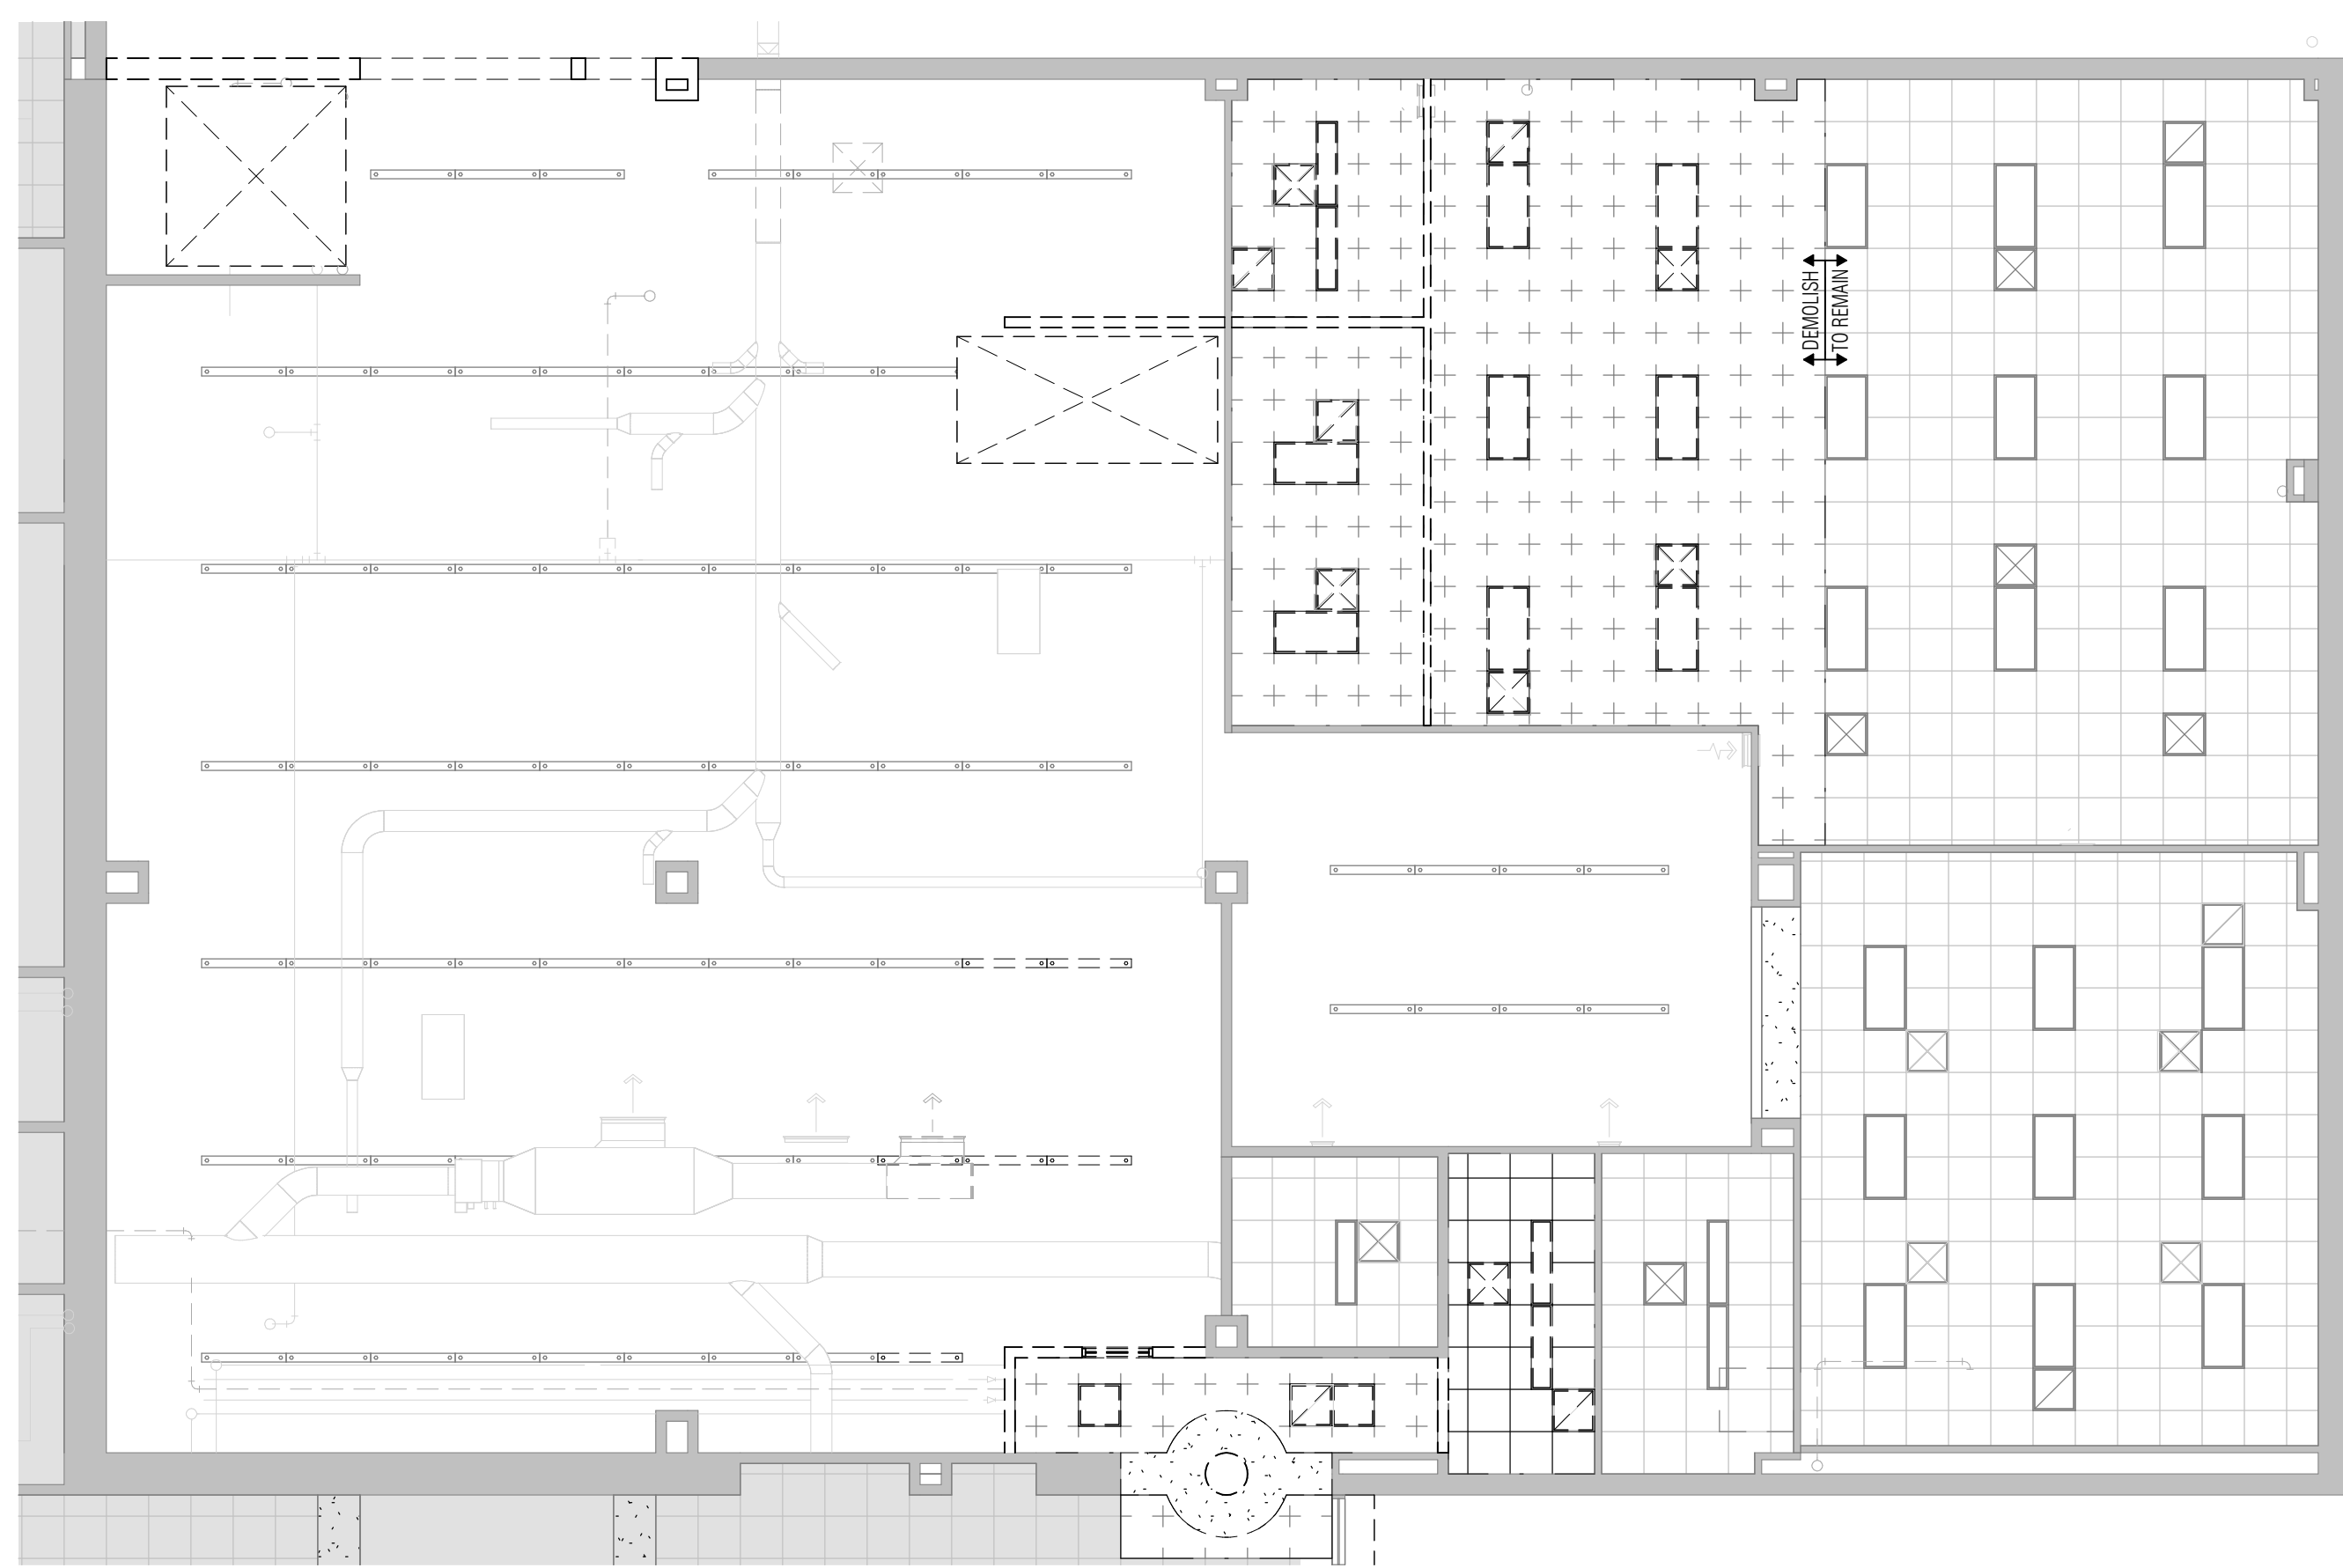

3 CTE ADDITION ENLARGED DEMOLITION RCP
SCALE: 1/8" = 1'-0"

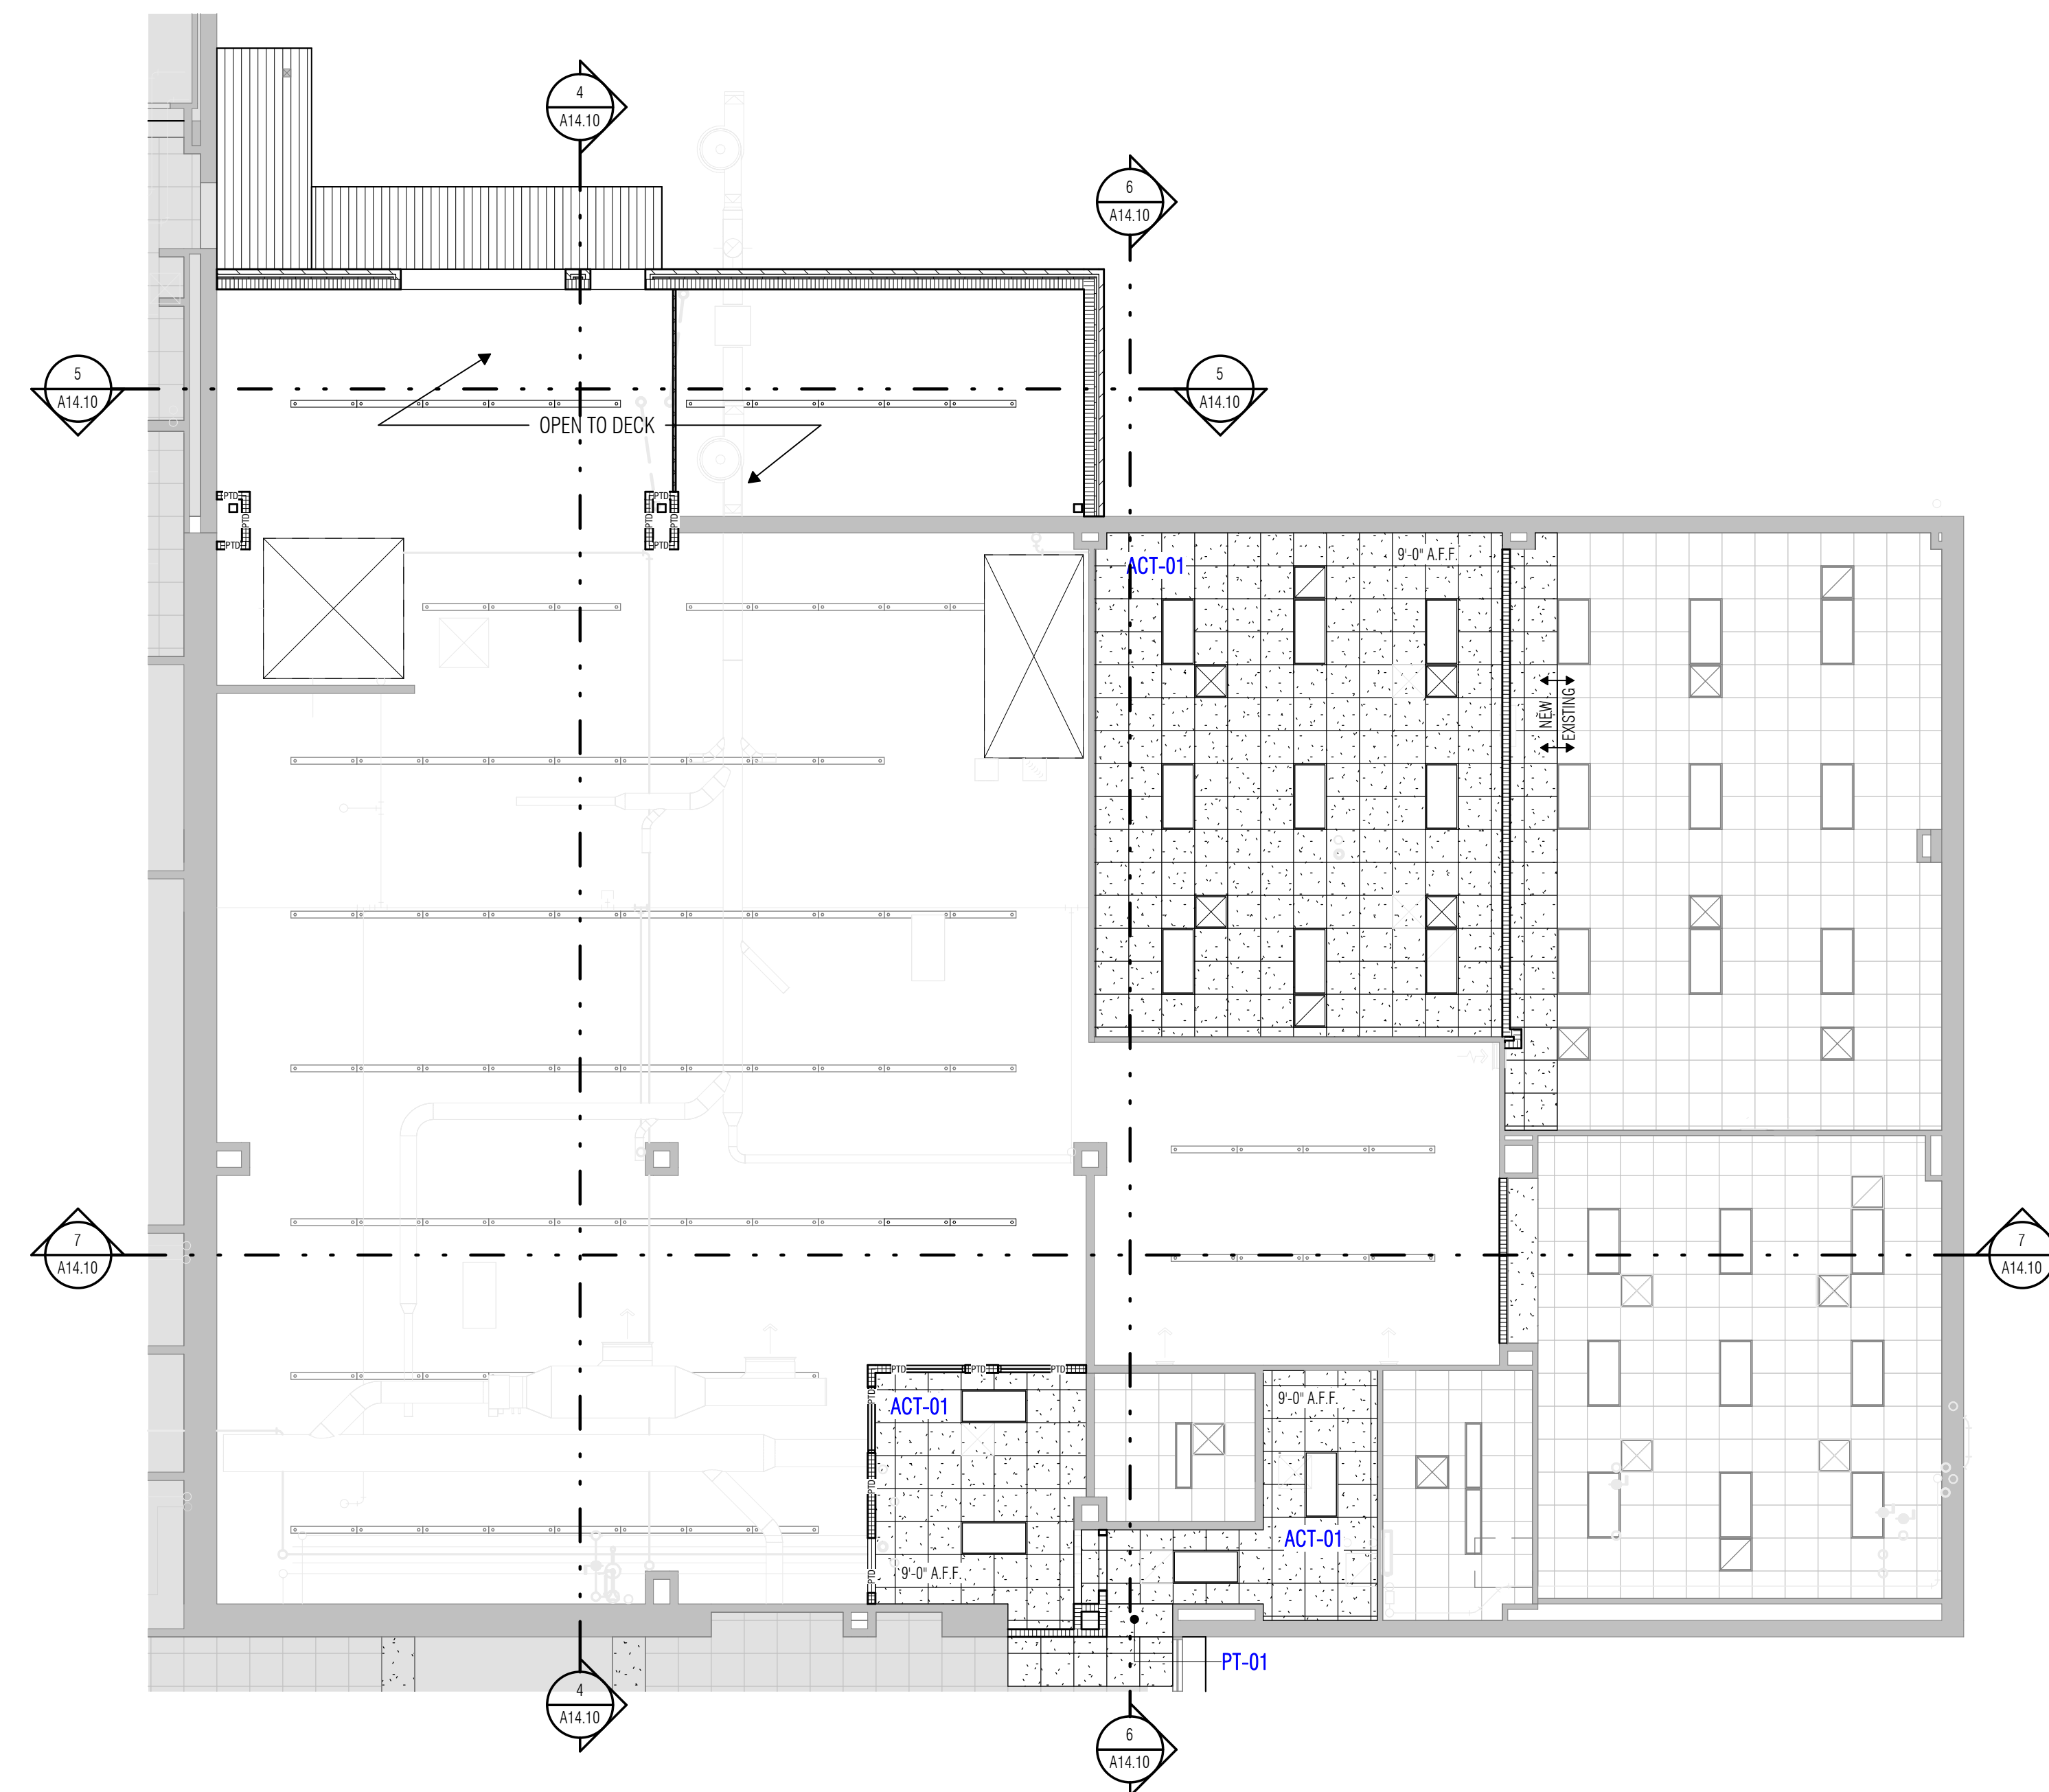

4 CTE ADDITION ENLARGED RCP
SCALE: 1/8" = 1'-0"

DEMOLITION REFLECTED CEILING PLAN LEGEND

- ITEMS TO BE DEMOLISHED (RE: DEMOLITION PLANS FOR MORE INFORMATION)
- [Cross-hatched box] AREAS EXISTING TO REMAIN WITH LIMITED OR NO ARCHITECTURAL WORK REQUIRED IN THIS AREA. REFER TO CIVIL, MEPT AND STRUCTURAL DRAWINGS FOR ANY ADDITIONAL WORK IN AREA.
- CEILING:**
- [Grid with dots] EXISTING ACOUSTIC LAY-IN CEILING TILE TO BE DEMOLISHED
- [Grid with dots] EXISTING ACOUSTIC LAY-IN CEILING TILE TO REMAIN
- [Cross-hatched box] CAREFULLY REMOVE, PROTECT AND STORE EXISTING CEILING TILES FOR RELOCATION TO NEW AREAS. PROTECT EXISTING GRID IN PLACE AND PREPARE TO RECEIVE NEW TILES. REFER TO RCPs FOR MORE INFORMATION

REFLECTED CEILING PLAN NOTES

- All new ceiling heights shall be 9'-0" A.F.F. unless noted otherwise.
- Where new ceilings are connected to existing ceilings, match existing ceiling height unless noted otherwise.
- Refer to A' 6.22 for Typical Gypsum Board Ceiling Control Joint Detail.
- Provide vented reveals at perimeter of all non-insulated exterior plaster soffits. Provide venting strips or perforated panels at perimeter of all non-insulated metal panel soffits (refer to Detail _J6_). Venting at non-insulated soffits shall be provided whether specifically indicated on the drawings or not.
- Provide partition to deck (PTD) at walls surrounding spaces with exposed structure. Refer to Reflected Ceiling Plan Legend for PTD requirements.
- Provide hold-down clips for all acoustic lay-in ceiling panels at vestibules, at sloped ceilings, at fire-rated ceilings, and within 6 feet of exterior doors without vestibules.
- At ceiling turning details, the suspended assemblies, bracing, blocking, etc. shown on the details are for schematic representation only. Provide stable, secure and permanent assemblies at these locations in accordance with recommended light-gage steel framing installation practices.
- At partitions that do not extend to deck above, extend partition 4" minimum above highest adjacent ceiling and brace per Floor Plan Legend and Floor Plan Notes.
- Contractor shall locate new ceiling grid according to the architectural reflected ceiling plans. Contractor shall locate equipment locations shown on consultant drawings accordingly.
- Contractor to locate new equipment centered in ceiling tiles. Notify Architect of any discrepancies.

REFLECTED CEILING PLAN LEGEND

- [Cross-hatched box] EXISTING TO REMAIN WITH LIMITED OR NO ARCHITECTURAL WORK REQUIRED IN THIS AREA. REFER TO CIVIL, MEPT AND STRUCTURAL DRAWINGS FOR ANY ADDITIONAL WORK IN AREA.
- CEILING:**
- [Grid with dots] EXISTING ACOUSTIC LAY-IN CEILING TILE TO REMAIN
- [Grid with dots] ACT-01 ACOUSTIC LAY-IN CEILING TILE 24" X 24"
- [Grid with dots] ACT-02 EXISTING GRID TO REMAIN, NEW ACOUSTIC LAY-IN CEILING TILE, HIGH NRC 24" X 24"
- [Grid with dots] ACT-03 ACOUSTIC LAY-IN CEILING TILE, HIGH NRC 24" X 24"
- [Grid with dots] EXISTING GYPSUM BOARD CEILING TO REMAIN
- [Grid with dots] PT-01 5/8" GYPSUM BOARD CEILING PAINTED PT-01, U.N.O.
- [Box with X] AP PYRAMID CEILING DIFFUSER PANELS (SIZE)
- [Box with lines] LIGHT FIXTURES. Refer to Electrical Drawings.
- [Box with lines] SUPPLY AND RETURN GRILLES. Shown for location purposes only. Refer to Mechanical Drawings.
- [Box with P-C] CEILING MOUNTED PROJECTOR
- [Box with M-C] CEILING MOUNTED MONITOR

PARTITION LEGEND

- 1HR 1-HOUR FIRE BARRIER PARTITION. Extend partition to deck above and seal with firestopping sealant as required for fire-resistance requirements. Paint stenciled label on partitions above ceiling at 15'-0" o.c. as follows: "1-HOUR FIRE AND SMOKE BARRIER - PROTECT ALL OPENINGS". Brace partitions per Floor Plan General Notes.
- 2HR 2-HOUR FIRE BARRIER PARTITION. Extend partition to deck above and seal with firestopping sealant as required for fire-resistance requirements. Paint stenciled label on partitions above ceiling at 15'-0" o.c. as follows: "2-HOUR FIRE AND SMOKE BARRIER - PROTECT ALL OPENINGS". Brace partitions per Floor Plan General Notes.
- SMK SMOKE PARTITION. Extend partition to deck above and seal with sealant as required to resist the passage of smoke. Seal all joints and penetrations. Brace partitions per Floor Plan General Notes.
- SND ACOUSTICAL DRYWALL PARTITION / SOUND-CONDITIONED CMU PARTITION. Extend partition to deck above and seal with acoustical sealant. Seal all joints and penetrations with acoustical sealant. Brace partitions per Floor Plan General Notes.
- PTD NON-RATED PARTITION TO DECK. Extend partition to deck above. Brace partitions per Floor Plan General Notes.



03/06/2025

ISSUED: February 24, 2025

REVISIONS

Revision No.	Revision Date
1 Addendum 1	03-06-2025

Director
RSJ
Designer

Drawn By
STH, KM
Quality Control

Proj. Arch.
TQ

PROJECT NO.

24-010.00


SHEET TITLE

COOK - ENLARGED REFLECTED CEILING PLANS


SHEET NO.

A16.20


DOOR NUMBER	DOOR TYPE	FRAME TYPE	DOOR OPENING WIDTH	DOOR OPENING HEIGHT	FIRE RATING	HDWR SET	REMARKS
1	X-SF1		6'-0"	8'-10"		5.0	
2	X-SF1		3'-0"	8'-10"		12.0	
3	F2		4'-0"	8'-10"		18.0	PROVIDE (2) PEEP HOLES
5	NL5		3'-0"	8'-10"		6.1	PROVIDE (2) PEEP HOLES
6	NL5		3'-0"	8'-10"		6.1	PROVIDE (2) PEEP HOLES
7	X-F2		3'-0"	8'-10"		6.1	PROVIDE (2) PEEP HOLES
8	NL5		3'-0"	8'-10"		6.1	PROVIDE (2) PEEP HOLES
9	NL5		3'-0"	8'-10"		6.1	PROVIDE (2) PEEP HOLES
11	X-FD2		6'-0"	8'-10"		6.1	
12	X-FD2		6'-0"	8'-10"		6.1	
13	X-SF1		3'-1"	8'-10"		2.1	
14	X-SF1		3'-1"	8'-10"		2.1	
15	X-SF1		6'-0"	8'-10"		2.0	
17	X-FD2		6'-0"	8'-10"		6.1	
19	X-F2		3'-0"	8'-10"		13.0	
20	NL2		3'-0"	8'-10"		18.0	PROVIDE (2) PEEP HOLES
21	X-F2		3'-0"	8'-10"		6.1	
22	X-SFD1		6'-4"	8'-10"		3.0	
25	X-SF1		3'-0"	8'-10"		2.1	
27	X-SF1		3'-0"	8'-10"		6.0	
28	X-SF1		3'-0"	8'-10"		2.1	
30	X-SF1		3'-0"	8'-10"		8.0	
100	X-NL2		3'-0"	8'-10"		10.0	
101	X-NL2		3'-0"	8'-10"		10.0	
102	X-NL2		3'-0"	8'-10"		10.0	
104	X-NL2		3'-0"	8'-10"		10.0	
106	X-NL2		3'-0"	8'-10"		10.0	
107	X-F2		3'-0"	8'-10"		13.0	
111	X-NL2		3'-0"	8'-10"		11.0	
112	X-NL2		3'-0"	8'-10"		11.0	
113	X-F2		3'-0"	8'-10"		10.0	
115.2	X-SFD1		6'-0"	8'-10"		17.0	
116	X-NL2		3'-0"	8'-10"		10.0	
117	X-NL2		3'-0"	8'-10"		10.0	
118	X-F2		3'-0"	8'-10"		13.0	
120	X-NL2		3'-0"	8'-10"		10.0	
121	X-NL2		3'-0"	8'-10"		10.0	
125	X-NL2		3'-0"	8'-10"		10.0	
126	X-NL2		3'-0"	8'-10"		10.0	
127	X-NL2		3'-0"	8'-10"		10.0	
128	X-NL2		3'-0"	8'-10"		10.0	
129	X-F2		3'-0"	8'-10"		13.0	
134	X-NL2		3'-0"	8'-10"		10.0	
135	X-NL2		3'-0"	8'-10"		11.0	
136	X-NL2		3'-0"	8'-10"		11.0	
139	X-NL2		3'-0"	8'-10"		10.0	
141	X-F2		3'-0"	8'-10"		10.0	
142	X-NL2		3'-0"	8'-10"		10.0	
143	X-F2		3'-0"	8'-10"		10.0	
144	X-F2		3'-0"	8'-10"		10.0	
205	X-NL2		3'-0"	8'-10"		11.0	
245	X-NL2		3'-0"	8'-10"		10.0	
252	X-NL2		3'-0"	8'-10"		10.0	
253	X-NL2		3'-0"	8'-10"		10.0	
316.1	NL2		3'-0"	8'-10"		13.1	SIGN TYPE B
316.2	NL2		3'-0"	8'-10"		13.0	SIGN TYPE B
317	NL2		3'-0"	6'-10"		18.0	SIGN TYPE B
318	NL2		3'-0"	6'-10"		18.0	SIGN TYPE B
400	X-SF1		3'-0"	8'-10"		-	
400.1	X-SF1		3'-0"	8'-10"		-	
400.2	X-SF1		3'-0"	8'-10"		-	
403	X-F2		3'-0"	8'-10"		13.0	
404	X-F2		3'-0"	8'-10"		13.0	
411	X-NL2		3'-0"	8'-10"		13.0	
411.1	X-NL2		3'-0"	8'-10"		13.0	
422	X-F2		3'-0"	8'-10"		14.0	
425	X-F2		3'-0"	8'-10"		13.0	
531	NL3		3'-0"	8'-10"		19.0	SIGN TYPE B
532	NL3		3'-0"	8'-10"		19.0	SIGN TYPE B
533	NL3		4'-0"	8'-10"		18.0	SIGN TYPE B
534	FB2		6'-0"	8'-10"		26.0	SIGN TYPE A
612	X-F2		3'-0"	8'-10"		-	
614	X-FD2		6'-0"	8'-10"		15.0	
623.1	X-F2		3'-0"	8'-10"		13.1	
640	BRT		10'-0"	8'-10"		-	MOTORIZED

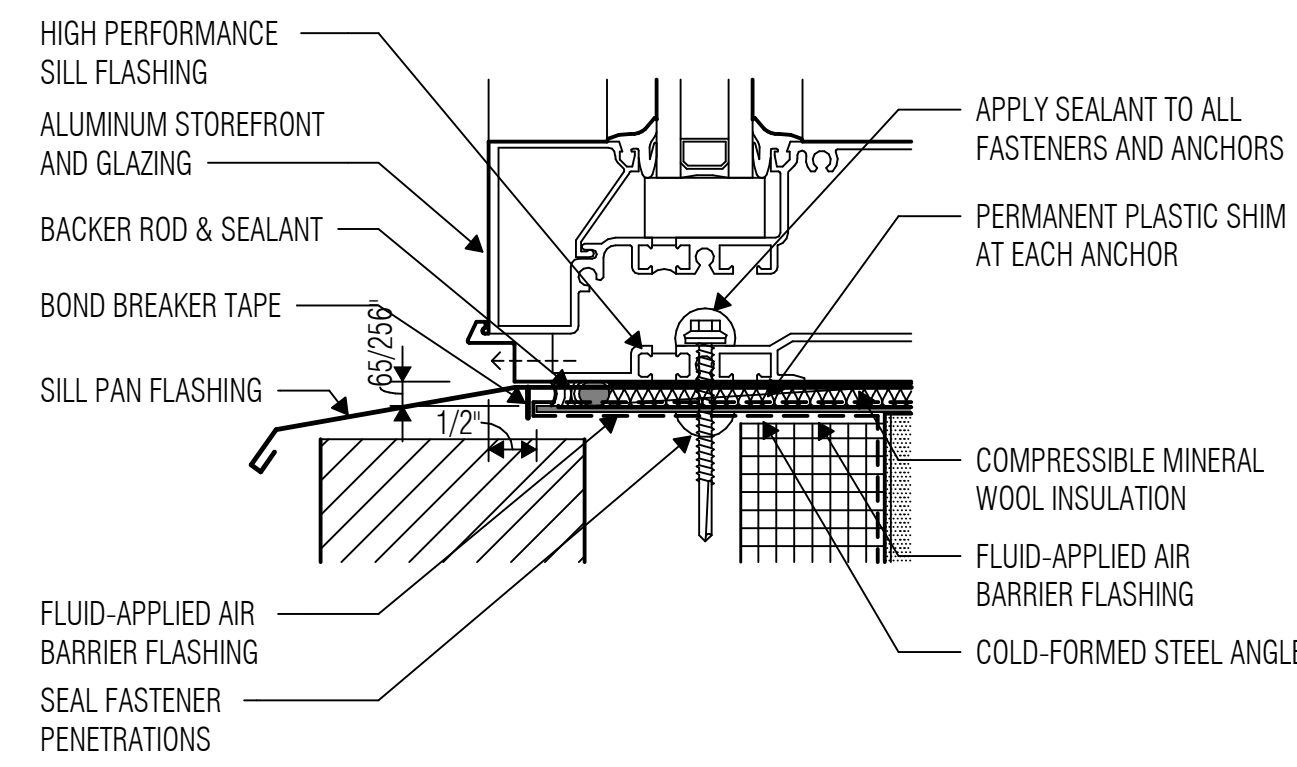


1 DETAIL AT STOREFRONT SILL FLASHING
SCALE: 6" = 1'-0"

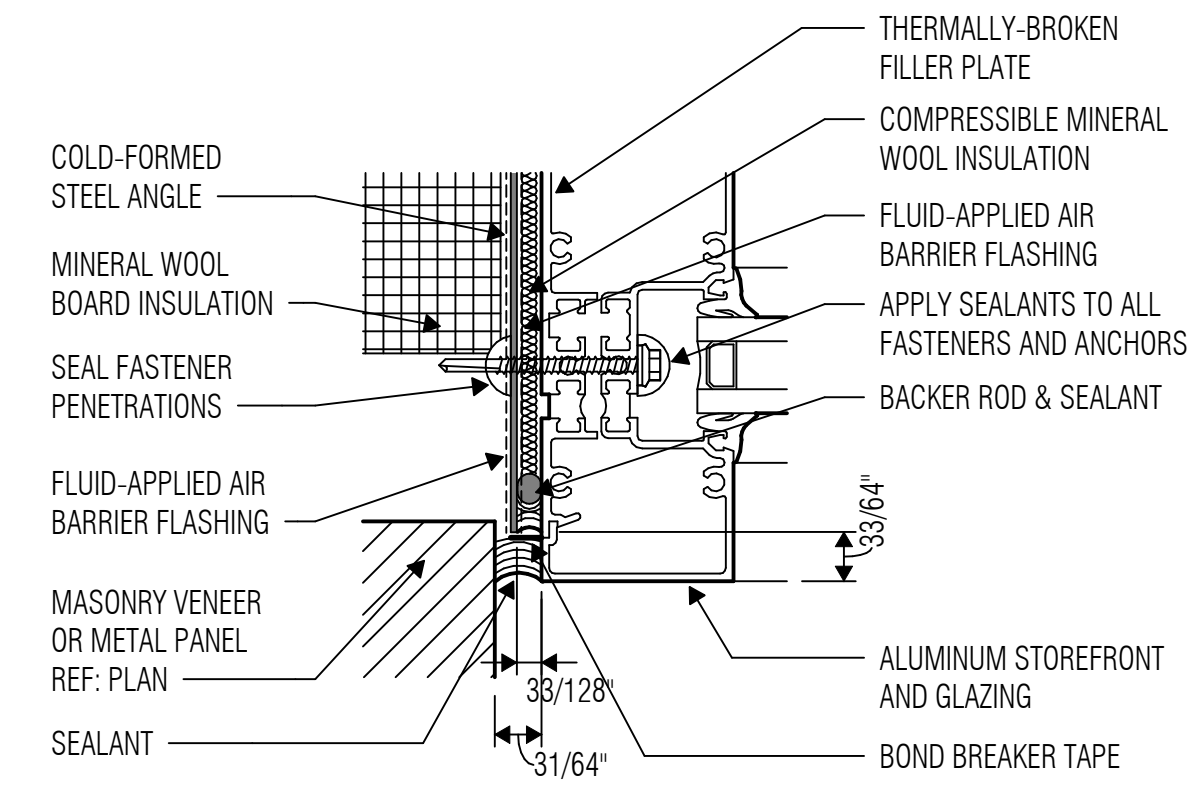


2 DETAIL AT STOREFRONT JAMB FLASHING
SCALE: 6" = 1'-0"

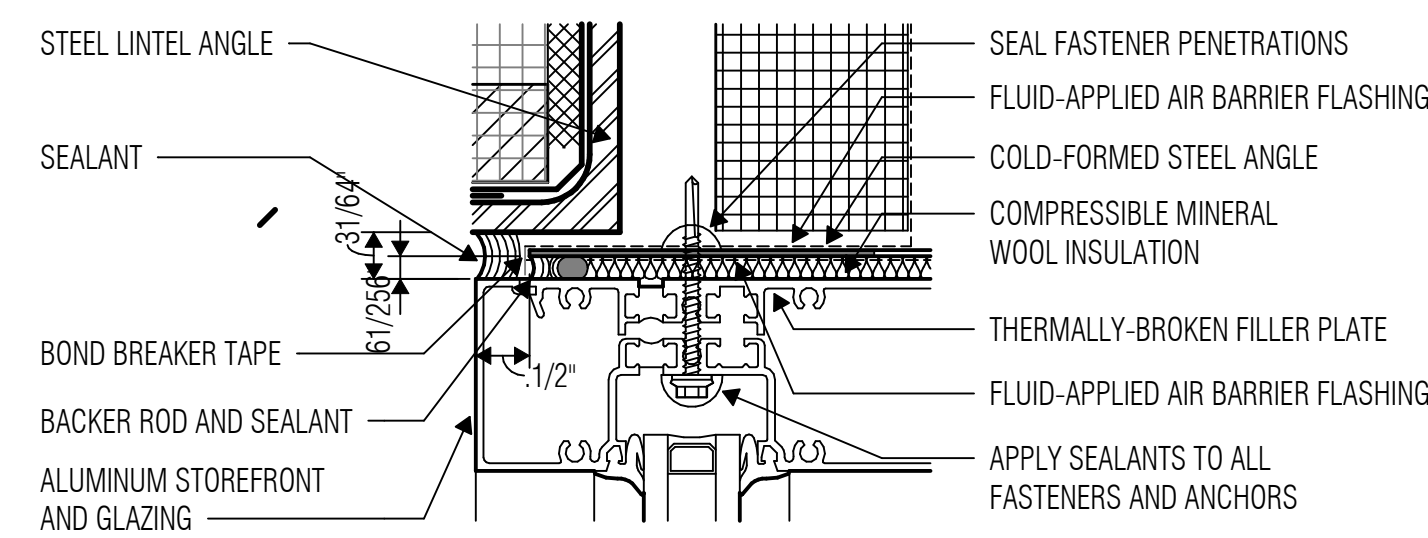

3 DETAIL AT STOREFRONT HEAD FLASHING
SCALE: 6" = 1'-0"

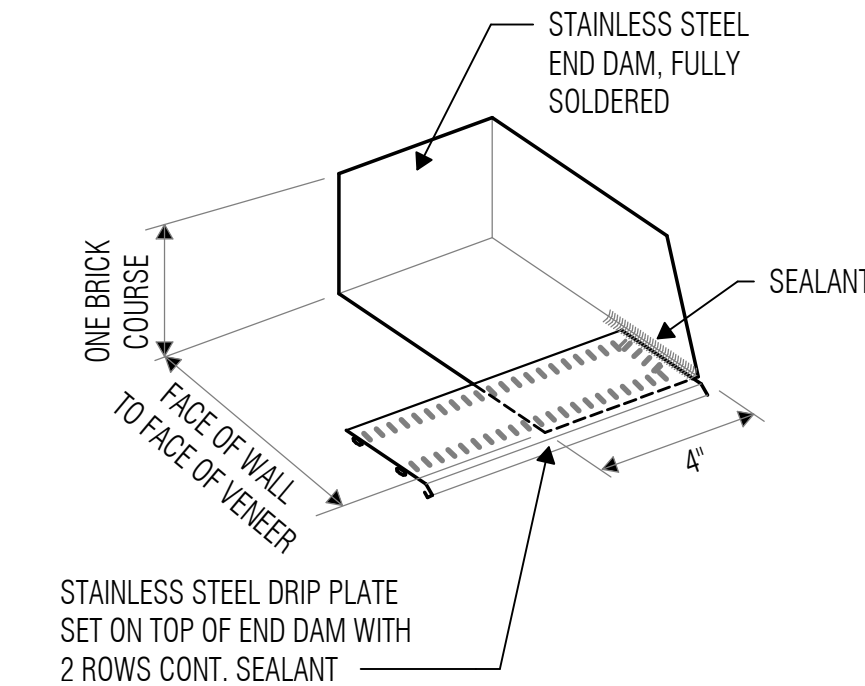

4 S.S. END DAM AT DOOR & WINDOW JAMBS
SCALE: 3" = 1'-0"

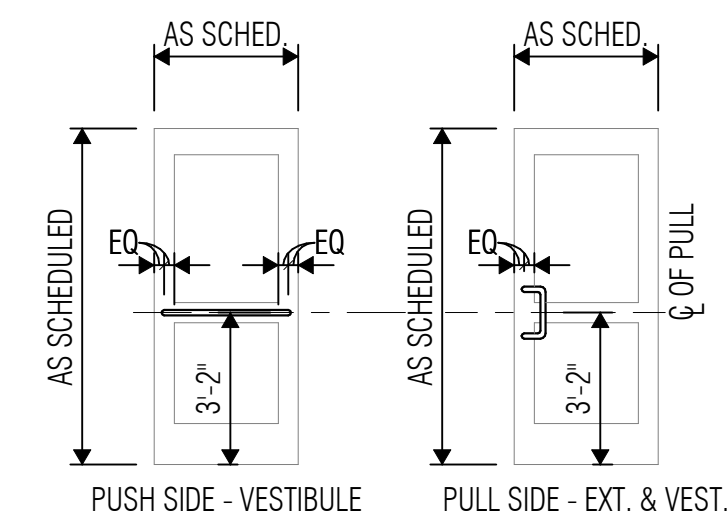


PUSH/PULL HEIGHTS
SCALE: 1/4" = 1'-0"

DOOR SCHEDULE NOTES

- At Doors marked "SMK", provide smoke seals at frame and door bottom to resist the passage of smoke. Provide threshold if required by code or if necessary for proper function of door bottom seal.
- At Doors marked "SND", provide sound seals at frame and door bottom.
- At Doors without a Frame Type designation, the door frame is part of a Glazing System.
- At Doors with a Frame Type designation "AL", the door frame is an interior aluminum frame that is not part of a glazing system.
- At Doors with a Frame Type designation "N/A", there is no door frame required (e.g. all-glass doors, gates, etc.).
- At Doors with a Frame Type designation "REF DET", refer to the referenced Head and Jamb detail for frame information.
- At Doors with a Door Type or Frame Type designation "EX", the door or door frame is existing to remain.
- Refer to Hardware Schedule for additional information regarding hardware.
- Vision panels at non-rated interior doors shall be 1/4" clear tempered glass (CT4) U.N.O. Vision panels at interior fire-rated glass (CC4) U.N.O. Vision panels at exterior doors shall be 1" tinted tempered insulating glass (TT1) U.N.O.
- Refer to Glazing System Elevation Sheets for Glass Types.

DOOR SCHEDULE KEYED NOTES


- CASED OPENING
- DOUBLE EGRESS DOORS
- FIRE-RATED WIRED GLASS
- FIRE-RATED CERAMIC GLASS
- KEYED REMOVABLE MULLION
- ELECTROMAGNETIC HOLD-OPEN
- MANUAL HOLD-OPEN, FLOOR MOUNTED
- MANUAL HOLD-OPEN, OVERHEAD
- ACCESS CONTROL / CARD READER
- DOOR POSITION SWITCH
- APPLIED SOUND SEALS & THRESHOLD

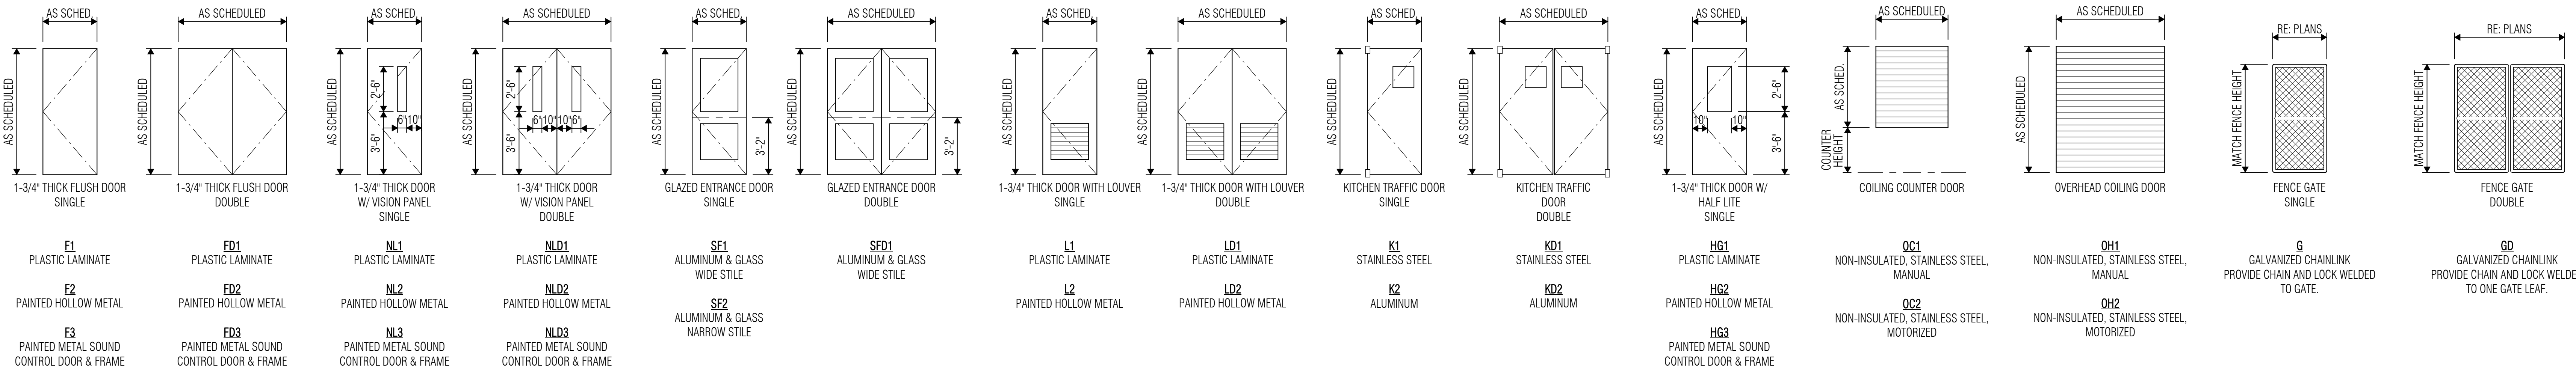

NOTE: "X" PREFIX INDICATES AN EXISTING DOOR OR FRAME TO REMAIN.

ARCHITECT

VLK Architects
20445 State Hwy 249, Suite 350
Houston, Texas 77070
Main Phone: 281.671.2300
www.vlkarchitects.com

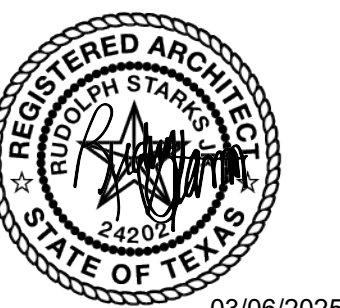

03/06/2025

ISSUED: February 24, 2025

REVISIONS

Revision No.	Revision Date
1 Addendum 1	03-06-2025

Director: RSJ
Designer: TQ
Drawn By: STH, KM
Quality Control: QC

PROJECT NO.





24-010.00

SHEET TITLE

COOK - DOOR TYPES, SCHEDULES, ELEVATIONS & DETAILS

SHEET NO.

A17.01

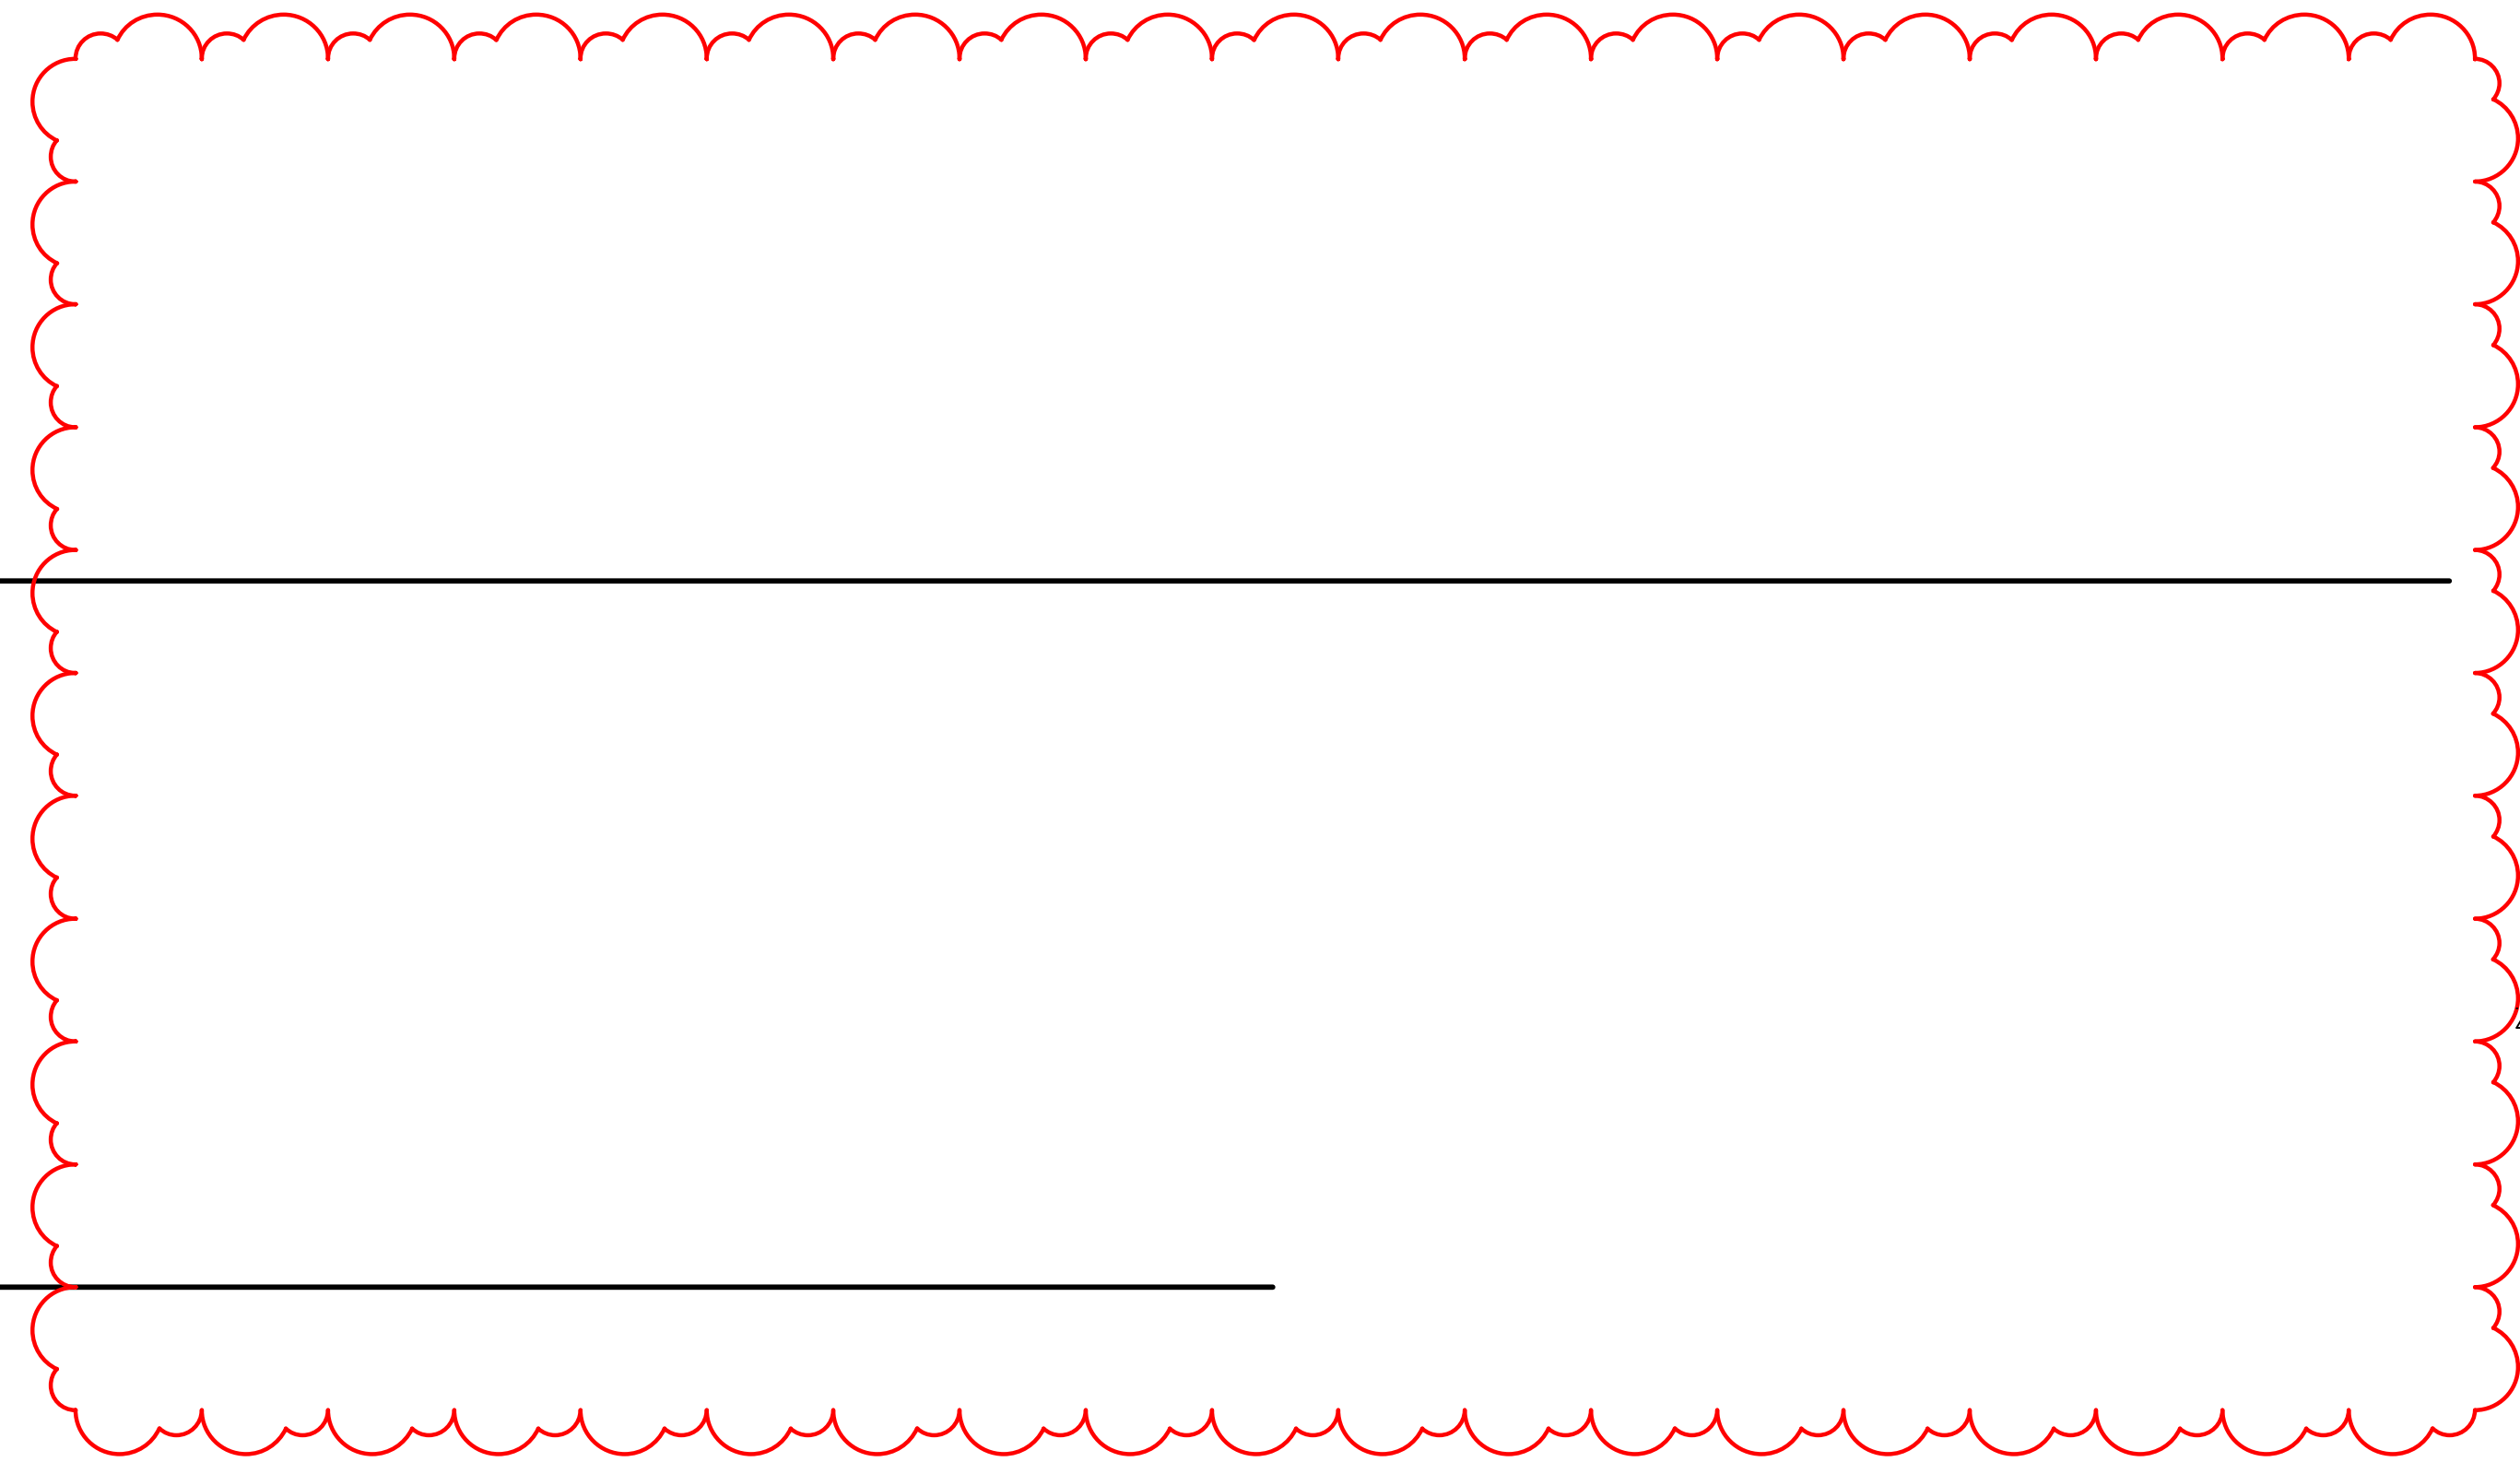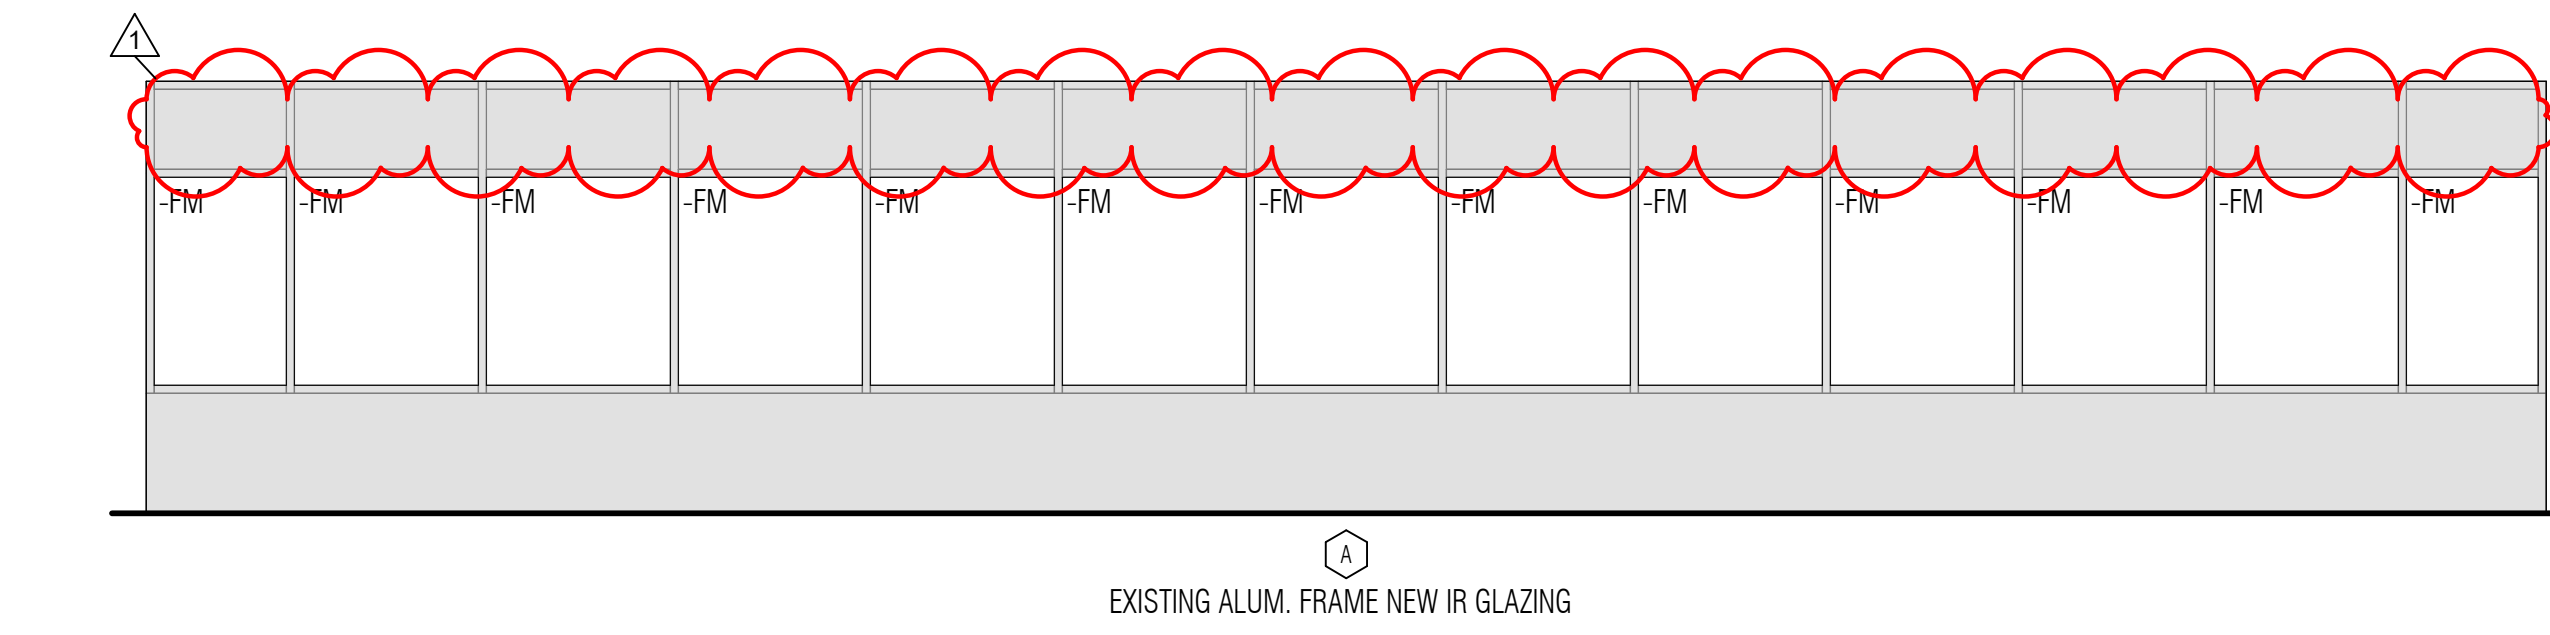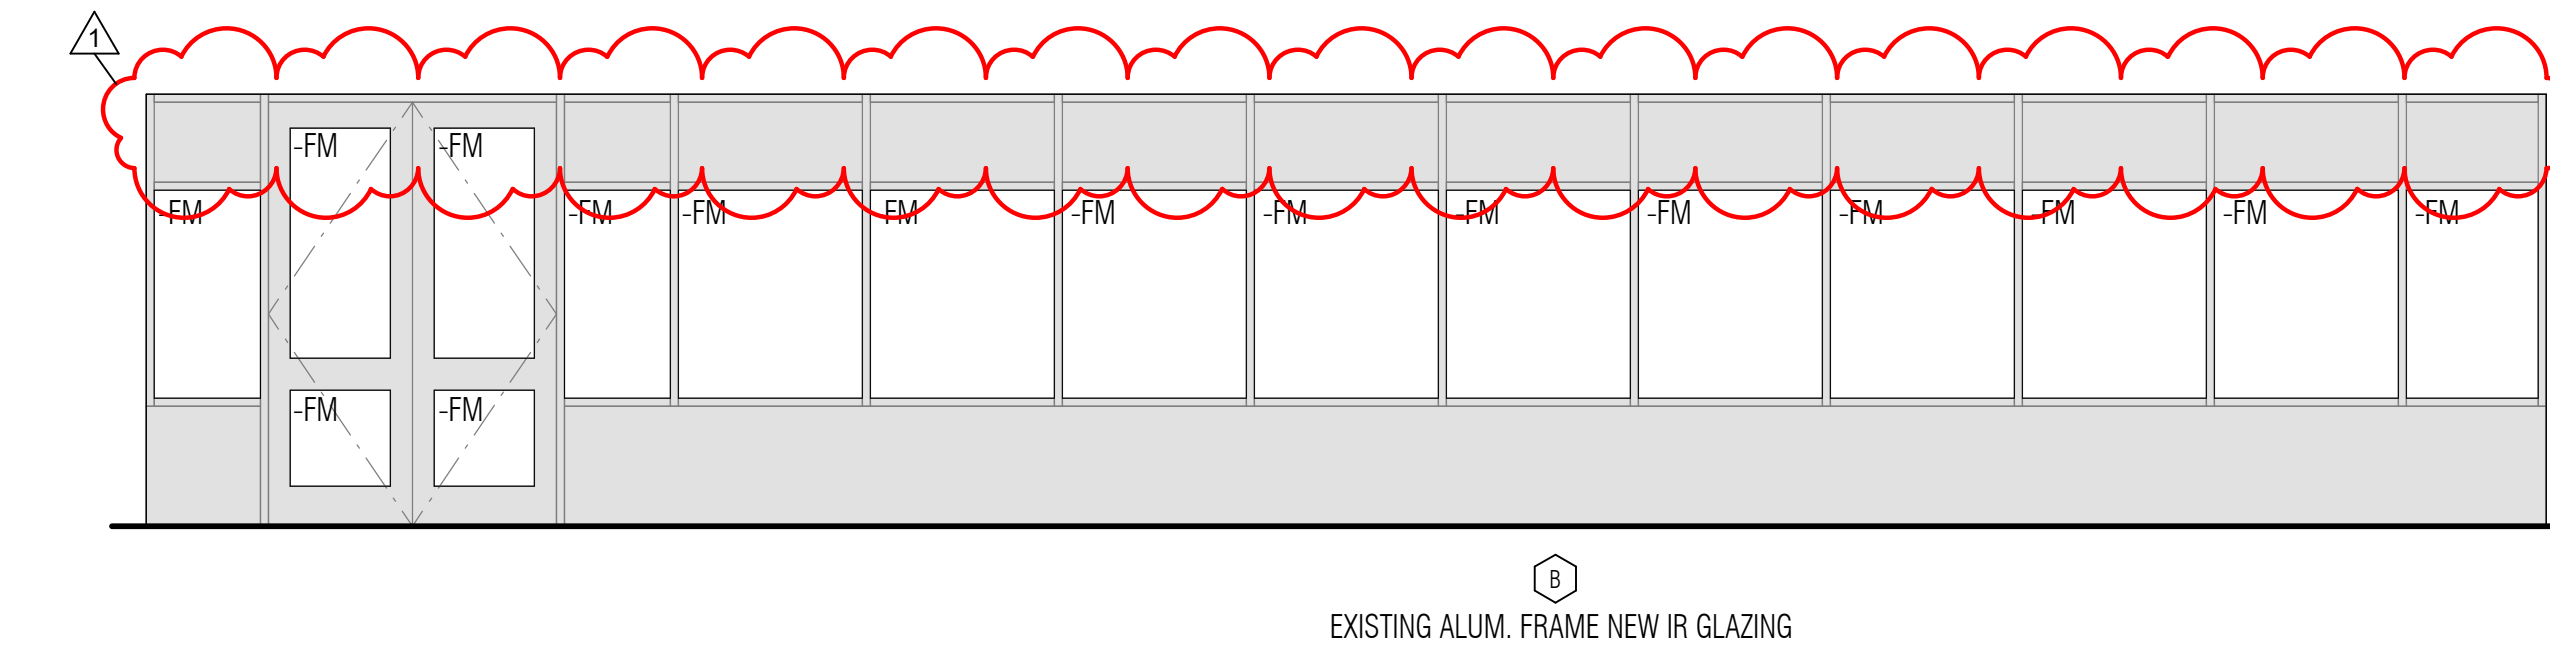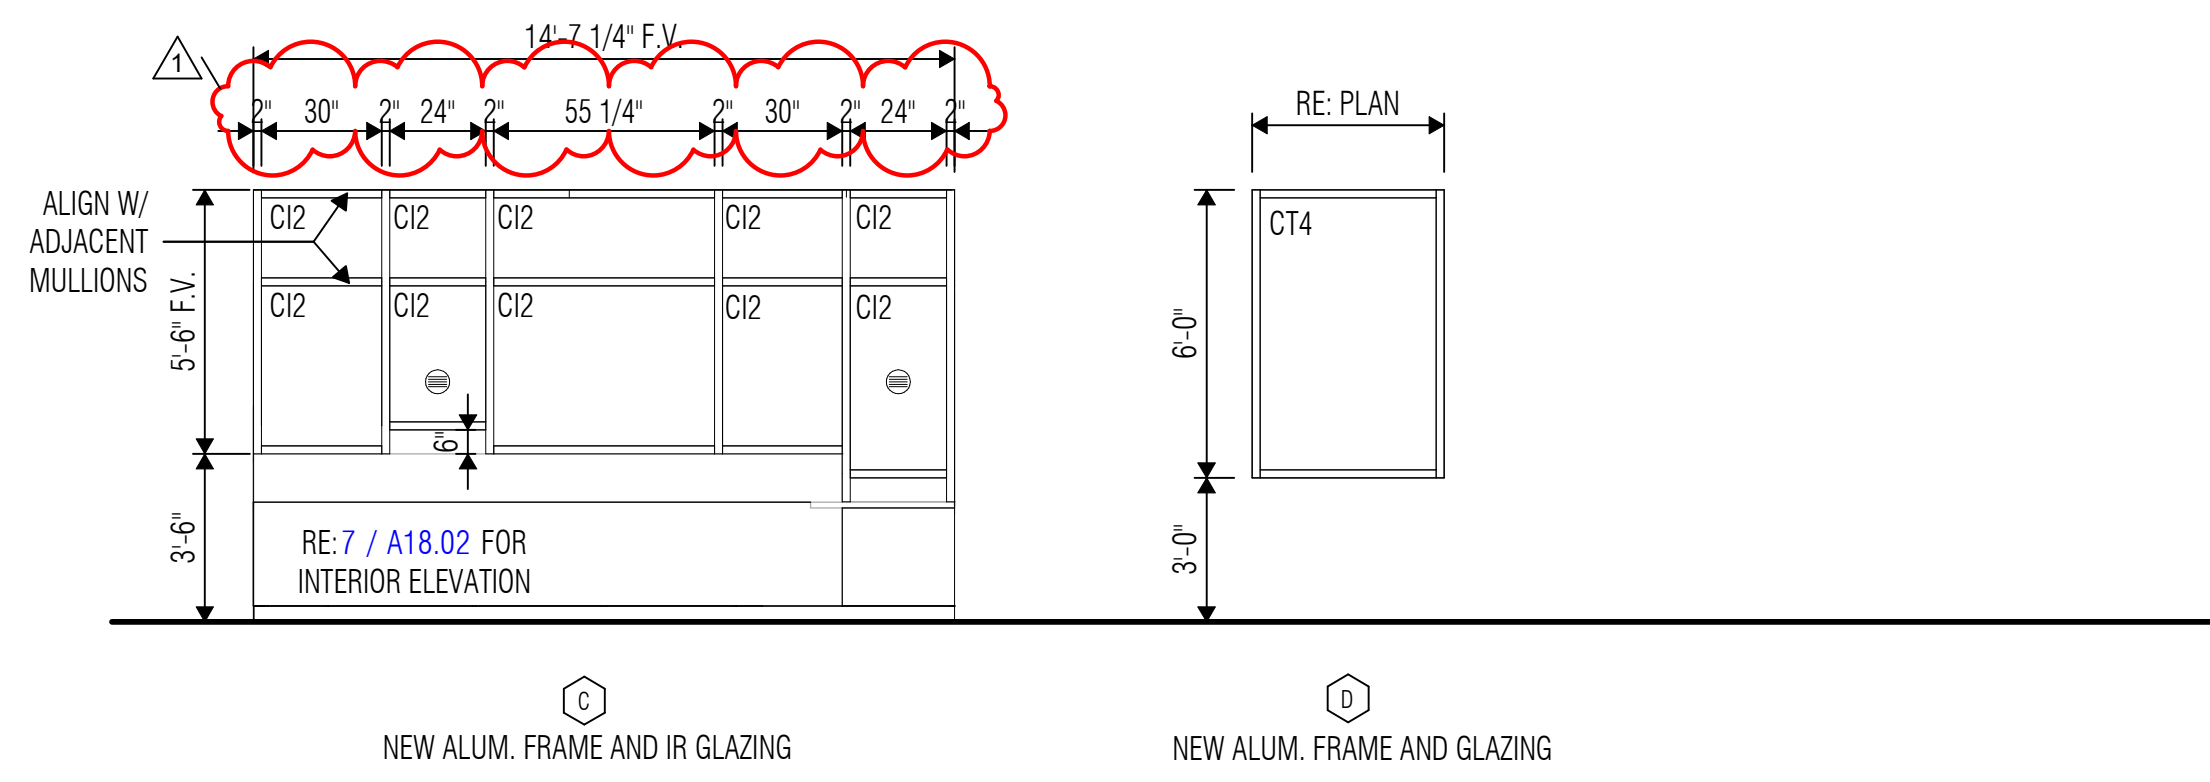

GLAZING SYSTEM NOTES

- Overall dimensions of glazing system elevations reflect rough opening dimensions, inclusive of perimeter joints.
- Provide 3/16" thick heavy wall framing members at all door frames in exterior and interior aluminum Storefront systems.
- Provide 3/16" thick heavy wall door adapters at all door frame members in exterior and interior aluminum Curtain Wall systems.
- Door opening dimensions in Curtain Wall systems reflect 1" door adapters at jamb conditions, and 1-3/4" door adapters at head conditions. Adjust dimensions between mullions at door openings in curtain wall systems as required for actual size of door adapters provided. Door sizes as identified in Door Schedule shall be maintained.
- Refer to A'17.01 for Typical Push/Pull Mounting Heights Detail for aluminum/glass doors

GLASS TYPE LEGEND

- CT4 CLEAR, TEMPERED, 1/4" THICK GLASS
 - CI2 CLEAR, IMPACT-RESISTANT, 9/16" THICK LAMINATED GLASS
 - FM 23 MIL IMPACT RESISTANT FILM OVERLAY, FIELD-APPLIED TO GLAZING UP TO 7'-0" A.F.F.
 - IF A PORTION OF THE GLAZING UNIT IS ABOVE 7'-0", APPLY FILM TO THE ENTIRE GLAZING UP TO MULLION.
 - DO NOT SPLICE FILM ON INTERIOR OR EXTERIOR GLAZING UNITS.
- GLAZING SHOWN WITH GREY HATCH IS EXISTING TO REMAIN

GLAZING SYSTEM LEGEND

- STOREFRONT FRAMING WITH 3/16" THICK HEAVY WALL MATERIAL, TYPICAL AT ALL DOOR FRAME MEMBERS IN STOREFRONT GLAZING SYSTEMS.
- CURTAIN WALL FRAMING WITH STEEL REINFORCING PROVIDED BY MANUFACTURER.



ARCHITECT

VLK Architects
 20445 State Hwy 249, Suite 350
 Houston, Texas 77070
 Main Phone: 281.671.2300
 www.vlkarchitects.com

CYPRESS-FAIRBANKS INDEPENDENT SCHOOL DISTRICT HOUSTON, TEXAS



03/06/2025

ISSUED: February 24, 2025

REVISIONS

Revision No.	Revision Date
1 Addendum 1	03-06-2025

Director
RSJ
Designer

Drawn By
STH, KM
Quality Control

Proj. Arch.
TQ

PROJECT NO.

24-010.00


SHEET TITLE

COOK - GLAZING
ASSEMBLY TYPES,
SCHEDULES, ELEVATIONS
& DETAILS


SHEET NO.

A17.11


2024 Cook, Labay & Truitt MS Renovations

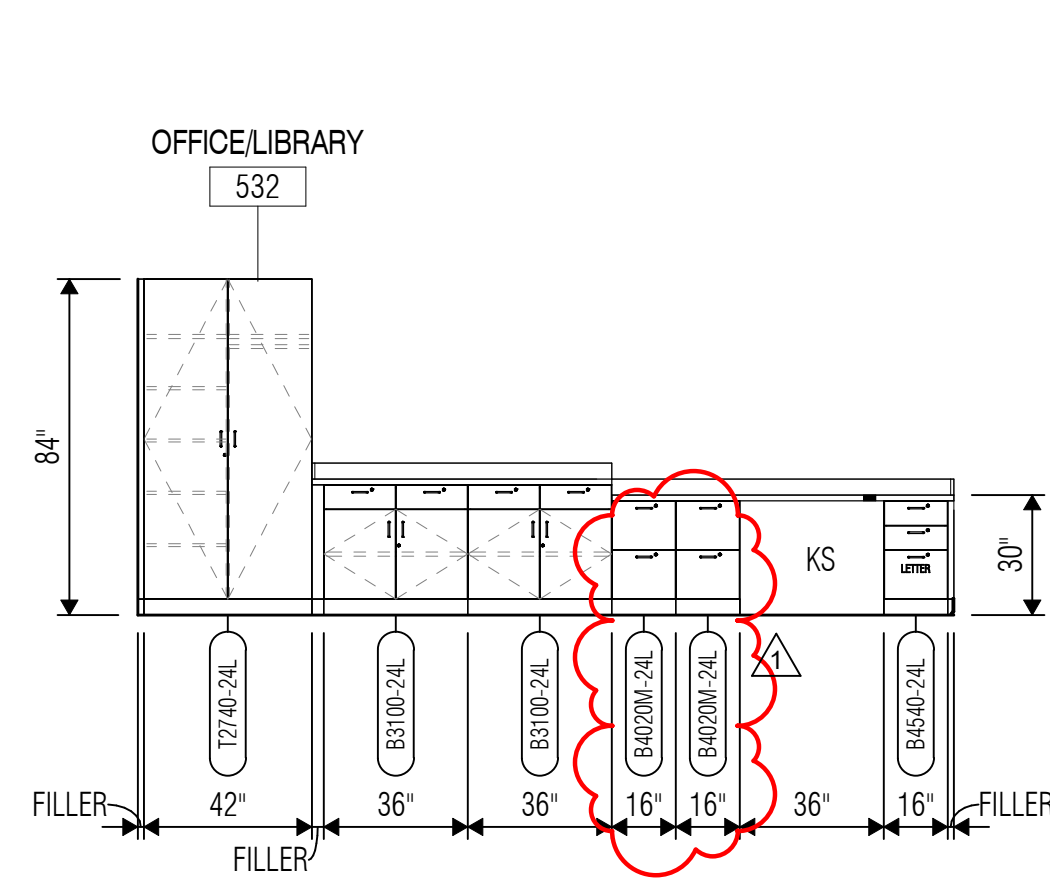


1 CASEWORK ELEVATION
SCALE: 1/4" = 1'-0"

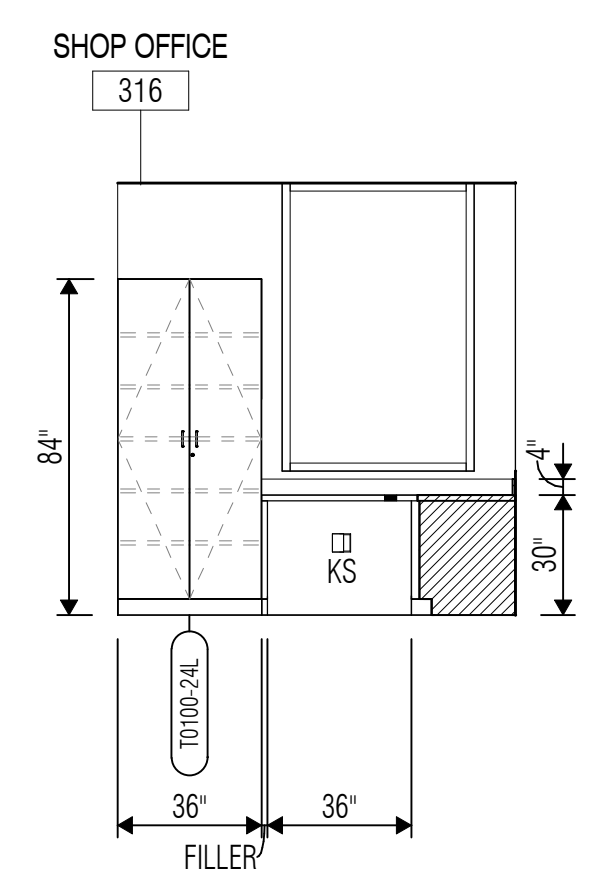


2 CASEWORK ELEVATION
SCALE: 1/4" = 1'-0"

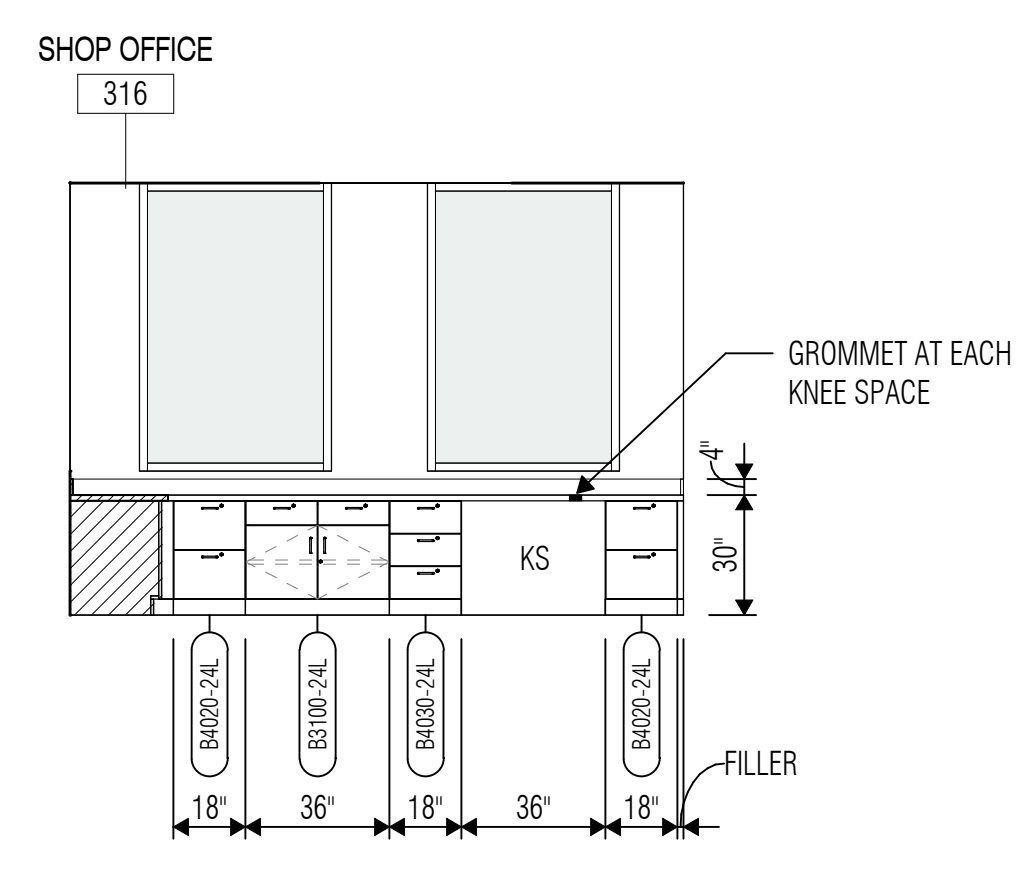

3 CASEWORK ELEVATION
SCALE: 1/4" = 1'-0"

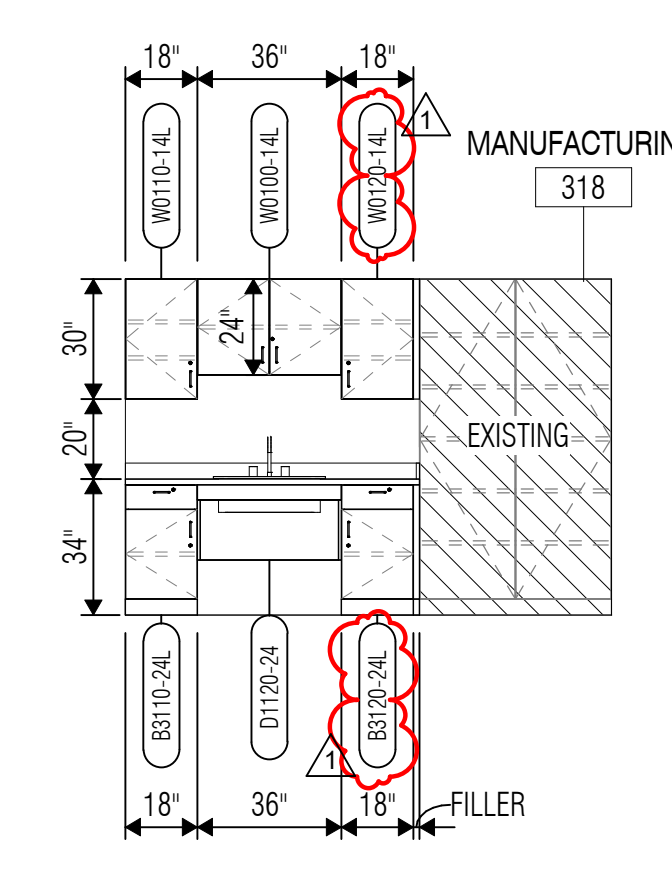

4 CASEWORK ELEVATION
SCALE: 1/4" = 1'-0"

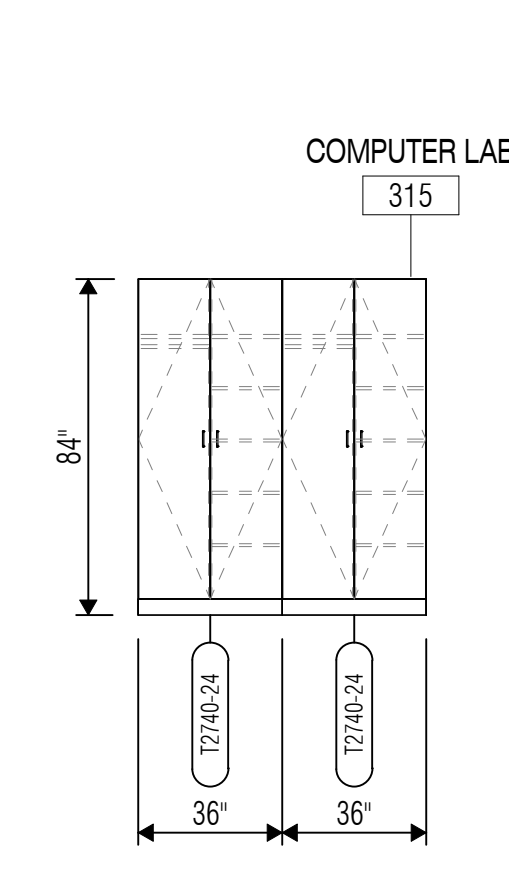

5 CASEWORK ELEVATION
SCALE: 1/4" = 1'-0"

CASEWORK NOTES

- Casework shall meet criteria set forth in Americans with Disabilities Act and Texas Accessibility Standards.
- All casework model numbers are based on Case Systems, Inc. Refer to casework elevations for height and width of each unit.
- Coordinate locations of electrical and/or plumbing within casework and millwork. Notify Architect of any conflicts prior to installation.
- Coordinate all column locations prior to installation of casework.
- Refer to Floor Plan Notes for blocking requirements at stud partitions.
- All adjustable shelves longer than 2'-3", and shelves of any length at open shelving units, shall be 1" thick.
- Provide finished surface on all exposed surfaces.
- Plastic Laminate on all casework shall be PL - U.N.O.
- Provide fillers and finished end panels (F.E.) as required. Refer to Typical Casework Details for filler requirements.
- Provide locks on all doors and drawers as indicated.
- All counters shall have 4" high splashes, U.N.O.
- At countertop locations, no joints in plastic laminate should occur over knee spaces, or within 24 inches of sinks and lavatories.
- Casework cabinet doors and drawers shall be flush overlay.
- Base cabinets should not extend to floor. Sub-base shall be separate and recessed 1/2" at sides of cabinet to receive rubber base.
- Provide 1-1/2" thick divider panel between knee spaces and adjacent spaces (e.g. dishwasher openings, other knee spaces, etc.).
- At front of casework, countertops shall extend 1/2" over base cabinet door/drawer (approximately 1-1/2" over base cabinet body). At ends of casework, countertops shall extend 1/2" over base cabinet body. Refer to Typical Casework Details.
- Provide custom height at all file-size drawers to be a minimum of 1'-0" deep. Provide locks at all file-size drawers.

C.S.I. CATALOG CASEWORK NUMBER: XXXXXX-2423

M = MODIFIED FROM STANDARD CATALOG SELECTION

NOTE:
1. The height indicated at base cabinets includes the countertop.

VLK ARCHITECTS
20445 State Hwy 249, Suite 350
Houston, Texas 77070
Main Phone: 281.671.2300
www.vlkarchitects.com


ARCHITECT
CYPRESS-FAIRBANKS INDEPENDENT SCHOOL DISTRICT
HOUSTON, TEXAS




ISSUED: February 24, 2025
REVISIONS
Revision No. 1 Addendum 1
Revision Date 03-06-2025

Director: RSJ
Designer: TQ
Drawn By: STH, KM
Quality Control: STH, KM
PROJECT NO.: 24-010.00
SHEET TITLE: COOK - CASEWORK ELEVATIONS & DETAILS
SHEET NO.:


A18.01
COPYRIGHT © 2025 VLK ARCHITECTS

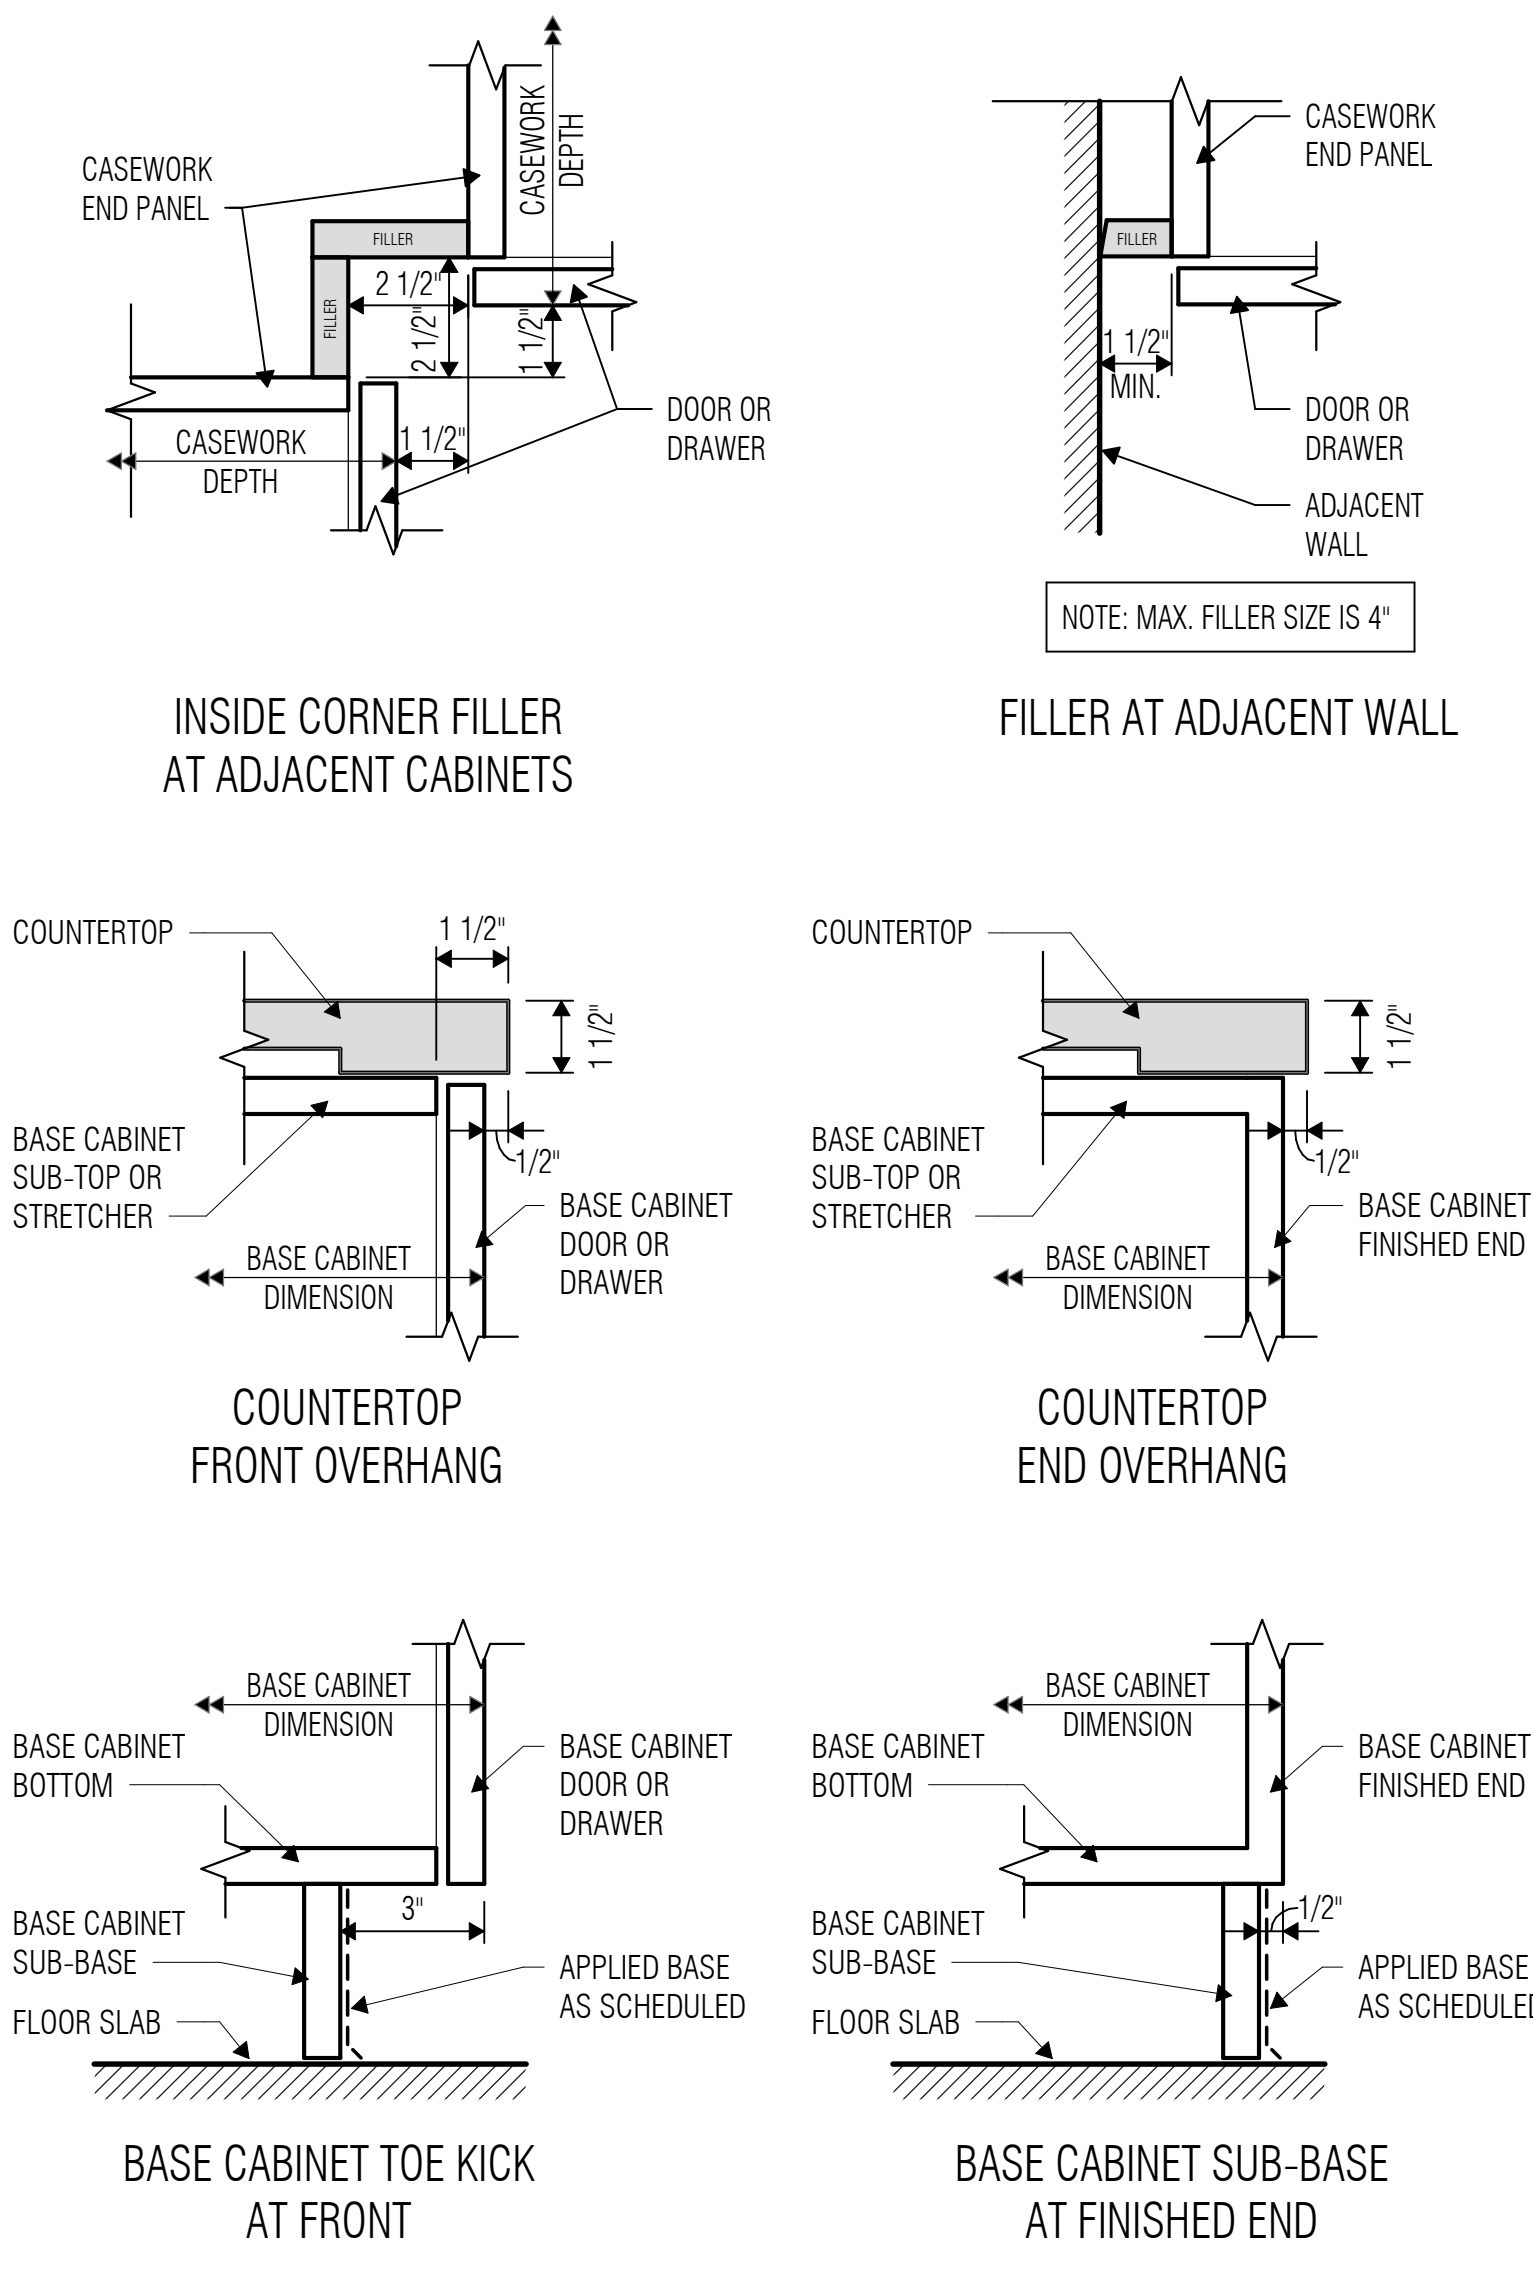

TYPICAL CASEWORK DETAILS
SCALE: 3" = 1'-0"

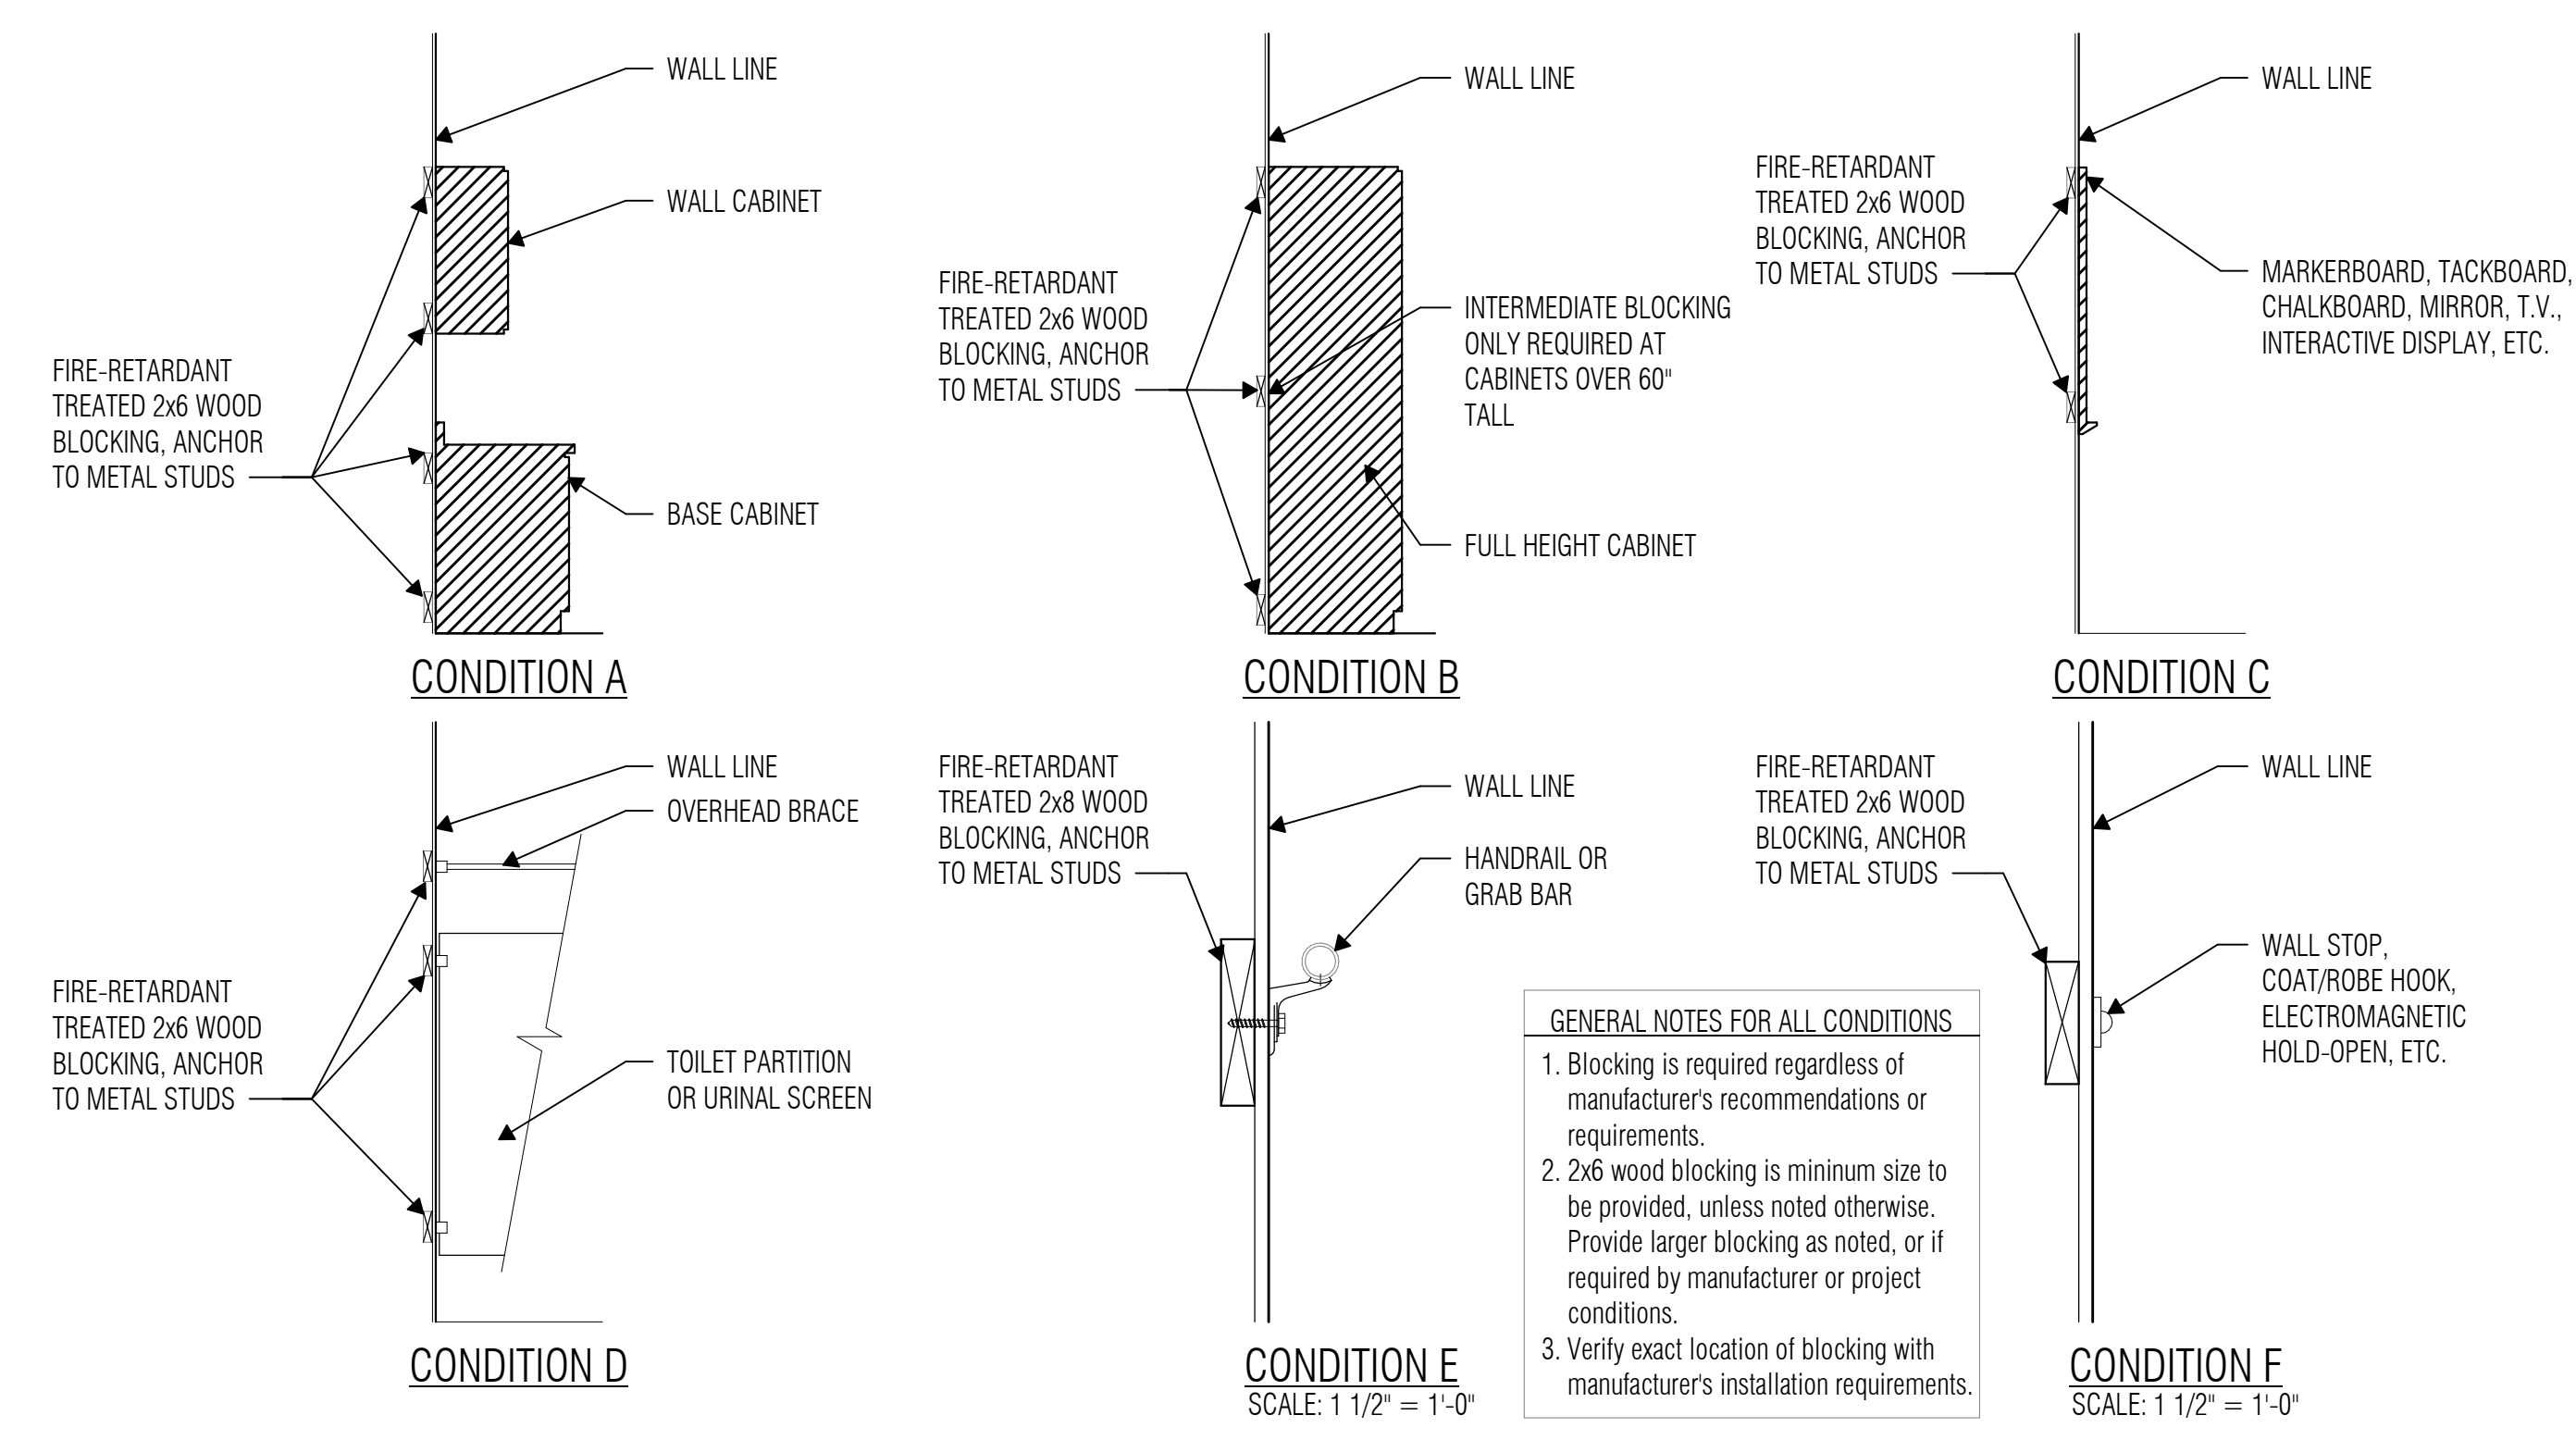

TYPICAL WOOD BLOCKING DETAILS
SCALE: 3/8" = 1'-0"

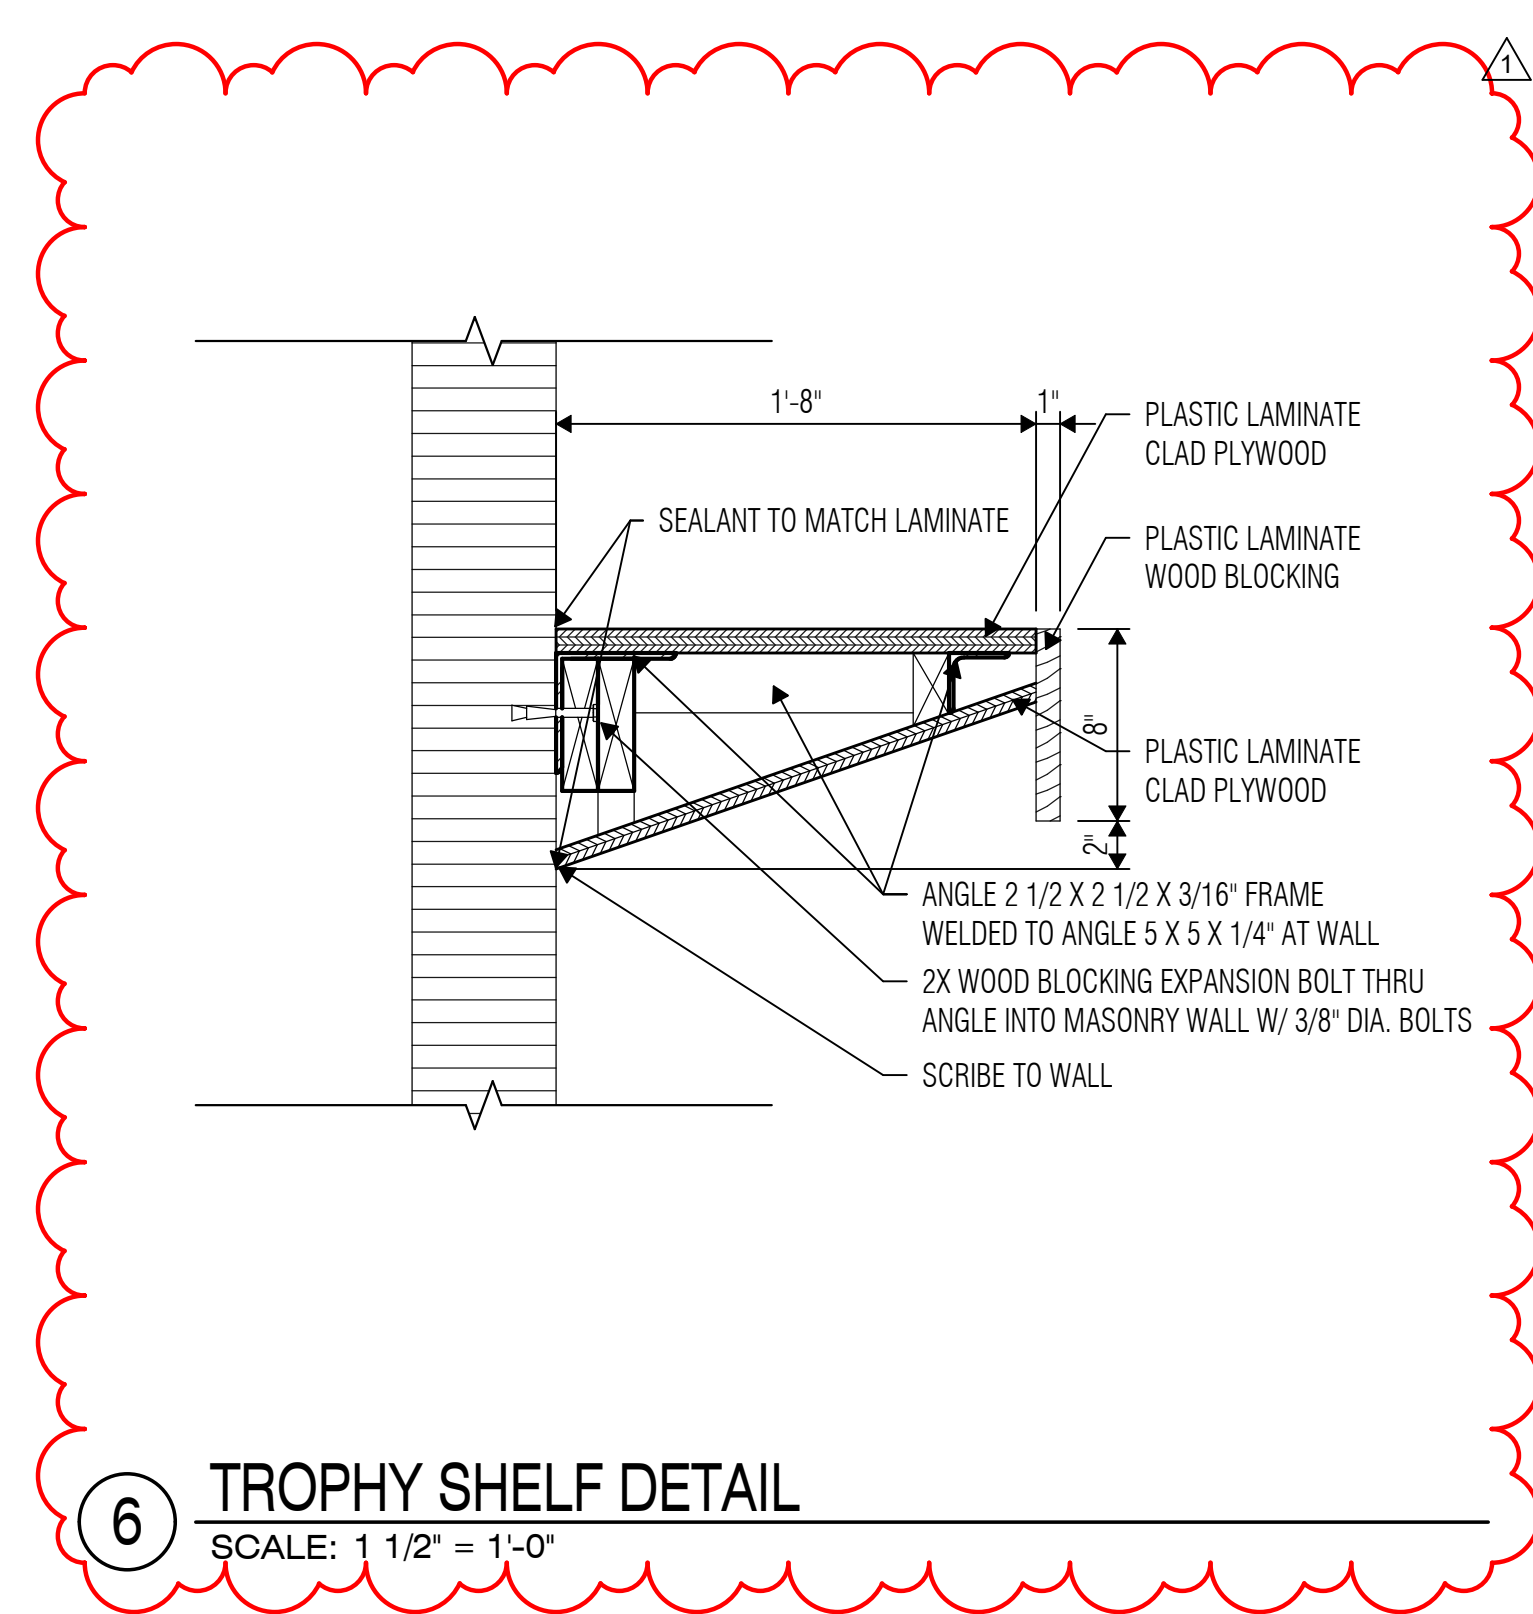

6 TROPHY SHELF DETAIL
SCALE: 1 1/2" = 1'-0"

2024 Cook, Labay & Truitt MS Renovations

ROOM FINISH SCHEDULE

LEVEL	ROOM NUMBER	ROOM NAME	FLOOR	BASE	WALL	COMMENTS
Not Placed						
COOK - UNIT D.2						
Not Placed	491	VESTIBULE	TZ-01/CO-01	BC	PT	COOK
LEVEL ONE						
COOK - UNIT A						
LEVEL ONE	532	OFFICE/LIBRARY	CPT	BC	PT	COOK
LEVEL ONE	531	PRACTICE	CPT	BC	PT	COOK
LEVEL ONE	533	ENSEMBLE	CPT	BC	PT	COOK
LEVEL ONE	533A	INSTRUMENT STORAGE	RF	BC	PT	COOK
LEVEL ONE	530	ORCHESTRA	CPT	BC	PT	COOK
LEVEL ONE	534	MECHANICAL	CO	BC	PT	COOK
COOK - UNIT C						
LEVEL ONE	400A	ENTRY VESTIBULE	EXST	EXST	EXST	COOK
LEVEL ONE	400	CHECK-IN	EXST	EXST	EXST	COOK
COOK - UNIT D.2						
LEVEL ONE	318	MANUFACTURING	EXST	BC	PT	COOK
LEVEL ONE	317	ENGINEERING	EXST	BC	PT	COOK
LEVEL ONE	315	COMPUTER LAB	EXST	BC	PT	COOK
LEVEL ONE	314	SHOP	EXST/CO	BC	PT	COOK
LEVEL ONE	316	SHOP OFFICE	EXST	BC	PT	COOK
LEVEL ONE	318A	STORAGE	EXST	EXST	EXST	COOK
LEVEL ONE	V314A	VESTIBULE	EXST	PT-03	PT	COOK
LEVEL ONE	316A	STORAGE	EXST	EXST	EXST	COOK

FINISH SCHEDULE NOTES

1. **General Finish Notes**
 - A. Any finish conflict between finish schedules and finish floor plans to be brought to the architect's attention for resolution.
 - B. Existing doors and operable window hardware shall be cleaned of all dirt and non-original paint.
 - C. **Plastic Laminate**
 - a. Typical Casework/Millwork cabinet body, doors, and drawer fronts shall be PL-01, unless noted otherwise.
 - b. Countertops shall be PL-02.
 - c. Interior Plastic Laminate clad wood doors to be PL-01.
 - d. All New and Existing Window Sills shall be QTZ-02.
 - e. All remaining casework shall have finished ends to match PL-01.
2. **Ceiling Finishes**
 - A. Refer to Reflected Ceiling Plans for scheduled finish.
 - B. At ceilings with exposed structure, all exposed elements shall be painted the scheduled color, including mechanical ductwork, electrical, piping, conduit, j-boxes, etc.
 - C. All interior gyp. bd. ceilings to be painted PT-01, unless noted otherwise.
 - D. All interior gyp. bd. furr-downs to be painted PT-01, unless noted otherwise.
3. **Floor Finishes**
 - A. All substrates receiving new flooring shall be clean of all adhesives and leveled as required to meet the installation recommendations of the flooring manufacturer.
 - B. Refer to Interior Finish Plans for floor finish patterns.
 - C. Refer to Interior Finish Plans for tile origin in each room. If origin point is not indicated, center in middle of the room or corridor.
 - D. All changes in floor material between rooms shall occur at centerline of doorway, unless noted otherwise.
 - E. Level and float flooring at public corridor walls.
 - F. All toilets and other areas capable of water mitigation shall have a 2" x 1/2" marble threshold with double 1/4" bevel edge. The thresholds shall be held in place with thin set.
 - G. Sealant color shall match adjacent material.
 - H. Typical flooring application at brick walls:
 - a. LVT: Rake brick joint at floor level and install sealant between LVT and brick.
 - b. Carpet: Rake brick joint at floor level and tuck carpet tight into raked brick joint.
4. **Wall Finishes**
 - A. Finishes shall continue to inside corner, unless noted otherwise.
 - B. At painted CMU base, paint as indicated in drawings.
 - C. **Paint Information:**
 - a. **Interior Paint:**
 - New interior walls and existing walls within area of work are to be painted PT-01 in their entirety, unless noted otherwise.
 - All interior sealants shall be painted to match adjacent wall.
 - b. **Hollow Metal Doors and Windows:**
 - Hollow metal doors to be painted PT-02, unless noted otherwise.
 - Hollow metal door frames and vision panel frames shall be painted PT-02, unless noted otherwise.
 - At door frames with 2 different colors, transition color at inside corner of door stop, on the door side of the stop.
 - Hollow metal glazed opening frames shall be painted PT-02, unless noted otherwise.



ARCHITECT

VLK Architects
 20445 State Hwy 249, Suite 350
 Houston, Texas 77070
 Main Phone: 281.671.2300
 www.vlkarchitects.com

CYPRESS-FAIRBANKS INDEPENDENT SCHOOL DISTRICT HOUSTON, TEXAS



03/06/2025

ISSUED: February 24, 2025

REVISIONS

Revision No.	Revision Date
1 Addendum 1	03-06-2025

Director
RSJ
Designer

Drawn By
STH, KM
Quality Control

Proj. Arch.
TQ

PROJECT NO.

24-010.00


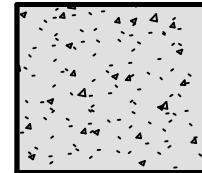
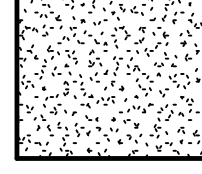
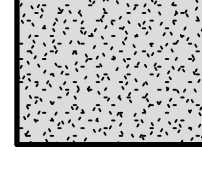
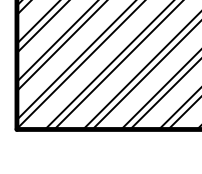


SHEET TITLE


COOK - ROOM FINISH
SCHEDULE

SHEET NO.

A19.02

2024 Cook, Labay & Truitt MS Renovations

INTERIOR FINISH LEGEND		
	CO-01	CONCRETE - SEALED
	CO-02	CONCRETE - POLISHED
	CPT-01	CARPET - FIELD
	CPT-02	CARPET - ACCENT
	RF-01	RESILIENT FLOOR - FIELD
	EXISTING TO REMAIN WITH LIMITED OR NO INTERIOR FINISH WORK REQUIRED IN THIS AREA. REFER TO CIVIL, MEPT AND STRUCTURAL DRAWINGS FOR ANY ADDITIONAL WORK IN AREA.	
	F1	EXISTING POLISHED CONCRETE TO BE REFINISHED.

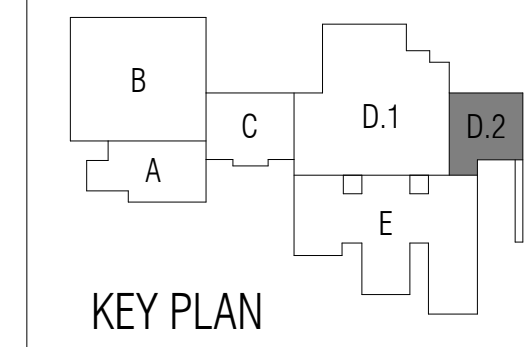

ISSUED: February 24, 2025

REVISIONS

Revision No.	Revision Date
1 Addendum 1	03-06-2025

Director: RSJ
 Drawn By: STH, KM
 Designer: Quality Control

Proj. Arch.: TQ

PROJECT NO.


24-010.00

SHEET TITLE


COOK - INTERIOR FINISH PLAN - LEVEL ONE - UNIT D.2

SHEET NO.


A19.11D.2

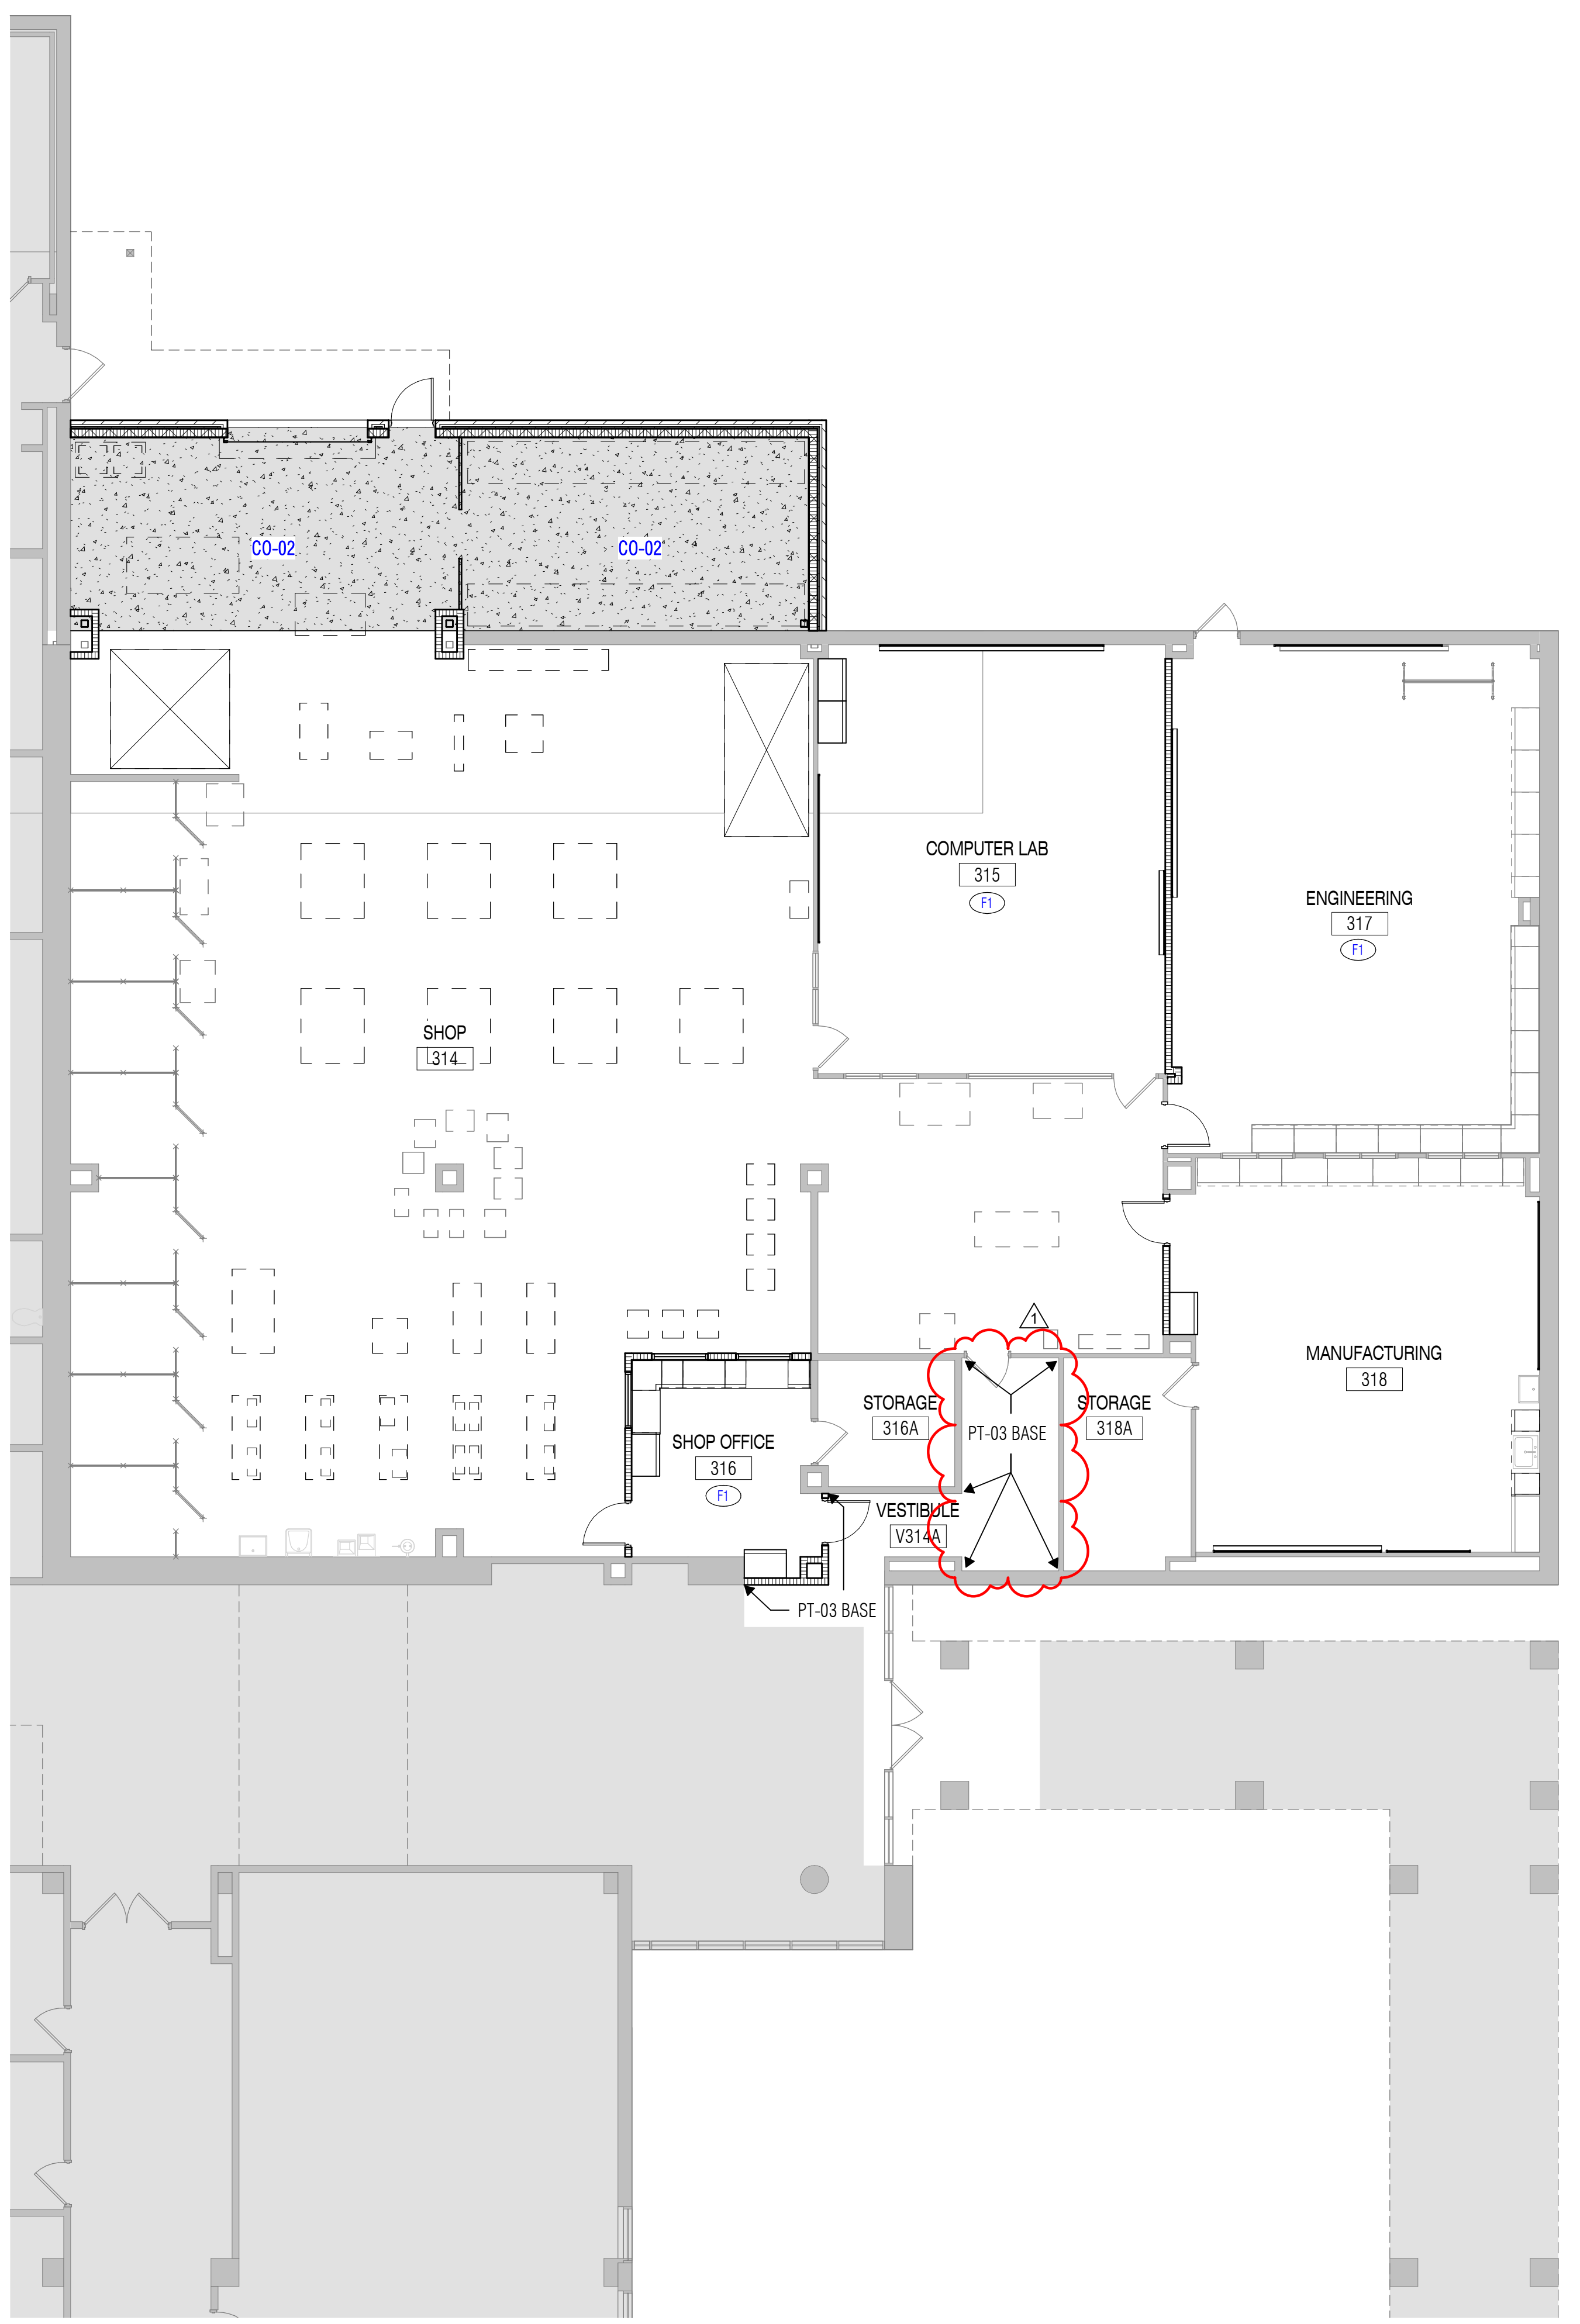


1 INTERIOR FINISH PLAN - LEVEL ONE - UNIT 'D.2'
 SCALE: 1/8" = 1'-0"

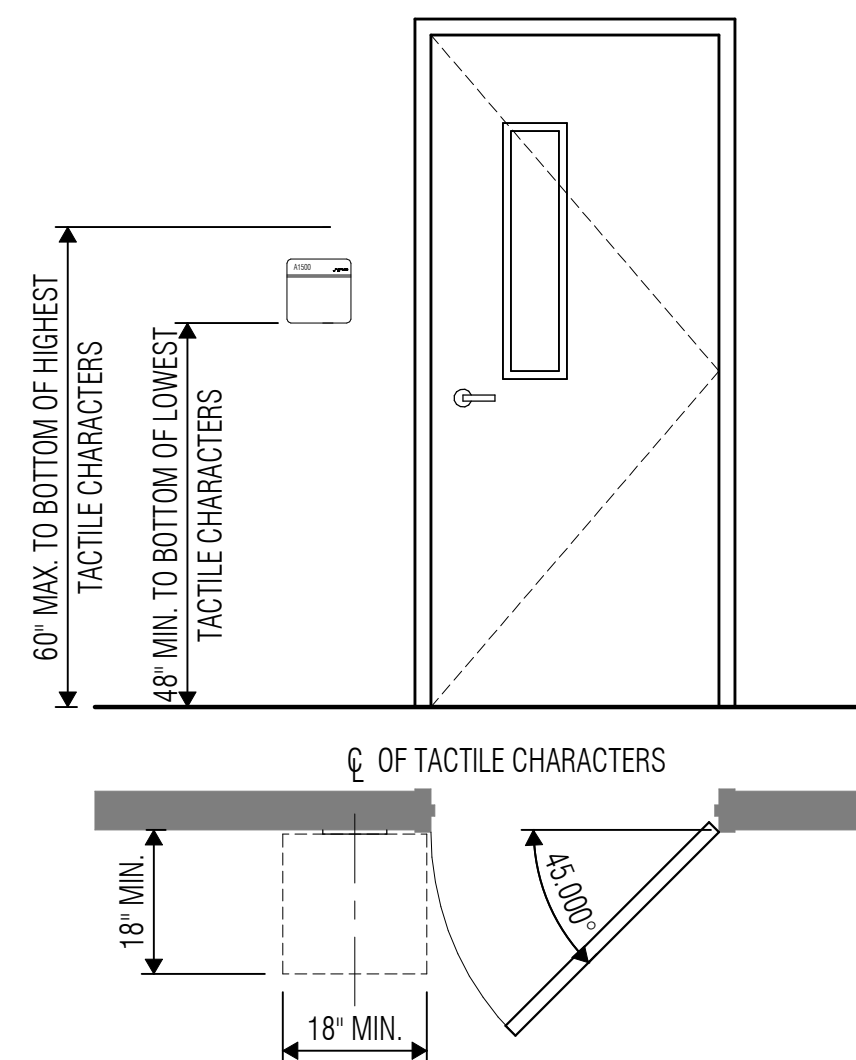


1 DETAIL/ELEV - DOOR SIGN
SCALE: 1/2" = 1'-0"

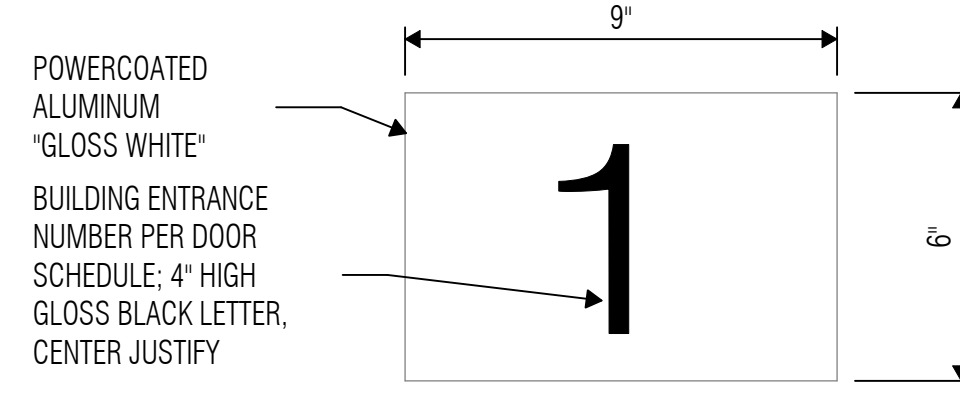



2 SIGN TYPE 'D'
SCALE: 3" = 1'-0"

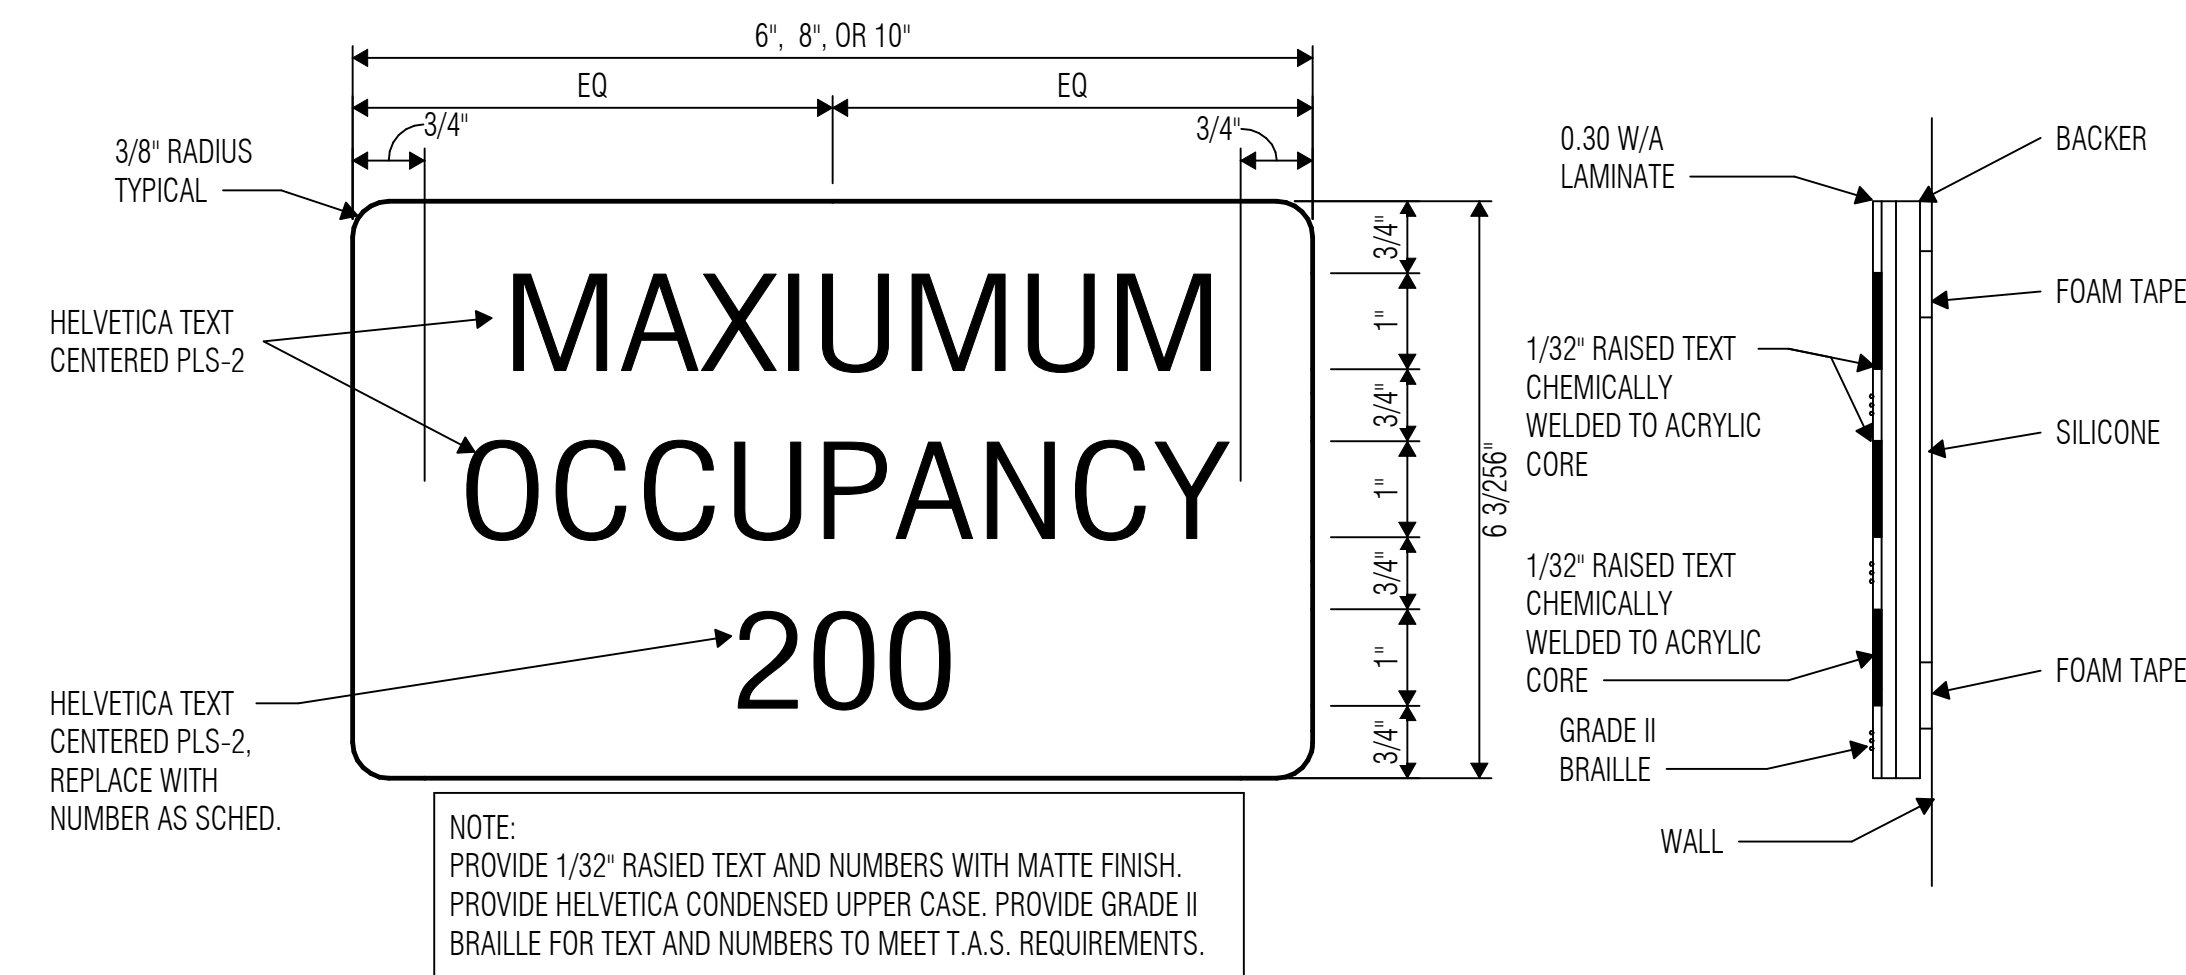


3 SIGN TYPE 'C1'
SCALE: 6" = 1'-0"

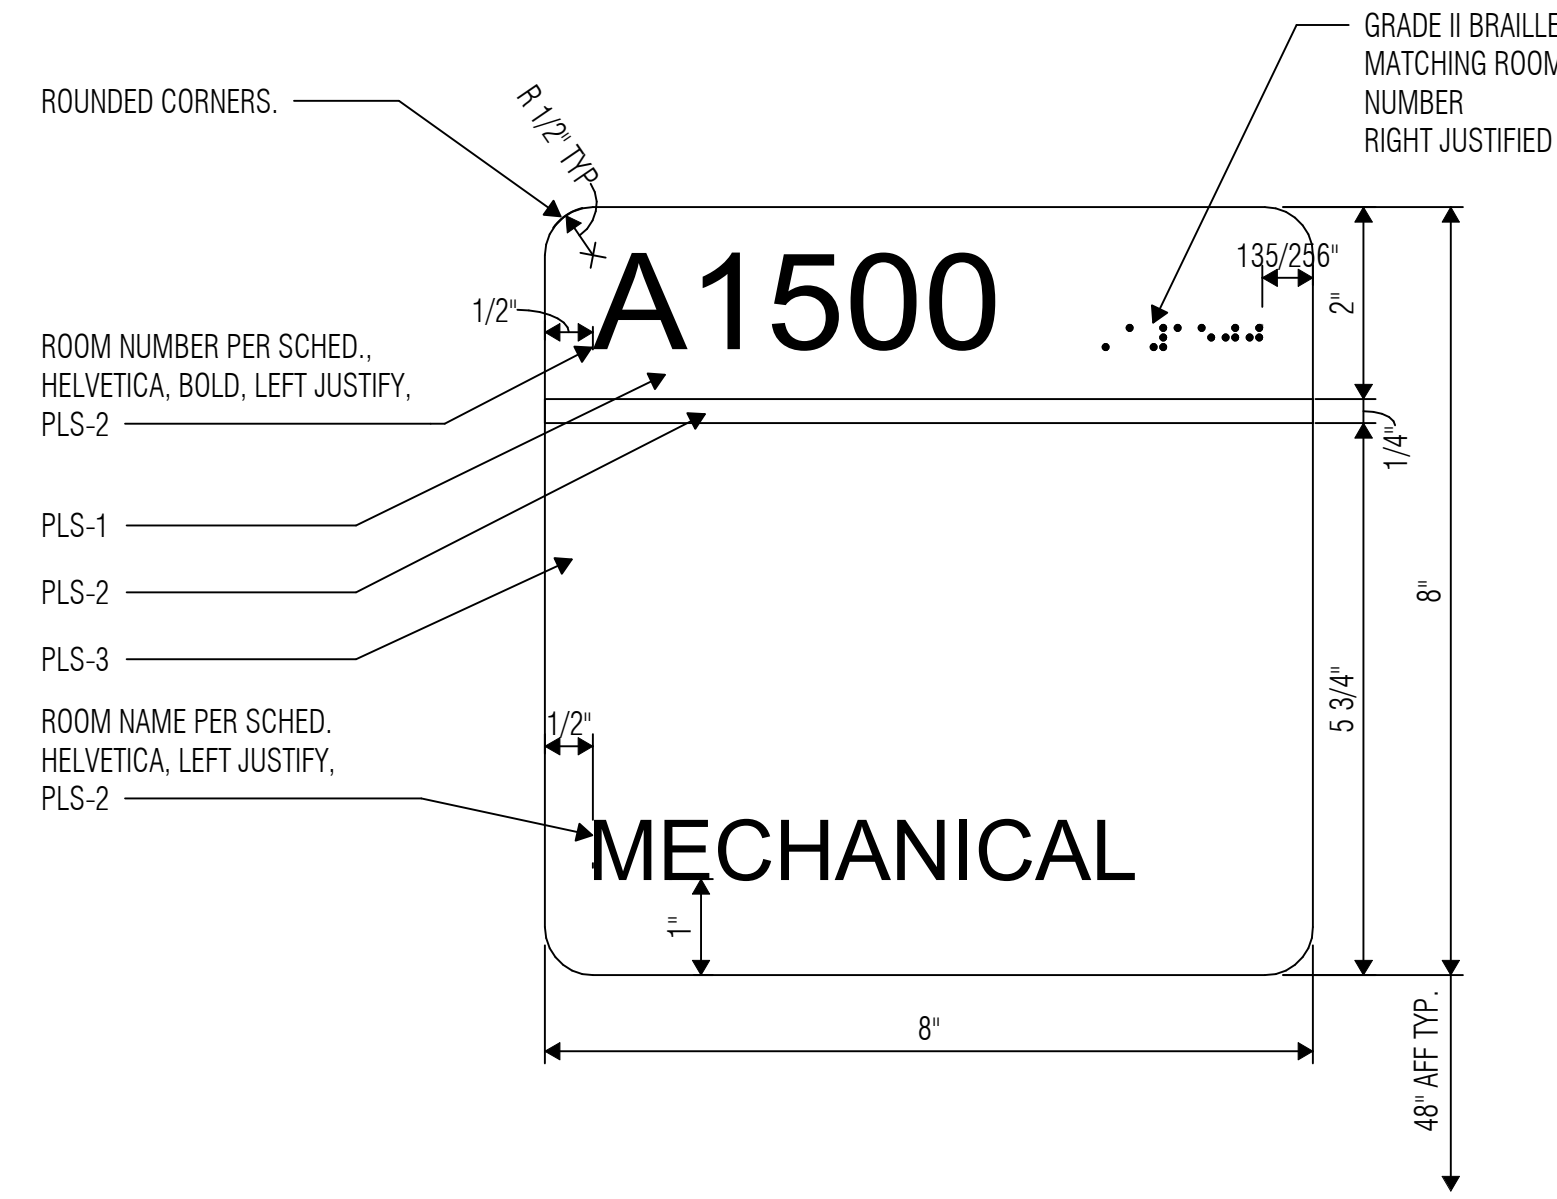

4 SIGN TYPE 'A1'
SCALE: 6" = 1'-0"

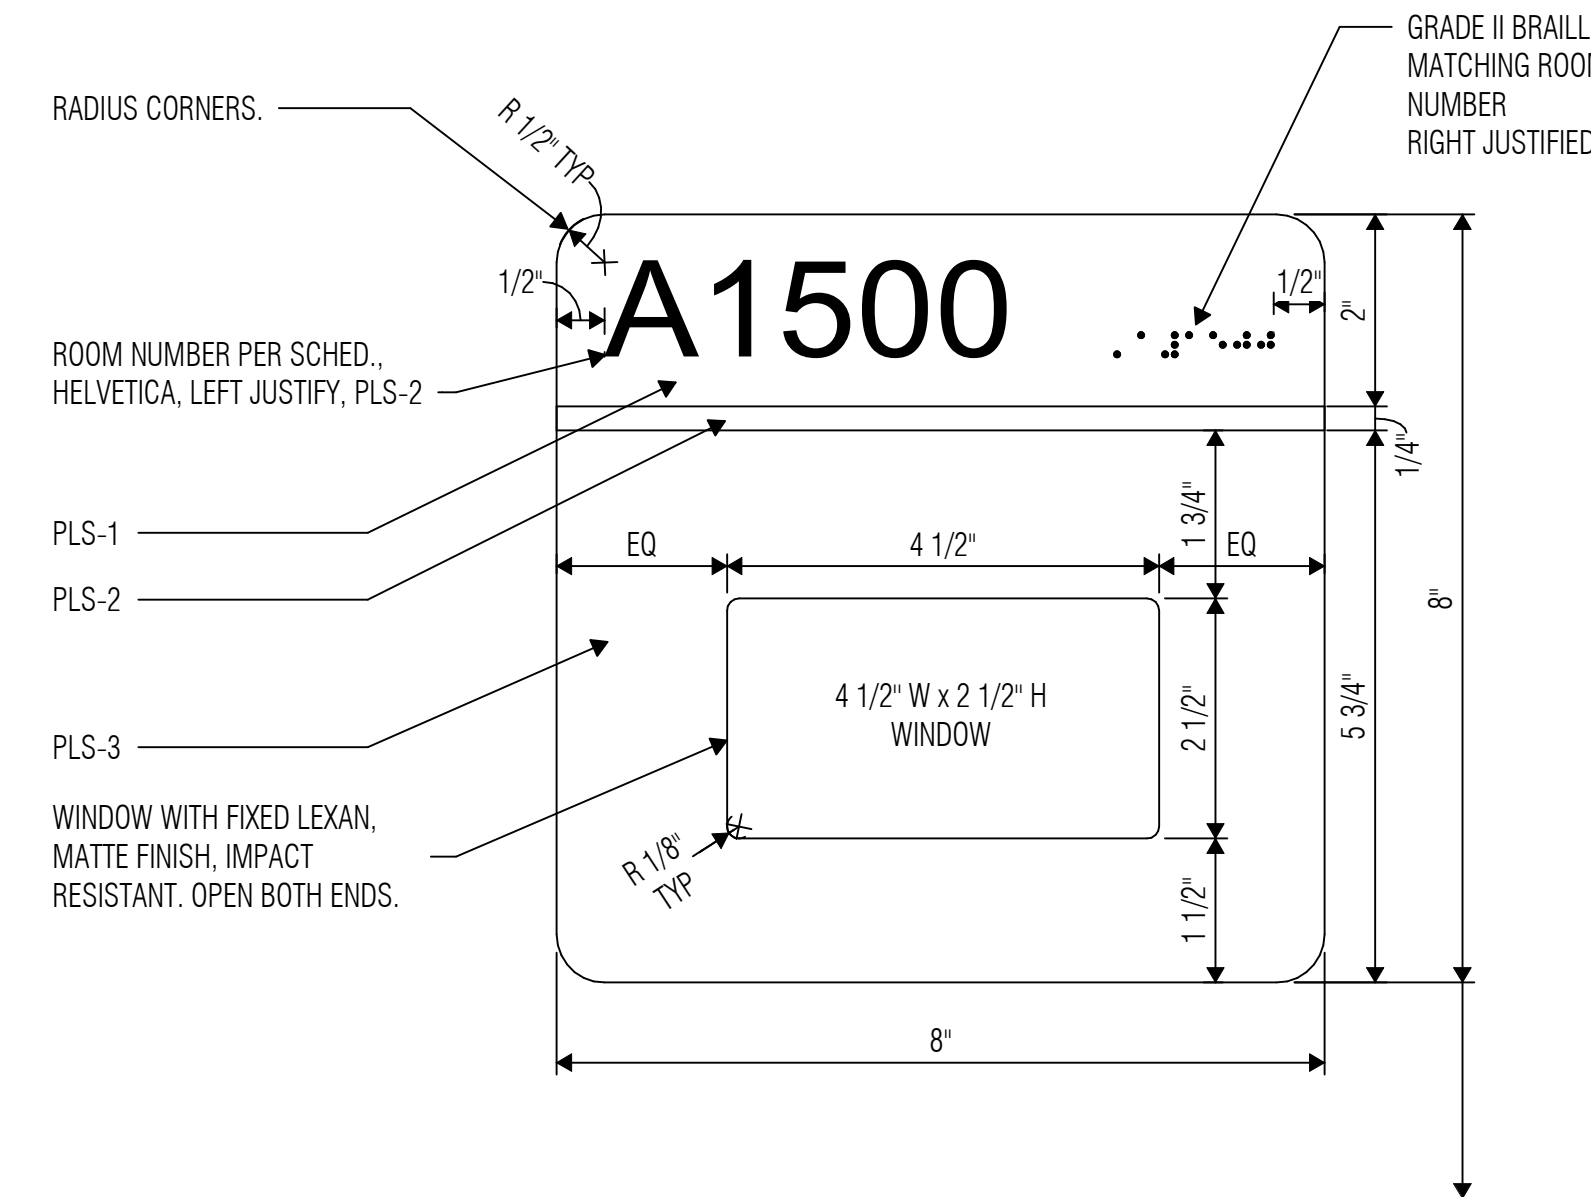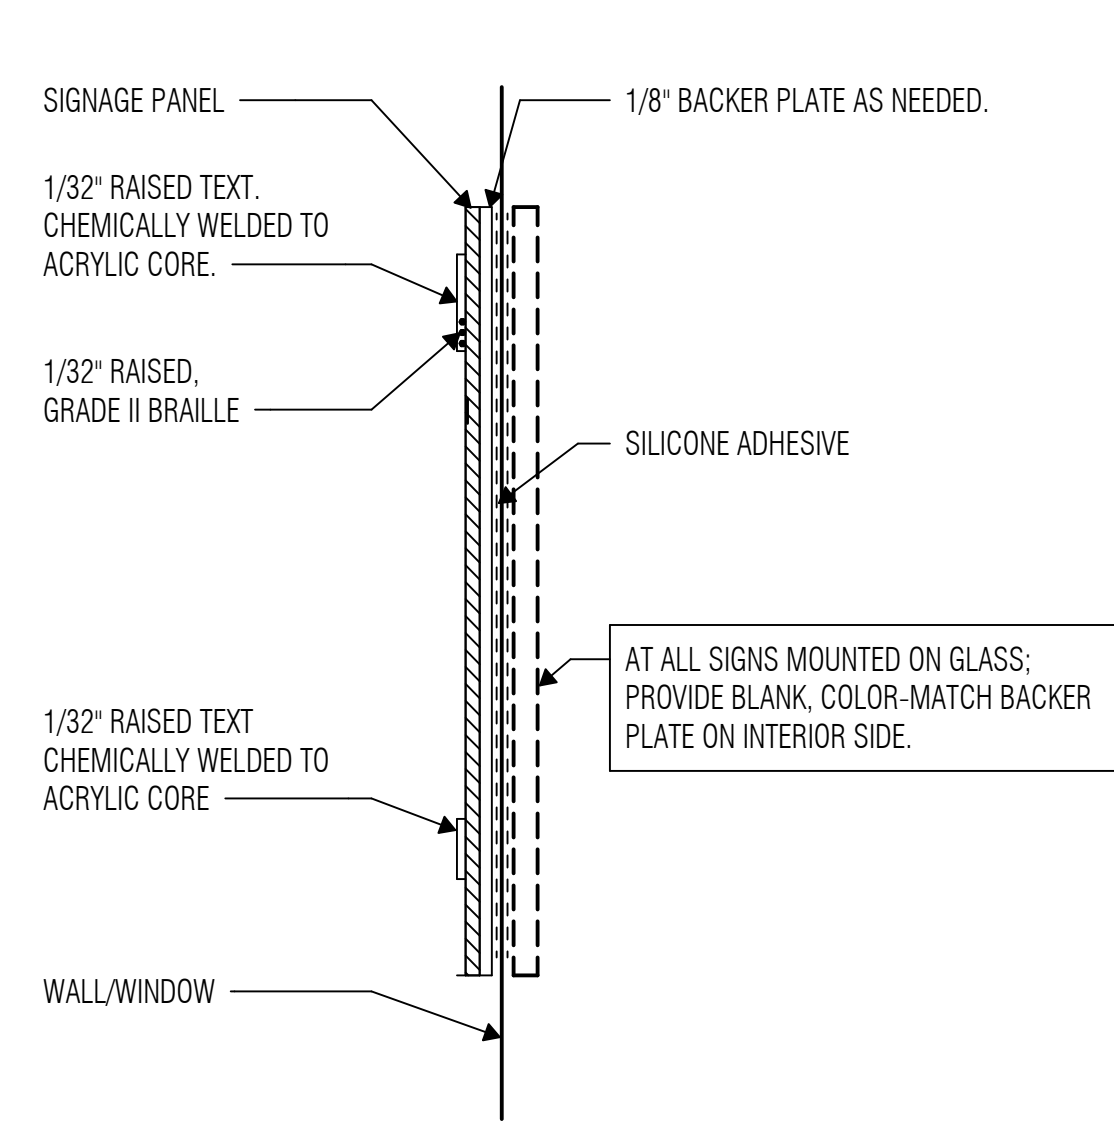

5 SIGN TYPE 'B1'
SCALE: 6" = 1'-0"

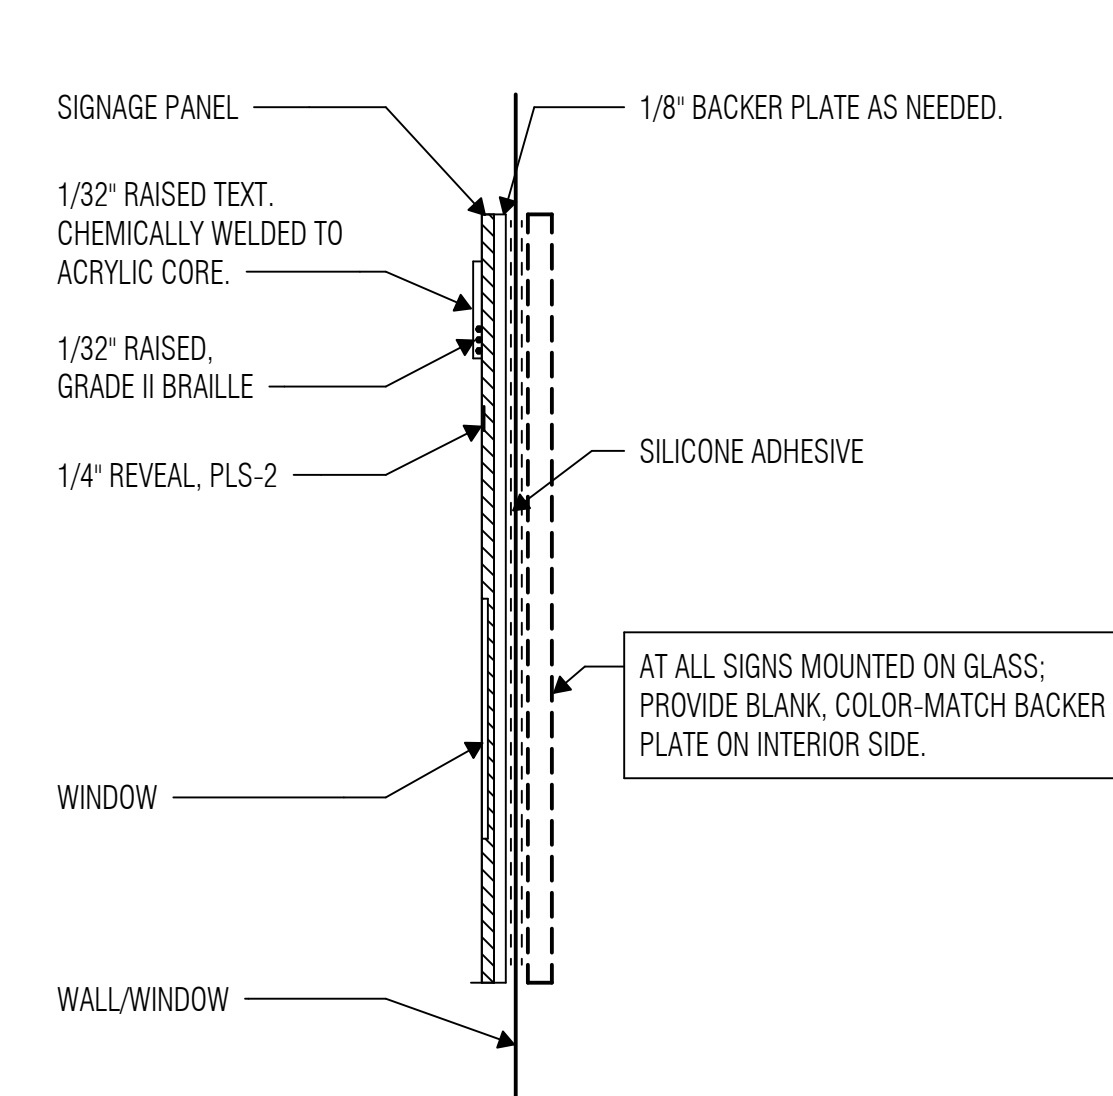

ISSUED: 03/06/25

REVISIONS

Revision No. Revision Date

Director: RSJ
Design: STH, KM
Quality Control: TQ

Proj. Arch: TQ

PROJECT NO.

24-010.00

SHEET TITLE

COOK - ROOM SIGNAGE
DETAILS

SHEET NO.

A19.20

2024 Cook, Labay & Truitt MS Renovations

CYPRESS-FAIRBANKS INDEPENDENT SCHOOL DISTRICT

HOUSTON, TEXAS



CYPRESS-FAIRBANKS INDEPENDENT SCHOOL DISTRICT HOUSTON, TEXAS

ARCHITECT

VLK Architects
20445 State Hwy 249, Suite 350
Houston, Texas 77070
Main Phone: 281.671.2300
www.vlkarchitects.com

CIVIL ENGINEER

Brooks & Sparks, Inc.
21020 Plank Row Blvd.
Katy, TX 77449
Main Phone: 281.578.9595
www.brooksandsparks.com

LANDSCAPE / IRRIGATION

Westwood
20329 State Hwy 249, #350
Houston, TX 77070
Main Phone: (281) 883-0103
www.westwoodps.com

STRUCTURAL ENGINEER

Dunaway
3200 Wilcrest Dr. Ste 4400
Houston, TX 77042
Main Phone: 512.306.8252
www.dunaway.com

M.E.P. ENGINEER

Salas O'Brien
10930 W Sam Houston Pkwy N #900
Houston, TX 77064
Main Phone: 281.664.1900
www.salasobrien.com

ACOUSTICAL / THEATRICAL

W.J.H.W.
3424 Midcourt Rd. Suite 124
Carrollton, TX 75006
Main Phone: 210.561.9800
www.wjhw.com



ISSUED: February 24, 2025

REVISIONS

Revision No.	Revision Date
1 Addendum 1	03-06-2025

Director: RSJ
Designer: -
Proj. Arch.: RS

PROJECT NO.

24-010.00

SHEET TITLE

COVER - LABAY MS

SHEET NO.

G20.01

SHEET NO.

G20.01

VOLUME 2

LABAY MIDDLE SCHOOL

BOARD OF TRUSTEES


SCOTT HENRY	PRESIDENT
DR. NATALIE BLASINGAME	VICE PRESIDENT
JUSTIN RAY	SECRETARY
TODD LECOMPTE	TRUSTEE
JULIE HINAMAN	TRUSTEE
CHRISTINE KALMBACH	TRUSTEE
LUCAS H. SCANLON	TRUSTEE



ADMINISTRATION

DOUGLAS KILLIAN, ED.D.	SUPERINTENDENT OF SCHOOLS
TERESA HULL	CHIEF OF STAFF
MATT MORGAN	CHIEF OF OPERATION OFFICER
LINDA MACIAS, ED.D.	CHIEF ACADEMIC OFFICER
DEBORAH STEWART, ED.D.	CHIEF OF EMPLOYEE & STUDENT SERVICES
KAREN SMITH	CHIEF FINANCIAL OFFICER
CHRISTINA COLE	CHIEF OFFICER FOR SCHOOL LEADERSHIP
MARNEY COLLINS-SIMS	GENERAL COUNCIL
JESSE CLAYBURN	ASSISTANT SUPERINTENDENT, FACILITIES AND CONSTRUCTION
DAN GROSZ	DIRECTOR OF DESIGN AND FACILITIES PLANNING
SHANNON THOMPSON	DIRECTOR OF PROJECT MANAGEMENT
STEVEN BRYAN	DIRECTOR OF CONSTRUCTION FIELD SERVICES
AMY HAYES	DIRECTOR OF CONTRACT MANAGEMENT

SCOPE OF WORK

SCOPE #	DESCRIPTION
1	Provide addition for electronics lab.
2	Renovate existing metal shop.
3	Renovate existing FCS area to meet District Standards. Replace all casework in Food Lab.
4	Add 1,000 SF total to Orchestra for the following: Increase main classroom size to 1,600 SF, Add one (1) Ensemble room 500 SF, Add one (1) Practice room 100 SF.
5	Provide outside storage for football and track equipment.
8	Replace gym wall padding, backboards, goals and supports.
9	Replace blue exterior metal wall panels.
10	Provide new cap sheet to existing modified bitumen roofing membrane
11	Remove and replace pavement joint sealant.
12	Provide generator backed power for all racks in all telecommunications rooms.
13	Provide interior lighting controls.
14	Update Cafeteria Stage Lighting, Sound, A/V Equipment and Drapery packages.
16	Provide sub-metering for kitchen cooling/heating and water usages.
17	Add dedicated HVAC unit to secondary telecommunications rooms (IDF)
18	Replace HVAC controls.
19	Separate irrigation meter from existing water meter.
20	Replace all existing data cables.
24	Additional card readers on exterior doors.
22	Harden main front desk.
25	Additional lockdown buttons.
26	Enhanced video alarms.
27	Exterior Window and Door Numbering.
29	Impact-resistant glass on doors and high-traffic areas.
30	Upgrade classroom and exterior door hardware.


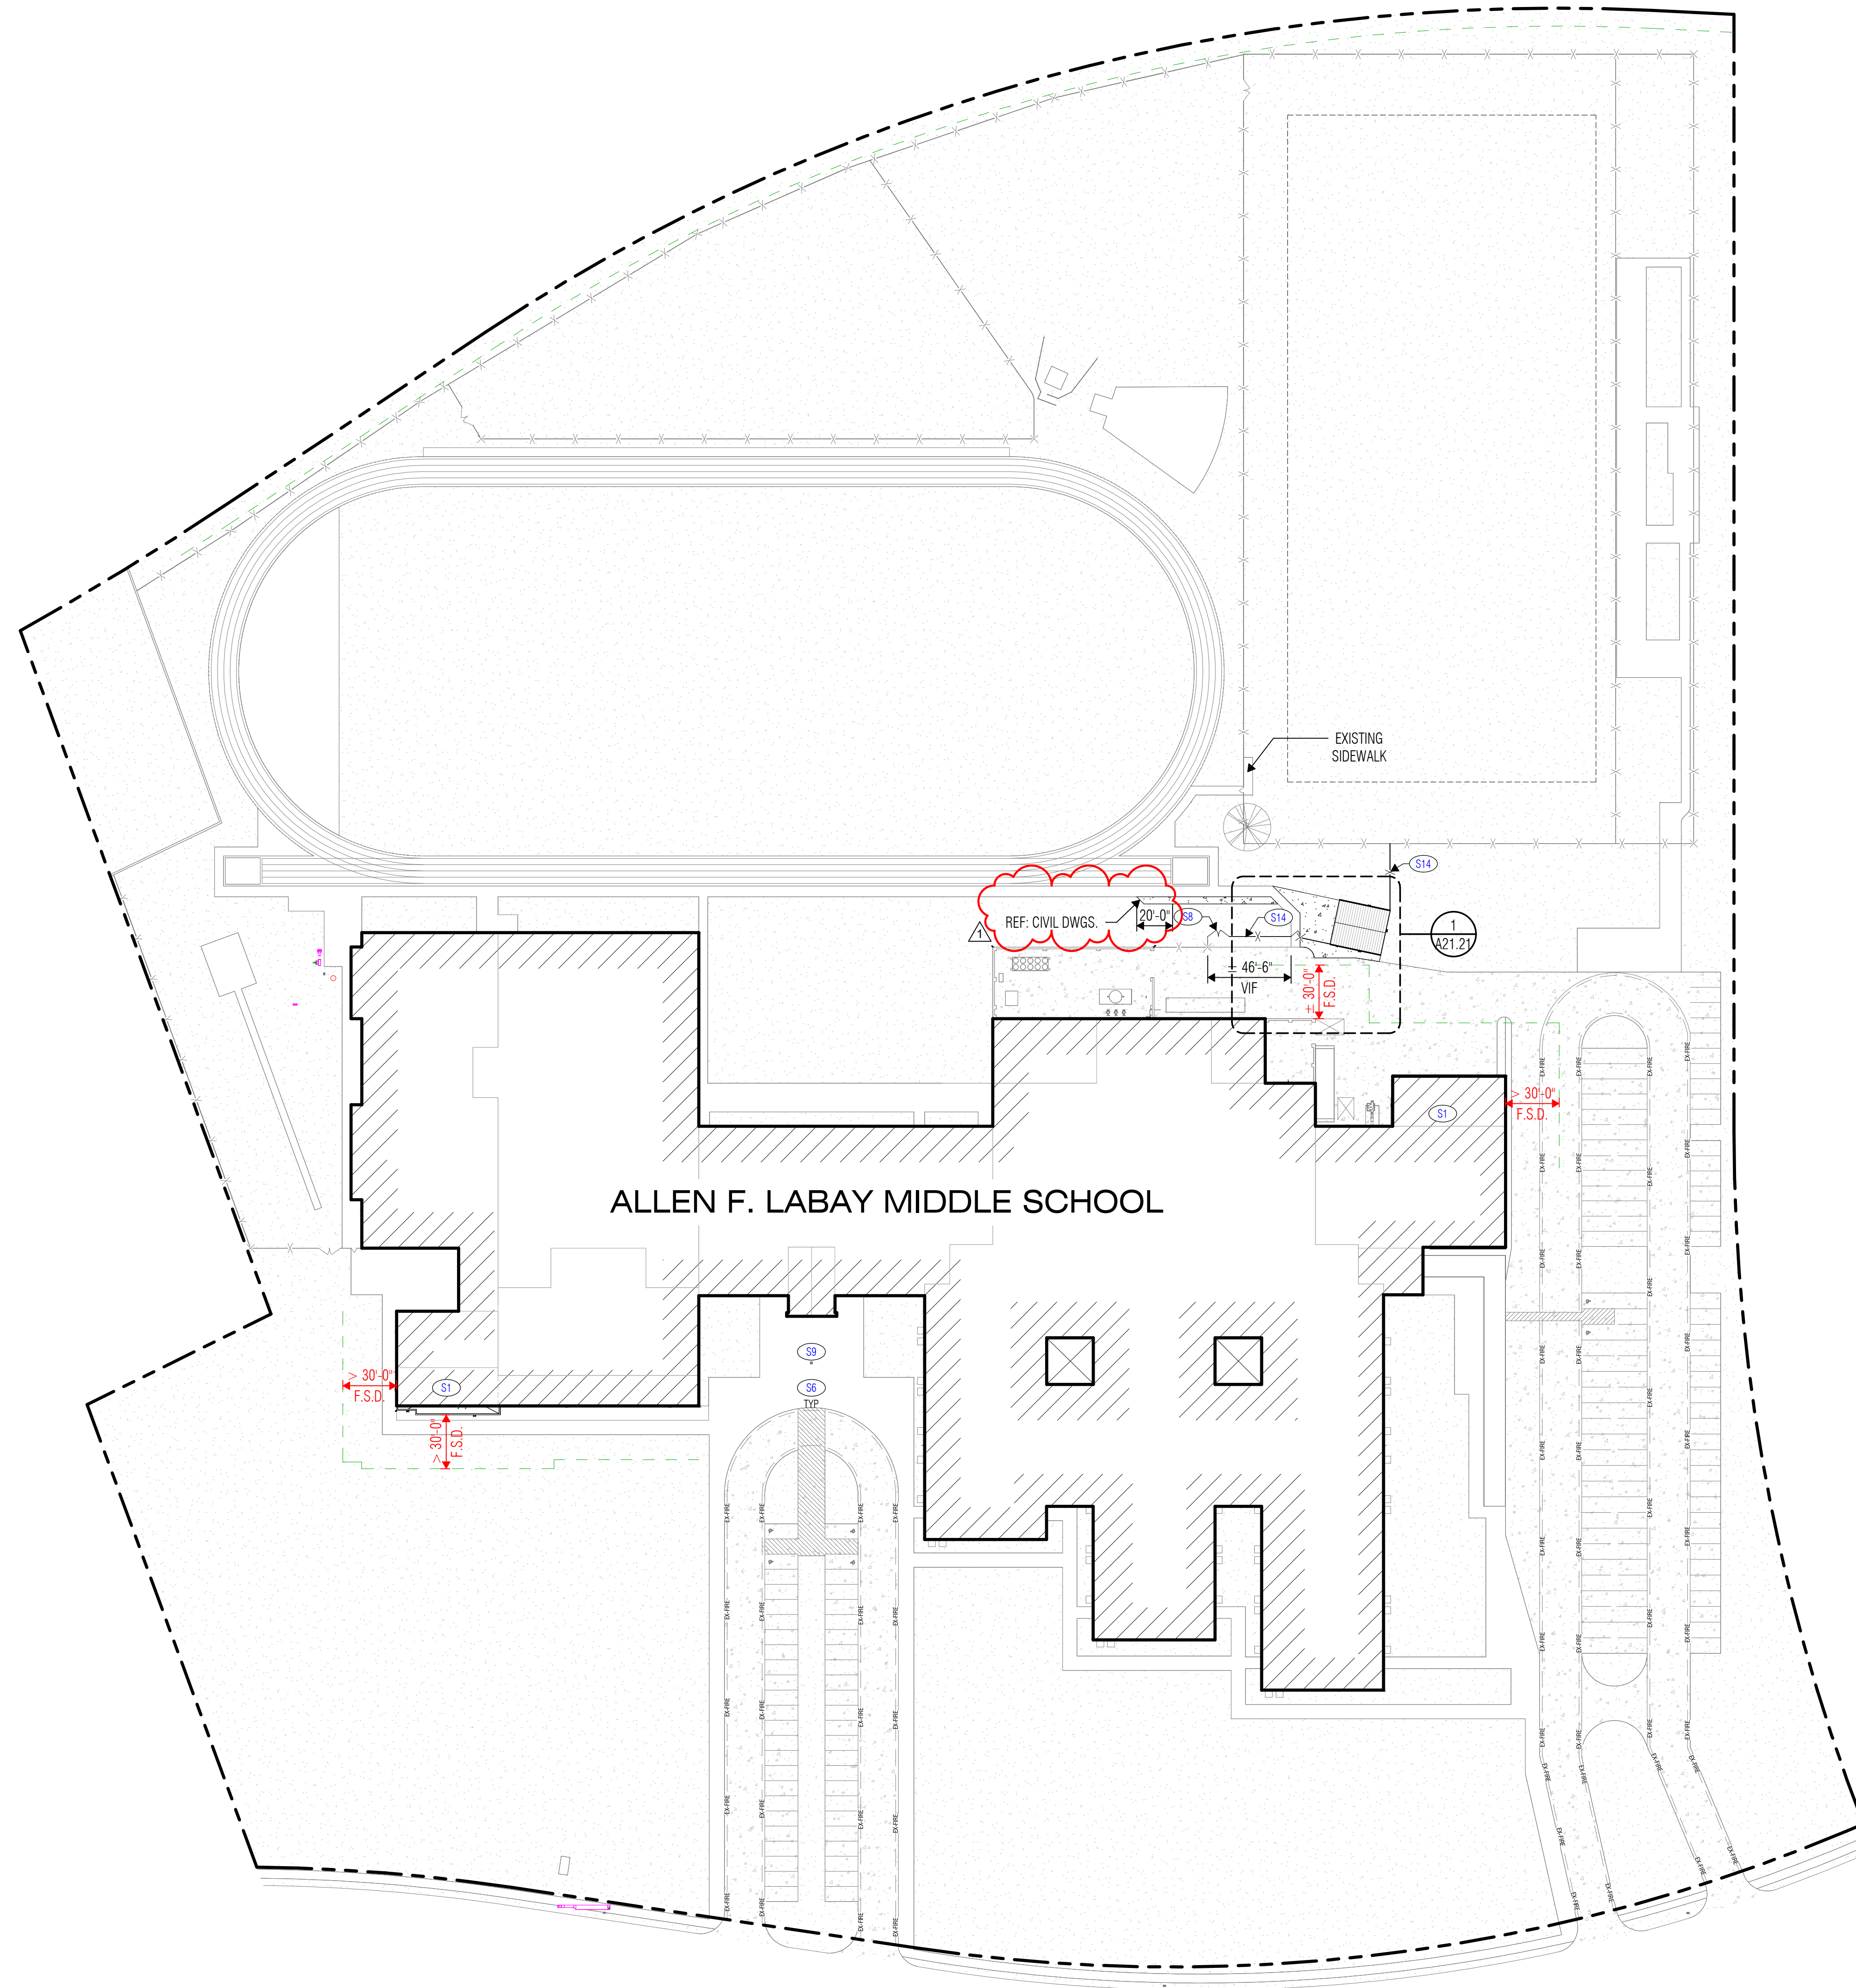

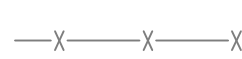
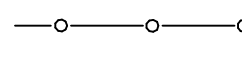
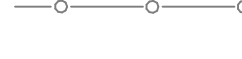


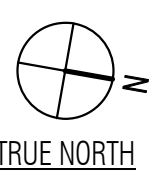



ARCHITECTURAL SITE PLAN
 SCALE: 1" = 50'-0"

SITE PLAN NOTES

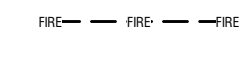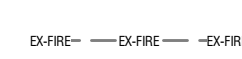1. Verify and document existing dimensions and conditions at the site before beginning construction. Notify the Architect of conflicts or variations prior to commencement of construction.
2. To prevent damage to existing trees and shrubs in proximity to the Work, provide and maintain protective barriers around those items in accordance with the specified procedures, or in the absence of those procedures, with recognized landscaping and horticultural practices.
3. Contractor shall repair any damages to landscaping and paving after construction is complete.

SITE PLAN LEGEND

	FIRE LANE
	EXISTING FIRE LANE
	CHAIN LINK FENCE. See Plan for Heights
	EXISTING CHAIN LINK FENCE. See Plan for Heights
	WOOD FENCE. See Plan for Heights
	EXISTING WOOD FENCE. See Plan for Heights
	ORNAMENTAL FENCE. See Plan for Heights
	EXISTING ORNAMENTAL FENCE. See Plan for Heights

KEYNOTE LEGEND

S1	PROPOSED BUILDING ADDITION
S6	REMOVE AND REPLACE ALL JOINT SEALANT AT EXISTING PAVEMENT TO REMAIN, INCLUDING ALL CONCRETE DRIVES, SIDEWALKS, JOINT AT BUILDING ENVELOPE, ETC.
S8	PROPOSED CHAINLINK GATE. HEIGHT TO MATCH ADJACENT FENCE. PROVIDE CHAIN AND PADLOCK WELDED TO GATE IN SEQUENCE.
S9	EXISTING FLAG POLE
S14	NEW 6H CHAINLINK FENCE TO MATCH EXISTING.



ARCHITECT
VLK Architects
 20445 State Hwy 249, Suite 350
 Houston, Texas 77070
 Main Phone: 281.671.2300
 www.vlkarchitects.com

CYPRESS-FAIRBANKS INDEPENDENT SCHOOL DISTRICT
 HOUSTON, TEXAS



ISSUED: February 24, 2025

REVISIONS

Revision No.	Revision Date
1 Addendum 1	03-06-2025

Director: RSJ
 Designer: RSJ
 Drawn By: STH, KM
 Quality Control: STH, KM

Proj. Arch. TQ

PROJECT NO.
24-010.00
SHEET TITLE

LABAY - ARCHITECTURAL SITE PLAN

SHEET NO.

A21.11

2024 Cook, Labay & Truitt MS Renovations

ARCHITECT

VLK Architects
 20445 State Hwy 249, Suite 350
 Houston, Texas 77070
 Main Phone: 281.671.2300
 www.vlkarchitects.com

CYPRESS-FAIRBANKS INDEPENDENT SCHOOL DISTRICT
 HOUSTON, TEXAS

2024 Cook, Labay & Truitt MS Renovations



ISSUED: February 24, 2025

REVISIONS

Revision No.	Revision Date
1 Addendum 1	03-06-2025

Director: RSJ
 Drawn By: STH, KM
 Designer: TQ
 Quality Control:

PROJECT NO.


24-010.00

SHEET TITLE


LABAY - ENLARGED ARCHITECTURAL SITE PLANS & CANOPY PLANS

SHEET NO.


A21.21

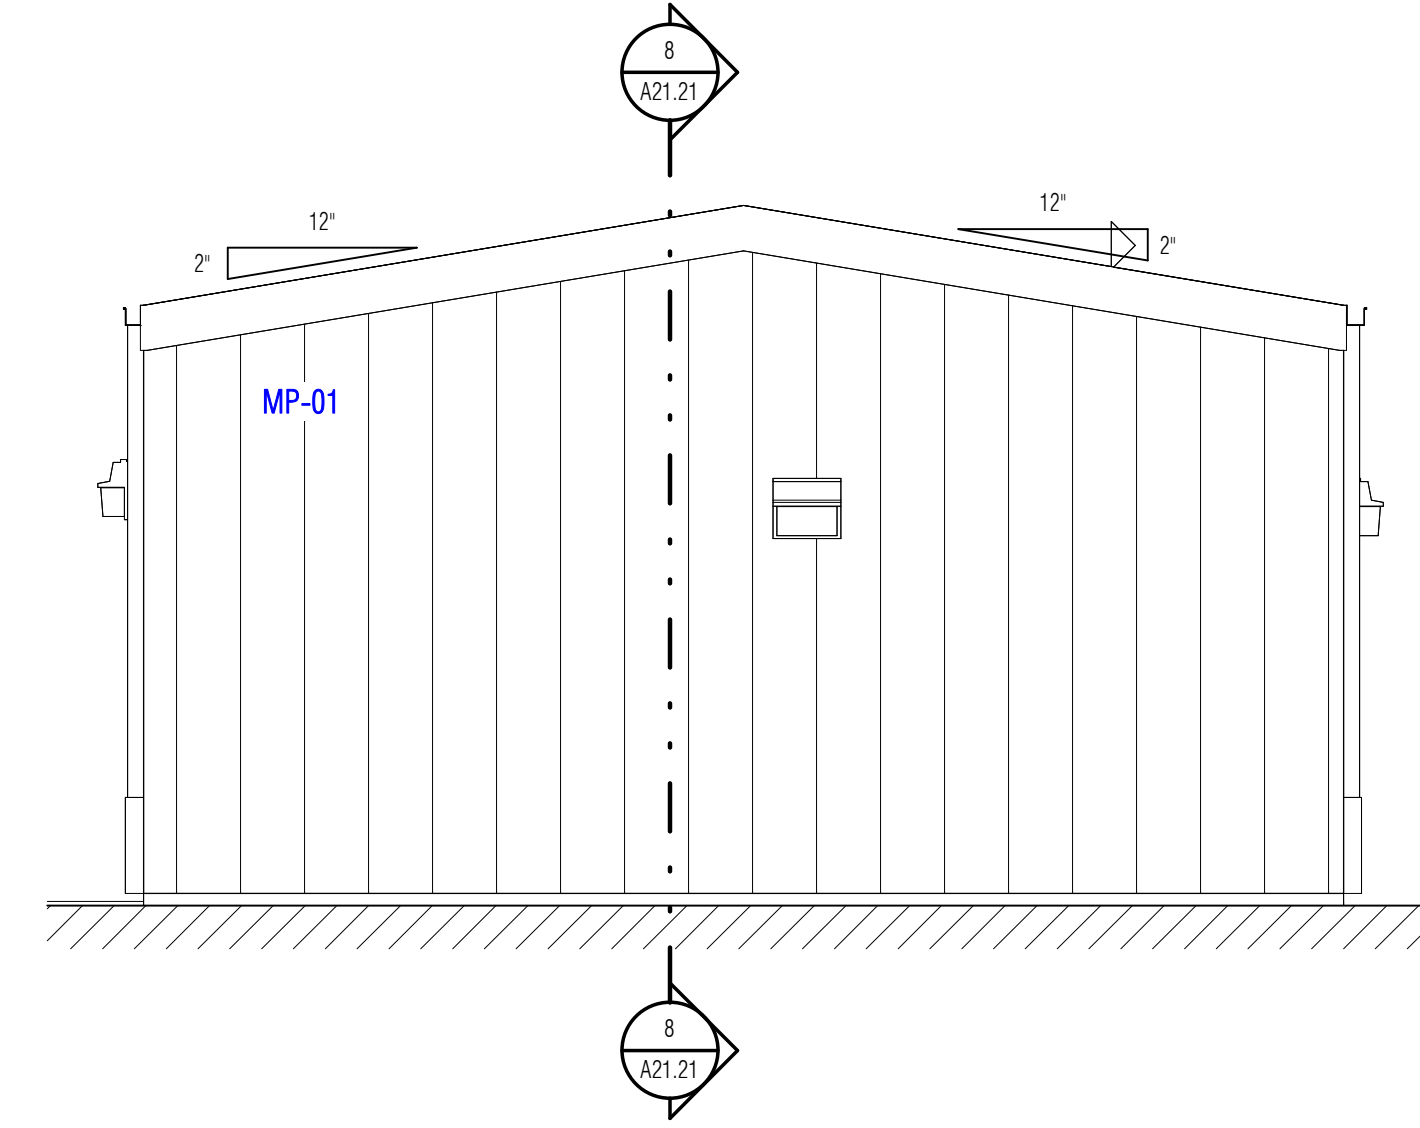


5 BUILDING ELEVATION
 SCALE: 1/4" = 1'-0"

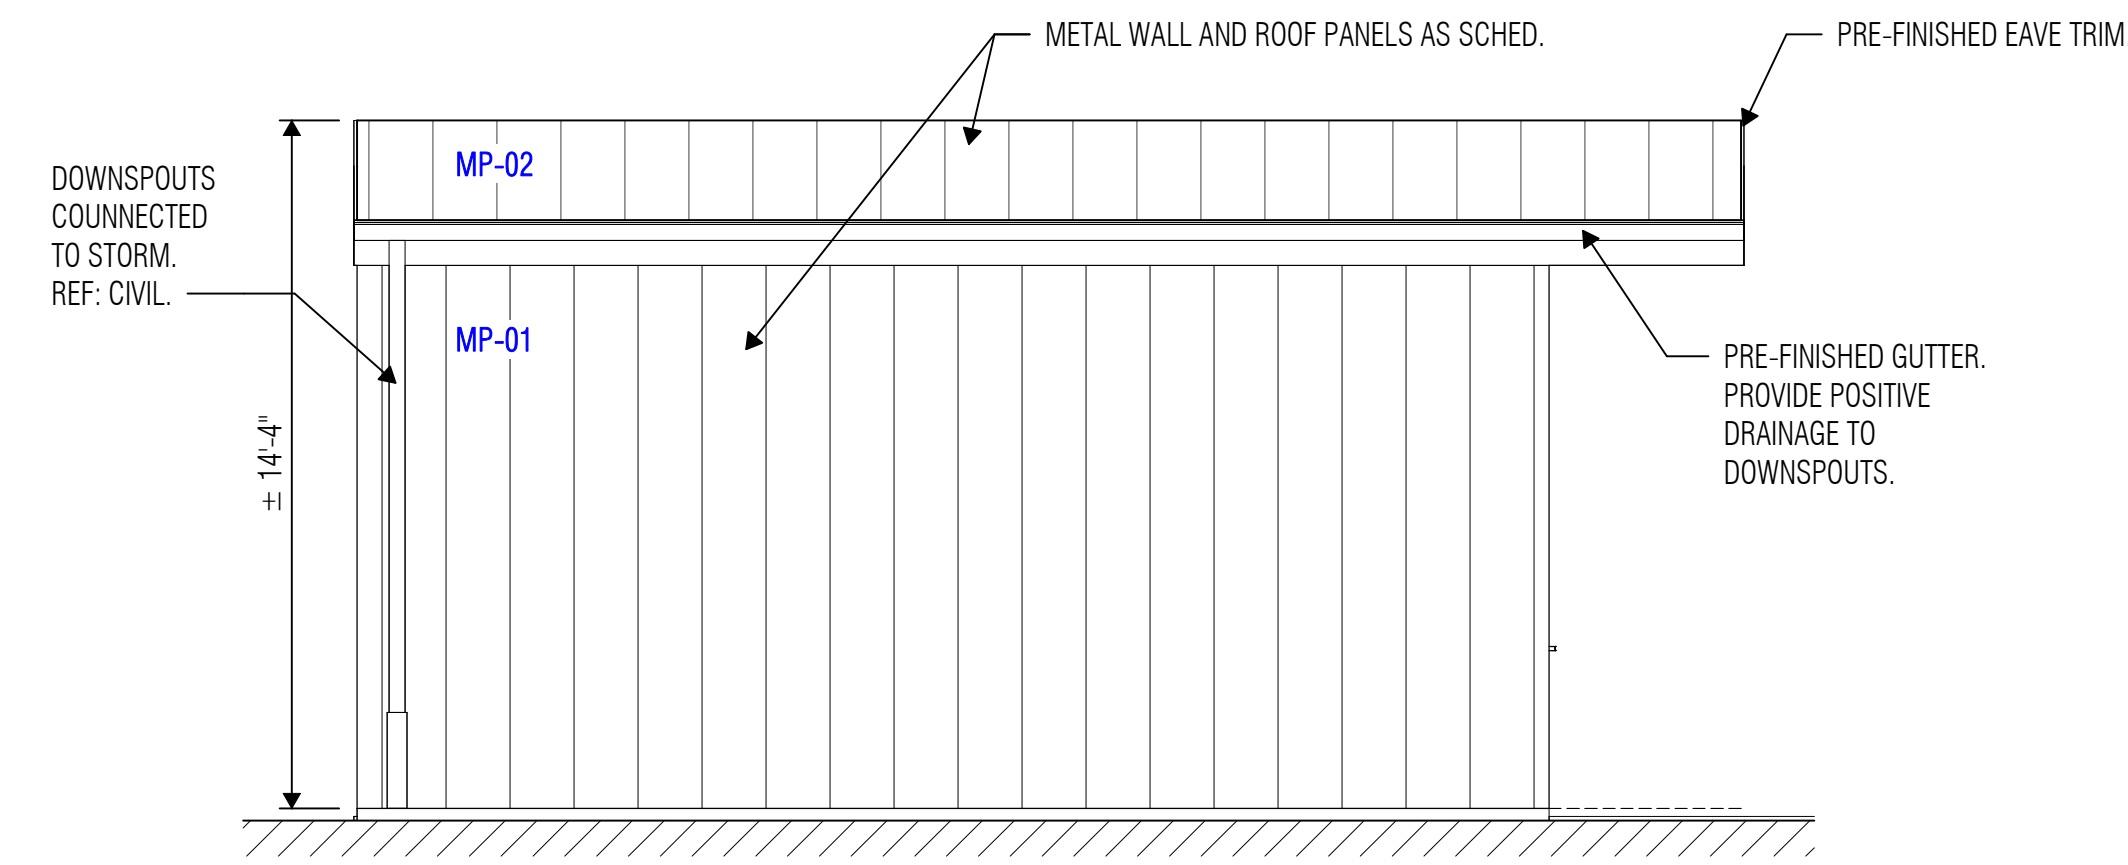


6 BUILDING ELEVATION
 SCALE: 1/4" = 1'-0"

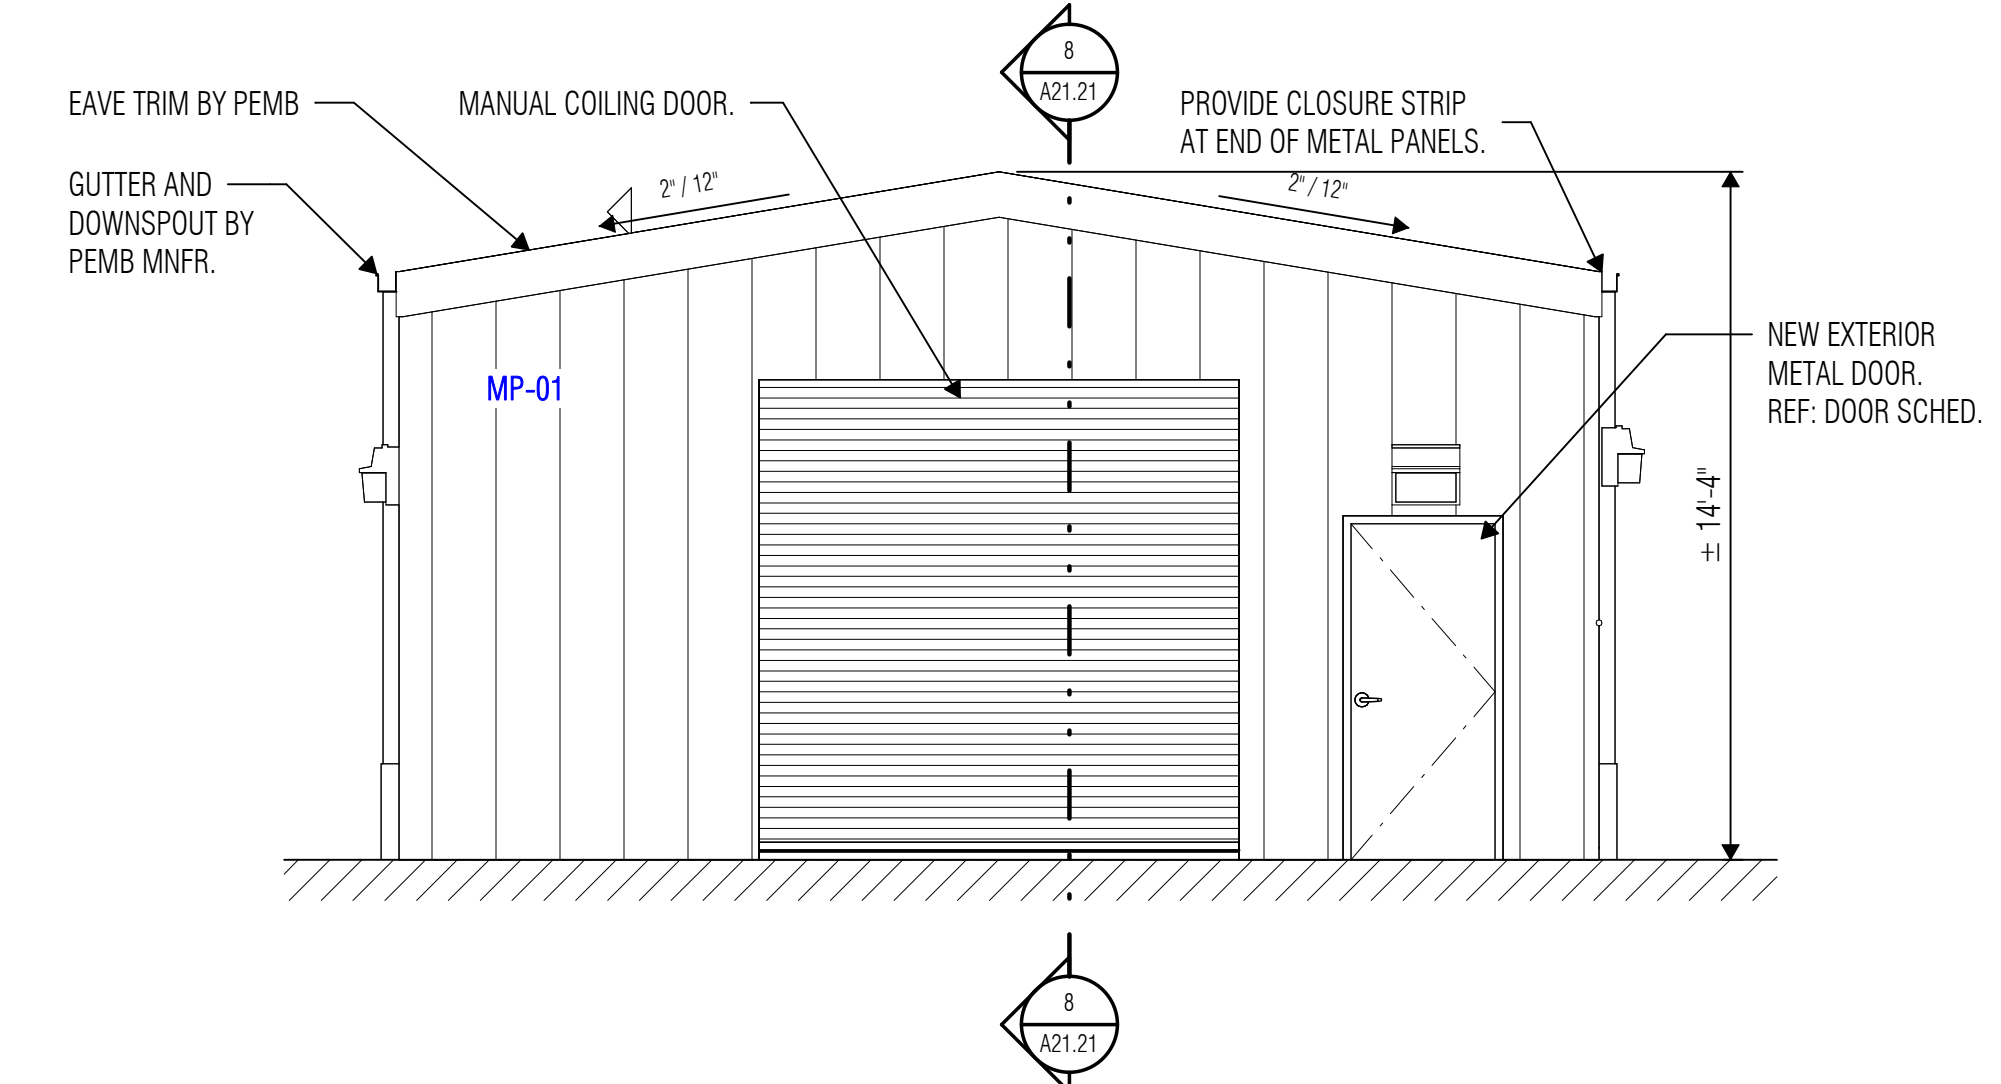


4 BUILDING ELEVATION
 SCALE: 1/4" = 1'-0"

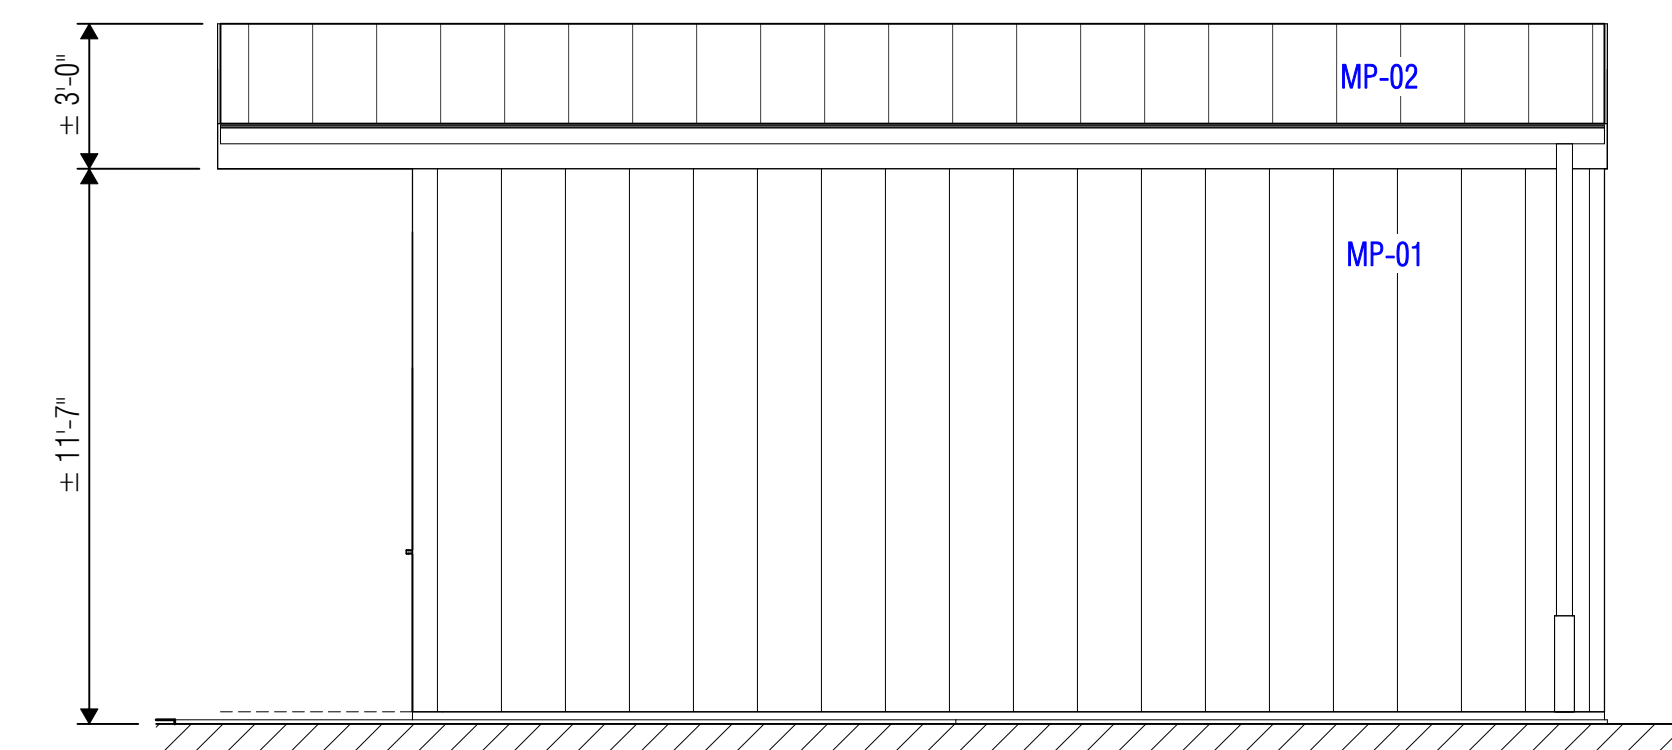


3 BUILDING ELEVATION
 SCALE: 1/4" = 1'-0"

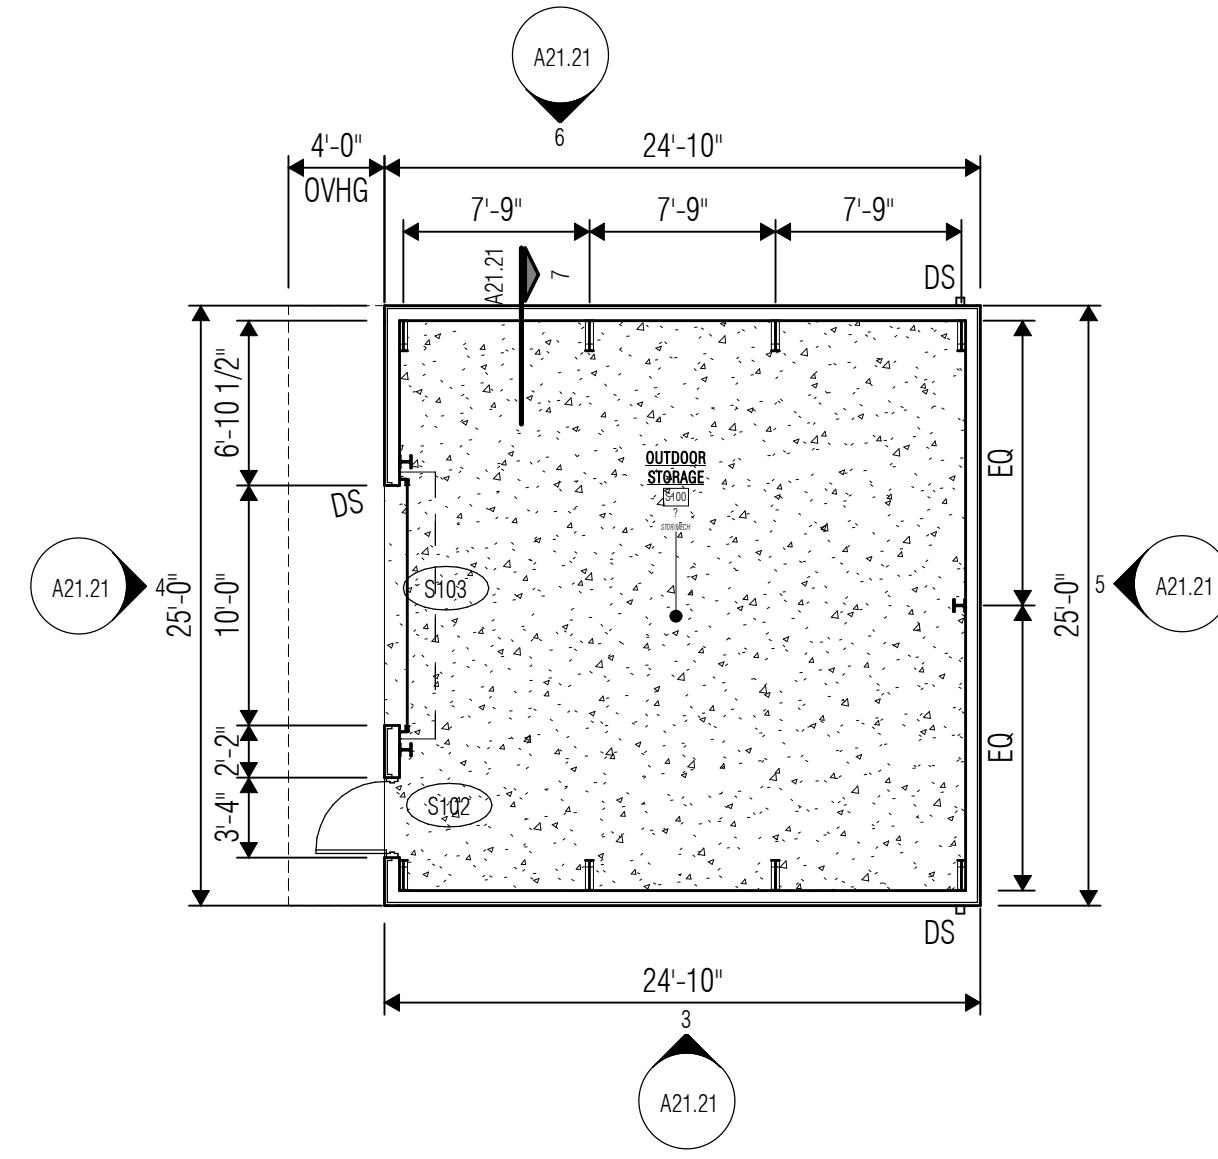


2 OUTDOOR STORAGE FLOOR PLAN
 SCALE: 1/8" = 1'-0"

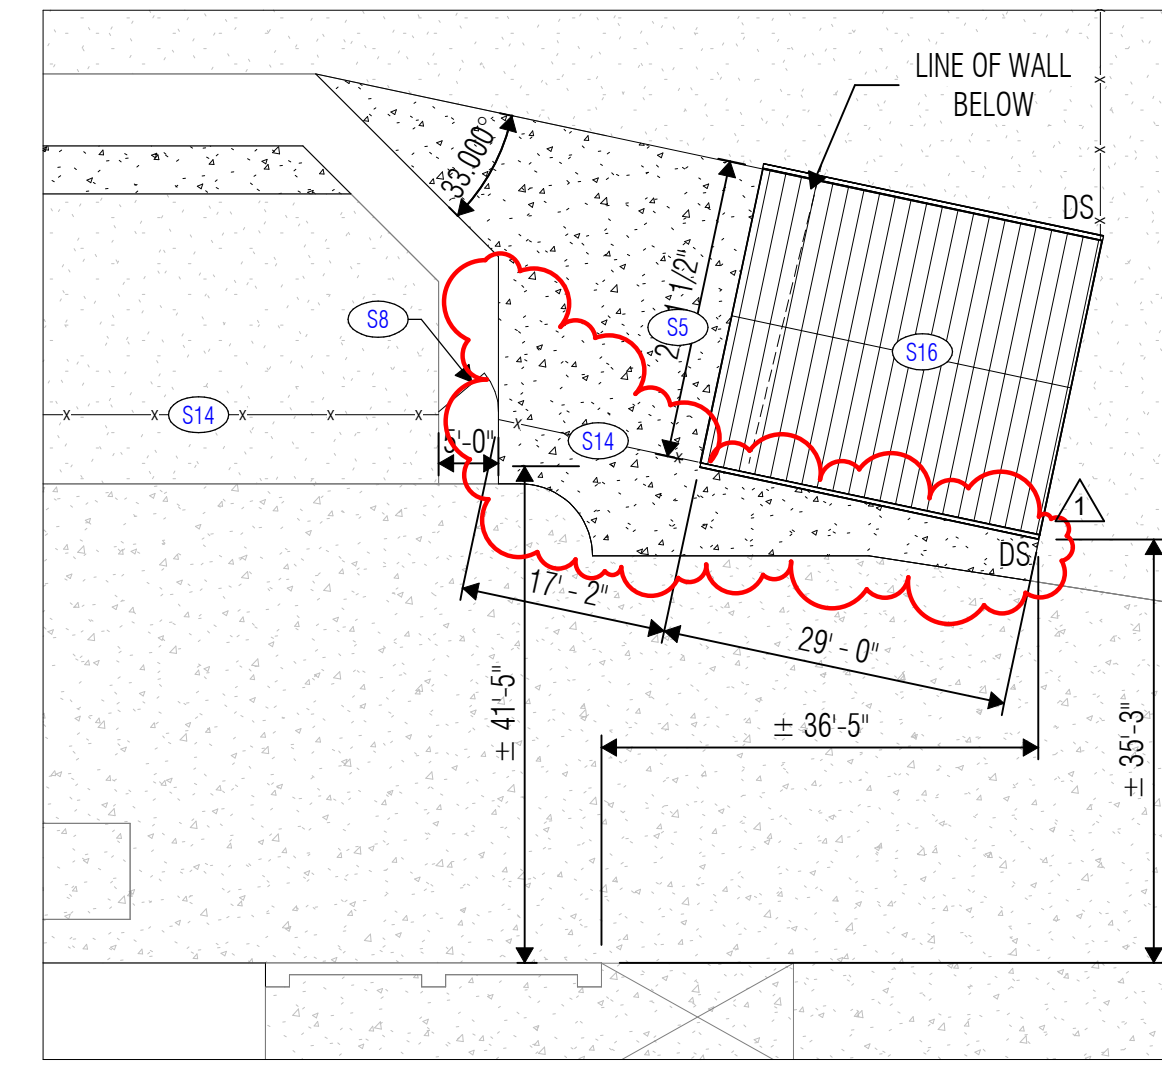


1 ENLARGED SITE PLAN
 SCALE: 1/16" = 1'-0"
 TRUE NORTH

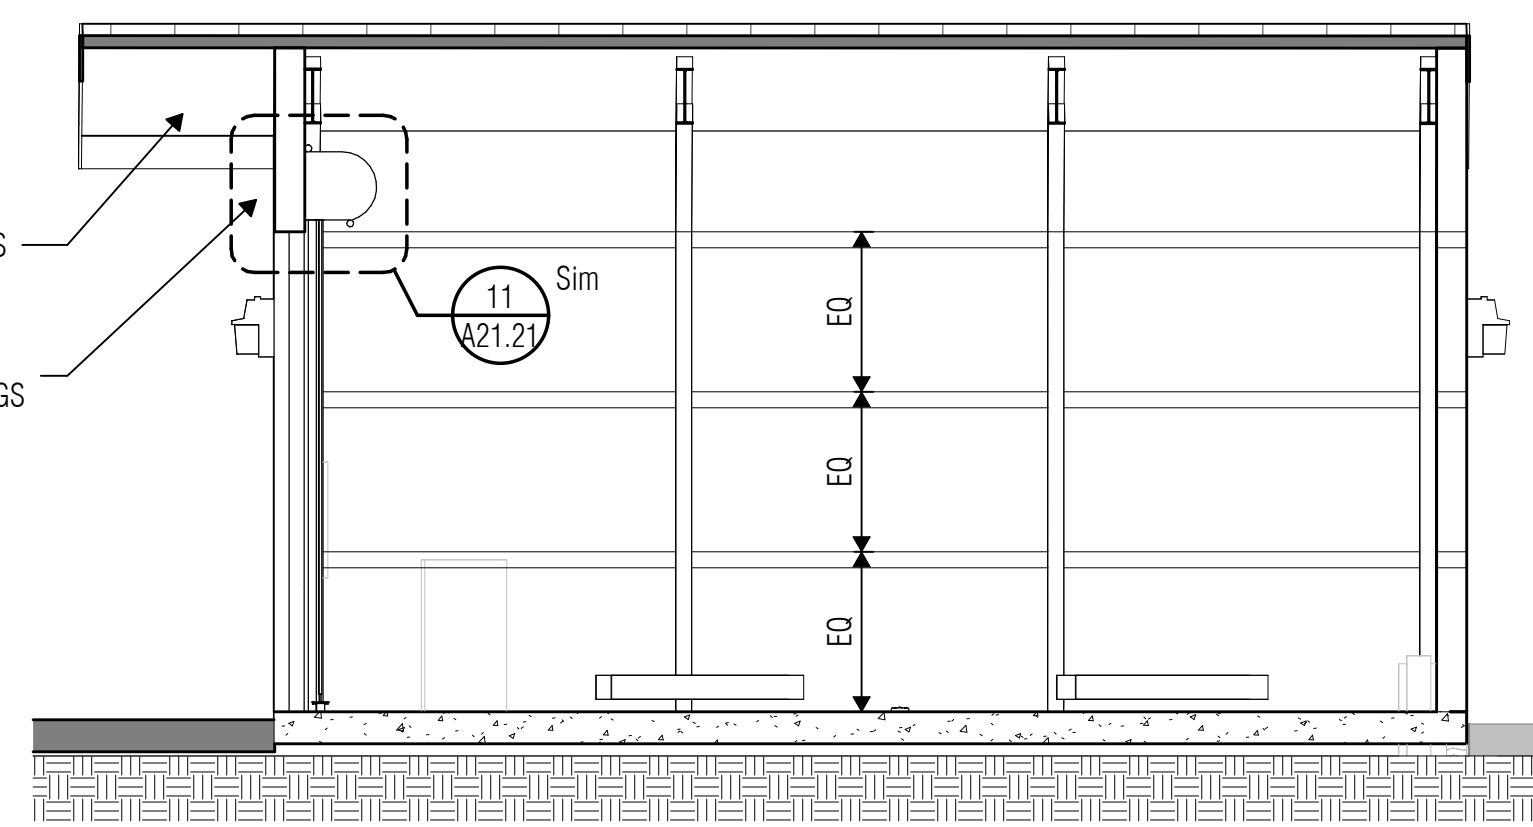


8 LABAY - ATHLETIC STORAGE SECTION
 SCALE: 1/4" = 1'-0"

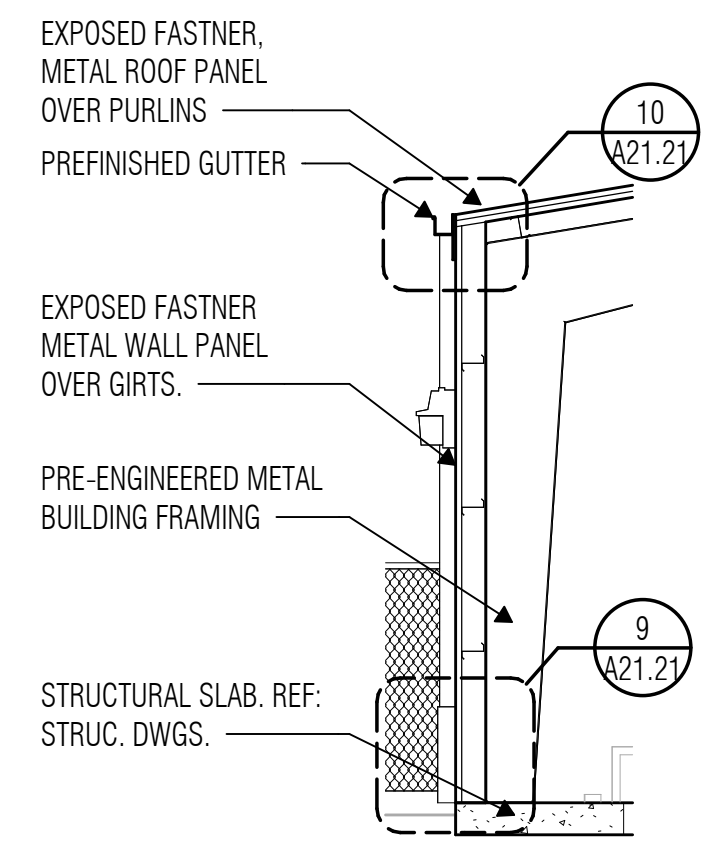


7 WALL SECTION
 SCALE: 1/4" = 1'-0"

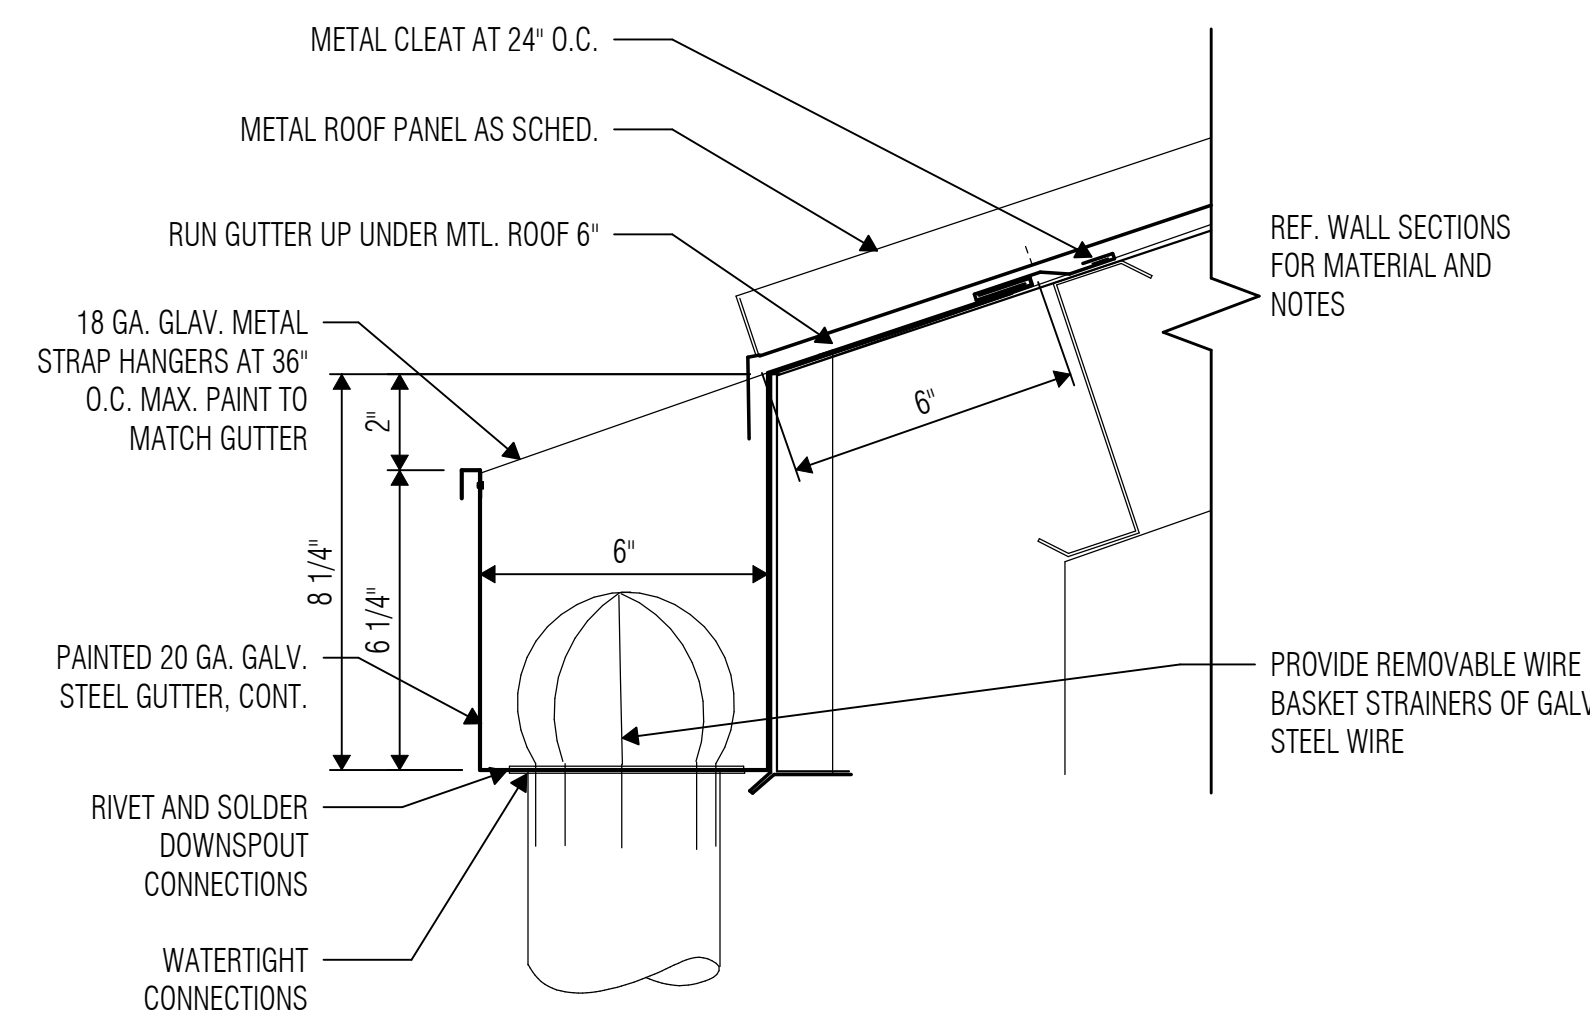


10 LABAY - GUTTER PREFINISHED METAL ROOF
 SCALE: 3" = 1'-0"

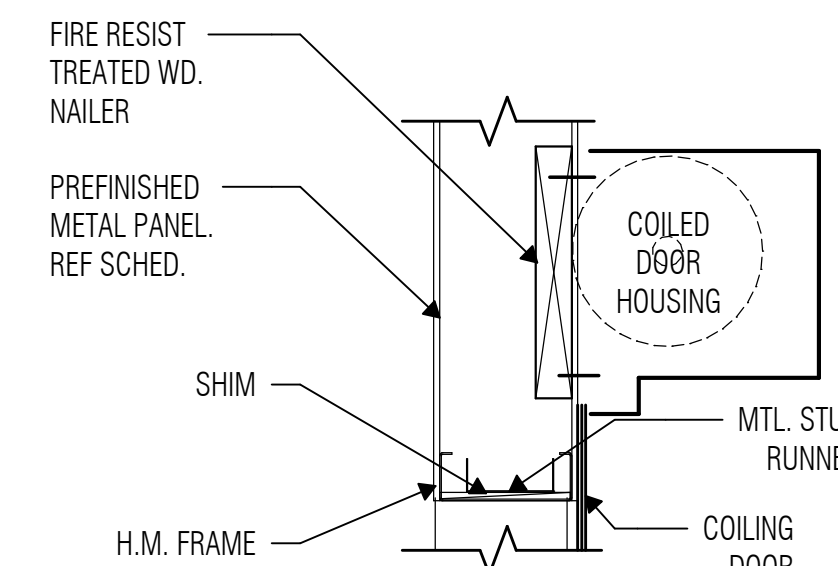

11 LABAY - HEAD DETAIL COILING DOOR
 SCALE: 1 1/2" = 1'-0"

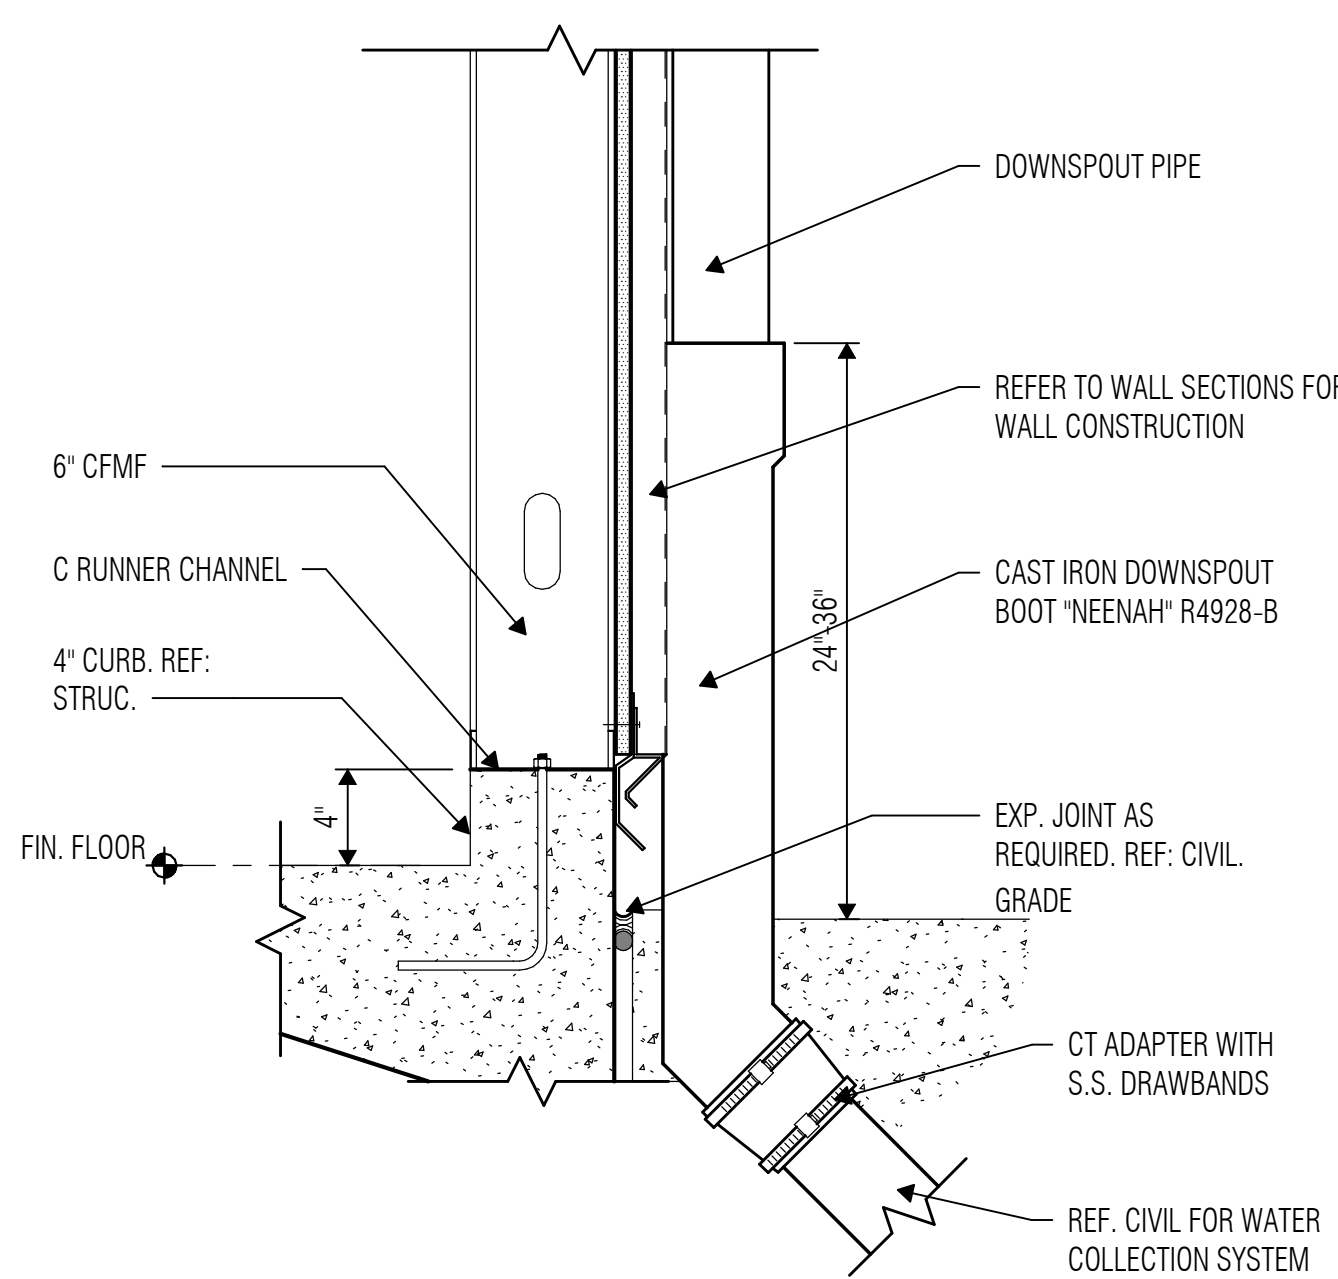

9 LABAY - STORAGE DOWNSPOUT BOOT
 SCALE: 1 1/2" = 1'-0"

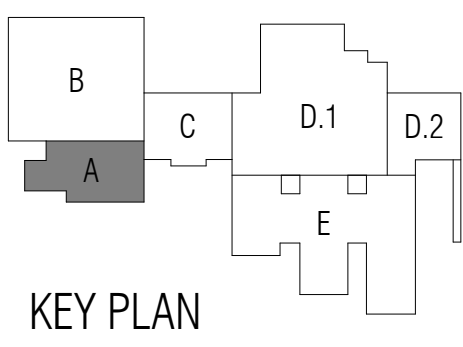

KEY PLAN



ISSUED: February 24, 2025

REVISIONS

Revision No.	Revision Date
1 Addendum 1	03-06-2025

Director Approver
 Designer
 Proj. Arch. Checker

Drawn By
 STH, KM
 Quality Control

PROJECT NO.

24-010.00

SHEET TITLE

LABAY - UNIT A
 DEMOLITION PLAN - LEVEL ONE

SHEET NO.

A22.01A

GENERAL DEMOLITION NOTES


- Drawings show the general extent of demolition work, however it is impractical to indicate or note every item of demolition. Any items shown dashed are to be removed to make way for new construction, unless noted otherwise. Contractor shall notify Architect of any discrepancies between demolition and construction drawings prior to demolition.
- Removal of any asbestos containing materials within the area of work shall be included in the Contractor's scope. Refer to asbestos abatement report and requirements.
- Contractor shall protect existing items to remain from damage throughout all phases of the project. Contractor shall repair, at no cost to the owner, any damages they incur on the existing building and site not scheduled for alteration, as a result of construction activities. Contractor shall provide video documentation of existing conditions prior to start of construction and provide video to Architect. Contractor to notify Architect if items shown as existing to remain need to be removed to make way for new work. Contractor is responsible for removing said items, unless noted otherwise, including but not limited to: furniture, equipment, shelving, fixtures, utilities, etc. Contractor shall carefully remove, protect, and reinstall items back to their original positions and make all original connections, when work in the affected area is complete. Any item damaged as a result of construction activity shall be replaced at Contractor's expense. This note shall apply to all areas with construction activity.
- Refer to Civil, MEPT, and Structural drawings for additional demolition scope.
- Patch/repair ceilings, walls, and flooring to match existing at all removed or demolished doors, windows, walls, millwork, lockers, and similar items. Refer to SECTION 01 36 13 for additional information regarding patch and repair.

DEMOLITION LEGEND

- == == ITEMS TO BE DEMOLISHED
- Existing to remain with limited or no architectural work required in this area. Refer to Civil, MEPT and Structural drawings for any additional work in area.
- Major architectural work required in this area.

KEYNOTE LEGEND

DD1	REMOVE AND PROPERLY DISPOSE OF DOOR, HARDWARE, AND FRAME. PREPARE AREA TO RECEIVE NEW CONSTRUCTION.
MD12	CAREFULLY REMOVE AND PROTECT ALL EXISTING BARREL SOUND DIFFUSERS WITHIN THIS ROOM AND RETURN TO OWNER.
MD19	CAREFULLY REMOVE STONE AND PROTECT ACOUSTIC PANELS. PREPARE AREA FOR NEW CONSTRUCTION.
WD1	CAREFULLY REMOVE AND PROPERLY DISPOSE OF WALLS SHOWN DASHED. CLEAN AND PREPARE AREA FOR NEW CONSTRUCTION. CAP AND ABANDON ALL EXISTING UTILITIES IN WALL. RE: MEP DRAWINGS FOR ADDITIONAL INFORMATION.

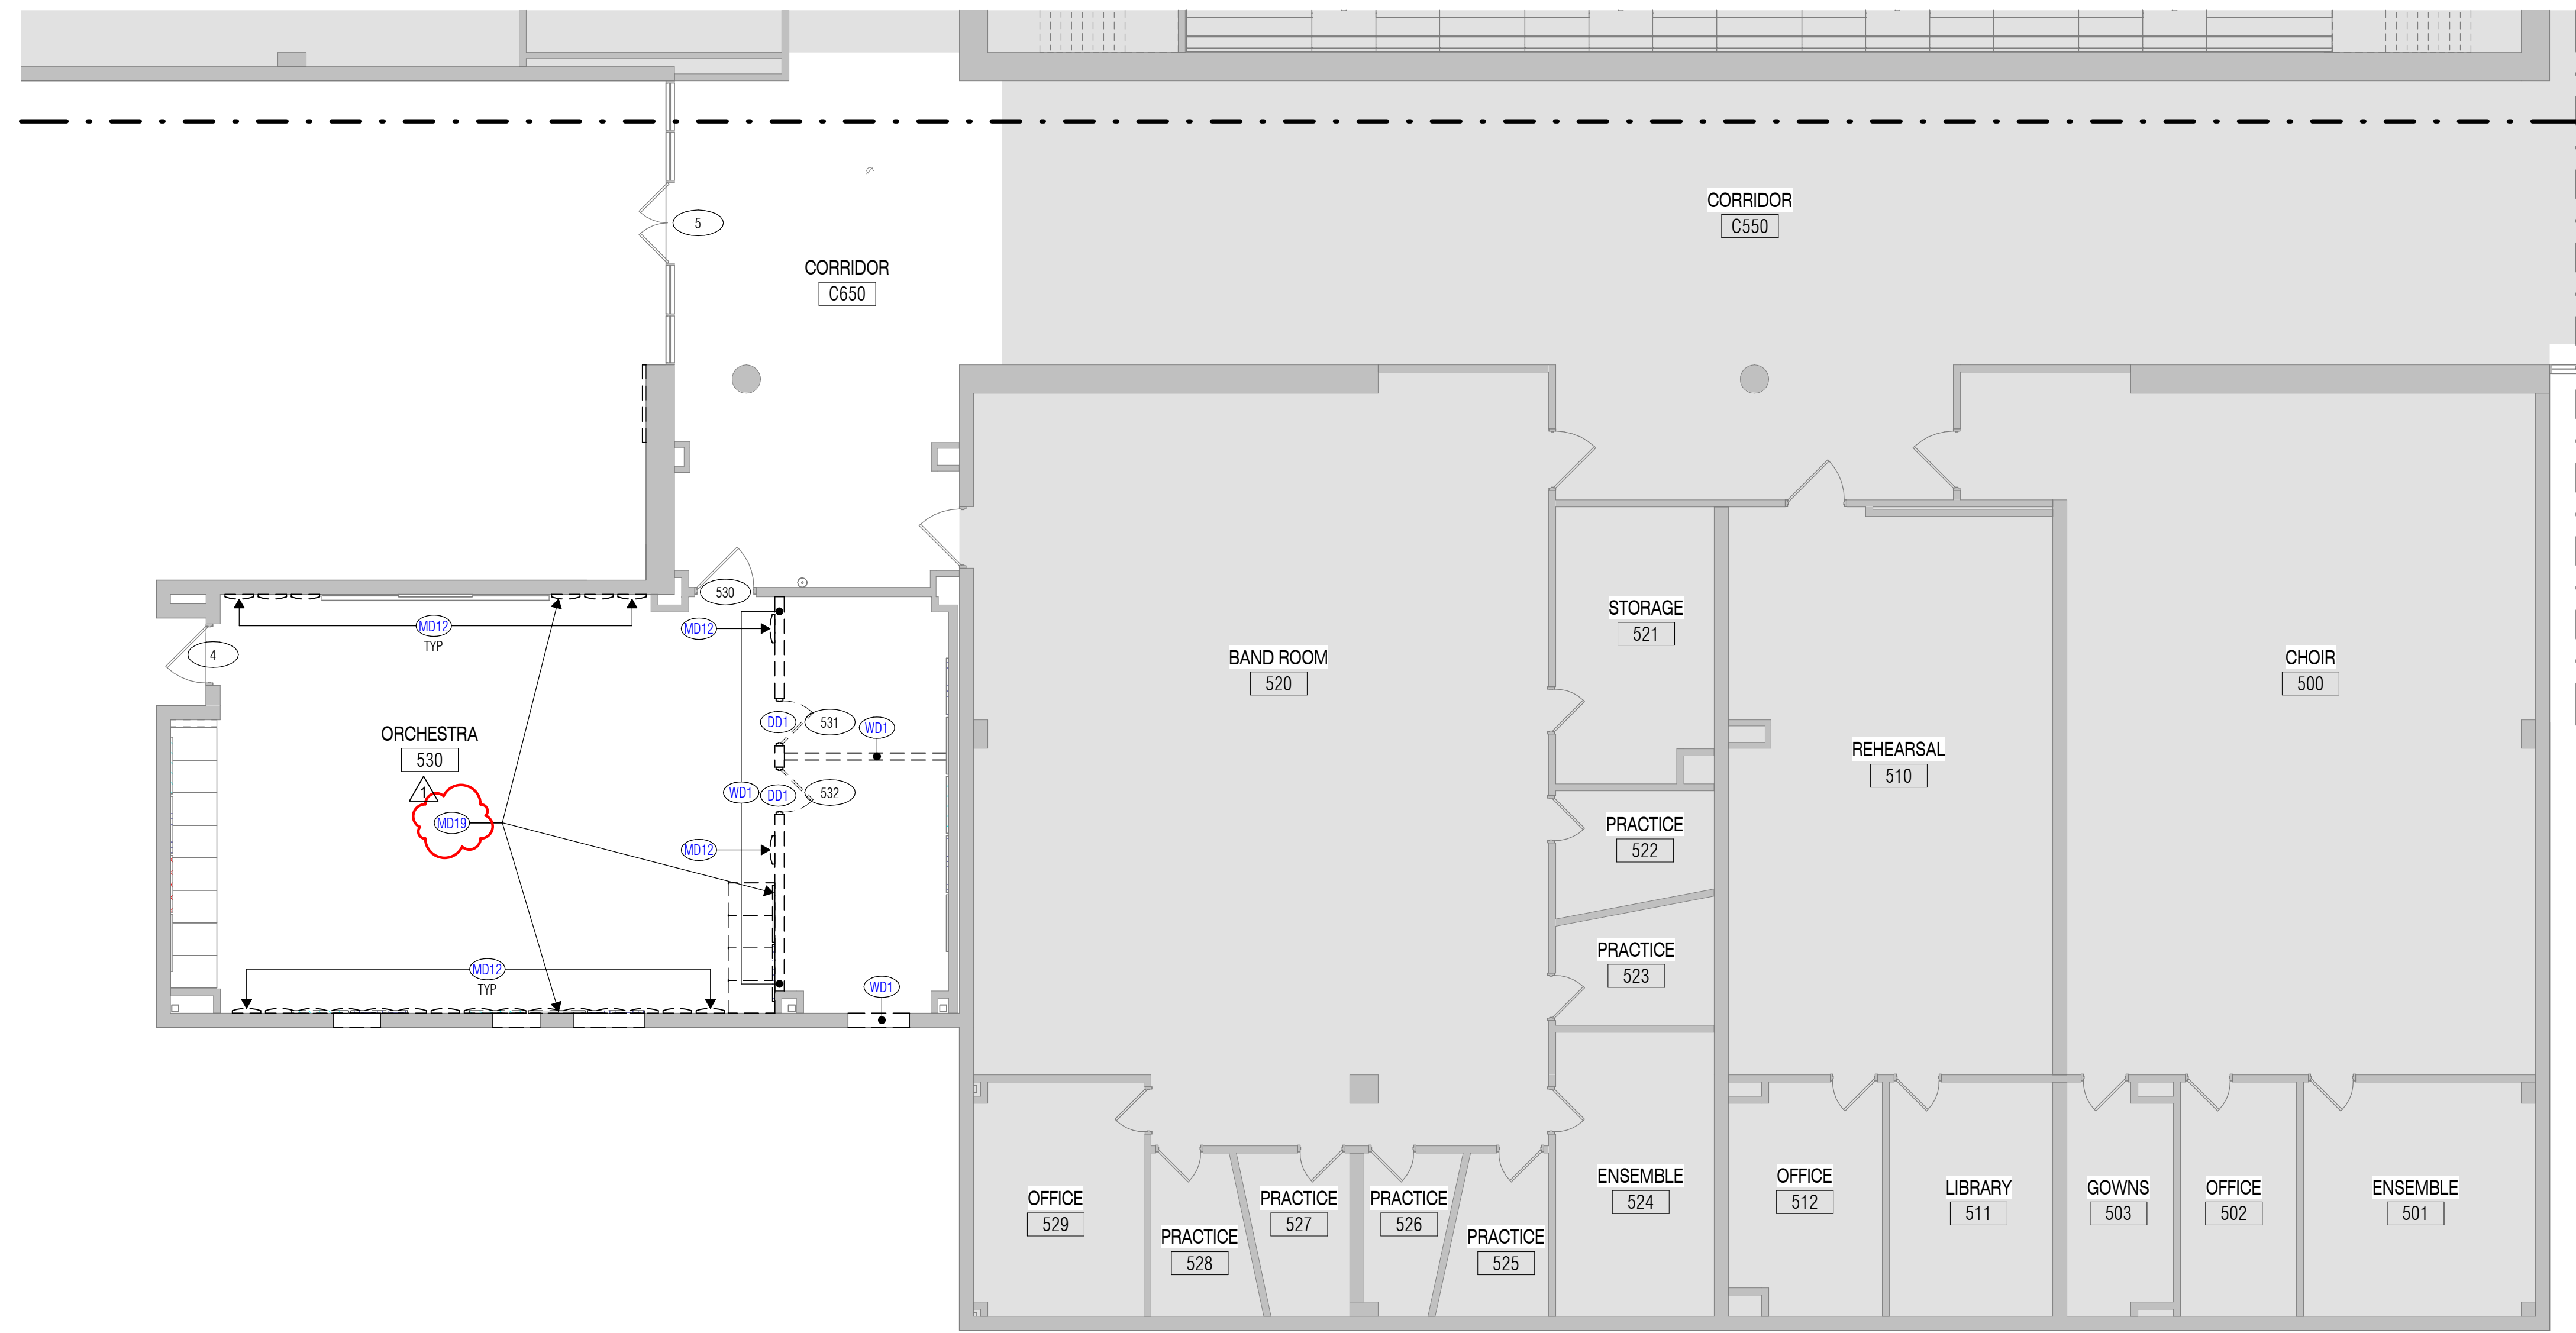

1 UNIT "A" DEMOLITION PLAN - LEVEL ONE
 SCALE: 1/8" = 1'-0"

FLOOR PLAN NOTES


- Refer to Civil Grading drawings for Primary Ground Level floor elevation relative to Mean Sea Level. Architectural Finish Floor (100'-0" datum) is equal to Civil FFE.
- Dimensions on Floor Plans are to face of stud or CMU unless noted otherwise.
- Coordinate the location of electrical devices with casework, millwork, lockers, etc. Any electrical device that is not properly coordinated shall be relocated at no additional cost.
- Exterior wall construction is identified on the Wall Sections. Refer to the A' 4-series sheets for Wall Sections, and to A14.30, A24.30, A34.30 for Exterior Wall Assemblies.
- Refer to Exterior Elevation Notes for control joint requirements at all inside corners of masonry veneer.
- Refer to PARTITION TYPES (A12.21, A22.21, A32.21) for Partition Types Legend.
- Interior partitions are Type "P6" unless noted otherwise.
- Refer to Detail 4/AO.31 for Typical Door Maneuvering Clearances. All new doors shall meet the requirements of that detail. If any door is found that does not comply with these requirements, request clarification from the Architect prior to construction.
- Refer to PARTITION DETAILS sheets for Typical Partition Penetration Details, including pipe, conduit and ductwork penetrations.
- Refer to PARTITION DETAILS sheets for Typical Bracing at Non-Loadbearing CMU Partitions.
- Refer to Exterior Elevations for exact locations of downspouts.
- Provide factory bullnose units at all interior exposed vertical edges of CMU, except at starter course with applied base material where square-edge units shall be provided in lieu of bullnose units.
- Provide 4" starter courses at all CMU walls and partitions unless noted otherwise.
- Provide steel or masonry lintels over all openings in CMU walls, including those required for mechanical ductwork and dampers, whether specifically indicated on the drawings or not.
- Provide minimum 20 gage light-gage steel studs at all interior partitions scheduled to receive ceramic tile or plaster.
- Provide minimum 18 gage cold-formed steel studs at all interior partitions scheduled to receive anchored masonry or stone veneer as well as interior partitions with steel plate or steel sheet X-bracing.
- Provide minimum 18 gage cold-formed steel studs as designed by stud engineer for all interior partitions scheduled to receive adhered masonry or stone veneer.
- At light-gage steel stud partitions that extend above the ceiling, provide diagonal 20 gage stud braces at 4'-0" o.c. to structure above (not to steel deck) as required to provide rigid anchorage and support of partitions.
- Provide minimum 2 X 6 fire-retardant treated wood blocking in both new and existing stud walls and partitions, at mounting locations for wall-mounted accessories, handrails, casework, markerboards, tackboards, folding partitions, toilet partitions, and all other wall-mounted items. Refer to CASEWORK ELEVATIONS & DETAILS sheets for typical blocking requirements at various conditions.
- At Mechanical, Electrical and Boiler Room partitions, seal tightly around all penetrations. Utilize fire safing material at rated partitions.
- Provide sealant and/or fire safing at all floor penetrations, as applicable.
- Existing equipment to remain U.N.O. Contractor to relocate equipment as needed to complete new construction. Contractor shall reinstall equipment upon completion of construction. All equipment to be in as good or better working condition as prior to the start of construction.

FLOOR PLAN LEGEND

- METAL STUD PARTITION. Extend 4" above highest ceiling plane and brace to structure above as noted in Floor Plan Notes. Refer to Reflected Ceiling Plan for fire, smoke and sound-conditioned partitions that extend to deck above.
 - CMU PARTITION. Extend 4" above highest ceiling plane and brace to structure above as detailed. Refer to Reflected Ceiling Plan for fire, smoke and sound-conditioned partitions that extend to deck above.
 - EXISTING WALL TO REMAIN.
 - MOVABLE METAL SHELVING. Depth and Width dimensions match that of this legend, unless otherwise noted.
 - FURNITURE, FIXTURE OR EQUIPMENT BY OWNER. Coordinate with adjacent electrical devices, casework, etc.
- | | |
|-----|---|
| MB | MARKERBOARD. Preceding number is length, in feet. |
| SL | WITH HALF STAFF LINES |
| TB | TACKBOARD. Preceding number is length, in feet. |
| TS | TACK STRIP. Preceding number is length, in feet. |
| IM | INTERACTIVE MARKERBOARD |
| EX | EXISTING |
| IFP | INTERACTIVE FLAT PANEL |
| FEC | FIRE EXTINGUISHER WITH CABINET AND BRACKET |
| FE | FIRE EXTINGUISHER WITH BRACKET |
| FHC | FIRE HOSE CABINET |
| HB | HORIZONTAL BLINDS |
| RS | ROLLING WINDOW SHADES |
| DS | DOWNSPOUT |

KEYNOTE LEGEND

- F2 CONTINUE CURB AROUND MECH ROOM DOOR. SIZE OF CURB TO MATCH ADJACENT PARTITION CURB. RE: STRUC.
- R10 WALL-MOUNTED ROOF LADDER WITH SAFETY POST.

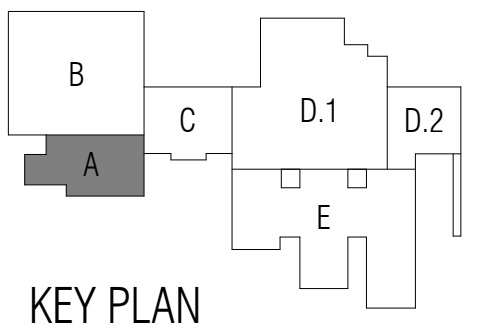

KEY PLAN



ISSUED: February 24, 2025

REVISIONS

Revision No.	Revision Date
1	Addendum 1 03-06-2025

Director Drawn By
RSJ STH, KM
Designer Quality Control

Proj. Arch.
TQ

PROJECT NO.


24-010.00

SHEET TITLE


LABAY - UNIT A FLOOR PLAN - LEVEL ONE

SHEET NO.


A22.11A

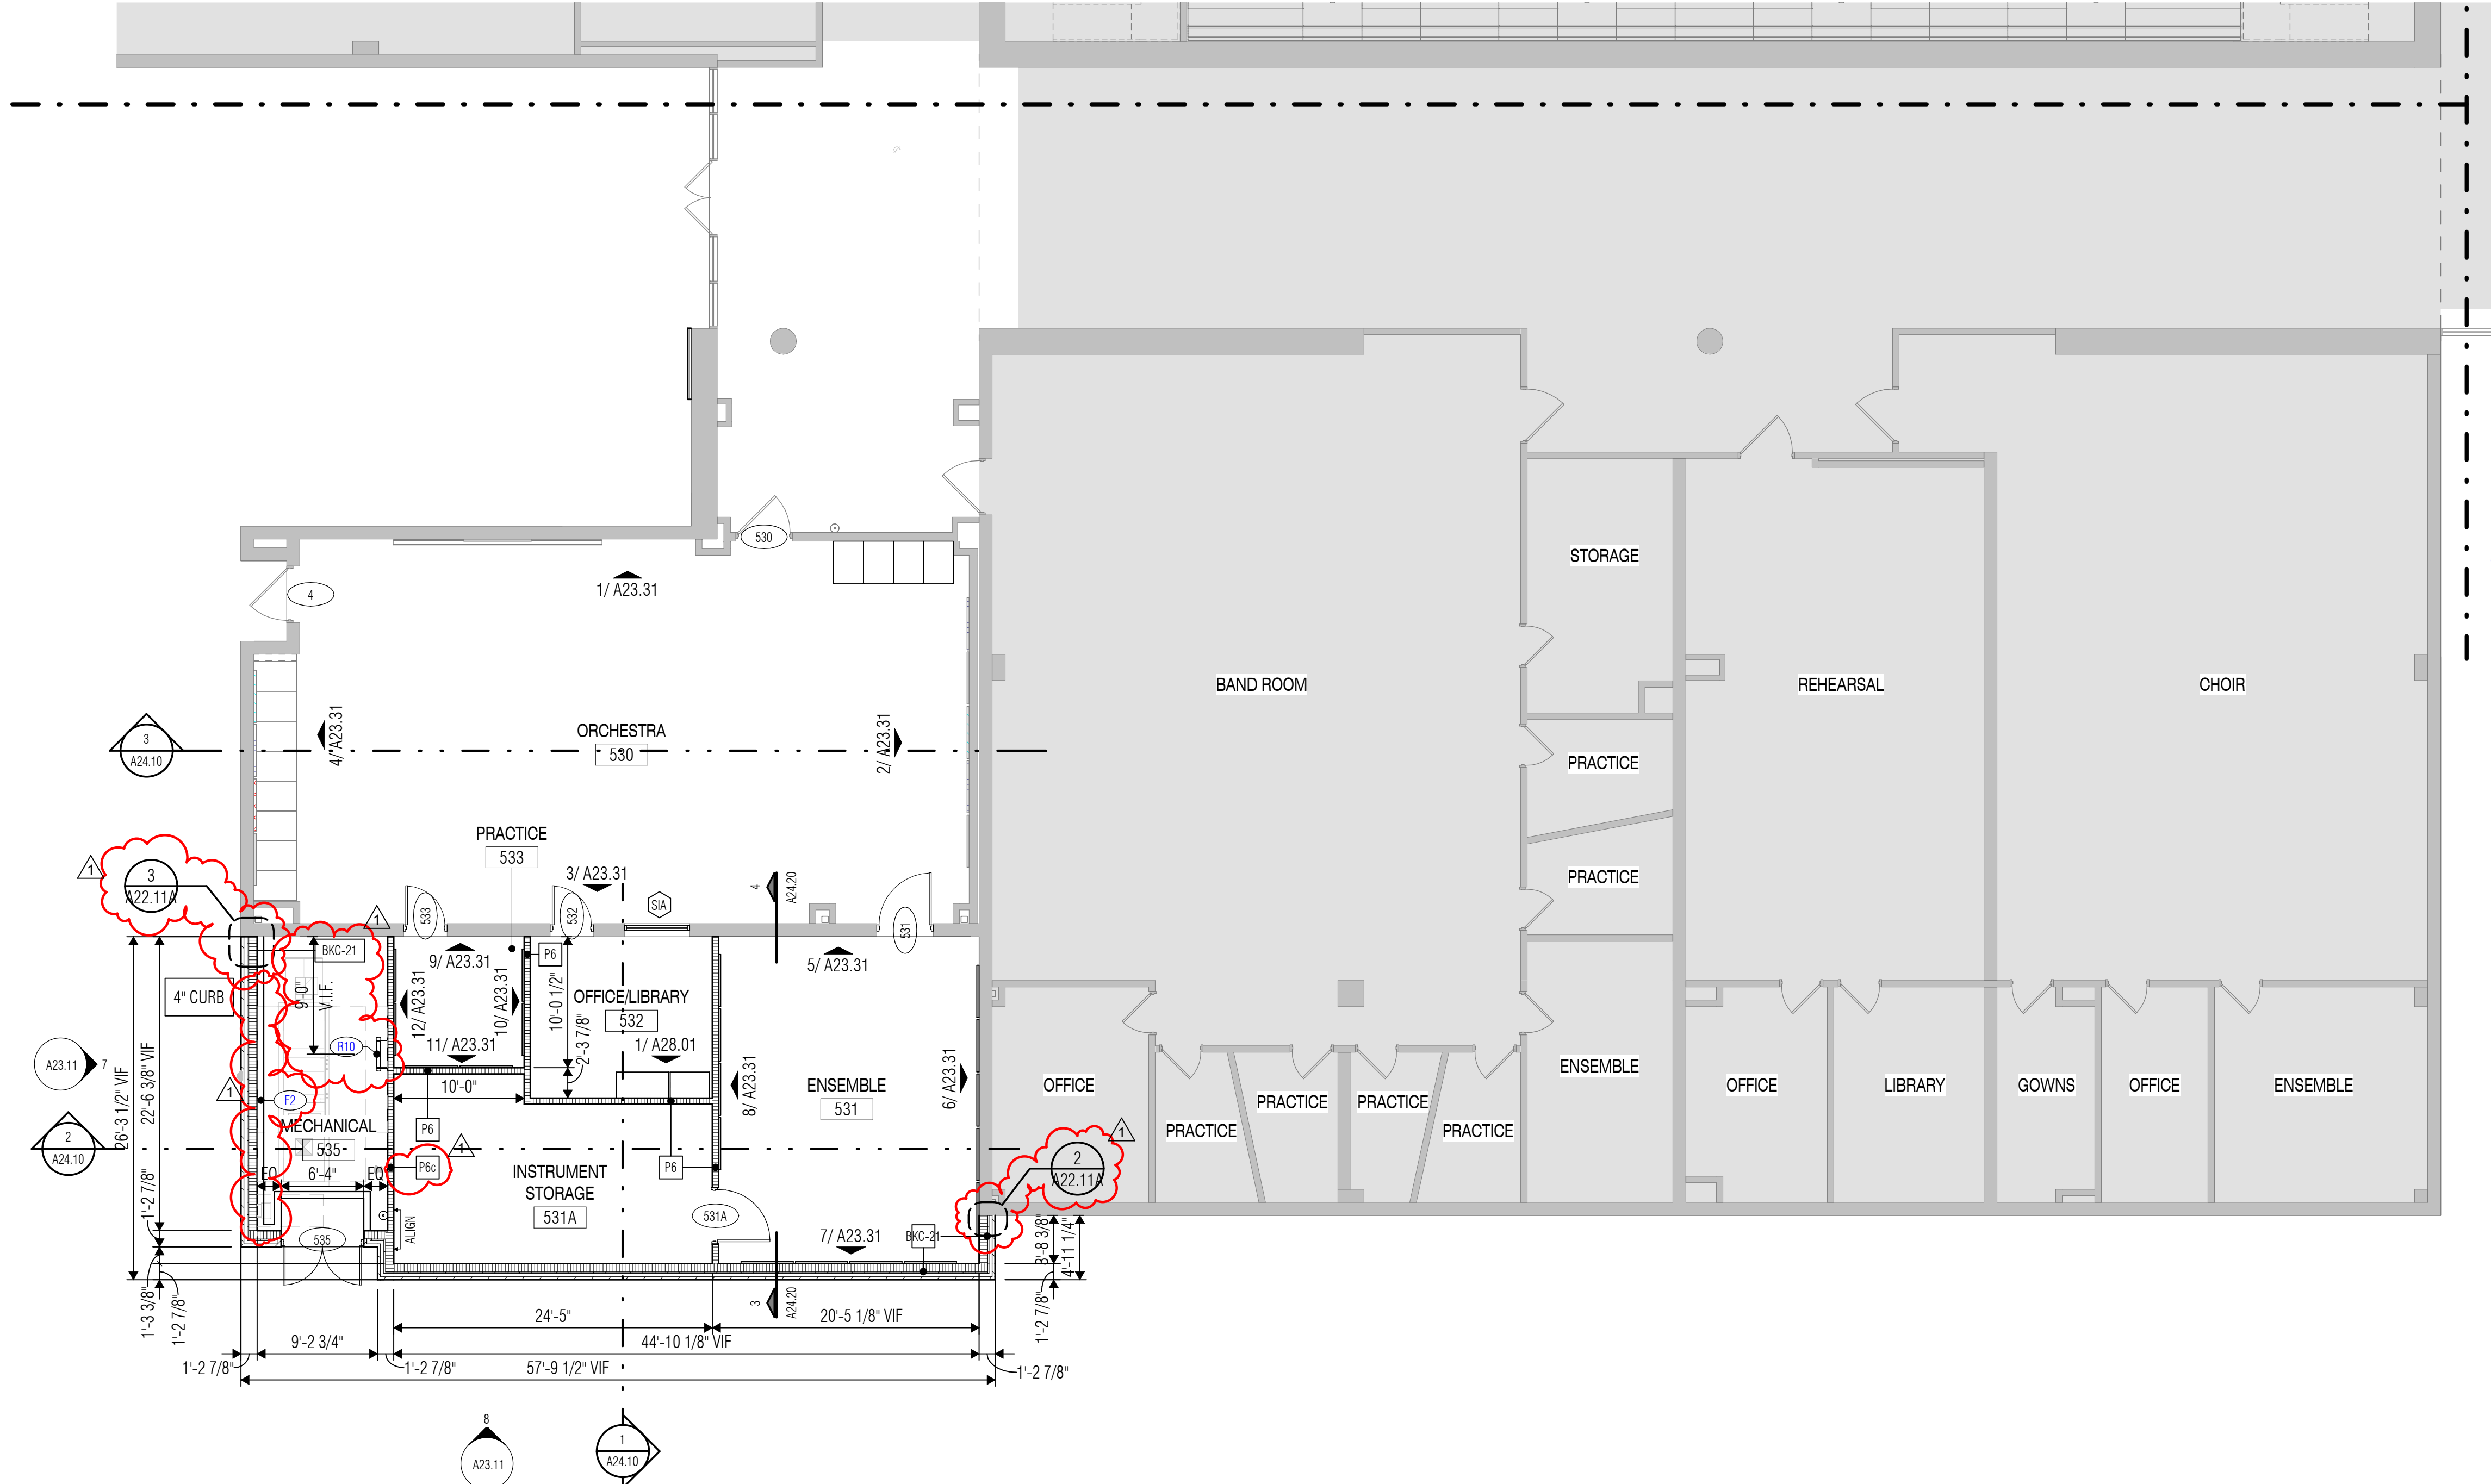


1 UNIT "A" PLAN - LEVEL ONE
SCALE: 1/8" = 1'-0"

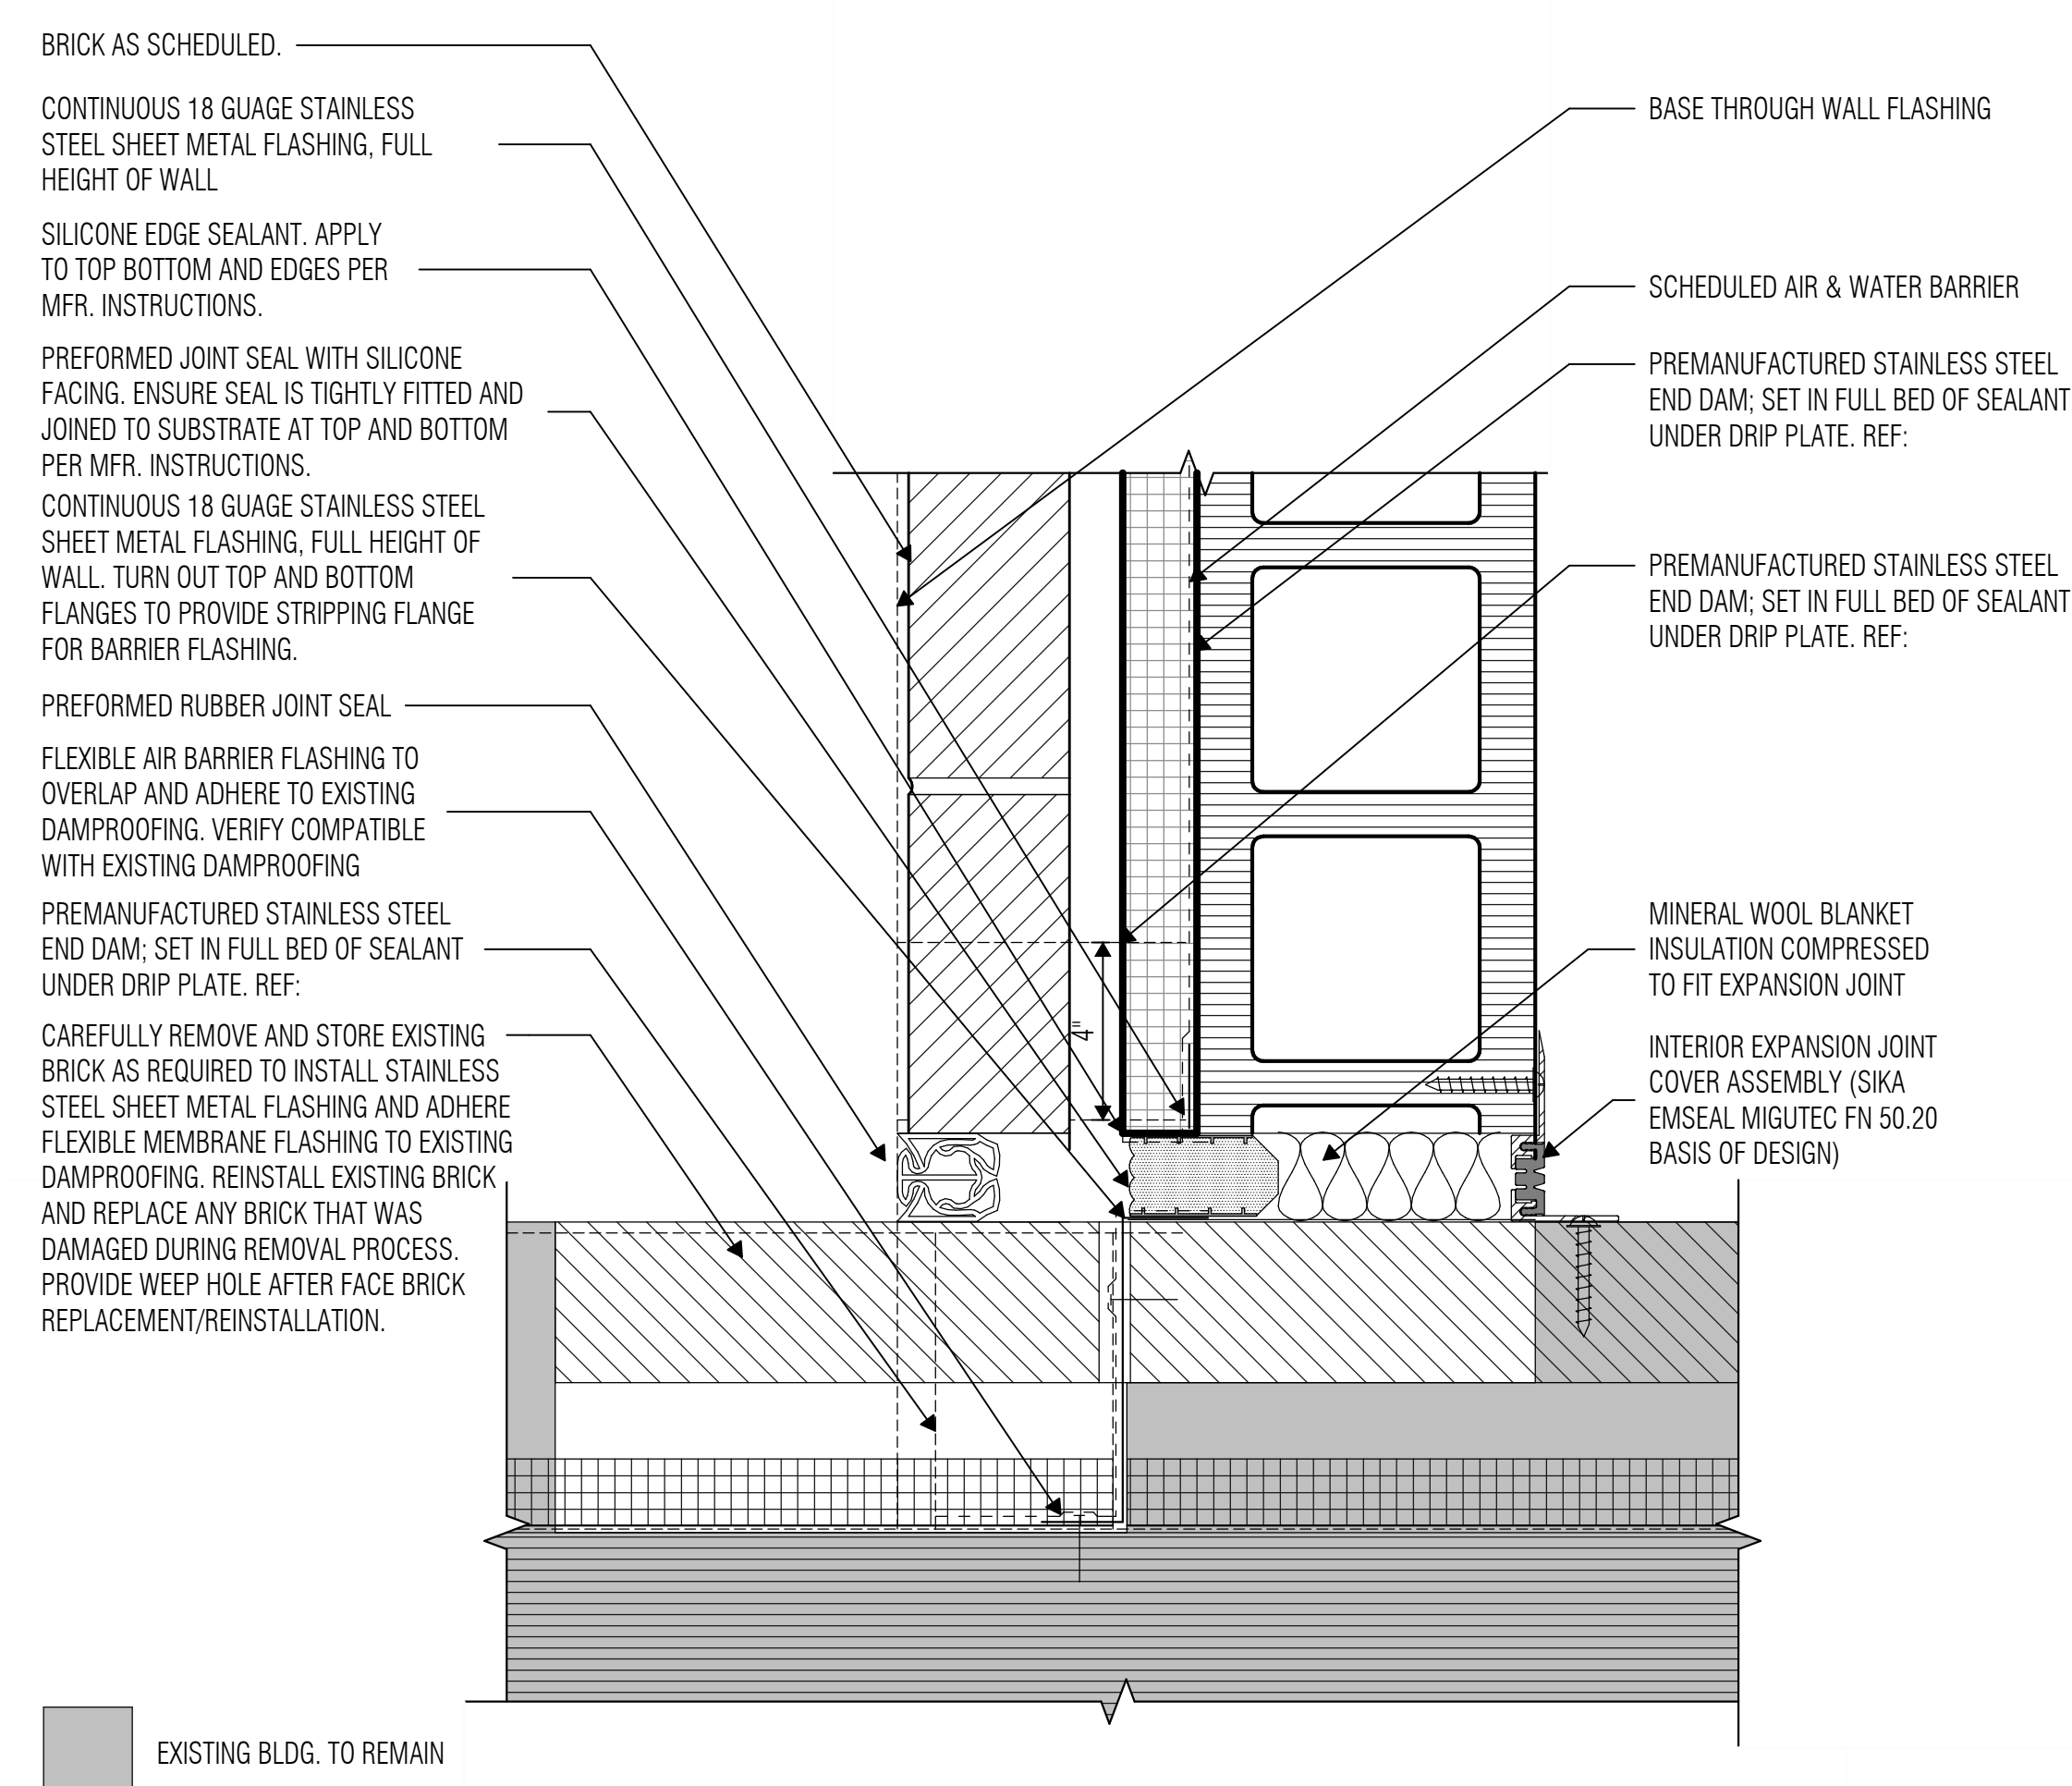

2 LABAY EXPANSION JOINT @ EXTERIOR WALL TYP.
SCALE: 3" = 1'-0"

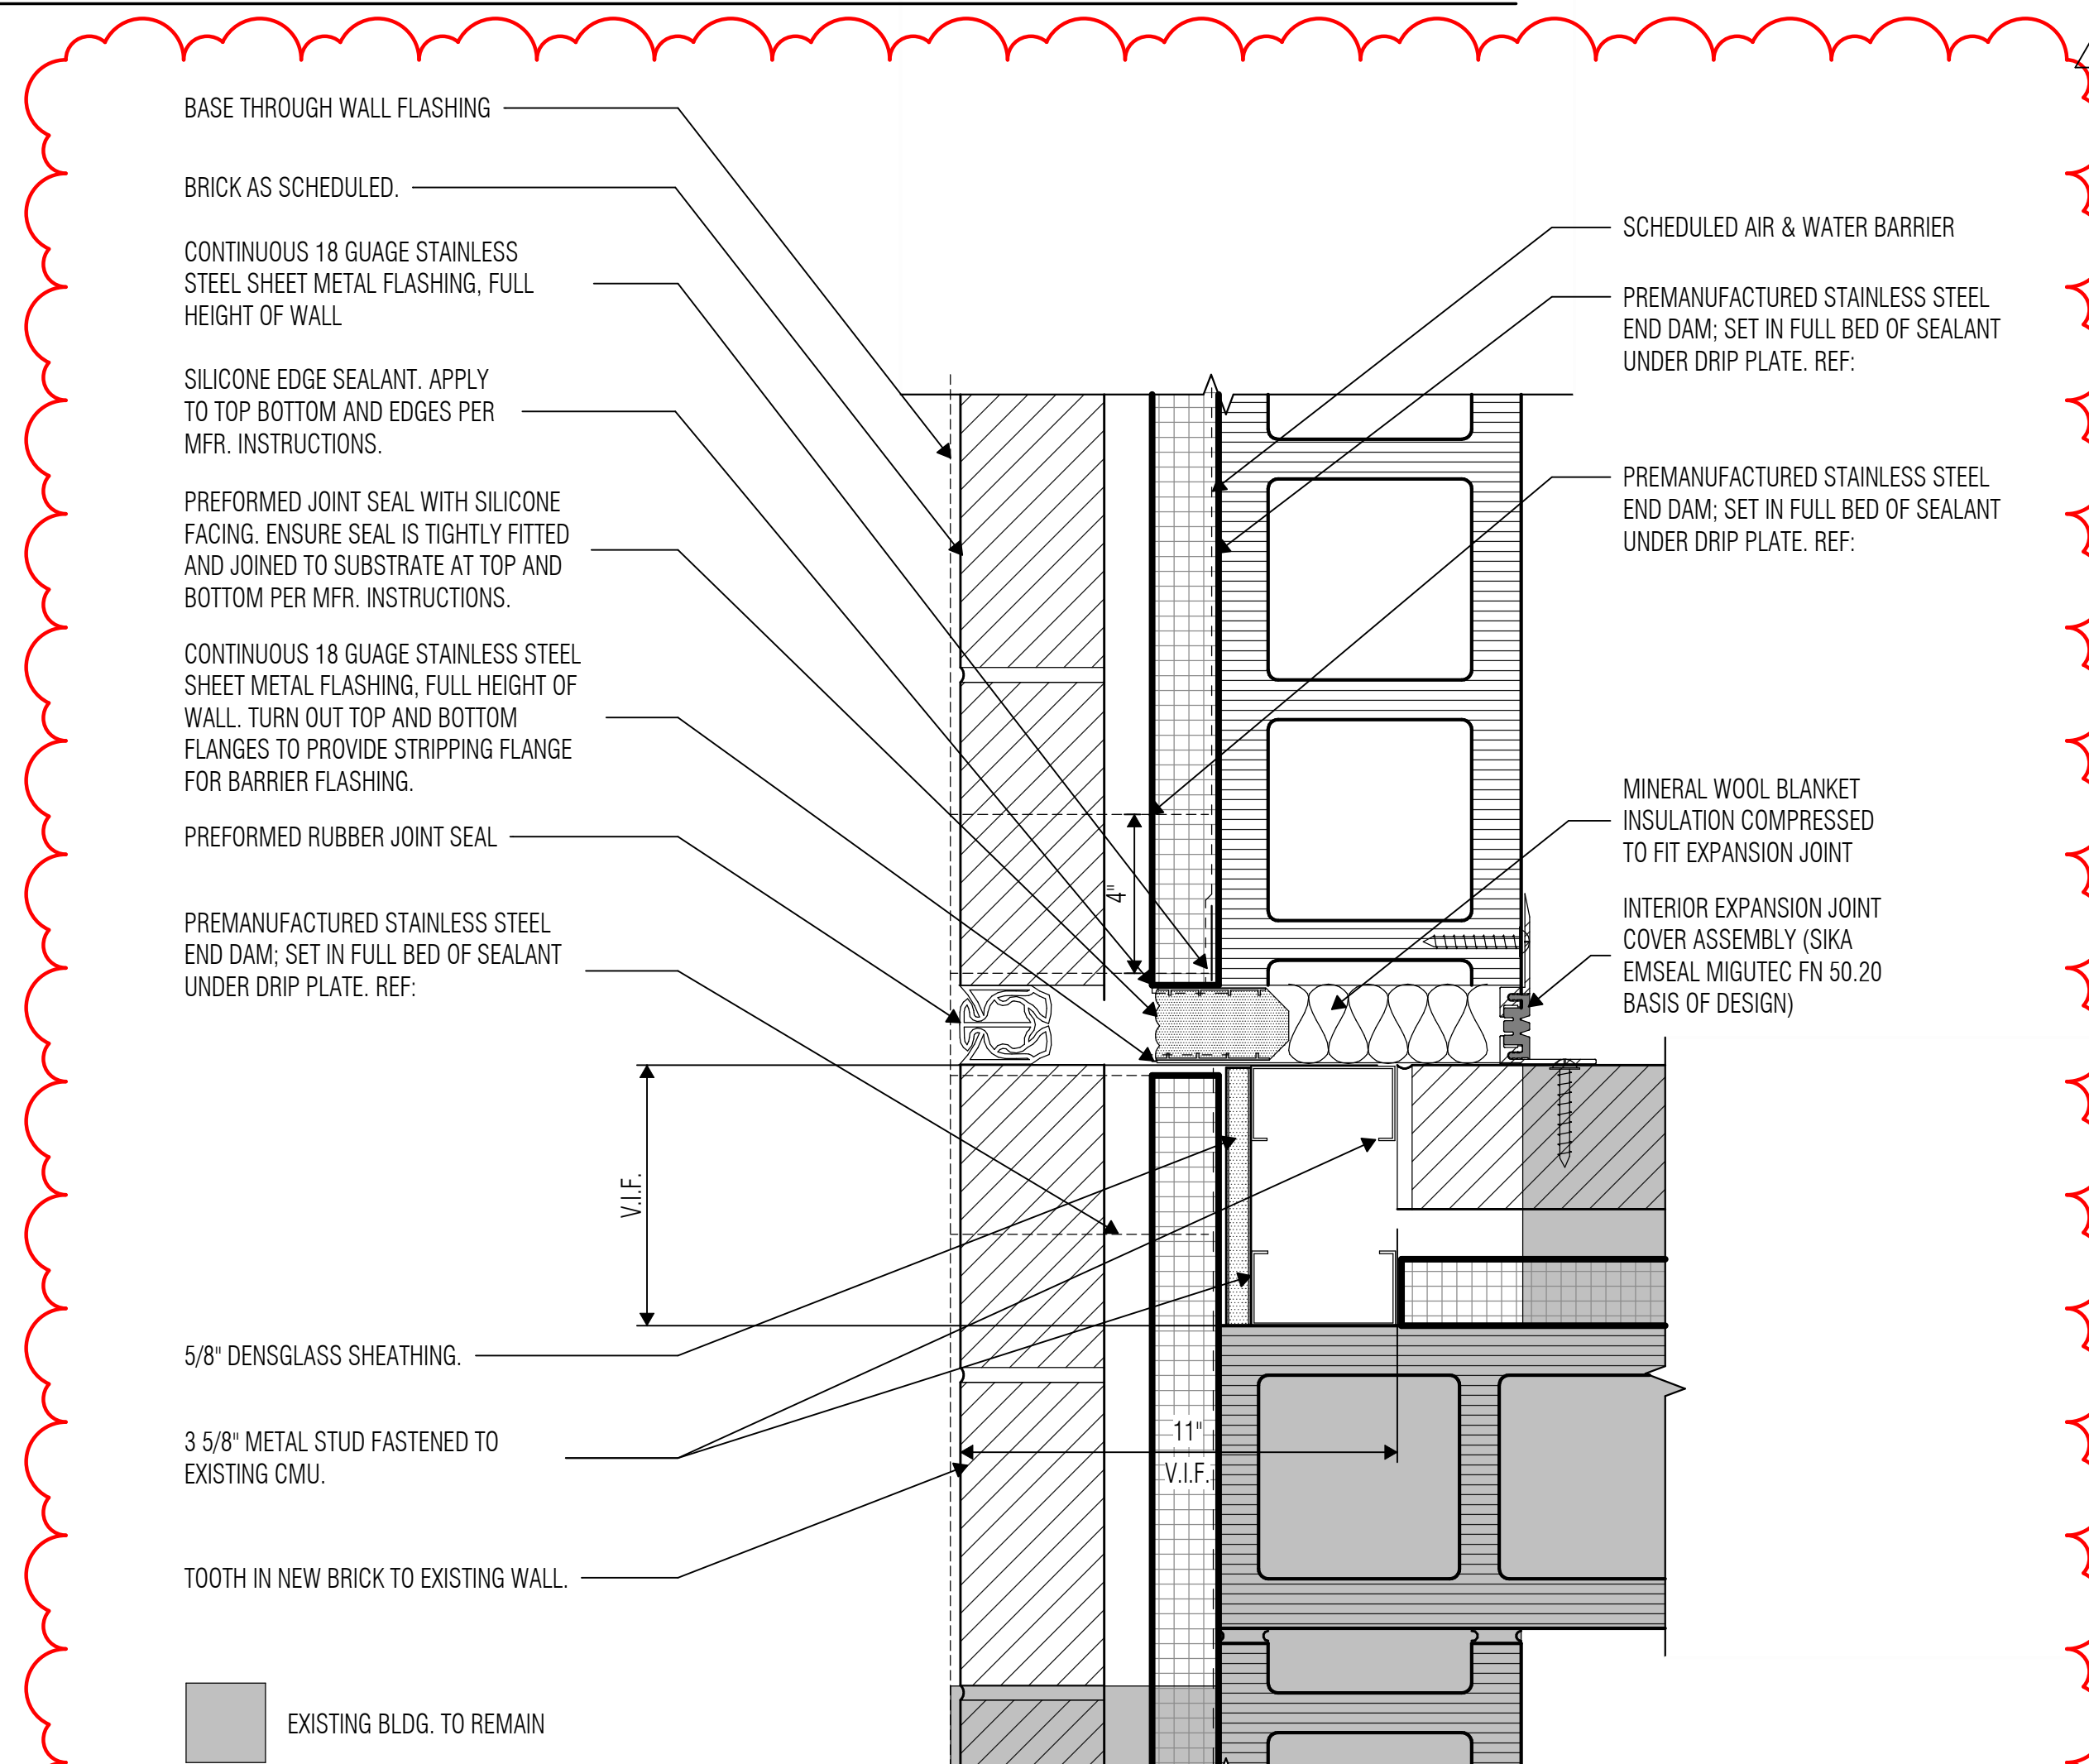

3 LABAY EXPANSION JOINT @ EXTERIOR WALL
SCALE: 3" = 1'-0"

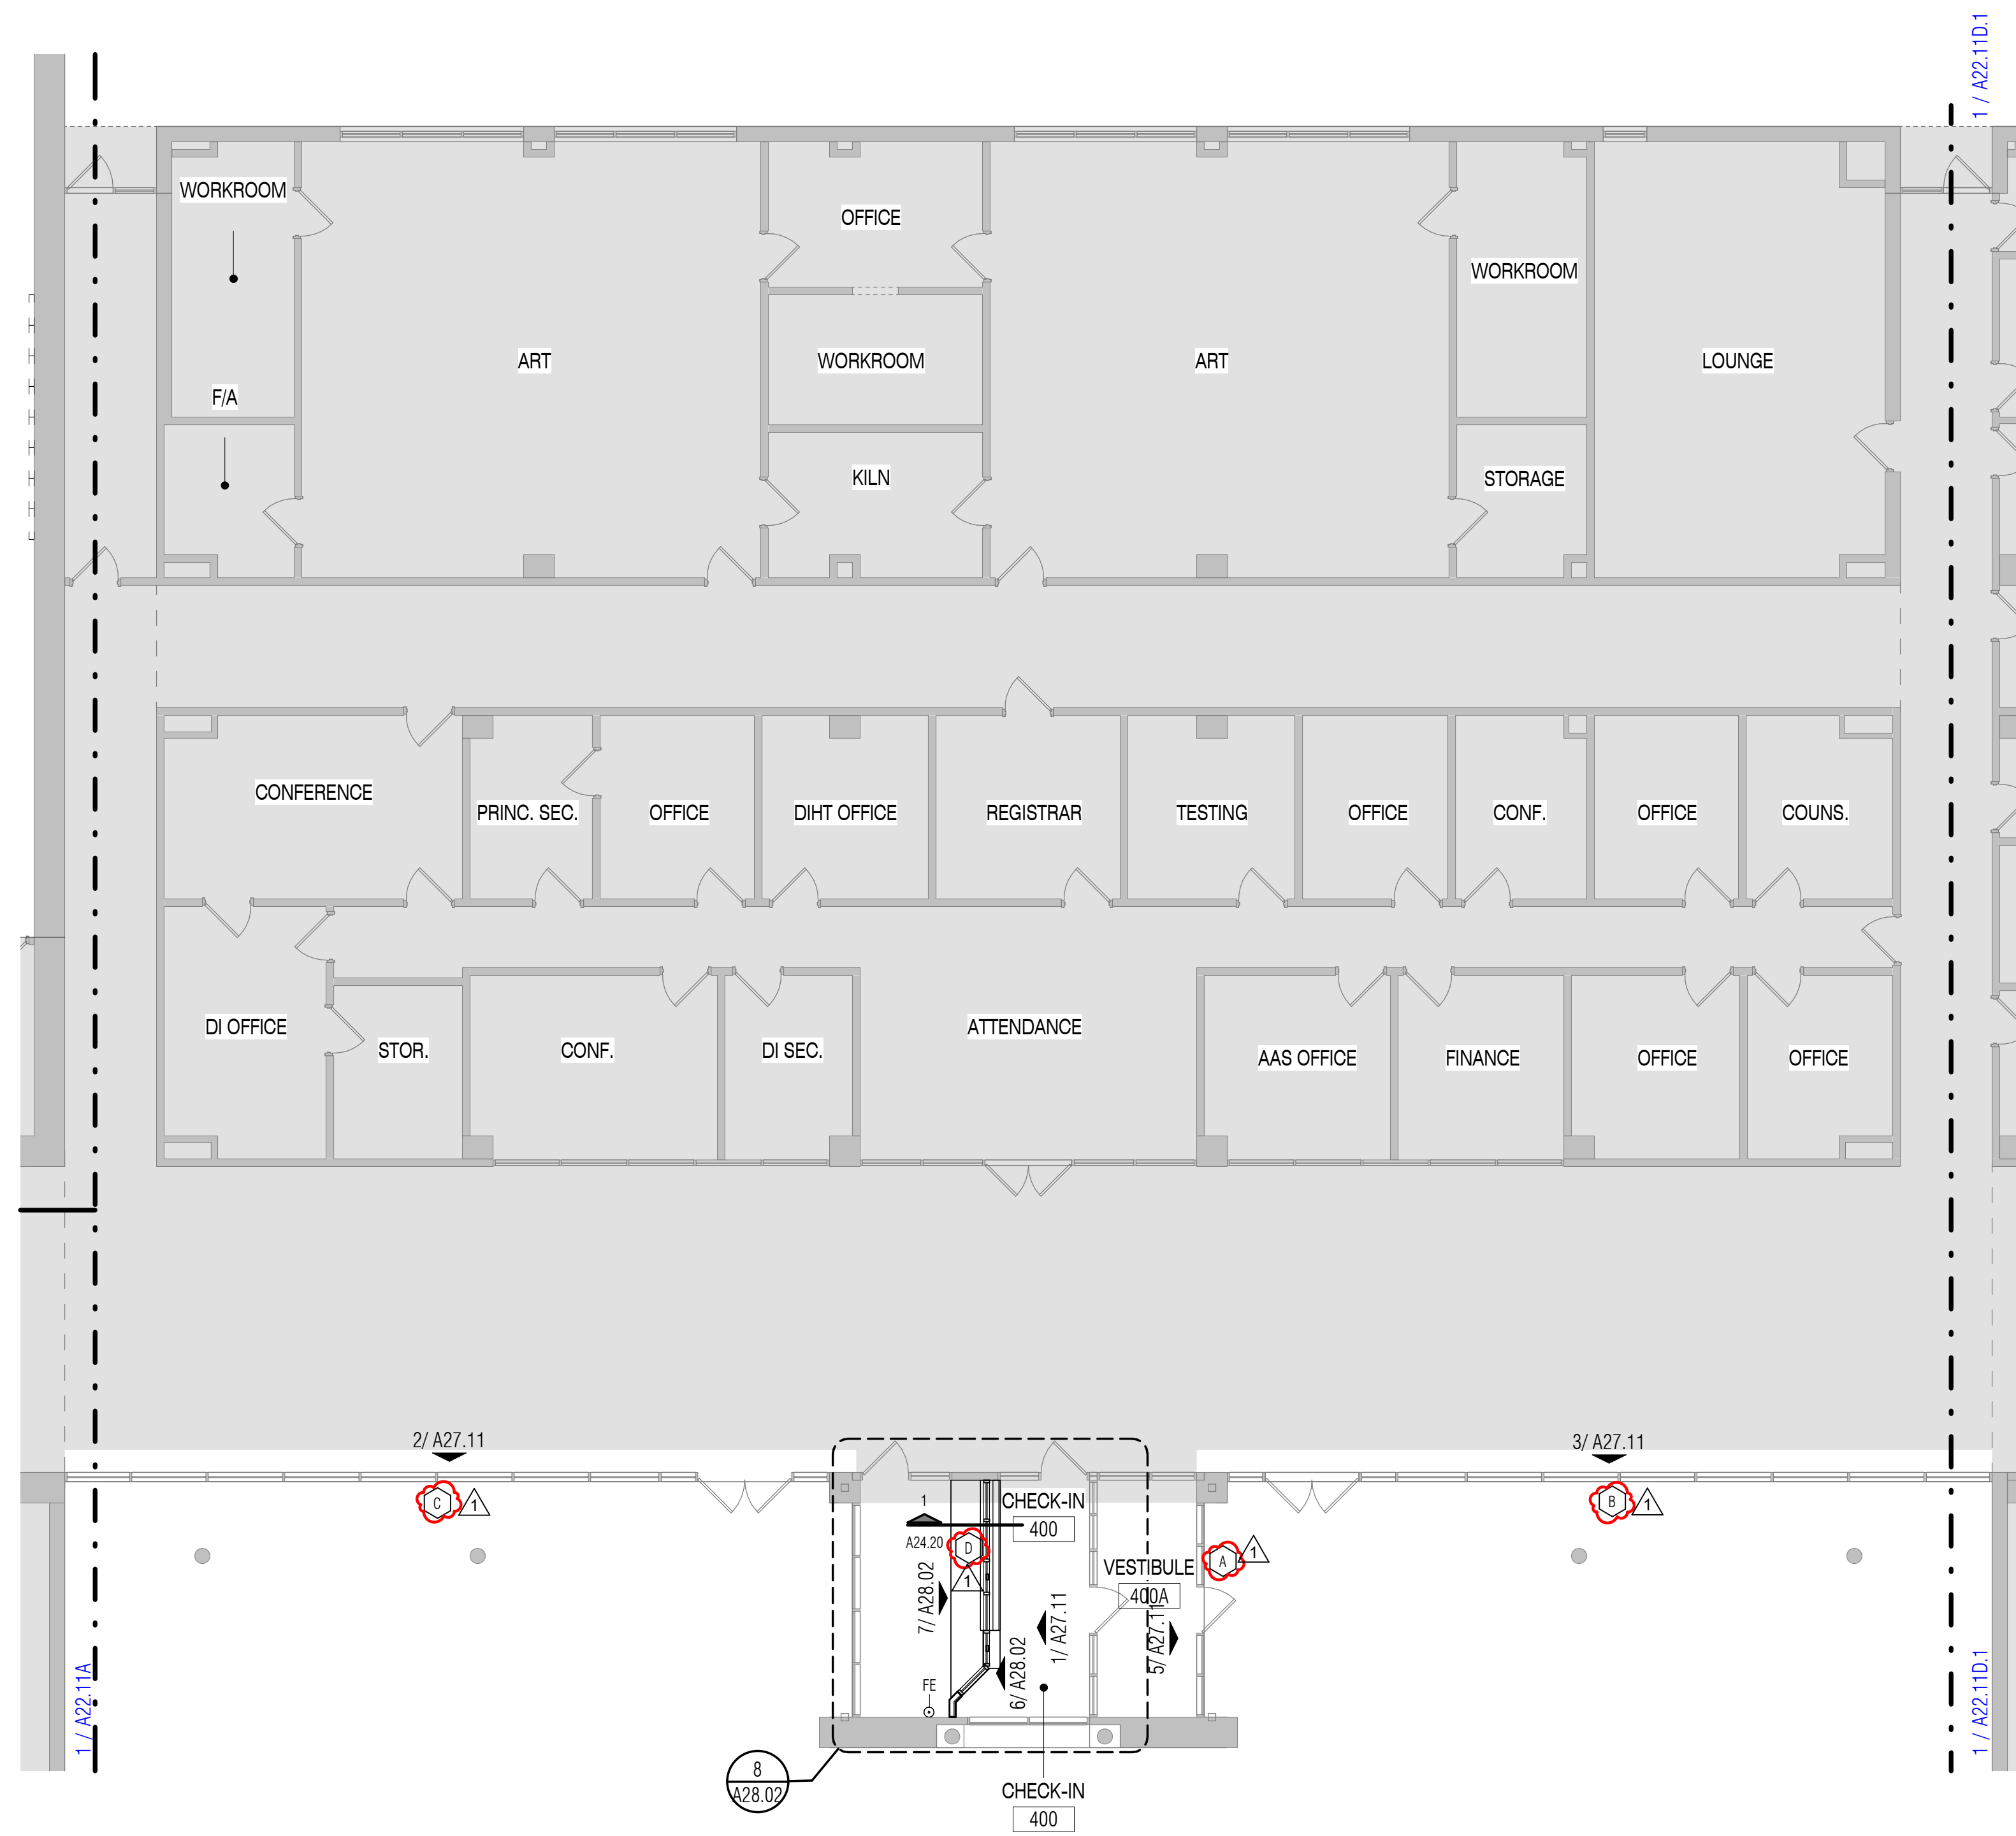

1 UNIT "C" PLAN - LEVEL ONE
SCALE: 1/8" = 1'-0"

FLOOR PLAN NOTES


- Refer to Civil Grading drawings for Primary Ground Level floor elevation relative to Mean Sea Level. Architectural Finish Floor (100'-0" datum) is equal to Civil FFE.
- Dimensions on Floor Plans are to face of stud or CMU unless noted otherwise.
- Coordinate the location of electrical devices with casework, millwork, lockers, etc. Any electrical device that is not properly coordinated shall be relocated at no additional cost.
- Exterior wall construction is identified on the Wall Sections. Refer to the A' 4-series sheets for Wall Sections, and to A14.30, A24.30, A34.30 for Exterior Wall Assemblies.
- Refer to Exterior Elevation Notes for control joint requirements at all inside corners of masonry veneer.
- Refer to PARTITION TYPES (A12.21, A22.21, A32.21) for Partition Types Legend.
- Interior partitions are Type "P6" unless noted otherwise.
- Refer to Detail 4/A0.31 for Typical Door Maneuvering Clearances. All new doors shall meet the requirements of that detail. If any door is found that does not comply with these requirements, request clarification from the Architect prior to construction.
- Refer to PARTITION DETAILS sheets for Typical Partition Penetration Details, including pipe, conduit and ductwork penetrations.
- Refer to PARTITION DETAILS sheets for Typical Bracing at Non-Loadbearing CMU Partitions.
- Refer to Exterior Elevations for exact locations of downspouts.
- Provide factory bullnose units at all interior exposed vertical edges of CMU, except at starter course with applied base material where square-edge units shall be provided in lieu of bullnose units.
- Provide 4" starter courses at all CMU walls and partitions unless noted otherwise.
- Provide steel or masonry lintels over all openings in CMU walls, including those required for mechanical ductwork and dampers, whether specifically indicated on the drawings or not.
- Provide minimum 20 gage light-gage steel studs at all interior partitions scheduled to receive ceramic tile or plaster.
- Provide minimum 18 gage cold-formed steel studs at all interior partitions scheduled to receive anchored masonry or stone veneer as well as interior partitions with steel plate or steel sheet X-bracing.
- Provide minimum 18 gage cold-formed steel studs as designed by stud engineer for all interior partitions scheduled to receive adhered masonry or stone veneer.
- At light-gage steel stud partitions that extend above the ceiling, provide diagonal 20 gage stud braces at 4'-0" o.c. to structure above (not to steel deck) as required to provide rigid anchorage and support of partitions.
- Provide minimum 2 X 6 fire-retardant treated wood blocking in both new and existing stud walls and partitions, at mounting locations for wall-mounted accessories, handrails, casework, markerboards, tackboards, folding partitions, toilet partitions, and all other wall-mounted items. Refer to CASEWORK ELEVATIONS & DETAILS sheets for typical blocking requirements at various conditions.
- At Mechanical, Electrical and Boiler Room partitions, seal tightly around all penetrations. Utilize fire safing material at rated partitions, as applicable.
- Provide sealant and/or fire safing at all floor penetrations, as applicable.
- Existing equipment to remain U.N.O. Contractor to relocate equipment as needed to complete new construction. Contractor shall reinstall equipment upon completion of construction. All equipment to be in as good or better working condition as prior to the start of construction.

FLOOR PLAN LEGEND

- METAL STUD PARTITION. Extend 4" above highest ceiling plane and brace to structure above as noted in Floor Plan Notes. Refer to Reflected Ceiling Plan for fire, smoke and sound-conditioned partitions that extend to deck above.
- CMU PARTITION. Extend 4" above highest ceiling plane and brace to structure above as detailed. Refer to Reflected Ceiling Plan for fire, smoke and sound-conditioned partitions that extend to deck above.
- EXISTING WALL TO REMAIN.
- MOVEABLE METAL SHELVING. Depth and Width dimensions match that of this legend, unless otherwise noted.
- FURNITURE, FIXTURE OR EQUIPMENT BY OWNER. Coordinate with adjacent electrical devices, casework, etc.
- MB MARKERBOARD. Preceding number is length, in feet.
- SL WITH HALF STAFF LINES
- TB TACKBOARD. Preceding number is length, in feet.
- TS TACK STRIP. Preceding number is length, in feet.
- IM INTERACTIVE MARKERBOARD
- EX EXISTING
- IFF INTERACTIVE FLAT PANEL
- FEC FIRE EXTINGUISHER WITH CABINET AND BRACKET
- FE FIRE EXTINGUISHER WITH BRACKET
- FHC FIRE HOSE CABINET
- HB HORIZONTAL BLINDS
- RS ROLLING WINDOW SHADES
- DS DOWNSPOUT



ARCHITECT
VLK Architects
 20445 State Hwy 249, Suite 350
 Houston, Texas 77070
 Main Phone: 281.671.2300
 www.vlkarchitects.com

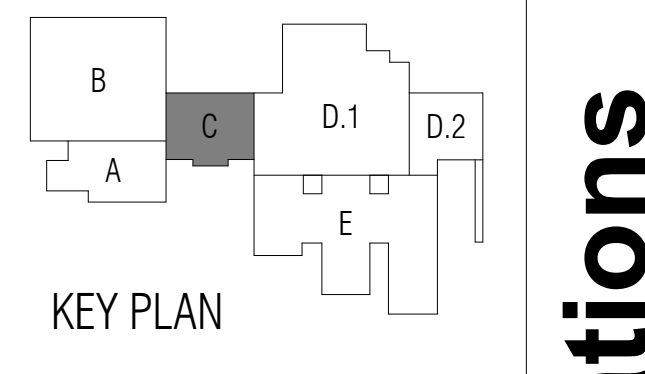

ISSUED: February 24, 2025

Revision No.	Revision Date
1 Addendum 1	03-06-2025

Director: RSJ
 Designer: TQ
 Drawn By: STH, KM
 Quality Control: Quality Control

Proj. Arch.: TQ
 PROJECT NO.: 24-010.00
 SHEET TITLE: LABAY - UNIT C FLOOR PLAN - LEVEL ONE
 SHEET NO.:

A22.11C

2024 Cook, Labay & Truitt MS Renovations

CYPRESS-FAIRBANKS INDEPENDENT SCHOOL DISTRICT HOUSTON, TEXAS

FLOOR PLAN NOTES

- Refer to Civil Grading drawings for Primary Ground Level floor elevation relative to Mean Sea Level. Architectural Finish Floor (100'-0" datum) is equal to Civil FFE.
- Dimensions on Floor Plans are to face of stud or CMU unless noted otherwise.
- Coordinate the location of electrical devices with casework, millwork, lockers, etc. Any electrical device that is not properly coordinated shall be relocated at no additional cost.
- Exterior wall construction is identified on the Wall Sections. Refer to the A' 4-series sheets for Wall Sections, and to A14.30, A24.30, A34.30 for Exterior Wall Assemblies.
- Refer to Exterior Elevation Notes for control joint requirements at all inside corners of masonry veneer.
- Refer to PARTITION TYPES (A12.21, A22.21, A32.21) for Partition Types Legend.
- Interior partitions are Type "P6" unless noted otherwise.
- Refer to Detail 4/A0.31 for Typical Door Maneuvering Clearances. All new doors shall meet the requirements of that detail. If any door is found that does not comply with these requirements, request clarification from the Architect prior to construction.
- Refer to PARTITION DETAILS sheets for Typical Partition Penetration Details, including pipe, conduit and ductwork penetrations.
- Refer to PARTITION DETAILS sheets for Typical Bracing at Non-Loadbearing CMU Partitions.
- Refer to Exterior Elevations for exact locations of downspouts.
- Provide factory bullnose units at all interior exposed vertical edges of CMU, except at starter course with applied base material where square-edge units shall be provided in lieu of bullnose units.
- Provide 4" starter courses at all CMU walls and partitions unless noted otherwise.
- Provide steel or masonry lintels over all openings in CMU walls, including those required for mechanical ductwork and dampers, whether specifically indicated on the drawings or not.
- Provide minimum 20 gage light-gage steel studs at all interior partitions scheduled to receive ceramic tile or plaster.
- Provide minimum 18 gage cold-formed steel studs at all interior partitions scheduled to receive anchored masonry or stone veneer as well as interior partitions with steel plate or steel sheet X-bracing.
- Provide minimum 18 gage cold-formed steel studs as designed by stud engineer for all interior partitions scheduled to receive adhered masonry or stone veneer.
- At light-gage steel stud partitions that extend above the ceiling, provide diagonal 20 gage stud braces at 4'-0" o.c. to structure above (not to steel deck) as required to provide rigid anchorage and support of partitions.
- Provide minimum 2 X 6 fire-retardant treated wood blocking in both new and existing stud walls and partitions, at mounting locations for wall-mounted accessories, handrails, casework, markerboards, tackboards, folding partitions, toilet partitions, and all other wall-mounted items. Refer to CASEWORK ELEVATIONS & DETAILS sheets for typical blocking requirements at various conditions.
- At Mechanical, Electrical and Boiler Room partitions, seal tightly around all penetrations. Utilize fire safing material at rated partitions.
- Provide sealant and/or fire safing at all floor penetrations, as applicable.
- Existing equipment to remain U.N.O. Contractor to relocate equipment as needed to complete new construction. Contractor shall reinstall equipment upon completion of construction. All equipment to be in as good or better working condition as prior to the start of construction.


FLOOR PLAN LEGEND

- METAL STUD PARTITION. Extend 4" above highest ceiling plane and brace to structure above as noted in Floor Plan Notes. Refer to Reflected Ceiling Plan for fire, smoke and sound-conditioned partitions that extend to deck above.
- CMU PARTITION. Extend 4" above highest ceiling plane and brace to structure above as detailed. Refer to Reflected Ceiling Plan for fire, smoke and sound-conditioned partitions that extend to deck above.
- EXISTING WALL TO REMAIN.
- MOVEABLE METAL SHELVING. Depth and Width dimensions match that of this legend, unless otherwise noted.
- FURNITURE, FIXTURE OR EQUIPMENT BY OWNER. Coordinate with adjacent electrical devices, casework, etc.
- MB MARKERBOARD. Preceding number is length, in feet.
- SL WITH HALF STAFF LINES
- TB TACKBOARD. Preceding number is length, in feet.
- TS TACK STRIP. Preceding number is length, in feet.
- IM INTERACTIVE MARKERBOARD
- EX EXISTING
- IFF INTERACTIVE FLAT PANEL
- FEC FIRE EXTINGUISHER WITH CABINET AND BRACKET
- FE FIRE EXTINGUISHER WITH BRACKET
- FHC FIRE HOSE CABINET
- HB HORIZONTAL BLINDS
- RS ROLLING WINDOW SHADES
- DS DOWNSPOUT



ARCHITECT
VLK Architects
 20445 State Hwy 249, Suite 350
 Houston, Texas 77070
 Main Phone: 281.671.2300
 www.vlkarchitects.com

CYPRESS-FAIRBANKS INDEPENDENT SCHOOL DISTRICT
 HOUSTON, TEXAS

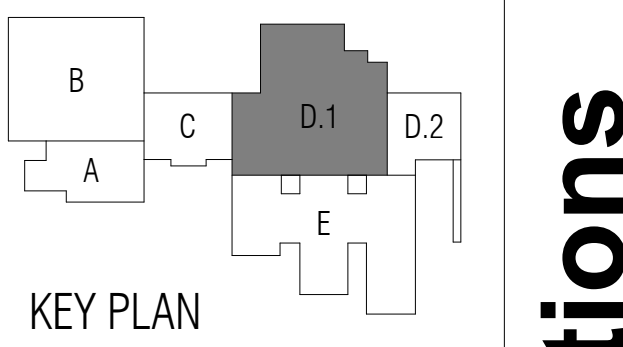

ISSUED: February 24, 2025

REVISIONS	
Revision No.	Revision Date
1 Addendum 1	03-06-2025

Director: RSJ
 Drawn By: STH, KM
 Designer: TQ
 Quality Control:

PROJECT NO.
24-010.00

SHEET TITLE

LABAY - UNIT D.1 FLOOR PLAN - LEVEL ONE

SHEET NO.

A22.11D.1



1 UNIT "D.1" PLAN - LEVEL ONE
 SCALE: 1/8" = 1'-0"

2024 Cook, Labay & Truitt MS Renovations



PARTITION NOTES

- Refer to Floor Plan Notes for additional metal stud requirements at Ceramic Tile, Plaster, Anchored Masonry or Stone Veneer, and Adhered Masonry or Stone Veneer.
- Refer to Floor Plan Notes for CMU starter course requirements.
- Refer to Sheet A' 2.22 for typical partition details.
- Refer to Reflected Ceiling Plans for location of fire rated partitions.
- Refer to Reflected Ceiling Plans for location of non-rated partitions that extend to the structural deck above.
- Provide firestopping as required to achieve the fire-resistive rating at all penetrations, gaps and other openings through or around rated floors, roofs, walls and partitions.
- At all rated and acoustical partitions that extend to structural deck above, seal to the floor below and to the structure above. Provide firestopping at rated partitions, and acoustical sealant at acoustical and sound conditioned other partitions.
- At all partitions that extend to structural deck above, provide gypsum board enclosure around beams, joists, ducts, etc. as required to maintain fire-resistive ratings and acoustical requirements.
- Typical CMU notes, unless otherwise noted on structural drawings:
 - Provide steel bracing as shown on Sheet A' 2.22
 - Provide continuous bond beam with (2) #4 reinforcing bars at top course of all 6" and 8" CMU partitions, whether indicated or not.
- 4" CMU shall not be used for interior partitions, except at chase walls where specifically indicated.

STUD PARTITION SIZING SCHEDULE

STUD DEPTH	STUD SPACING	STUD GAGE	EQ STUD	MAX LENGTH	MAX LENGTH (at Tile/Plaster)
3-5/8"	16" O.C	25 (18 mils)	25EQ	15'-6"	N/A
3-5/8"	16" O.C	20 (30 mils)	20EQ	16'-0"	14'-0"
6"	16" O.C	25 (18 mils)	25EQ	21'-6"	N/A
6"	16" O.C	20 (30 mils)	20EQ	22'-6"	19'-6"

- NOTES:**
- All doors shall have a minimum of 20 gage framing where required by specifications.
 - See Floor Plan Notes and Partition Notes for additional metal stud requirements at ceramic tile, plaster, anchored masonry/stone veneer, or adhered masonry/stone veneer.
 - Max. Lengths assume both sides of studs braced full-height of partition.
 - Max. Lengths are based on 5 psf lateral loading and L/240 deflection (L/360 at tile/plaster).
 - Equivalent (EQ) studs are not allowable at abuse-resistant or impact-resistant gyp board. Provide true 20 gage studs with minimum 0.0312 inches design thickness at these locations.

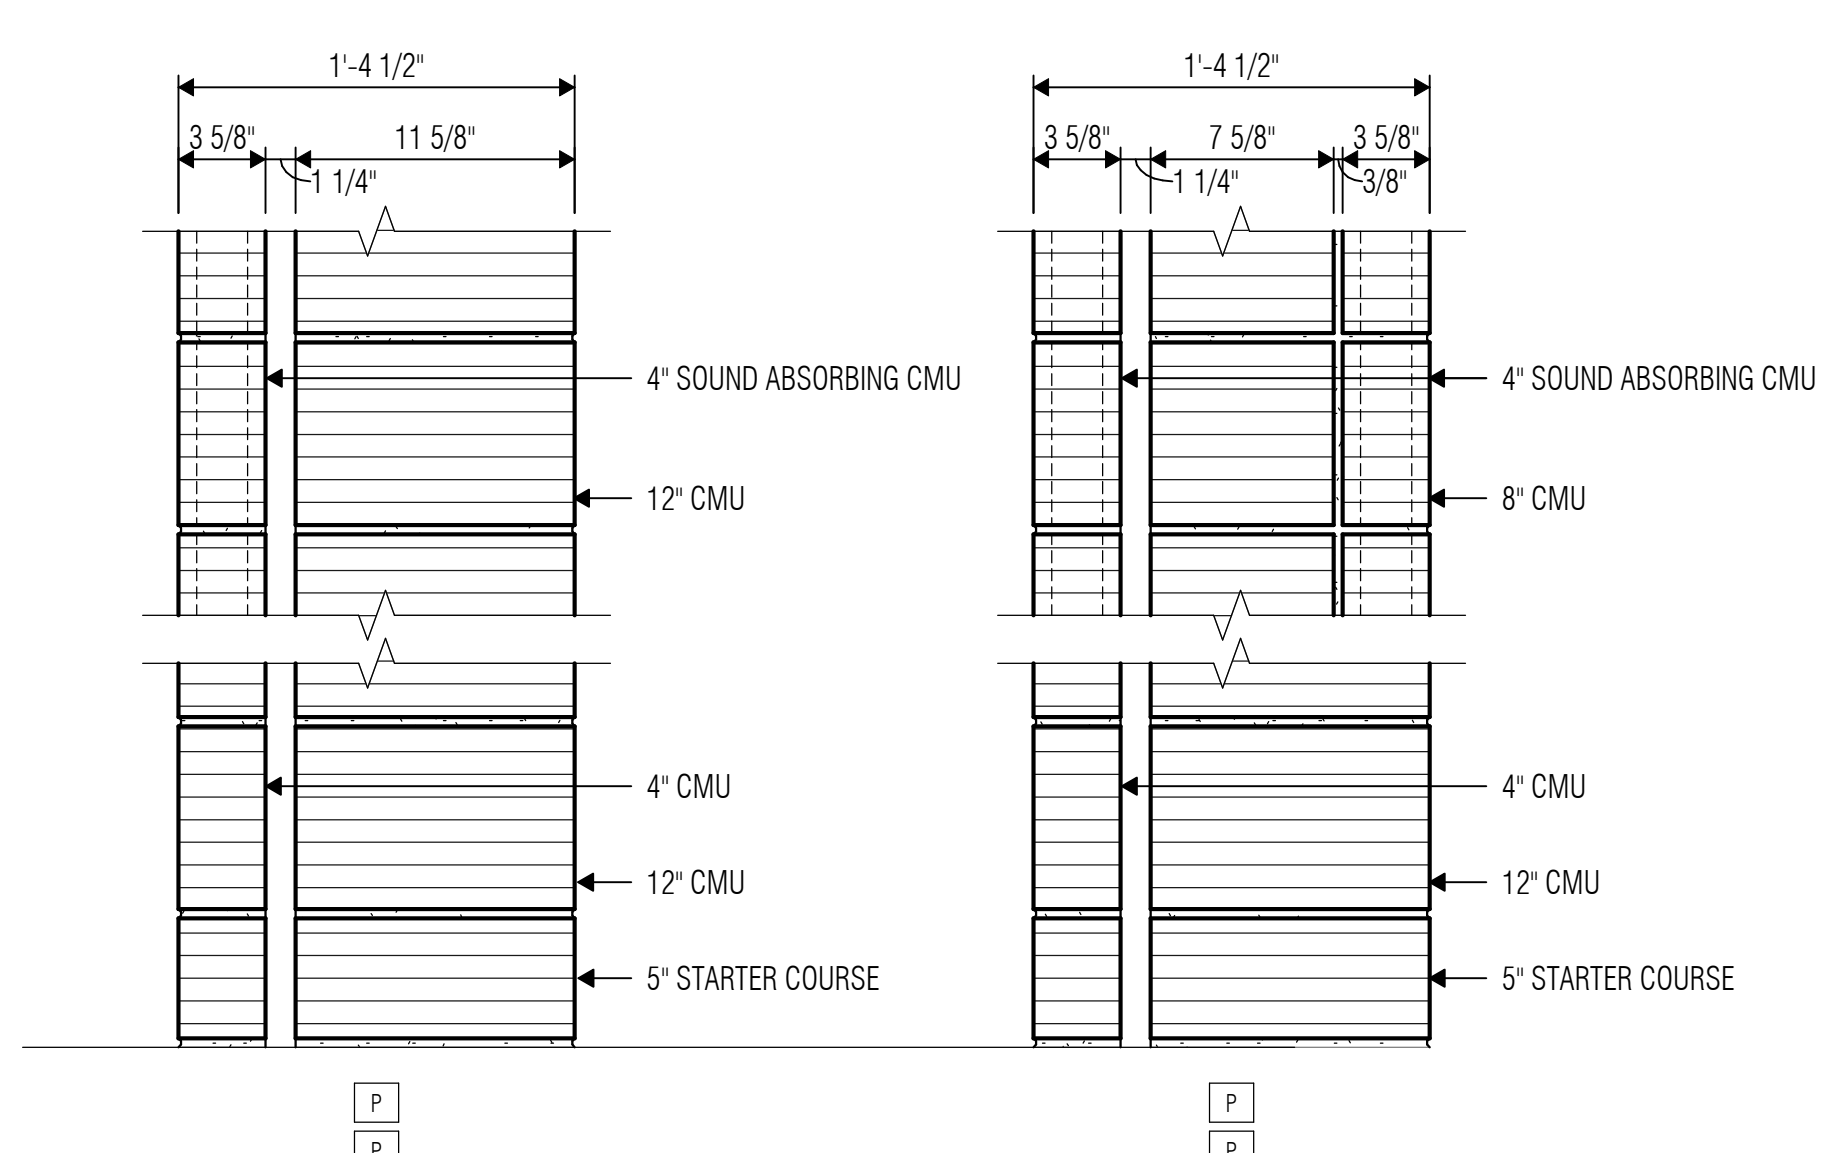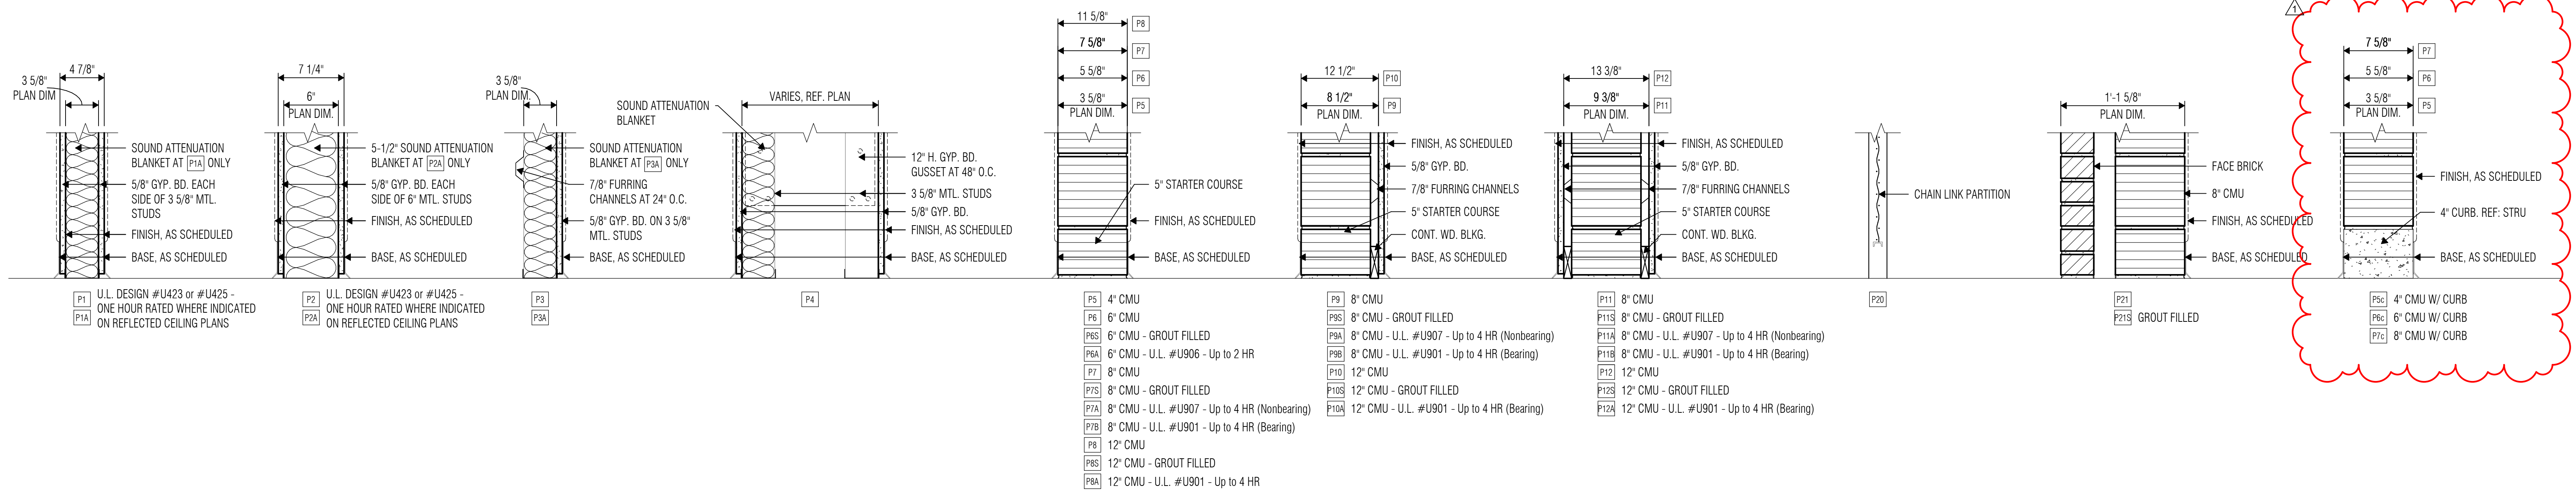

ISSUED: February 24, 2025


REVISIONS

Revision No.	Revision Date
1 Addendum 1	03-06-2025


Director: RSJ
 Designer: TQ
 Drawn By: STH, KM
 Quality Control:

PROJECT NO.
24-010.00
 SHEET TITLE
 LABAY - PARTITION TYPES
 SHEET NO.


A22.21

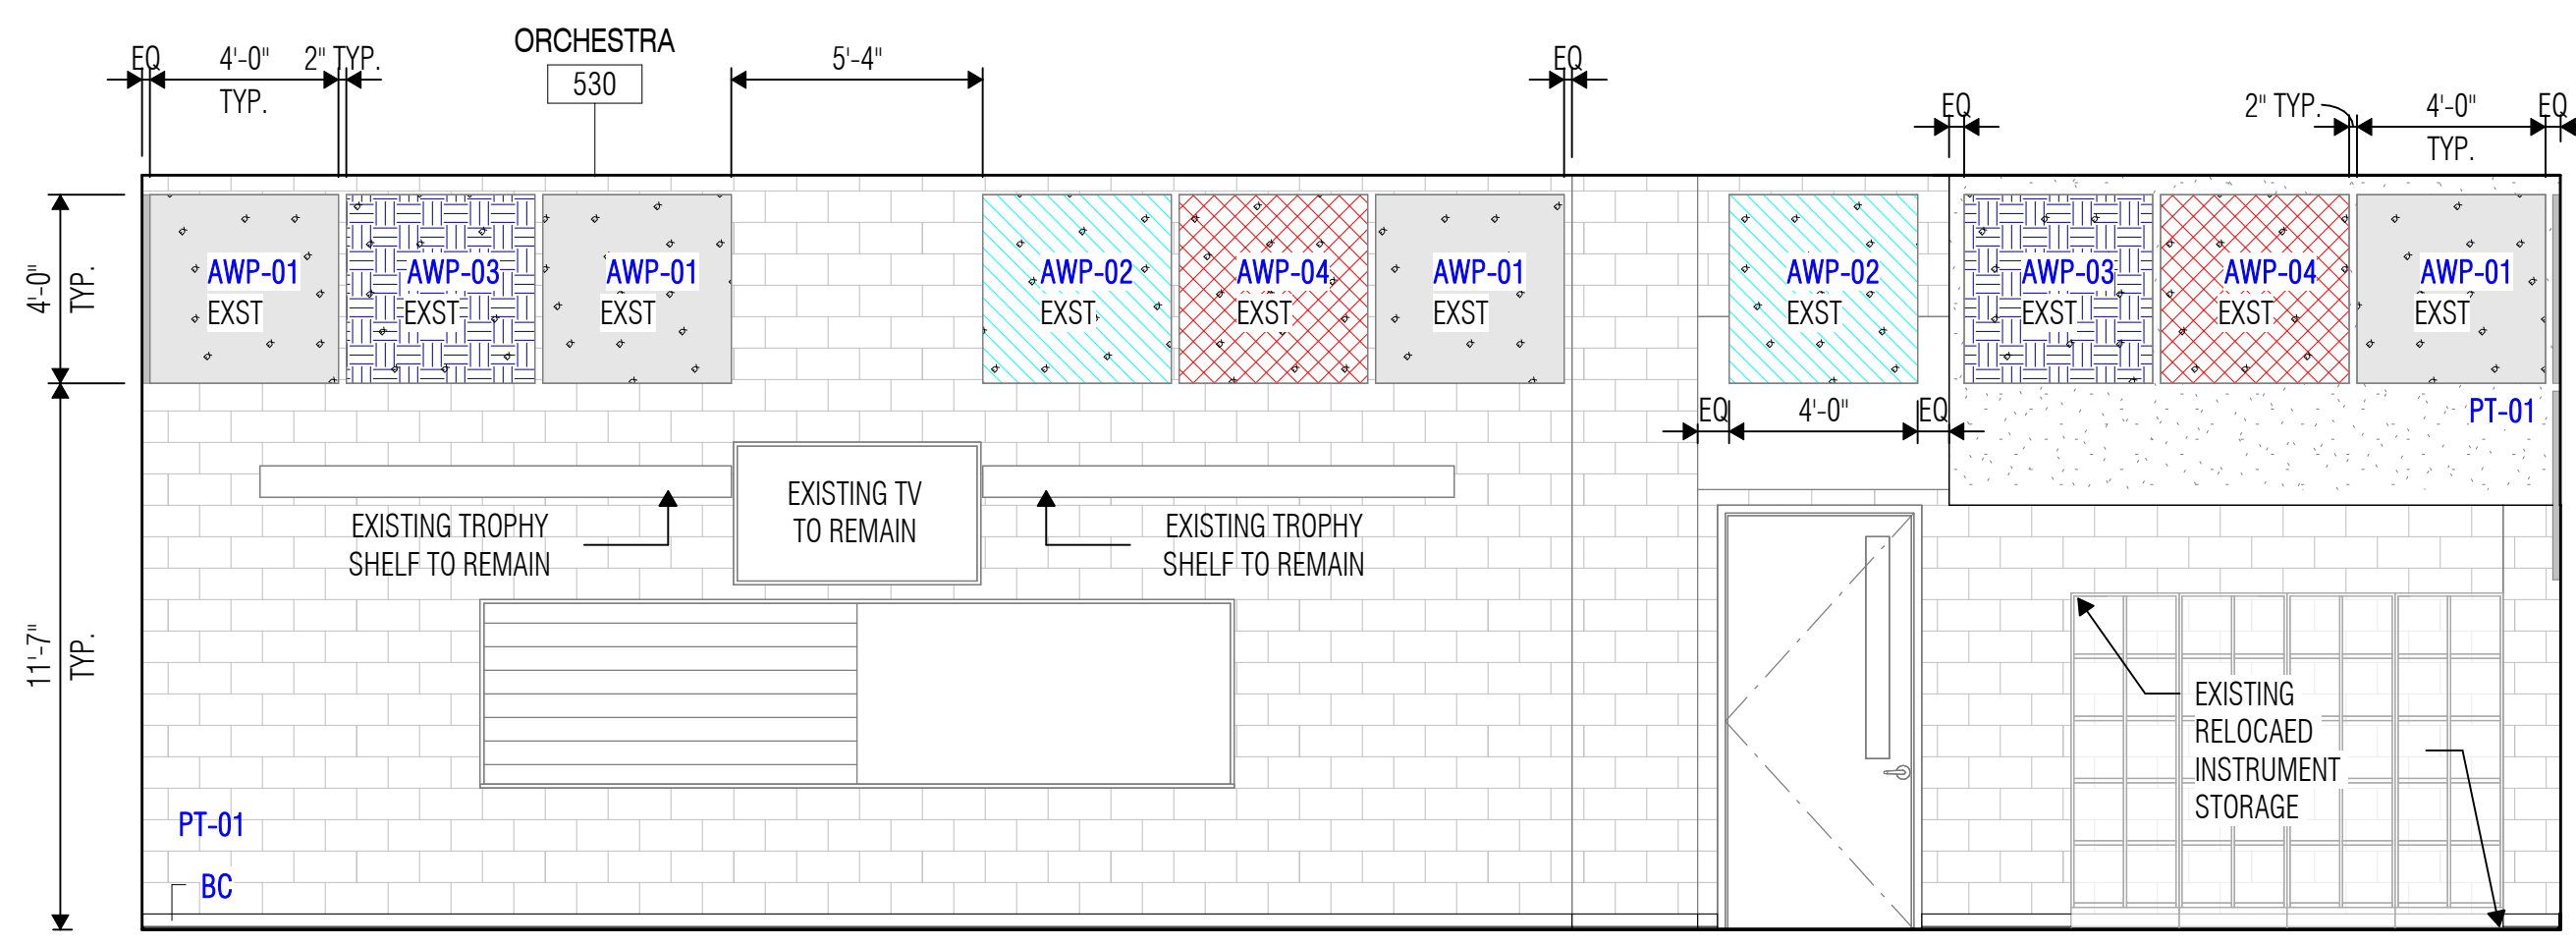


1 INTERIOR ELEVATION
SCALE: 1/4" = 1'-0"

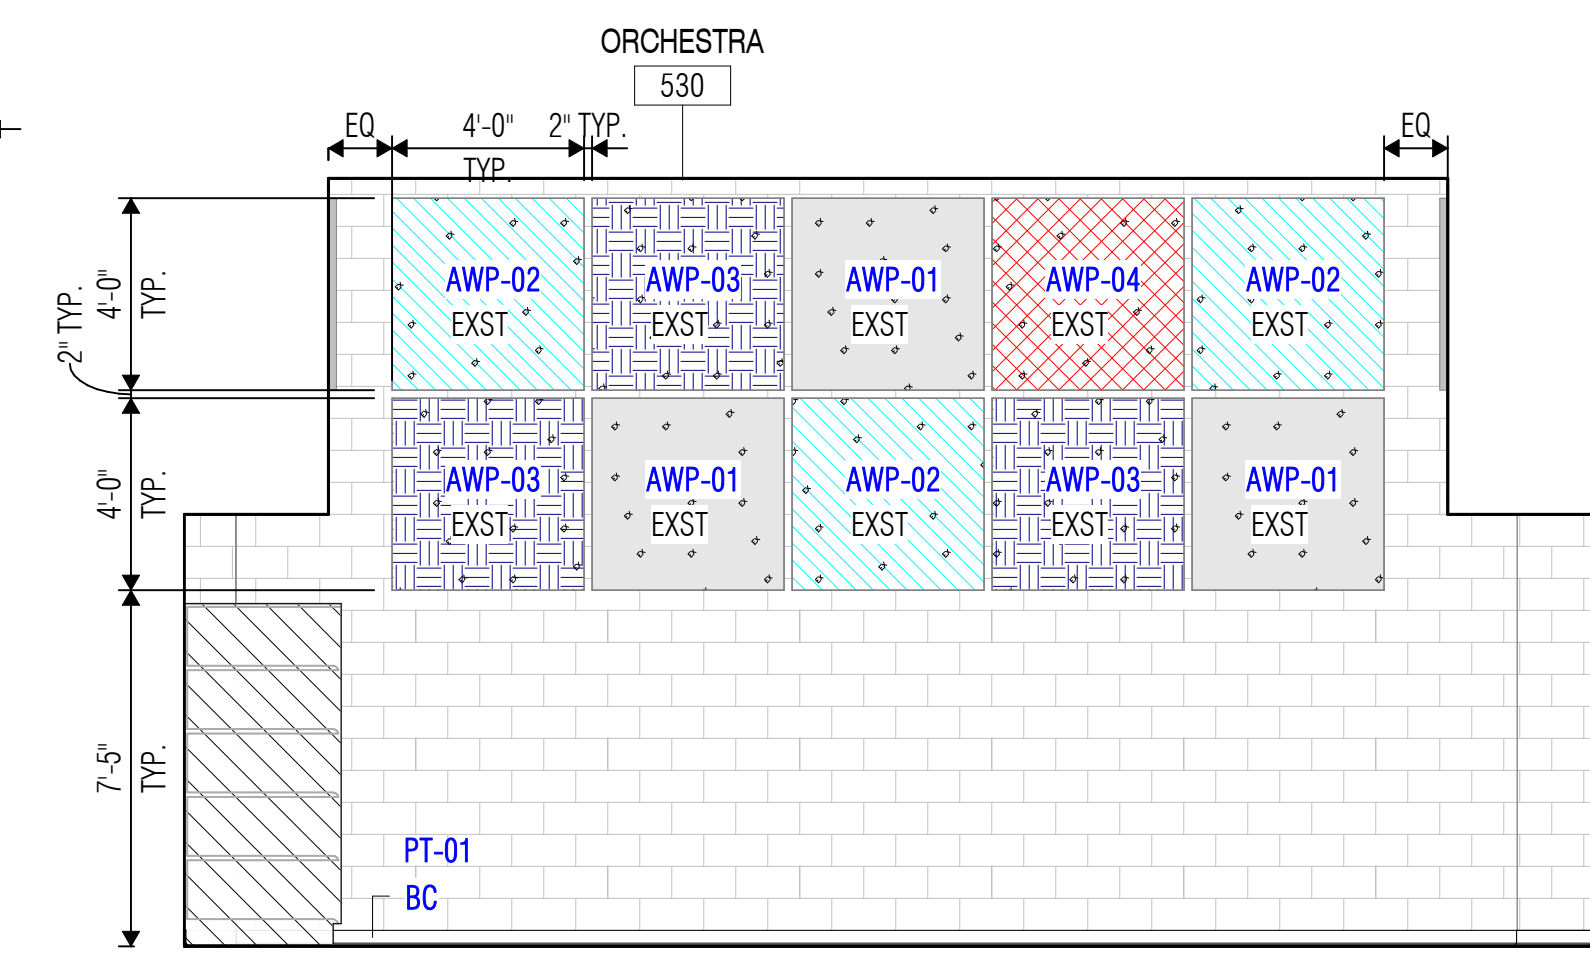


2 INTERIOR ELEVATION
SCALE: 1/4" = 1'-0"

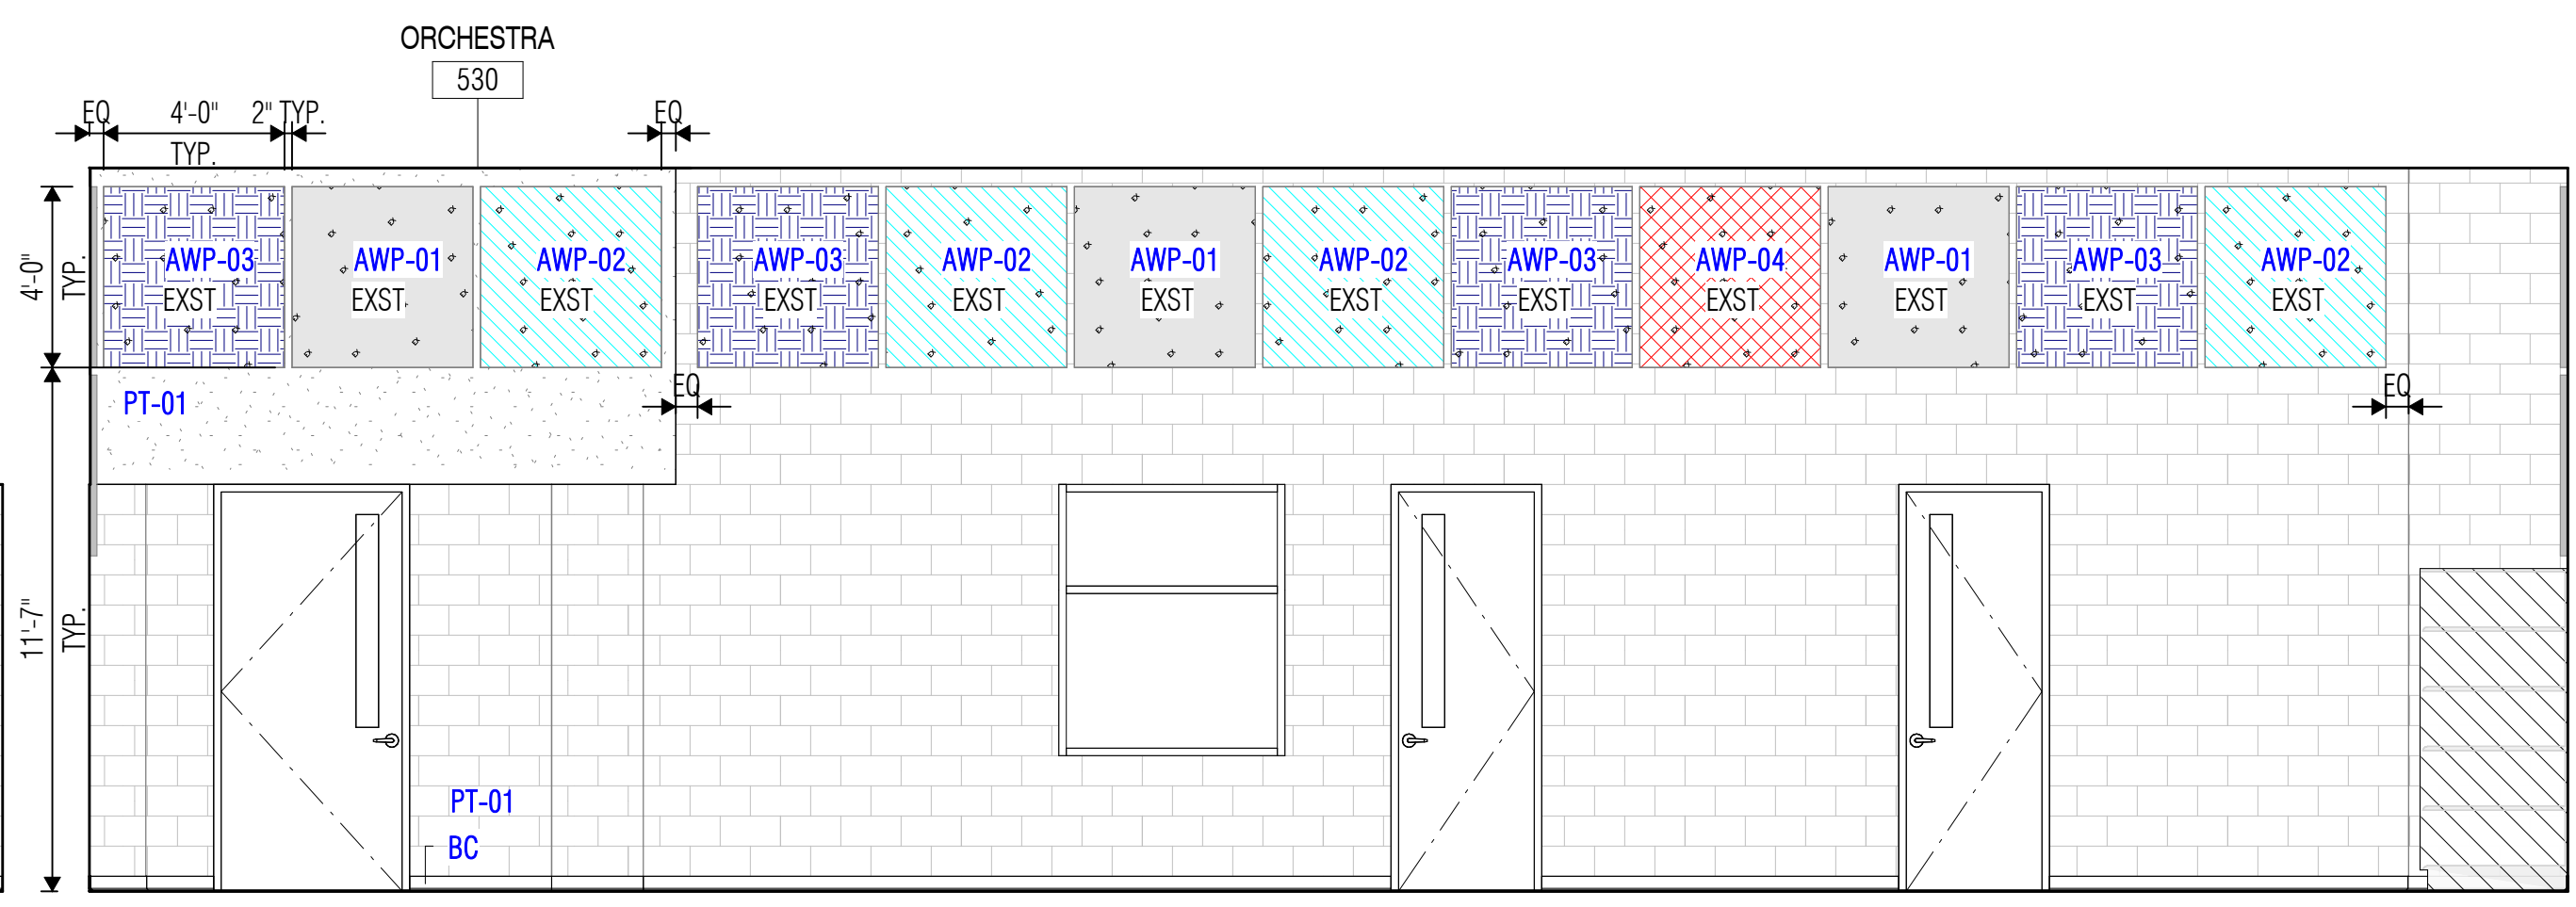


3 INTERIOR ELEVATION
SCALE: 1/4" = 1'-0"

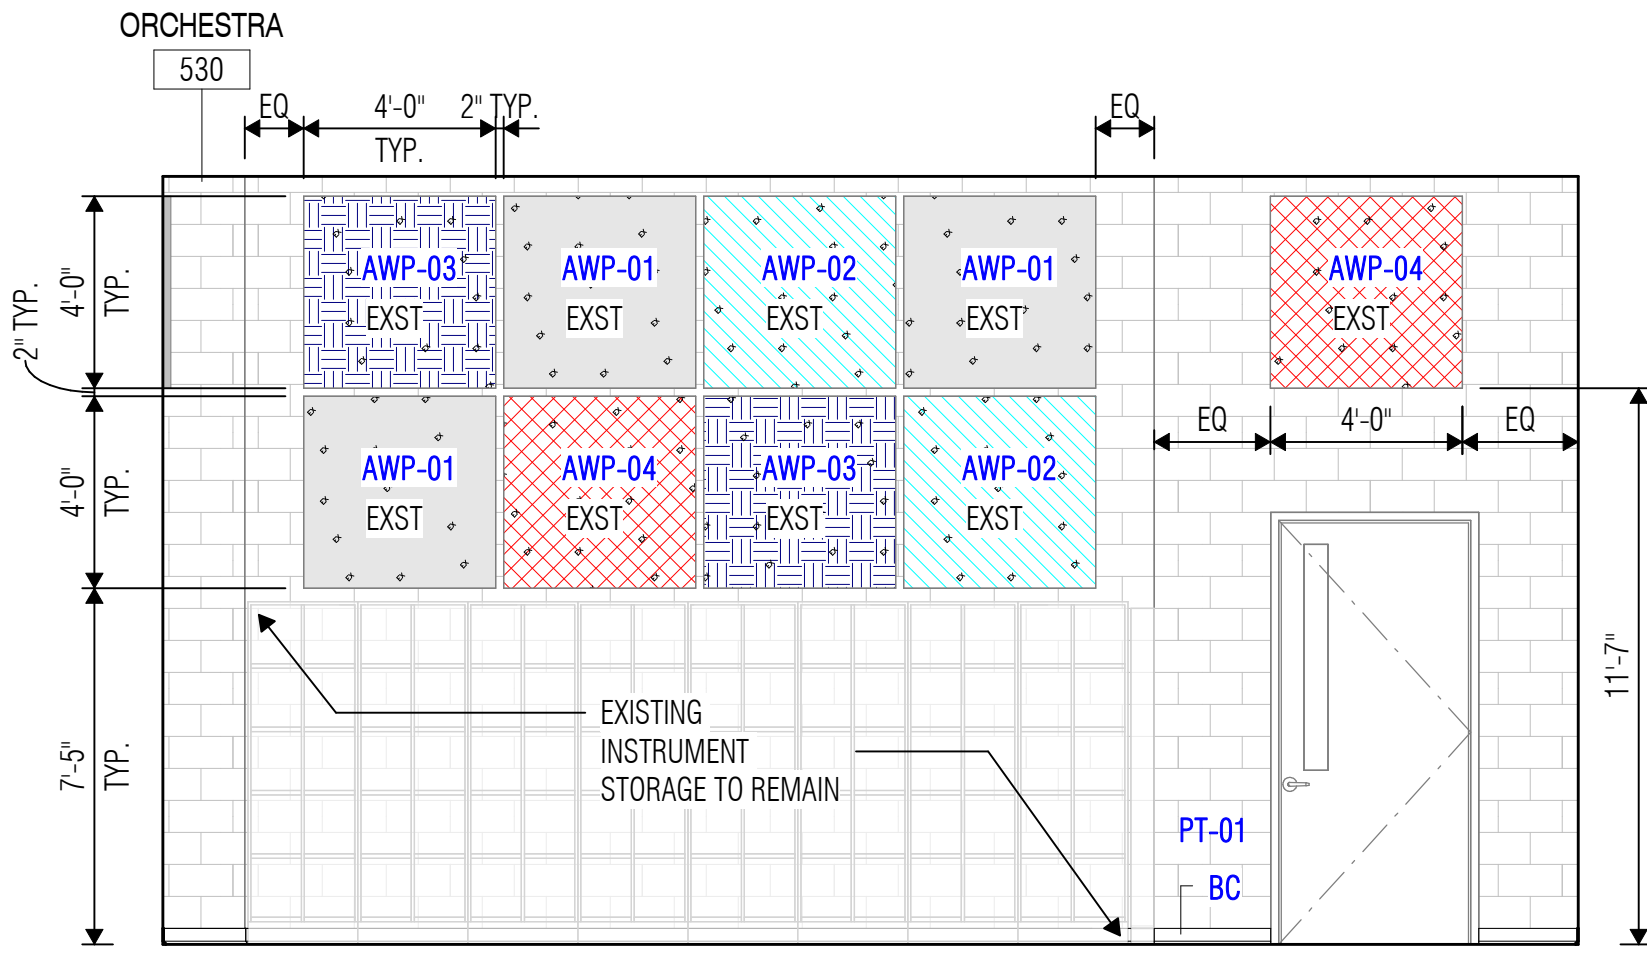


4 INTERIOR ELEVATION
SCALE: 1/4" = 1'-0"

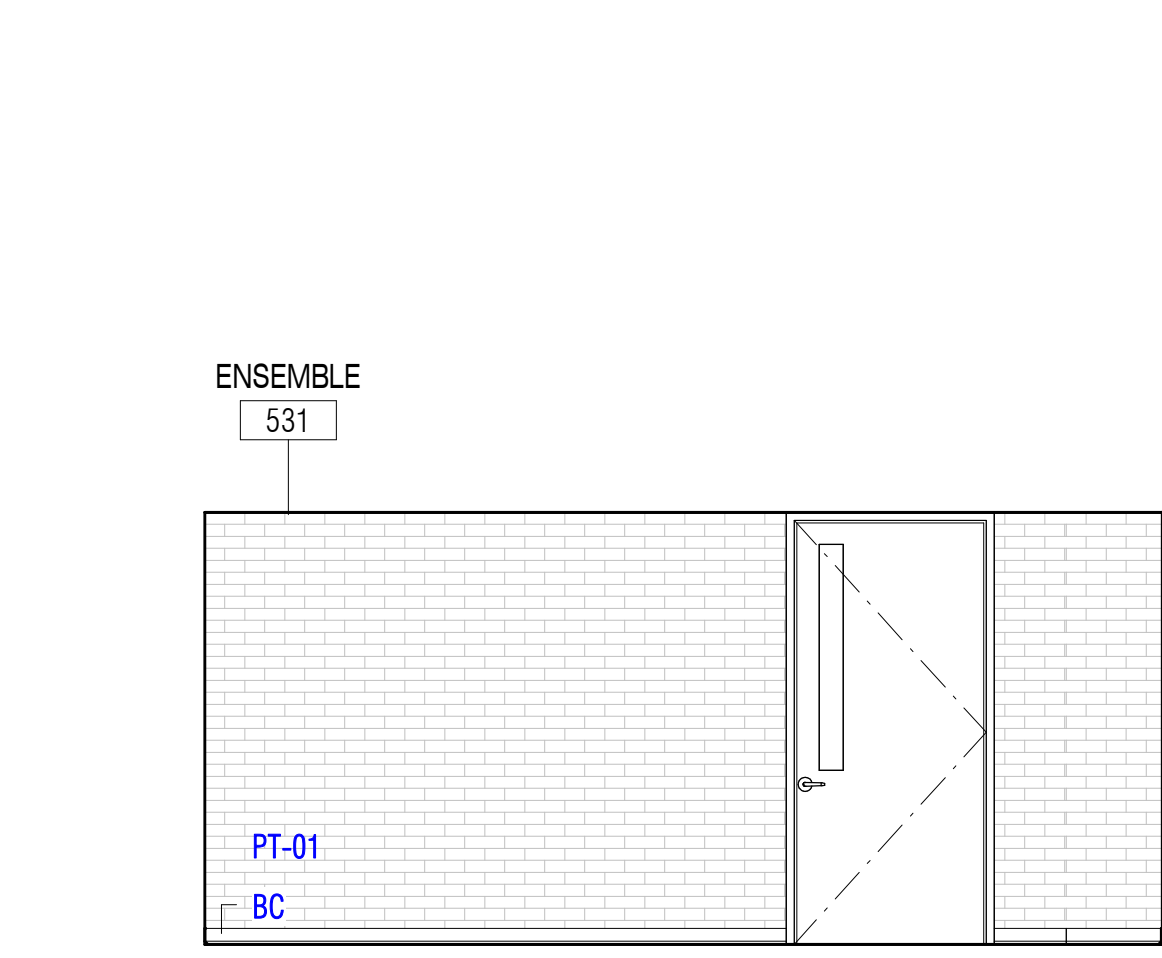


5 INTERIOR ELEVATION
SCALE: 1/4" = 1'-0"

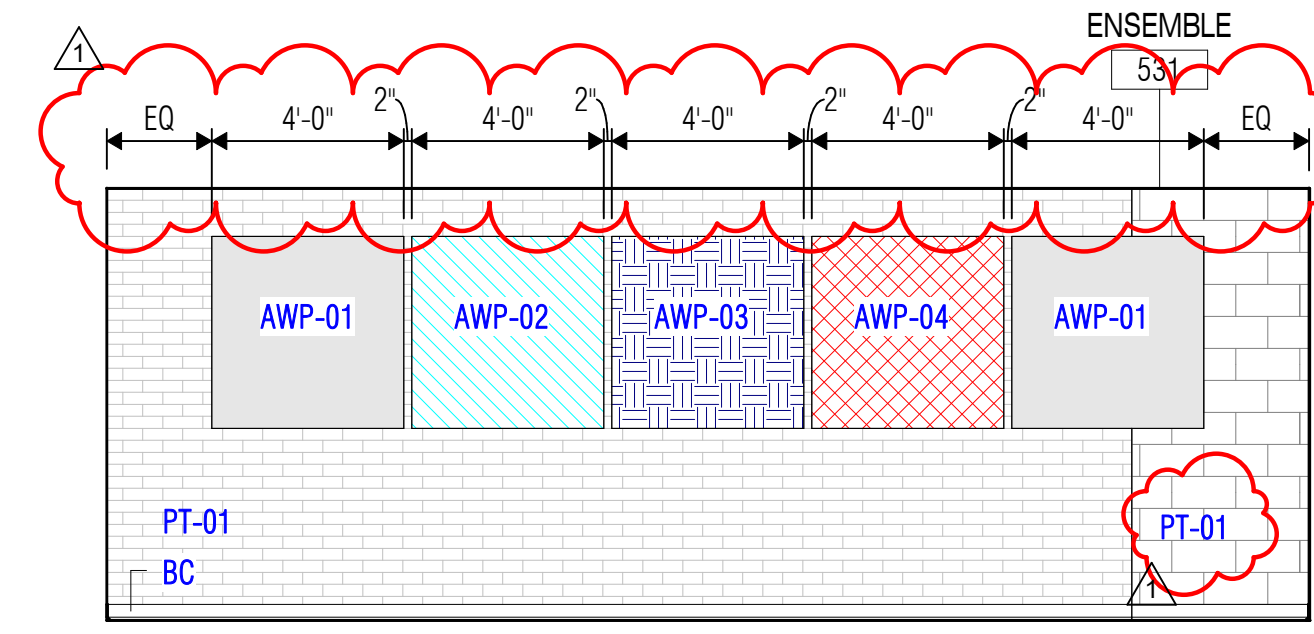


6 INTERIOR ELEVATION
SCALE: 1/4" = 1'-0"

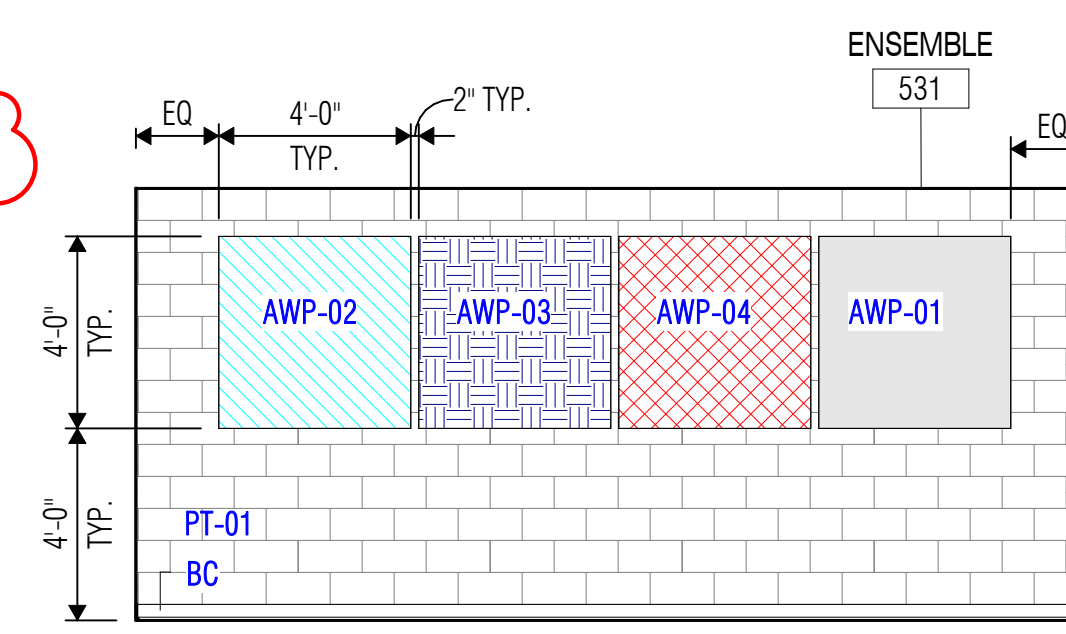


7 INTERIOR ELEVATION
SCALE: 1/4" = 1'-0"

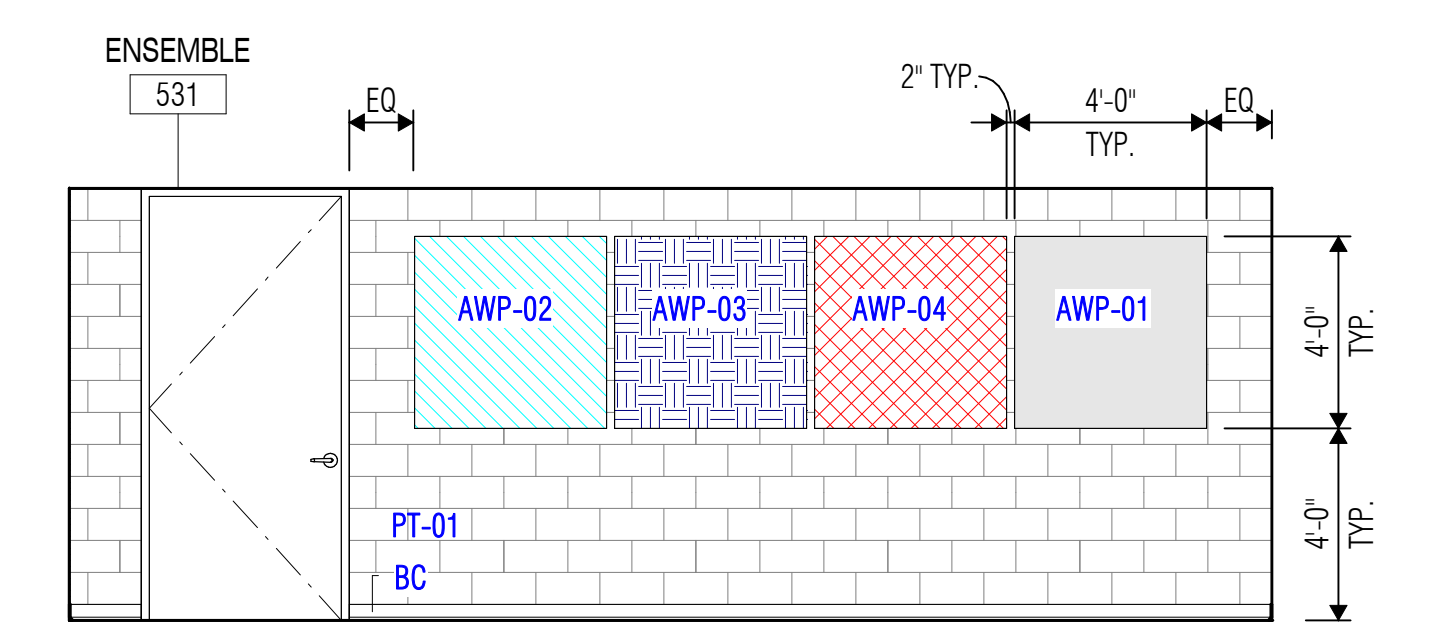


8 INTERIOR ELEVATION
SCALE: 1/4" = 1'-0"

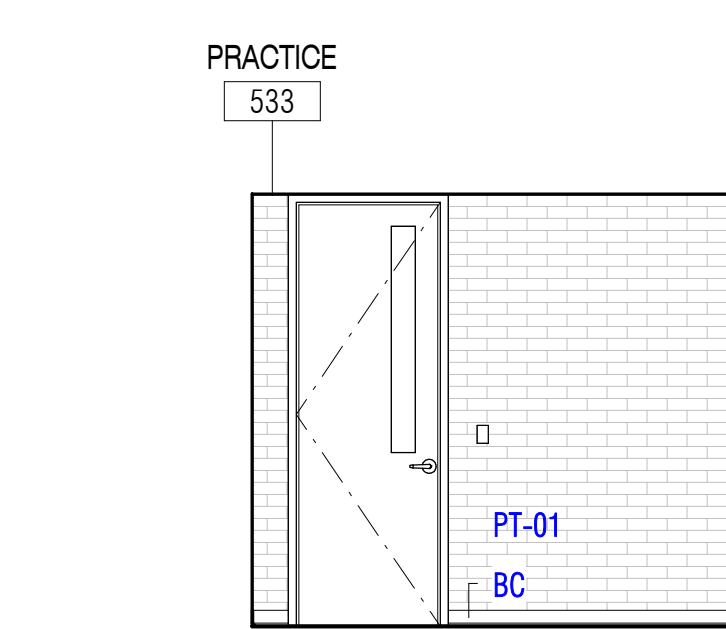


9 INTERIOR ELEVATION
SCALE: 1/4" = 1'-0"

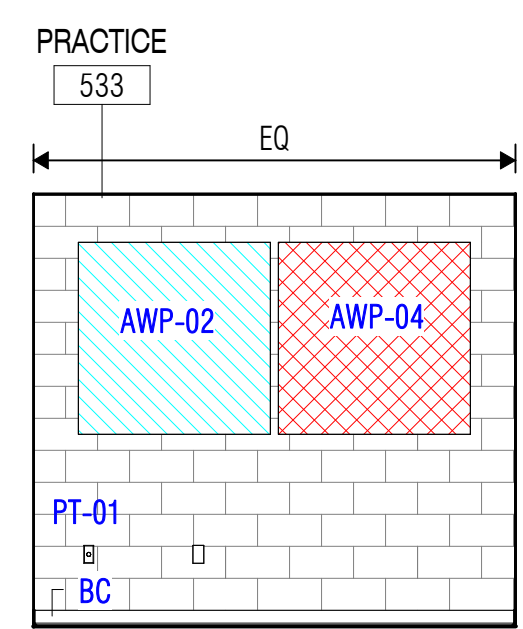



10 INTERIOR ELEVATION
SCALE: 1/4" = 1'-0"

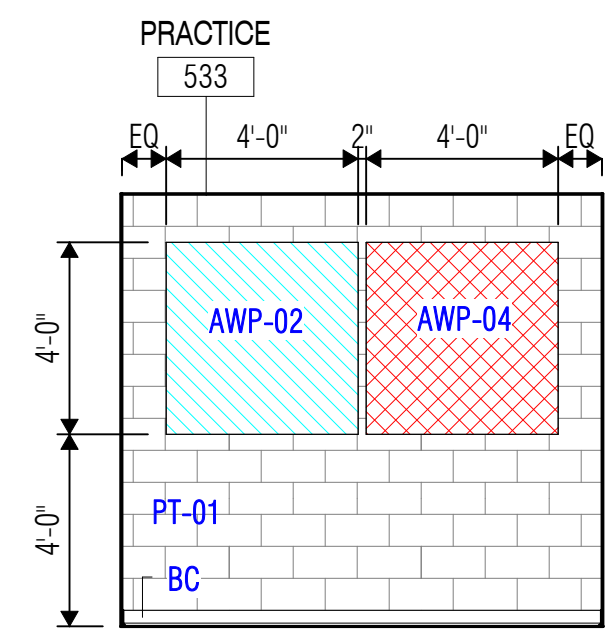

11 INTERIOR ELEVATION
SCALE: 1/4" = 1'-0"

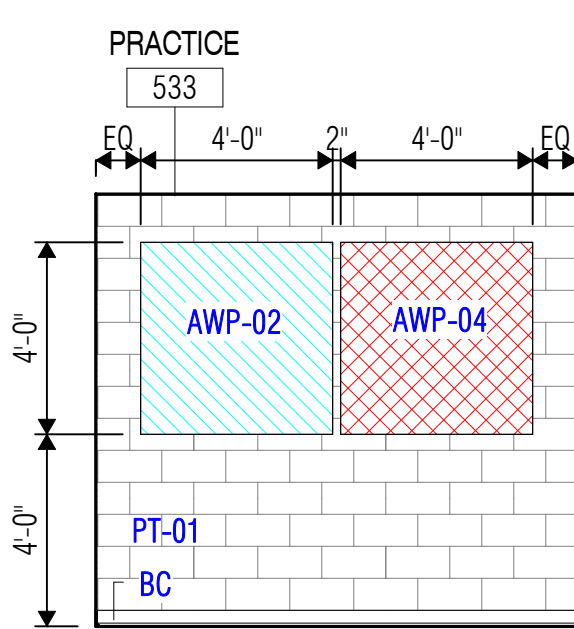

12 INTERIOR ELEVATION
SCALE: 1/4" = 1'-0"

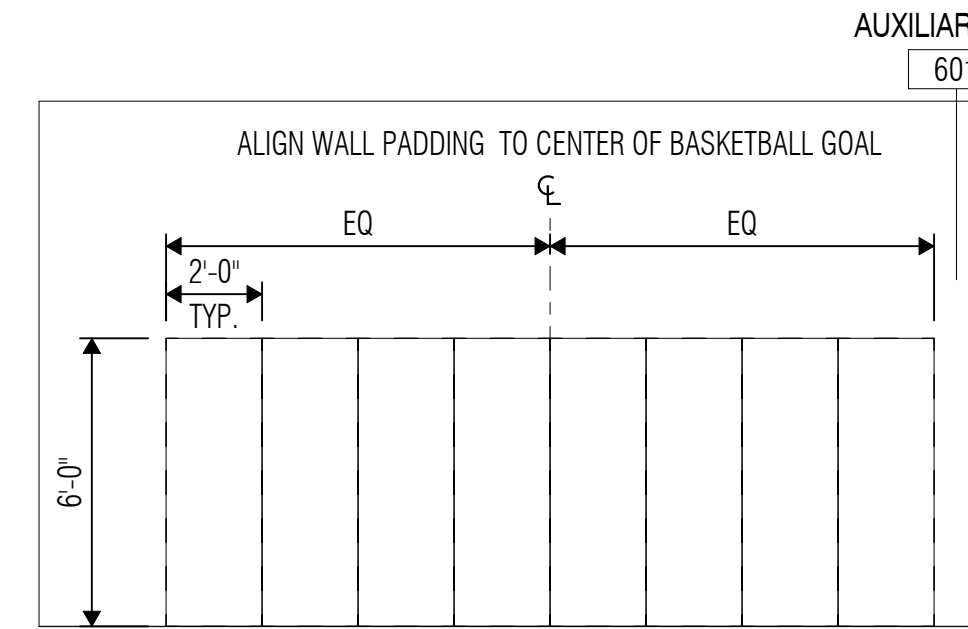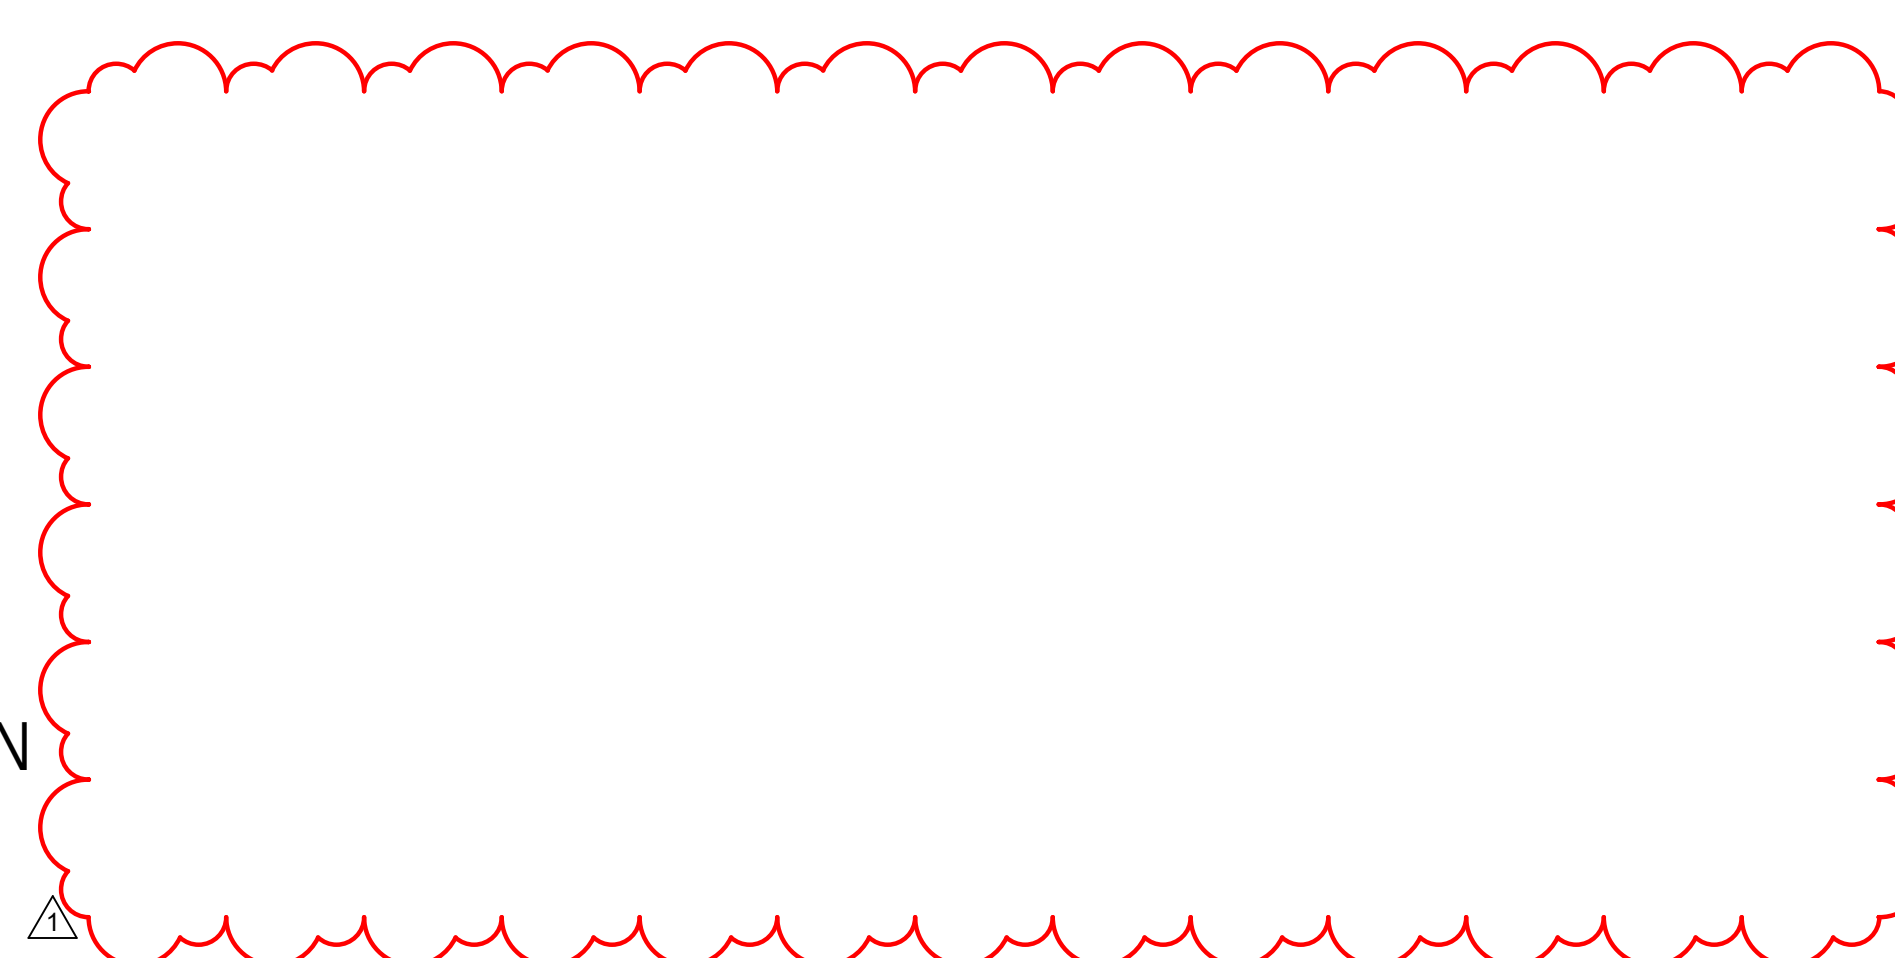

15 WALL PADDING TYP.
SCALE: 1/4" = 1'-0"



03/06/2025

ISSUED: February 24, 2025

REVISIONS

Revision No.	Revision Date
1 Addendum 1	03-06-2025

Director: RSJ
Design: Designer

Drawn By: STH, KM
Quality Control: Quality Control

Proj. Arch.: TQ

PROJECT NO.


24-010.00

SHEET TITLE

LABAY - INTERIOR ELEVATIONS

SHEET NO.

A23.31

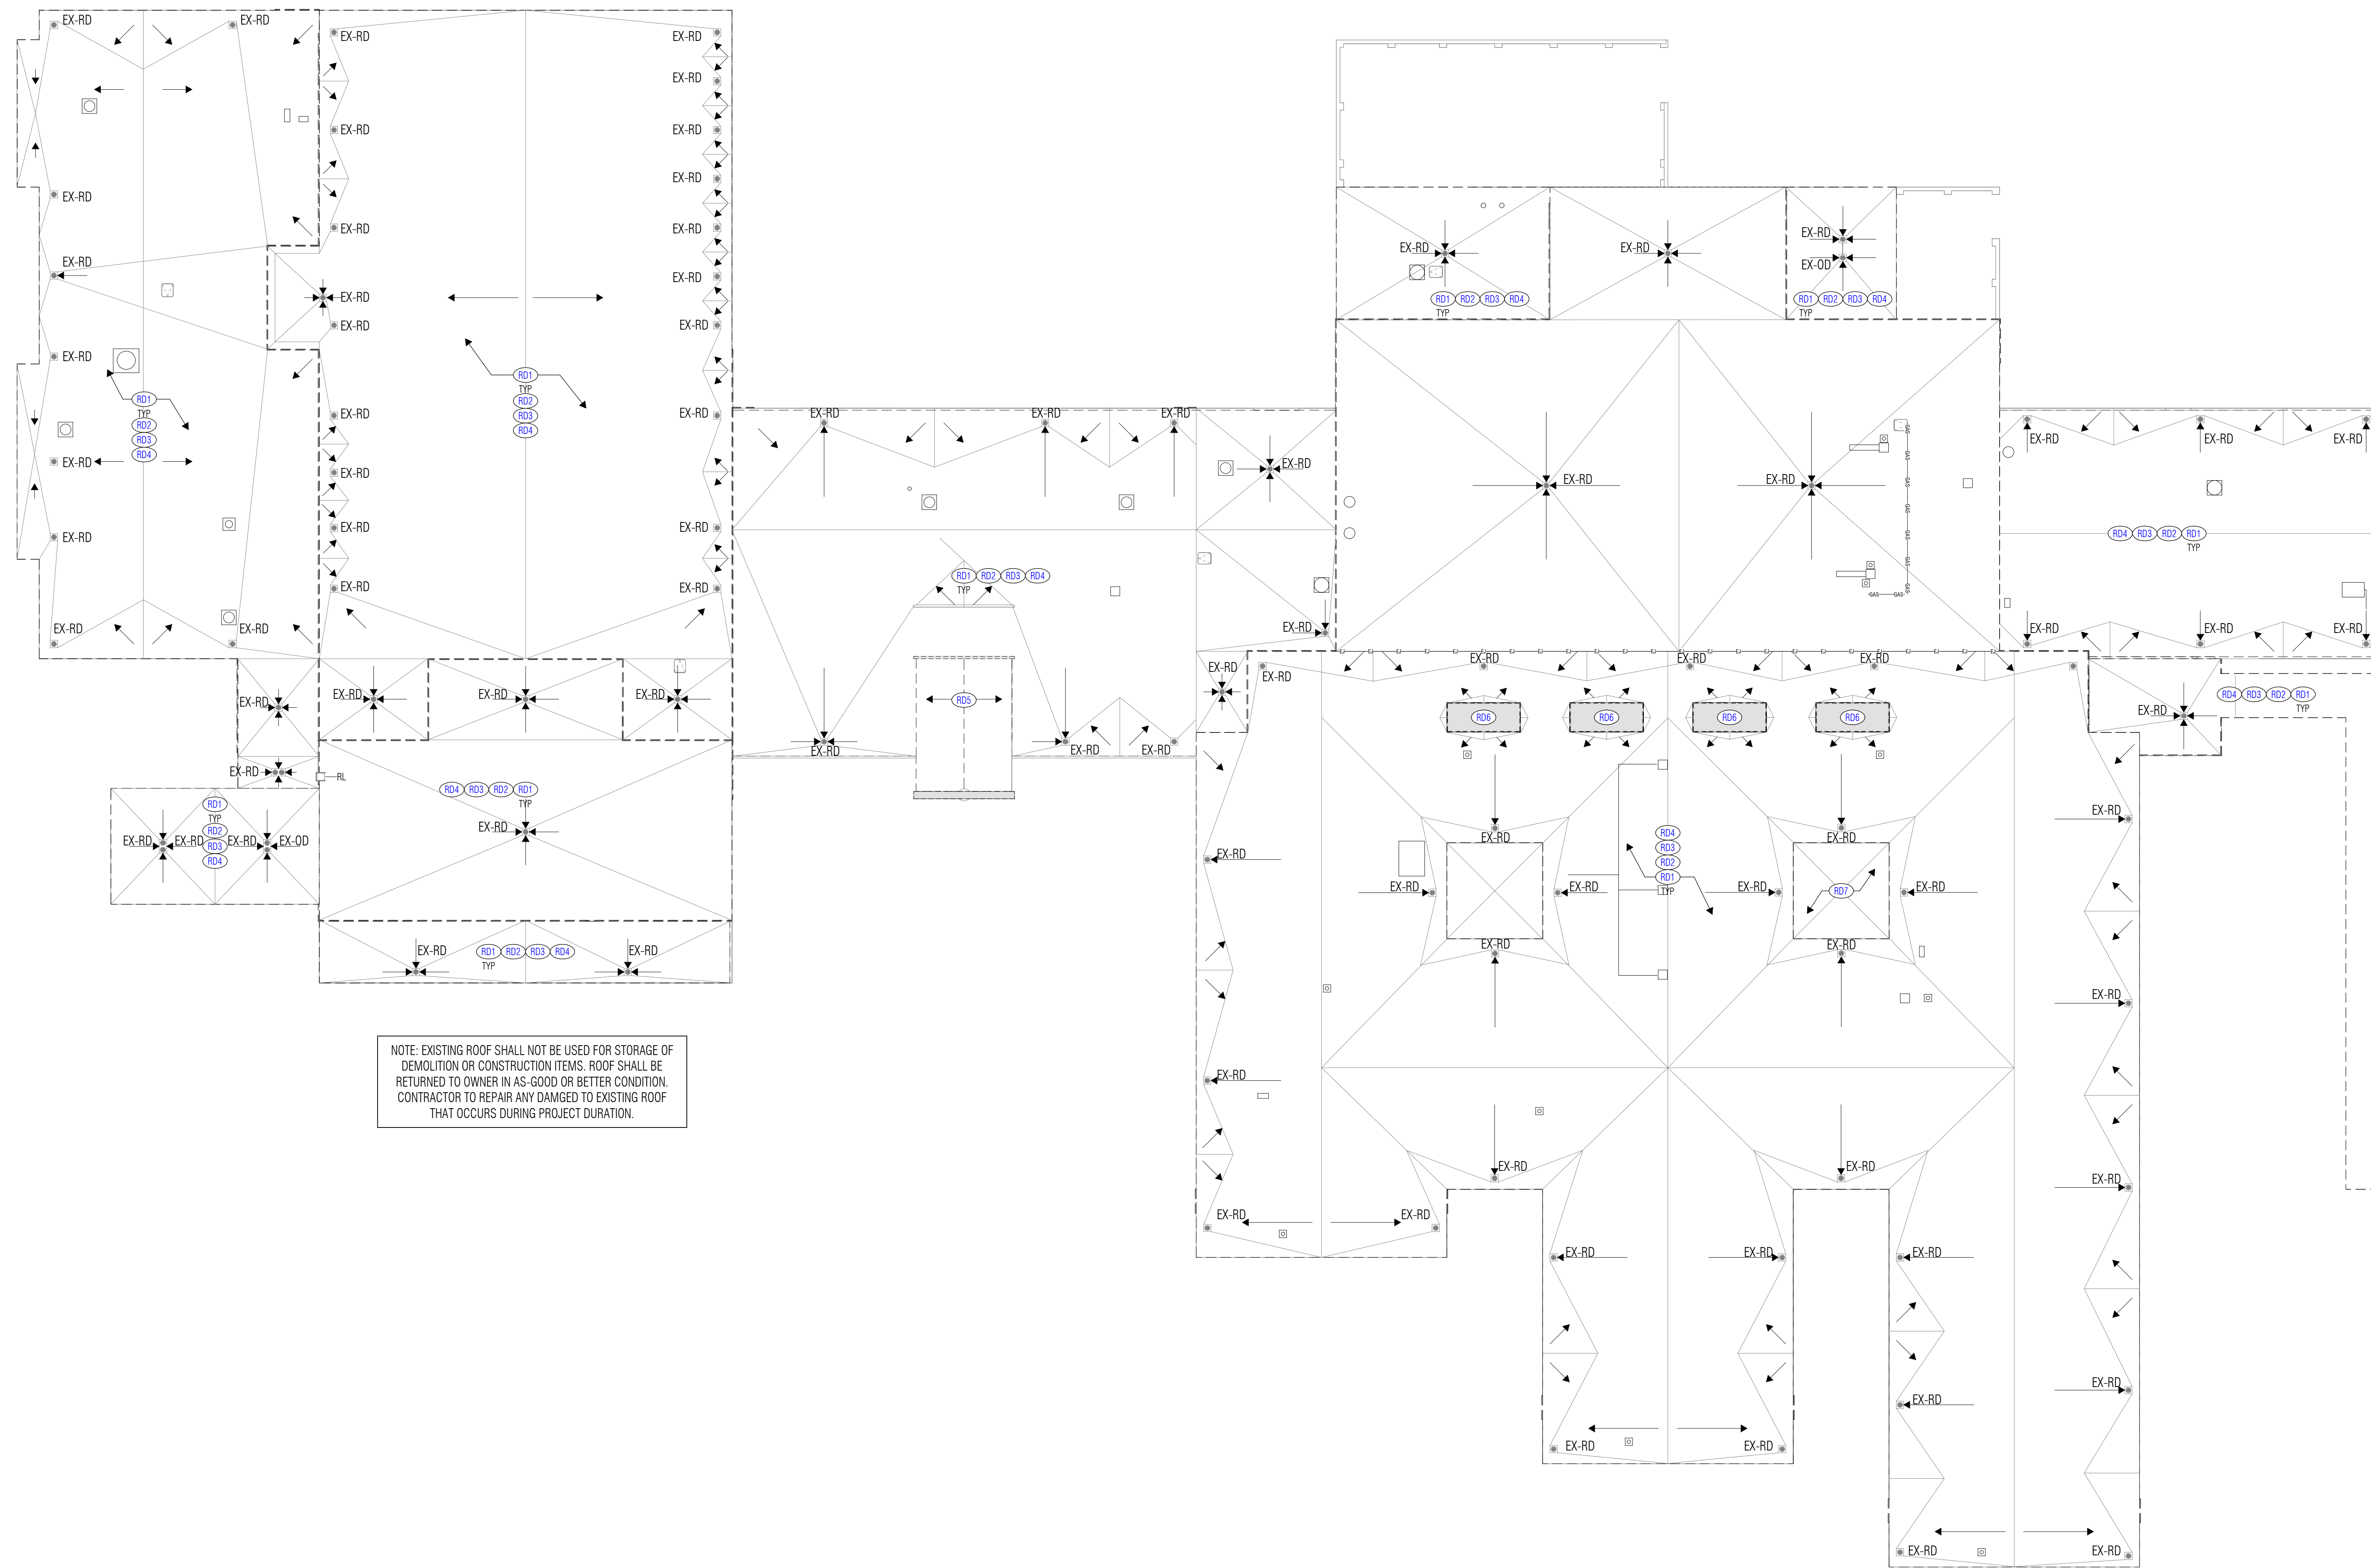

NOTE: EXISTING ROOF SHALL NOT BE USED FOR STORAGE OF DEMOLITION OR CONSTRUCTION ITEMS. ROOF SHALL BE RETURNED TO OWNER IN AS-GOOD OR BETTER CONDITION. CONTRACTOR TO REPAIR ANY DAMAGED TO EXISTING ROOF THAT OCCURS DURING PROJECT DURATION.

1 OVERALL ROOF DEMO PLAN
SCALE: 3/64" = 1'-0"

- ### ROOF PLAN NOTES
- Provide tapered insulation crickets at the high side of all rooftop curbs, mounting rails, and other miscellaneous roof penetrations as required to shed water around them and to ensure positive roof drainage, whether indicated on the drawings or not.
 - Crickets shall slope 1/2" per foot, unless noted otherwise.
 - Locate overflow scuppers per Building Elevations. If conflicts occur, contact Architect prior to construction.
 - Provide roof walkway protection at base of all roof ladders, around all sides of roof hatches, on all sides of rooftop units and condensing units, and on paths leading from roof access points to rooftop units and condensing units, whether indicated on drawings or not.
 - Provide layer of roof walkway protection under all pipe and conduit supports, fully-adhered to roof membrane.
 - Provide additional layer of single-ply roof membrane at the discharge point of downspouts, where splash pans are not provided.
 - Provide metal end closure at the ends of expansion joints, flashings and counterflashings.
 - Paint all exposed galvanized metal flashings, miscellaneous steel, piping, conduits, etc. that are not prefinished.
 - Clean and paint strainer baskets.
 - All sheet metal fascia, gutters and downspouts shall be pre-finished aluminum. All metal flashings embedded in roof membrane and in through-wall conditions shall be stainless steel.
- ### ROOF PLAN LEGEND
- NEW ROOF ASSEMBLY
 - EX-RD EXISTING ROOF DRAIN
 - EX-OD EXISTING OVERFLOW PLAN
 - CTES-TCT EXISTING COAL-TAR PITCH ELASTOMERIC SHEET ROOFING OVER EXISTING TECTUM PANEL DECKING
 - CTES-LW EXISTING COAL-TAR PITCH ELASTOMERIC SHEET ROOFING OVER EXISTING TECTUM PANEL DECKING
 - CTES-STRLW EXISTING COAL-TAR PITCH ELASTOMERIC SHEET ROOFING OVER EXISTING LIGHT WEIGHT CONCRETE DECKING
 - EXISTING EXPANSION JOINT
 - NEW STAINLESS STEEL THROUGH WALL FLASHING
 - EXISTING FIRE HATCH
 - EXISTING MECHANICAL, ELECTRICAL, PLUMBING UNITS
 - DEMOLISHED ITEMS


- ### ROOF PLAN LEGEND
- BUR BUILT-UP BITUMINOUS ROOFING
 - MBM MODIFIED BITUMINOUS MEMBRANE ROOFING
 - CTES COAL-TAR PITCH ELASTOMERIC SHEET ROOFING
 - T.O.M. TOP OF MASONRY ELEVATION
 - T.O.D. TOP OF DECK ELEVATION
 - T.O.S. TOP OF STEEL ELEVATION
 - RD ROOF DRAIN, REF.
 - OD OVERFLOW DRAIN WITH DOWNSPOUT NOZZLE, REF.
 - OS OVERFLOW SCUPPER, REF. /A
 - DS DOWNSPOUT, REF. /A
 - DSC DOWNSPOUT WITH SCUPPER AND CONDUCTOR HEAD, REF. /A
 - SB SPLASH BLOCK CONCRETE, REF. /A
 - SP SPLASH PAN, REF. /A
 - MC MANUFACTURED COPING, REF. /A
 - RH ROOF HATCH, REF.
 - RL ROOF LADDER, REF. /A
 - RTU ROOFTOP UNIT, REF. MECHANICAL & /A
 - CU CONDENSING UNIT, REF. FOOD SERVICE, M.E.P. & /A
 - GP GAS PIPE PENETRATION, REF.
 - RV RELIEF VENT, REF. M.E.P.
 - EF EXHAUST FAN, REF. M.E.P.

- ### DEMO KEYED NOTES
- | | |
|-----|--|
| RD1 | CLEAN AND PREPARE ROOF TO RECEIVE NEW CAP SHEET. CUT OUT AND REPAIR ANY DEFORMATIONS OR BUBBLES IN THE EXISTING ROOF LAYERS. |
| RD2 | CAREFULLY REMOVE ALL EXISTING ROOF COPING AND FLASHING. EXISTING BLOCKING TO REMAIN. U.N.O. REMOVE AND REPLACE ANY DETERIORATED BLOCKING. PREPARE AREA FOR NEW CONSTRUCTION. |
| RD3 | EXISTING ROOF TOP UNITS TO REMAIN, U.N.O. PROTECT IN PLACE. GC TO WALK WITH OWNER REPS TO VERIFY UNITS' FUNCTIONALITY. REF: MEP |
| RD4 | REMOVE AND PROPERLY DISPOSE OF ABANDONED EQUIPMENT AND ASSOCIATED ITEMS ON EXISTING ROOF. COORDINATE WITH OWNER FOR SALVAGE. |
| RD5 | REMOVE AND PROPERLY DISPOSE OF ROOF SHINGLES AND WATERPROOFING. SHEATHING AND INSULATION TO REMAIN. REPLACE ANY DAMAGED SHEATHING. CLEAN AND PREPARE FOR NEW CONSTRUCTION. |
| RD6 | EXISTING FLASHING TO REMAIN. PROTECT IN PLACE. CONTRACTOR TO REPAIR ANY DAMAGE CAUSED AS A RESULT OF CONSTRUCTION ACTIVITIES. |
| RD7 | TRIM AND REMOVE ANY TREE BRANCHES OVERHANGING ROOF. PREPARE AREA FOR NEW CONSTRUCTION. |



ARCHITECT
VLK Architects
20445 State Hwy 249, Suite 350
Houston, Texas 77070
Main Phone: 281.671.2300
www.vlkarchitects.com

CYPRESS-FAIRBANKS INDEPENDENT SCHOOL DISTRICT
HOUSTON, TEXAS

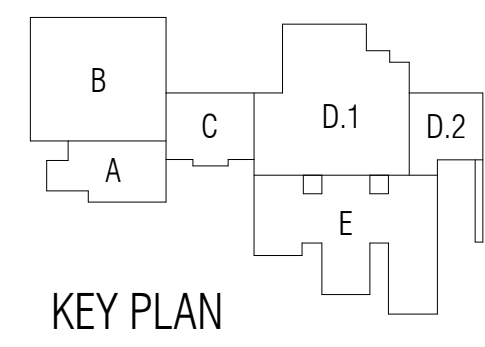

ISSUED: February 24, 2025

REVISIONS	
Revision No.	Revision Date
1 Addendum 1	03-06-2025

Director: RSJ
Designer: STH, KM
Quality Control: TQ

Proj. Arch.: TQ

PROJECT NO.
24-010.00


SHEET TITLE

LABAY - ROOF DEMO PLANS

SHEET NO.

A25.01


2024 Cook, Labay & Truitt MS Renovations

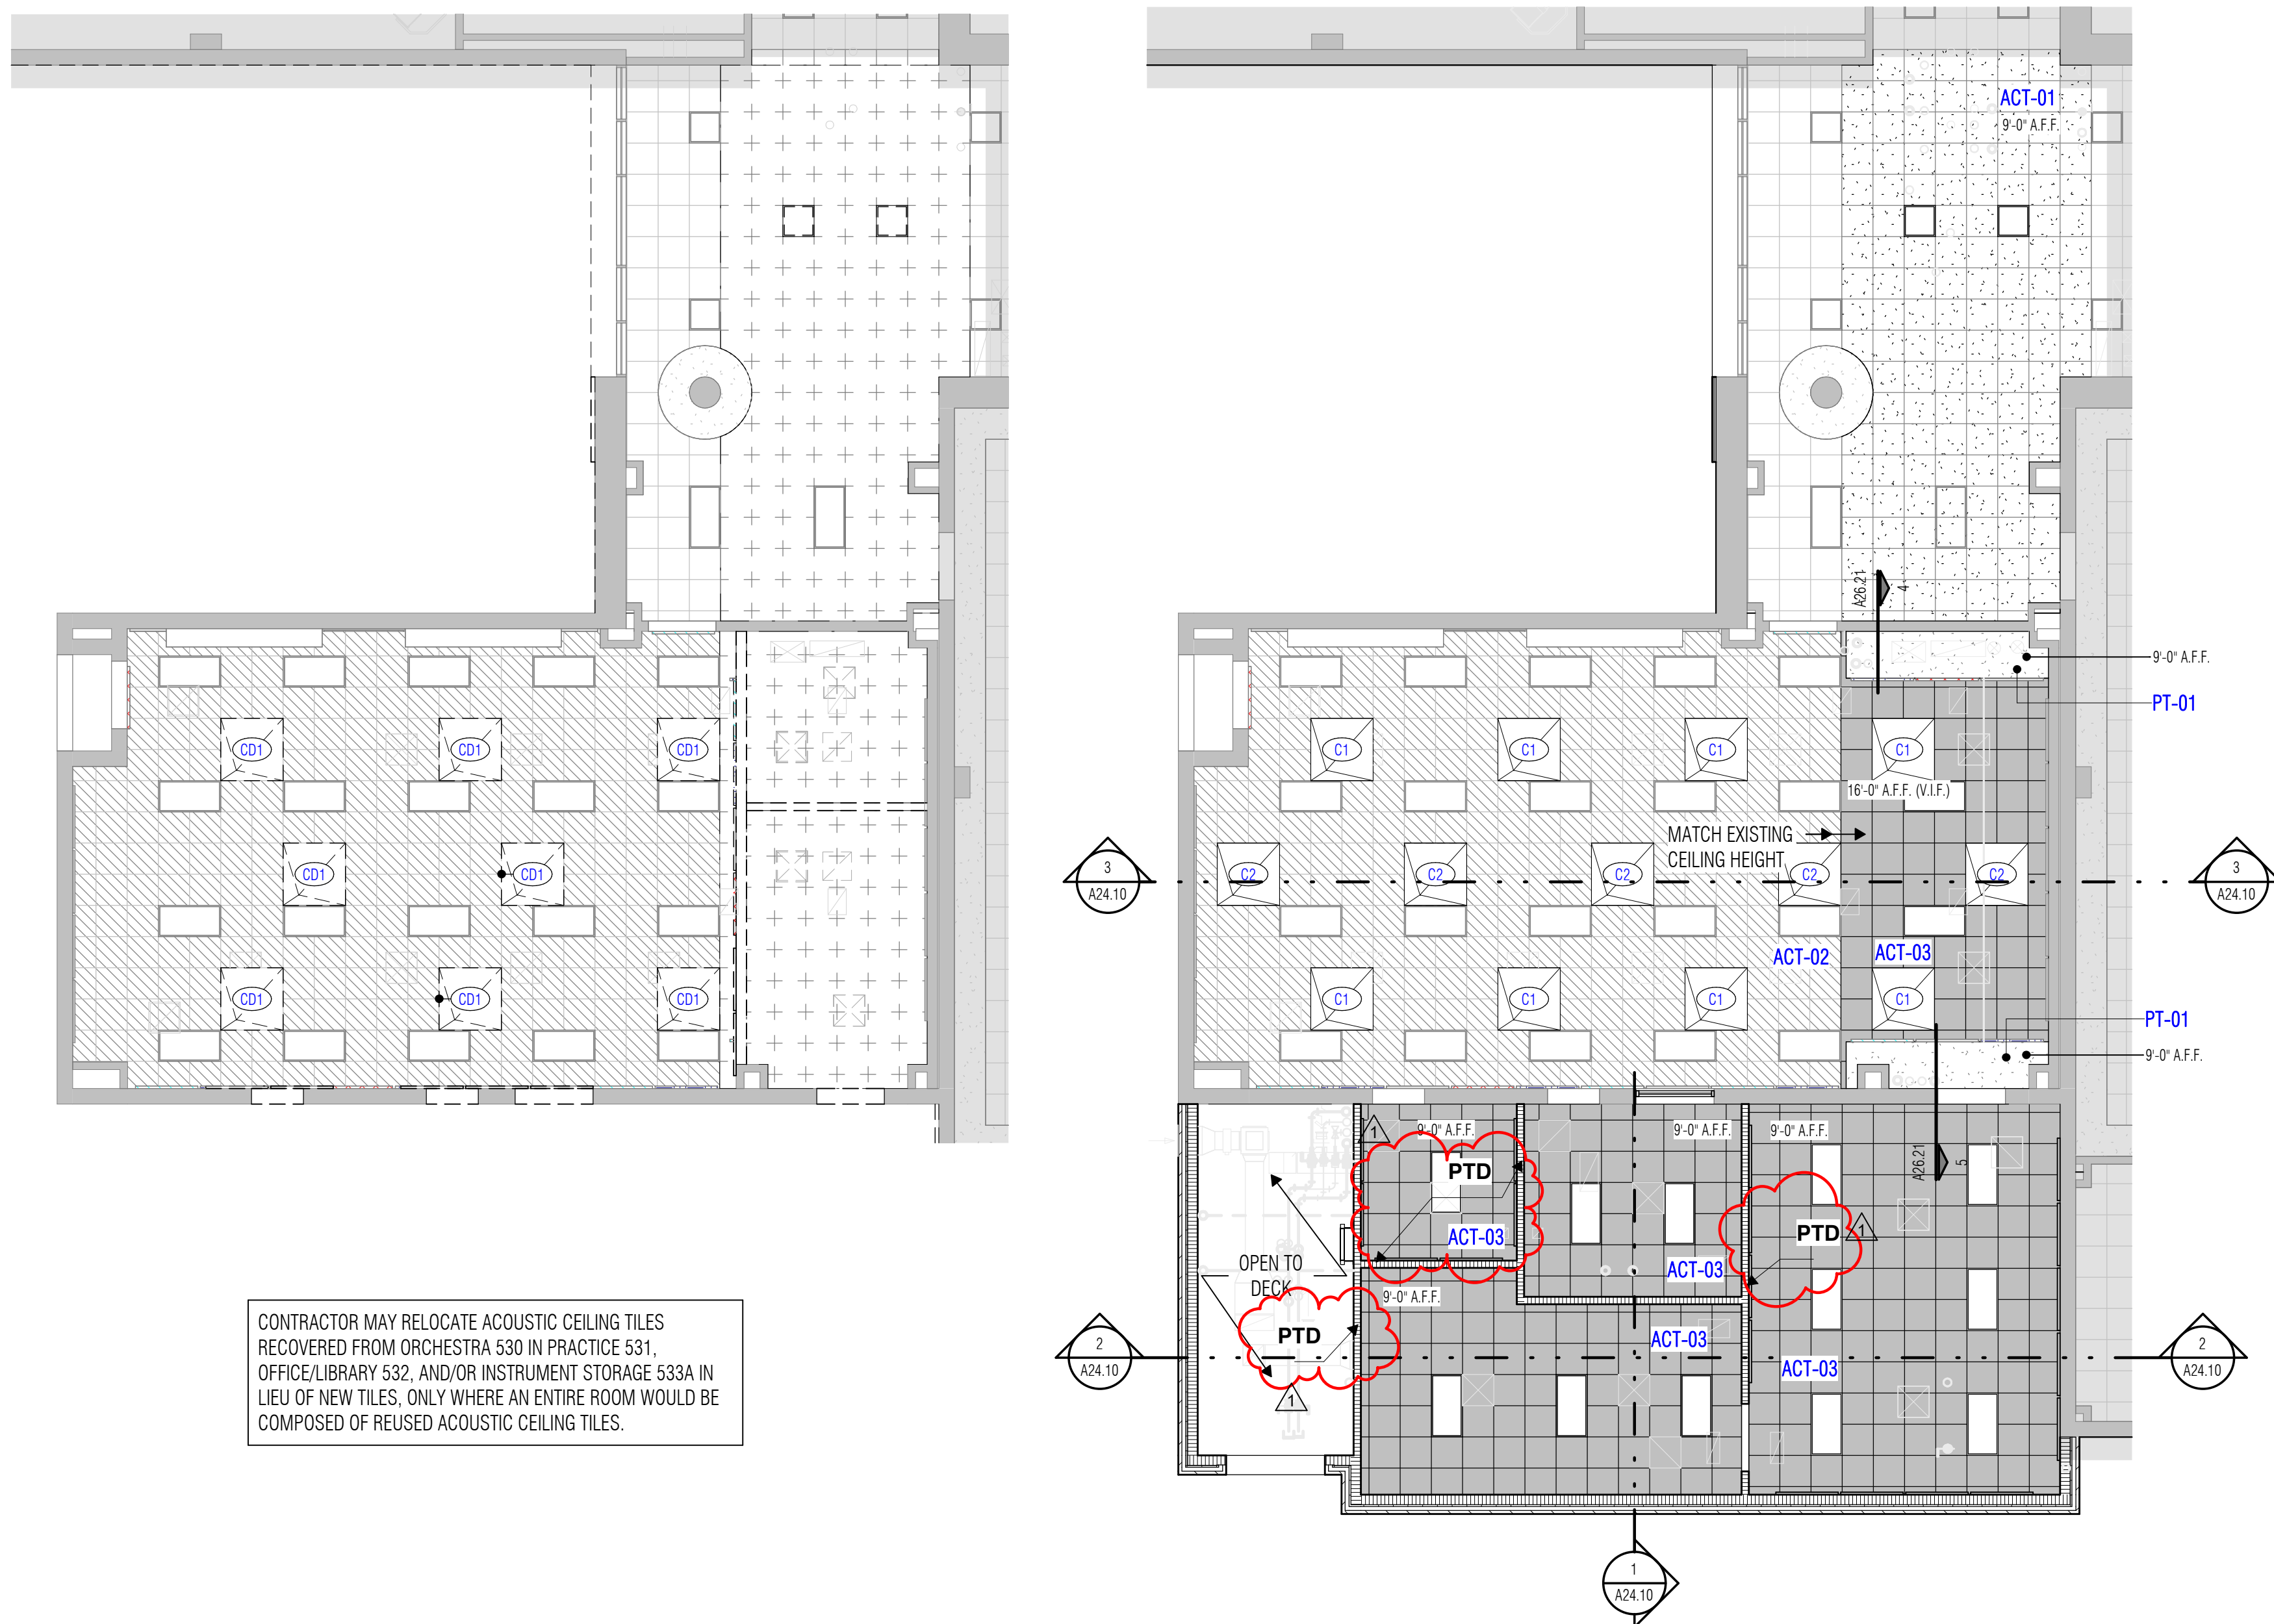


CONTRACTOR MAY RELOCATE ACOUSTIC CEILING TILES RECOVERED FROM ORCHESTRA 530 IN PRACTICE 531, OFFICE/LIBRARY 532, AND/OR INSTRUMENT STORAGE 533A IN LIEU OF NEW TILES, ONLY WHERE AN ENTIRE ROOM WOULD BE COMPOSED OF REUSED ACOUSTIC CEILING TILES.

1 LABAY ORCH ENLG DEMO RCP
SCALE: 1/8" = 1'-0"


2 LABAY ORCH ENLG RCP
SCALE: 1/8" = 1'-0"

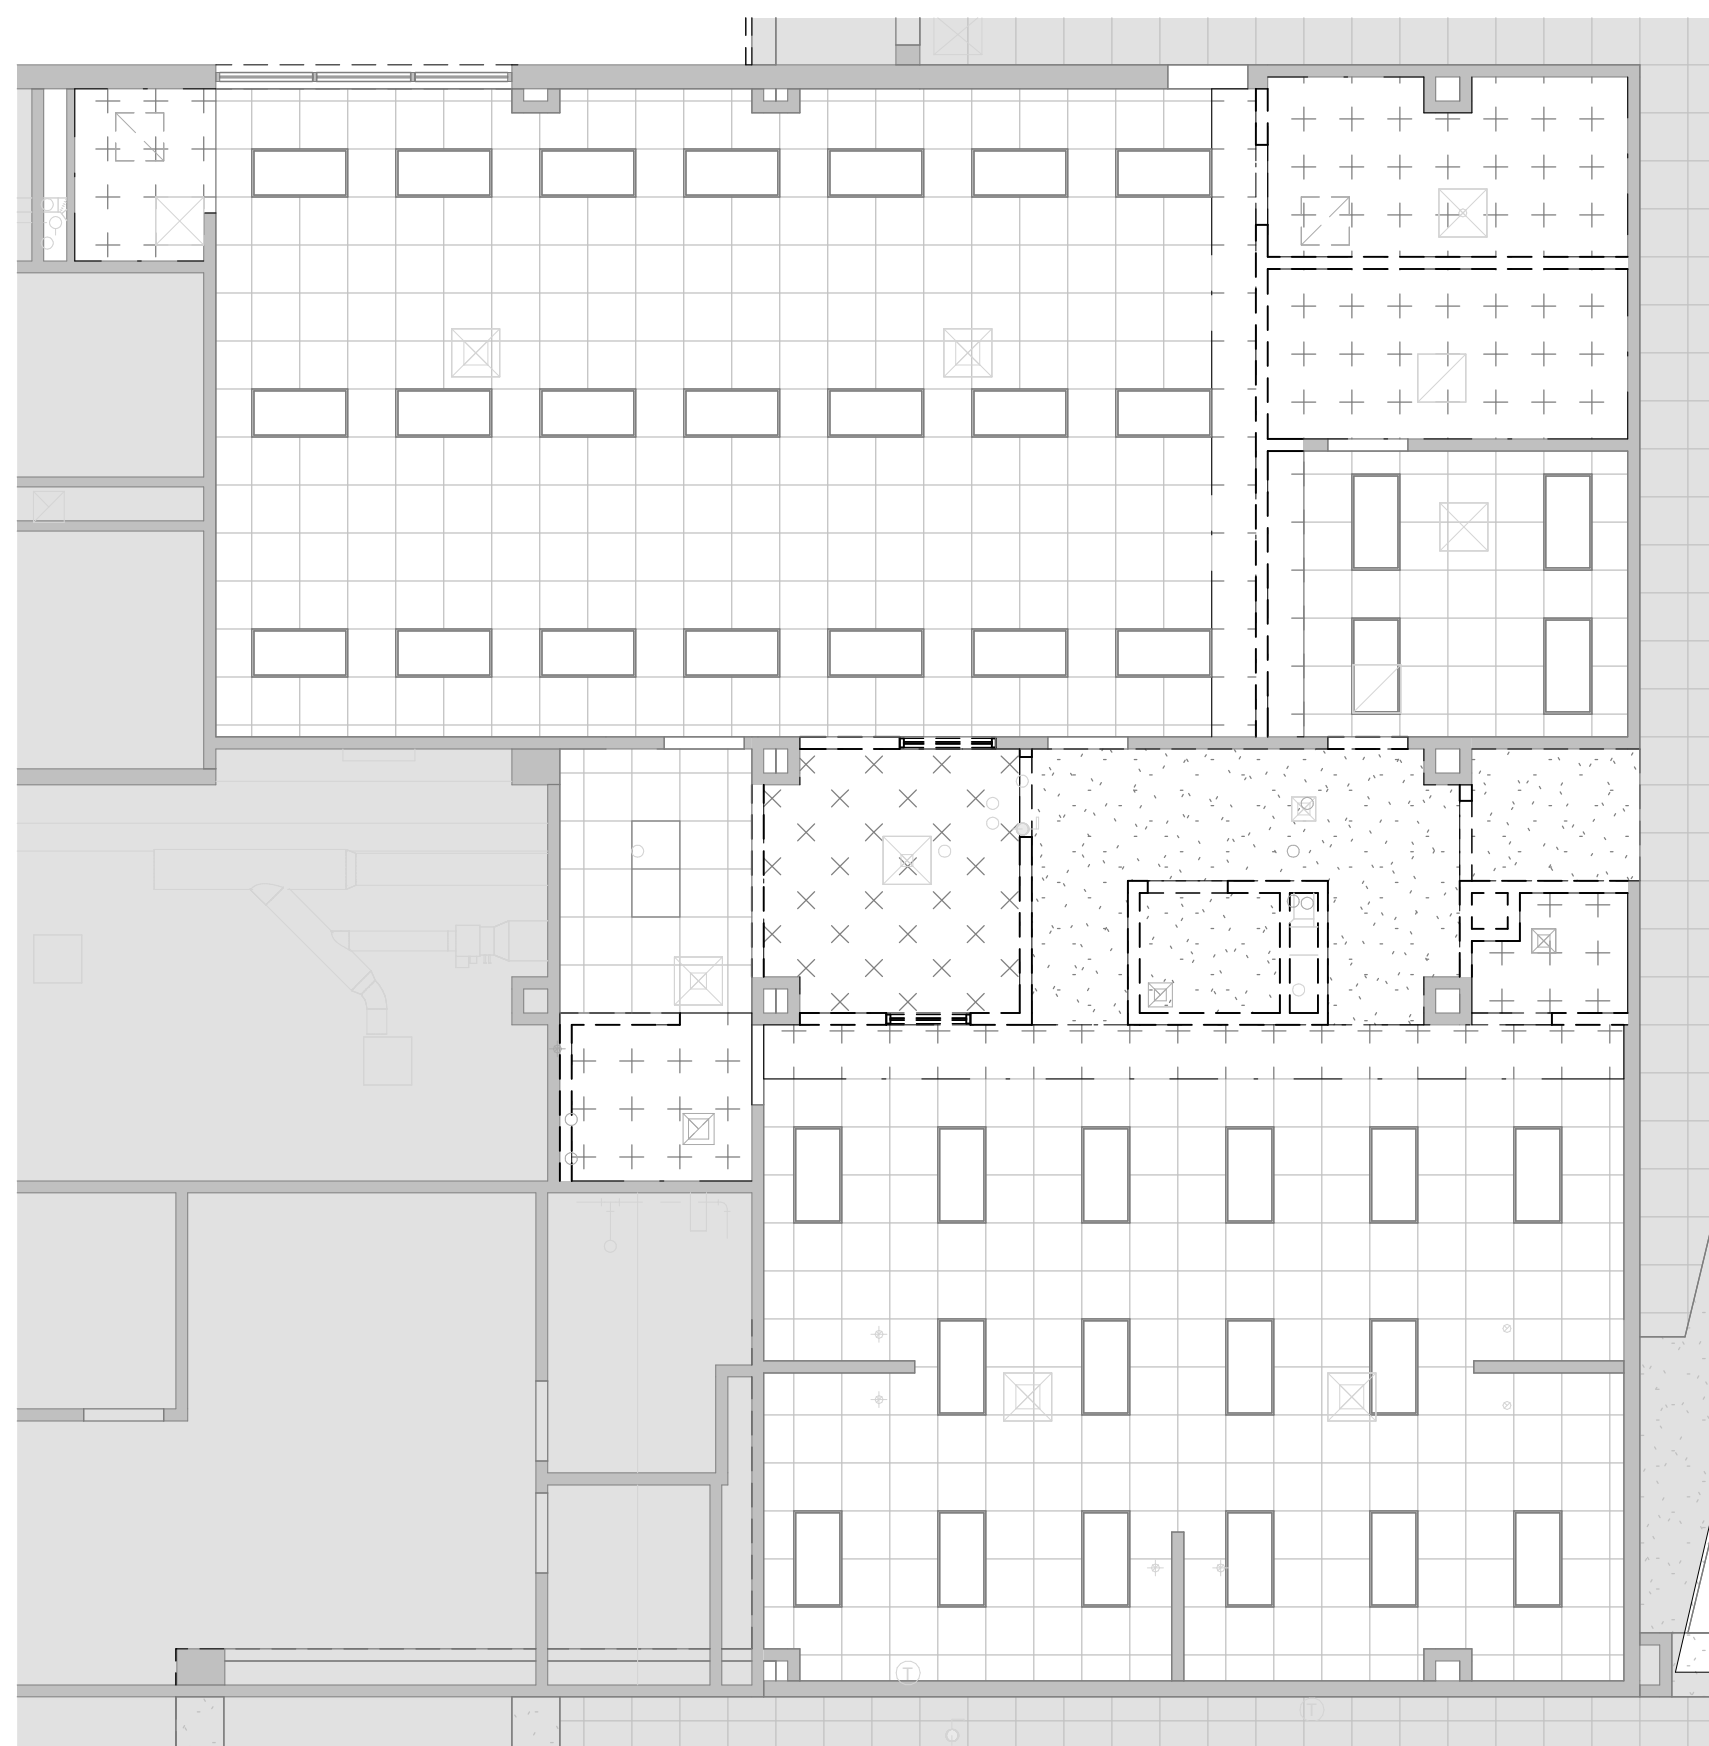


3 LABAY FCS ENLG DEMO RCP
SCALE: 1/8" = 1'-0"

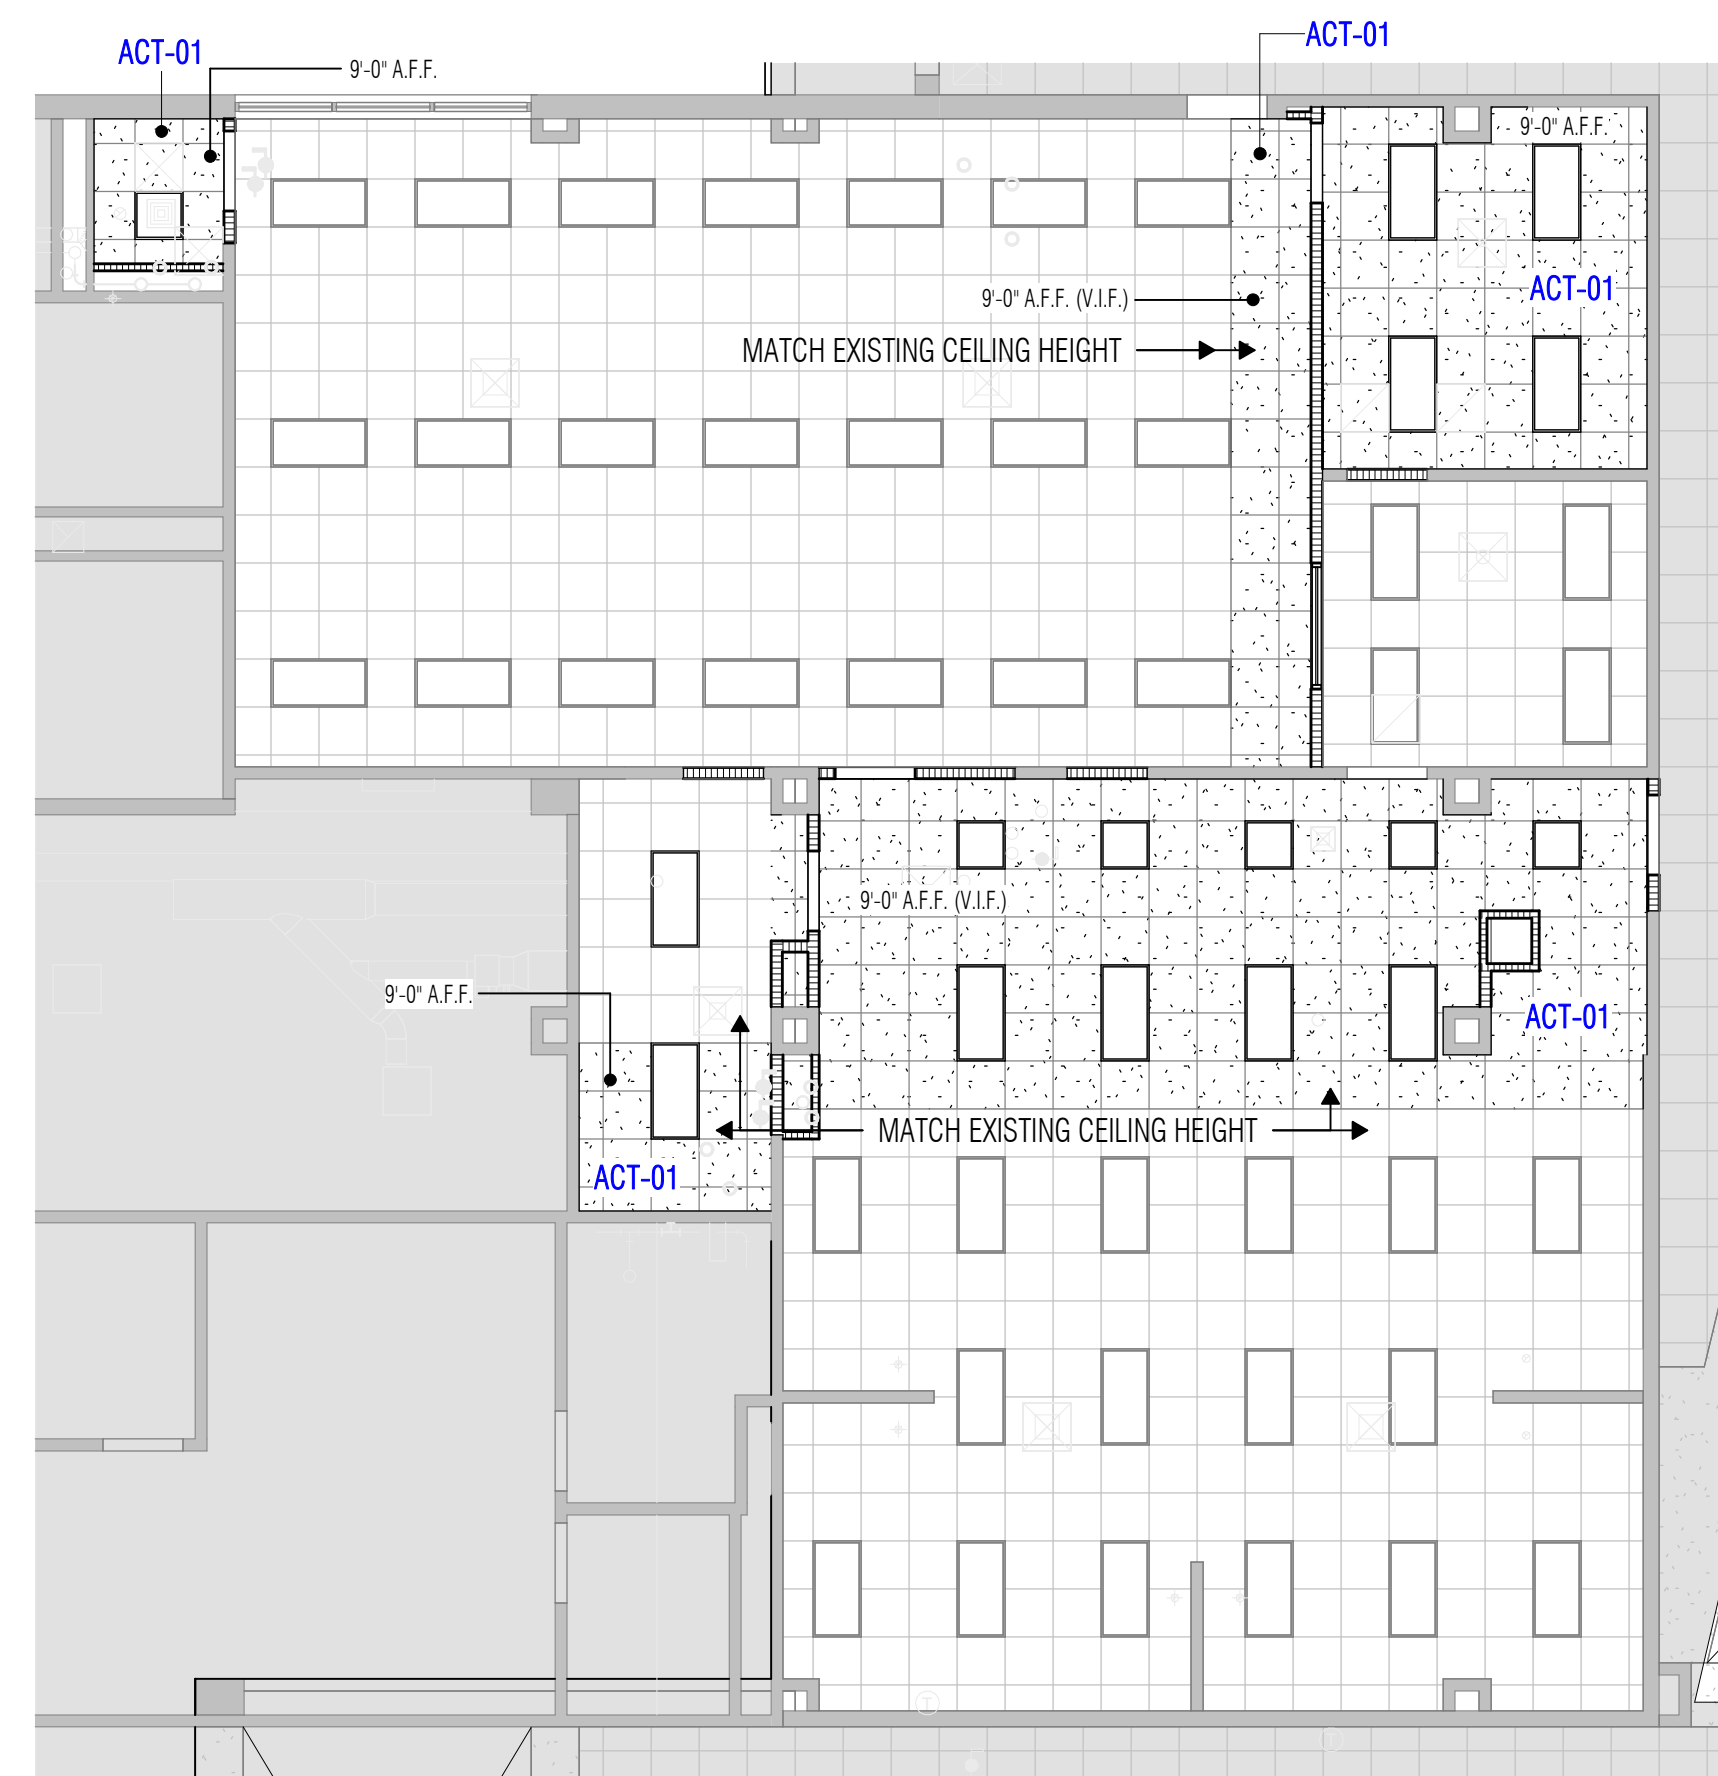

4 LABAY FCS ENLG RCP
SCALE: 1/8" = 1'-0"

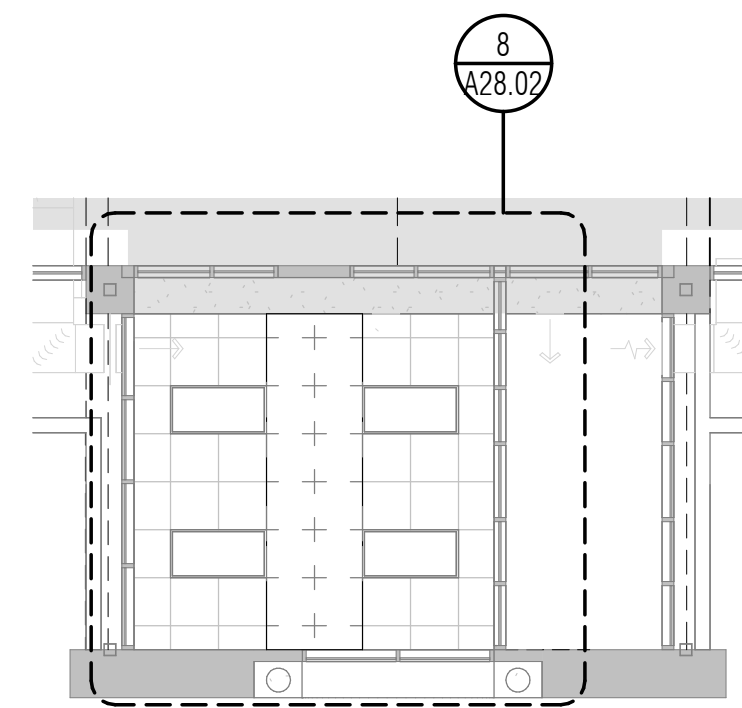


5 LABAY REC ENLG DEMO RCP
SCALE: 1/8" = 1'-0"

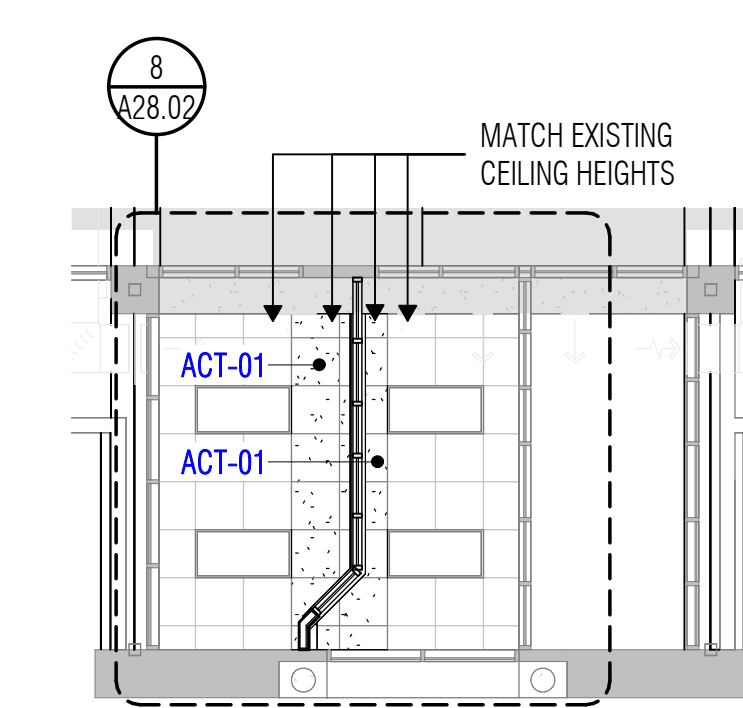

6 LABAY REC ENLG RCP
SCALE: 1/8" = 1'-0"

DEMOLITION REFLECTED CEILING PLAN LEGEND

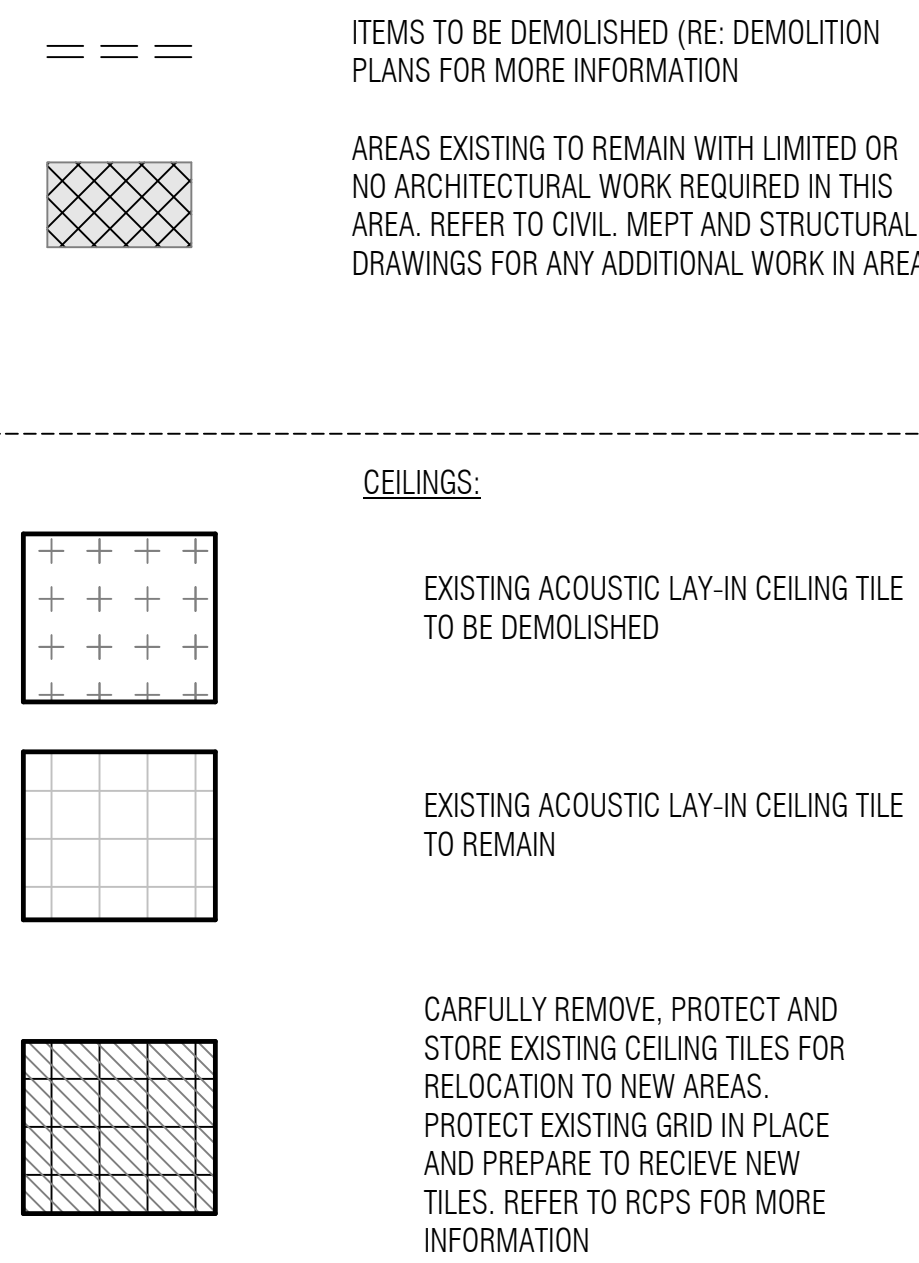


KEYNOTE LEGEND

C1	RELOCATED EXISTING CEILING PYRAMID SOUND DIFFUSER
C2	NEW CEILING PYRAMID SOUND DIFFUSER TO MATCH EXISTING.
CD1	CAREFULLY REMOVE AND PROTECT EXISTING PYRAMID DIFFUSERS. PREPARE FOR RELOCATION (RE: NEW CONSTRUCTION REFLECTED CEILING PLAN).

REFLECTED CEILING PLAN NOTES

- All new ceiling heights shall be 9'-0" A.F.F. unless noted otherwise.
- Where new ceilings are connected to existing ceilings, match existing ceiling height unless noted otherwise.
- Refer to A' 6.22 for Typical Gypsum Board Ceiling Control Joint Detail.
- Provide vented reveals at perimeter of all non-insulated exterior plaster soffits. Provide venting strips or perforated panels at perimeter of all non-insulated metal panel soffits (refer to Detail /A6.1). Venting at non-insulated soffits shall be provided whether specifically indicated on the drawings or not.
- Provide partition to deck (PTD) at walls surrounding spaces with exposed structure. Refer to Reflected Ceiling Plan Legend for PTD requirements.
- Provide hold-down clips for all acoustic lay-in ceiling panels at vestibules, at sloped ceilings, at fire-rated ceilings, and within 6 feet of exterior doors without vestibules.
- At ceiling turning details, the suspended assemblies, bracing, blocking, etc. shown on the details are for schematic representation only. Provide stable, secure and permanent assemblies at these locations in accordance with recommended light-gage steel framing installation practices.
- At partitions that do not extend to deck above, extend partition 4" minimum above highest adjacent ceiling and brace per Floor Plan Legend and Floor Plan Notes.
- Contractor shall locate new ceiling grid according to the architectural reflected ceiling plans. Contractor shall locate equipment locations shown on consultant drawings accordingly.
- Contractor to locate new equipment centered in ceiling tiles. Notify Architect of any discrepancies.

REFLECTED CEILING PLAN LEGEND

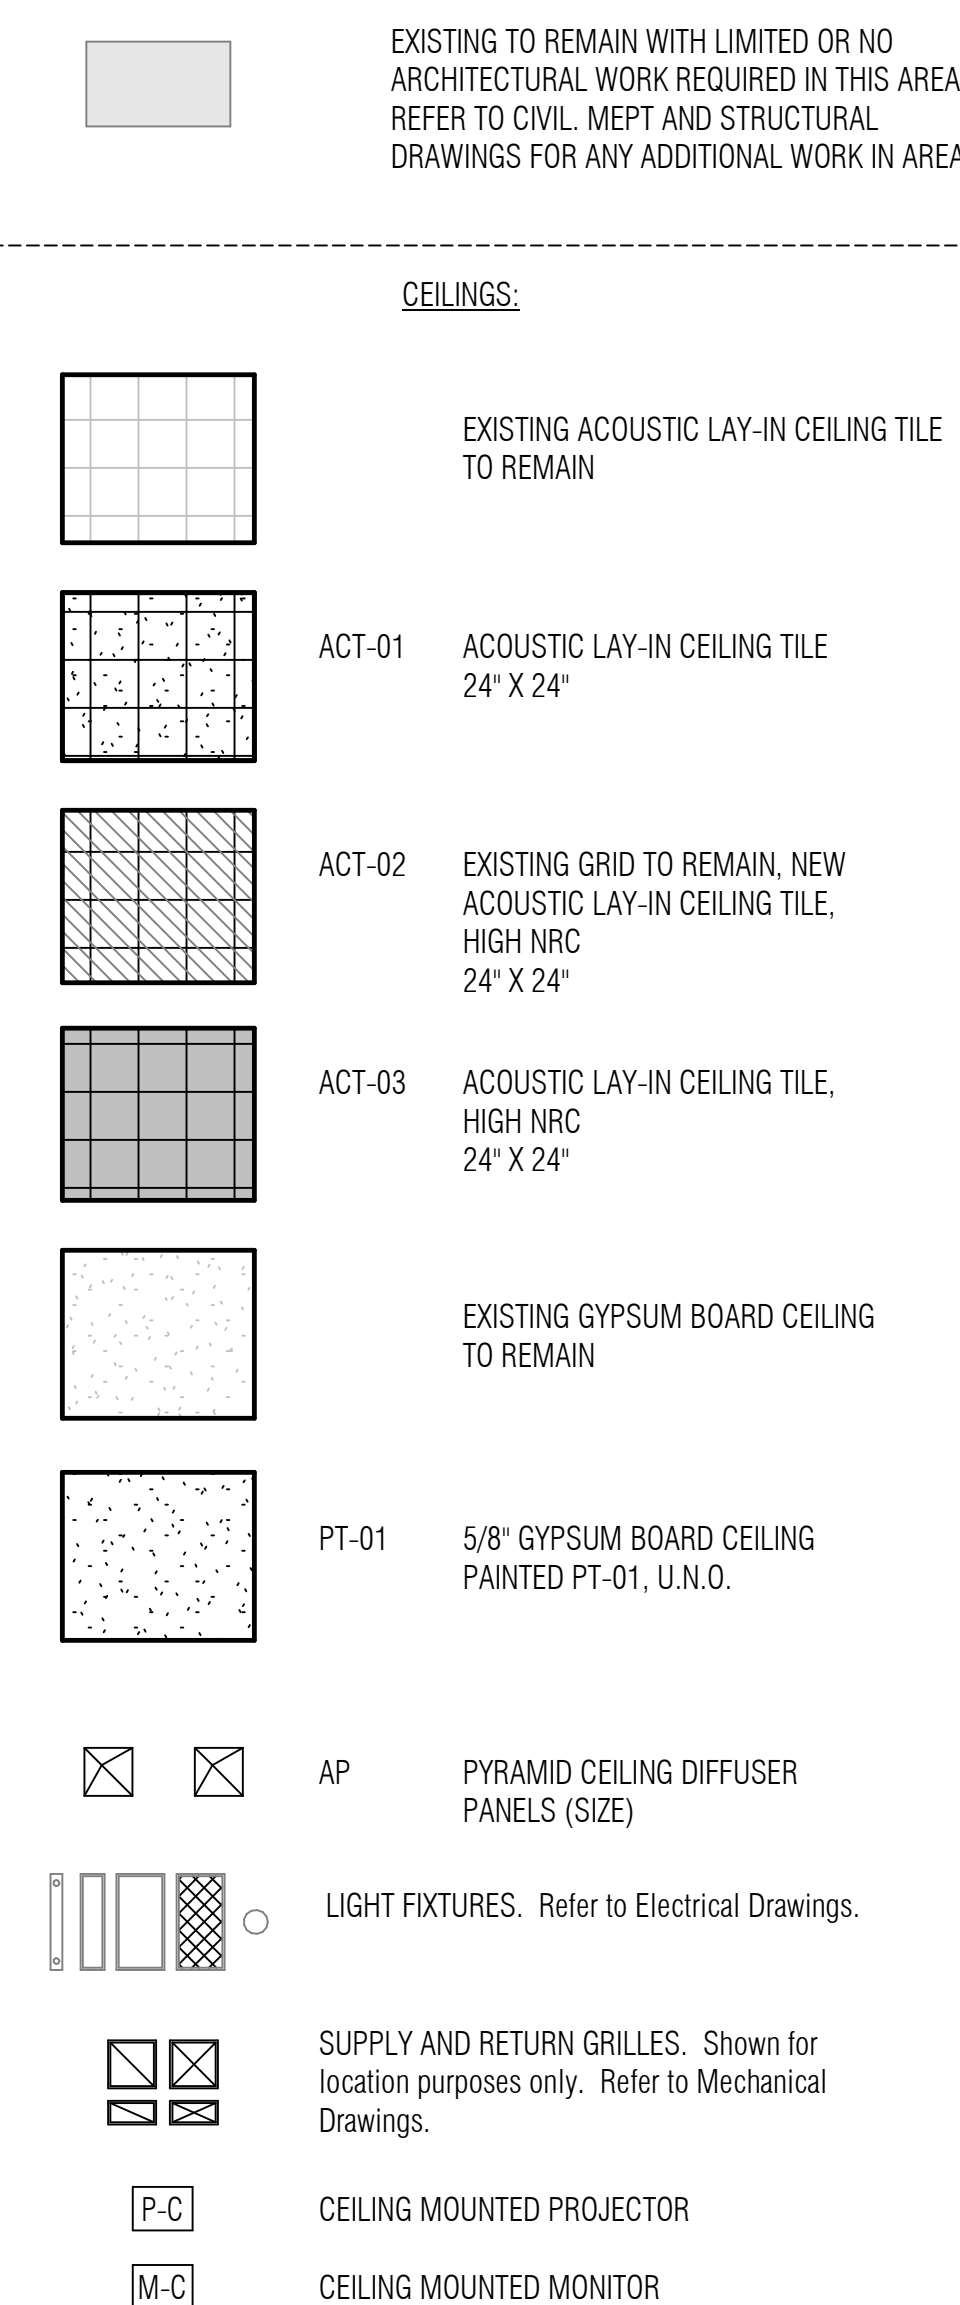


PARTITION LEGEND

- 1HR - 1-HOUR FIRE BARRIER PARTITION. Extend partition to deck above and seal with firestopping sealant as required for fire-resistance requirements. Paint stenciled label on partitions above ceiling at 15'-0" o.c. as follows: '1-HOUR FIRE AND SMOKE BARRIER - PROTECT ALL OPENINGS'. Brace partitions per Floor Plan General Notes.
- 2HR - 2-HOUR FIRE BARRIER PARTITION. Extend partition to deck above and seal with firestopping sealant as required for fire-resistance requirements. Paint stenciled label on partitions above ceiling at 15'-0" o.c. as follows: '2-HOUR FIRE AND SMOKE BARRIER - PROTECT ALL OPENINGS'. Brace partitions per Floor Plan General Notes.
- SMK - SMOKE PARTITION. Extend partition to deck above and seal with sealant as required to resist the passage of smoke. Seal all joints and penetrations. Brace partitions per Floor Plan General Notes.
- SND - ACOUSTICAL DRYWALL PARTITION / SOUND-CONDITIONED CMU PARTITION. Extend partition to deck above and seal with acoustical sealant. Seal all joints and penetrations with acoustical sealant. Brace partitions per Floor Plan General Notes.
- PTD - NON-RATED PARTITION TO DECK. Extend partition to deck above. Brace partitions per Floor Plan General Notes.



ARCHITECT
VLK Architects
20445 State Hwy 249, Suite 350
Houston, Texas 77070
Main Phone: 281.671.2300
www.vlkarchitects.com

CYPRESS-FAIRBANKS INDEPENDENT SCHOOL DISTRICT
HOUSTON, TEXAS

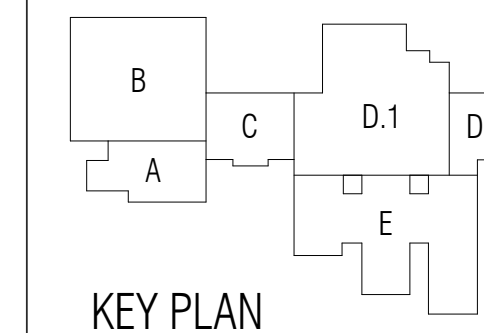

KEY PLAN



ISSUED: February 24, 2025

Revision No.	Revision Date
1 Addendum 1	03-06-2025

Director
RSJ
Designer

Drawn By
STH, KM
Quality Control

PROJECT NO.

24-010.00


SHEET TITLE

LABAY - ENLARGED REFLECTED CEILING PLANS

SHEET NO.

A26.20

2024 Cook, Labay & Truitt MS Renovations

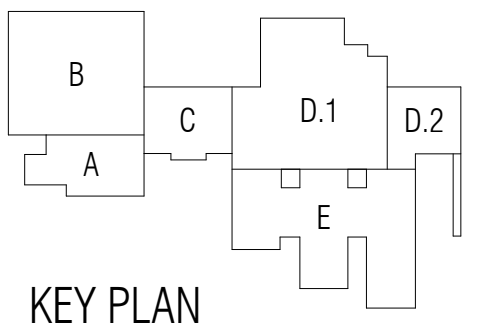

KEY PLAN



03/06/2025

ISSUED: February 24, 2025

REVISIONS

Revision No.	Revision Date
1 Addendum 1	03-06-2025

Director: RSJ
Design: STH, KM
Quality Control: TQ

Proj. Arch.: TQ

PROJECT NO.

24-010.00

SHEET TITLE

LABAY - ENLARGED REFLECTED CEILING PLANS & DETAILS

SHEET NO.

A26.21

DEMOLITION REFLECTED CEILING PLAN LEGEND

	ITEMS TO BE DEMOLISHED (RE: DEMOLITION PLANS FOR MORE INFORMATION)
	AREAS EXISTING TO REMAIN WITH LIMITED OR NO ARCHITECTURAL WORK REQUIRED IN THIS AREA. REFER TO CIVIL, MEPT AND STRUCTURAL DRAWINGS FOR ANY ADDITIONAL WORK IN AREA.
CEILING:	
	EXISTING ACOUSTIC LAY-IN CEILING TILE TO BE DEMOLISHED
	EXISTING ACOUSTIC LAY-IN CEILING TILE TO REMAIN
	CAREFULLY REMOVE, PROTECT AND STORE EXISTING CEILING TILES FOR RELOCATION TO NEW AREAS. PROTECT EXISTING GRID IN PLACE AND PREPARE TO RECEIVE NEW TILES. REFER TO RCPS FOR MORE INFORMATION

REFLECTED CEILING PLAN NOTES


- All new ceiling heights shall be 9'-0" A.F.F. unless noted otherwise.
- Where new ceilings are connected to existing ceilings, match existing ceiling height unless noted otherwise.
- Refer to A' 6.22 for Typical Gypsum Board Ceiling Control Joint Detail.
- Provide vented reveals at perimeter of all non-insulated exterior plaster soffits. Provide venting strips or perforated panels at perimeter of all non-insulated metal panel soffits (refer to Detail _J6_). Venting at non-insulated soffits shall be provided whether specifically indicated on the drawings or not.
- Provide partition to deck (PTD) at walls surrounding spaces with exposed structure. Refer to Reflected Ceiling Plan Legend for PTD requirements.
- Provide hold-down clips for all acoustic lay-in ceiling panels at vestibules, at sloped ceilings, at fire-rated ceilings, and within 6 feet of exterior doors without vestibules.
- At ceiling furring details, the suspended assemblies, bracing, blocking, etc. shown on the details are for schematic representation only. Provide stable, secure and permanent assemblies at these locations in accordance with recommended light-gage steel framing installation practices.
- At partitions that do not extend to deck above, extend partition 4" minimum above highest adjacent ceiling and brace per Floor Plan Legend and Floor Plan Notes.
- Contractor shall locate new ceiling grid according to the architectural reflected ceiling plans. Contractor shall locate equipment locations shown on consultant drawings accordingly.
- Contractor to locate new equipment centered in ceiling tiles. Notify Architect of any discrepancies.

REFLECTED CEILING PLAN LEGEND


	EXISTING TO REMAIN WITH LIMITED OR NO ARCHITECTURAL WORK REQUIRED IN THIS AREA. REFER TO CIVIL, MEPT AND STRUCTURAL DRAWINGS FOR ANY ADDITIONAL WORK IN AREA.
CEILING:	
	EXISTING ACOUSTIC LAY-IN CEILING TILE TO REMAIN
	ACT-01 ACOUSTIC LAY-IN CEILING TILE 24" X 24"
	ACT-02 EXISTING GRID TO REMAIN, NEW ACOUSTIC LAY-IN CEILING TILE, HIGH NRC 24" X 24"
	ACT-03 ACOUSTIC LAY-IN CEILING TILE, HIGH NRC 24" X 24"
	EXISTING GYPSUM BOARD CEILING TO REMAIN
	PT-01 5/8" GYPSUM BOARD CEILING PAINTED PT-01, U.N.O.
	AP PYRAMID CEILING DIFFUSER PANELS (SIZE)
	LIGHT FIXTURES. Refer to Electrical Drawings.
	SUPPLY AND RETURN GRILLES. Shown for location purposes only. Refer to Mechanical Drawings.
	CEILING MOUNTED PROJECTOR
	CEILING MOUNTED MONITOR

PARTITION LEGEND


	1-HOUR FIRE BARRIER PARTITION. Extend partition to deck above and seal with firestopping sealant as required for fire-resistance requirements. Paint stenciled label on partitions above ceiling at 15'-0" o.c. as follows: '1-HOUR FIRE AND SMOKE BARRIER - PROTECT ALL OPENINGS'. Brace partitions per Floor Plan General Notes.
	2-HOUR FIRE BARRIER PARTITION. Extend partition to deck above and seal with firestopping sealant as required for fire-resistance requirements. Paint stenciled label on partitions above ceiling at 15'-0" o.c. as follows: '2-HOUR FIRE AND SMOKE BARRIER - PROTECT ALL OPENINGS'. Brace partitions per Floor Plan General Notes.
	SMOKE PARTITION. Extend partition to deck above and seal with sealant as required to resist the passage of smoke. Seal all joints and penetrations. Brace partitions per Floor Plan General Notes.
	ACOUSTICAL DRYWALL PARTITION / SOUND-CONDITIONED CMU PARTITION. Extend partition to deck above and seal with acoustical sealant. Seal all joints and penetrations with acoustical sealant. Brace partitions per Floor Plan General Notes.
	NON-RATED PARTITION TO DECK. Extend partition to deck above. Brace partitions per Floor Plan General Notes.

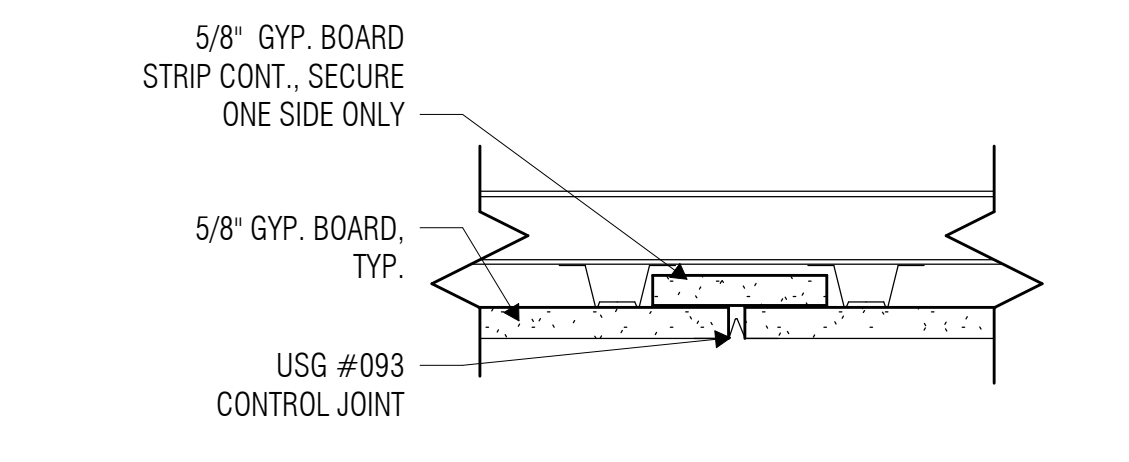


3 TYP. GYP. BD CONTROL JOINT DETAIL
SCALE: 3" = 1'-0"

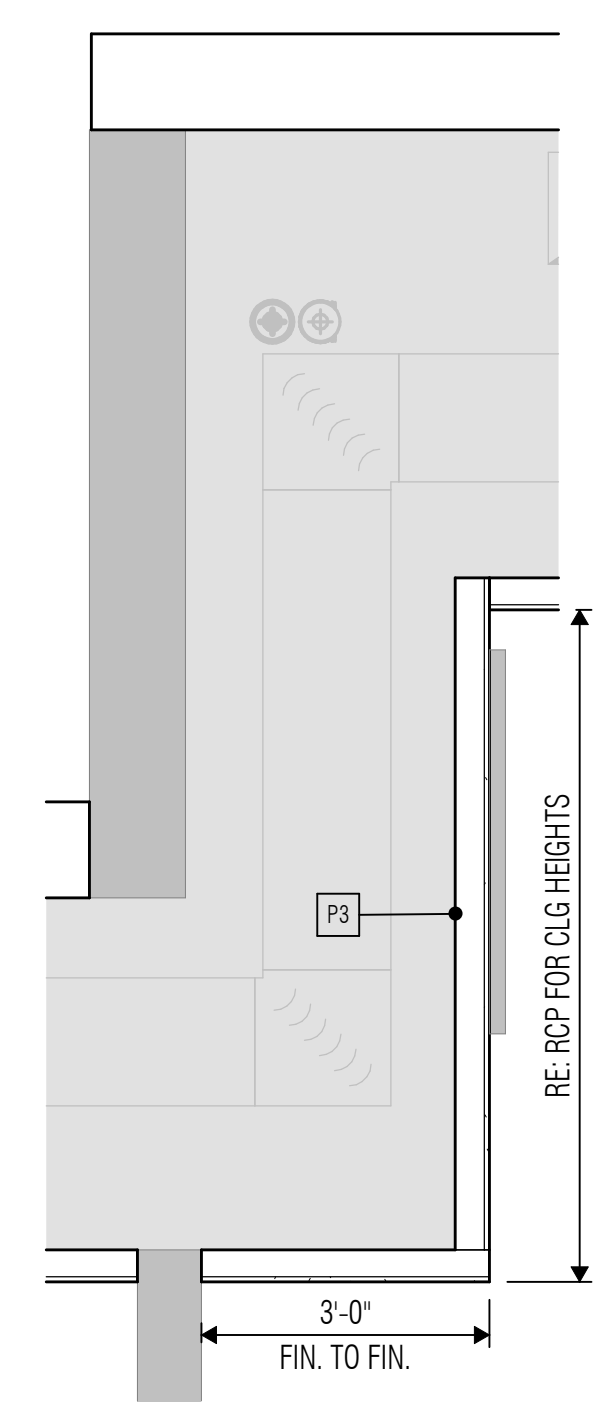


4 FURR OUT SECTION DETAIL
SCALE: 1/2" = 1'-0"

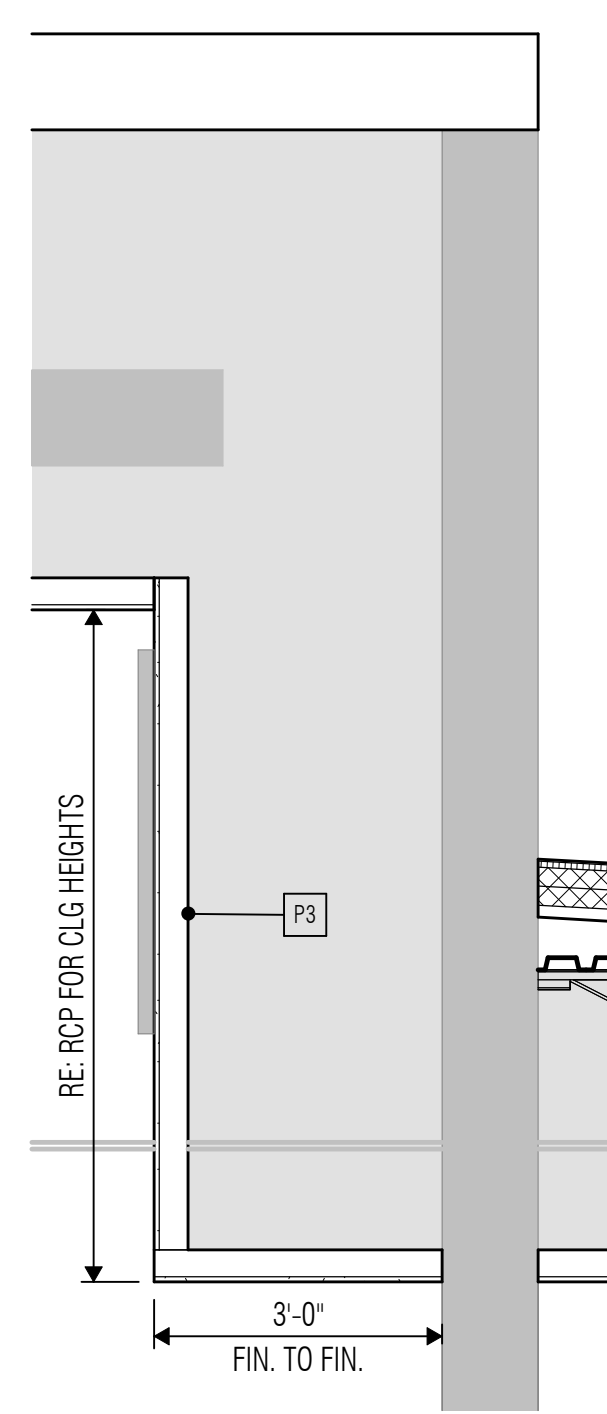

5 FURR OUT SECTION DETAIL
SCALE: 1/2" = 1'-0"

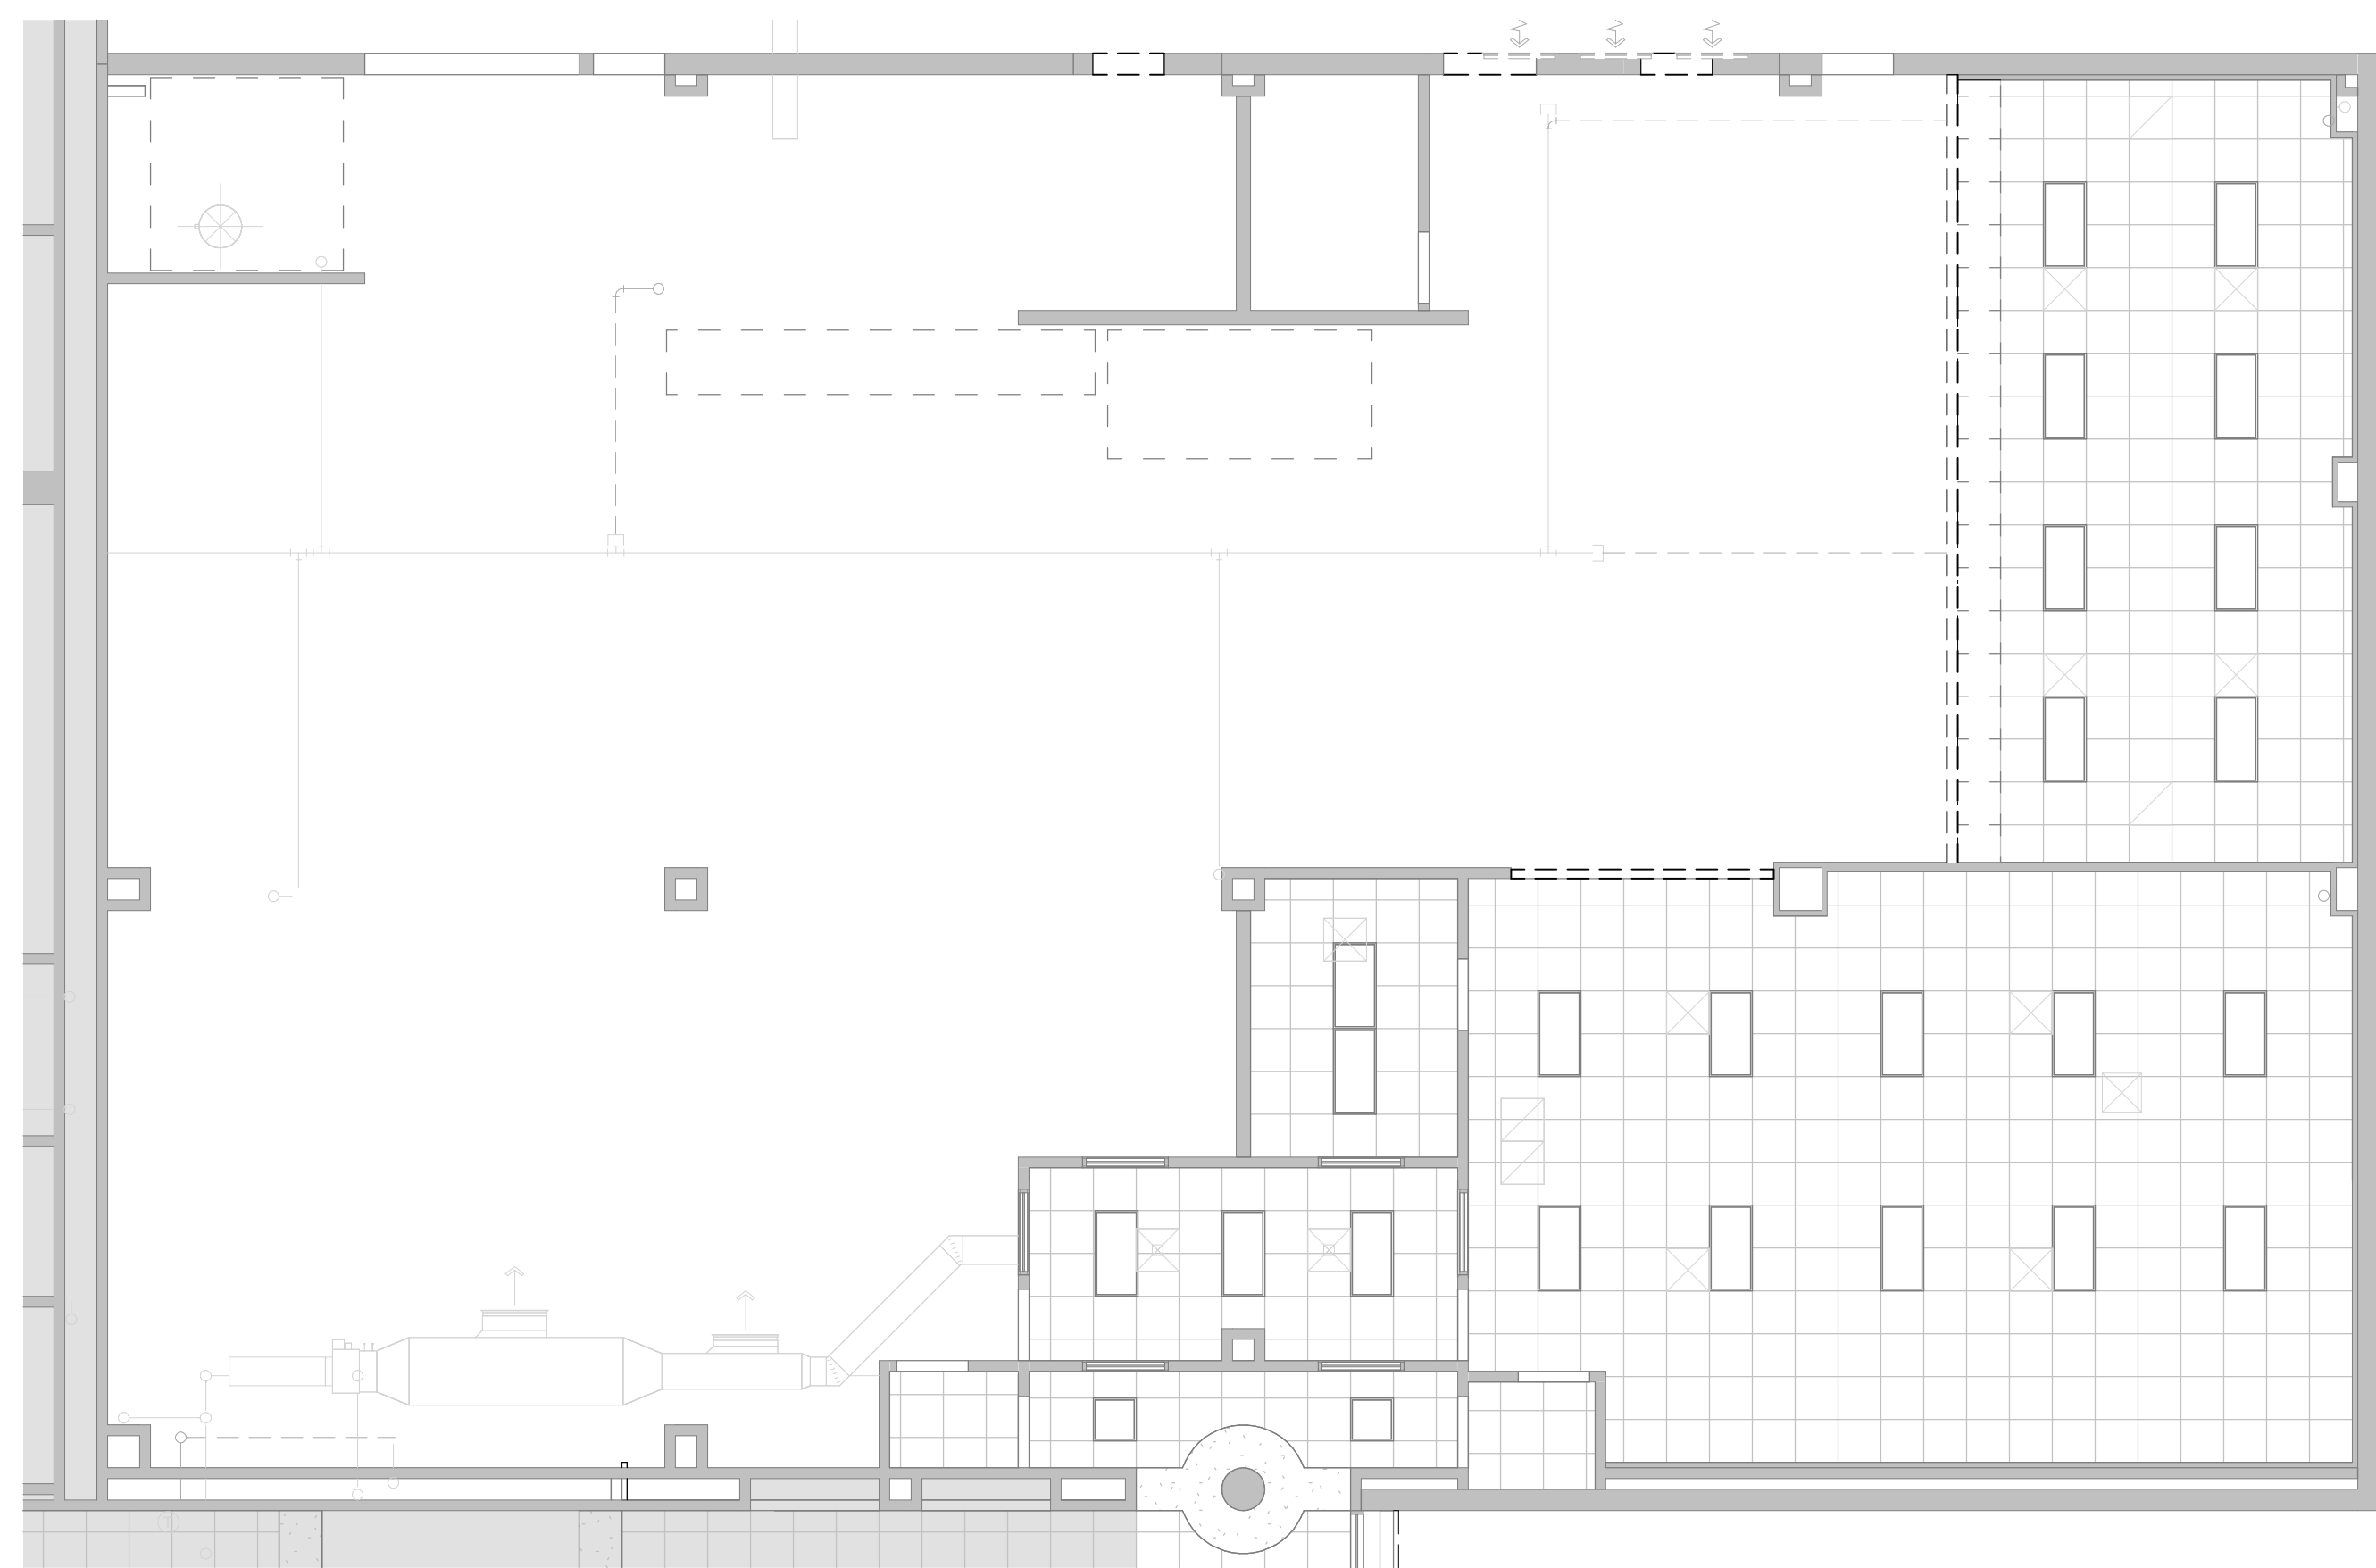

1 LABAY CTE ENLG DEMO RCP
SCALE: 1/8" = 1'-0"

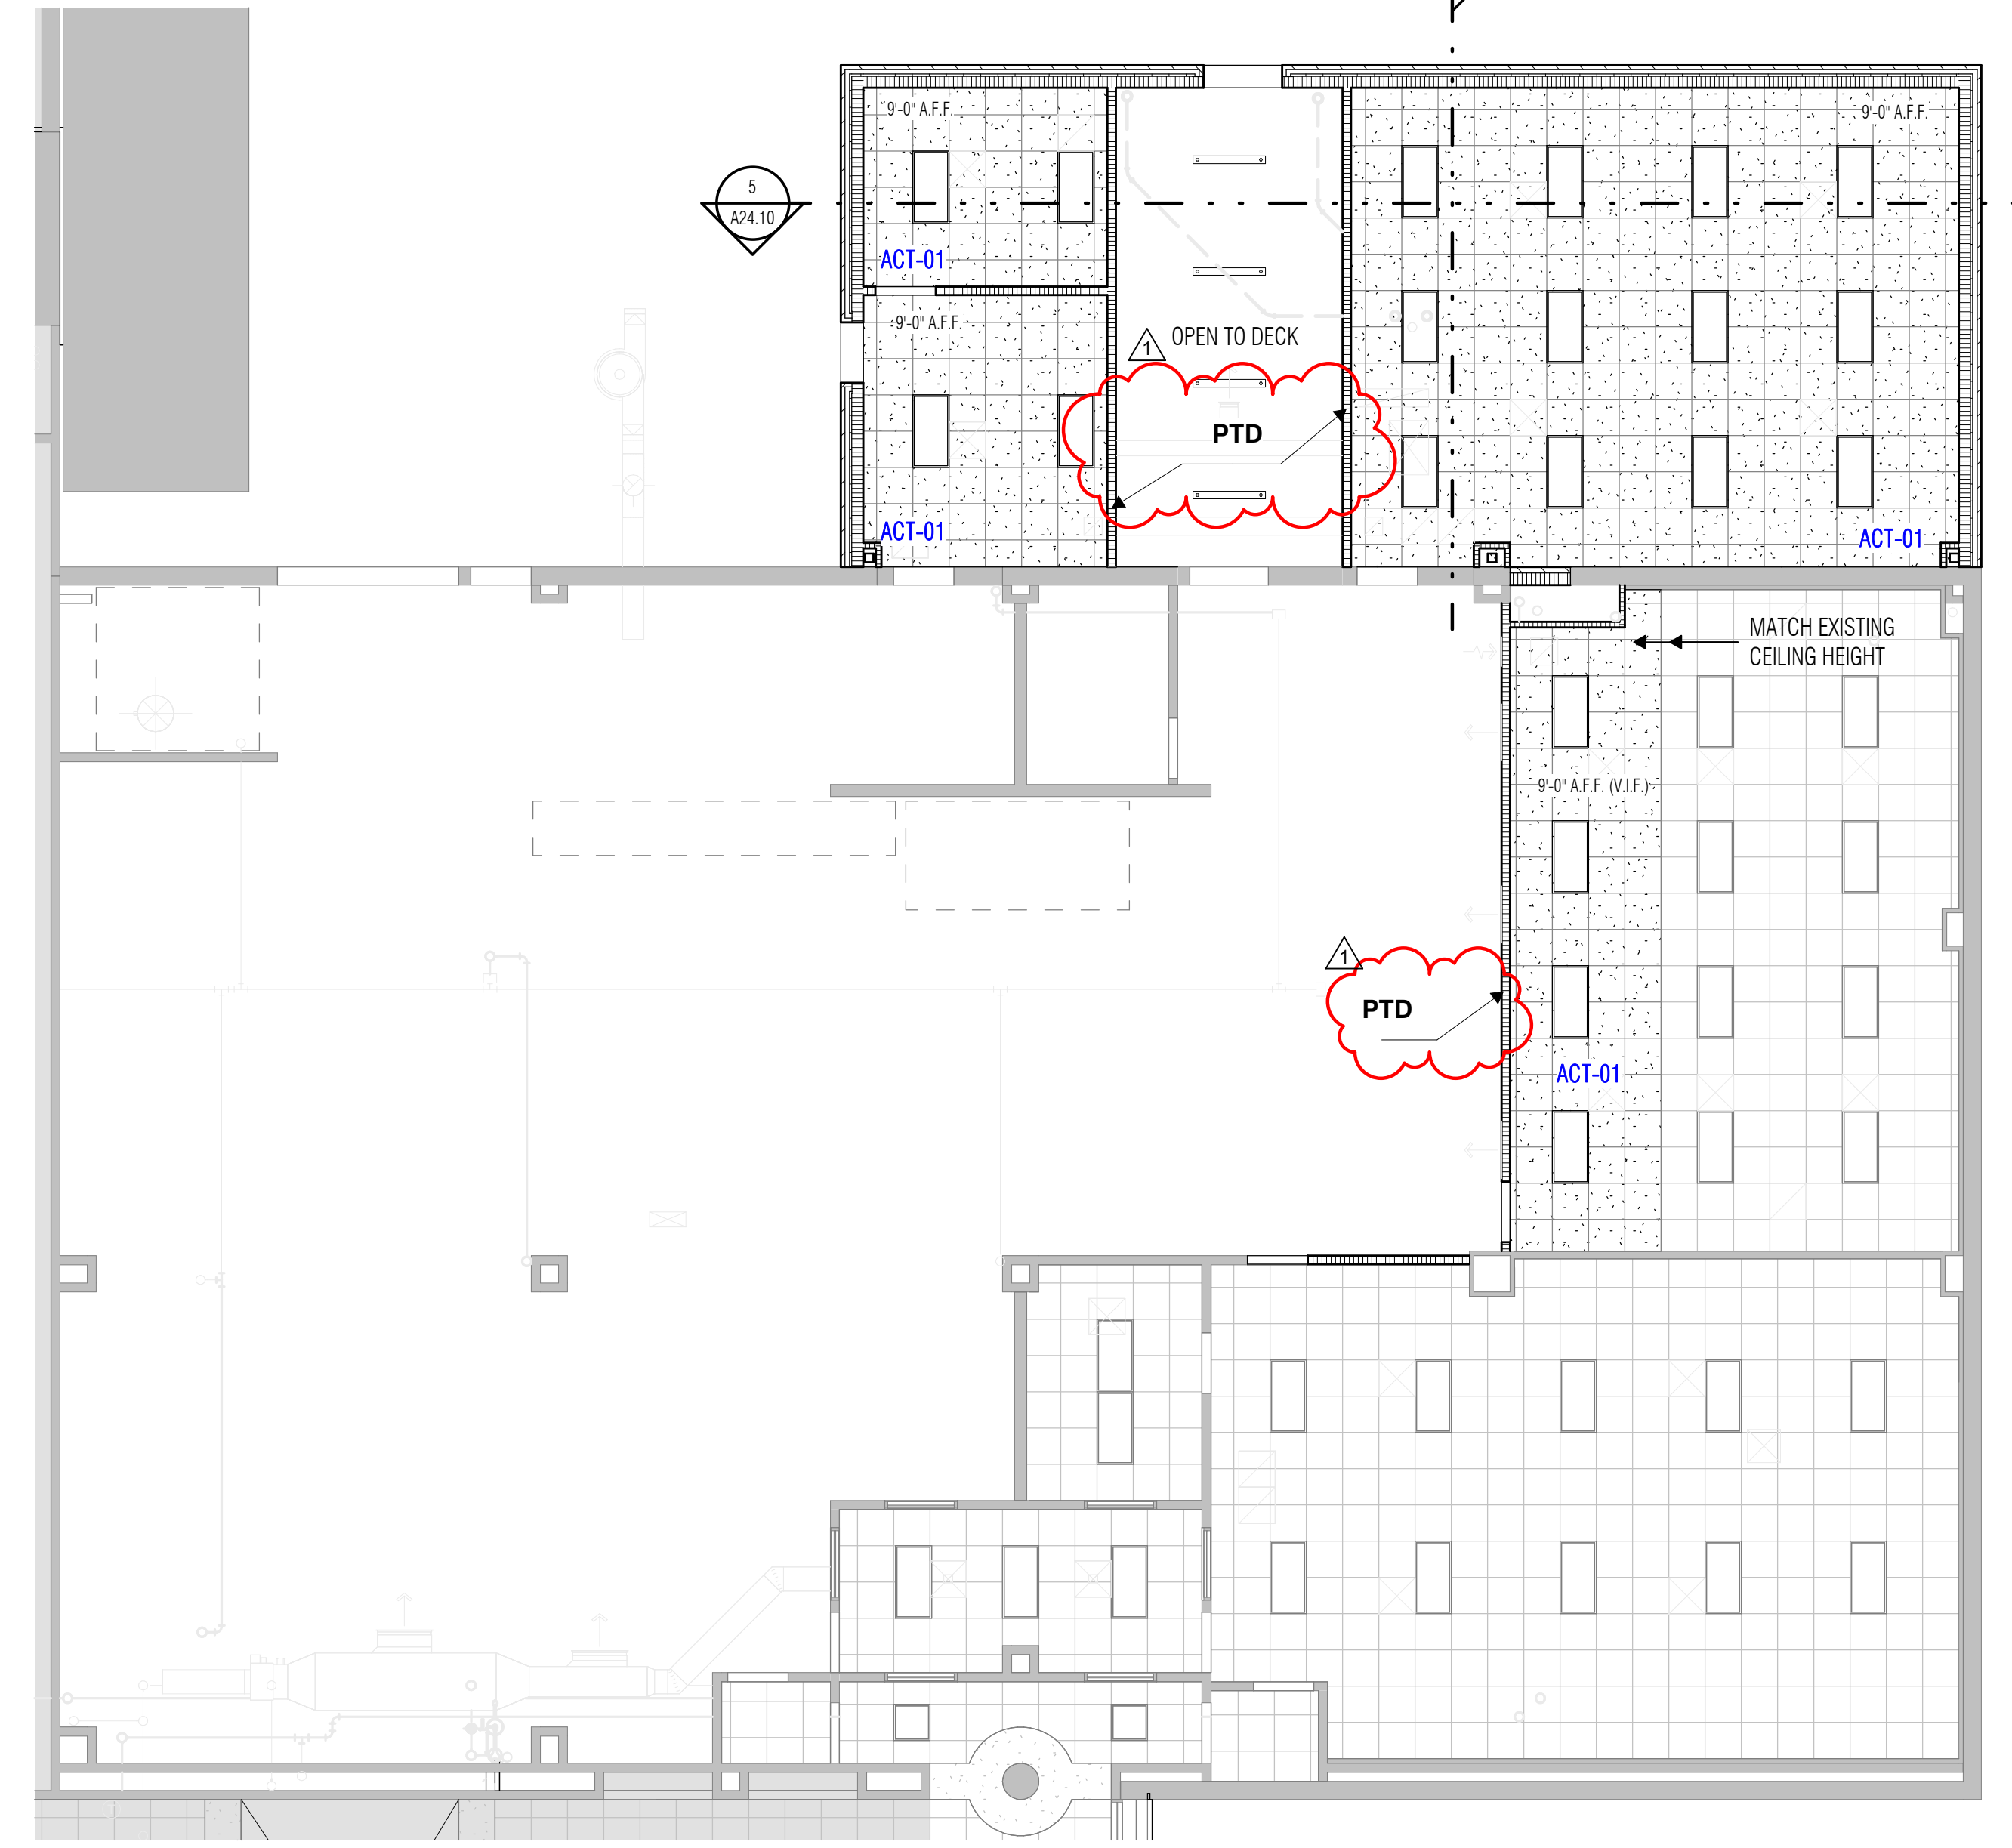

2 LABAY CTE ENLG RCP
SCALE: 1/8" = 1'-0"


DOOR NUMBER	DOOR TYPE	FRAME TYPE	DOOR OPENING WIDTH	DOOR OPENING HEIGHT	FIRE RATING	HDWR SET	REMARKS	DOOR NUMBER	DOOR TYPE	FRAME TYPE	DOOR OPENING WIDTH	DOOR OPENING HEIGHT	FIRE RATING	HDWR SET	REMARKS
1	X-SFD		6'-1 1/2"	7'-0"		3.0		27	X-SF		3'-0"	8'-7"		15.0	
2	X-SF		3'-0"	7'-0"		1.0		107	X-NL2		3'-0"	8'-10"		22.0	
3	X-SFD		6'-1 1/2"	7'-0"		4.0		114	X-SF		3'-0"	8'-7"		17.0	
4	X-NL2		4'-0"	8'-10"		8.0		114.1	X-SFD		6'-0"	8'-10"		18.0	
5	X-SFD		5'-8"	7'-0"		6.0		114.2	X-SFD		6'-0"	8'-10"		18.0	
6	X-F2		3'-0"	8'-10"		7.0		124	X-NL2		3'-0"	8'-10"		23.0	
7	X-F2		3'-0"	8'-10"		7.0		128	X-NL2		3'-0"	8'-10"		22.0	
8	X-F2		3'-0"	8'-10"		7.0		212	X-NL2		3'-0"	8'-10"		22.0	
9	X-F2		3'-0"	8'-10"		7.0		224	X-NL2		3'-0"	8'-10"		22.0	
10	X-F2		3'-0"	8'-10"		7.0		232	X-NL2		3'-0"	8'-10"		22.0	
11	X-SFD		6'-0"	7'-0"		6.0		236	X-NL2		3'-0"	8'-10"		22.0	
12	X-FD2		6'-0"	8'-10"		12.0		301.1	NL2		3'-0"	8'-10"		25.0	SIGN TYPE B
13	X-FD2		6'-0"	8'-10"		12.0		301.2	NL2		3'-0"	8'-10"		25.0	SIGN TYPE B
14	X-SF		3'-0"	8'-7"		2.0		302	NL2		3'-0"	8'-10"		26.0	SIGN TYPE B
15	X-SF		3'-0"	8'-7"		2.0		303A	NL2		3'-0"	8'-10"		24.0	SIGN TYPE B
16	X-FD2		6'-0"	8'-10"		9.0		303B	NL2		3'-0"	8'-10"		24.0	SIGN TYPE B
18	X-F2		3'-0"	8'-10"		14.0		312.1	NL2		3'-0"	8'-10"		25.0	SIGN TYPE B
19	X-NL2		4'-0"	8'-10"		10.0		314	NL2		3'-0"	8'-10"		24.0	SIGN TYPE B
20	X-F2		3'-0"	8'-10"		10.0		316	NL2		3'-0"	8'-10"		24.0	SIGN TYPE B
21	NL2		3'-0"	8'-10"		5.0	PROVIDE (2) PEEP HOLES	317	NL2		3'-0"	8'-10"		24.0	SIGN TYPE B
22	F2		4'-0"	8'-10"		5.0	PROVIDE (2) PEEP HOLES	317A	NL2		3'-0"	8'-10"		24.0	SIGN TYPE B
23	X-SFD		5'-8 1/2"	7'-0"		15.0		351	X-NL2		3'-0"	8'-10"		24.0	
24	X-SF		3'-0"	8'-7"		15.0		400.1	X-SF		3'-0"	7'-0"		16.0	
25	X-SF		3'-0"	8'-7"		15.0		400.2	X-SF		3'-0"	6'-11"		16.0	
26	X-SF		3'-0"	8'-7"		15.0		400.3	X-SF		3'-0"	7'-0"		16.0	
								400.4	X-NL2		3'-0"	8'-10"		22.0	
								401	X-NL2		3'-0"	8'-10"		24.0	
								403	X-NL2		3'-0"	8'-10"		24.0	
								404	X-NL2		3'-0"	8'-10"		24.0	
								405	X-NL2		3'-0"	8'-10"		24.0	
								406	X-NL2		3'-0"	8'-10"		24.0	
								406A	X-NL2		3'-0"	8'-10"		22.1	
								407.1	X-NL2		3'-0"	8'-10"		24.0	
								407.2	X-NL2		3'-0"	8'-10"		24.0	
								420	X-NL2		3'-0"	8'-10"		22.0	
								424	X-NL2		3'-0"	8'-10"		22.0	
								500	X-NL2		4'-0"	8'-10"		19.0	
								520	X-NL2		4'-0"	8'-10"		19.0	
								520.1	X-NL2		4'-0"	8'-10"		19.0	
								530	X-NL2		4'-0"	8'-10"		19.0	
								531	X-NL2		4'-0"	8'-10"		24.0	SIGN TYPE B
								531A	F2		4'-0"	8'-10"		24.0	SIGN TYPE B
								532	NL2		3'-0"	8'-10"		24.0	SIGN TYPE B
								533	NL2		3'-0"	8'-10"		24.0	SIGN TYPE B
								600.1	X-FD2		6'-0"	8'-10"		20.0	
								600.2	X-FD2		6'-0"	8'-10"		20.0	
								601	X-FD2		6'-0"	8'-10"		20.0	
								601A	X-FD2		6'-0"	8'-10"		20.0	
								608	X-NL2		3'-0"	8'-10"		21.0	
								609	X-NL2		3'-0"	8'-10"		21.0	

DOOR SCHEDULE NOTES

- At Doors marked "SMK", provide smoke seals at frame and door bottom to resist the passage of smoke. Provide threshold if required by code or if necessary for proper function of door bottom seal.
- At Doors marked "SND", provide sound seals at frame and door bottom.
- At Doors without a Frame Type designation, the door frame is part of a Glazing System.
- At Doors with a Frame Type designation "AL", the door frame is an interior aluminum frame that is not part of a glazing system.
- At Doors with a Frame Type designation "N/A", there is no door frame required (e.g. all-glass doors, gates, etc.).
- At Doors with a Frame Type designation "REF DET", refer to the referenced Head and Jamb detail for frame information.
- At Doors with a Door Type or Frame Type designation "EX", the door or door frame is existing to remain.
- Refer to Hardware Schedule for additional information regarding hardware.
- Vision panels at non-rated interior doors shall be 1/4" clear tempered glass (CT4) U.N.O. Vision panels at interior fire-rated glass (CC4) U.N.O. Vision panels at exterior doors shall be 1" tinted tempered insulating glass (TT1) U.N.O. Refer to Glazing System Elevation Sheets for Glass Types.

DOOR SCHEDULE KEYED NOTES

- CASED OPENING
- DOUBLE EGRESS DOORS
- FIRE-RATED WIRED GLASS
- FIRE-RATED CERAMIC GLASS
- KEYED REMOVABLE MULLION
- ELECTROMAGNETIC HOLD-OPEN
- MANUAL HOLD-OPEN, FLOOR MOUNTED
- MANUAL HOLD-OPEN, OVERHEAD
- ACCESS CONTROL / CARD READER
- DOOR POSITION SWITCH
- APPLIED SOUND SEALS & THRESHOLD

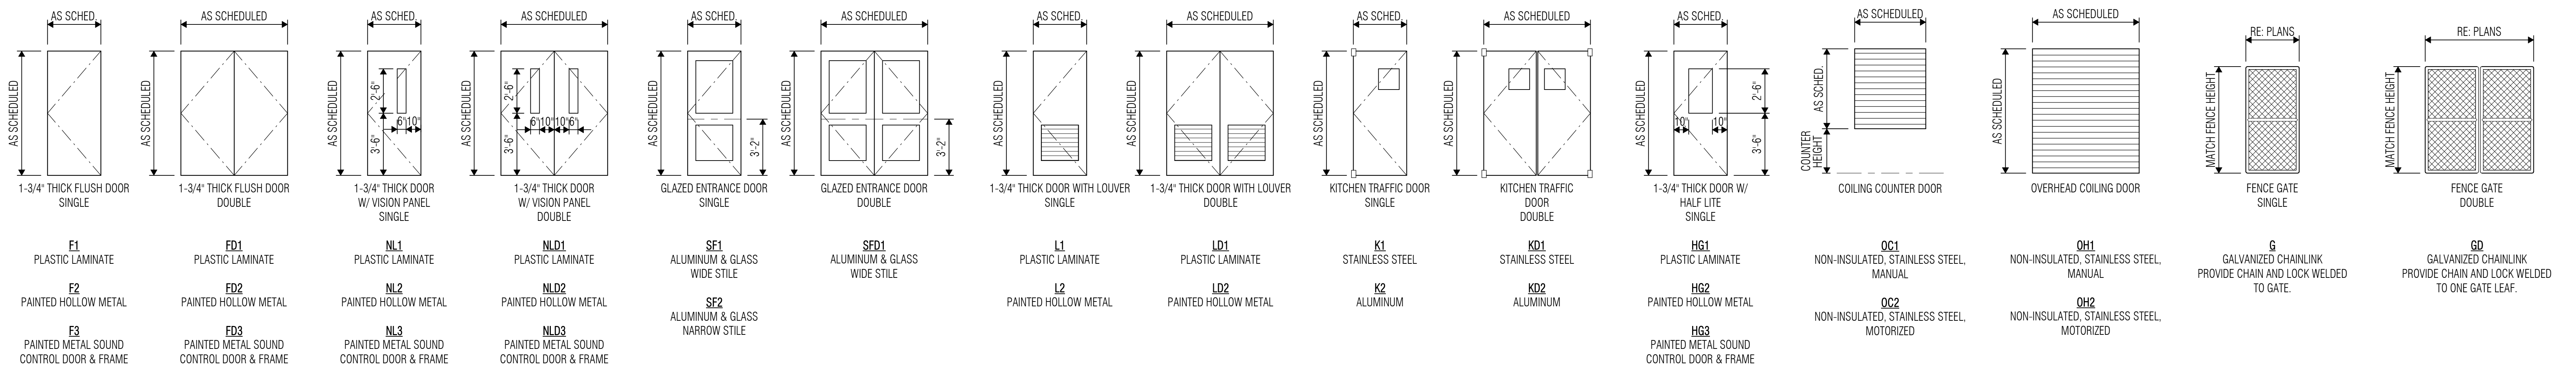

NOTE: *X - PREFIX INDICATES AN EXISTING DOOR OR FRAME TO REMAIN.



ARCHITECT
VLK Architects
 20445 State Hwy 249, Suite 350
 Houston, Texas 77070
 Main Phone: 281.671.2300
 www.vlkarchitects.com

CYPRESS-FAIRBANKS INDEPENDENT SCHOOL DISTRICT
 HOUSTON, TEXAS






ISSUED: February 24, 2025
REVISIONS
 Revision No. Revision Date
 1 Addendum 1 03-06-2025

Director: RSJ
 Designer: TQ
 Drawn By: STH, KM
 Quality Control: QC

PROJECT NO.
 24-010.00
SHEET TITLE
 LABAY - DOOR TYPES, SCHEDULES, ELEVATIONS & DETAILS
SHEET NO.

A27.01

2024 Cook, Labay & Truitt MS Renovations

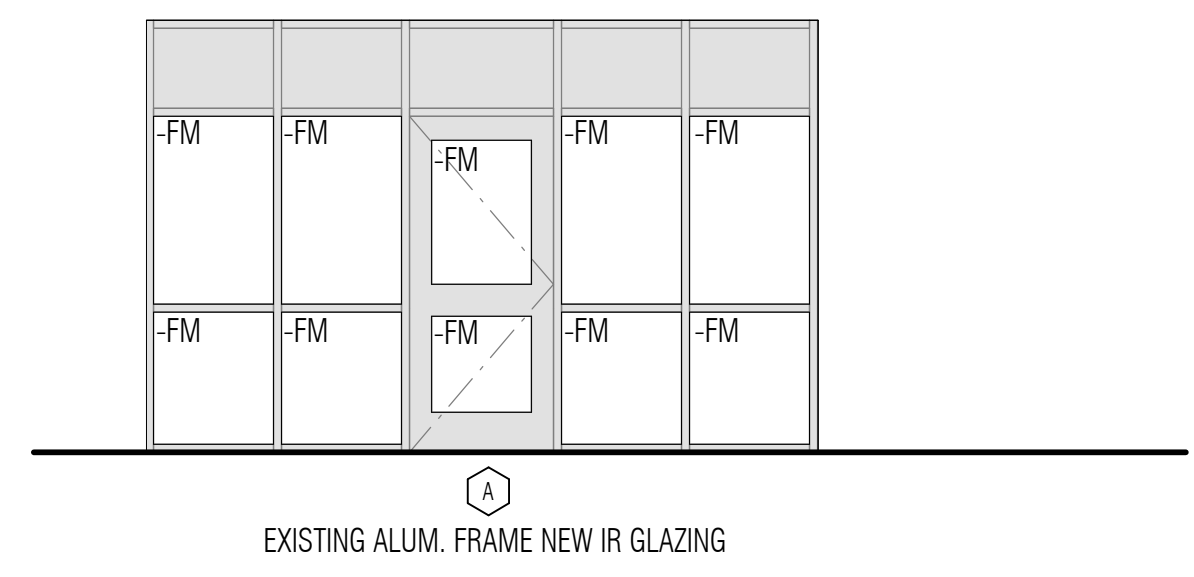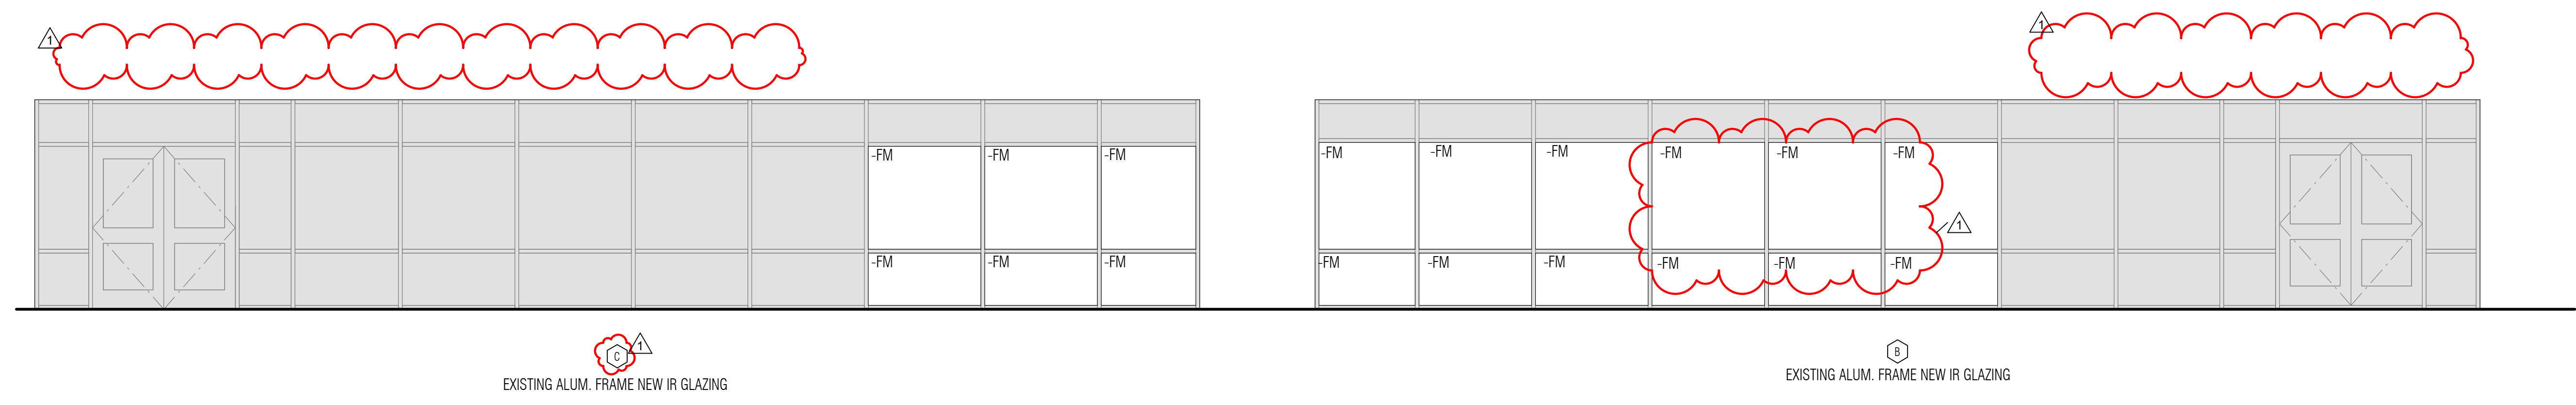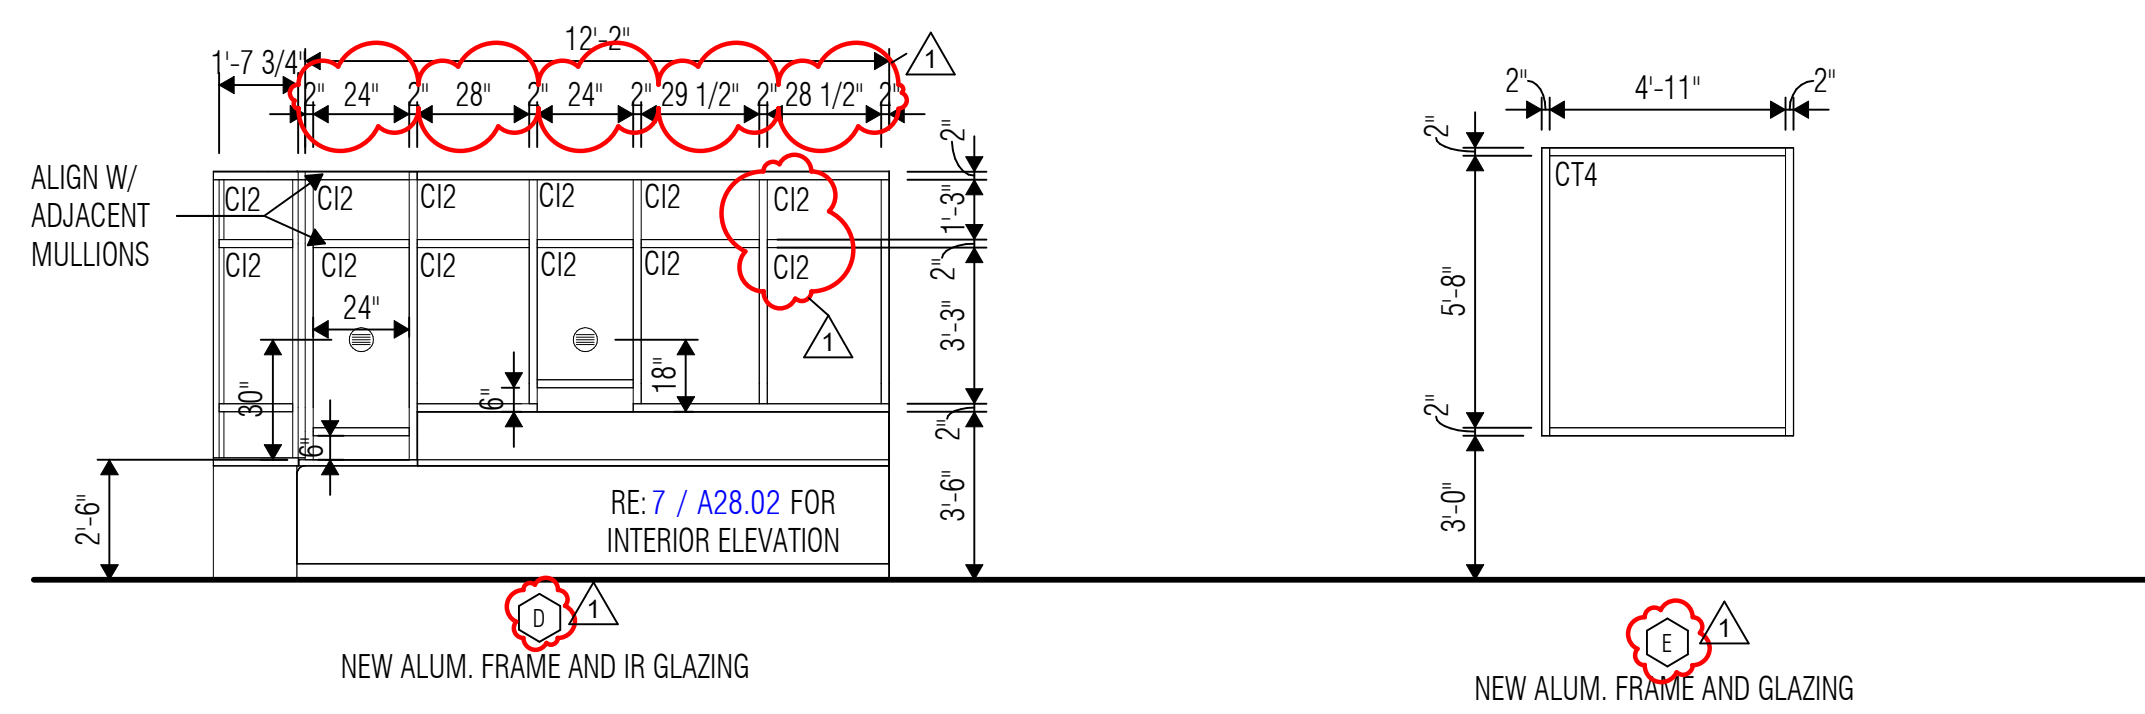

GLAZING SYSTEM NOTES

1. Overall dimensions of glazing system elevations reflect rough opening dimensions, inclusive of perimeter joints.
2. Provide 3/16" thick heavy wall framing members at all door frames in exterior and interior aluminum Storefront systems.
3. Provide 3/16" thick heavy wall door adapters at all door frame members in exterior and interior aluminum Curtain Wall systems.
4. Door opening dimensions in Curtain Wall systems reflect 1" door adapters at jamb conditions, and 1-3/4" door adapters at head conditions. Adjust dimensions between mullions at door openings in curtain wall systems as required for actual size of door adapters provided. Door sizes as identified in Door Schedule shall be maintained.
5. Refer to A'17.01 for Typical Push/Pull Mounting Heights Detail for aluminum/glass doors

GLASS TYPE LEGEND

- CT4 CLEAR, TEMPERED, 1/4" THICK GLASS
 - C12 CLEAR, IMPACT-RESISTANT, 9/16" THICK LAMINATED GLASS
 - FM 23 MIL IMPACT RESISTANT FILM OVERLAY, FIELD-APPLIED TO GLAZING UP TO 7'-0" A.F.F.
 - IF A PORTION OF THE GLAZING UNIT IS ABOVE 7'-0", APPLY FILM TO THE ENTIRE GLAZING UP TO MULLION.
 - DO NOT SPLICE FILM ON INTERIOR OR EXTERIOR GLAZING UNITS.
- GLAZING SHOWN WITH GREY HATCH IS EXISTING TO REMAIN

GLAZING SYSTEM LEGEND

- STOREFRONT FRAMING WITH 3/16" THICK HEAVY WALL MATERIAL, TYPICAL AT ALL DOOR FRAME MEMBERS IN STOREFRONT GLAZING SYSTEMS.
- CURTAIN WALL FRAMING WITH STEEL REINFORCING PROVIDED BY MANUFACTURER.



ARCHITECT
VLK Architects
 20445 State Hwy 249, Suite 350
 Houston, Texas 77070
 Main Phone: 281.671.2300
 www.vlkarchitects.com

CYPRESS-FAIRBANKS INDEPENDENT SCHOOL DISTRICT HOUSTON, TEXAS



ISSUED: February 24, 2025

REVISIONS	
Revision No.	Revision Date
1 Addendum 1	03-06-2025

Director: RSJ
 Designer: RSJ
 Drawn By: STH, KM
 Quality Control: STH, KM

Proj. Arch.: TQ


PROJECT NO.
24-010.00

SHEET TITLE
LABAY - GLAZING ASSEMBLY TYPES, SCHEDULES, ELEVATIONS & DETAILS


SHEET NO.

A27.11


2024 Cook, Labay & Truitt MS Renovations

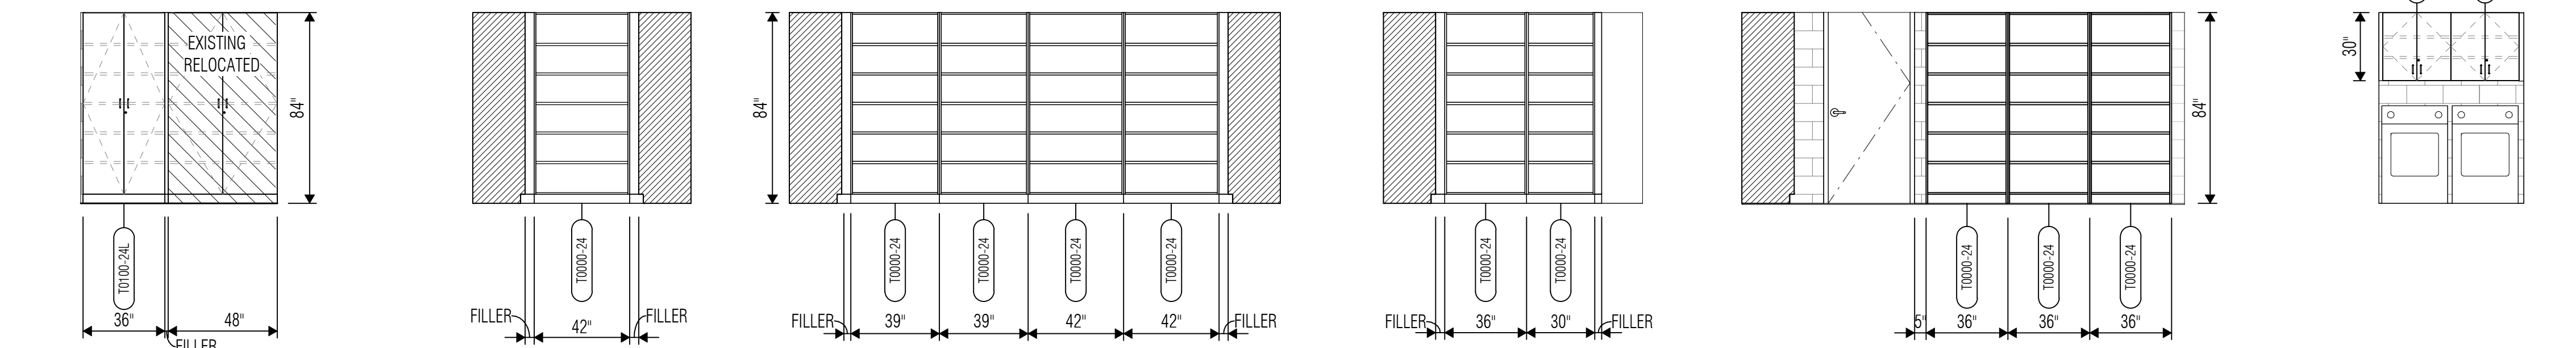

1 OFFICE/LIBRARY SCALE: 1/4" = 1'-0"
 2 PANTRY SCALE: 1/4" = 1'-0"
 3 PANTRY SCALE: 1/4" = 1'-0"
 4 PANTRY SCALE: 1/4" = 1'-0"
 5 PANTRY SCALE: 1/4" = 1'-0"
 6 LAUNDRY SCALE: 1/4" = 1'-0"

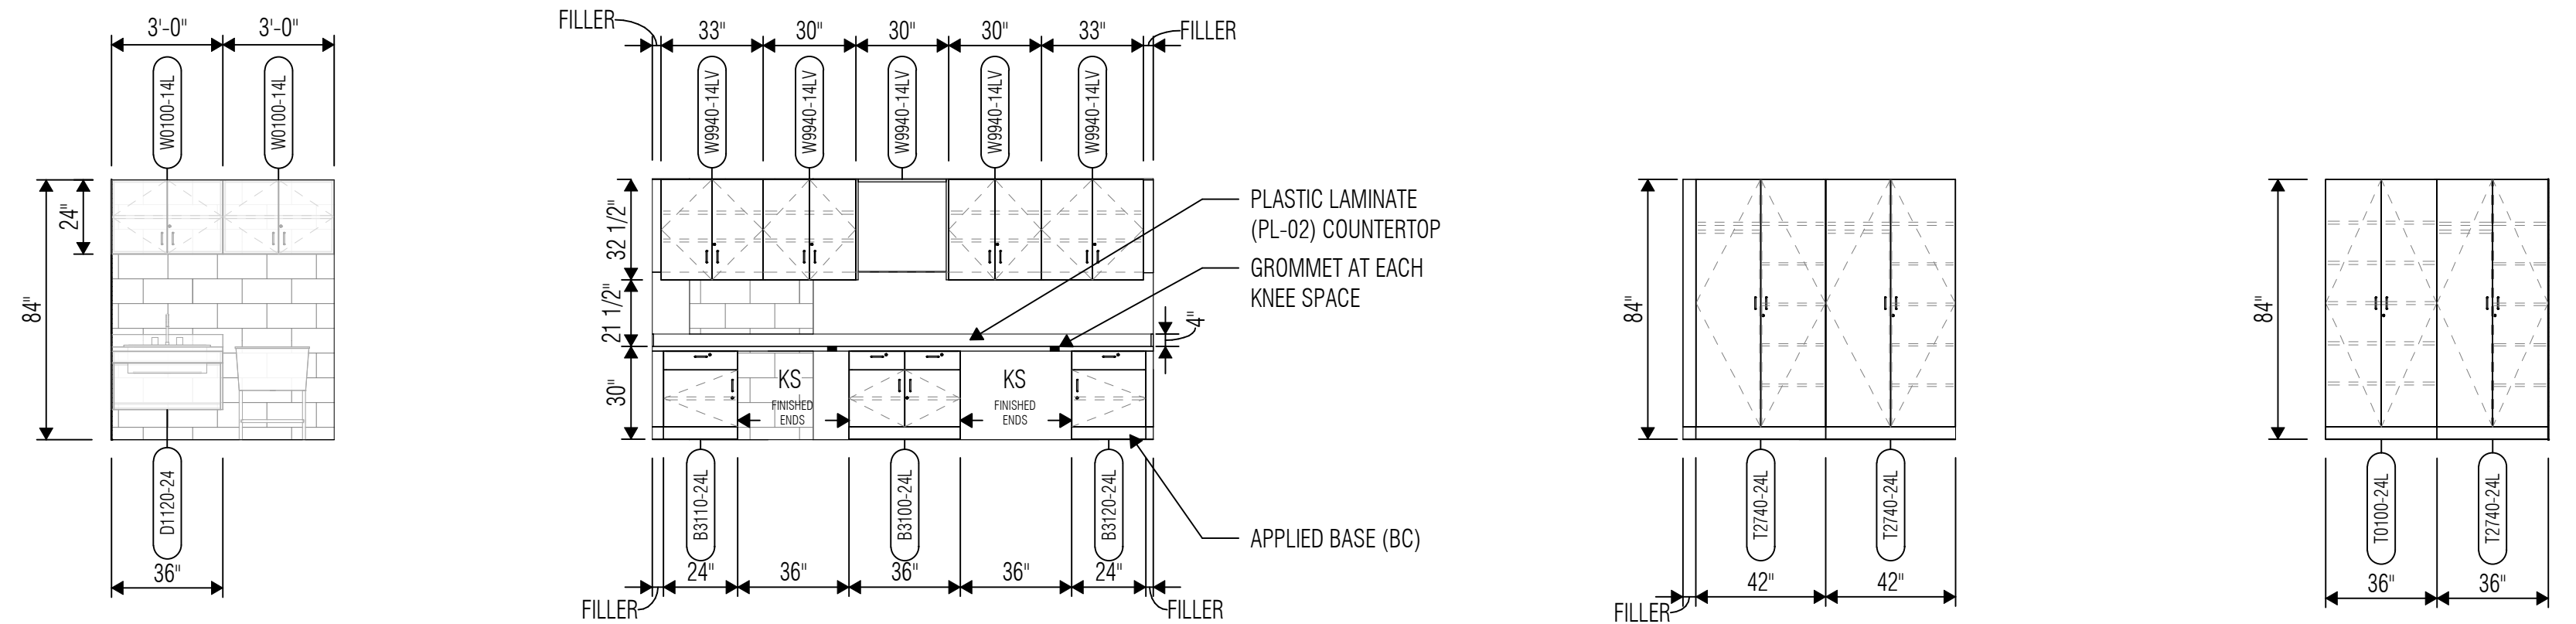

7 MANUFACTURING SCALE: 1/4" = 1'-0"
 8 ELEVATION SCALE: 1/4" = 1'-0"
 9 ELEVATION SCALE: 1/4" = 1'-0"
 10 ELEVATION SCALE: 1/4" = 1'-0"

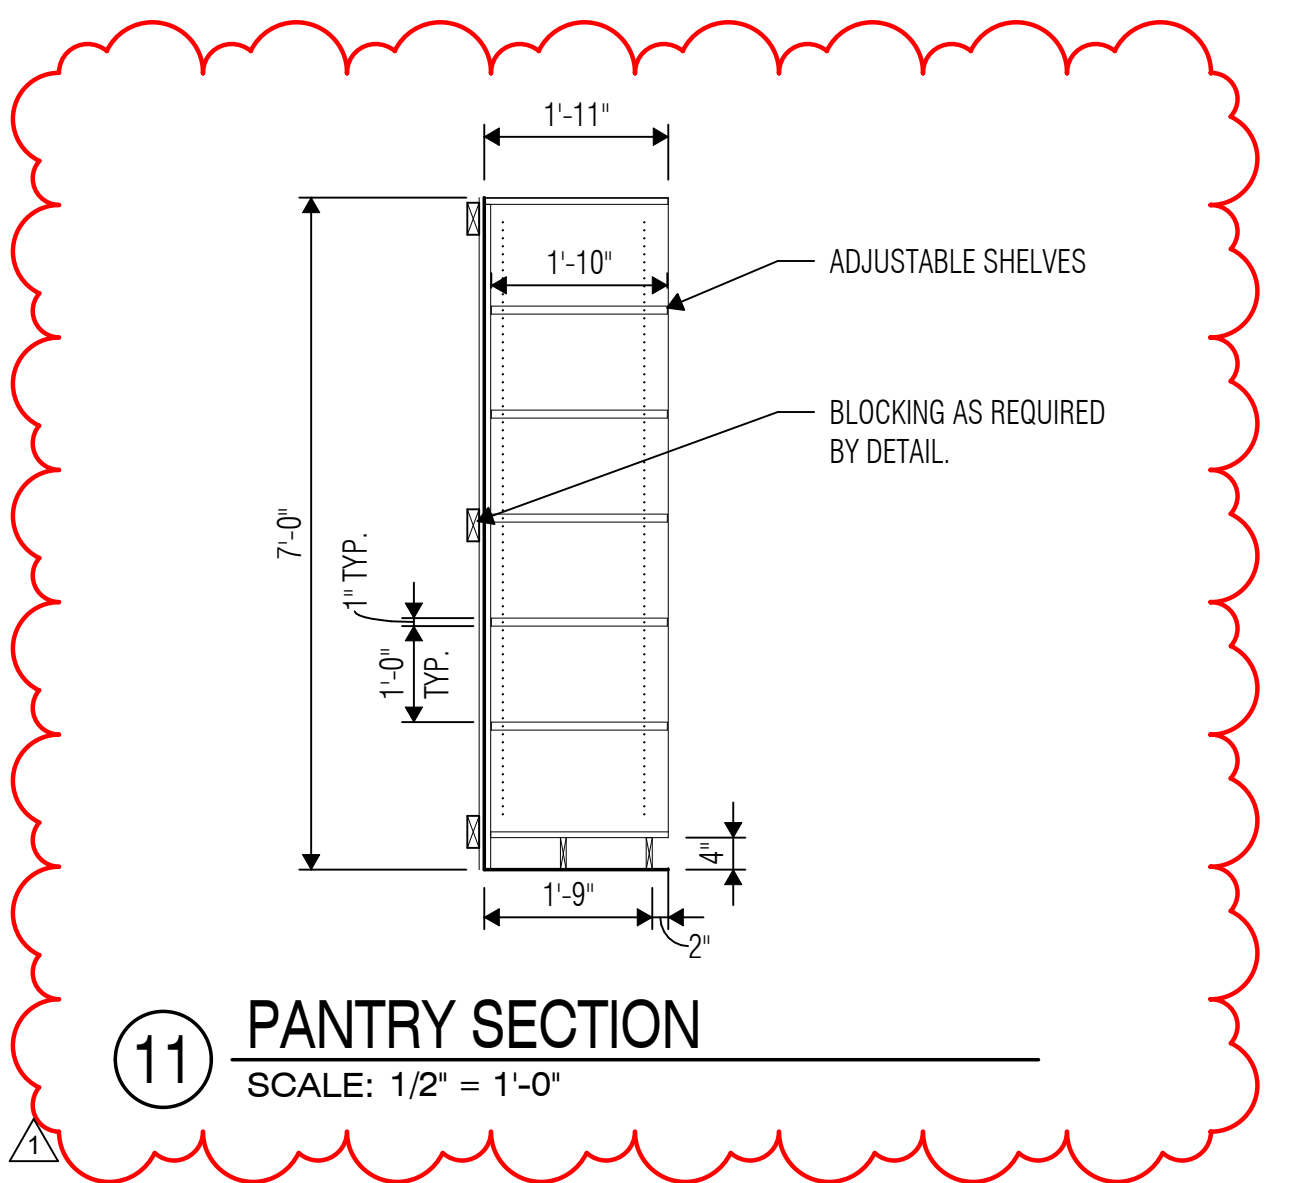

11 PANTRY SECTION SCALE: 1/2" = 1'-0"

CASEWORK NOTES

- Casework shall meet criteria set forth in Americans with Disabilities Act and Texas Accessibility Standards.
- All casework model numbers are based on Case Systems, Inc. Refer to casework elevations for height and width of each unit.
- Coordinate locations of electrical and/or plumbing within casework and millwork. Notify Architect of any conflicts prior to installation.
- Coordinate all column locations prior to installation of casework.
- Refer to Floor Plan Notes for blocking requirements at stud partitions.
- All adjustable shelves longer than 2'-3", and shelves of any length at open shelving units, shall be 1" thick.
- Provide finished surface on all exposed surfaces.
- Plastic Laminate on all casework shall be PL- U.N.O.
- Provide fillers and finished end panels (F.E.) as required. Refer to Typical Casework Details for filler requirements.
- Provide locks on all doors and drawers as indicated.
- All counters shall have 4" high splashes, U.N.O.
- At countertop locations, no joints in plastic laminate should occur over knee spaces, or within 24 inches of sinks and lavatories.
- Casework cabinet doors and drawers shall be flush overlay.
- Base cabinets should not extend to floor. Sub-base shall be separate and recessed 1/2" at sides of cabinet to receive rubber base.
- Provide 1-1/2" thick divider panel between knee spaces and adjacent spaces (e.g. dishwasher openings, other knee spaces, etc.).
- At front of casework, countertops shall extend 1/2" over base cabinet door/drawer (approximately 1-1/2" over base cabinet body). At ends of casework, countertops shall extend 1/2" over base cabinet body. Refer to Typical Casework Details.
- Provide custom height at all file-size drawers to be a minimum of 1'-0" deep. Provide locks at all file-size drawers.

C.S.I. CATALOG CASEWORK NUMBER: XXXXXX-2423
 CASEWORK NOMINAL DEPTH: V = LIGHT VALANCE PANEL (C.S.I. #R9600-03)
 M = MODIFIED FROM STANDARD CATALOG SELECTION
 L = LOCKED CABINET

NOTE:
 1. The height indicated at base cabinets includes the countertop.

VLK ARCHITECTS
 ARCHITECT
 20445 State Hwy 249, Suite 350
 Houston, Texas 77070
 Main Phone: 281.671.2300
 www.vlkarchitects.com

CYPRESS-FAIRBANKS INDEPENDENT SCHOOL DISTRICT
 HOUSTON, TEXAS



ISSUED: February 24, 2025
 REVISIONS
 1 Addendum 1 03-06-2025

Director: RSJ
 Drawn By: STH, KM
 Designer: Quality Control


PROJECT NO.: 24-010.00
 SHEET TITLE: LABAY - CASEWORK ELEVATIONS & DETAILS

SHEET NO.


A28.01

2024 Cook, Labay & Truitt MS Renovations

TYPICAL CASEWORK DETAILS
 SCALE: 3" = 1'-0"

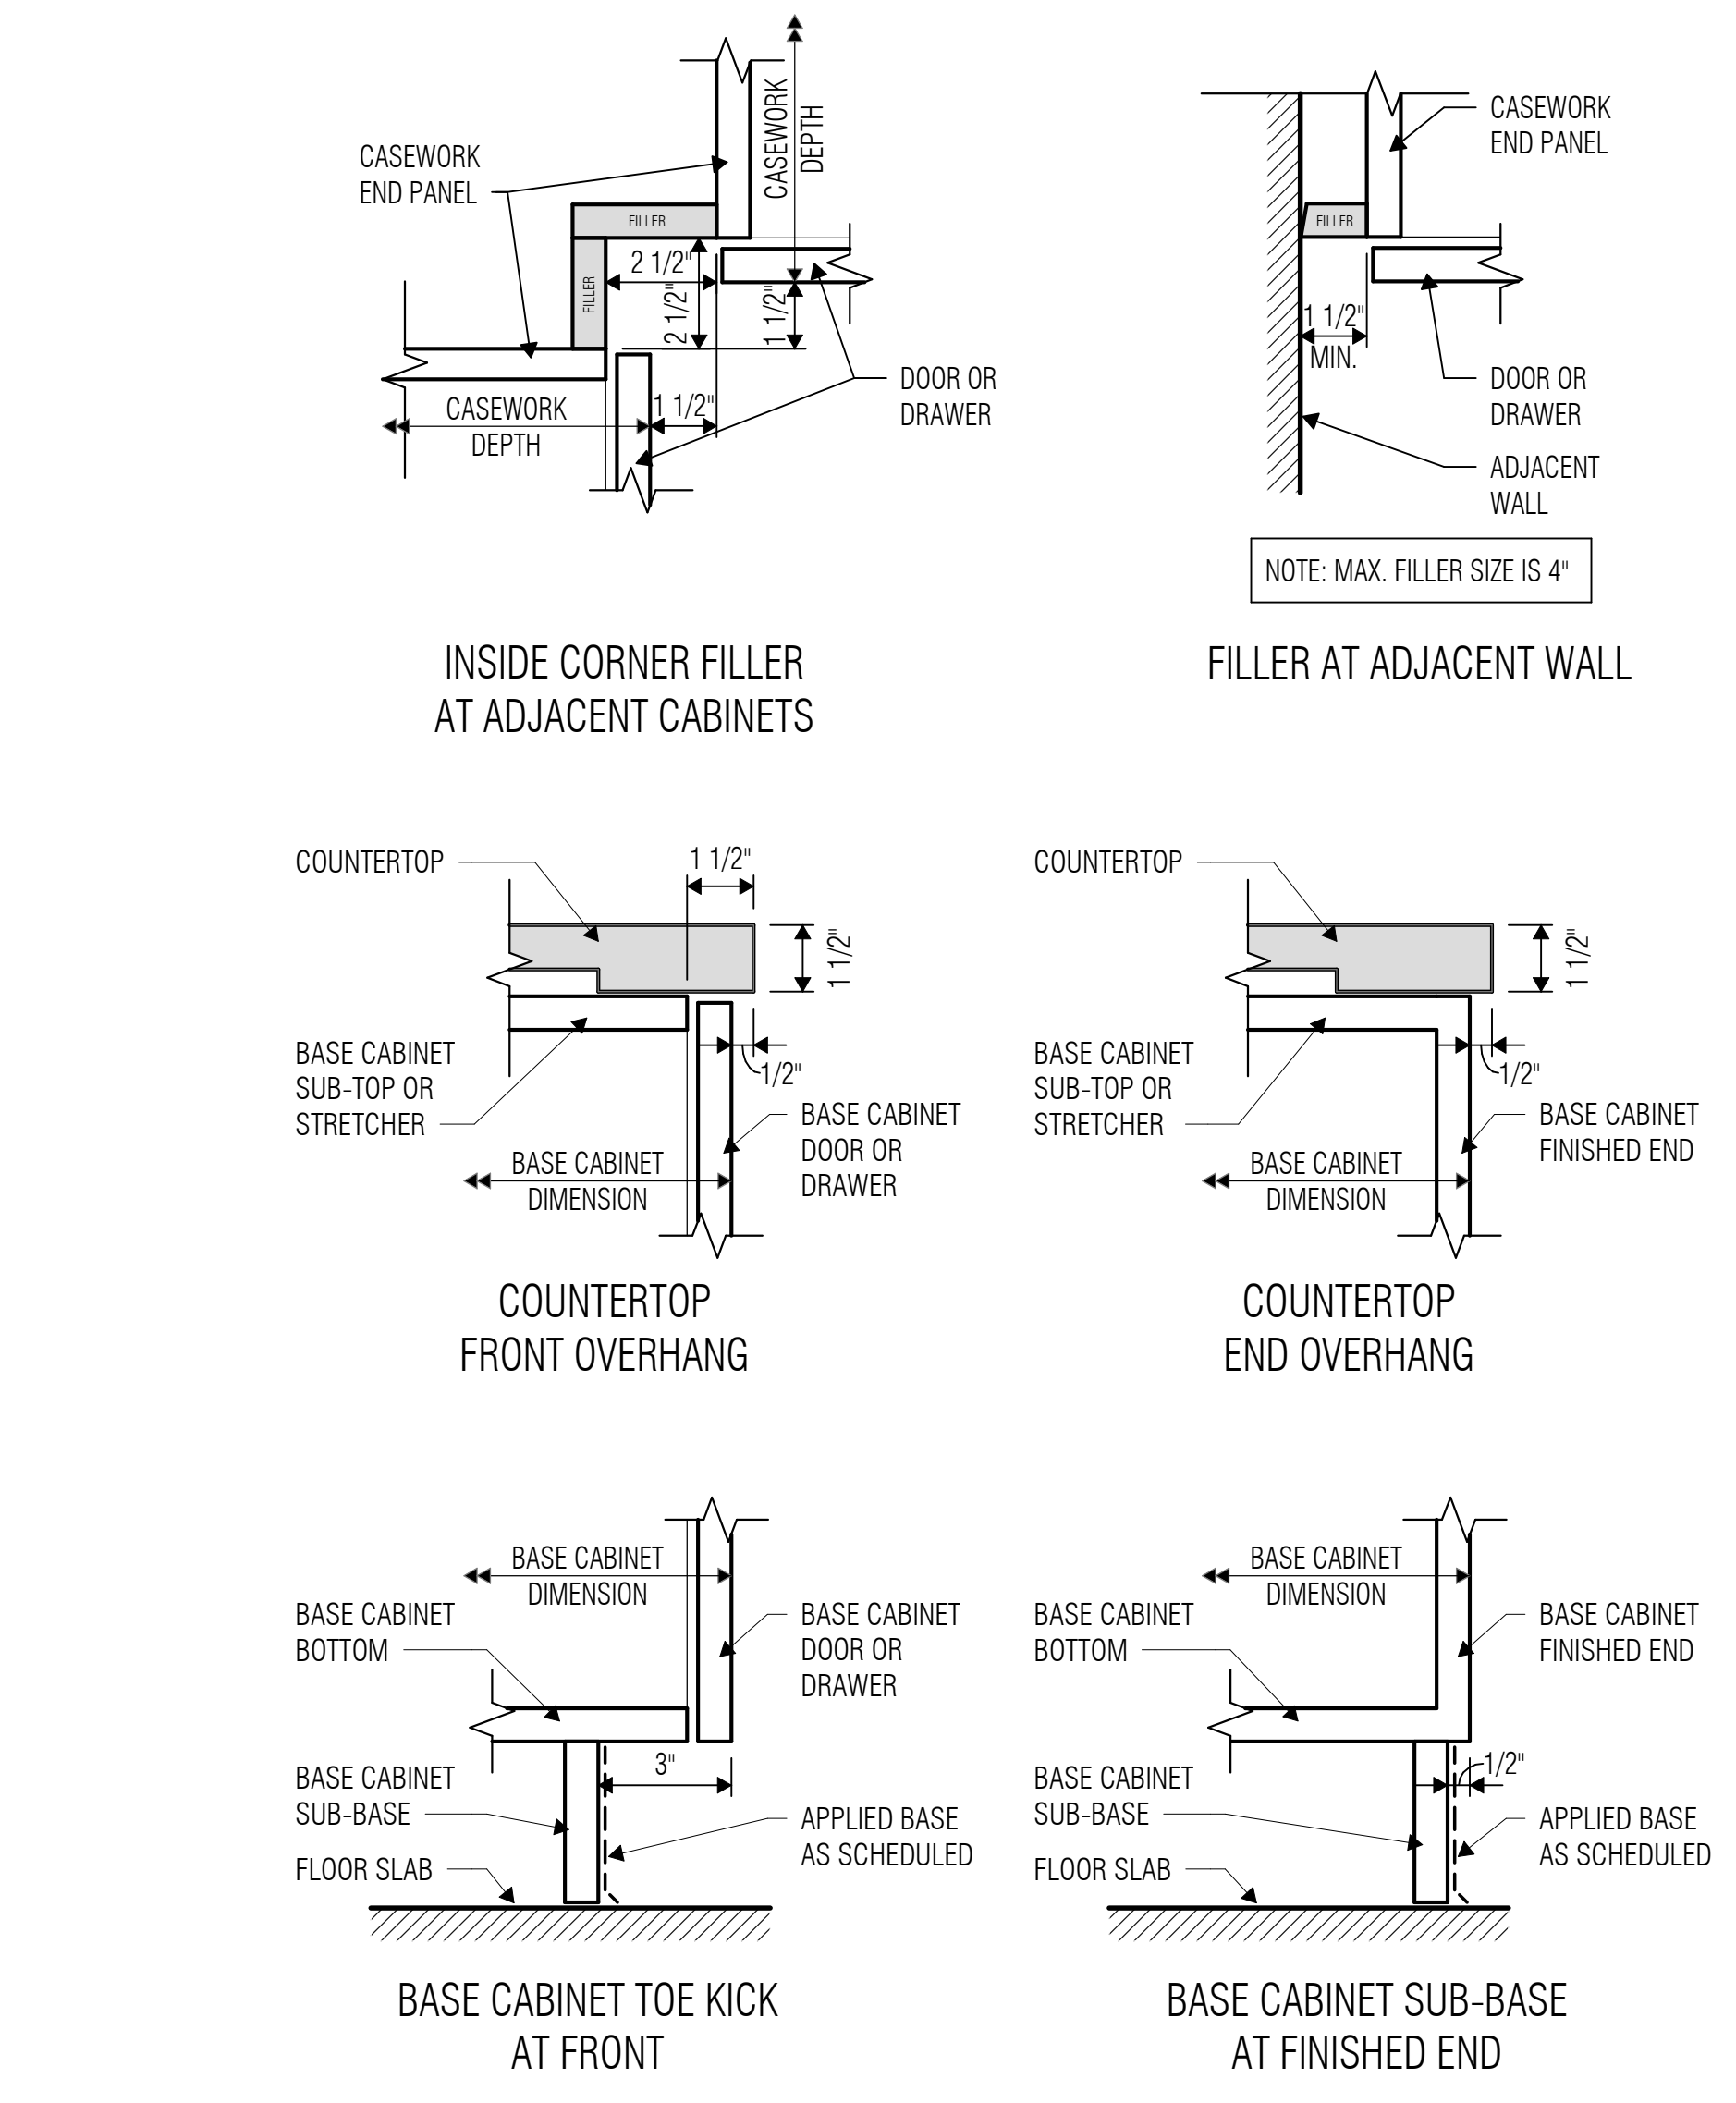

TYPICAL WOOD BLOCKING DETAILS
 SCALE: 3/8" = 1'-0"

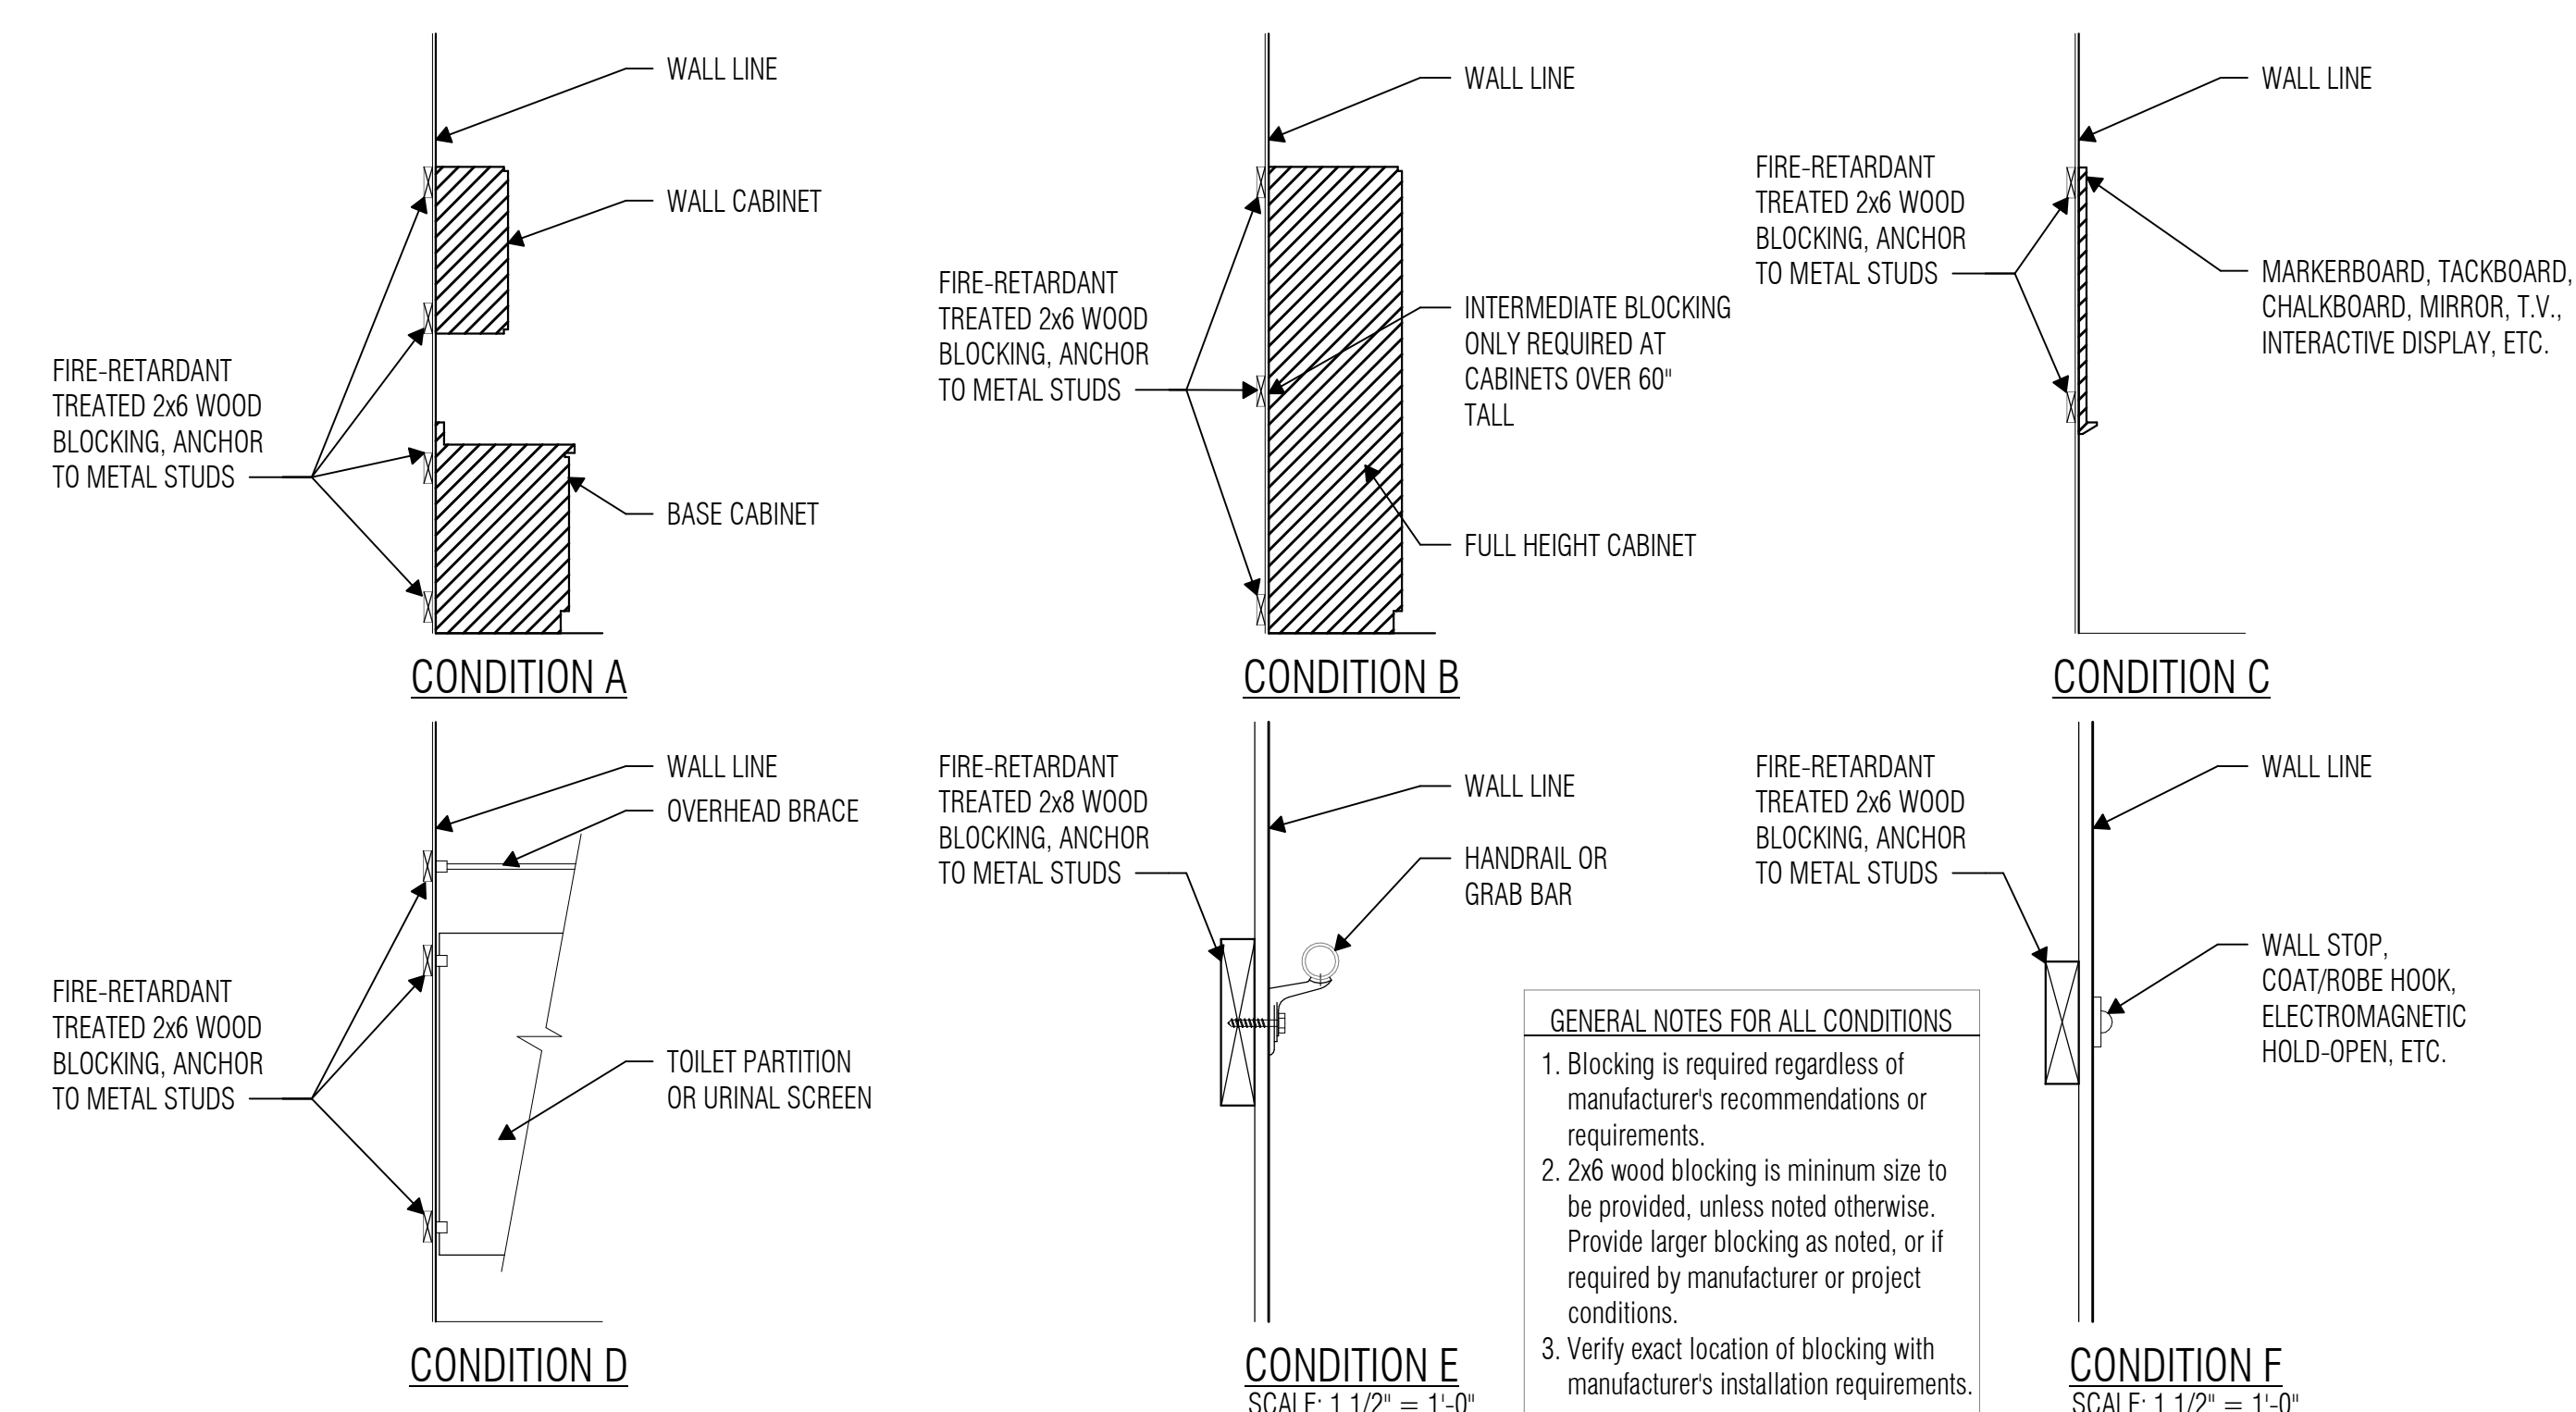

GENERAL NOTES FOR ALL CONDITIONS

- Blocking is required regardless of manufacturer's recommendations or requirements.
- 2x6 wood blocking is minimum size to be provided, unless noted otherwise. Provide larger blocking as noted, or if required by manufacturer or project conditions.
- Verify exact location of blocking with manufacturer's installation requirements.

MC005

FINISH ACCESSORY, FURNITURE AND EQUIPMENT SCHEDULE


NOTE: ALL MATERIALS, PRODUCTS, SIZES, COLORS AND PATTERNS ARE THE BASIS OF DESIGN. REFERENCE PROJECT MANUAL FOR ADDITIONAL APPROVED MANUFACTURERS MEETING THE DESIGN INTENT. SUBSTITUTIONS WILL BE CONSIDERED WHEN SUBMITTED IN COMPLIANCE WITH SECTION 01 62 00 – PRODUCT OPTIONS.

MARK	DESCRIPTION	SPEC SECTION	MANUFACTURER INFO			SIZE	COMMENTS
			MANUFACTURER	SERIES/STYLE	COLOR/FINISH		
PTD				-		-	
EXTERIOR EQUIPMENT AND SPECIALTIES							
EJ	Expansion Joint Covers	07 95 00		As Specified		-	
PJS	PREFORMED JOINT SEAL	07 95 00		-		-	PREFORMED JOINT SEAL
EXTERIOR FINISH ACCESSORY							
EFA-01	PREFINISHED METAL TRIM	07 42 13		As Specified		-	
EFA-02	FIBER CEMENT TRIM	07 46 46		As Specified		-	
EFA-03	WOOD TRIM	07 46 23		As Specified		-	
FLOOR FINISH ACCESSORY							
FFA-01	FLOOR TRANSITION	09 68 00	Johnsonite	Wheeled Traffic Transition	Black 40	--	RF to CPT. Provide floor transition to match flooring thickness.
FFA-02	FLOOR TRANSITION	09 68 00	Johnsonite	Slim Line Transition	Black	--	CPT to EXST. Provide floor transition to match flooring thickness.
MILLWORK FINISH ACCESSORY							
MFA-01	MILLWORK REVEAL	09 21 16	Fry Reglet	Millwork Profiles/Millwork U Channel	To be selected by architect.	1/2"	At Reception Desk refer to Casework Elevations for details.
MISC.							
BV	BRICK VENT	05 50 00		As Specified		-	
CB	CONCRETE BOLLARD	12 93 00		As Specified		-	
DN	DOWNSPOUT NOZZLE	DIVISION 22		As Specified		-	
JSE	EXTERIOR JOINT SEALANT	07 92 00		As Specified		-	
L	LOUVER	08 91 00		As Specified		-	
SPECIALTY EQUIPMENT							
ATH	Athletic Wall Pads	11 66 00		As Specified			AT LABAY
FEC	Fire Extinguisher Cabinet	10 44 13		As Specified		-	
HB	Horizontal Blinds	12 21 13		As Specified			
ID	IDENTIFYING DEVICES	10 14 00		As Specified			
MB	Markerboard - Premanufactured	10 11 16		As Specified			
PC-01	Platform Stage Curtain	10 21 23	KM Fabrics	Charisma	Black		COOK
PC-02	Platform Stage Curtain	10 21 23	KM Fabrics	Charisma	Navy		LABAY/TRUITT
TB	Tackboard	10 11 16		As Specified			

MATERIAL FINISH SCHEDULE

NOTE: ALL MATERIALS, PRODUCTS, SIZES, COLORS AND PATTERNS ARE THE BASIS OF DESIGN. REFERENCE PROJECT MANUAL FOR ADDITIONAL APPROVED MANUFACTURERS MEETING THE DESIGN INTENT. SUBSTITUTIONS WILL BE CONSIDERED WHEN SUBMITTED IN COMPLIANCE WITH SECTION 01 62 00 – PRODUCT OPTIONS.

MARK	DESCRIPTION	SPEC SECTION	MANUFACTURER INFO				SIZE	COMMENTS
			MANUFACTURER	SERIES/STYLE	COLOR/FINISH	SIZE		
BASE FINISH								
BC	Base, Rubber Coved	09 65 00	Roppe	700 Series - Standard	193 Black Brown		4"	
PT-03	Paint - Base	09 91 00	Sherwin Williams	--	Architect to select.		VIF	
CEILING FINISH								
ACT-01	Acoustic Ceiling Tile (24X24)	09 51 00	Armstrong	School Zone Fine Fissued	White		24"X24"	
ACT-02	Acoustic Ceiling Tile (24X24) - High NRC - New Tiles Only	09 51 00	Armstrong	Calla 2820	White		24"X24"	
ACT-03	Acoustic Ceiling Tile (24X24) - High NRC	09 51 00	Armstrong	Calla 2820	White		24"X24"	
EXTERIOR FINISH								
MA-01	4A-1 - Brick Veneer King Labay	04 20 00	ACME		Steele Gray			
MP-01	Metal - Panel	07 42 13	Berridge		Architect to select.		Athletic Storage	
MP-02	Metal - Roofing	07 42 13	Berridge		Architect to select.		Athletic Storage	
FLOOR FINISH								
CO-01	Concrete - Sealed	03 30 00	--	--	--		--	
CO-02	Concrete - Polished	03 30 00	--	--	--		--	
CPT-01	Carpet - Broadloom	09 68 00	Tarkett	Aftermath II	Fleece 23508		Roll	
RF-01	Resilient Floor - Sheet Vinyl	09 65 44	Forbo	Marmoleum Fresco	Sparrow 3252		13" X 13"	
MILLWORK & ARCHITECTURAL FINISHES								
PL-01	Plastic Laminate - Vertical	08 14 23	Formica		5883-58 Pecan Woodline		--	
PL-02	Plastic Laminate - Casework Counters	12 32 16	Wilsonart	General Laminate - Type 107	Classic Linen 4943-38 - Fine Velvet Finish		--	
QTZ-01	Quartz surface - Counters	12 36 61 19	Wilsonart	Quartz	Isselburg - Q4013		--	
QTZ-02	Quartz surface - Window Sills	12 36 61 19	Wilsonart	Quartz	Isselburg - Q4013		--	
WALL FINISH								
AWP-01	Acoustic Wall Panel, Fabric Wrapped - Field	09 84 13	Carnegie	Xorel Meteor	(Tan) 766		--	
AWP-02	Acoustic Wall Panel, Fabric Wrapped - Light Blue Accent	09 84 13	Carnegie	Xorel Meteor	(Light Blue) 739		--	
AWP-03	Acoustic Wall Panel, Fabric Wrapped -Dark Blue Accent	09 84 13	Carnegie	Xorel Meteor	(Dark Blue) 746		--	
AWP-04	Acoustic Wall Panel, Fabric Wrapped -Red Accent	09 84 13	Carnegie	Xorel Meteor	(Red) 727		--	
AWP-05	Acoustic Wall Panel, Fabric Wrapped -Blue Accent	09 84 13	Guilford of Maine	Anchorage 2335	2026 Quarry Blue		--	
PT-01	Paint - Field	09 91 00	Sherwin Williams	--	Aesthetic White SW7035		--	
PT-02	Paint - Bronze Accent	09 91 00	Sherwin Williams	--	Urbane Bronze SW7048		--	

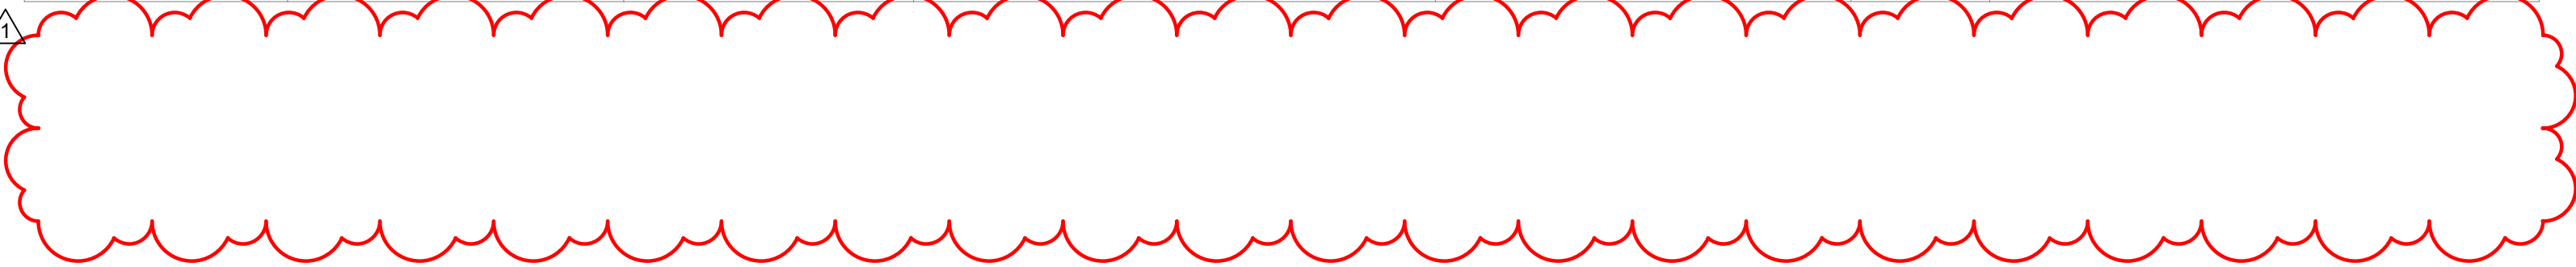

ARCHITECT
VLK Architects
 20445 State Hwy 249, Suite 350
 Houston, Texas 77070
 Main Phone: 281.671.2300
 www.vlkarchitects.com

CYPRESS-FAIRBANKS INDEPENDENT SCHOOL DISTRICT HOUSTON, TEXAS



ISSUED: February 24, 2025

REVISIONS	
Revision No.	Revision Date
1 Addendum 1	03-06-2025

Director
RSJ
Designer

Drawn By
STH, KM
Quality Control

Proj. Arch.
TQ

PROJECT NO.
24-010.00
SHEET TITLE

LABAY - MATERIAL FINISH SCHEDULES

SHEET NO.

A29.01

2024 Cook, Labay & Truitt MS Renovations

ROOM FINISH SCHEDULE

LEVEL	ROOM NUMBER	ROOM NAME	FLOOR	BASE	WALL	COMMENTS
LEVEL ONE						
LABAY - UNIT A						
LEVEL ONE	530	ORCHESTRA	CPT	BC	PT	LABAY
LEVEL ONE	535	MECHANICAL	CO	BC	PT	LABAY
LEVEL ONE	533	PRACTICE	CPT	BC	PT	LABAY
LEVEL ONE	531A	INSTRUMENT STORAGE	RF	BC	PT	LABAY
LEVEL ONE	531	ENSEMBLE	CPT	BC	PT	LABAY
LEVEL ONE	532	OFFICE/LIBRARY	CPT	BC	PT	LABAY
LABAY - UNIT C						
LEVEL ONE	400A	VESTIBULE	EXST	EXST	EXST	LABAY
LEVEL ONE	400	CHECK-IN	EXST	EXST	EXST	LABAY
LABAY - UNIT D.1						
LEVEL ONE	302	OFFICE	CPT	BC	PT	LABAY
LEVEL ONE	303B	STORAGE	RF	BC	PT	LABAY
LEVEL ONE	301	CULINARY LAB	RF	BC	PT	LABAY
LEVEL ONE	303A	LAUNDRY	EXST	BC	PT	LABAY
LEVEL ONE	303	SEWING LAB	RF	BC	PT	LABAY
LEVEL ONE	301A	PANTRY	RF	BC	PT	LABAY
LABAY - UNIT D.2						
LEVEL ONE	316	COMPUTER LAB	CO	BC	PT	LABAY
LEVEL ONE	311	SHOP	EXST	BC	PT	LABAY
LEVEL ONE	312	ENGINEERING	EXST	BC	PT	LABAY
LEVEL ONE	312A	STORAGE	EXST	EXST	EXST	LABAY
LEVEL ONE	313	OFFICE	EXST	EXST	EXST	LABAY
LEVEL ONE	315	ELECTRICAL	EXST	EXST	EXST	LABAY
LEVEL ONE	314	MANUFACTURING	EXST	BC	PT	LABAY
LEVEL ONE	355	CORRIDOR	EXST	EXST	EXST	LABAY
LEVEL ONE	317	CUSTODIAN OFFICE	CO	BC	PT	LABAY
LEVEL ONE	317A	STORAGE	CO	BC	PT	LABAY
LEVEL ONE	311A	MATERIAL STORAGE	CO	BC	PT	LABAY

FINISH SCHEDULE NOTES

- General Finish Notes**
 - Any finish conflict between finish schedules and finish floor plans to be brought to the architect's attention for resolution.
 - Existing doors and operable window hardware shall be cleaned of all dirt and non-original paint.
- Plastic Laminate**
 - Typical Casework/Millwork cabinet body, doors, and drawer fronts shall be PL-01, unless noted otherwise.
 - Countertops shall be PL-02.
 - Interior Plastic Laminate clad wood doors to be PL-01.
 - All New Window Sills shall be QTZ-02.
- Ceiling Finishes**
 - Refer to Reflected Ceiling Plans for scheduled finish.
 - At ceilings with exposed structure, all exposed elements shall be painted the scheduled color, including mechanical ductwork, electrical, piping, conduit, j-boxes, etc.
 - All interior gyp. bd. ceilings to be painted PT-01, unless noted otherwise.
 - All interior gyp. bd. furr-downs to be painted PT-01, unless noted otherwise.
- Floor Finishes**
 - All substrates receiving new flooring shall be clean of all adhesives and leveled as required to meet the installation recommendations of the flooring.
 - Refer to Interior Finish Plans for floor finish patterns.
 - Refer to Interior Finish Plans for tile origin in each room. If origin point is not indicated, center in middle of the room or corridor.
 - All changes in floor material between rooms shall occur at centerline of doorway, unless noted otherwise.
 - Level and float flooring at public corridor walls.
 - All toilets and other areas capable of water mitigation shall have a 2" x 1/2" marble threshold with double 1/4" bevel edge. The thresholds shall be held in place with thin set.
 - Sealant color shall match adjacent material.
 - Typical flooring application at brick walls:
 - LVT. Rake brick joint at floor level and install sealant between LVT and brick.
 - Carpet: Rake brick joint at floor level and tuck carpet tight into raked brick joint.
- Wall Finishes**
 - Finishes shall continue to inside corner, unless noted otherwise.
 - At painted CMU base, paint as indicated in drawings.
- Paint Information:**
 - Interior Paint:**
 - New interior walls and existing walls within area of work are to be painted PT-01 in their entirety, unless noted otherwise.
 - All interior sealant shall be painted to match adjacent wall.
 - Hollow Metal Doors and Windows:**
 - Hollow metal doors to be painted PT-02, unless noted otherwise.
 - Hollow metal door frames and vision panel frames shall be painted PT-02, unless noted otherwise.
 - At door frames with 2 different colors, transition color at inside corner of door stop, on the door side of the stop.
 - Hollow metal glazed opening frames shall be painted PT-02, unless noted otherwise.



ARCHITECT

VLK Architects
 20445 State Hwy 249, Suite 350
 Houston, Texas 77070
 Main Phone: 281.671.2300
 www.vlkarchitects.com

CYPRESS-FAIRBANKS INDEPENDENT SCHOOL DISTRICT
 HOUSTON, TEXAS



03/06/2025

ISSUED: February 24, 2025

REVISIONS

Revision No.	Revision Date
1 Addendum 1	03-06-2025

Director: RSJ
 Designer: TQ
 Drawn By: STH, KM
 Quality Control:

Proj. Arch.
 TQ

PROJECT NO.

24-010.00


SHEET TITLE

LABAY - ROOM FINISH
 SCHEDULE


SHEET NO.

A29.02


2024 Cook, Labay & Truitt MS Renovations

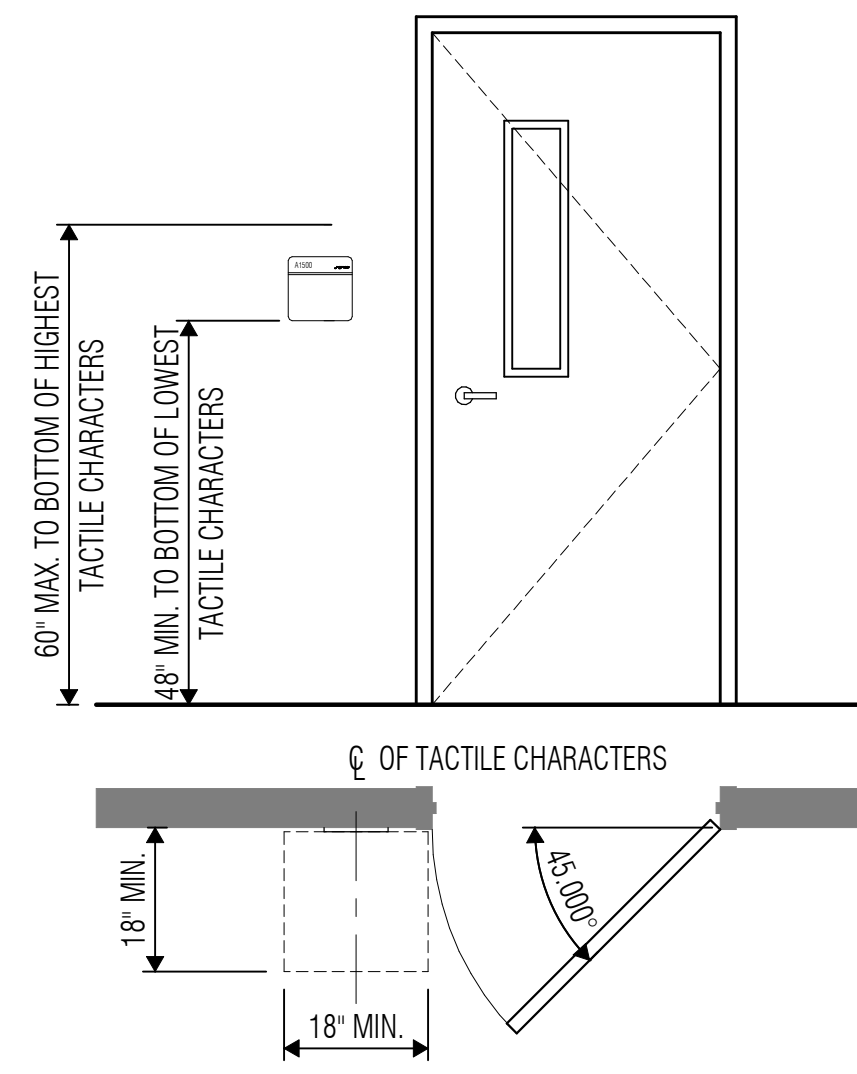


1 DETAIL/ELEV - DOOR SIGN
SCALE: 1/2" = 1'-0"

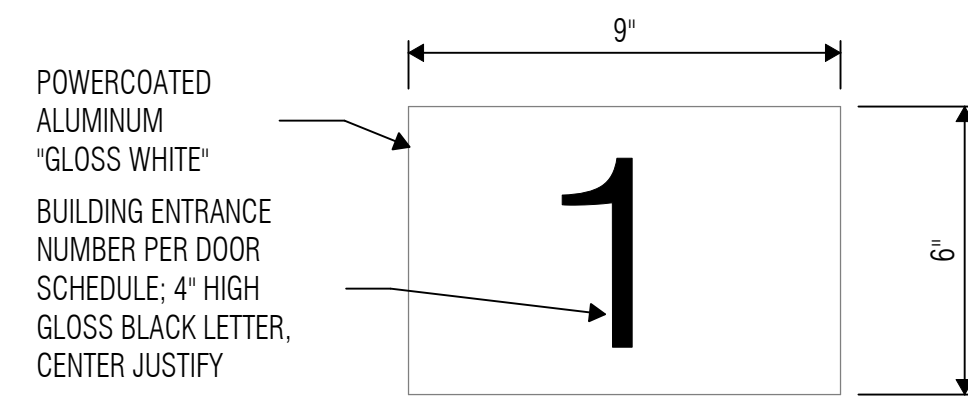



2 SIGN TYPE 'D'
SCALE: 3" = 1'-0"

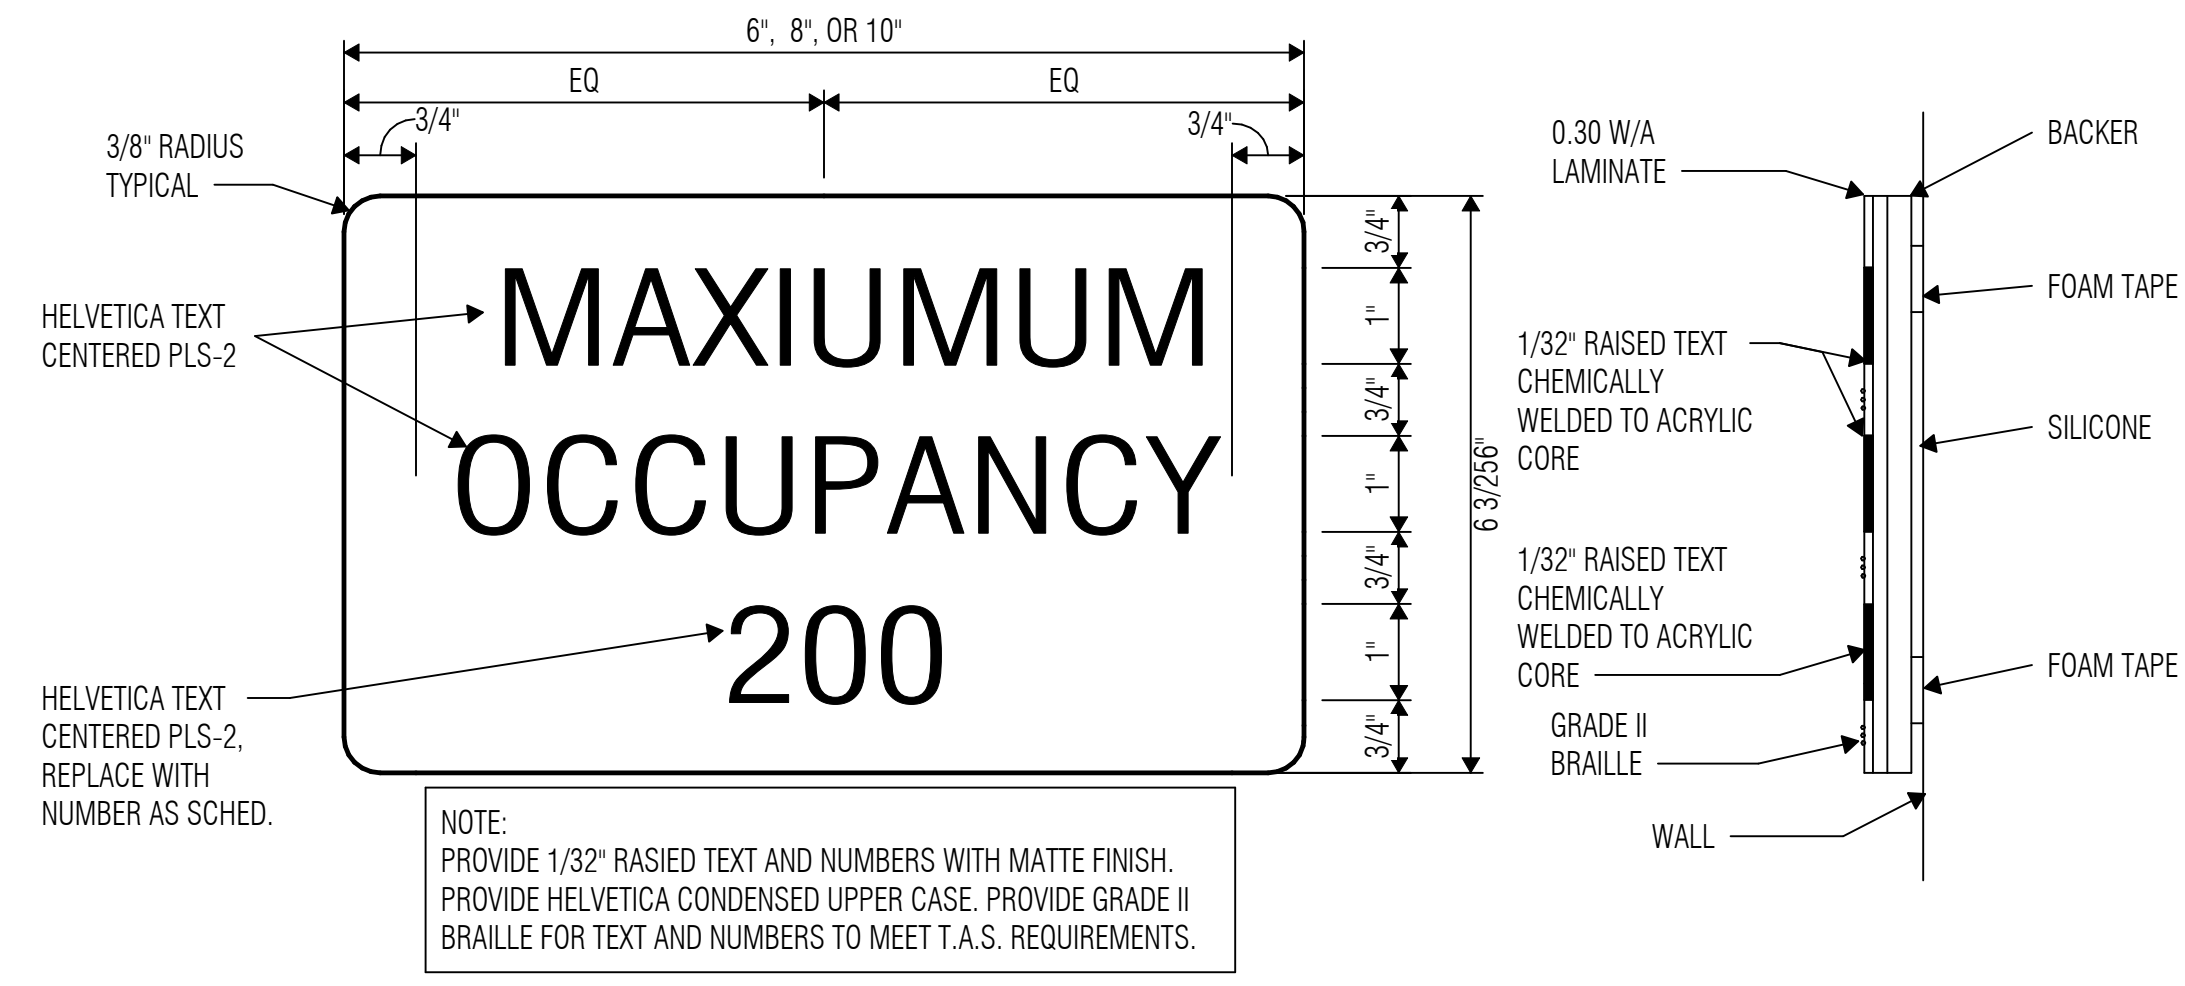


3 SIGN TYPE 'C'1
SCALE: 6" = 1'-0"

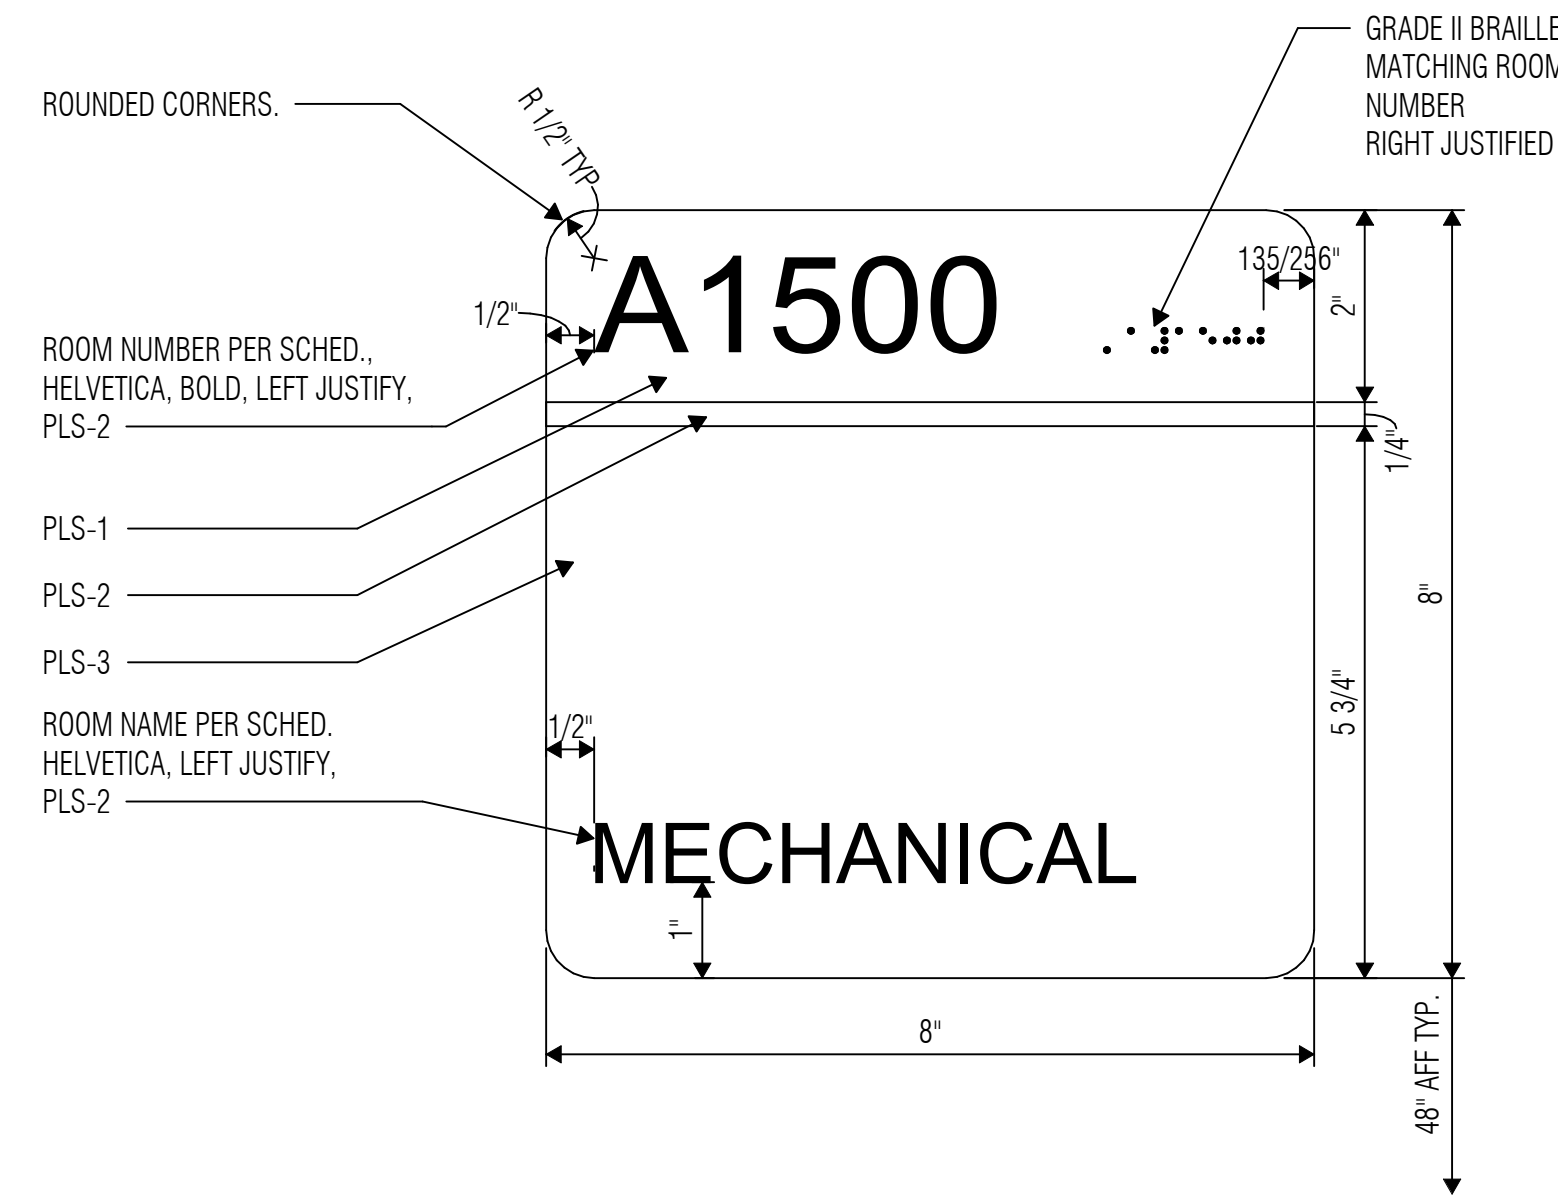

4 SIGN TYPE 'A'1
SCALE: 6" = 1'-0"

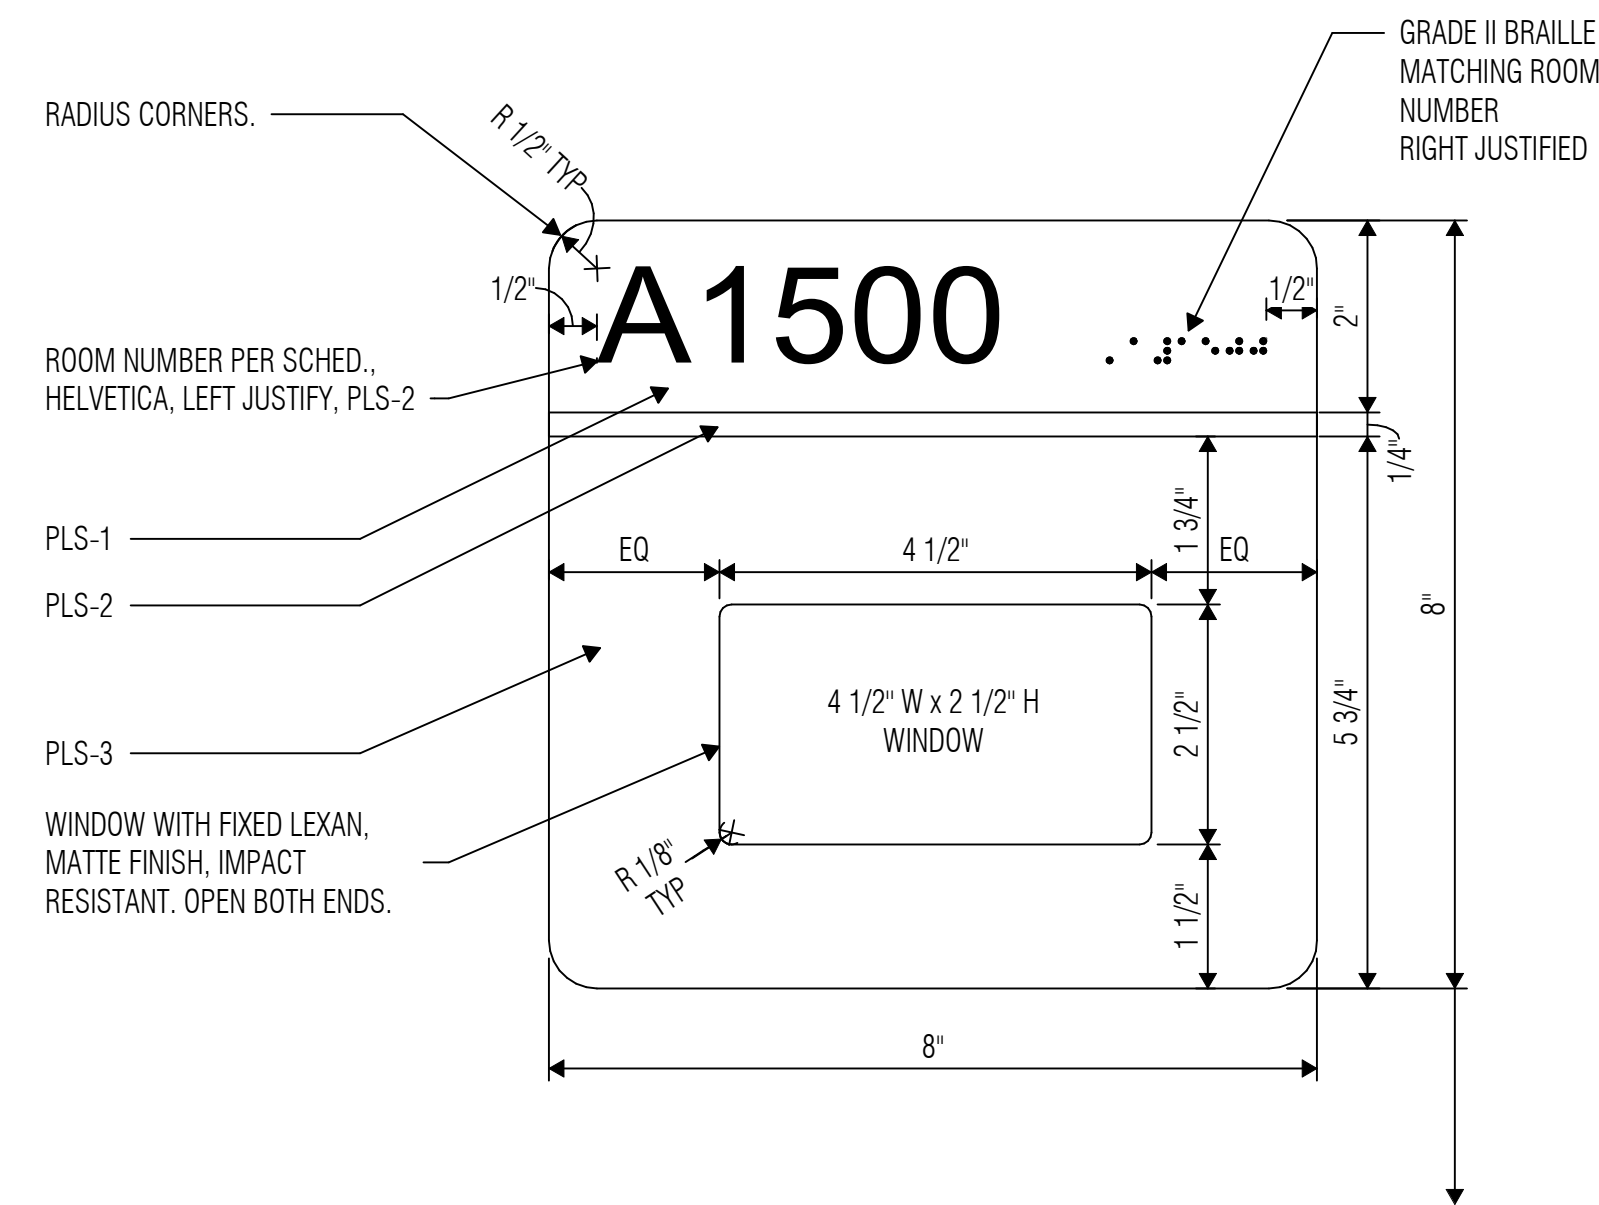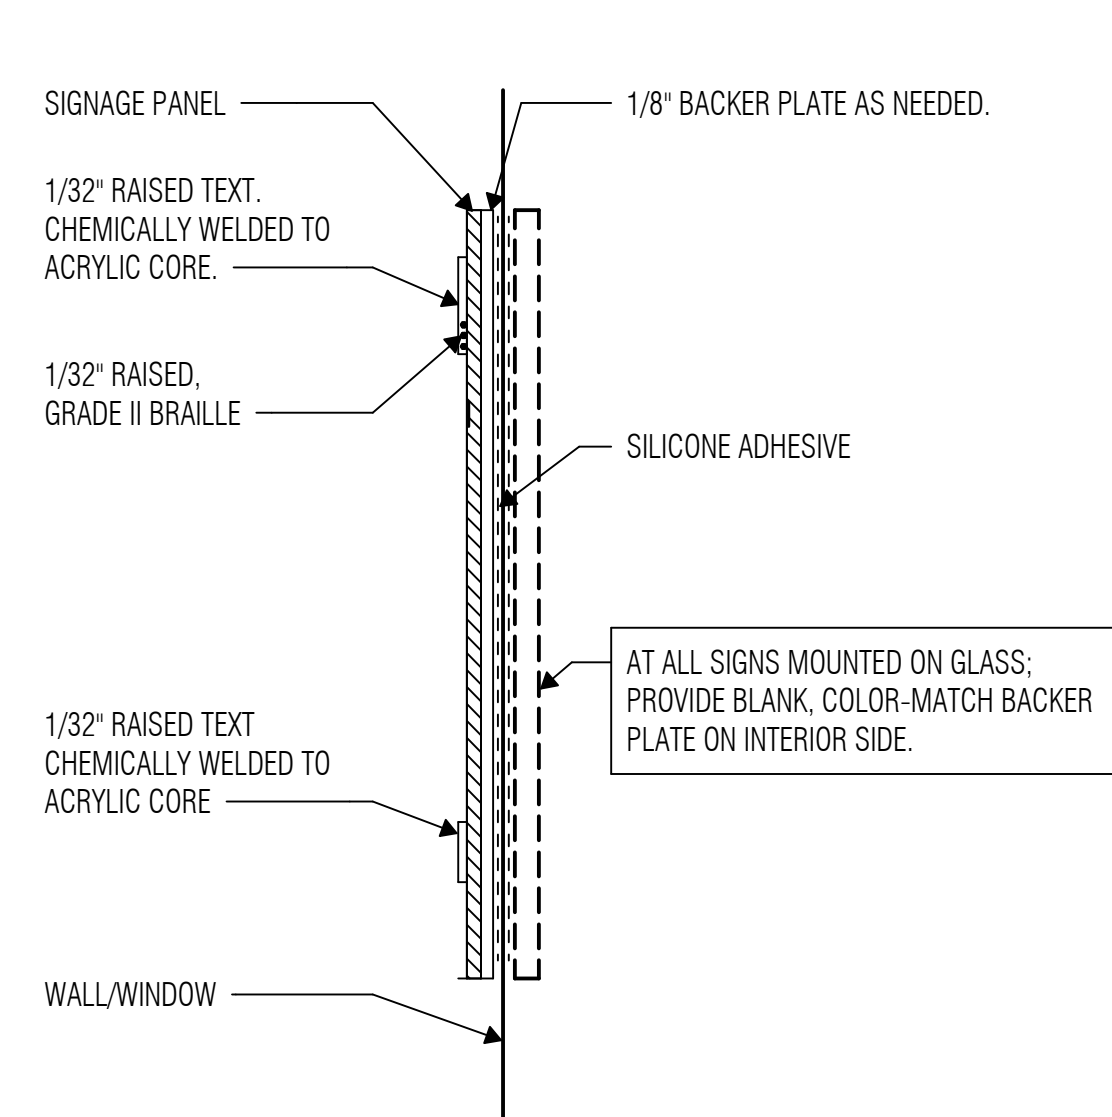

5 SIGN TYPE 'B'1
SCALE: 6" = 1'-0"

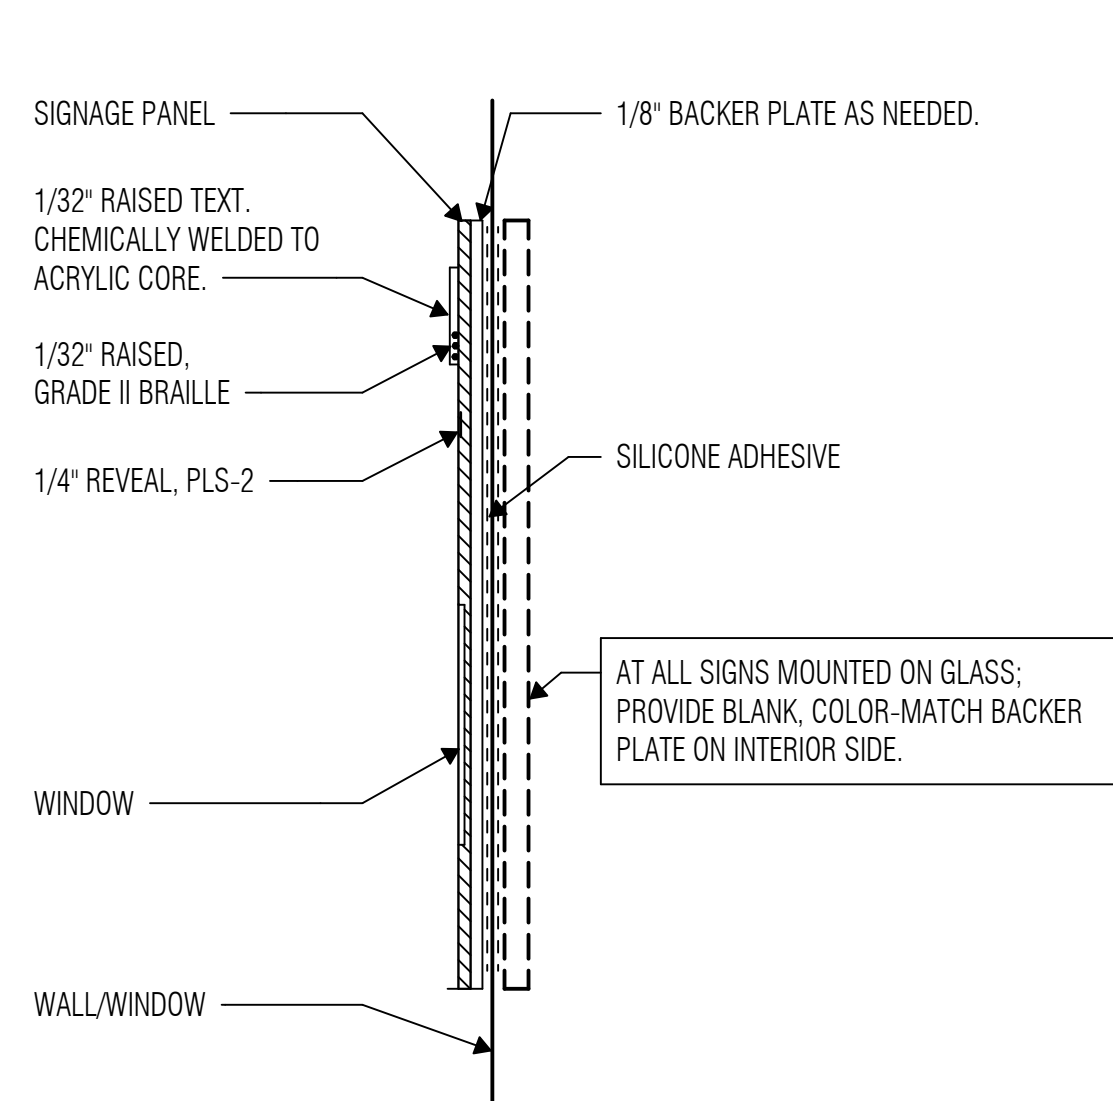

ISSUED: 03/06/25

REVISIONS

Revision No. Revision Date

Director: RSJ
Design: STH, KM
Drawn By: STH, KM
Quality Control: TQ

Proj. Arch: TQ

PROJECT NO.

24-010.00

SHEET TITLE

LABAY - ROOM SIGNAGE DETAILS

SHEET NO.

A29.20

2024 Cook, Labay & Truitt MS Renovations

CYPRESS-FAIRBANKS INDEPENDENT SCHOOL DISTRICT

HOUSTON, TEXAS



CYPRESS-FAIRBANKS INDEPENDENT SCHOOL DISTRICT HOUSTON, TEXAS

ARCHITECT

VLK Architects
20445 State Hwy 249, Suite 350
Houston, Texas 77070
Main Phone: 281.671.2300
www.vlkarchitects.com

CIVIL ENGINEER

Brooks & Sparks, Inc.
21020 Plank Row Blvd.
Katy, TX 77449
Main Phone: 281.578.9595
www.brooksandsparks.com

LANDSCAPE / IRRIGATION

Westwood
20329 State Hwy 249, #350
Houston, TX 77070
Main Phone: (281) 883-0103
www.westwoodps.com

STRUCTURAL ENGINEER

Dunaway
3200 Wilcrest Dr. Ste 4400
Houston, TX 77042
Main Phone: 512.306.8252
www.dunaway.com

M.E.P. ENGINEER

Salas O'Brien
10930 W Sam Houston Pkwy N #900
Houston, TX 77064
Main Phone: 281.664.1900
www.salasobrien.com

ACOUSTICAL / THEATRICAL

W.J.H.W.
3424 Midcourt Rd. Suite 124
Carrollton, TX 75006
Main Phone: 210.561.9800
www.wjhw.com



ISSUED: February 24, 2025

REVISIONS

Revision No.	Revision Date
1 Addendum 1	03-06-2025

Director: RSJ, Drawn By: -
Designer: -, Quality Control: -
Proj. Arch.: RS

PROJECT NO.

24-010.00

SHEET TITLE

COVER - TRUITT MS

SHEET NO.

G30.01

2024 Cook, Labay & Truitt MS Renovations

VOLUME 3

TRUITT MIDDLE SCHOOL

BOARD OF TRUSTEES

SCOTT HENRY	PRESIDENT
DR. NATALIE BLASINGAME	VICE PRESIDENT
JUSTIN RAY	SECRETARY
TODD LECOMPTE	TRUSTEE
JULIE HINAMAN	TRUSTEE
CHRISTINE KALMBACH	TRUSTEE
LUCAS H. SCANLON	TRUSTEE

ADMINISTRATION

DOUGLAS KILLIAN, ED.D.	SUPERINTENDENT OF SCHOOLS
TERESA HULL	CHIEF OF STAFF
MATT MORGAN	CHIEF OF OPERATION OFFICER
LINDA MACIAS, ED.D.	CHIEF ACADEMIC OFFICER
DEBORAH STEWART, ED.D.	CHIEF OF EMPLOYEE & STUDENT SERVICES
KAREN SMITH	CHIEF FINANCIAL OFFICER
CHRISTINA COLE	CHIEF OFFICER FOR SCHOOL LEADERSHIP
MARNEY COLLINS-SIMS	GENERAL COUNCIL
JESSE CLAYBURN	ASSISTANT SUPERINTENDENT, FACILITIES AND CONSTRUCTION
DAN GROSZ	DIRECTOR OF DESIGN AND FACILITIES PLANNING
SHANNON THOMPSON	DIRECTOR OF PROJECT MANAGEMENT
STEVEN BRYAN	DIRECTOR OF CONSTRUCTION FIELD SERVICES
AMY HAYES	DIRECTOR OF CONTRACT MANAGEMENT


SCOPE OF WORK

SCOPE #	DESCRIPTION
1	Renovate Shop and Classroom to allocate more space to Shop.
2	Renovate existing communications to provide manufacturing classroom and storage area.
3	Addition and Renovation at Sewing and FCS area to meet District Standards.
4	Provide brick service yard wall enclosure.
5	Add 1,000 SF total to Orchestra for the following: Increase main classroom size to 1,600 SF, Add one (1) Ensemble room 500 SF, Add one (1) Practice room 100 SF.
6	Provide outside storage for football and track equipment.
7	Replace deteriorated window sills.
8	Update Cafeteria Stage Lighting, Sound, A/V Equipment and Drapery packages.
9	Strip, regrade, and resod existing competition football field with TIF-419 Bermuda.
10	Replace athletics clothes washer.
11	Replace pumps in lift station.
12	Remove and replace pavement joint sealant.
13	Provide generator backed power for all racks in all telecommunications rooms.
15	Provide sub-metering for kitchen electrical, cooling/heating and water usages.
16	Add dedicated HVAC unit to secondary telecommunications room (IDF).
19	Repair gas piping on roof. Remove surface rust and paint. Replace all gas valves on roof.
20	Separate irrigation meter from existing water meter.
21	Replace all existing data cables to CAT 6A.
22	Additional card readers on exterior doors.
23	Harden main front desk.
26	Addition lockdown buttons.
27	Enhanced Video Intercoms.
28	Exterior Window and Door Numbering.
31	Impact-resistant glass on doors and high-traffic areas.
32	Upgrade classroom and exterior door hardware.

GENERAL DEMOLITION NOTES




1. Drawings show the general extent of demolition work, however it is impractical to indicate or note every item of demolition. Any items shown dashed are to be removed to make way for new construction, unless noted otherwise. Contractor shall notify Architect of any discrepancies between demolition and construction drawings prior to demolition.
2. Removal of any asbestos containing materials within the area of work shall be included in the Contractor's scope. Refer to asbestos abatement report and requirements.
3. Contractor shall protect existing items to remain from damage throughout all phases of the project. Contractor shall repair, at no cost to the owner, any damages they incur on the existing building and site not scheduled for alteration, as a result of construction activities. Contractor shall provide video documentation of existing conditions prior to start of construction and provide video to Architect.
4. Contractor to notify Architect if items shown as existing to remain need to be removed to make way for new work. Contractor is responsible for removing said items, unless noted otherwise, including but not limited to: furniture, equipment, shelving, fixtures, utilities, etc. Contractor shall carefully remove, protect, and reinstall items back to their original positions and make all original connections, when work in the affected area is complete. Any item damaged as a result of construction activity shall be replaced at Contractor's expense. This note shall apply to all areas with construction activity.
5. Refer to Civil, MEPT, and Structural drawings for additional demolition scope.
6. Patch/repair ceilings, walls, and flooring to match existing at all removed or demolished doors, windows, walls, millwork, lockers, and similar items. Refer to SECTION 01 36 13 for additional information regarding patch and repair.

DEMOLITION LEGEND

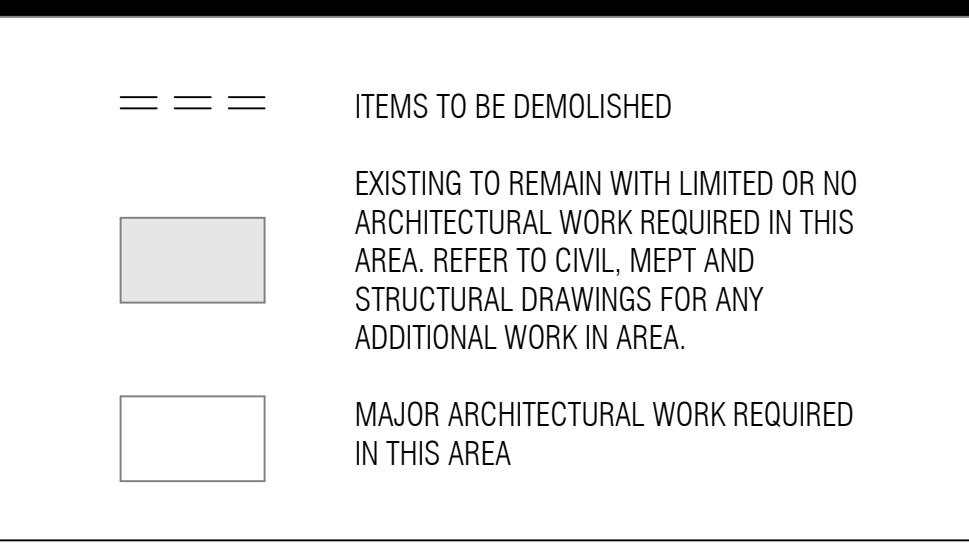

ARCHITECT
VLK Architects
 20445 State Hwy 249, Suite 350
 Houston, Texas 77070
 Main Phone: 281.671.2300
 www.vlkarchitects.com

CYPRESS-FAIRBANKS INDEPENDENT SCHOOL DISTRICT HOUSTON, TEXAS

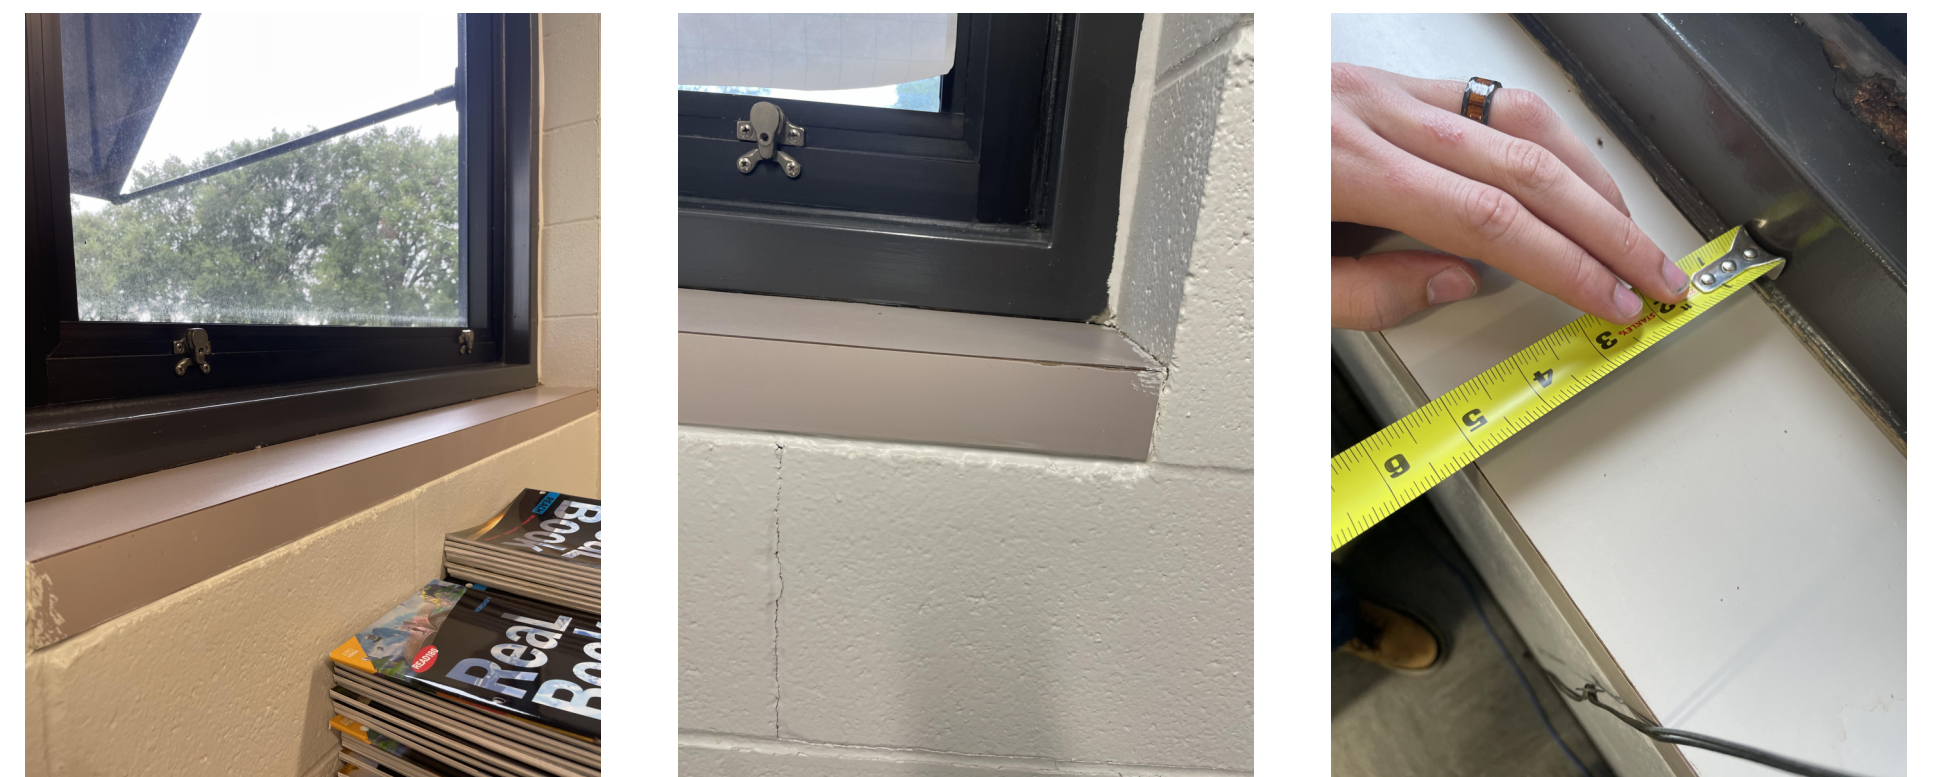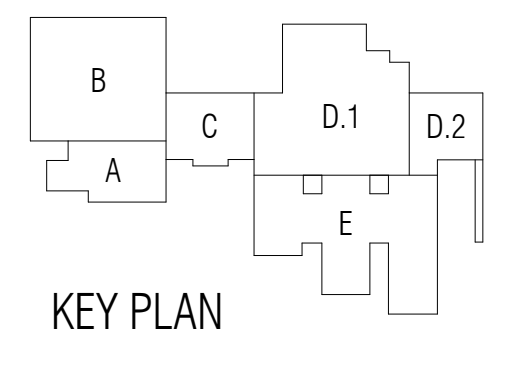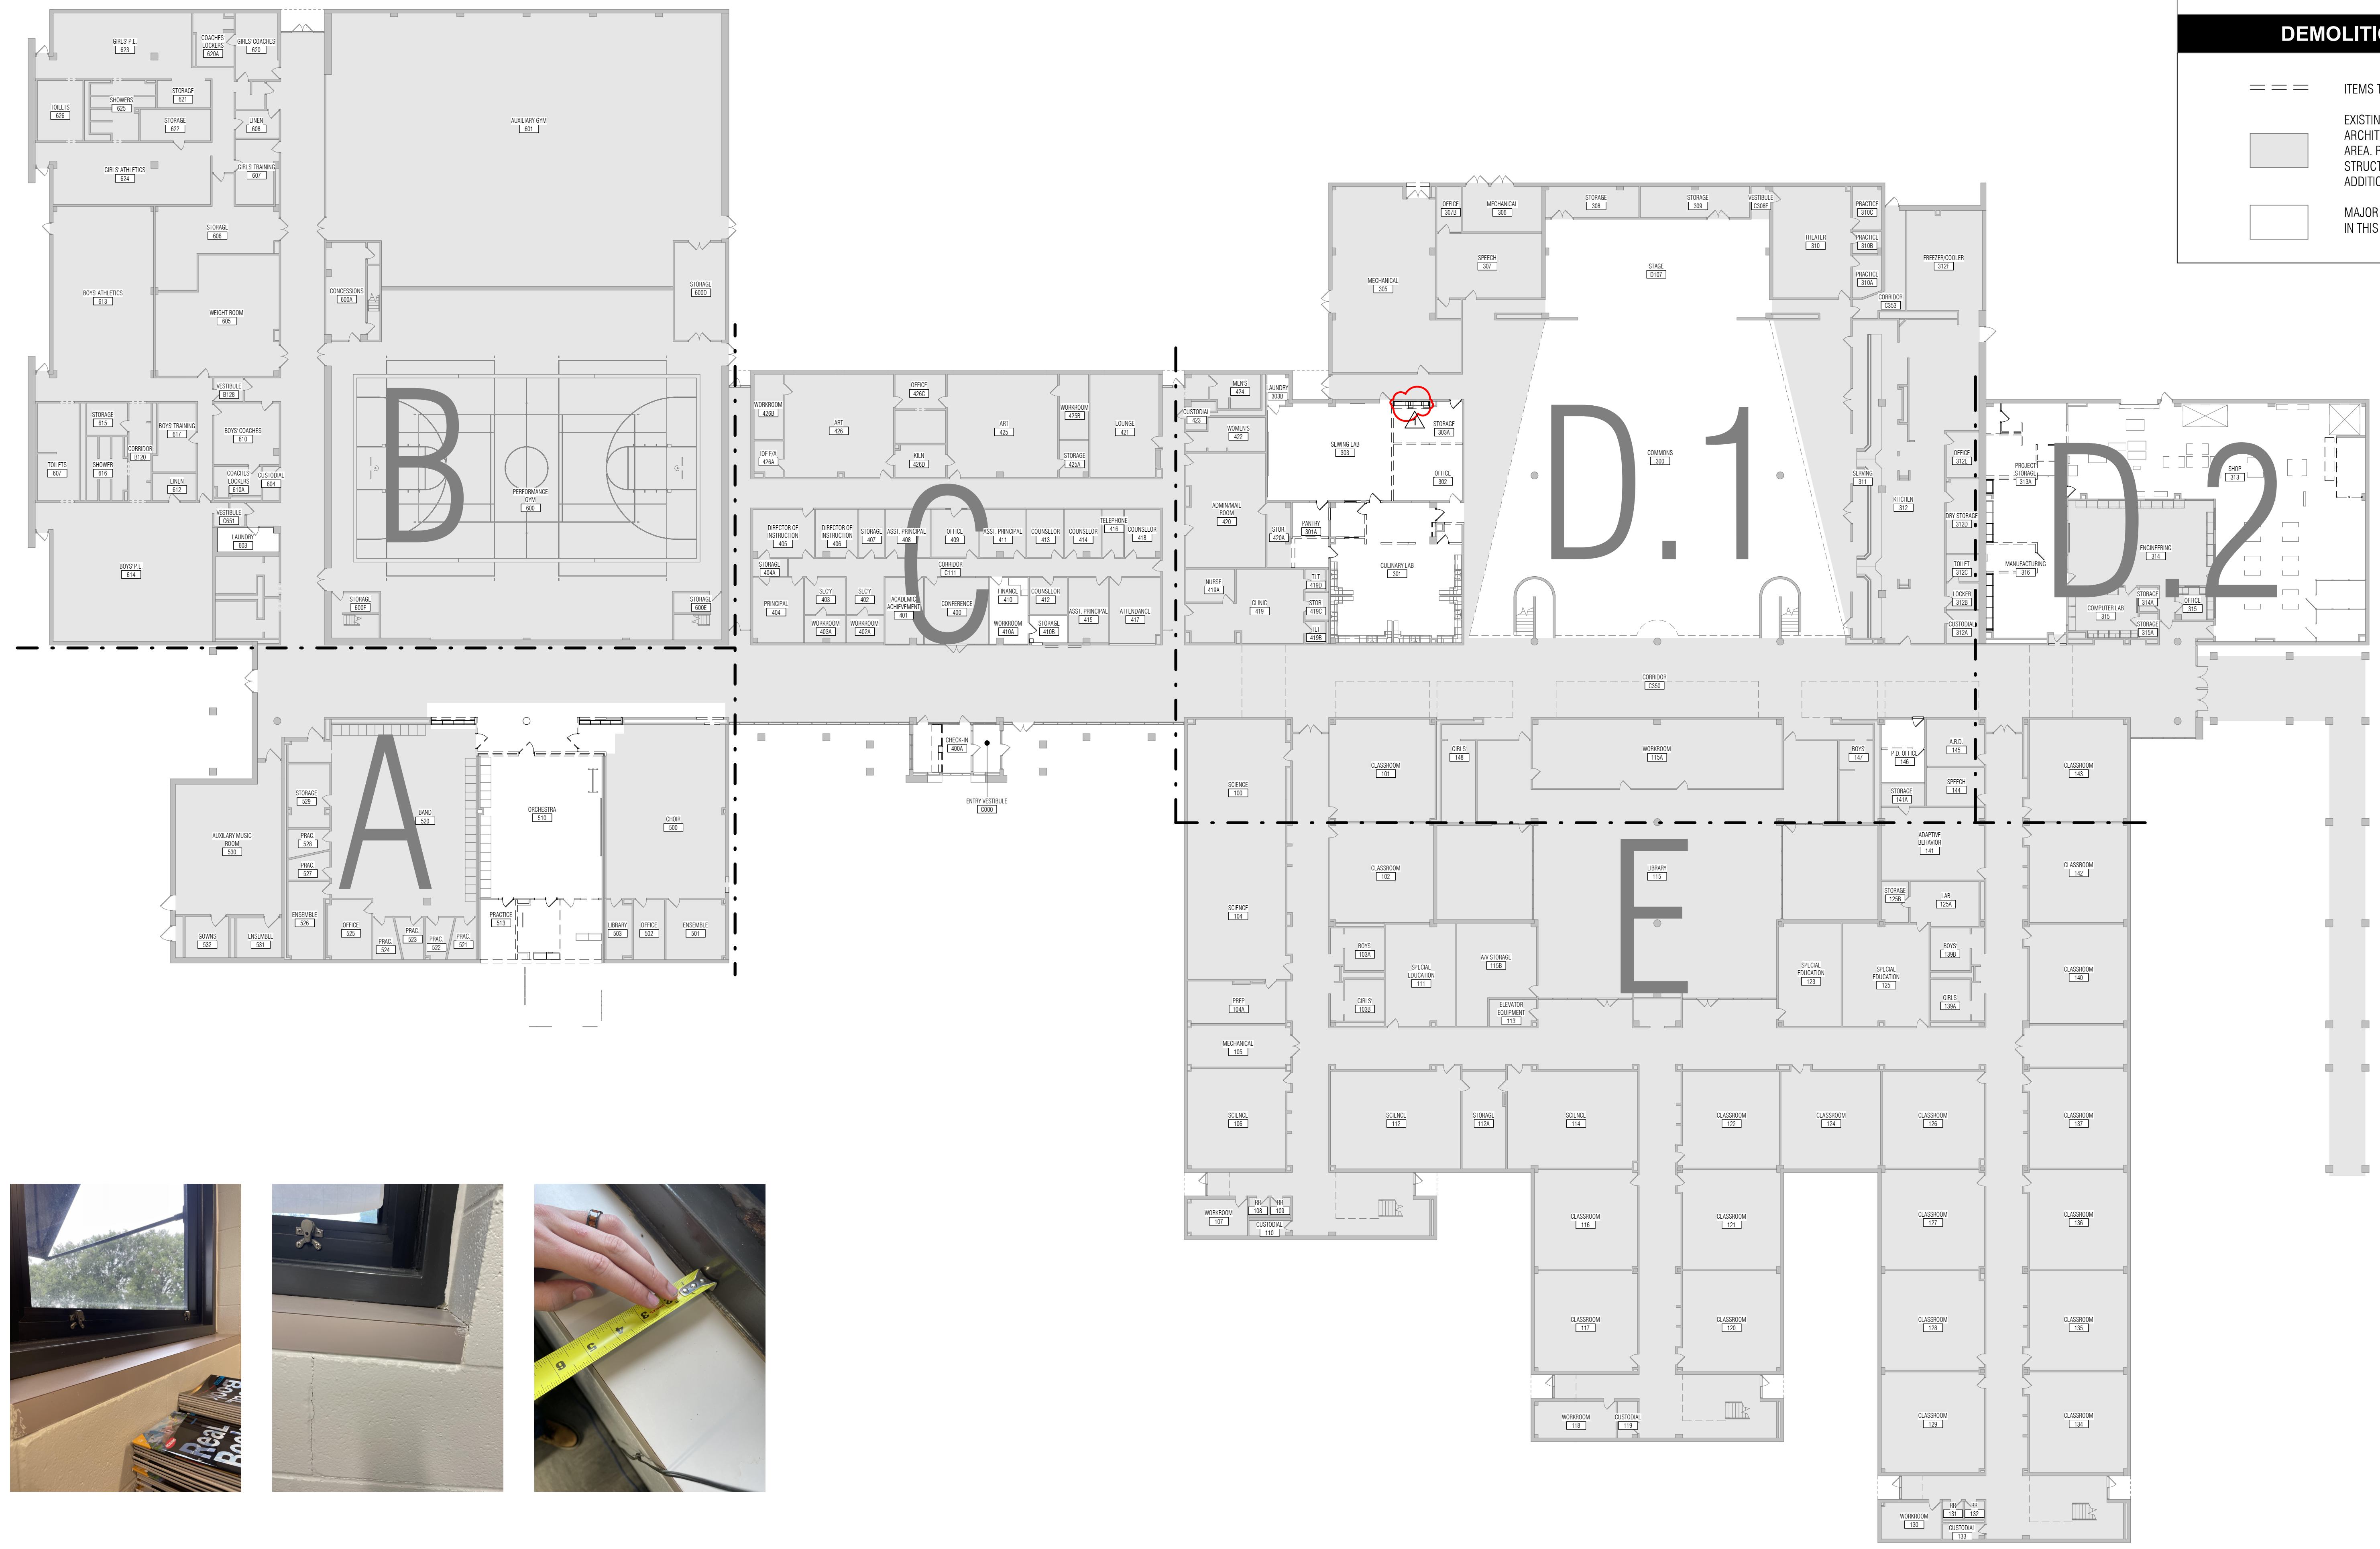

1 DEMOLITION ORIENTATION PLAN - LEVEL ONE
 SCALE: 3/64" = 1'-0"



ISSUED: February 24, 2025
REVISIONS
 Revision No. Revision Date
 1 Addendum 1 03-06-2025

Director: RSJ
 Designer: RSJ
 Drawn By: STH, KM
 Quality Control: STH, KM

Proj. Arch.: TQ


PROJECT NO.
24-010.00

SHEET TITLE
 TRUITT - ORIENTATION DEMOLITION PLAN - LEVEL ONE

SHEET NO.

A32.01

2024 Cook, Labay & Truitt MS Renovations

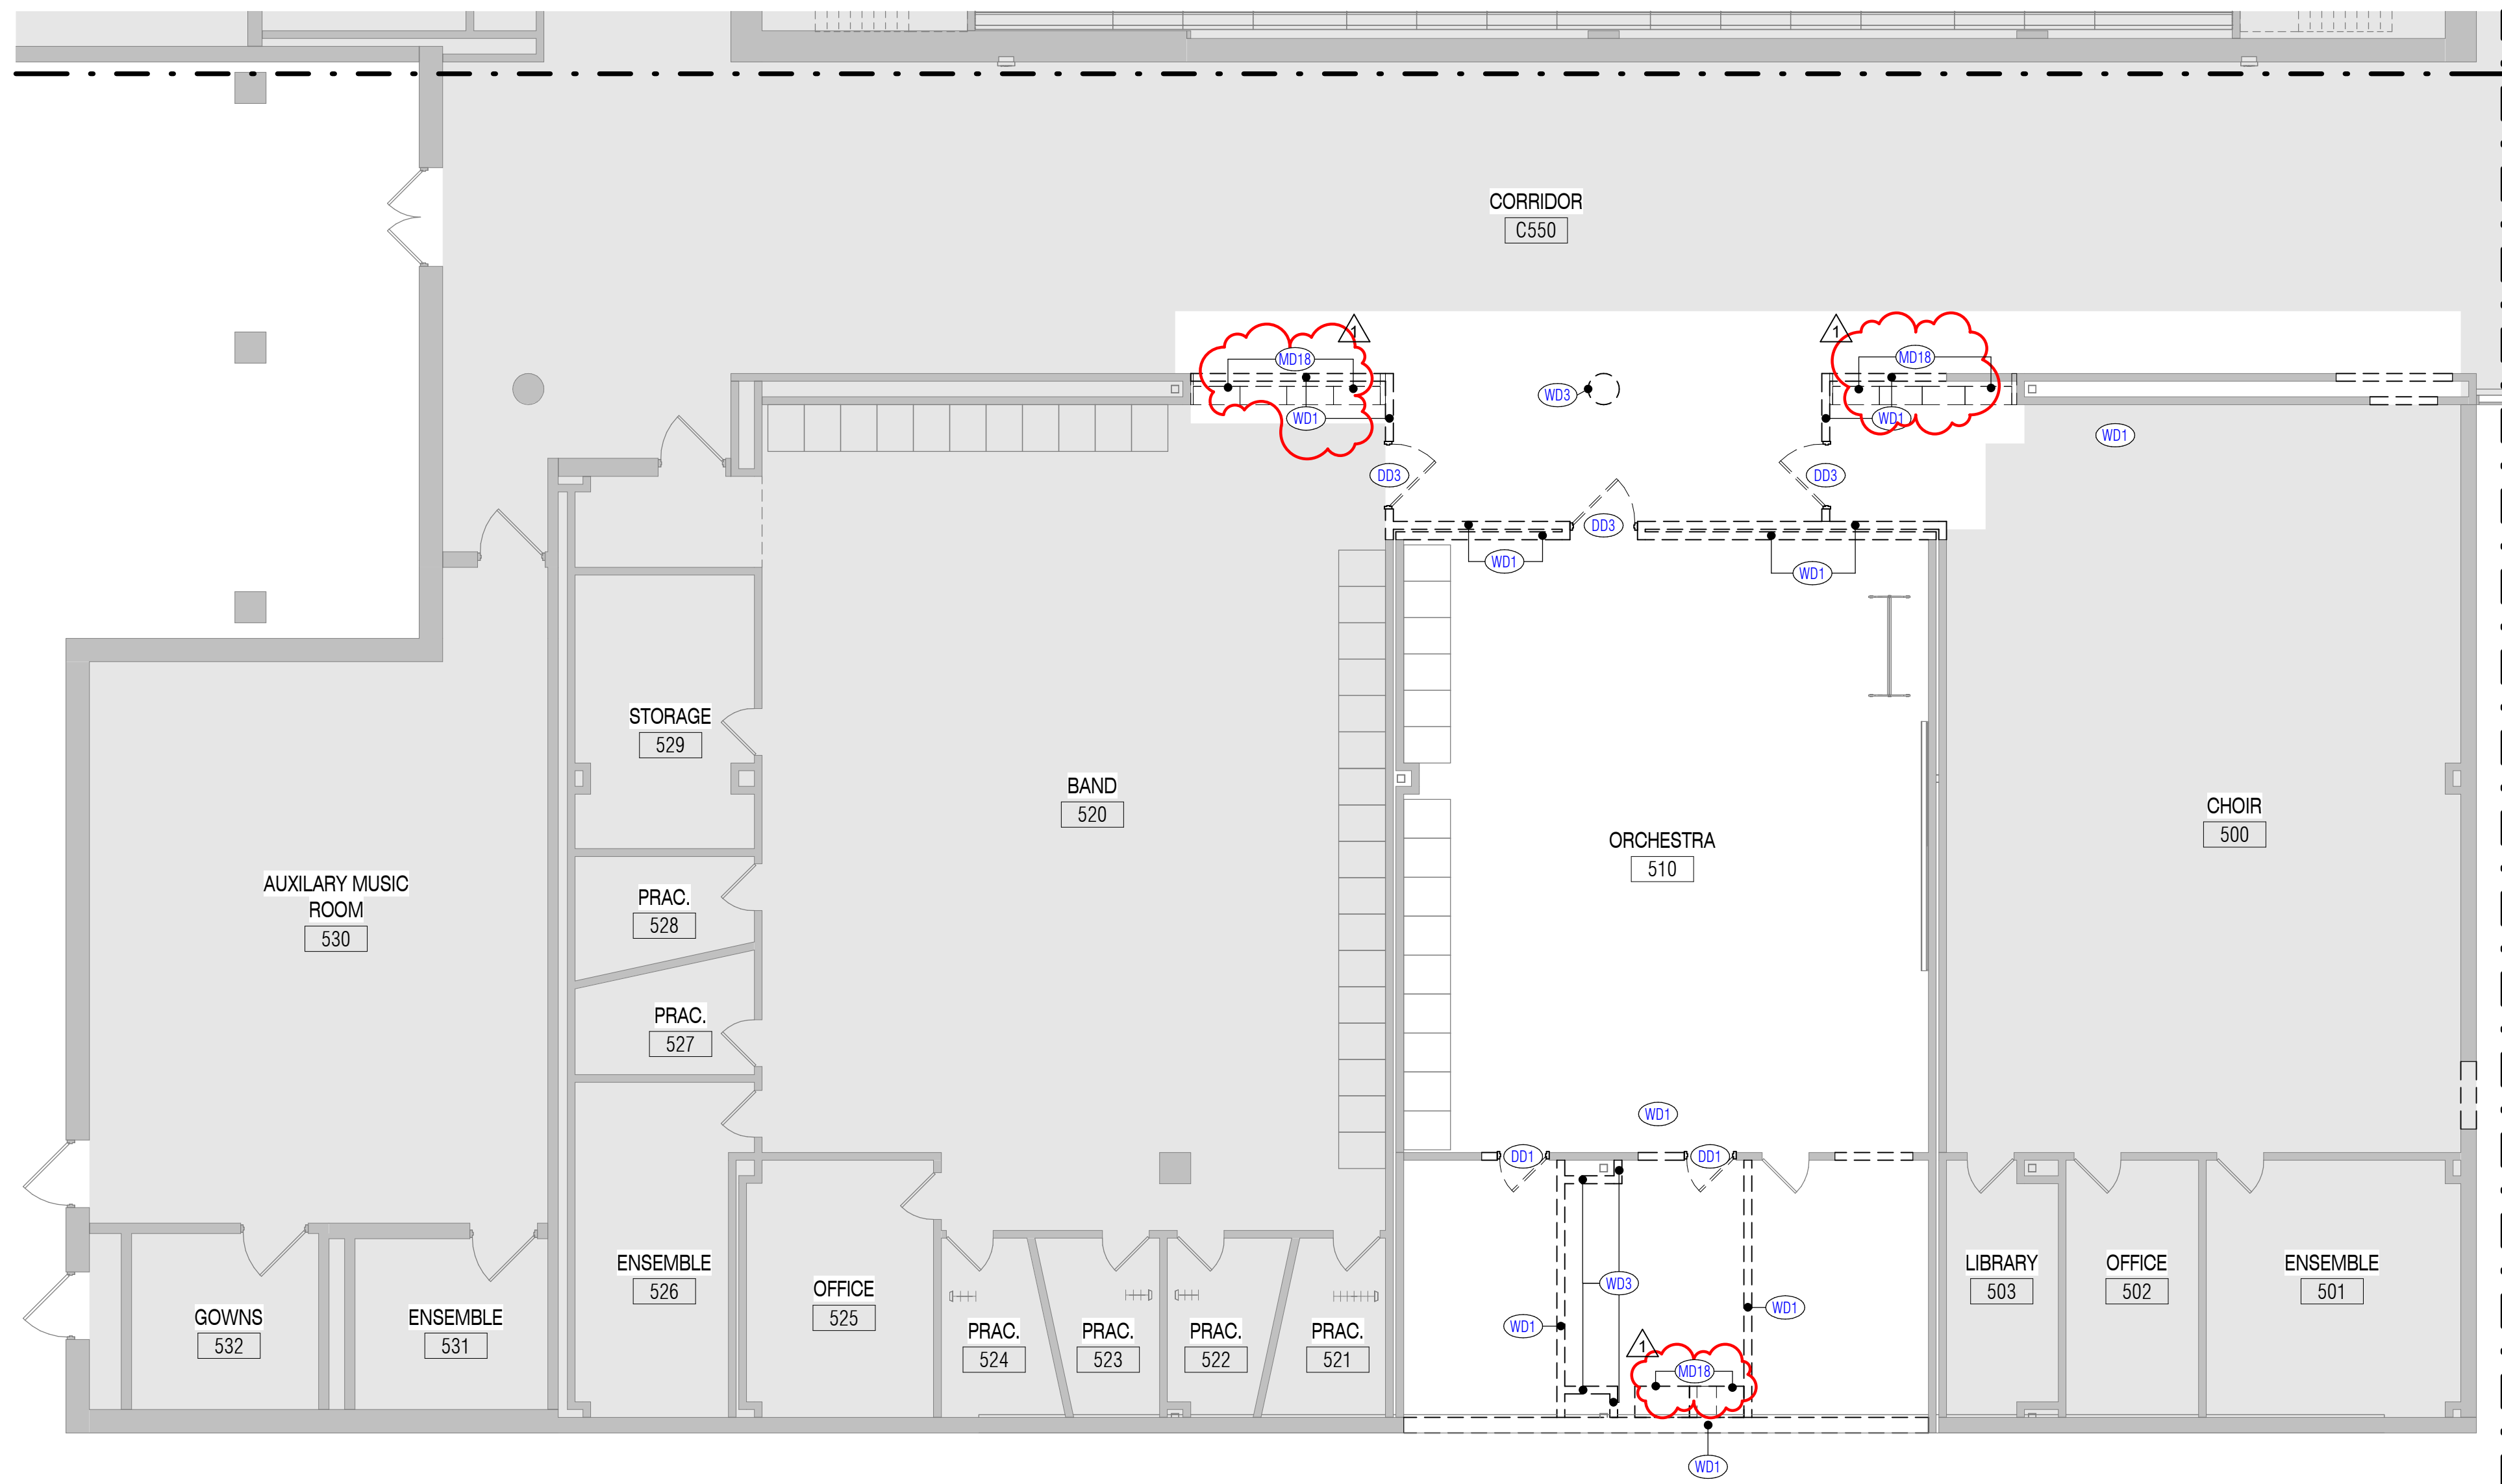

1 UNIT "A" DEMOLITION PLAN - LEVEL ONE
SCALE: 1/8" = 1'-0"

GENERAL DEMOLITION NOTES

- Drawings show the general extent of demolition work, however it is impractical to indicate or note every item of demolition. Any items shown dashed are to be removed to make way for new construction, unless noted otherwise. Contractor shall notify Architect of any discrepancies between demolition and construction drawings prior to demolition.
- Removal of any asbestos containing materials within the area of work shall be included in the Contractor's scope. Refer to asbestos abatement report and requirements.
- Contractor shall protect existing items to remain from damage throughout all phases of the project. Contractor shall repair, at no cost to the owner, any damages they incur on the existing building and site not scheduled for alteration, as a result of construction activities. Contractor shall provide video documentation of existing conditions prior to start of construction and provide video to Architect.
- Contractor to notify Architect if items shown as existing to remain need to be removed to make way for new work. Contractor is responsible for removing said items, unless noted otherwise, including but not limited to: furniture, equipment, shelving, fixtures, utilities, etc. Contractor shall carefully remove, protect, and reinstall items back to their original positions and make all original connections, when work in the affected area is complete. Any item damaged as a result of construction activity shall be replaced at Contractor's expense. This note shall apply to all areas with construction activity.
- Refer to Civil, MEPT, and Structural drawings for additional demolition scope.
- Patch/repair ceilings, walls, and flooring to match existing at all removed or demolished doors, windows, walls, millwork, lockers, and similar items. Refer to SECTION 01 36 13 for additional information regarding patch and repair.

DEMOLITION LEGEND

- == == ITEMS TO BE DEMOLISHED
- EXISTING TO REMAIN WITH LIMITED OR NO ARCHITECTURAL WORK REQUIRED IN THIS AREA. REFER TO CIVIL, MEPT AND STRUCTURAL DRAWINGS FOR ANY ADDITIONAL WORK IN AREA.
- MAJOR ARCHITECTURAL WORK REQUIRED IN THIS AREA

KEYNOTE LEGEND


- DD1 REMOVE AND PROPERLY DISPOSE OF DOOR, HARDWARE, AND FRAME. PREPARE AREA TO RECEIVE NEW CONSTRUCTION.
- DD3 REMOVE AND RETURN DOOR TO OWNER, HARDWARE, AND FRAME. PREPARE AREA TO RECEIVE NEW CONSTRUCTION.
- DD18 REMOVE AND PROTECT CASEWORK. PREPARE FOR RELOCATION. RE: RESPECTIVE UNIT RENOVATION PLAN FOR NEW LOCATION.
- WD1 CAREFULLY REMOVE AND PROPERLY DISPOSE OF WALL AS SHOWN IN DASHED LINES. CLEAN AND PREPARE AREA FOR NEW CONSTRUCTION. CAP AND ABANDON ALL EXISTING UTILITIES IN WALL. RE: MEP DRAWINGS FOR ADDITIONAL INFORMATION.
- WD3 CAREFULLY REMOVE AND PROPERLY DISPOSE OF COLUMN COVER. PROTECT INTERNAL STRUCTURAL COLUMN. CLEAN AND PREPARE AREA FOR NEW CONSTRUCTION.



ARCHITECT

VLK Architects
20445 State Hwy 249, Suite 350
Houston, Texas 77070
Main Phone: 281.671.2300
www.vlkarchitects.com

CYPRESS-FAIRBANKS INDEPENDENT SCHOOL DISTRICT
HOUSTON, TEXAS

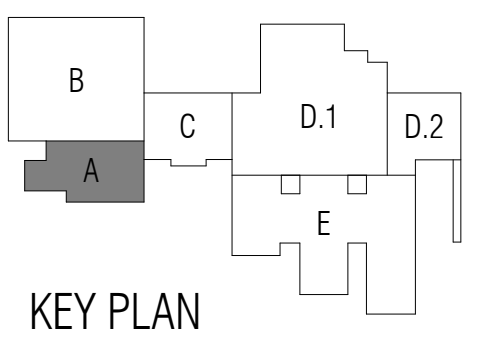

KEY PLAN



ISSUED: February 24, 2025

REVISIONS

Revision No.	Revision Date
1 Addendum 1	03-06-2025

Director Approver
Designer
Proj. Arch. Checker

Drawn By
STH, KM
Quality Control

PROJECT NO.

24-010.00

SHEET TITLE

TRUITT - UNIT A
DEMOLITION PLAN - LEVEL ONE

SHEET NO.

A32.01A

2024 Cook, Labay & Truitt MS Renovations

GENERAL DEMOLITION NOTES




- Drawings show the general extent of demolition work, however it is impractical to indicate or note every item of demolition. Any items shown dashed are to be removed to make way for new construction, unless noted otherwise. Contractor shall notify Architect of any discrepancies between demolition and construction drawings prior to demolition.
- Removal of any asbestos containing materials within the area of work shall be included in the Contractor's scope. Refer to asbestos abatement report and requirements.
- Contractor shall protect existing items to remain from damage throughout all phases of the project. Contractor shall repair, at no cost to the owner, any damages they incur on the existing building and site not scheduled for alteration, as a result of construction activities. Contractor shall provide video documentation of existing conditions prior to start of construction and provide video to Architect.
- Contractor to notify Architect if items shown as existing to remain need to be removed to make way for new work. Contractor is responsible for removing said items, unless noted otherwise, including but not limited to: furniture, equipment, shelving, fixtures, utilities, etc. Contractor shall carefully remove, protect, and reinstall items back to their original positions and make all original connections, when work in the affected area is complete. Any item damaged as a result of construction activity shall be replaced at Contractor's expense. This note shall apply to all areas with construction activity.
- Refer to Civil, MEPT, and Structural drawings for additional demolition scope.
- Patch/repair ceilings, walls, and flooring to match existing at all removed or demolished doors, windows, walls, millwork, lockers, and similar items. Refer to SECTION 01 36 13 for additional information regarding patch and repair.

DEMOLITION LEGEND

- ITEMS TO BE DEMOLISHED
- ▒ EXISTING TO REMAIN WITH LIMITED OR NO ARCHITECTURAL WORK REQUIRED IN THIS AREA. REFER TO CIVIL, MEPT AND STRUCTURAL DRAWINGS FOR ANY ADDITIONAL WORK IN AREA.
- MAJOR ARCHITECTURAL WORK REQUIRED IN THIS AREA

KEYNOTE LEGEND

- DD1 REMOVE AND PROPERLY DISPOSE OF DOOR, HARDWARE, AND FRAME. PREPARE AREA TO RECEIVE NEW CONSTRUCTION.
- DD6 CAREFULLY REMOVE AND PROTECT DOOR LEAF AND HARDWARE. PREPARE TO BE MOVED TO NEW LOCATION AT STORAGE 308 (RE: A32.01C)
- MD2 REMOVE AND PROPERLY DISPOSE CASEWORK. PREPARE AREA FOR NEW CONSTRUCTION.
- MD6 CAREFULLY REMOVE TO BE REUSED.
- MD17 CAREFULLY REMOVE AND SALVAGE SAFE TO BE RELOCATED. COORDINATE WITH DISTRICT REP.
- MD18 REMOVE AND PROTECT CASEWORK. PREPARE FOR RELOCATION. RE: RESPECTIVE UNIT RENOVATION PLAN FOR NEW LOCATION
- WD1 CAREFULLY REMOVE AND PROPERLY DISPOSE OF WALL AS SHOWN IN DASHED LINES. CLEAN AND PREPARE AREA FOR NEW CONSTRUCTION. CAP AND ABANDON ALL EXISTING UTILITIES IN WALL. RE: MEP DRAWINGS FOR ADDITIONAL INFORMATION.
- WD2 CAREFULLY REMOVE AND PROPERLY DISPOSE OF STOREFRONT SYSTEM. CLEAN AND PREPARE AREA FOR NEW CONSTRUCTION.

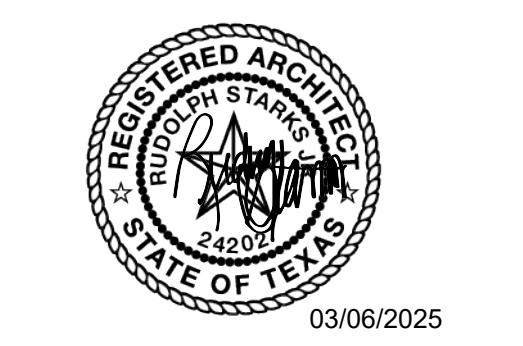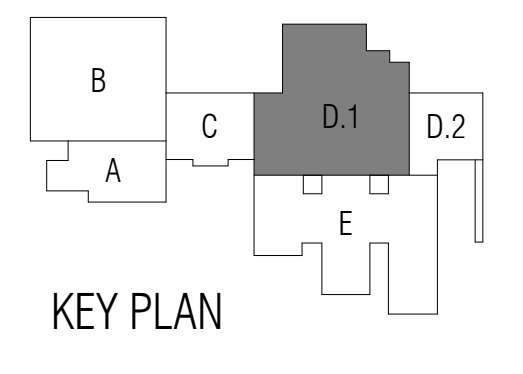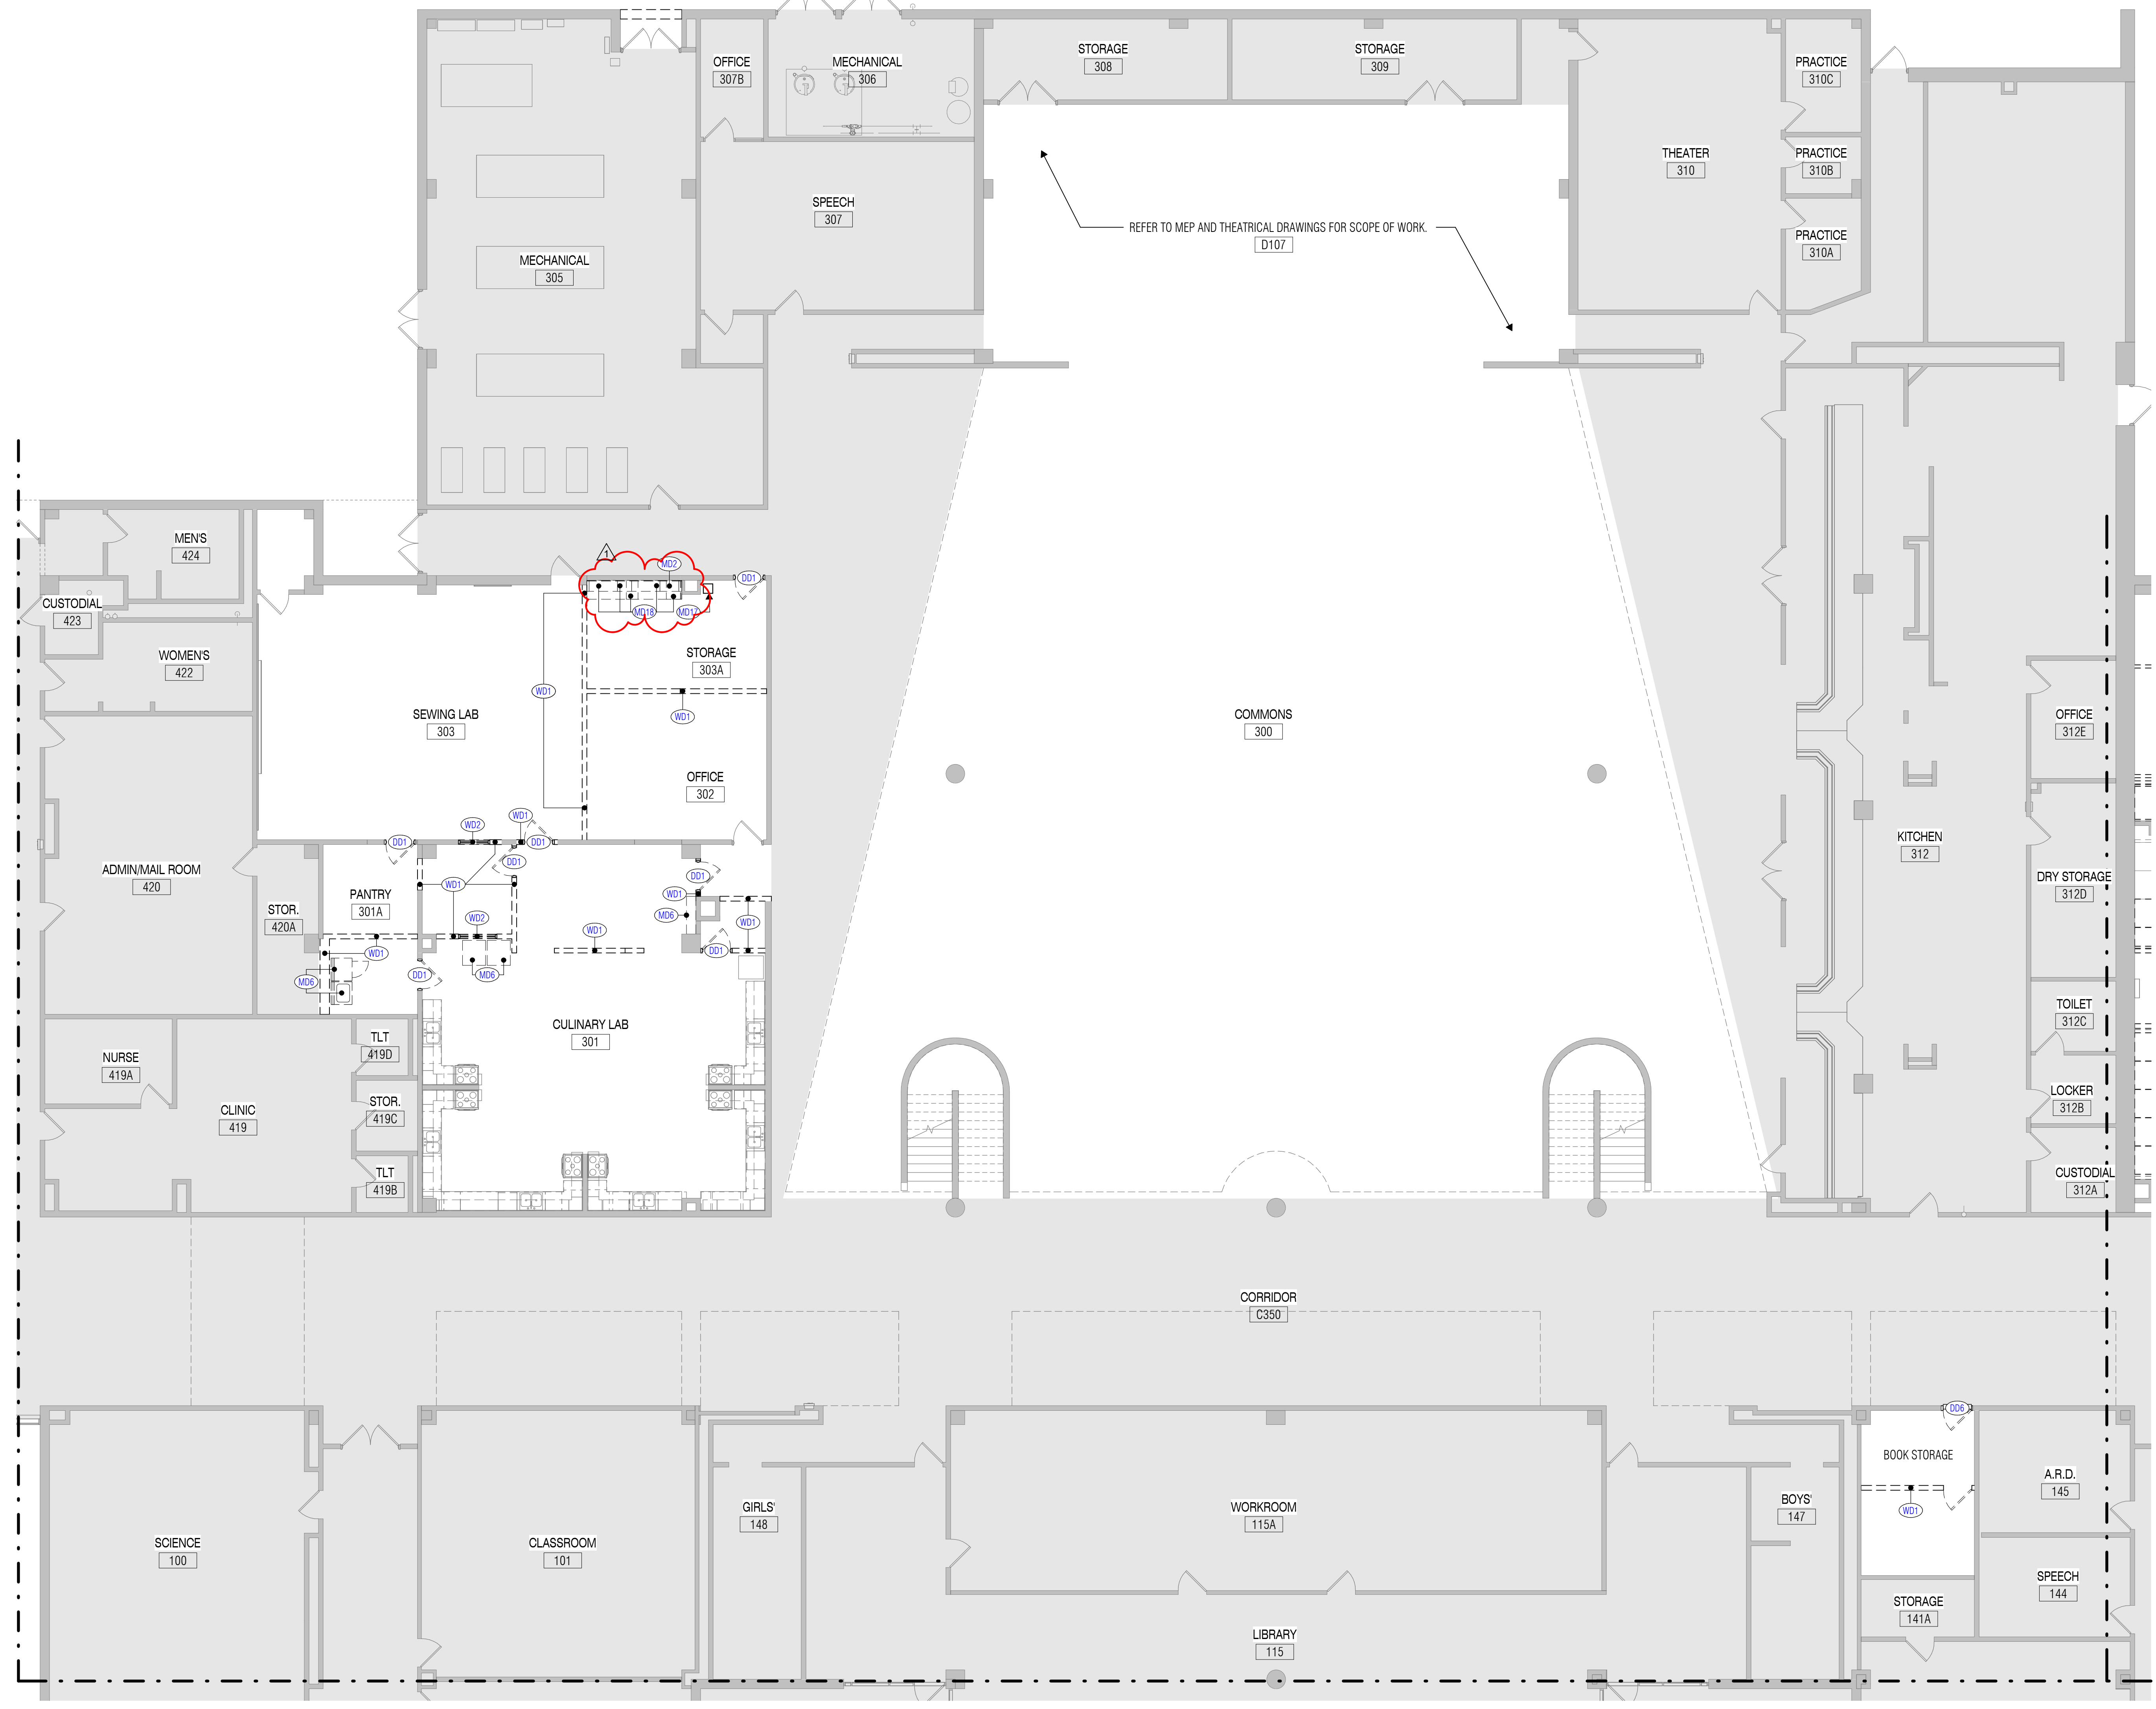

ISSUED: February 24, 2025

REVISIONS

Revision No.	Revision Date
1 Addendum 1	03-06-2025


Director
 Approver
 Designer
 Designer
 Proj. Arch.
 Checker

Drawn By
 STH, KM
 Quality Control


PROJECT NO.
24-010.00
 SHEET TITLE
 TRUITT - UNIT D.1
 DEMOLITION PLAN - LEVEL ONE
 SHEET NO.

A32.01D.1

① UNIT "D.1" DEMOLITION PLAN - LEVEL ONE
 SCALE: 1/8" = 1'-0"

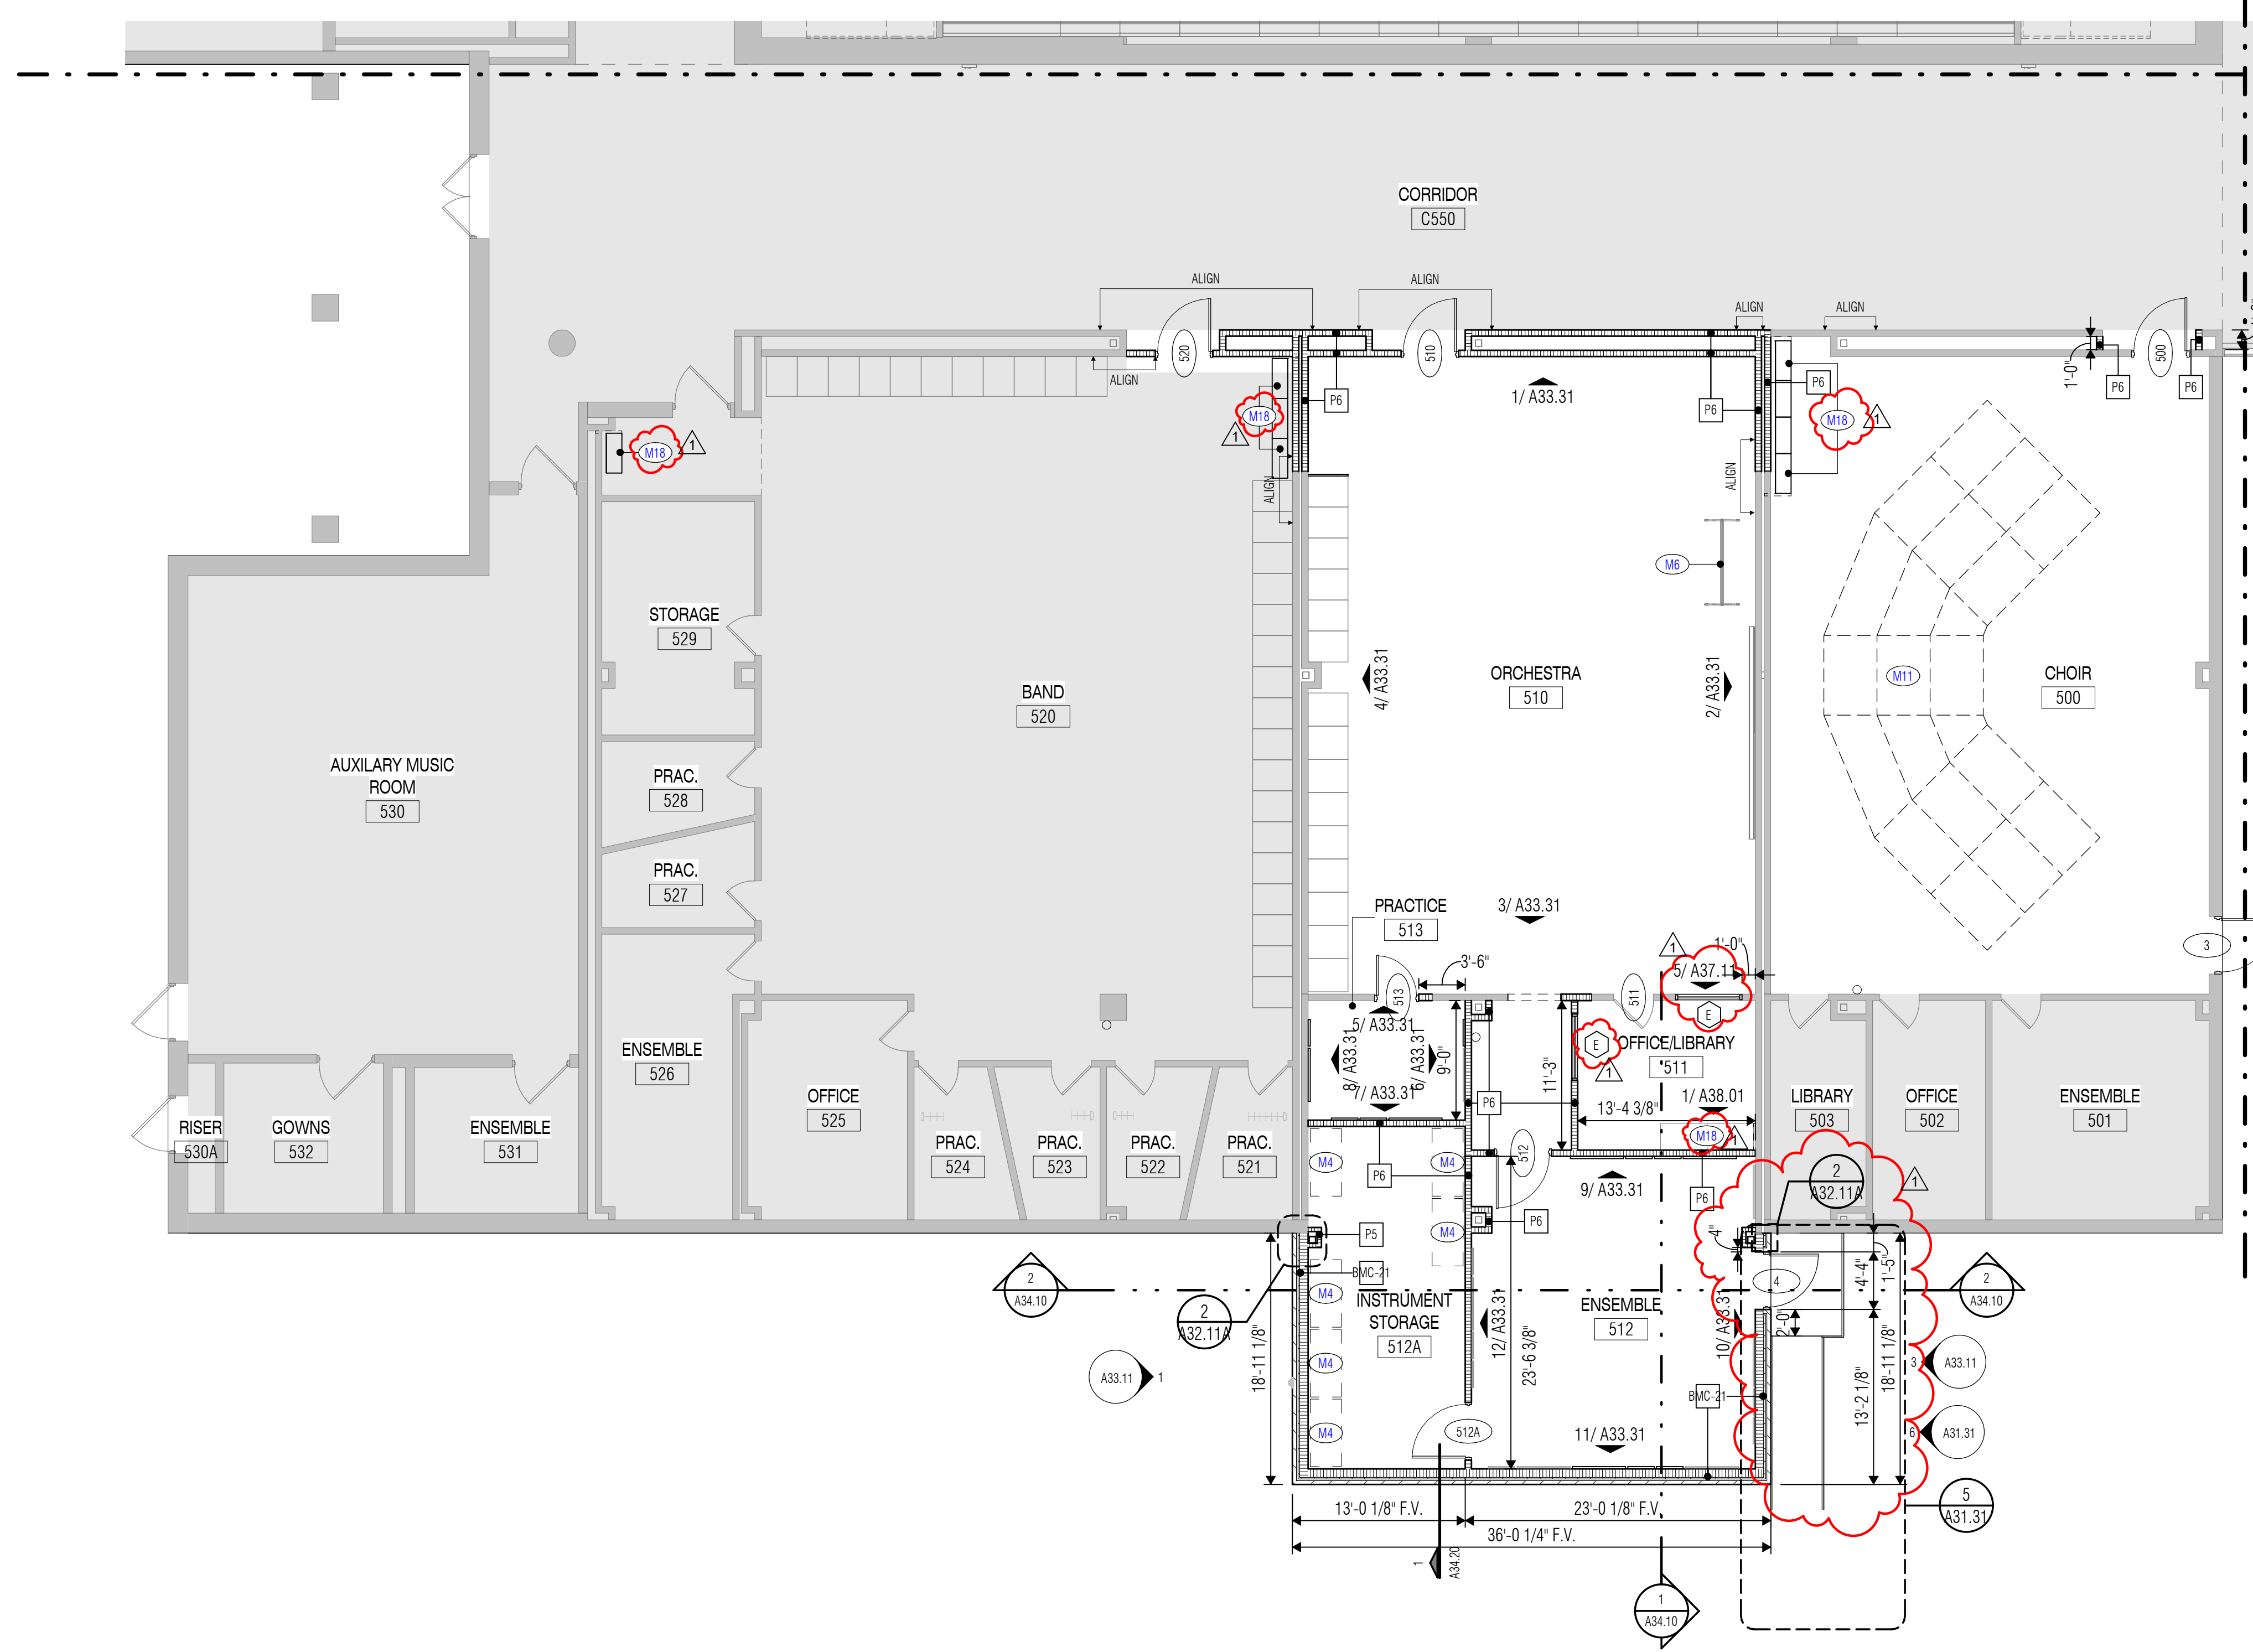

1 UNIT "A" PLAN - LEVEL ONE
SCALE: 1/8" = 1'-0"

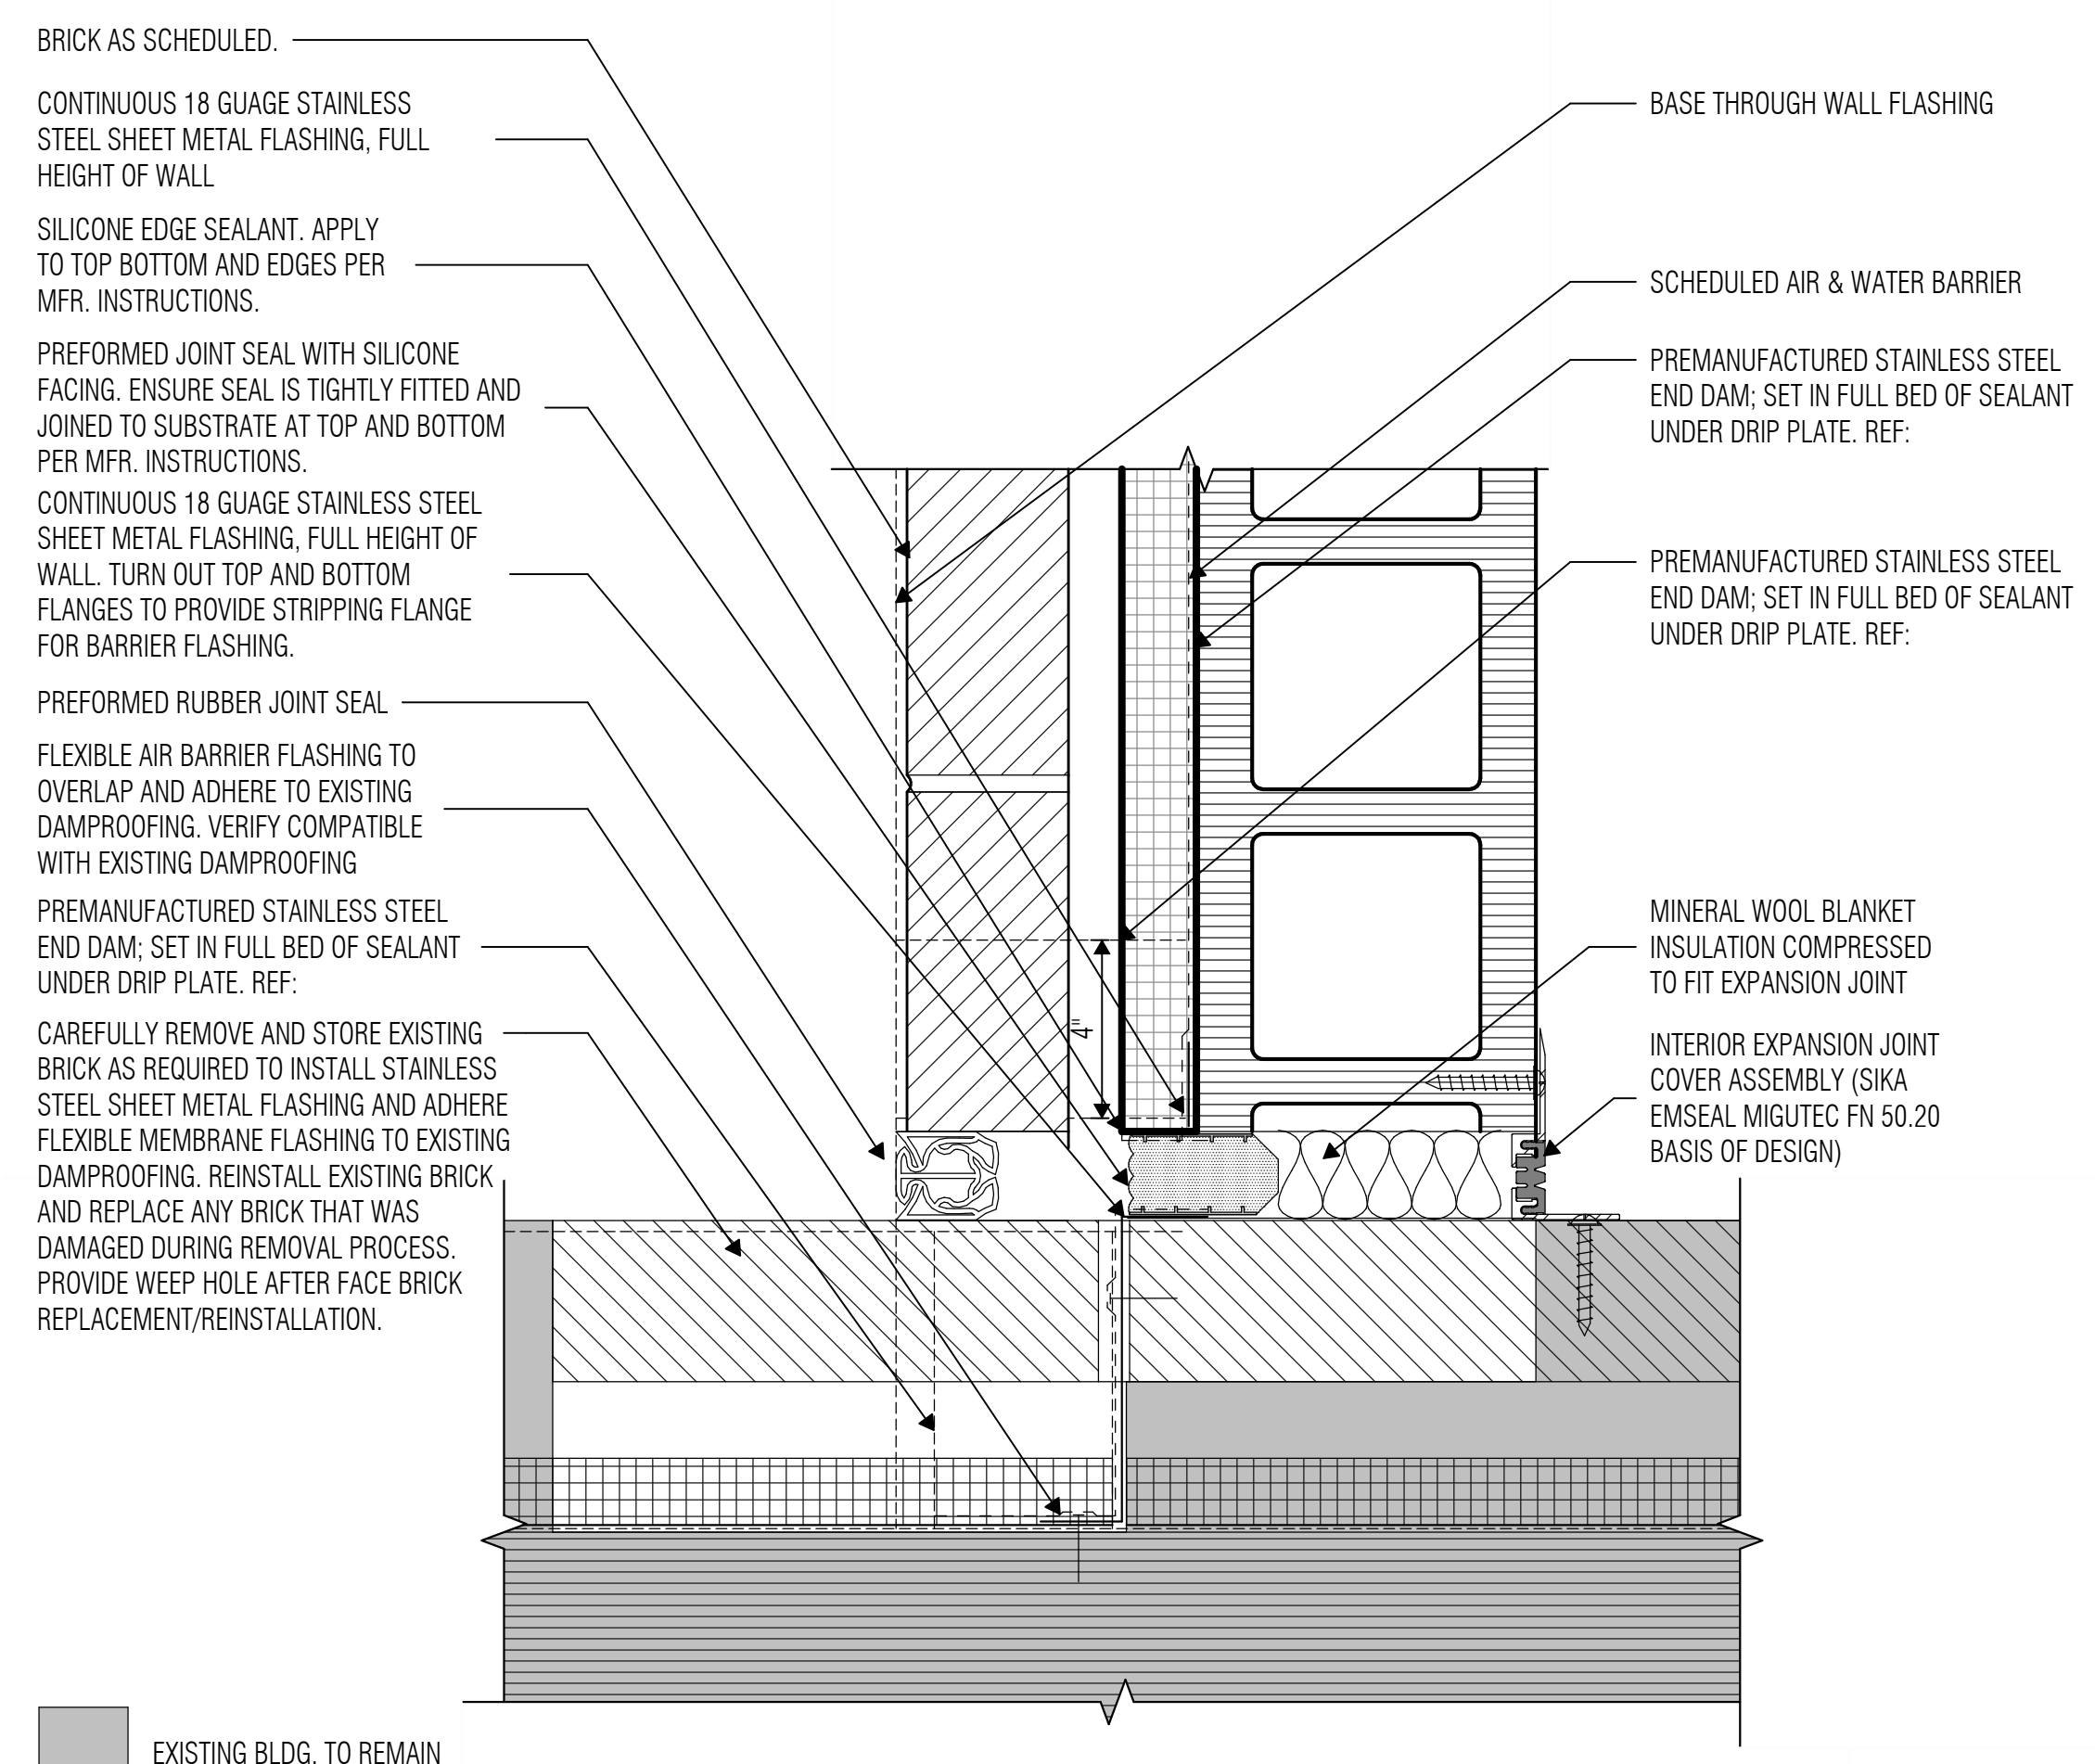

2 EXPANSION JOINT @ EXTERIOR WALL TYP.
SCALE: 3/8" = 1'-0"

FLOOR PLAN NOTES

- Refer to Civil Grading drawings for Primary Ground Level floor elevation relative to Mean Sea Level. Architectural Finish Floor (100'-0" datum) is equal to Civil FFE.
- Dimensions on Floor Plans are to face of stud or CMU unless noted otherwise.
- Coordinate the location of electrical devices with casework, millwork, lockers, etc. Any electrical device that is not properly coordinated shall be relocated at no additional cost.
- Exterior wall construction is identified on the Wall Sections. Refer to the A' 4-series sheets for Wall Sections, and to A14.30, A24.30, A34.30 for Exterior Wall Assemblies.
- Refer to Exterior Elevation Notes for control joint requirements at all inside corners of masonry veneer.
- Refer to PARTITION TYPES (A12.21, A22.21, A32.21) for Partition Types Legend.
- Interior partitions are Type "P6" unless noted otherwise.
- Refer to Detail 4/A31.31 for Typical Door Maneuvering Clearances. All new doors shall meet the requirements of that detail. If any door is found that does not comply with these requirements, request clarification from the Architect prior to construction.
- Refer to PARTITION DETAILS sheets for Typical Partition Penetration Details, including pipe, conduit and ductwork penetrations.
- Refer to PARTITION DETAILS sheets for Typical Bracing at Non-Loadbearing CMU Partitions.
- Refer to Exterior Elevations for exact locations of downsputs.
- Provide factory bullnose units at all interior exposed vertical edges of CMU, except at starter course with applied base material where square-edge units shall be provided in lieu of bullnose units.
- Provide 4" starter courses at all CMU walls and partitions unless noted otherwise.
- Provide steel or masonry lintels over all openings in CMU walls, including those required for mechanical ductwork and dampers, whether specifically indicated on the drawings or not.
- Provide minimum 20 gage light-gage steel studs at all interior partitions scheduled to receive ceramic tile or plaster.
- Provide minimum 18 gage cold-formed steel studs at all interior partitions scheduled to receive anchored masonry or stone veneer as well as interior partitions with steel plate or steel sheet X-bracing.
- Provide minimum 18 gage cold-formed steel studs as designed by stud engineer for all interior partitions scheduled to receive adhered masonry or stone veneer.
- At light-gage steel stud partitions that extend above the ceiling, provide diagonal 20 gage stud braces at 4'-0" o.c. to structure above (not to steel deck) as required to provide rigid anchorage and support of partitions.
- Provide minimum 2 X 6 fire-retardant treated wood blocking in both new and existing stud walls and partitions, at mounting locations for wall-mounted accessories, handrails, casework, markerboards, tackboards, folding partitions, toilet partitions, and all other wall-mounted items. Refer to CASEWORK ELEVATIONS & DETAILS sheets for typical blocking requirements at various conditions.
- At Mechanical, Electrical and Boiler Room partitions, seal tightly around all penetrations. Utilize fire safing material at rated partitions.
- Provide sealant and/or fire safing at all floor penetrations, as applicable.
- Existing equipment to remain U.N.O. Contractor to relocate equipment as needed to complete new construction. All equipment to be in as good or better working condition as prior to the start of construction.

FLOOR PLAN LEGEND



- METAL STUD PARTITION. Extend 4" above highest ceiling plane and brace to structure above as noted in Floor Plan Notes. Refer to Reflected Ceiling Plan for fire, smoke and sound-conditioned partitions that extend to deck above.
- CMU PARTITION. Extend 4" above highest ceiling plane and brace to structure above as detailed. Refer to Reflected Ceiling Plan for fire, smoke and sound-conditioned partitions that extend to deck above.
- EXISTING WALL TO REMAIN.
- MOVABLE METAL SHELVING. Depth and Width dimensions match that of this legend, unless otherwise noted.
- FURNITURE, FIXTURE OR EQUIPMENT BY OWNER. Coordinate with adjacent electrical devices, casework, etc.
- MB MARKERBOARD. Preceding number is length, in feet.
- SL WITH HALF STAFF LINES
- TB TACKBOARD. Preceding number is length, in feet.
- TS TACK STRIP. Preceding number is length, in feet.
- IM INTERACTIVE MARKERBOARD
- EX EXISTING
- IFP INTERACTIVE FLAT PANEL
- FEF FIRE EXTINGUISHER WITH CABINET AND BRACKET
- FE FIRE EXTINGUISHER WITH BRACKET
- FHC FIRE HOSE CABINET
- HB HORIZONTAL BLINDS
- RS ROLLING WINDOW SHADES
- DS DOWNSPOUT

KEYNOTE LEGEND

- M4 RELOCATED INSTRUMENT STORAGE RACK.
- M6 EXISTING MOBILE INTERACTIVE MARKERBOARD.
- M11 EXISTING CHORAL RISERS TO REMAIN.
- M18 RELOCATED CASEWORK.



ARCHITECT
VLK Architects
20445 State Hwy 249, Suite 350
Houston, Texas 77070
Main Phone: 281.671.2300
www.vlkarchitects.com

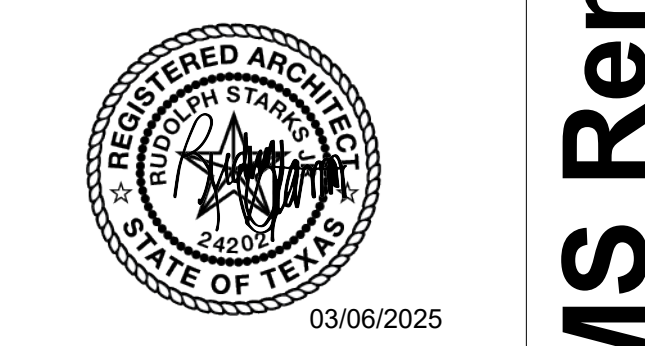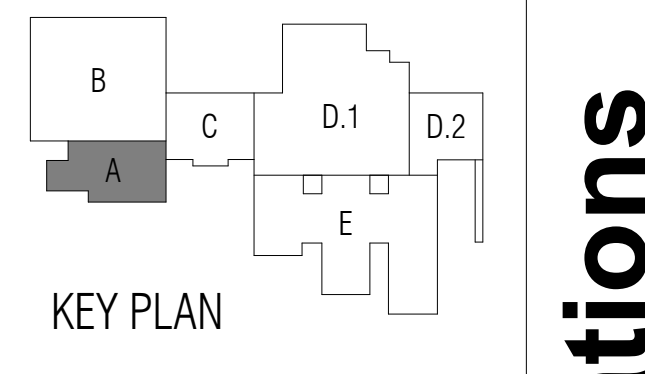

ISSUED: February 24, 2025

Revision No.	Revision Date
1 Addendum 1	03-06-2025


Director Drawn By
RSJ STH, KM
Designer Quality Control

PROJECT NO.
24-010.00

SHEET TITLE
TRUITT - UNIT A FLOOR PLAN - LEVEL ONE

SHEET NO.

A32.11A

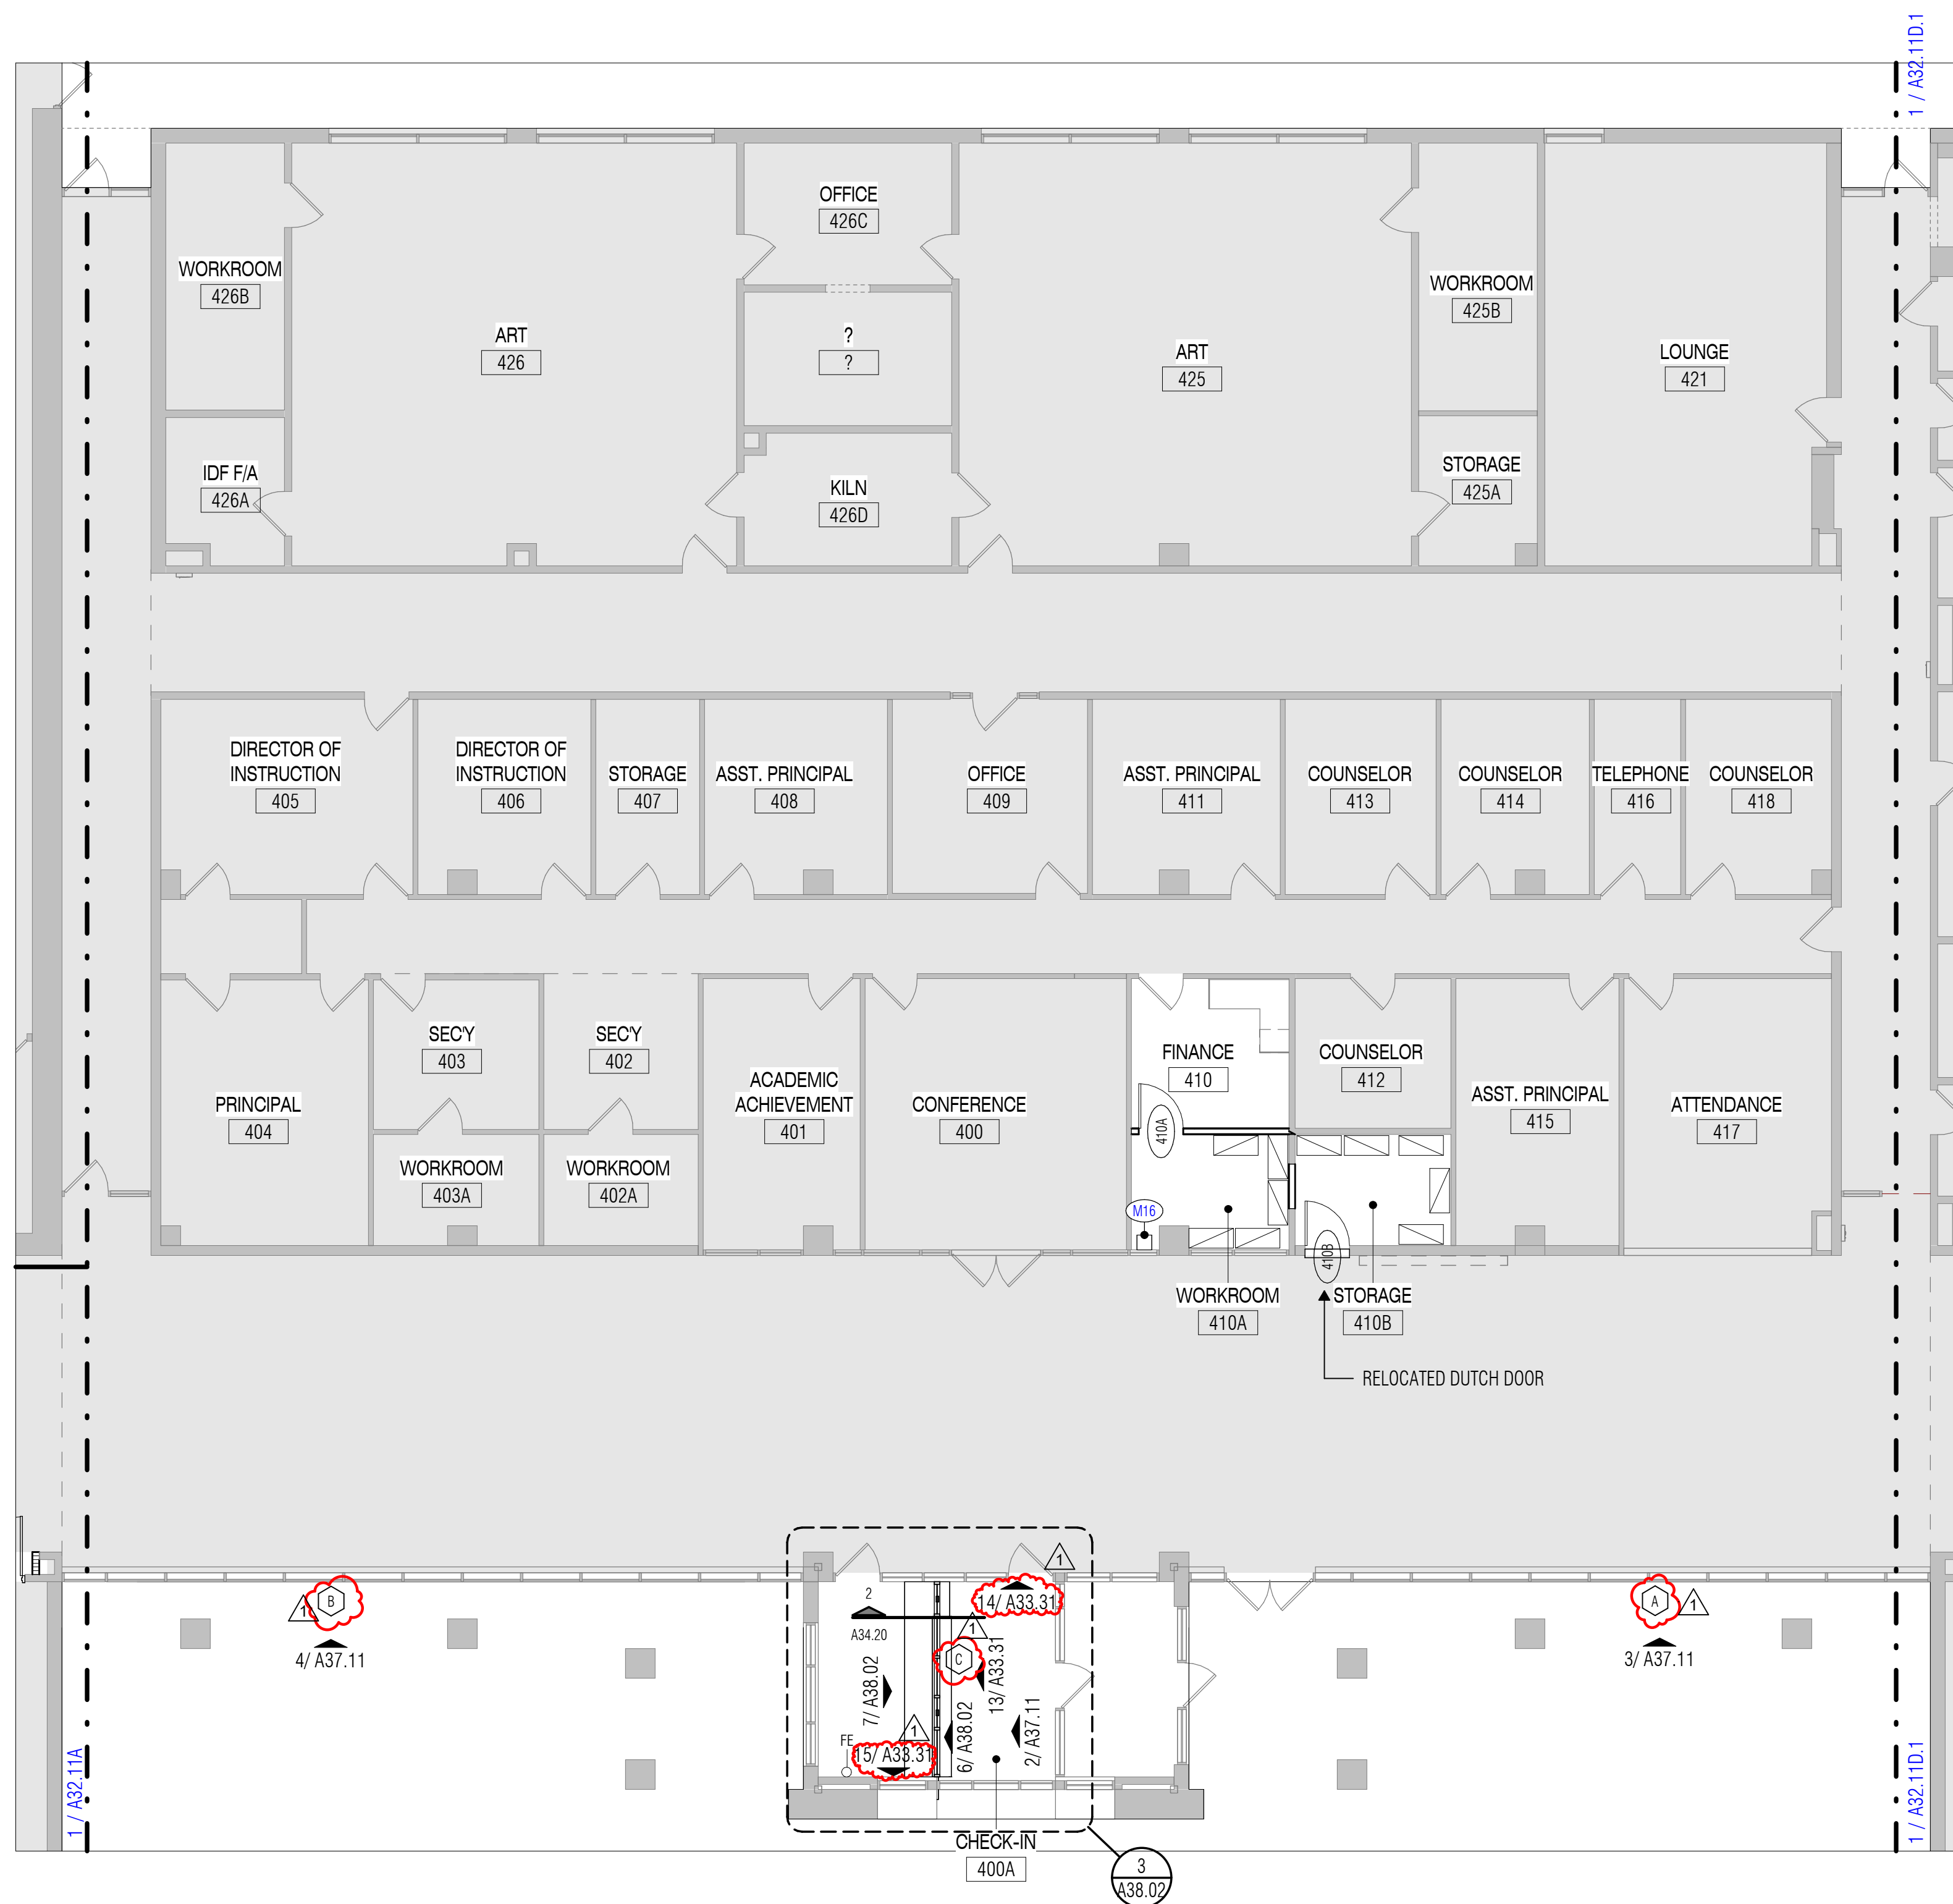

1 UNIT "C" PLAN - LEVEL ONE
SCALE: 1/8" = 1'-0"

FLOOR PLAN NOTES

- Refer to Civil Grading drawings for Primary Ground Level floor elevation relative to Mean Sea Level. Architectural Finish Floor (100'-0" datum) is equal to Civil FFE.
- Dimensions on Floor Plans are to face of stud or CMU unless noted otherwise.
- Coordinate the location of electrical devices with casework, millwork, lockers, etc. Any electrical device that is not properly coordinated shall be relocated at no additional cost.
- Exterior wall construction is identified on the Wall Sections. Refer to the A'-4-series sheets for Wall Sections, and to A14.30, A24.30, A34.30 for Exterior Wall Assemblies.
- Refer to Exterior Elevation Notes for control joint requirements at all inside corners of masonry veneer.
- Refer to PARTITION TYPES (A12.21, A22.21, A32.21) for Partition Types Legend.
- Interior partitions are Type "P6" unless noted otherwise.
- Refer to Detail 4/A0.31 for Typical Door Maneuvering Clearances. All new doors shall meet the requirements of that detail. If any door is found that does not comply with these requirements, request clarification from the Architect prior to construction.
- Refer to PARTITION DETAILS sheets for Typical Partition Penetration Details, including pipe, conduit and ductwork penetrations.
- Refer to PARTITION DETAILS sheets for Typical Bracing at Non-Loadbearing CMU Partitions.
- Refer to Exterior Elevations for exact locations of downspouts.
- Provide factory bullnose units at all interior exposed vertical edges of CMU, except at starter course with applied base material where square-edge units shall be provided in lieu of bullnose units.
- Provide 4" starter courses at all CMU walls and partitions unless noted otherwise.
- Provide steel or masonry lintels over all openings in CMU walls, including those required for mechanical ductwork and dampers, whether specifically indicated on the drawings or not.
- Provide minimum 20 gage light-gage steel studs at all interior partitions scheduled to receive ceramic tile or plaster.
- Provide minimum 18 gage cold-formed steel studs at all interior partitions scheduled to receive anchored masonry or stone veneer as well as interior partitions with steel plate or steel sheet X-bracing.
- Provide minimum 18 gage cold-formed steel studs as designed by stud engineer for all interior partitions scheduled to receive adhered masonry or stone veneer.
- At light-gage steel stud partitions that extend above the ceiling, provide diagonal 20 gage stud braces at 4'-0" o.c. to structure above (not to steel deck) as required to provide rigid anchorage and support of partitions.
- Provide minimum 2 X 6 fire-retardant treated wood blocking in both new and existing stud walls and partitions, at mounting locations for wall-mounted accessories, handrails, casework, markerboards, tackboards, folding partitions, toilet partitions, and all other wall-mounted items. Refer to CASEWORK ELEVATIONS & DETAILS sheets for typical blocking requirements at various conditions.
- At Mechanical, Electrical and Boiler Room partitions, seal tightly around all penetrations. Utilize fire safing material at rated partitions.
- Provide sealant and/or fire safing at all floor penetrations, as applicable.
- Existing equipment to remain U.N.O. Contractor to relocate equipment as needed to complete new construction. Contractor shall reinstall equipment upon completion of construction. All equipment to be in as good or better working condition as prior to the start of construction.

FLOOR PLAN LEGEND

- METAL STUD PARTITION. Extend 4" above highest ceiling plane and brace to structure above as noted in Floor Plan Notes. Refer to Reflected Ceiling Plan for fire, smoke and sound-conditioned partitions that extend to deck above.
- CMU PARTITION. Extend 4" above highest ceiling plane and brace to structure above as detailed. Refer to Reflected Ceiling Plan for fire, smoke and sound-conditioned partitions that extend to deck above.
- EXISTING WALL TO REMAIN.
- MOVABLE METAL SHELVING. Depth and Width dimensions match that of this legend, unless otherwise noted.
- FURNITURE, FIXTURE OR EQUIPMENT BY OWNER. Coordinate with adjacent electrical devices, casework, etc.
- MB MARKERBOARD. Preceding number is length, in feet.
- SL WITH HALF STAFF LINES
- TB TACKBOARD. Preceding number is length, in feet.
- TS TACK STRIP. Preceding number is length, in feet.
- IM INTERACTIVE MARKERBOARD
- EX EXISTING
- IFP INTERACTIVE FLAT PANEL
- FEC FIRE EXTINGUISHER WITH CABINET AND BRACKET
- FE FIRE EXTINGUISHER WITH BRACKET
- FHC FIRE HOSE CABINET
- HB HORIZONTAL BLINDS
- RS ROLLING WINDOW SHADES
- DS DOWNSPOUT

KEYNOTE LEGEND


- M16 RELOCATED SAFE.



ARCHITECT

VLK Architects
20445 State Hwy 249, Suite 350
Houston, Texas 77070
Main Phone: 281.671.2300
www.vlkarchitects.com

CYPRESS-FAIRBANKS INDEPENDENT SCHOOL DISTRICT
HOUSTON, TEXAS

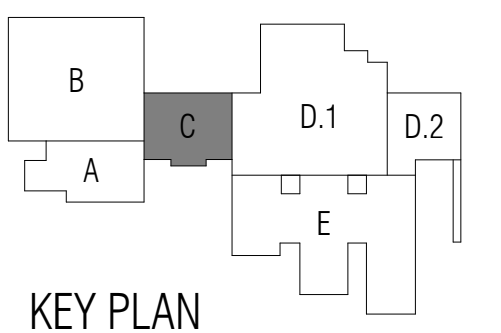

ISSUED: February 24, 2025

REVISIONS	
Revision No.	Revision Date
1 Addendum 1	03-06-2025

Director Drawn By
RSJ STH, KM
Designer Quality Control

Proj. Arch.
TQ

PROJECT NO.
24-010.00
SHEET TITLE

TRUITT - UNIT C FLOOR
PLAN - LEVEL ONE

SHEET NO.


A32.11C

2024 Cook, Labay & Truitt MS Renovations

- ### FLOOR PLAN NOTES
- Refer to Civil Grading drawings for Primary Ground Level floor elevation relative to Mean Sea Level. Architectural Finish Floor (100'-0" datum) is equal to Civil FFE.
 - Dimensions on Floor Plans are to face of stud or CMU unless noted otherwise.
 - Coordinate the location of electrical devices with casework, millwork, lockers, etc. Any electrical device that is not properly coordinated shall be relocated at no additional cost.
 - Exterior wall construction is identified on the Wall Sections. Refer to the A' 4-series sheets for Wall Sections, and to A14.30, A24.30, A34.30 for Exterior Wall Assemblies.
 - Refer to Exterior Elevation Notes for control joint requirements at all inside corners of masonry veneer.
 - Refer to PARTITION TYPES (A12.21, A22.21, A32.21) for Partition Types Legend.
 - Interior partitions are Type "P6" unless noted otherwise.
 - Refer to Detail 4/AO.31 for Typical Door Maneuvering Clearances. All new doors shall meet the requirements of that detail. If any door is found that does not comply with these requirements, request clarification from the Architect prior to construction.
 - Refer to PARTITION DETAILS sheets for Typical Partition Penetration Details, including pipe, conduit and ductwork penetrations.
 - Refer to PARTITION DETAILS sheets for Typical Bracing at Non-Loadbearing CMU Partitions.
 - Refer to Exterior Elevations for exact locations of downspouts.
 - Provide factory bullnose units at all interior exposed vertical edges of CMU, except at starter course with applied base material where square-edge units shall be provided in lieu of bullnose units.
 - Provide 4" starter courses at all CMU walls and partitions unless noted otherwise.
 - Provide steel or masonry lintels over all openings in CMU walls, including those required for mechanical ductwork and dampers, whether specifically indicated on the drawings or not.
 - Provide minimum 20 gage light-gage steel studs at all interior partitions scheduled to receive ceramic tile or plaster.
 - Provide minimum 18 gage cold-formed steel studs at all interior partitions scheduled to receive anchored masonry or stone veneer as well as interior partitions with steel plate or steel sheet X-bracing.
 - Provide minimum 18 gage cold-formed steel studs as designed by stud engineer for all interior partitions scheduled to receive adhered masonry or stone veneer.
 - At light-gage steel stud partitions that extend above the ceiling, provide diagonal 20 gage stud braces at 4'-0" o.c. to structure above (not to steel deck) as required to provide rigid anchorage and support of partitions.
 - Provide minimum 2 X 6 fire-retardant treated wood blocking in both new and existing stud walls and partitions, at mounting locations for wall-mounted accessories, handrails, casework, markerboards, tackboards, folding partitions, toilet partitions, and all other wall-mounted items. Refer to CASEWORK ELEVATIONS & DETAILS sheets for typical blocking requirements at various conditions.
 - At Mechanical, Electrical and Boiler Room partitions, seal tightly around all penetrations. Utilize fire safing material at rated partitions.
 - Provide sealant and/or fire safing at all floor penetrations, as applicable.
 - Existing equipment to remain U.N.O. Contractor to relocate equipment as needed to complete new construction. Contractor shall reinstall equipment upon completion of construction. All equipment to be in as good or better working condition as prior to the start of construction.

- ### FLOOR PLAN LEGEND
- METAL STUD PARTITION. Extend 4" above highest ceiling plane and brace to structure above as noted in Floor Plan Notes. Refer to Reflected Ceiling Plan for fire, smoke and sound-conditioned partitions that extend to deck above.
 - CMU PARTITION. Extend 4" above highest ceiling plane and brace to structure above as detailed. Refer to Reflected Ceiling Plan for fire, smoke and sound-conditioned partitions that extend to deck above.
 - EXISTING WALL TO REMAIN.
 - MOVABLE METAL SHELVING. Depth and Width dimensions match that of this legend, unless otherwise noted.
 - FURNITURE, FIXTURE OR EQUIPMENT BY OWNER. Coordinate with adjacent electrical devices, casework, etc.
 - MB MARKERBOARD. Preceding number is length, in feet.
 - SL WITH HALF STAFF LINES
 - TB TACKBOARD. Preceding number is length, in feet.
 - TS TACK STRIP. Preceding number is length, in feet.
 - IM INTERACTIVE MARKERBOARD
 - EX EXISTING
 - IFP INTERACTIVE FLAT PANEL
 - FEC FIRE EXTINGUISHER WITH CABINET AND BRACKET
 - FE FIRE EXTINGUISHER WITH BRACKET
 - FHC FIRE HOSE CABINET
 - HB HORIZONTAL BLINDS
 - RS ROLLING WINDOW SHADES
 - DS DOWNSPOUT

- ### KEYNOTE LEGEND
- M16 RELOCATED CASEWORK.

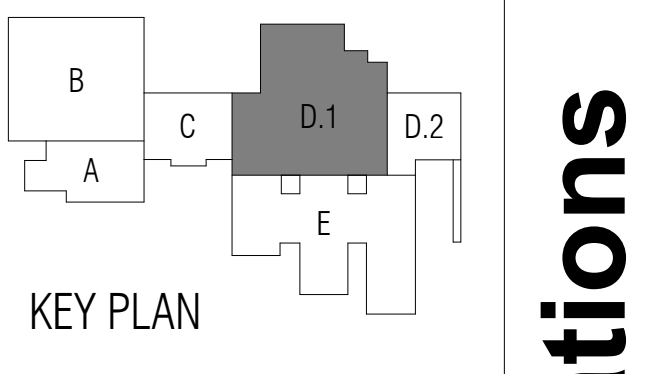

ISSUED: February 24, 2025

REVISIONS	
Revision No.	Revision Date
1 Addendum 1	03-06-2025

Director: RSJ
 Drawn By: STH, KM
 Designer: Quality Control


Proj. Arch.: TQ

PROJECT NO.
24-010.00
 SHEET TITLE

TRUITT - UNIT D.1 FLOOR PLAN - LEVEL ONE

SHEET NO.

A32.11D.1

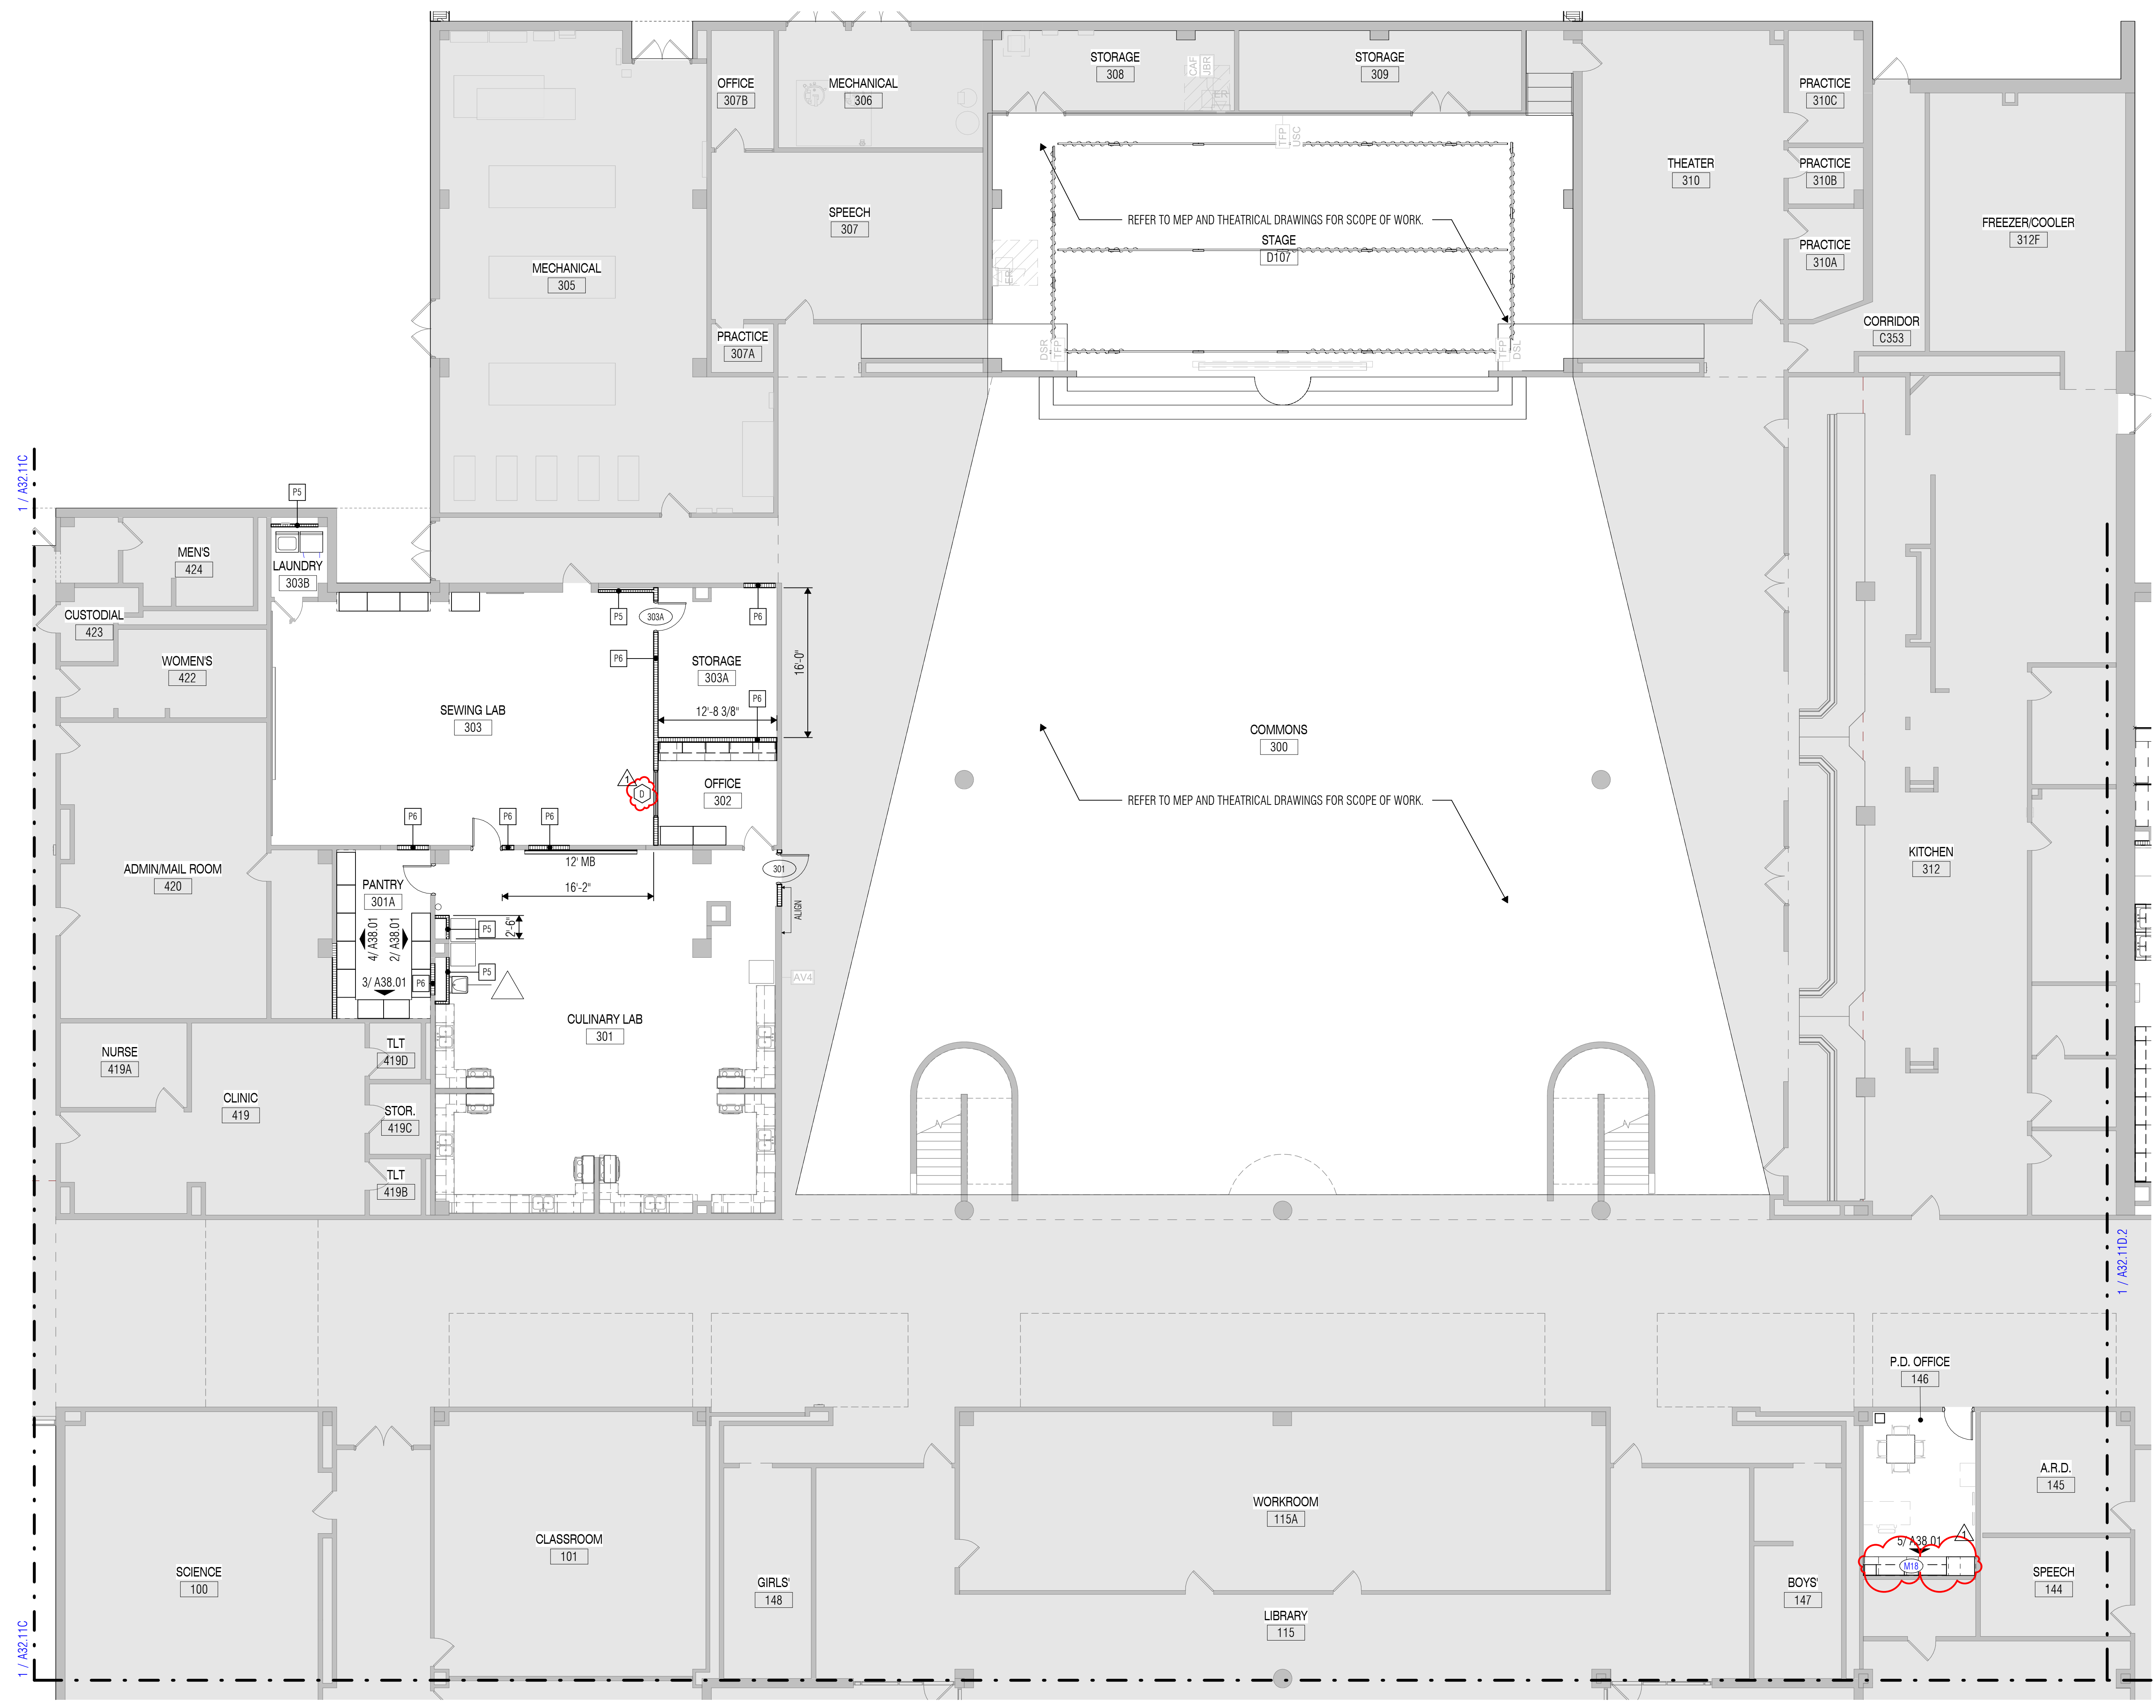

1 UNIT "D.1" PLAN - LEVEL ONE
 SCALE: 1/8" = 1'-0"



PARTITION NOTES

- Refer to Floor Plan Notes for additional metal stud requirements at Ceramic Tile, Plaster, Anchored Masonry or Stone Veneer, and Adhered Masonry or Stone Veneer.
- Refer to Floor Plan Notes for CMU starter course requirements.
- Refer to Sheet A' 2.22 for typical partition details.
- Refer to Reflected Ceiling Plans for location of fire rated partitions.
- Refer to Reflected Ceiling Plans for location of non-rated partitions that extend to the structural deck above.
- Provide firestopping as required to achieve the fire-resistive rating at all penetrations, gaps and other openings through or around rated floors, roofs, walls and partitions.
- At all rated and acoustical partitions that extend to structural deck above, seal to the floor below and to the structure above. Provide firestopping at rated partitions, and acoustical sealant at acoustical and sound conditioned other partitions.
- At all partitions that extend to structural deck above, provide gypsum board enclosure around beams, joists, ducts, etc. as required to maintain fire-resistive ratings and acoustical requirements.
- Typical CMU notes, unless otherwise noted on structural drawings:
 - Provide steel bracing as shown on Sheet A' 2.2
 - Provide continuous bond beam with (2) #4 reinforcing bars at top course of all 6" and 8" CMU partitions, whether indicated or not.
- 4" CMU shall not be used for interior partitions, except at chase walls where specifically indicated.

STUD PARTITION SIZING SCHEDULE

STUD DEPTH	STUD SPACING	STUD GAGE	EQ STUD	MAX LENGTH	MAX LENGTH (at Tile/Plaster)
3-5/8"	16" O.C	25 (18 mils)	25EQ	15'-6"	N/A
3-5/8"	16" O.C	20 (30 mils)	20EQ	16'-0"	14'-0"
6"	16" O.C	25 (18 mils)	25EQ	21'-6"	N/A
6"	16" O.C	20 (30 mils)	20EQ	22'-6"	19'-6"

- NOTES:**
- All doors shall have a minimum of 20 gage framing where required by specifications.
 - See Floor Plan Notes and Partition Notes for additional metal stud requirements at ceramic tile, plaster, anchored masonry/stone veneer, or adhered masonry/stone veneer.
 - Max. Lengths assume both sides of studs braced full-height of partition.
 - Max. Lengths are based on 5 psf lateral loading and L/240 deflection (L/360 at tile/plaster).
 - Equivalent (EQ) studs are not allowable at abuse-resistant or impact-resistant gyp board. Provide true 20 gage studs with minimum 0.0312 inches design thickness at these locations.

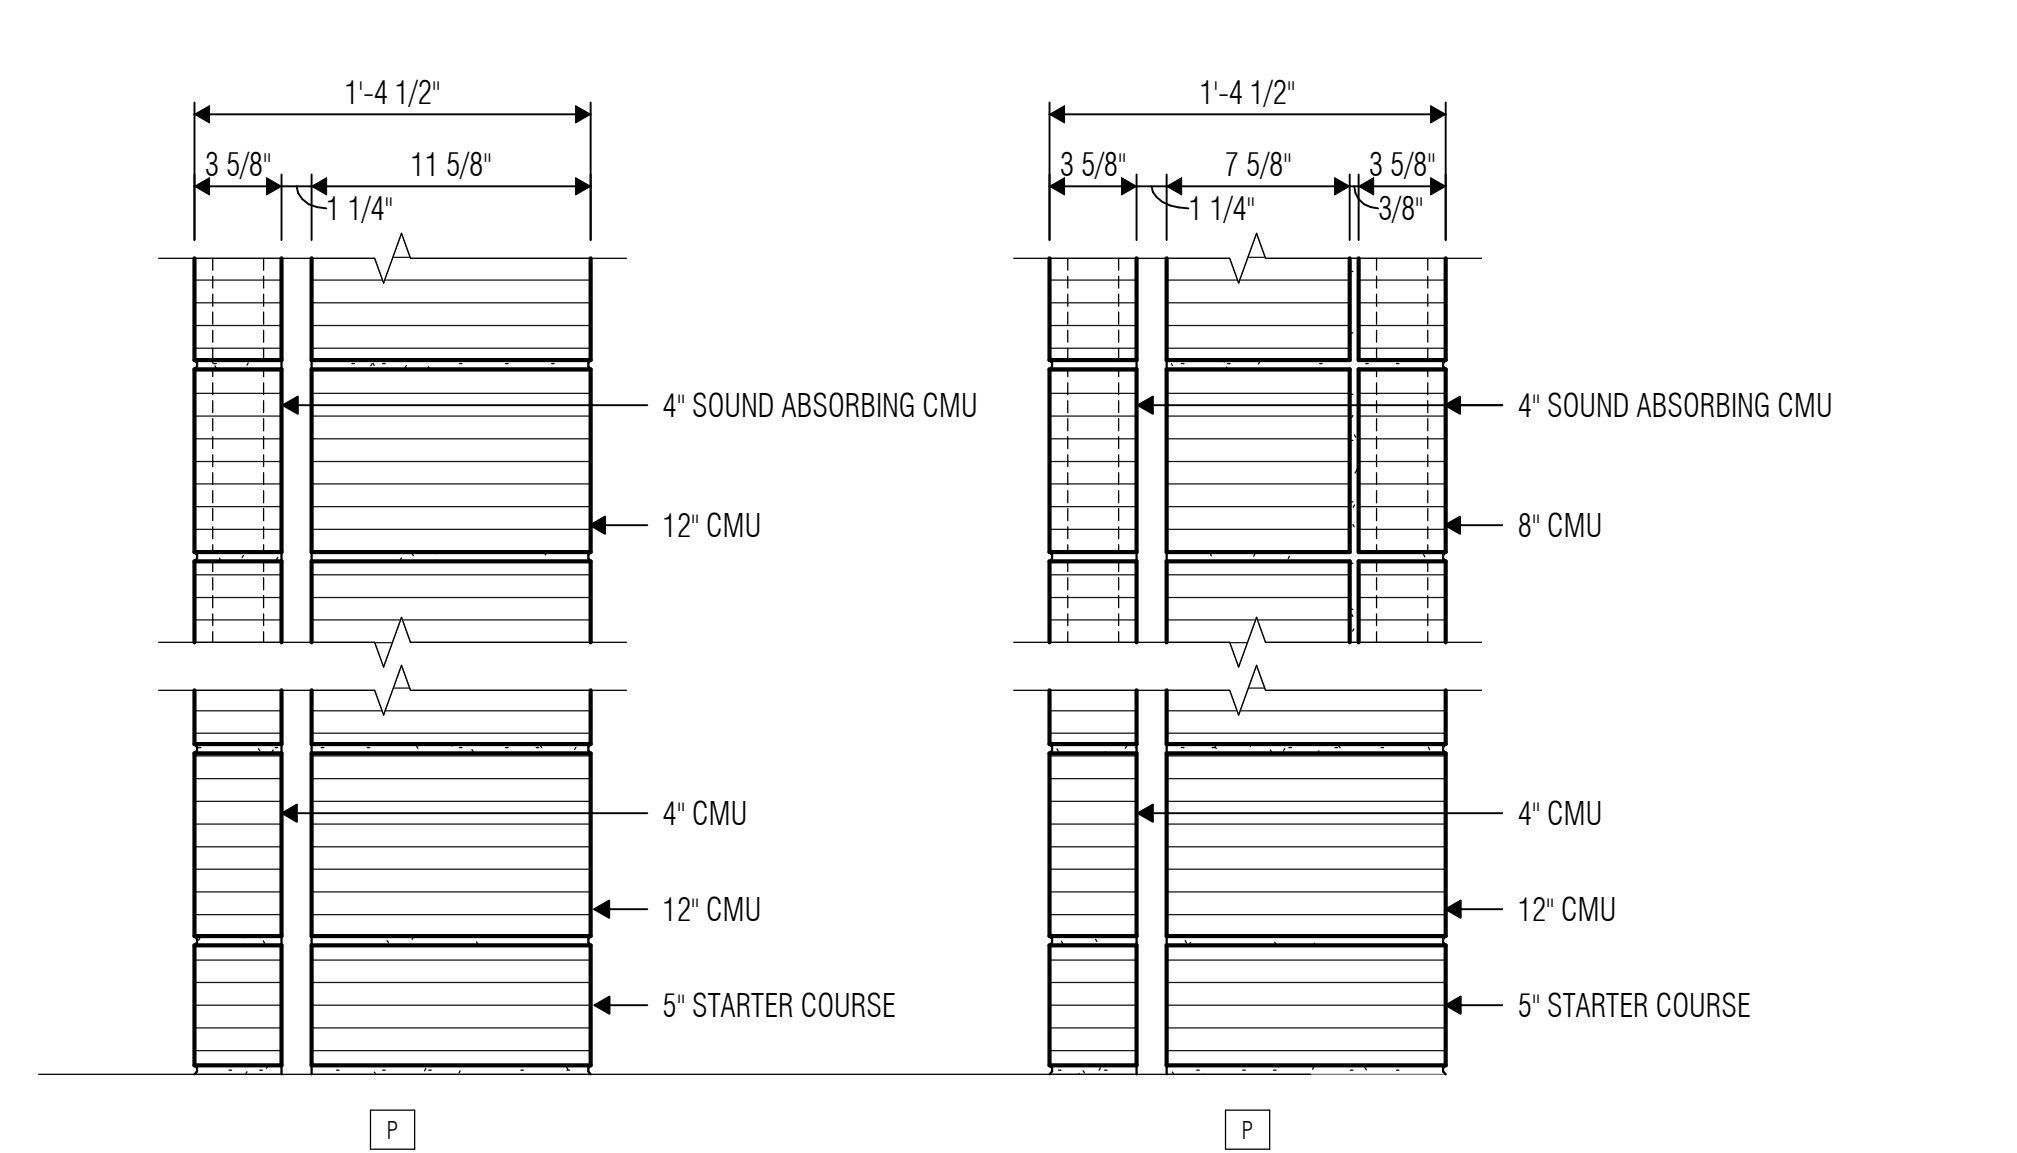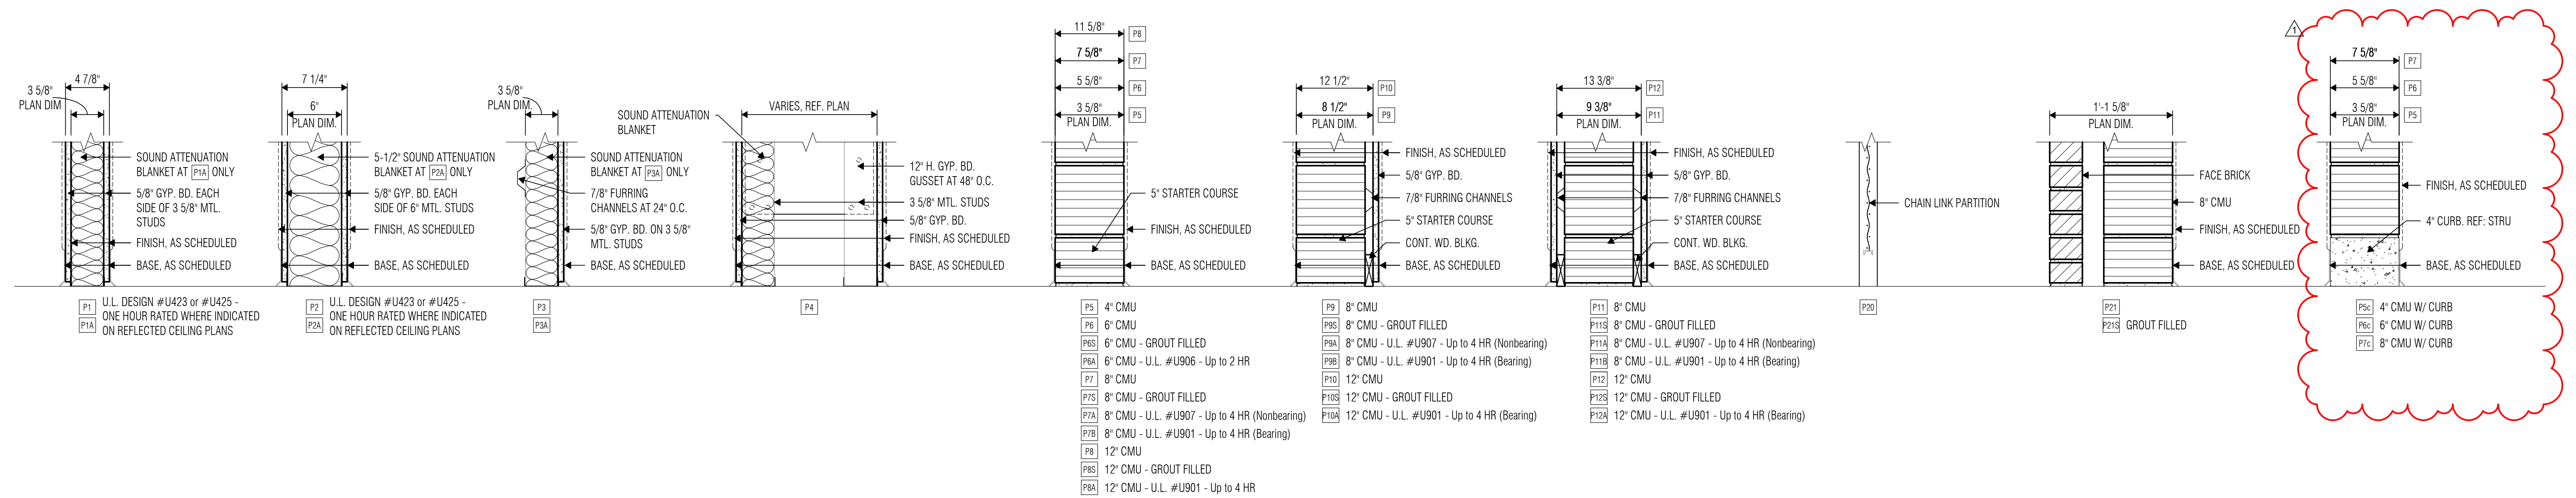

ISSUED: February 24, 2025

REVISIONS

Revision No.	Revision Date
1 Addendum 1	03-06-2025

Director: RSJ
 Designer: STH, KM
 Drawn By: STH, KM
 Quality Control: STH, KM

Proj. Arch. TQ


PROJECT NO.
24-010.00

SHEET TITLE
 TRUITT - PARTITION TYPES


SHEET NO.

ARCHITECT


VLK Architects
20445 State Hwy 249, Suite 350
Houston, Texas 77070
Main Phone: 281.671.2300
www.vlkarchitects.com

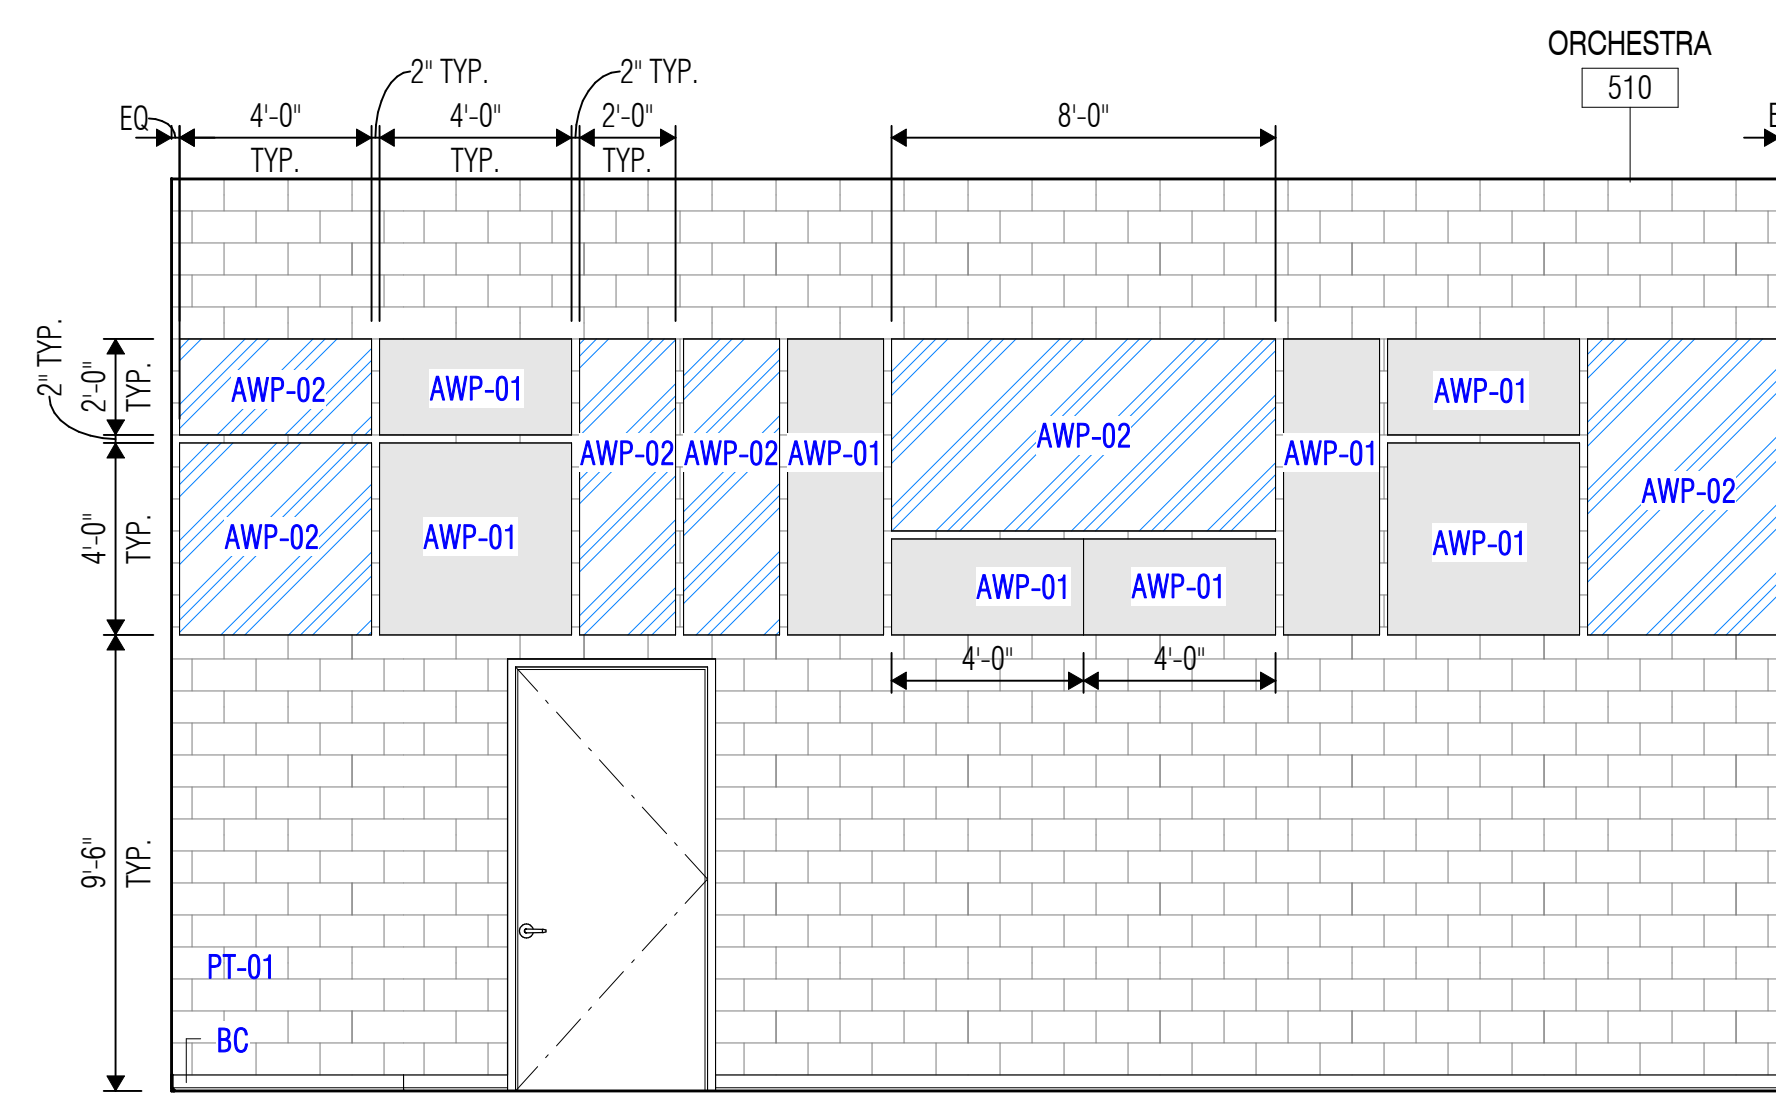


1 INTERIOR ELEVATION
SCALE: 1/4" = 1'-0"

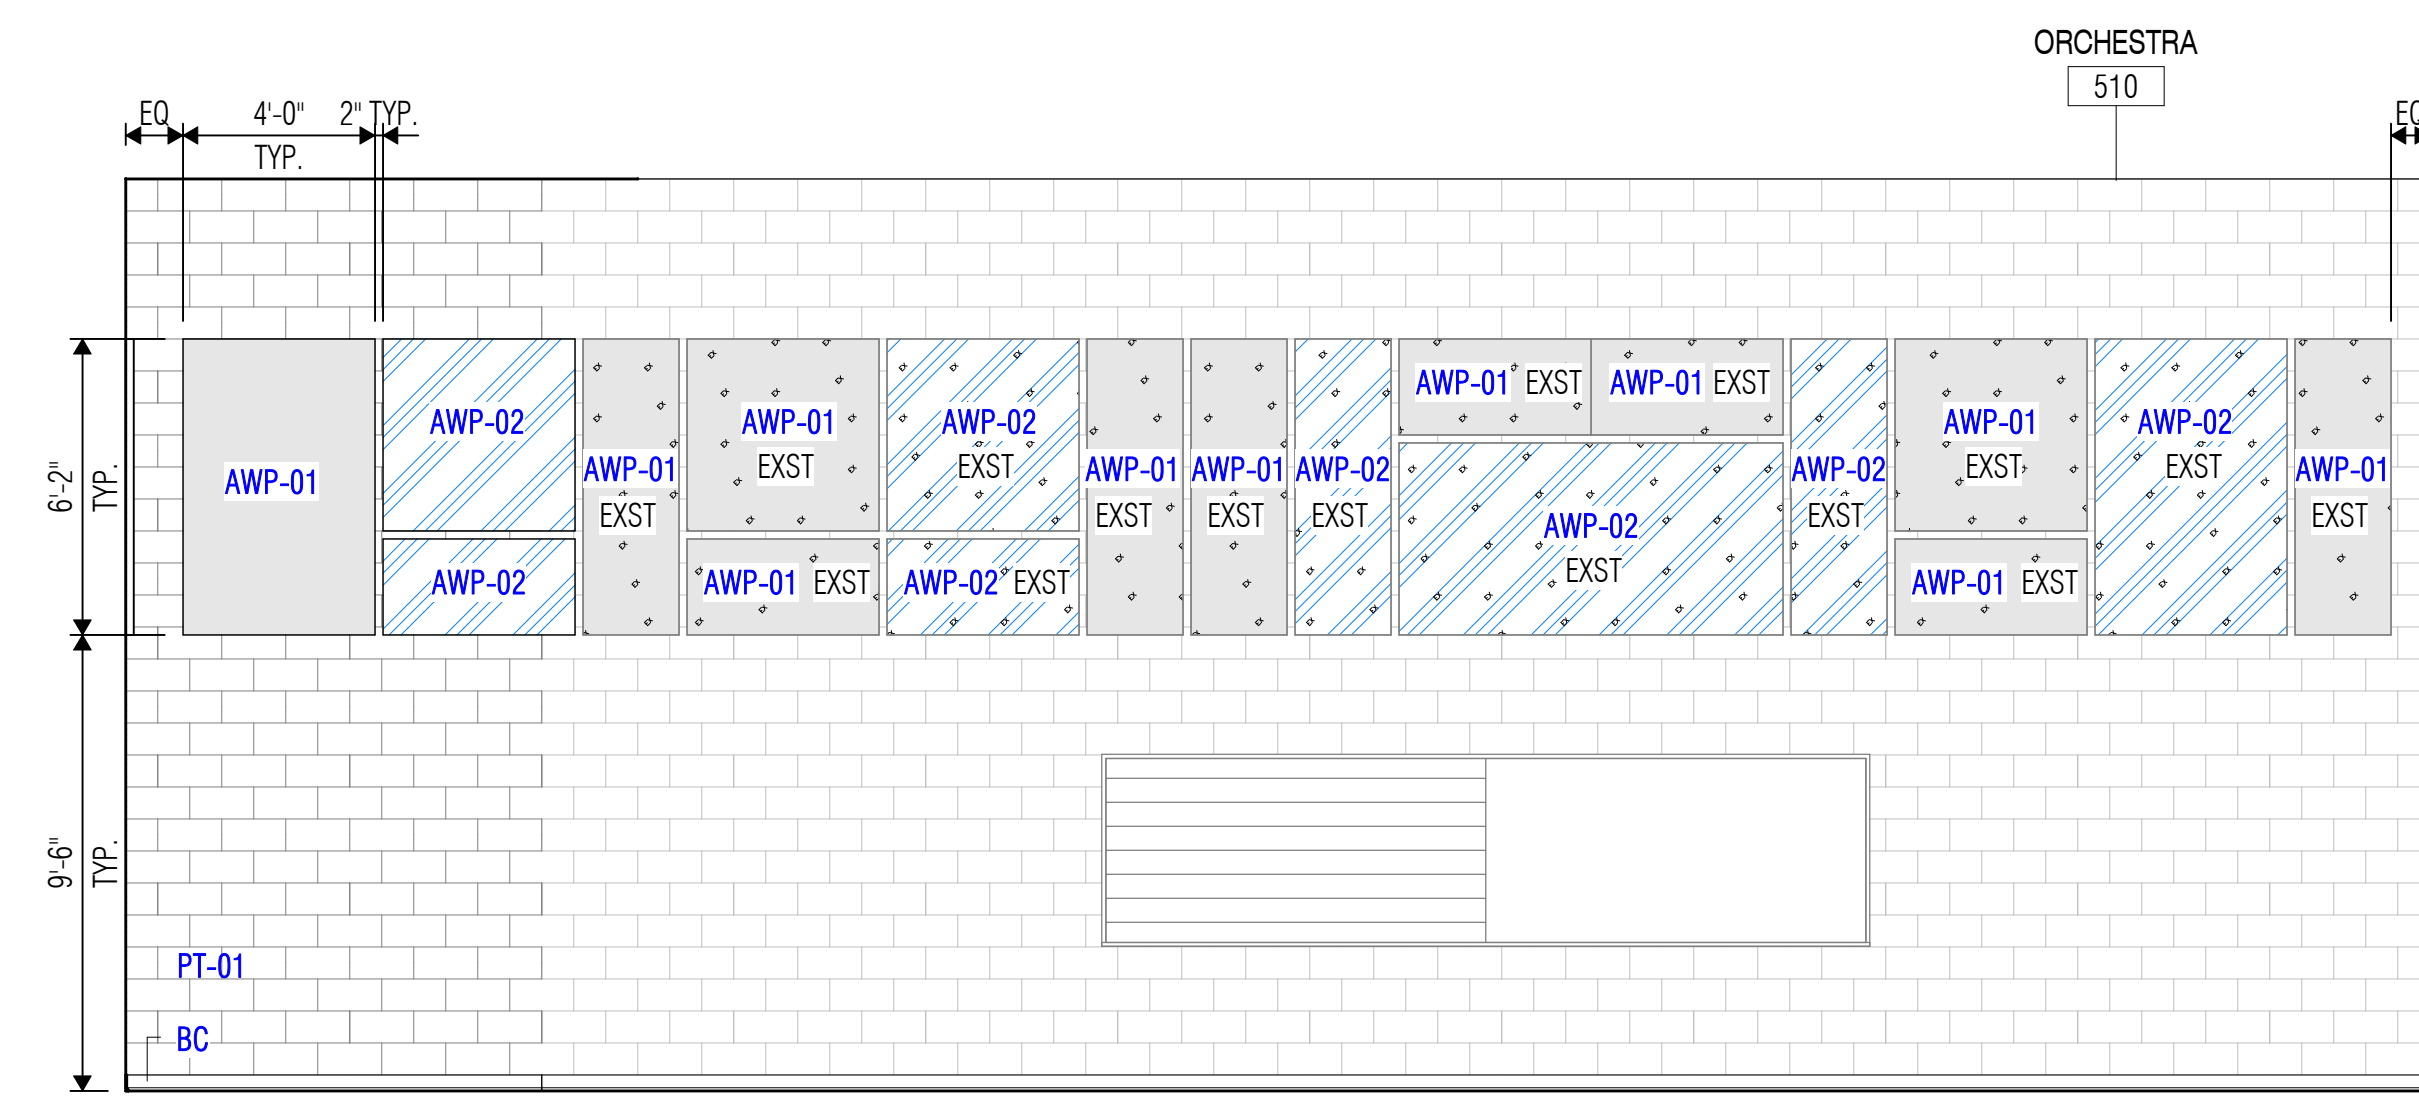


2 INTERIOR ELEVATION
SCALE: 1/4" = 1'-0"

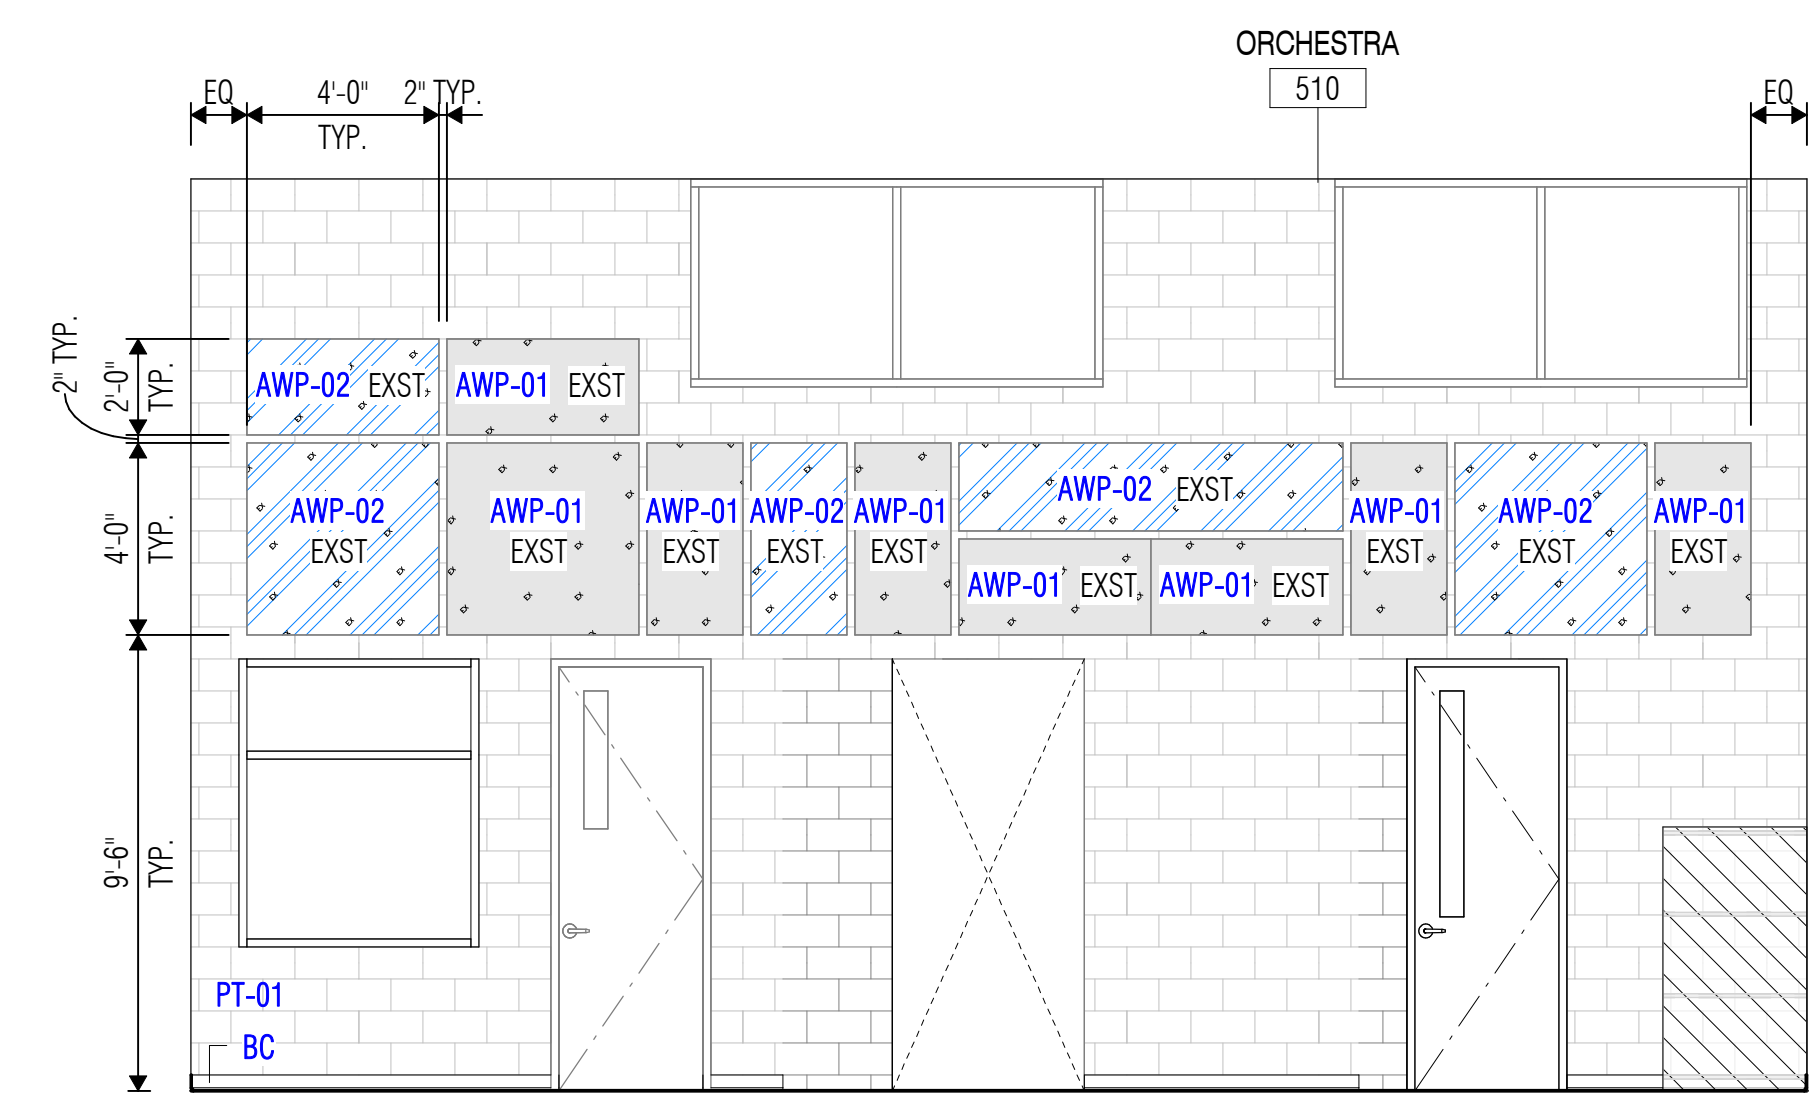


3 INTERIOR ELEVATION
SCALE: 1/4" = 1'-0"

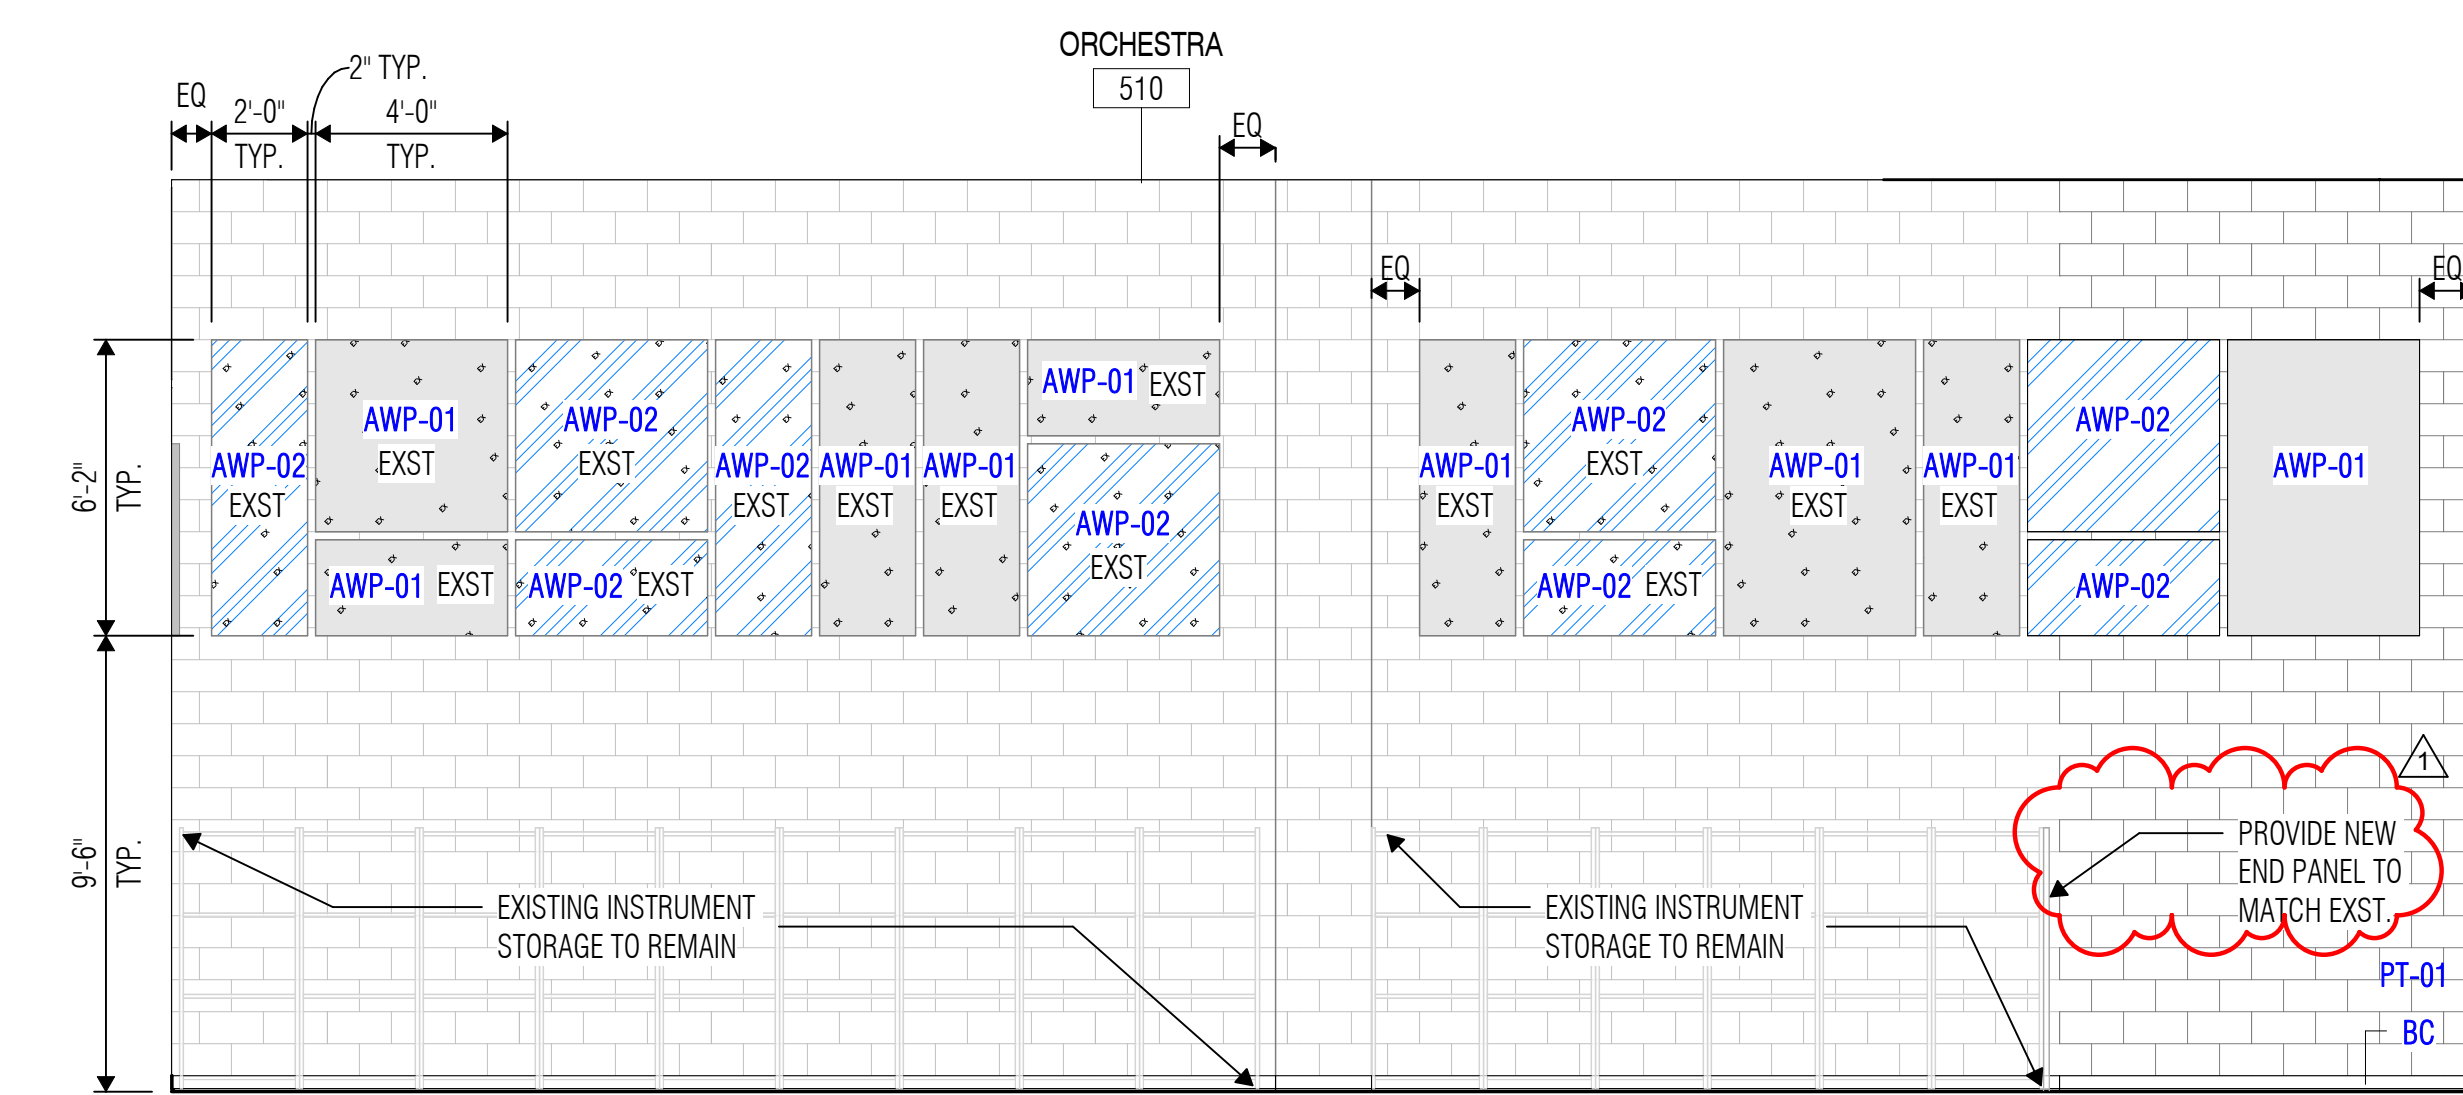


4 INTERIOR ELEVATION
SCALE: 1/4" = 1'-0"

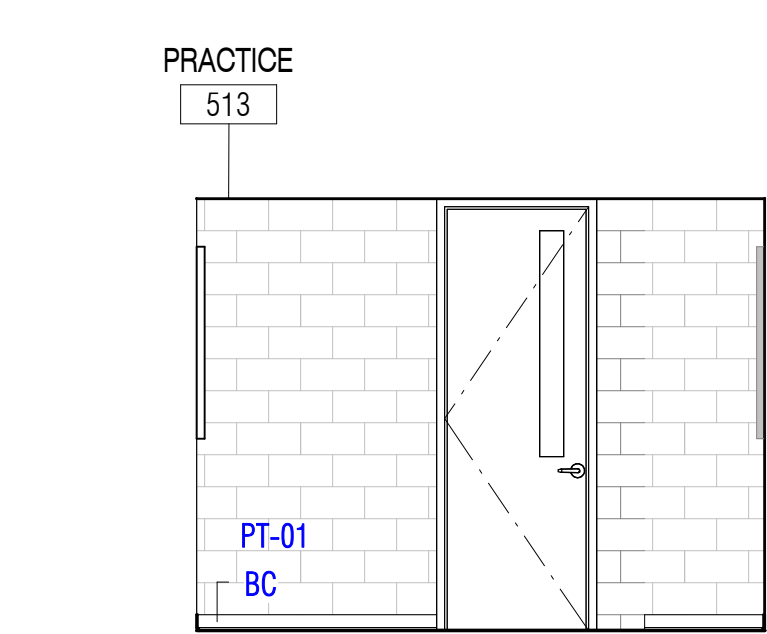


5 INTERIOR ELEVATION
SCALE: 1/4" = 1'-0"

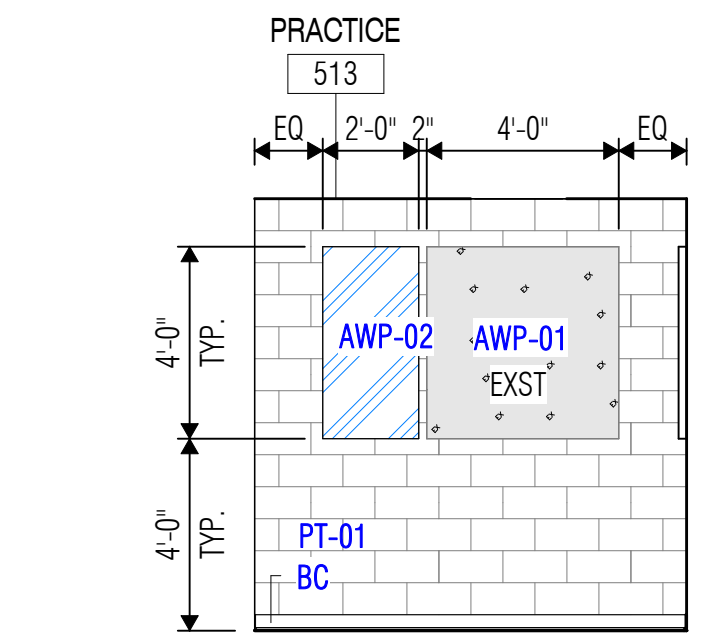


6 INTERIOR ELEVATION
SCALE: 1/4" = 1'-0"

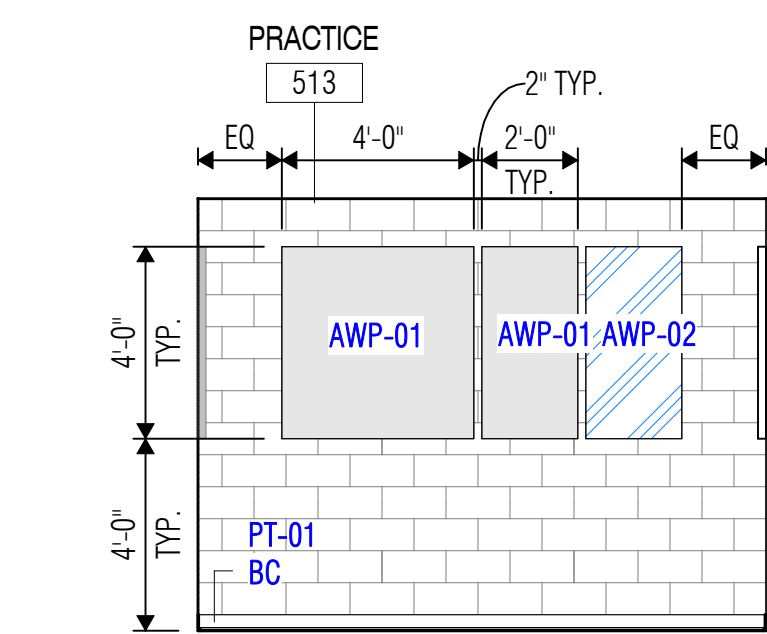


7 INTERIOR ELEVATION
SCALE: 1/4" = 1'-0"

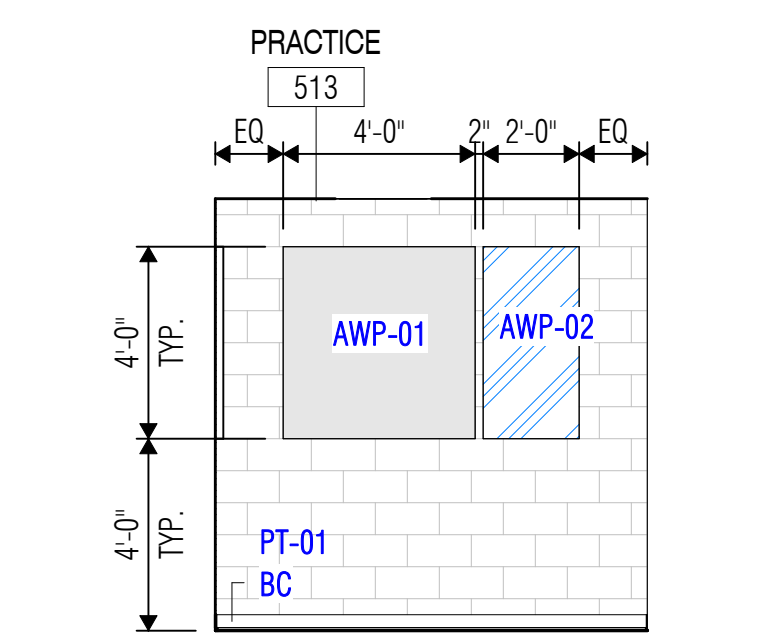


8 INTERIOR ELEVATION
SCALE: 1/4" = 1'-0"

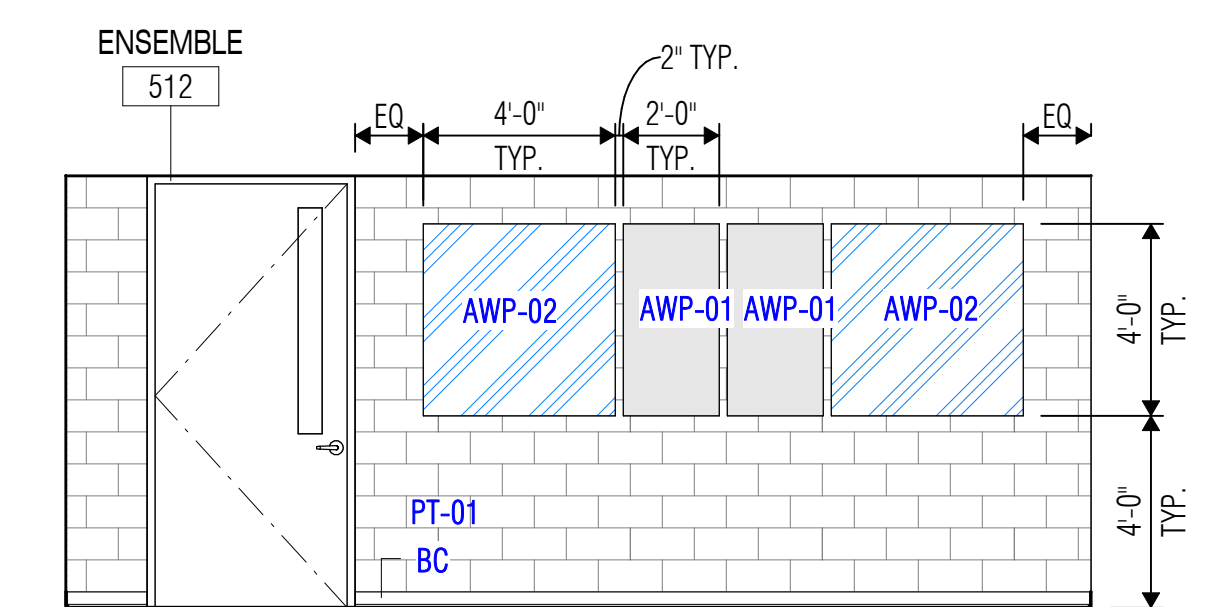


9 INTERIOR ELEVATION
SCALE: 1/4" = 1'-0"

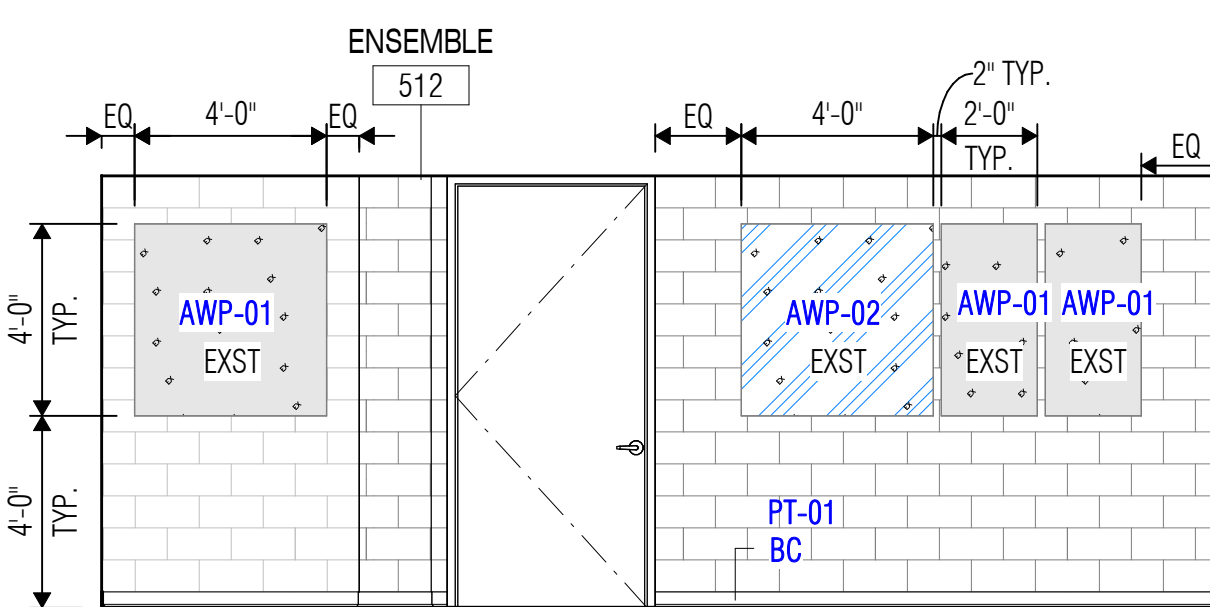


10 INTERIOR ELEVATION
SCALE: 1/4" = 1'-0"

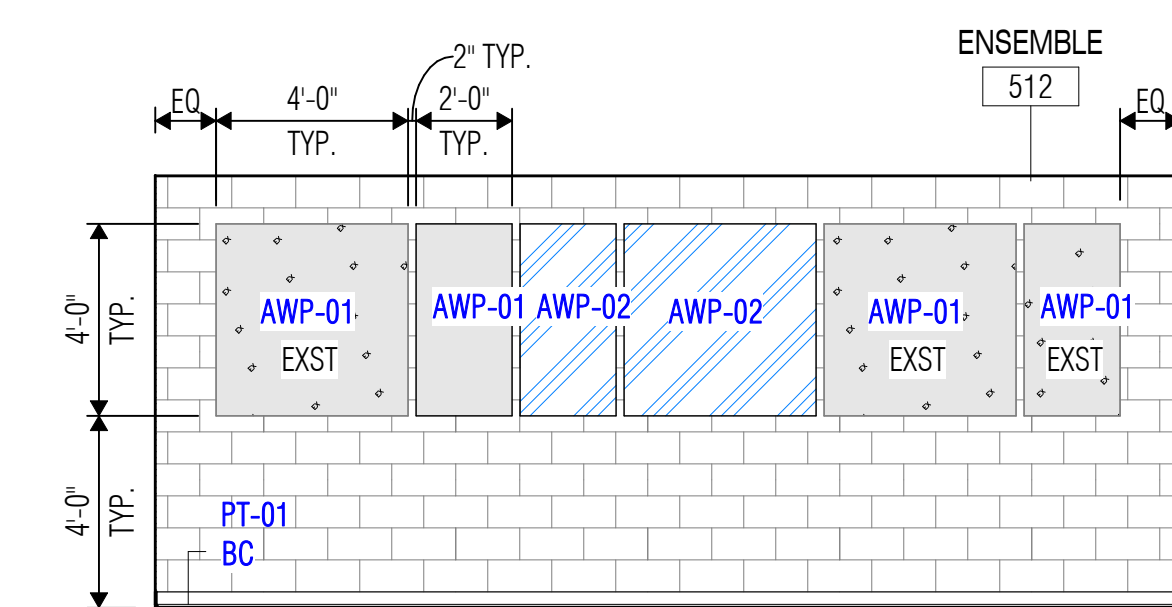


11 INTERIOR ELEVATION
SCALE: 1/4" = 1'-0"

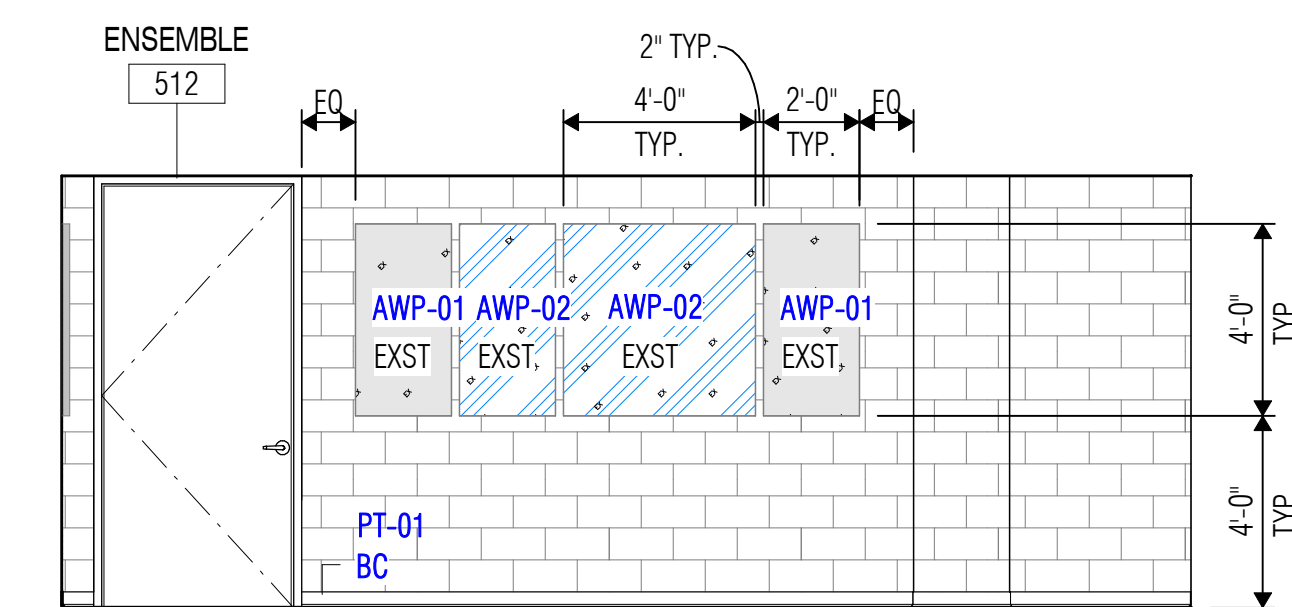


12 INTERIOR ELEVATION
SCALE: 1/4" = 1'-0"

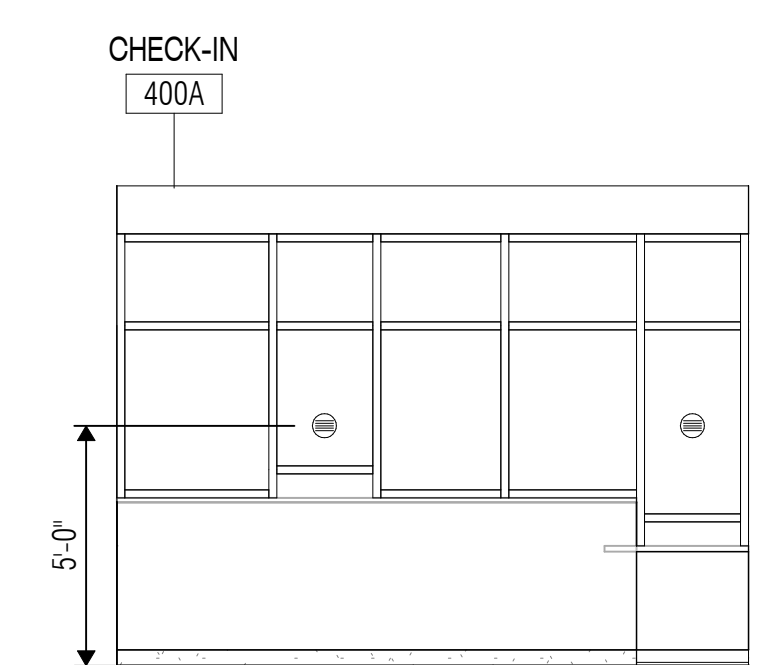


13 INTERIOR ELEVATION
SCALE: 1/4" = 1'-0"

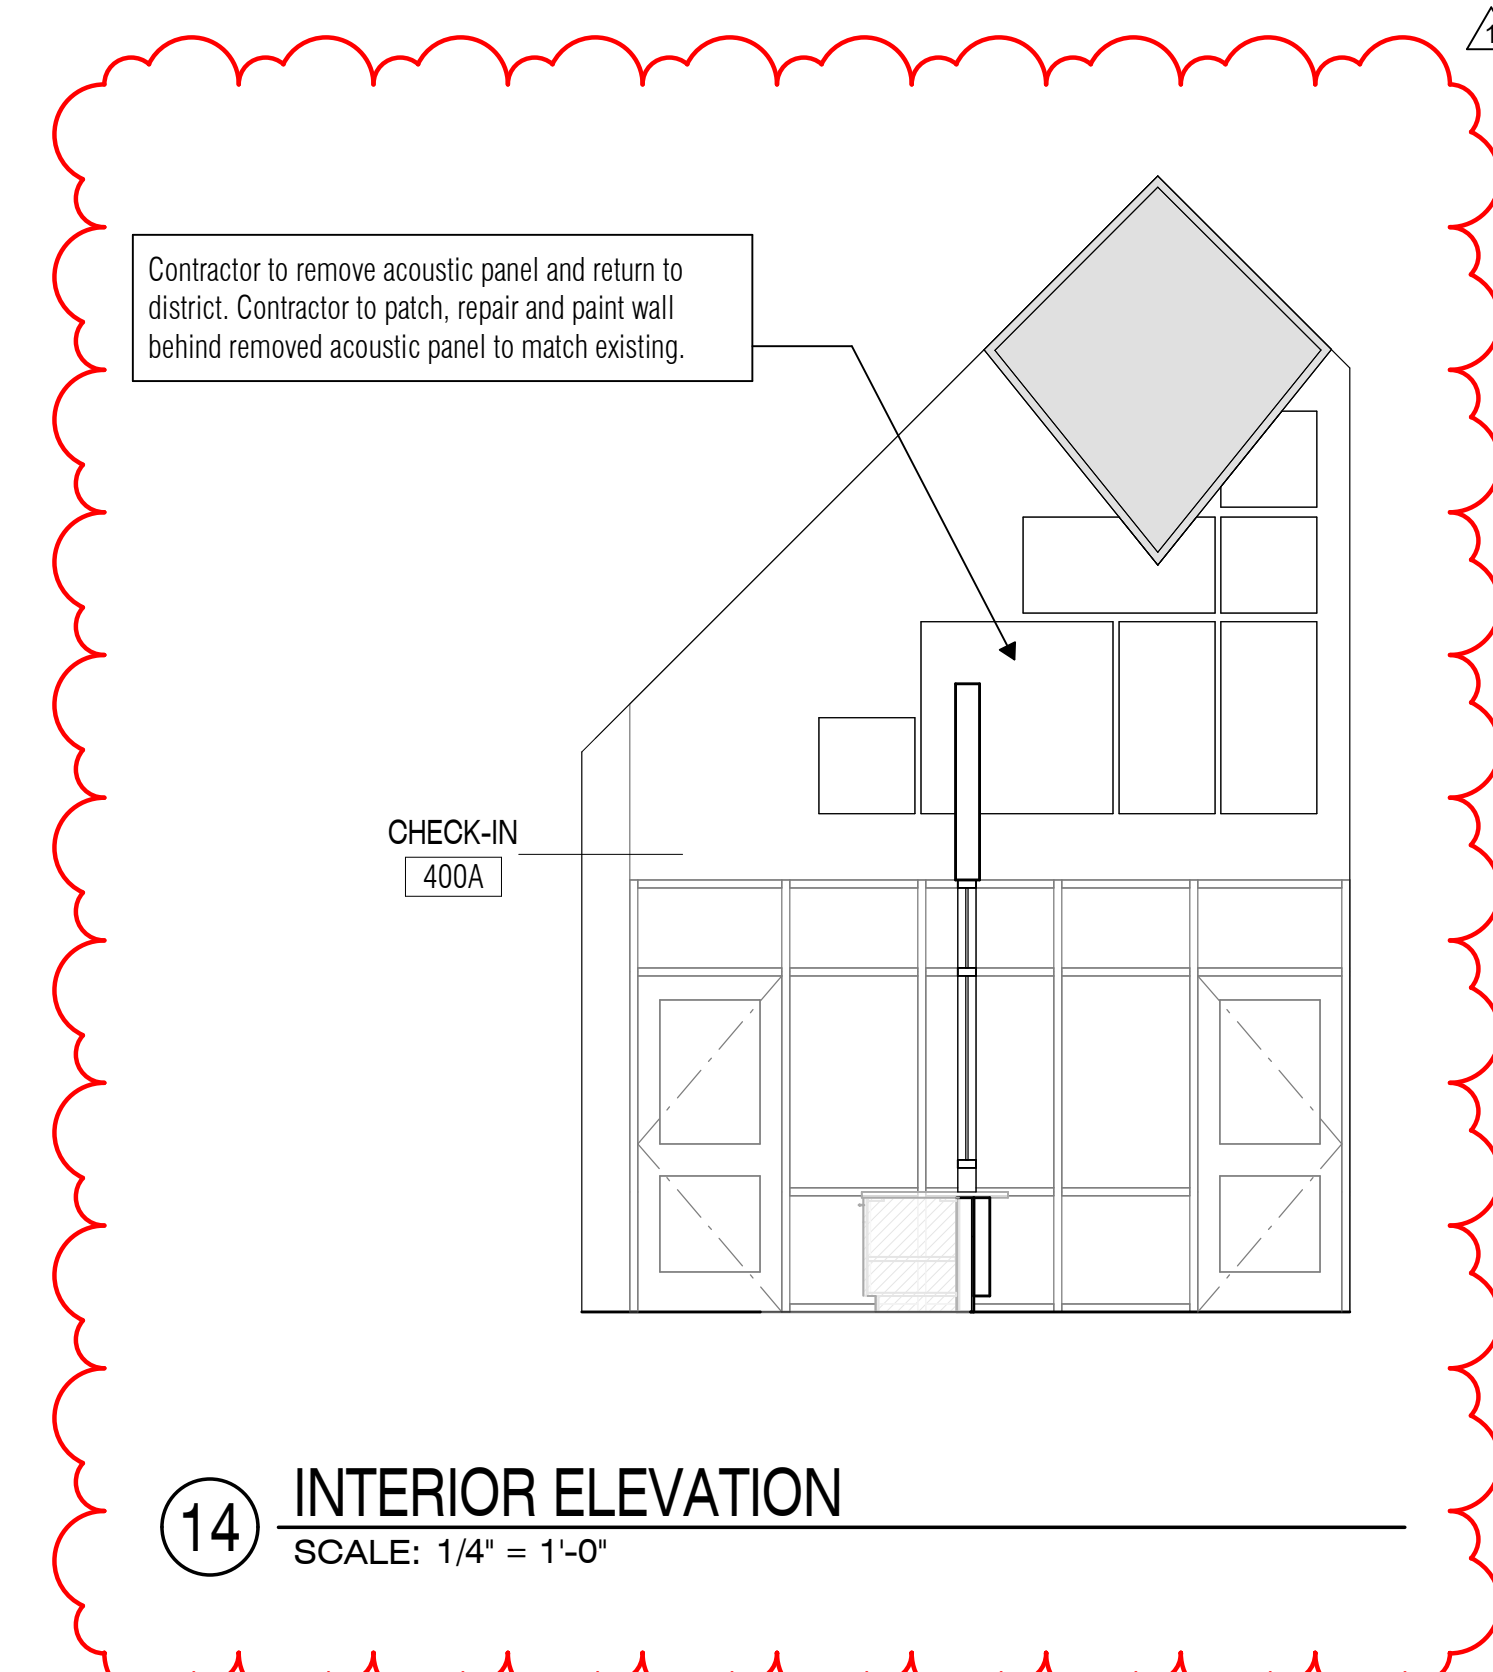

14 INTERIOR ELEVATION
SCALE: 1/4" = 1'-0"

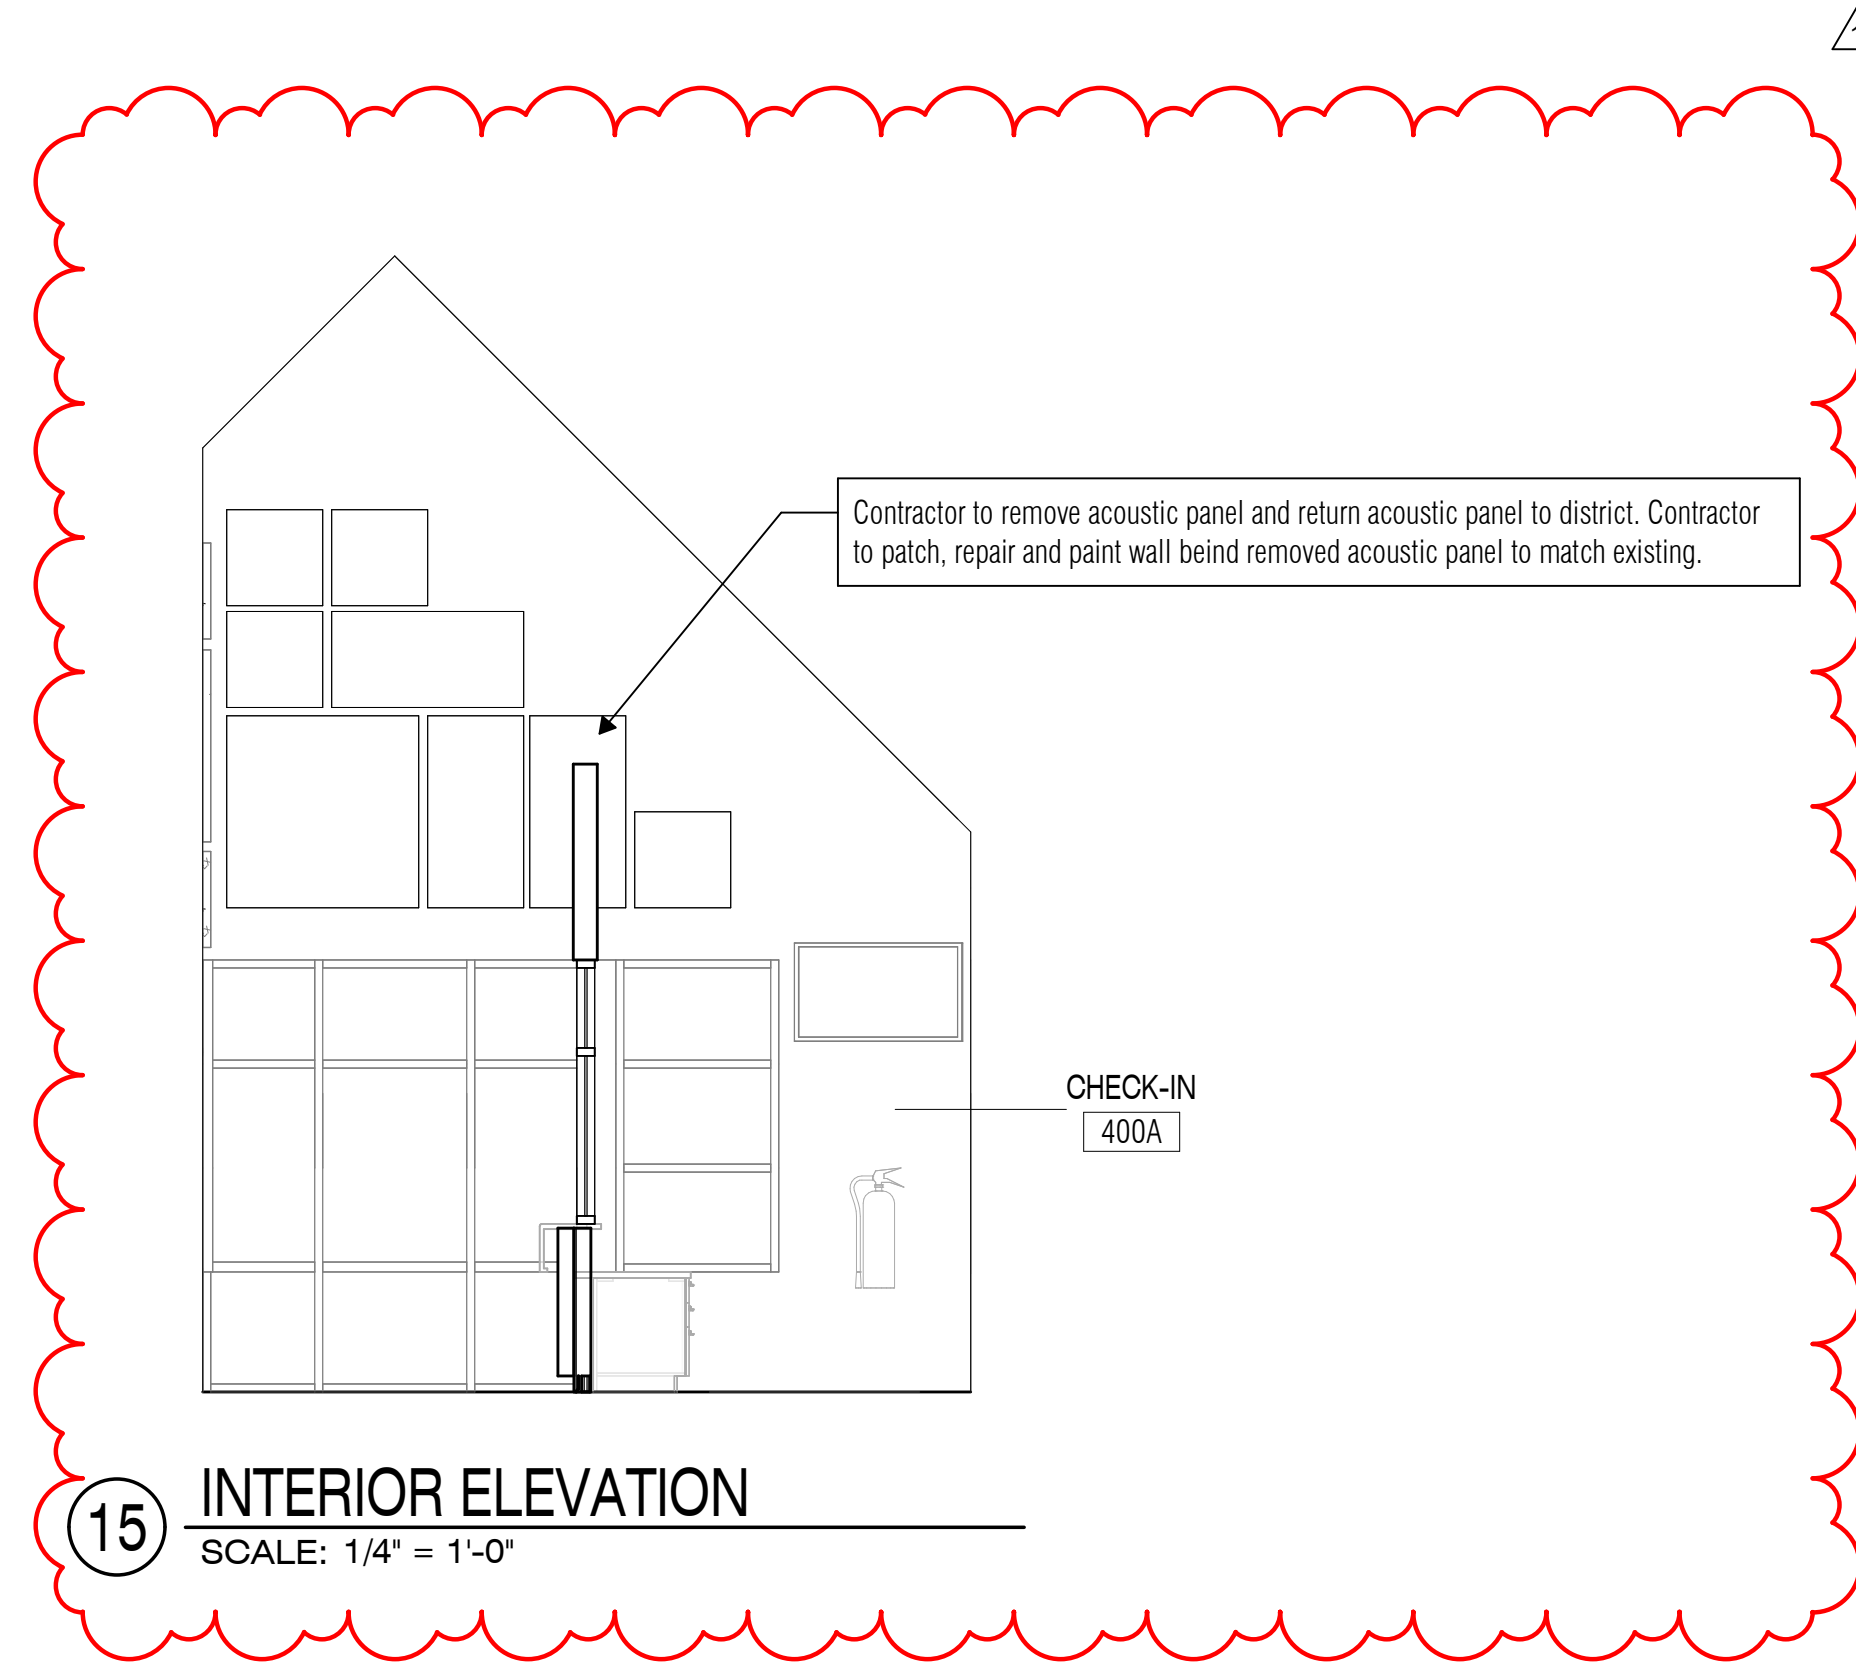

15 INTERIOR ELEVATION
SCALE: 1/4" = 1'-0"

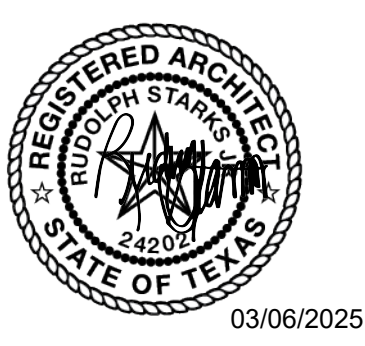

ISSUED: February 24, 2025

REVISIONS	
Revision No.	Revision Date
1 Addendum 1	03-06-2025

Director: RSJ
Designer: STH, KM
Quality Control: TQ

Proj. Arch. TQ

PROJECT NO.

24-010.00

SHEET TITLE

TRUITT - INTERIOR ELEVATIONS

SHEET NO.

A33.31

KEYNOTE LEGEND

MD19 CAREFULLY REMOVE STORE AND PROTECT ACOUSTIC PANELS. PREPARE AREA FOR NEW CONSTRUCTION.












REFLECTED CEILING PLAN NOTES

- All new ceiling heights shall be 9'-0" A.F.F. unless noted otherwise.
- Where new ceilings are connected to existing ceilings, match existing ceiling height unless noted otherwise.
- Refer to A' 6.22 for Typical Gypsum Board Ceiling Control Joint Detail.
- Provide vented reveals at perimeter of all non-insulated exterior plaster soffits. Provide venting strips or perforated panels at perimeter of all non-insulated metal panel soffits (refer to Detail /A6.). Venting at non-insulated soffits shall be provided whether specifically indicated on the drawings or not.
- Provide partition to deck (PTD) at walls surrounding spaces with exposed structure. Refer to Reflected Ceiling Plan Legend for PTD requirements.
- Provide hold-down clips for all acoustic lay-in ceiling panels at vestibules, at sloped ceilings, at fire-rated ceilings, and within 6 feet of exterior doors without vestibules.
- At ceiling turning details, the suspended assemblies, bracing, blocking, etc. shown on the details are for schematic representation only. Provide stable, secure and permanent assemblies at these locations in accordance with recommended light-gage steel framing installation practices.
- At partitions that do not extend to deck above, extend partition 4" minimum above highest adjacent ceiling and brace per Floor Plan Legend and Floor Plan Notes.
- Contractor shall locate new ceiling grid according to the architectural reflected ceiling plans. Contractor shall locate equipment locations shown on consultant drawings accordingly.
- Contractor to locate new equipment centered in ceiling tiles. Notify Architect of any discrepancies.


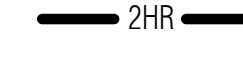
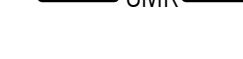
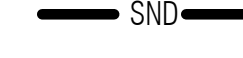

REFLECTED CEILING PLAN LEGEND


EXISTING TO REMAIN WITH LIMITED OR NO ARCHITECTURAL WORK REQUIRED IN THIS AREA. REFER TO CIVIL, MEPT AND STRUCTURAL DRAWINGS FOR ANY ADDITIONAL WORK IN AREA.

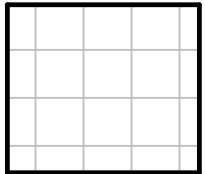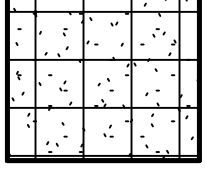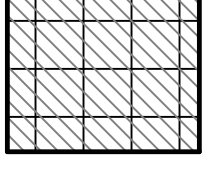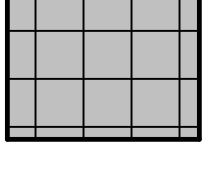CEILING:

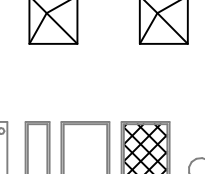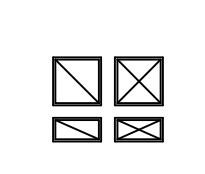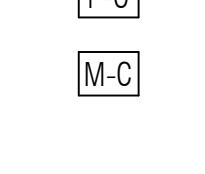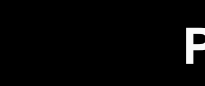-  EXISTING ACOUSTIC LAY-IN CEILING TILE TO REMAIN
-  ACT-01 ACOUSTIC LAY-IN CEILING TILE 24" X 24"
-  ACT-02 EXISTING GRID TO REMAIN, NEW ACOUSTIC LAY-IN CEILING TILE, HIGH NRC 24" X 24"
-  ACT-03 ACOUSTIC LAY-IN CEILING TILE, HIGH NRC 24" X 24"
-  EXISTING GYPSUM BOARD CEILING TO REMAIN
-  PT-01 5/8" GYPSUM BOARD CEILING PAINTED PT-01, U.N.O.
-  AP PYRAMID CEILING DIFFUSER PANELS (SIZE)
-  LIGHT FIXTURES. Refer to Electrical Drawings.
-  SUPPLY AND RETURN GRILLES. Shown for location purposes only. Refer to Mechanical Drawings.
-  P-C CEILING MOUNTED PROJECTOR
-  M-C CEILING MOUNTED MONITOR

PARTITION LEGEND

-  1-HR 1-HOUR FIRE BARRIER PARTITION. Extend partition to deck above and seal with firestopping sealant as required for fire-resistance requirements. Paint stenciled label on partitions above ceiling at 15'-0" o.c. as follows: "1-HOUR FIRE AND SMOKE BARRIER - PROTECT ALL OPENINGS". Brace partitions per Floor Plan General Notes.
-  2-HR 2-HOUR FIRE BARRIER PARTITION. Extend partition to deck above and seal with firestopping sealant as required for fire-resistance requirements. Paint stenciled label on partitions above ceiling at 15'-0" o.c. as follows: "2-HOUR FIRE AND SMOKE BARRIER - PROTECT ALL OPENINGS". Brace partitions per Floor Plan General Notes.
-  SMK SMOKE PARTITION. Extend partition to deck above and seal with sealant as required to resist the passage of smoke. Seal all joints and penetrations. Brace partitions per Floor Plan General Notes.
-  SND ACOUSTICAL DRYWALL PARTITION / SOUND-CONDITIONED CMU PARTITION. Extend partition to deck above and seal with acoustical sealant. Seal all joints and penetrations with acoustical sealant. Brace partitions per Floor Plan General Notes.
-  PTD NON-RATED PARTITION TO DECK. Extend partition to deck above. Brace partitions per Floor Plan General Notes.

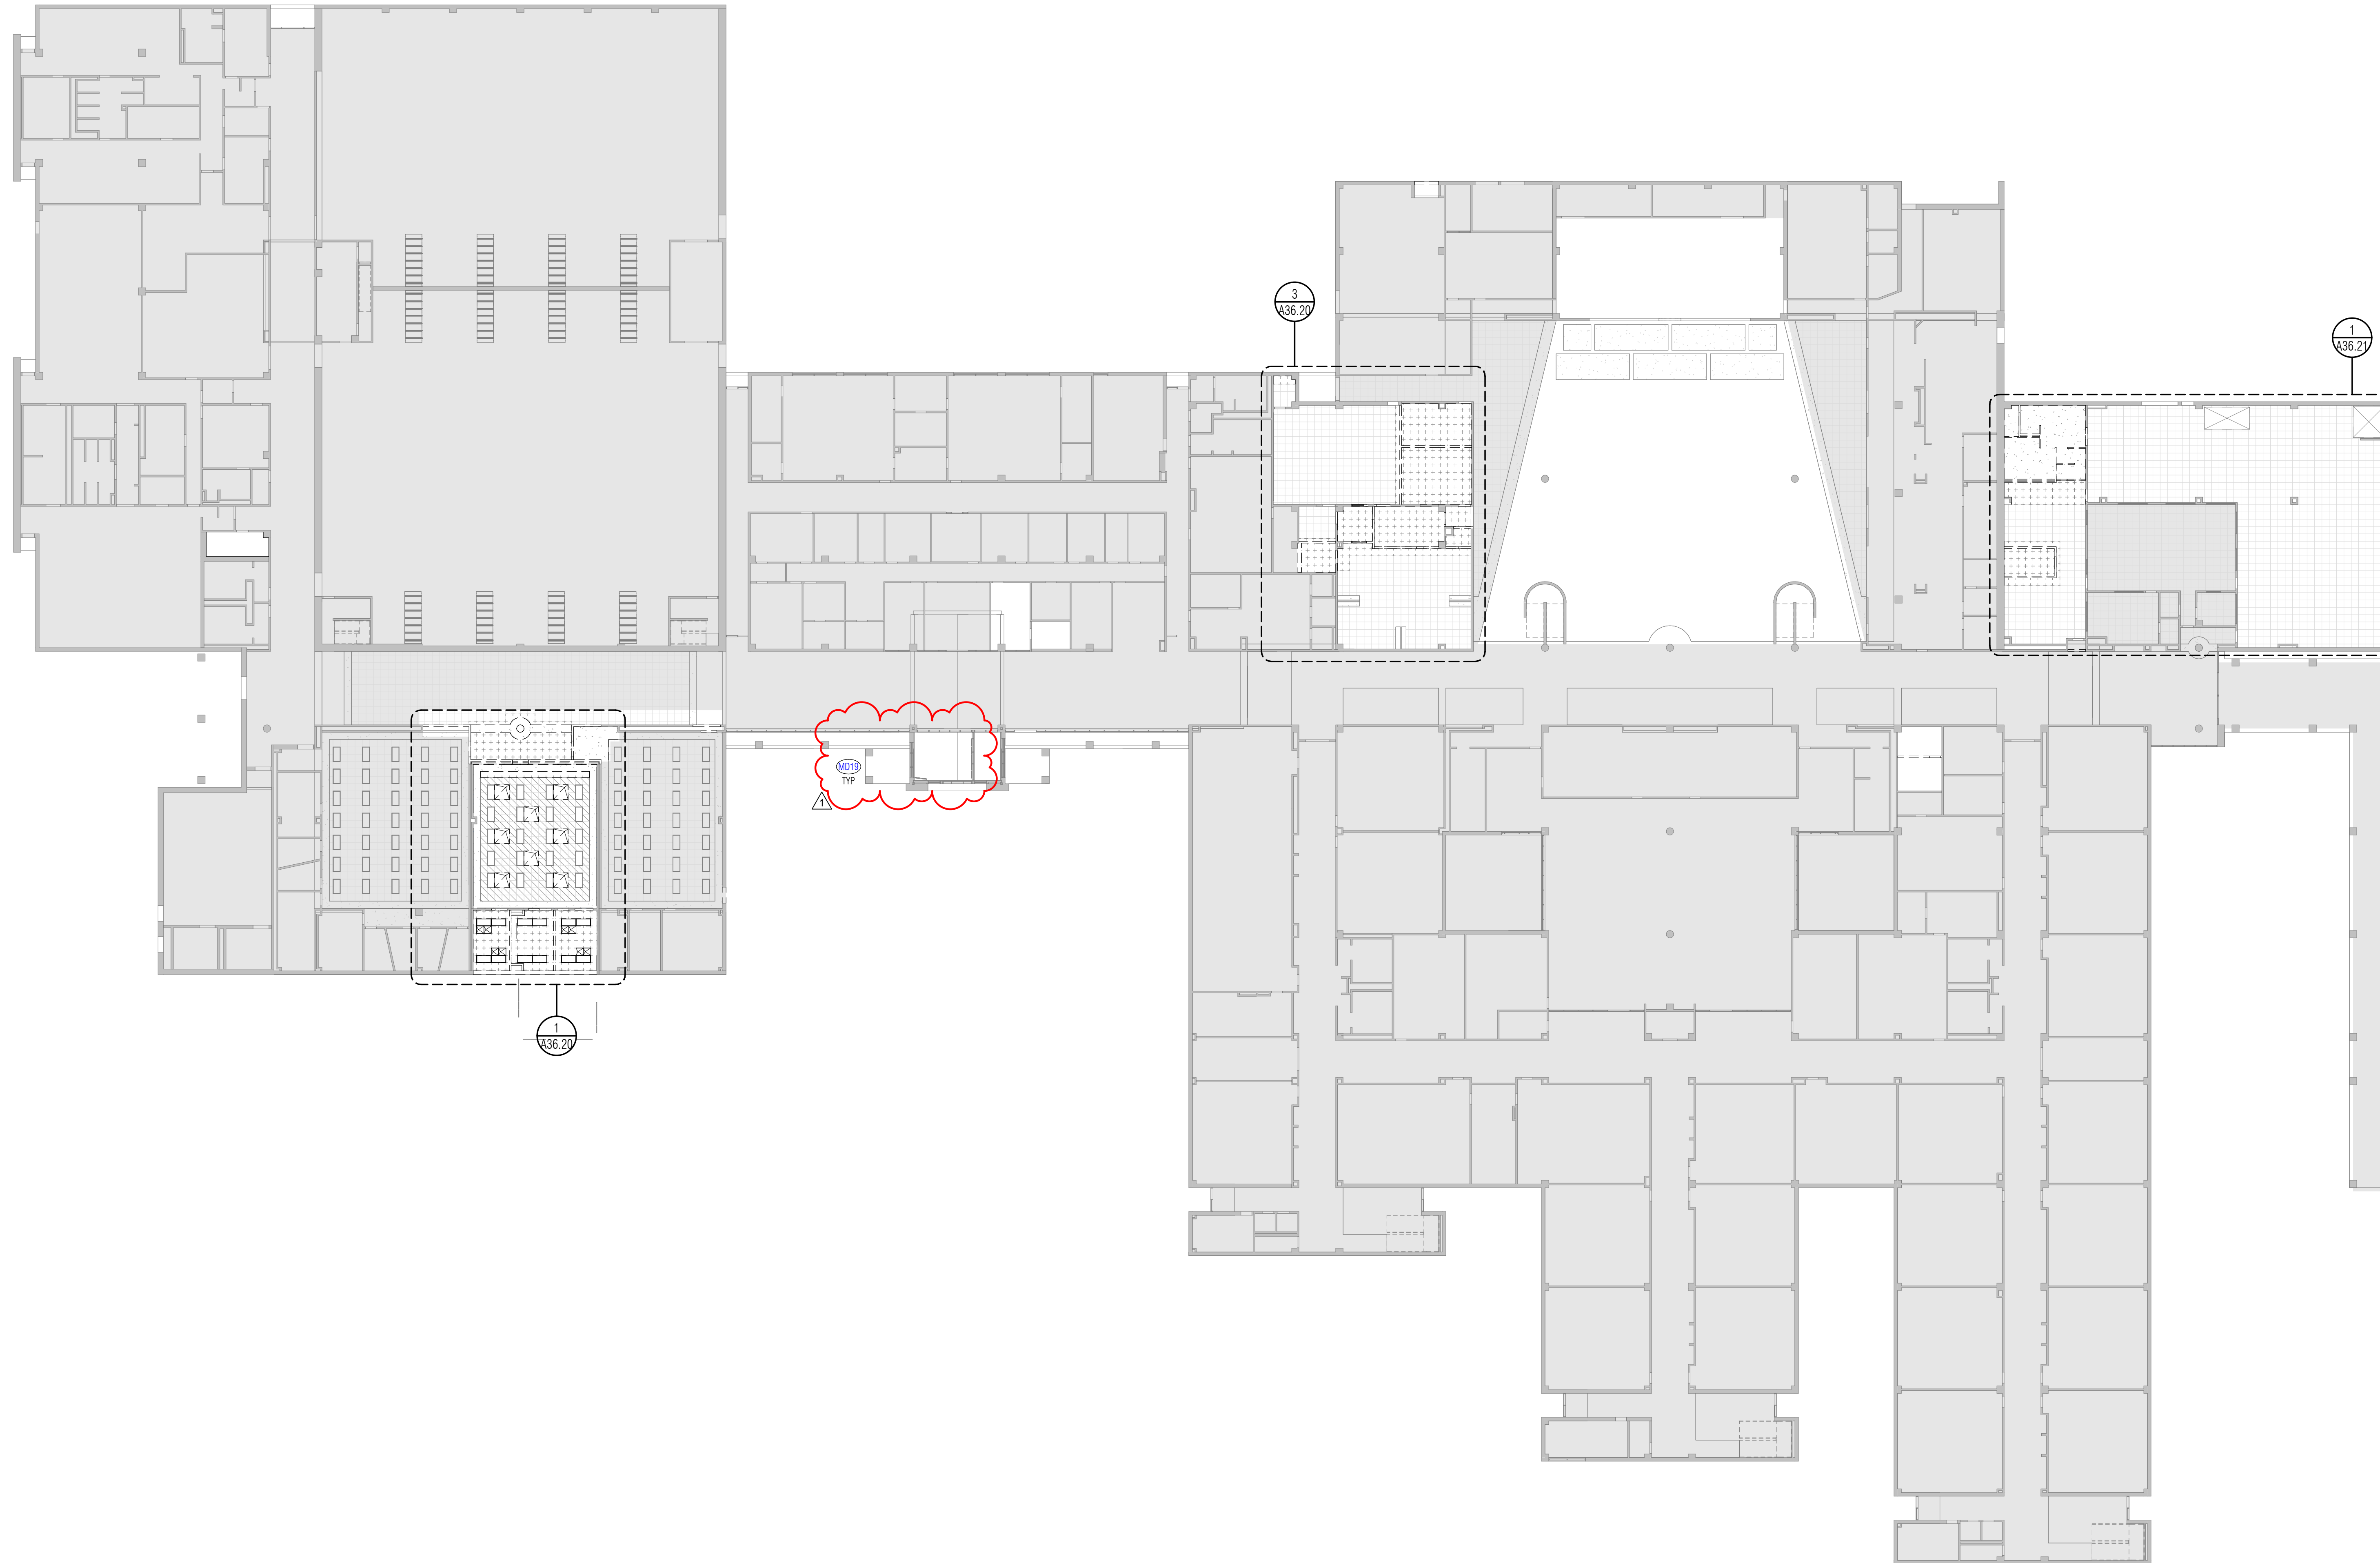


1 DEMOLITION REFLECTED CEILING PLAN - LEVEL ONE
SCALE: 3/64" = 1'-0"



ARCHITECT

VLK Architects
20445 State Hwy 249, Suite 350
Houston, Texas 77070
Main Phone: 281.871.2300
www.vlkarchitects.com

CYPRESS-FAIRBANKS INDEPENDENT SCHOOL DISTRICT
HOUSTON, TEXAS

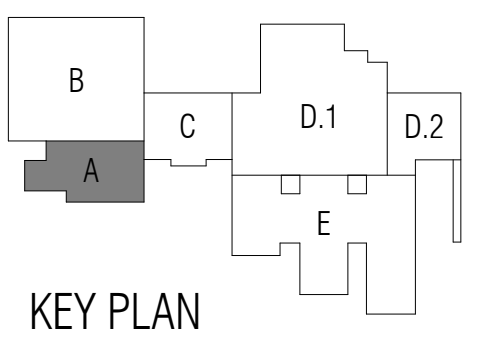

KEY PLAN



ISSUED: February 24, 2025

REVISIONS

Revision No.	Revision Date
1 Addendum 1	03-06-2025

Director: RSJ, Drawn By: STH, KM
Designer: TQ, Quality Control

Proj. Arch. TQ

PROJECT NO.

24-010.00


SHEET TITLE

TRUITT - DEMOLITION REFLECTED CEILING PLAN - LEVEL ONE


SHEET NO.

A36.01


2024 Cook, Labay & Truitt MS Renovations

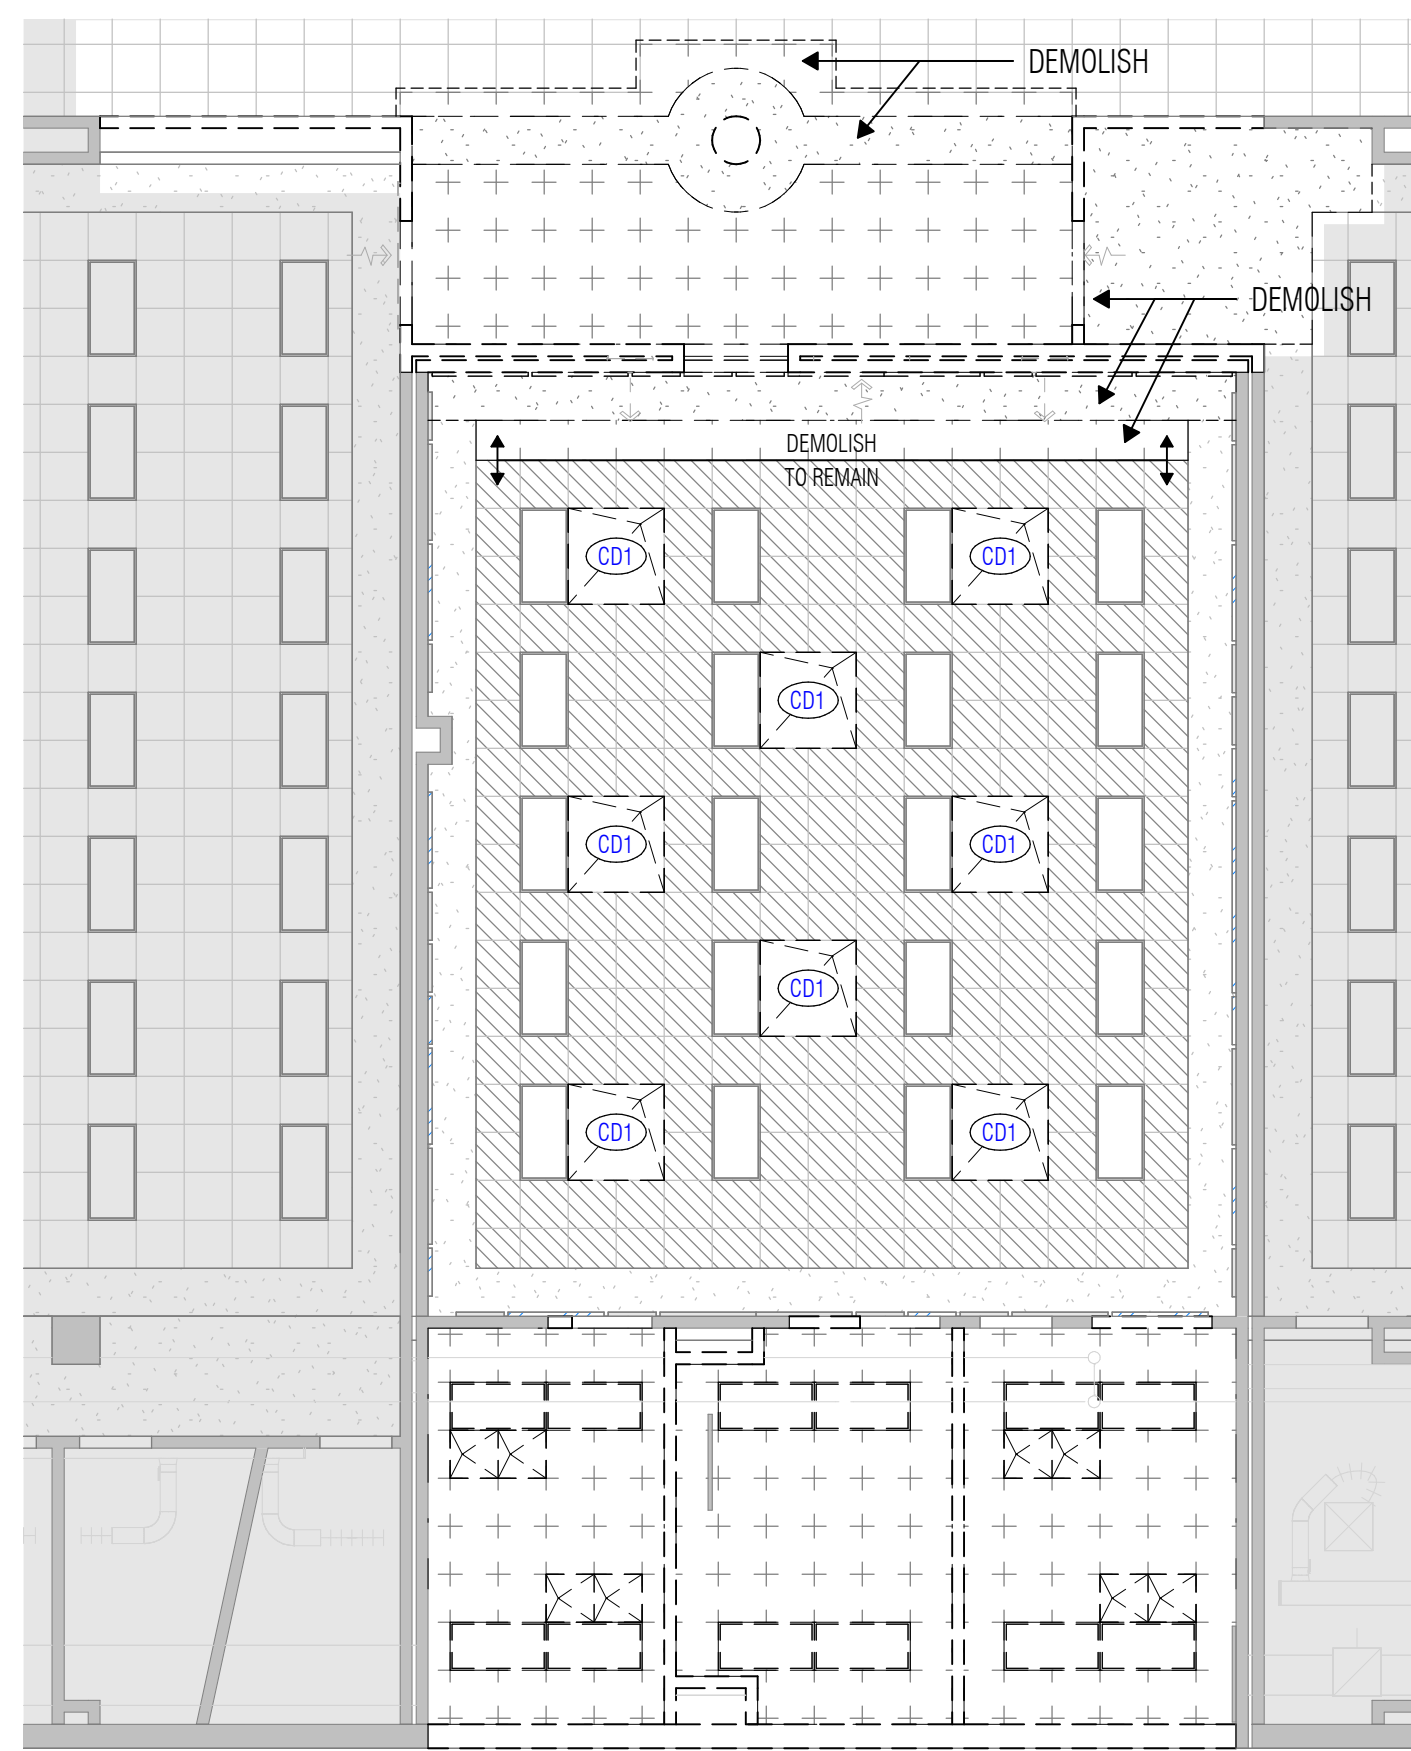


1 TRUITT ORCH ENLG DEMO RCP
SCALE: 1/8" = 1'-0"

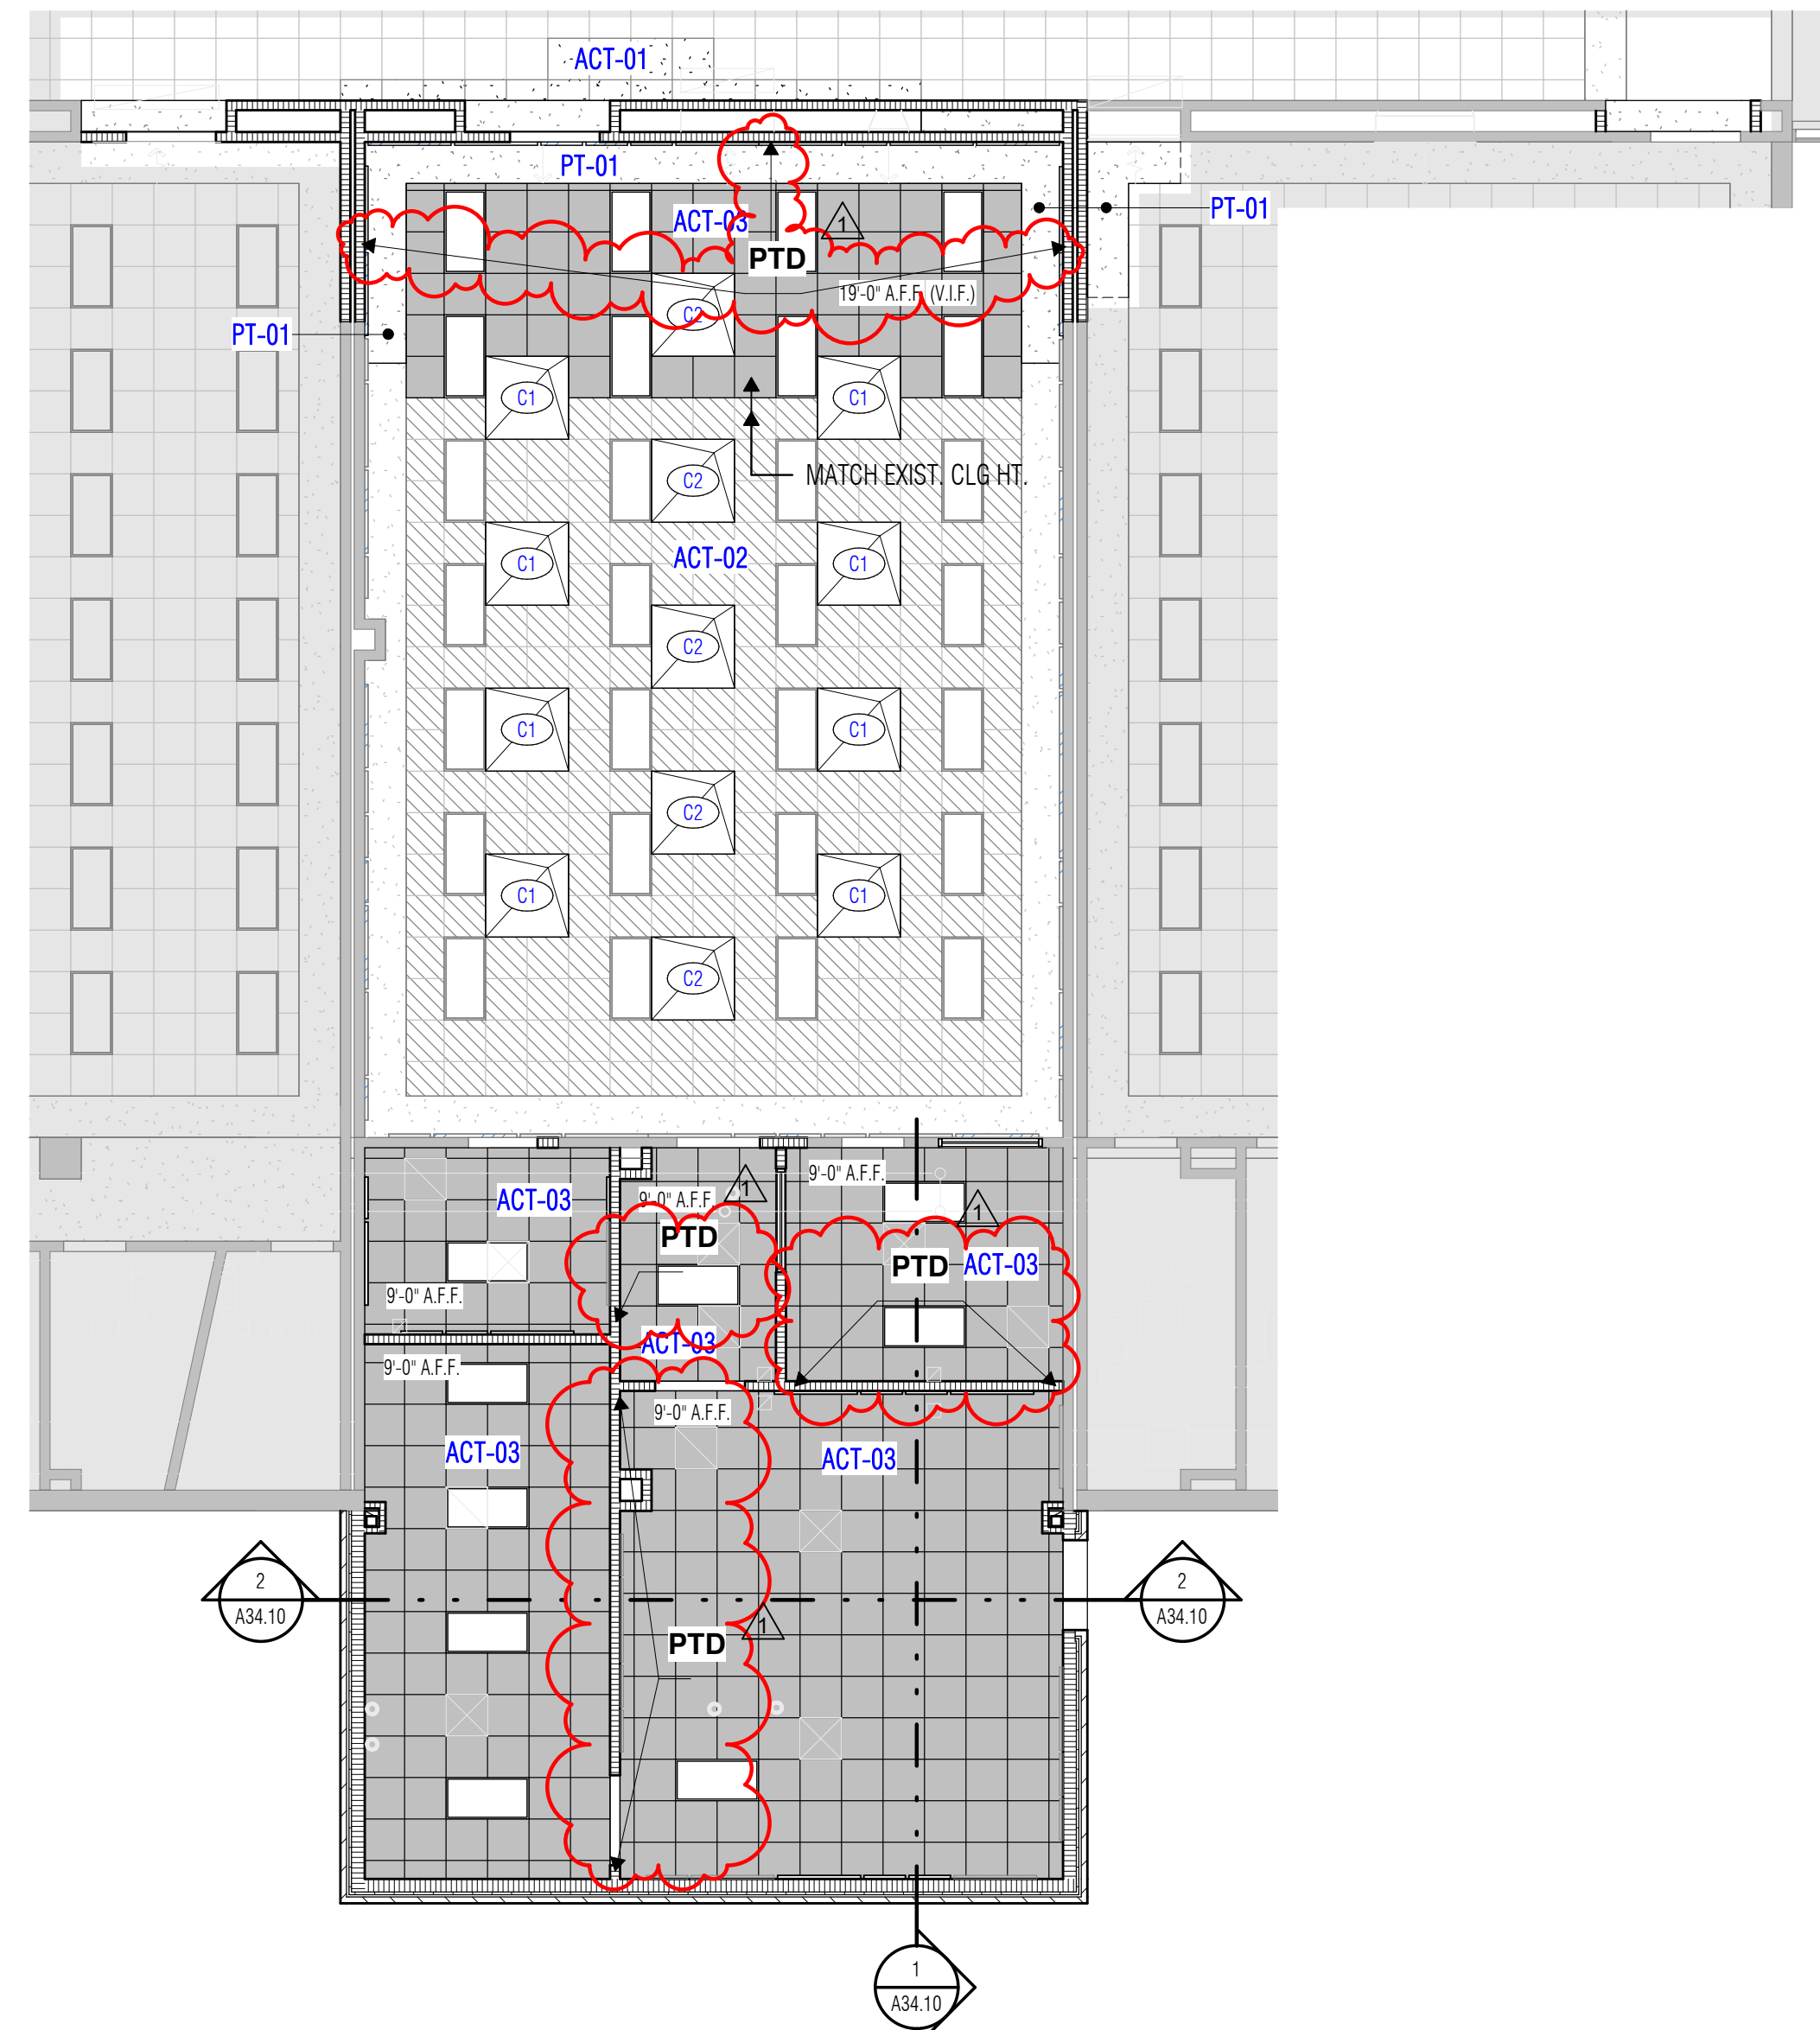

2 ORCHESTRA ADDITION ENLARGED RCP
SCALE: 1/8" = 1'-0"

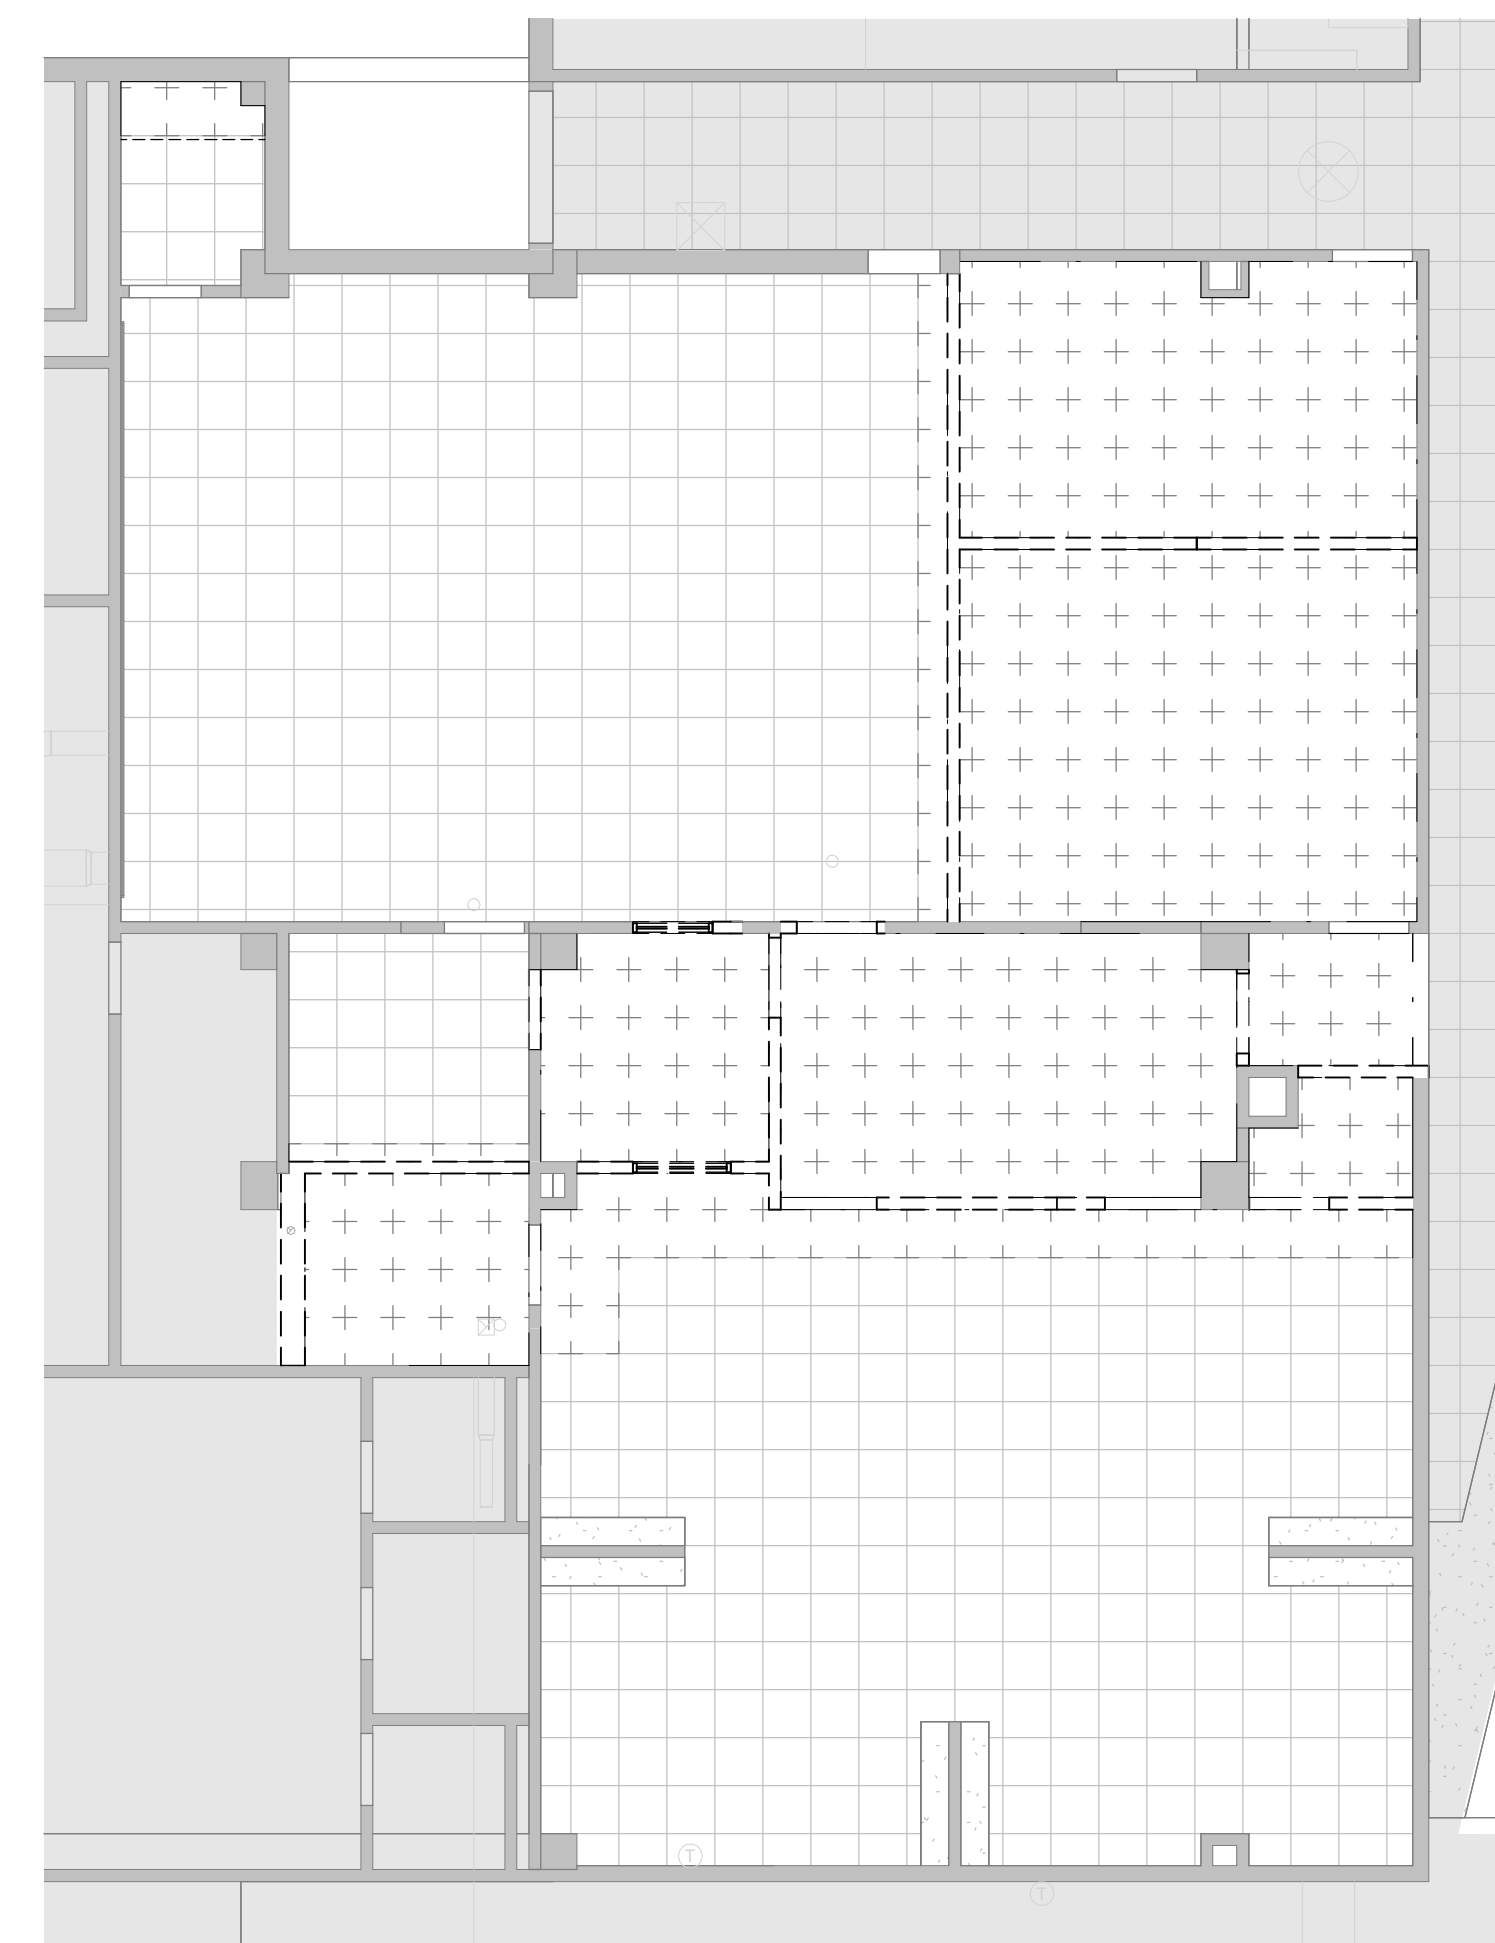


3 FCS RENOVATION ENLARGED DEMOLITION RCP
SCALE: 1/8" = 1'-0"

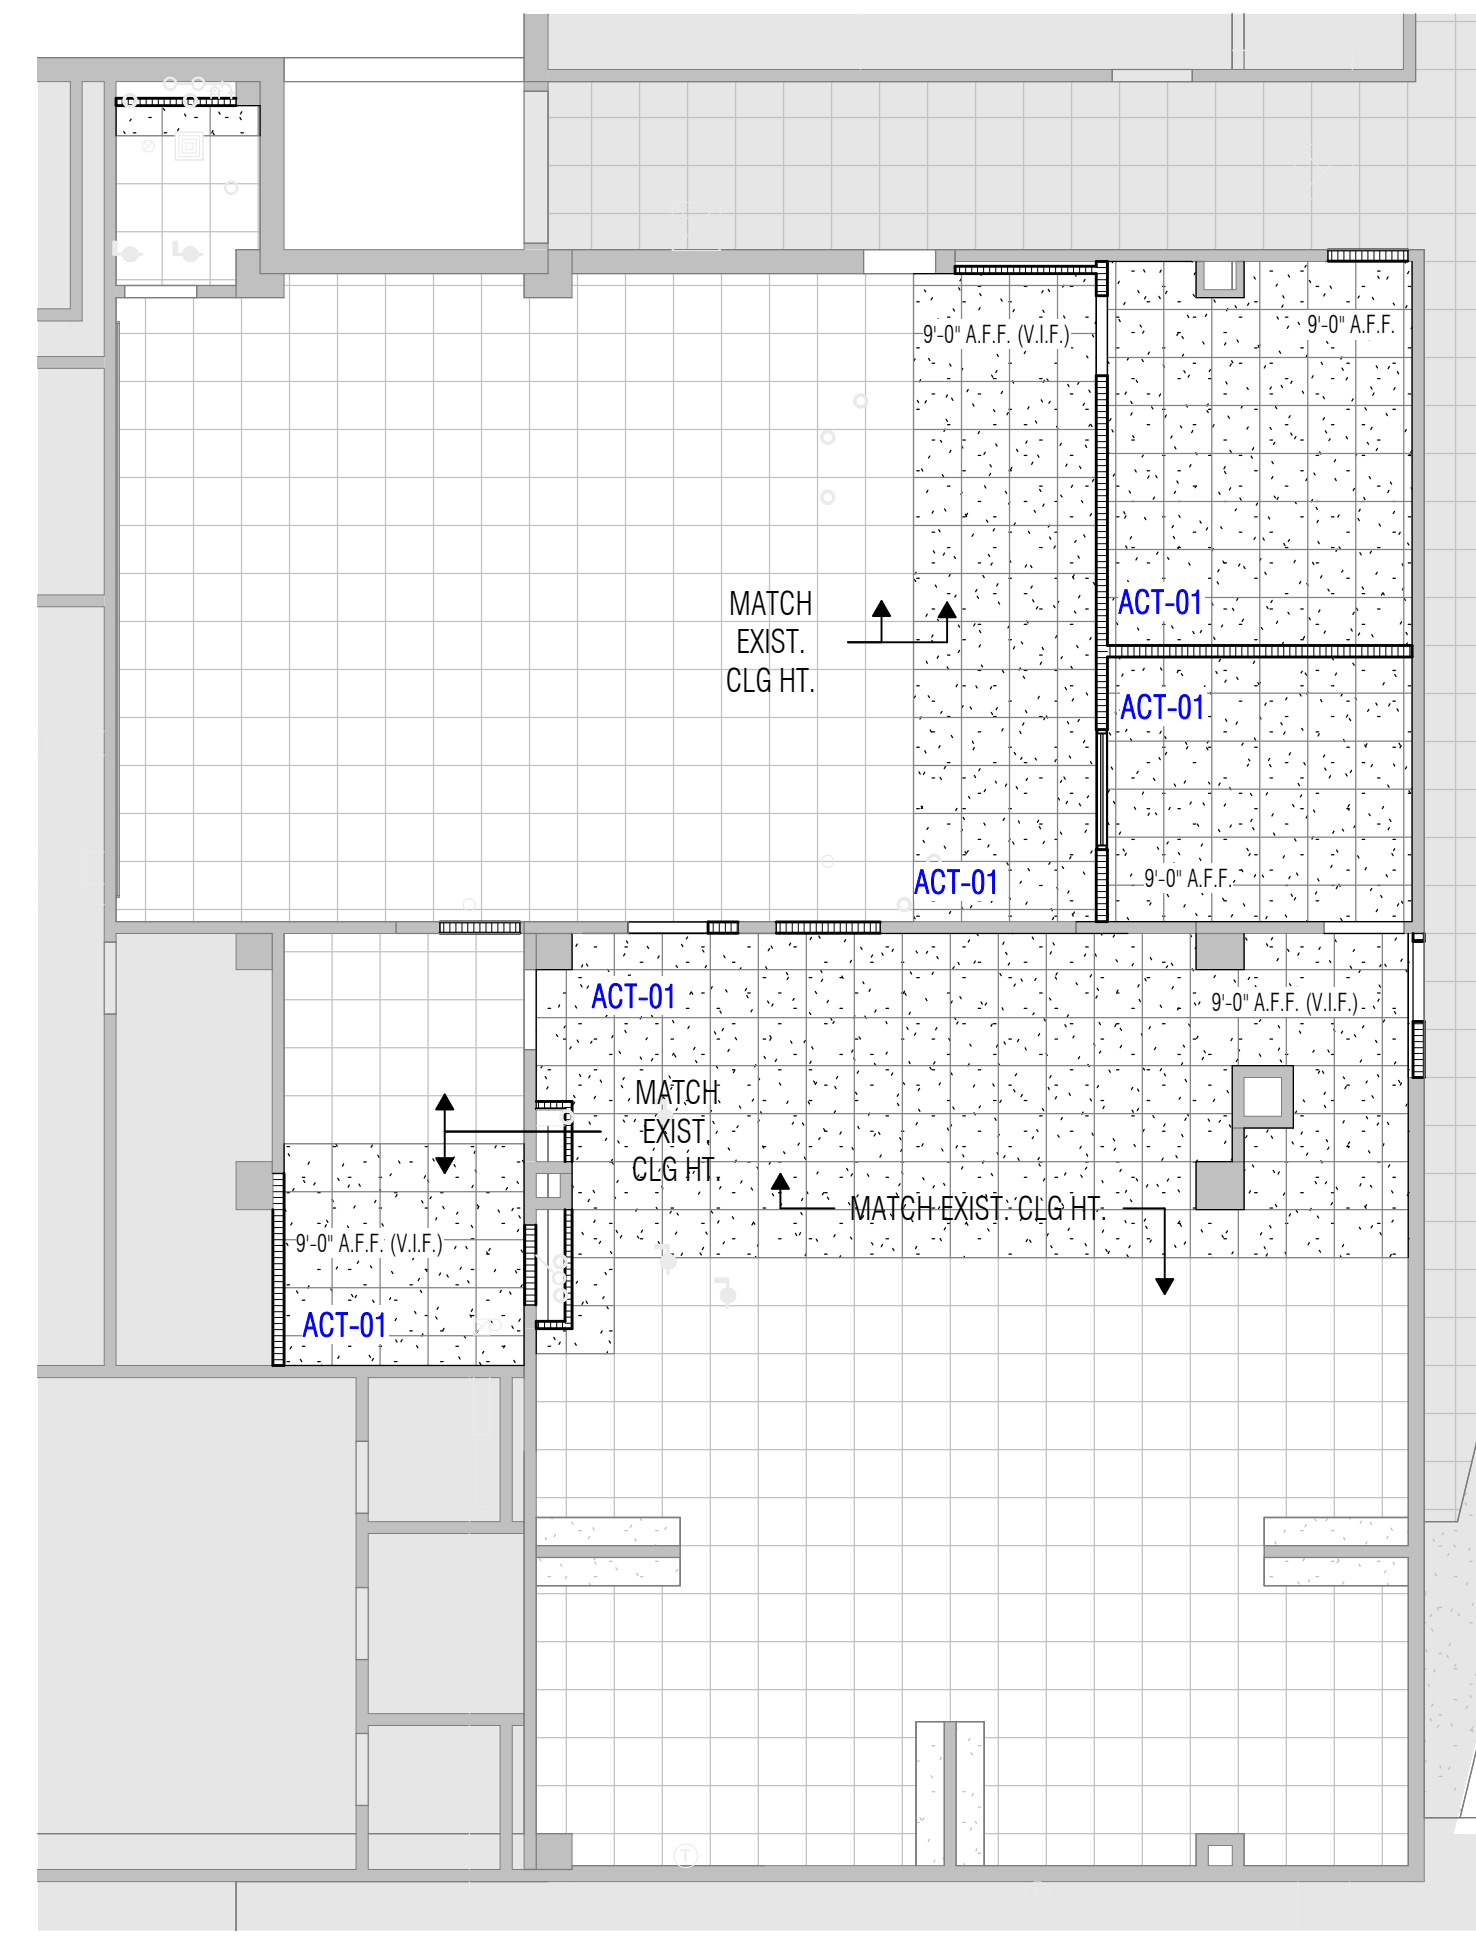

4 FCS RENOVATION ENLARGED RCP
SCALE: 1/8" = 1'-0"

DEMOLITION REFLECTED CEILING PLAN LEGEND

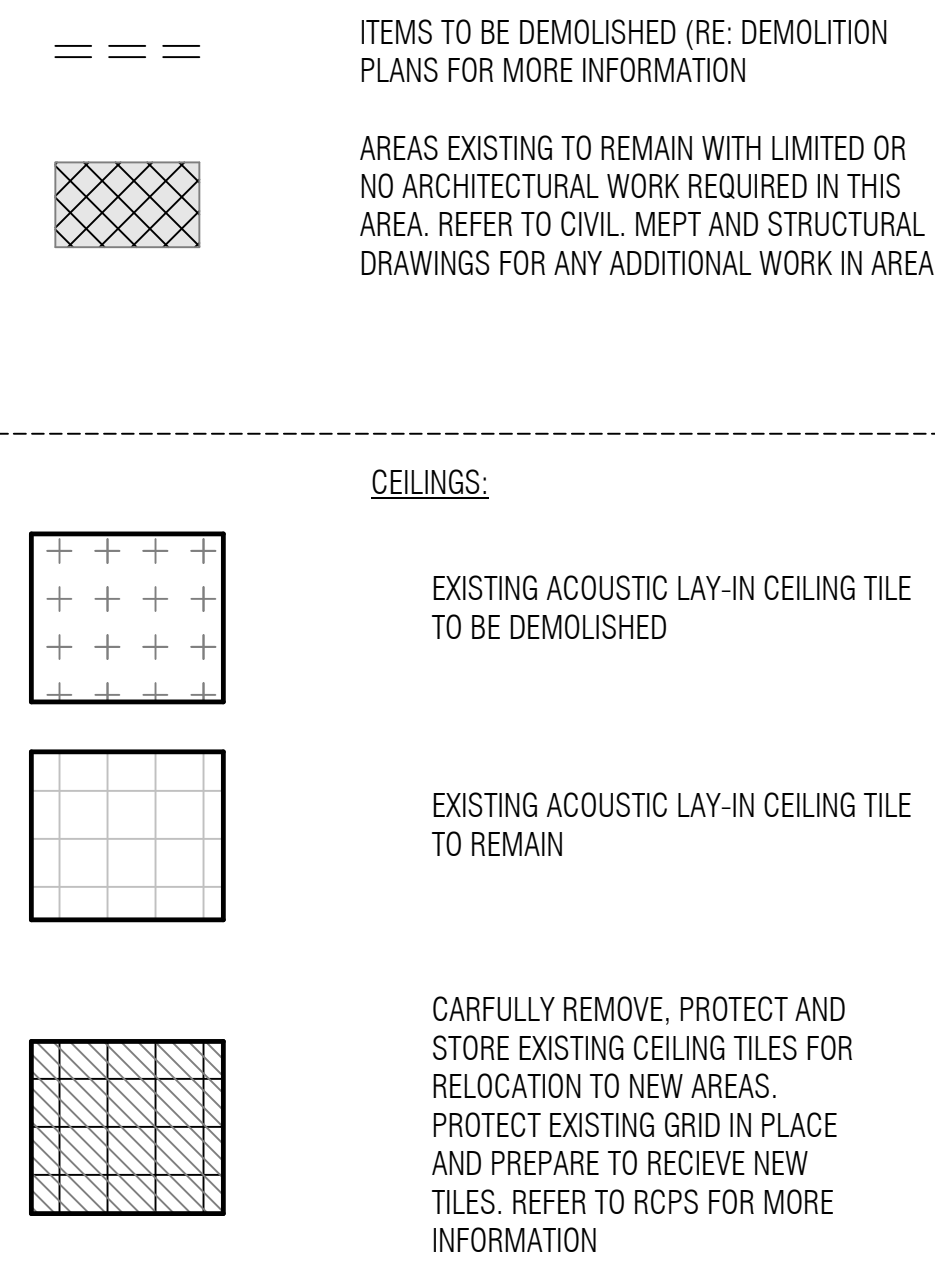


KEYNOTE LEGEND

C1	RELOCATED EXISTING CEILING PYRAMID SOUND DIFFUSER
C2	NEW CEILING PYRAMID SOUND DIFFUSER TO MATCH EXISTING
CD1	CAREFULLY REMOVE AND PROTECT EXISTING PYRAMID DIFFUSERS. PREPARE FOR RELOCATION (RE: NEW CONSTRUCTION REFLECTED CEILING PLAN).


REFLECTED CEILING PLAN NOTES

- All new ceiling heights shall be 9'-0" A.F.F. unless noted otherwise.
- Where new ceilings are connected to existing ceilings, match existing ceiling height unless noted otherwise.
- Refer to A' 6.22 for Typical Gypsum Board Ceiling Control Joint Detail.
- Provide vented reveals at perimeter of all non-insulated exterior plaster soffits. Provide venting strips or perforated panels at perimeter of all non-insulated metal panel soffits (refer to Detail /A6...). Venting at non-insulated soffits shall be provided whether specifically indicated on the drawings or not.
- Provide partition to deck (PTD) at walls surrounding spaces with exposed structure. Refer to Reflected Ceiling Plan Legend for PTD requirements.
- Provide hold-down clips for all acoustic lay-in ceiling panels at vestibules, at sloped ceilings, at fire-rated ceilings, and within 6 feet of exterior doors without vestibules.
- At ceiling turning details, the suspended assemblies, bracing, blocking, etc. shown on the details are for schematic representation only. Provide stable, secure and permanent assemblies at these locations in accordance with recommended light-gage steel framing installation practices.
- At partitions that do not extend to deck above, extend partition 4" minimum above highest adjacent ceiling and brace per Floor Plan Legend and Floor Plan Notes.
- Contractor shall locate new ceiling grid according to the architectural reflected ceiling plans. Contractor shall locate equipment locations shown on consultant drawings accordingly.
- Contractor to locate new equipment centered in ceiling tiles. Notify Architect of any discrepancies.

REFLECTED CEILING PLAN LEGEND


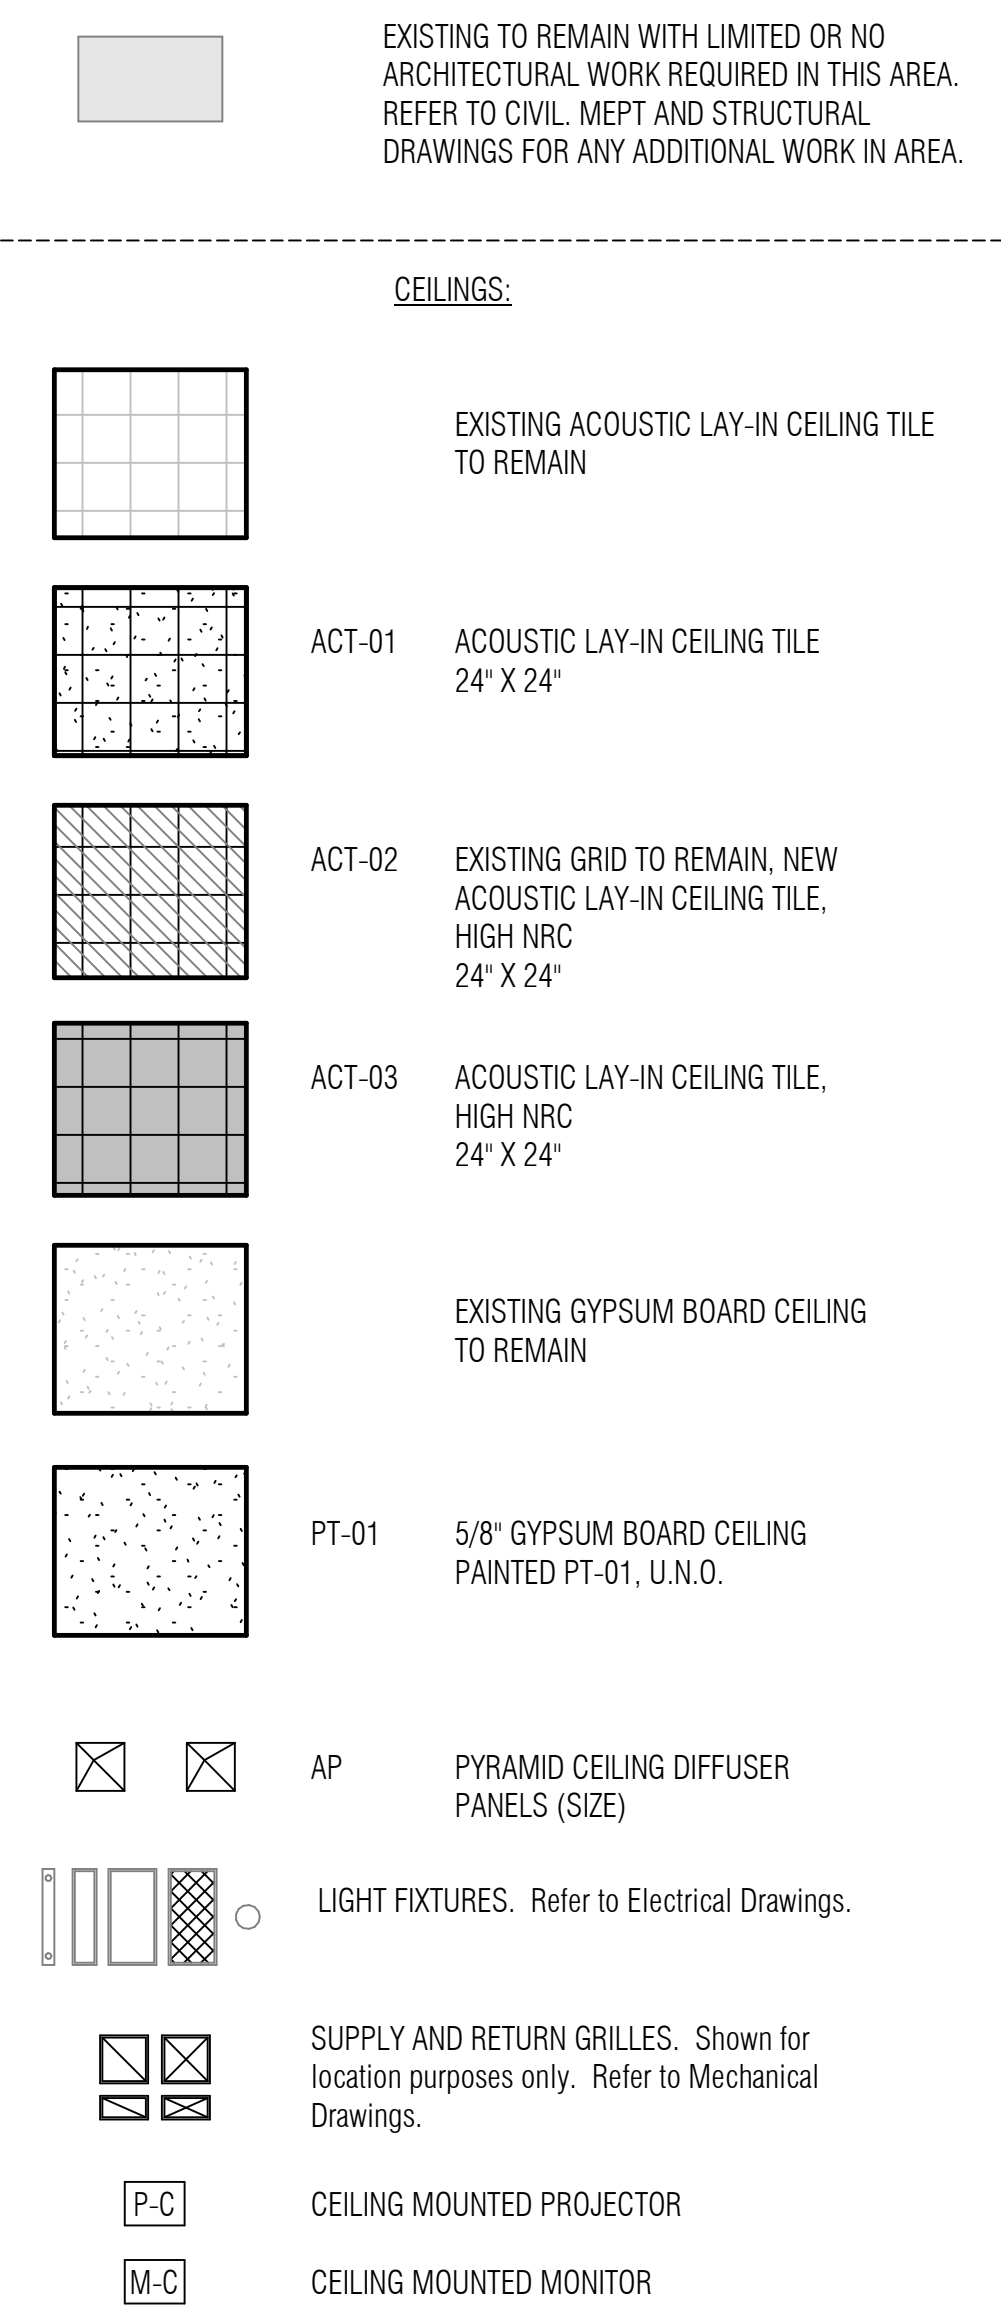


PARTITION LEGEND

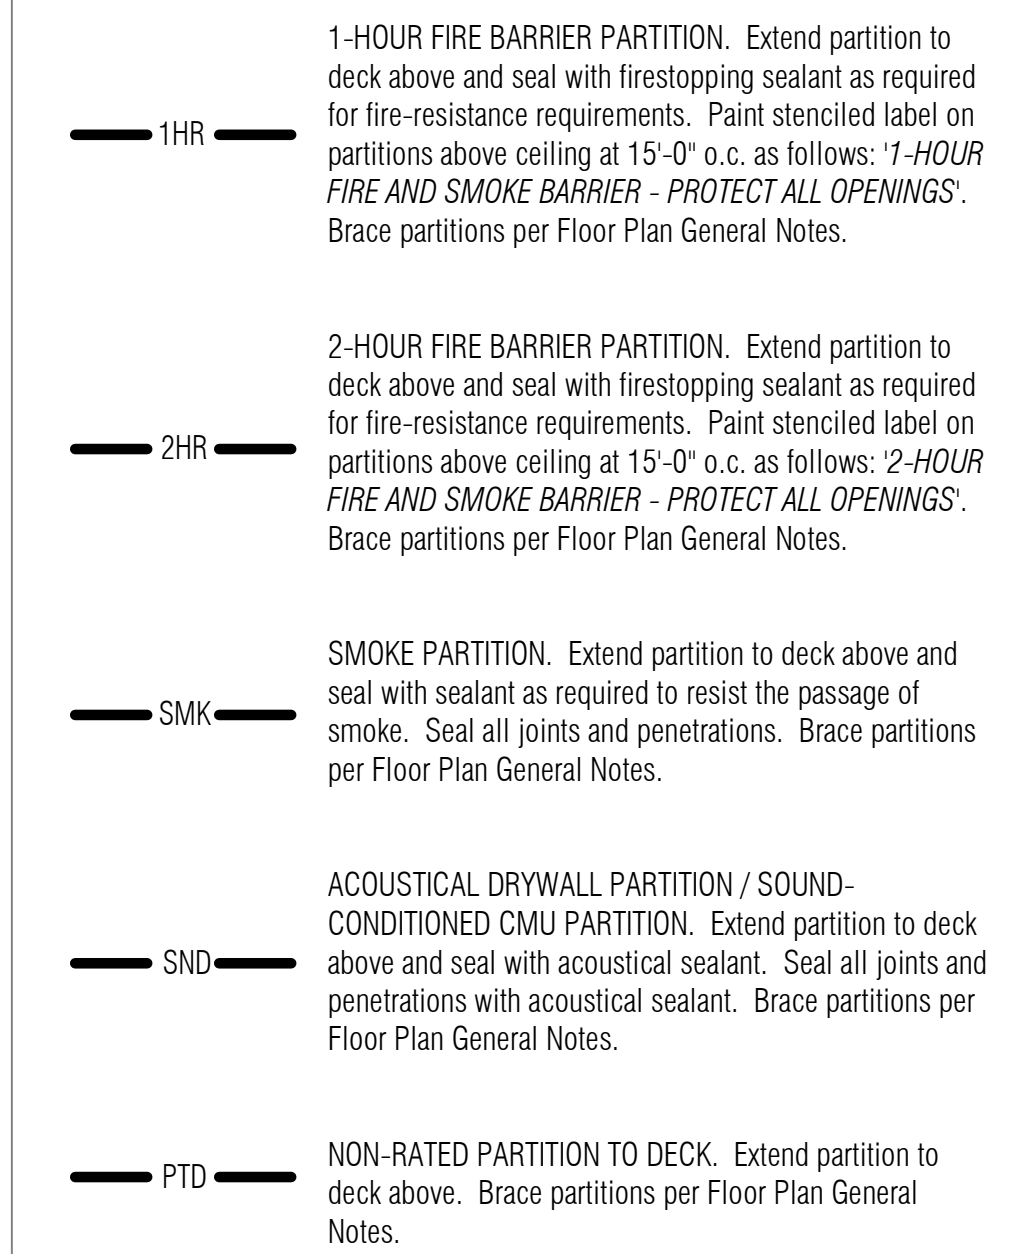

ARCHITECT
VLK Architects
20445 State Hwy 249, Suite 350
Houston, Texas 77070
Main Phone: 281.671.2300
www.vlkarchitects.com

CYPRESS-FAIRBANKS INDEPENDENT SCHOOL DISTRICT
HOUSTON, TEXAS

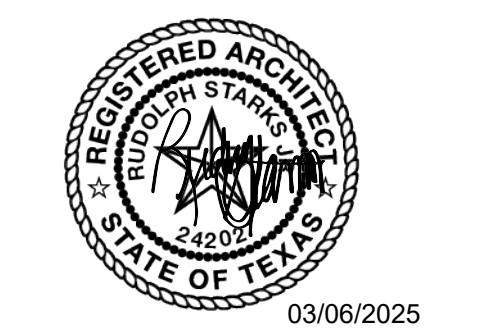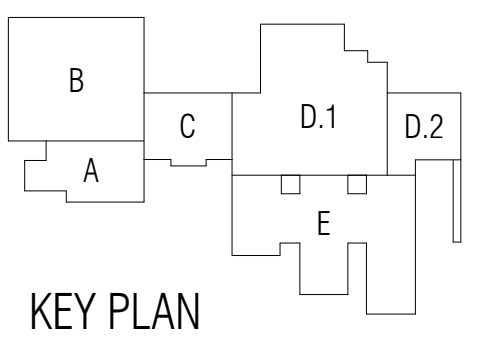

ISSUED: February 24, 2025

Revision No.	Revision Date
1 Addendum 1	03-06-2025

Director: RSJ
Designer: TQ
Drawn By: STH, KM
Quality Control: TQ

PROJECT NO.

24-010.00

SHEET TITLE

TRUITT - ENLARGED REFLECTED CEILING PLANS

SHEET NO.

A36.20

2024 Cook, Labay & Truitt MS Renovations


DOOR NUMBER	DOOR TYPE	FRAME TYPE	DOOR OPENING		FIRE RATING	HDWR SET	REMARKS	DOOR NUMBER	DOOR TYPE	FRAME TYPE	DOOR OPENING		FIRE RATING	HDWR SET	REMARKS	DOOR NUMBER	DOOR TYPE	FRAME TYPE	DOOR OPENING		FIRE RATING	HDWR SET	REMARKS
			WIDTH	HEIGHT							WIDTH	HEIGHT							WIDTH	HEIGHT			
1	X-SFD		5'-10"	8'-10"		8.0		100	X-NL2		3'-0"	8'-10"		20.0		220	X-NL2		3'-0"	8'-10"		20.0	
2	X-SF		3'-0"	7'-0"		2.0		101	X-NL2		3'-0"	8'-10"		20.0		221	X-NL2		3'-0"	8'-10"		4.0	
5	X-F2		4'-0"	8'-10"		9.0		102	X-NL2		3'-0"	8'-10"		20.0		222	X-NL2		3'-0"	8'-10"		20.0	
6	X-FD2		6'-0"	8'-10"		9.0		104	X-NL2		3'-0"	8'-10"		20.0		223	X-F2		2'-6"	8'-10"		20.0	
8	X-F2		3'-0"	8'-10"		9.0		105	X-FD2		6'-0"	8'-10"		17.0		224	X-NL2		3'-0"	8'-10"		20.0	
9	X-F2		3'-0"	8'-10"		9.0		106	X-NL2		3'-0"	8'-10"		20.0		225	X-NL2		3'-0"	8'-10"		14.0	
12	X-SFD		6'-0"	6'-9"		10.0		111	X-NL2		3'-0"	8'-10"		20.0		229	X-NL2		3'-0"	8'-10"		20.0	
13	X-FD2		6'-0"	8'-10"		7.0		112	X-NL2		3'-0"	8'-10"		20.0		230	X-NL2		3'-0"	8'-10"		20.0	
14	X-FD2		6'-0"	8'-10"		7.0		114	X-NL2		3'-0"	8'-10"		20.0		231	X-NL2		3'-0"	8'-10"		20.0	
15	X-SF		3'-0"	8'-7"		7.1		115.3	X-SFD		6'-0 1/4"	8'-7"		16.0		233	X-NL2		3'-0"	8'-10"		20.0	
16	X-SF		2'-11"	8'-9"		7.1		115.4	X-SFD		5'-11 7/8"	8'-7"		16.0		234	X-NL2		3'-0"	8'-10"		20.0	
17	X-FD2		6'-0"	8'-10"		5.0		115.5	X-SF		3'-2"	8'-7"		16.0		235	X-NL2		3'-0"	8'-10"		20.0	
18	X-FD2		3'-8"	8'-10"		6.0		116	X-NL2		3'-0"	8'-10"		20.0		237	X-NL2		3'-0"	8'-10"		20.0	
19	X-NL2		4'-0"	8'-10"		11.0		117	X-NL2		3'-0"	8'-10"		20.0		238	X-F2		2'-6"	8'-10"		20.0	
20	X-F2		3'-0"	8'-10"		13.0		120	X-NL2		3'-0"	8'-10"		20.0		239	X-NL2		3'-0"	8'-10"		20.0	
21.1	X-SFD		6'-0"	8'-10"		7.0		121	X-NL2		3'-0"	8'-10"		20.0		240	X-NL2		3'-0"	8'-10"		14.0	
22	X-SF		3'-0"	8'-7"		7.1		122	X-NL2		3'-0"	8'-10"		20.0		244	X-NL2		3'-0"	8'-10"		20.0	
23	X-SF		3'-0"	8'-7"		7.1		123	X-NL2		3'-0"	8'-10"		20.0		246	X-NL2		3'-0"	8'-10"		20.0	
24	X-SF		3'-0"	8'-7"		7.0		124	X-NL2		3'-0"	8'-10"		20.0		247	X-NL2		3'-0"	8'-10"		20.0	
25	X-SF		3'-0"	8'-7"		13.0		125	X-NL2		3'-0"	8'-10"		20.0		248	X-NL2		3'-0"	8'-10"		17.0	
								126	X-NL2		3'-0"	8'-10"		20.0		249	X-NL2		3'-0"	8'-10"		20.0	
								127	X-NL2		3'-0"	8'-10"		20.0		251	X-NL2		3'-0"	8'-10"		20.0	
								128	X-NL2		3'-0"	8'-10"		20.0		254	X-NL2		3'-0"	8'-10"		20.0	
								129	X-NL2		3'-0"	8'-10"		20.0		261	X-FD2		6'-0"	8'-10"		20.0	
								130	X-NL2		3'-0"	8'-10"		14.0		262	X-FD2		6'-0"	8'-10"		20.0	
								134	X-NL2		3'-0"	8'-10"		20.0		301	NL2		3'-0"	8'-10"		19.0	SIGN TYPE B
								135	X-NL2		3'-0"	8'-10"		20.0		301A	NL2		3'-0"	8'-10"		24.0	SIGN TYPE B
								136	X-NL2		3'-0"	8'-10"		20.0		303A	NL2		3'-0"	8'-10"		24.0	SIGN TYPE B
								137	X-NL2		3'-0"	8'-10"		20.0		310	X-NL2		3'-0"	8'-10"		20.0	
								138	X-FD2		6'-0"	8'-10"		17.0		313.OH1	DH		10'-0"	8'-10"		27.0	
								140	X-NL2		3'-0"	8'-10"		20.0		314.1	X-NL2		3'-0"	8'-10"		23.0	
								141	X-NL2		3'-0"	8'-10"		20.0		316	X-NL2		3'-0"	8'-10"		21.0	
								142	X-NL2		3'-0"	8'-10"		20.0		331A	NL2		3'-0"	8'-10"		24.0	SIGN TYPE B
								143	X-NL2		3'-0"	8'-10"		20.0		451	X-NL2		3'-0"	8'-10"		18.0	
								144	X-NL2		3'-0"	8'-10"		20.0		400A.1	X-SF		3'-0 1/2"	7'-0"		-	
								145	X-NL2		3'-0"	8'-10"		20.0		400A.2	X-SF		3'-0"	7'-0"		-	
								200	X-NL2		3'-0"	8'-10"		20.0		400A.3	X-SF		3'-0"	7'-0"		-	
								203	X-NL2		3'-0"	8'-10"		20.0		401	X-NL2		3'-0"	8'-10"		14.0	
								204	X-NL2		3'-0"	8'-10"		20.0		403	X-NL2		3'-0"	8'-10"		14.0	
								206	X-NL2		3'-0"	8'-10"		20.0		409	X-NL2		3'-0"	8'-10"		14.0	
								207	X-FD2		6'-0"	8'-10"		20.0		410	X-NL2		3'-0"	8'-10"		14.0	
								209	X-NL2		3'-0"	8'-10"		20.0		420.1	X-NL2		3'-0"	8'-10"		15.0	
								210	X-NL2		3'-0"	8'-10"		17.0		421	X-NL2		3'-0"	8'-10"		14.0	
								211	X-NL2		3'-0"	8'-10"		20.0		500	NL3		4'-0"	8'-10"		25.0	SIGN TYPE B
								212	X-F2		2'-6"	8'-10"		14.0		512	NL3		4'-0"	8'-10"		26.0	SIGN TYPE B
								216	X-NL2		3'-0"	8'-10"		20.0		512A	NL2		4'-0"	8'-10"		24.0	SIGN TYPE B
								219	X-NL2		3'-0"	8'-10"		20.0		513	NL2		3'-0"	8'-10"		26.0	SIGN TYPE B
															520	NL3		4'-0"	8'-10"		25.0	SIGN TYPE B	
															600	X-FD2		6'-0"	8'-10"		22.0		
															600.1	X-FD2		6'-0"	8'-10"		22.0		
															601	X-FD2		6'-0"	8'-10"		22.0		
															614	X-F2		3'-0"	8'-10"		18.0		

DOOR SCHEDULE NOTES

- At Doors marked "SMK", provide smoke seals at frame and door bottom to resist the passage of smoke. Provide threshold if required by code or if necessary for proper function of door bottom seal.
- At Doors marked "SND", provide sound seals at frame and door bottom.
- At Doors without a Frame Type designation, the door frame is part of a Glazing System.
- At Doors with a Frame Type designation "AL", the door frame is an interior aluminum frame that is not part of a glazing system.
- At Doors with a Frame Type designation "N/A", there is no door frame required (e.g. all-glass doors, gates, etc.).
- At Doors with a Frame Type designation "REF DET", refer to the referenced Head and Jamb detail for frame information.
- At Doors with a Door Type or Frame Type designation "EX", the door or door frame is existing to remain.
- Refer to Hardware Schedule for additional information regarding hardware.
- Vision panels at non-rated interior doors shall be 1/4" clear tempered glass (CT4) U.N.O. Vision panels at interior fire-rated glass (CC4) U.N.O. Vision panels at exterior doors shall be 1" tinted tempered insulating glass (TT1) U.N.O. Refer to Glazing System Elevation Sheets for Glass Types.

DOOR SCHEDULE KEYED NOTES

- CASED OPENING
- DOUBLE EGRESS DOORS
- FIRE-RATED WIRED GLASS
- FIRE-RATED CERAMIC GLASS
- KEYED REMOVABLE MULLION
- ELECTROMAGNETIC HOLD-OPEN
- MANUAL HOLD-OPEN, FLOOR MOUNTED
- MANUAL HOLD-OPEN, OVERHEAD
- ACCESS CONTROL / CARD READER
- DOOR POSITION SWITCH
- APPLIED SOUND SEALS & THRESHOLD

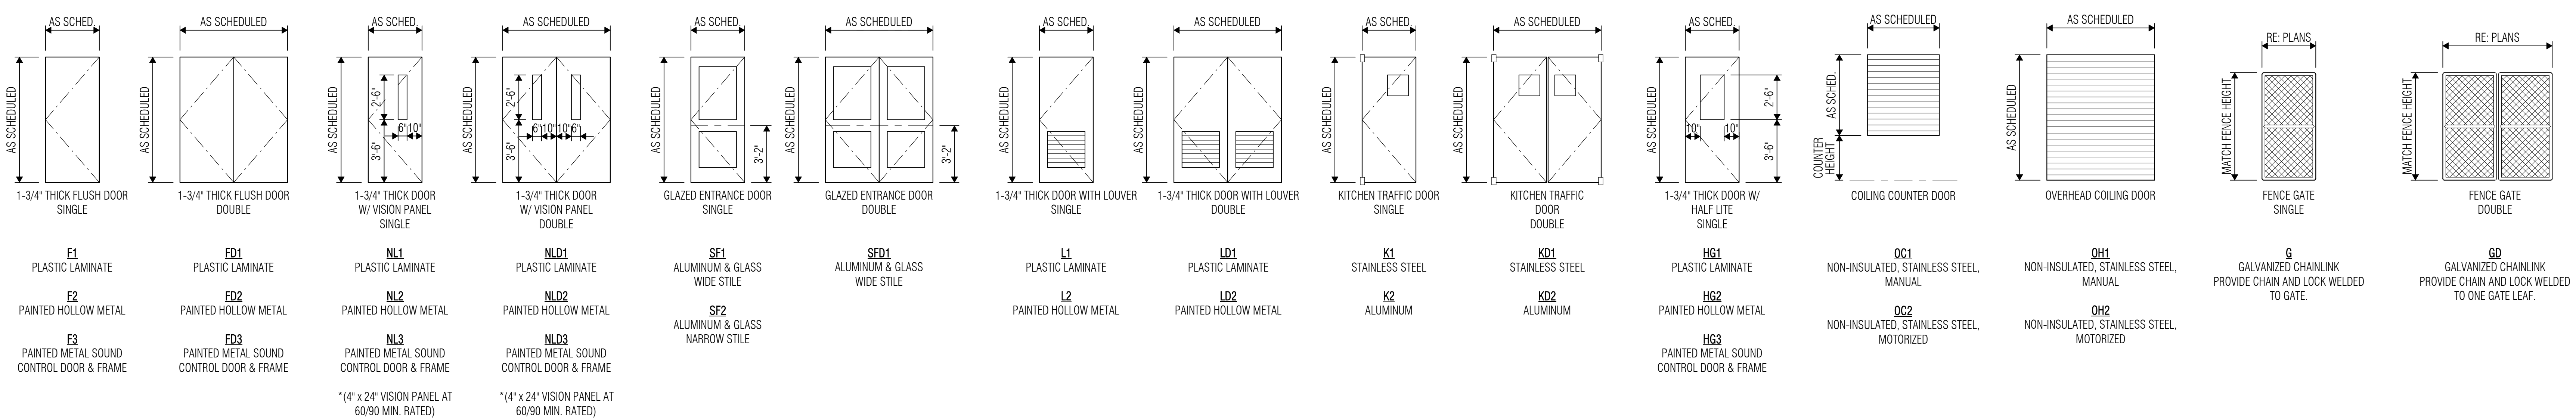


NOTE: *X-* PREFIX INDICATES AN EXISTING DOOR OR FRAME TO REMAIN.



ARCHITECT
VLK Architects
 20445 State Hwy 249, Suite 350
 Houston, Texas 77070
 Main Phone: 281.671.2300
 www.vlkarchitects.com

CYPRESS-FAIRBANKS INDEPENDENT SCHOOL DISTRICT
 HOUSTON, TEXAS

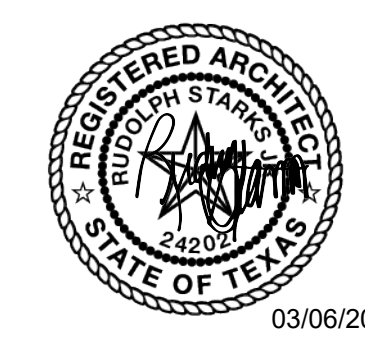


ISSUED: February 24, 2025
REVISIONS
 Revision No. Revision Date
 1 Addendum 1 03-06-2025

Director Drawn By
 RSG STH, KM
 Designer Quality Control
 QC
 Proj. Arch.
 TQ
PROJECT NO.
24-010.00
SHEET TITLE
TRUITT - DOOR TYPES, SCHEDULES, ELEVATIONS & DETAILS
SHEET NO.

A37.01


2024 Cook, Labay & Truitt MS Renovations

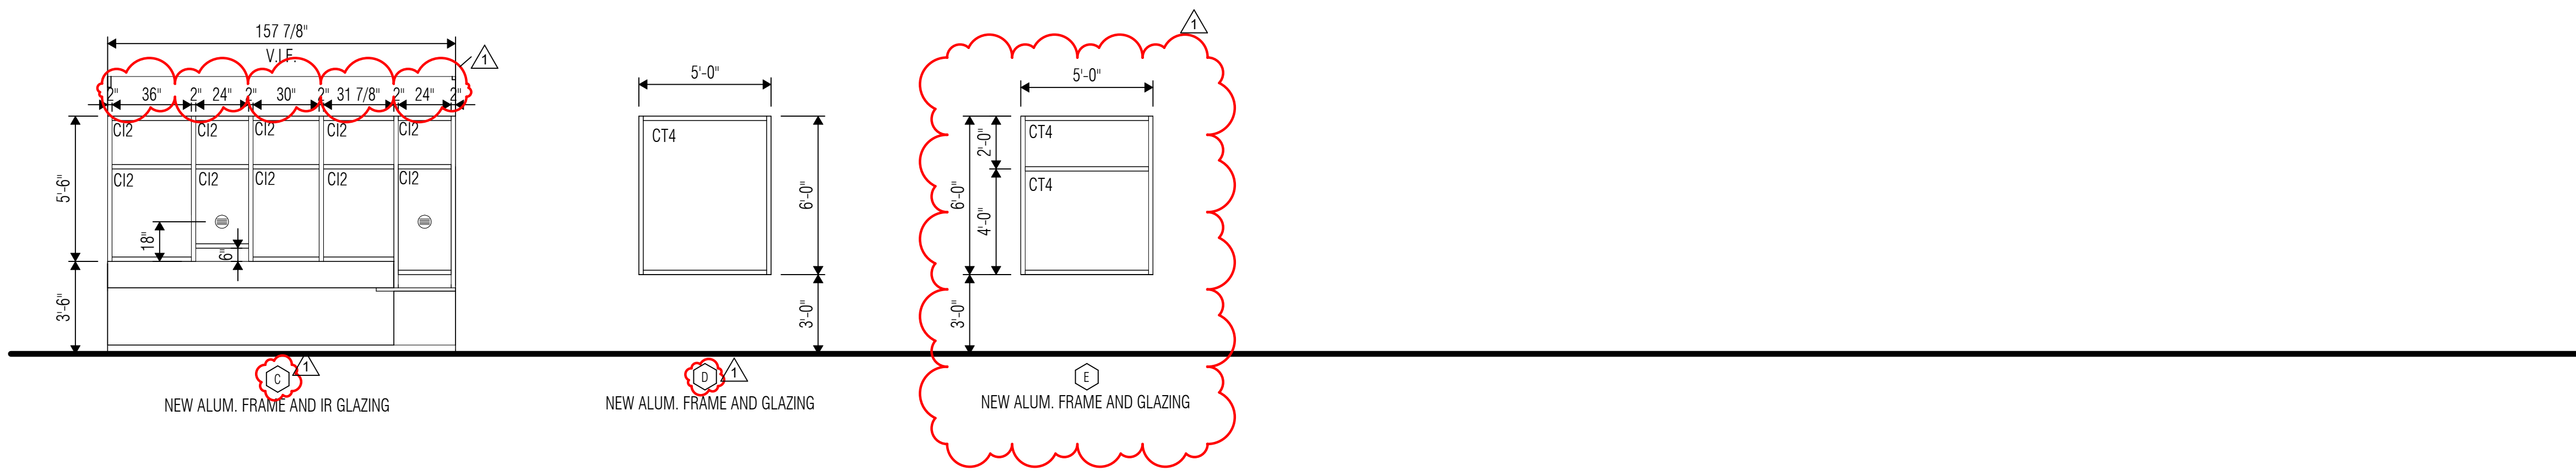

NEW ALUM. FRAME AND IR GLAZING

NEW ALUM. FRAME AND GLAZING

NEW ALUM. FRAME AND GLAZING

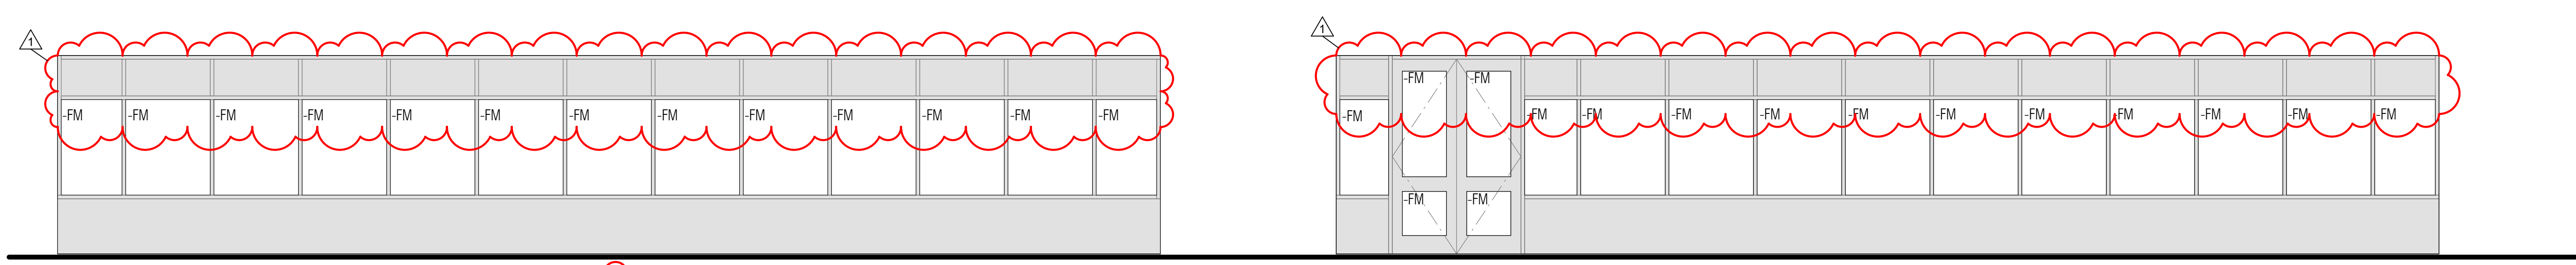

EXISTING ALUM. FRAME NEW IR GLAZING

EXISTING ALUM. FRAME NEW IR GLAZING

GLAZING SYSTEM NOTES

1. Overall dimensions of glazing system elevations reflect rough opening dimensions, inclusive of perimeter joints.
2. Provide 3/16" thick heavy wall framing members at all door frames in exterior and interior aluminum Storefront systems.
3. Provide 3/16" thick heavy wall door adapters at all door frame members in exterior and interior aluminum Curtain Wall systems.
4. Door opening dimensions in Curtain Wall systems reflect 1" door adapters at jamb conditions, and 1-3/4" door adapters at head conditions. Adjust dimensions between mullions at door openings in curtain wall systems as required for actual size of door adapters provided. Door sizes as identified in Door Schedule shall be maintained.
5. Refer to A'17.01 for Typical Push/Pull Mounting Heights Detail for aluminum/glass doors

GLASS TYPE LEGEND

- CT4 CLEAR, TEMPERED, 1/4" THICK GLASS
 - CI2 CLEAR, IMPACT-RESISTANT, 9/16" THICK LAMINATED GLASS
 - FM 23 MIL IMPACT RESISTANT FILM OVERLAY, FIELD-APPLIED TO GLAZING UP TO 7'-0" A.F.F.
 - IF A PORTION OF THE GLAZING UNIT IS ABOVE 7'-0", APPLY FILM TO THE ENTIRE GLAZING UP TO MULLION.
 - DO NOT SPLICE FILM ON INTERIOR OR EXTERIOR GLAZING UNITS.
- GLAZING SHOWN WITH GREY HATCH IS EXISTING TO REMAIN

GLAZING SYSTEM LEGEND


- STOREFRONT FRAMING WITH 3/16" THICK HEAVY WALL MATERIAL. TYPICAL AT ALL DOOR FRAME MEMBERS IN STOREFRONT GLAZING SYSTEMS.
- CURTAIN WALL FRAMING WITH STEEL REINFORCING PROVIDED BY MANUFACTURER.



ARCHITECT

VLK Architects
 20445 State Hwy 249, Suite 350
 Houston, Texas 77070
 Main Phone: 281.671.2300
 www.vlkarchitects.com

CYPRESS-FAIRBANKS INDEPENDENT SCHOOL DISTRICT HOUSTON, TEXAS

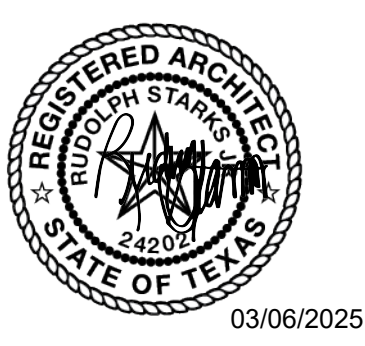

ISSUED: February 24, 2025

REVISIONS	
Revision No.	Revision Date
1 Addendum 1	03-06-2025

Director: RSJ
 Designer: TQ
 Drawn By: STH, KM
 Quality Control: STH, KM

Proj. Arch.: TQ





PROJECT NO.
24-010.00

SHEET TITLE
TRUITT - GLAZING ASSEMBLY TYPES, SCHEDULES, ELEVATIONS & DETAILS

SHEET NO.

A37.11

2024 Cook, Labay & Truitt MS Renovations

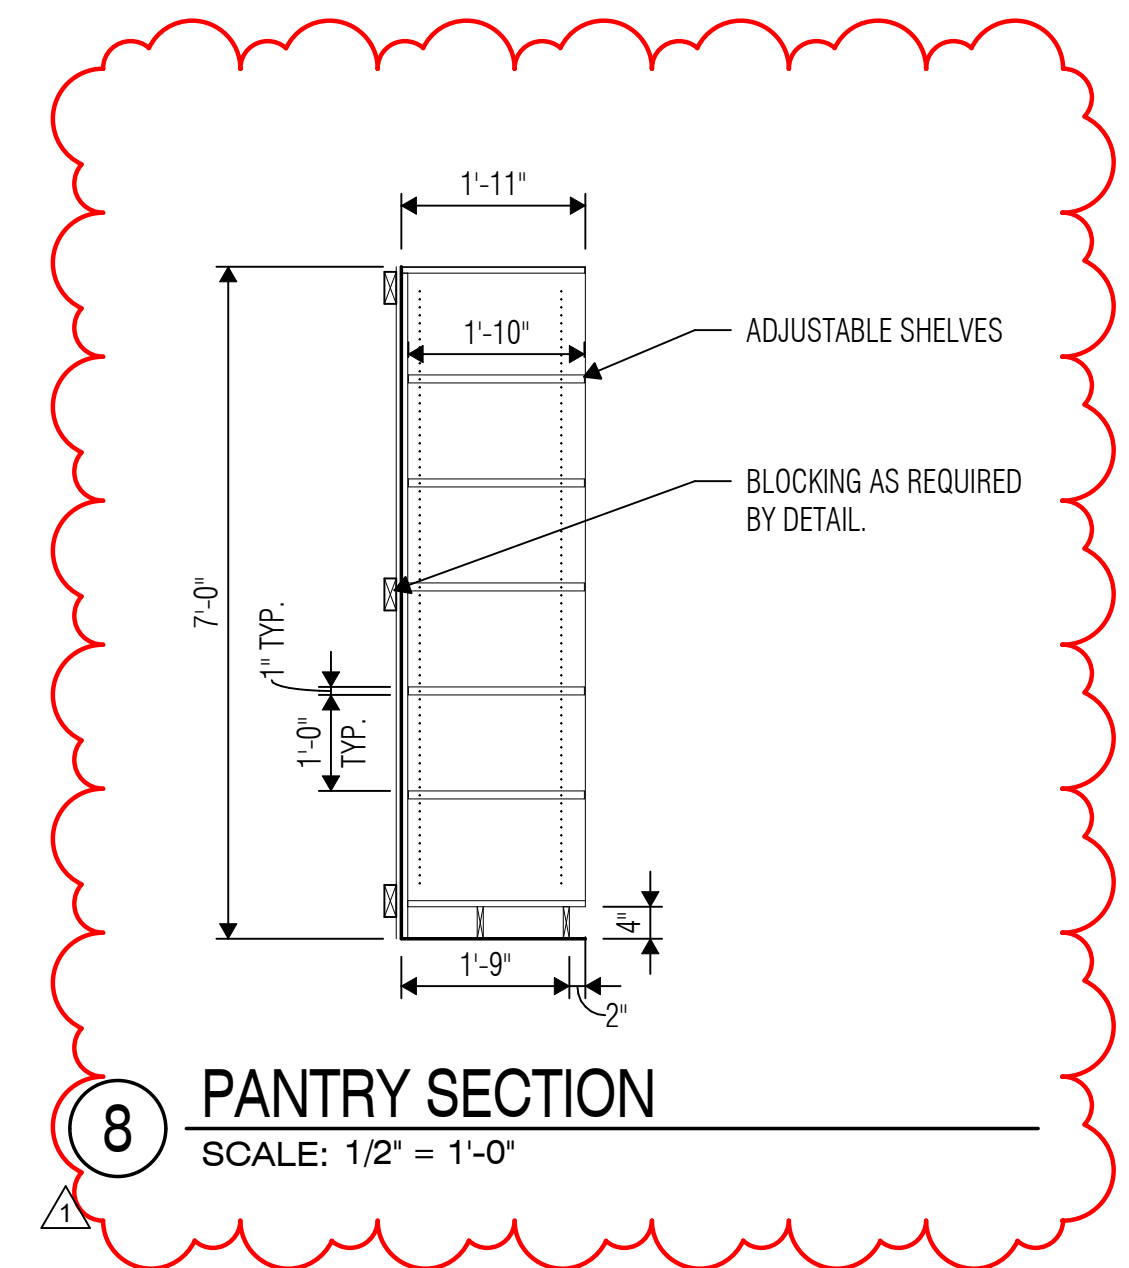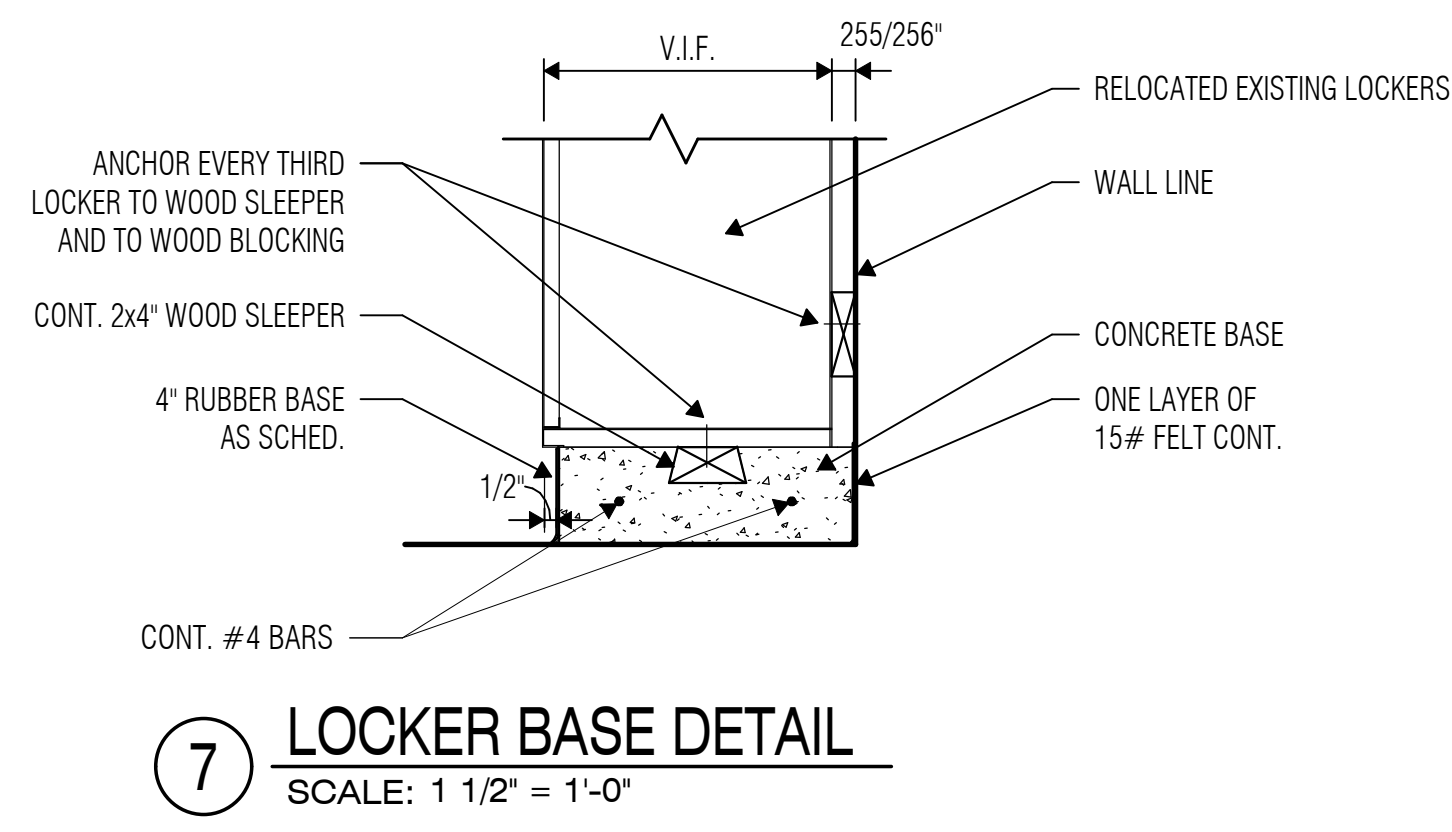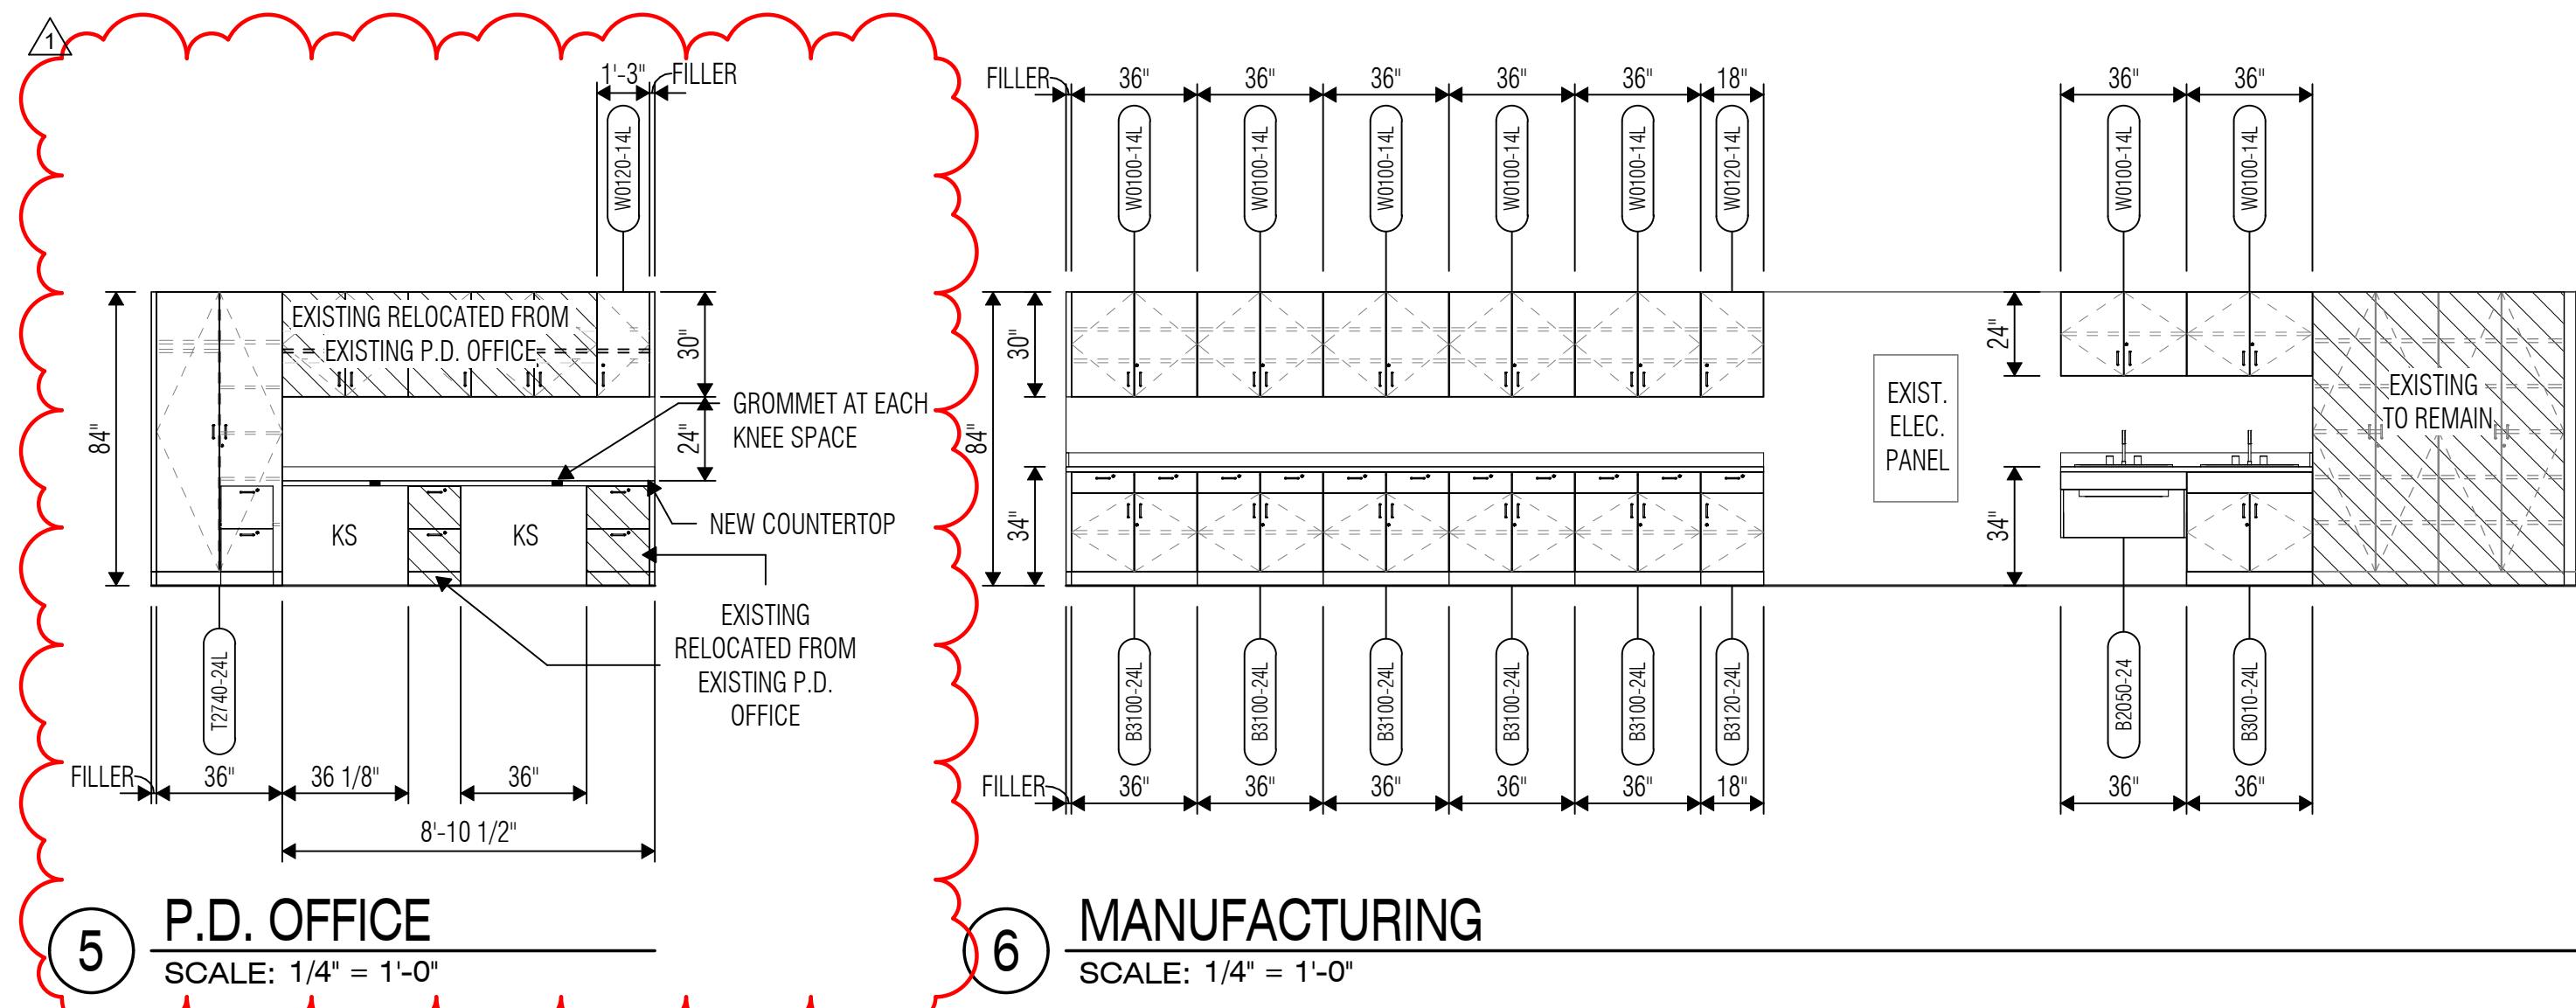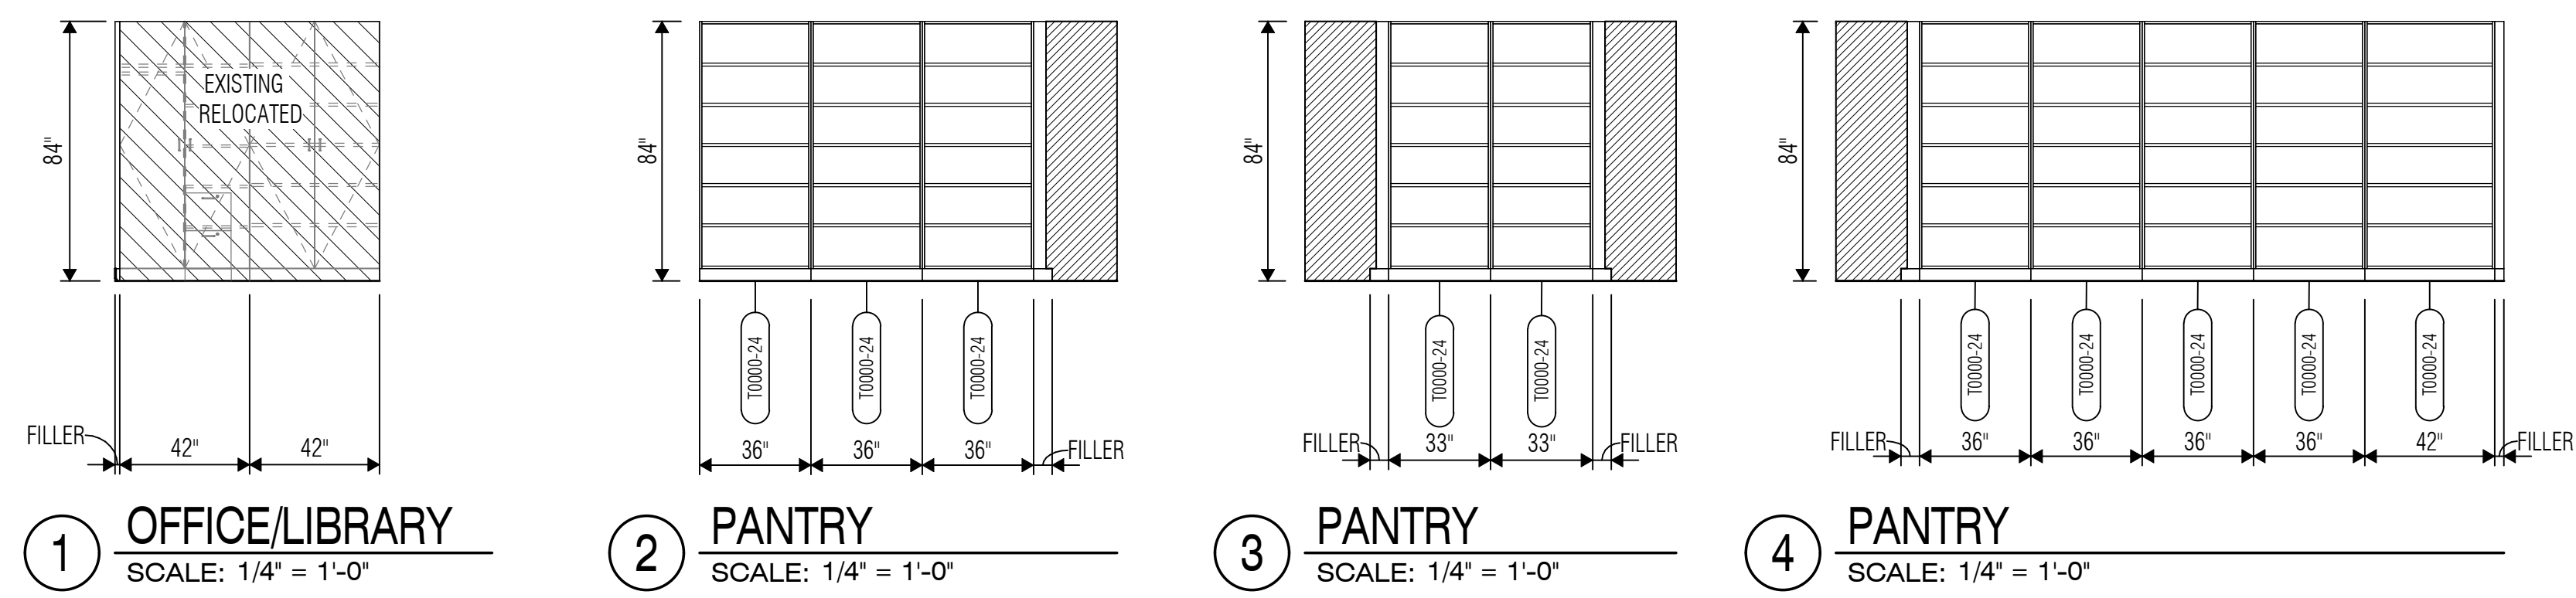

CASEWORK NOTES

1. Casework shall meet criteria set forth in Americans with Disabilities Act and Texas Accessibility Standards.
2. All casework model numbers are based on Case Systems, Inc. Refer to casework elevations for height and width of each unit.
3. Coordinate locations of electrical and/or plumbing within casework and millwork. Notify Architect of any conflicts prior to installation.
4. Coordinate all column locations prior to installation of casework.
5. Refer to Floor Plan Notes for blocking requirements at stud partitions.
6. All adjustable shelves longer than 2'-3", and shelves of any length at open shelving units, shall be 1" thick.
7. Provide finished surface on all exposed surfaces.
8. Plastic Laminate on all casework shall be PL - U.N.O.
9. Provide fillers and finished end panels (F.E.) as required. Refer to Typical Casework Details for filler requirements.
10. Provide locks on all doors and drawers as indicated.
11. All counters shall have 4" high splashes, U.N.O.
12. At countertop locations, no joints in plastic laminate should occur over knee spaces, or within 24 inches of sinks and lavatories.
13. Casework cabinet doors and drawers shall be flush overlay.
14. Base cabinets should not extend to floor. Sub-base shall be separate and recessed 1/2" at sides of cabinet to receive rubber base.
15. Provide 1-1/2" thick divider panel between knee spaces and adjacent spaces (e.g. dishwasher openings, other knee spaces, etc.).
16. At front of casework, countertops shall extend 1/2" over base cabinet door/drawer (approximately 1-1/2" over base cabinet body). At ends of casework, countertops shall extend 1/2" over base cabinet body. Refer to Typical Casework Details.
17. Provide custom height at all file-size drawers to be a minimum of 1'-0" deep. Provide locks at all file-size drawers.

C.S.I. CATALOG CASEWORK NUMBER: XXXXXX-24L3
 M = MODIFIED FROM STANDARD CATALOG SELECTION
 V = LIGHT VALANCE PANEL (C.S.I. #R9600-03)
 L = LOCKED CABINET

NOTE:
 1. The height indicated at base cabinets includes the countertop.



ISSUED: February 24, 2025

REVISIONS

Revision No.	Revision Date
1 Addendum 1	03-06-2025

Director: RSJ
 Designer: STH, KM

Drawn By: STH, KM
 Quality Control: STH, KM



Proj. Arch. TQ

PROJECT NO.
24-010.00

SHEET TITLE
TRUITT - CASEWORK ELEVATIONS & DETAILS

SHEET NO.

A38.01

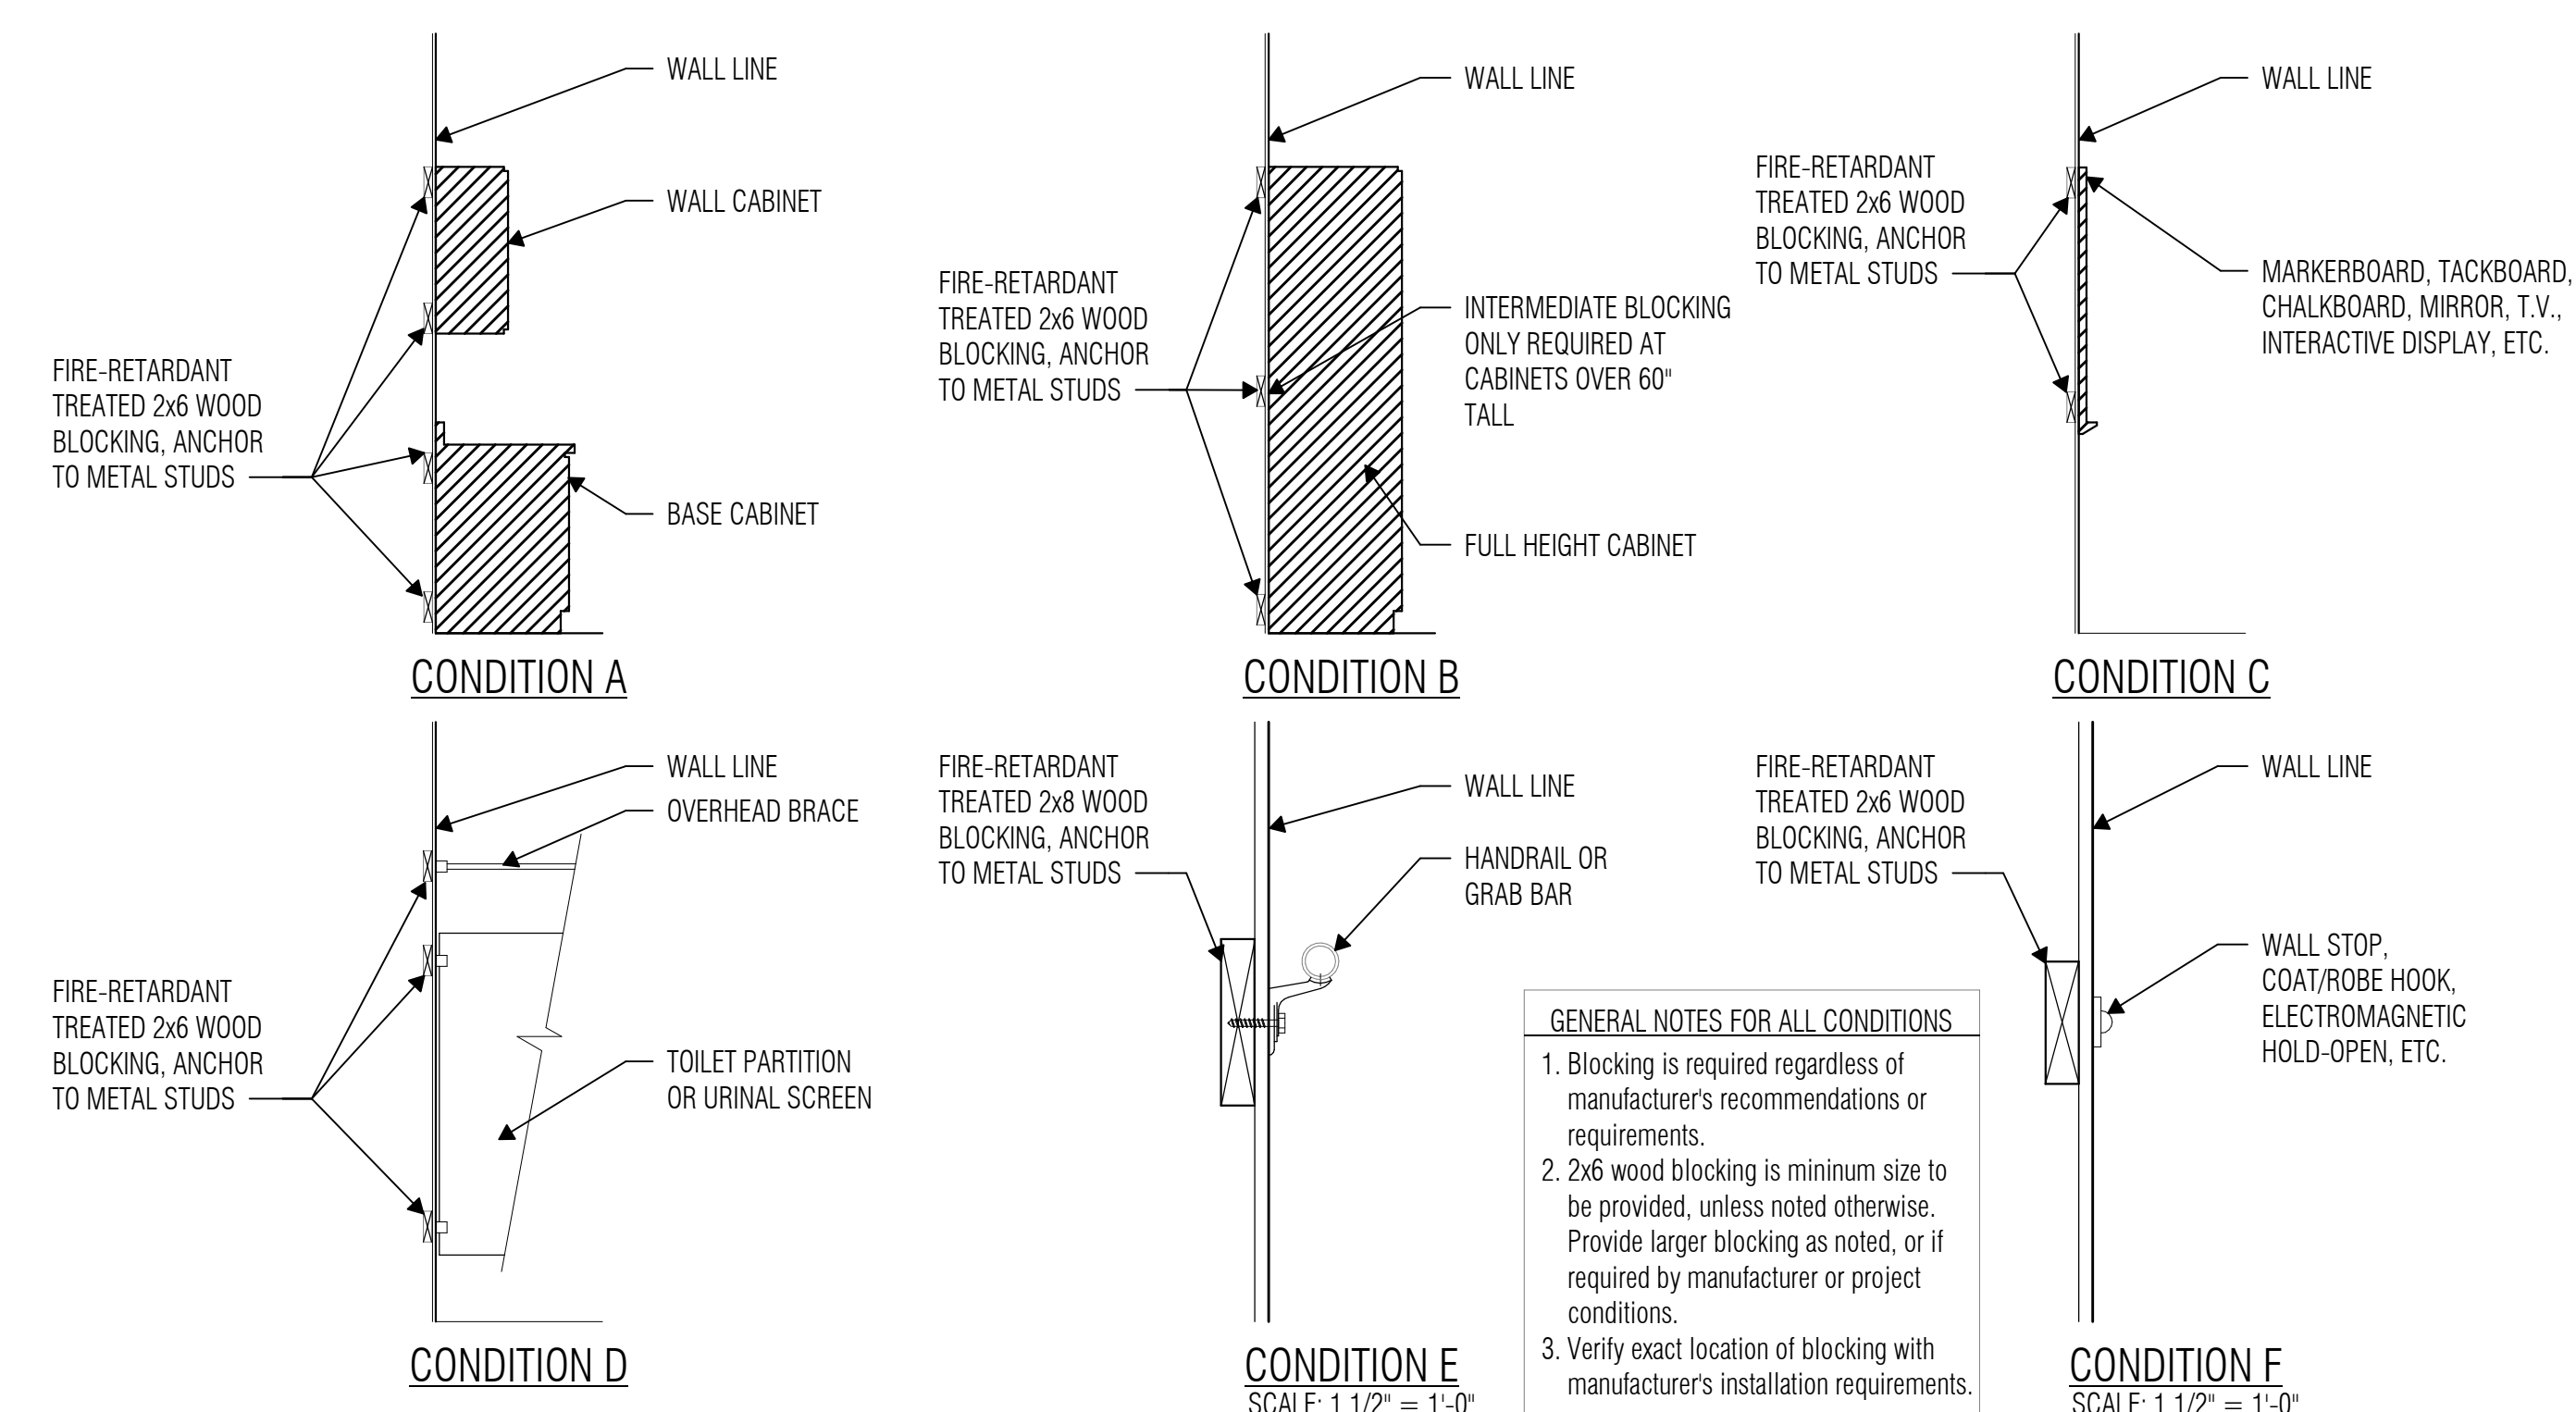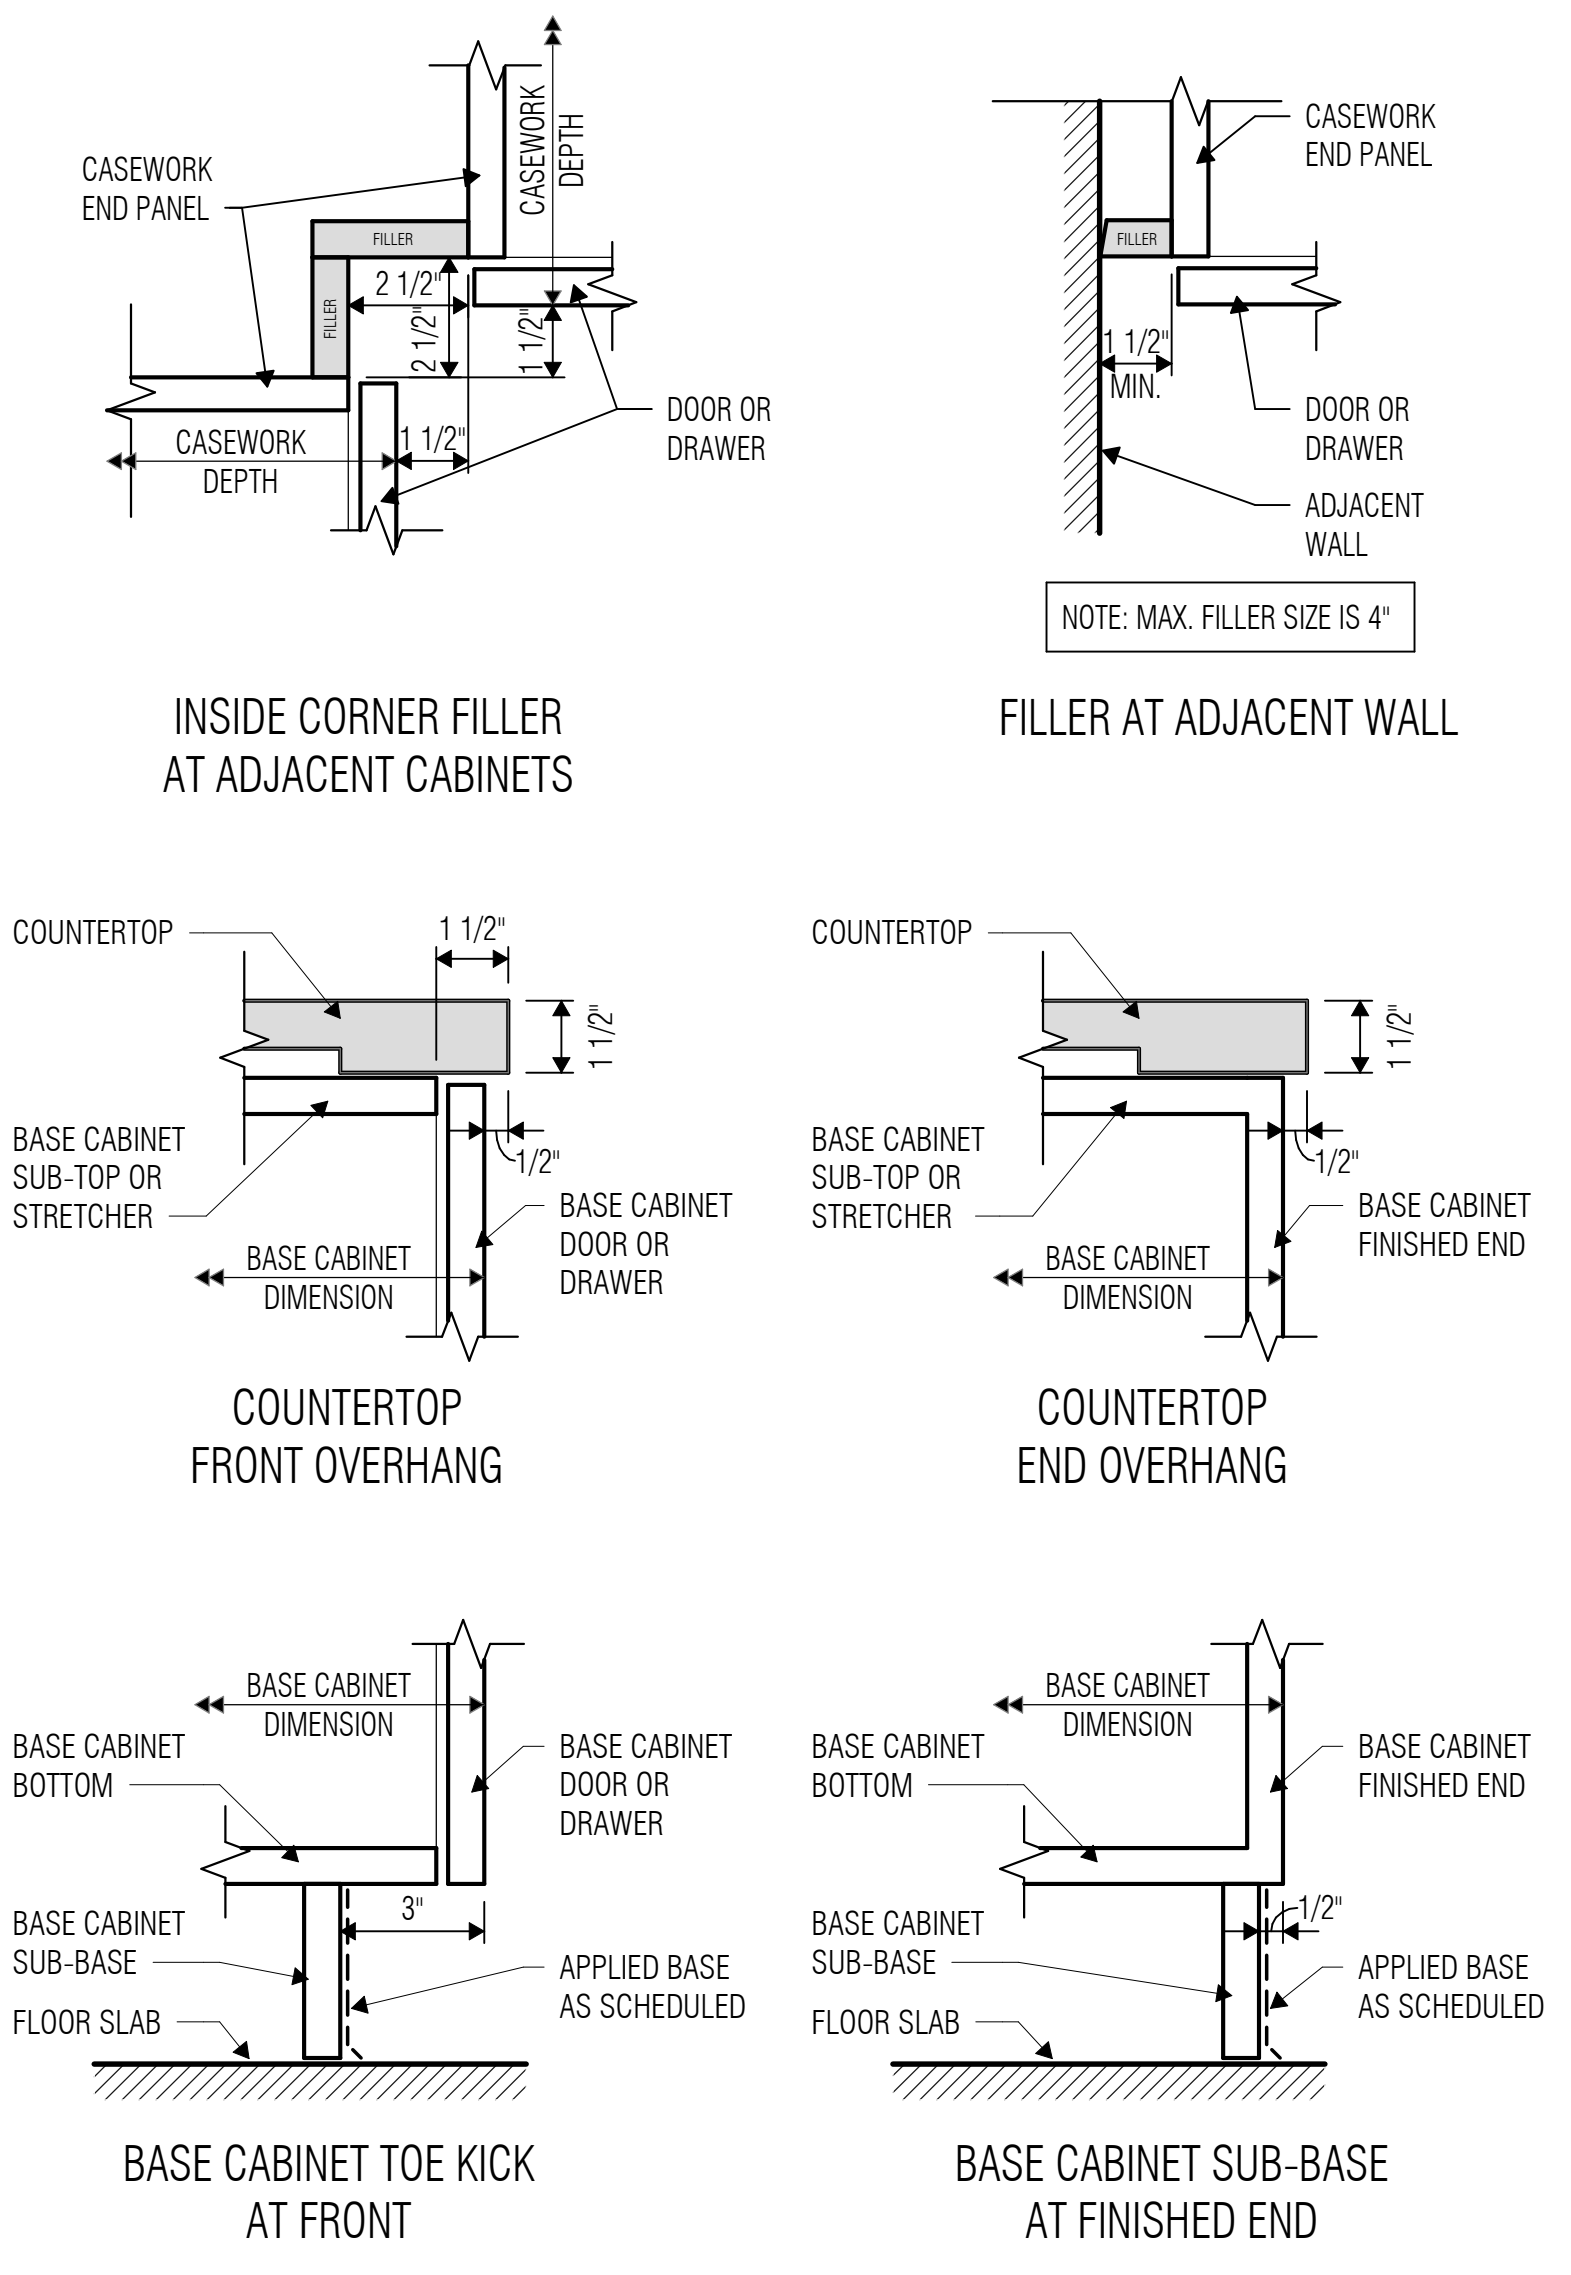

FINISH ACCESSORY, FURNITURE AND EQUIPMENT SCHEDULE

NOTE: ALL MATERIALS, PRODUCTS, SIZES, COLORS AND PATTERNS ARE THE BASIS OF DESIGN. REFERENCE PROJECT MANUAL FOR ADDITIONAL APPROVED MANUFACTURERS MEETING THE DESIGN INTENT. SUBSTITUTIONS WILL BE CONSIDERED WHEN SUBMITTED IN COMPLIANCE WITH SECTION 01 62 00 – PRODUCT OPTIONS.

MARK	DESCRIPTION	SPEC SECTION	MANUFACTURER INFO			SIZE	COMMENTS
			MANUFACTURER	SERIES/STYLE	COLOR/FINISH		
PTD				-		-	
EXTERIOR EQUIPMENT AND SPECIALTIES							
EJ	Expansion Joint Covers	07 95 00		As Specified		-	
PJS	PREFORMED JOINT SEAL	07 95 00		-		-	PREFORMED JOINT SEAL
EXTERIOR FINISH ACCESSORY							
EFA-01	PREFINISHED METAL TRIM	07 42 13		As Specified		-	
EFA-02	FIBER CEMENT TRIM	07 46 46		As Specified		-	
EFA-03	WOOD TRIM	07 46 23		As Specified		-	
FLOOR FINISH ACCESSORY							
FFA-01	FLOOR TRANSITION	09 68 00	Johnsonite	Wheeled Traffic Transition	Black 40	--	RF to CPT. Provide floor transition to match flooring thickness.
FFA-02	FLOOR TRANSITION	09 68 00	Johnsonite	Slim Line Transition	Black	--	CPT to EXIST. Provide floor transition to match flooring thickness.
MILLWORK FINISH ACCESSORY							
MFA-01	MILLWORK REVEAL	09 21 16	Fry Reglet	Millwork Profiles/Millwork U Channel	To be selected by architect.	1/2"	At Reception Desk refer to Casework Elevations for details.
MISC.							
BV	BRICK VENT	05 50 00		As Specified		-	
CB	CONCRETE BOLLARD	12 93 00		As Specified		-	
DN	DOWNSPOUT NOZZLE	DIVISION 22		As Specified		-	
JSE	EXTERIOR JOINT SEALANT	07 92 00		As Specified		-	
L	LOUVER	08 91 00		As Specified		-	
SPECIALTY EQUIPMENT							
ATH	Athletic Wall Pads	11 66 00		As Specified			AT LABAY
FEC	Fire Extinguisher Cabinet	10 44 13		As Specified		-	
HB	Horizontal Blinds	12 21 13		As Specified			
ID	IDENTIFYING DEVICES	10 14 00		As Specified			
MB	Markerboard - Premanufactured	10 11 16		As Specified			
PC-01	Platform Stage Curtain	10 21 23	KM Fabrics	Charisma	Black		COOK
PC-02	Platform Stage Curtain	10 21 23	KM Fabrics	Charisma	Navy		LABAY/TRUITT
TB	Tackboard	10 11 16		As Specified			

MATERIAL FINISH SCHEDULE

NOTE: ALL MATERIALS, PRODUCTS, SIZES, COLORS AND PATTERNS ARE THE BASIS OF DESIGN. REFERENCE PROJECT MANUAL FOR ADDITIONAL APPROVED MANUFACTURERS MEETING THE DESIGN INTENT. SUBSTITUTIONS WILL BE CONSIDERED WHEN SUBMITTED IN COMPLIANCE WITH SECTION 01 62 00 – PRODUCT OPTIONS.

MARK	DESCRIPTION	SPEC SECTION	MANUFACTURER INFO			SIZE	COMMENTS
			MANUFACTURER	SERIES/STYLE	COLOR/FINISH		
BASE FINISH							
BC	Base, Rubber Cove	09 65 00	Roppe	700 Series - Standard	193 Black Brown	4'	
PT-03	Paint - Base	09 91 00	Sherwin Williams	--	Architect to Select	VIF	Contractor to paint base at new CMU walls. Base height to align to adjacent existing base.
CEILING FINISH							
ACT-01	Acoustic Ceiling Tile (24X24)	09 51 00	Armstrong	School Zone Fine Fissued	White	24" X 24"	
ACT-02	Acoustic Ceiling Tile (24X24) - High NRC - New Tiles Only	09 51 00	Armstrong	Calla 2820	White	24" X 24"	
ACT-03	Acoustic Ceiling Tile (24X24) - High NRC	09 51 00	Armstrong	Calla 2820	White	24" X 24"	
EXTERIOR FINISH							
MA-01	< varies >	04 20 00	ACME		50% Burnt Pumpkin / 50% Med Orchid		
MP-01	Metal - Panel	07 42 13	Berridge		Architect to Select		Athletic Storage
MP-02	Metal - Roofing	07 42 13	Berridge		Architect to Select		Athletic Storage
FLOOR FINISH							
CPT-01	Carpet - Field	09 68 00	Tarkett	Aftermath II	Tapestry 23512	Roll	
CPT-02	Carpet - Existing Band	09 68 00	Tarkett	Aftermath II	Mineral 23519	Roll	
RF-01	Resilient Floor - Field	09 65 44	Forbo	Marmoleum	629 Eiger	13' X 13"	
RF-02	Resilient Floor - Accent	09 65 44	Forbo	To be selected by architect.	To be selected by architect.	To be selected by architect.	
MILLWORK & ARCHITECTURAL FINISHES							
PL-01	Plastic Laminate - Vertical	12 32 16	Wilsonart	Vertical Laminate - Type 335	Asian Night 7949K-18		Run Wood Grain Vertical.
PL-02	Plastic Laminate - Horizontal	12 32 16	Wilsonart	General Laminate - Type 107	Natural Cotton 4946-38		
QTZ-01	Quartz surface - Counters	12 36 61.19	Wilsonart	Quartz	Lyra Q2001		
QTZ-02	Quartz surface - Window Sills	12 36 61.19	Cambria	Classic Series	Templeton		
WALL FINISH							
AWP-01	AWP - Goose	09 84 13	Gullford of Maine	Anchorage 2335	2049 Goose	--	
AWP-02	AWP - Quarry Blue	09 84 13	Gullford of Maine	Anchorage 2335	2049 Quarry Blue	--	
PT-01	Paint - Field	09 91 00	Sherwin Williams	--	Grayish SW6001	--	
PT-02	Paint - Dark Gray Accent	09 91 00	Sherwin Williams	--	Iron Ore SW7069	--	



ARCHITECT

VLK Architects
 20445 State Hwy 249, Suite 350
 Houston, Texas 77070
 Main Phone: 281.671.2300
 www.vlkarchitects.com

CYPRESS-FAIRBANKS INDEPENDENT SCHOOL DISTRICT HOUSTON, TEXAS



ISSUED: February 24, 2025

REVISIONS

Revision No.	Revision Date
1 Addendum 1	03-06-2025

Director
RSJ
Designer

Drawn By
STH, KM
Quality Control

Proj. Arch.
TQ

PROJECT NO.

24-010.00

SHEET TITLE

TRUITT - MATERIAL FINISH SCHEDULES

SHEET NO.

A39.01

2024 Cook, Labay & Truitt MS Renovations

ROOM FINISH SCHEDULE

LEVEL	ROOM NUMBER	ROOM NAME	FLOOR	BASE	WALL	COMMENTS
LEVEL ONE						
TRUITT - UNIT A						
LEVEL ONE	511	OFFICE/LIBRARY	CPT	BC	PT	Truitt
LEVEL ONE	512A	INSTRUMENT STORAGE	RF	BC	PT	Truitt
LEVEL ONE	512	ENSEMBLE	CPT	BC	PT	Truitt
LEVEL ONE	510A	CORRIDOR	CPT	BC	PT	Truitt
LEVEL ONE	510	ORCHESTRA	CPT	BC	PT	Truitt
LEVEL ONE	520	BAND	EXST	BC	PT	Truitt
LEVEL ONE	500	CHOIR	EXST	BC	PT	Truitt
LEVEL ONE	513	PRACTICE	CPT	BC	PT	Truitt
TRUITT - UNIT C						
LEVEL ONE	C000	ENTRY VESTIBULE	EXST	EXST	EXST	Truitt
LEVEL ONE	400A	CHECK-IN	EXST	EXST	EXST	Truitt
LEVEL ONE	400	CONFERENCE	EXST	EXST	EXST	Truitt
LEVEL ONE	410	FINANCE	CPT	BC	PT	Truitt
LEVEL ONE	410A	WORKROOM	CPT	BC	PT	Truitt
LEVEL ONE	410B	STORAGE	CPT	BC	PT	Truitt
TRUITT - UNIT D.1						
LEVEL ONE	301	CULINARY LAB	RF	BC	PT	Truitt
LEVEL ONE	303	SEWING LAB	RF	BC	PT	Truitt
LEVEL ONE	303A	STORAGE	RF	BC	PT	Truitt
LEVEL ONE	303B	LAUNDRY	EXST	BC	PT	Truitt
LEVEL ONE	302	OFFICE	CPT	BC	PT	Truitt
LEVEL ONE	301A	PANTRY	RF	BC	PT	Truitt
LEVEL ONE	146	P.D. OFFICE	CPT	BC	PT	Truitt
TRUITT - UNIT D.2						
LEVEL ONE	316	MANUFACTURING	EXST	BC	PT	Truitt
LEVEL ONE	313	SHOP	EXST	BC	PT	Truitt

FINISH SCHEDULE NOTES

- General Finish Notes**
 - Any finish conflict between finish schedules and finish floor plans to be brought to the architect's attention for resolution.
 - Existing doors and operable window hardware shall be cleaned of all dirt and non-original paint.
 - Plastic Laminate**
 - Typical Casework/Millwork cabinet body, doors, and drawer fronts shall be PL-01, unless noted otherwise.
 - Countertops shall be PL-02.
 - Interior Plastic Laminate clad wood doors to be PL-01.
 - All New and Existing Window Sills shall be QTZ-02.
 - All remaining casework shall have finished ends to match PL-01.
 - Ceiling Finishes**
 - Refer to Reflected Ceiling Plans for scheduled finish.
 - At ceilings with exposed structure, all exposed elements shall be painted the scheduled color, including mechanical ductwork, electrical, piping, conduit, j-boxes, etc.
 - All interior gyp. bd. ceilings to be painted PT-01, unless noted otherwise.
 - All interior gyp. bd. furr-downs to be painted PT-01, unless noted otherwise.
 - Floor Finishes**
 - All substrates receiving new flooring shall be clean of all adhesives and leveled as required to meet the installation recommendations of the flooring manufacturer.
 - Refer to Interior Finish Plans for floor finish patterns.
 - Refer to Interior Finish Plans for tile origin in each room. If origin point is not indicated, center in middle of the room or corridor.
 - All changes in floor material between rooms shall occur at centerline of doorway, unless noted otherwise.
 - Level and float flooring at public corridor walls.
 - All toilets and other areas capable of water mitigation shall have a 2" x 1/2" marble threshold with double 1/4" bevel edge. The thresholds shall be held in place with thin set.
 - Sealant color shall match adjacent material.
 - Typical flooring application at brick walls:
 - LVT: Rake brick joint at floor level and install sealant between LVT and brick.
 - Carpet: Rake brick joint at floor level and tuck carpet tight into raked brick joint.
 - Wall Finishes**
 - Finishes shall continue to inside corner, unless noted otherwise.
 - At painted CMU base, paint as indicated in drawings.
- Paint Information:**
- Interior Paint**
 - New interior walls and existing walls within area of work are to be painted PT-01 in their entirety, unless noted otherwise.
 - All interior sealants shall be painted to match adjacent wall.
 - Hollow Metal Doors and Windows**
 - Hollow metal doors to be painted PT-02, unless noted otherwise.
 - Hollow metal door frames and vision panel frames shall be painted PT-02, unless noted otherwise.
 - At door frames with 2 different colors, transition color at inside corner of door stop, on the door side of the stop.
 - Hollow metal glazed opening frames shall be painted PT-02, unless noted otherwise.



ARCHITECT

VLK Architects
 20445 State Hwy 249, Suite 350
 Houston, Texas 77070
 Main Phone: 281.671.2300
 www.vlkarchitects.com

CYPRESS-FAIRBANKS INDEPENDENT SCHOOL DISTRICT
 HOUSTON, TEXAS



03/06/2025

ISSUED: February 24, 2025

REVISIONS

Revision No.	Revision Date
1 Addendum 1	03-06-2025

Director
 RSJ
 Designer

Drawn By
 STH, KM
 Quality Control

Proj. Arch.
 TQ

PROJECT NO.

24-010.00


SHEET TITLE

TRUITT - ROOM FINISH
 SCHEDULE

SHEET NO.

A39.02

2024 Cook, Labay & Truitt MS Renovations

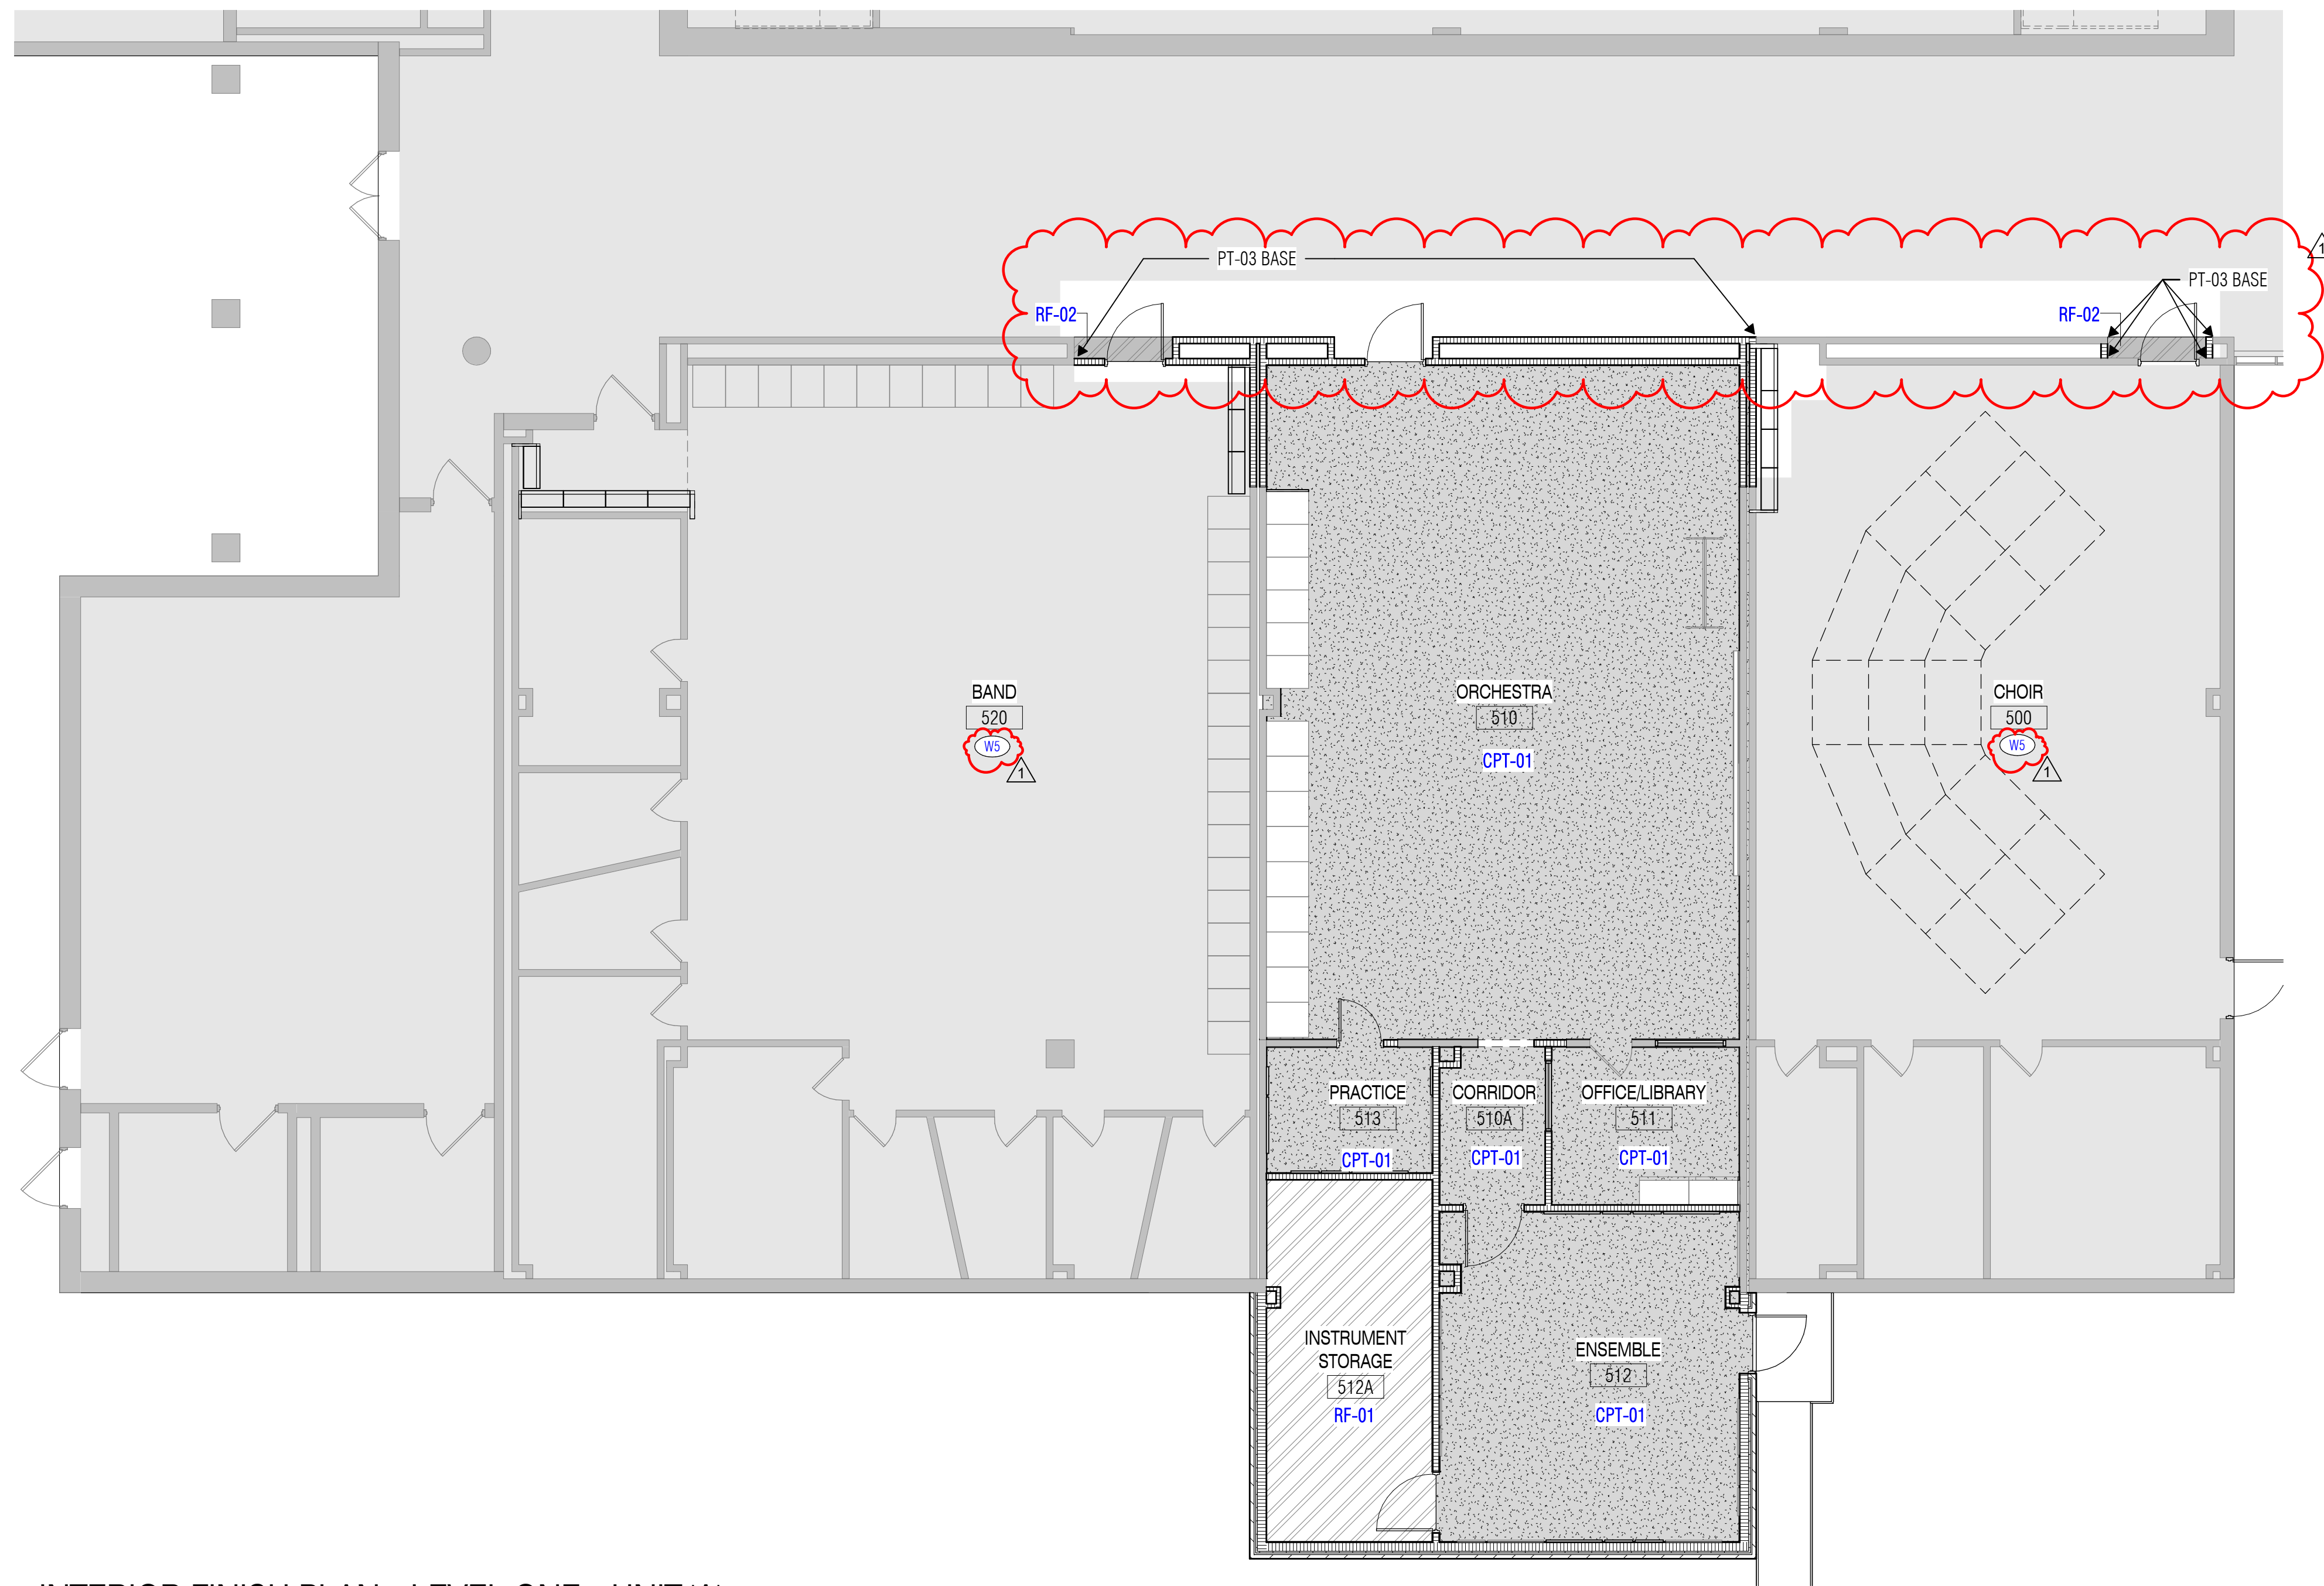


1 INTERIOR FINISH PLAN - LEVEL ONE - UNIT 'A'
SCALE: 1/8" = 1'-0"

INTERIOR FINISH LEGEND		
	CO-01	CONCRETE - SEALED
	CO-02	CONCRETE - POLISHED
	CPT-01	CARPET - FIELD
	CPT-02	CARPET - ACCENT
	RF-01	RESILIENT FLOOR - FIELD
	RF-02	RESILIENT FLOOR - ACCENT
	EXISTING TO REMAIN WITH LIMITED OR NO INTERIOR FINISH WORK REQUIRED IN THIS AREA. REFER TO CIVIL, MEPT AND STRUCTURAL DRAWINGS FOR ANY ADDITIONAL WORK IN AREA.	
	W5 CONTRACTOR TO PAINT PT-01 TO 9' AFF. AT ALL EXISTING WALLS AND TO PAINT NEW WALLS PT-01 TO FULL EXTENTS. PROTECT AND PAINT AROUND ALL EXISTING MARKERBOARDS, TACKBOARDS, ACOUSTIC PANELS, CASEWORK, DISPLAY CASES, ETC.	



ARCHITECT
VLK Architects
 20445 State Hwy 249, Suite 350
 Houston, Texas 77070
 Main Phone: 281.671.2300
 www.vlkarchitects.com

CYPRESS-FAIRBANKS INDEPENDENT SCHOOL DISTRICT
HOUSTON, TEXAS

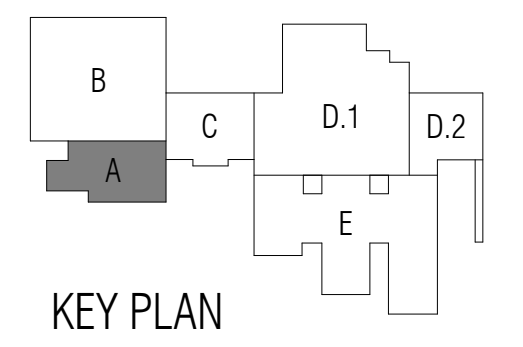

ISSUED: February 24, 2025

REVISIONS		
Revision No.	Revision Description	Revision Date
1	Addendum 1	03-06-2025

Director: RSJ
 Designer: STH, KM
 Drawn By: STH, KM
 Quality Control: STH, KM

Proj. Arch.: TQ


PROJECT NO.
24-010.00

SHEET TITLE
TRUITT - INTERIOR FINISH PLAN - LEVEL ONE - UNIT A

SHEET NO.

A39.11A

2024 Cook, Labay & Truitt MS Renovations

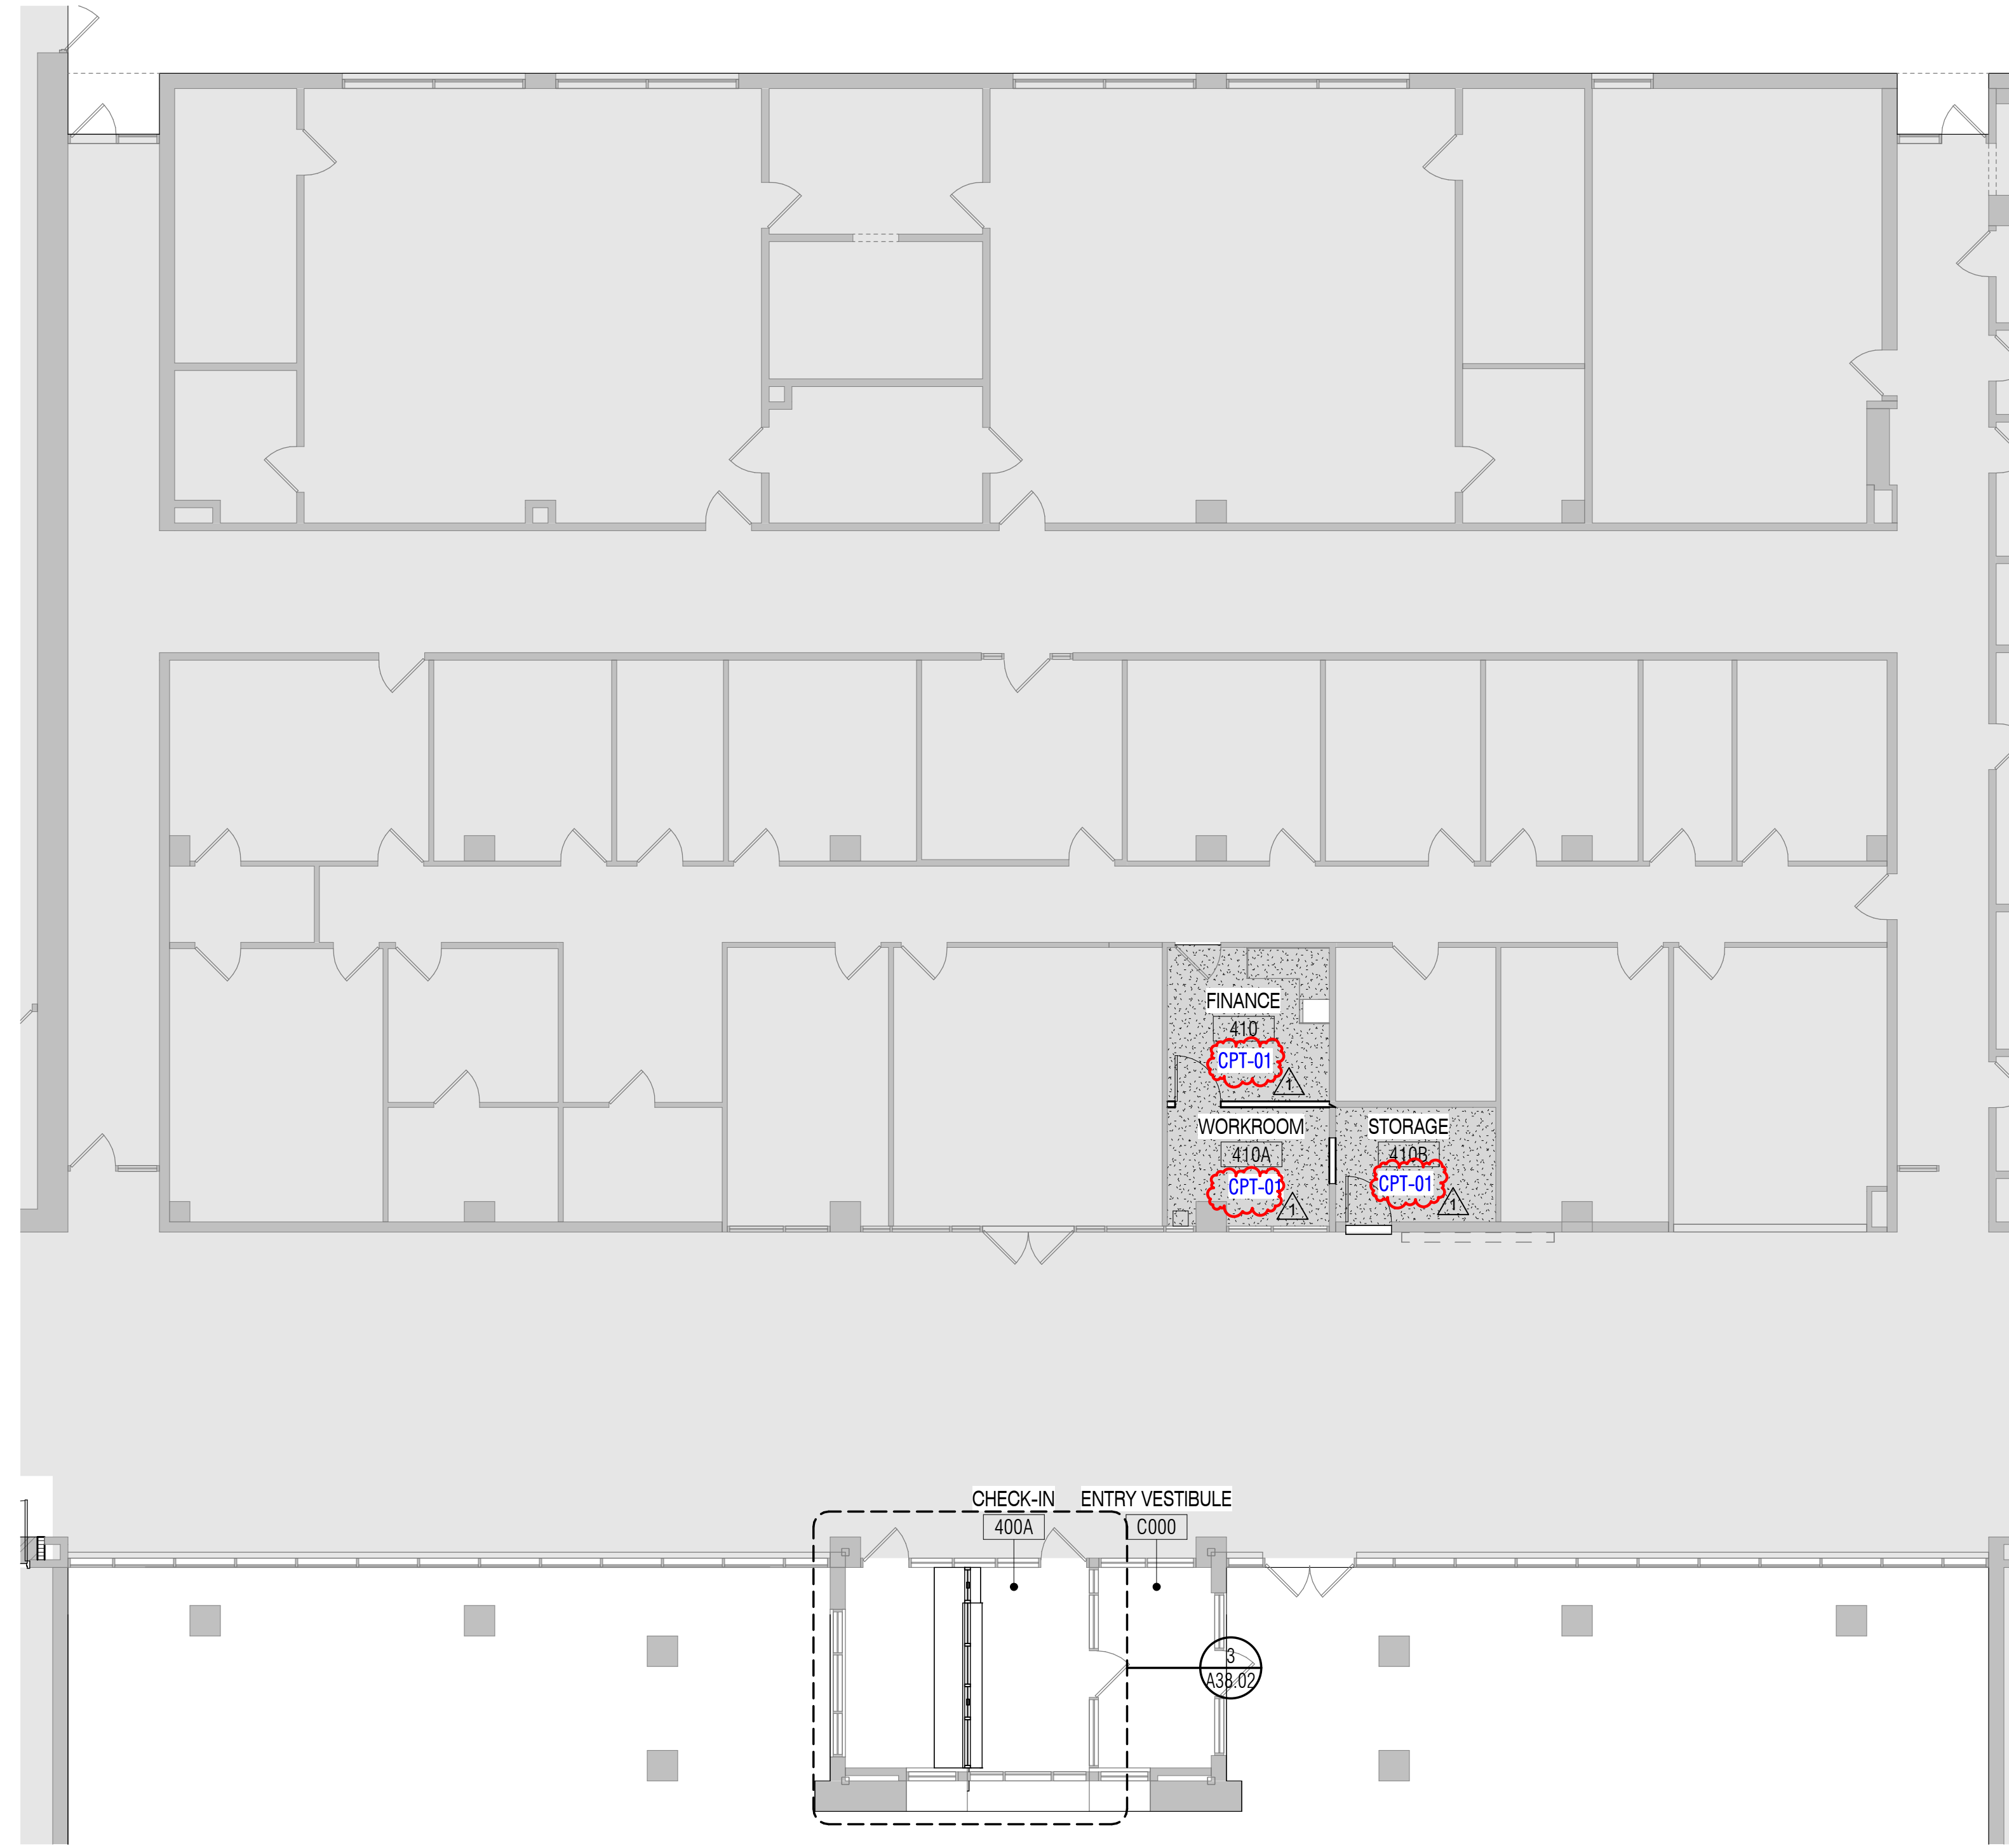

1 INTERIOR FINISH PLAN - LEVEL ONE - UNIT 'C'
SCALE: 1/8" = 1'-0"


INTERIOR FINISH LEGEND		
	CO-01	CONCRETE - SEALED
	CO-02	CONCRETE - POLISHED
	CPT-01	CARPET - FIELD
	CPT-02	CARPET - ACCENT
	RF-01	RESILIENT FLOOR - FIELD
	RF-02	RESILIENT FLOOR - ACCENT
	EXISTING TO REMAIN WITH LIMITED OR NO INTERIOR FINISH WORK REQUIRED IN THIS AREA. REFER TO CIVIL, MEPT AND STRUCTURAL DRAWINGS FOR ANY ADDITIONAL WORK IN AREA.	



ARCHITECT

VLK Architects
20445 State Hwy 249, Suite 350
Houston, Texas 77070
Main Phone: 281.671.2300
www.vlkarchitects.com

CYPRESS-FAIRBANKS INDEPENDENT SCHOOL DISTRICT
HOUSTON, TEXAS

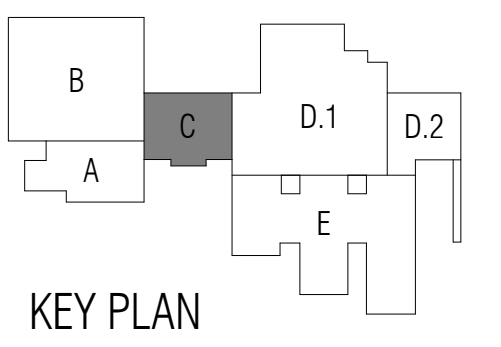

ISSUED: February 24, 2025

REVISIONS

Revision No.	Revision Date
1 Addendum 1	03-06-2025

Director: RSJ
Designer: STH, KM
Quality Control

Proj. Arch.: TQ

PROJECT NO.

24-010.00

SHEET TITLE




TRUITT - INTERIOR FINISH
PLAN - LEVEL ONE - UNIT C

SHEET NO.

A39.11C

2024 Cook, Labay & Truitt MS Renovations

INTERIOR FINISH LEGEND		
	CO-01	CONCRETE - SEALED
	CO-02	CONCRETE - POLISHED
	CPT-01	CARPET - FIELD
	CPT-02	CARPET - ACCENT
	RF-01	RESILIENT FLOOR - FIELD
	RF-02	RESILIENT FLOOR - ACCENT
		EXISTING TO REMAIN WITH LIMITED OR NO INTERIOR FINISH WORK REQUIRED IN THIS AREA. REFER TO CIVIL, MEPT AND STRUCTURAL DRAWINGS FOR ANY ADDITIONAL WORK IN AREA.

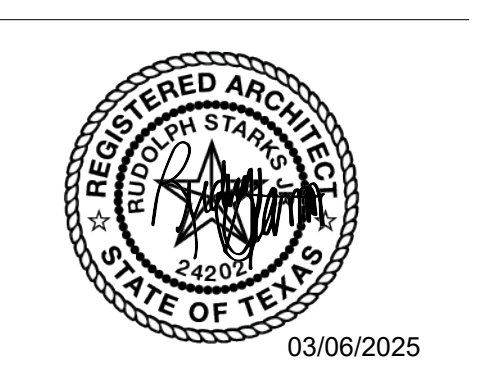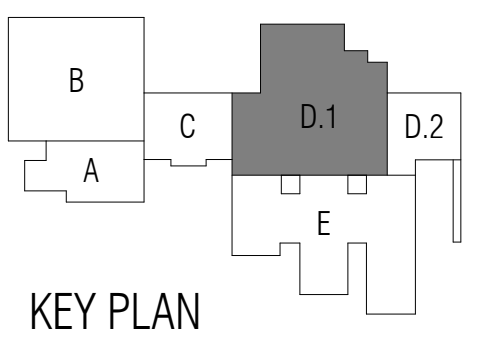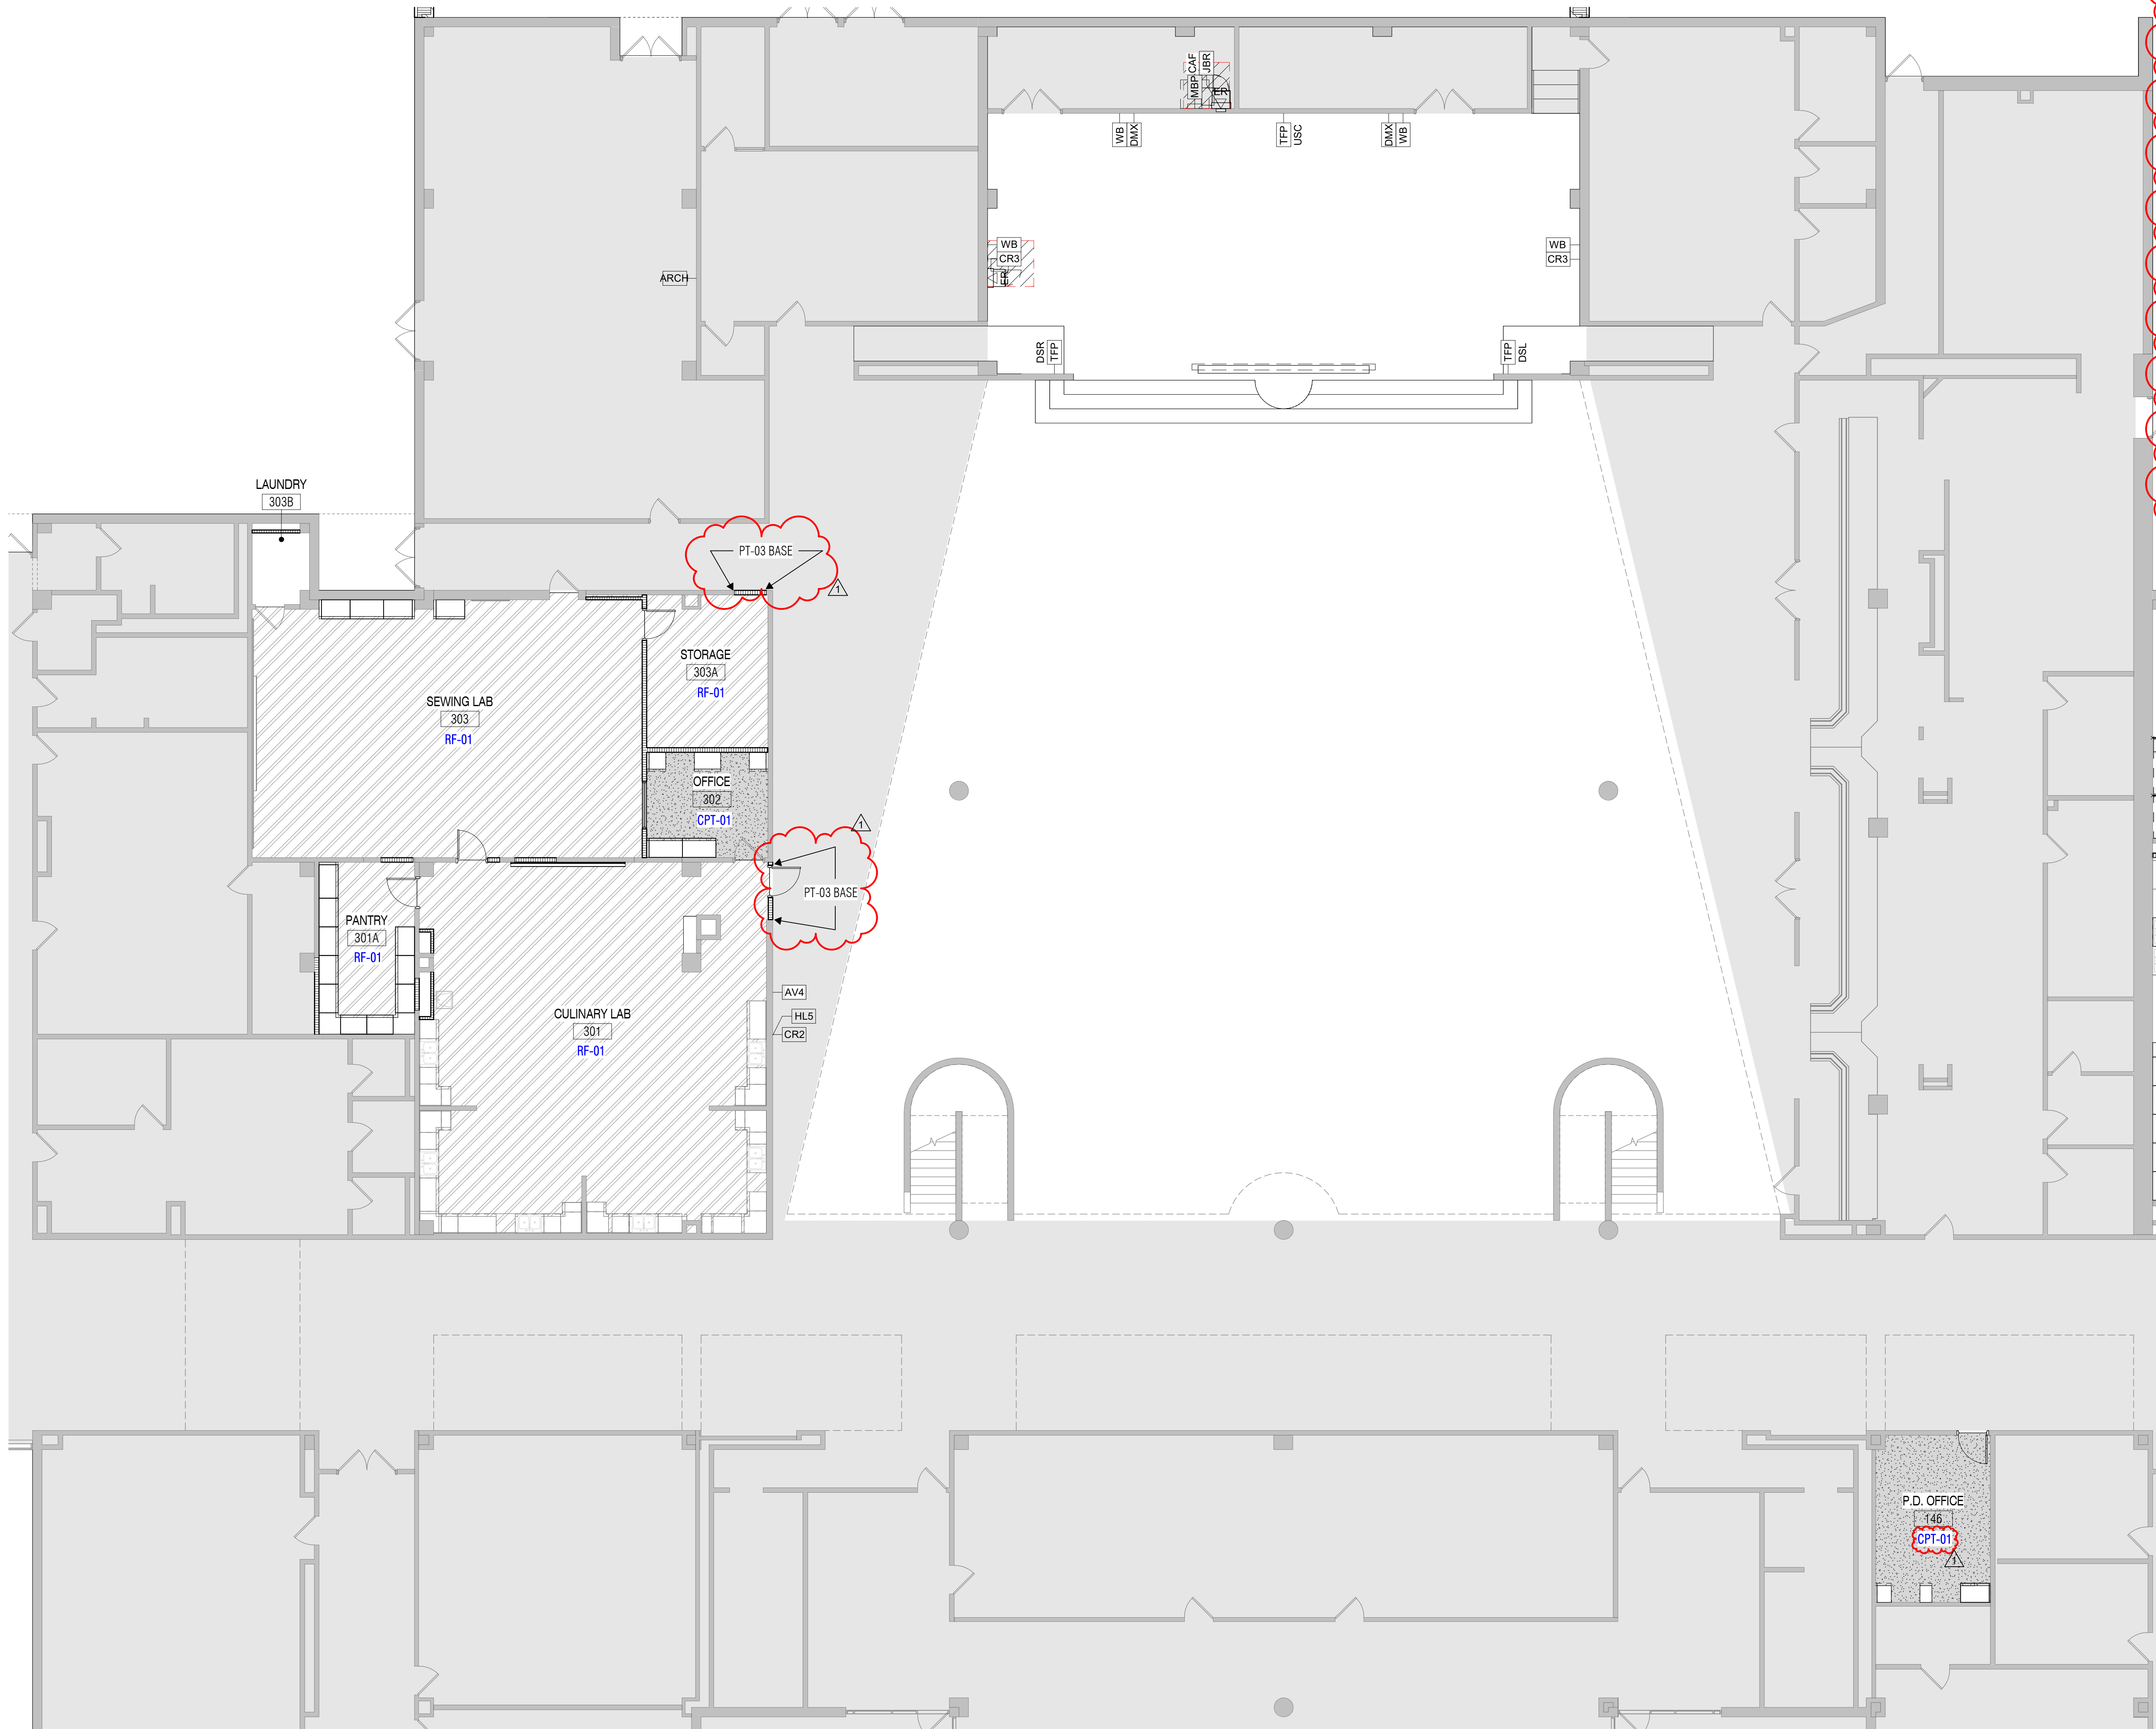

ISSUED: February 24, 2025

REVISIONS		
Revision No.	Revision Description	Revision Date
1	Addendum 1	03-06-2025

Director: RSJ
 Designer: STH, KM
 Drawn By: STH, KM
 Quality Control: Quality Control

Proj. Arch.: TQ


PROJECT NO.
24-010.00

SHEET TITLE
 TRUITT - INTERIOR FINISH PLAN - LEVEL ONE - UNIT D.1

SHEET NO.

A39.11D.1

1 INTERIOR FINISH PLAN - LEVEL ONE - UNIT 'D.1'
 SCALE: 1/8" = 1'-0"

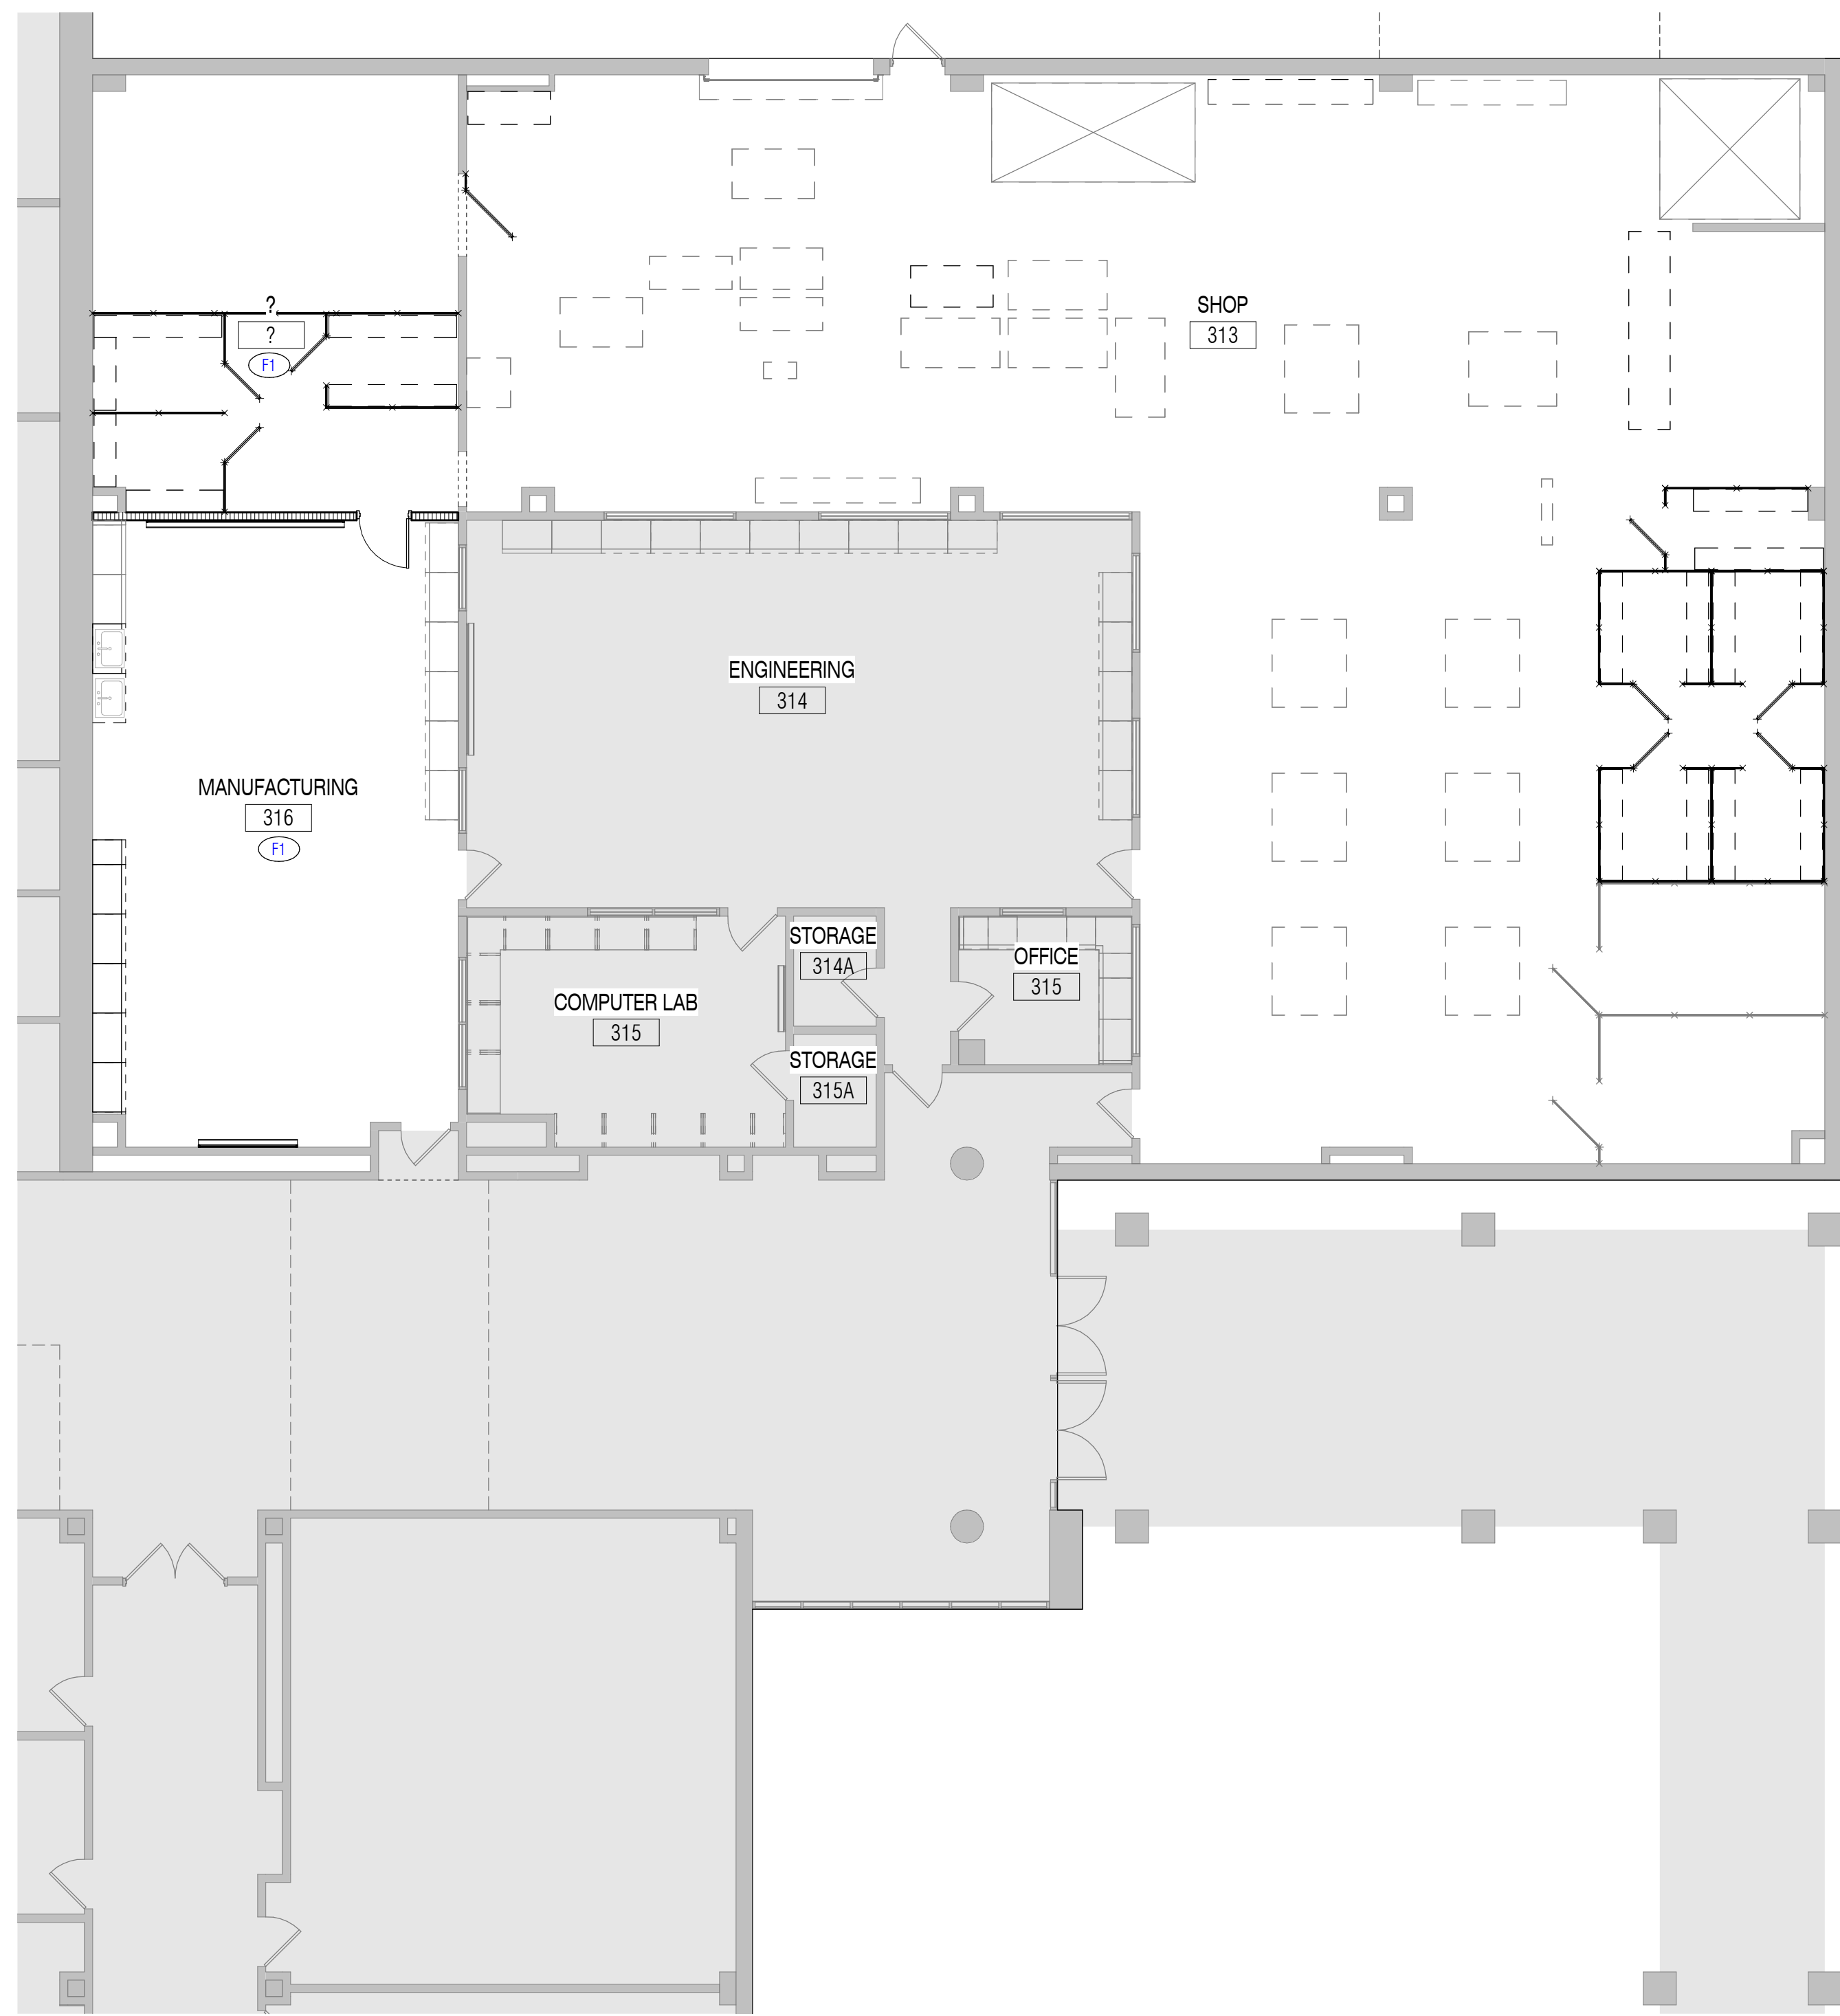


1 INTERIOR FINISH PLAN - LEVEL ONE - UNIT 'D.2'
SCALE: 1/8" = 1'-0"

INTERIOR FINISH LEGEND		
	CO-01	CONCRETE - SEALED
	CO-02	CONCRETE - POLISHED
	CPT-01	CARPET - FIELD
	CPT-02	CARPET - ACCENT
	RF-01	RESILIENT FLOOR - FIELD
	RF-02	RESILIENT FLOOR - ACCENT
	F1	EXISTING POLISHED CONCRETE TO BE REFINISHED.
EXISTING TO REMAIN WITH LIMITED OR NO INTERIOR FINISH WORK REQUIRED IN THIS AREA. REFER TO CIVIL, MEPT AND STRUCTURAL DRAWINGS FOR ANY ADDITIONAL WORK IN AREA.		



ARCHITECT
VLK Architects
 20445 State Hwy 249, Suite 350
 Houston, Texas 77070
 Main Phone: 281.671.2300
 www.vlkarchitects.com

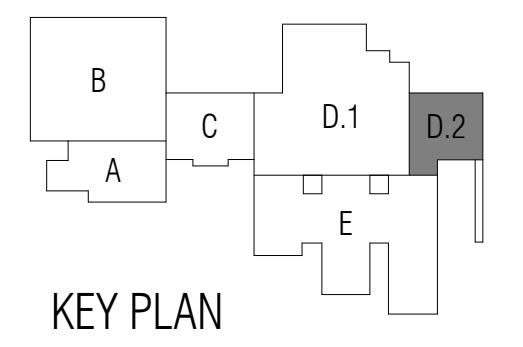

ISSUED: February 24, 2025

REVISIONS	
Revision No.	Revision Date
1 Addendum 1	03-06-2025

Director: RSJ
 Designer: STH, KM
 Drawn By: STH, KM
 Quality Control: STH, KM


Proj. Arch.: TQ

PROJECT NO.
24-010.00


SHEET TITLE
TRUITT - INTERIOR FINISH PLAN - LEVEL ONE - UNIT D.2

SHEET NO.

A39.11D.2

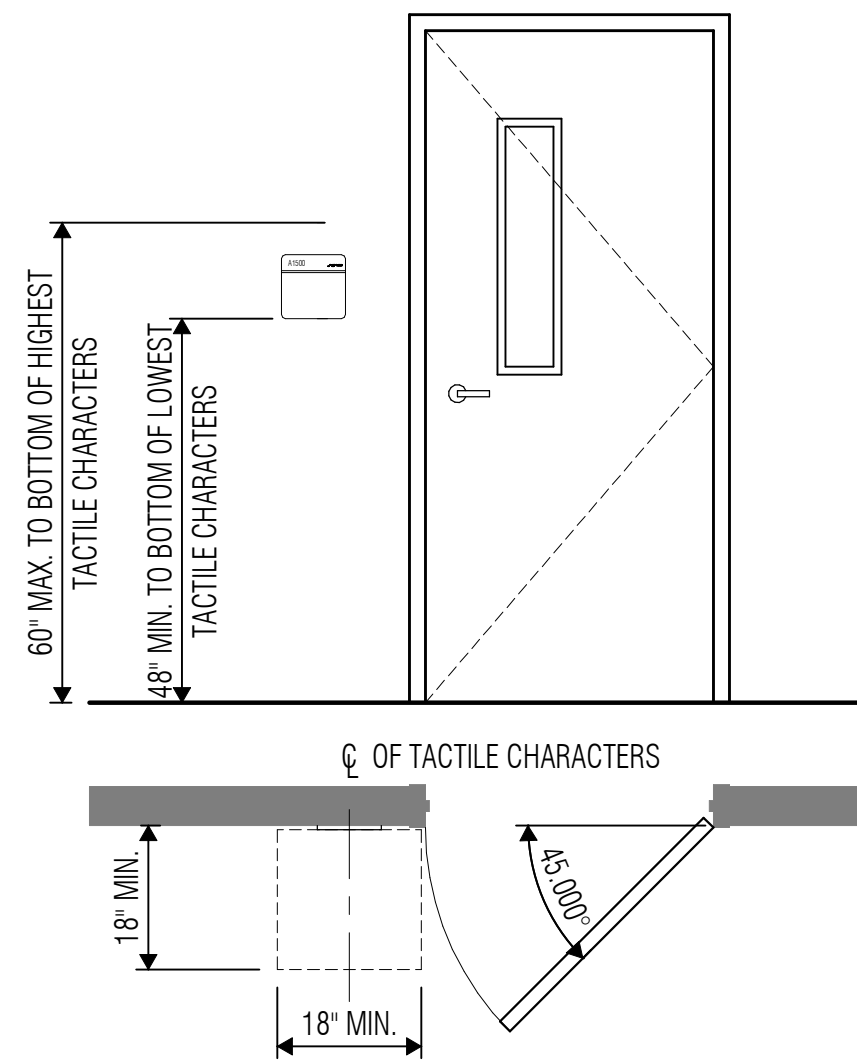


1 DETAIL/ELEV - DOOR SIGN
SCALE: 1/2" = 1'-0"

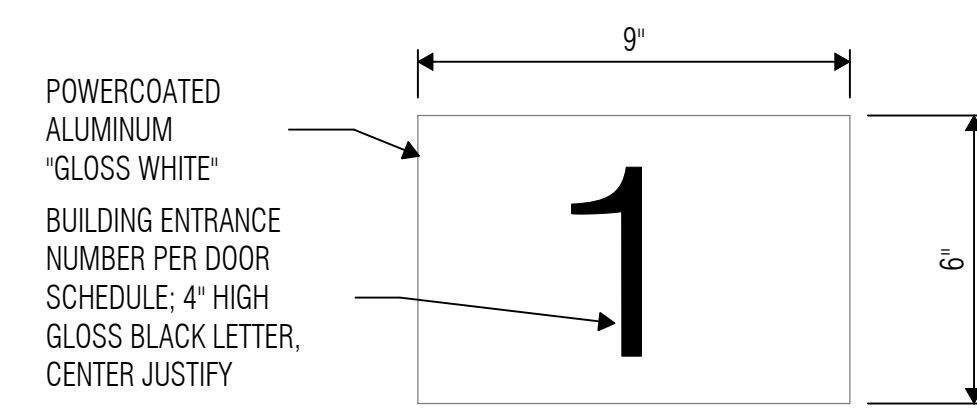



NOTE:
PROVIDE (2) SIGNS AT EACH ENTRANCE AS NOTED. ONE ON THE INTERIOR AND ONE ON THE EXTERIOR. BUILDING ENTRANCE SIGNS SHALL BE MOUNTED ABOVE AND CENTERED ON THE DOOR(S), WITH MECHANICAL FASTENERS (ON WALL) OR CLEAR DOUBLE SIDED VHB TAPE (ON GLAZING).

2 SIGN TYPE 'D'
SCALE: 3" = 1'-0"

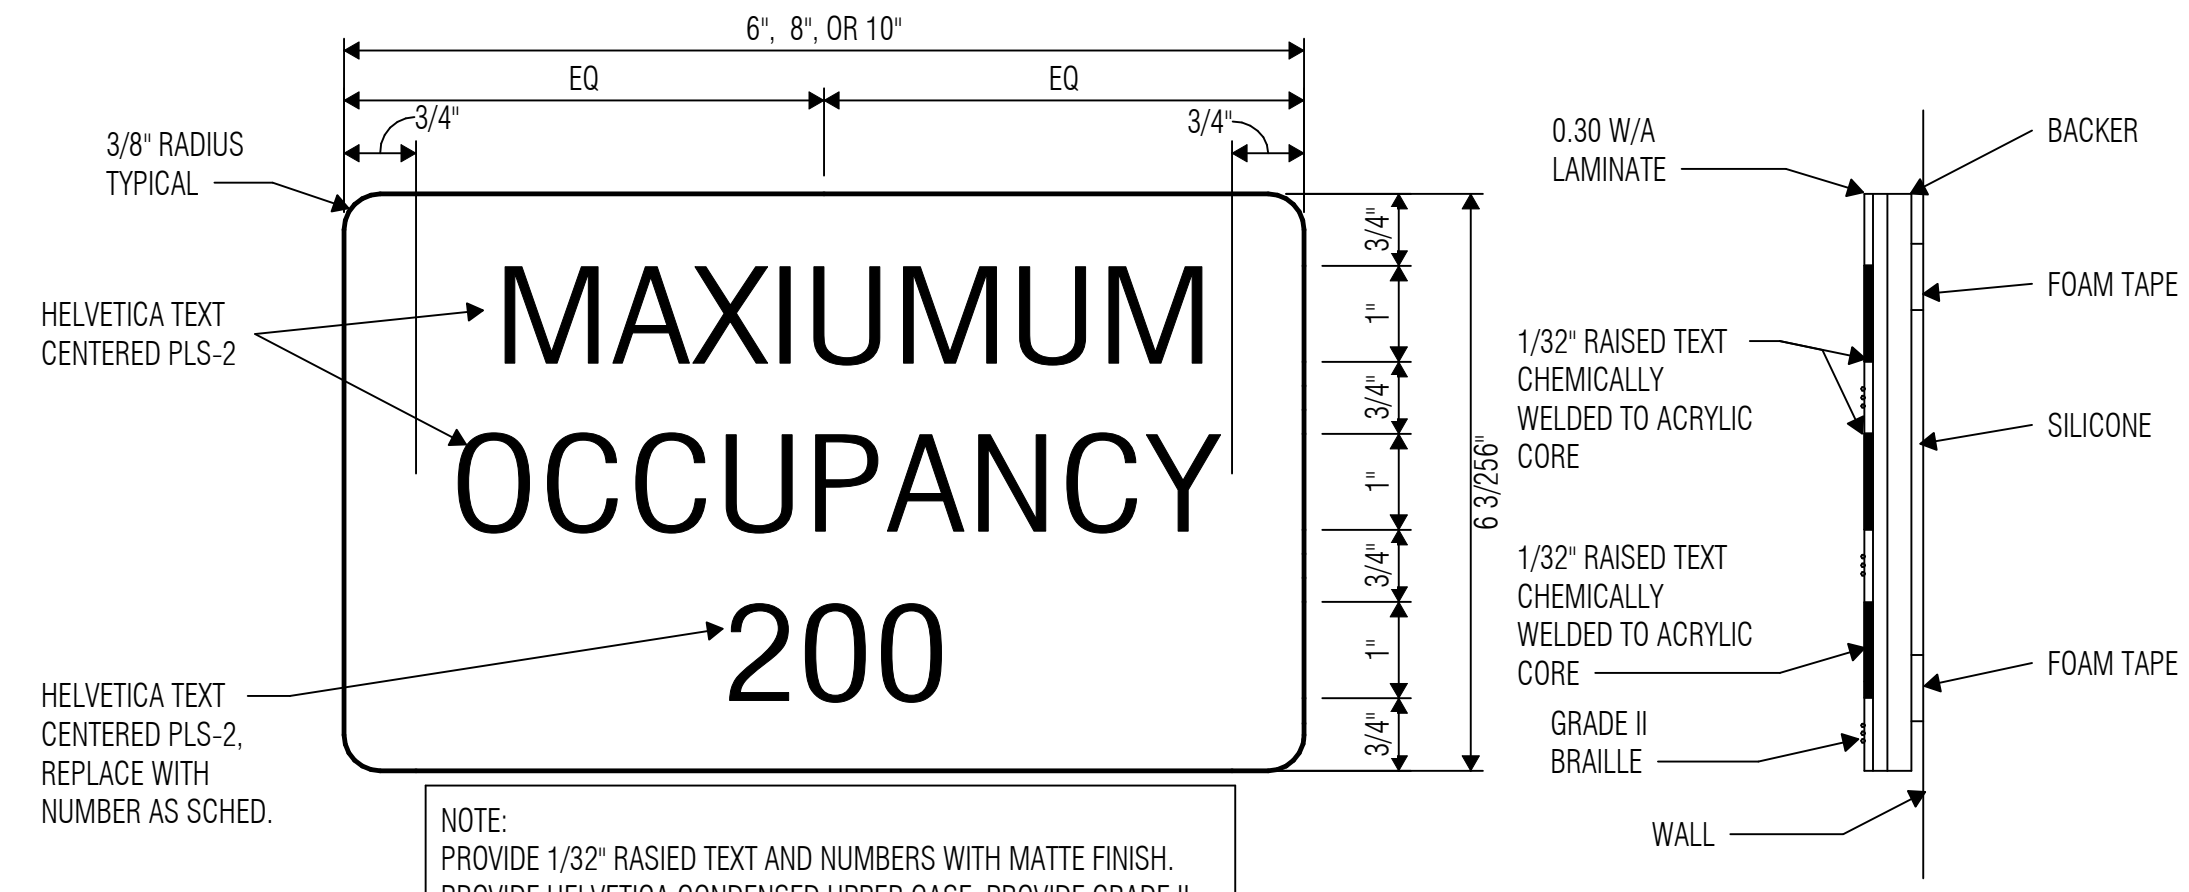



NOTE:
PROVIDE 1/32" RAISED TEXT AND NUMBERS WITH MATTE FINISH. PROVIDE HELVETICA CONDENSED UPPER CASE. PROVIDE GRADE II BRAILLE FOR TEXT AND NUMBERS TO MEET T.A.S. REQUIREMENTS.

3 SIGN TYPE 'C'1
SCALE: 6" = 1'-0"

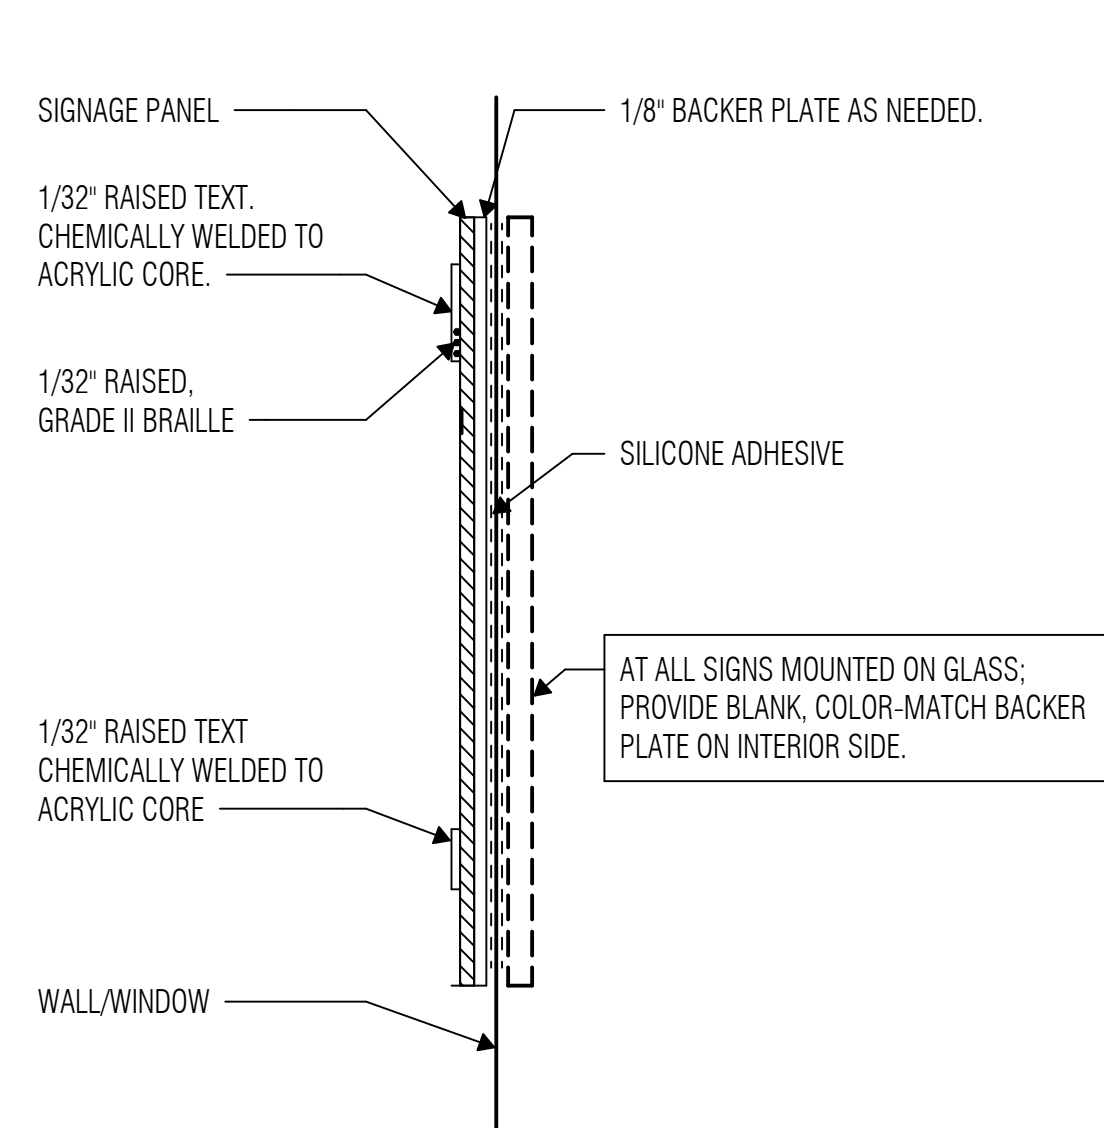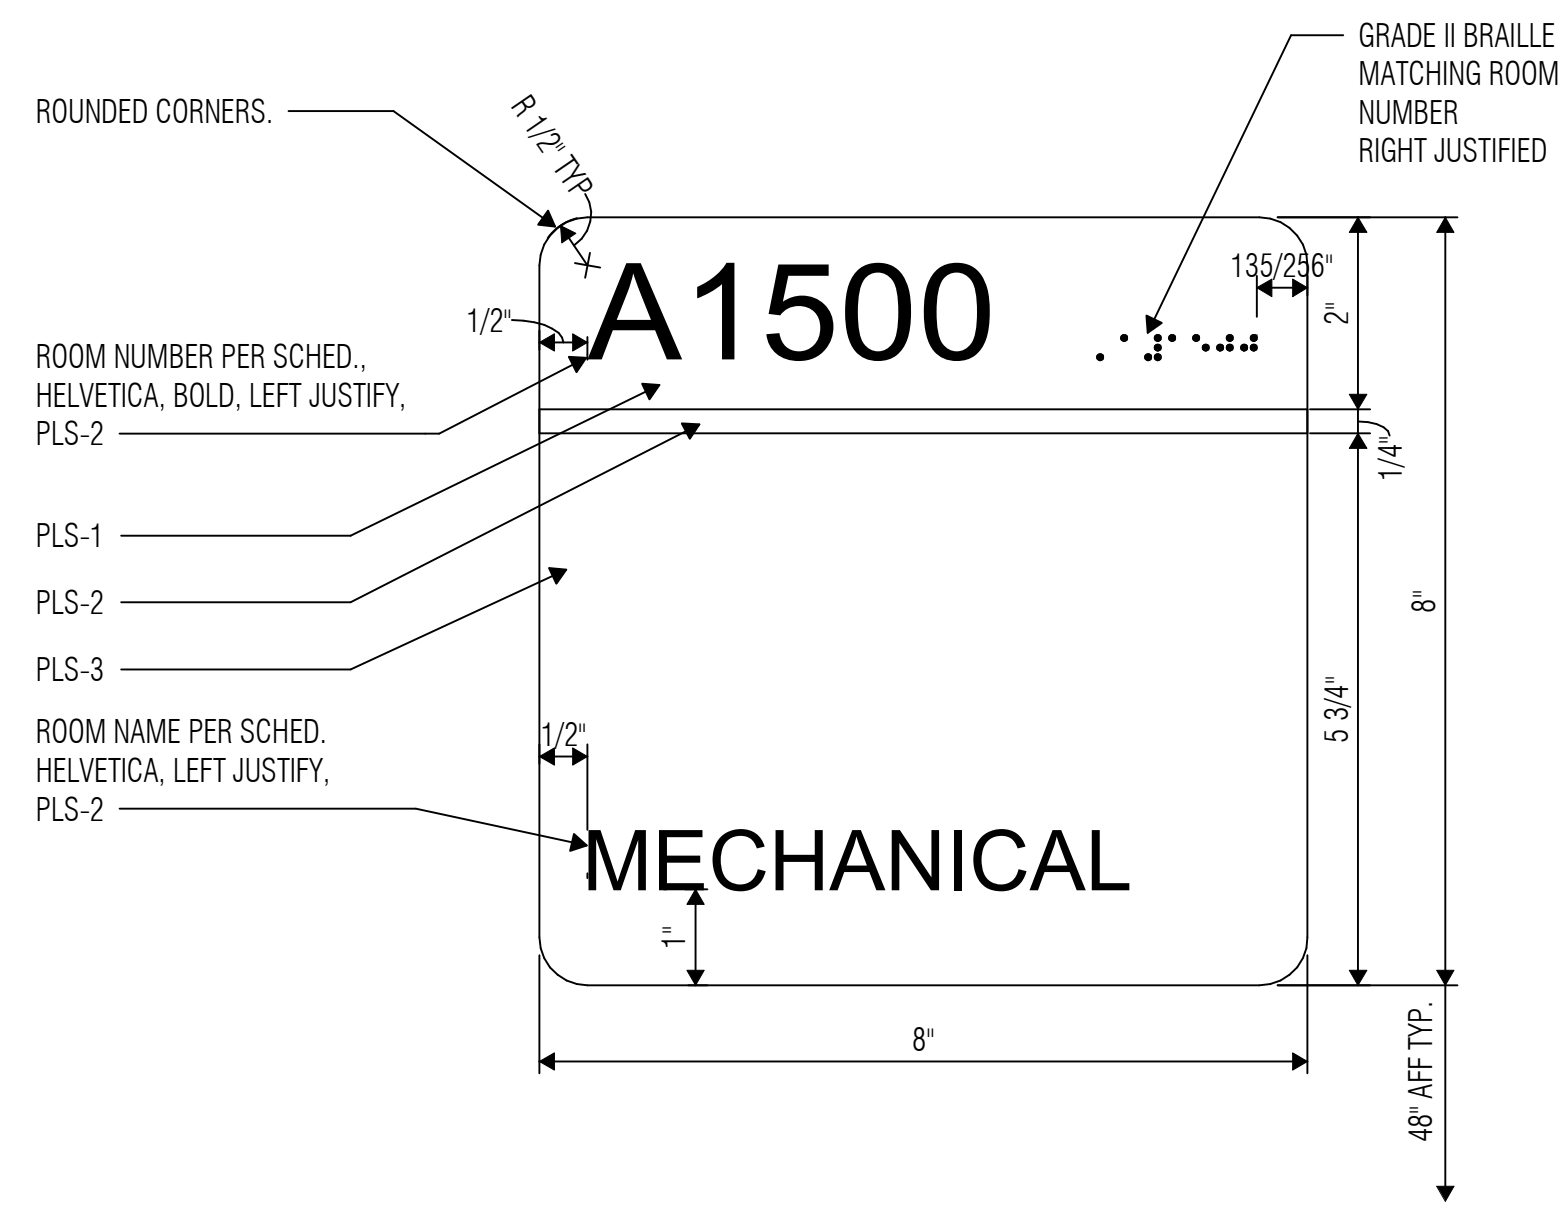

AT ALL SIGNS MOUNTED ON GLASS; PROVIDE BLANK, COLOR-MATCH BACKER PLATE ON INTERIOR SIDE.

4 SIGN TYPE 'A'1
SCALE: 6" = 1'-0"

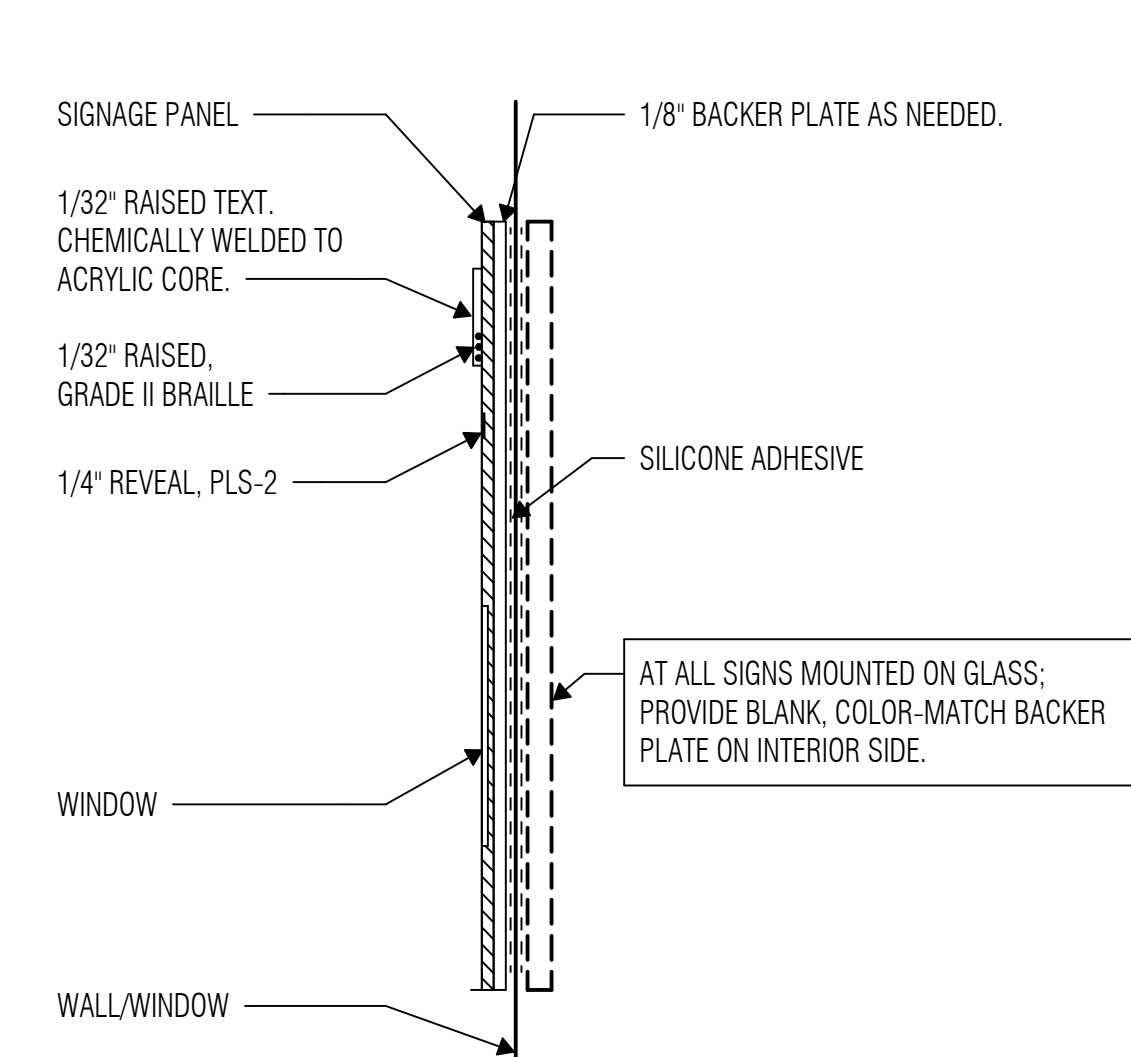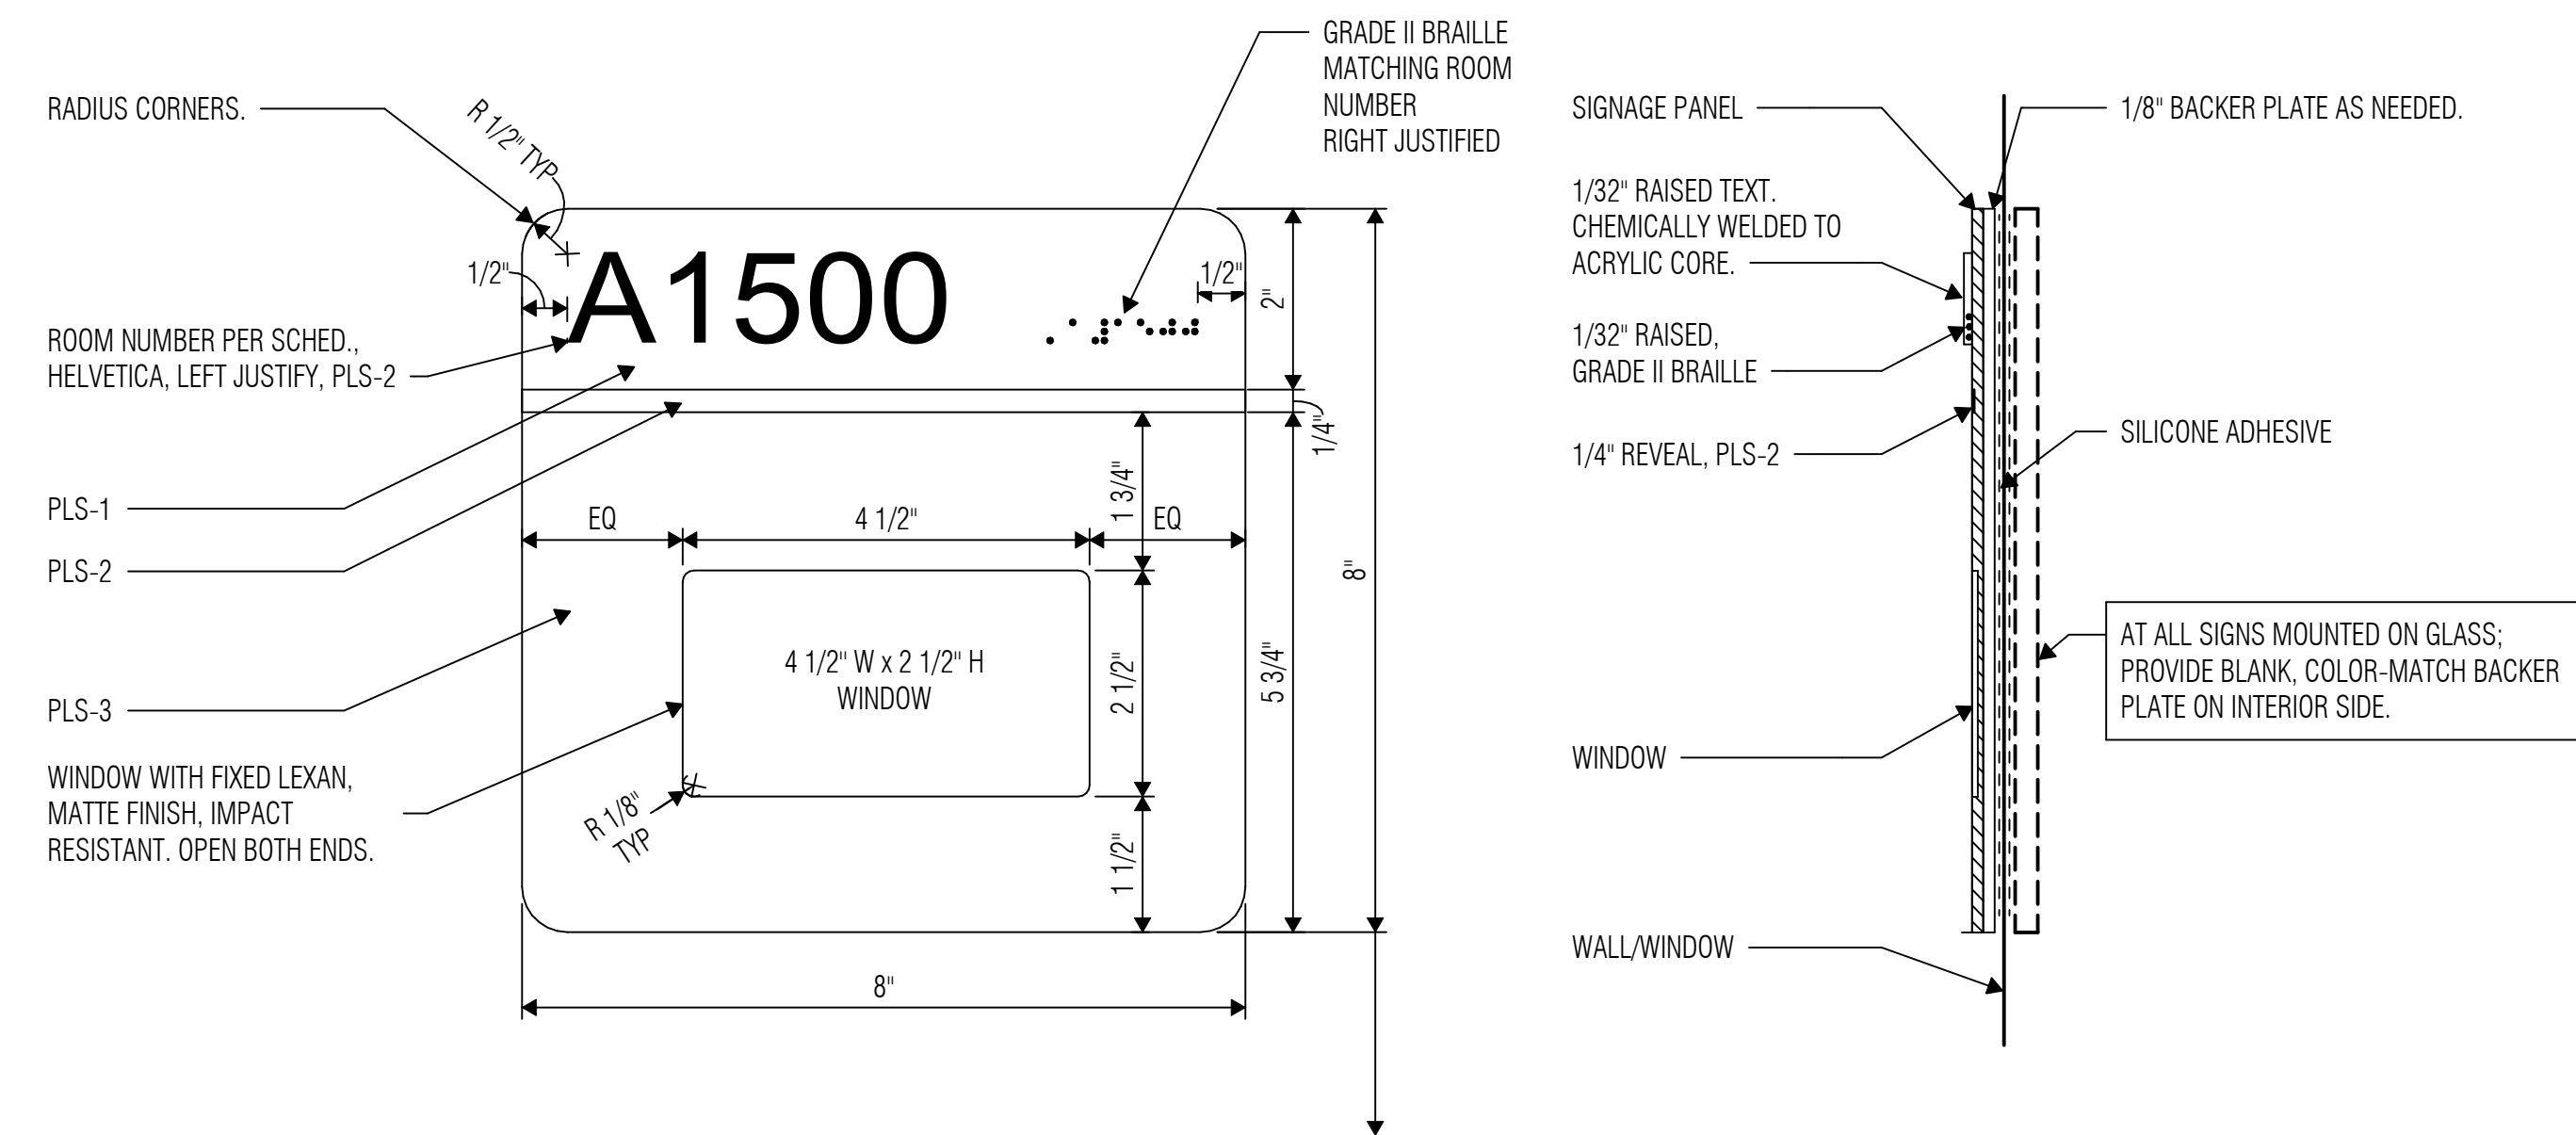

AT ALL SIGNS MOUNTED ON GLASS; PROVIDE BLANK, COLOR-MATCH BACKER PLATE ON INTERIOR SIDE.

5 SIGN TYPE 'B'1
SCALE: 6" = 1'-0"



ISSUED: 03/06/25

REVISIONS

Revision No.	Revision Date

Director: RSJ
Design: STH, KM

Drawn By: STH, KM
Quality Control: TQ

PROJECT NO.

24-010.00

SHEET TITLE

TRUITT - ROOM SIGNAGE DETAILS


SHEET NO.

A39.20


BRACE FRAMING			
STUD TYPE	SPACING	MAX LENGTH	MISCELLANEOUS
3625162-43	4'-0" OC	14'-0"	BRACE @ MID-PT FOR LENGTHS OVER 14'-0"
6005162-43	4'-0" OC	20'-0"	BRACE @ MID-PT FOR LENGTHS OVER 20'-0"

VERTICAL FRAMING			
STUD TYPE	SPACING	MAX LENGTH	MISCELLANEOUS
3625162-43	1'-4" OC	22'-6"	ONE LAYER * SHEATHING (MIN)
6005162-43	1'-4" OC	32'-9"	ONE LAYER * SHEATHING (MIN)


* ALTERNATIVELY PROVIDE 1/2" (2) 12x16 GA HORIZONTAL CHANNEL FASTENED TO STUDS WITH 1/2" (2) 1/2x14 GA CLIP AT 4'-0" OC VERTICALLY

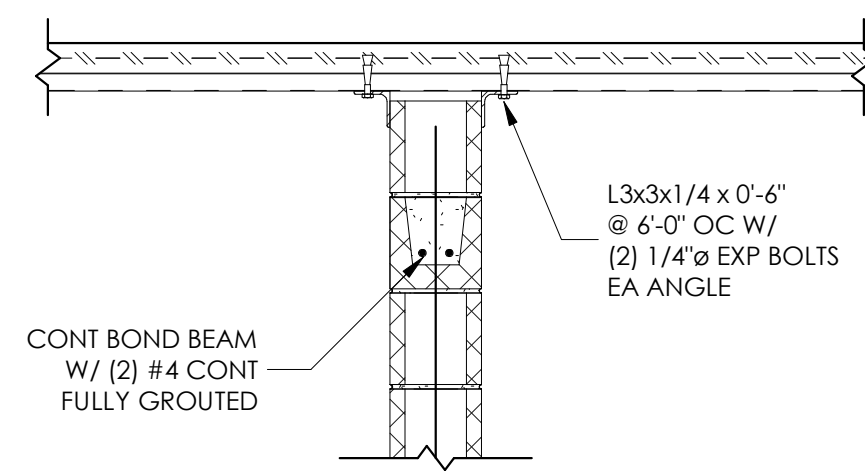


TYPE A (FLOOR)

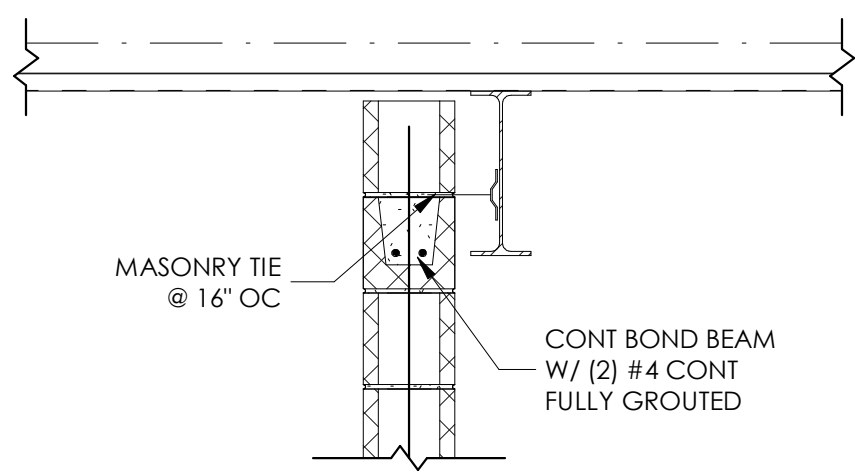


TYPE D (FLOOR/ROOF)

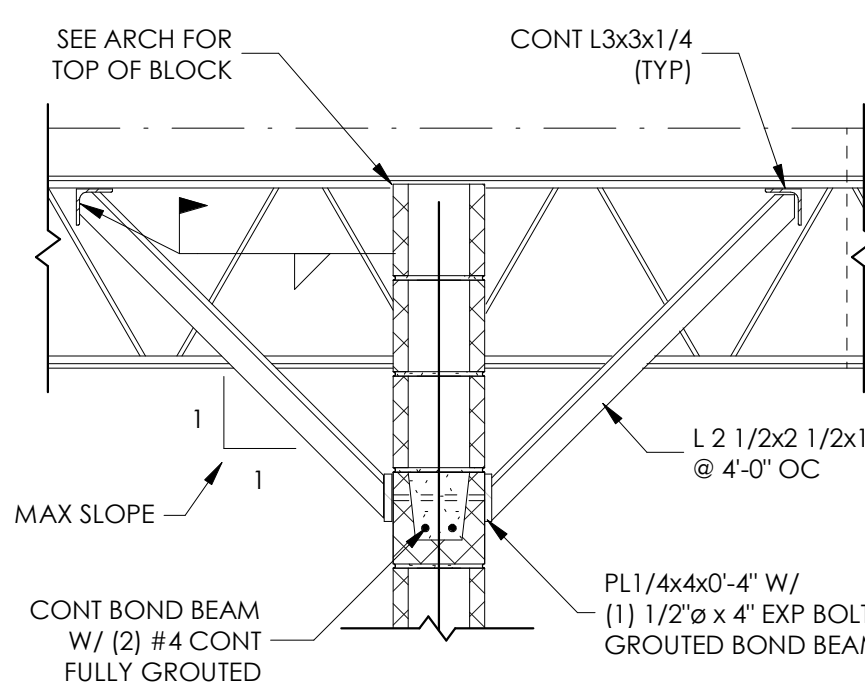


TYPE B (FLOOR / ROOF)

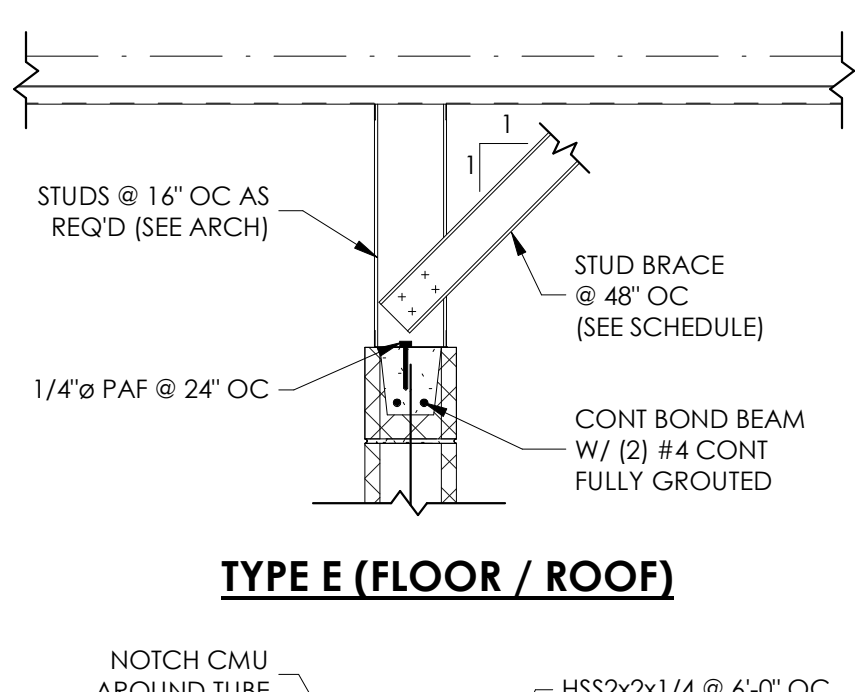

TYPE E (FLOOR / ROOF)

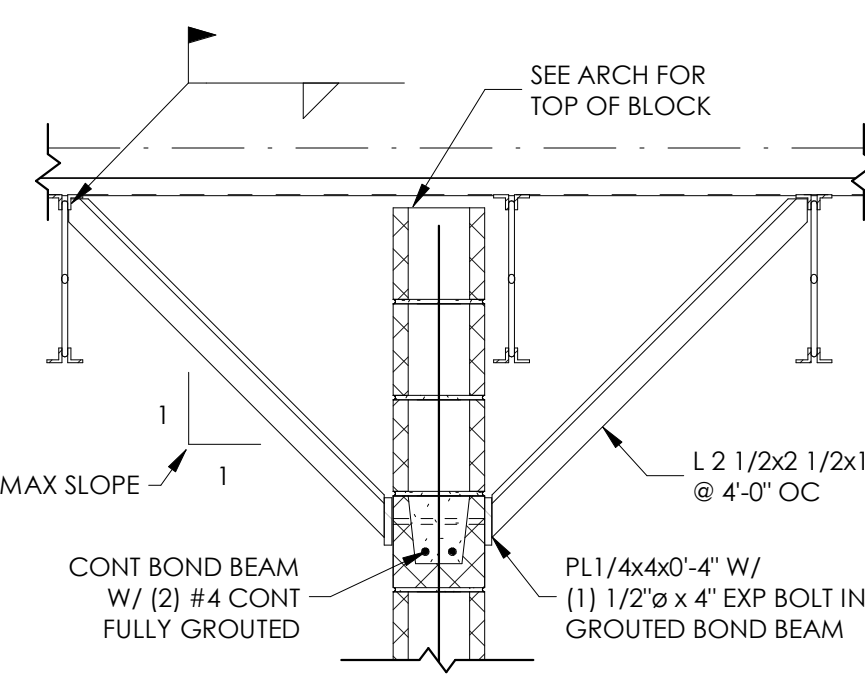

TYPE C (FLOOR / ROOF)

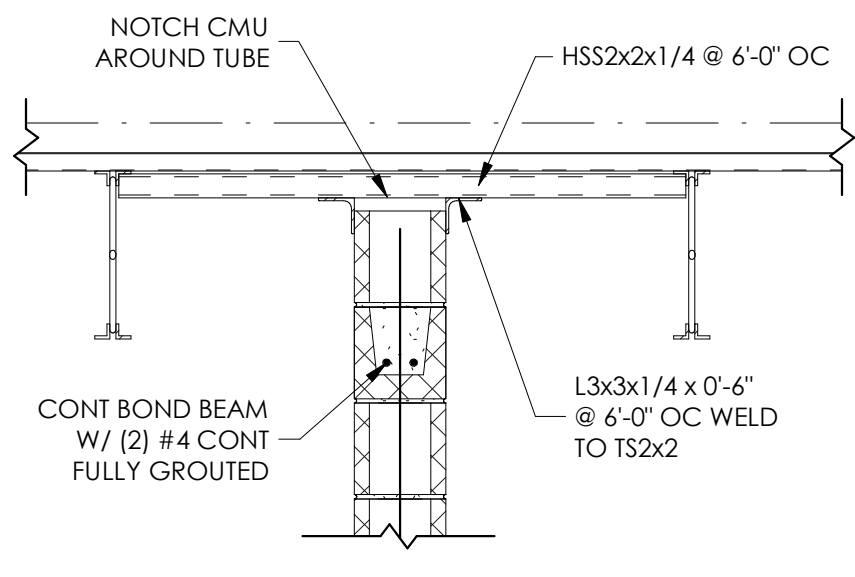


TYPE F (FLOOR / ROOF)

NOTES: INTERIOR LOCATIONS ONLY
 1. NON-LOAD BEARING MASONRY WALL BRACES. BRACING AT THE TOP OF MASONRY WALLS IS REQUIRED ON STRAIGHT RUNS OF WALL MORE THAN SIX FEET FROM A CORNER, INTERSECTING WALL, OR AS NOTED ABOVE.
 2. WHEN THE MASONRY WALL TERMINATES AT THE BOTTOM OF THE DECK, A TYPE 'A' ATTACHMENT AT THE FLOOR DECK OR A TYPE 'B', 'C', 'D' OR 'E' ATTACHMENT AT EITHER THE FLOOR OR ROOF MAY BE USED. WHEN WALLS TERMINATE ABOVE THE CEILING A TYPE 'B', 'C' OR 'E' ATTACHMENT SHOULD BE USED.

TYPICAL CMU WALL BRACING LOCATION PLAN

12 PREFABRICATED CANOPY SUPPORT DETAIL AT NEW SCALE: 3/4" = 1'-0"

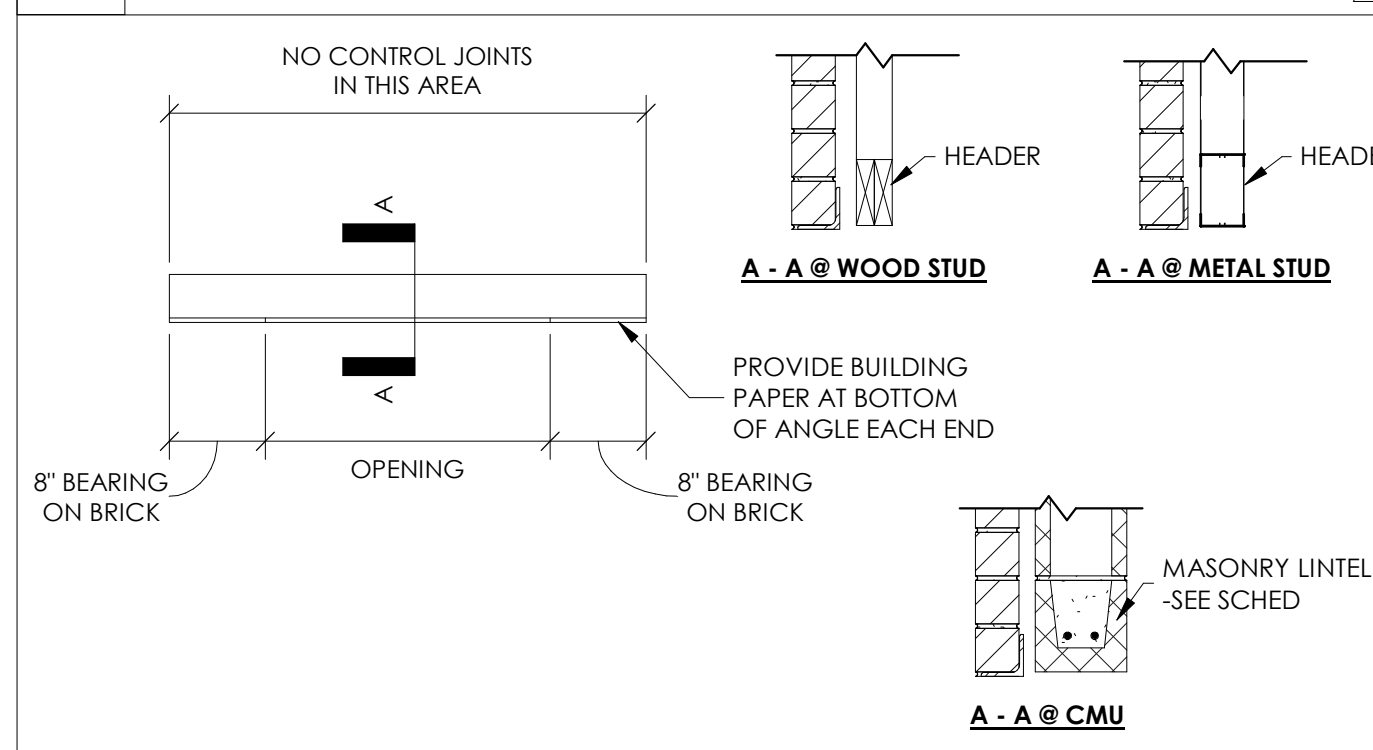

BRICK LOOSE LINTEL SCHEDULE		
OPENING	ANGLE SIZE	
LESS THAN 5'-0"	L 3 1/2 x 3 1/2 x 5/16	
5'-0" TO LESS THAN 6'-0"	L 5 x 3 1/2 x 5/16 (LLV)	
6'-0" TO LESS THAN 8'-0"	L 6 x 3 1/2 x 5/16 (LLV)	
8'-0" TO LESS THAN 9'-0"	L 7 x 4 x 3/8 (LLV)	


NOTES:
 1. LLV = LONG LEG VERTICAL
 2. GALVANIZE ALL LINTEL ANGLES.
 3. ANGLE SIZES ARE MIN - SEE ARCHITECTURAL DRAWINGS.

11 BRICK LOOSE LINTEL SCHEDULE SCALE: 3/4" = 1'-0"

MASONRY LAP SPLICE LENGTHS, F _m = 1,900 psi, GRADE 60 REINFORCEMENT IN CENTER OF WALL IN.					
BAR SIZE	6-in. CMU	8-in. CMU	10-in. CMU	12-in. CMU	BAR SIZE
#3	12	12	12	12	#3
#4	20	15	12	12	#4
#5	32	23	18	15	#5
#6	54	43	34	28	#6
#7	N/A	60	46	38	#7
#8	N/A	72	71	57	#8
#9	N/A	N/A	82	74	#9

10 MASONRY LAP SPLICE LENGTH SCHEDULE SCALE: 3/4" = 1'-0"

8 TYPICAL DECK EDGE AT MASONRY SCALE: 3/4" = 1'-0"

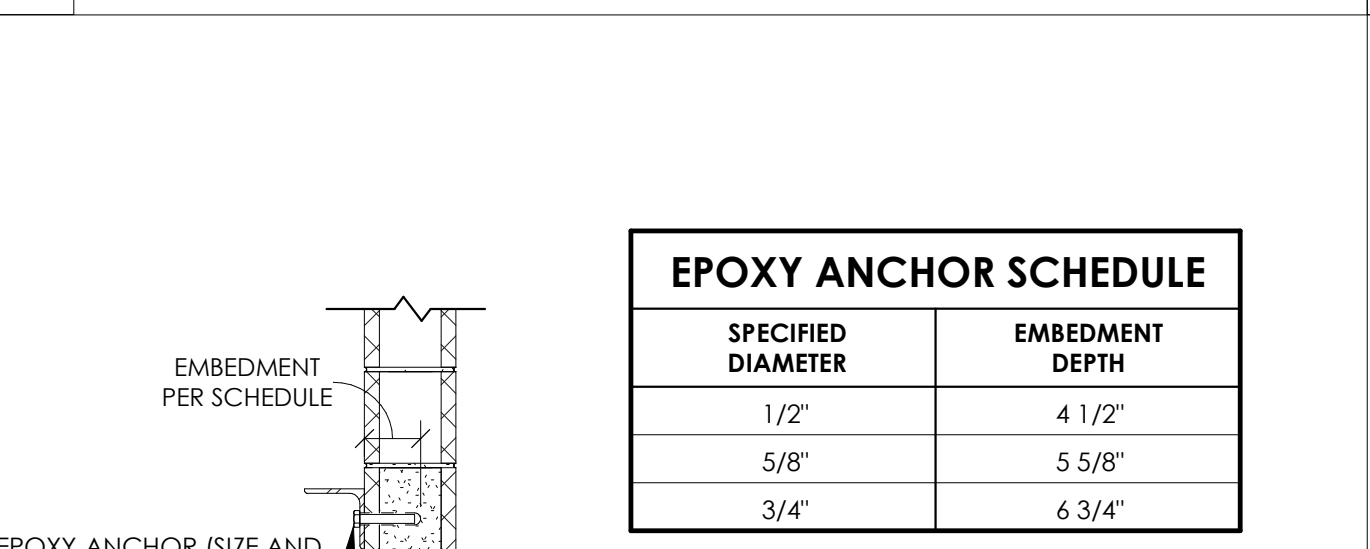

EPOXY ANCHOR SCHEDULE	
SPECIFIED DIAMETER	EMBEDMENT DEPTH
1/2"	4 1/2"
5/8"	5 5/8"
3/4"	6 3/4"

NOTES:
 1. THIS DETAIL SHALL APPLY AT ALL LOCATIONS WHERE EPOXY OR ADHESIVE ANCHORS ARE SPECIFIED WITHIN THE DRAWINGS.
 2. ALL THREADED RODS FOR EPOXY ANCHORS SHALL BE MADE FROM EITHER A307 OR A36 STEEL.
 3. IF GREATER EMBEDMENT DEPTHS ARE SPECIFIED IN THE DRAWINGS, THOSE EMBEDMENT DEPTHS SHALL GOVERN.
 4. EPOXY ANCHORS IN CMU AND CONCRETE SHALL BE LOCATED AT LEAST 4" AWAY FROM ALL EDGES. THE CENTER TO CENTER SPACING OF EPOXY ANCHORS SHALL NOT BE LESS THAN 8". WHERE EPOXY ANCHORS ARE LOCATED IN CMU, THERE SHALL BE A MAXIMUM OF ONE ANCHOR PER CELL.
 5. ALL EPOXY ANCHORS SHALL BE INSTALLED IN ACCORDANCE WITH THE MANUFACTURER'S RECOMMENDATIONS (INCLUDING HOLE DIAMETERS, HOLE CLEANING PROCEDURES, TORQUE SPECIFICATIONS, AND SPECIAL INSPECTIONS).
 6. HILTI HIT-HY 270 ADHESIVE ANCHORING SYSTEM SHALL BE USED AT ALL ADHESIVE ANCHORS IN CMU.



7 TYPICAL EPOXY ANCHOR DETAIL SCALE: 3/4" = 1'-0"

CMU WALL SCHEDULE			
DESCRIPTION	SIZE	WALL HEIGHT	VERTICAL REINFORCEMENT
EXTERIOR WALLS	12"	H ≤ 30'-0"	#6 @ 32' OC
	8"	20'-0" < H ≤ 25'-0"	#7 @ 24' OC
		14'-0" < H ≤ 20'-0"	#5 @ 32' OC
INTERIOR WALLS	8"	0'-0" < H ≤ 14'-0"	#4 @ 48' OC
		H ≤ 30'-0"	#4 @ 48' OC
		20'-0" < H ≤ 30'-0"	#5 @ 32' OC
	6"	0'-0" < H ≤ 20'-0"	#4 @ 48' OC
		ALL HEIGHTS	#4 @ 48' OC


NOTES:
 1. WALL HEIGHT, H, SHALL BE CONSIDERED AS THE DISTANCE BETWEEN LATERAL SUPPORTS
 2. ALL DOWELS TO FLOOR SLAB SHALL MATCH SIZE & SPACING OF VERTICAL REINFORCEMENT
 3. UNLESS NOTED OTHERWISE ON PLANS, PROVIDE (2) #4 CONT. IN FULLY GROUTED BOND BEAM SPACED @ 8'-0" O.C. VERTICALLY (MAX) (2) #5 IN 12" CMU WALLS
 4. ALL CELLS WITH REINFORCING SHALL BE FULLY GROUTED
 5. F_m = 1,900 PSI

6 NON-LOAD BEARING CMU WALL SCHEDULE SCALE: 3/4" = 1'-0"


4 REBAR PLACEMENT DETAIL SCALE: 3/4" = 1'-0"

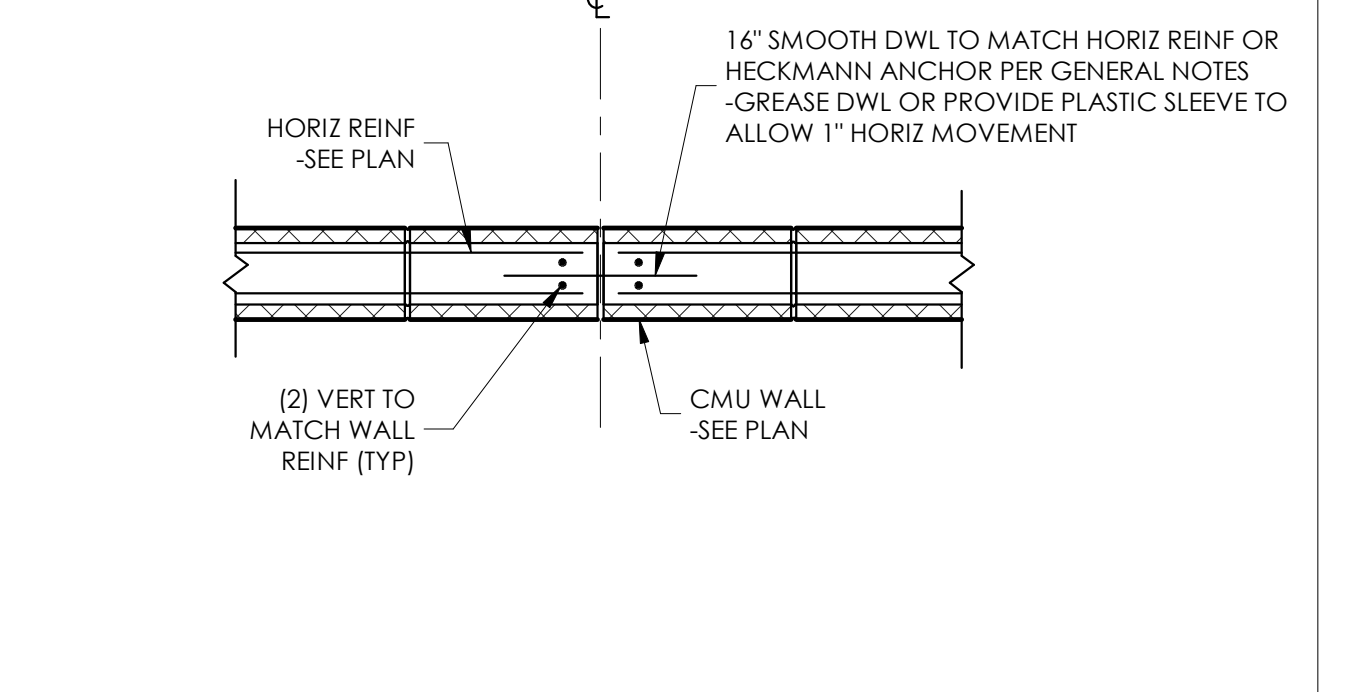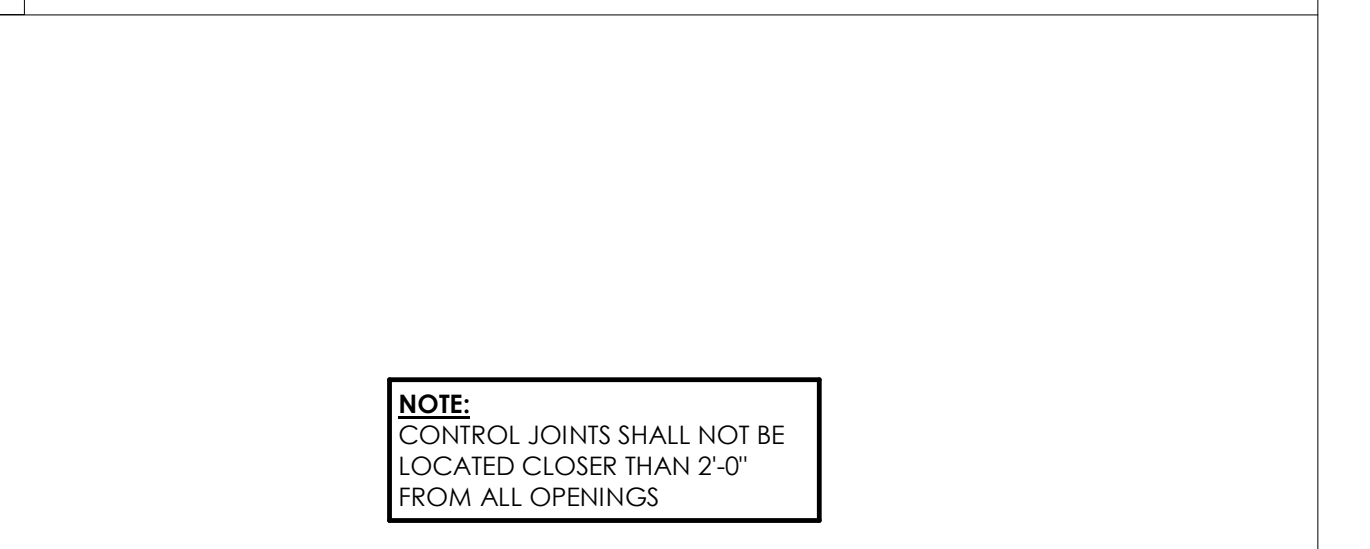

3 TYPICAL CONTROL JOINT DETAIL SCALE: 3/4" = 1'-0"

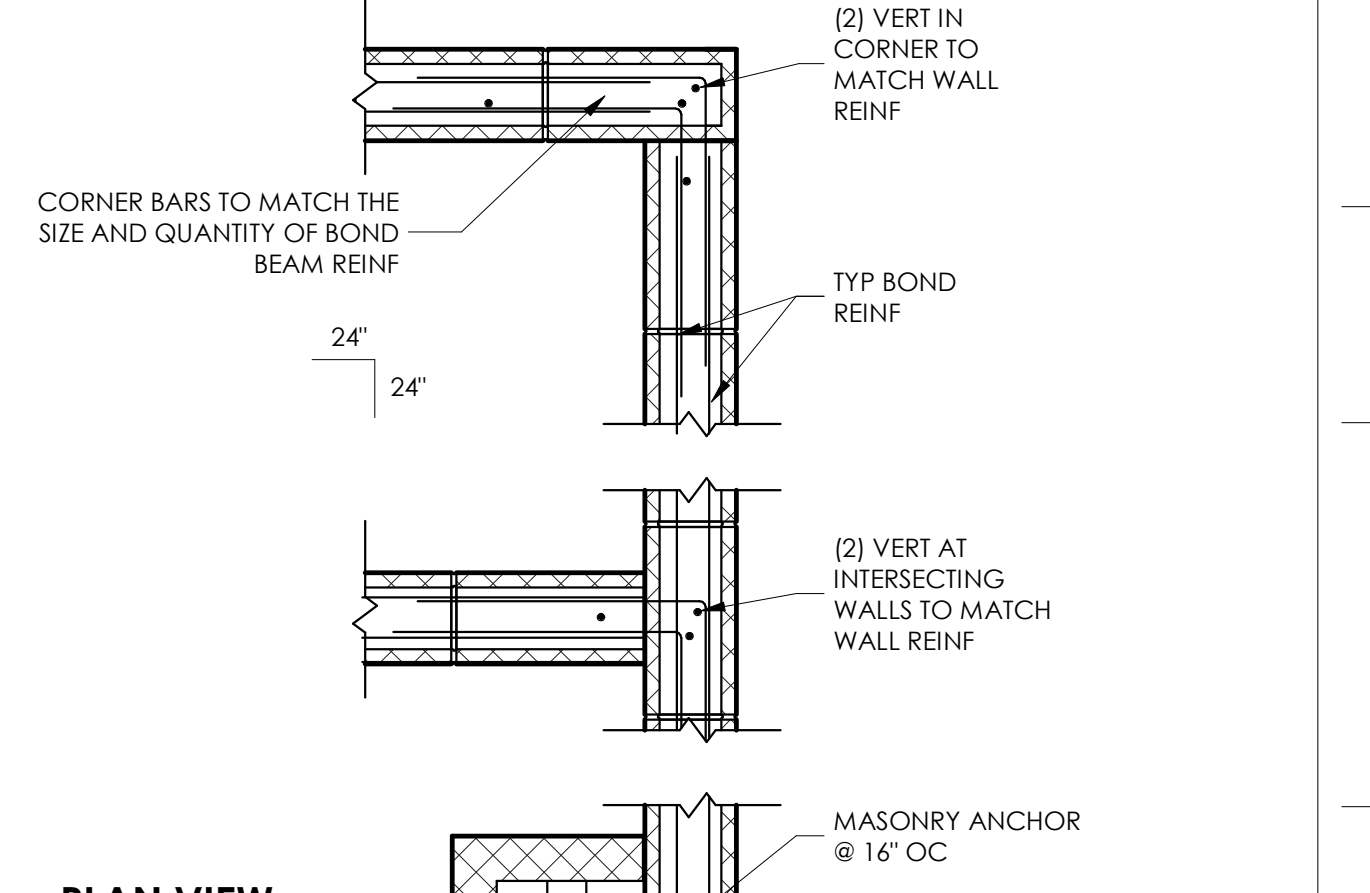


2 CMU REINFORCING AND ANCHOR PLAN SCALE: 3/4" = 1'-0"

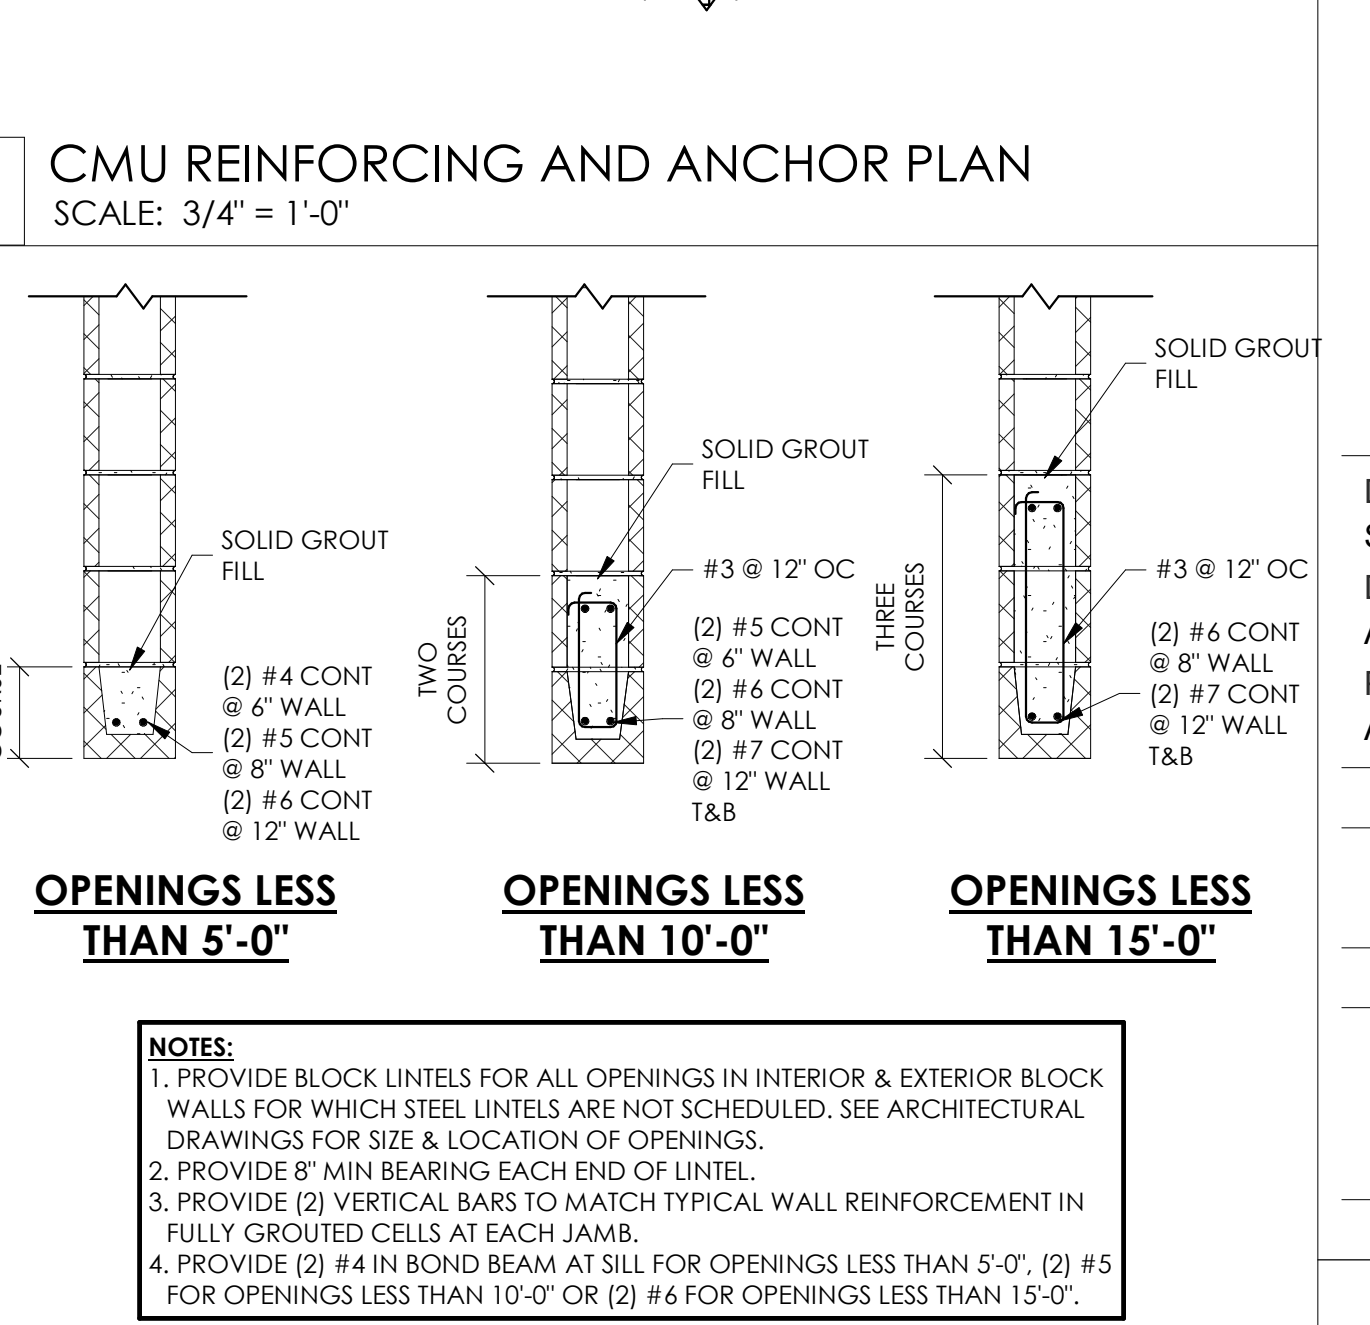


1 MASONRY LINTEL SCHEDULE SCALE: 3/4" = 1'-0"


18 TYPICAL NON LOAD BEARING CMU WALL BRACE CONNECTION DETAILS SCALE: 3/4" = 1'-0"

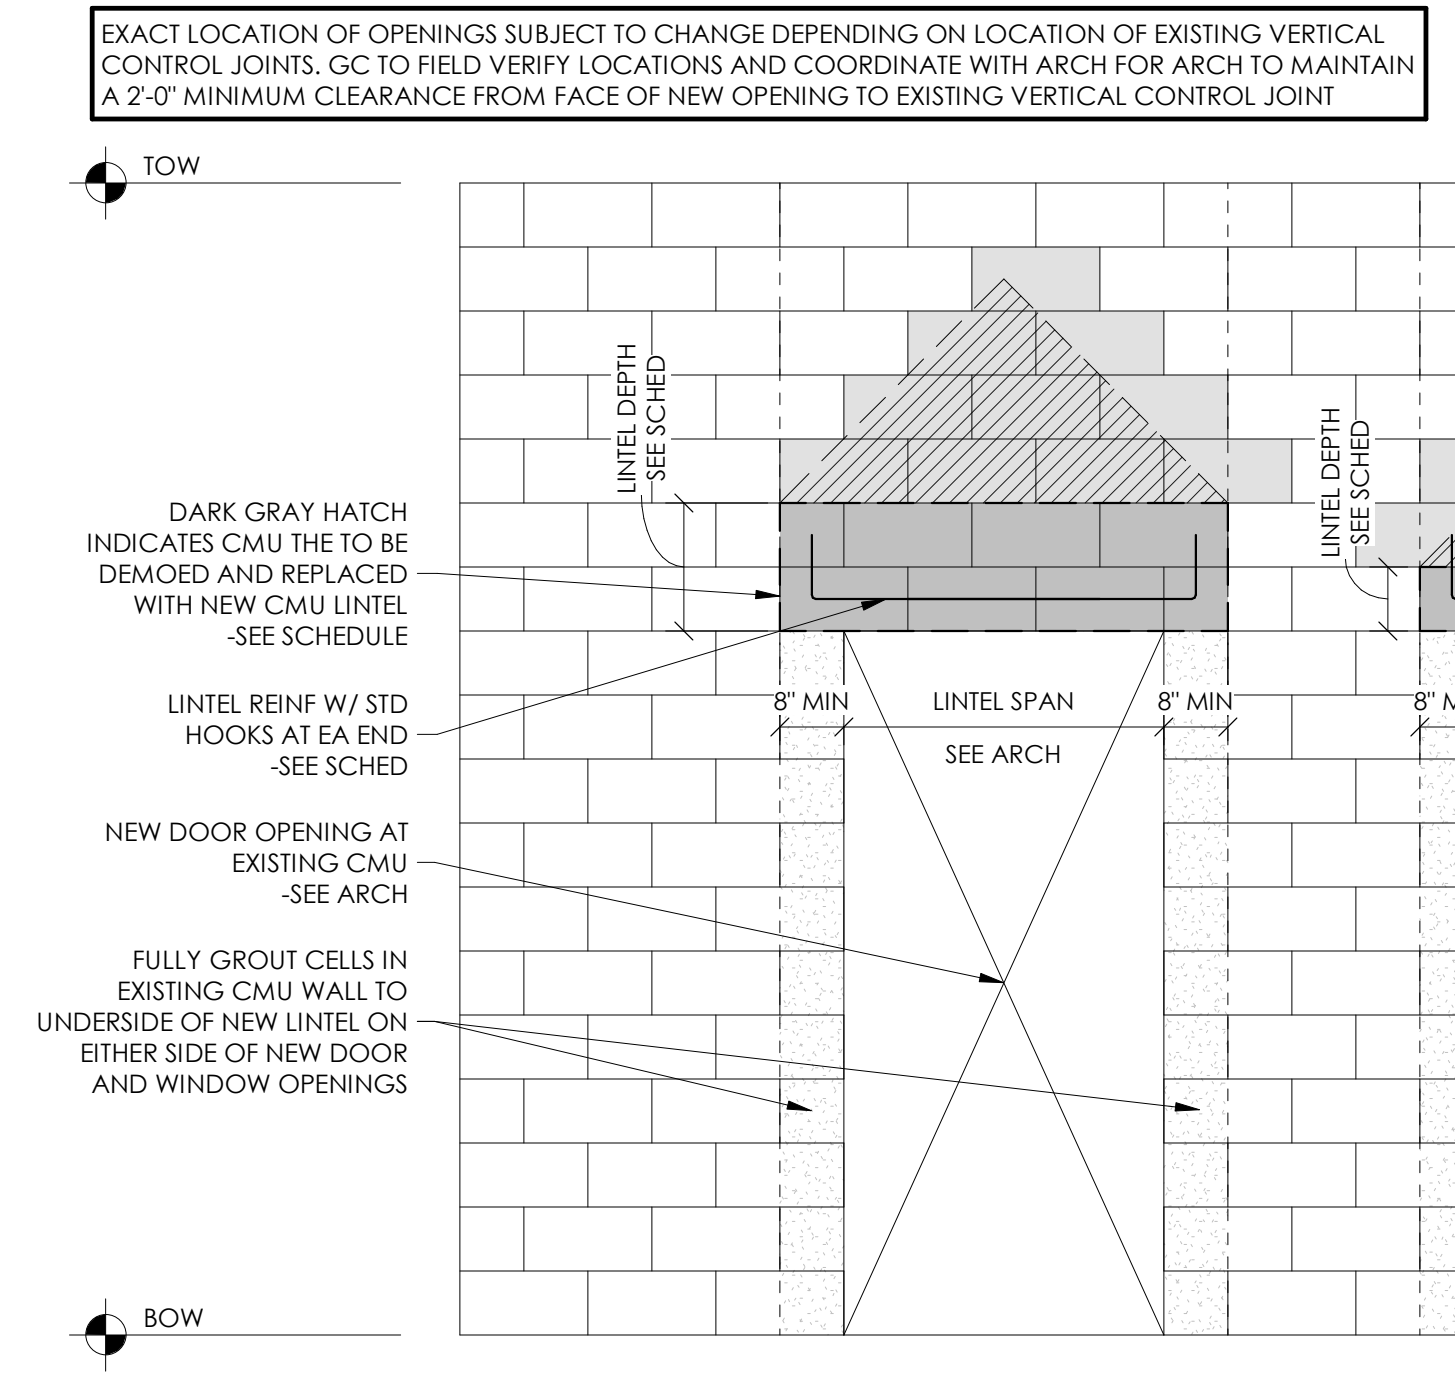


17 EXISTING MASONRY WALL ELEVATION W/ NEW POST-INSTALLED CMU LINTEL AT NEW OPENING SCALE: 1/2" = 1'-0"

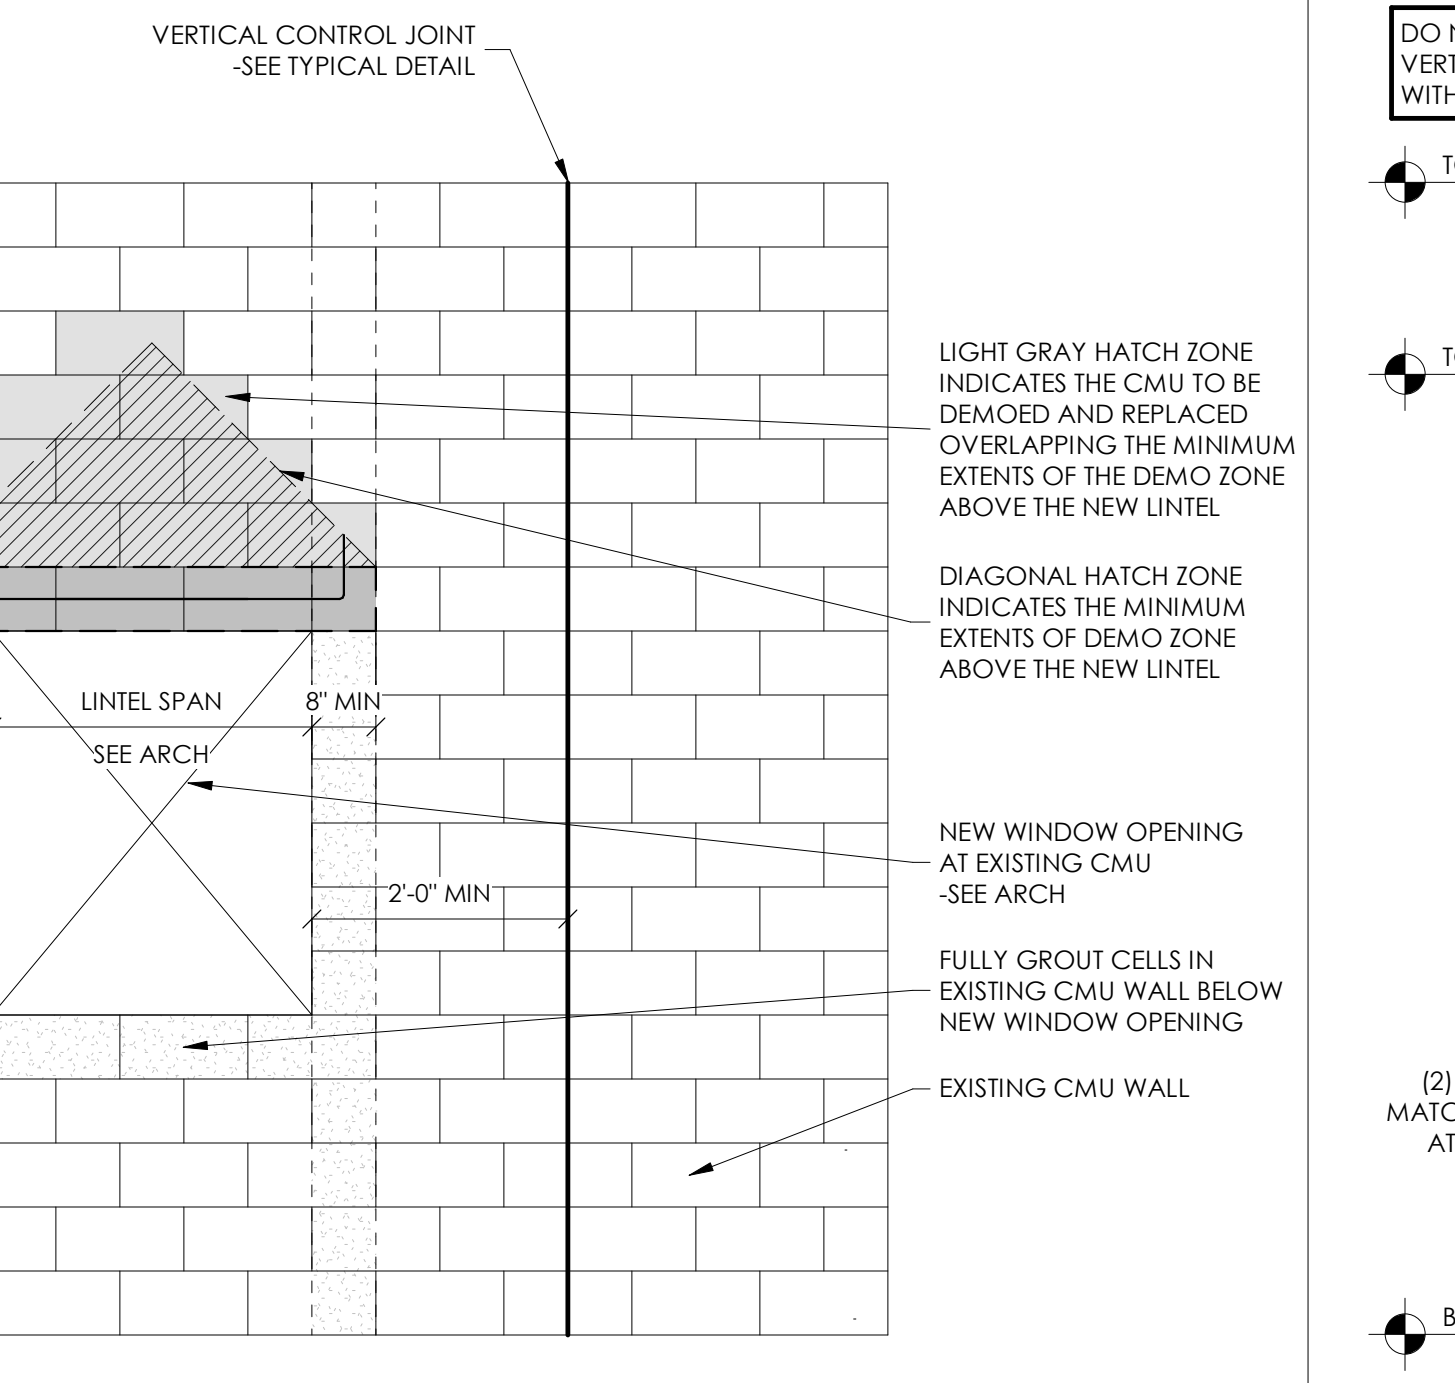

9 TYPICAL MASONRY WALL ELEVATION SCALE: 1/2" = 1'-0"

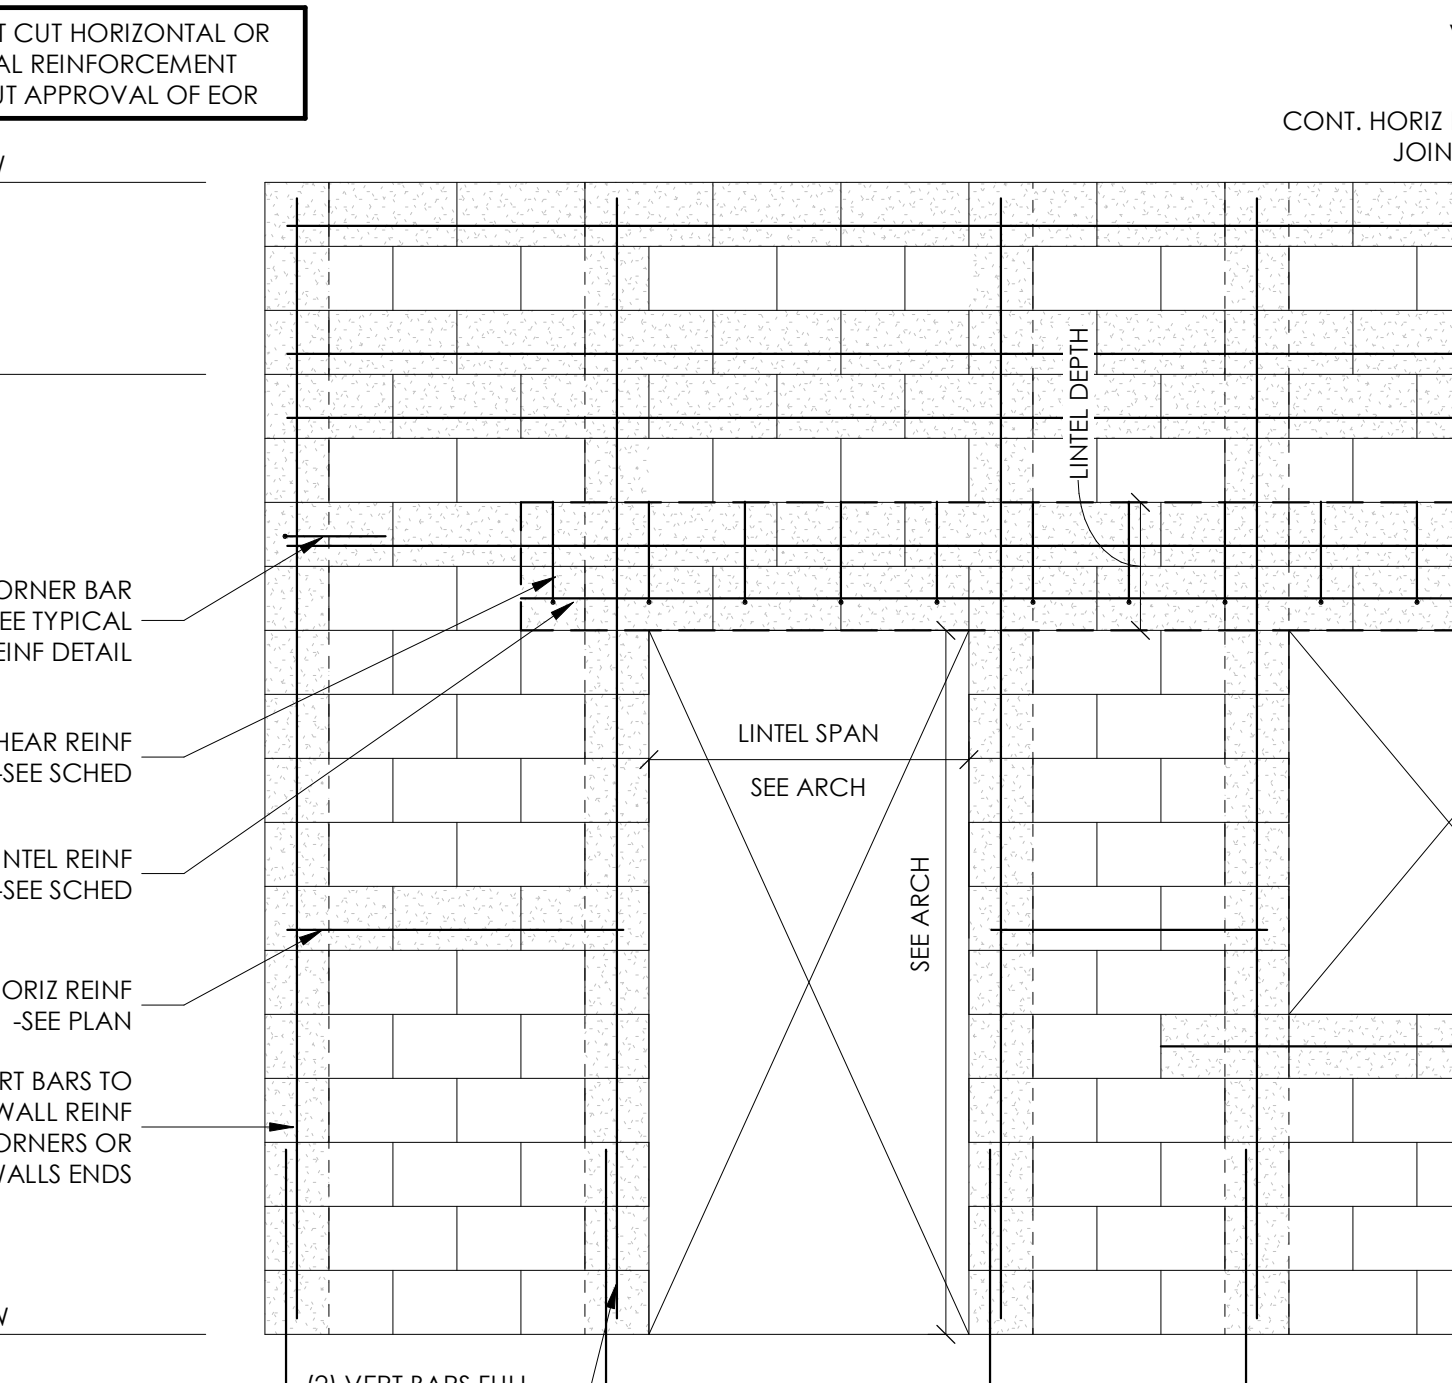

10 TYPICAL MASONRY WALL ELEVATION SCALE: 1/2" = 1'-0"

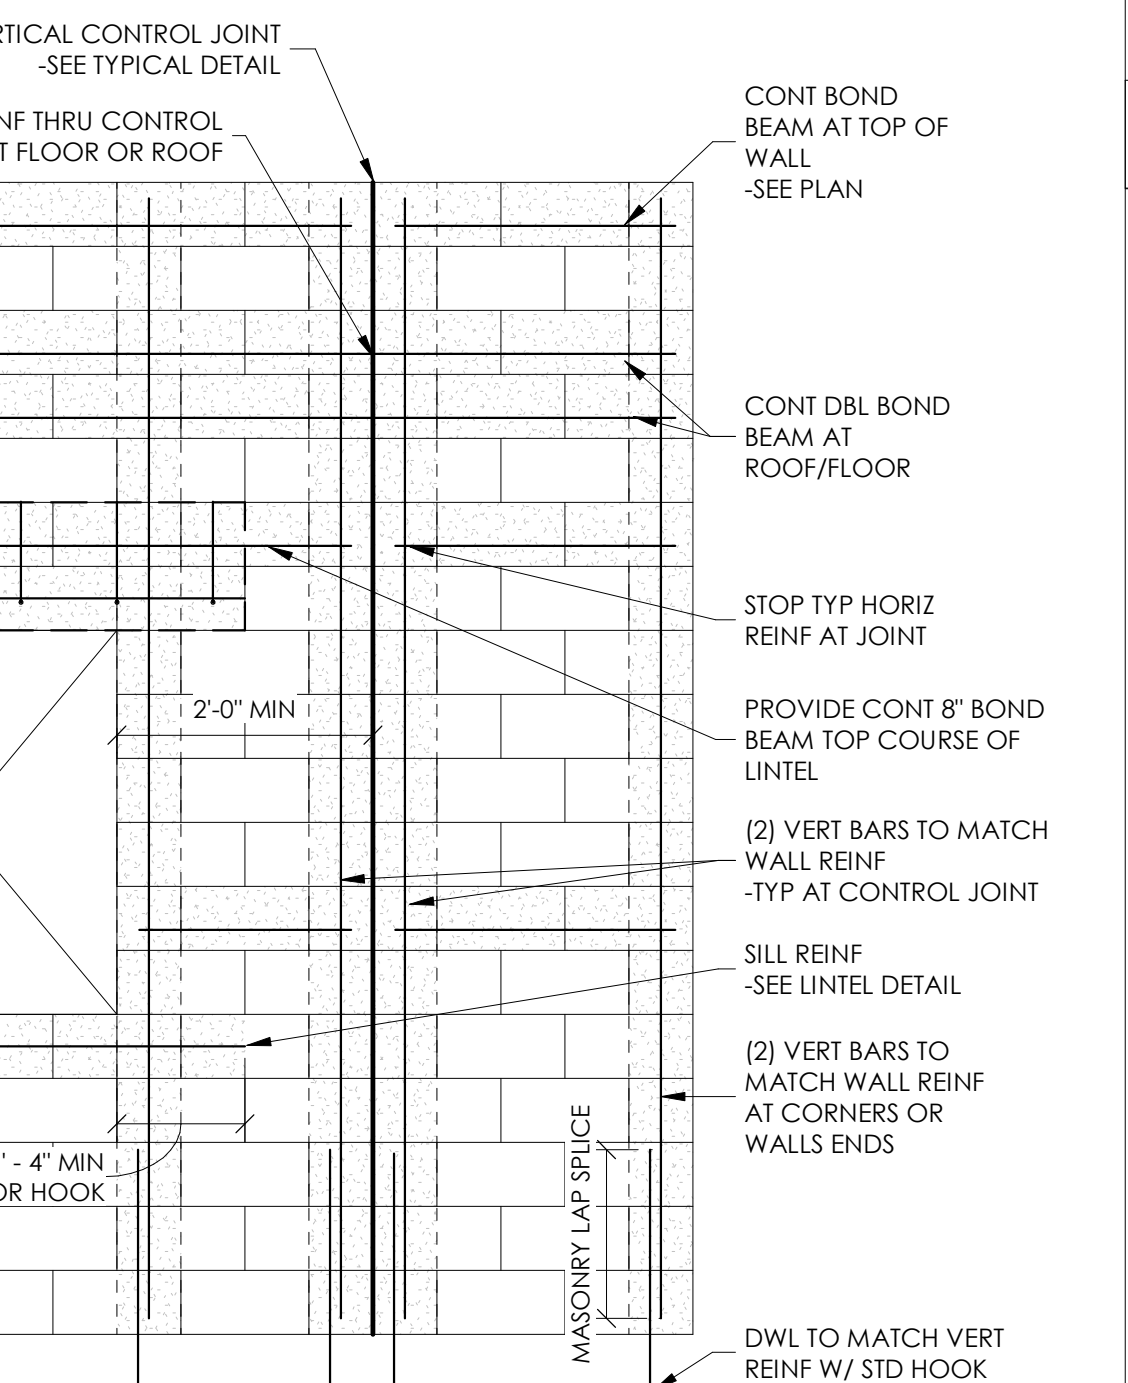

9 TYPICAL MASONRY WALL ELEVATION SCALE: 1/2" = 1'-0"

VLK ARCHITECTS

ARCHITECT
 VLK Architects
 20445 State Hwy 249, Suite 350
 Houston, Texas 77070
 Main Phone: 281.671.2300
 www.vlkarchitects.com

STRUCTURAL
 Dunaway
 3200 Wilcrest Dr., Ste 4400
 Houston, Texas 77042
 Main Phone: 512.306.8252
 www.dunaway.com

CYPRESS-FAIRBANKS INDEPENDENT SCHOOL DISTRICT HOUSTON, TEXAS

2024 Cook, Labay & Truitt MS Renovations

ISSUED: 02/24/2025

Revision No. 1 ADDENDUM 1 Revision Date 03/06/25

Director SW Drawn By LM
 Designer AB Quality Control SW
 Proj. Eng. AB

PROJECT NO. 11364
 SHEET TITLE TYPICAL MASONRY DETAILS
 SHEET NO.

S10.40

COPYRIGHT © 2024 VLK ARCHITECTS

ARCHITECT

VLK Architects
20445 State Hwy 249, Suite 350
Houston, Texas 77070
Main Phone: 281.671.2300
www.vlkarchitects.com

STRUCTURAL

Dunaway
5200 Wilcrest Dr., Ste 4400
Houston, Texas 77042
Main Phone: 512.306.8252
www.dunaway.com



ISSUED: 02/24/2025

Revision No. Revision Date
1 ADDENDUM 1 03/06/25

Director SW Drawn By LM
Designer AB Quality Control SW
Proj. Eng. AB

PROJECT NO.


11364

SHEET TITLE


ROOF FRAMING DETAILS

SHEET NO.


S14.10

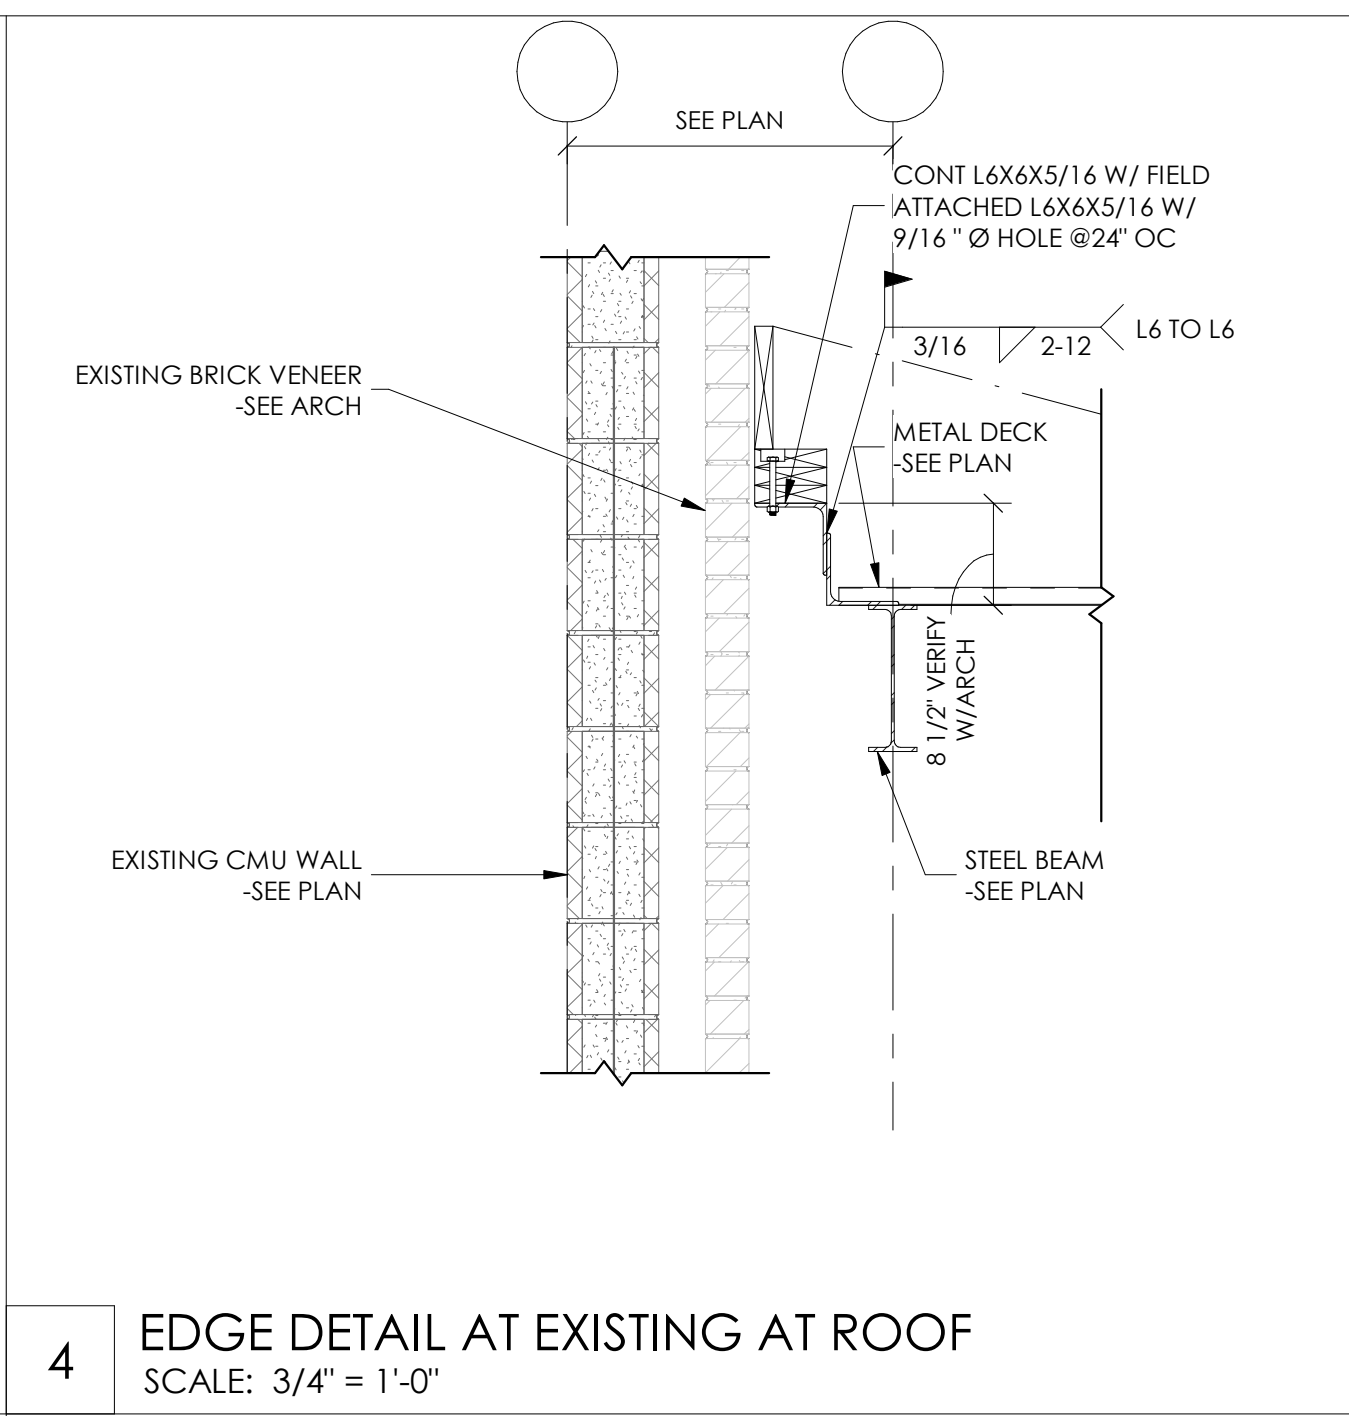


4 EDGE DETAIL AT EXISTING AT ROOF
SCALE: 3/4" = 1'-0"

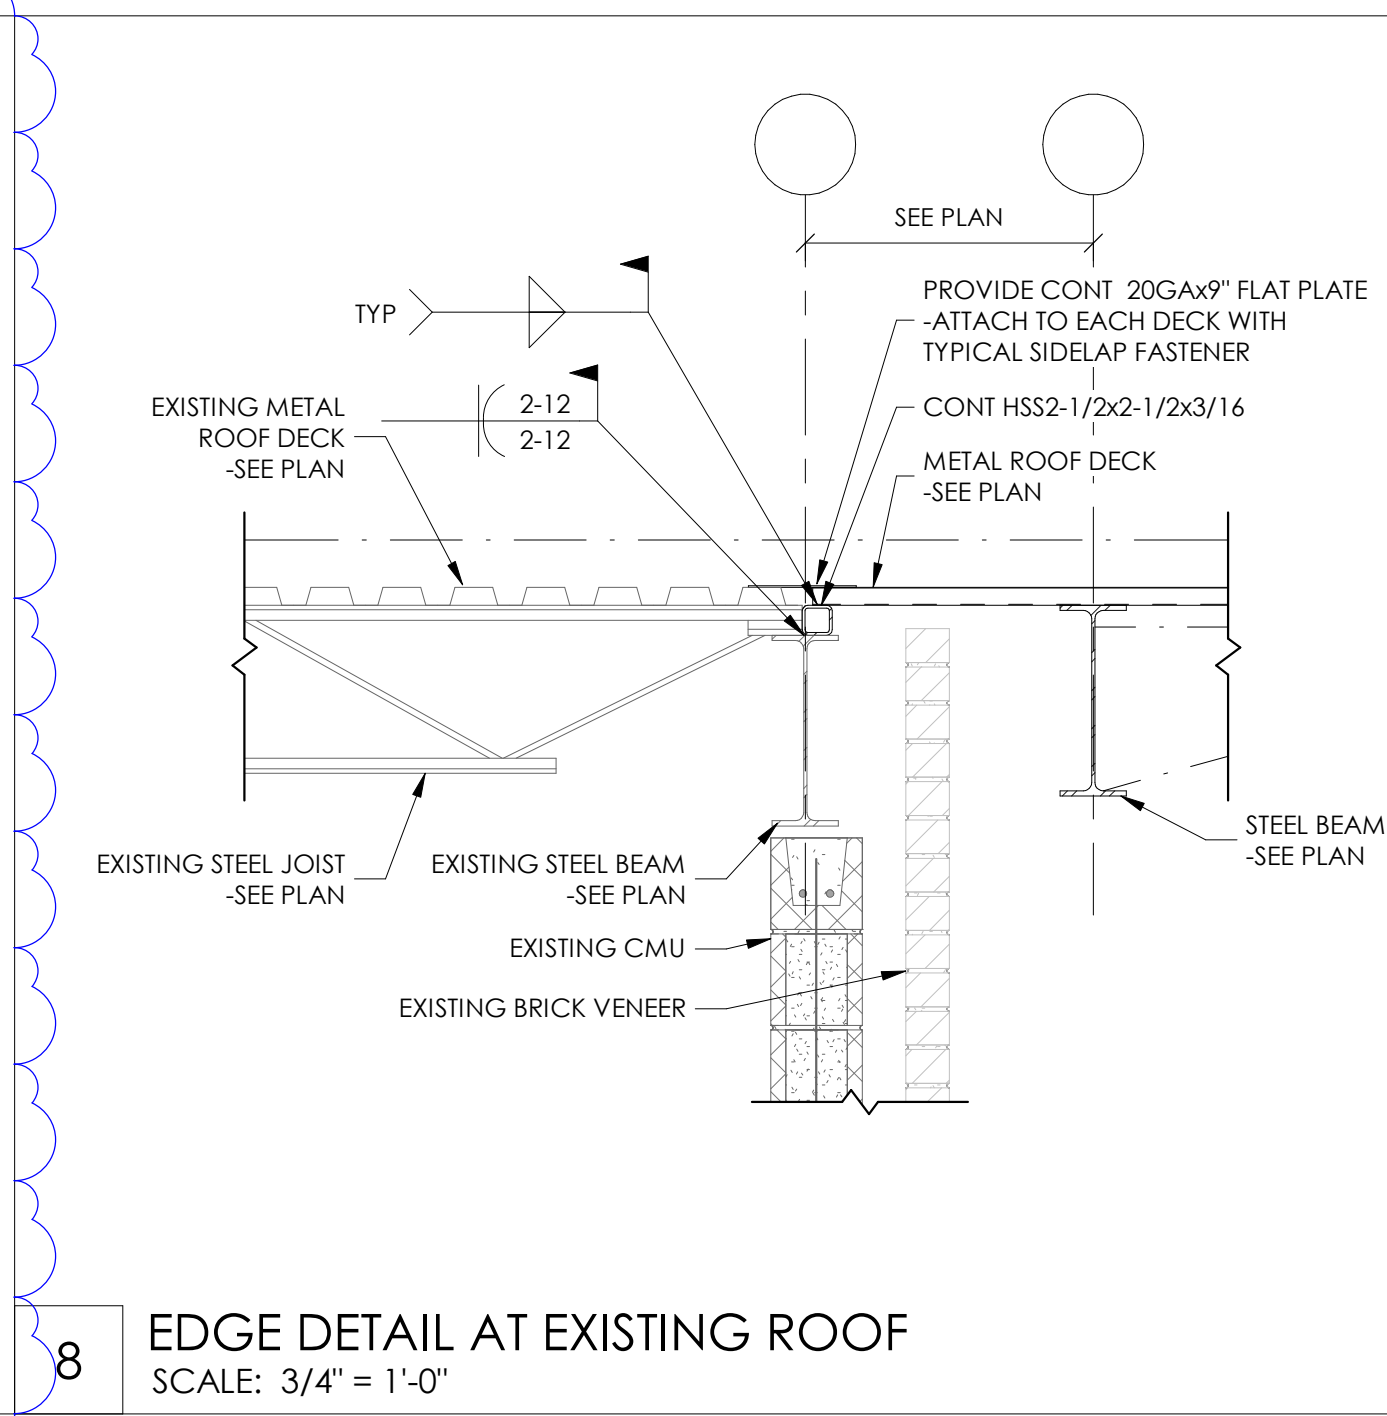


8 EDGE DETAIL AT EXISTING ROOF
SCALE: 3/4" = 1'-0"

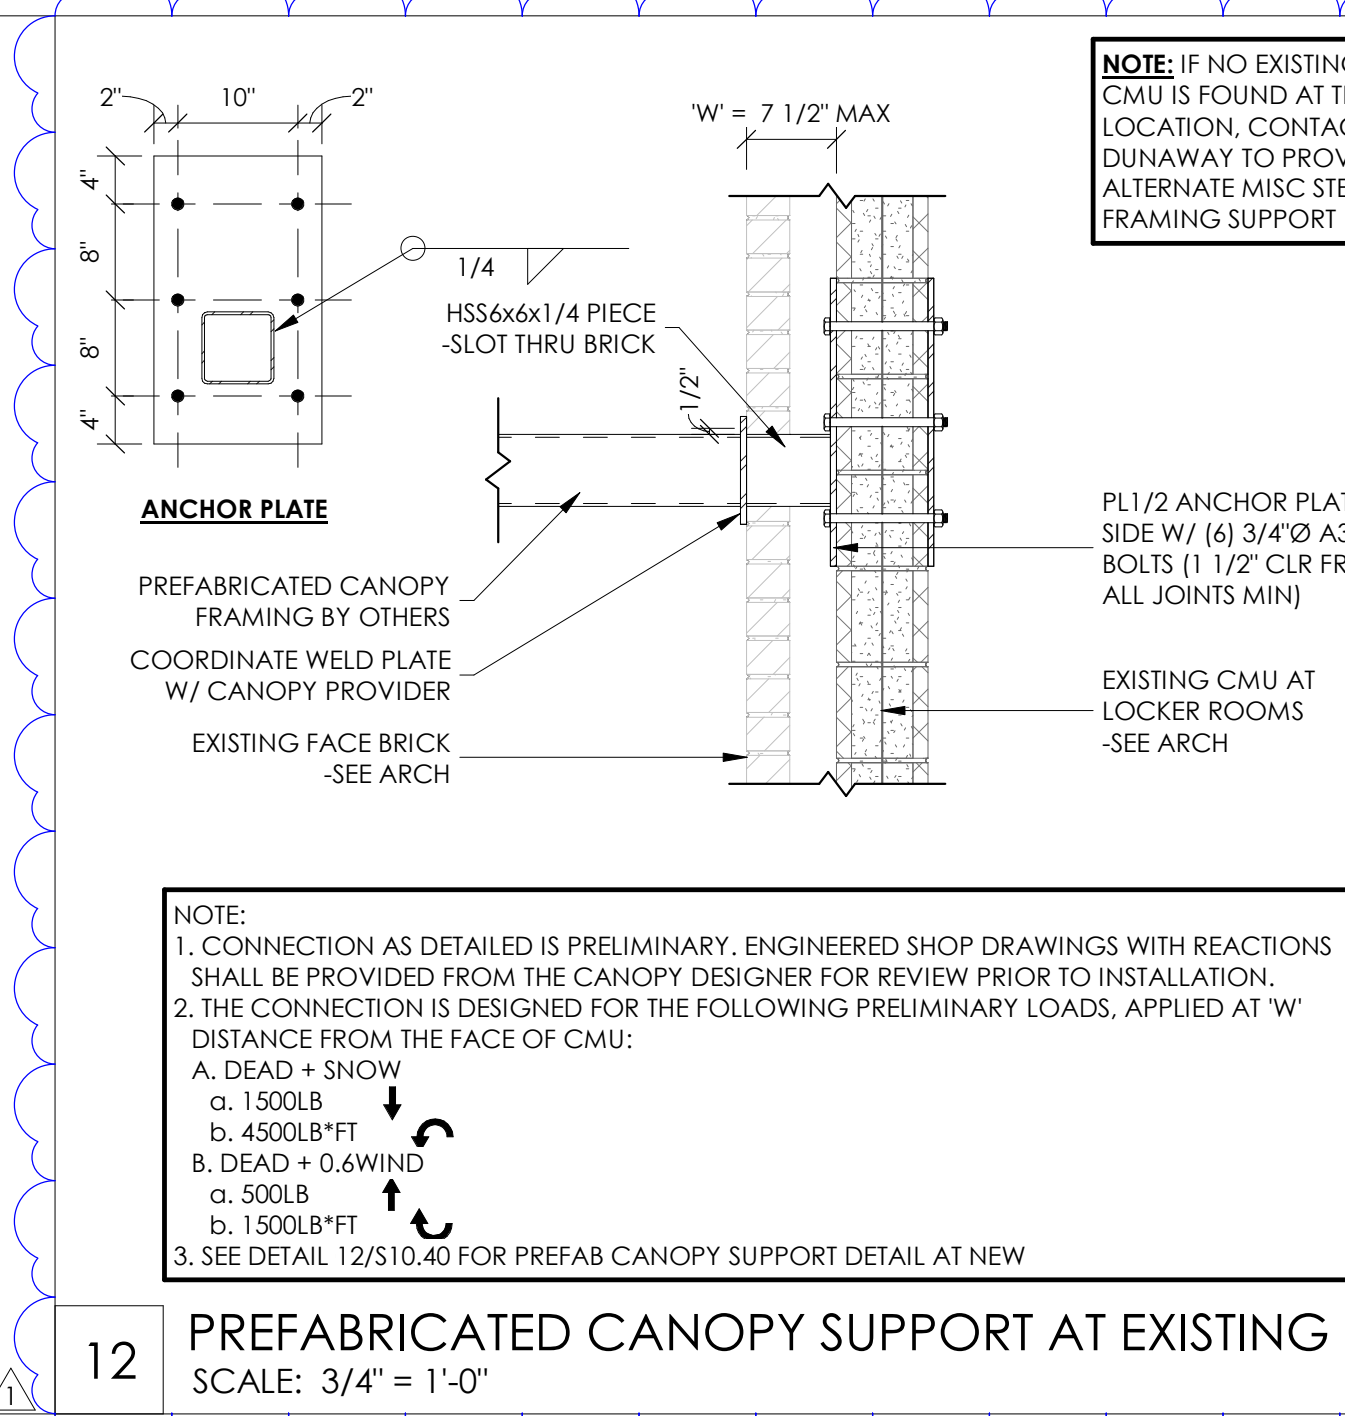


12 PREFABRICATED CANOPY SUPPORT AT EXISTING
SCALE: 3/4" = 1'-0"

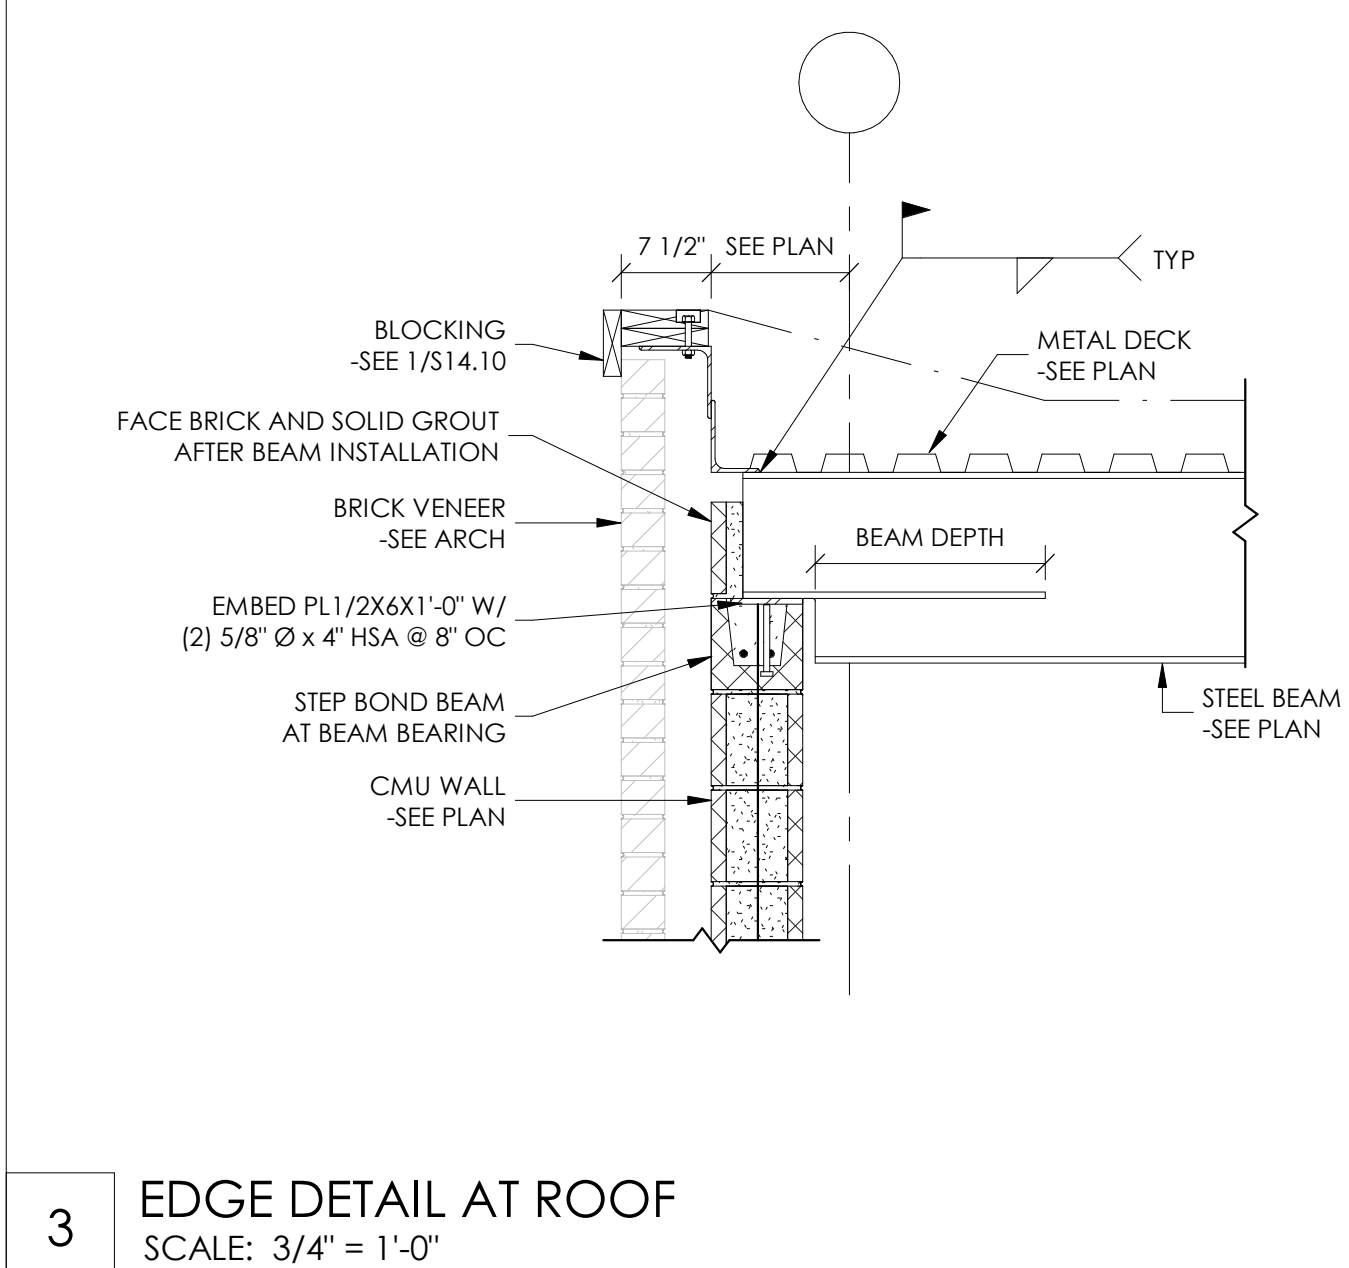


3 EDGE DETAIL AT ROOF
SCALE: 3/4" = 1'-0"

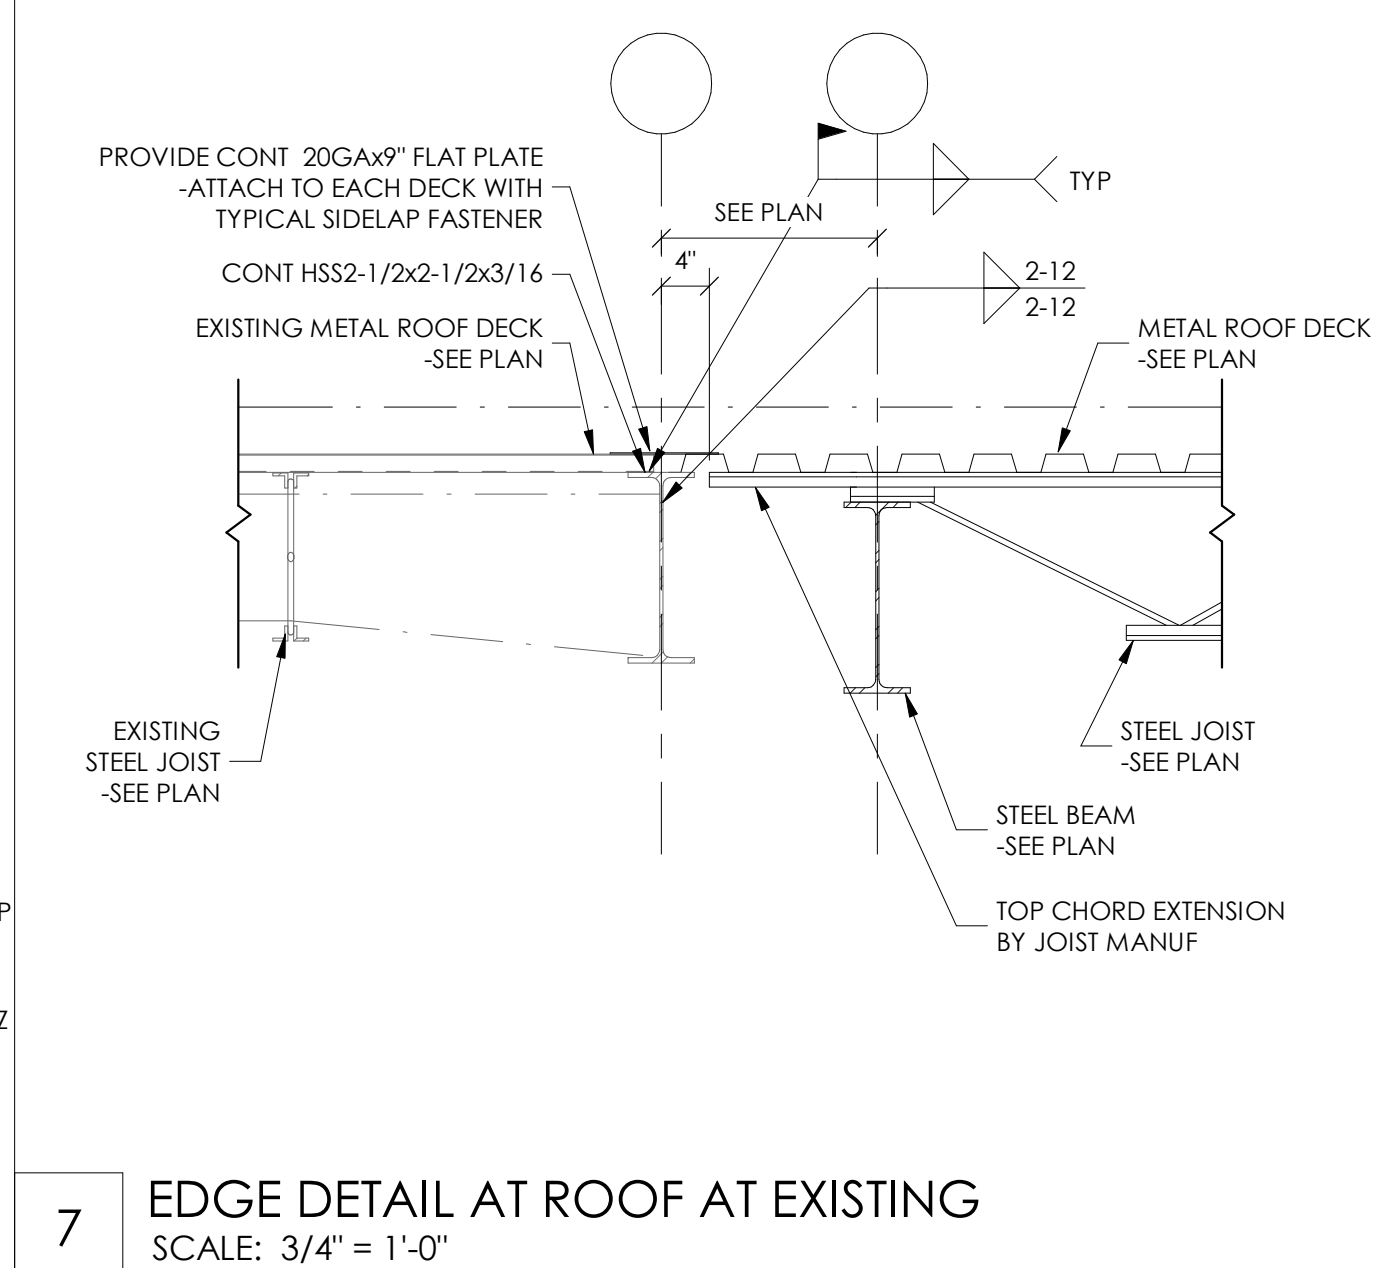


7 EDGE DETAIL AT ROOF AT EXISTING
SCALE: 3/4" = 1'-0"

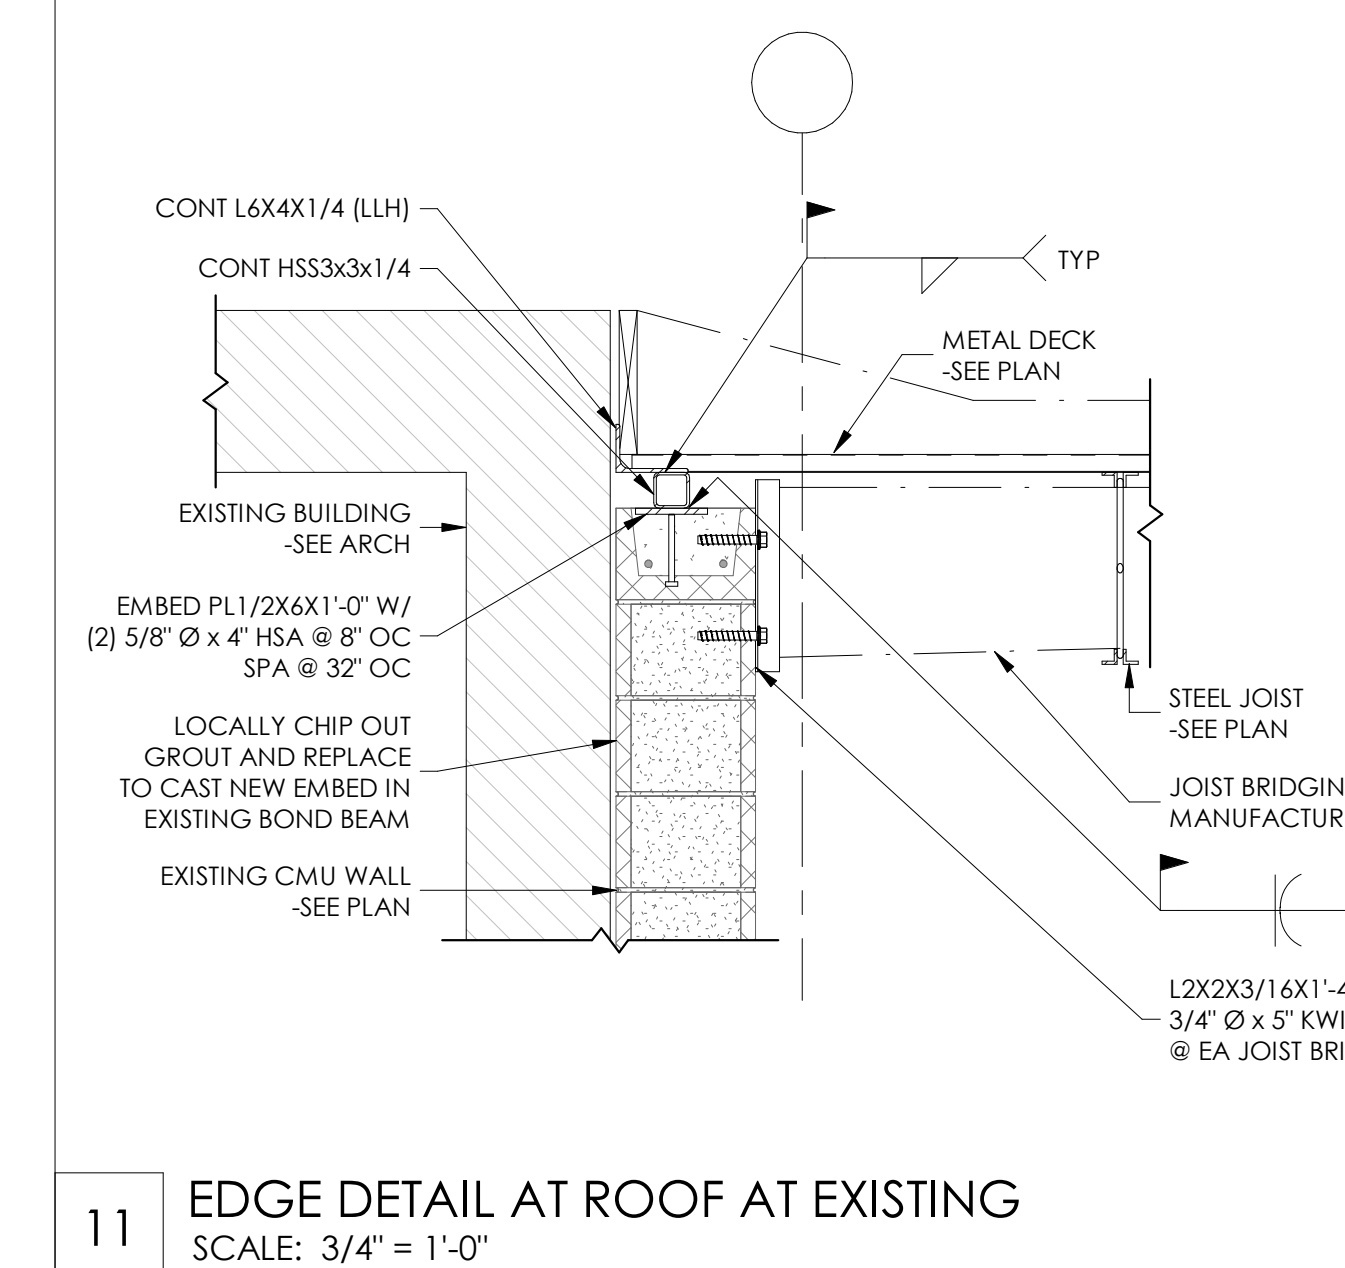


11 EDGE DETAIL AT ROOF AT EXISTING
SCALE: 3/4" = 1'-0"

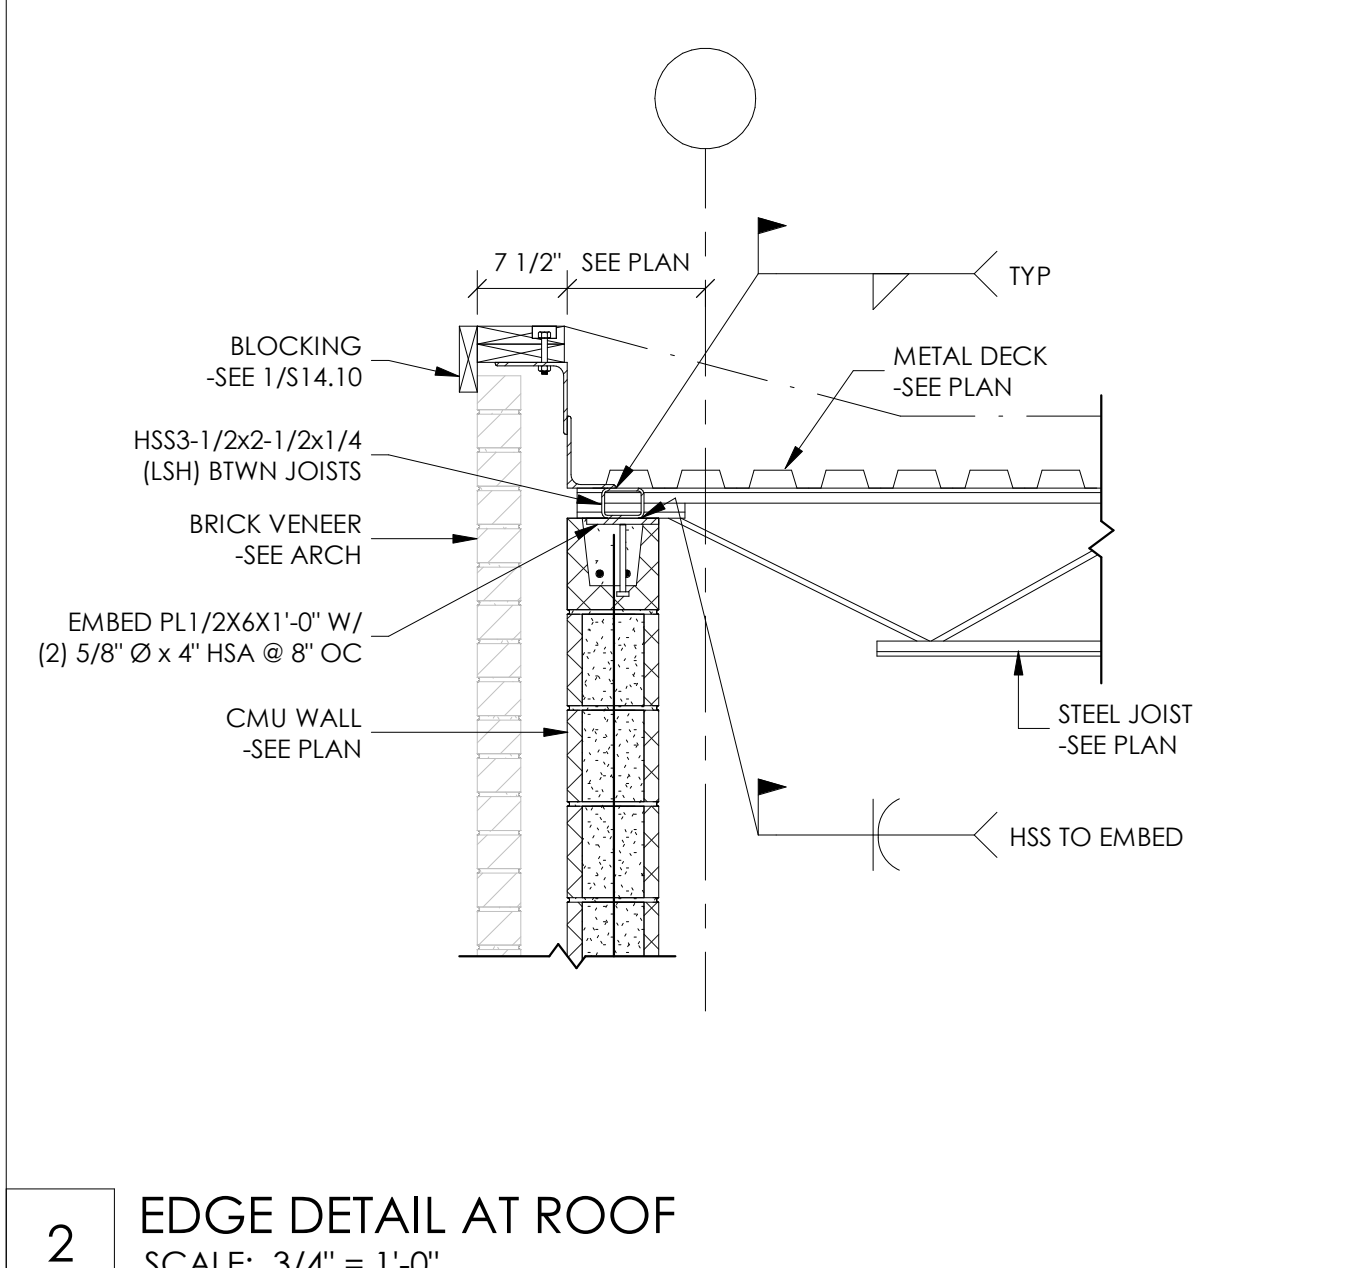


2 EDGE DETAIL AT ROOF
SCALE: 3/4" = 1'-0"

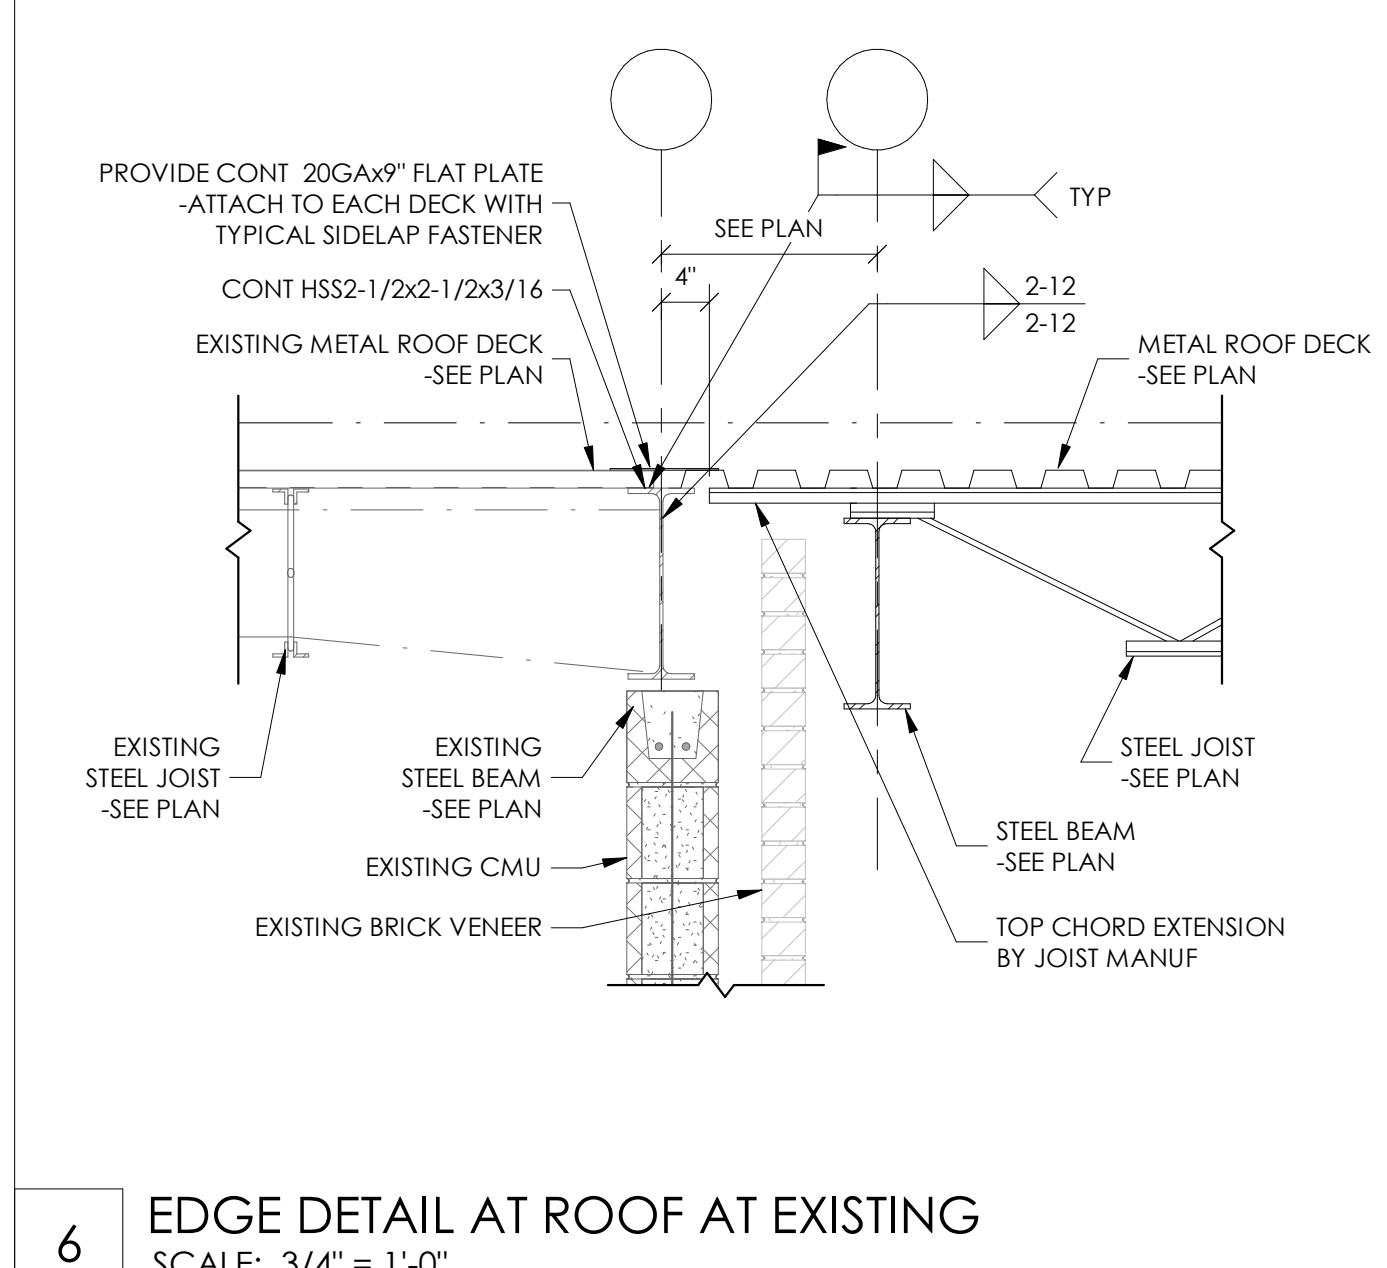


6 EDGE DETAIL AT ROOF AT EXISTING
SCALE: 3/4" = 1'-0"

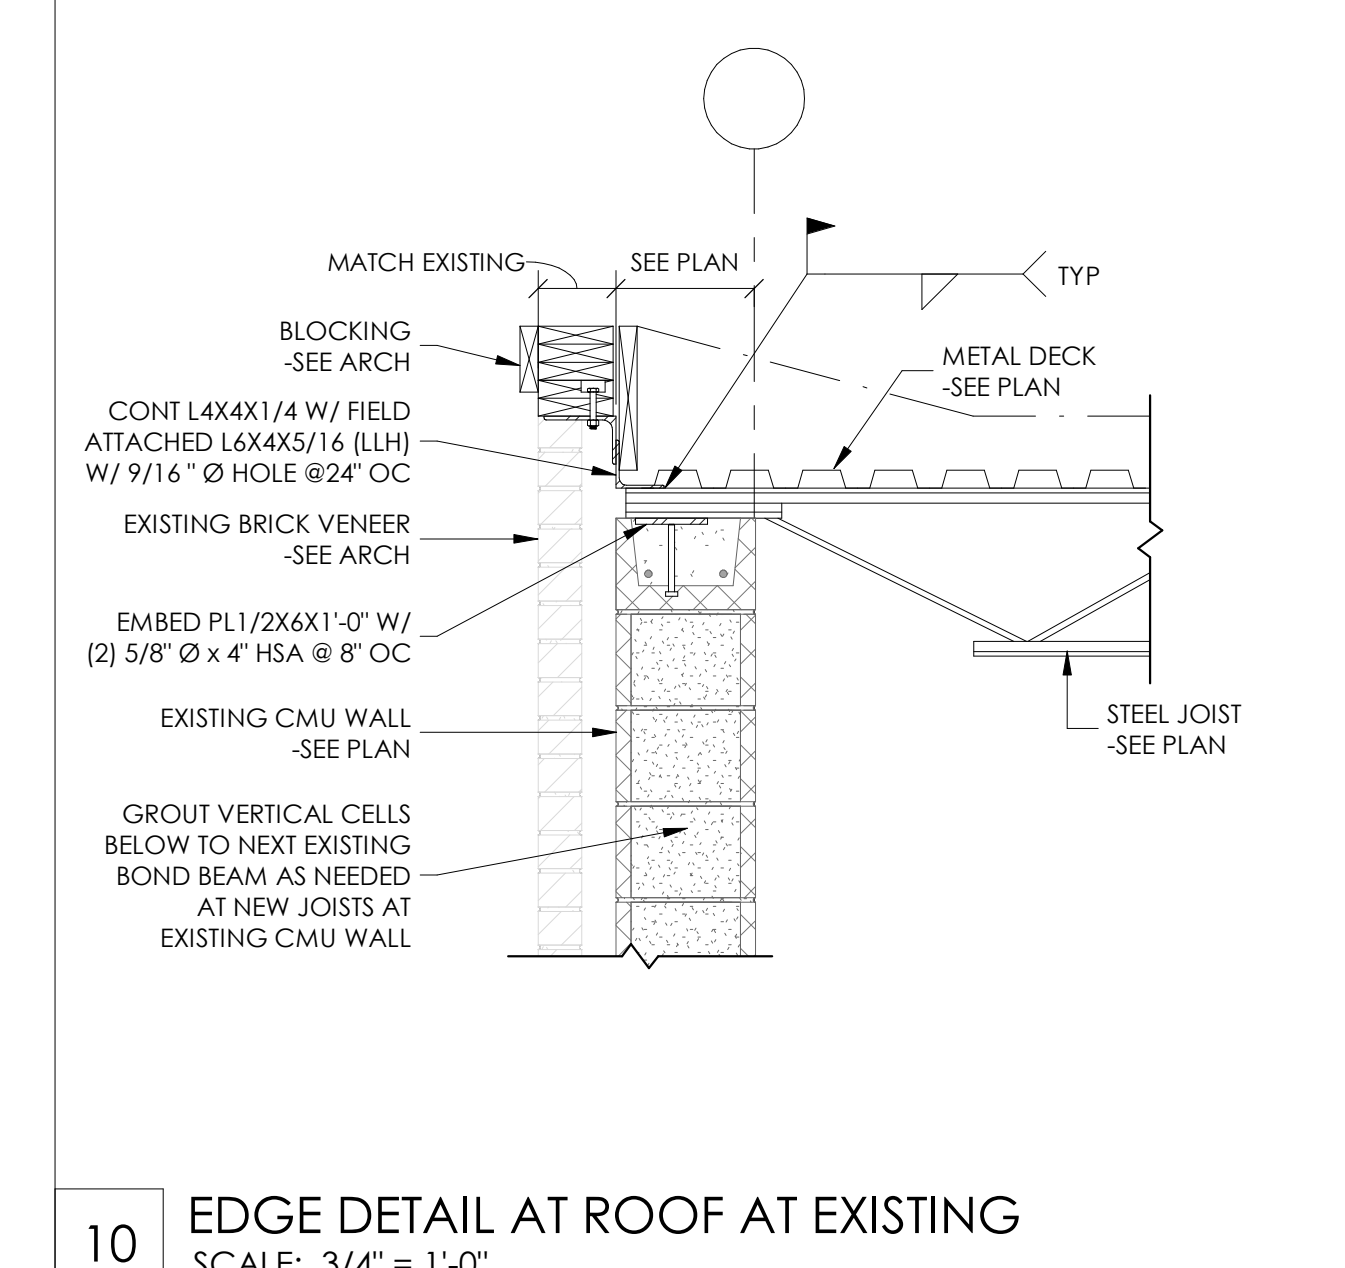


10 EDGE DETAIL AT ROOF AT EXISTING
SCALE: 3/4" = 1'-0"

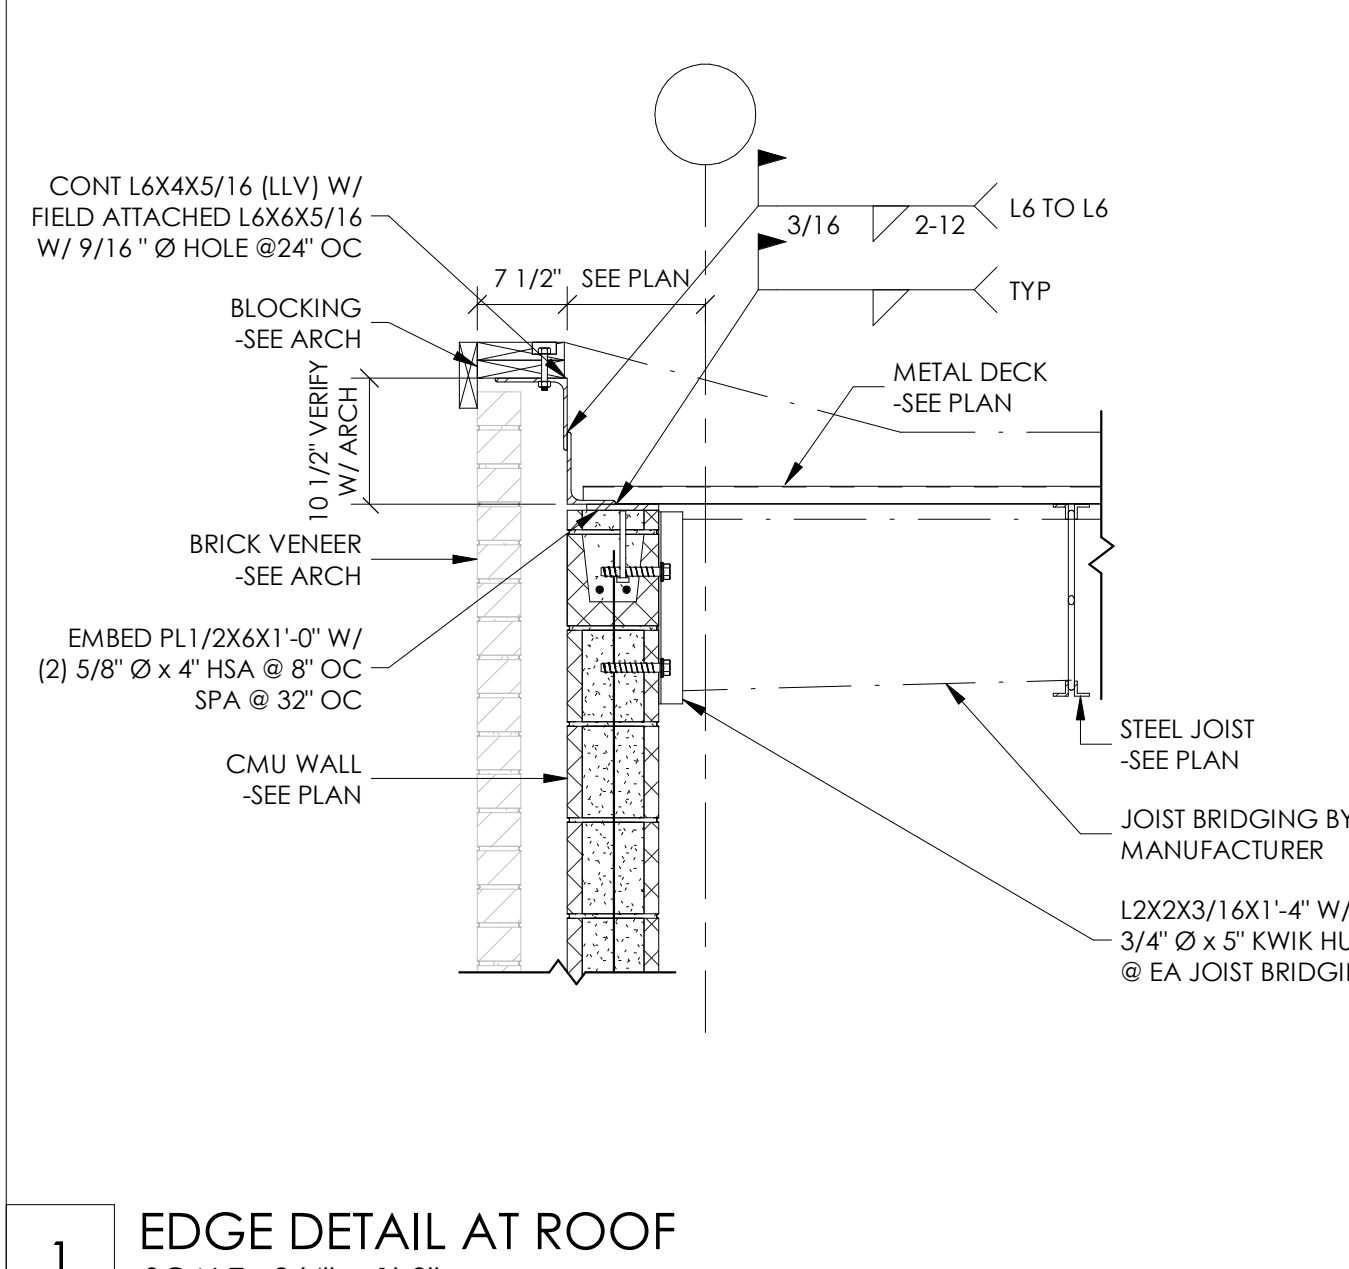


1 EDGE DETAIL AT ROOF
SCALE: 3/4" = 1'-0"

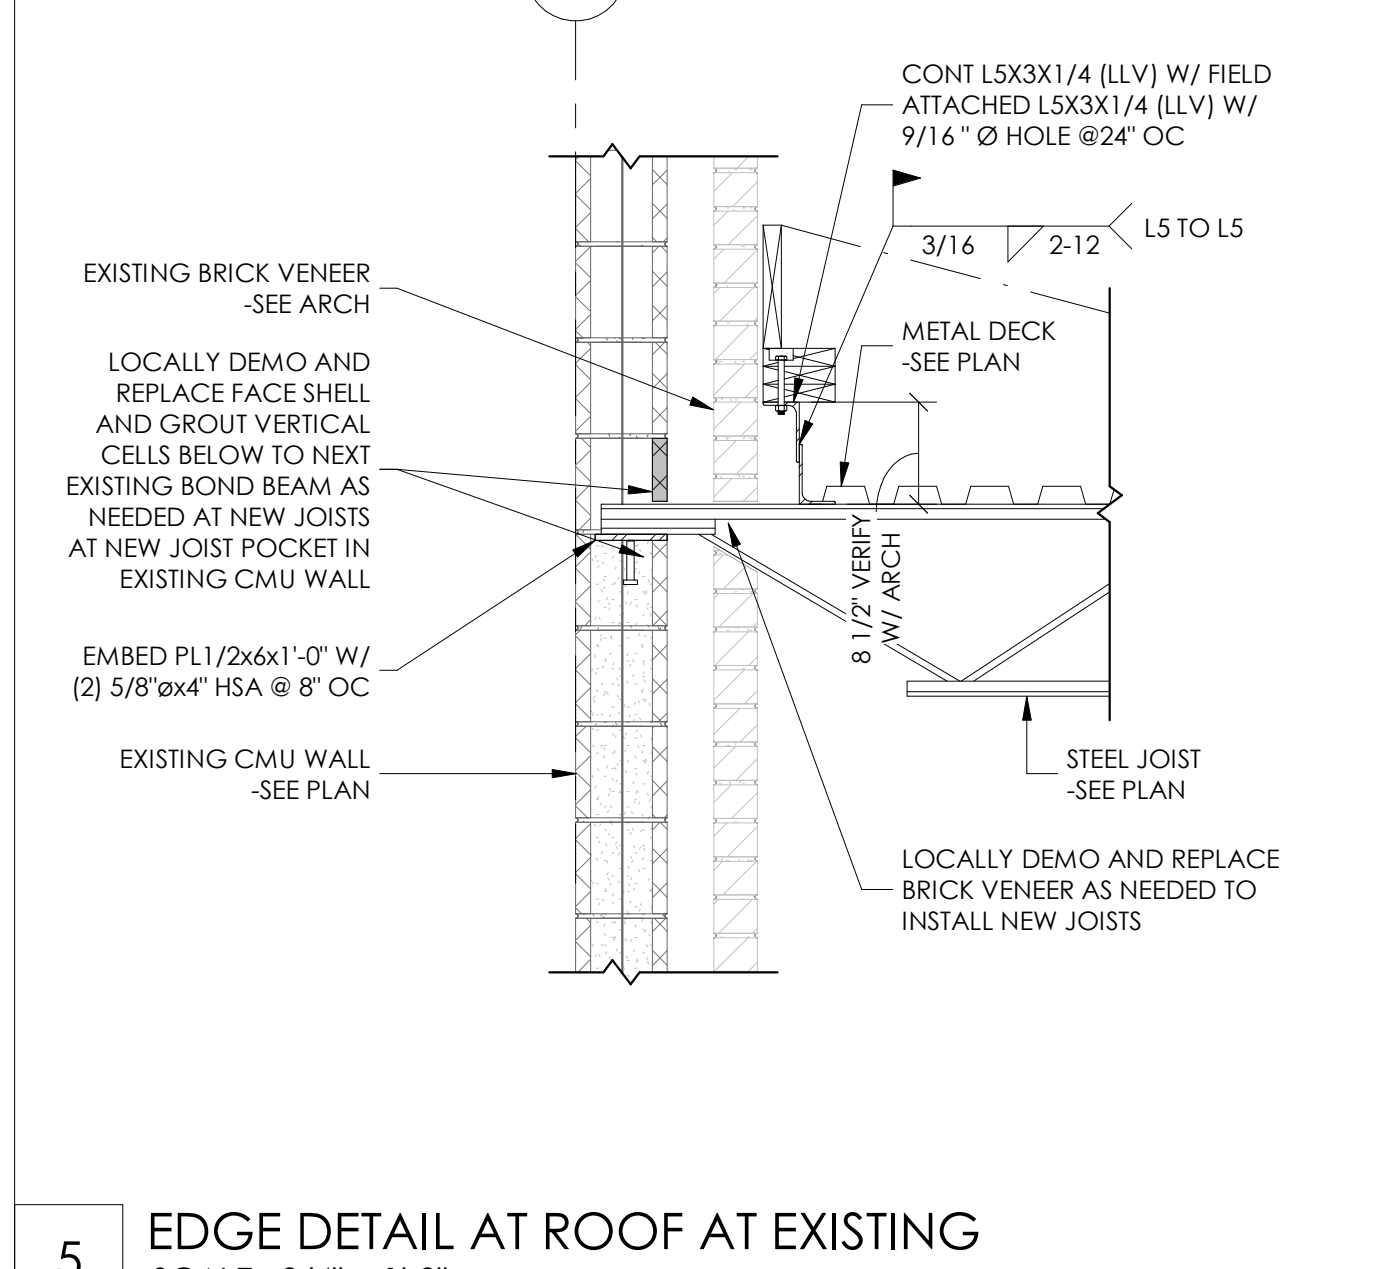

5 EDGE DETAIL AT ROOF AT EXISTING
SCALE: 3/4" = 1'-0"

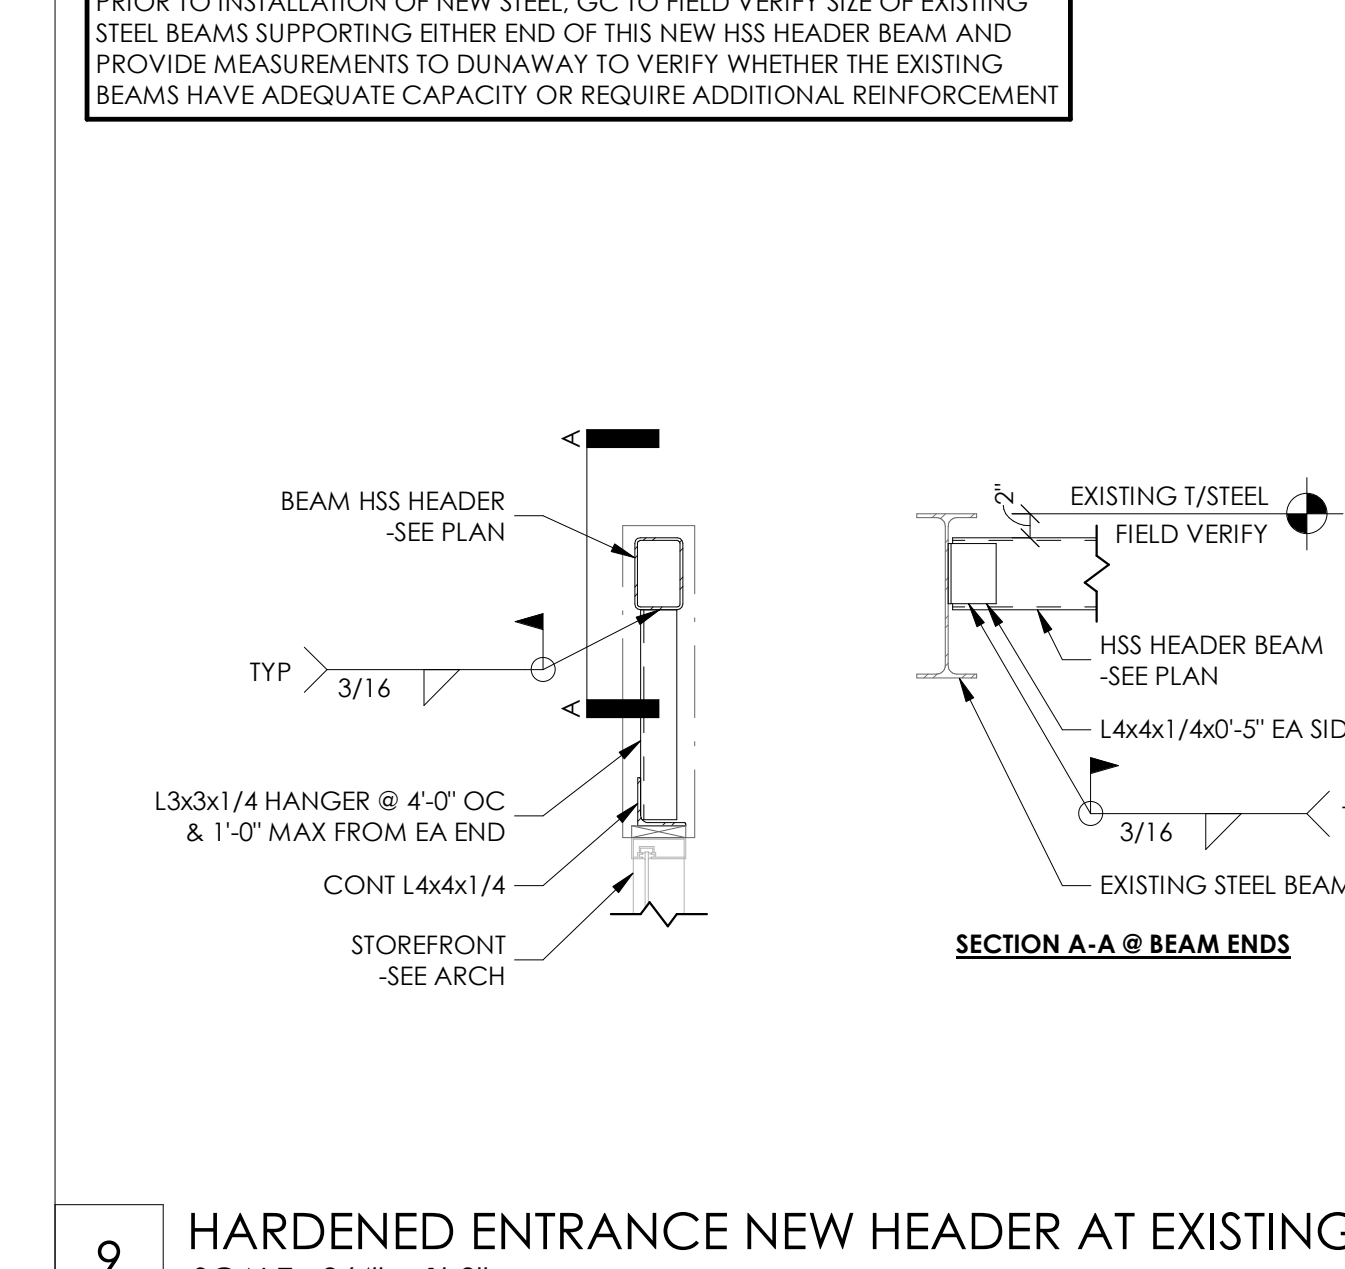

9 HARDENED ENTRANCE NEW HEADER AT EXISTING
SCALE: 3/4" = 1'-0"

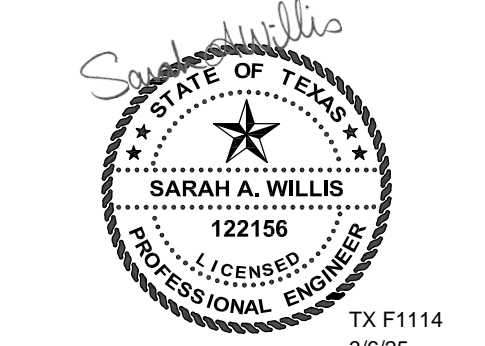




ISSUED: 02/24/2025

REVISIONS	Revision Date
1 ADDENDUM 1	03/06/25

Director	Drawn By
SW	LM
Designer	Quality Control
AB	SW
Proj. Eng.	
AB	




PROJECT NO.	11365
SHEET TITLE	TYPICAL MASONRY DETAILS
SHEET NO.	

BRACE FRAMING			
STUD TYPE	SPACING	MAX LENGTH	MISCELLANEOUS
3625162-43	4'-0" OC	14'-0"	BRACE @ MID-PT FOR LENGTHS OVER 14'-0"
6005162-43	4'-0" OC	20'-0"	BRACE @ MID-PT FOR LENGTHS OVER 20'-0"

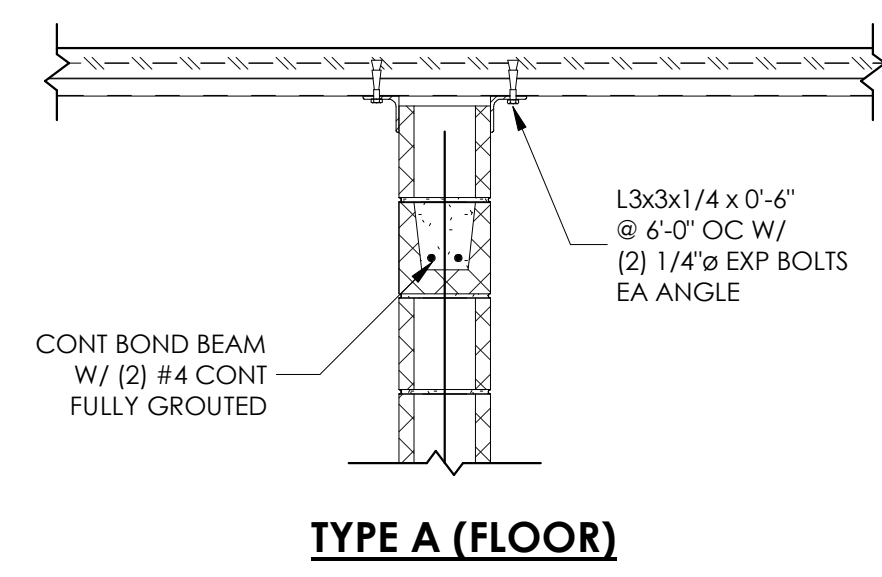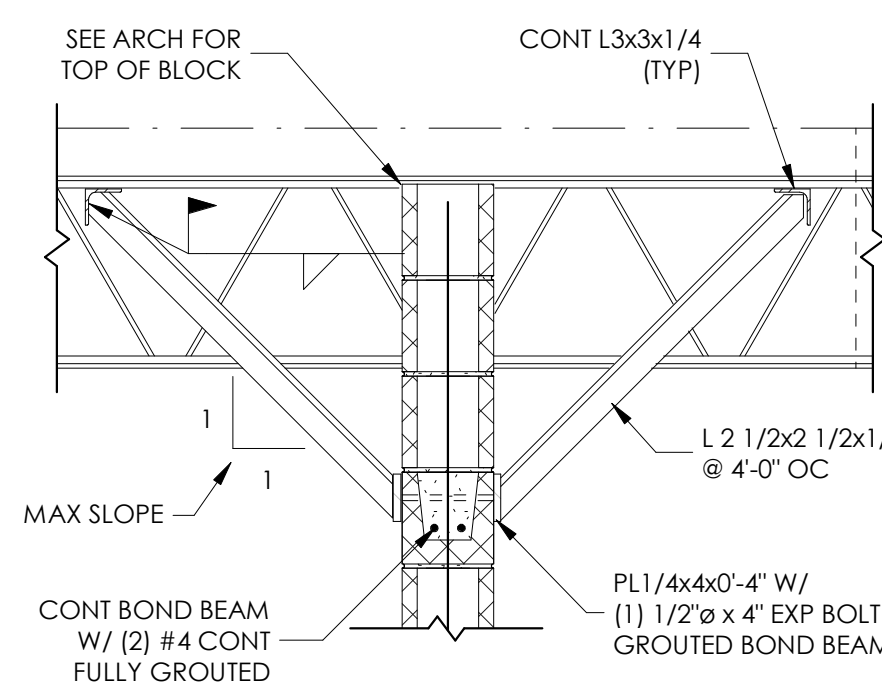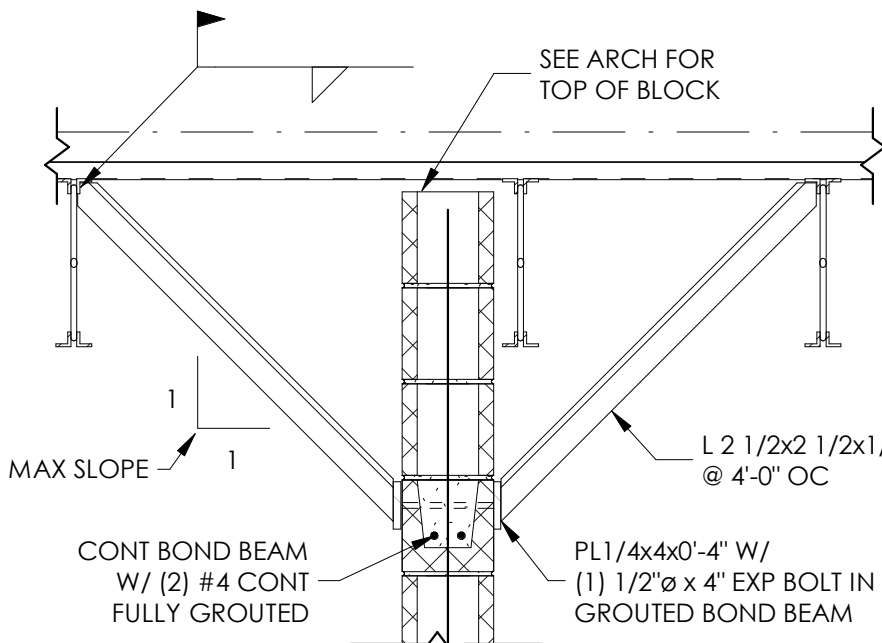

TYPE A (FLOOR)

TYPE B (FLOOR / ROOF)

TYPE C (FLOOR / ROOF)

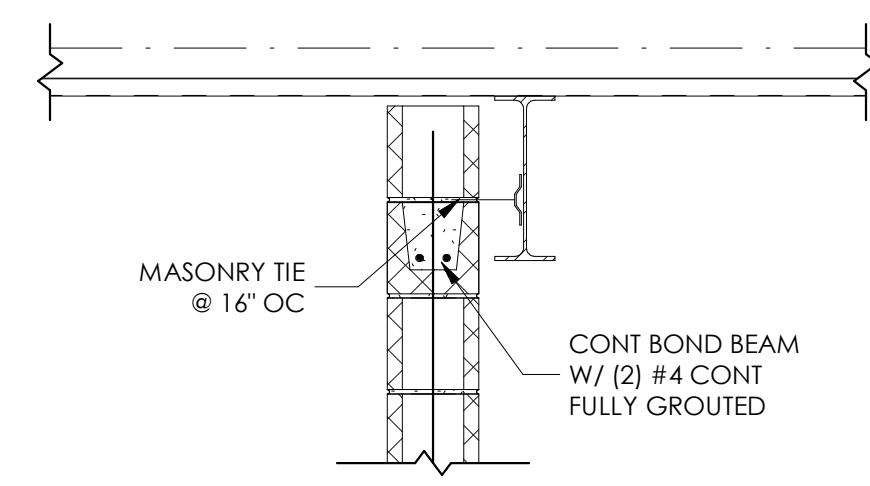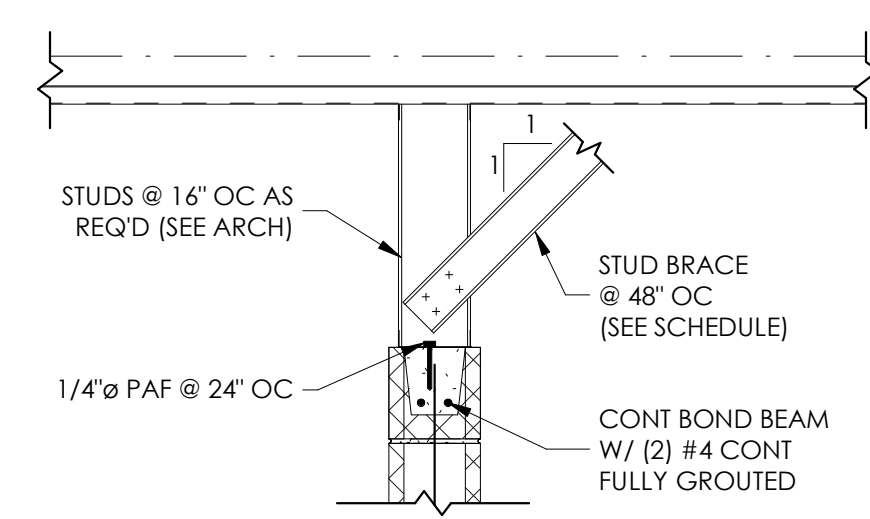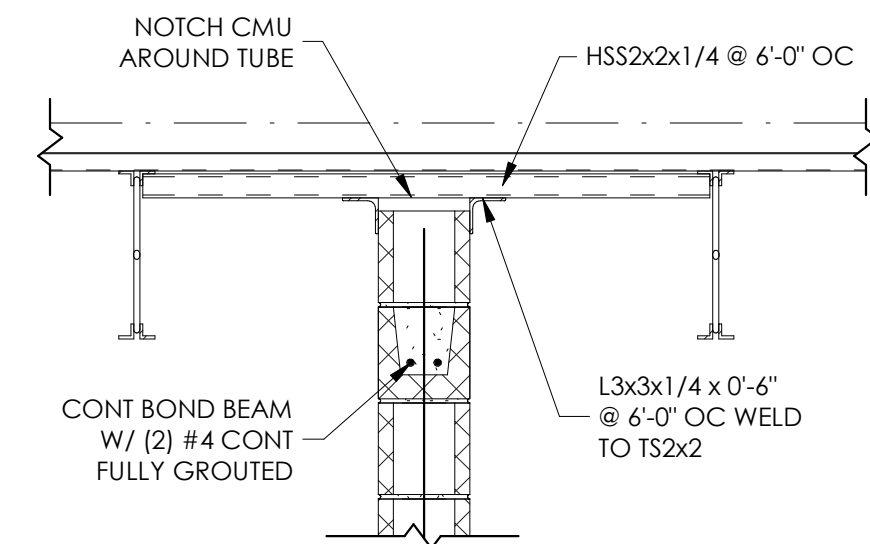VERTICAL FRAMING			
STUD TYPE	SPACING	MAX LENGTH	MISCELLANEOUS
3625162-43	1'-4" OC	22'-6"	ONE LAYER * SHEATHING (MIN)
6005162-43	1'-4" OC	32'-9"	ONE LAYER * SHEATHING (MIN)


* ALTERNATIVELY PROVIDE 1/2x2x1/4 GA HORIZONTAL CHANNEL FASTENED TO STUDS WITH 1/2x1/4x1/4 GA CLIP AT 4'-0" OC VERTICALLY

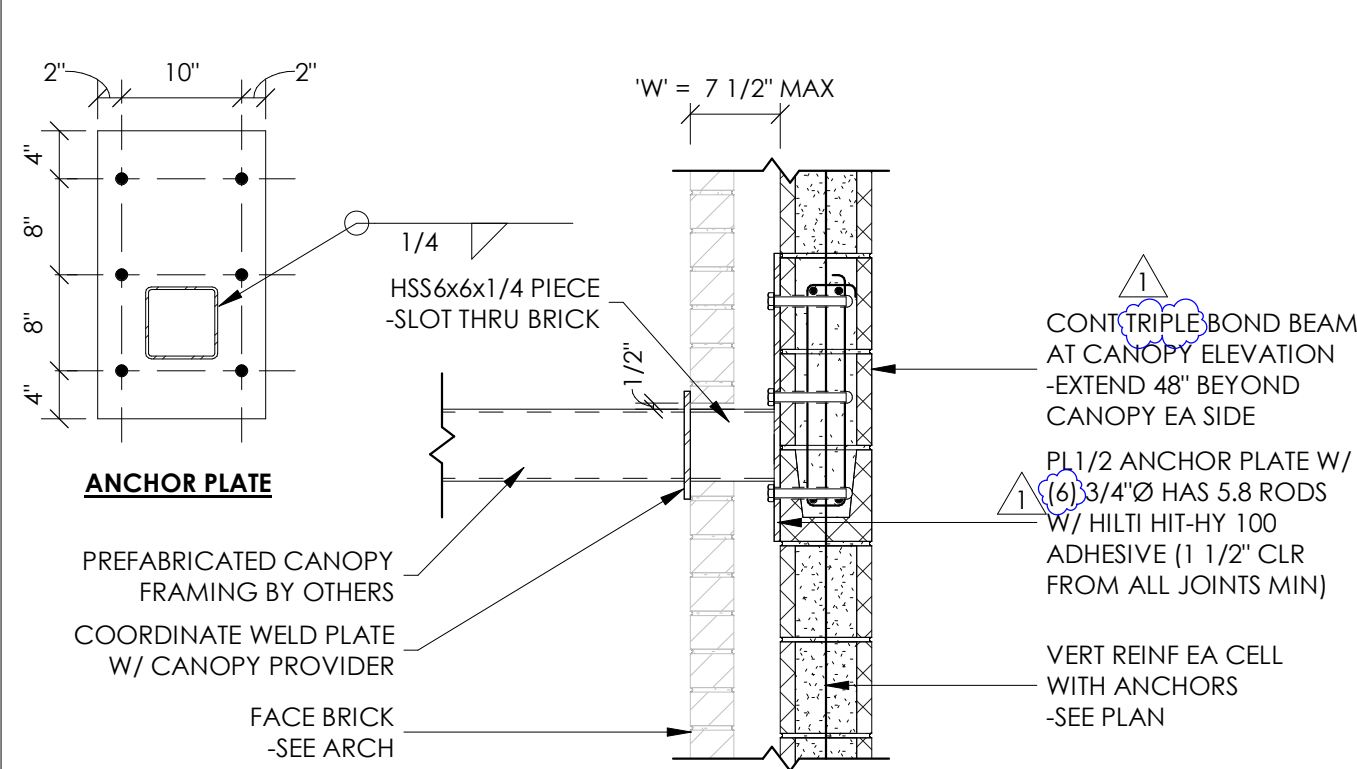
TYPE D (FLOOR/ROOF)

TYPE E (FLOOR / ROOF)

TYPE F (FLOOR / ROOF)

- NOTES: INTERIOR LOCATIONS ONLY**
- NON-LOAD BEARING MASONRY WALL BRACES. BRACING AT THE TOP OF MASONRY WALLS IS REQUIRED ON STRAIGHT RUNS OF WALL MORE THAN SIX FEET FROM A CORNER, INTERSECTING WALL, OR AS NOTED ABOVE.
 - WHEN THE MASONRY WALL TERMINATES AT THE BOTTOM OF THE DECK, A TYPE 'A' ATTACHMENT AT THE FLOOR DECK OR A TYPE 'B', 'C', 'D' OR 'E' ATTACHMENT AT EITHER THE FLOOR OR ROOF MAY BE USED. WHEN WALLS TERMINATE ABOVE THE CEILING A TYPE 'B', 'C' OR 'E' ATTACHMENT SHOULD BE USED.

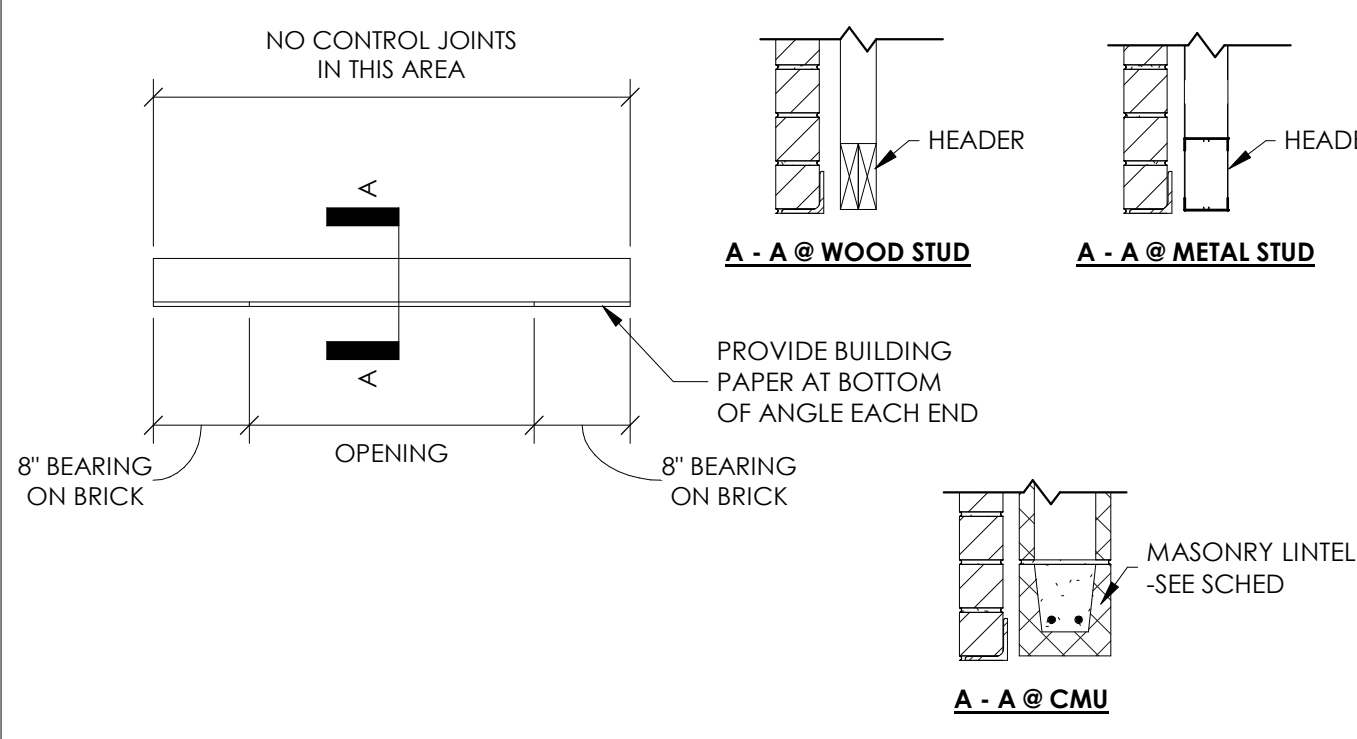TYPICAL CMU WALL BRACING LOCATION PLAN


- NOTE:**
- CONNECTION AS DETAILED IS PRELIMINARY. ENGINEERED SHOP DRAWINGS WITH REACTIONS SHALL BE PROVIDED FROM THE CANOPY DESIGNER FOR REVIEW PRIOR TO INSTALLATION.
 - THE CONNECTION IS DESIGNED FOR THE FOLLOWING PRELIMINARY LOADS. APPLIED AT 'W' DISTANCE FROM THE FACE OF CMU:
 A. DEAD + SNOW
 a. 150LB
 b. 450LB/FT
 B. DEAD + 0.6WIND
 c. 500LB
 d. 1500LB/FT


12 PRE-FABRICATED CANOPY SUPPORT DETAIL
 SCALE: 3/4" = 1'-0"


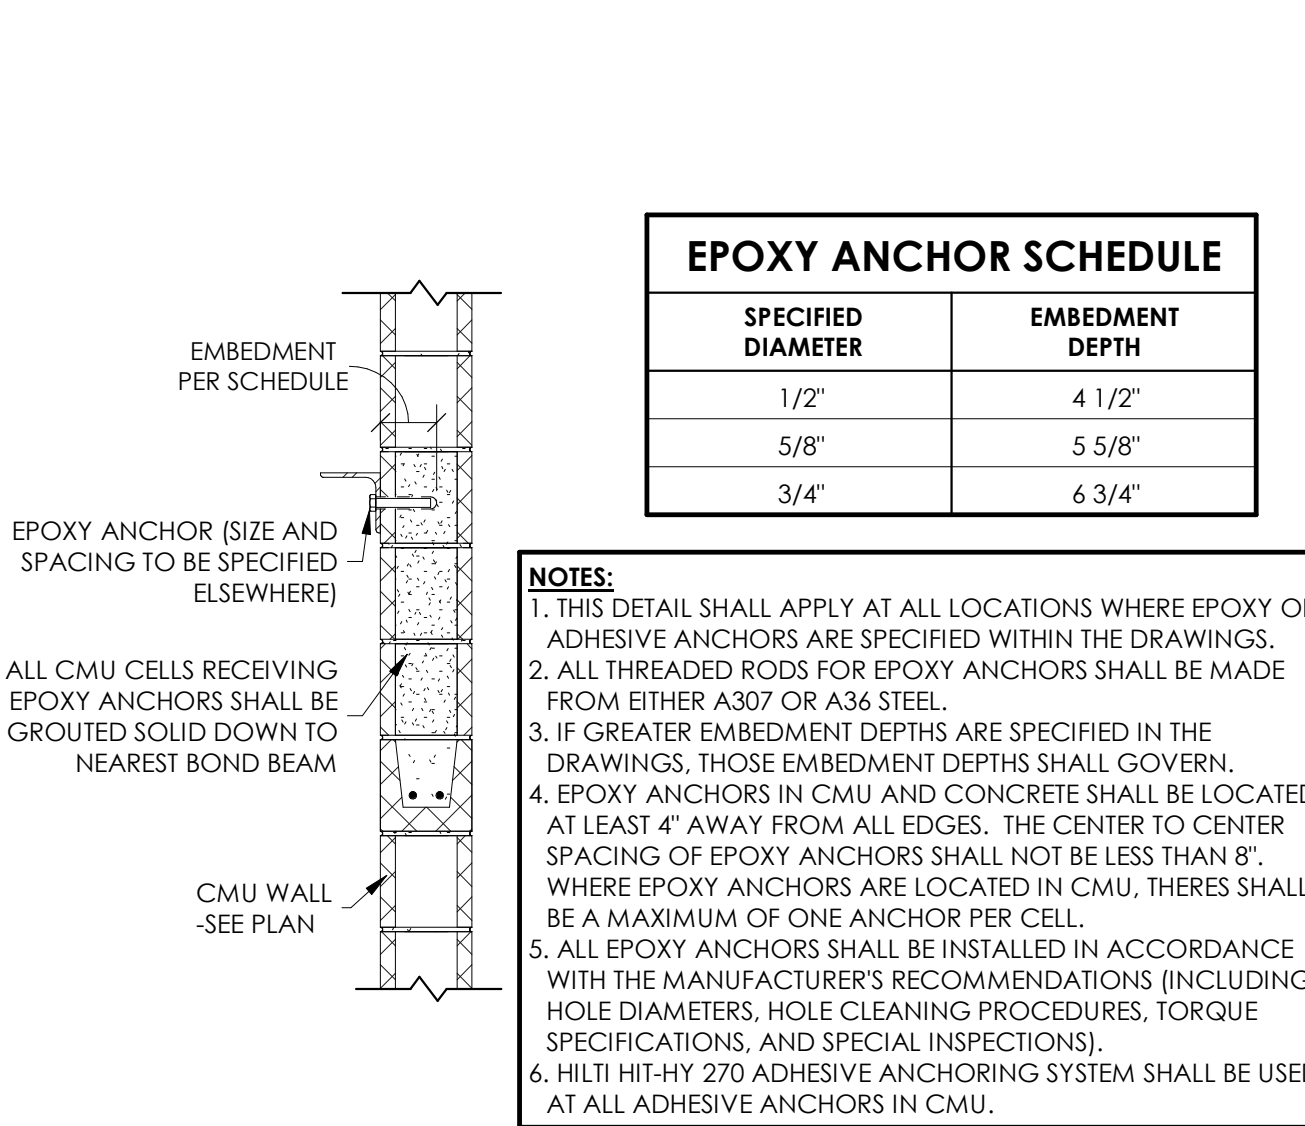
BRICK LOOSE LINTEL SCHEDULE		
OPENING	ANGLE SIZE	
LESS THAN 5'-0"	L 3 1/2 x 3 1/2 x 5/16	
5'-0" TO LESS THAN 6'-0"	L 5 x 3 1/2 x 5/16 (LLV)	
6'-0" TO LESS THAN 8'-0"	L 6 x 3 1/2 x 5/16 (LLV)	
8'-0" TO LESS THAN 9'-0"	L 7 x 4 x 3/8 (LLV)	

NOTES:
 1. LLV = LONG LEG VERTICAL
 2. GALVANIZE ALL LINTEL ANGLES.
 3. ANGLE SIZES ARE MIN - SEE ARCHITECTURAL DRAWINGS.

11 BRICK LOOSE LINTEL SCHEDULE
 SCALE: 3/4" = 1'-0"

MASONRY LAP SPlice LENGTHS, F _m = 1,900 psf, GRADE 60 REINFORCEMENT IN CENTER OF WALL IN.					
BAR SIZE	6-in. CMU	8-in. CMU	10-in. CMU	12-in. CMU	BAR SIZE
#3	12	12	12	12	#3
#4	20	15	12	12	#4
#5	32	23	18	15	#5
#6	54	43	34	28	#6
#7	N/A	60	46	38	#7
#8	N/A	72	71	57	#8
#9	N/A	N/A	82	74	#9

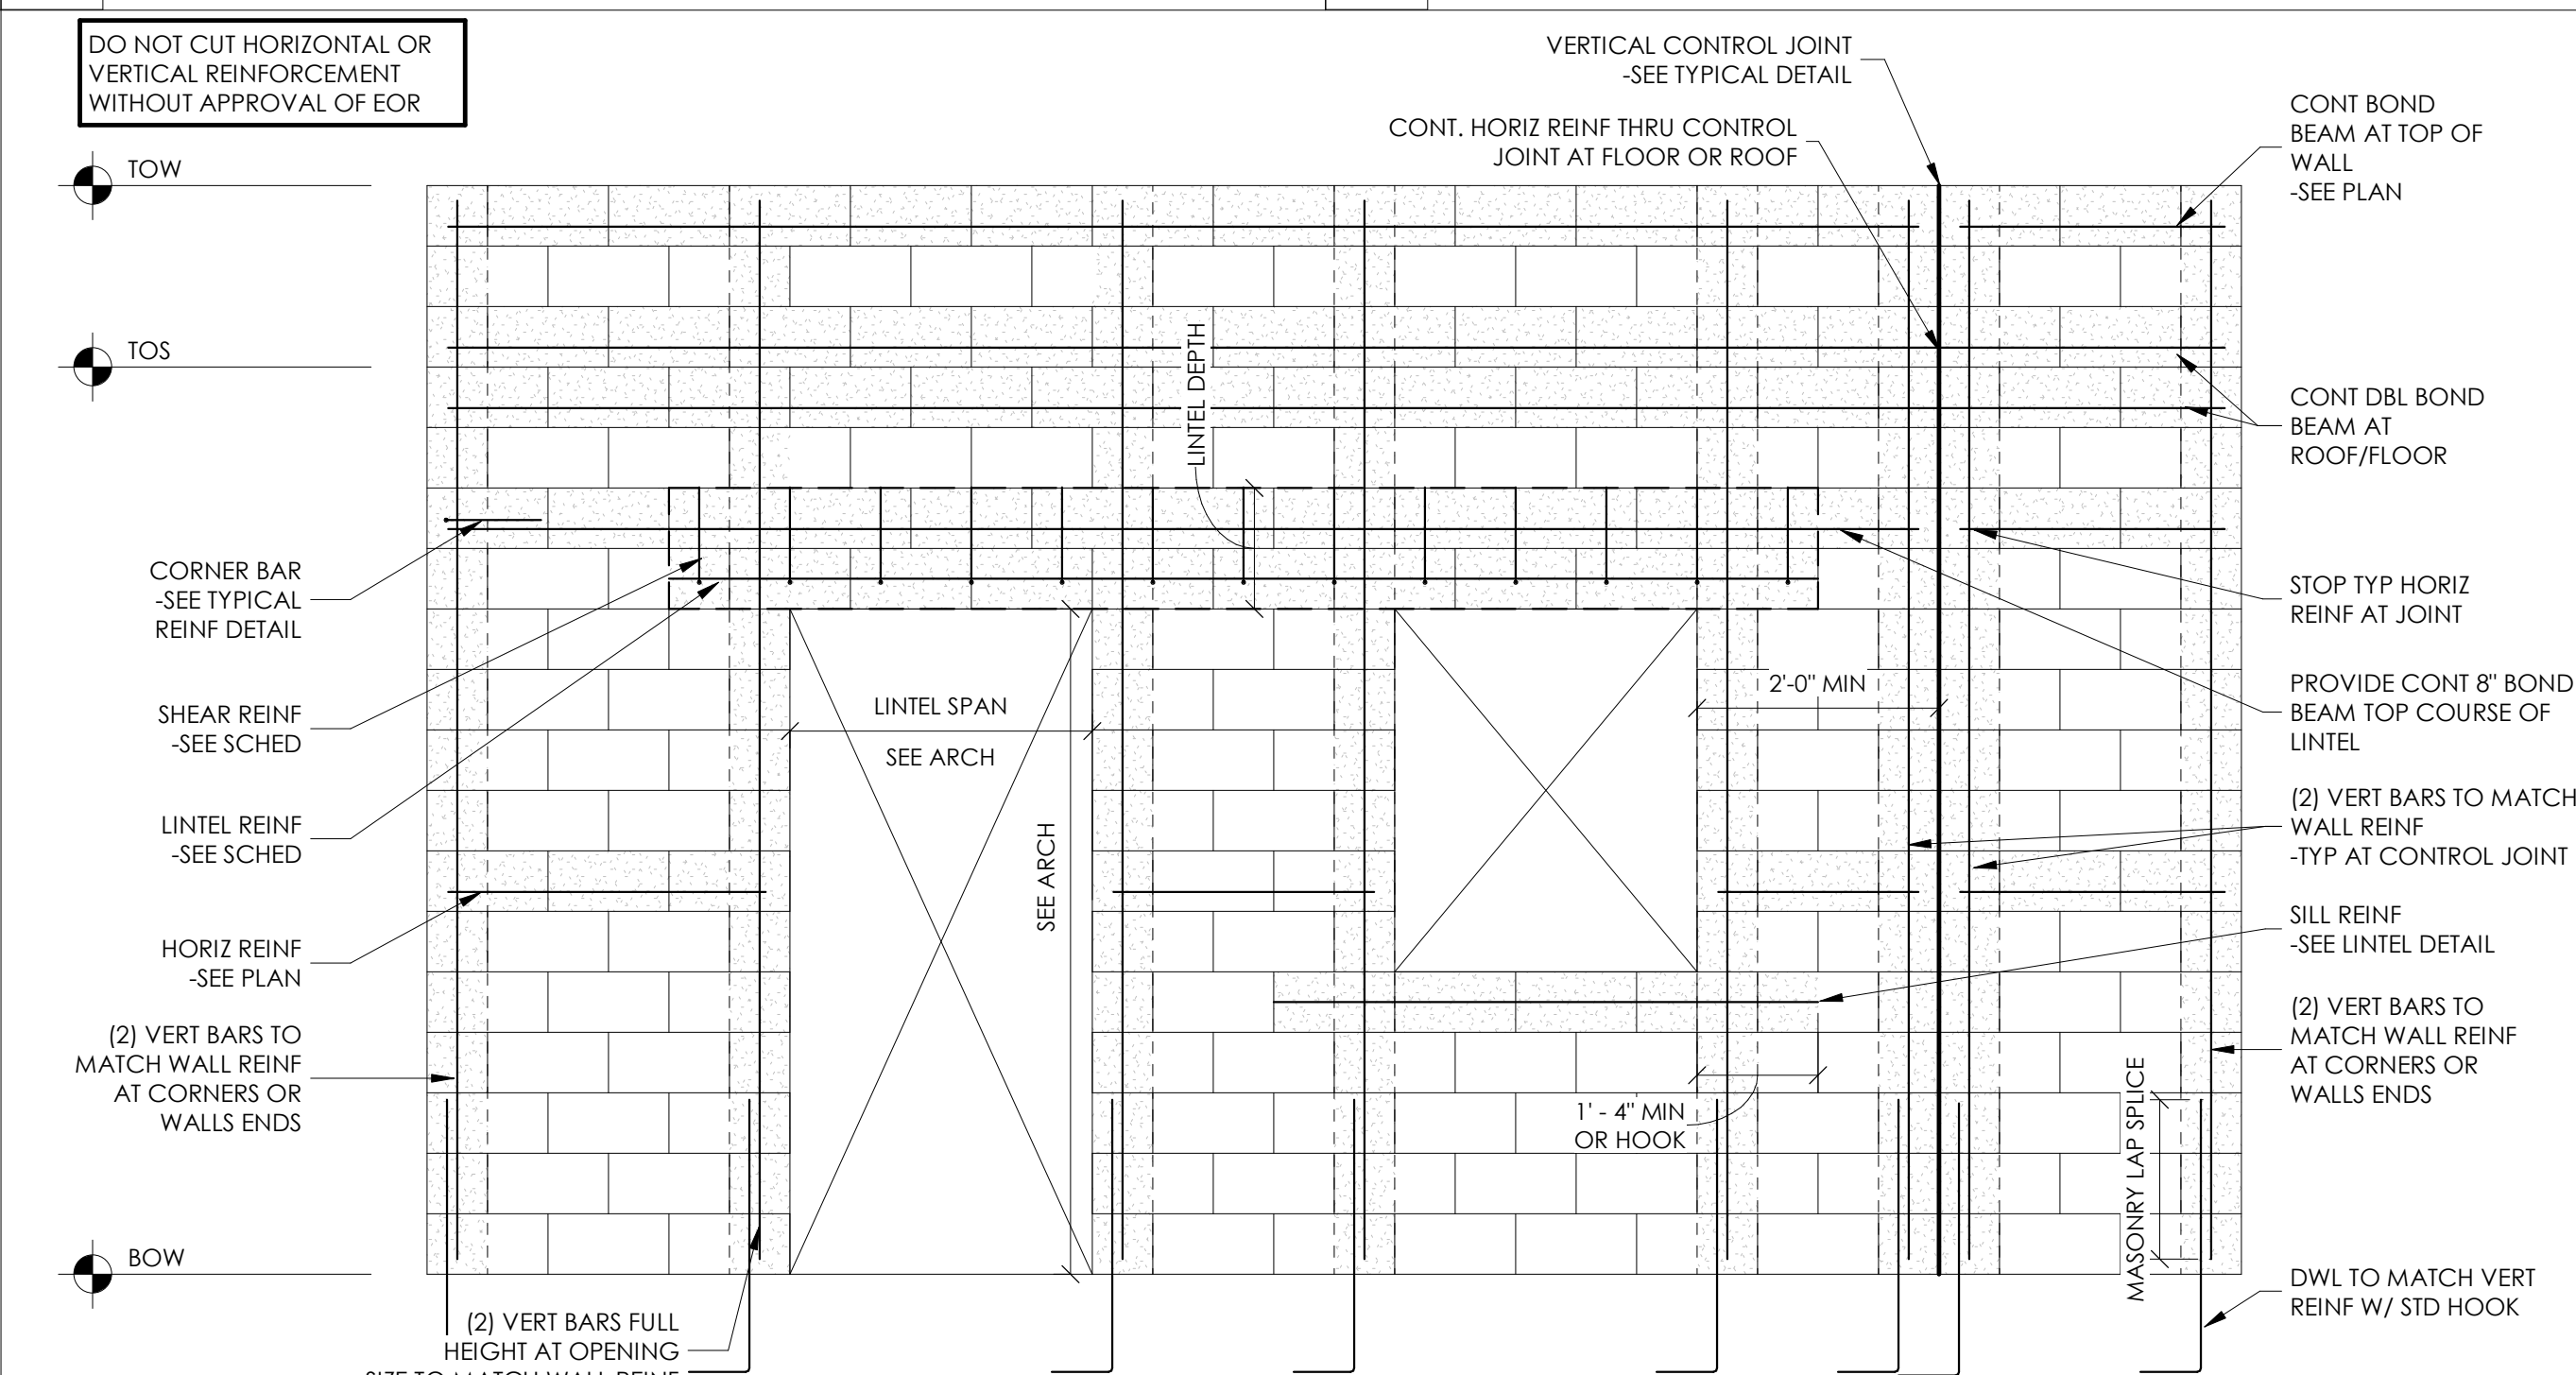10 MASONRY LAP SPlice LENGTH SCHEDULE
 SCALE: 3/4" = 1'-0"

9 TYPICAL MASONRY WALL ELEVATION
 SCALE: 1/2" = 1'-0"

8 TYPICAL DECK EDGE AT MASONRY
 SCALE: 3/4" = 1'-0"


EPOXY ANCHOR SCHEDULE	
SPECIFIED DIAMETER	EMBEDMENT DEPTH
1/2"	4 1/2"
5/8"	5 5/8"
3/4"	6 3/4"

- NOTES:**
- THIS DETAIL SHALL APPLY AT ALL LOCATIONS WHERE EPOXY OR ADHESIVE ANCHORS ARE SPECIFIED WITHIN THE DRAWINGS.
 - ALL THREADED RODS FOR EPOXY ANCHORS SHALL BE MADE FROM EITHER A307 OR A36 STEEL.
 - IF GREATER EMBEDMENT DEPTHS ARE SPECIFIED IN THE DRAWINGS, THOSE EMBEDMENT DEPTHS SHALL GOVERN.
 - EPOXY ANCHORS IN CMU AND CONCRETE SHALL BE LOCATED AT LEAST 4" AWAY FROM ALL EDGES. THE CENTER TO CENTER SPACING OF EPOXY ANCHORS SHALL NOT BE LESS THAN 8". WHERE EPOXY ANCHORS ARE LOCATED IN CMU, THERE SHALL BE A MAXIMUM OF ONE ANCHOR PER CELL.
 - ALL EPOXY ANCHORS SHALL BE INSTALLED IN ACCORDANCE WITH THE MANUFACTURER'S RECOMMENDATIONS (INCLUDING HOLE DIAMETERS, HOLE CLEANING PROCEDURES, TORQUE SPECIFICATIONS, AND SPECIAL INSPECTIONS).
 - HILTI HIT-HY 270 ADHESIVE ANCHORING SYSTEM SHALL BE USED AT ALL ADHESIVE ANCHORS IN CMU.

7 TYPICAL EPOXY ANCHOR DETAIL
 SCALE: 3/4" = 1'-0"


CMU WALL SCHEDULE			
DESCRIPTION	SIZE	WALL HEIGHT	VERTICAL REINFORCEMENT
EXTERIOR WALLS	12"	H ≤ 30'-0"	#6 @ 32' OC
	8"	20'-0" < H ≤ 25'-0"	#7 @ 24' OC
		14'-0" < H ≤ 20'-0"	#5 @ 32' OC
INTERIOR WALLS	8"	0'-0" < H ≤ 14'-0"	#4 @ 48' OC
		H ≤ 30'-0"	#4 @ 48' OC
		20'-0" < H ≤ 30'-0"	#5 @ 32' OC
	6"	0'-0" < H ≤ 20'-0"	#4 @ 48' OC
		ALL HEIGHTS	#4 @ 48' OC

NOTES:


- WALL HEIGHT, H, SHALL BE CONSIDERED AS THE DISTANCE BETWEEN LATERAL SUPPORTS
- ALL DOWELS TO FLOOR SLAB SHALL MATCH SIZE & SPACING OF VERTICAL REINFORCEMENT
- UNLESS NOTED OTHERWISE ON PLANS, PROVIDE (2) #4 CONT. IN FULLY GROUTED BOND BEAM SPACED @ 8'-0" O.C. VERTICALLY (MAX) (2) #5 IN 12" CMU WALLS
- ALL CELLS WITH REINFORCING SHALL BE FULLY GROUTED
- F_m = 1,900 PSI

6 NON-LOAD BEARING CMU WALL SCHEDULE
 SCALE: 3/4" = 1'-0"



REBAR CLEARANCE SCHEDULE	
EXPOSED TO WEATHER OR EARTH	
BARS LARGER THAN #5	2"
#5 OR SMALLER	1 1/2"
NOT EXPOSED TO WEATHER OR EARTH	
ALL BARS	1 1/2"

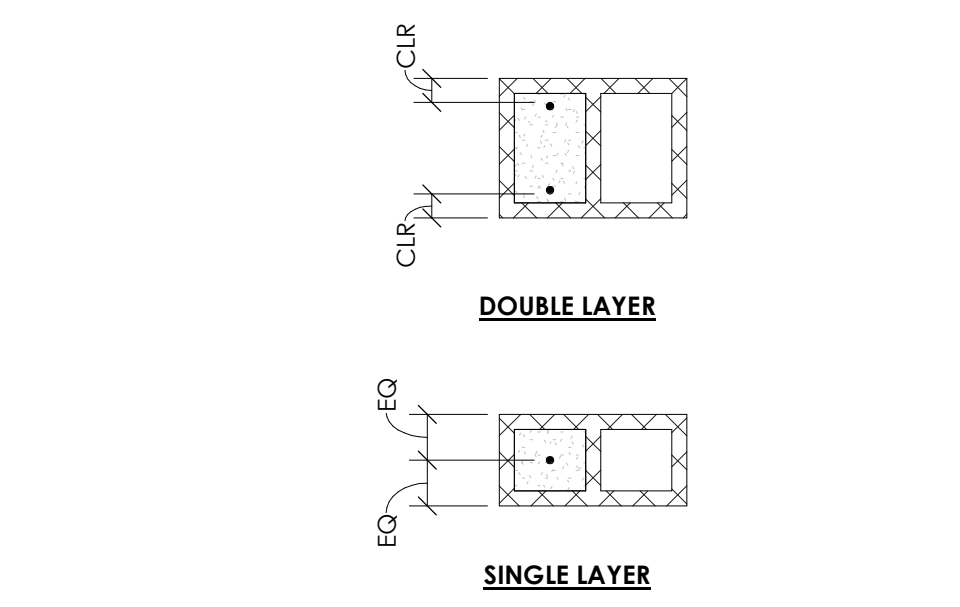


- NOTES:**
- ALL CELLS WITH REINFORCEMENT SHALL BE SOLID GROUTED. CELLS ARE TO BE CLEAN AND FREE OF EXCESS MORTAR AND DEBRIS.
 - ALL REINFORCING BARS SHALL CONFORM TO ASTM A615, GRADE 60.
 - ALL REINFORCEMENT SHALL BE PLACED PRIOR TO POURING OF GROUT.

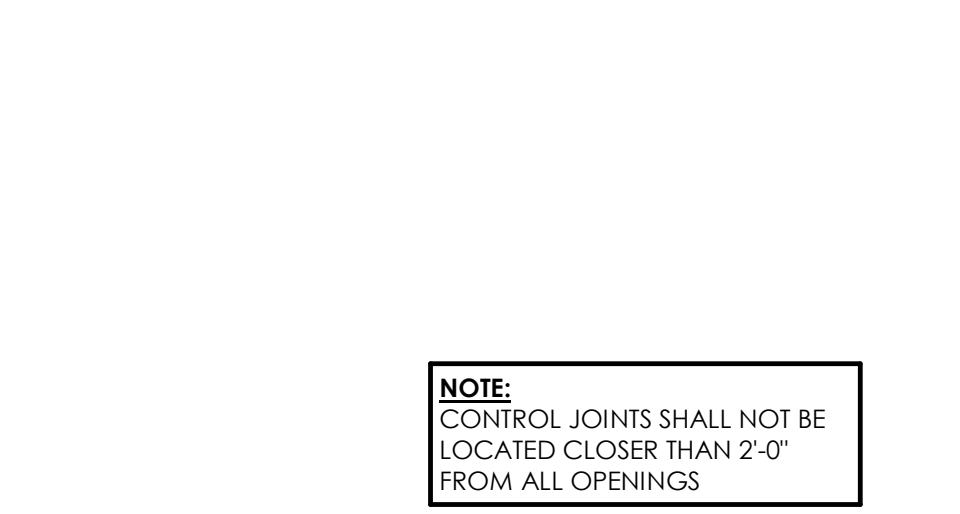4 REBAR PLACEMENT DETAIL
 SCALE: 3/4" = 1'-0"


- NOTE:** CONTROL JOINTS SHALL NOT BE LOCATED CLOSER THAN 2'-0" FROM ALL OPENINGS
- 16" SMOOTH DWL TO MATCH HORIZ REIN OR HECKMANN ANCHOR PER GENERAL NOTES
 - GREASE DWL OR PROVIDE PLASTIC SLEEVE TO ALLOW 1" HORIZ MOVEMENT

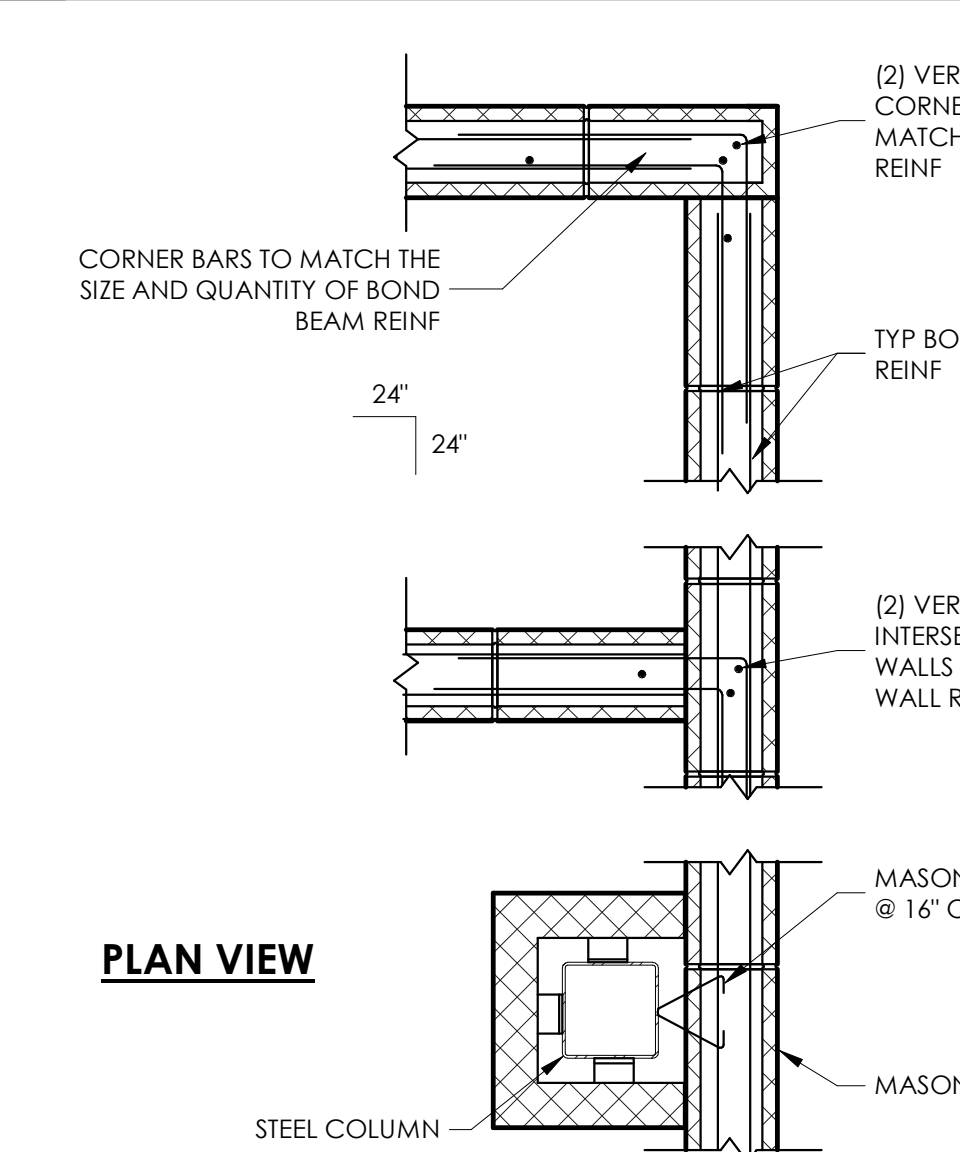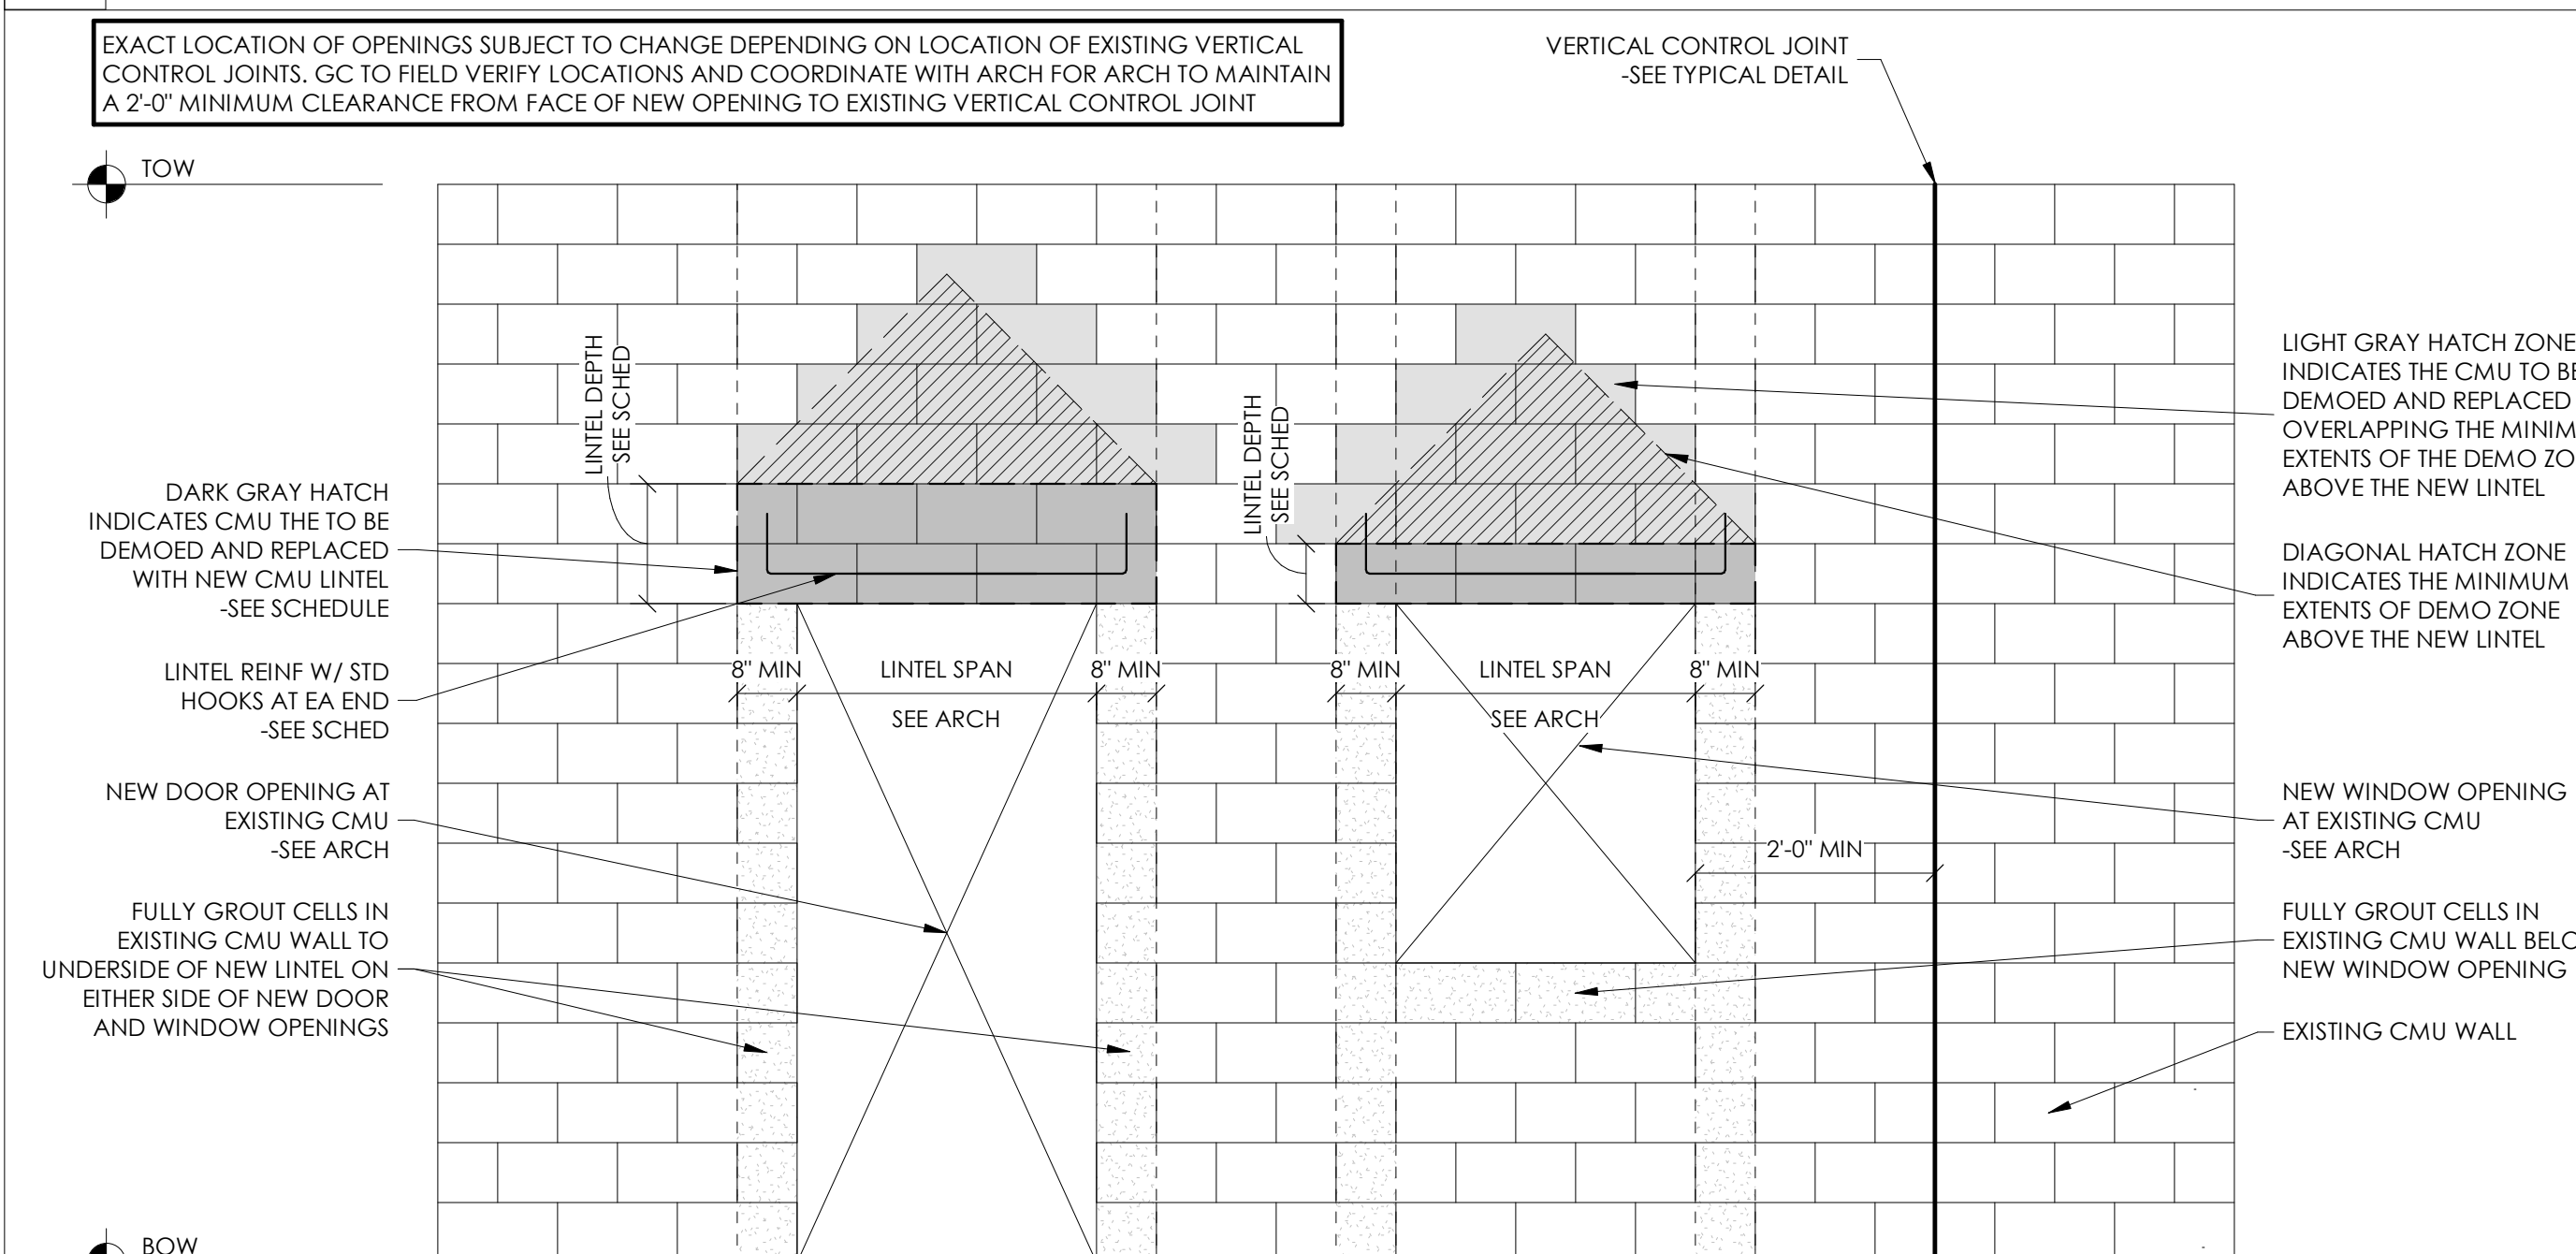3 TYPICAL CONTROL JOINT DETAIL
 SCALE: 3/4" = 1'-0"

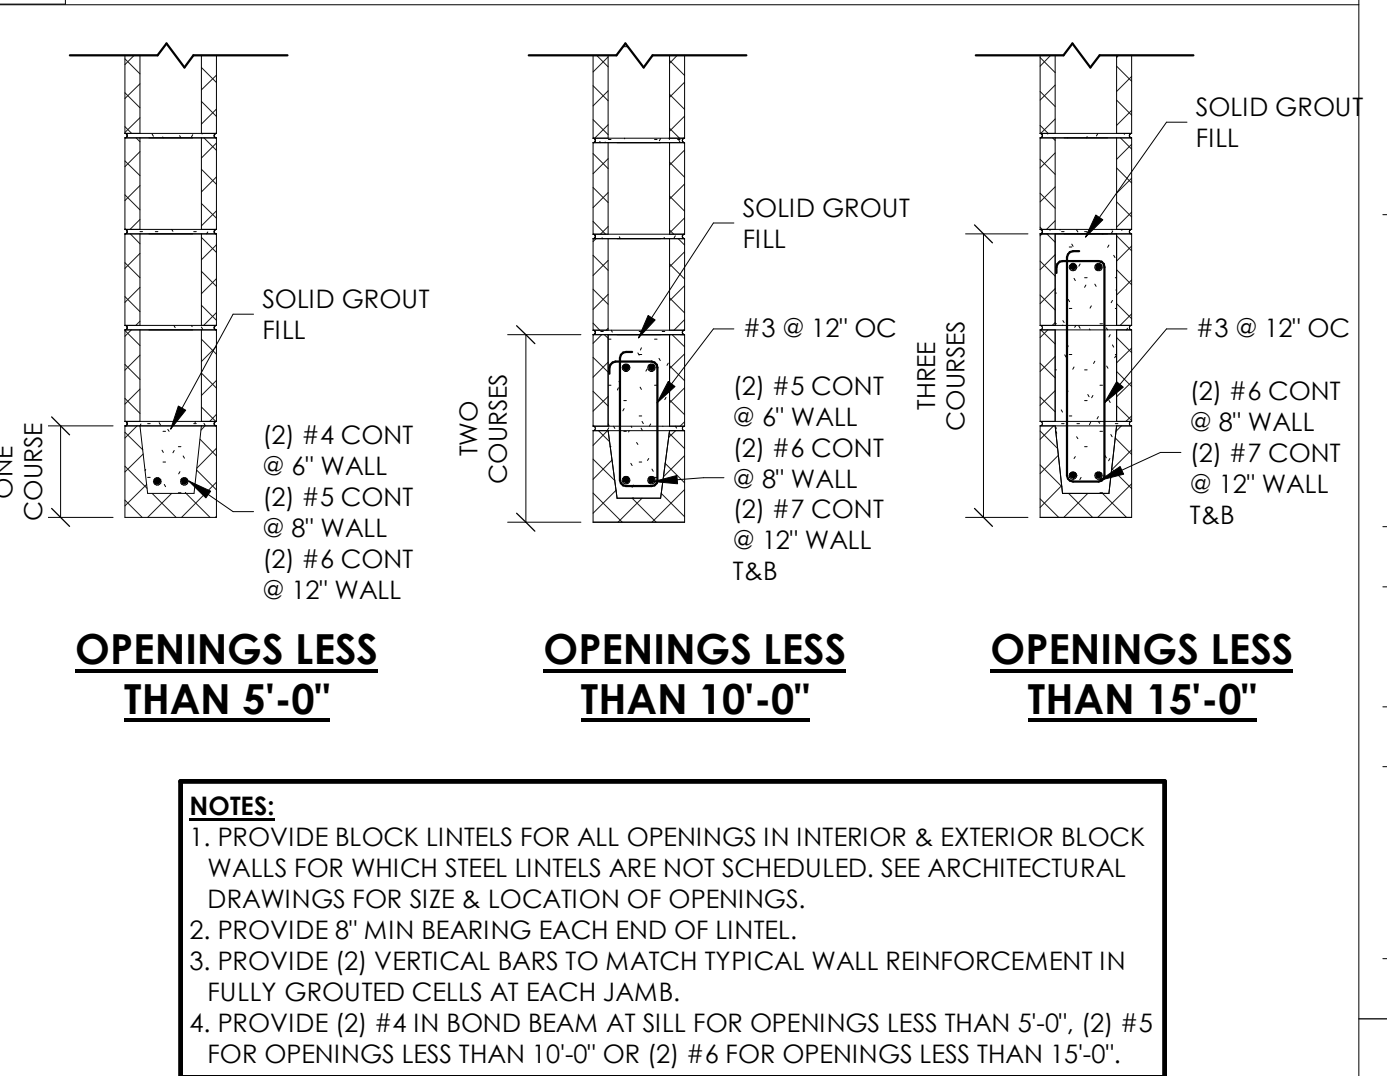PLAN VIEW
18 TYPICAL NON LOAD BEARING CMU WALL BRACE CONNECTION DETAILS
 SCALE: 3/4" = 1'-0"

17 EXISTING MASONRY WALL ELEVATION W/ NEW POST-INSTALLED CMU LINTEL AT NEW OPENING
 SCALE: 1/2" = 1'-0"

2 CMU REINFORCING AND ANCHOR PLAN
 SCALE: 3/4" = 1'-0"

1 MASONRY LINTEL SCHEDULE
 SCALE: 3/4" = 1'-0"


BRACE FRAMING

STUD TYPE	SPACING	MAX LENGTH	MISCELLANEOUS
3625162-43	4'-0" OC	14'-0"	BRACE @ MID-PT FOR LENGTHS OVER 14'-0"
6005162-43	4'-0" OC	20'-0"	BRACE @ MID-PT FOR LENGTHS OVER 20'-0"


VERTICAL FRAMING

STUD TYPE	SPACING	MAX LENGTH	MISCELLANEOUS
3625162-43	1'-4" OC	22'-6"	ONE LAYER * SHEATHING (MIN)
6005162-43	1'-4" OC	32'-9"	ONE LAYER * SHEATHING (MIN)


* ALTERNATIVELY PROVIDE 1 (2) 1/2" x 1/4" GA HORIZONTAL CHAINSLINK FASTENED TO STUDS WITH 1 (2) 1/4" x 1/4" GA CLIP AT 4'-0" OC VERTICALLY

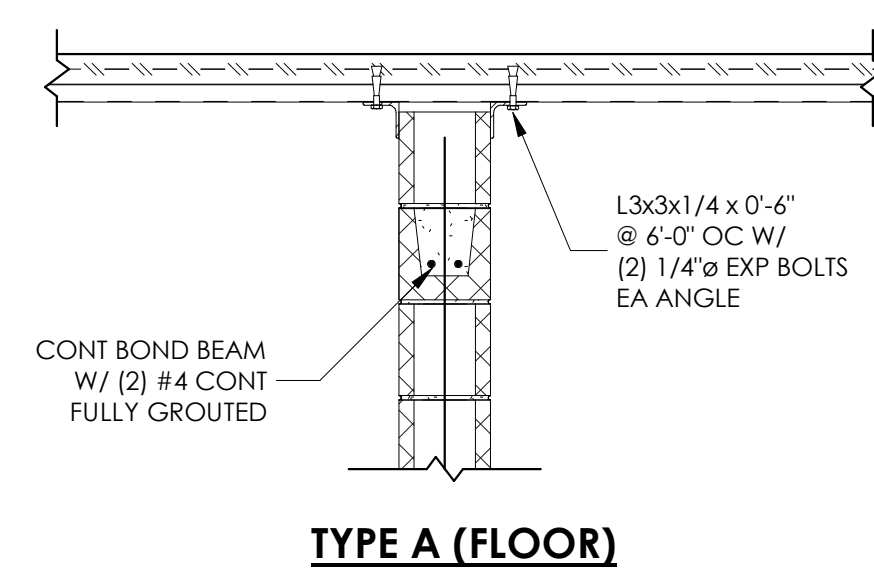


TYPE A (FLOOR)

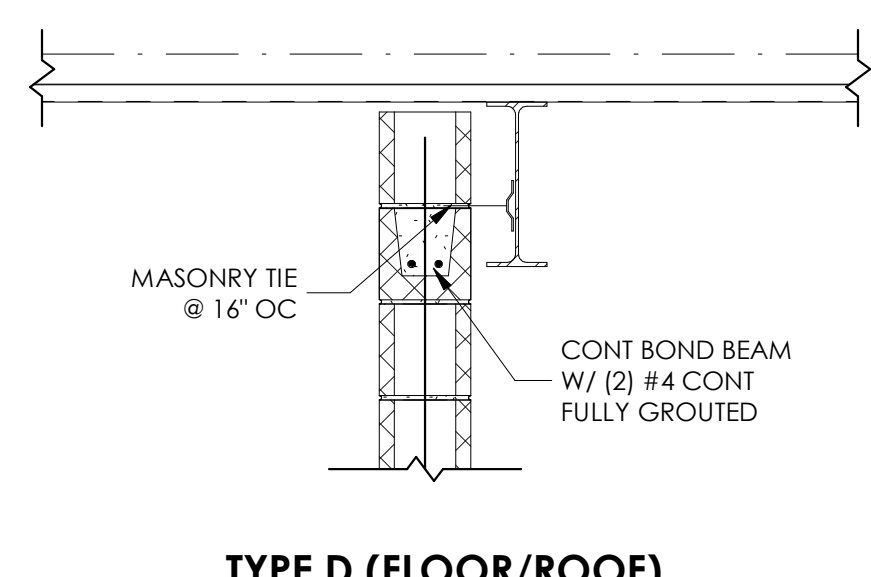


TYPE D (FLOOR/ROOF)

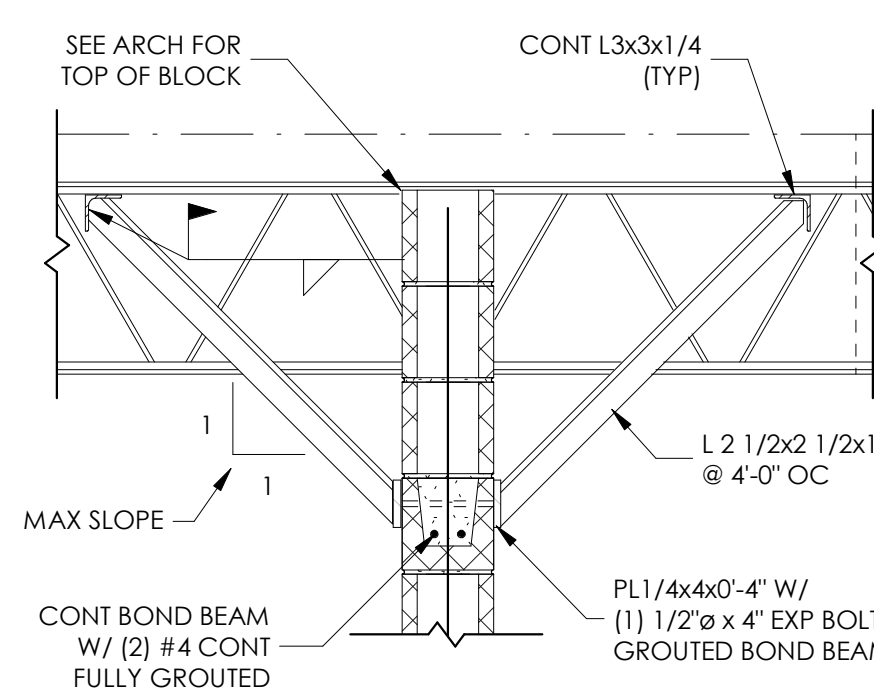


TYPE B (FLOOR / ROOF)

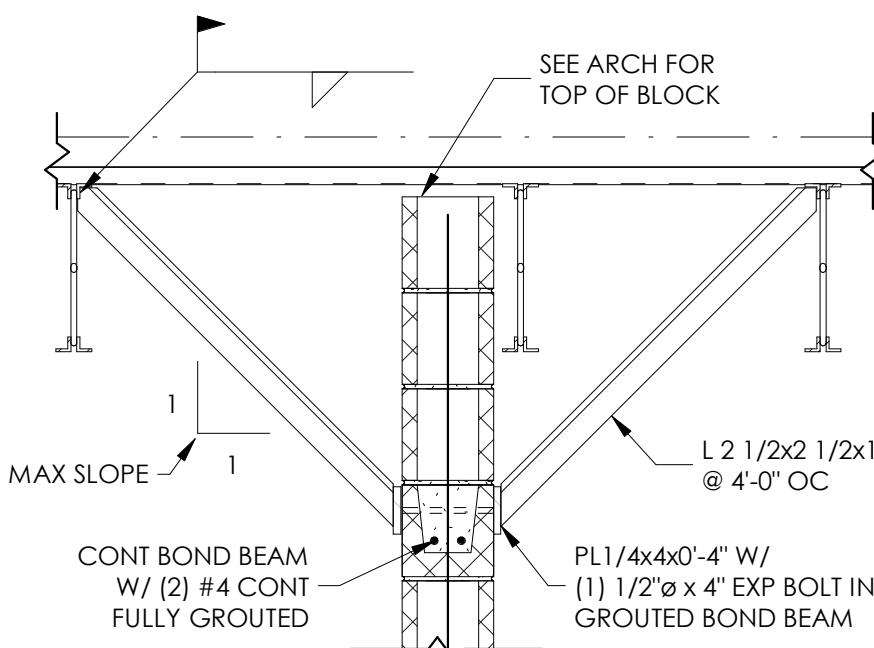

TYPE C (FLOOR / ROOF)

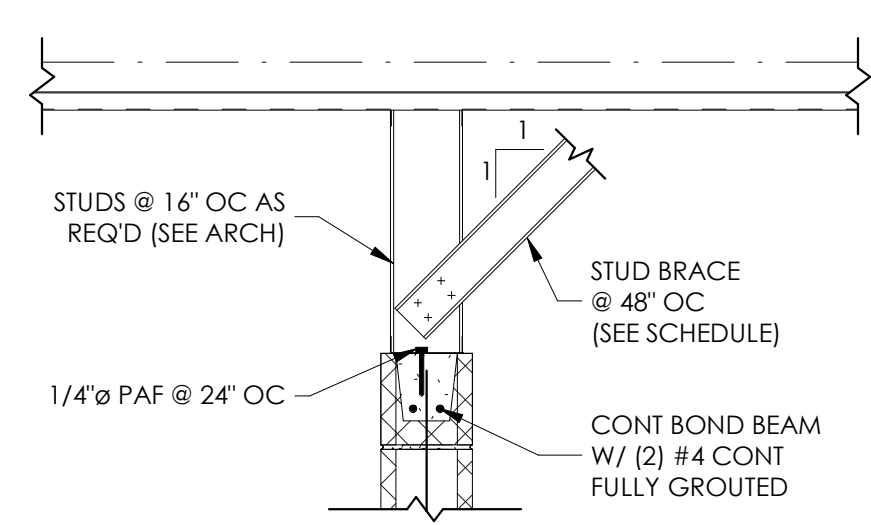

TYPE E (FLOOR / ROOF)

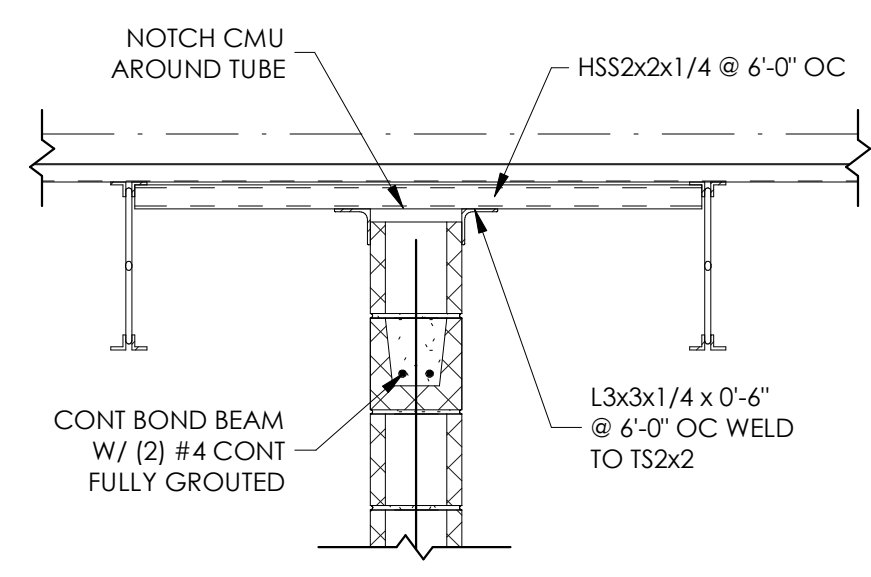


TYPE F (FLOOR / ROOF)

NOTES: INTERIOR LOCATIONS ONLY

- NON-LOAD BEARING MASONRY WALL BRACES. BRACING AT THE TOP OF MASONRY WALLS IS REQUIRED ON STRAIGHT RUNS OF WALL MORE THAN SIX FEET FROM A CORNER, INTERSECTING WALL, OR AS NOTED ABOVE.
- WHEN THE MASONRY WALL TERMINATES AT THE BOTTOM OF THE DECK, A TYPE 'A' ATTACHMENT AT THE FLOOR DECK OR A TYPE 'B', 'C', 'D' OR 'E' ATTACHMENT AT EITHER THE FLOOR OR ROOF MAY BE USED. WHEN WALLS TERMINATE ABOVE THE CEILING A TYPE 'B', 'C' OR 'E' ATTACHMENT SHOULD BE USED.


TYPICAL CMU WALL BRACING LOCATION PLAN

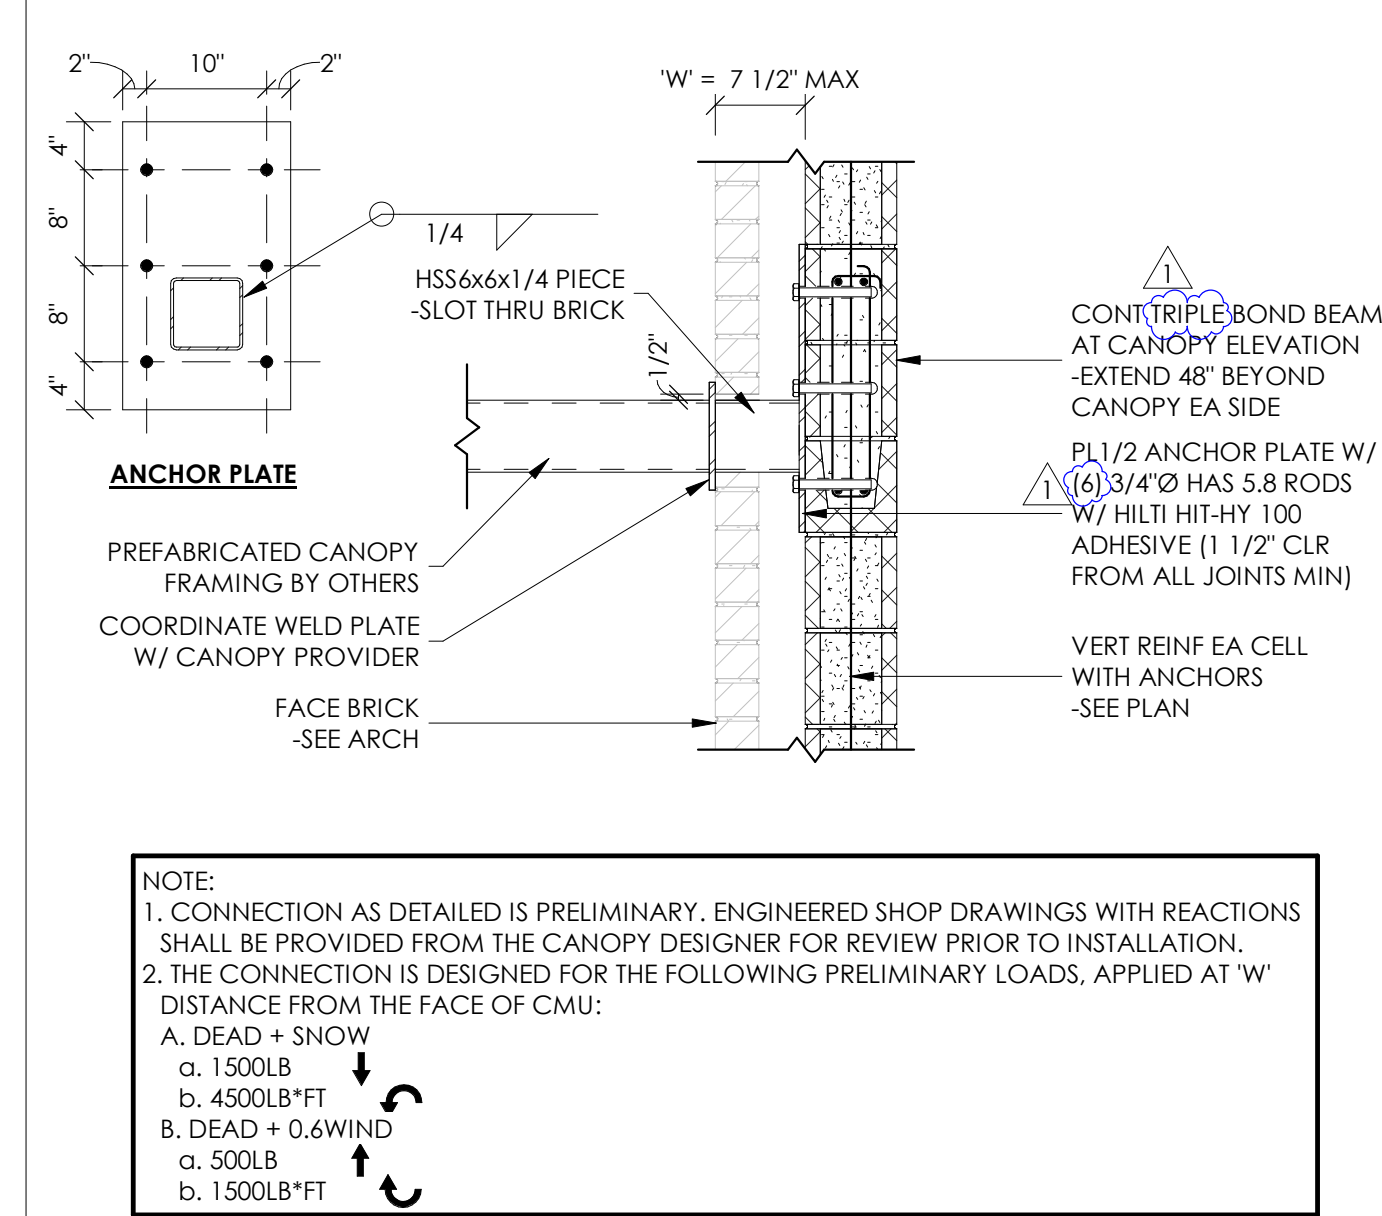

NOTE:

- CONNECTION AS DETAILED IS PRELIMINARY. ENGINEERED SHOP DRAWINGS WITH REACTIONS SHALL BE PROVIDED FROM THE CANOPY DESIGNER FOR REVIEW PRIOR TO INSTALLATION.
- THE CONNECTION IS DESIGNED FOR THE FOLLOWING PRELIMINARY LOADS, APPLIED AT 'W' DISTANCE FROM THE FACE OF CMU:
A. DEAD + SNOW
o. 150LB
b. 450LB/FT
B. DEAD + 0.6WIND
o. 500LB
b. 1500LB/FT

12 PREFABRICATED CANOPY SUPPORT DETAIL
SCALE: 3/4" = 1'-0"

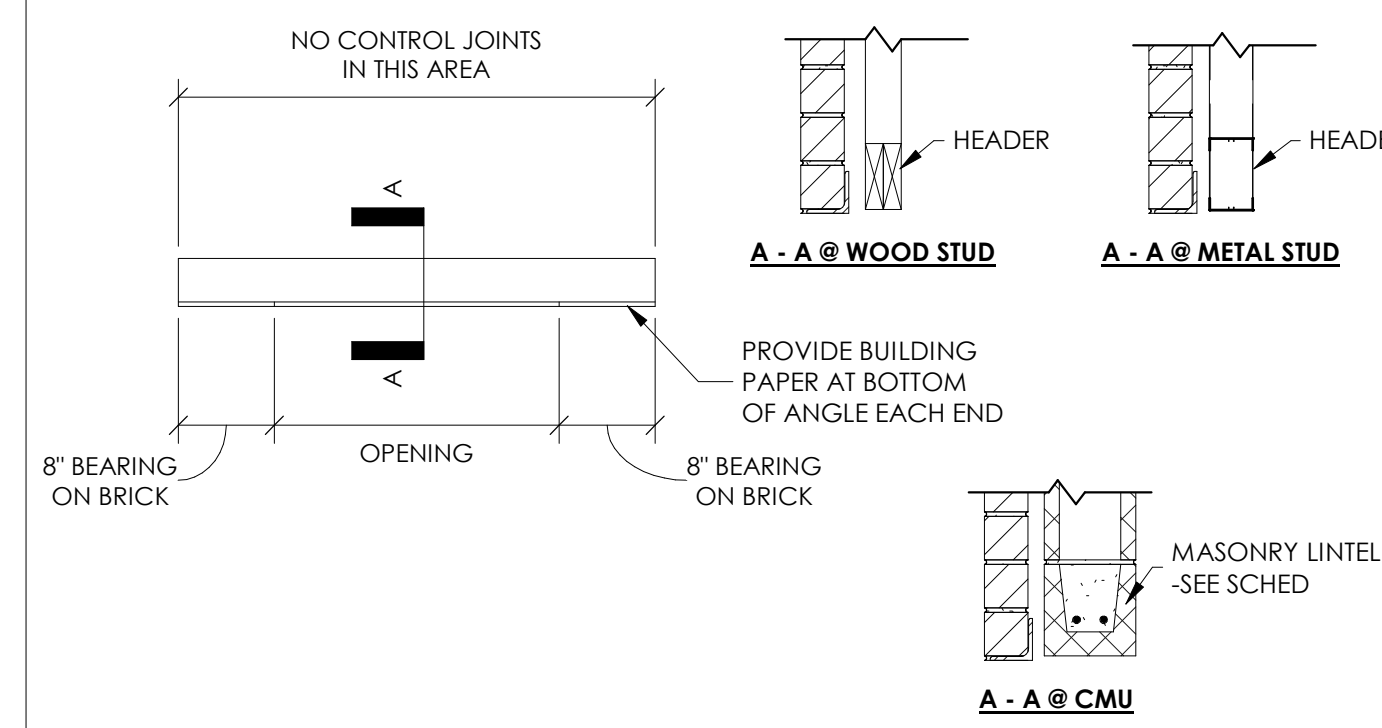

BRICK LOOSE LINTEL SCHEDULE

OPENING	ANGLE SIZE
LESS THAN 5'-0"	L 3 1/2 x 3 1/2 x 5/16
5'-0" TO LESS THAN 6'-0"	L 5 x 3 1/2 x 5/16 (LLV)
6'-0" TO LESS THAN 8'-0"	L 6 x 3 1/2 x 5/16 (LLV)
8'-0" TO LESS THAN 9'-0"	L 7 x 4 x 3/8 (LLV)

NOTES:


- LLV = LONG LEG VERTICAL
- GALVANIZE ALL LINTEL ANGLES.
- ANGLE SIZES ARE MIN - SEE ARCHITECTURAL DRAWINGS.

11 BRICK LOOSE LINTEL SCHEDULE
SCALE: 3/4" = 1'-0"


MASONRY LAP SPICE LENGTHS: Fm = 1,900 psi, GRADE 60 REINFORCEMENT IN CENTER OF WALL IN.

BAR SIZE	6-in. CMU	8-in. CMU	10-in. CMU	12-in. CMU	BAR SIZE
#3	12	12	12	12	#3
#4	20	15	12	12	#4
#5	32	23	18	15	#5
#6	54	43	34	28	#6
#7	N/A	60	46	38	#7
#8	N/A	72	71	57	#8
#9	N/A	N/A	82	74	#9

10 MASONRY LAP SPICE LENGTH SCHEDULE
SCALE: 3/4" = 1'-0"

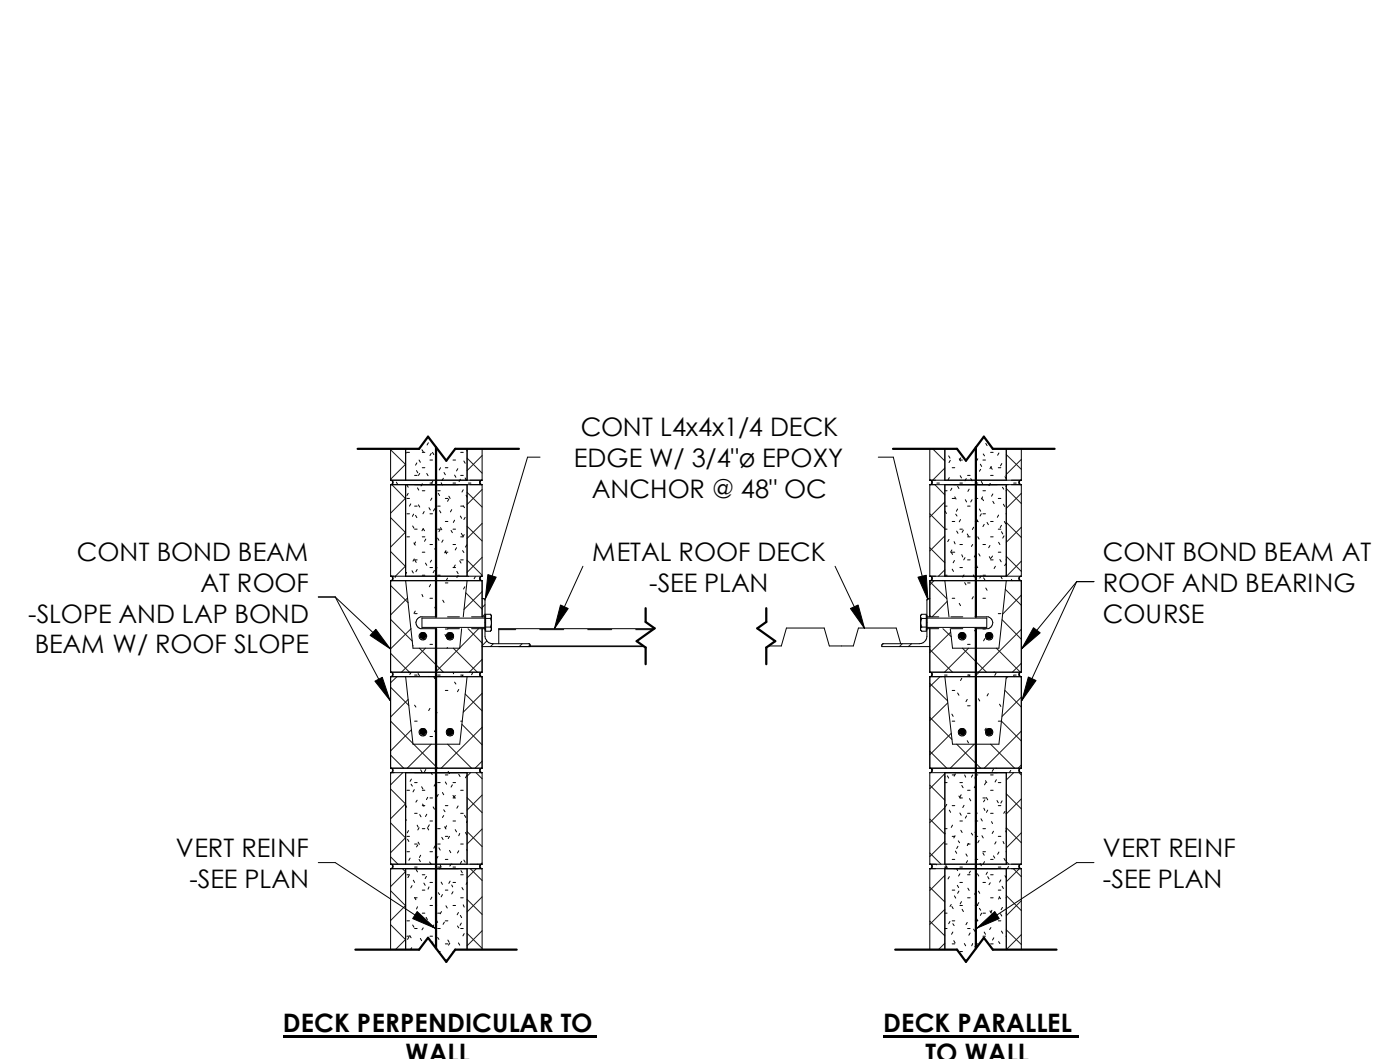

8 TYPICAL DECK EDGE AT MASONRY
SCALE: 3/4" = 1'-0"

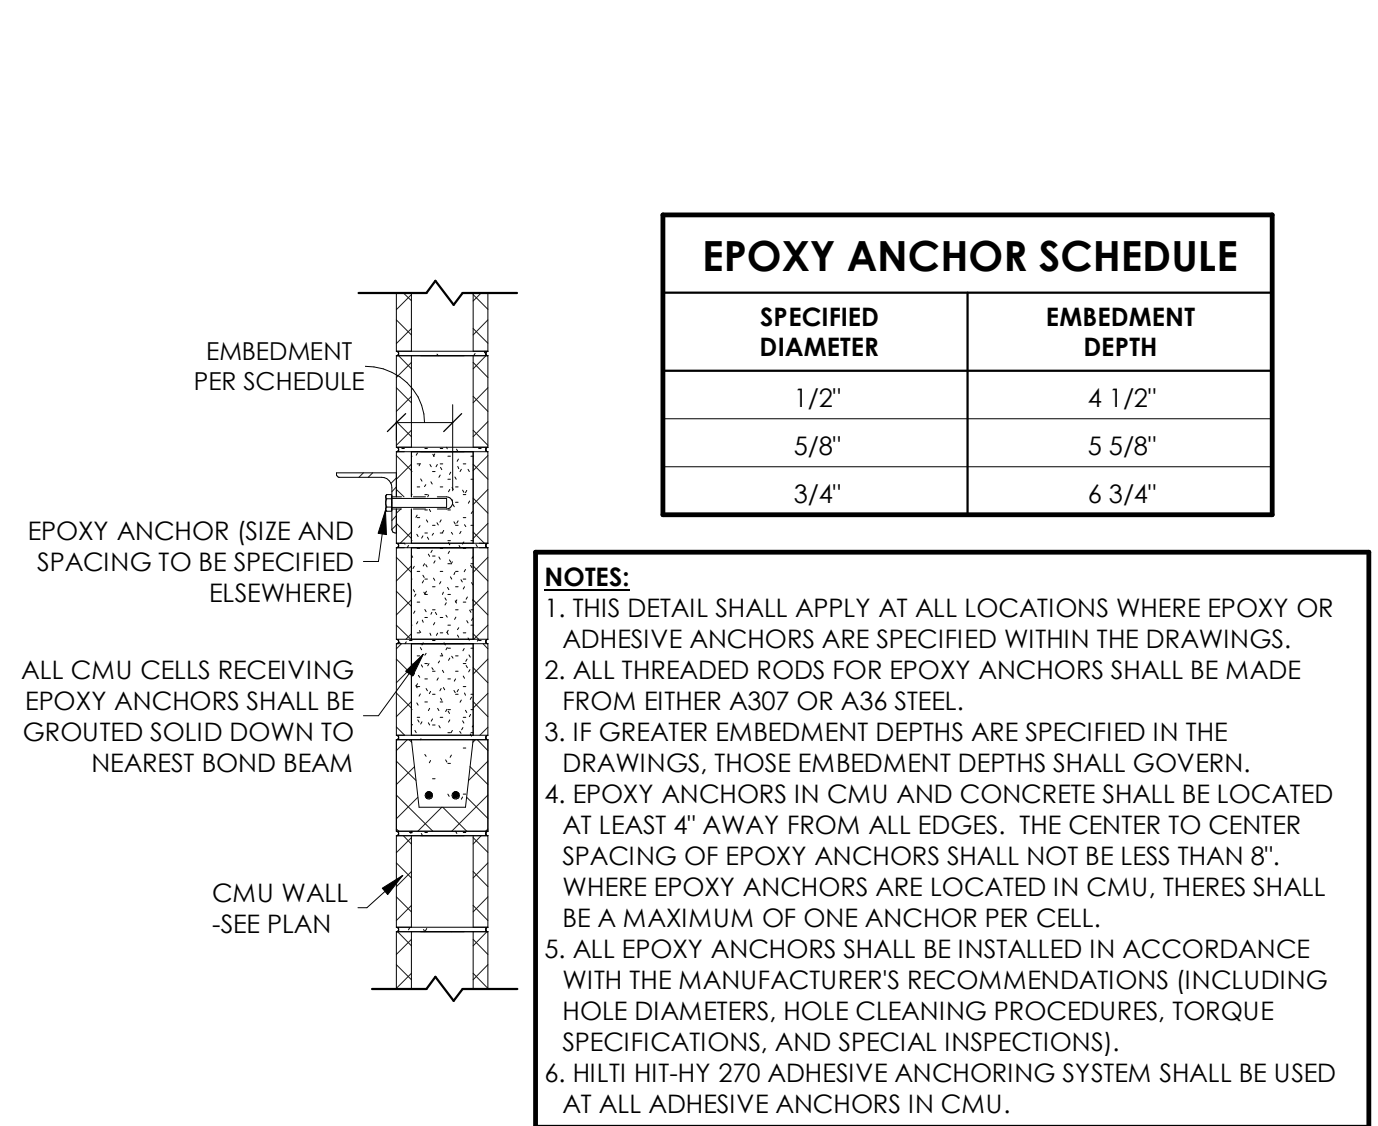

EPOXY ANCHOR SCHEDULE

SPECIFIED DIAMETER	EMBEDMENT DEPTH
1/2"	4 1/2"
5/8"	5 5/8"
3/4"	6 3/4"

NOTES:

- THIS DETAIL SHALL APPLY AT ALL LOCATIONS WHERE EPOXY OR ADHESIVE ANCHORS ARE SPECIFIED WITHIN THE DRAWINGS.
- ALL THREADED RODS FOR EPOXY ANCHORS SHALL BE MADE FROM EITHER A307 OR A36 STEEL.
- IF GREATER EMBEDMENT DEPTHS ARE SPECIFIED IN THE DRAWINGS, THOSE EMBEDMENT DEPTHS SHALL GOVERN.
- EPOXY ANCHORS IN CMU AND CONCRETE SHALL BE LOCATED AT LEAST 4" AWAY FROM ALL EDGES. THE CENTER TO CENTER SPACING OF EPOXY ANCHORS SHALL NOT BE LESS THAN 8". WHERE EPOXY ANCHORS ARE LOCATED IN CMU, THERES SHALL BE A MAXIMUM OF ONE ANCHOR PER CELL.
- ALL EPOXY ANCHORS SHALL BE INSTALLED IN ACCORDANCE WITH THE MANUFACTURER'S RECOMMENDATIONS (INCLUDING HOLE DIAMETERS, HOLE CLEANING PROCEDURES, TORQUE SPECIFICATIONS, AND SPECIAL INSPECTIONS).
- HILTI HIT-HY 270 ADHESIVE ANCHORING SYSTEM SHALL BE USED AT ALL ADHESIVE ANCHORS IN CMU.

7 TYPICAL EPOXY ANCHOR DETAIL
SCALE: 3/4" = 1'-0"

CMU WALL SCHEDULE

DESCRIPTION	SIZE	WALL HEIGHT	VERTICAL REINFORCEMENT
EXTERIOR WALLS	12"	H ≤ 30'-0"	#6 @ 32" OC
	8"	20'-0" < H ≤ 25'-0"	#7 @ 24" OC
	8"	14'-0" < H ≤ 20'-0"	#5 @ 32" OC
INTERIOR WALLS	12"	H ≤ 30'-0"	#4 @ 48" OC
	8"	MAIN CORRIDOR WALLS	#5 @ 32" OC
	8"	20'-0" < H ≤ 30'-0"	#5 @ 48" OC
	6"	0'-0" < H ≤ 20'-0"	#4 @ 48" OC
	6"	ALL HEIGHTS	#4 @ 48" OC


NOTES:

- WALL HEIGHT, H, SHALL BE CONSIDERED AS THE DISTANCE BETWEEN LATERAL SUPPORTS
- ALL DOWELS TO FLOOR SLAB SHALL MATCH SIZE & SPACING OF VERTICAL REINFORCEMENT
- UNLESS NOTED OTHERWISE ON PLANS, PROVIDE (2) #4 CONT. IN FULLY GROUDED BOND BEAM SPACED @ 8'-0" O.C. VERTICALLY (MAX) (2) #5 IN 12" CMU WALLS
- ALL CELLS WITH REINFORCING SHALL BE FULLY GROUDED
- Fm = 1,900 PSI

6 NON-LOAD BEARING CMU WALL SCHEDULE
SCALE: 3/4" = 1'-0"

REBAR CLEARANCE SCHEDULE


EXPOSED TO WEATHER OR EARTH	
BARS LARGER THAN #5	2"
#5 OR SMALLER	1 1/2"
NOT EXPOSED TO WEATHER OR EARTH	
ALL BARS	1 1/2"

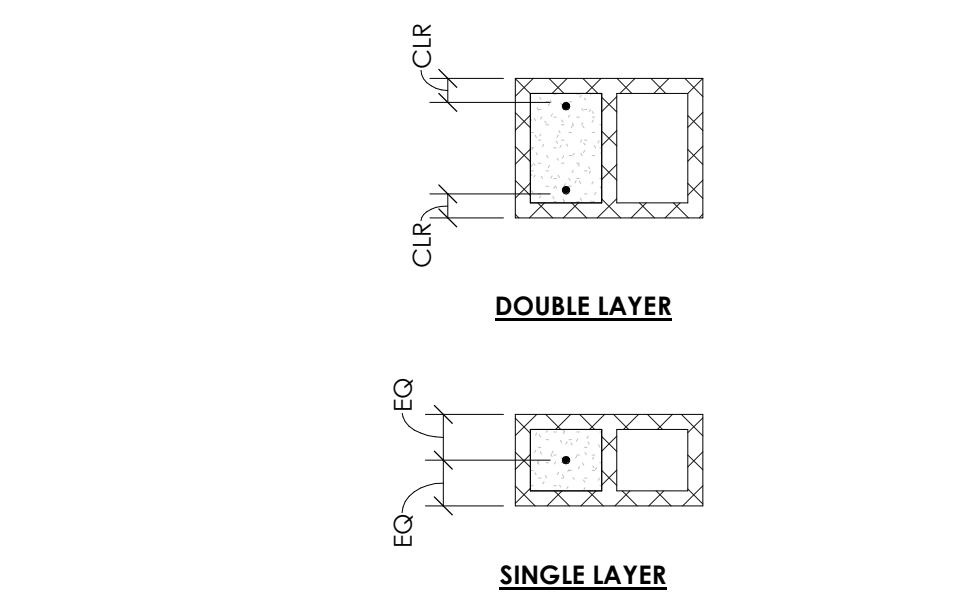


NOTES:

- ALL CELLS WITH REINFORCEMENT SHALL BE SOLID GROUDED. CELLS ARE TO BE CLEAN AND FREE OF EXCESS MORTAR AND DEBRIS.
- ALL REINFORCING BARS SHALL CONFORM TO ASTM A615, GRADE 60.
- ALL REINFORCEMENT SHALL BE PLACED PRIOR TO POURING OF GROUT.


4 REBAR PLACEMENT DETAIL
SCALE: 3/4" = 1'-0"

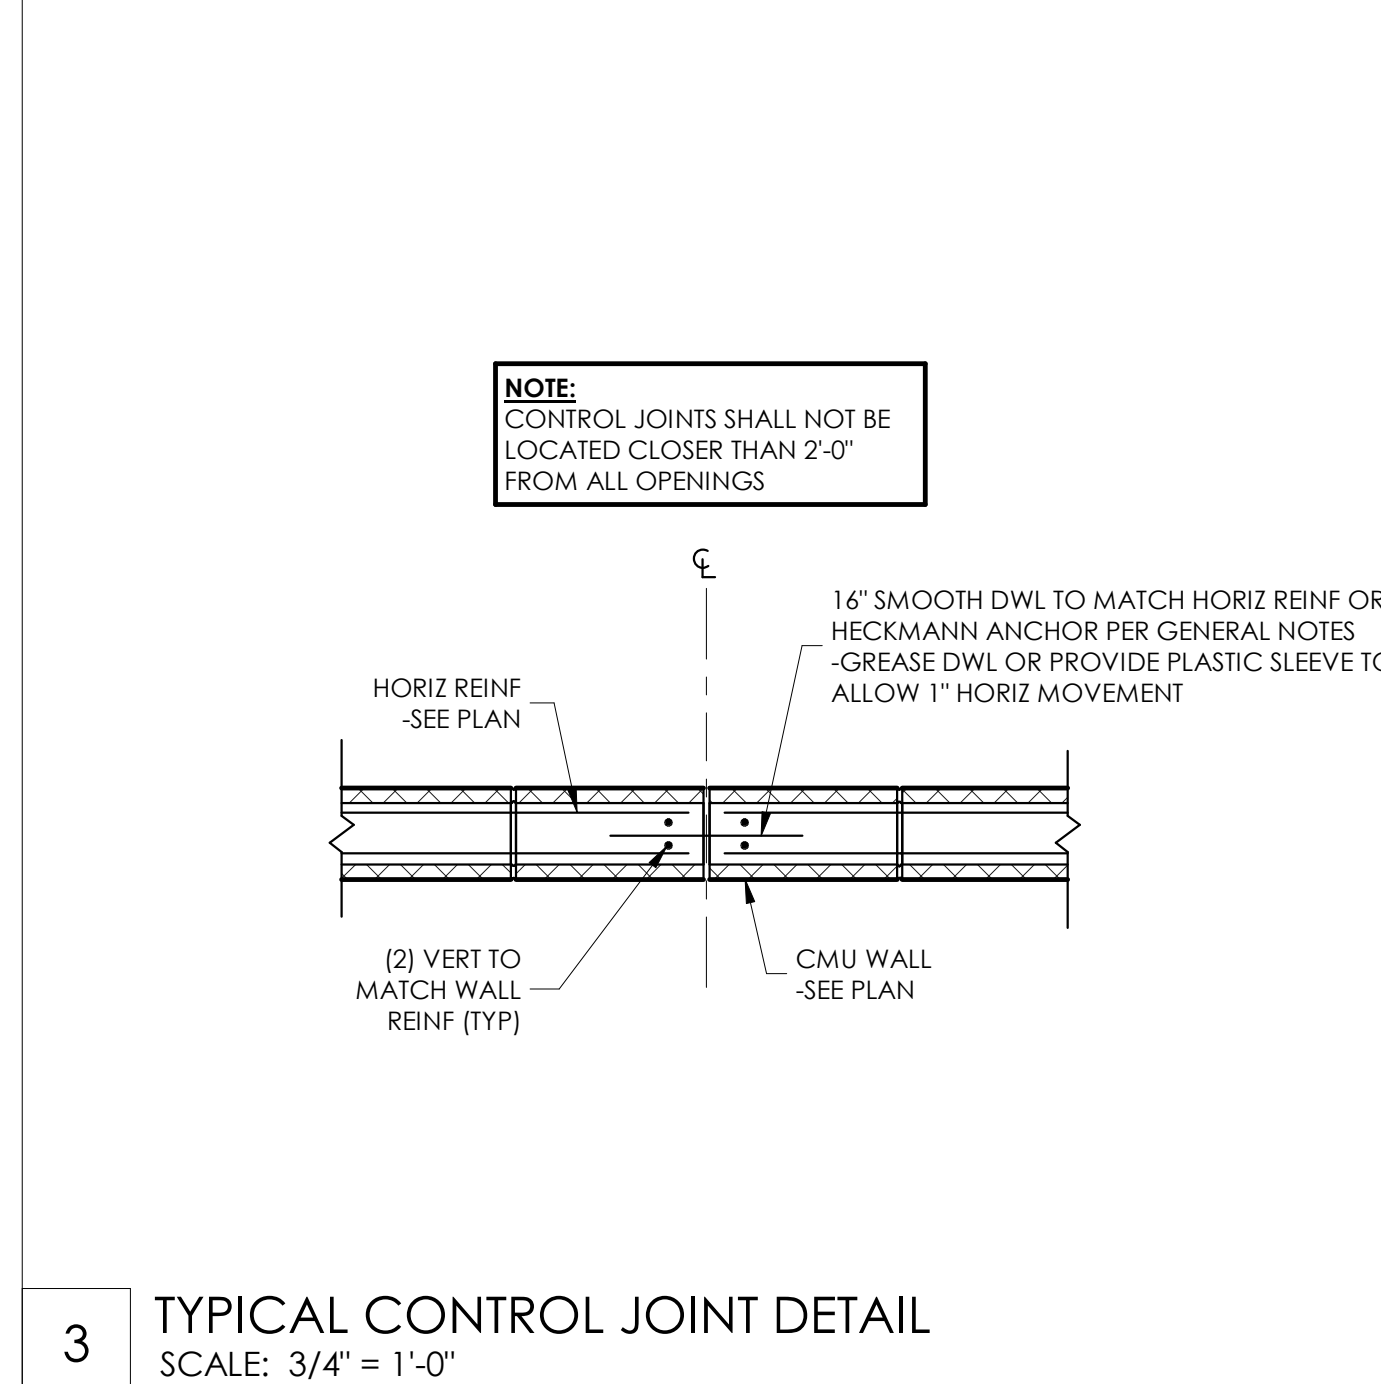

3 TYPICAL CONTROL JOINT DETAIL
SCALE: 3/4" = 1'-0"

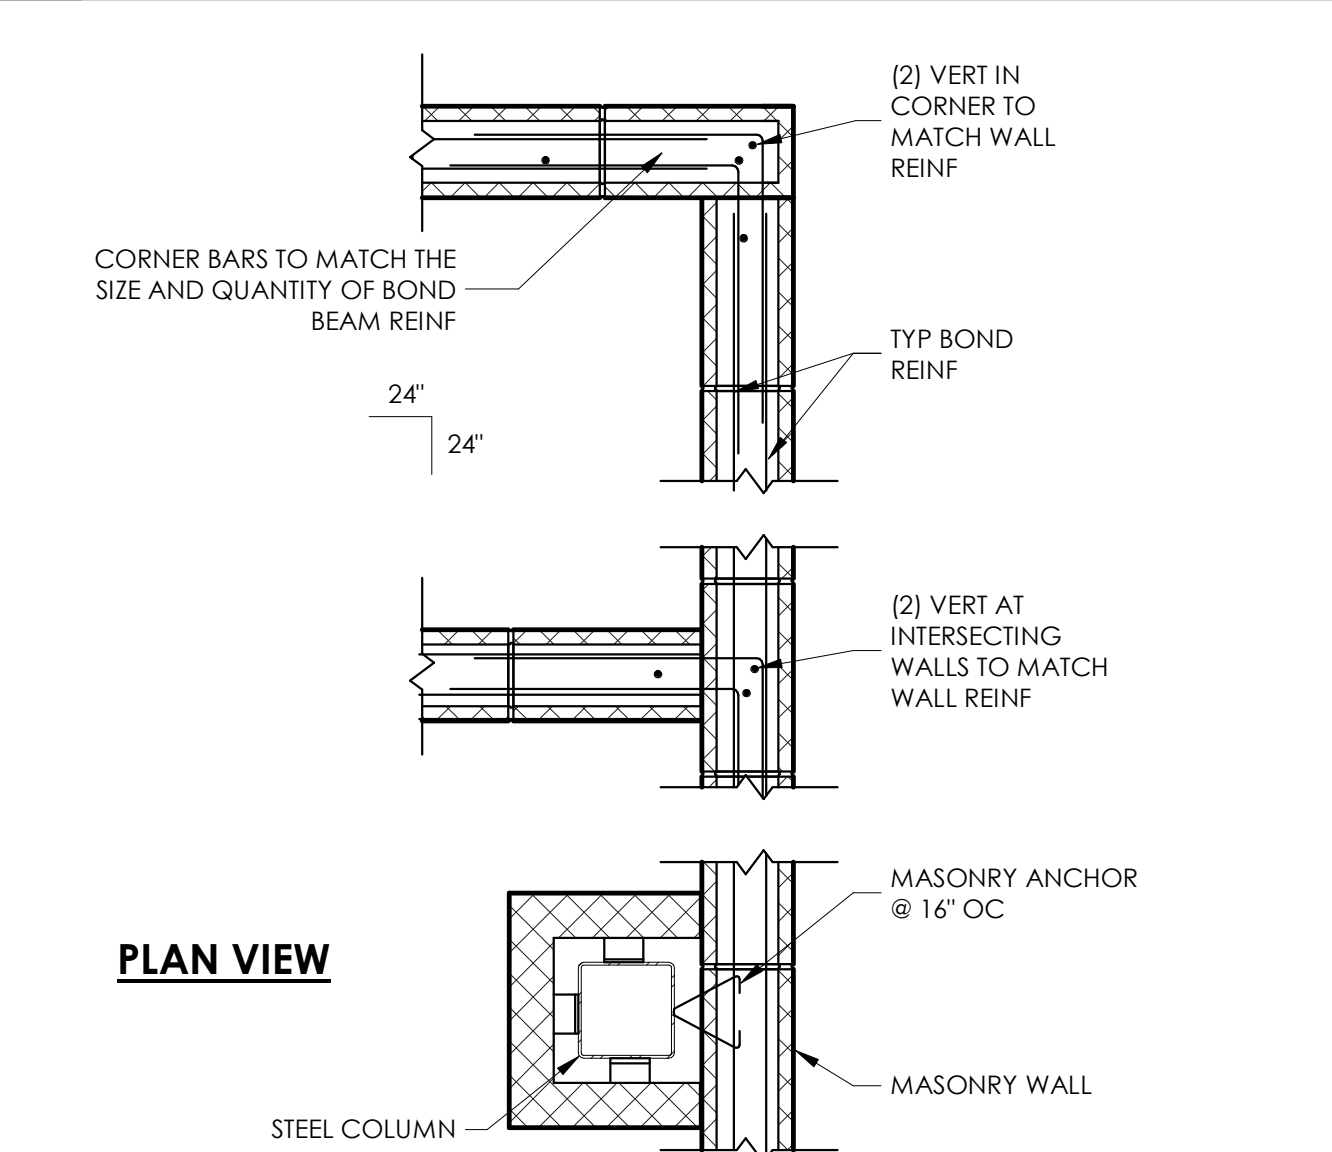

2 CMU REINFORCING AND ANCHOR PLAN
SCALE: 3/4" = 1'-0"

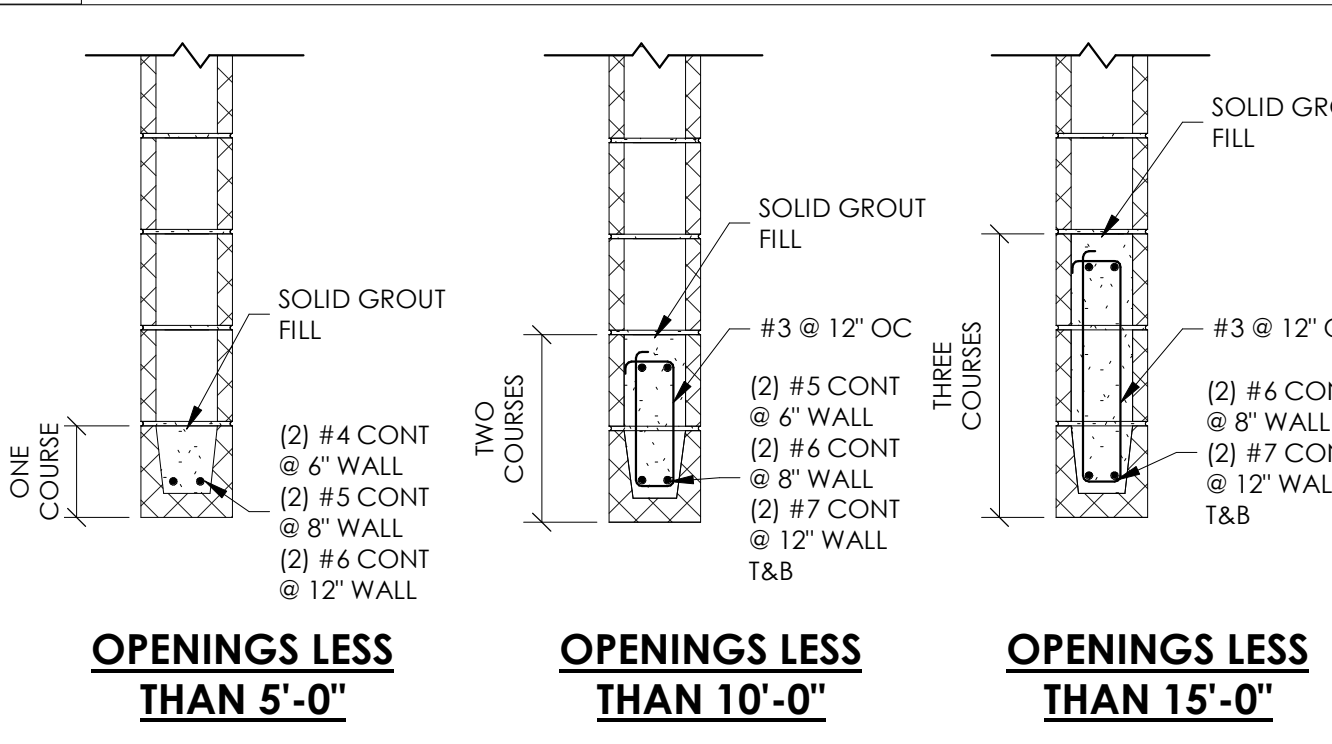


NOTES:


- PROVIDE BLOCK LINTELS FOR ALL OPENINGS IN INTERIOR & EXTERIOR BLOCK WALLS FOR WHICH STEEL LINTELS ARE NOT SCHEDULED. SEE ARCHITECTURAL DRAWINGS FOR SIZE & LOCATION OF OPENINGS.
- PROVIDE 8" MIN BEARING EACH END OF LINTEL
- PROVIDE (2) VERTICAL BARS TO MATCH TYPICAL WALL REINFORCEMENT IN FULLY GROUDED CELLS AT EACH JAMB.
- PROVIDE (2) #4 IN BOND BEAM AT SILL FOR OPENINGS LESS THAN 5'-0". (2) #5 FOR OPENINGS LESS THAN 10'-0" OR (2) #6 FOR OPENINGS LESS THAN 15'-0".

1 MASONRY LINTEL SCHEDULE
SCALE: 3/4" = 1'-0"

18 TYPICAL NON LOAD BEARING CMU WALL BRACE CONNECTION DETAILS
SCALE: 3/4" = 1'-0"

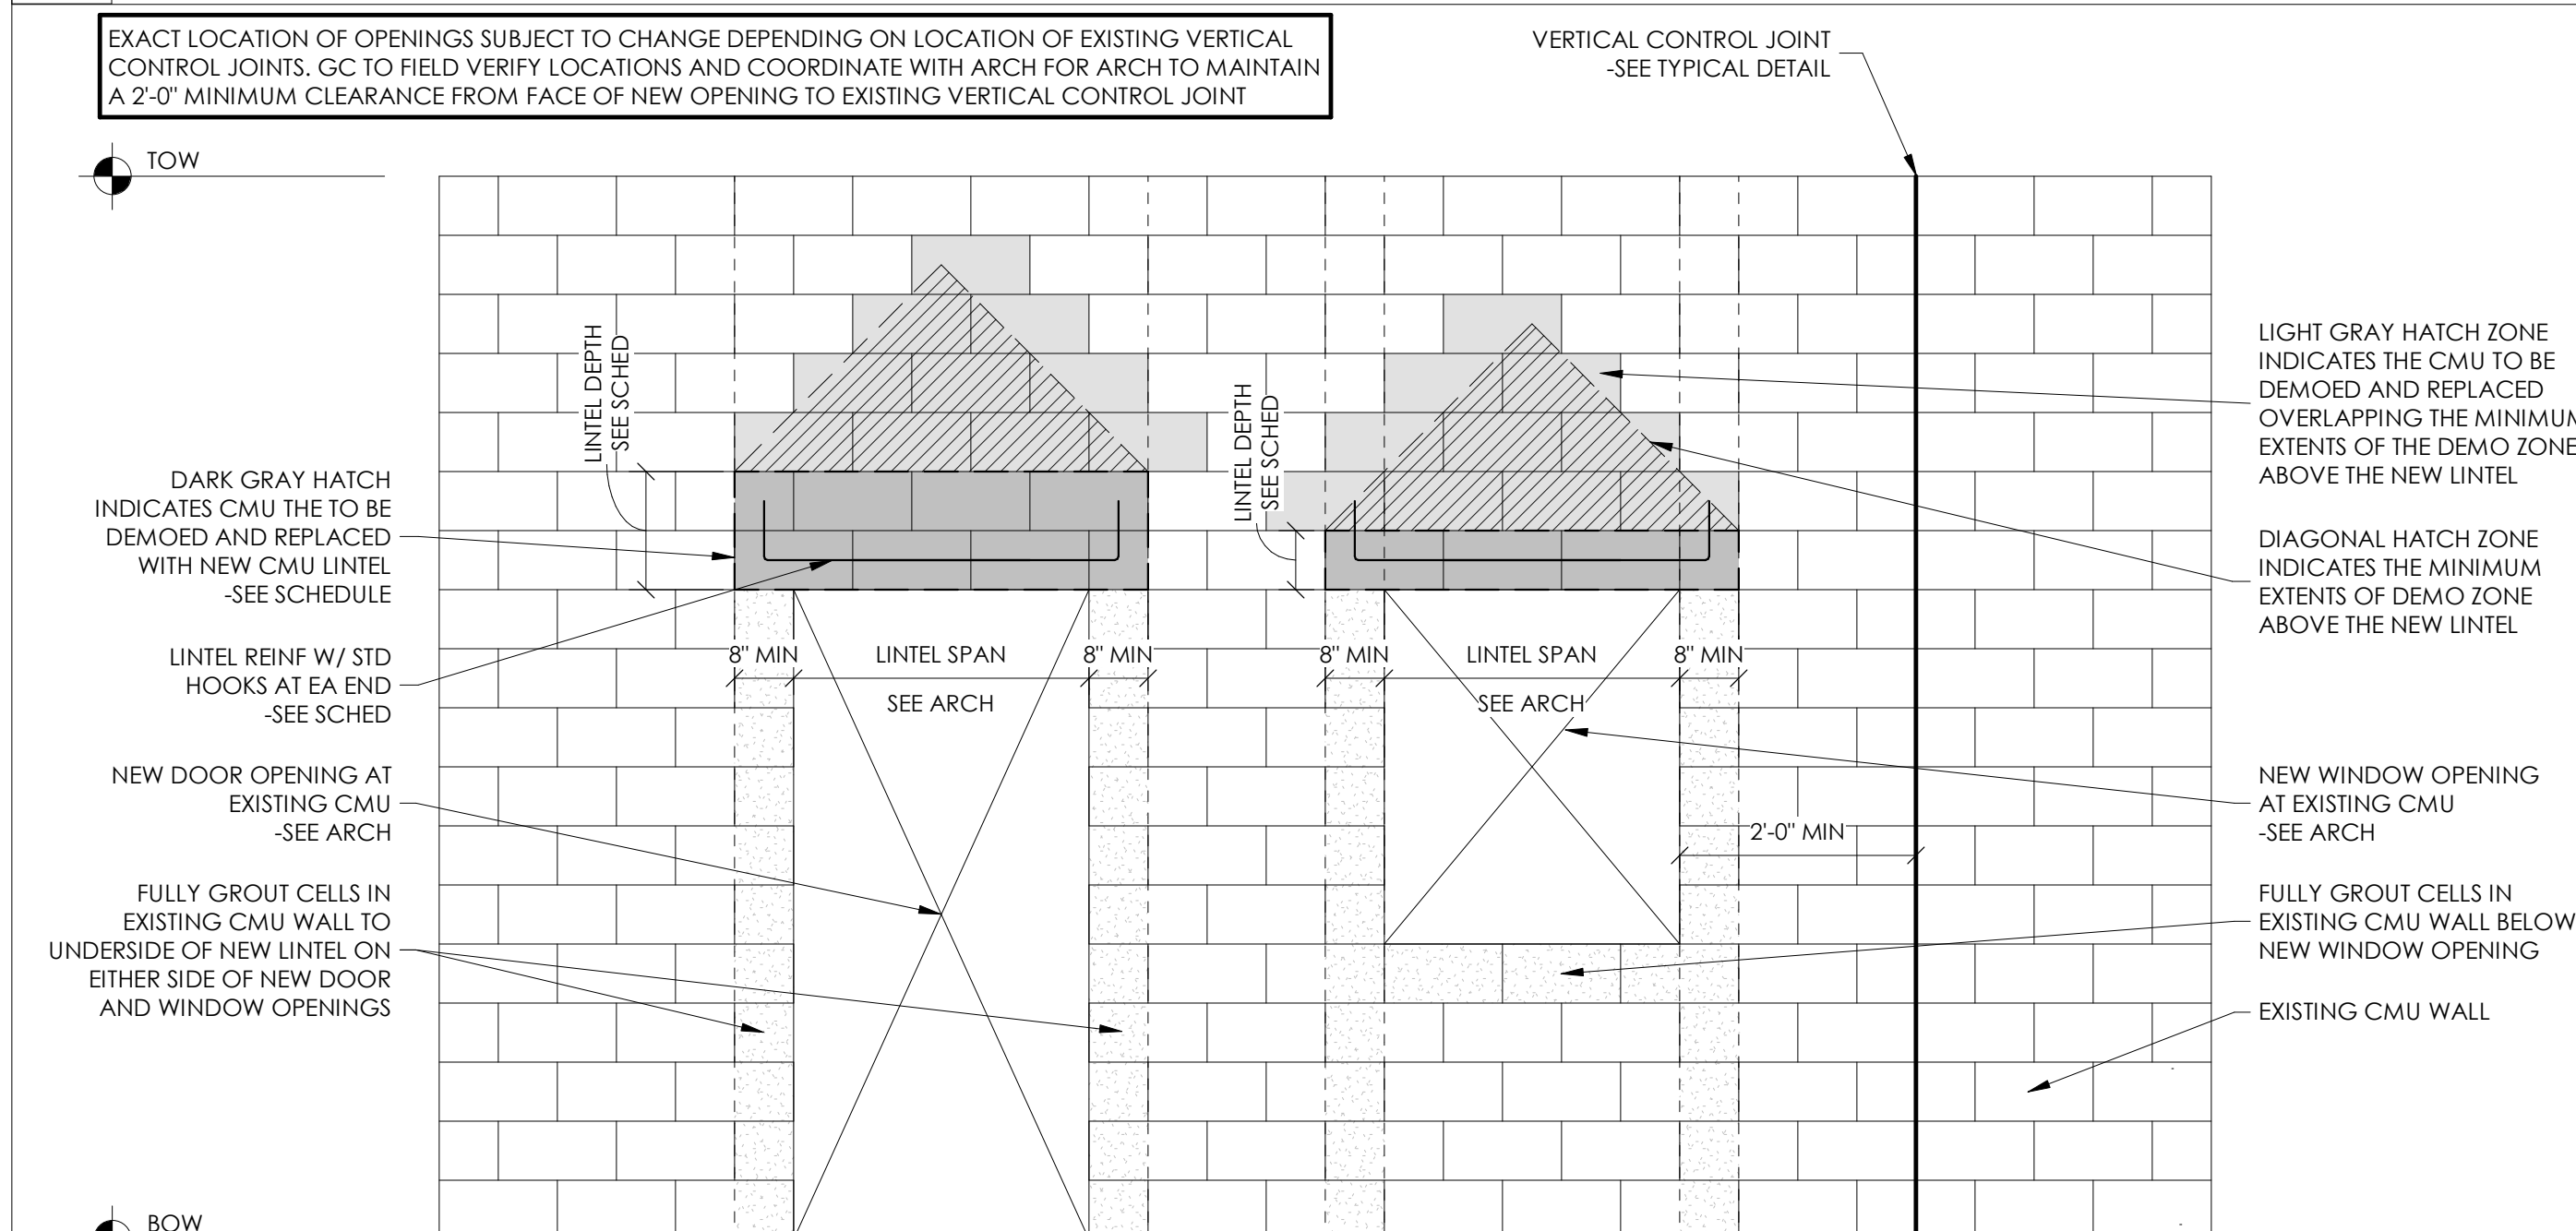

17 EXISTING MASONRY WALL ELEVATION W/ NEW POST-INSTALLED CMU LINTEL AT NEW OPENING
SCALE: 1/2" = 1'-0"

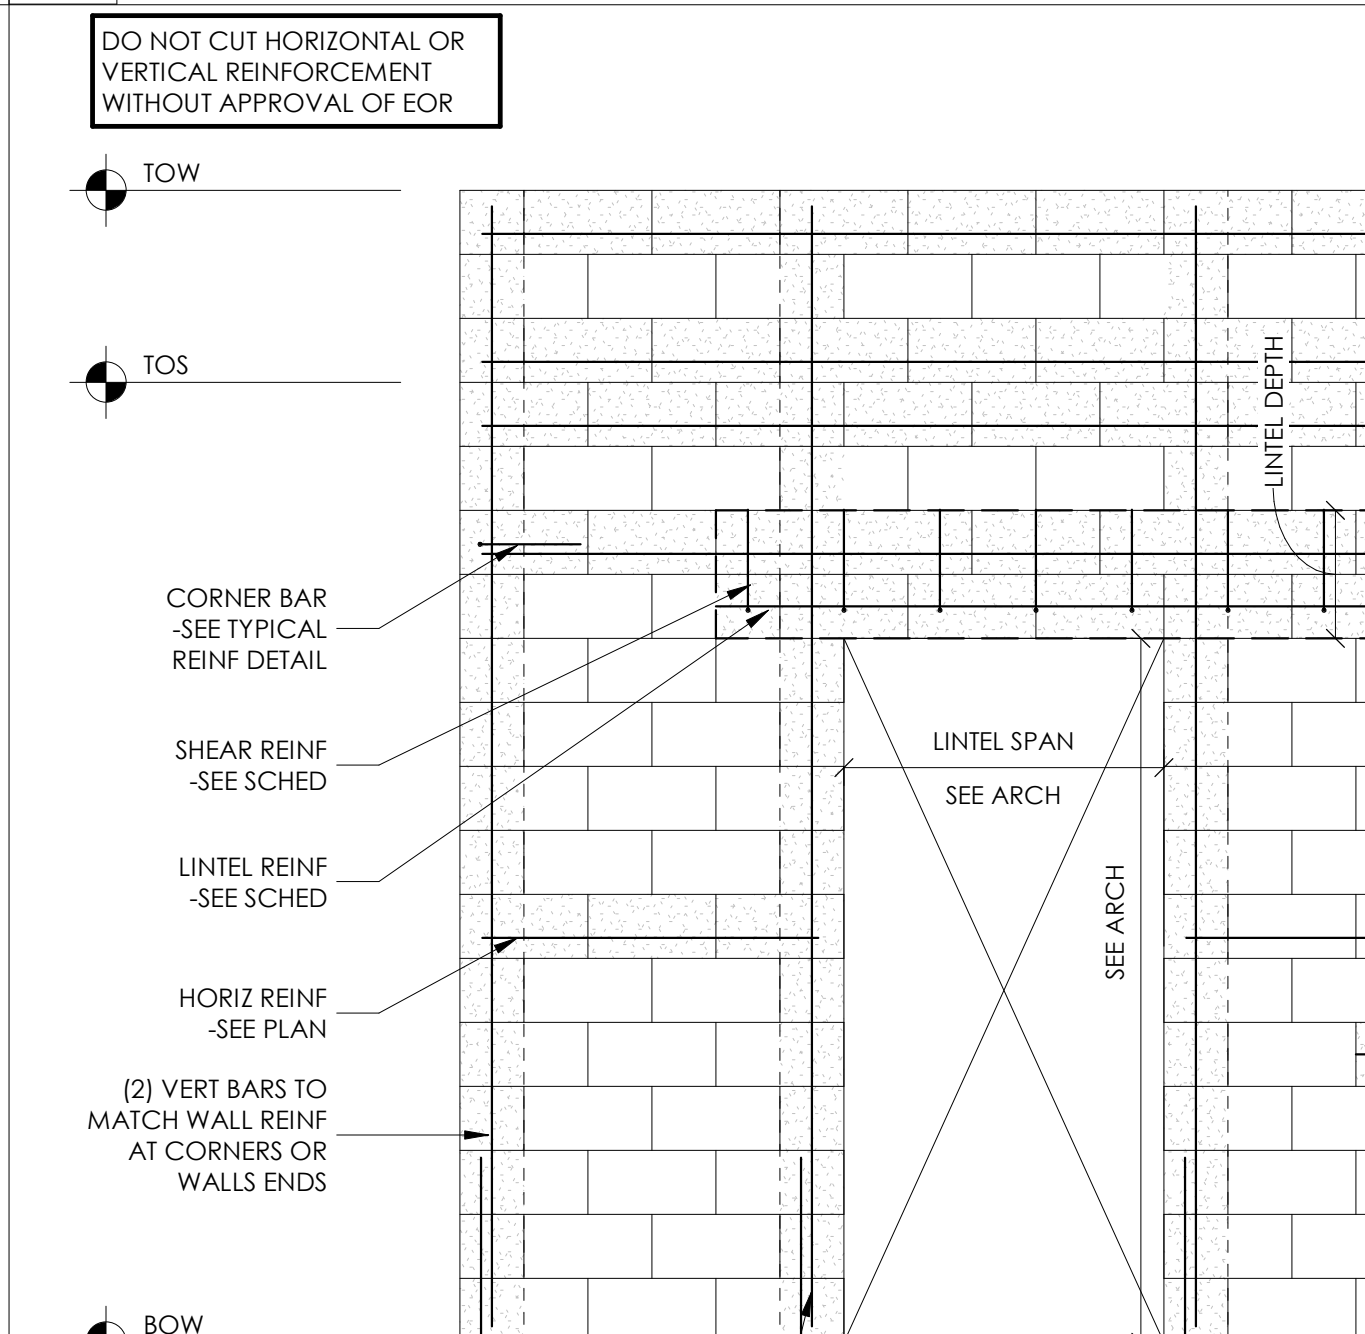


9 TYPICAL MASONRY WALL ELEVATION
SCALE: 1/2" = 1'-0"

ARCHITECT

VLK Architects
20445 State Hwy 249, Suite 350
Houston, Texas 77070
Main Phone: 281.671.2300
www.vlkarhitects.com

STRUCTURAL

Dunaway
3200 Wilcrest Dr. Ste 4400
Houston, Texas 77042
Main Phone: 512.306.8252
www.dunaway.com

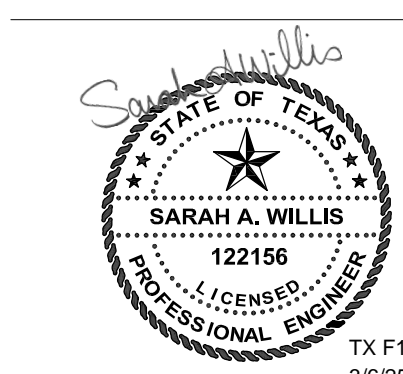

ISSUED: 02/24/2025

REVISIONS

Revision No.	Revision Date
1	ADDENDUM 1
	03/06/25

Director
SW
Designated
AB
Proj. Eng.
AB

Drawn By
LM
Quality Control
SW

PROJECT NO.
11366
SHEET TITLE
TYPICAL MASONRY DETAILS
SHEET NO.

S30.40

ARCHITECT

VLK Architects
 20445 State Hwy 249, Suite 350
 Houston, Texas 77070
 Main Phone: 281.671.2300
 www.vlkarchitects.com

STRUCTURAL

Dunaway
 3200 Wilcrest Dr. Ste 4400
 Houston, Texas 77042
 Main Phone: 512.306.8252
 www.dunaway.com



ISSUED: 02/24/2025

REVISIONS

Revision No.	Revision Date
1	ADDENDUM 1
	03/06/25

Director SW
 Drawn By LM
 Designer AB
 Proj. Eng. AB
 Quality Control SW

PROJECT NO.


11366

SHEET TITLE


FOUNDATION DETAILS

SHEET NO.



S33.10

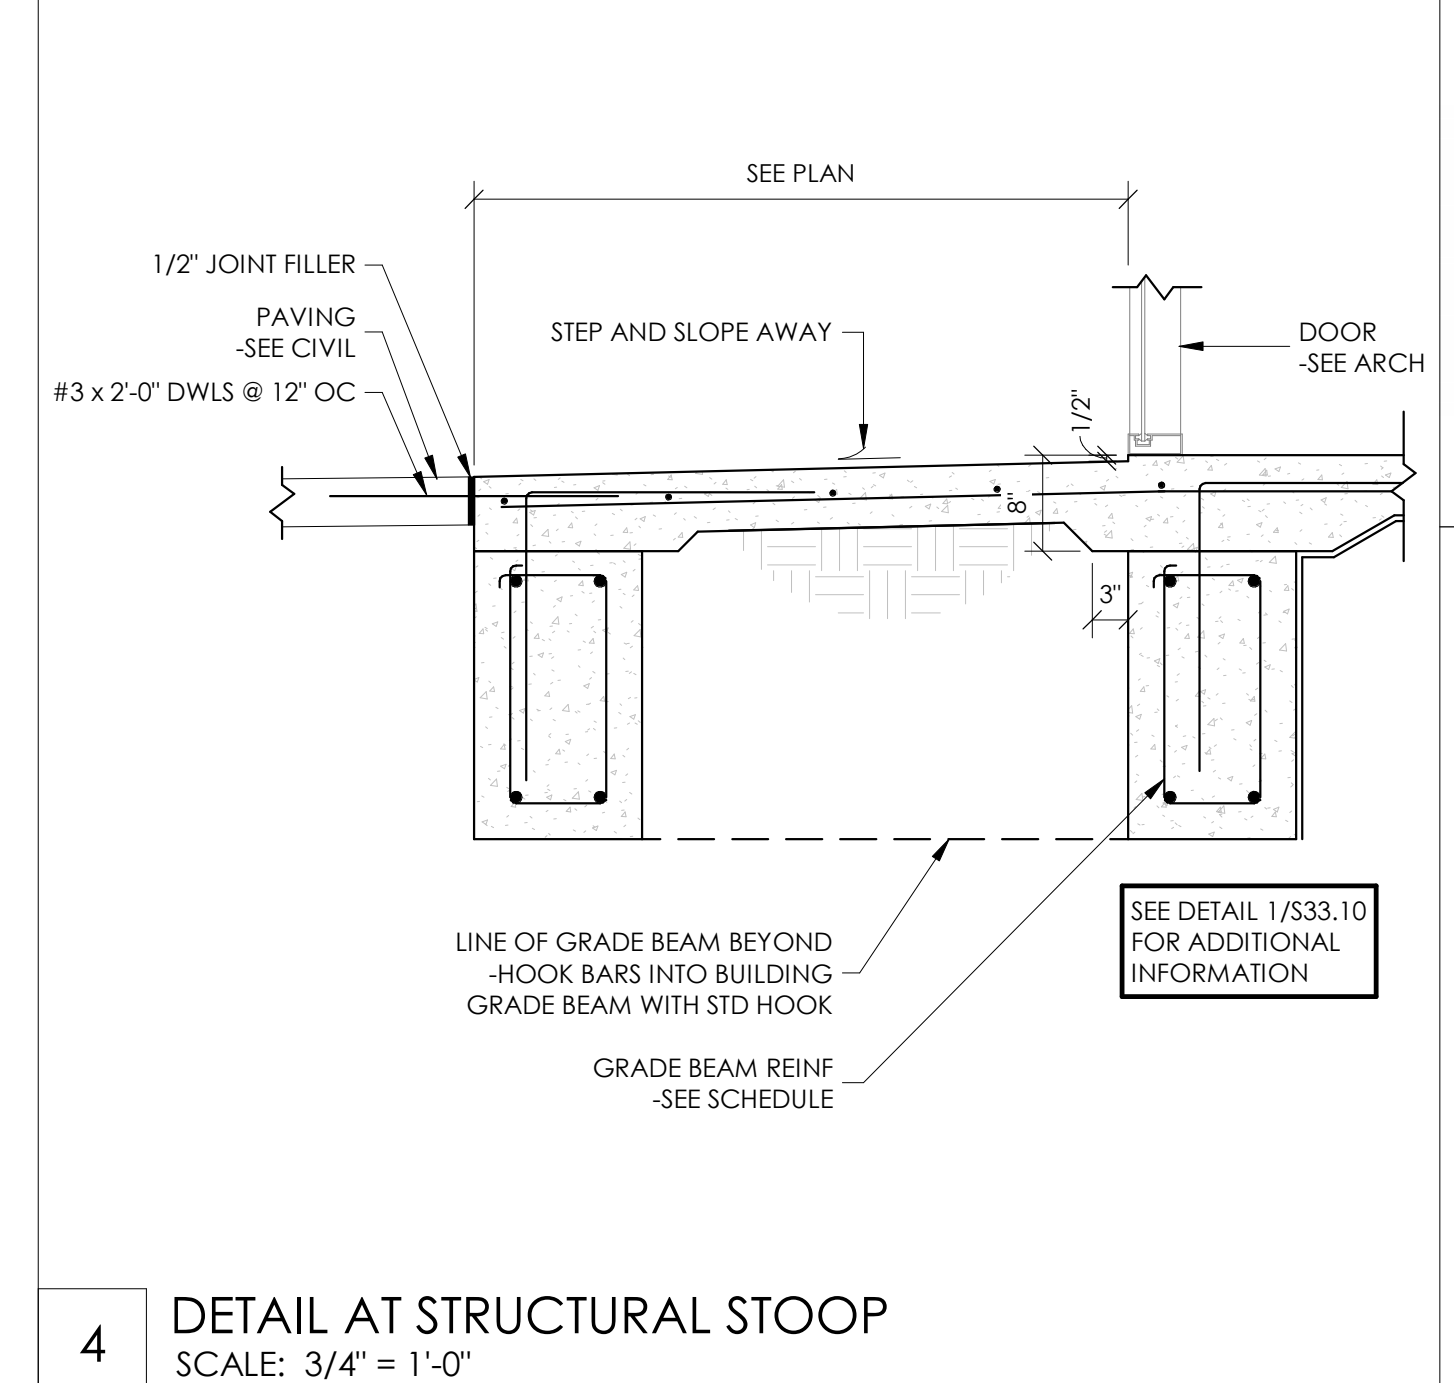

4 DETAIL AT STRUCTURAL STOOP
 SCALE: 3/4" = 1'-0"

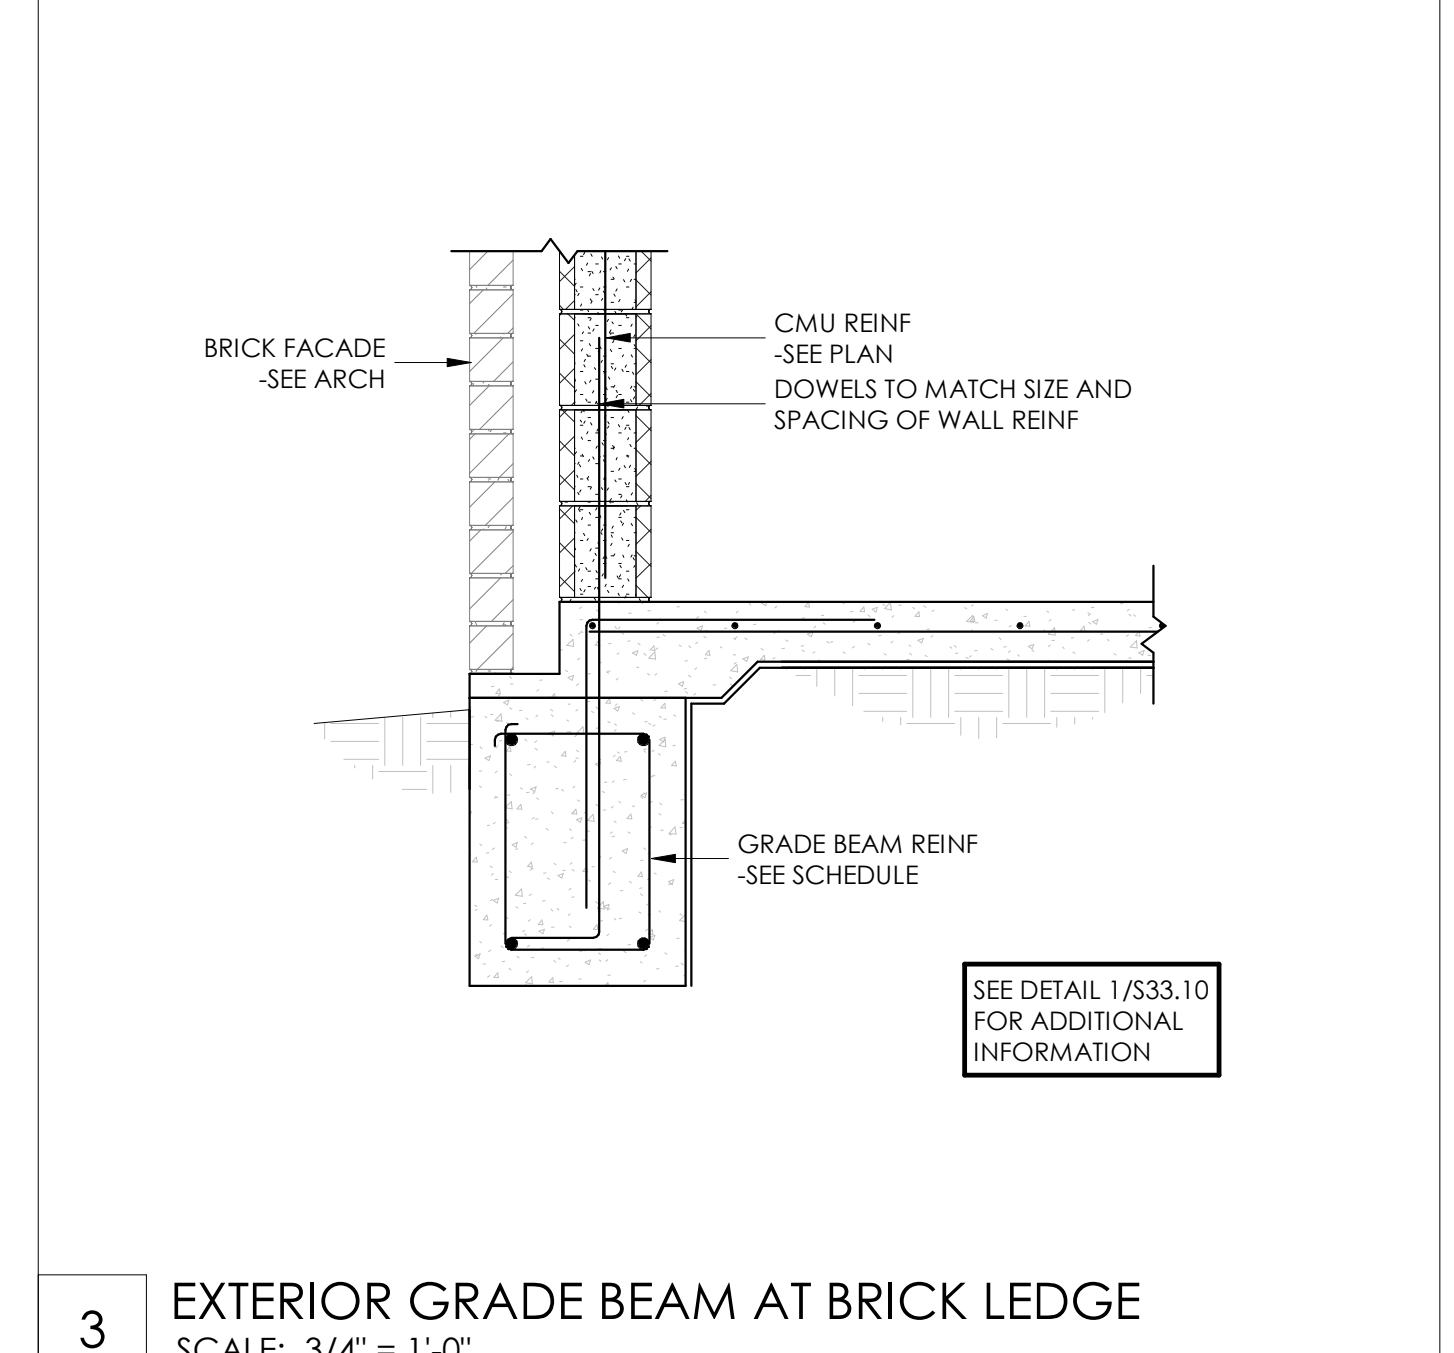


3 EXTERIOR GRADE BEAM AT BRICK LEDGE
 SCALE: 3/4" = 1'-0"

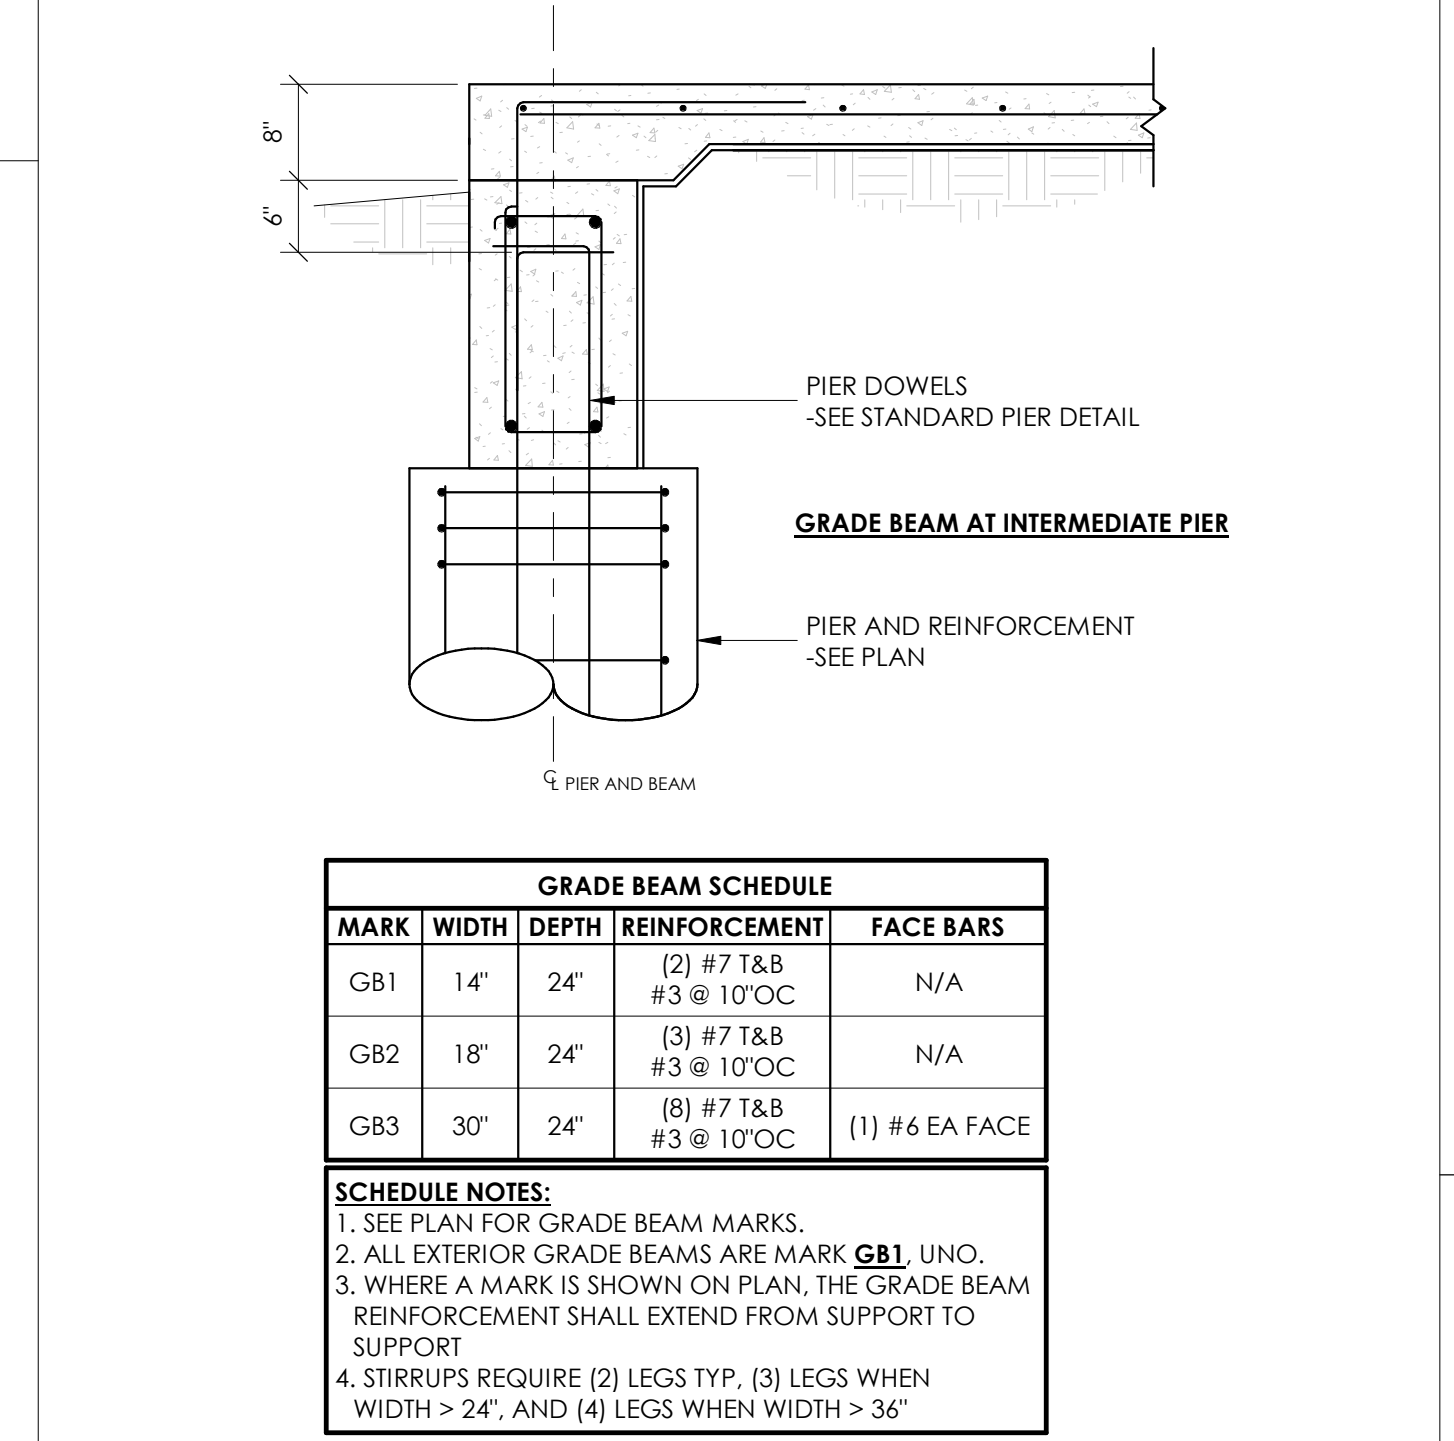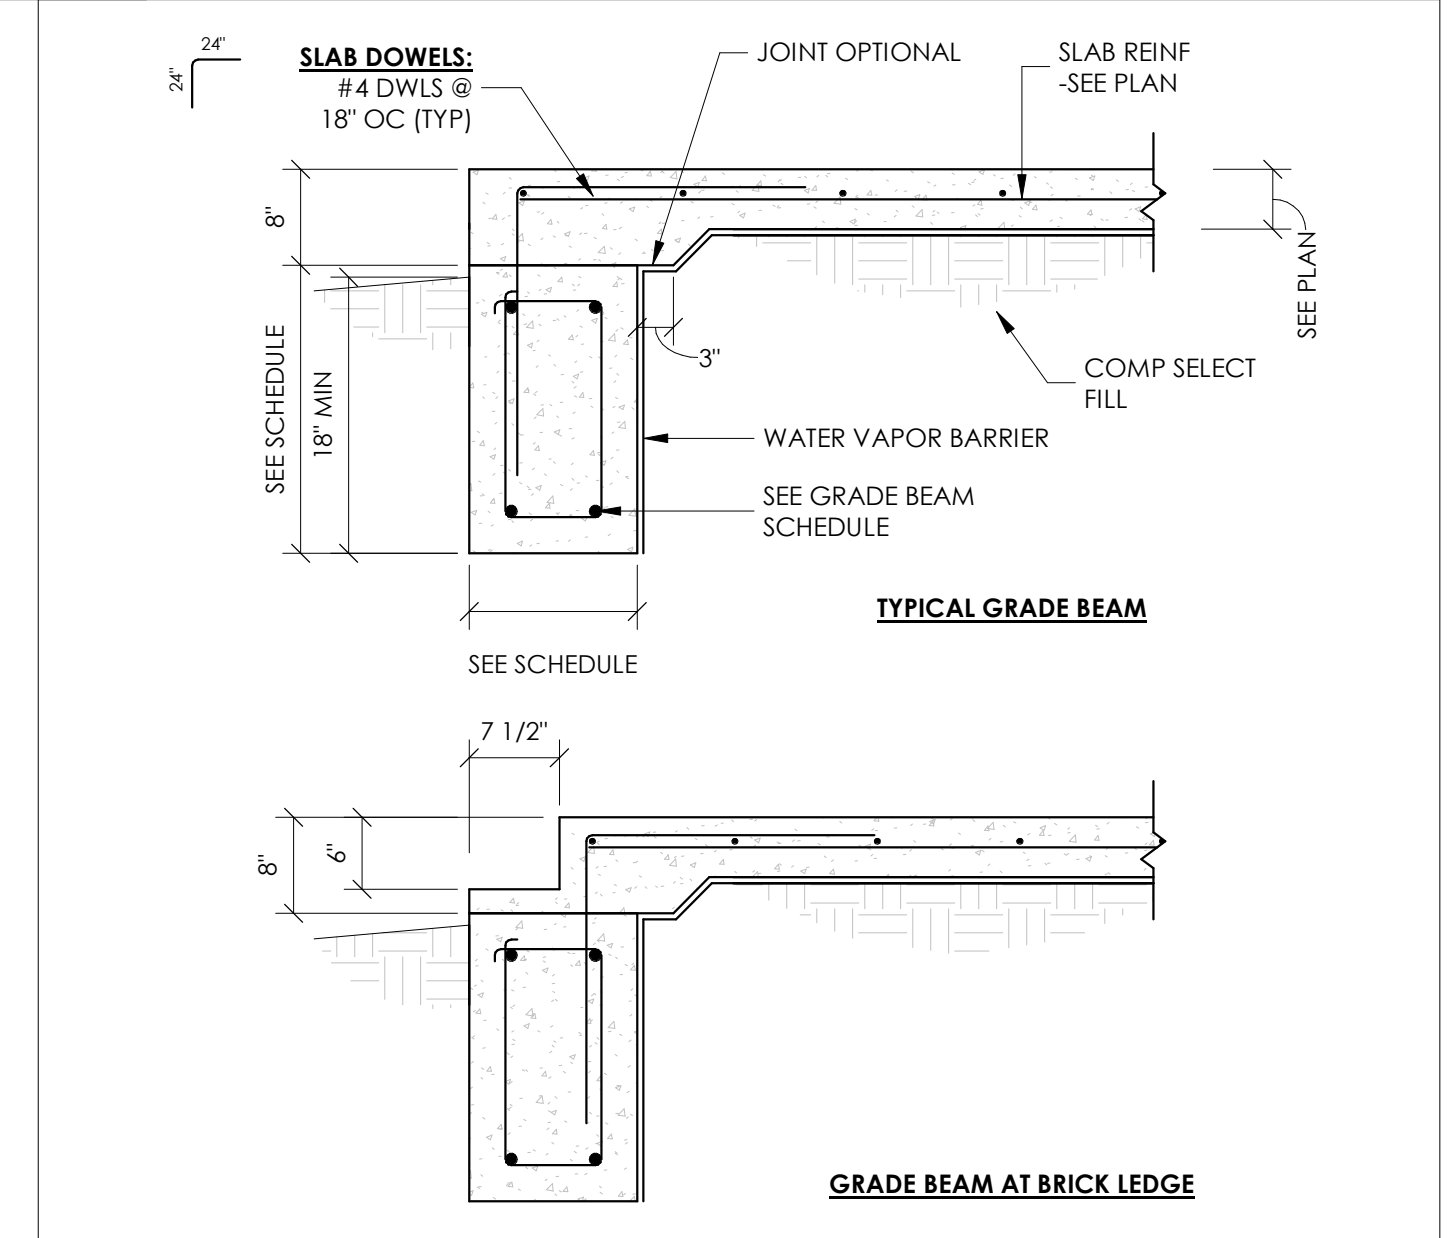


1 EXTERIOR GRADE BEAM DETAIL
 SCALE: 3/4" = 1'-0"

MARK	WIDTH	DEPTH	REINFORCEMENT	FACE BARS
GB1	14"	24"	(2) #7 T&B (3) #3 @ 10" OC	N/A
GB2	18"	24"	(3) #7 T&B (3) #3 @ 10" OC	N/A
GB3	30"	24"	(8) #7 T&B (3) #3 @ 10" OC	(1) #6 EA FACE


SCHEDULE NOTES:
 1. SEE PLAN FOR GRADE BEAM MARKS.
 2. ALL EXTERIOR GRADE BEAMS ARE MARK **GB1** UNO.
 3. WHERE A MARK IS SHOWN ON PLAN, THE GRADE BEAM REINFORCEMENT SHALL EXTEND FROM SUPPORT TO SUPPORT.
 4. STIRRUPS REQUIRE (2) LEGS TYP. (3) LEGS WHEN WIDTH > 24". AND (4) LEGS WHEN WIDTH > 36".

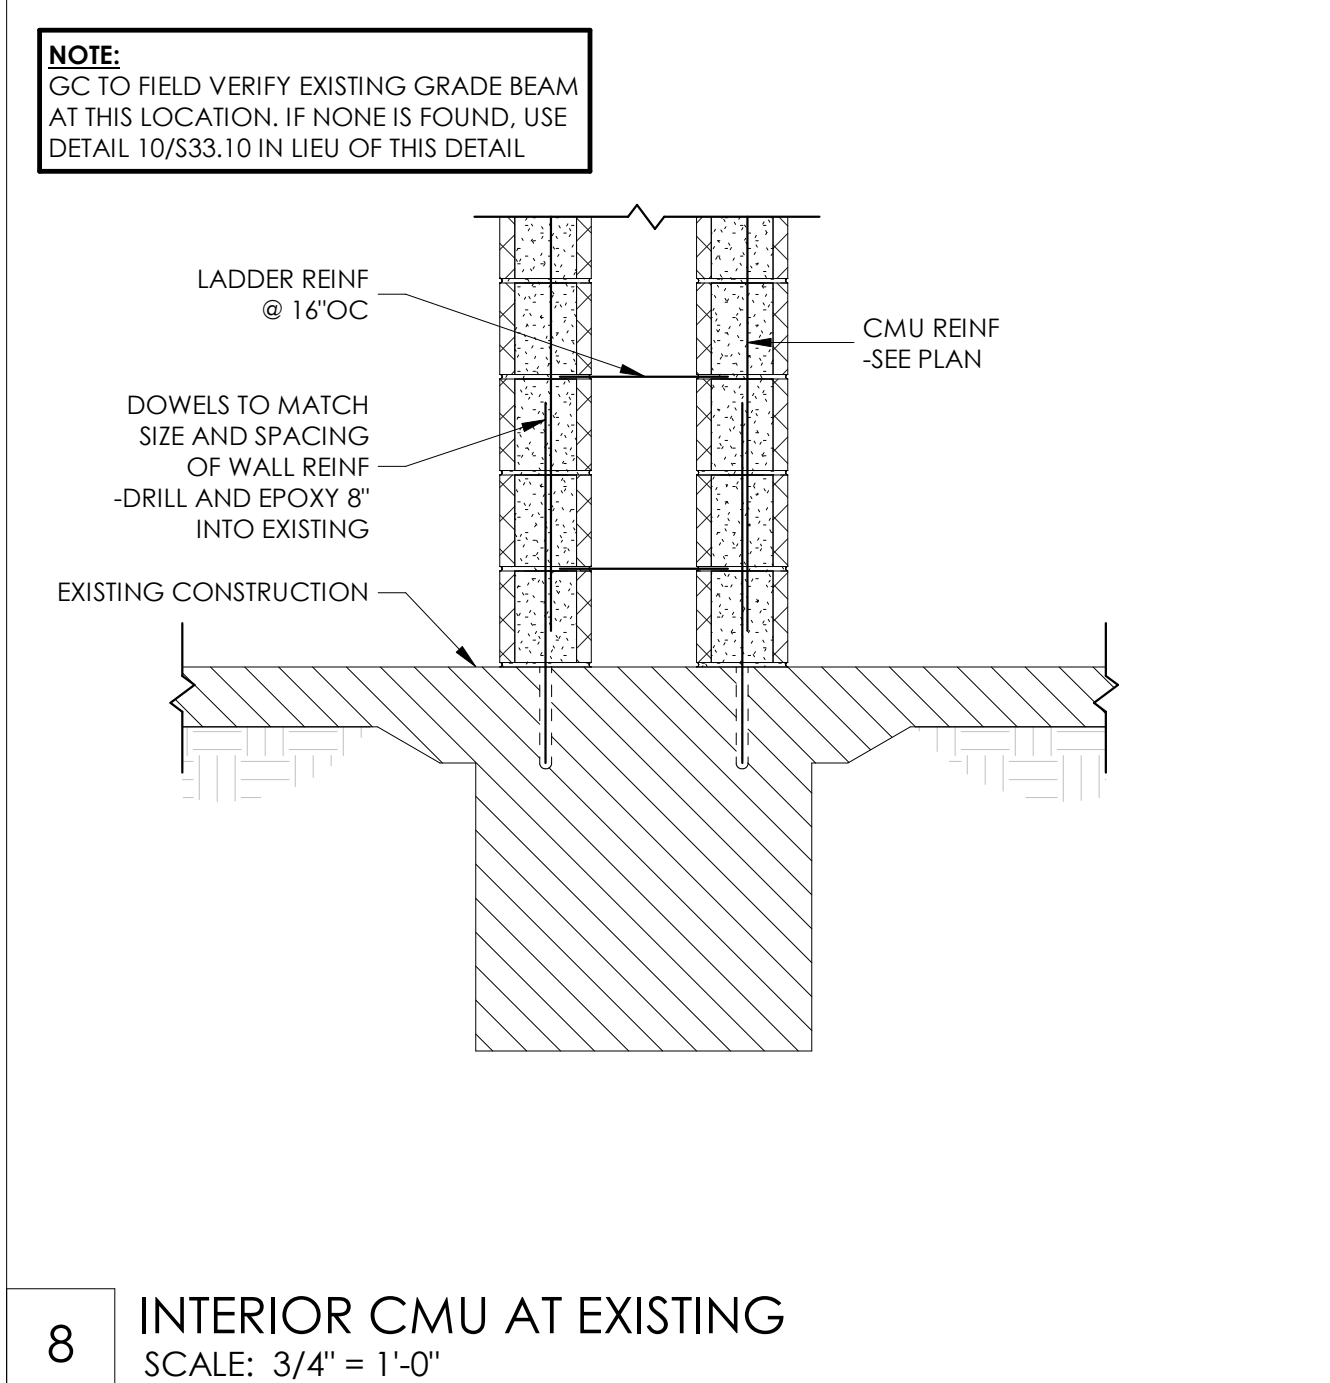


8 INTERIOR CMU AT EXISTING
 SCALE: 3/4" = 1'-0"

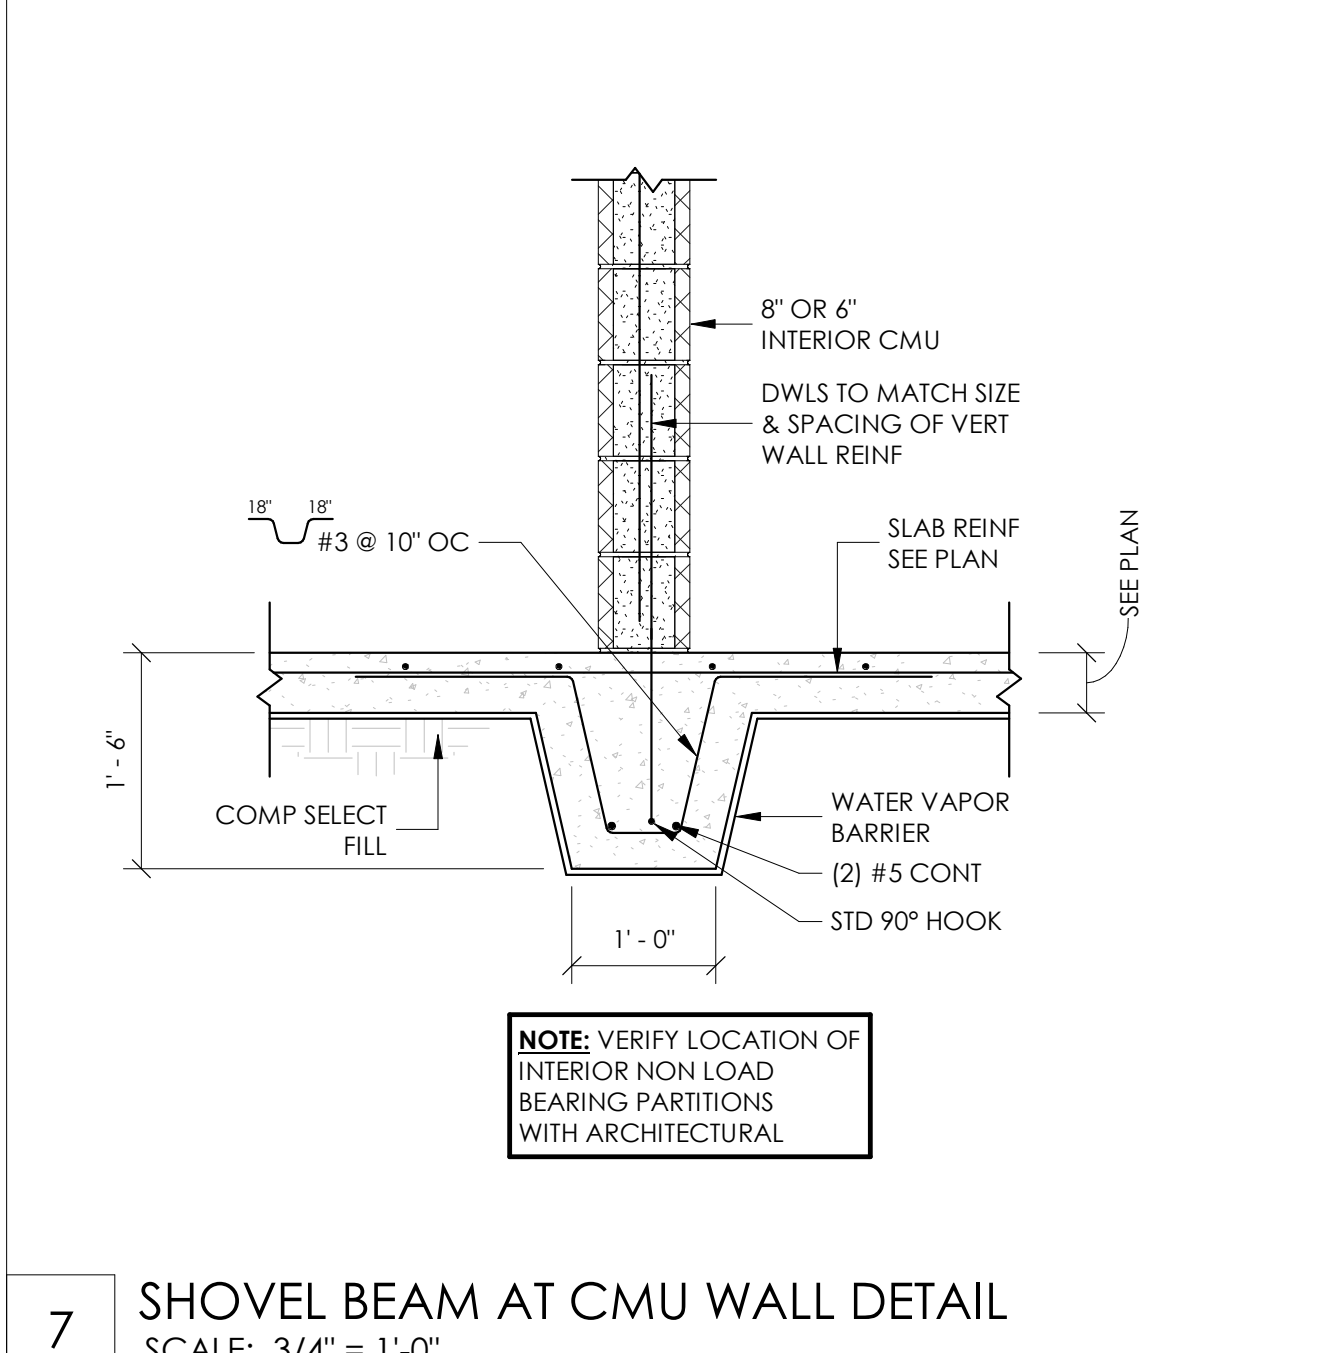


7 SHOVEL BEAM AT CMU WALL DETAIL
 SCALE: 3/4" = 1'-0"

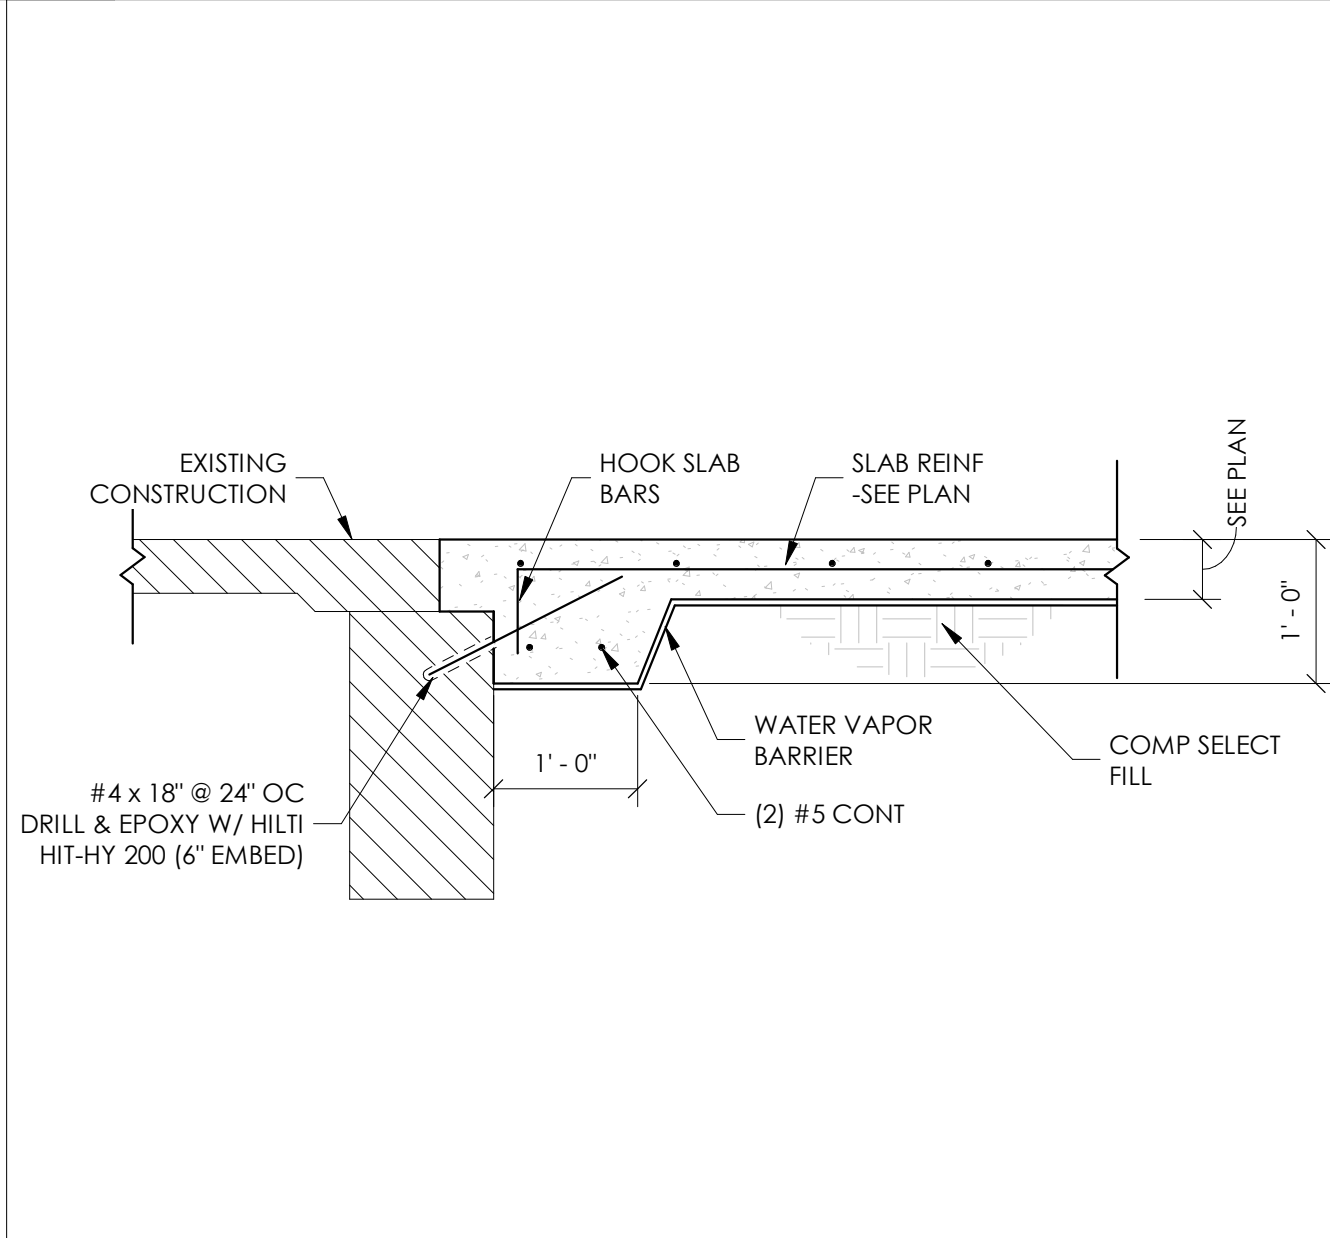


6 TYPICAL TURNDOWN AT EXISTING
 SCALE: 3/4" = 1'-0"

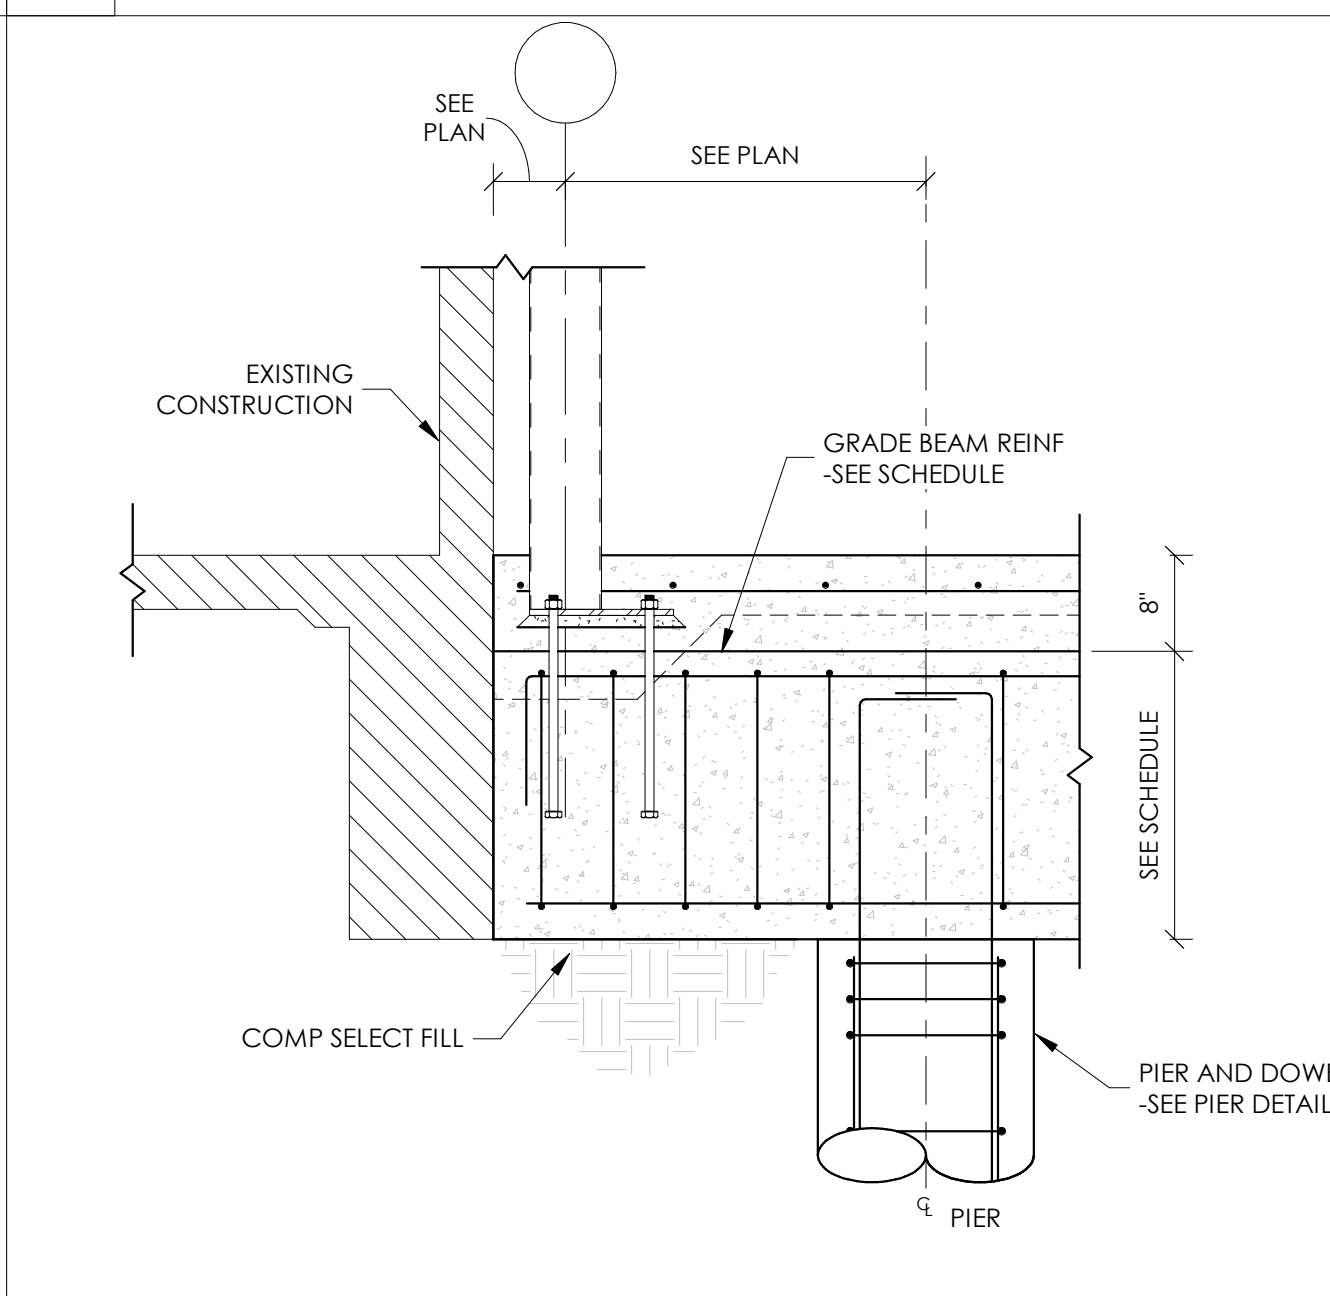


5 CANTILEVER GRADE BEAM AT COLUMN
 SCALE: 3/4" = 1'-0"

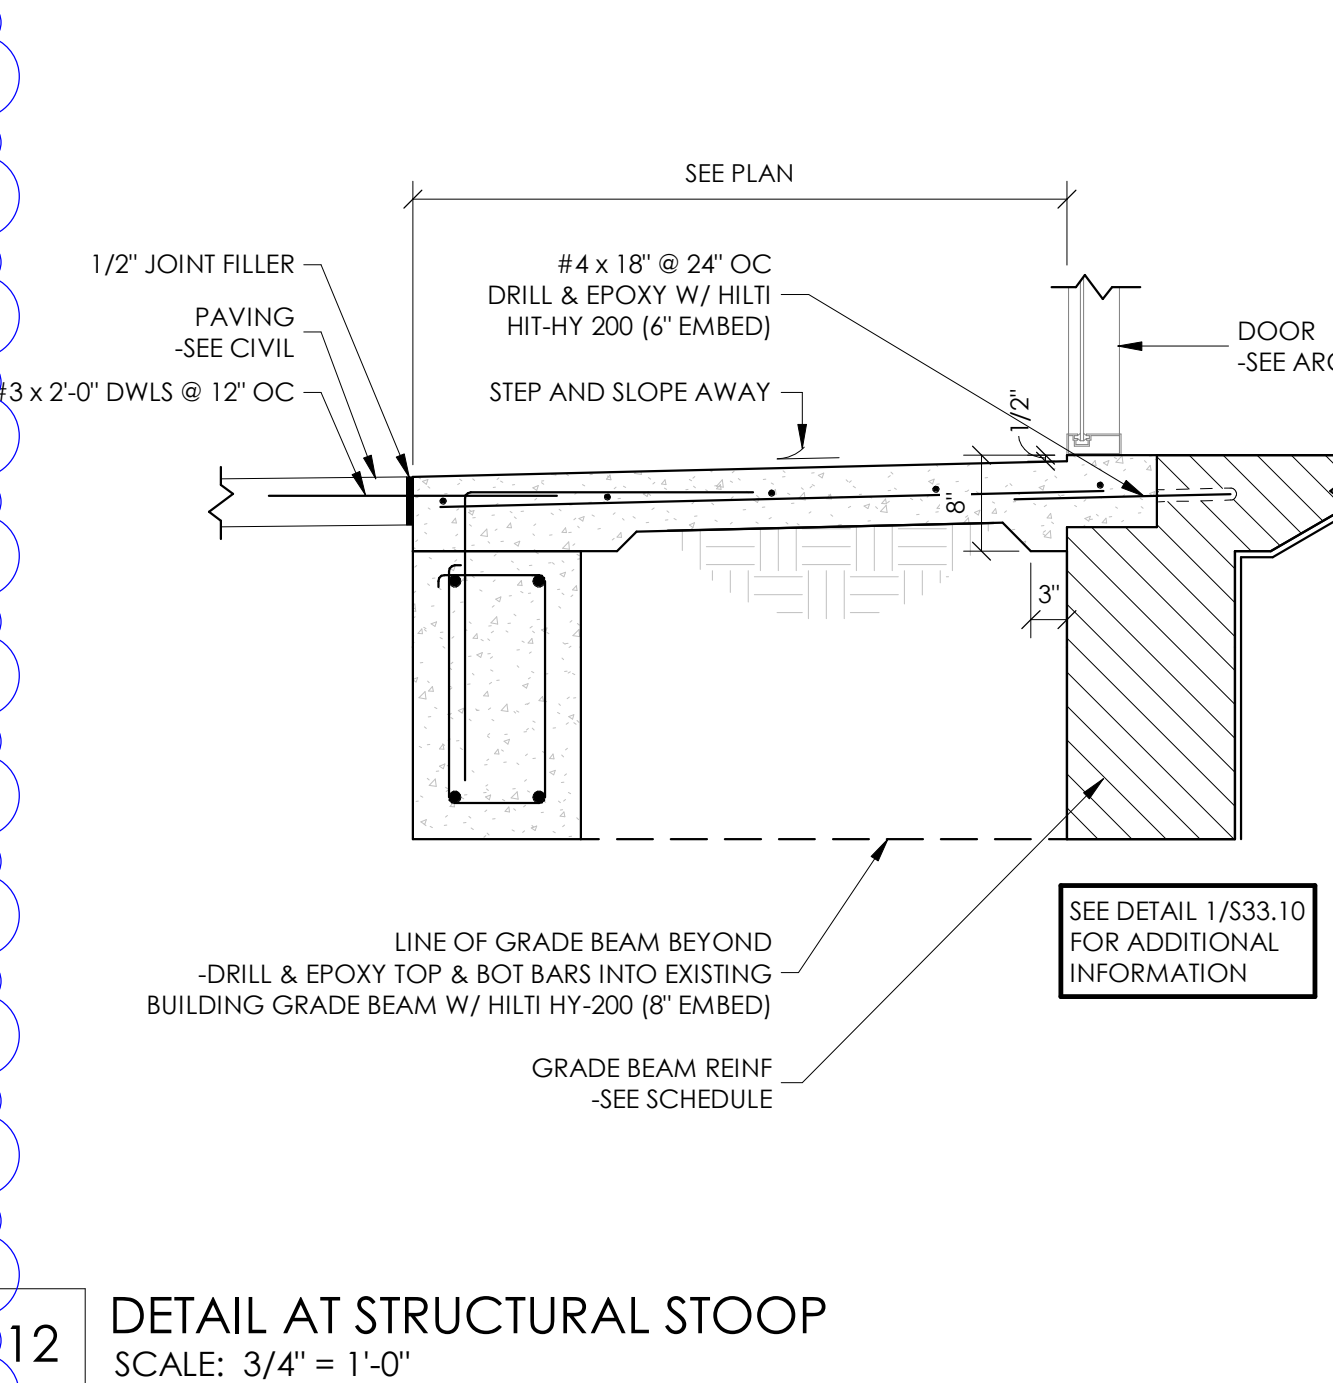


12 DETAIL AT STRUCTURAL STOOP
 SCALE: 3/4" = 1'-0"

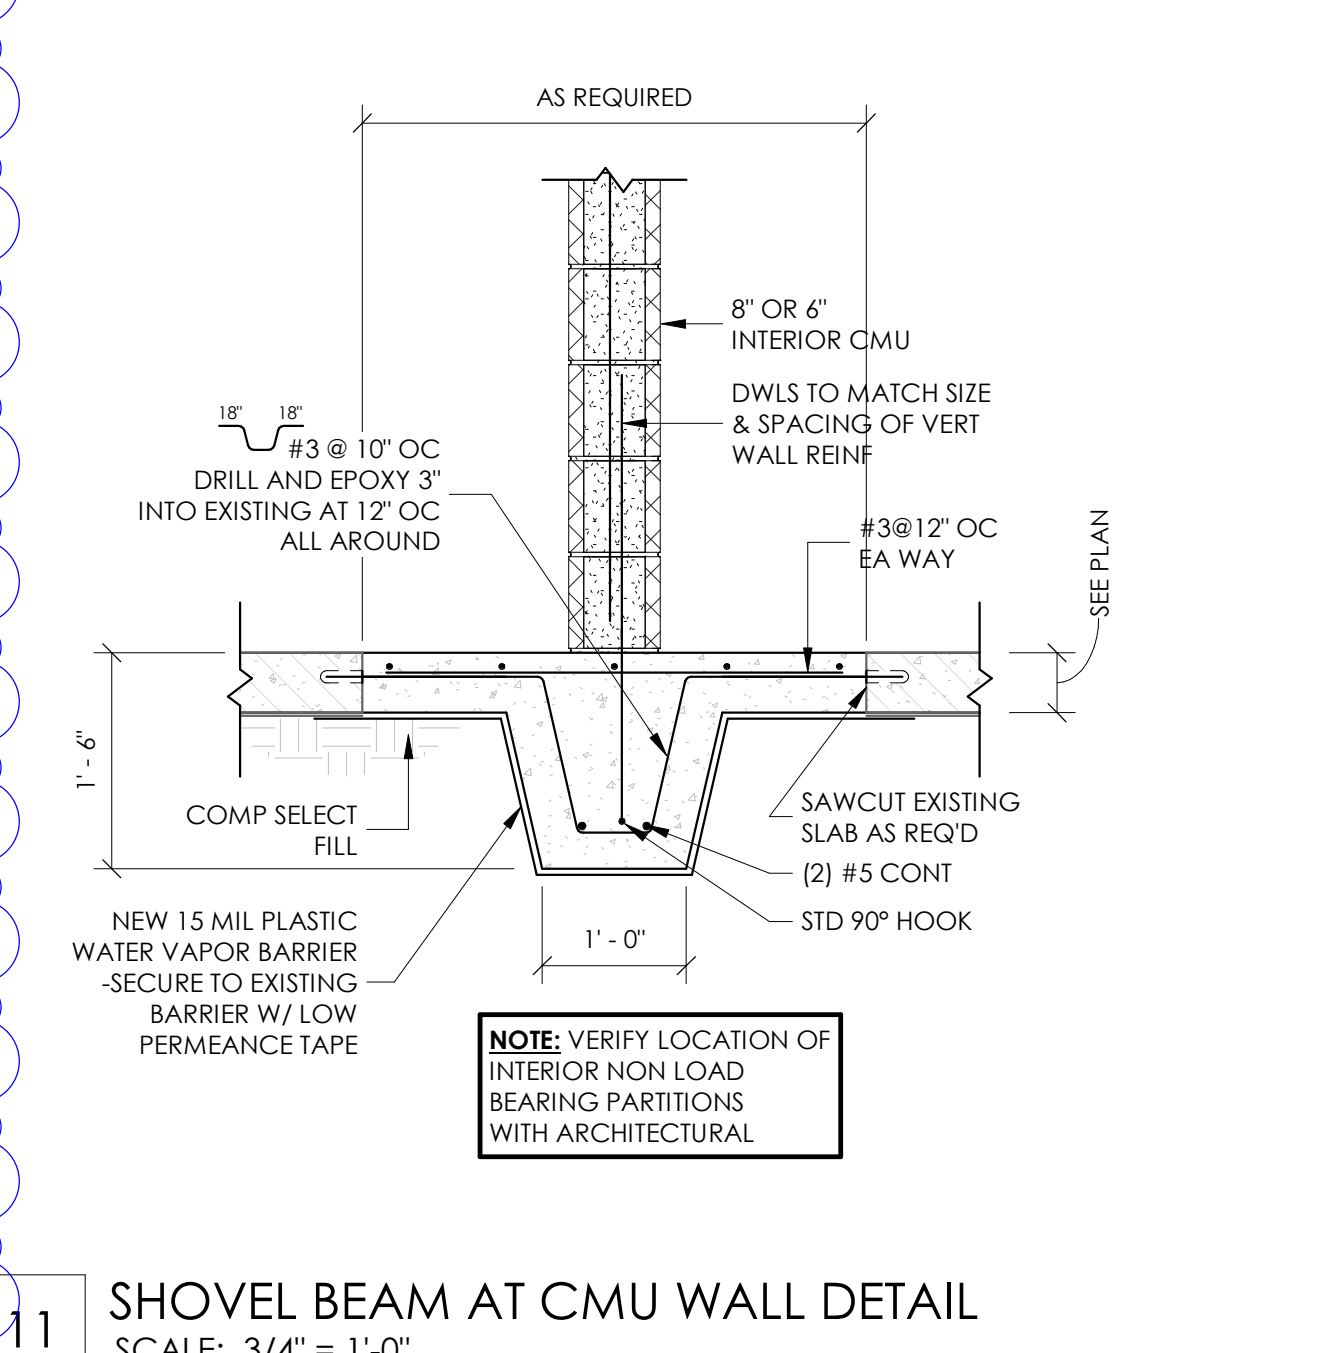


11 SHOVEL BEAM AT CMU WALL DETAIL
 SCALE: 3/4" = 1'-0"

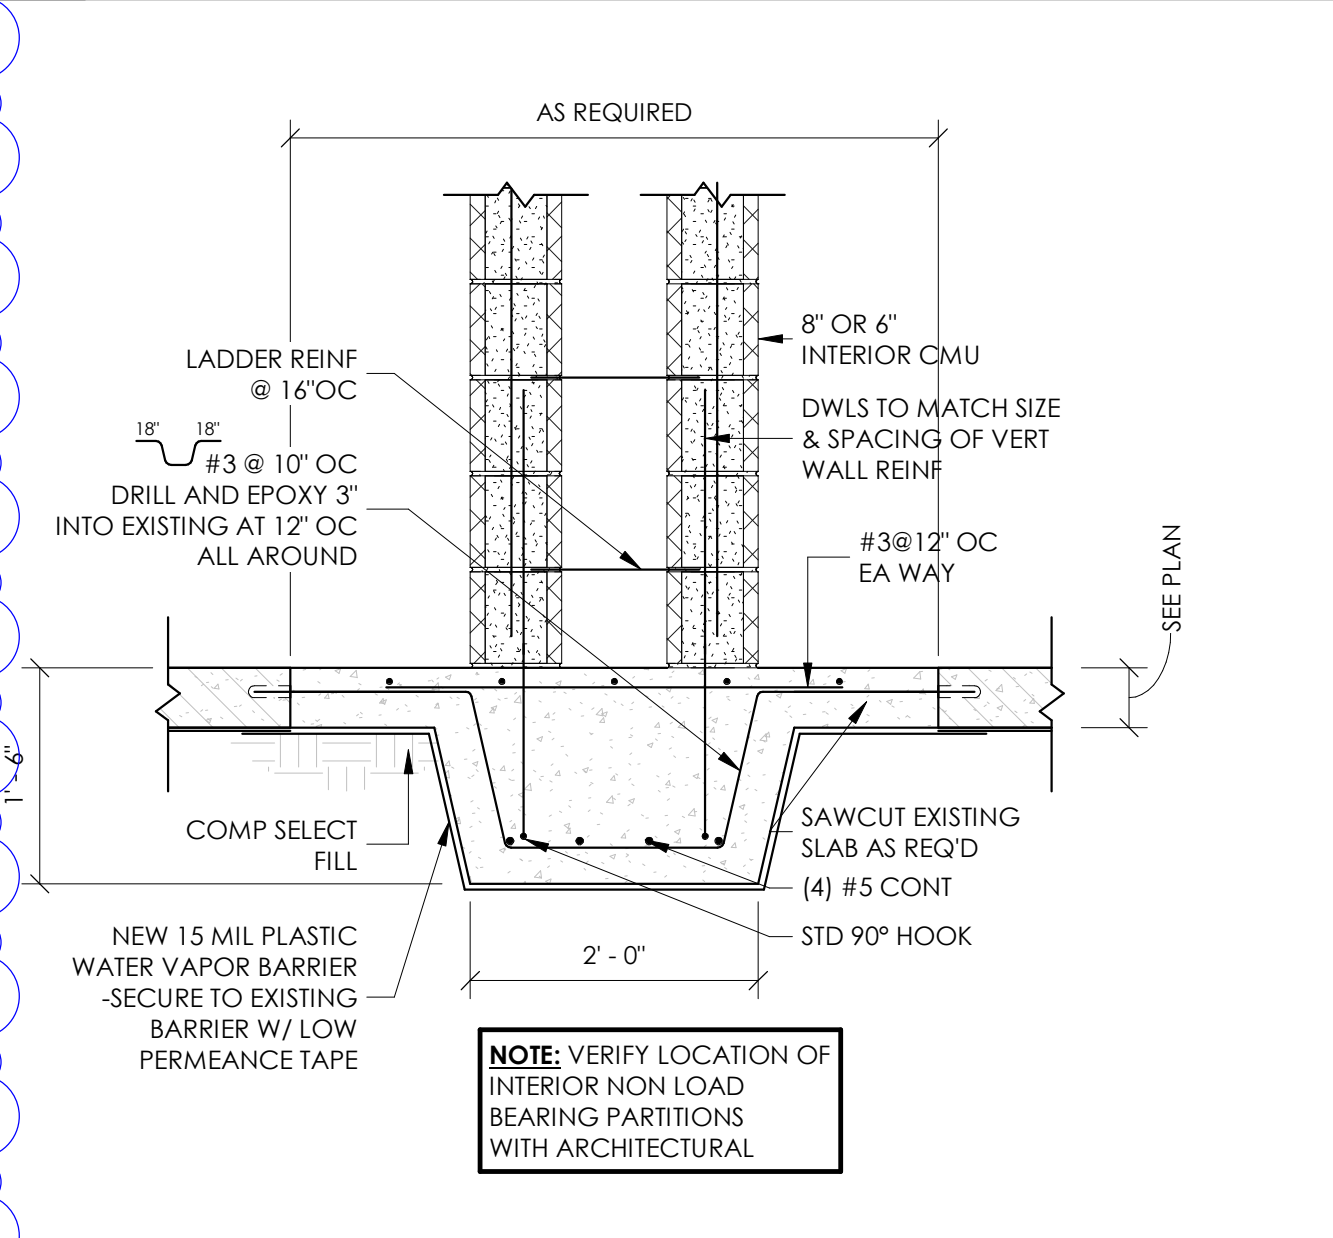


10 SHOVEL BEAM AT DOUBLE CMU WALL DETAIL
 SCALE: 3/4" = 1'-0"

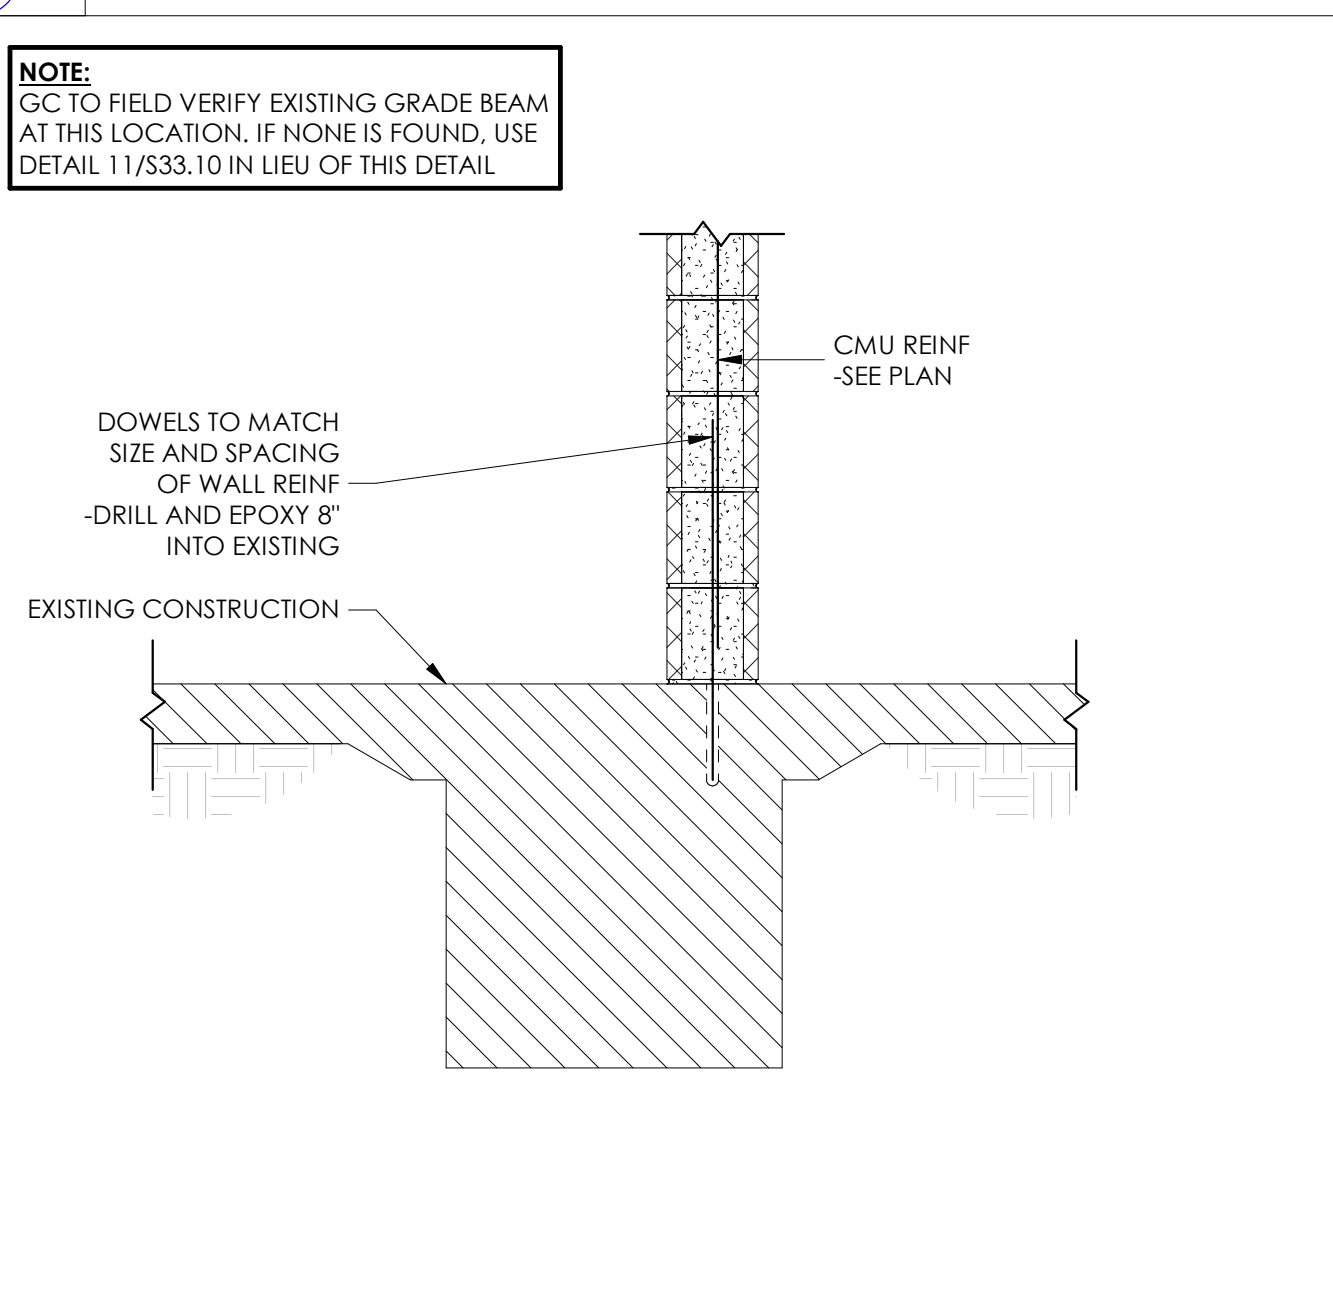


9 INTERIOR CMU AT EXISTING
 SCALE: 3/4" = 1'-0"

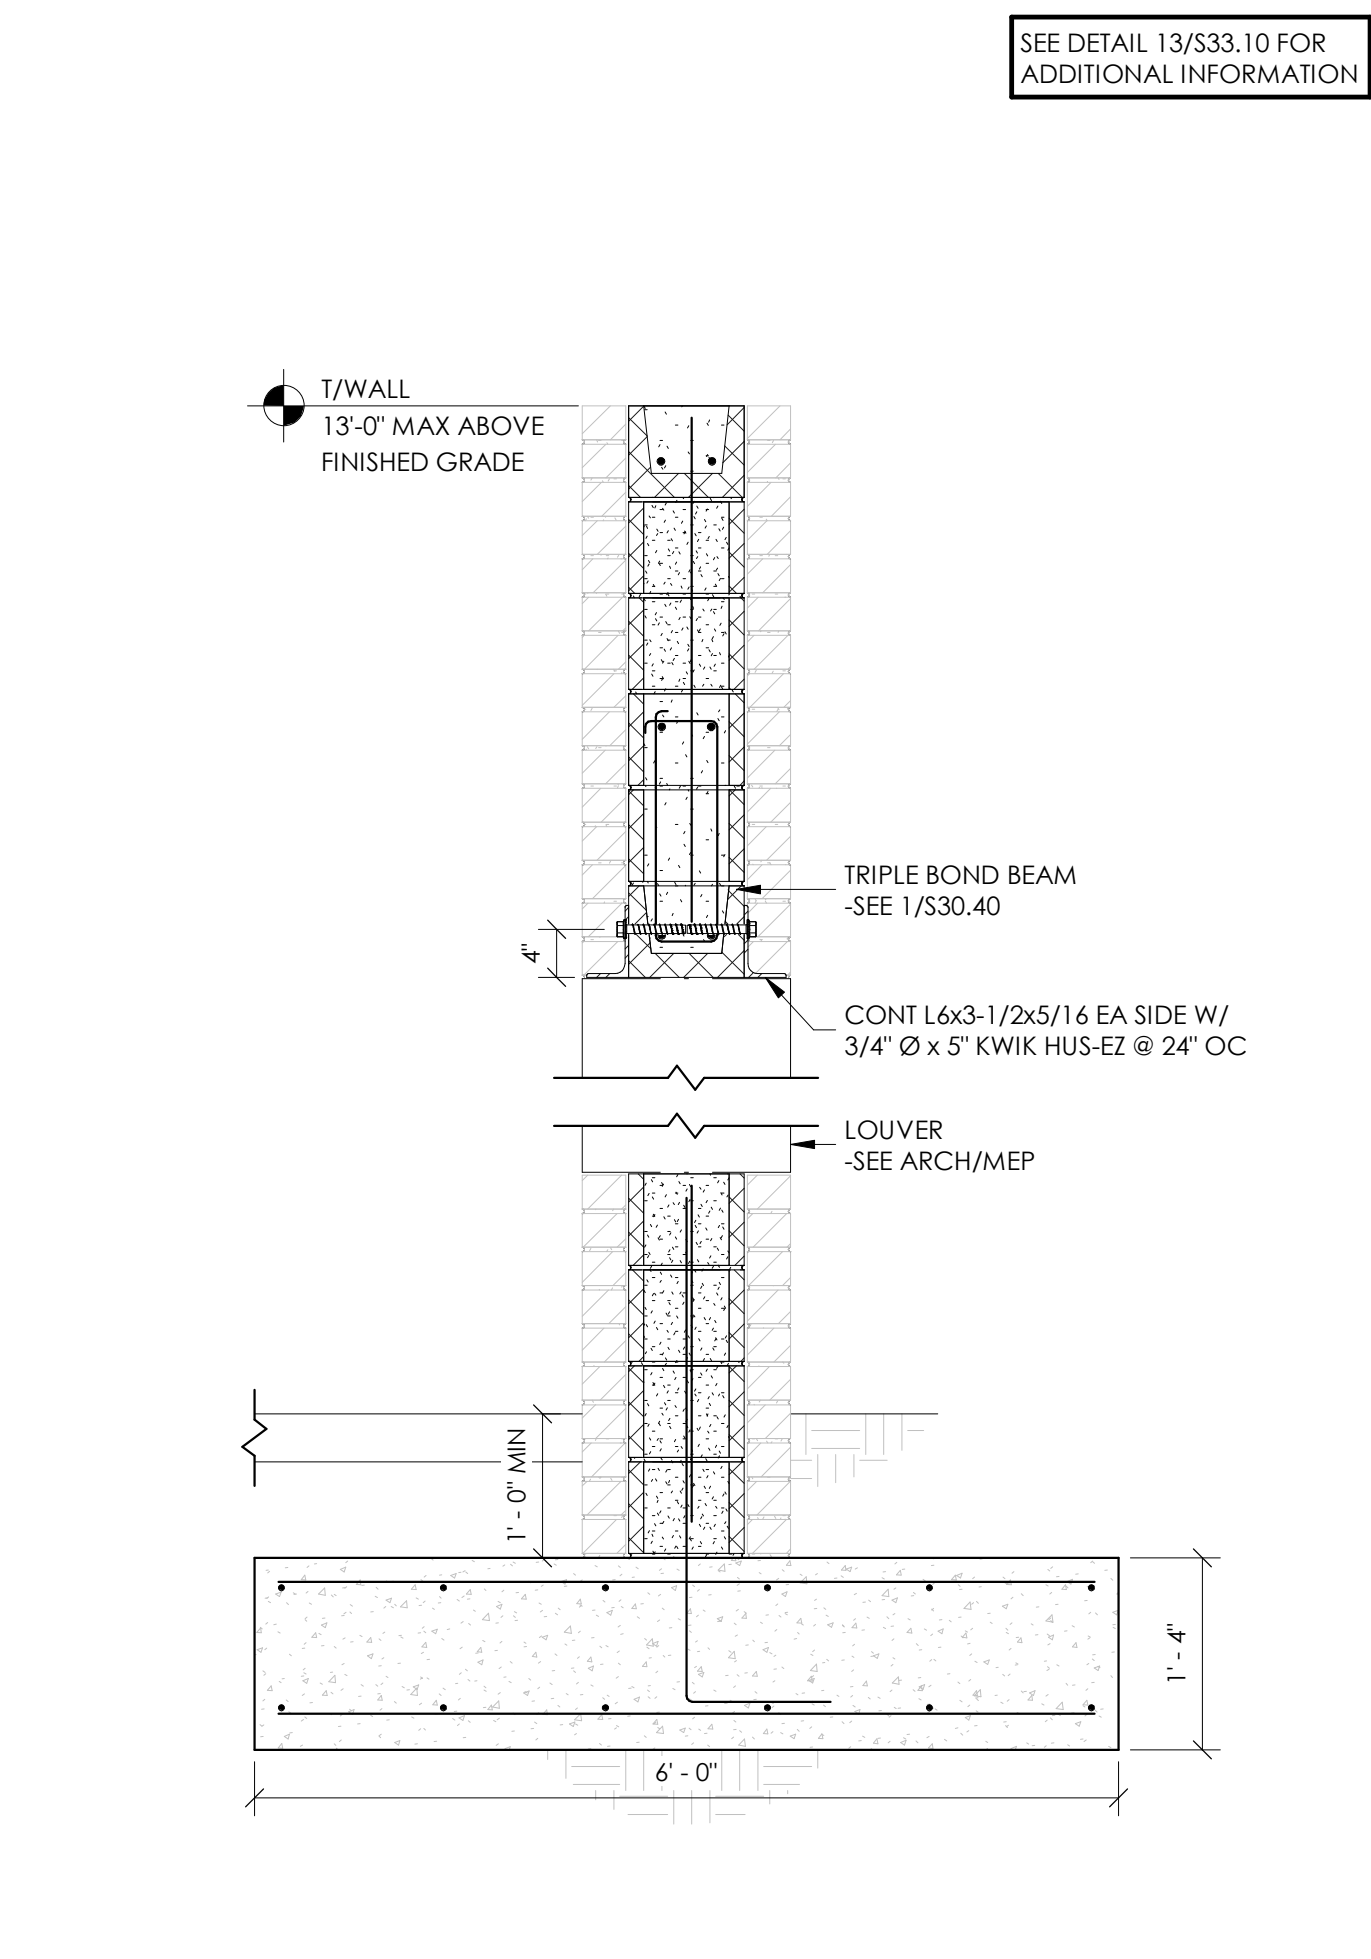


15 CMU SCREEN WALL AT MECHANICAL YARD LOUVER
 SCALE: 3/4" = 1'-0"

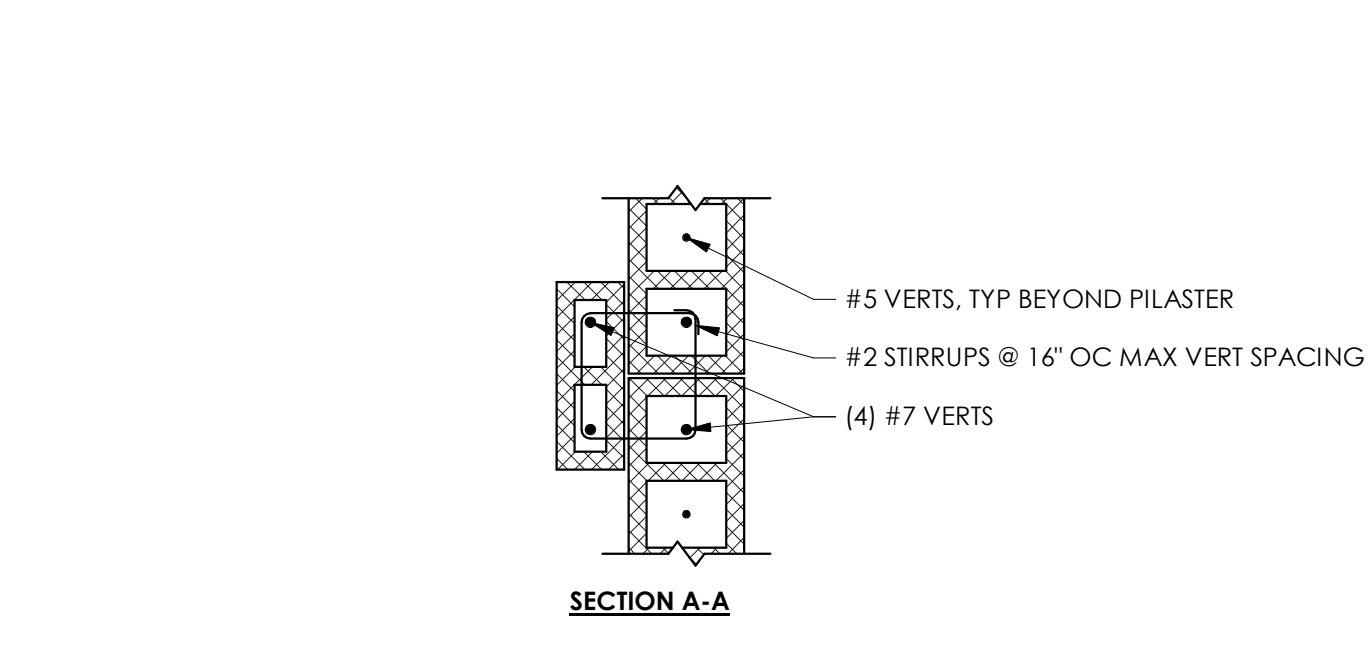

14 CMU SCREEN WALL PILASTER AT MECHANICAL YARD
 SCALE: 3/4" = 1'-0"

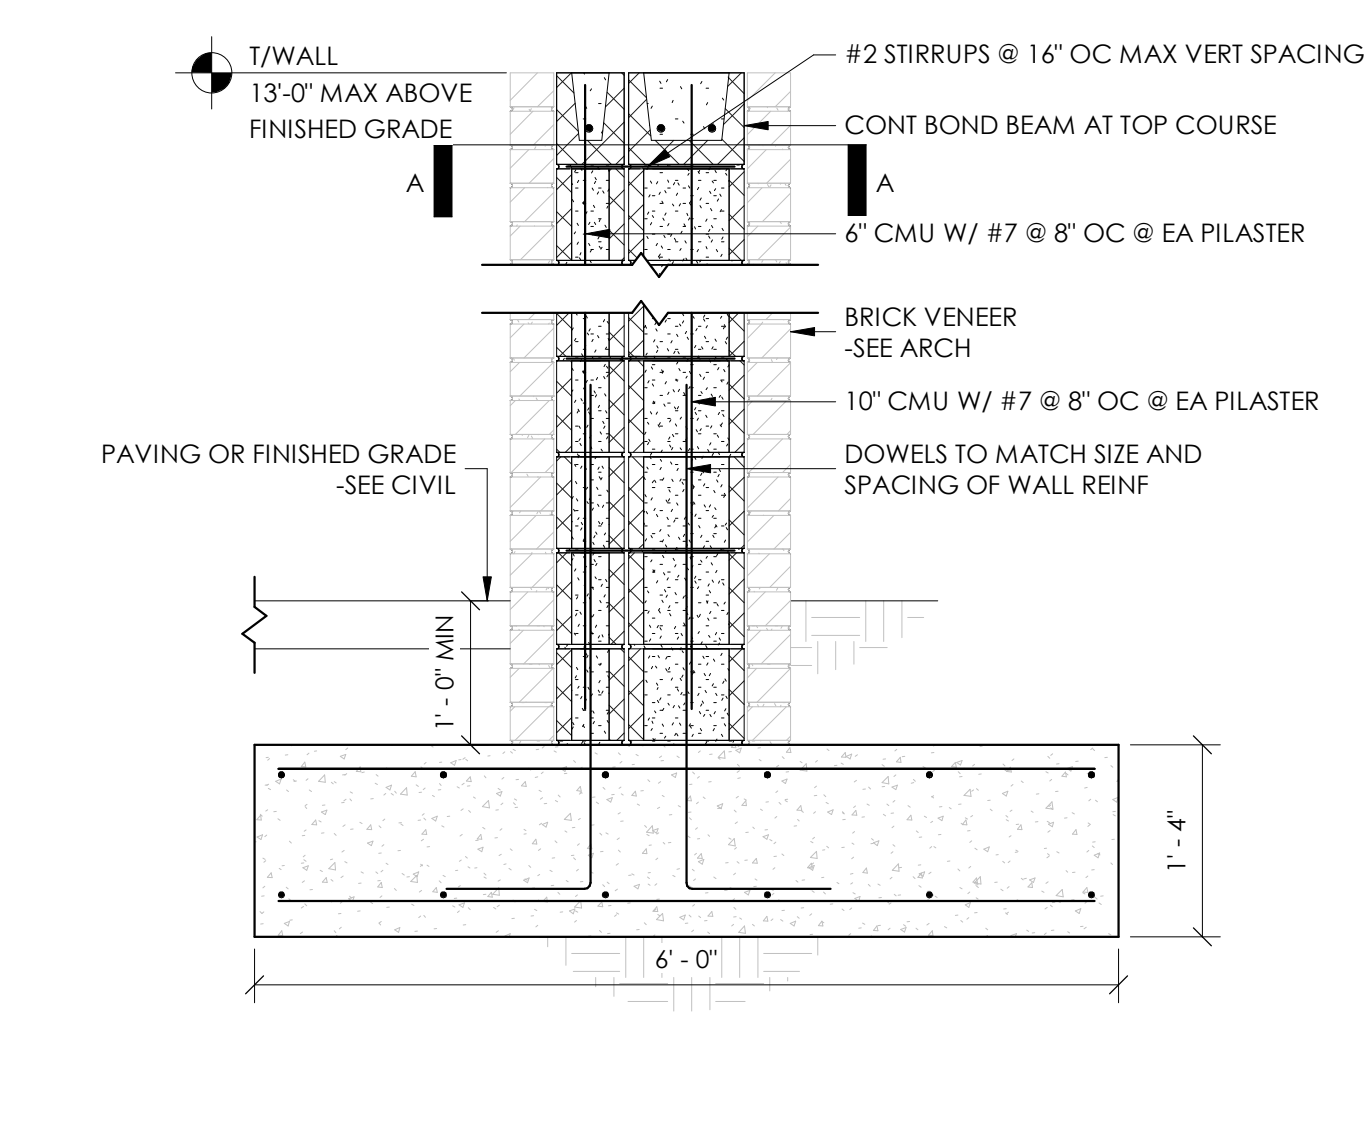

13 CMU SCREEN WALL AT MECHANICAL YARD
 SCALE: 3/4" = 1'-0"

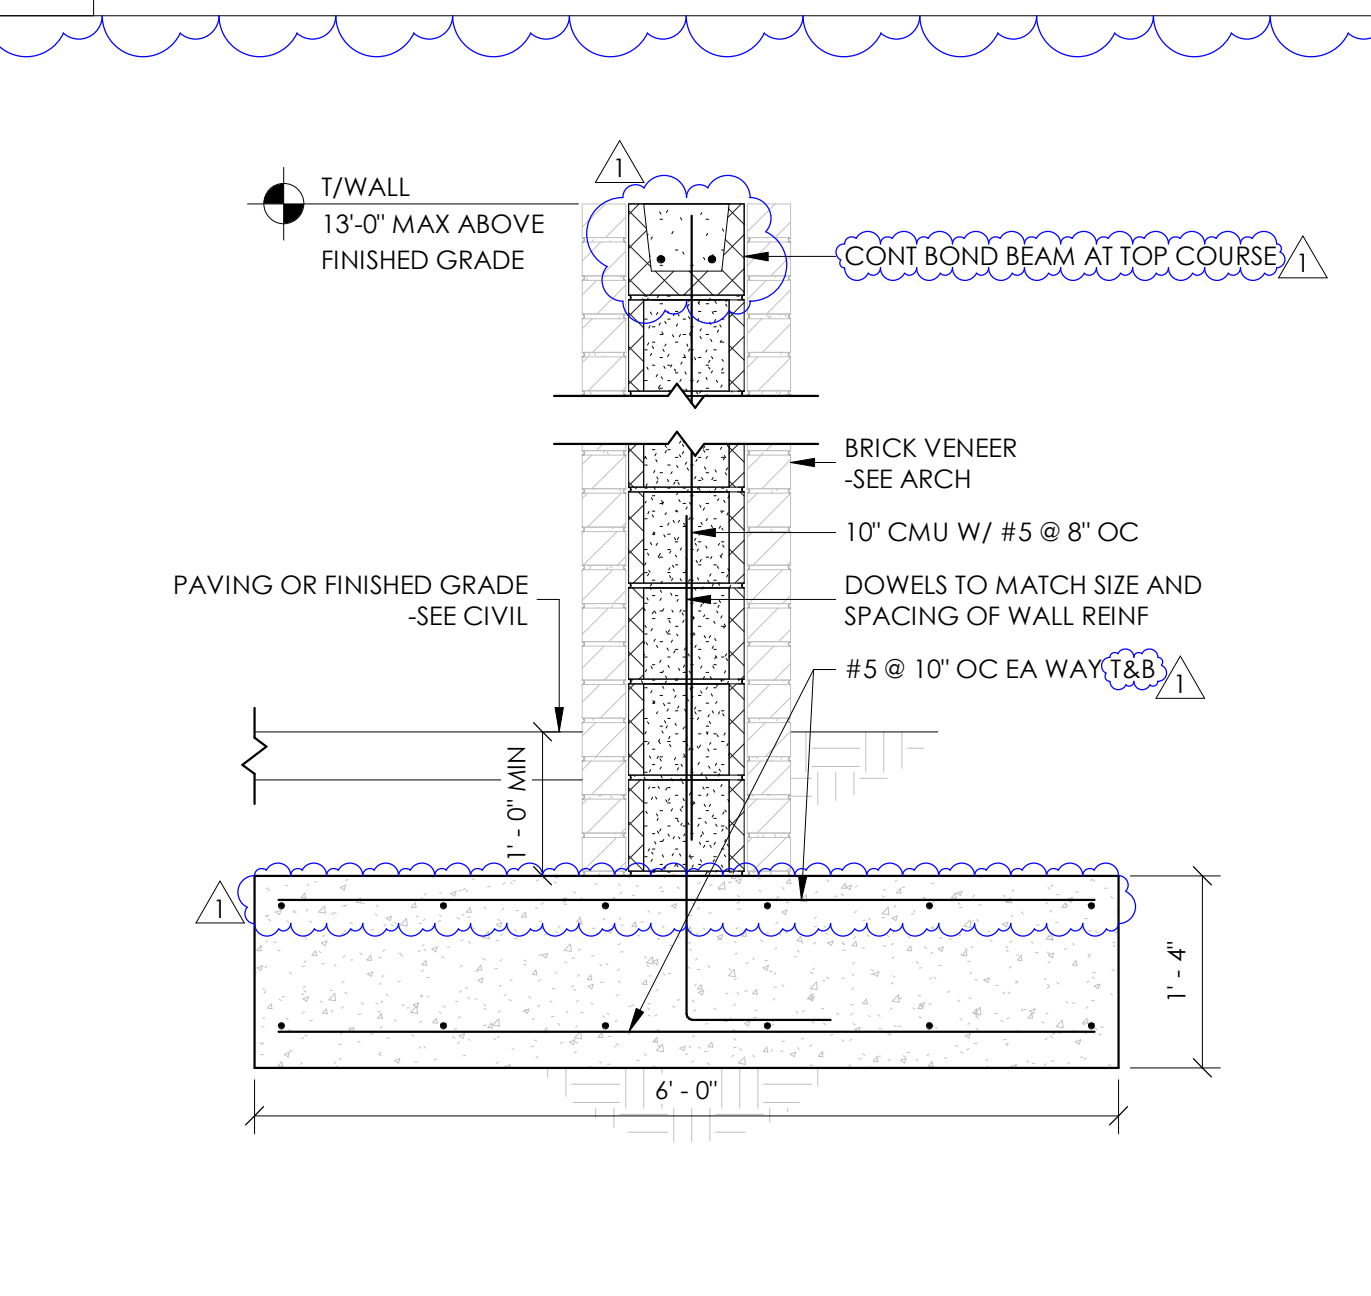

12 CMU SCREEN WALL AT MECHANICAL YARD
 SCALE: 3/4" = 1'-0"

SEE DETAIL 13/S33.10 FOR ADDITIONAL INFORMATION

SEE DETAIL 1/S33.10 FOR ADDITIONAL INFORMATION

SEE DETAIL 1/S33.10 FOR ADDITIONAL INFORMATION

SEE DETAIL 1/S33.10 FOR ADDITIONAL INFORMATION

NOTE: VERIFY LOCATION OF INTERIOR NON-LOAD BEARING PARTITIONS WITH ARCHITECTURAL

NOTE: VERIFY LOCATION OF INTERIOR NON-LOAD BEARING PARTITIONS WITH ARCHITECTURAL

NOTE: VERIFY LOCATION OF INTERIOR NON-LOAD BEARING PARTITIONS WITH ARCHITECTURAL

NOTE: GC TO FIELD VERIFY EXISTING GRADE BEAM AT THIS LOCATION. IF NONE IS FOUND, USE DETAIL 11/S33.10 IN LIEU OF THIS DETAIL.

SCHEDULE NOTES:
 1. SEE PLAN FOR GRADE BEAM MARKS.
 2. ALL EXTERIOR GRADE BEAMS ARE MARK **GB1** UNO.
 3. WHERE A MARK IS SHOWN ON PLAN, THE GRADE BEAM REINFORCEMENT SHALL EXTEND FROM SUPPORT TO SUPPORT.
 4. STIRRUPS REQUIRE (2) LEGS TYP. (3) LEGS WHEN WIDTH > 24". AND (4) LEGS WHEN WIDTH > 36".

MECHANICAL DEMOLITION GENERAL NOTES

- 1 THESE CONSTRUCTION DRAWINGS ARE DIAGRAMMATIC AND DO NOT NECESSARILY REFLECT ACTUAL DIMENSIONS. IT IS THE RESPONSIBILITY OF THE CONTRACTOR TO FIELD VERIFY ALL DIMENSIONS AND COORDINATE PLACEMENT OF ALL EQUIPMENT AND ROUTING OF ALL PIPING AND/OR DUCT SYSTEM.
- 2 ALL MECHANICAL SYSTEMS SHOWN ON THIS PLAN ARE FROM EXISTING DRAWINGS AND PRELIMINARY FIELD WORK. CONTRACTOR IS RESPONSIBLE FOR FIELD VERIFYING ALL LOCATIONS AND SIZES OF MECHANICAL SYSTEMS PRIOR TO THE START OF WORK.


MECHANICAL DEMOLITION KEYED NOTES

- 1 REMOVE EXISTING DUCTWORK BACK TO POINT INDICATED.
- 2 EXISTING AIR RECIRCULATING UNIT TO REMAIN.
- 3 EXISTING TERMINAL UNIT TO REMAIN.
- 4 EXISTING DUST COLLECTOR AND ALL ASSOCIATED APPURTENANCES TO REMAIN AND BE REUSED. CONTRACTOR SHALL CLEAN, REPAIR, AND PROTECT FOR REUSE. REFER TO M12.03 FOR NEW LOCATION AND ROUTING.
- 5 REMOVE EXISTING SELF CONTAINED MINI MATE UNIT ALONG WITH ALL ASSOCIATED DUCTWORK AND APPURTENANCES.
- 6 REMOVE EXISTING DUCTWORK BACK TO POINT INDICATED. CAP, SEAL AND REINSULATE TO MATCH EXISTING.
- 7 REMOVE EXISTING INTAKE HOOD AND CURB ALONG WITH ALL ASSOCIATED APPURTENANCES PATCH AND SEAL ROOF TO MATCH EXISTING CONDITIONS.
- 8 REMOVE EXISTING AIR DIFFUSER / GRILLE AND ASSOCIATED APPURTENANCES.
- 9 EXISTING AIR DIFFUSER/GRILLE SHALL REMAIN.
- 10 REMOVE EXISTING THERMOSTAT AND ALL ASSOCIATED WIRING.
- 11 REMOVE EXISTING CONDENSATE DRAIN ALONG WITH ALL ASSOCIATED APPURTENANCES.
- 12 REMOVE EXISTING PAINT BOOTH EXHAUST DUCT, FAN, HOOD, DUCTWORK AND ANY ASSOCIATED APPURTENANCES. PROVIDE TEMPORARY COVER TO ROOF OPENING. PREP FOR FUTURE REUSE.
- 13 EXISTING EXHAUST FAN TO REMAIN.
- 14 EXISTING GRILLE SHALL BE REMOVED AND RELOCATED. CONTRACTOR SHALL CLEAN, REPAIR, AND PROTECT FOR REUSE. RE: M12.03 FOR NEW LOCATION.
- 15 REMOVE EXISTING EXHAUST DUCTWORK.
- 16 EXISTING CHILLED AND HOT WATER PIPING TO REMAIN.
- 17 EXISTING MOTOR STARTER AND ALL ASSOCIATED APPURTENANCES TO REMAIN AND BE REUSED. CONTRACTOR SHALL PROTECT FOR REUSE. REFER TO ELECTRICAL DRAWINGS FOR ADDITIONAL INFORMATION.


CONTRACTOR SHALL PROVIDE DEHUMIDIFICATION DURING THE ENTIRE CONSTRUCTION SCHEDULE. THE SCOPE IS TO MAINTAIN ACCEPTABLE HUMIDITY LEVELS WITHIN THE BUILDING. THE REMOVAL OF EXCESS HUMIDITY FROM THE AIR THROUGHOUT THE BUILDING. PROVIDE MOISTURE CONTROL RENTAL EQUIPMENT AND SOLUTION FOR PREVENTING THE LONG-TERM EFFECTS OF MOISTURE LEVELS THAT CAN DAMAGE INTERIOR BUILDING MATERIALS, BOOKS, AND ELECTRONIC EQUIPMENT.

CONTRACTOR IS RESPONSIBLE TO PROVIDE ALL REQUIRED POWER GENERATING EQUIPMENT.

PIPE INSULATION SHALL BE INSTALLED ON CLEAN AND DRY SURFACES ONLY. CONTRACTOR SHALL COORDINATE REMOVAL OF EXISTING INSULATION AND RE-INSULATION OF EXISTING CHILLED AND HOT WATER PIPING WITH OWNER, ARCHITECT AND ENGINEER PRIOR TO STARTING WORK TO ENSURE ANY REQUIRED CHILLED AND HOT WATER SHUTDOWNS ARE SCHEDULE AND ACCEPTABLE TO ALL PARTIES.

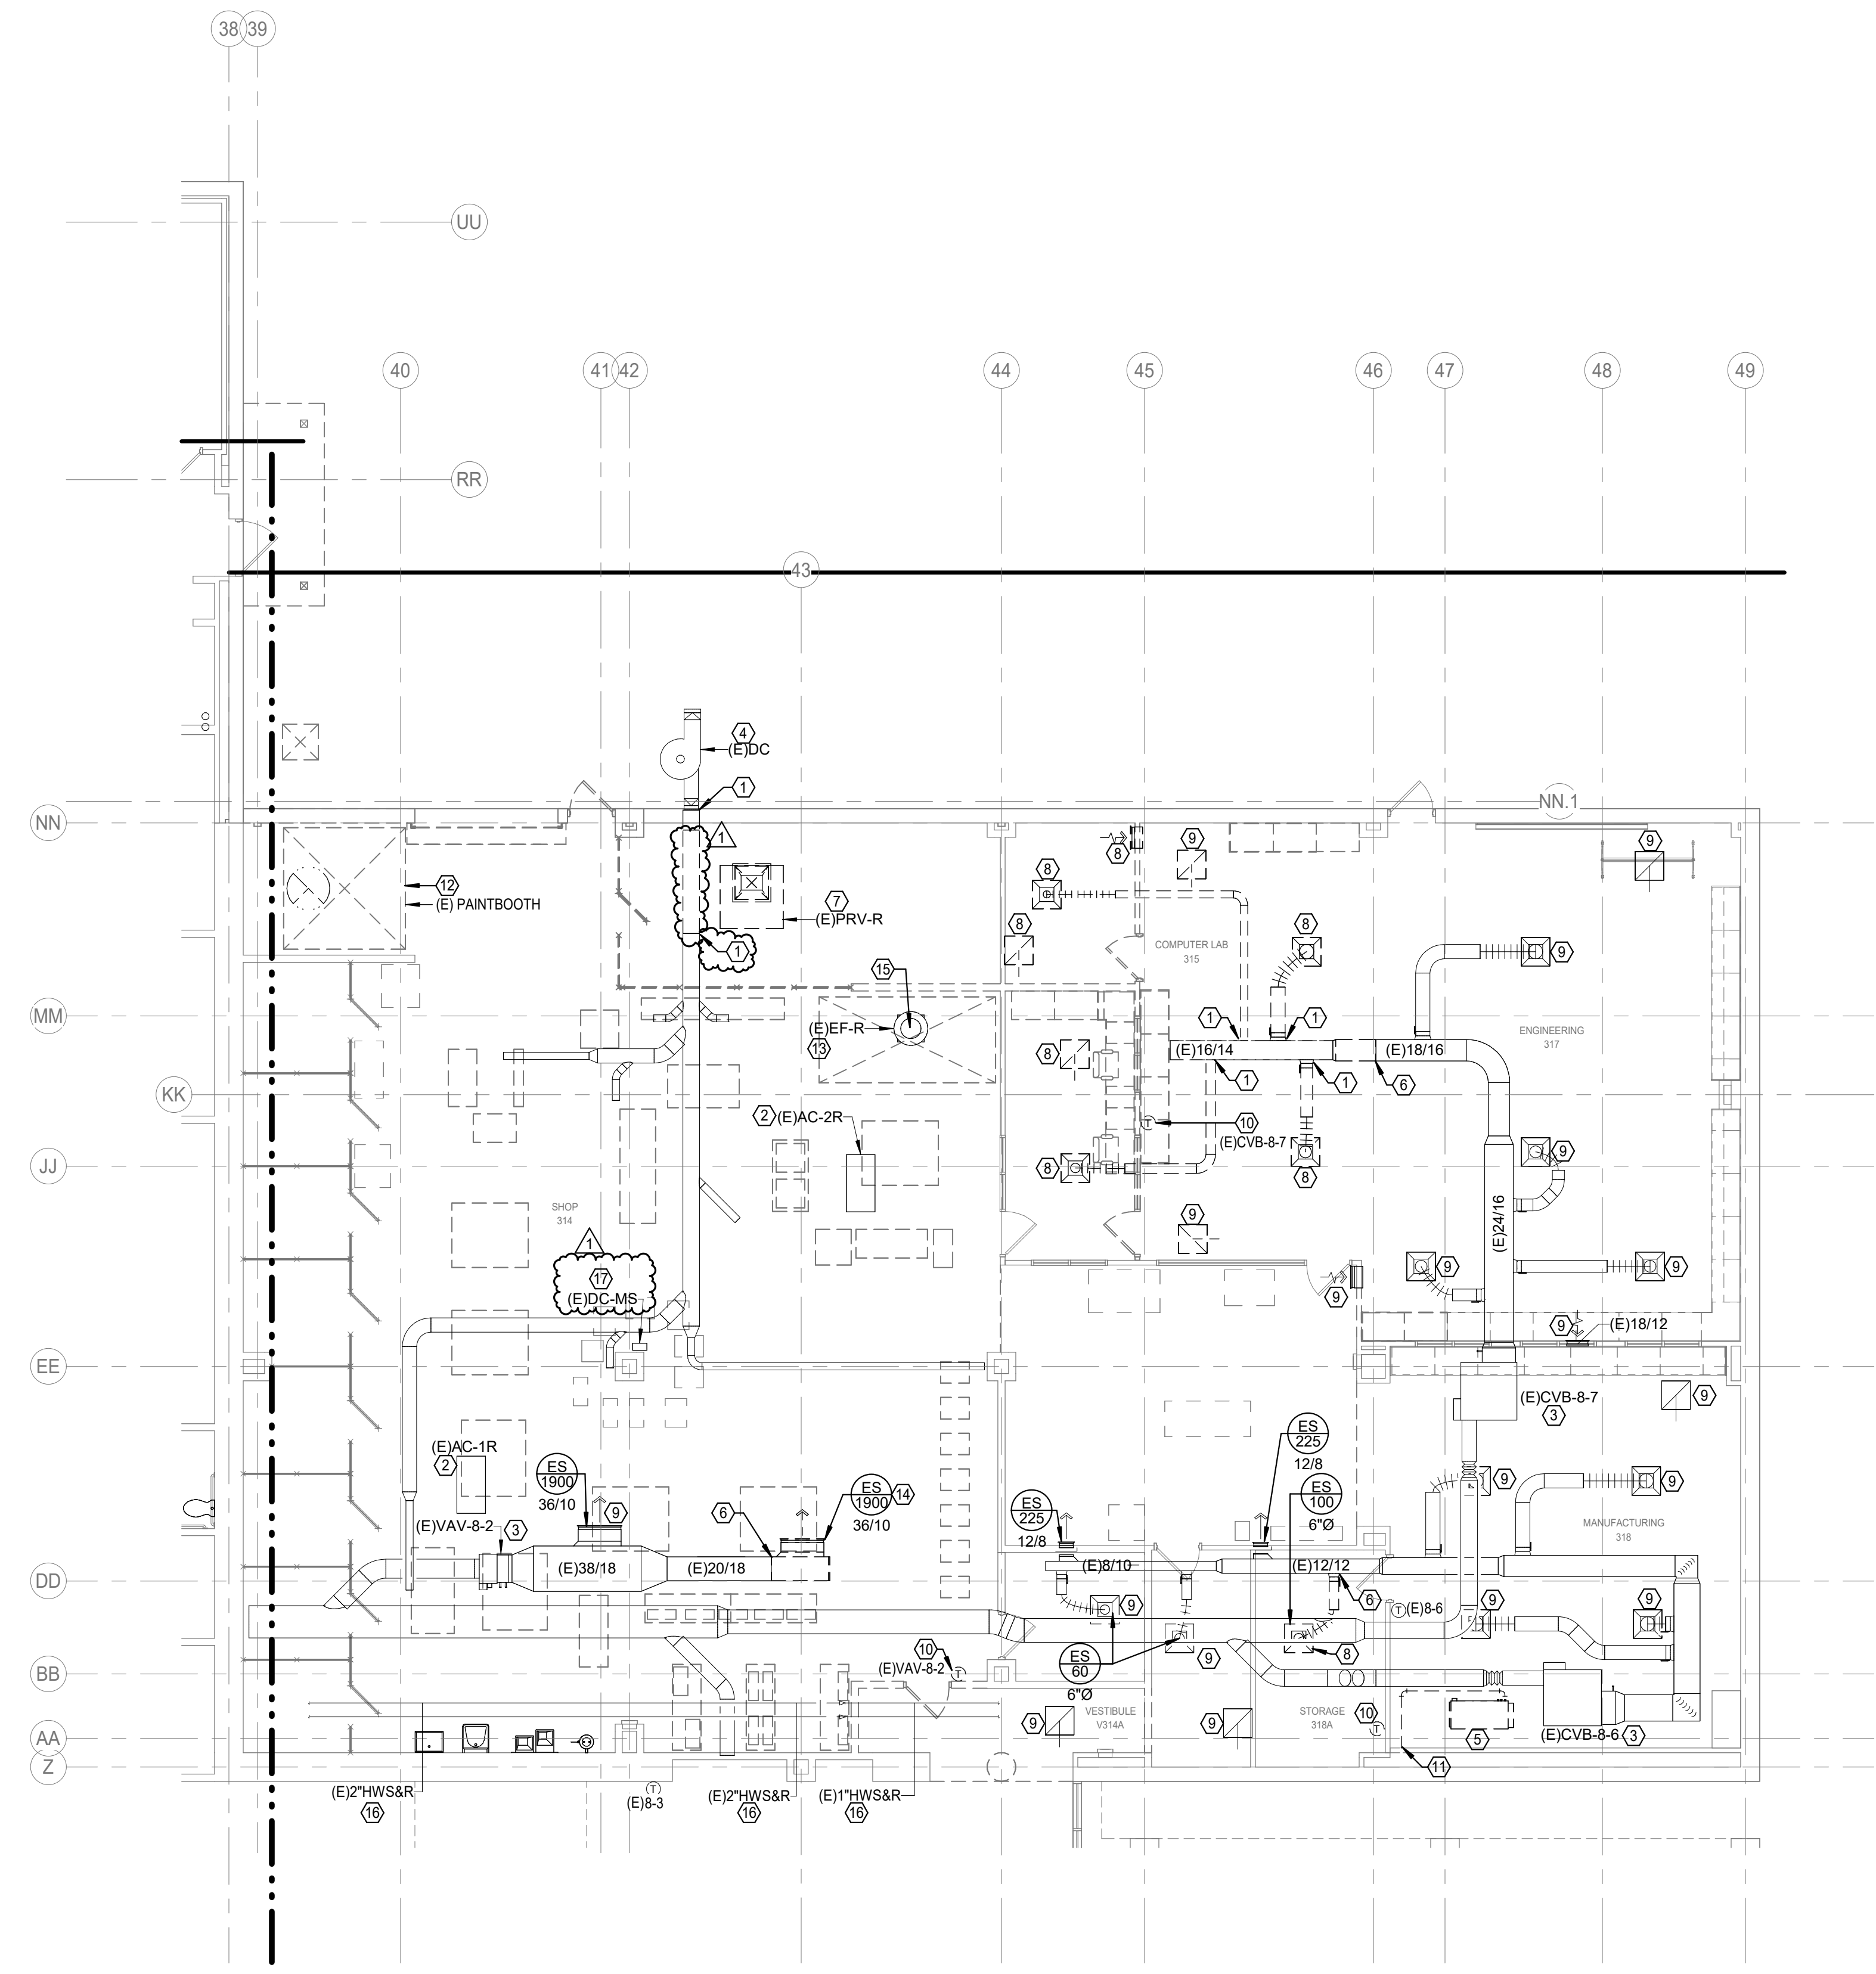

MECHANICAL DEMOLITION FLOOR PLAN - LEVEL 1 - C - UNIT D.2
 Scale: 1/8" = 1'-0"

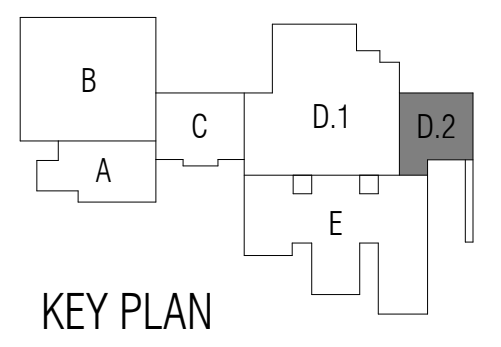

Issue For Proposal



ISSUED: February 24, 2025

REVISIONS

Revision No.	Revision Date
1	03-06-2025

Director
 Approver
 Designer
 Designer
 Proj. Coord.
 Checker

Drawn By
 Author
 Quality Control
 Designer

PROJECT NO.
 24-010.00

SHEET TITLE
 COOK - MECHANICAL
 DEMOLITION FLOOR PLAN -
 LEVEL 1 - UNIT D.2

SHEET NO.

Salas O'Brien
 Houston
 10930 W. Sam Houston Pkwy North, Suite 900
 Houston, TX 77064
 Salas O'Brien Registration: F-4111
 Salas O'Brien Project Number: 2024-00901-00

M10.03

- MECHANICAL GENERAL NOTES**
- 1 ALL DUCTS ARE INSIDE CLEAR DIMENSIONS. INCREASE ACCORDINGLY WHERE INTERIOR LINER IS SHOWN OR SPECIFIED.
 - 2 COORDINATE IN THE FIELD THE EXACT LOCATION OF ALL CEILING MOUNTED GRILLES AND DIFFUSERS AND ARCHITECT'S REFLECTED CEILING PLAN.
 - 3 THERMOSTATS SHALL BE MOUNTED AT 48" AFF. UNLESS OTHERWISE NOTED.
 - 4 MECHANICAL CONTRACTOR SHALL COORDINATE WITH THE ELECTRICAL CONTRACTOR FOR ALL ELECTRICAL POWER REQUIREMENTS.
 - 5 ACTUAL DIMENSIONS. IT IS THE RESPONSIBILITY OF THE CONTRACTOR TO FIELD VERIFY ALL DIMENSIONS AND COORDINATE PLACEMENT OF ALL EQUIPMENT AND ROUTING OF ALL PIPING AND/OR DUCT SYSTEM.
 - 6 CONTRACTOR SHALL REMOVE AND REPLACE CEILING WHERE REQUIRED TO COMPLETE INDICATED SCOPE OF WORK. EXISTING CEILING SHALL BE RE-INSTALLED IN THE EXACT CONDITION IT WAS REMOVED IN. DAMAGED CEILING AND/OR CEILING TILES SHALL BE REPLACED TO MATCH EXISTING CONDITIONS PRIOR TO CONSTRUCTION. IF A MATCH IS NOT POSSIBLE CONTRACTOR SHALL REPLACE ALL CEILING FROM WALL TO WALL OR BOUNDARY SEPARATING IN ADJOINING ROOMS. REFER TO ARCHITECTURAL REFLECTED CEILING PLANS FOR ADDITIONAL INFORMATION.
 - 7 THE USE OF CY-FAIR ISD MOBILE/ON-PERMANENT EQUIPMENT (I.E. LADDERS, CART, DOLLIES, ETC.) IS STRICTLY PROHIBITED.


- MECHANICAL KEYED NOTES**
- 1 PROVIDE HARD WIRED THERMOSTAT.
 - 2 PROVIDE THERMOSTAT FOR BMS/ MONITOR.
 - 3 PROVIDE WITH LITTLE GIANT CONDENSATE PUMP MODEL 554652 VDMA-20ULS-C-PRO, 1/30 HP, 115V/1PH/60HZ.
 - 4 VERIFY SERVICE CLEARANCE FOR AIR FILTER REMOVAL WITH EQUIPMENT MANUFACTURER. COORDINATE WITH ALL TRADES NOT TO OBSTRUCT.
 - 5 VERIFY SERVICE CLEARANCE FOR FAN SHAFT AND COIL REMOVAL WITH EQUIPMENT MANUFACTURER. COORDINATE WITH ALL TRADES NOT TO OBSTRUCT.
 - 6 INSULATE ALL PIPINGS PER SPECIFICATIONS.
 - 7 ROUTE REFRIGERANT PIPING FROM CONDENSING UNIT TO ASSOCIATED INDOOR UNIT. PIPING SHOWN SINGLE LINE FOR CLARITY.
 - 8 ROUTE FULL SIZE CONDENSATE DRAINPIPE AS HIGH AS POSSIBLE AND GRAVITY DRAIN TO SINK WYE TAILPIECE. INSTALL TRAP AS RECOMMENDED BY MANUFACTURER. REFER TO PLUMBING FOR EXACT LOCATION.
 - 9 PROVIDE AND INSTALL NEW INTAKE HOOD WITH MOTORIZED DAMPER. PROVIDE NEW ROOF OPENING AS NECESSARY.
 - 10 ROOF MOUNTED EQUIPMENT SHALL BE MOUNTED ON ROOF CURB. RE: 10MM14.02.
 - 11 CONDENSING UNIT SHALL BE MOUNTED ON ROOF SUPPORT. REFER TO ARCHITECTURAL DRAWINGS FOR ADDITIONAL INFORMATION.
 - 12 BALANCE EXISTING SUPPLY AIR DIFFUSER TO CFM INDICATED.
 - 13 PROVIDE ALL NEW THERMOSTAT AND WIRE. REFER TO SPECIFICATIONS FOR MORE INFORMATION.
 - 14 ROUTE NEW EXHAUST DUCT FROM PAINT BOOTH UP AND THROUGH ROOF.
 - 15 PROVIDE PHP MODEL PP-10 ON ROOF WITH ROLLER AND FULLY ADJUSTABLE HEIGHT THROUGHOUT PIPE RUN EVERY 6'-0" ON CENTER AND EVERY CHANGE IN DIRECTION. REFER TO 3M14.01.
 - 16 RE: 03V12.03 FOR PAINT SPRAY BOOTH ELEVATION.
 - 17 PROVIDE PIPE SUPPORT. RE: M14.01 FOR DETAIL.
 - 18 PROVIDE ECOMAXX NO RETURN EXPLOSION ISOLATION VALVE MODEL EM-NRV, WALL MOUNTED. PROVIDE REQUIRED SUPPORTS FOR WALL MOUNTING IN LOCATION SHOWN. INSTALL PER MANUFACTURER GUIDELINES.
 - 19 VERIFY SERVICE CLEARANCE WITH EQUIPMENT MANUFACTURER. COORDINATE WITH ALL TRADES NOT TO OBSTRUCT.
 - 20 FINAL LOCATION OF EXISTING DUST COLLECTOR WHEN ADDITION IS COMPLETED. PROVIDE WITH NEW 4" HOUSEKEEPING PAD.
 - 21 NEW LOCATION OF EXISTING GRILLE.
 - 22 INSTALL REFRIGERANT PIPES NOT LESS THAN 7'-3" AFF.
 - 23 PROVIDE ISOLATION VALVE AT LOCATION SHOWN.
 - 24 PROVIDE NEW BYPASS PIPING AND VALVES AS SHOWN TO ALLOW FOR ISOLATING THE NEW PIPING FROM THE EXISTING HYDRONIC LOOPS. TESTING, FLUSHING, AND TREATMENT OF NEW PIPING SHALL BE PERFORMED PRIOR TO OPENING THE NEW PIPING TO THE EXISTING HYDRONIC LOOPS. PURGERITE OR COMPARABLE COMPANY SHALL PROVIDE ASSISTANCE TO THE MECHANICAL CONTRACTOR PERFORM FLUSHING AND CLEANING AT DESIGN SYSTEM FLOW RATES. CHEMICAL TREATMENT MANUFACTURER SHALL TEST WATER TO CONFIRM COMPLIANCE OF FLUSHING AND TREATMENT OF WATER PRIOR TO OPENING THE NEW PIPING VALVES TO THE EXISTING HYDRONIC LOOPS.
 - 25 ROUTE NEW EXHAUST AIR DUCTWORK FROM THE EXISTING HOOD UP TO EXISTING FAN ON ROOF. TRANSITION DUCTWORK AS NECESSARY TO MAKE COMPLETE CONNECTION. MATCH EXISTING CONDITIONS.
 - 26 PROVIDE PIPE SUPPORT. RE: M14.01 FOR DETAILS.
 - 27 TEMPORARY LOCATION OF EXISTING DUST COLLECTOR WHILE ADDITION IS BEING CONSTRUCTED. PROVIDE WITH 4" HOUSEKEEPING PAD.
 - 28 PROVIDE DUCTWORK AS SHOWN TO CONNECT TO EXISTING DUST COLLECTOR FOR TEMPORARY RELOCATION.

CONTRACTOR SHALL PROVIDE DEHUMIDIFICATION DURING THE ENTIRE CONSTRUCTION SCHEDULE. THE SCOPE IS TO MAINTAIN ACCEPTABLE HUMIDITY LEVELS WITHIN THE BUILDING. THE REMOVAL OF EXCESS HUMIDITY FROM THE AIR THROUGHOUT THE BUILDING. PROVIDE MOISTURE CONTROL RENTAL EQUIPMENT AND SOLUTION FOR PREVENTING THE LONG-TERM EFFECTS OF MOISTURE LEVELS THAT CAN DAMAGE INTERIOR BUILDING MATERIALS, BOOKS, AND ELECTRONIC EQUIPMENT.


CONTRACTOR IS RESPONSIBLE TO PROVIDE ALL REQUIRED POWER GENERATING EQUIPMENT.

PRIOR TO BID, CONTRACTOR AND EQUIPMENT MANUFACTURER SHALL VISIT SITE TO INVESTIGATE EXISTING FIELD CONDITIONS, UNIT SIZES AND MECHANICAL ROOM ACCESSIBILITY TO ENSURE PROPER PROVISIONS ARE PROVIDED TO ALLOW FOR INSTALLATIONS.


PIPE INSULATION SHALL BE INSTALLED ON CLEAN AND DRY SURFACES ONLY. CONTRACTOR SHALL COORDINATE REMOVAL OF EXISTING INSULATION AND RE-INSULATION OF EXISTING CHILLED AND HOT WATER PIPING WITH OWNER, ARCHITECT AND ENGINEER PRIOR TO STARTING WORK TO ENSURE ANY REQUIRED CHILLED AND HOT WATER SHUTDOWNS ARE SCHEDULED AND ACCEPTABLE TO ALL PARTIES.

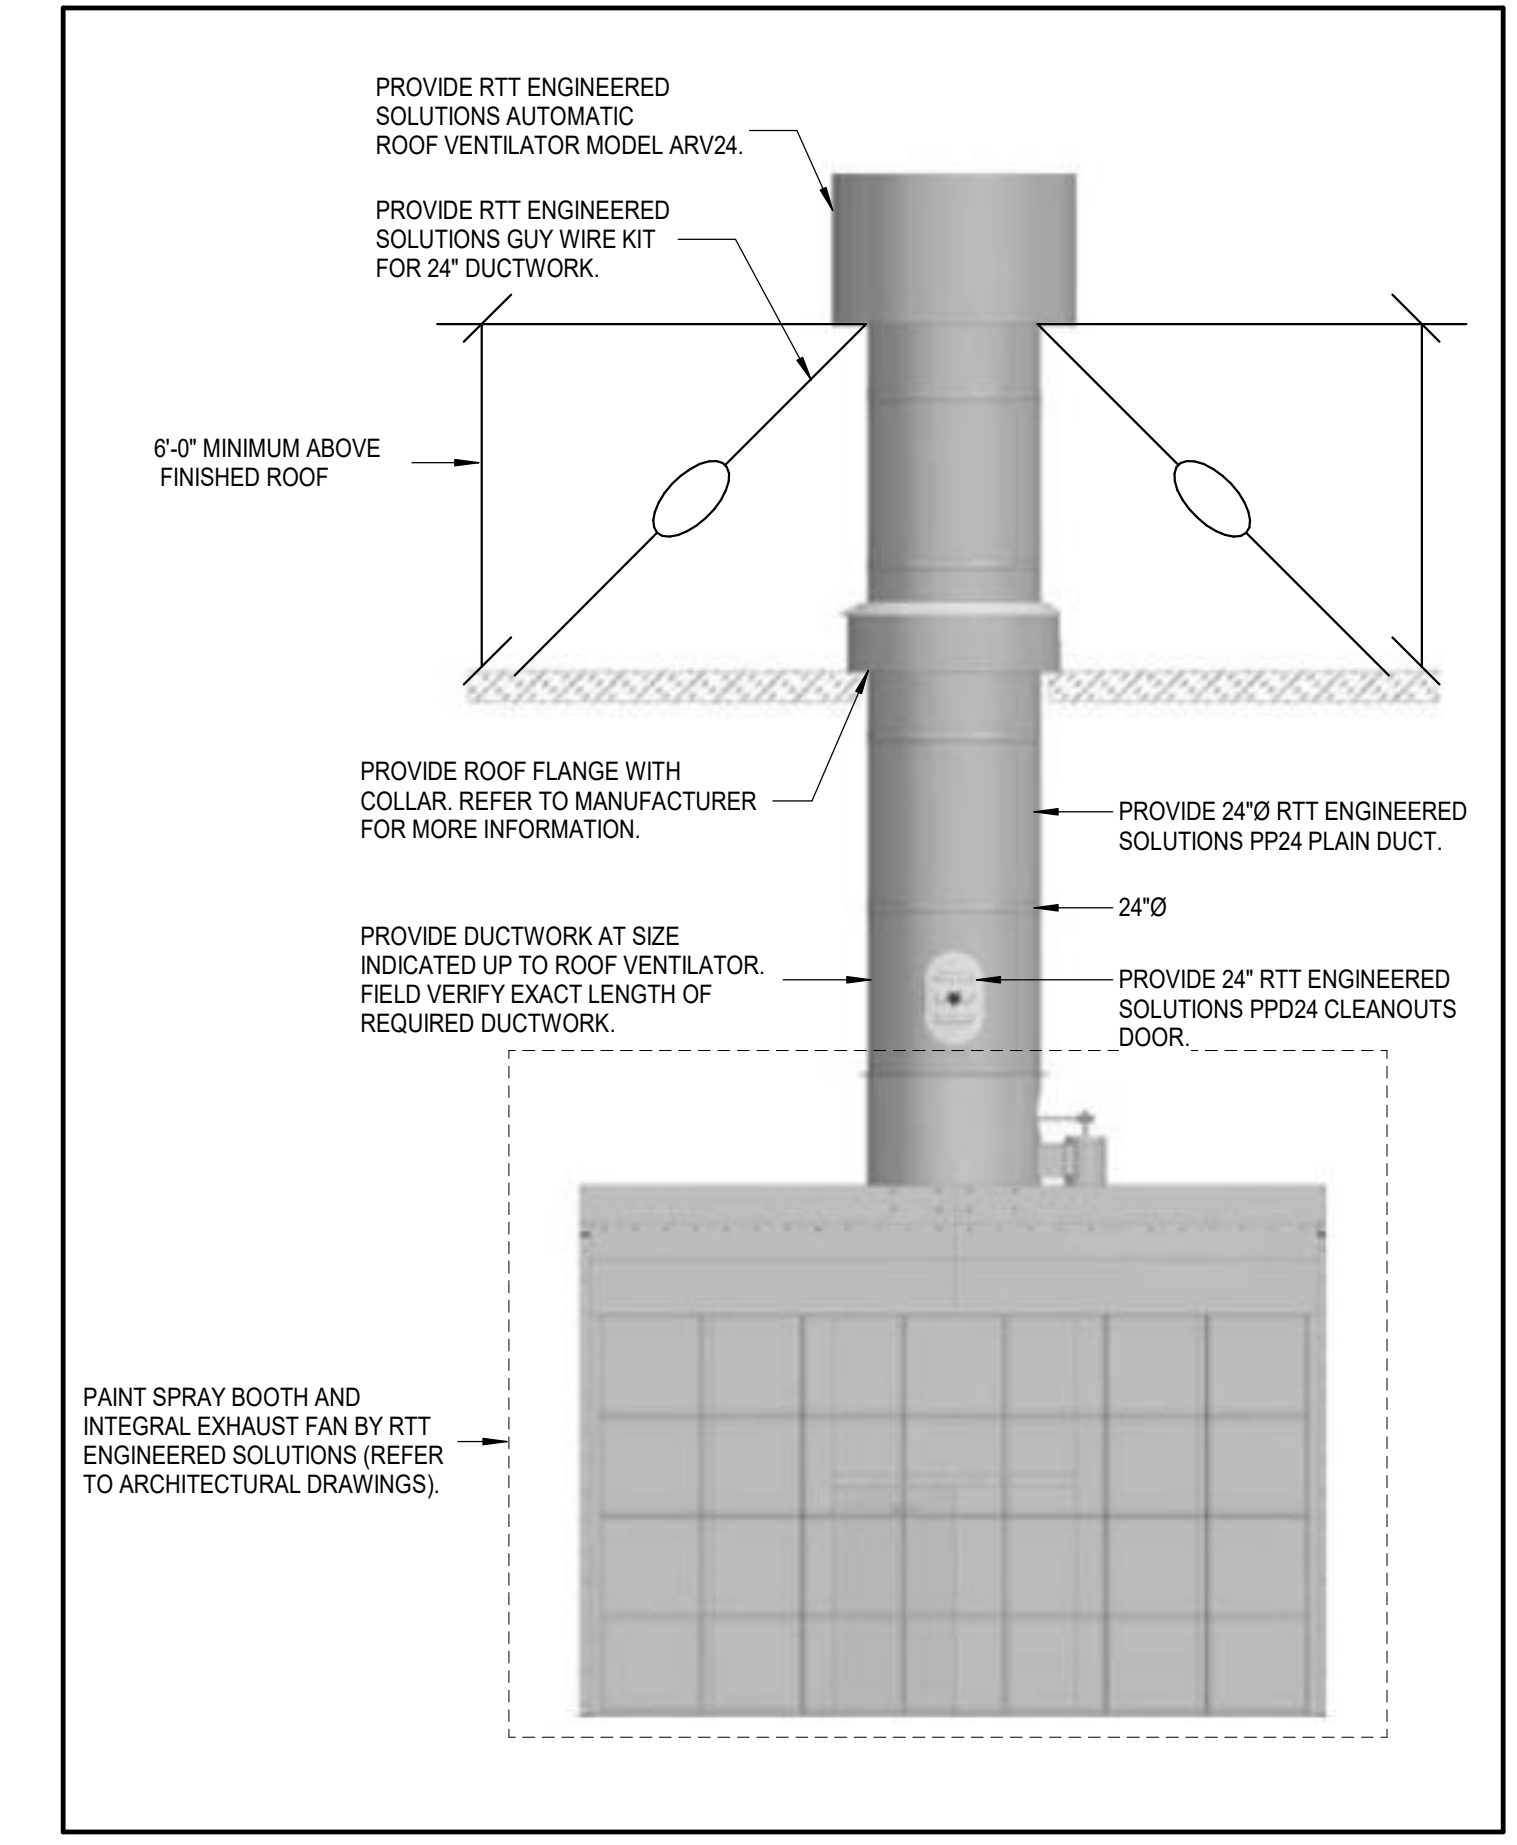

2 PAINT SPRAY BOOTH ELEVATION
Scale: 1/2" = 1'-0"

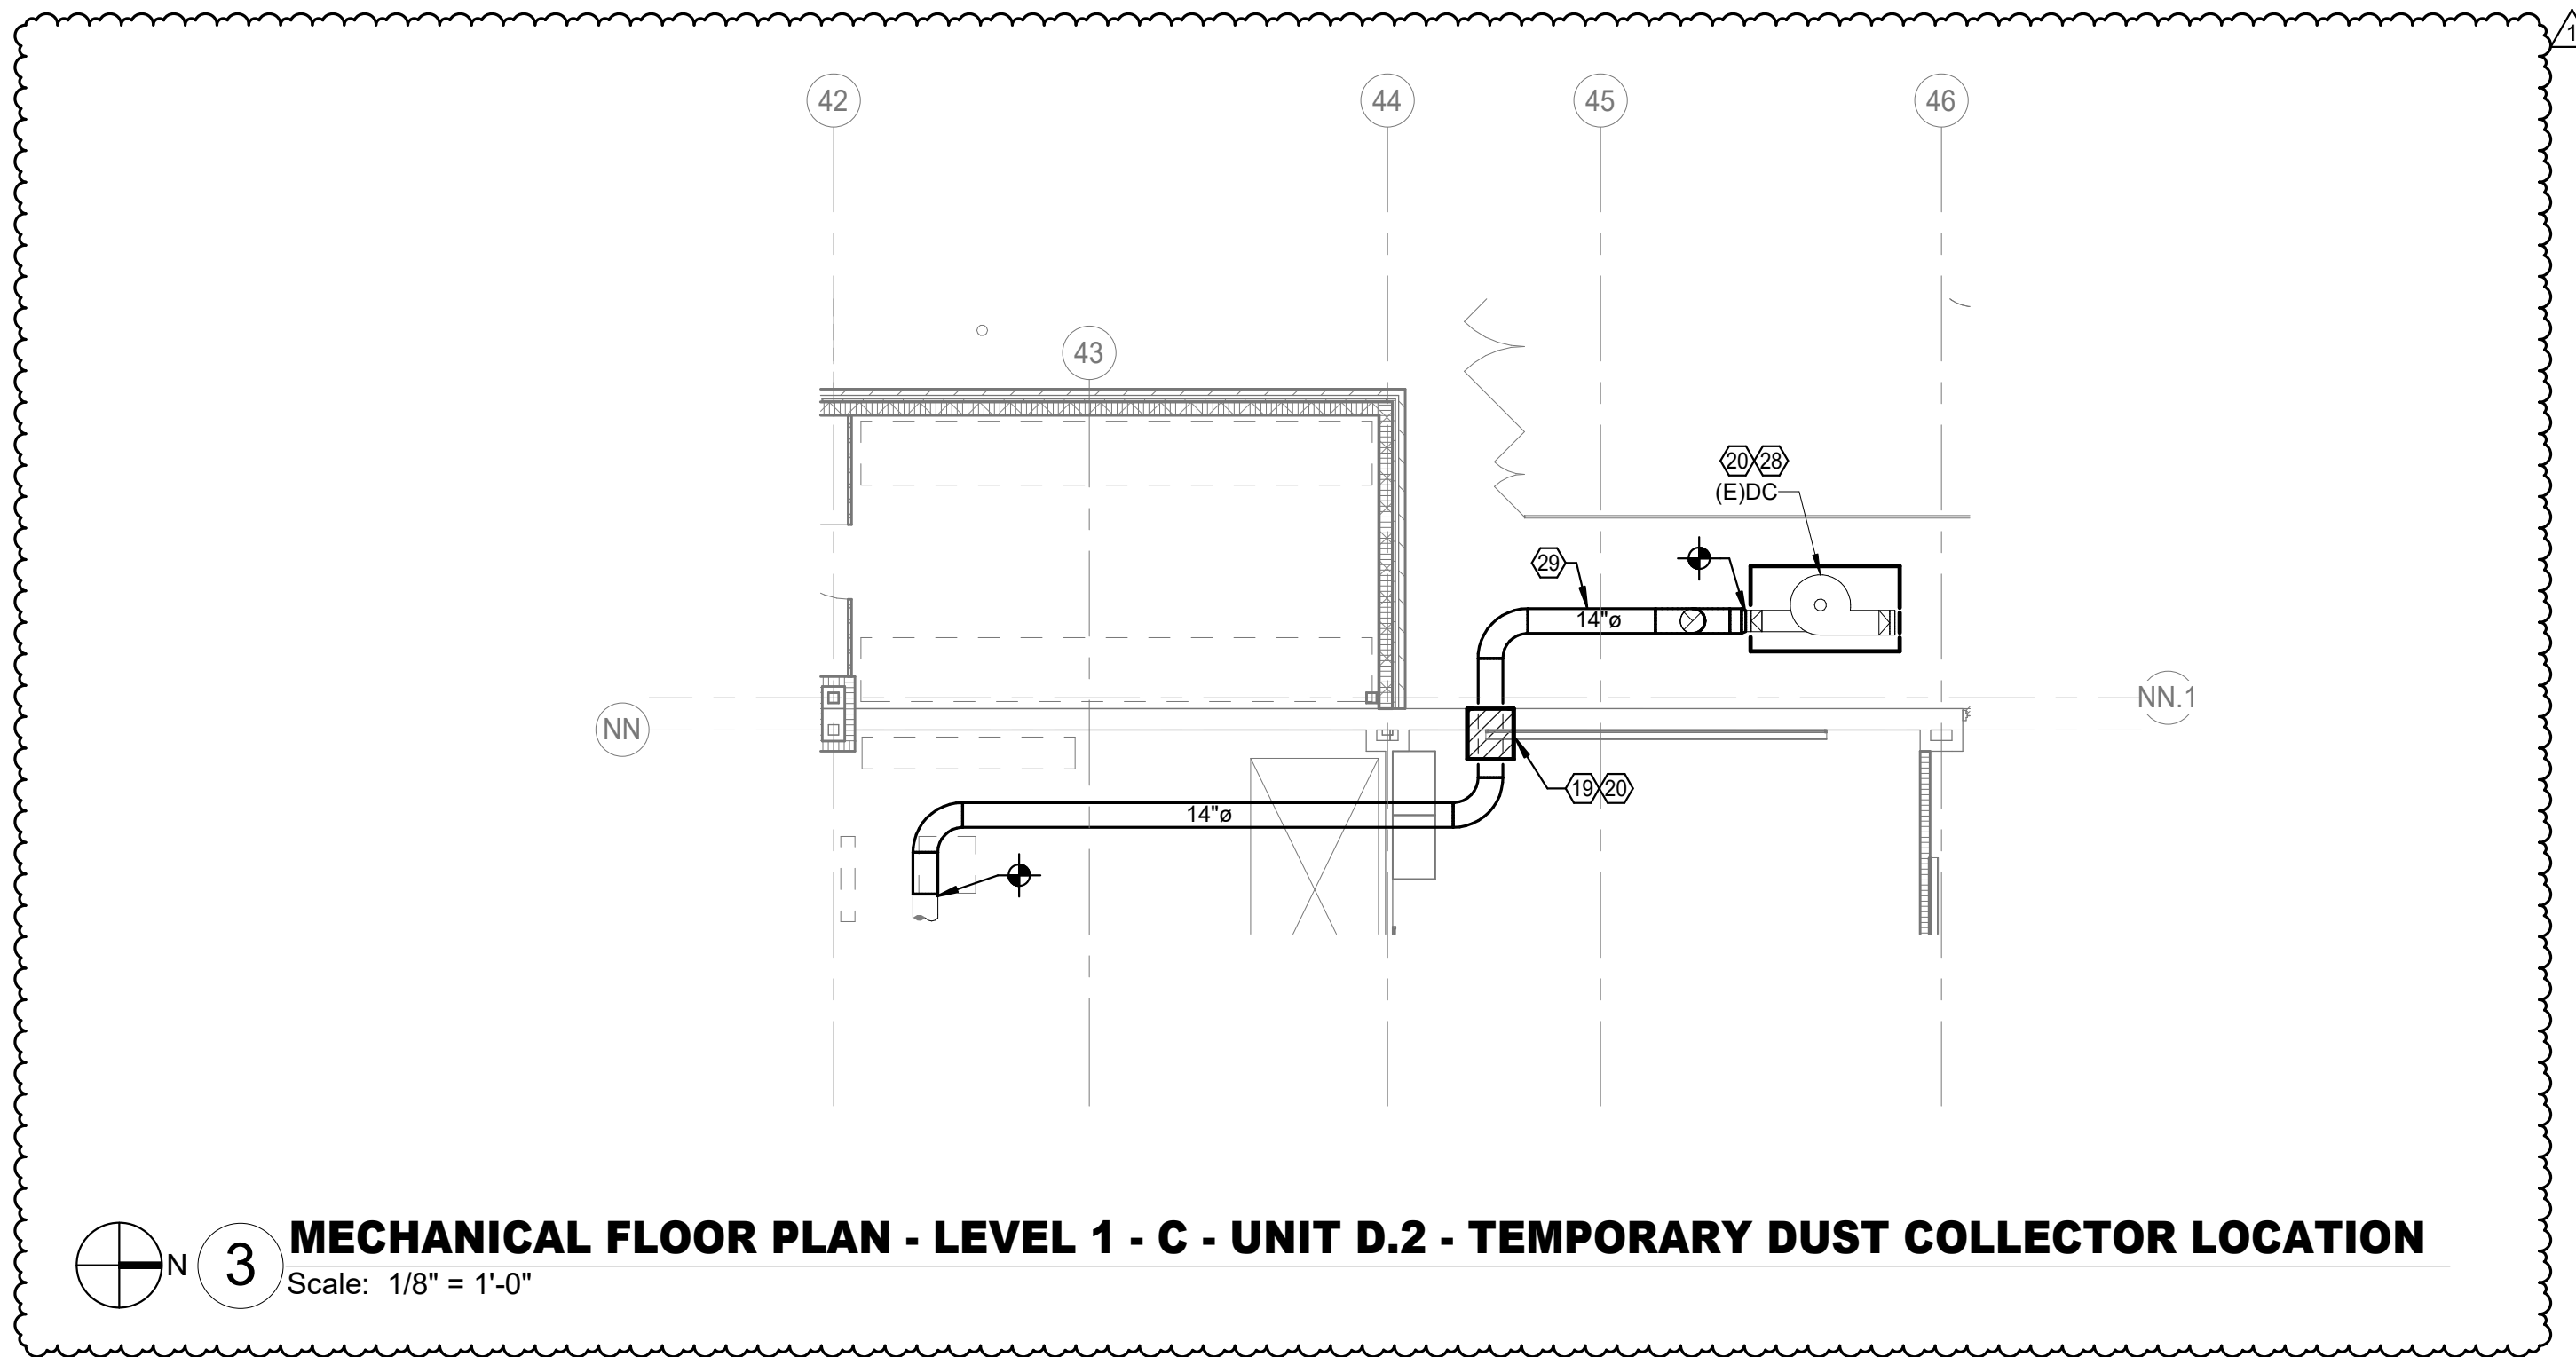

3 MECHANICAL FLOOR PLAN - LEVEL 1 - C - UNIT D.2 - TEMPORARY DUST COLLECTOR LOCATION
Scale: 1/8" = 1'-0"

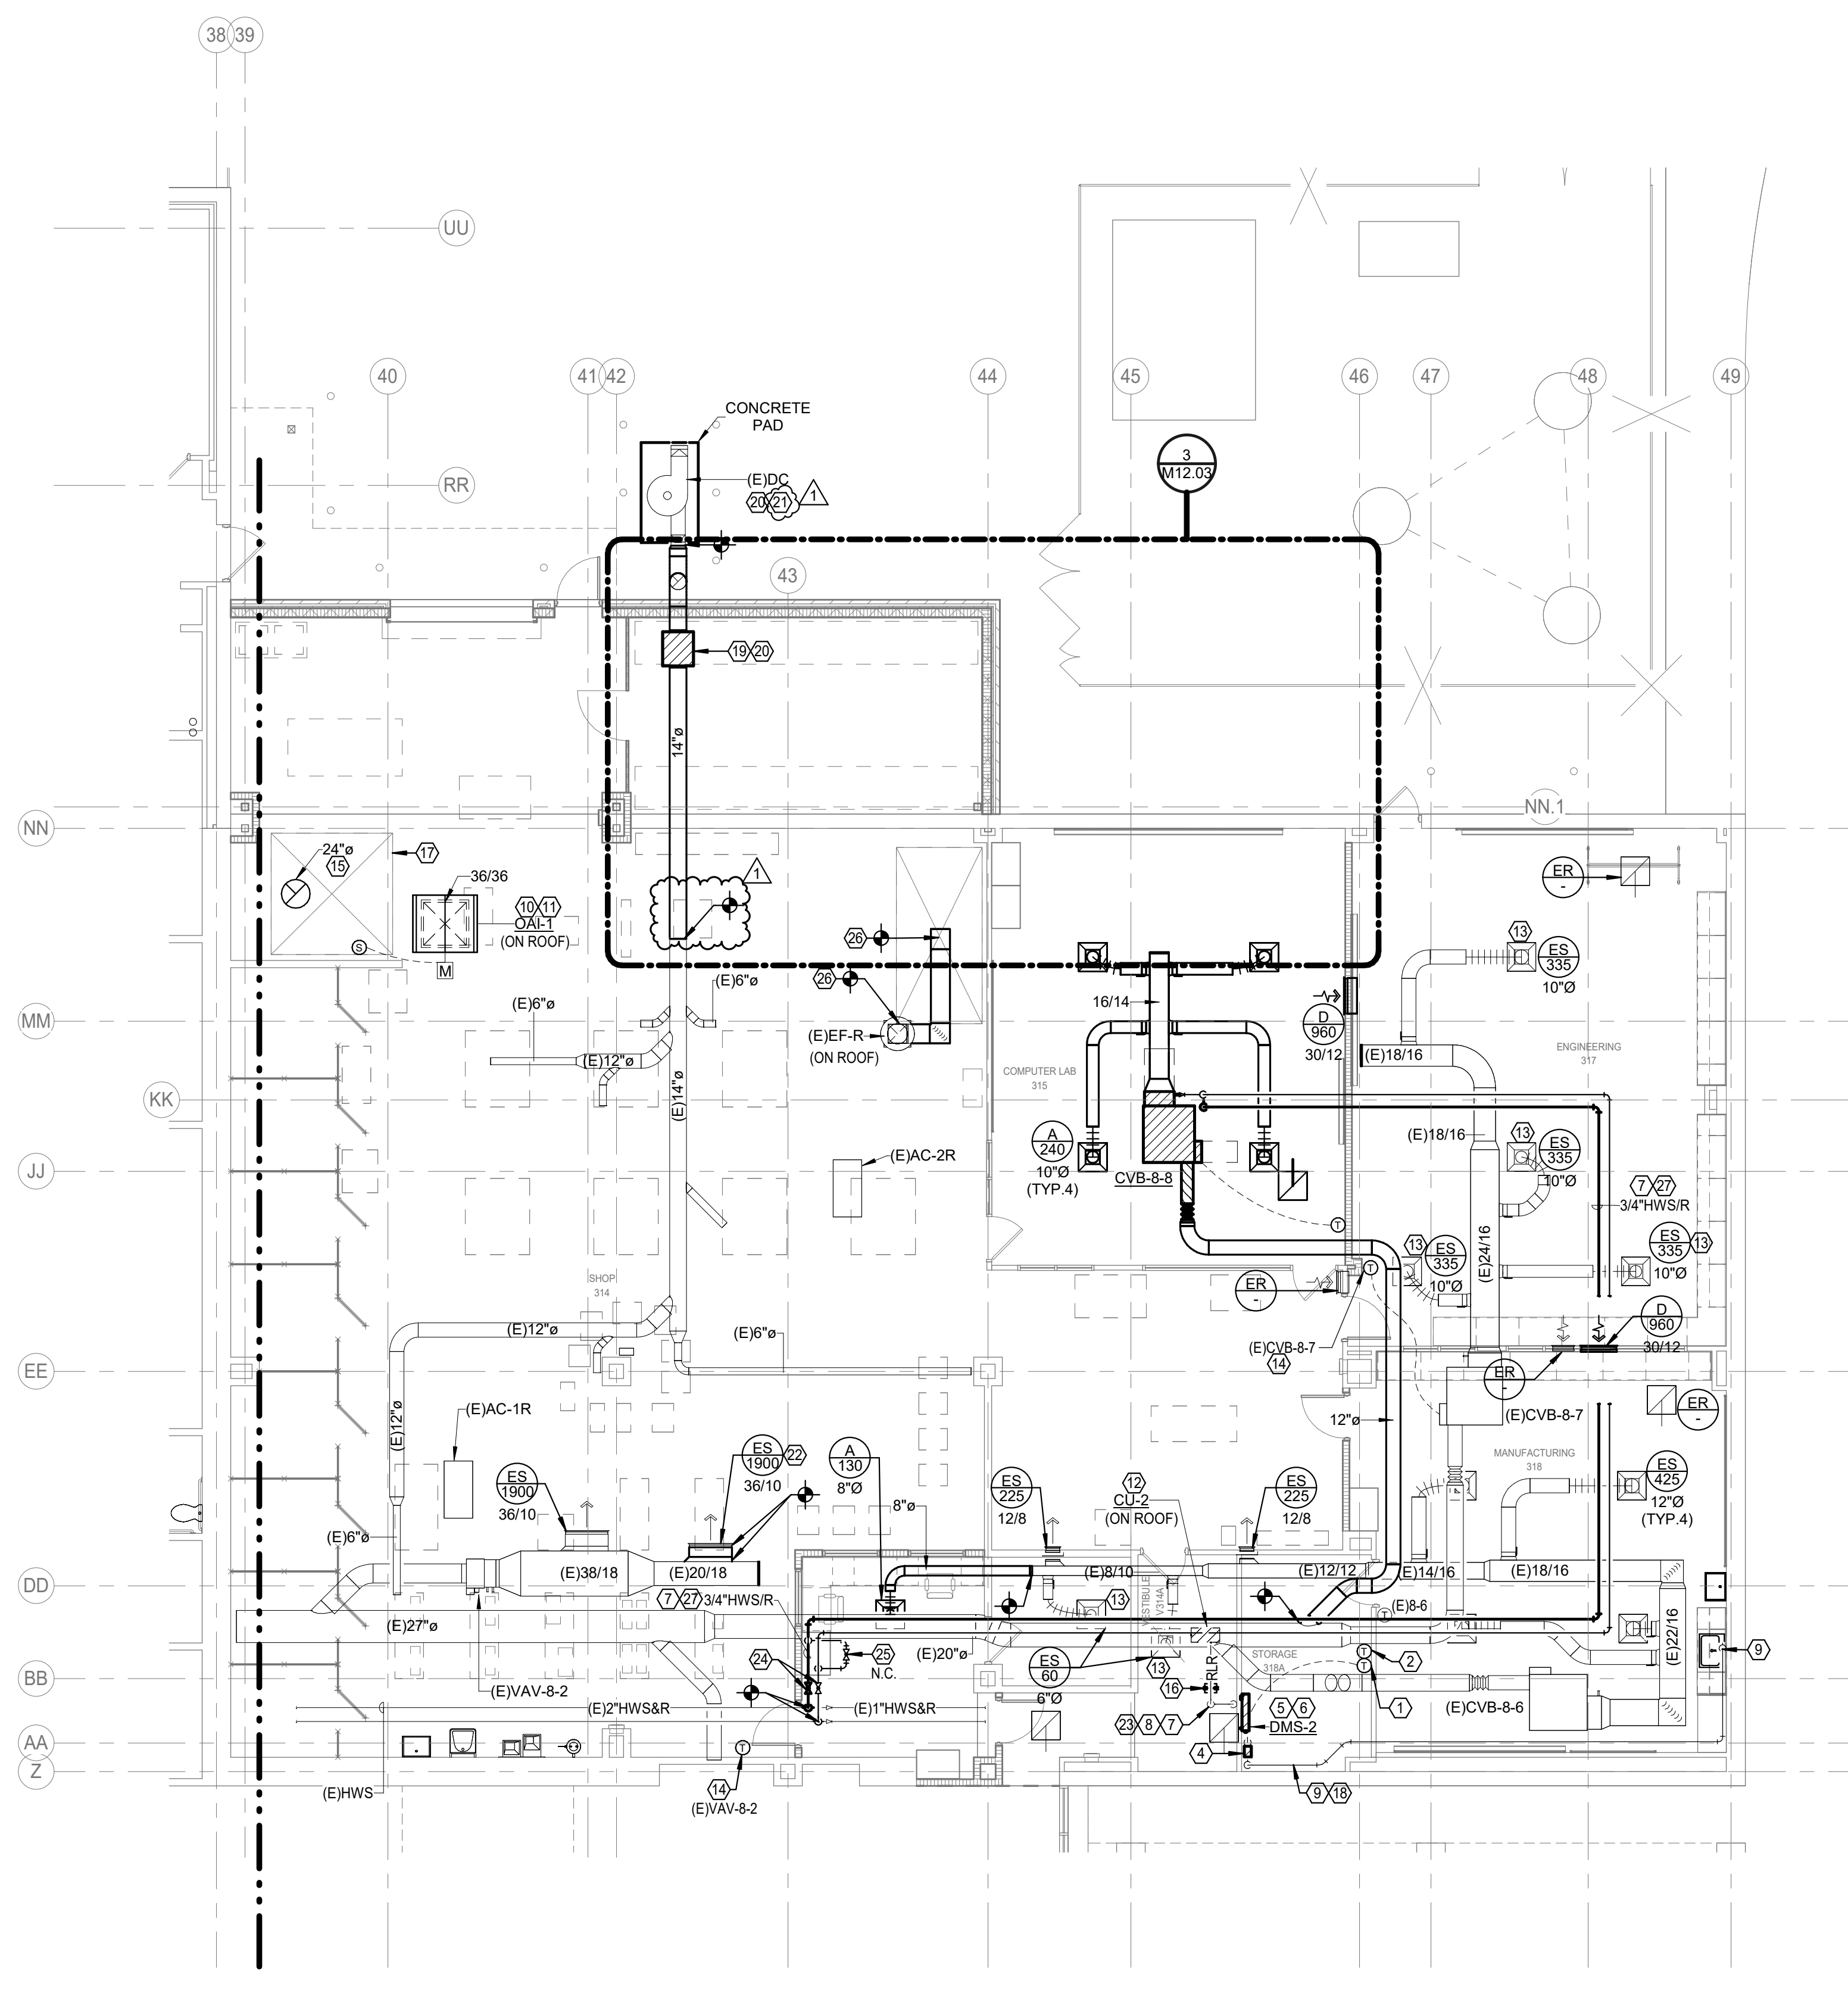


1 MECHANICAL FLOOR PLAN - LEVEL 1 - C - UNIT D.2
Scale: 1/8" = 1'-0"




ARCHITECT
VLK Architects
20445 State Hwy 249, Suite 350
Houston, Texas 77070
Main Phone: 281.671.2300
www.vlkarchitects.com

M.E.P. ENGINEER
Salas O'Brien
10930 W. Sam Houston Pkwy North
Houston, Texas 77064
Main Phone: 281.664.1900
www.salasobrien.com

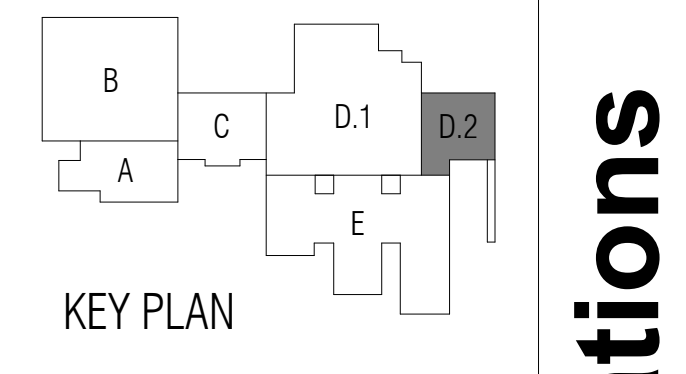

Issue For Proposal

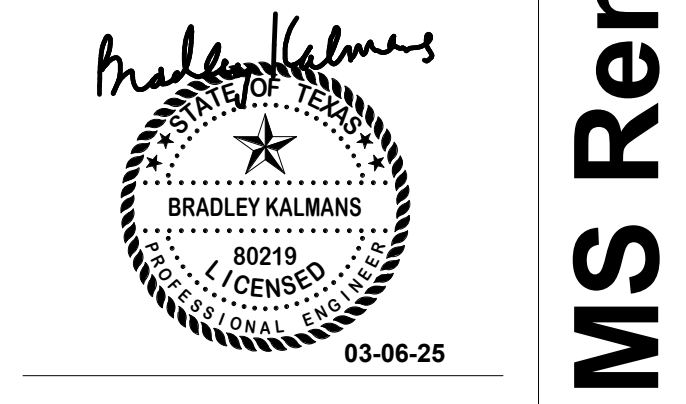

ISSUED: February 24, 2025

REVISIONS

Revision No.	Revision Date
1	ADDENDUM 01 03-06-2025

Director: [Signature]
Approved By: [Signature]
Designer: [Signature]
Project Coord. Checker: [Signature]

Drawn By: [Signature]
Author: [Signature]
Quality Control Designer: [Signature]

PROJECT NO.
24-010.00


SHEET TITLE
COOK - MECHANICAL FLOOR PLAN - LEVEL 1 - UNIT D.2

SHEET NO.

M12.03

COPYRIGHT © 2024 VLK ARCHITECTS


2024 Cook, Labay & Truitt MS Renovations

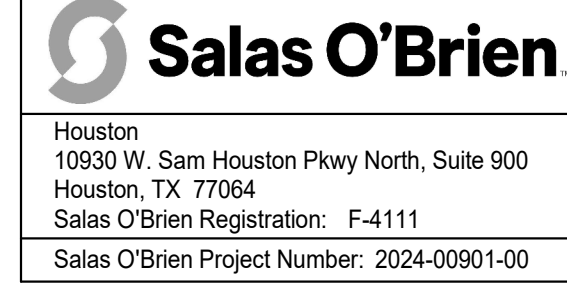


GENERAL DEMOLITION NOTES	
1	ALL EQUIPMENT AND MATERIAL WITHIN AREAS IDENTIFIED TO BE DEMOLISHED ON ARCHITECTURAL PLANS SHALL BE DISCONNECTED AND REMOVED, UNLESS IDENTIFIED OTHERWISE. ALL EQUIPMENT AND MATERIAL DEMOLISHED SHALL BE THE RESPONSIBILITY OF THE CONTRACTOR TO DISPOSE OF IN A PROPER MANNER. ALL EQUIPMENT MATERIALS TO BE DISPOSED OF SHALL BE DONE IN ACCORDANCE WITH ALL LOCAL, STATE AND FEDERAL REQUIREMENTS. IN ADDITION TO REQUIREMENTS OF THE ENVIRONMENTAL PROTECTION AGENCIES AND/OR ANY OTHER GOVERNING AUTHORITY.
2	E.C. SHALL INCLUDE IN BID COST OF REPLACING ALL EXISTING ELECTRICAL DEVICE FACEPLATES TO MATCH NEWLY INSTALLED ELECTRICAL DEVICE FACEPLATES AND PAINT TO MATCH.
3	DURING DEMOLITION THE FIRE PROTECTION AND FIRE ALARM SYSTEMS SHALL REMAIN IN FULL OPERATING CONDITION TO THE SATISFACTION OF THE AUTHORITY HAVING JURISDICTION. CONTRACTOR SHALL INCLUDE ALL REQUIRED DESIGN, LABOR, AND MATERIALS IN ORDER TO KEEP THESE SYSTEMS FUNCTIONAL. ALL DESIGNS SHALL BE DONE BY A LICENSED FIRE SPRINKLER AND FIRE ALARM CONTRACTOR.
4	THESE CONSTRUCTION DRAWINGS ARE DIAGRAMMATIC AND DO NOT NECESSARILY REFLECT ACTUAL DIMENSIONS. IT IS THE RESPONSIBILITY OF THE CONTRACTOR TO FIELD VERIFY ALL DIMENSIONS AND COORDINATE PLACEMENT OF ALL EQUIPMENT AND ROUTING OF ALL CONDUITS, CIRCUITS.

ELECTRICAL KEYED NOTES:


- ① DISCONNECT AND DEMO THE EXISTING MECHANICAL UNIT. PRESERVE THE EXISTING CIRCUIT DURING DEMOLITION TO BE REUSED.
- ② DISCONNECT AND DEMO THE EXISTING WALL PACK AND PRESERVE THE EXISTING CIRCUIT DURING DEMOLITION TO BE REUSED.
- ③ DISCONNECT AND DEMO EXISTING WALL PACK AND PRESERVE THE EXISTING CIRCUIT DURING DEMOLITION TO BE REUSED.
- ④ DEMO EXISTING LIGHTING FIXTURES AND ASSOCIATED CONTROLS, SWITCHES AND PRESERVE THE CIRCUIT ABOVE CEILING.
- ⑤ REMOVE AND RELOCATE EXISTING DUST COLLECTOR/DISCONNECT SWITCH TO NEW LOCATION. EXTEND AND RECONNECT WIRING.
- ⑥ DISCONNECT AND RELOCATE EXISTING LIGHTING SWITCHES TO NEW LOCATION BY THE DOOR IN THE ROOM. REFER TO SHEET E12.02 FOR NEW LOCATION.

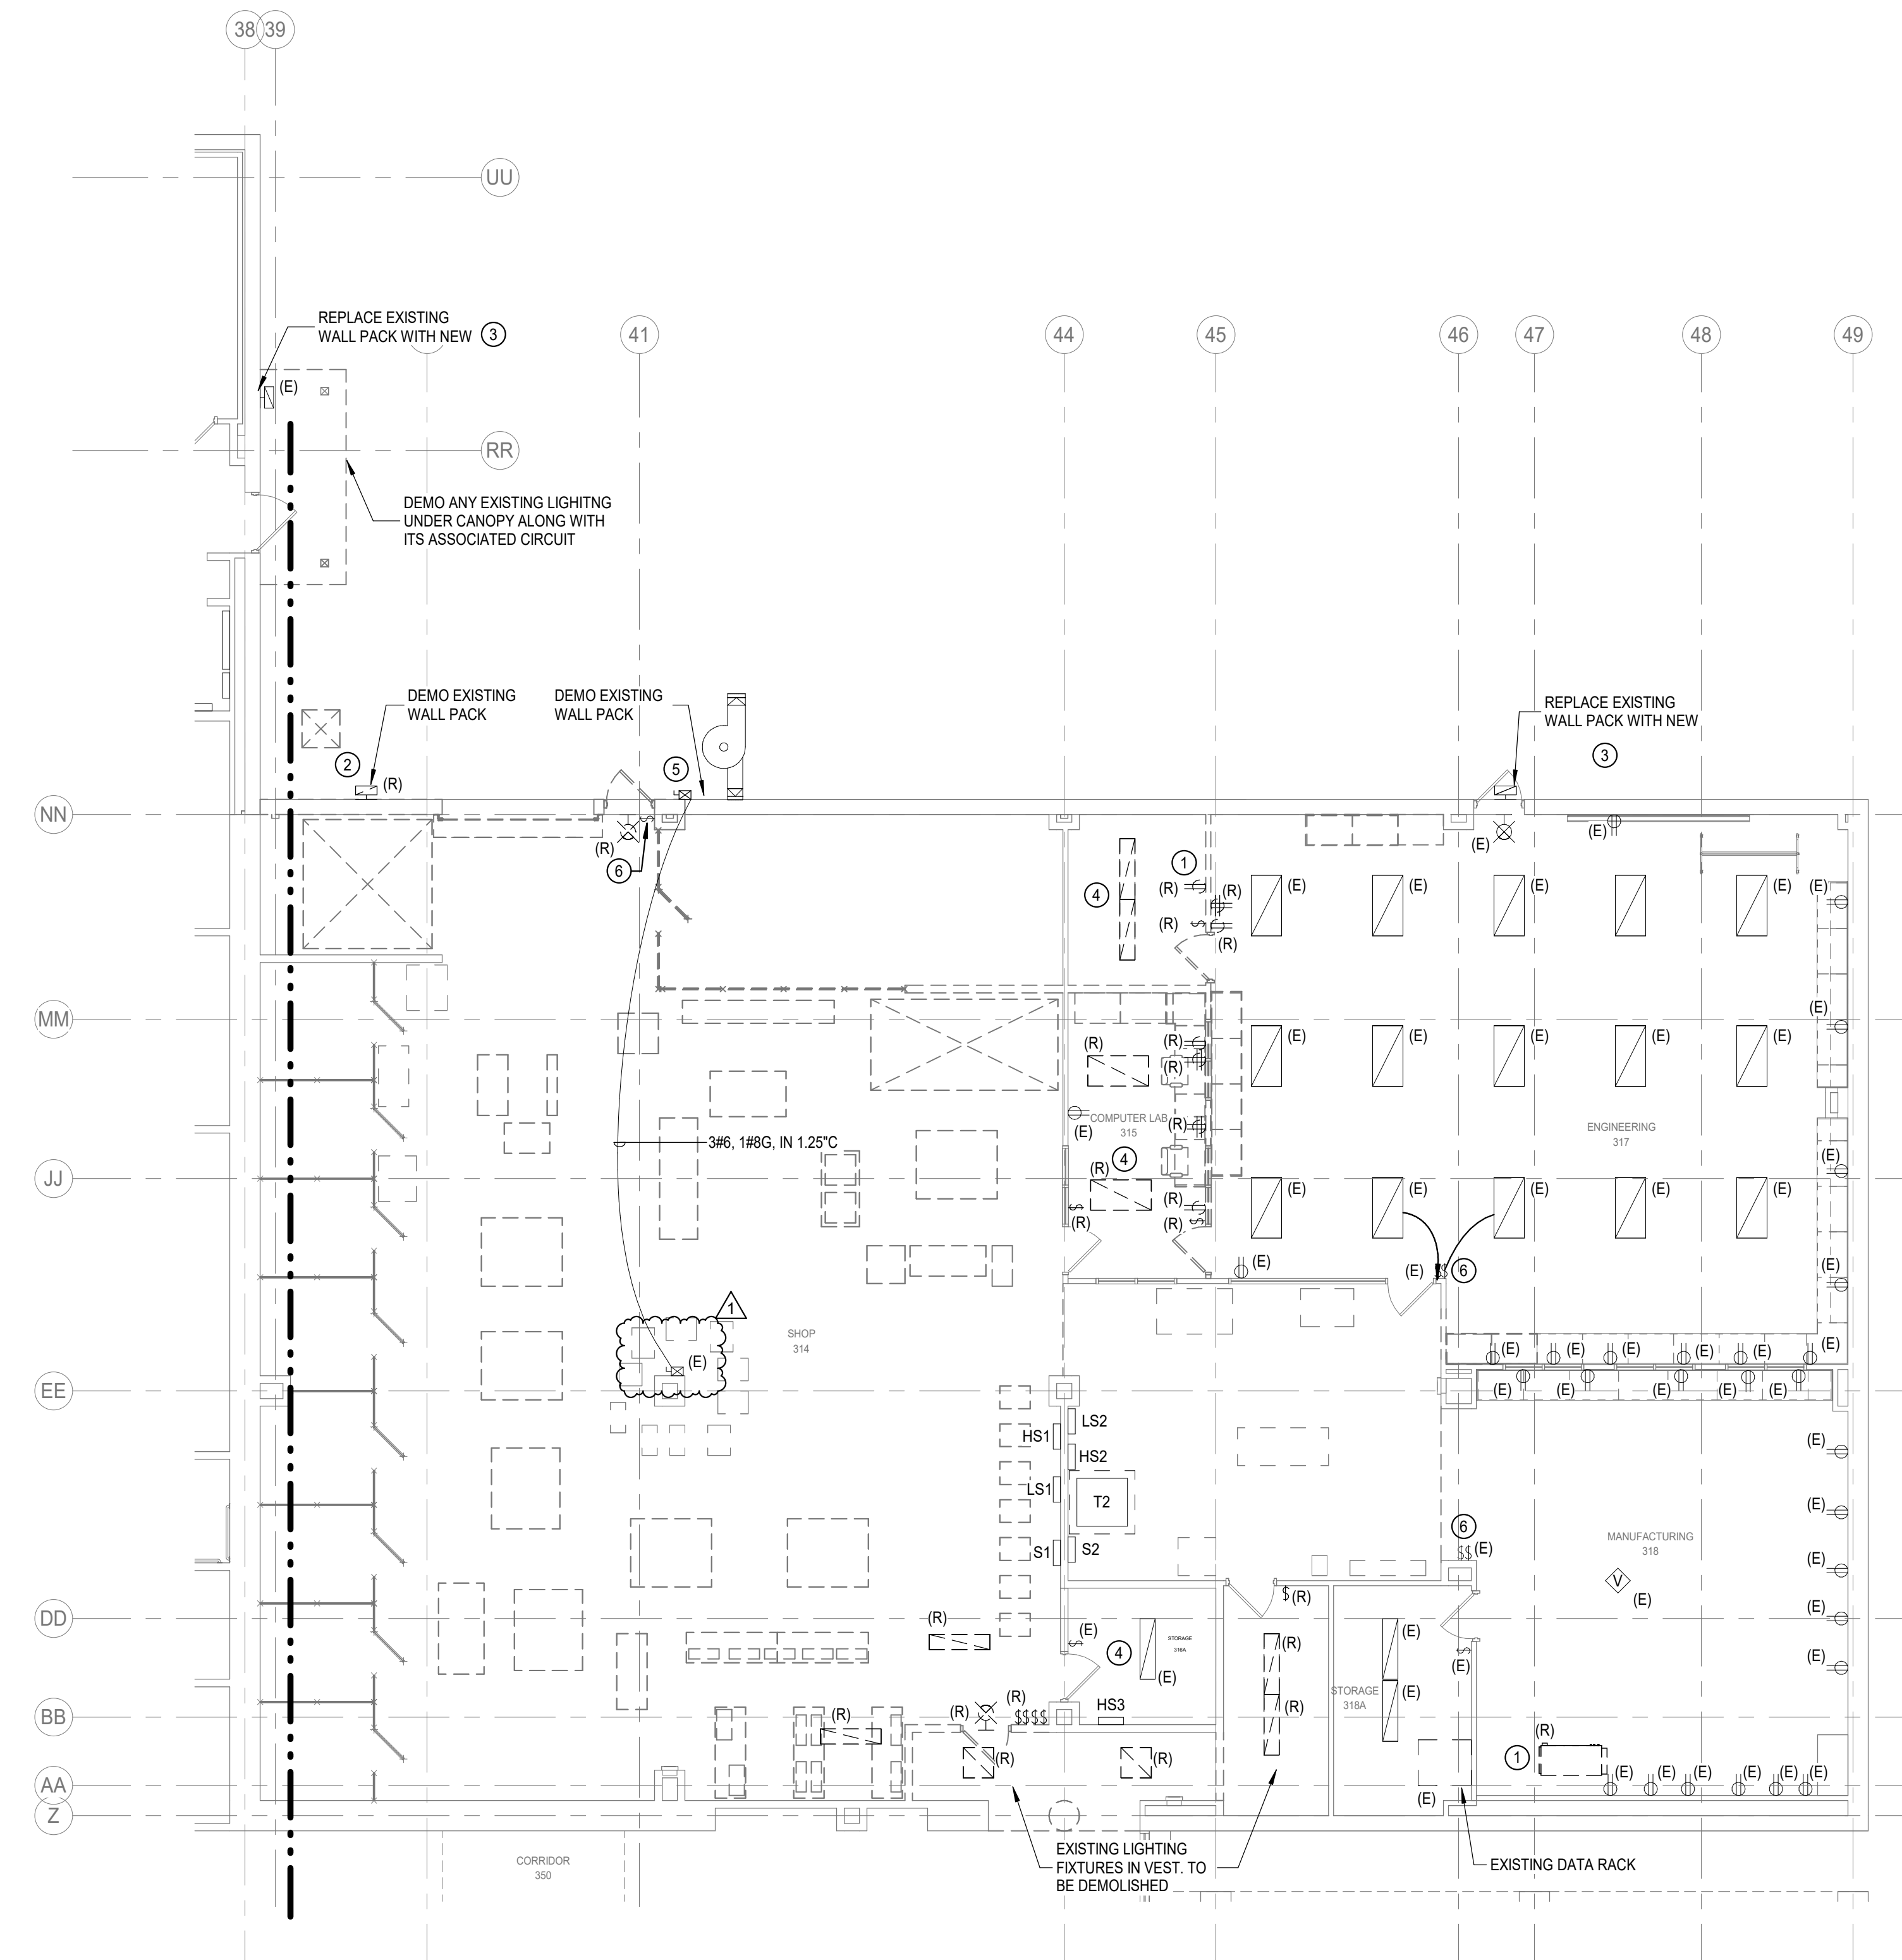

1 ELECTRICAL DEMOLITION FLOOR PLAN - LEVEL 1 - C - UNIT D.2
 Scale: 1/8" = 1'-0"

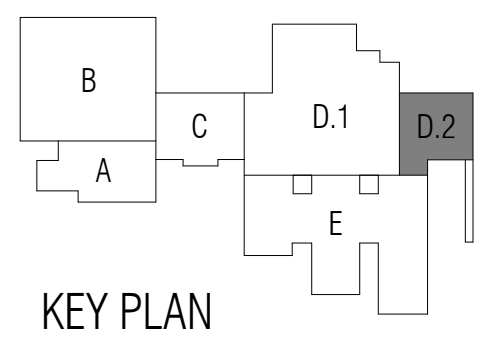

Issue For Proposal

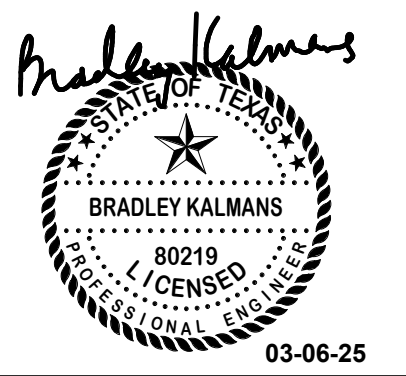

ISSUED: February 24, 2025

REVISIONS	
Revision No.	Revision Date
1	ADDENDUM 01 03-06-2025



Director	MS	Drawn By	SA
Designer	SA	Quality Control	SA
Proj. Coord.	MS		

PROJECT NO.	24-010.00
SHEET TITLE	COOK - ELECTRICAL DEMOLITION FLOOR PLAN - LEVEL 1 - UNIT D.2
SHEET NO.	E10.03

Salas O'Brien
 Houston
 10930 W. Sam Houston Pkwy North, Suite 900
 Houston, TX 77064
 Salas O'Brien Registration: F-4111
 Salas O'Brien Project Number: 2024-00901-00

LIGHTING GENERAL NOTES	
1	PROVIDE PULL STRINGS IN ALL EMPTY CONDUITS.
2	ALL JUNCTION BOXES, CONDUITS, AND WIRES SHALL BE SIZED PER NEC.
3	CONNECT ALL EXIT LIGHTS AHEAD OF ANY LOCAL OR AUTOMATIC SWITCHING DEVICE. PROVIDE POWER VIA NEAREST LIGHTING CIRCUIT NOT TO EXCEED 16A.
4	REFER TO ARCHITECTURAL DRAWINGS FOR EXACT LOCATION & MOUNTING HEIGHTS OF ALL LIGHTING FIXTURES SHOWN ON THIS DRAWING.
5	REFER TO SHEETS 16.01 FOR LIGHTING FIXTURE SCHEDULE AND LIGHTING CONTACTOR SCHEDULE.
6	ELECTRICAL CONTRACTOR SHALL NOTIFY THE ENGINEER OF ANY PROBLEMS PERTAINING TO CIRCUIT AVAILABILITY OR LOAD CAPACITY PRIOR TO INSTALLATION.
7	ELECTRICAL CONTRACTOR SHALL CONFIRM COMPATIBILITY OF ALL LIGHTING CONTROL SYSTEMS.
8	PROVIDE A CONSTANT HOT FROM PANEL BOARD DIRECTLY TO ALL EMERGENCY BATTERY PACKS IN EMERGENCY LIGHTING FIXTURES AND EXIT SIGNS. EMERGENCY LIGHTING FIXTURES SHALL TURN ON TO FULL BRIGHTNESS IN CASE OF POWER LOSS.
9	ALL CLASSROOMS AND SPACES DO NOT REQUIRE DAYLIGHT HARVESTING CONTROLS, UNLESS NOTED ON PLAN. PER 2018 IECC CODE 2.3 WATTAGE REQUIREMENT.
10	PROVIDE CONNECTION FROM EMERGENCY PANEL FOR EMERGENCY POWER FOR ALL EXPOSED FIXTURES. PROVIDE EQUIVALENT CONNECTION OF EMERGENCY LOADS. CIRCUIT NORMAL AND EMERGENCY POWER AS INDICATED. REFER TO DETAIL ON SHEET 16.03 AND ONE-LINE DIAGRAM ON SHEET 14.01.
11	LOWER CASE LETTER INDICATES SWITCHING SCHEME.
12	ALL ABOVE CEILING POWER PACKS TO BE MOUNTED ABOVE ROOM DOORS REGARDLESS OF SCHEMATIC DESIGN SHOWN ON FLOOR PLANS. E.C. SHALL ENSURE INSTALLATION OF ALL POWER PACKS OCCUR ABOVE ROOM DOORS.

- ELECTRICAL KEYED NOTES:**
- ① REPLACE EXISTING WALL PACK WITH NEW LED WALL PACK AND CONNECT TO EXISTING CIRCUIT IN PLACE. ALL EXTERIOR WALL PACKS AND CANOPY LIGHT FIXTURES TO BE CONTROLLED BY BMCS.
 - ② CONNECT NEW WALL PACK TO ADJACENT WALL PACK CIRCUIT VIA 2#12, #12G IN 3/4C TO BE CONTROLLED BY BMCS.
 - ③ EXTEND AND CONNECT EXISTING CIRCUIT PRESERVED DURING DEMO TO NEW FIXTURES. CONTROL FIXTURES WITH EXISTING SWITCHES AND CEILING SENSOR IN THE ROOM.
 - ④ COORDINATE MOUNTING OF ALL NEW WALL PACK TO BE UNDER THE CANOPY. COORDINATE WITH ARCHITECTURE PLANS.

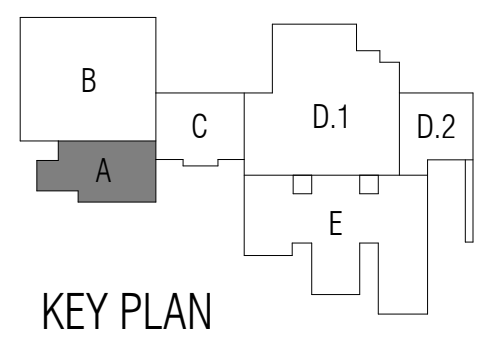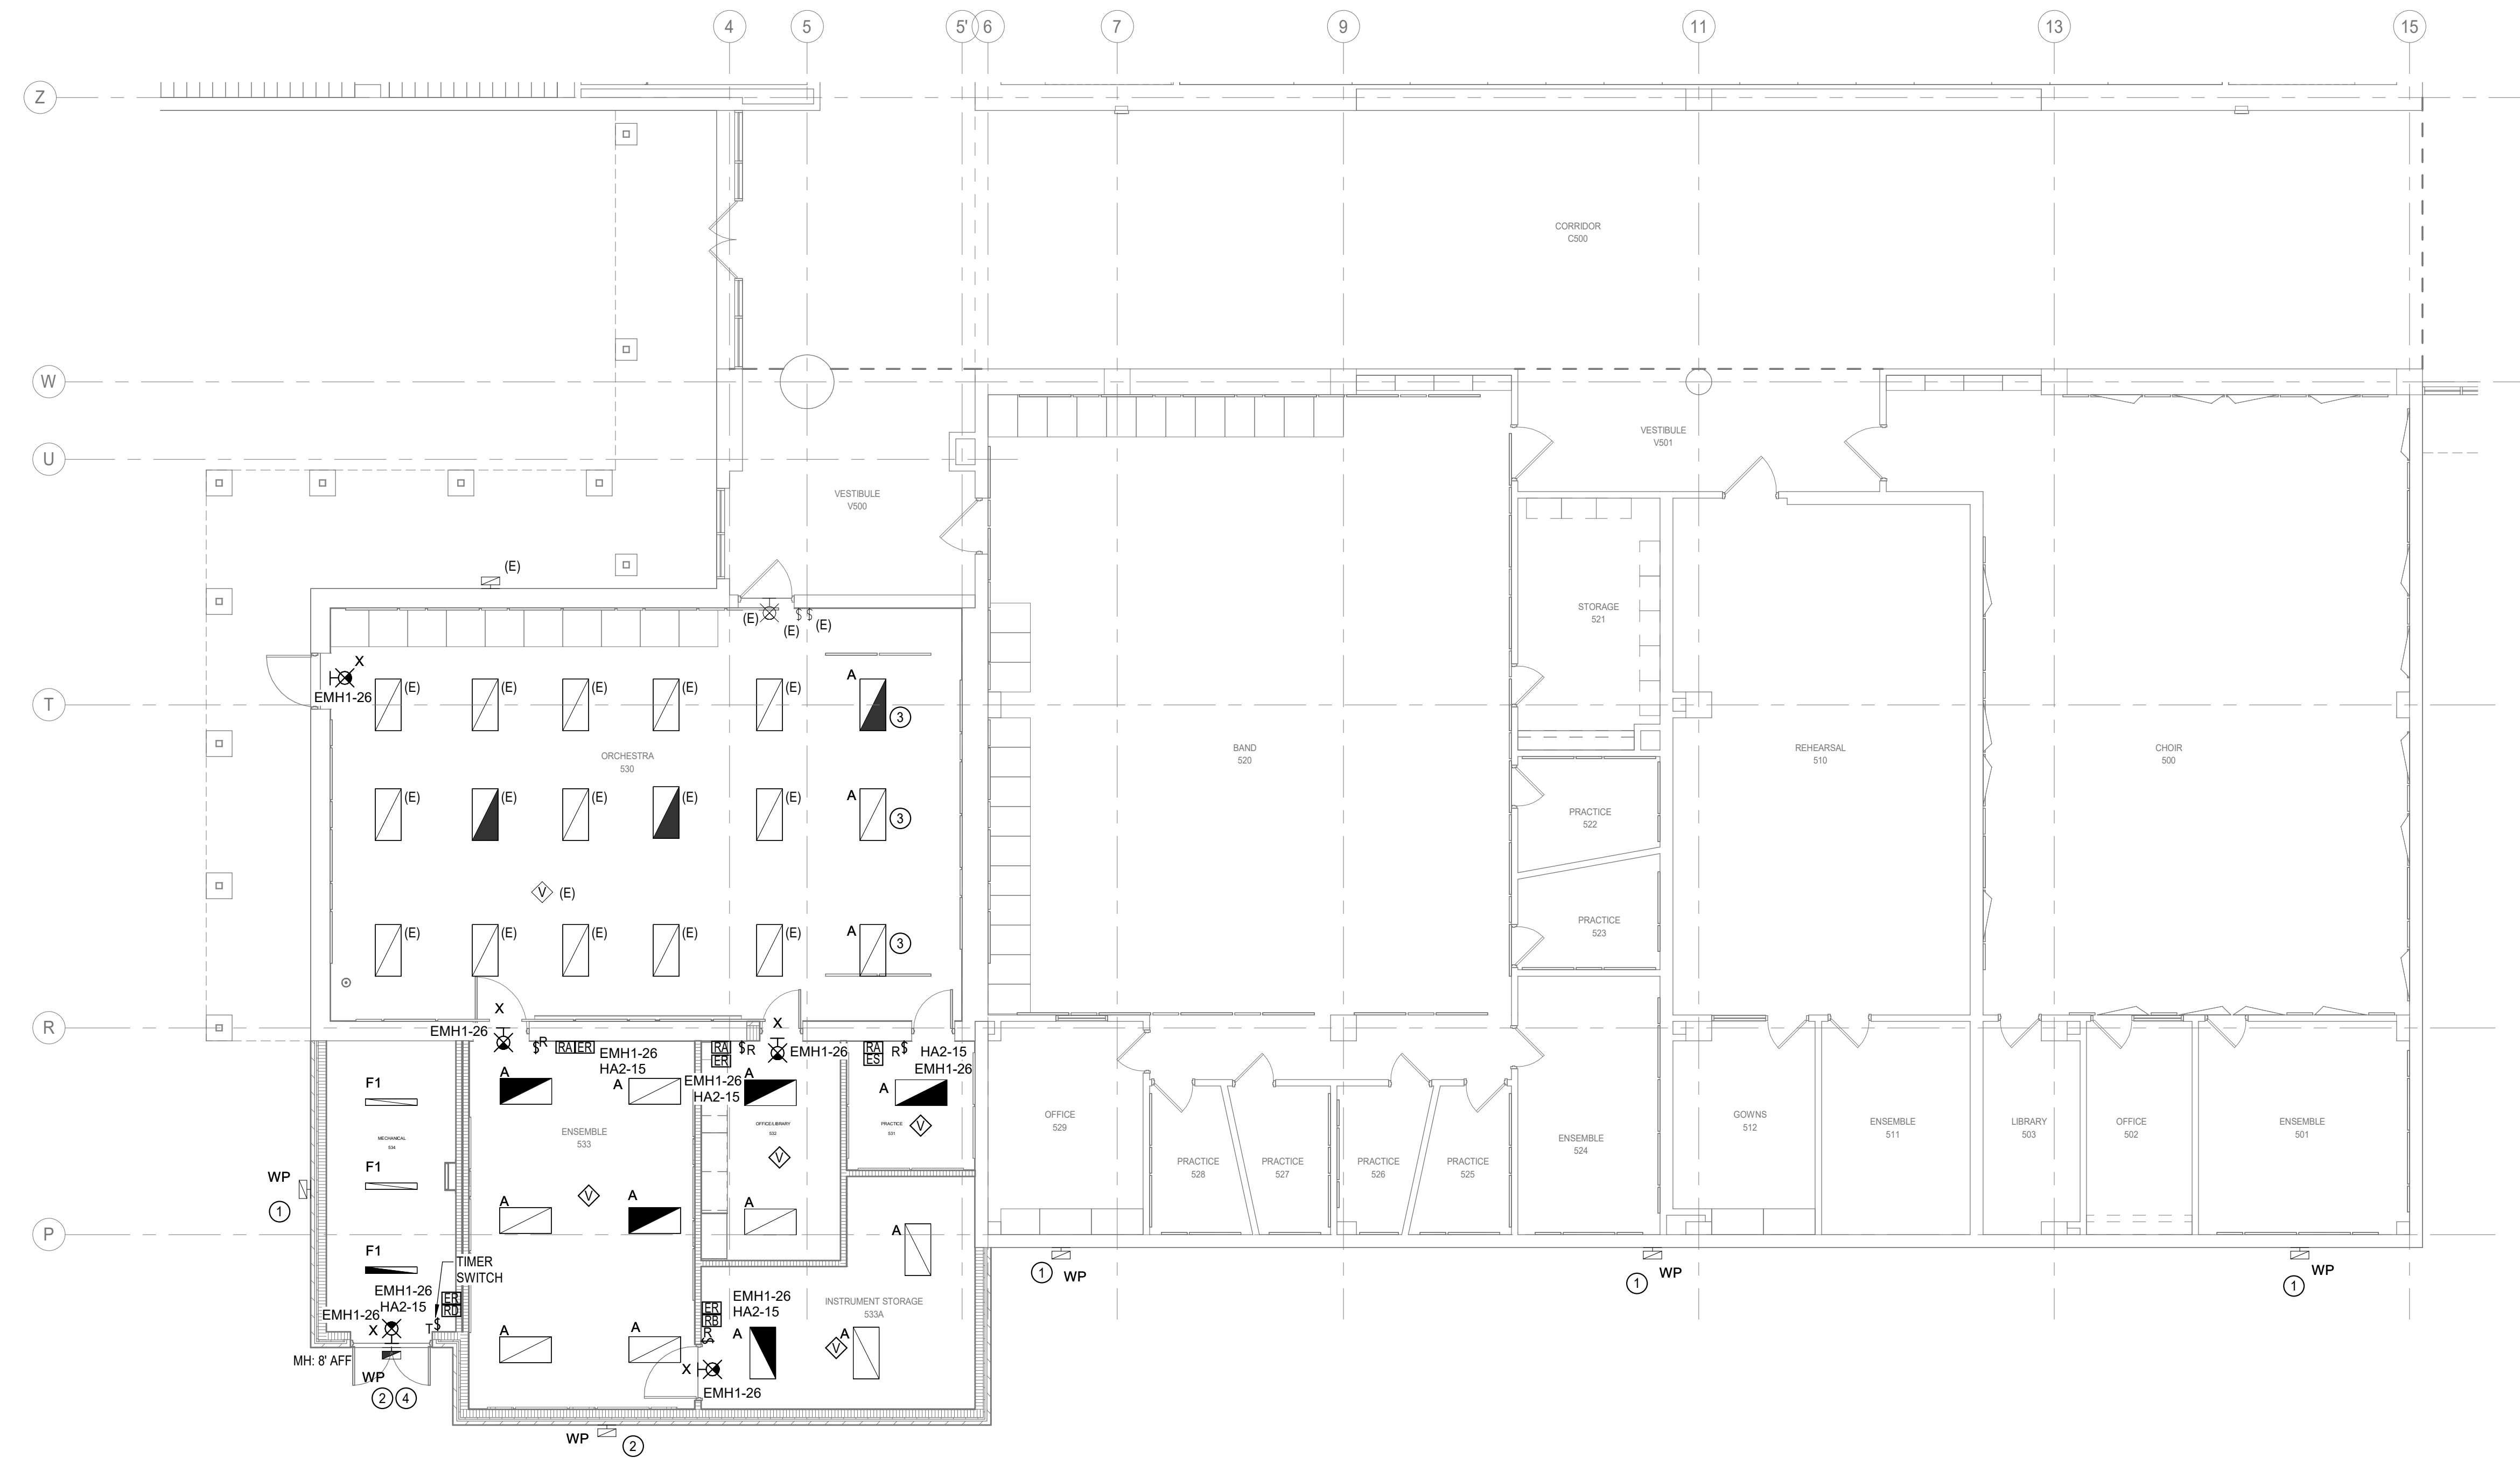

KEY PLAN

Issue For Proposal



ISSUED: February 24, 2025

REVISIONS	
Revision No.	Revision Date
1	ADDENDUM 01 03-06-2025

Director: Drawn By
 Approver: SA
 Designer: Quality Control
 SA
 Proj. Coord.
 Checker

PROJECT NO.
24-010.00

SHEET TITLE
COOK - ELECTRICAL LIGHTING FLOOR PLAN - LEVEL 1 - UNIT A

SHEET NO.

1 ELECTRICAL LIGHTING FLOOR PLAN - LEVEL 1 - C - UNIT A
 Scale: 1/8" = 1'-0"

Salas O'Brien
 Houston
 10930 W. Sam Houston Pkwy North, Suite 900
 Houston, TX 77064
 Salas O'Brien Registration: F-4111
 Salas O'Brien Project Number: 2024-00901-00

E12.01


ARCHITECT

VLK Architects
 20445 State Hwy 249, Suite 350
 Houston, Texas 77070
 Main Phone: 281.671.2300
 www.vlkarchitects.com

M.E.P. ENGINEER


Salas O'Brien
 10930 W. Sam Houston Pkwy North
 Houston, Texas 77064
 Main Phone: 281.664.1900
 www.salasobrien.com

CYPRESS-FAIRBANKS INDEPENDENT SCHOOL DISTRICT
 HOUSTON, TEXAS

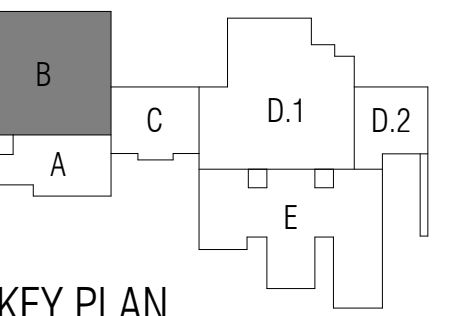

KEY PLAN

Issue For Proposal

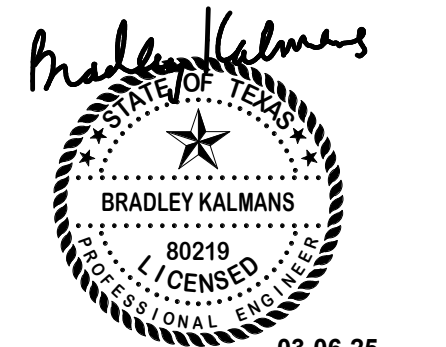

ISSUED: February 24, 2025

REVISIONS

Revision No.	Revision Date
1	ADDENDUM 01 03-06-2025

Director	Drawn By
CA	SA
Designer	Quality Control
SA	JZ
Proj. Coord.	
MS	

PROJECT NO.

24-010.00

SHEET TITLE

ELECTRICAL LIGHTING FLOOR PLAN - LEVEL 1 - UNIT B

SHEET NO.


E12.02

Salas O'Brien
 Houston
 10930 W. Sam Houston Pkwy North, Suite 900
 Houston, TX 77064
 Salas O'Brien Registration: F-4111
 Salas O'Brien Project Number: 2024-00901-00

LIGHTING GENERAL NOTES	
1	PROVIDE PULL STRINGS IN ALL EMPTY CONDUITS.
2	ALL JUNCTION BOXES, CONDUITS, AND WIRES SHALL BE SIZED PER NEC.
3	CONNECT ALL EXIT LIGHTS AHEAD OF ANY LOCAL OR AUTOMATIC SWITCHING DEVICE. PROVIDE POWER VIA NEAREST LIGHTING CIRCUIT NOT TO EXCEED 16A.
4	REFER TO ARCHITECTURAL DRAWINGS FOR EXACT LOCATION & MOUNTING HEIGHTS OF ALL LIGHTING FIXTURES SHOWN ON THIS DRAWING.
5	REFER TO SHEETS 16.01 FOR LIGHTING FIXTURE SCHEDULE AND LIGHTING CONTACTOR SCHEDULE.
6	ELECTRICAL CONTRACTOR SHALL NOTIFY THE ENGINEER OF ANY PROBLEMS PERTAINING TO CIRCUIT AVAILABILITY OR LOAD CAPACITY PRIOR TO INSTALLATION.
7	ELECTRICAL CONTRACTOR SHALL CONFIRM COMPATIBILITY OF ALL LIGHTING CONTROL SYSTEMS.
8	PROVIDE A CONSTANT HOT FROM PANEL BOARD DIRECTLY TO ALL EMERGENCY BATTERY PACKS IN EMERGENCY LIGHTING FIXTURES AND EXIT SIGNS. EMERGENCY LIGHTING FIXTURES SHALL TURN ON TO FULL BRIGHTNESS IN CASE OF POWER LOSS.
9	ALL CLASSROOMS AND SPACES DO NOT REQUIRE DAYLIGHT HARVESTING CONTROLS, UNLESS NOTED ON PLAN, PER 2018 IECC C405.2.3 WATTAGE REQUIREMENT.
10	PROVIDE CONNECTION FROM EMERGENCY PANEL FOR EMERGENCY POWER FOR ALL EGRESS FIXTURES, PROVIDE ECM MODULE FOR CONNECTION OF EMERGENCY LOADS. CIRCUIT NORMAL AND EMERGENCY POWER AS INDICATED. REFER TO DETAIL ON SHEET 16.03 AND ONE-LINE DIAGRAM ON SHEET 14.01.
11	LOWER CASE LETTER INDICATES SWITCHING SCHEME.
12	ALL ABOVE CEILING POWER PACKS TO BE MOUNTED ABOVE ROOM DOORS REGARDLESS OF SCHEMATIC DESIGN SHOWN ON FLOOR PLANS. E.C. SHALL ENSURE INSTALLATION OF ALL POWER PACKS OCCUR ABOVE ROOM DOORS.

ELECTRICAL KEYED NOTES:


- ① DISCONNECT AND DEMO THE EXISTING WALL PACK AND PRESERVE THE EXISTING CIRCUIT DURING DEMOLITION TO BE REUSED.
- ② CONNECT NEW WALL PACK TO EXISTING ADJACENT WALL PACK CIRCUIT VIA 2#12, 1#12G IN 3/4" TO BE CONTROLLED BY BMCS. COORDINATE MOUNTING OF ALL NEW WALL PACK TO BE UNDER THE CANOPY. COORDINATE WITH ARCHITECTURE PLANS.

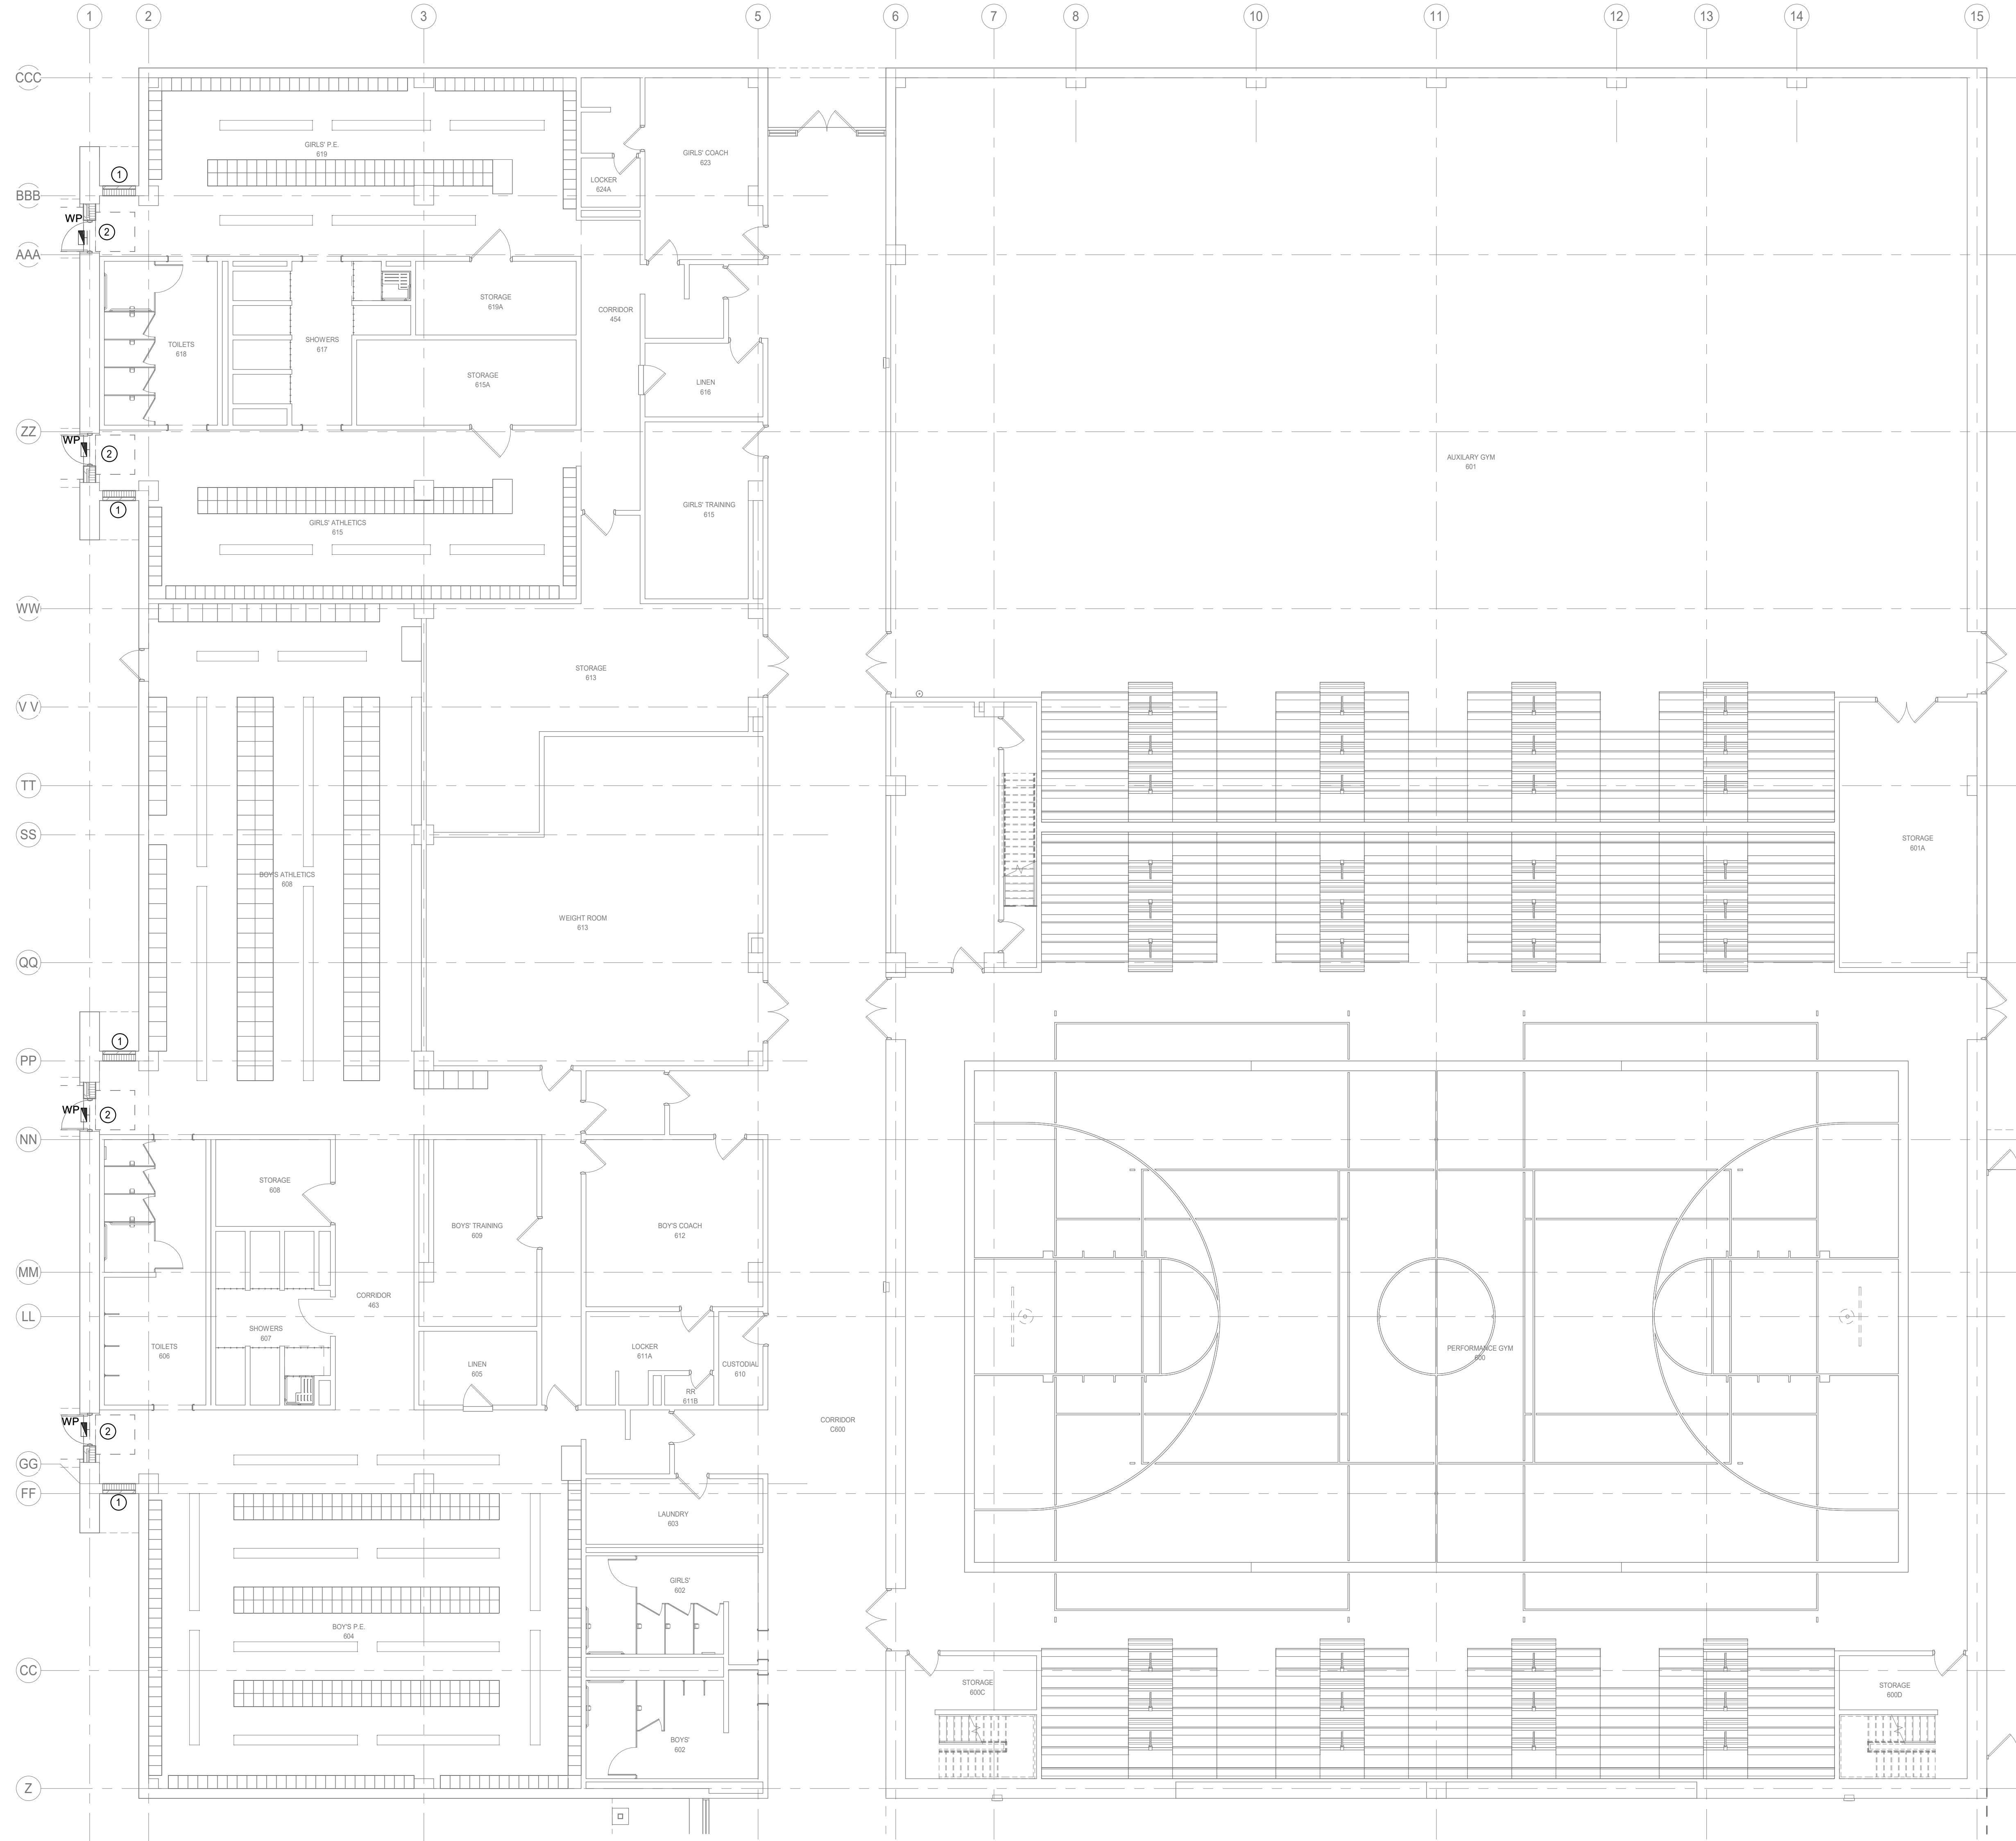


ELECTRICAL LIGHTING FLOOR PLAN - LEVEL 1 - C - UNIT B
 Scale: 1/8" = 1'-0"

LIGHTING GENERAL NOTES	
1	PROVIDE PULL STRINGS IN ALL EMPTY CONDUITS.
2	ALL JUNCTION BOXES, CONDUITS, AND WIRES SHALL BE SIZED PER NEC.
3	CONNECT ALL EXIT LIGHTS AHEAD OF ANY LOCAL OR AUTOMATIC SWITCHING DEVICE. PROVIDE POWER VIA NEAREST LIGHTING CIRCUIT NOT TO EXCEED 16A.
4	REFER TO ARCHITECTURAL DRAWINGS FOR EXACT LOCATION & MOUNTING HEIGHTS OF ALL LIGHTING FIXTURES SHOWN ON THIS DRAWING.
5	REFER TO SHEETS 16.01 FOR LIGHTING FIXTURE SCHEDULE AND LIGHTING CONTACTOR SCHEDULE.
6	ELECTRICAL CONTRACTOR SHALL NOTIFY THE ENGINEER OF ANY PROBLEMS PERTAINING TO CIRCUIT AVAILABILITY OR LOAD CAPACITY PRIOR TO INSTALLATION.
7	ELECTRICAL CONTRACTOR SHALL CONFIRM COMPATIBILITY OF ALL LIGHTING CONTROL SYSTEMS.
8	PROVIDE A CONSTANT HOT FROM PANEL BOARD DIRECTLY TO ALL EMERGENCY BATTERY PACKS IN EMERGENCY LIGHTING FIXTURES AND EXIT SIGNS. EMERGENCY LIGHTING FIXTURES SHALL TURN ON TO FULL BRIGHTNESS IN CASE OF POWER LOSS.
9	ALL CLASSROOMS AND SPACES DO NOT REQUIRE DAYLIGHT HARVESTING CONTROLS, UNLESS NOTED ON PLAN, PER 2018 IECC C405.2.3 WATTAGE REQUIREMENT.
10	PROVIDE CONNECTION FROM EMERGENCY PANEL FOR EMERGENCY POWER FOR ALL EGRESS FIXTURES. PROVIDE ECM MODULE FOR CONNECTION OF EMERGENCY LOADS. CIRCUIT NORMAL AND EMERGENCY POWER AS INDICATED. REFER TO DETAIL ON SHEET 16.03 AND ONE-LINE DIAGRAM ON SHEET 14.01.
11	LOWER CASE LETTER INDICATES SWITCHING SCHEME.
12	ALL ABOVE CEILING POWER PACKS TO BE MOUNTED ABOVE ROOM DOORS REGARDLESS OF SCHEMATIC DESIGN SHOWN ON FLOOR PLANS. E.C. SHALL ENSURE INSTALLATION OF ALL POWER PACKS OCCUR ABOVE ROOM DOORS.

- ELECTRICAL KEYED NOTES:**
- ① REPLACE EXISTING WALL PACK WITH NEW LED WALL PACK AND CONNECT TO EXISTING CIRCUIT IN PLACE. ALL EXTERIOR WALL PACKS AND CANOPY LIGHT FIXTURES TO BE CONTROLLED BY BMCS.
 - ② CONNECT NEW WALL PACK TO EXISTING ADJACENT WALL PACK CIRCUIT VIA 2#12, 1#12G IN 3/4" TO BE CONTROLLED BY BMCS.
 - ③ EXTEND AND CONNECT EXISTING CIRCUIT PRESERVED DURING DEMO TO NEW FIXTURES. CONTROL FIXTURES WITH EXISTING SWITCHES AND CEILING SENSOR IN THE ROOM.
 - ④ EXTEND AND RELOCATE EXISTING CONTROL SWITCHES TO EXISTING WALL ADJACENT TO THE ROOM DOOR.
 - ⑤ PROVIDE NEW SWITCHES TO CONTROL EXISTING LIGHTING IN WOOD SHOP.
 - ⑥ REPLACE EXISTING FIXTURE WITH NEW AND RECONNECT TO EXISTING CIRCUIT IN PLACE UNDER THE CANOPY.
 - ⑦ COORDINATE MOUNTING OF ALL NEW WALL PACK TO BE UNDER THE CANOPY. COORDINATE WITH ARCHITECTURE PLANS.

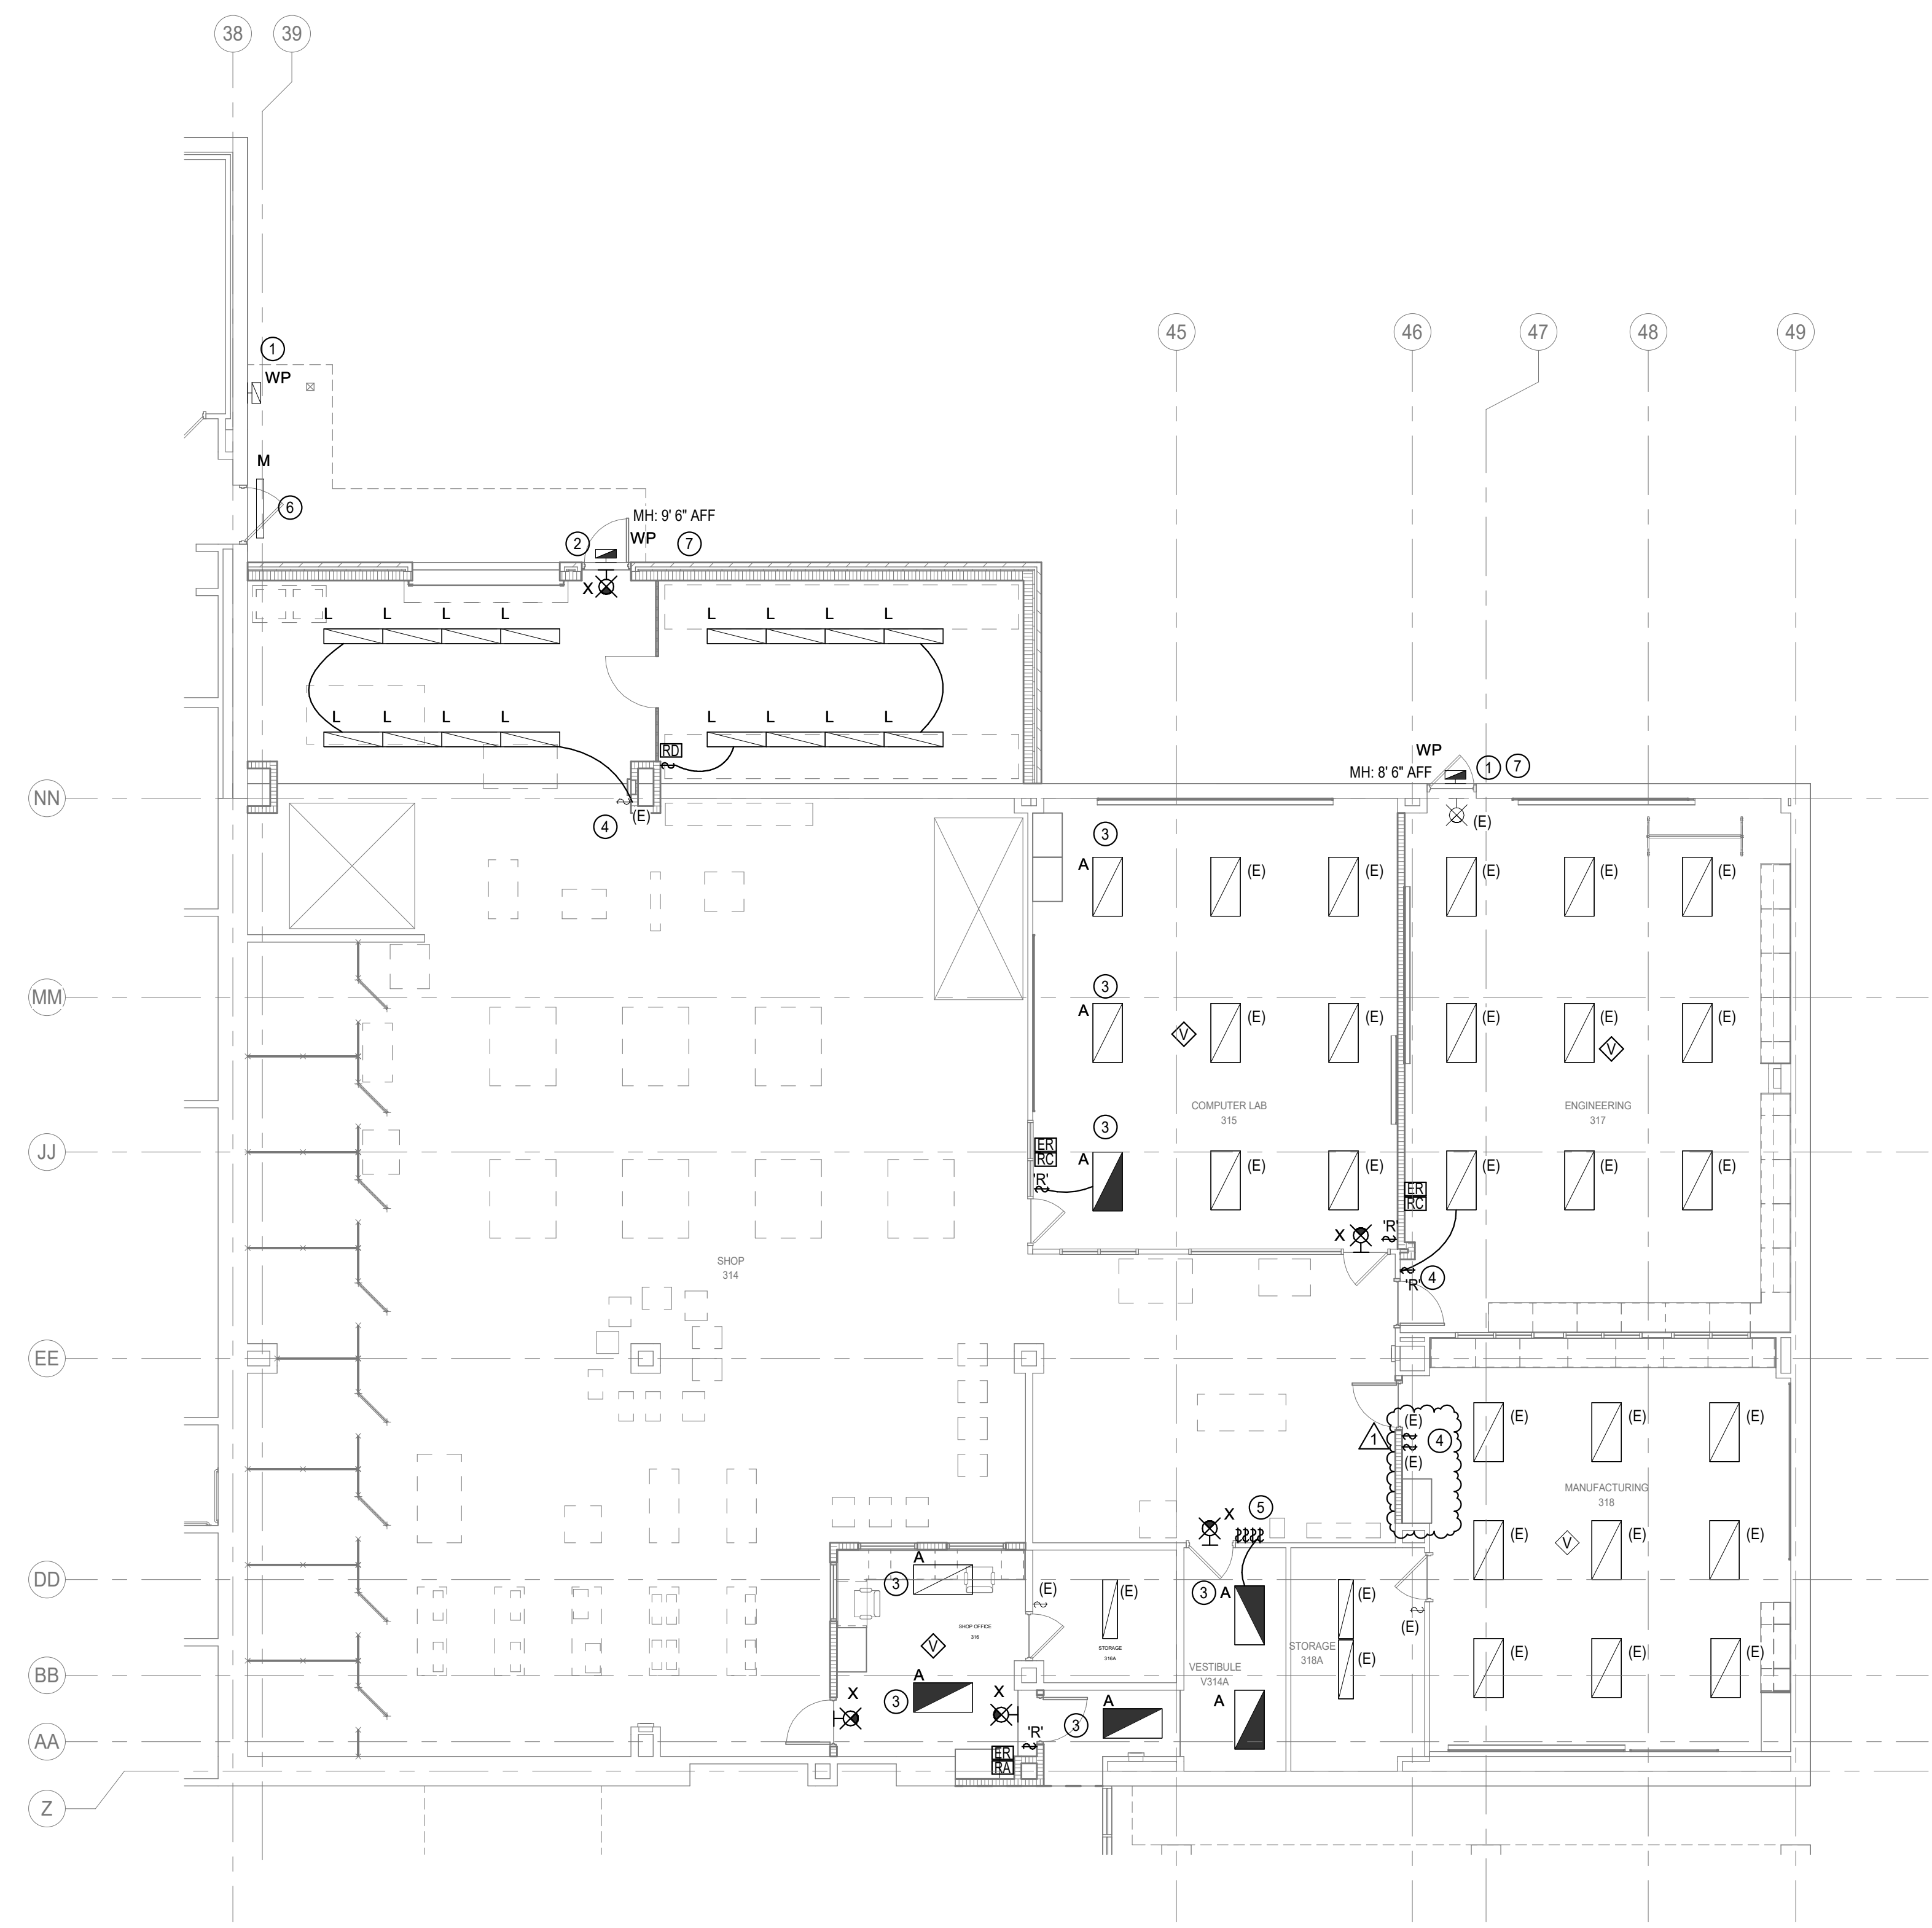

1 ELECTRICAL LIGHTING FLOOR PLAN - LEVEL 1 - C - UNIT D.2
 Scale: 1/8" = 1'-0"

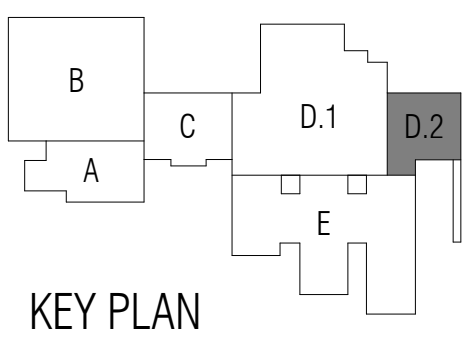

Issue For Proposal



ISSUED: February 24, 2025

REVISIONS	
Revision No.	Revision Date
1	ADDENDUM 01 03-06-2025

Director	CA	Drawn By	SA
Designer	SA	Quality Control	JZ
Proj. Coord.	MS		

PROJECT NO.
24-010.00

SHEET TITLE
COOK - ELECTRICAL LIGHTING FLOOR PLAN - LEVEL 1 - UNIT D.2

SHEET NO.

Salas O'Brien
 Houston
 10930 W. Sam Houston Pkwy North, Suite 900
 Houston, TX 77064
 Salas O'Brien Registration: F-4111
 Salas O'Brien Project Number: 2024-00901-00

E12.03

ARCHITECT

VLK Architects
20445 State Hwy 249, Suite 350
Houston, Texas 77070
Main Phone: 281.671.2300
www.vlkarchitects.com


M.E.P. ENGINEER

Salas O'Brien
10930 W. Sam Houston Pkwy North
Houston, Texas 77064
Main Phone: 281.664.1900
www.salasobrien.com


POWER GENERAL NOTES	
1	ELECTRICAL CONTRACTOR SHALL NOTIFY THE ENGINEER OF ANY PROBLEMS PERTAINING TO CIRCUIT AVAILABILITY OR LOAD CAPACITY PRIOR TO INSTALLATION.
2	CONTRACTOR SHALL REFER TO MECHANICAL AND PLUMBING DRAWINGS FOR EXACT LOCATION OF MECHANICAL AND PLUMBING EQUIPMENT AND SCHEDULES. CONTRACTOR SHALL PROVIDE ALL ELECTRICAL DISCONNECTS, BRANCH CIRCUITRY, STARTERS/CONTROLS, CIRCUIT BREAKERS AND CONNECTIONS REQUIRED TO POWER EQUIPMENT.
3	CONTRACTOR TO COORDINATE EXACT LOCATION OF DISCONNECT SWITCHES, JUNCTION BOXES AND SINGLE POLE TOGGLE SWITCHES FOR MECHANICAL EQUIPMENT WITH MECHANICAL CONTRACTOR PRIOR TO INSTALLATION.
4	ALL RECEPTACLES LOCATED WITHIN 6" OF SINK SHALL BE GFCI TYPE.
5	CONTRACTOR SHALL COORDINATE EXACT LOCATIONS OF RECEPTACLES AND SWITCHES WITH ARCHITECTURAL ELEVATIONS PRIOR TO ELECTRICAL ROUGH-IN. ADJUST DEVICES AS REQUIRED SO THAT NO DEVICES ARE INSTALLED BEHIND CABINETS OR SHELVES.
6	ALL BLANK FACE GFCI DEVICES SHALL BE INSTALLED IN A READILY ACCESSIBLE LOCATION AND NOT BEHIND EQUIPMENT.
7	CONTRACTOR SHALL REFER TO TECHNOLOGY SERIES CONSTRUCTION DOCUMENTS FOR EXACT LOCATION AND REQUIREMENTS OF ALL LOW VOLTAGE BACK BOXES, FITTINGS, AND CONDUITS. REFER TO SPECIFICATIONS FOR ADDITIONAL REQUIREMENTS.
8	ALL EXTERIOR OUTLETS SHALL BE WP GFI IN METAL WHILE-IN-USE LOCKABLE ENCLOSURE WITH EXCEPTION TO INTEGRAL RTU RECEPTACLES.

ELECTRICAL KEYED NOTES:

- 1 PROVIDE MANUFACTURER RECOMMENDED WIRING FROM OUTDOOR UNIT TO INDOOR UNIT IN 1".
- 2 PROVIDE QUAD OUTLET ABOVE THE IDF RACK AS REQUIRED PER DISTRICT STANDARDS.
- 3 RELOCATE EXISTING DISCONNECT SWITCH TO NEW LOCATION AS SHOWN FOR DUST COLLECT. EXTEND AND RECONNECT AS SHOWN.
- 4 PROVIDE CONNECTION TO CEILING SPEAKER AND COORDINATE FINAL LOCATION WITH TECHNOLOGY PLANS.
- 5 PROVIDE CONNECTION TO EMERGENCY SIGNALING SYSTEM PROVIDED BY PLUMBING CONTRACTOR AND COORDINATE FINAL LOCATION AND MOUNTING HEIGHT PRIOR TO ROUGH-IN.
- 6 RELOCATE EXISTING EXTERIOR DISCONNECT SWITCH TO NEW TEMPORARY LOCATION AS SHOWN AND EXTEND EXISTING CIRCUIT FROM MOTOR STARTER LOCATED AT COLUMN.

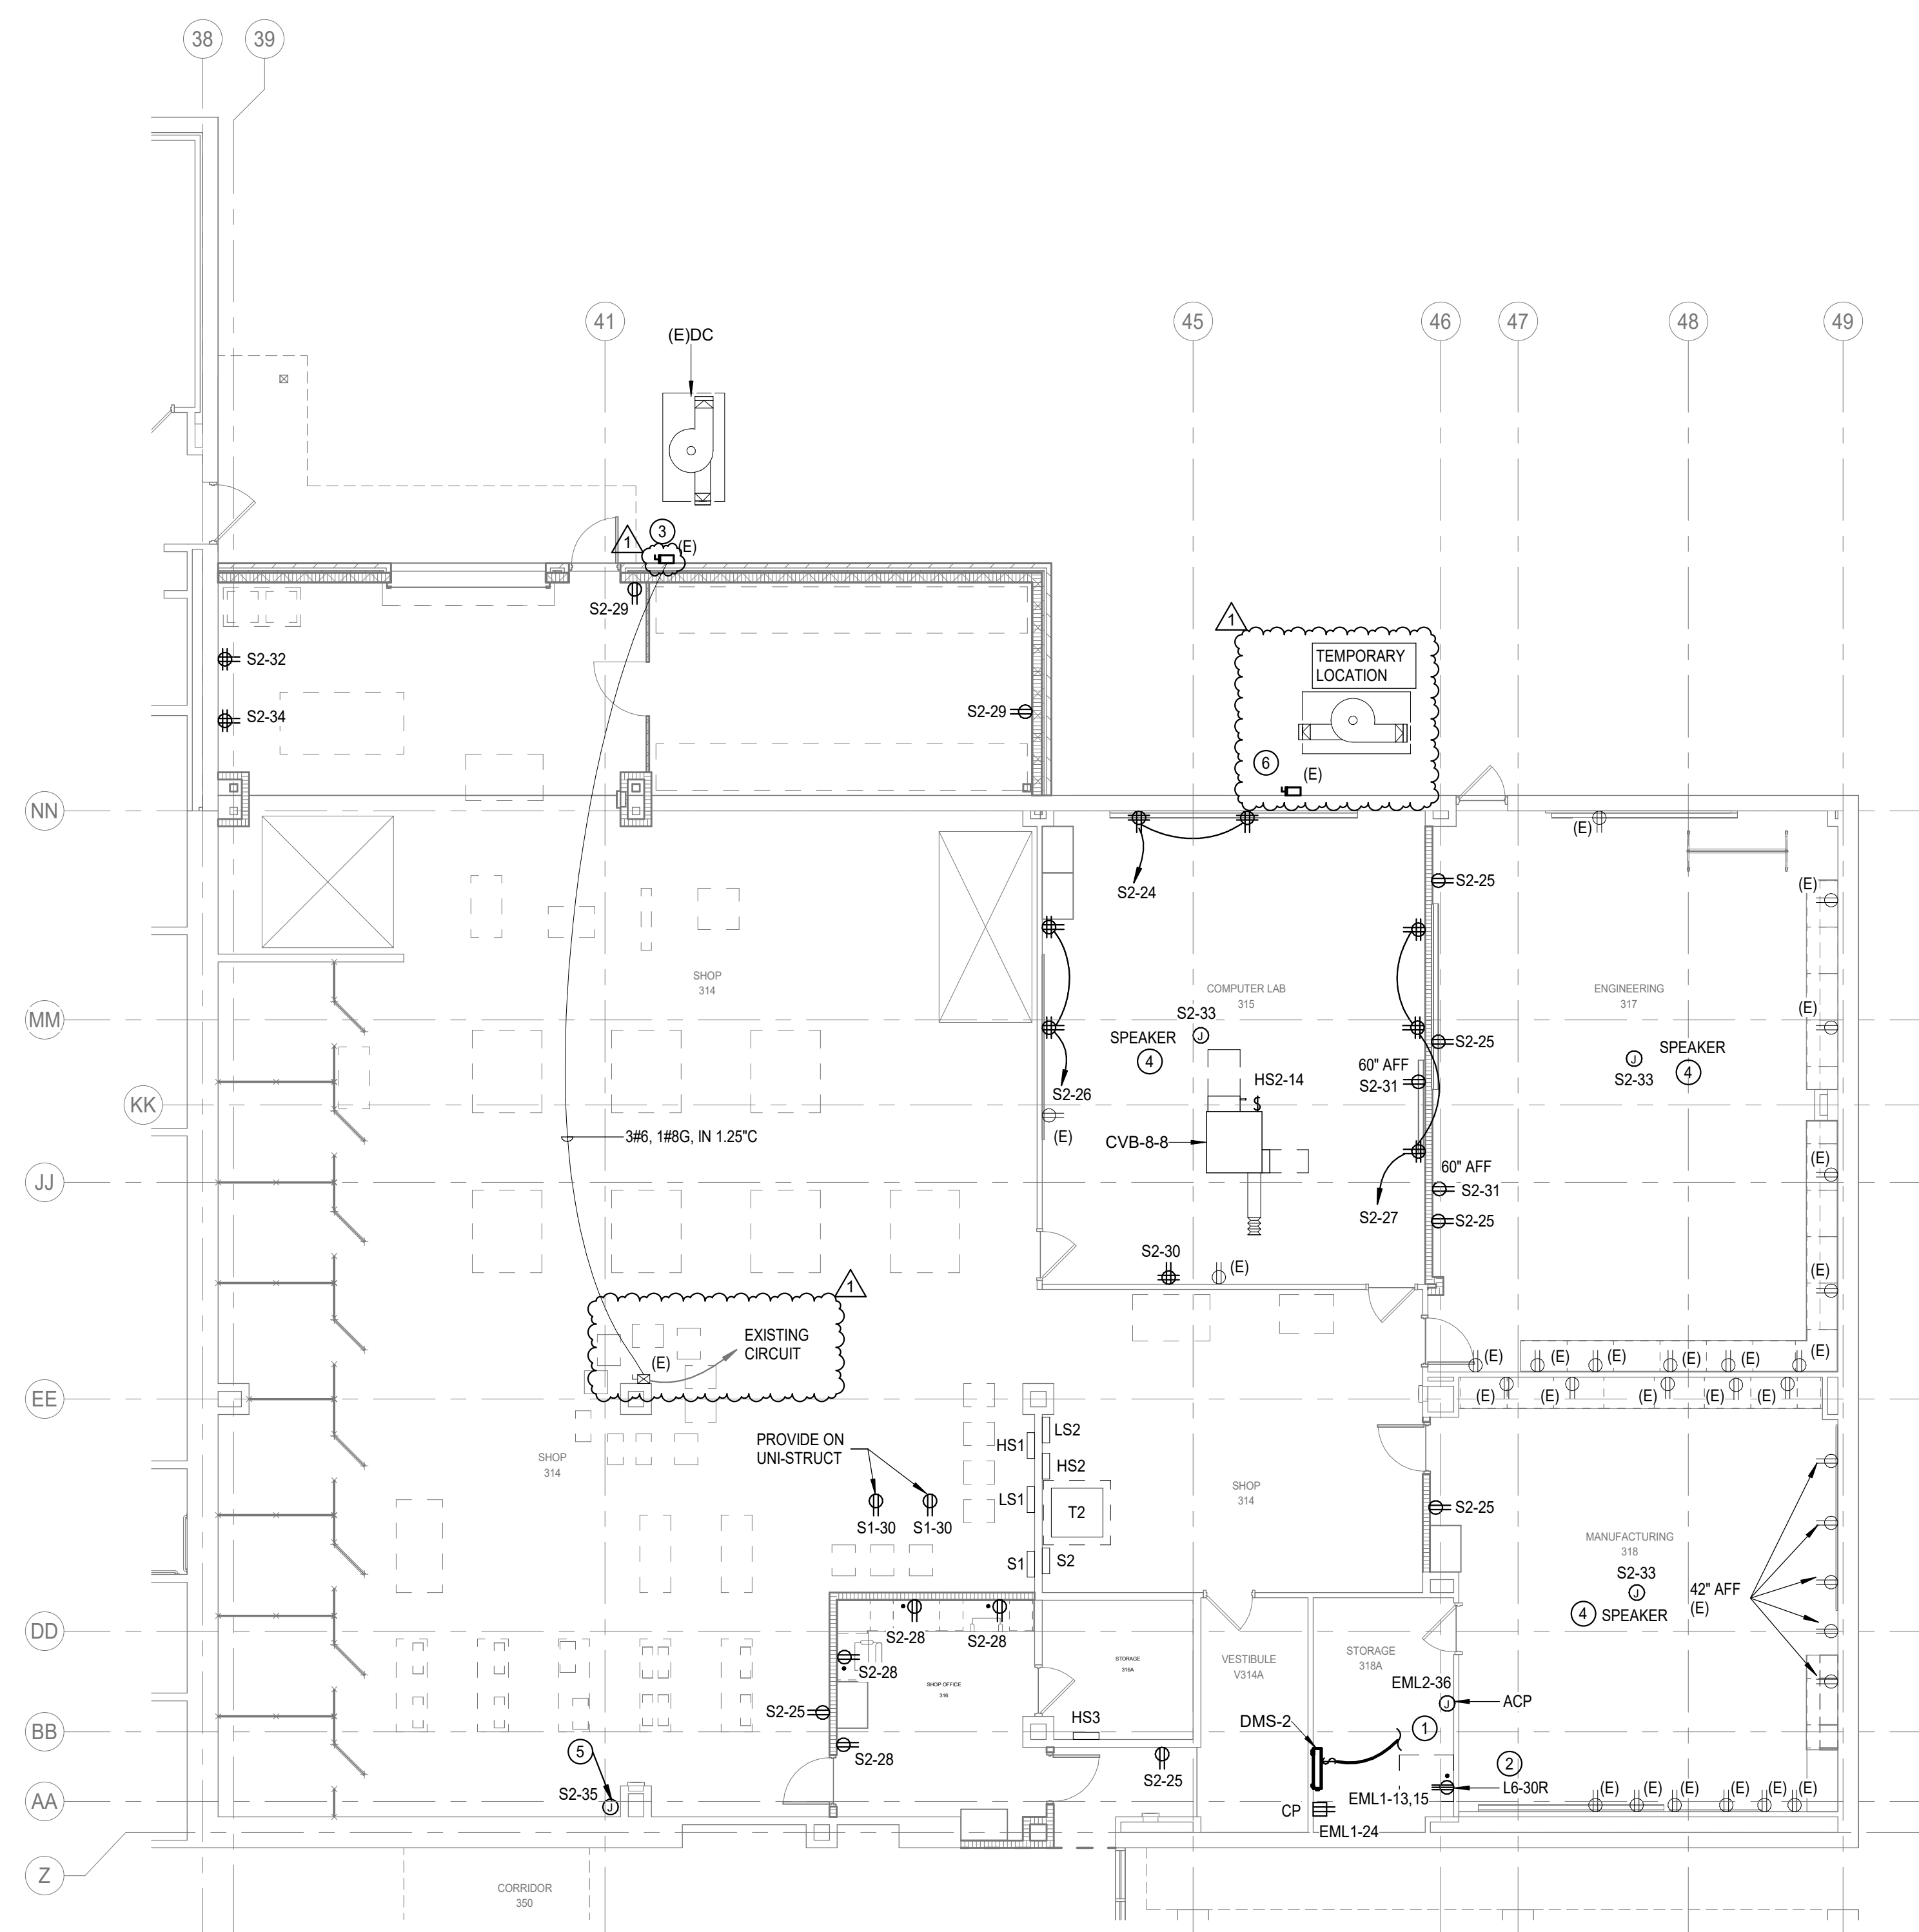


1 ELECTRICAL POWER FLOOR PLAN - LEVEL 1 - C - UNIT D.2
Scale: 1/8" = 1'-0"

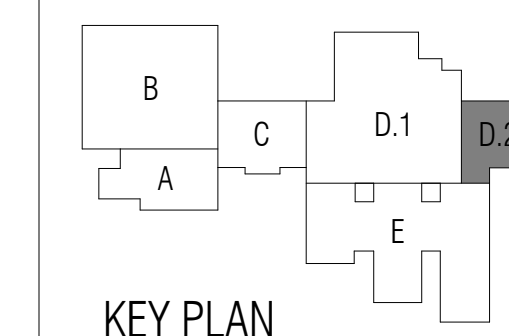

KEY PLAN

Issue For Proposal

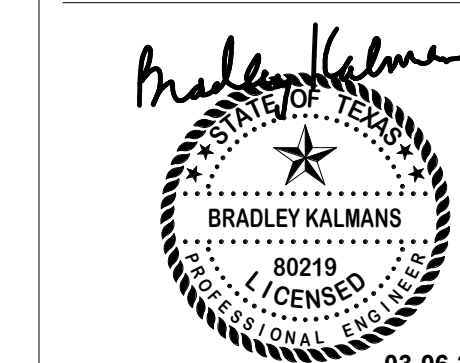

ISSUED: February 24, 2025

REVISIONS	
Revision No.	Revision Date
1	ADDENDUM 01 03-06-2025

Director	MS	Drawn By	SA
Designer	SA	Quality Control	JZ
Proj. Coord.	MS		


PROJECT NO.

24-010.00

SHEET TITLE

COOK - ELECTRICAL POWER FLOOR PLAN - LEVEL 1 - UNIT D.2

SHEET NO.

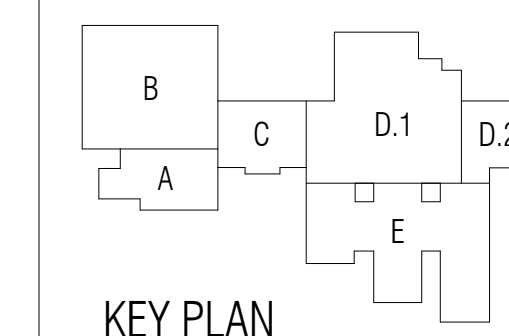

KEY PLAN

Issue For Proposal



ISSUED: February 24, 2025

REVISIONS	
Revision No.	Revision Date
1	ADDENDUM 01 03-06-2025

Director	Drawn By
MS	NY
Designer	Quality Control
NY	
Proj. Coord.	
AS	

PROJECT NO.


24-010.00

SHEET TITLE


COOK - TECHNOLOGY SITE PLAN

SHEET NO.


T11.00

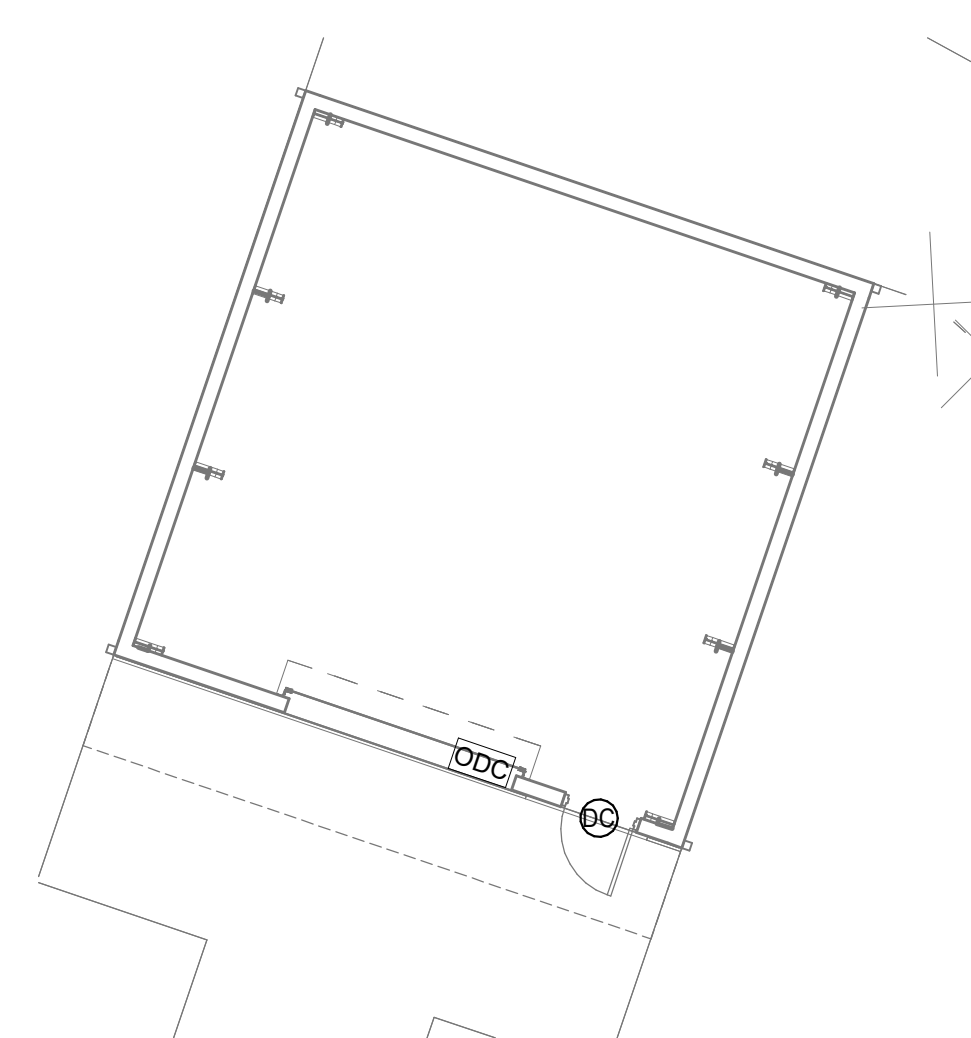

3 TECHNOLOGY ATHLETIC STORAGE
 Scale: 1/8" = 1'-0"

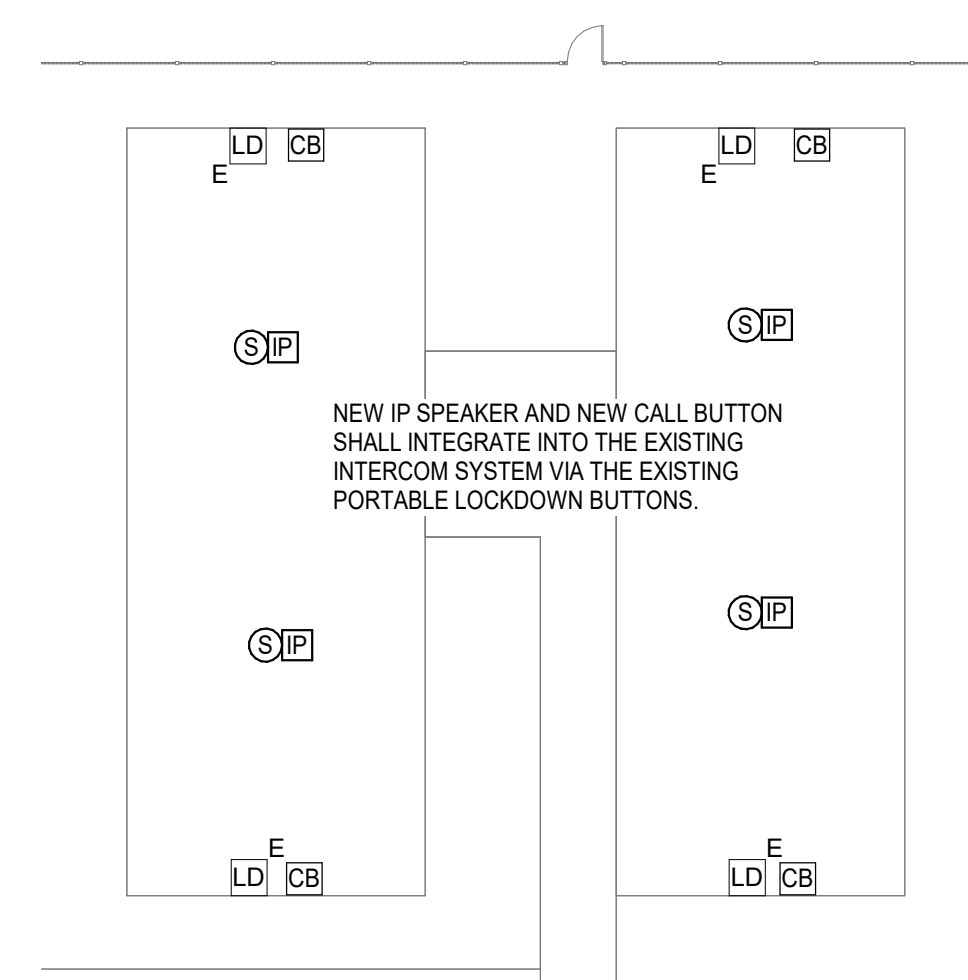

2 TECHNOLOGY - PORTABLES
 Scale: 1/16" = 1'-0"

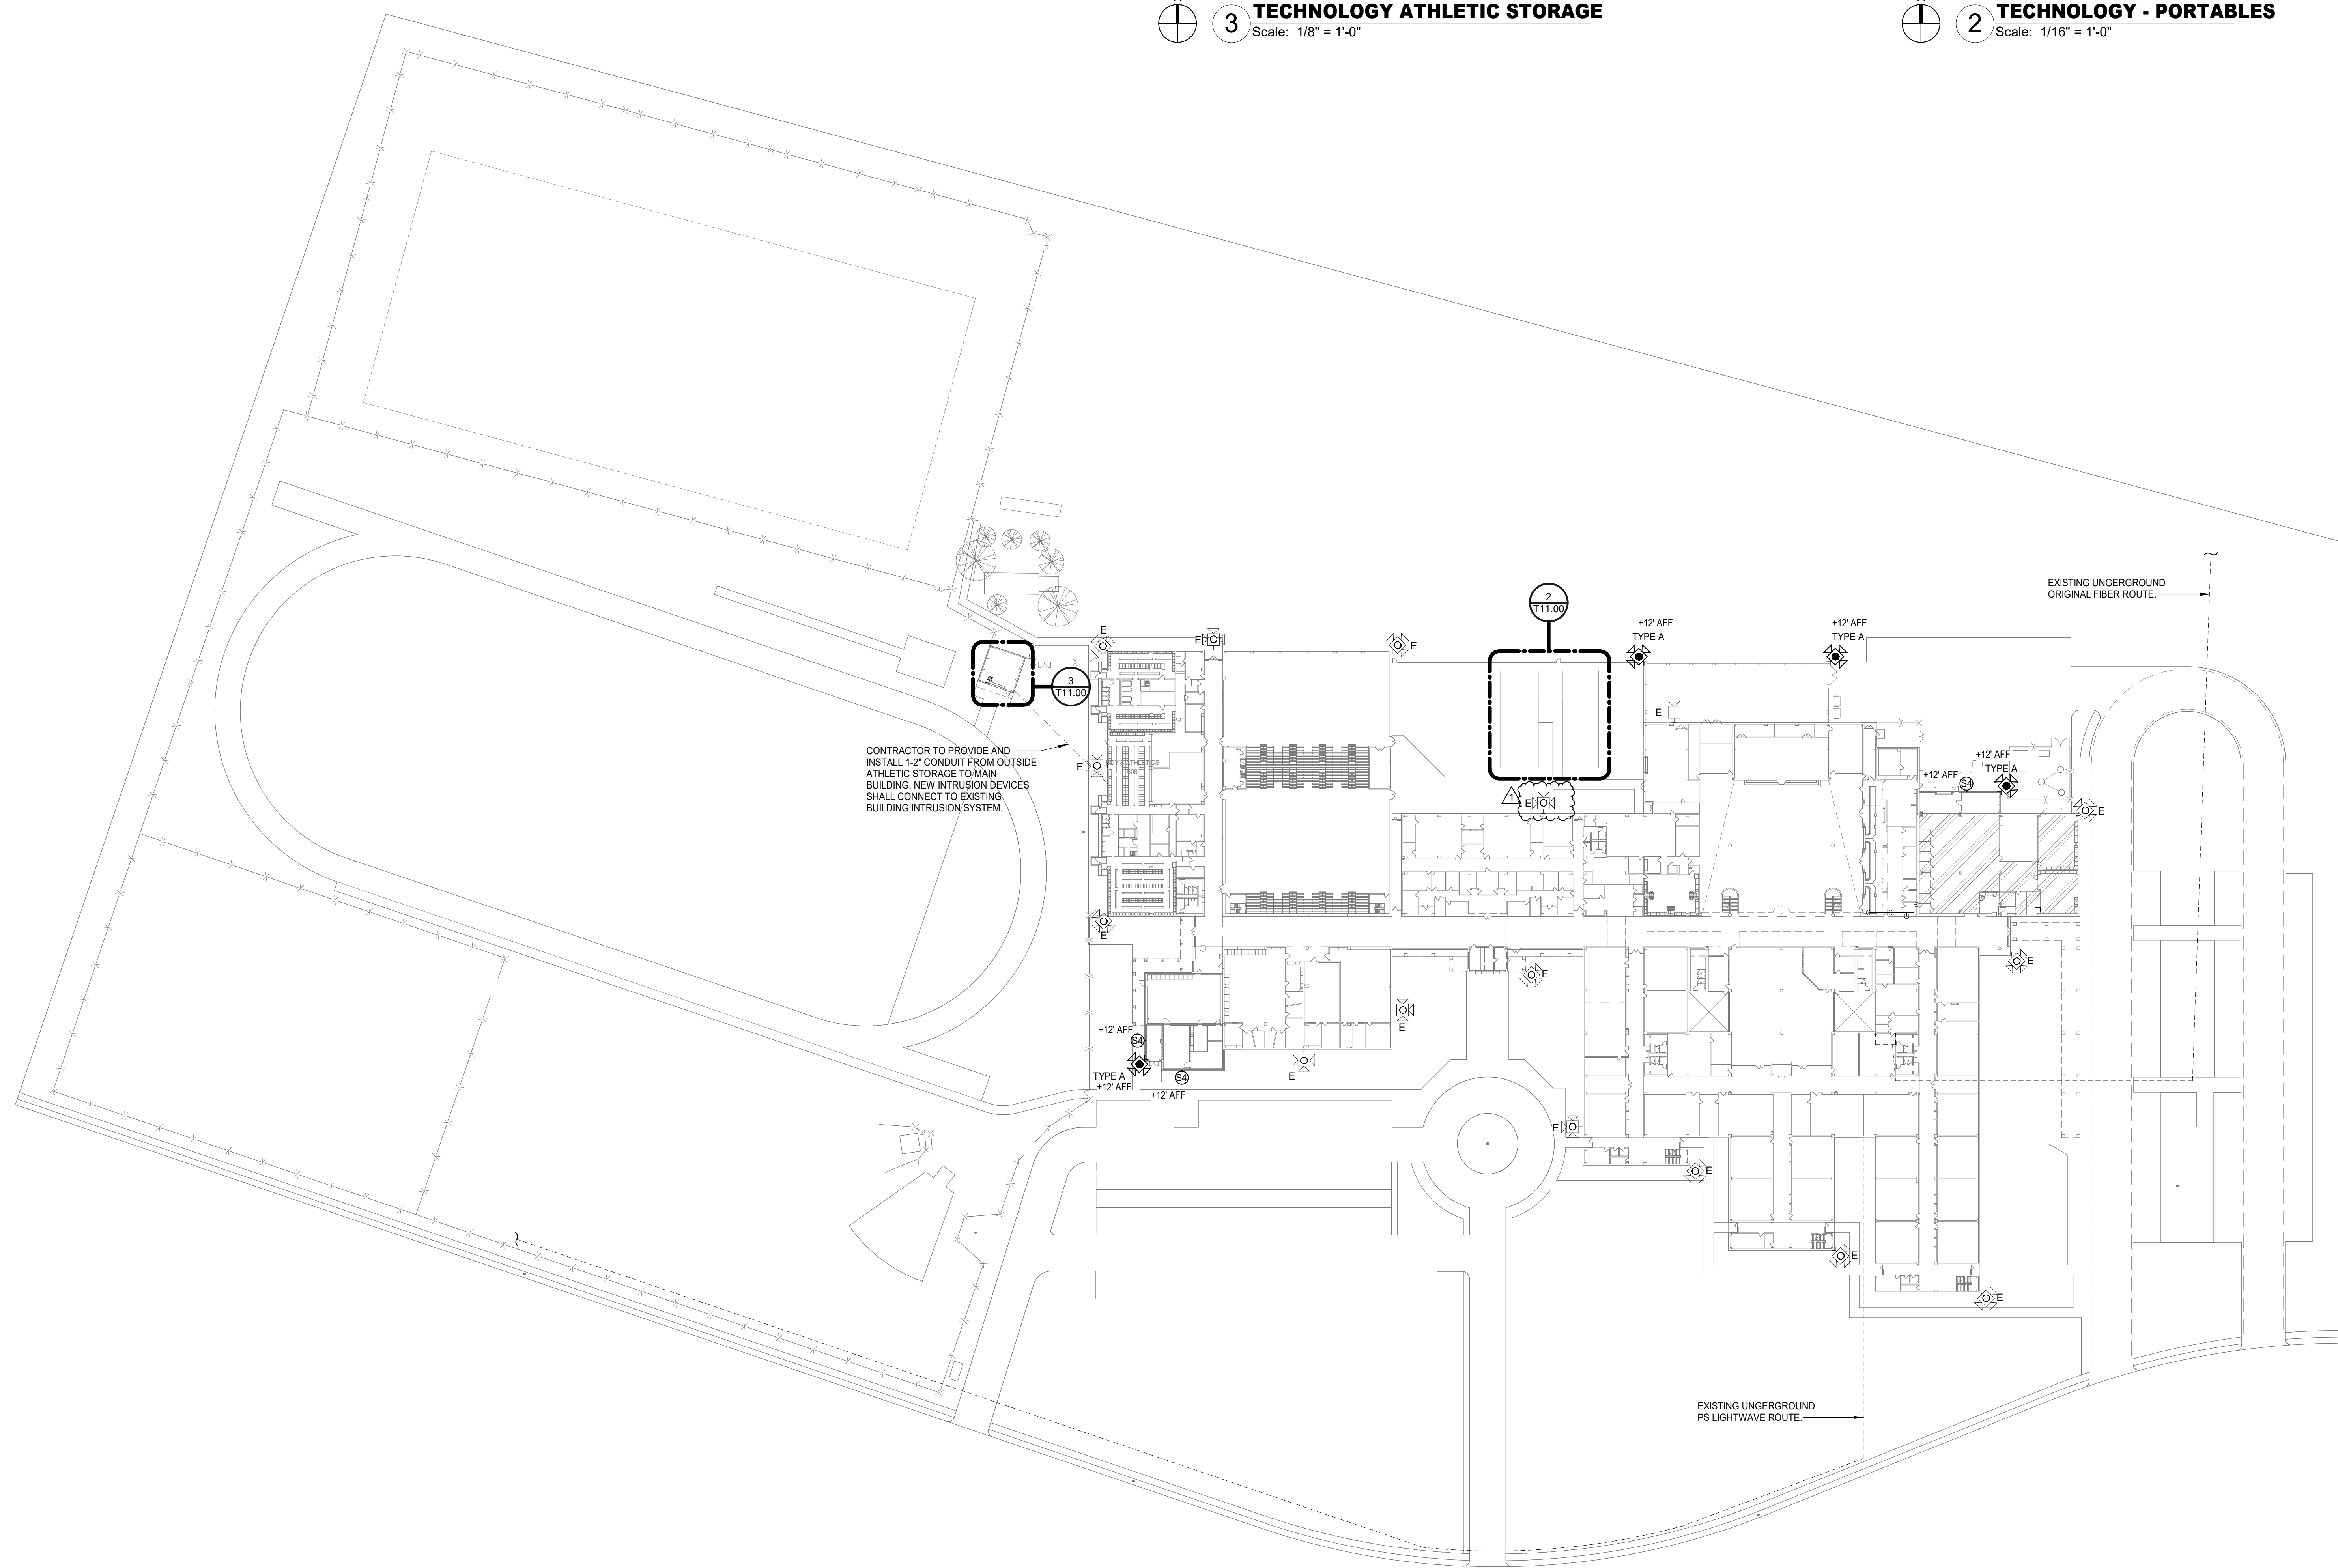


1 TECHNOLOGY SITE PLAN
 Scale: 1" = 50'-0"

CONTRACTOR TO PROVIDE AND INSTALL 1/2" CONDUIT FROM OUTSIDE ATHLETIC STORAGE TO MAIN BUILDING. NEW INTRUSION DEVICES SHALL CONNECT TO EXISTING BUILDING INTRUSION SYSTEM.


Salas O'Brien
 Houston
 10930 W. Sam Houston Pkwy North, Suite 900
 Houston, TX 77064
 Salas O'Brien Registration: F-4111
 Salas O'Brien Project Number: 2024-00901-00

ARCHITECT
VLK Architects
 20445 State Hwy 249, Suite 350
 Houston, Texas 77070
 Main Phone: 281.671.2300
 www.vlkarchitects.com

M.E.P. ENGINEER
Salas O'Brien
 10930 W. Sam Houston Pkwy North
 Houston, Texas 77064
 Main Phone: 281.664.1900
 www.salasobrien.com

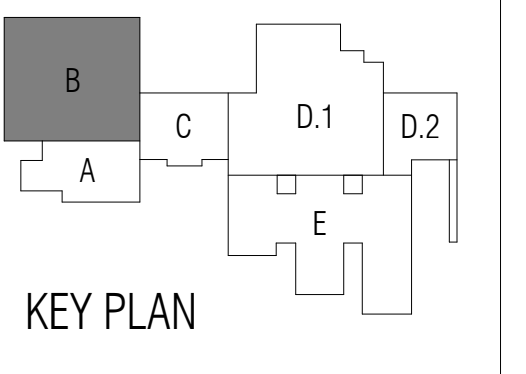

Issue For Proposal

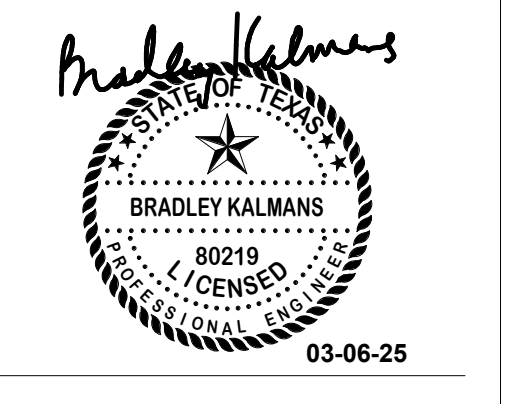

ISSUED: February 24, 2025

REVISIONS	
Revision No.	Revision Date
1	ADDENDUM 01 03-06-2025

Director MS
 Designer NY
 Proj. Coord. AS

Drawn By NY
 Quality Control NY

PROJECT NO.
24-010.00

SHEET TITLE
COOK - TECHNOLOGY FLOOR PLAN - LEVEL 1 - UNIT B

SHEET NO.

T12.02

Salas O'Brien
 Houston
 10930 W. Sam Houston Pkwy North, Suite 900
 Houston, TX 77064
 Salas O'Brien Registration: F-4111
 Salas O'Brien Project Number: 2024-00901-00

FIRE ALARM

A FIRE ALARM SYSTEM IS A PERFORMANCE BASED PER SPECIFICATIONS 28.46.00. CONTRACTOR TO REFERENCE SPECIFICATIONS FOR ADDITIONAL INFORMATION.

B A LICENSED FIRE ALARM PLANNING SUPERINTENDENT CERTIFIED TO A MINIMUM LEVEL 3 IN THE SUBFIELD OF FIRE ALARM SYSTEMS THROUGH THE NATIONAL INSTITUTE FOR CERTIFICATION IN ENGINEERING TECHNOLOGIES (NICET), SHALL PROVIDE PLANS AND CALCULATIONS FOR A MANUAL AND AUTOMATIC FIRE DETECTION AND ALARM SYSTEM TO COMPLY WITH THE BUILDING SPACE LAYOUT BUILDING OCCUPANCY, CURRENT NFPA 72, LOCAL AND STATE CODE REQUIREMENTS, AND THE FIRE ALARM AND DETECTION SYSTEM SPECIFICATIONS.

TECHNOLOGY PLAN GENERAL NOTES

A COORDINATE ALL FINAL MOUNTING HEIGHTS, FOR WALL MOUNTED DEVICES, PRIOR TO ROUGH-IN. COORDINATE WITH ARCHITECT, OWNER AND ENGINEER.

B COORDINATE ALL CEILING DEVICE LOCATIONS WITH ARCHITECTURAL DRAWINGS AND INTERIOR DESIGN CONSULTANT (IF APPLICABLE) PRIOR TO ROUGH-IN.

C REFERENCE TECHNOLOGY SITE PLAN, COMPOSITE, NOTES & LEGENDS AND DETAILS FOR ADDITIONAL INFORMATION AND DEVICE/OUTLET LOCATIONS.

D CONTRACTOR TO COORDINATE INTERCOM SPEAKER MOUNTING TYPES WITH ARCHITECTURAL CEILING PLANS PRIOR TO FINAL SPEAKER SELECTION. COORDINATE WITH ENGINEER ON ANY DISCREPANCIES.

E CONTRACTOR TO COORDINATE ALL DROP LOCATIONS WITH FURNITURE. COORDINATE WITH ARCHITECT AND OWNER FOR MORE INFORMATION.


F ALL EXISTING LOCKDOWN BUTTONS THAT ARE BEING REUSED SHALL HAVE EXISTING WIRING DEMOLISHED AND REPLACED BY CONTRACTOR WITH HOME RUNS TO HEAD END.

G NEW DATA CABLING IN EXISTING ROOMS SHALL REUSE EXISTING DATA CABLING RACEWAY AND BACKBOXES UNLESS NOTED OTHERWISE, PROVIDE AND INSTALL NEW FACEPLATES.

H DATA CABLING TO MECHANICAL ROOMS SHALL BE REPLACED ONE TO ONE. CONTRACTOR TO REUSE EXISTING RACEWAY AND BACKBOXES. PROVIDE AND INSTALL NEW FACEPLATES.

I ALL EXISTING CLASSROOM CALL BUTTONS SHALL BE DISCONNECTED FROM EXISTING SPEAKERS AND RECONNECTED TO NEW IP SPEAKERS. CONTRACTOR TO FIELD VERIFY EXISTING CLASSROOM CB LOCATIONS.

J GC TO COORDINATE WITH EC AND STRUCTURED CABLING CONTRACTOR ON REQUIRED PATHWAYS AND PENETRATIONS FOR NEW DATA CABLING INSTALLATION.

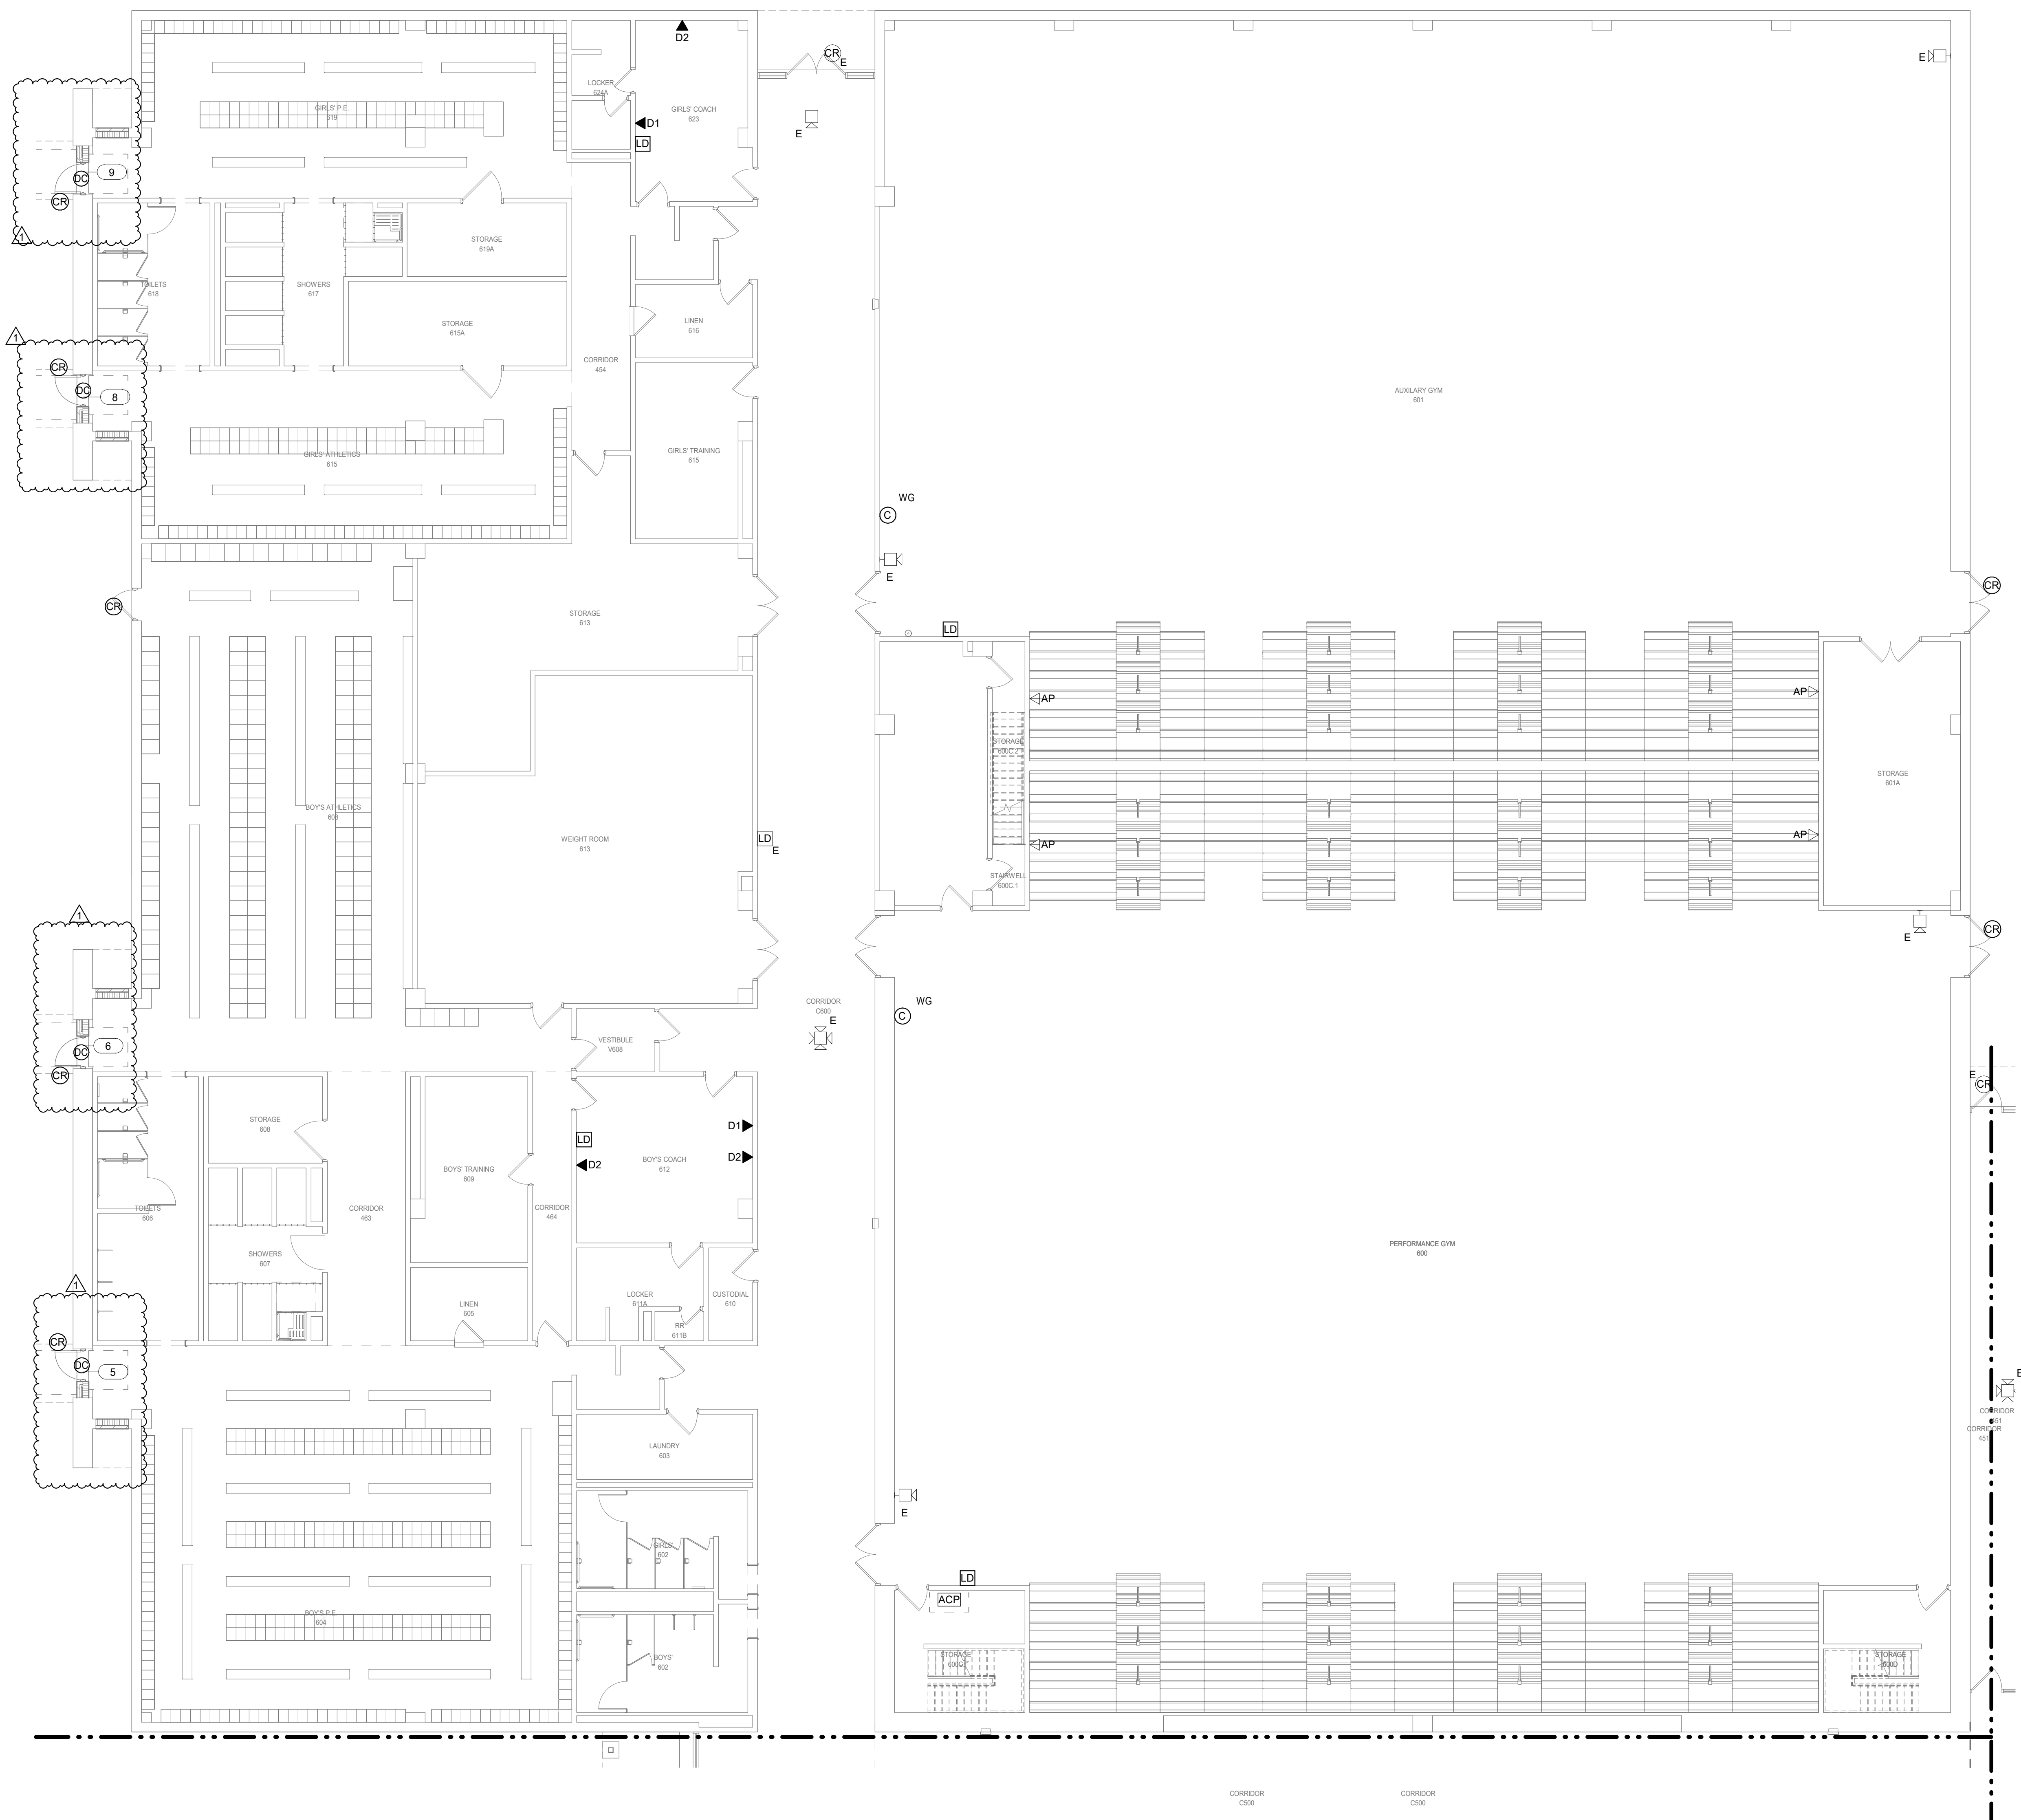


1 TECHNOLOGY FLOOR PLAN - LEVEL 1 - C - UNIT B
 Scale: 1/8" = 1'-0"

ARCHITECT


VLK Architects
 20445 State Hwy 249, Suite 350
 Houston, Texas 77070
 Main Phone: 281.671.2300
 www.vlkarchitects.com

M.E.P. ENGINEER


Salas O'Brien
 10930 W. Sam Houston Pkwy North
 Houston, Texas 77064
 Main Phone: 281.664.1900
 www.salasobrien.com

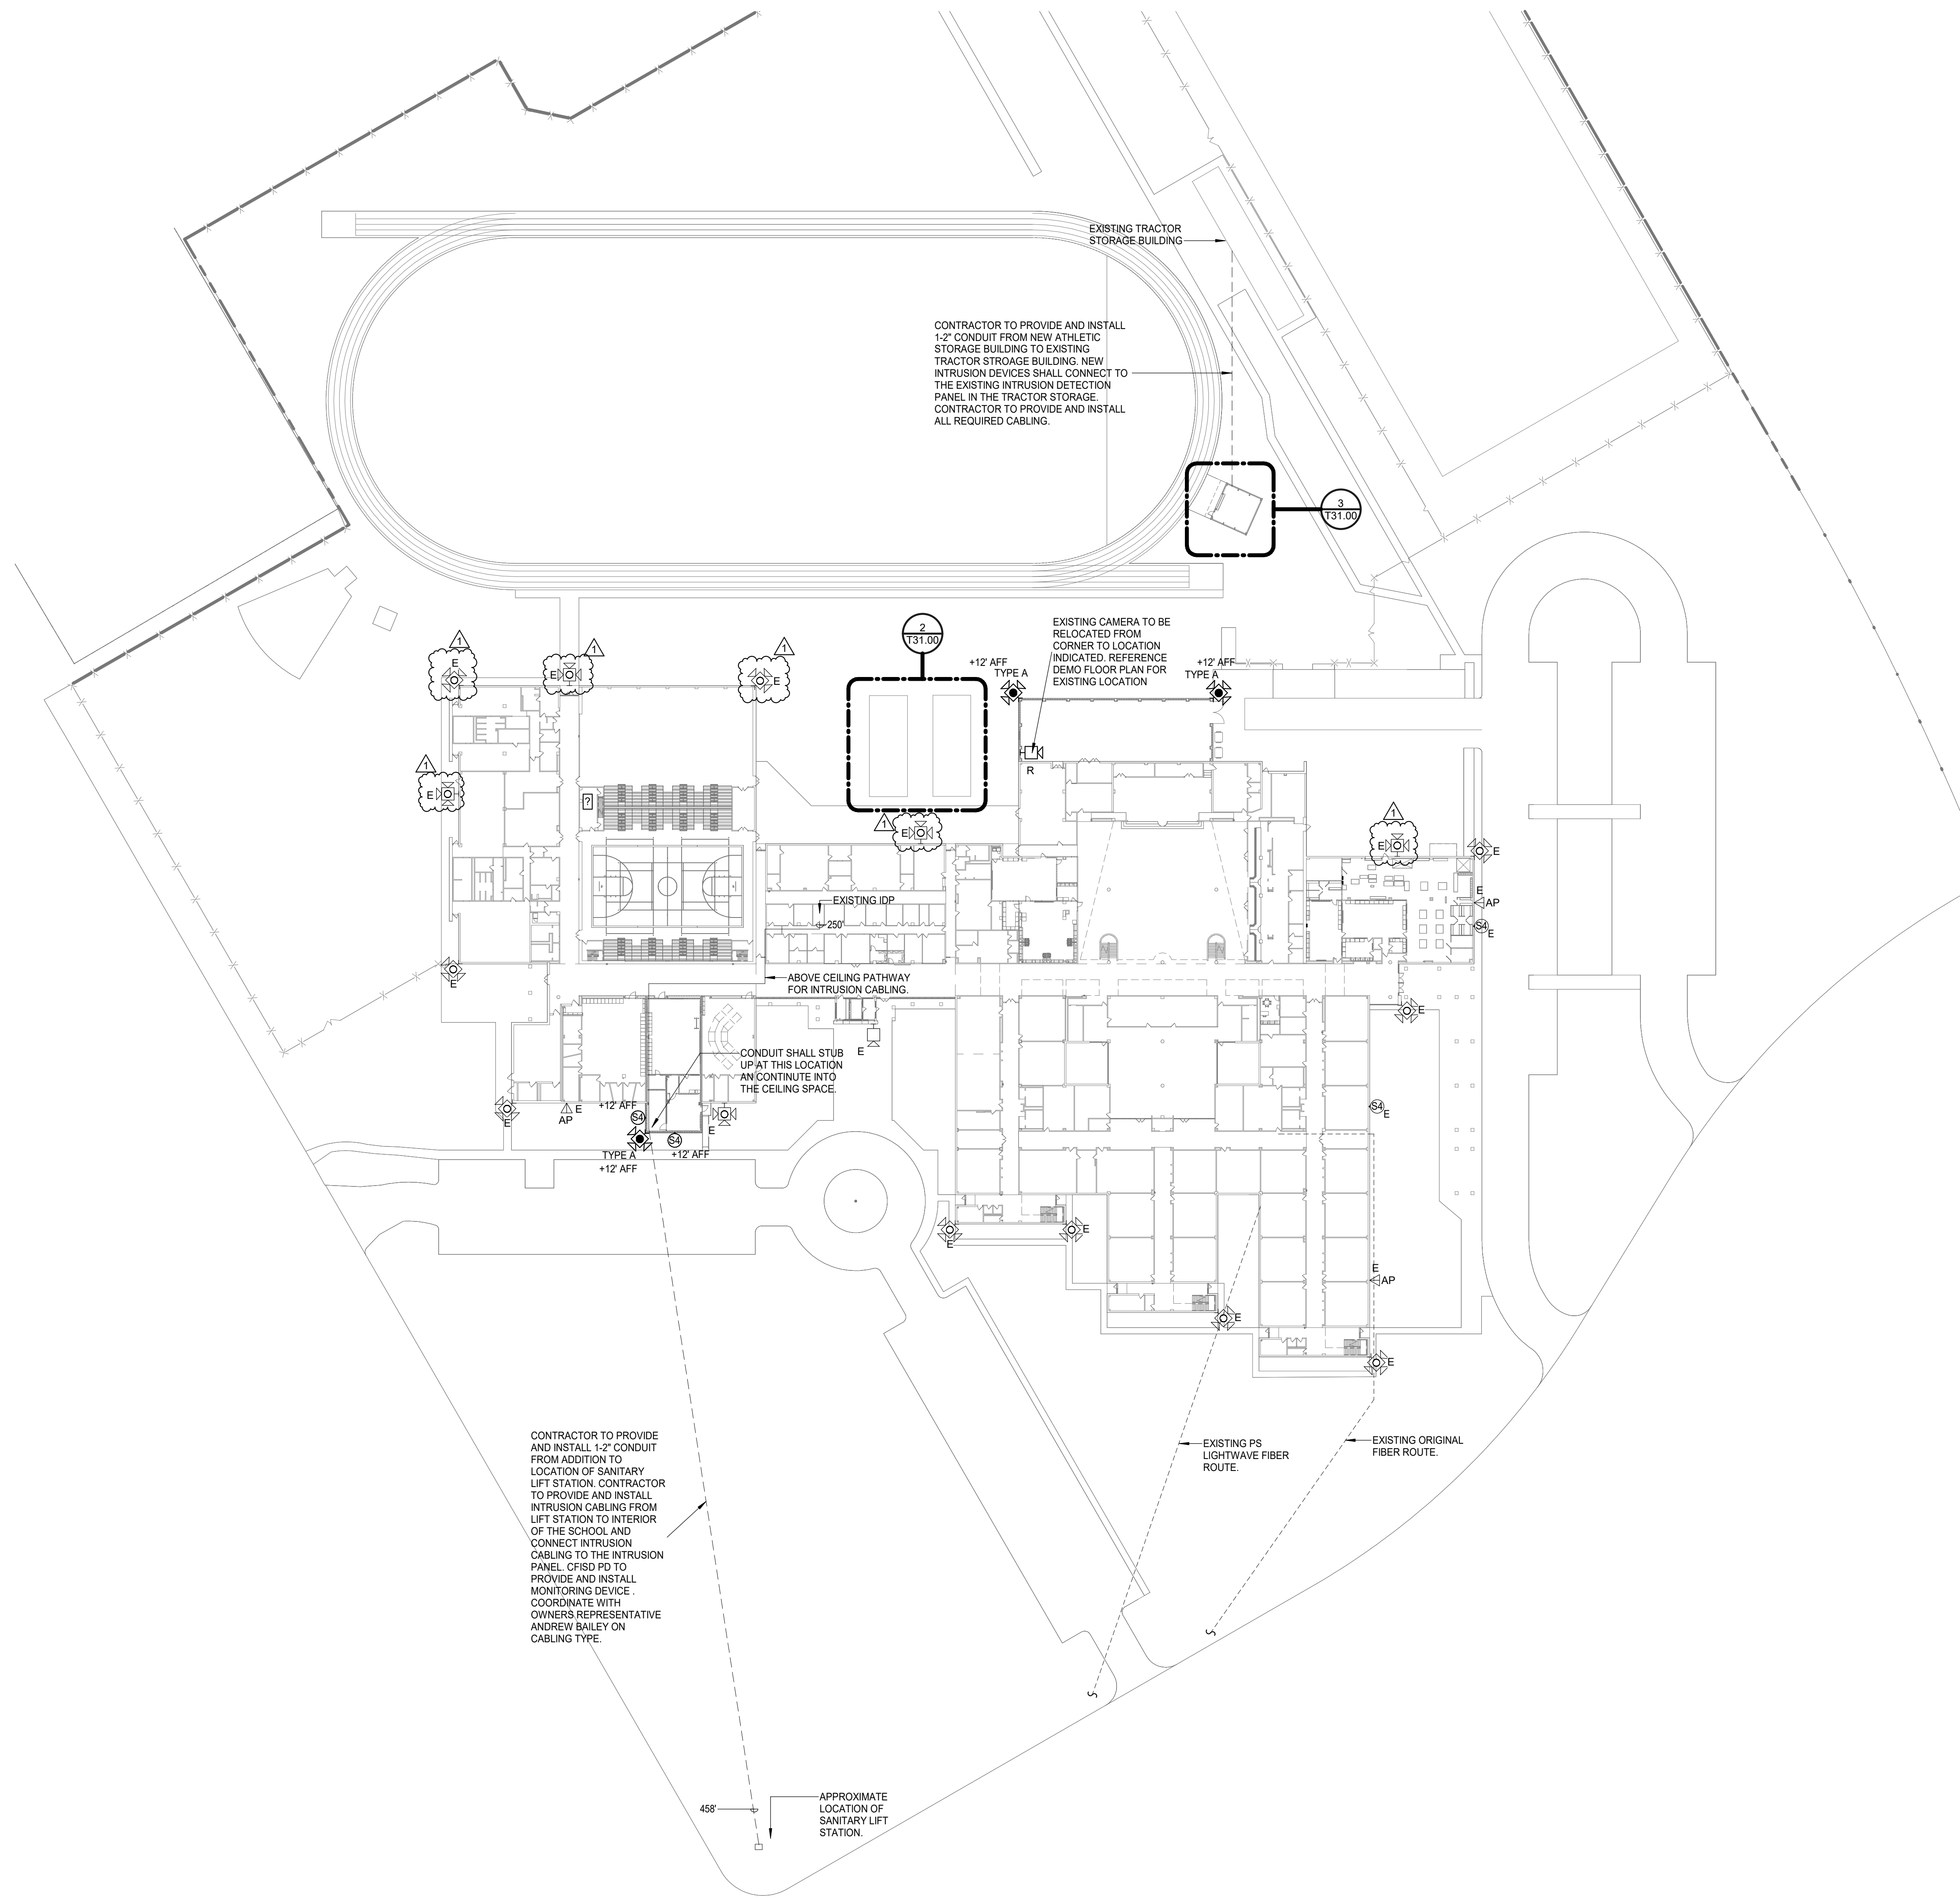

1 TECHNOLOGY SITE PLAN
 Scale: 1" = 50'-0"

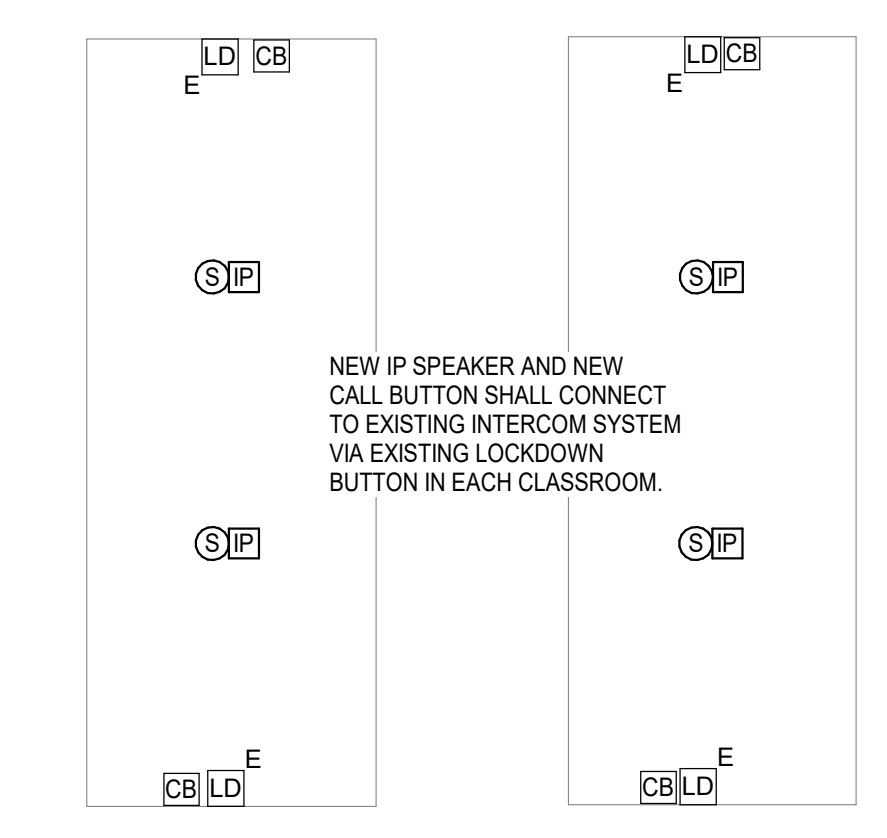


2 TECHNOLOGY - PORTABLE BUILDINGS
 Scale: 1/16" = 1'-0"

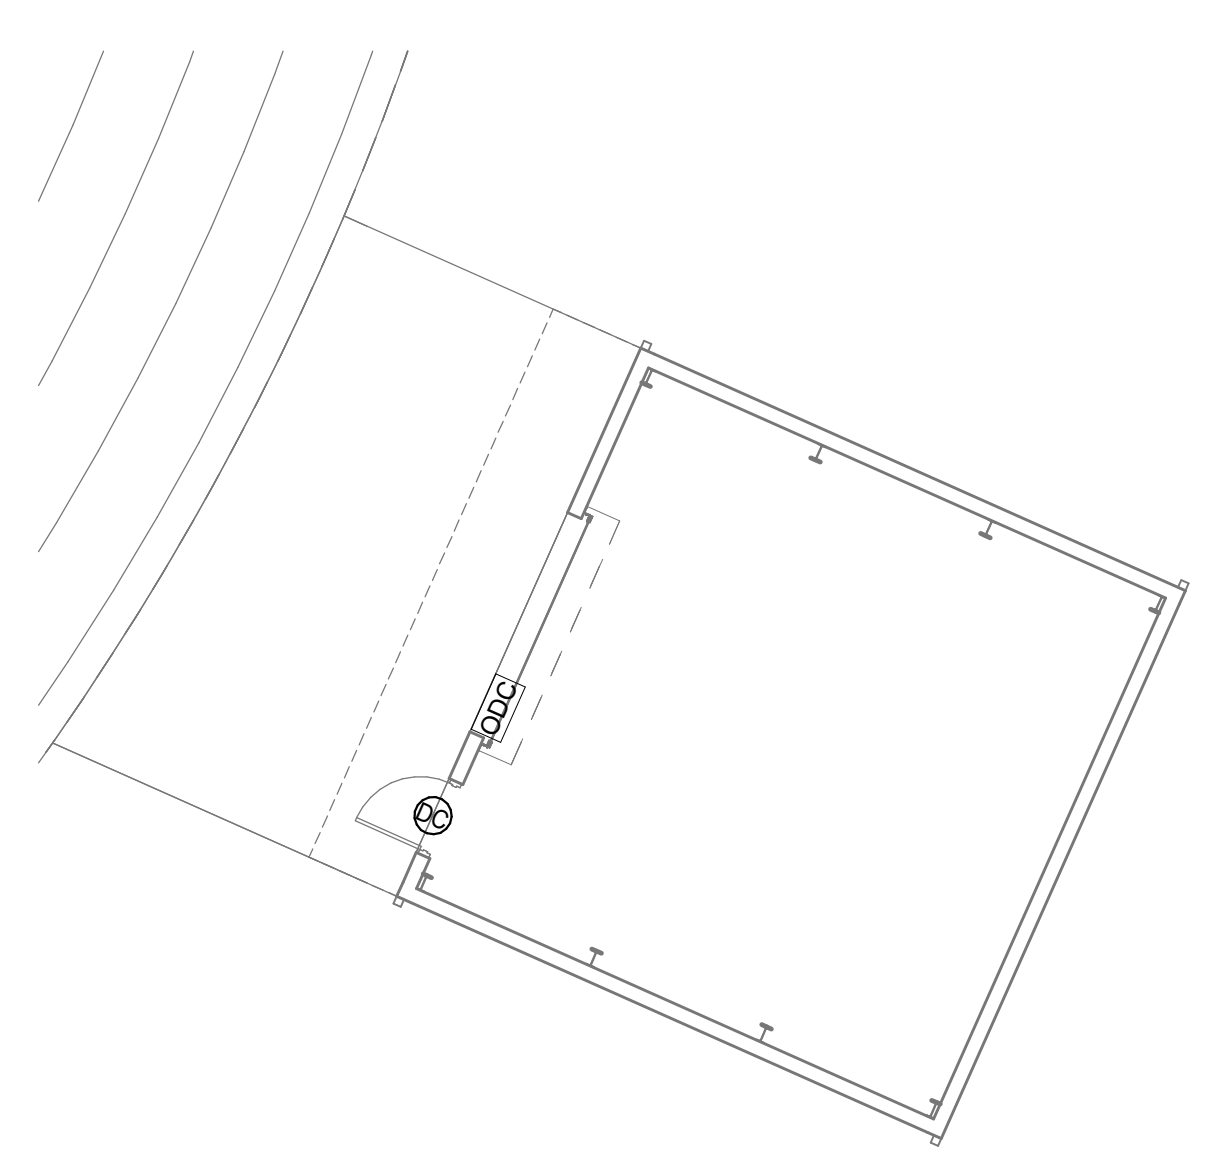

3 TECHNOLOGY SITE PLAN - ATHLETIC STORAGE
 Scale: 1/8" = 1'-0"

TECHNOLOGY SITE PLAN GENERAL NOTES

A CONTRACTOR TO PROTECT EMERGENCY RADIO SYSTEM ANTENNAS, DEVICES AND CABLING. EXISTING EMERGENCY RADIO ANTENNA LOCATED ON ROOF.

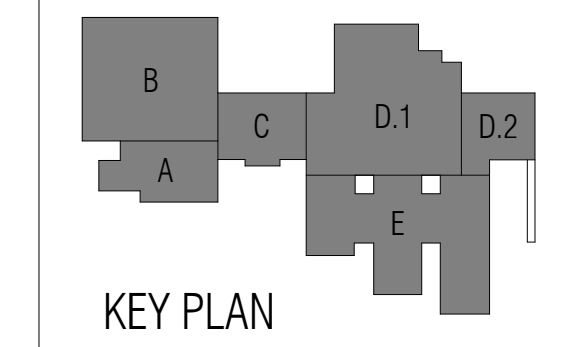

Issue For Proposal

Bradley Kalman
 BRADLEY KALMANS
 80218
 03-06-25

ISSUED: February 24, 2025

REVISIONS	
Revision No.	Revision Date
1	ADDENDUM 01 03-06-2025

Director MS
 Designer NY
 Proj. Coord. AY

Drawn By NY
 Quality Control AY

PROJECT NO.
24-010.00

SHEET TITLE
 TRUITT - TECHNOLOGY SITE PLAN

SHEET NO.

Salas O'Brien
 Houston
 10930 W. Sam Houston Pkwy North, Suite 900
 Houston, TX 77064
 Salas O'Brien Registration: F-4111
 Salas O'Brien Project Number: 2024-00901-00

T31.00

ABATEMENT PLAN GENERAL NOTES:


1. ABATEMENT PLANS WERE DERIVED FROM EXISTING BUILDING PLANS AND ARE INTENDED TO REASONABLY PRESENT EXISTING CONDITIONS. ABATEMENT CONTRACTOR SHALL VERIFY ACTUAL CONDITIONS AND COORDINATE ABATEMENT AND DEMOLITION WORK.
2. REFERENCE ARCHITECT'S DEMOLITION SPECIFICATIONS AND DRAWINGS FOR DEMOLITION REQUIREMENTS AND EXISTING BUILDING DRAWINGS FOR BUILDING CONSTRUCTION CONDITIONS.
3. THESE DRAWINGS ARE REPRESENTATIVE OF TYPICAL CONDITIONS IN THE BUILDING. HOWEVER, THE LOCATIONS OF ALL ASBESTOS CONTAINING MATERIALS ARE NOT SHOWN. ABATEMENT CONTRACTOR SHALL VERIFY ALL EXISTING CONDITIONS IN THE AREAS TO BE ABATED AND THE LOCATIONS OF ALL ASBESTOS-CONTAINING MATERIALS.
4. ABATEMENT CONTRACTOR SHALL BE RESPONSIBLE FOR ABATEMENT OF ALL ASBESTOS-CONTAINING MATERIALS.
5. THE ASBESTOS ABATEMENT SCOPE OF WORK IS DESCRIBED IN THE ABATEMENT SPECIFICATIONS. THE ASBESTOS ABATEMENT SCOPE OF WORK SHALL ALSO INCLUDE ANY HIDDEN ASBESTOS-CONTAINING MATERIALS THAT MAY BE ASSUMED OR UNCOVERED DURING THE BUILDING SELECTIVE DEMOLITION ACTIVITIES. THE ASBESTOS-CONTAINING MATERIALS IDENTIFIED IN THE BUILDING INCLUDE, AS A MINIMUM, THE FOLLOWING MATERIALS: INTERIOR ASBESTOS-CONTAINING MATERIALS: BLACK DAMPPROOFING MASTICS AND ANY ASSOCIATED FLASHINGS; EXTERIOR ASBESTOS-CONTAINING MATERIALS: BLACK DAMPPROOFING MASTICS AND ANY ASSOCIATED FLASHINGS.
6. ABATEMENT CONTRACTOR SHALL BE RESPONSIBLE FOR DETERMINING AND VERIFYING THE ACTUAL QUANTITIES OF ALL ASBESTOS-CONTAINING MATERIALS AND OTHER REGULATED MATERIALS THAT WILL BE ABATED UNDER THE IDENTIFIED SCOPE OF WORK. WHILE SOME OF THE EXISTING AREAS OF ASBESTOS-CONTAINING MATERIALS ARE ACCESSIBLE OR EXPOSED, OTHER AREAS OF ASBESTOS-CONTAINING MATERIALS MAY BE "HIDDEN" (E.G. LOCATED ABOVE CEILINGS, IN WALLS OR CHASES, UNDER CARPET OR OTHER FLOOR FINISH MATERIALS, ABOVE AND/OR UNDER WALLS, MILLWORK, ETC.). ALL "HIDDEN" AREAS OF ASBESTOS-CONTAINING MATERIALS IN AREAS SCHEDULED FOR DEMOLITION IN THE SUBJECT BUILDING SHALL BE UNCOVERED AND ABATED BY THE ABATEMENT CONTRACTOR AS PART OF THE PROJECT SCOPE OF WORK.
7. PERFORM SELECTIVE DEMOLITION OF WALL AREAS, CEILING AREAS, FLOOR AREAS, CHASE AREAS, ETC. AS REQUIRED TO UNCOVER AND LOCATE ALL "HIDDEN" AREAS OF ASBESTOS-CONTAINING MATERIALS IN AREAS SCHEDULED FOR DEMOLITION IN THE SUBJECT BUILDING.
8. FOR INTERIOR OR EXTERIOR WALL OPENINGS THAT IMPACT ASBESTOS CONTAINING MATERIALS, THE GENERAL CONTRACTOR IS RESPONSIBLE FOR IDENTIFYING AND MARKING OFF ANY NEW WALL OPENING LOCATIONS FOR THE ABATEMENT CONTRACTOR.

ABATEMENT PLAN KEYED NOTES:

1. DAMP PROOFING BLACK MASTIC APPLIED TO EXTERIOR CMU BLOCK AND ANY ASSOCIATED FLASHING/MASTIC AROUND DOORS/WINDOWS AND AT COLUMNS, BEAMS OR BRICK LEDGES IN THIS AREA ARE TO BE ABATED. (NESHAP METHODS) REFER TO THE ARCHITECTURAL DRAWINGS FOR EXACT SCOPE OF DEMOLITION AND REMOVAL. FIELD VERIFY ALL COMPONENTS TO BE DEMOLISHED.
2. DAMP PROOFING BLACK MASTIC APPLIED TO INTERIOR (ONCE EXTERIOR WALL) CMU BLOCK AND ANY ASSOCIATED FLASHING/MASTIC AROUND DOORS/WINDOWS AND ON COLUMNS, BEAMS OR BRICK LEDGES IN THIS AREA ARE TO BE ABATED. (THAPR - FULL CONTAINMENT) REFER TO THE ARCHITECTURAL DRAWINGS FOR EXACT SCOPE OF DEMOLITION AND REMOVAL. FIELD VERIFY ALL COMPONENTS TO BE DEMOLISHED.
3. DAMP PROOFING BLACK MASTIC APPLIED TO THRU WALL FLASHING OR ON BRICK IN THIS AREA ARE TO BE ABATED (NESHAP METHODS). REFER TO THE ARCHITECTURAL DRAWINGS FOR EXACT SCOPE OF DEMOLITION AND REMOVAL. FIELD VERIFY ALL COMPONENTS TO BE DEMOLISHED.

ASBESTOS LEGEND (LOCATION PURPOSES ONLY)

BLACK MASTIC DAMP PROOFING AND ASSOCIATED FLASHING APPLIED TO CMU BLOCK (MAY BE APPLIED TO COLUMNS, BEAMS, DOOR/WINDOW FLASHING, THRU-WALL FLASHING AND/OR BRICK LEDGE FLASHING).

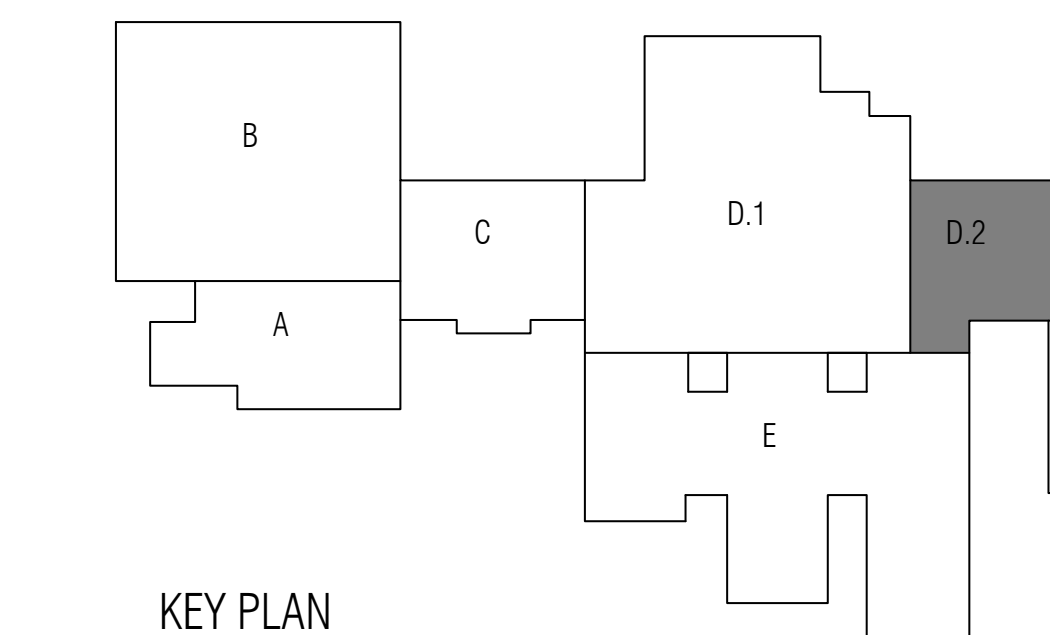

Issue For Proposal

SAM HUFF TDSHS# 105902
SAM.HUFF@EFIGLOBAL.COM
EFI PROJECT#: 029.07283

ISSUED: February 28, 2025

REVISIONS	
Revision No.	Revision Date
ADDENDUM #01	MARCH 6, 2025

Director RA
Designer
Proj. Coord.

Drawn By SH
Quality Control

EFI PROJECT NO.


029.07283

SHEET TITLE


COOK - UNIT D.2
ABATEMENT PLAN - LEVEL ONE

SHEET NO.

ABT1.D.2

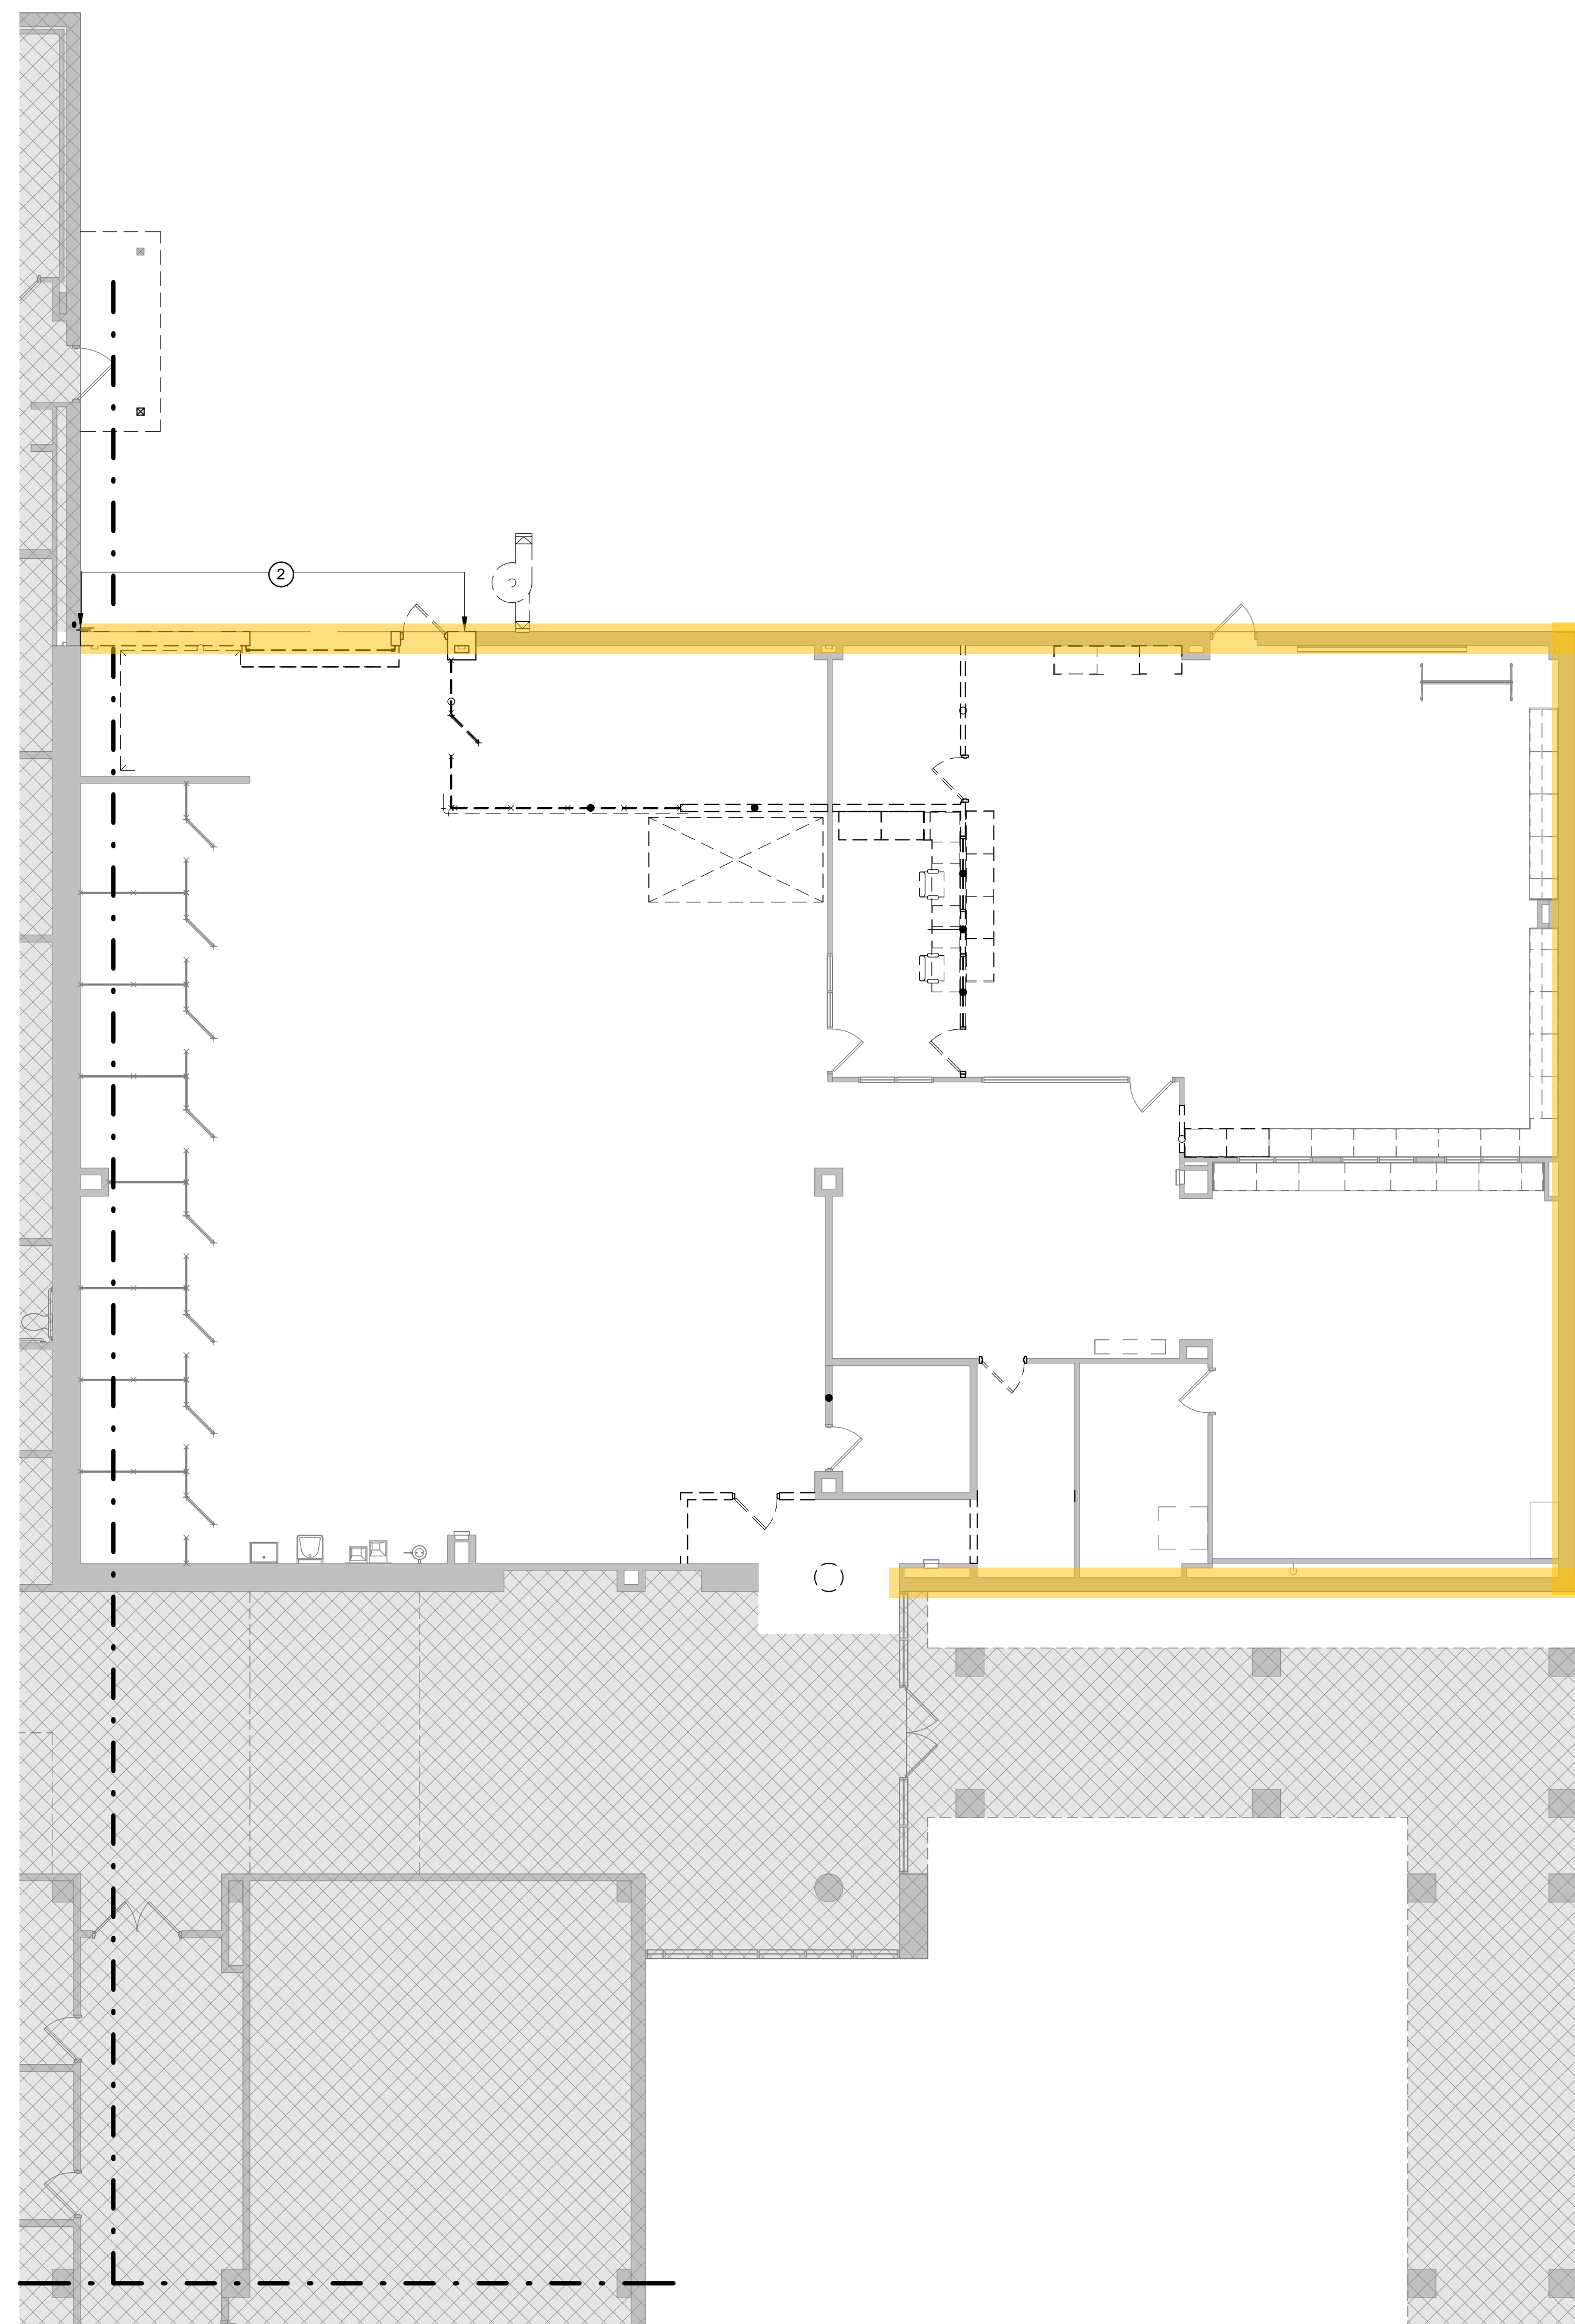

1 UNIT "D.2" ABATEMENT PLAN - LEVEL ONE
SCALE: 1/8" = 1'-0"

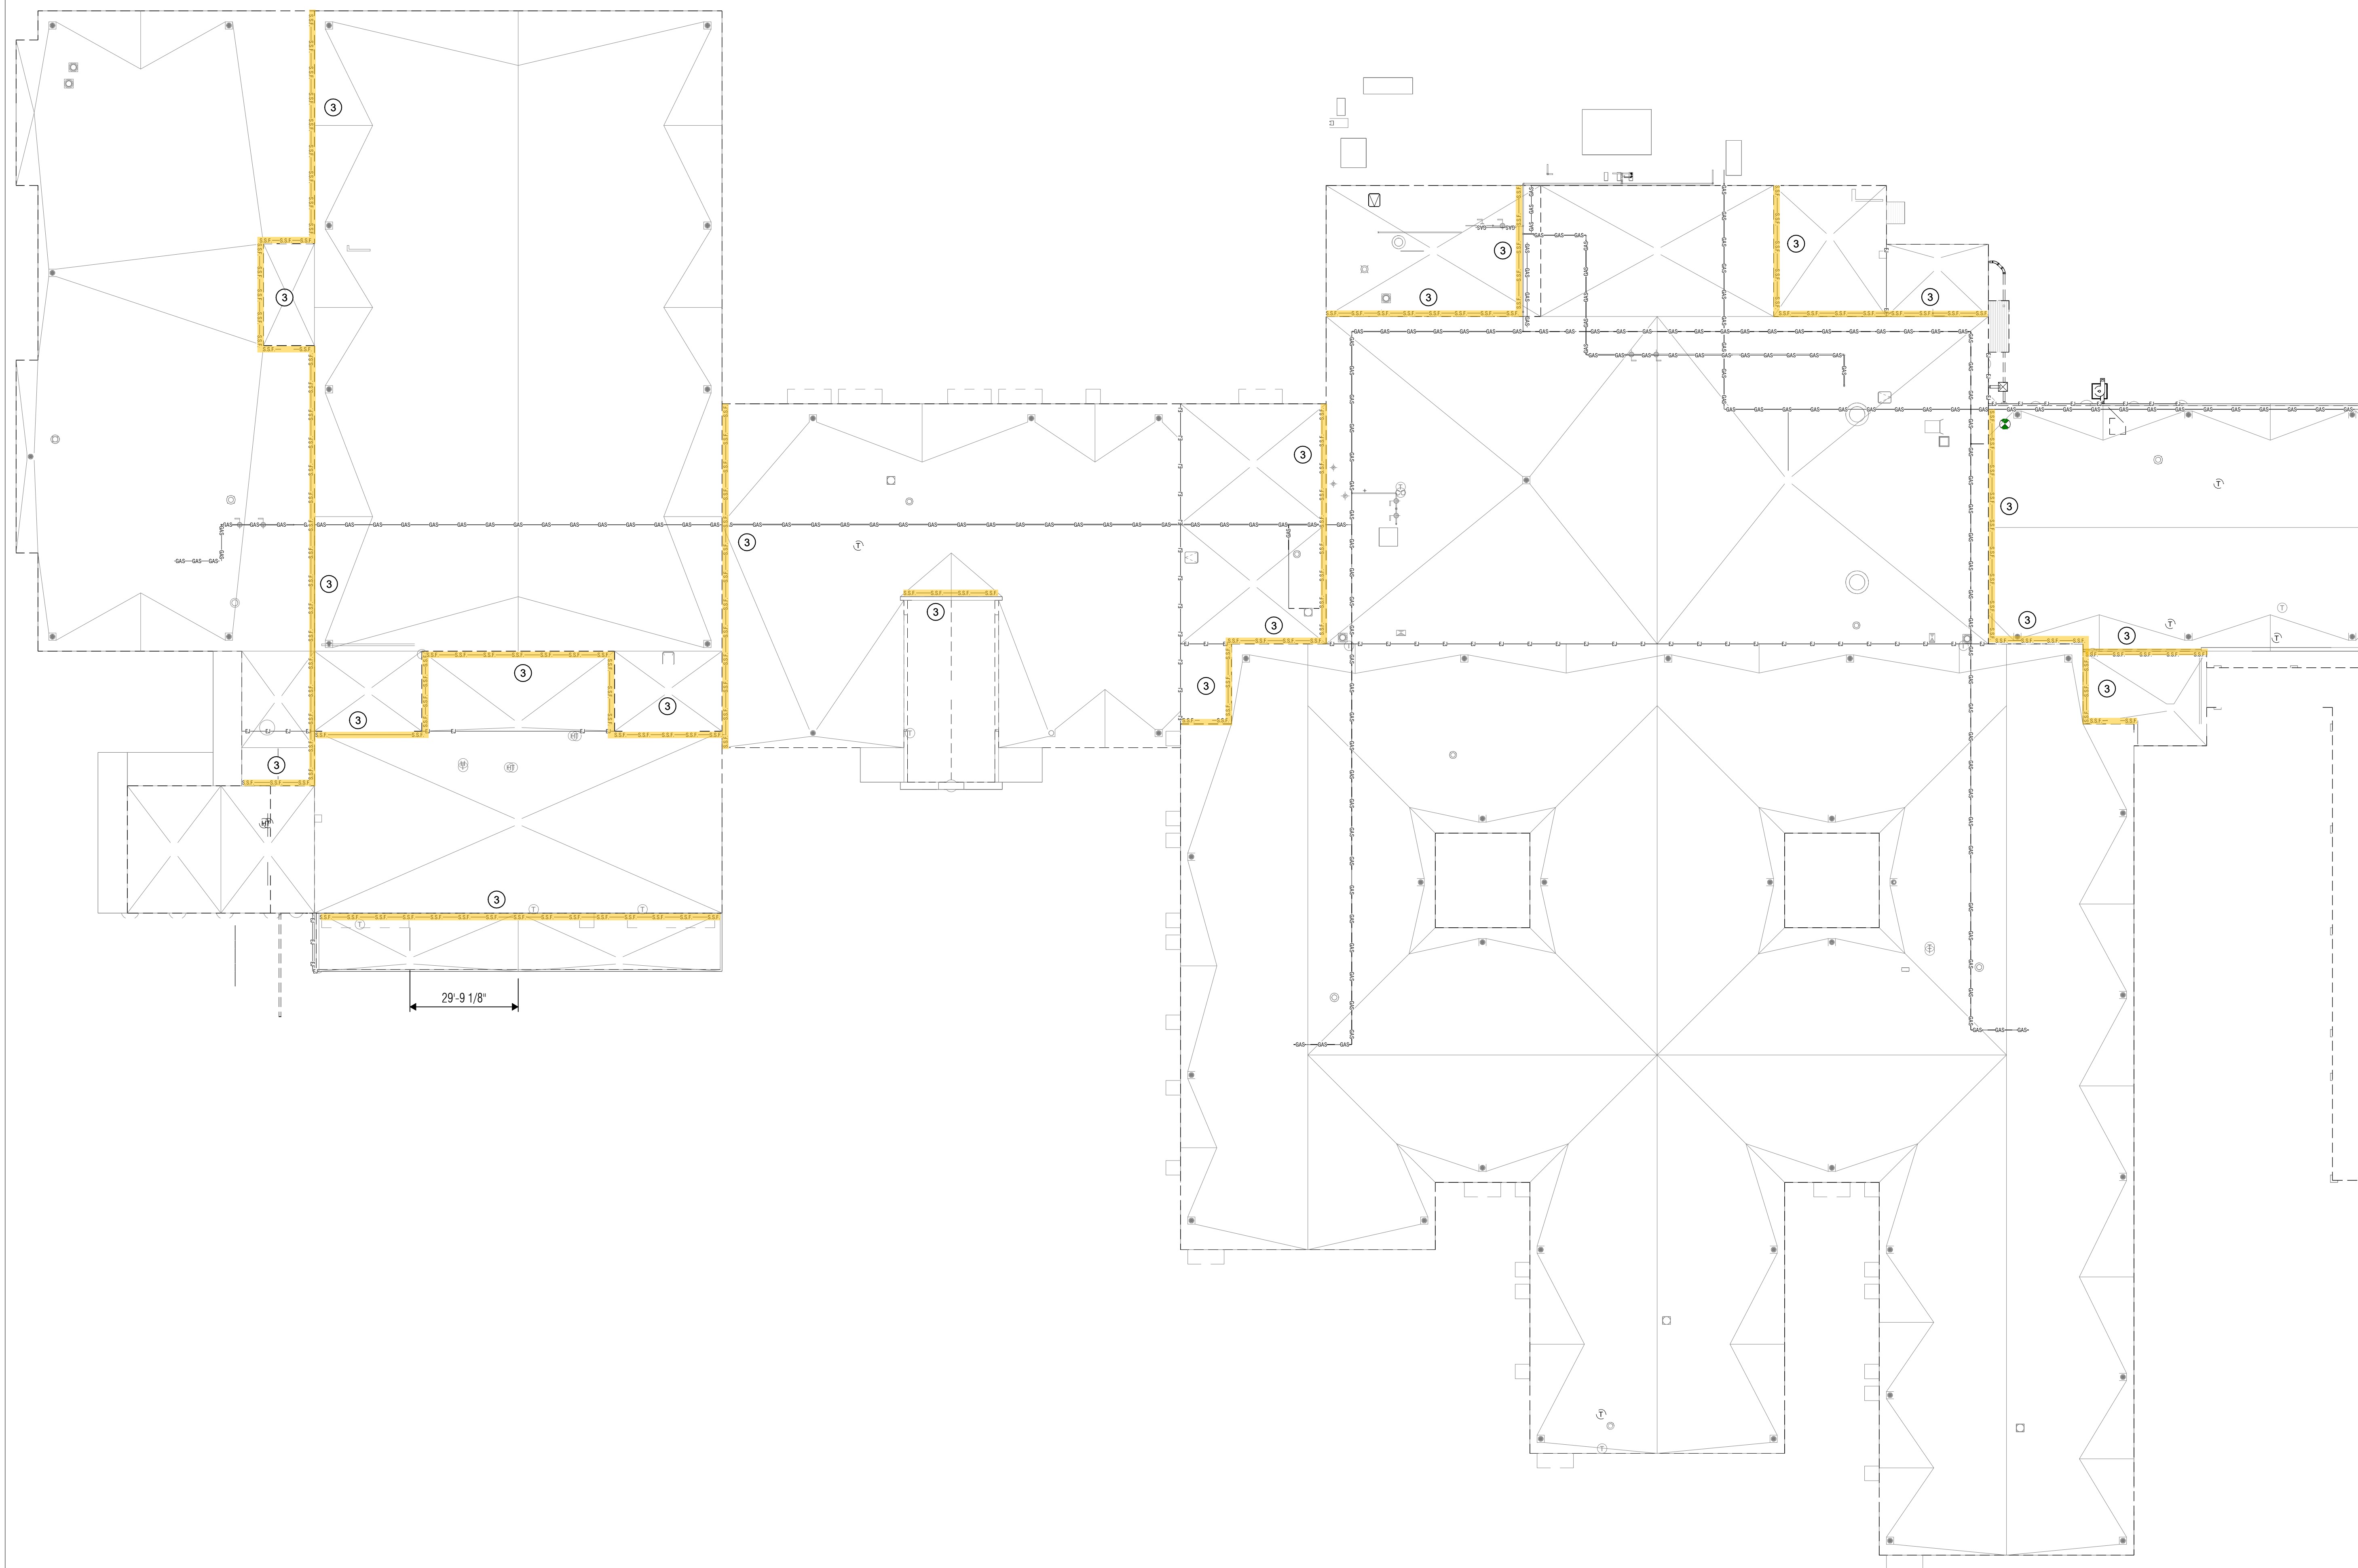

ABATEMENT PLAN GENERAL NOTES:

1. ABATEMENT PLANS WERE DERIVED FROM EXISTING BUILDING PLANS AND ARE INTENDED TO REASONABLY PRESENT EXISTING CONDITIONS. ABATEMENT CONTRACTOR SHALL VERIFY ACTUAL CONDITIONS AND COORDINATE ABATEMENT AND DEMOLITION WORK.
2. REFERENCE ARCHITECT'S DEMOLITION SPECIFICATIONS AND DRAWINGS FOR DEMOLITION REQUIREMENTS AND EXISTING BUILDING DRAWINGS FOR BUILDING CONSTRUCTION CONDITIONS.
3. THESE DRAWINGS ARE REPRESENTATIVE OF TYPICAL CONDITIONS IN THE BUILDING. HOWEVER, THE LOCATIONS OF ALL ASBESTOS CONTAINING MATERIALS ARE NOT SHOWN. ABATEMENT CONTRACTOR SHALL VERIFY ALL EXISTING CONDITIONS IN THE AREAS TO BE ABATED AND THE LOCATIONS OF ALL ASBESTOS-CONTAINING MATERIALS.
4. ABATEMENT CONTRACTOR SHALL BE RESPONSIBLE FOR ABATEMENT OF ALL ASBESTOS-CONTAINING MATERIALS.
5. THE ASBESTOS ABATEMENT SCOPE OF WORK IS DESCRIBED IN THE ABATEMENT SPECIFICATIONS. THE ASBESTOS ABATEMENT SCOPE OF WORK SHALL ALSO INCLUDE ANY HIDDEN ASBESTOS-CONTAINING MATERIALS THAT MAY BE ASSUMED OR UNCOVERED DURING THE BUILDING SELECTIVE DEMOLITION ACTIVITIES. THE ASBESTOS-CONTAINING MATERIALS IDENTIFIED IN THE BUILDING INCLUDE, AS A MINIMUM, THE FOLLOWING MATERIALS: INTERIOR ASBESTOS-CONTAINING MATERIALS: BLACK DAMPPROOFING MASTICS AND ANY ASSOCIATED FLASHINGS; EXTERIOR ASBESTOS-CONTAINING MATERIALS: BLACK DAMPPROOFING MASTICS AND ANY ASSOCIATED FLASHINGS.
6. ABATEMENT CONTRACTOR SHALL BE RESPONSIBLE FOR DETERMINING AND VERIFYING THE ACTUAL QUANTITIES OF ALL ASBESTOS-CONTAINING MATERIALS AND OTHER REGULATED MATERIALS THAT WILL BE ABATED UNDER THE IDENTIFIED SCOPE OF WORK. WHILE SOME OF THE EXISTING AREAS OF ASBESTOS-CONTAINING MATERIALS ARE ACCESSIBLE OR EXPOSED, OTHER AREAS OF ASBESTOS-CONTAINING MATERIALS MAY BE "HIDDEN" (E.G. LOCATED ABOVE CEILINGS, IN WALLS OR CHASES, UNDER CARPET OR OTHER FLOOR FINISH MATERIALS, ABOVE AND/OR UNDER WALLS, MILLWORK, ETC.). ALL "HIDDEN" AREAS OF ASBESTOS-CONTAINING MATERIALS IN AREAS SCHEDULED FOR DEMOLITION IN THE SUBJECT BUILDING SHALL BE UNCOVERED AND ABATED BY THE ABATEMENT CONTRACTOR AS PART OF THE PROJECT SCOPE OF WORK.
7. PERFORM SELECTIVE DEMOLITION OF WALL AREAS, CEILING AREAS, FLOOR AREAS, CHASE AREAS, ETC. AS REQUIRED TO UNCOVER AND LOCATE ALL "HIDDEN" AREAS OF ASBESTOS-CONTAINING MATERIALS IN AREAS SCHEDULED FOR DEMOLITION IN THE SUBJECT BUILDING.
8. FOR INTERIOR OR EXTERIOR WALL OPENINGS THAT IMPACT ASBESTOS CONTAINING MATERIALS, THE GENERAL CONTRACTOR IS RESPONSIBLE FOR IDENTIFYING AND MARKING OFF ANY NEW WALL OPENING LOCATIONS FOR THE ABATEMENT CONTRACTOR.

ABATEMENT PLAN KEYED NOTES:

1. DAMP PROOFING BLACK MASTIC APPLIED TO EXTERIOR CMU BLOCK AND ANY ASSOCIATED FLASHING/MASTIC AROUND DOORS/WINDOWS AND AT COLUMNS, BEAMS OR BRICK LEDGES IN THIS AREA ARE TO BE ABATED. (NESHAP METHODS) REFER TO THE ARCHITECTURAL DRAWINGS FOR EXACT SCOPE OF DEMOLITION AND REMOVAL. FIELD VERIFY ALL COMPONENTS TO BE DEMOLISHED.
2. DAMP PROOFING BLACK MASTIC APPLIED TO INTERIOR (ONCE EXTERIOR WALL) CMU BLOCK AND ANY ASSOCIATED FLASHING/MASTIC AROUND DOORS/WINDOWS AND ON COLUMNS, BEAMS OR BRICK LEDGES IN THIS AREA ARE TO BE ABATED. (THAPR - FULL CONTAINMENT) REFER TO THE ARCHITECTURAL DRAWINGS FOR EXACT SCOPE OF DEMOLITION AND REMOVAL. FIELD VERIFY ALL COMPONENTS TO BE DEMOLISHED.
3. DAMP PROOFING BLACK MASTIC APPLIED TO THRU WALL FLASHING OR ON BRICK IN THIS AREA ARE TO BE ABATED (NESHAP METHODS). REFER TO THE ARCHITECTURAL DRAWINGS FOR EXACT SCOPE OF DEMOLITION AND REMOVAL. FIELD VERIFY ALL COMPONENTS TO BE DEMOLISHED.

ASBESTOS LEGEND (LOCATION PURPOSES ONLY)

- BLACK MASTIC DAMP PROOFING AND ASSOCIATED FLASHING APPLIED TO CMU BLOCK (MAY BE APPLIED TO COLUMNS, BEAMS, DOOR/WINDOW FLASHING, THRU-WALL FLASHING AND/OR BRICK LEDGE FLASHING).

1 ROOF ABATEMENT PLAN
SCALE: 3/64" = 1'-0"

Issue For Proposal

SAM HUFF TDSH# 105902
SAM.HUFF@EFIGLOBAL.COM
EFI PROJECT#: 029.07283

ISSUED: February 28, 2025

REVISIONS

Revision No.	Revision Date
ADDENDUM #01	MARCH 6, 2025

Director RA
Designer SH
Proj. Coord.

EFI PROJECT NO.

029.07283

SHEET TITLE

COOK - ROOF
ABATEMENT PLAN

SHEET NO.

ABT2.R



ABATEMENT PLAN GENERAL NOTES:


1. ABATEMENT PLANS WERE DERIVED FROM EXISTING BUILDING PLANS AND ARE INTENDED TO REASONABLY PRESENT EXISTING CONDITIONS. ABATEMENT CONTRACTOR SHALL VERIFY ACTUAL CONDITIONS AND COORDINATE ABATEMENT AND DEMOLITION WORK.
2. REFERENCE ARCHITECT'S DEMOLITION SPECIFICATIONS AND DRAWINGS FOR DEMOLITION REQUIREMENTS AND EXISTING BUILDING DRAWINGS FOR BUILDING CONSTRUCTION CONDITIONS.
3. THESE DRAWINGS ARE REPRESENTATIVE OF TYPICAL CONDITIONS IN THE BUILDING. HOWEVER, THE LOCATIONS OF ALL ASBESTOS CONTAINING MATERIALS ARE NOT SHOWN. ABATEMENT CONTRACTOR SHALL VERIFY ALL EXISTING CONDITIONS IN THE AREAS TO BE ABATED AND THE LOCATIONS OF ALL ASBESTOS-CONTAINING MATERIALS.
4. ABATEMENT CONTRACTOR SHALL BE RESPONSIBLE FOR ABATEMENT OF ALL ASBESTOS-CONTAINING MATERIALS.
5. THE ASBESTOS ABATEMENT SCOPE OF WORK IS DESCRIBED IN THE ABATEMENT SPECIFICATIONS. THE ASBESTOS ABATEMENT SCOPE OF WORK SHALL ALSO INCLUDE ANY HIDDEN ASBESTOS-CONTAINING MATERIALS THAT MAY BE ASSUMED OR UNCOVERED DURING THE BUILDING SELECTIVE DEMOLITION ACTIVITIES. THE ASBESTOS-CONTAINING MATERIALS IDENTIFIED IN THE BUILDING INCLUDE, AS A MINIMUM, THE FOLLOWING MATERIALS: INTERIOR ASBESTOS-CONTAINING MATERIALS: BLACK DAMPPROOFING MASTICS AND ANY ASSOCIATED FLASHINGS, CREAM/TAN DUCT MASTIC, OLD DOMESTIC HOT WATER PIPE INSULATION WITH WHITE/CREAM MASTIC, CHILLED HEATING WATER PIPE INSULATION WITH WHITE/CREAM MASTIC, BLACK WINDOW GLAZING PUTTY AROUND INTERIOR WINDOWS, AND FIRE DOORS (ASSUMED ASBESTOS). EXTERIOR ASBESTOS-CONTAINING MATERIALS: BLACK DAMPPROOFING MASTICS AND ANY ASSOCIATED FLASHINGS.
6. ABATEMENT CONTRACTOR SHALL BE RESPONSIBLE FOR DETERMINING AND VERIFYING THE ACTUAL QUANTITIES OF ALL ASBESTOS-CONTAINING MATERIALS AND OTHER REGULATED MATERIALS THAT WILL BE ABATED UNDER THE IDENTIFIED SCOPE OF WORK. WHILE SOME OF THE EXISTING AREAS OF ASBESTOS-CONTAINING MATERIALS ARE ACCESSIBLE OR EXPOSED, OTHER AREAS OF ASBESTOS-CONTAINING MATERIALS MAY BE "HIDDEN" (E.G. LOCATED ABOVE CEILINGS, IN WALLS OR CHASES, UNDER CARPET OR OTHER FLOOR FINISH MATERIALS, ABOVE AND/OR UNDER WALLS, MILLWORK, ETC.). ALL "HIDDEN" AREAS OF ASBESTOS-CONTAINING MATERIALS IN AREAS SCHEDULED FOR DEMOLITION IN THE SUBJECT BUILDING SHALL BE UNCOVERED AND ABATED BY THE ABATEMENT CONTRACTOR AS PART OF THE PROJECT SCOPE OF WORK.
7. PERFORM SELECTIVE DEMOLITION OF WALL AREAS, CEILING AREAS, FLOOR AREAS, CHASE AREAS, ETC. AS REQUIRED TO UNCOVER AND LOCATE ALL "HIDDEN" AREAS OF ASBESTOS-CONTAINING MATERIALS IN AREAS SCHEDULED FOR DEMOLITION IN THE SUBJECT BUILDING.
8. FOR INTERIOR OR EXTERIOR WALL OPENINGS THAT IMPACT ASBESTOS CONTAINING MATERIALS, THE GENERAL CONTRACTOR IS RESPONSIBLE FOR IDENTIFYING AND MARKING OFF ANY NEW WALL OPENING LOCATIONS FOR THE ABATEMENT CONTRACTOR.

ABATEMENT PLAN KEYED NOTES:

1. DAMP PROOFING BLACK MASTIC APPLIED TO EXTERIOR CMU BLOCK AND ANY ASSOCIATED FLASHING/MASTIC AROUND DOORS/WINDOWS AND AT COLUMNS, BEAMS OR BRICK LEDGES IN THIS AREA ARE TO BE ABATED. (RESHAP METHODS) REFER TO THE ARCHITECTURAL DRAWINGS FOR EXACT SCOPE OF DEMO AND REMOVAL. FIELD VERIFY ALL COMPONENTS TO BE DEMOLISHED.
2. DAMP PROOFING BLACK MASTIC APPLIED TO INTERIOR (ONCE EXTERIOR WALL) CMU BLOCK AND ANY ASSOCIATED FLASHING/MASTIC AROUND DOORS/WINDOWS AND ON COLUMNS, BEAMS OR BRICK LEDGES IN THIS AREA ARE TO BE ABATED. (THAPR - FULL CONTAINMENT) REFER TO THE ARCHITECTURAL DRAWINGS FOR EXACT SCOPE OF DEMO AND REMOVAL. FIELD VERIFY ALL COMPONENTS TO BE DEMOLISHED.
3. BLACK WINDOW GLAZING PUTTY IN THIS AREA IS TO BE ABATED (THAPR - FULL CONTAINMENT) FROM THE WINDOW FRAMING SYSTEM. REFER TO THE ARCHITECTURAL DRAWINGS FOR EXACT SCOPE OF REMOVAL. FIELD VERIFY ALL COMPONENTS TO BE REMOVED.
4. DAMP PROOFING BLACK MASTIC APPLIED TO INTERIOR (ONCE EXTERIOR WALL) CMU BLOCK AND ASSOCIATED FLASHING/MASTIC AT LOUVERS IN THIS AREA ARE TO BE ABATED. (THAPR - FULL CONTAINMENT) REFER TO THE M.E.P. DRAWINGS FOR EXACT SCOPE OF DEMO AND REMOVAL. FIELD VERIFY ALL COMPONENTS TO BE DEMOLISHED.
5. WHITE OR CREAM MASTIC APPLIED TO CHILLED WATER PIPE INSULATION RUNS AND FITTINGS IN THIS AREA IS TO BE ABATED FROM CEILING PLENUM AREA. REFER TO THE ARCHITECTURAL/M.E.P. DRAWINGS FOR EXACT SCOPE OF REMOVAL. FIELD VERIFY ALL COMPONENTS/MATERIALS TO BE REMOVED. (THAPR - FULL CONTAINMENT OR GLOVEBAG).
6. WHITE OR CREAM MASTIC APPLIED TO HEATING WATER PIPE INSULATION RUNS AND FITTINGS IN THIS AREA IS TO BE ABATED FROM CEILING PLENUM AREA. REFER TO THE ARCHITECTURAL/M.E.P. DRAWINGS FOR EXACT SCOPE OF REMOVAL. FIELD VERIFY ALL COMPONENTS/MATERIALS TO BE REMOVED. (THAPR - FULL CONTAINMENT OR GLOVEBAG).
7. DAMP PROOFING BLACK MASTIC APPLIED TO CMU BLOCK AND/OR INSULATION WITH BLACK MASTIC SEALANT BEHIND BRICK VENEER IN THIS AREA IS TO BE ABATED FOR NEW THROUGH-WALL FLASHING INSTALLATION. (RESHAP METHODS) REFER TO THE ARCHITECTURAL DRAWINGS FOR EXACT SCOPE OF DEMOLITION AND REMOVAL. FIELD VERIFY ALL COMPONENTS TO BE DEMOLISHED.

ASBESTOS LEGEND (LOCATION PURPOSES ONLY)

- BLACK MASTIC DAMP PROOFING AND ASSOCIATED FLASHING APPLIED TO CMU BLOCK (MAY BE APPLIED TO COLUMNS, BEAMS, DOOR/WINDOW FLASHING AND/OR BRICK LEDGE FLASHING).
- BLACK WINDOW GLAZING PUTTY

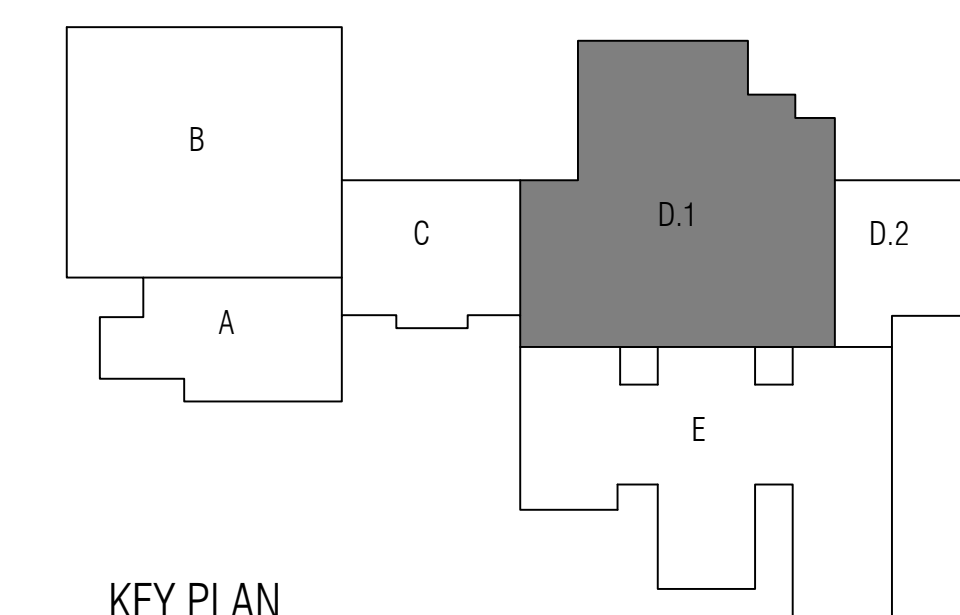

1 UNIT "D.1" ABATEMENT PLAN - LEVEL ONE
SCALE: 1/8" = 1'-0"

Issue For Proposal

SAM HUFF TDSHS# 105902
SAM.HUFF@EFIGLOBAL.COM
EFI PROJECT#: 029-07284

ISSUED: February 28, 2025

REVISIONS

Revision No.	Revision Date
ADDENDUM #01	MARCH 6, 2025

Director RA
Designer SH
Proj. Coord. Quality Control

EFI PROJECT NO.


029.07284

SHEET TITLE

LABAY - UNIT D.1
ABATEMENT PLAN - LEVEL ONE

SHEET NO.

ABT3.D.1

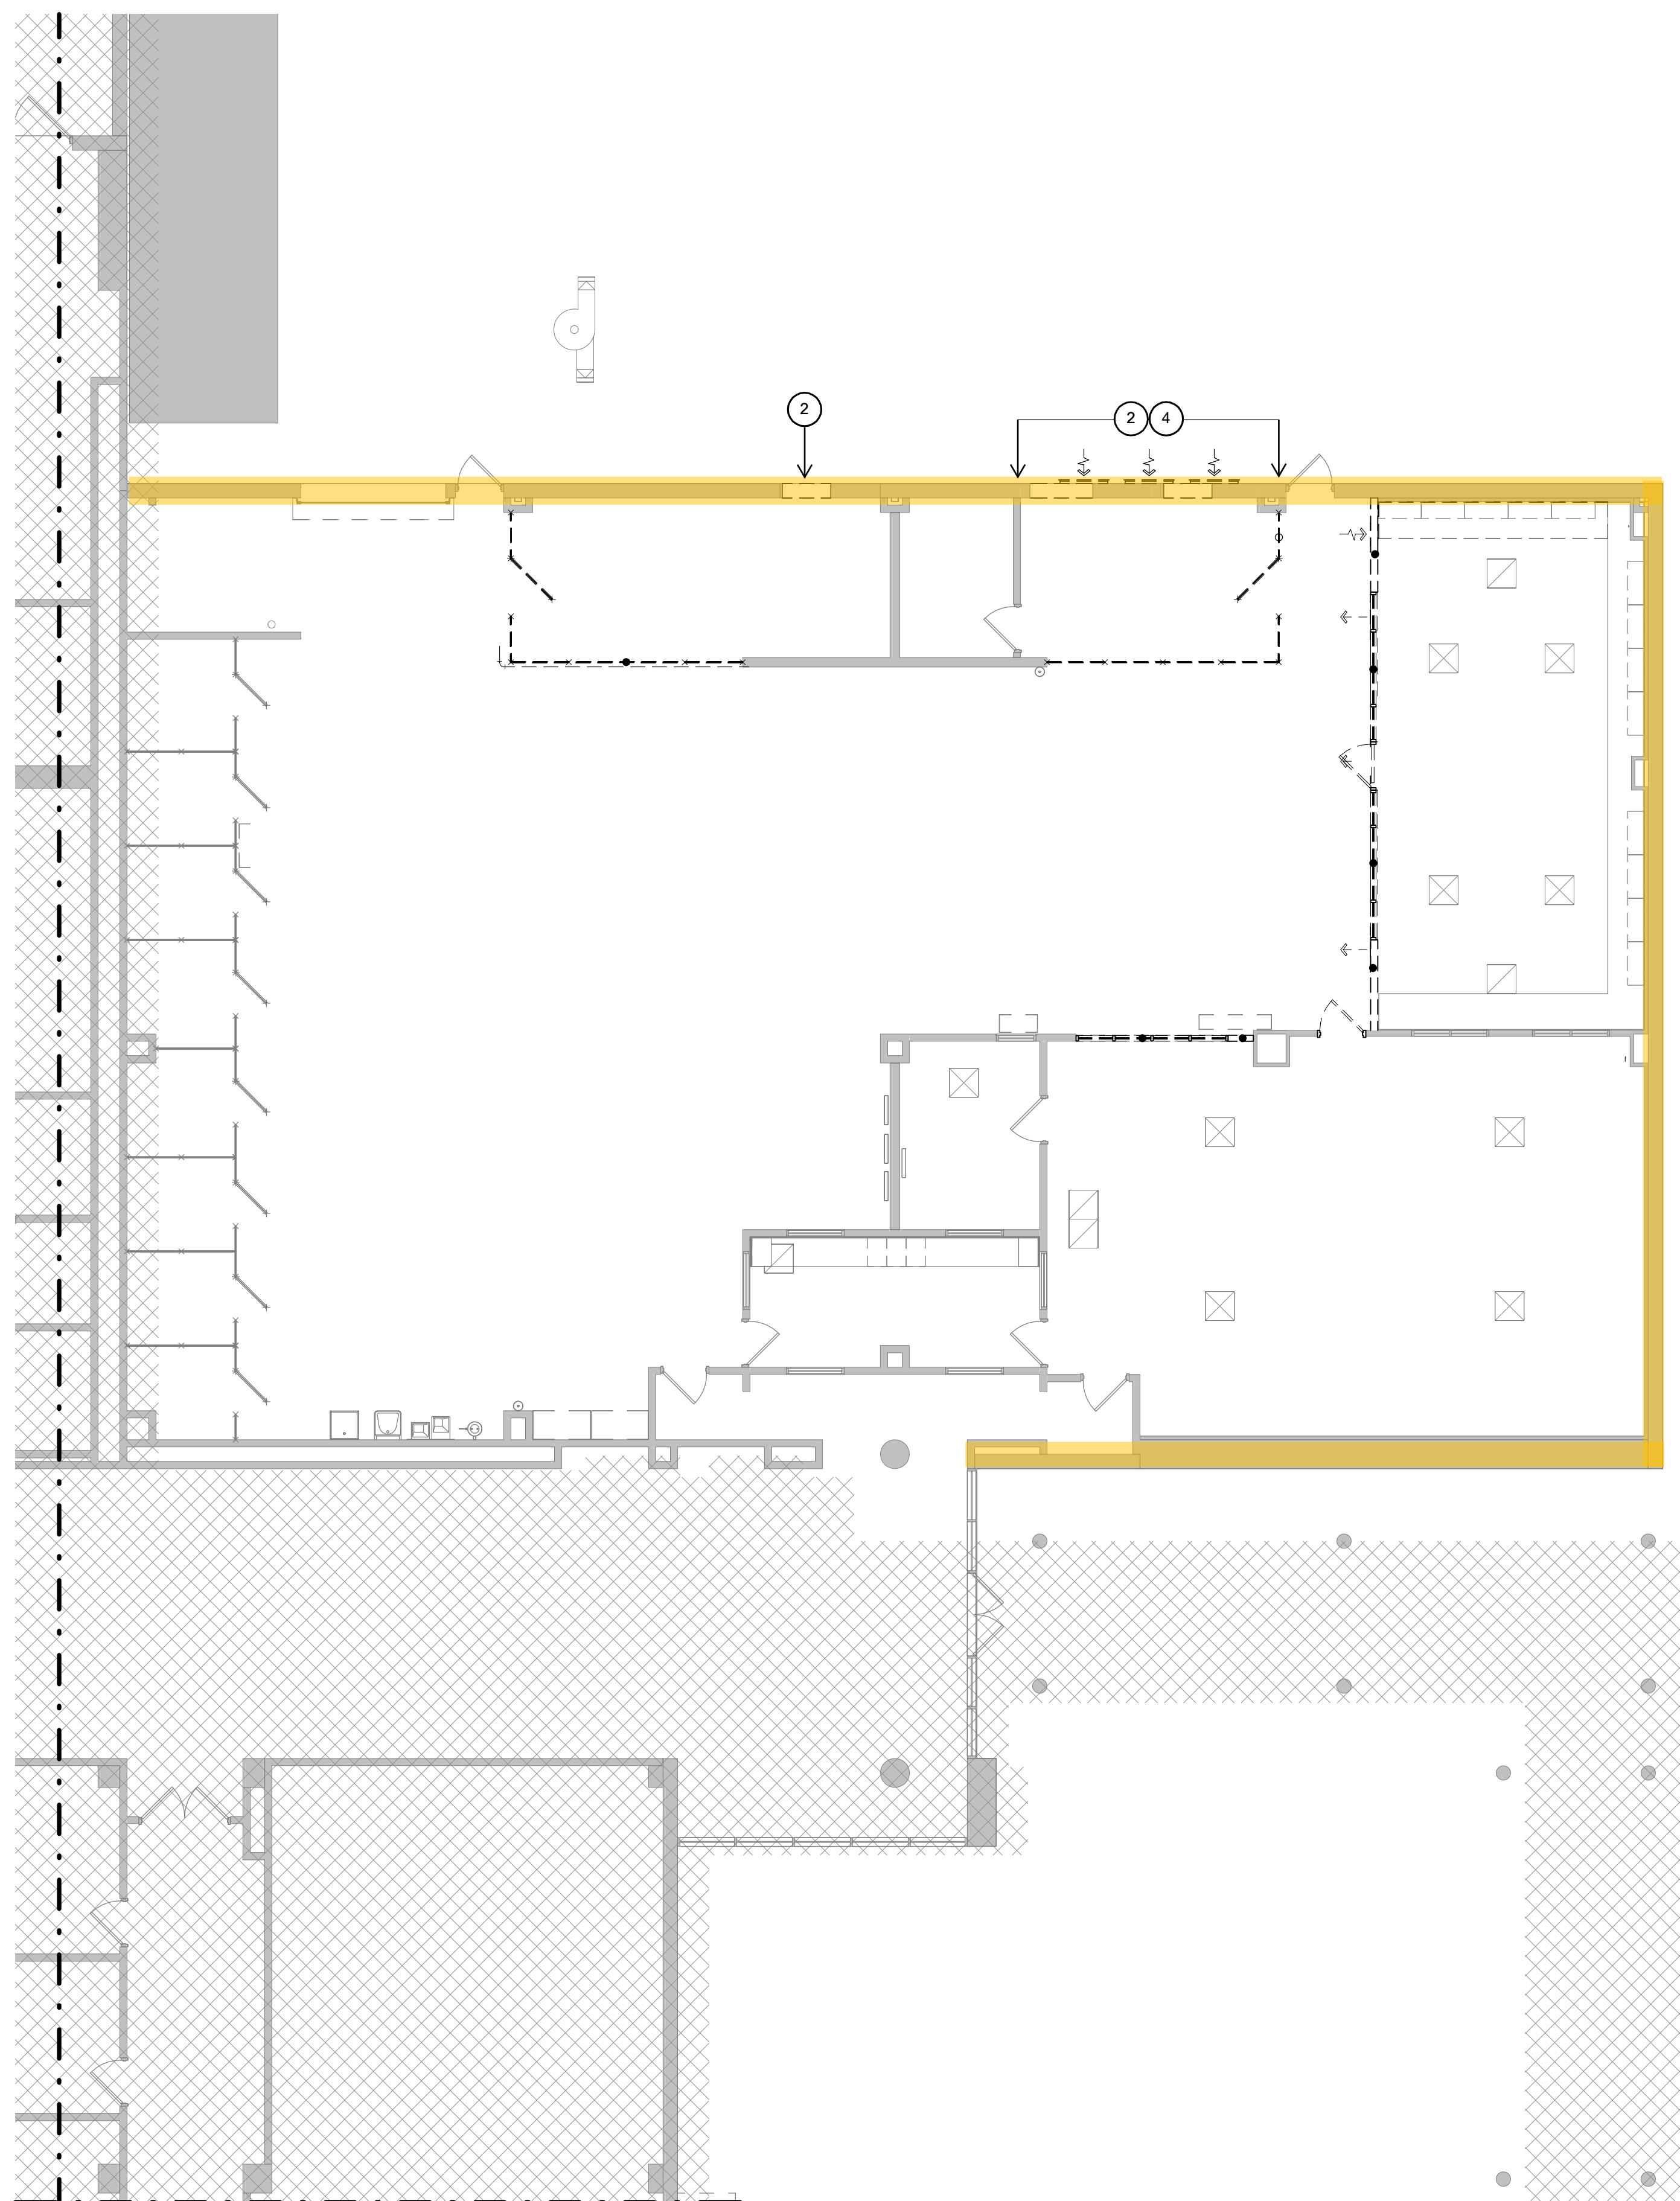

ABATEMENT PLAN GENERAL NOTES:

1. ABATEMENT PLANS WERE DERIVED FROM EXISTING BUILDING PLANS AND ARE INTENDED TO REASONABLY PRESENT EXISTING CONDITIONS. ABATEMENT CONTRACTOR SHALL VERIFY ACTUAL CONDITIONS AND COORDINATE ABATEMENT AND DEMOLITION WORK.
2. REFERENCE ARCHITECT'S DEMOLITION SPECIFICATIONS AND DRAWINGS FOR DEMOLITION REQUIREMENTS AND EXISTING BUILDING DRAWINGS FOR BUILDING CONSTRUCTION CONDITIONS.
3. THESE DRAWINGS ARE REPRESENTATIVE OF TYPICAL CONDITIONS IN THE BUILDING. HOWEVER, THE LOCATIONS OF ALL ASBESTOS CONTAINING MATERIALS ARE NOT SHOWN. ABATEMENT CONTRACTOR SHALL VERIFY ALL EXISTING CONDITIONS IN THE AREAS TO BE ABATED AND THE LOCATIONS OF ALL ASBESTOS-CONTAINING MATERIALS.
4. ABATEMENT CONTRACTOR SHALL BE RESPONSIBLE FOR ABATEMENT OF ALL ASBESTOS-CONTAINING MATERIALS.
5. THE ASBESTOS ABATEMENT SCOPE OF WORK IS DESCRIBED IN THE ABATEMENT SPECIFICATIONS. THE ASBESTOS ABATEMENT SCOPE OF WORK SHALL ALSO INCLUDE ANY HIDDEN ASBESTOS-CONTAINING MATERIALS THAT MAY BE ASSUMED OR UNCOVERED DURING THE BUILDING SELECTIVE DEMOLITION ACTIVITIES. THE ASBESTOS-CONTAINING MATERIALS IDENTIFIED IN THE BUILDING INCLUDE, AS A MINIMUM, THE FOLLOWING MATERIALS: INTERIOR ASBESTOS-CONTAINING MATERIALS: BLACK DAMPPROOFING MASTICS AND ANY ASSOCIATED FLASHINGS, CREAM/TAN DUCT MASTIC, OLD DOMESTIC HOT WATER PIPE INSULATION WITH WHITE/CREAM MASTIC, CHILLED HEATING WATER PIPE INSULATION WITH WHITE/CREAM MASTIC, BLACK WINDOW GLAZING PUTTY AROUND INTERIOR WINDOWS, AND FIRE DOORS (ASSUMED ASBESTOS). EXTERIOR ASBESTOS-CONTAINING MATERIALS: BLACK DAMPPROOFING MASTICS AND ANY ASSOCIATED FLASHINGS.
6. ABATEMENT CONTRACTOR SHALL BE RESPONSIBLE FOR DETERMINING AND VERIFYING THE ACTUAL QUANTITIES OF ALL ASBESTOS-CONTAINING MATERIALS AND OTHER REGULATED MATERIALS THAT WILL BE ABATED UNDER THE IDENTIFIED SCOPE OF WORK. WHILE SOME OF THE EXISTING AREAS OF ASBESTOS-CONTAINING MATERIALS ARE ACCESSIBLE OR EXPOSED, OTHER AREAS OF ASBESTOS-CONTAINING MATERIALS MAY BE "HIDDEN" (E.G. LOCATED ABOVE CEILINGS, IN WALLS OR CHASES, UNDER CARPET OR OTHER FLOOR FINISH MATERIALS, ABOVE AND/OR UNDER WALLS, MILLWORK, ETC.). ALL "HIDDEN" AREAS OF ASBESTOS-CONTAINING MATERIALS IN AREAS SCHEDULED FOR DEMOLITION IN THE SUBJECT BUILDING SHALL BE UNCOVERED AND ABATED BY THE ABATEMENT CONTRACTOR AS PART OF THE PROJECT SCOPE OF WORK.
7. PERFORM SELECTIVE DEMOLITION OF WALL AREAS, CEILING AREAS, FLOOR AREAS, CHASE AREAS, ETC. AS REQUIRED TO UNCOVER AND LOCATE ALL "HIDDEN" AREAS OF ASBESTOS-CONTAINING MATERIALS IN AREAS SCHEDULED FOR DEMOLITION IN THE SUBJECT BUILDING.
8. FOR INTERIOR OR EXTERIOR WALL OPENINGS THAT IMPACT ASBESTOS CONTAINING MATERIALS, THE GENERAL CONTRACTOR IS RESPONSIBLE FOR IDENTIFYING AND MARKING OFF ANY NEW WALL OPENING LOCATIONS FOR THE ABATEMENT CONTRACTOR.

ABATEMENT PLAN KEYED NOTES:

1. DAMP PROOFING BLACK MASTIC APPLIED TO EXTERIOR CMU BLOCK AND ANY ASSOCIATED FLASHING/MASTIC AROUND DOORS/WINDOWS AND AT COLUMNS, BEAMS OR BRICK LEDGES IN THIS AREA ARE TO BE ABATED. (NEESHAP METHODS) REFER TO THE ARCHITECTURAL DRAWINGS FOR EXACT SCOPE OF DEMO AND REMOVAL. FIELD VERIFY ALL COMPONENTS TO BE DEMOLISHED.
2. DAMP PROOFING BLACK MASTIC APPLIED TO INTERIOR (ONCE EXTERIOR WALL) CMU BLOCK AND ANY ASSOCIATED FLASHING/MASTIC AROUND DOORS/WINDOWS AND ON COLUMNS, BEAMS OR BRICK LEDGES IN THIS AREA ARE TO BE ABATED. (THAPR - FULL CONTAINMENT) REFER TO THE ARCHITECTURAL DRAWINGS FOR EXACT SCOPE OF DEMO AND REMOVAL. FIELD VERIFY ALL COMPONENTS TO BE DEMOLISHED.
3. BLACK WINDOW GLAZING PUTTY IN THIS AREA IS TO BE ABATED (THAPR - FULL CONTAINMENT) FROM THE WINDOW FRAMING SYSTEM. REFER TO THE ARCHITECTURAL DRAWINGS FOR EXACT SCOPE OF REMOVAL. FIELD VERIFY ALL COMPONENTS TO BE REMOVED.
4. DAMP PROOFING BLACK MASTIC APPLIED TO INTERIOR (ONCE EXTERIOR WALL) CMU BLOCK AND ASSOCIATED FLASHING/MASTIC AT LOUVERS IN THIS AREA ARE TO BE ABATED. (THAPR - FULL CONTAINMENT) REFER TO THE M.E.P. DRAWINGS FOR EXACT SCOPE OF DEMO AND REMOVAL. FIELD VERIFY ALL COMPONENTS TO BE DEMOLISHED.
5. WHITE OR CREAM MASTIC APPLIED TO CHILLED WATER PIPE INSULATION RUNS AND FITTINGS IN THIS AREA IS TO BE ABATED FROM CEILING PLENUM AREA. REFER TO THE ARCHITECTURAL/M.E.P. DRAWINGS FOR EXACT SCOPE OF REMOVAL. FIELD VERIFY ALL COMPONENTS/MATERIALS TO BE REMOVED. (THAPR - FULL CONTAINMENT OR GLOVEBAG).
6. WHITE OR CREAM MASTIC APPLIED TO HEATING WATER PIPE INSULATION RUNS AND FITTINGS IN THIS AREA IS TO BE ABATED FROM CEILING PLENUM AREA. REFER TO THE ARCHITECTURAL/M.E.P. DRAWINGS FOR EXACT SCOPE OF REMOVAL. FIELD VERIFY ALL COMPONENTS/MATERIALS TO BE REMOVED. (THAPR - FULL CONTAINMENT OR GLOVEBAG).
7. DAMP PROOFING BLACK MASTIC APPLIED TO CMU BLOCK AND/OR INSULATION WITH BLACK MASTIC SEALANT BEHIND BRICK VENEER IN THIS AREA IS TO BE ABATED FOR NEW THROUGH-WALL FLASHING INSTALLATION. (NEESHAP METHODS) REFER TO THE ARCHITECTURAL DRAWINGS FOR EXACT SCOPE OF DEMOLITION AND REMOVAL. FIELD VERIFY ALL COMPONENTS TO BE DEMOLISHED.

ASBESTOS LEGEND (LOCATION PURPOSES ONLY)

- BLACK MASTIC DAMP PROOFING AND ASSOCIATED FLASHING APPLIED TO CMU BLOCK (MAY BE APPLIED TO COLUMNS, BEAMS, DOOR/WINDOW FLASHING AND/OR BRICK LEDGE FLASHING).
- BLACK WINDOW GLAZING PUTTY

Issue For Proposal

[Signature]

SAM HUFF TDSHS# 105902
SAM.HUFF@EFIGLOBAL.COM
EFI PROJECT#: 029.07283

ISSUED: February 28, 2025

REVISIONS


Revision No.	Revision Date
ADDENDUM #01	MARCH 6, 2025

Director RA Drawn By SH Designer Quality Control Proj. Coord.

EFI PROJECT NO.
029.07284

SHEET TITLE
LABAY - UNIT D.2
ABATEMENT PLAN - LEVEL ONE

SHEET NO.
ABT4.D.2

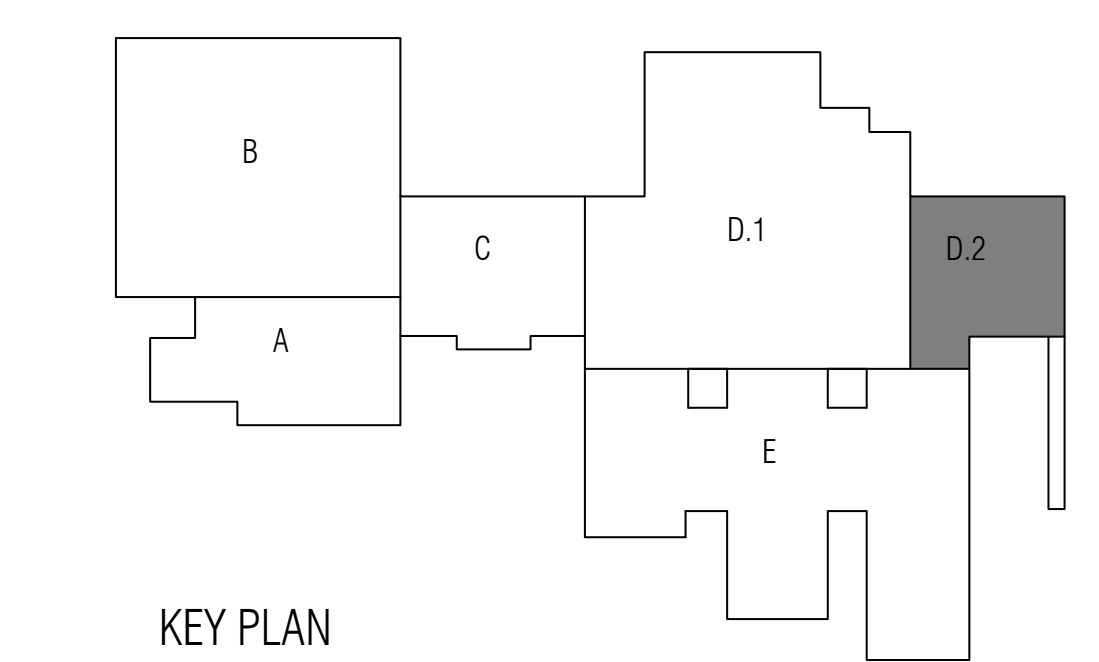

1 UNIT "D.2" ABATEMENT PLAN - LEVEL ONE
SCALE: 1/8" = 1'-0"

Issue For Proposal

SAM HUFF TDSHS# 105902
SAM.HUFF@EFIGLOBAL.COM
EFI PROJECT#: 029.07284

ISSUED: February 28, 2025

REVISIONS

Revision No.	Revision Date
ADDENDUM #01	MARCH 6, 2025

Director RA
Designator SH
Quality Control

Proj. Coord.

EFI PROJECT NO.

029.07284

SHEET TITLE

LABAY - UNIT A
ABATEMENT PLAN - LEVEL
ONE

SHEET NO.

ABT5.A

ABATEMENT PLAN GENERAL NOTES:


1. ABATEMENT PLANS WERE DERIVED FROM EXISTING BUILDING PLANS AND ARE INTENDED TO REASONABLY PRESENT EXISTING CONDITIONS. ABATEMENT CONTRACTOR SHALL VERIFY ACTUAL CONDITIONS AND COORDINATE ABATEMENT AND DEMOLITION WORK.
2. REFERENCE ARCHITECT'S DEMOLITION SPECIFICATIONS AND DRAWINGS FOR DEMOLITION REQUIREMENTS AND EXISTING BUILDING DRAWINGS FOR BUILDING CONSTRUCTION CONDITIONS.
3. THESE DRAWINGS ARE REPRESENTATIVE OF TYPICAL CONDITIONS IN THE BUILDING. HOWEVER, THE LOCATIONS OF ALL ASBESTOS CONTAINING MATERIALS ARE NOT SHOWN. ABATEMENT CONTRACTOR SHALL VERIFY ALL EXISTING CONDITIONS IN THE AREAS TO BE ABATED AND THE LOCATIONS OF ALL ASBESTOS-CONTAINING MATERIALS.
4. ABATEMENT CONTRACTOR SHALL BE RESPONSIBLE FOR ABATEMENT OF ALL ASBESTOS-CONTAINING MATERIALS.
5. THE ASBESTOS ABATEMENT SCOPE OF WORK IS DESCRIBED IN THE ABATEMENT SPECIFICATIONS. THE ASBESTOS ABATEMENT SCOPE OF WORK SHALL ALSO INCLUDE ANY HIDDEN ASBESTOS-CONTAINING MATERIALS THAT MAY BE ASSUMED OR UNCOVERED DURING THE BUILDING SELECTIVE DEMOLITION ACTIVITIES. THE ASBESTOS-CONTAINING MATERIALS IDENTIFIED IN THE BUILDING INCLUDE, AS A MINIMUM, THE FOLLOWING MATERIALS: INTERIOR ASBESTOS-CONTAINING MATERIALS: BLACK DAMPPROOFING MASTICS AND ANY ASSOCIATED FLASHINGS, CREAM/TAN DUCT MASTIC, OLD DOMESTIC HOT WATER PIPE INSULATION WITH WHITE/CREAM MASTIC, CHILLED HEATING WATER PIPE INSULATION WITH WHITE/CREAM MASTIC, BLACK WINDOW GLAZING PUTTY AROUND INTERIOR WINDOWS, AND FIRE DOORS (ASSUMED ASBESTOS); EXTERIOR ASBESTOS-CONTAINING MATERIALS: BLACK DAMPPROOFING MASTICS AND ANY ASSOCIATED FLASHINGS.
6. ABATEMENT CONTRACTOR SHALL BE RESPONSIBLE FOR DETERMINING AND VERIFYING THE ACTUAL QUANTITIES OF ALL ASBESTOS-CONTAINING MATERIALS AND OTHER REGULATED MATERIALS THAT WILL BE ABATED UNDER THE IDENTIFIED SCOPE OF WORK. WHILE SOME OF THE EXISTING AREAS OF ASBESTOS-CONTAINING MATERIALS ARE ACCESSIBLE OR EXPOSED, OTHER AREAS OF ASBESTOS-CONTAINING MATERIALS MAY BE "HIDDEN" (E.G. LOCATED ABOVE CEILINGS, IN WALLS OR CHASES; UNDER CARPET OR OTHER FLOOR FINISH MATERIALS; ABOVE AND/OR UNDER WALLS, MILLWORK, ETC.). ALL "HIDDEN" AREAS OF ASBESTOS-CONTAINING MATERIALS IN AREAS SCHEDULED FOR DEMOLITION IN THE SUBJECT BUILDING SHALL BE UNCOVERED AND ABATED BY THE ABATEMENT CONTRACTOR AS PART OF THE PROJECT SCOPE OF WORK.
7. PERFORM SELECTIVE DEMOLITION OF WALL AREAS, CEILING AREAS, FLOOR AREAS, CHASE AREAS, ETC. AS REQUIRED TO UNCOVER AND LOCATE ALL "HIDDEN" AREAS OF ASBESTOS-CONTAINING MATERIALS IN AREAS SCHEDULED FOR DEMOLITION IN THE SUBJECT BUILDING.
8. FOR INTERIOR OR EXTERIOR WALL OPENINGS THAT IMPACT ASBESTOS CONTAINING MATERIALS, THE GENERAL CONTRACTOR IS RESPONSIBLE FOR IDENTIFYING AND MARKING OFF ANY NEW WALL OPENING LOCATIONS FOR THE ABATEMENT CONTRACTOR.

ABATEMENT PLAN KEYED NOTES:


1. DAMP PROOFING BLACK MASTIC APPLIED TO EXTERIOR CMU BLOCK AND ANY ASSOCIATED FLASHING/MASTIC AROUND DOORS/WINDOWS AND AT COLUMNS, BEAMS OR BRICK LEDGES IN THIS AREA ARE TO BE ABATED. (RESHAP METHODS) REFER TO THE ARCHITECTURAL DRAWINGS FOR EXACT SCOPE OF DEMO AND REMOVAL. FIELD VERIFY ALL COMPONENTS TO BE DEMOLISHED.
2. DAMP PROOFING BLACK MASTIC APPLIED TO INTERIOR (ONCE EXTERIOR WALL) CMU BLOCK AND ANY ASSOCIATED FLASHING/MASTIC AROUND DOORS/WINDOWS AND ON COLUMNS, BEAMS OR BRICK LEDGES IN THIS AREA ARE TO BE ABATED. (THAPR - FULL CONTAINMENT) REFER TO THE ARCHITECTURAL DRAWINGS FOR EXACT SCOPE OF DEMO AND REMOVAL. FIELD VERIFY ALL COMPONENTS TO BE DEMOLISHED.
3. BLACK WINDOW GLAZING PUTTY IN THIS AREA IS TO BE ABATED (THAPR - FULL CONTAINMENT) FROM THE WINDOW FRAMING SYSTEM. REFER TO THE ARCHITECTURAL DRAWINGS FOR EXACT SCOPE OF REMOVAL. FIELD VERIFY ALL COMPONENTS TO BE REMOVED.
4. DAMP PROOFING BLACK MASTIC APPLIED TO INTERIOR (ONCE EXTERIOR WALL) CMU BLOCK AND ASSOCIATED FLASHING/MASTIC AT LOUVERS IN THIS AREA ARE TO BE ABATED. (THAPR - FULL CONTAINMENT) REFER TO THE M.E.P. DRAWINGS FOR EXACT SCOPE OF DEMO AND REMOVAL. FIELD VERIFY ALL COMPONENTS TO BE DEMOLISHED.
5. WHITE OR CREAM MASTIC APPLIED TO CHILLED WATER PIPE INSULATION RUNS AND FITTINGS IN THIS AREA IS TO BE ABATED FROM CEILING PLENUM AREA. REFER TO THE ARCHITECTURAL M.E.P. DRAWINGS FOR EXACT SCOPE OF REMOVAL. FIELD VERIFY ALL COMPONENTS/MATERIALS TO BE REMOVED. (THAPR - FULL CONTAINMENT OR GLOVEBAG).
6. WHITE OR CREAM MASTIC APPLIED TO HEATING WATER PIPE INSULATION RUNS AND FITTINGS IN THIS AREA IS TO BE ABATED FROM CEILING PLENUM AREA. REFER TO THE ARCHITECTURAL M.E.P. DRAWINGS FOR EXACT SCOPE OF REMOVAL. FIELD VERIFY ALL COMPONENTS/MATERIALS TO BE REMOVED. (THAPR - FULL CONTAINMENT OR GLOVEBAG).
7. DAMP PROOFING BLACK MASTIC APPLIED TO CMU BLOCK AND/OR INSULATION WITH BLACK MASTIC SEALANT BEHIND BRICK VENEER IN THIS AREA IS TO BE ABATED FOR NEW THROUGH-WALL FLASHING INSTALLATION. (RESHAP METHODS) REFER TO THE ARCHITECTURAL DRAWINGS FOR EXACT SCOPE OF DEMOLITION AND REMOVAL. FIELD VERIFY ALL COMPONENTS TO BE DEMOLISHED.

ASBESTOS LEGEND (LOCATION PURPOSES ONLY)


- BLACK MASTIC DAMP PROOFING AND ASSOCIATED FLASHING APPLIED TO CMU BLOCK (MAY BE APPLIED TO COLUMNS, BEAMS, DOOR/WINDOW FLASHING AND/OR BRICK LEDGE FLASHING).
- BLACK WINDOW GLAZING PUTTY

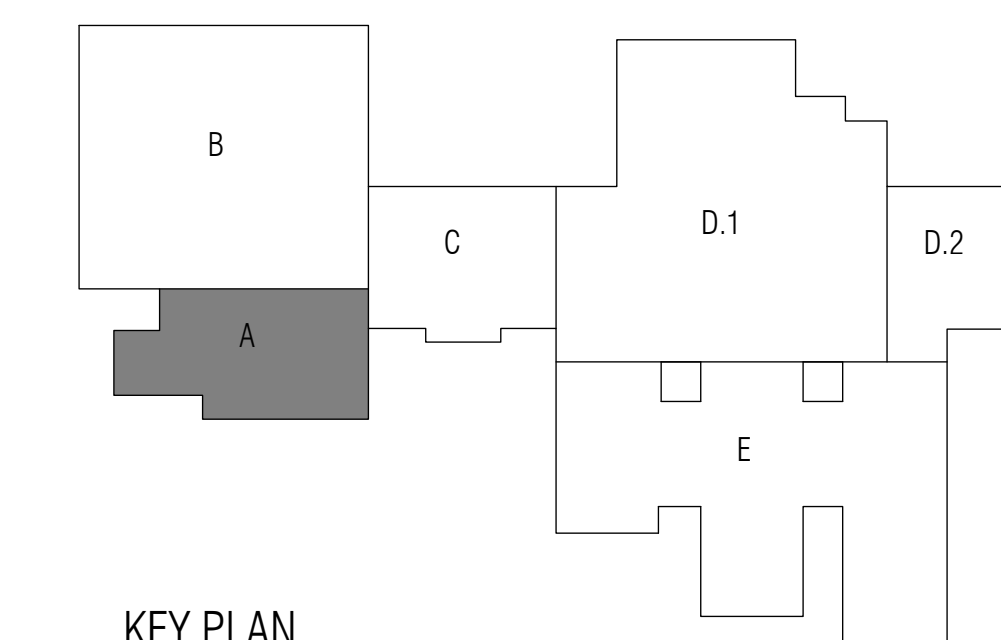


KEY PLAN

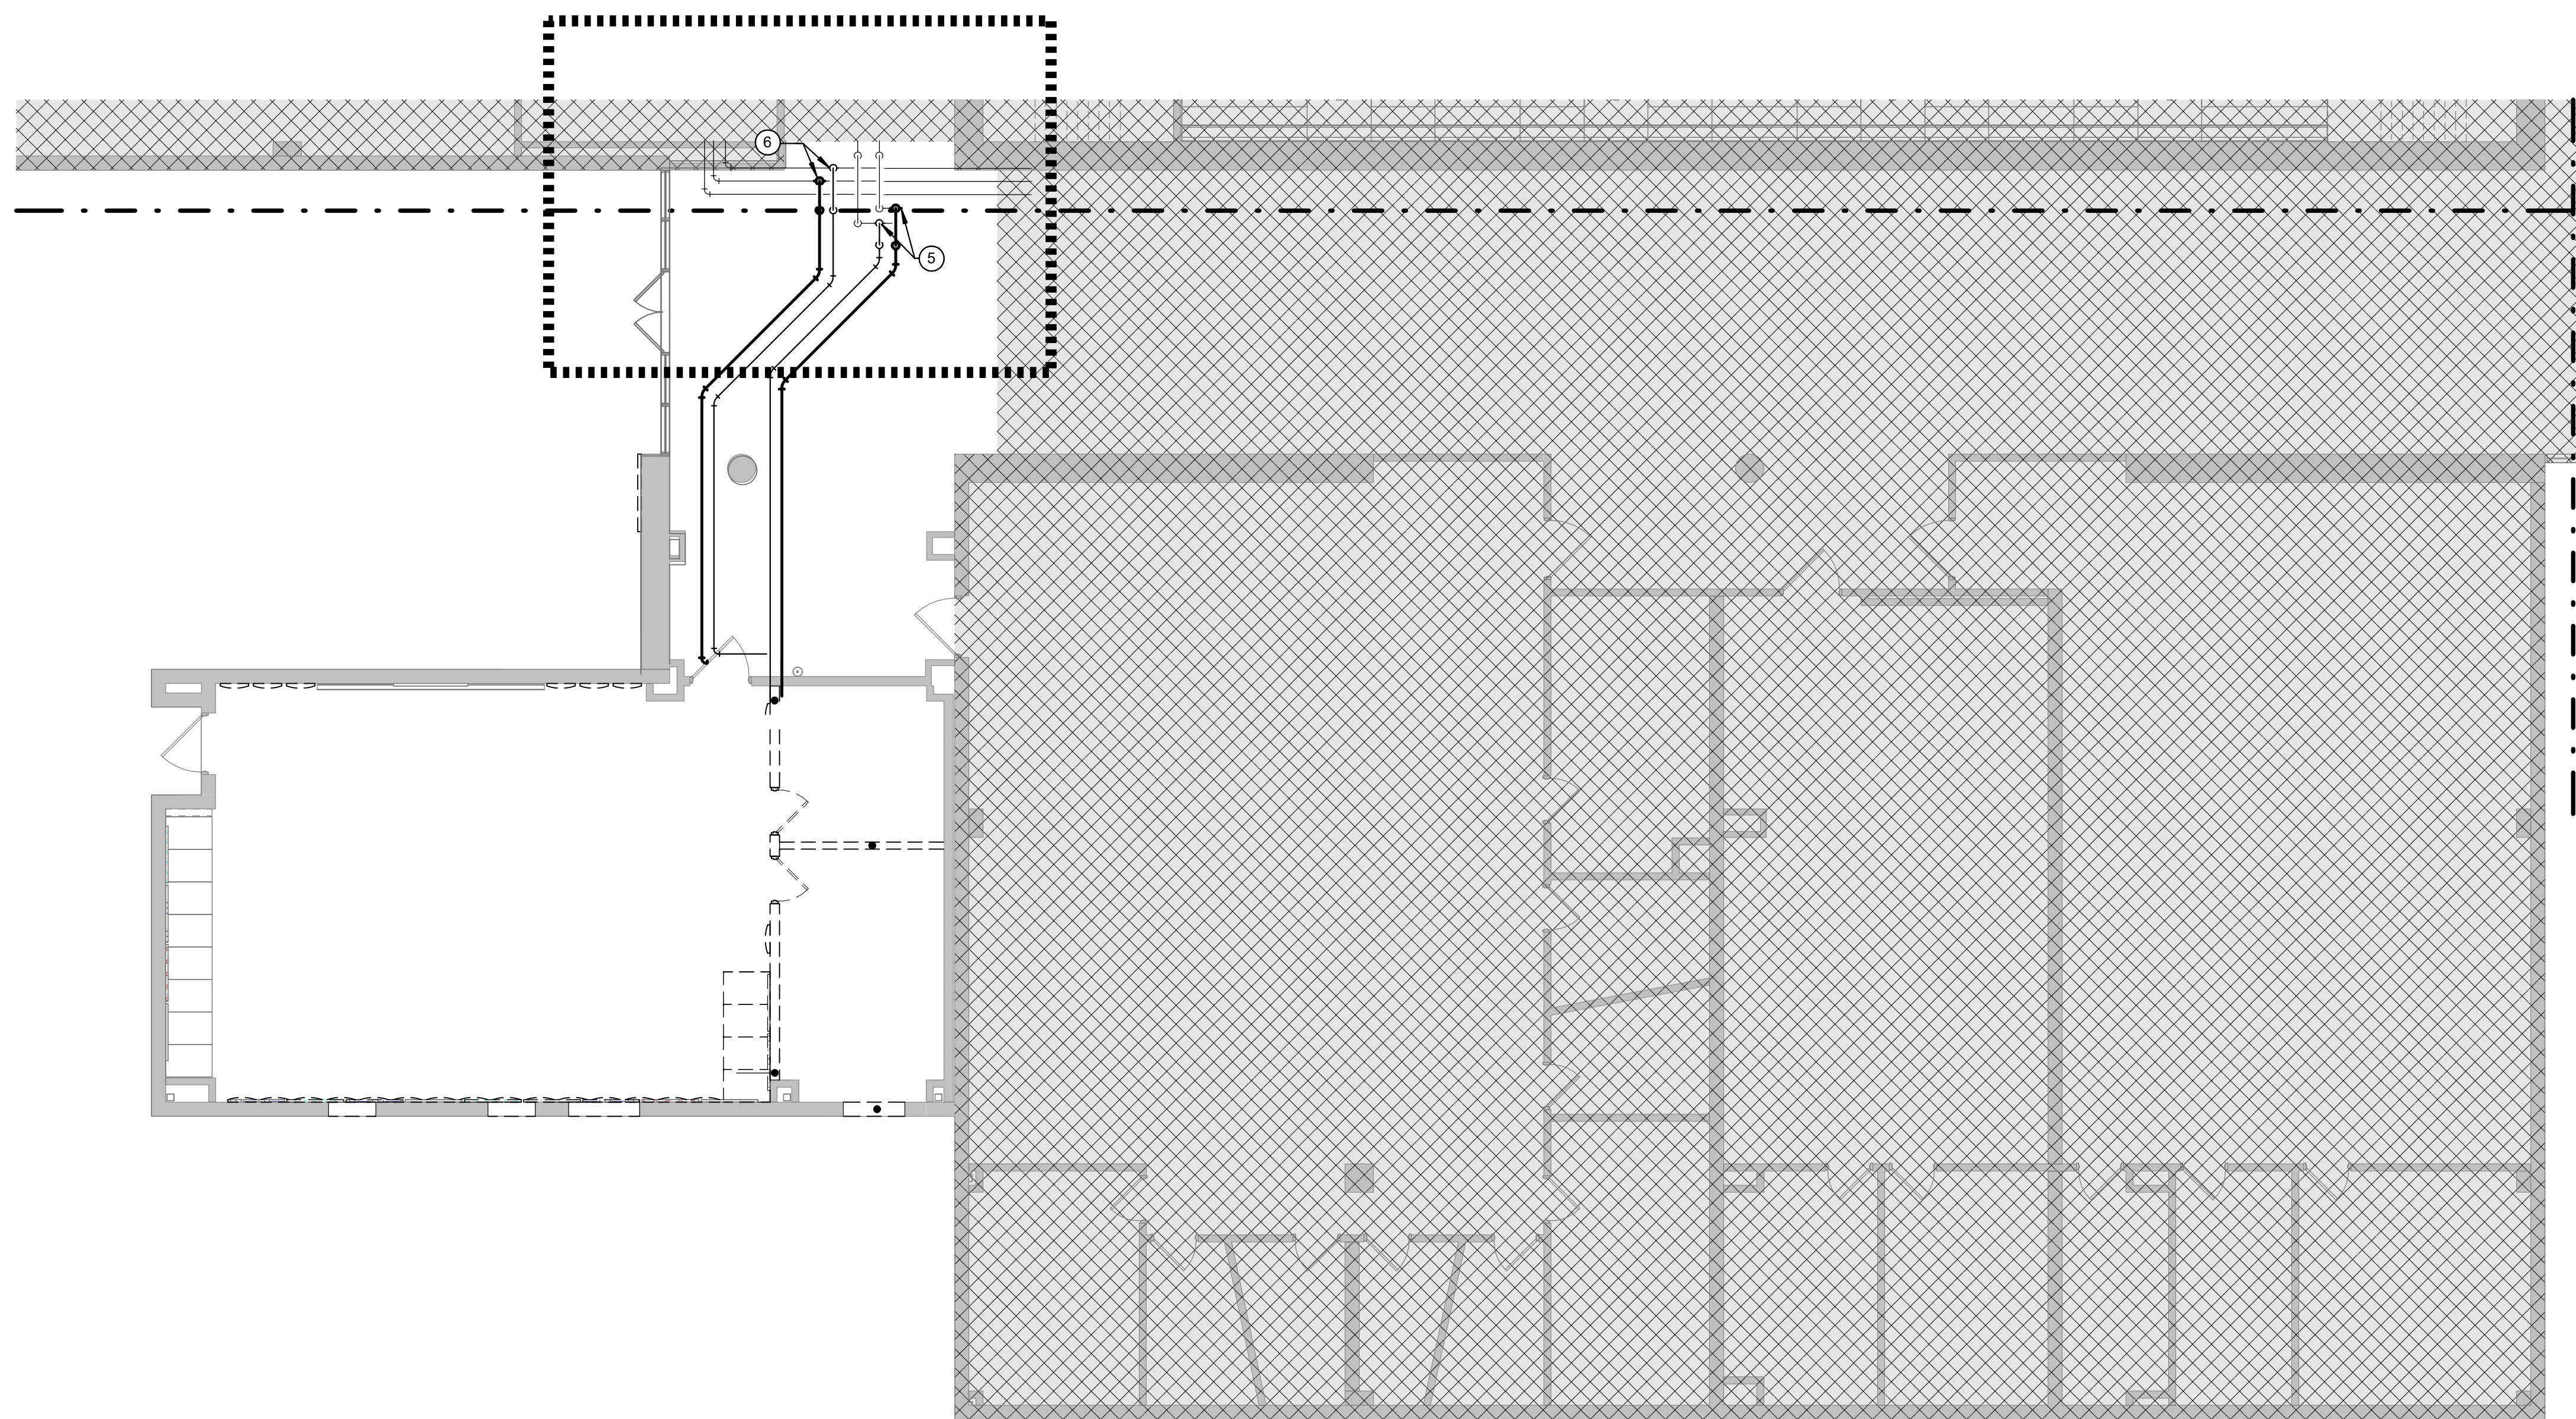

1 UNIT "A" ABATEMENT PLAN - LEVEL ONE

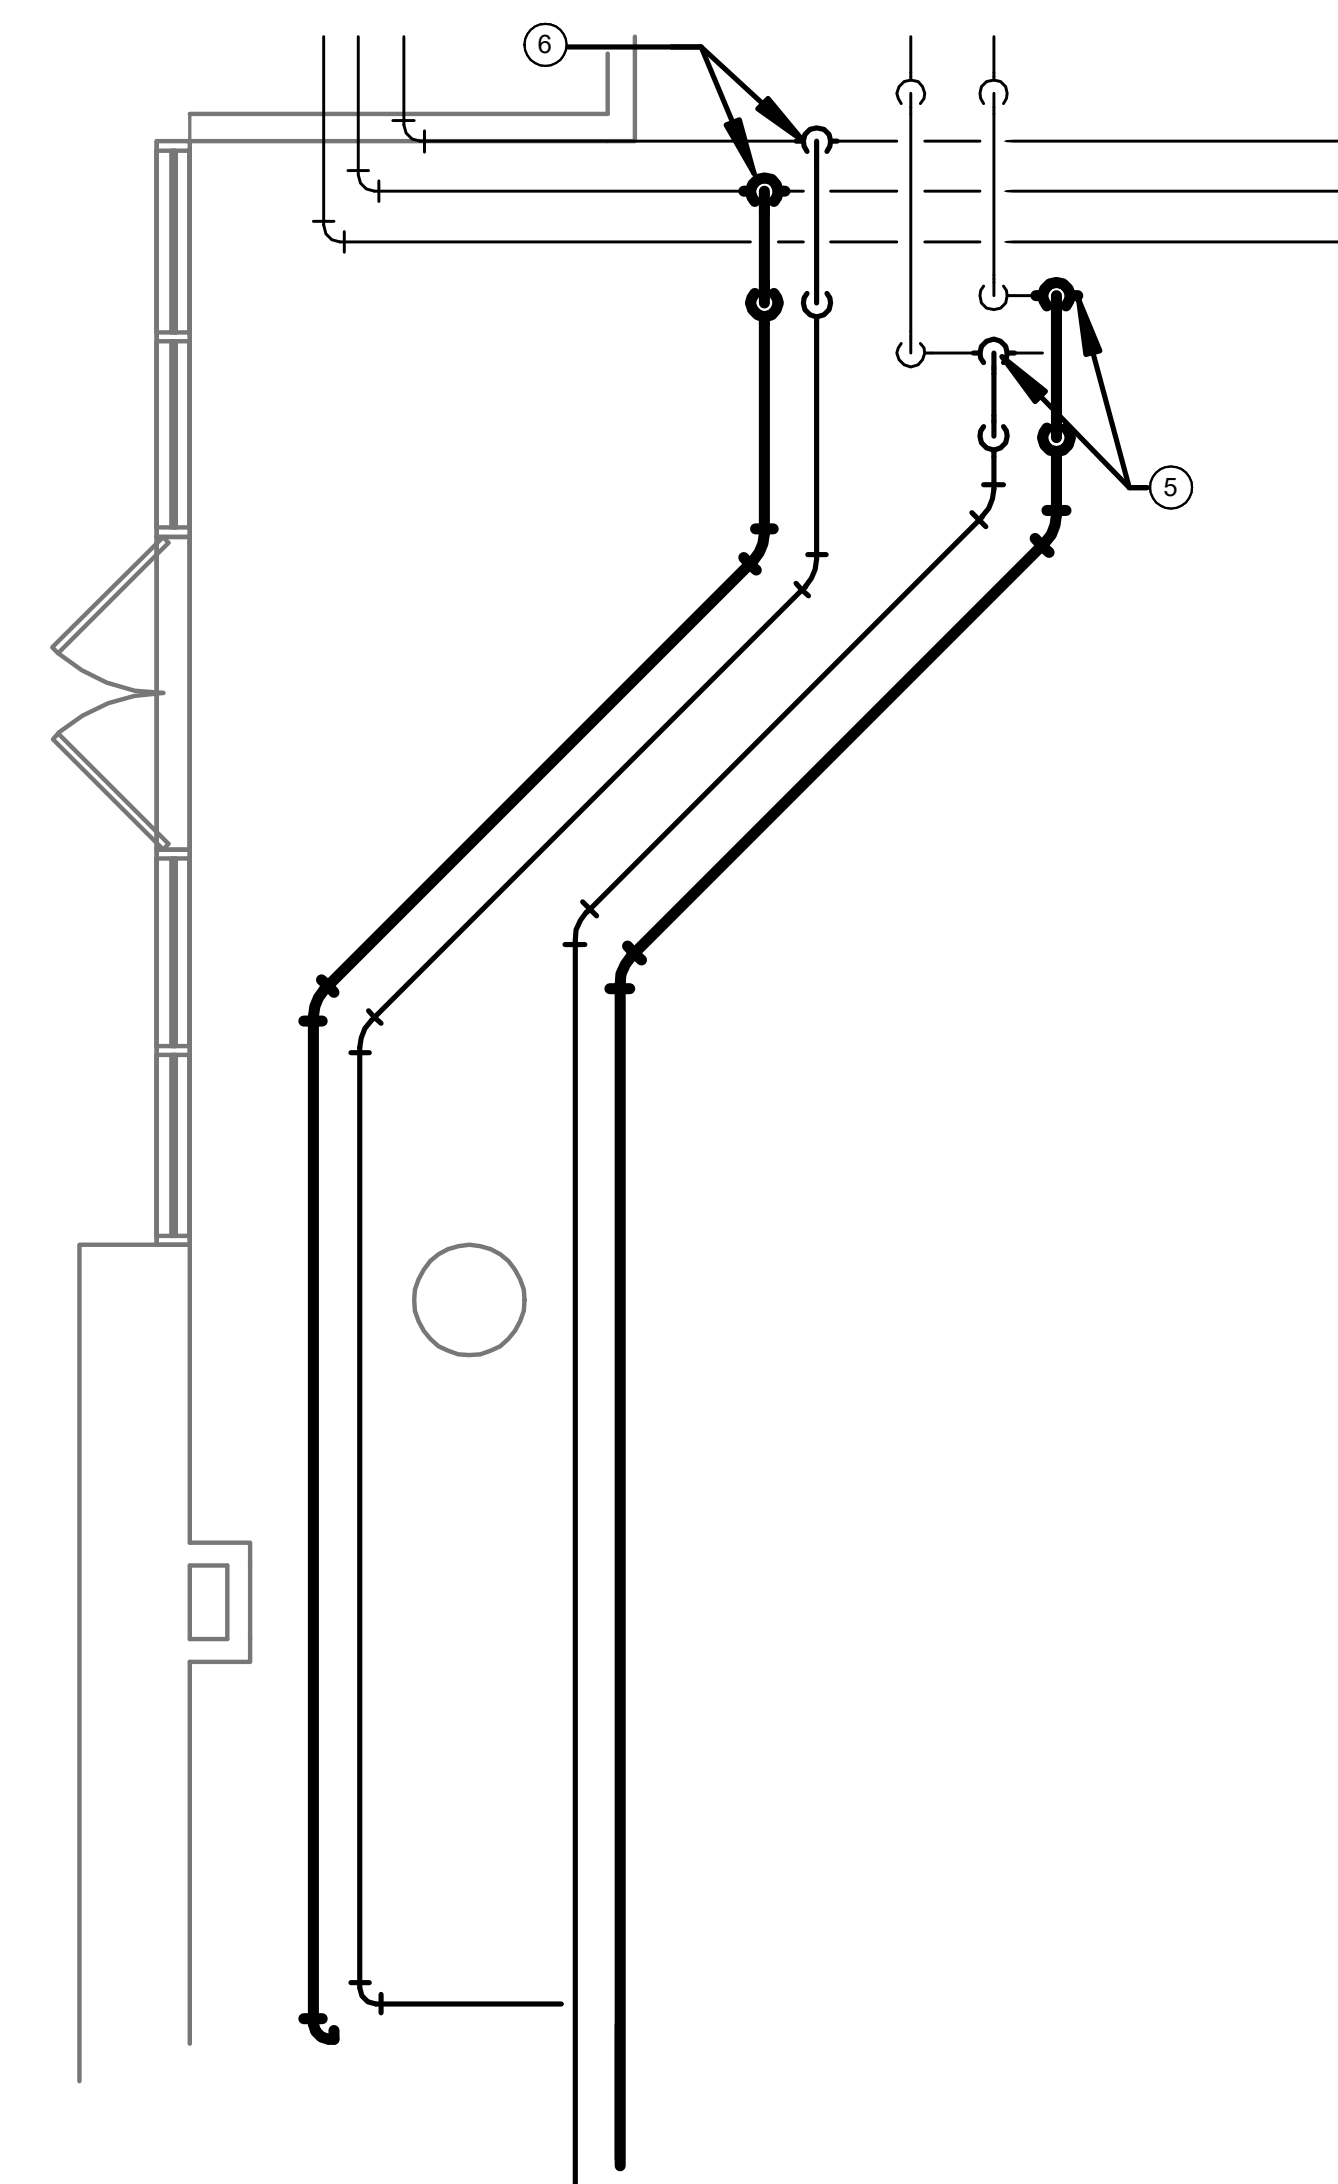

1 UNIT "A" ABATEMENT PLAN - LEVEL ONE MECHANICAL PIPING DETAIL

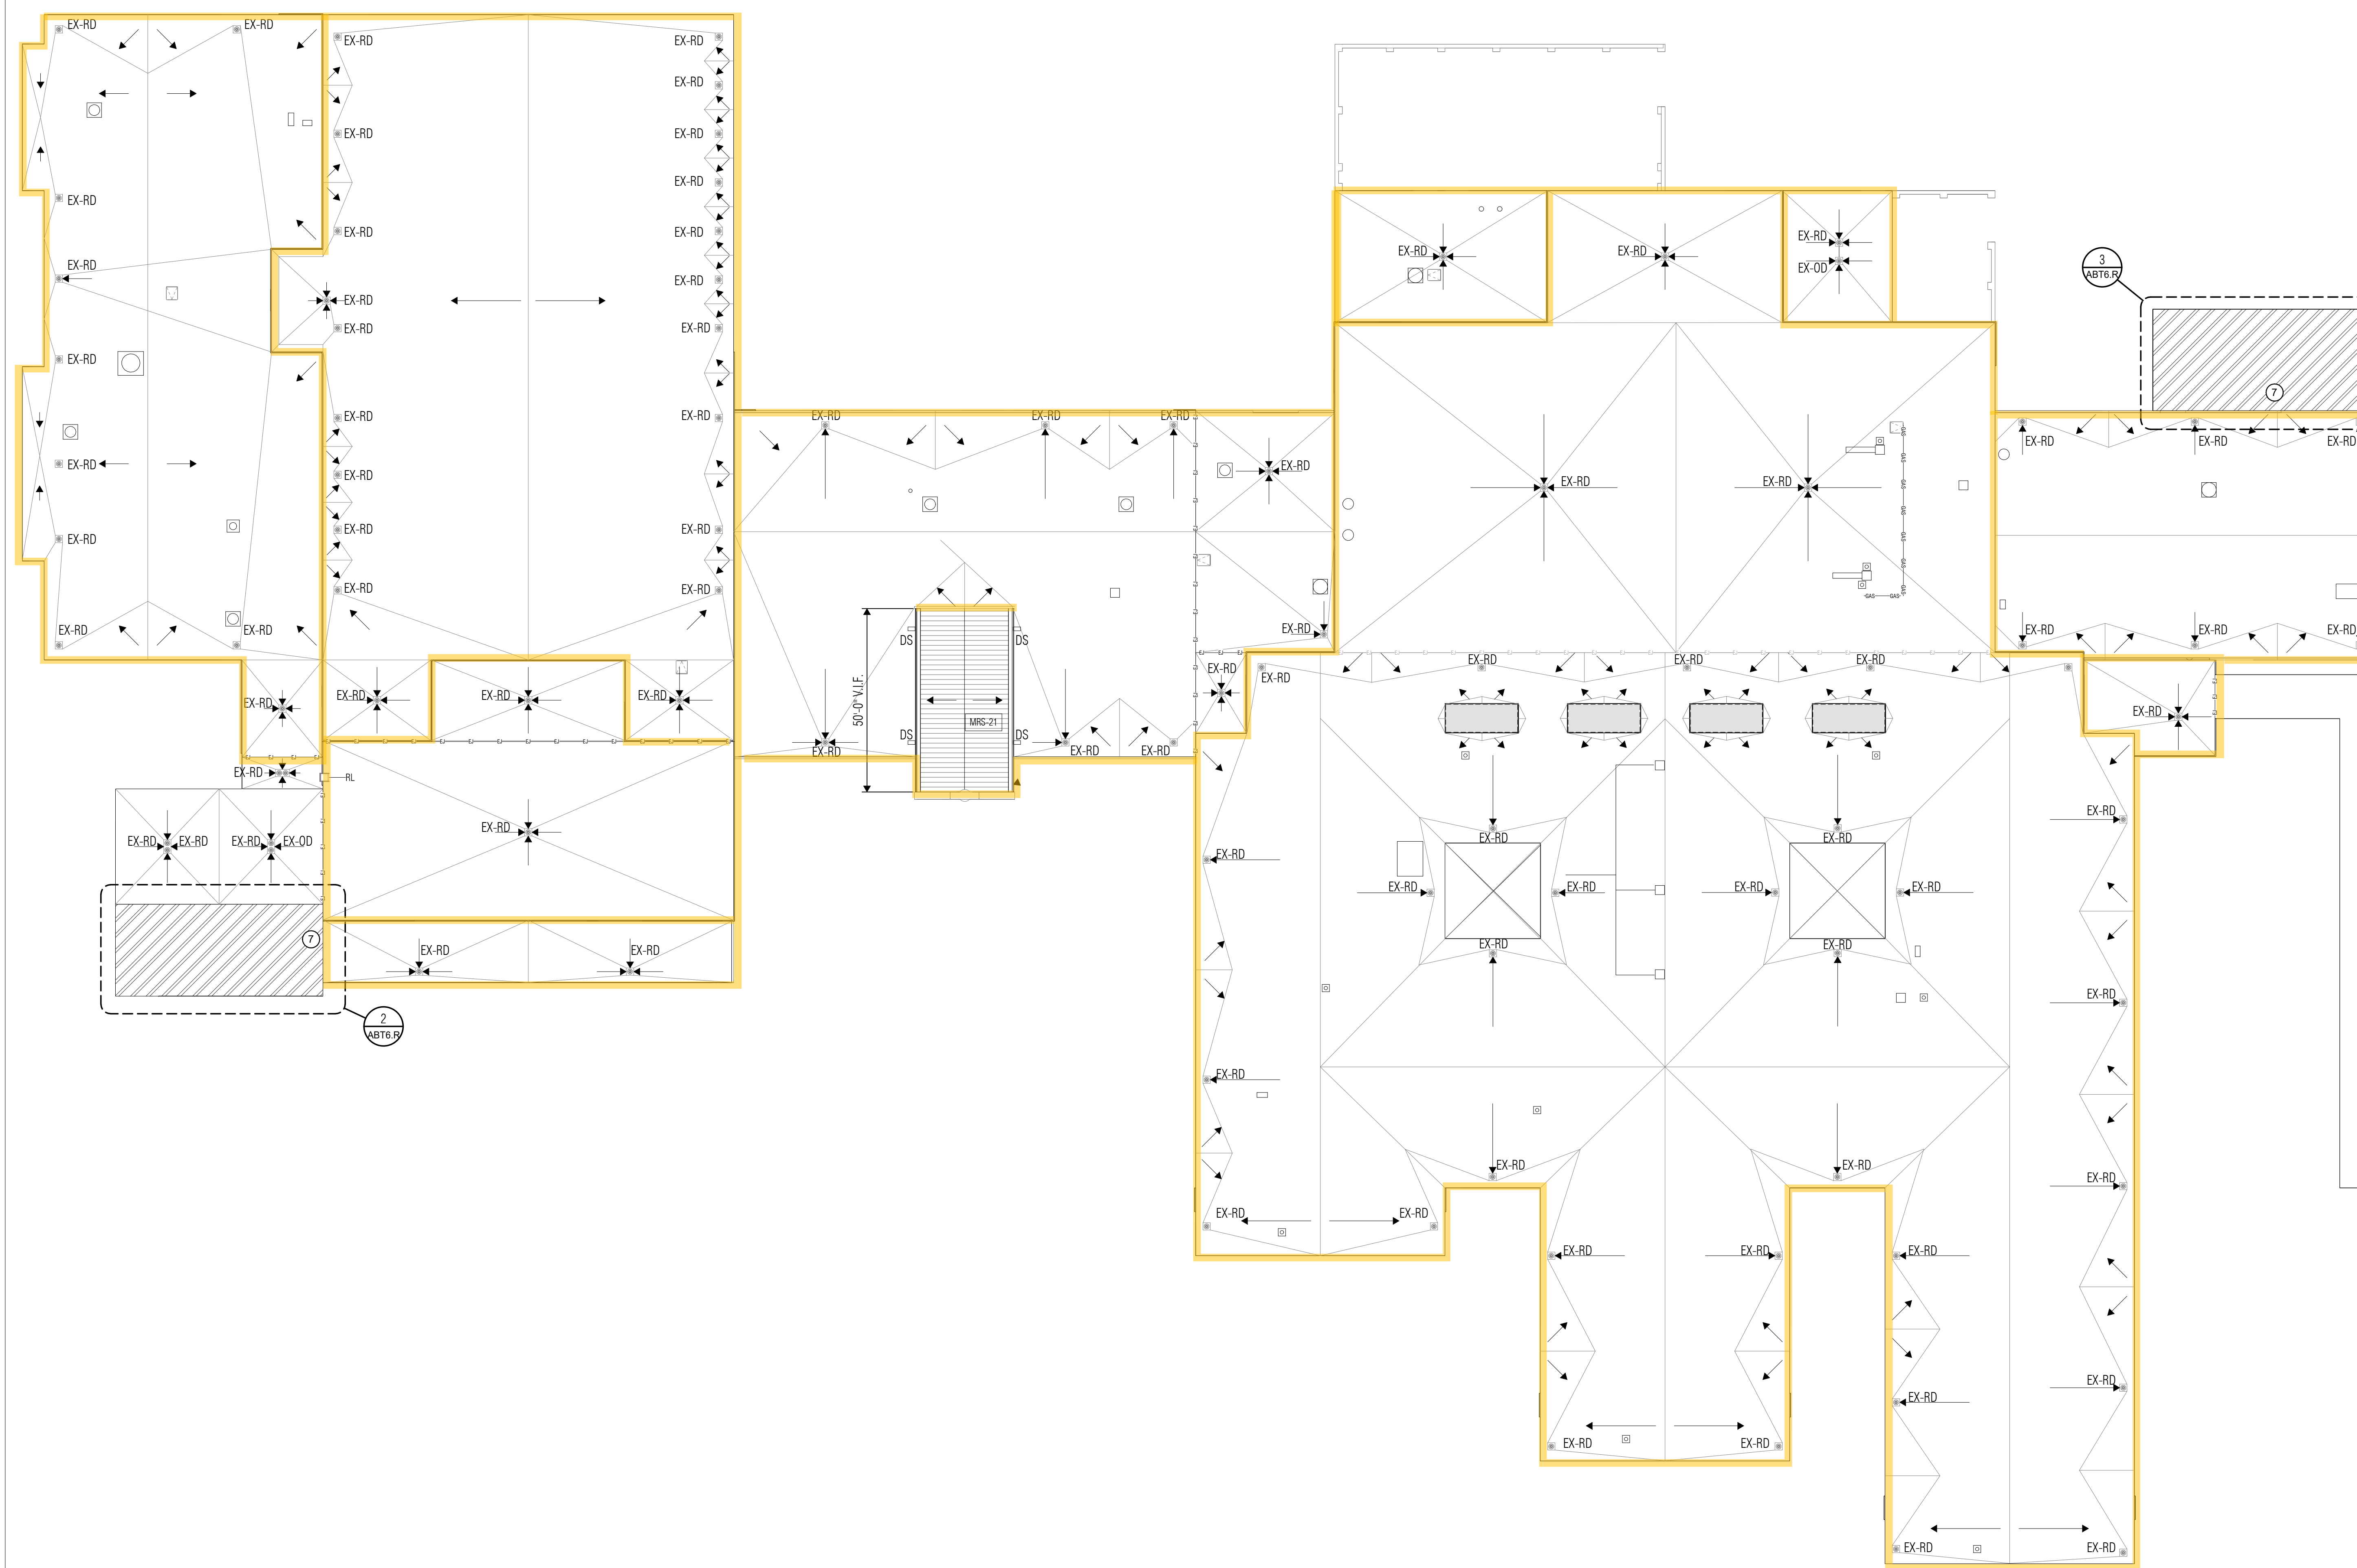

ABATEMENT PLAN GENERAL NOTES:

1. ABATEMENT PLANS WERE DERIVED FROM EXISTING BUILDING PLANS AND ARE INTENDED TO REASONABLY PRESENT EXISTING CONDITIONS. ABATEMENT CONTRACTOR SHALL VERIFY ACTUAL CONDITIONS AND COORDINATE ABATEMENT AND DEMOLITION WORK.
2. REFERENCE ARCHITECT'S DEMOLITION SPECIFICATIONS AND DRAWINGS FOR DEMOLITION REQUIREMENTS AND EXISTING BUILDING DRAWINGS FOR BUILDING CONSTRUCTION CONDITIONS.
3. THESE DRAWINGS ARE REPRESENTATIVE OF TYPICAL CONDITIONS IN THE BUILDING. HOWEVER, THE LOCATIONS OF ALL ASBESTOS CONTAINING MATERIALS ARE NOT SHOWN. ABATEMENT CONTRACTOR SHALL VERIFY ALL EXISTING CONDITIONS IN THE AREAS TO BE ABATED AND THE LOCATIONS OF ALL ASBESTOS-CONTAINING MATERIALS.
4. ABATEMENT CONTRACTOR SHALL BE RESPONSIBLE FOR ABATEMENT OF ALL ASBESTOS-CONTAINING MATERIALS.
5. THE ASBESTOS ABATEMENT SCOPE OF WORK IS DESCRIBED IN THE ABATEMENT SPECIFICATIONS. THE ASBESTOS ABATEMENT SCOPE OF WORK SHALL ALSO INCLUDE ANY HIDDEN ASBESTOS-CONTAINING MATERIALS THAT MAY BE ASSUMED OR UNCOVERED DURING THE BUILDING SELECTIVE DEMOLITION ACTIVITIES. THE ASBESTOS-CONTAINING MATERIALS IDENTIFIED IN THE BUILDING INCLUDE, AS A MINIMUM, THE FOLLOWING MATERIALS: INTERIOR ASBESTOS-CONTAINING MATERIALS: BLACK DAMPPROOFING MASTICS AND ANY ASSOCIATED FLASHINGS, CREAM/TAN DUCT MASTIC, OLD DOMESTIC HOT WATER PIPE INSULATION WITH WHITE/CREAM MASTIC, CHILLED HEATING WATER PIPE INSULATION WITH WHITE/CREAM MASTIC, BLACK WINDOW GLAZING PUTTY AROUND INTERIOR WINDOWS, AND FIRE DOORS (ASSUMED ASBESTOS); EXTERIOR ASBESTOS-CONTAINING MATERIALS: BLACK DAMPPROOFING MASTICS AND ANY ASSOCIATED FLASHINGS.
6. ABATEMENT CONTRACTOR SHALL BE RESPONSIBLE FOR DETERMINING AND VERIFYING THE ACTUAL QUANTITIES OF ALL ASBESTOS-CONTAINING MATERIALS AND OTHER REGULATED MATERIALS THAT WILL BE ABATED UNDER THE IDENTIFIED SCOPE OF WORK. WHILE SOME OF THE EXISTING AREAS OF ASBESTOS-CONTAINING MATERIALS ARE ACCESSIBLE OR EXPOSED, OTHER AREAS OF ASBESTOS-CONTAINING MATERIALS MAY BE "HIDDEN" (E.G. LOCATED ABOVE CEILINGS, IN WALLS OR CHASES, UNDER CARPET OR OTHER FLOOR FINISH MATERIALS, ABOVE AND/OR UNDER WALLS, MILLWORK, ETC.). ALL "HIDDEN" AREAS OF ASBESTOS-CONTAINING MATERIALS SCHEDULED FOR DEMOLITION IN THE SUBJECT BUILDING SHALL BE UNCOVERED AND ABATED BY THE ABATEMENT CONTRACTOR AS PART OF THE PROJECT SCOPE OF WORK.
7. PERFORM SELECTIVE DEMOLITION OF WALL AREAS, CEILING AREAS, FLOOR AREAS, CHASE AREAS, ETC. AS REQUIRED TO UNCOVER AND LOCATE ALL "HIDDEN" AREAS OF ASBESTOS-CONTAINING MATERIALS IN AREAS SCHEDULED FOR DEMOLITION IN THE SUBJECT BUILDING.
8. FOR INTERIOR OR EXTERIOR WALL OPENINGS THAT IMPACT ASBESTOS CONTAINING MATERIALS, THE GENERAL CONTRACTOR IS RESPONSIBLE FOR IDENTIFYING AND MARKING OFF ANY NEW WALL OPENING LOCATIONS FOR THE ABATEMENT CONTRACTOR.

ABATEMENT PLAN KEYED NOTES:


1. DAMP PROOFING BLACK MASTIC APPLIED TO EXTERIOR CMU BLOCK AND ANY ASSOCIATED FLASHING/MASTIC AROUND DOORS/WINDOWS AND AT COLUMNS, BEAMS OR BRICK LEDGES IN THIS AREA ARE TO BE ABATED. (NEESHAP METHODS) REFER TO THE ARCHITECTURAL DRAWINGS FOR EXACT SCOPE OF DEMO AND REMOVAL. FIELD VERIFY ALL COMPONENTS TO BE DEMOLISHED.
2. DAMP PROOFING BLACK MASTIC APPLIED TO INTERIOR (ONCE EXTERIOR WALL) CMU BLOCK AND ANY ASSOCIATED FLASHING/MASTIC AROUND DOORS/WINDOWS AND ON COLUMNS, BEAMS OR BRICK LEDGES IN THIS AREA ARE TO BE ABATED. (THAPR - FULL CONTAINMENT) REFER TO THE ARCHITECTURAL DRAWINGS FOR EXACT SCOPE OF DEMO AND REMOVAL. FIELD VERIFY ALL COMPONENTS TO BE DEMOLISHED.
3. BLACK WINDOW GLAZING PUTTY IN THIS AREA IS TO BE ABATED (THAPR - FULL CONTAINMENT) FROM THE WINDOW FRAMING SYSTEM. REFER TO THE ARCHITECTURAL DRAWINGS FOR EXACT SCOPE OF REMOVAL. FIELD VERIFY ALL COMPONENTS TO BE REMOVED.
4. DAMP PROOFING BLACK MASTIC APPLIED TO INTERIOR (ONCE EXTERIOR WALL) CMU BLOCK AND ASSOCIATED FLASHING/MASTIC AT LOUVERS IN THIS AREA ARE TO BE ABATED. (THAPR - FULL CONTAINMENT) REFER TO THE M.E.P. DRAWINGS FOR EXACT SCOPE OF DEMO AND REMOVAL. FIELD VERIFY ALL COMPONENTS TO BE DEMOLISHED.
5. WHITE OR CREAM MASTIC APPLIED TO CHILLED WATER PIPE INSULATION RUNS AND FITTINGS IN THIS AREA IS TO BE ABATED FROM CEILING PLENUM AREA. REFER TO THE ARCHITECTURAL M.E.P. DRAWINGS FOR EXACT SCOPE OF REMOVAL. FIELD VERIFY ALL COMPONENTS/MATERIALS TO BE REMOVED. (THAPR - FULL CONTAINMENT OR GLOVEBAG).
6. WHITE OR CREAM MASTIC APPLIED TO HEATING WATER PIPE INSULATION RUNS AND FITTINGS IN THIS AREA IS TO BE ABATED FROM CEILING PLENUM AREA. REFER TO THE ARCHITECTURAL M.E.P. DRAWINGS FOR EXACT SCOPE OF REMOVAL. FIELD VERIFY ALL COMPONENTS/MATERIALS TO BE REMOVED. (THAPR - FULL CONTAINMENT OR GLOVEBAG).
7. DAMP PROOFING BLACK MASTIC APPLIED TO CMU BLOCK AND/OR INSULATION WITH BLACK MASTIC SEALANT BEHIND BRICK VENEER IN THIS AREA IS TO BE ABATED FOR NEW THROUGH-WALL FLASHING INSTALLATION. (NEESHAP METHODS) REFER TO THE ARCHITECTURAL DRAWINGS FOR EXACT SCOPE OF DEMOLITION AND REMOVAL. FIELD VERIFY ALL COMPONENTS TO BE DEMOLISHED.

ASBESTOS LEGEND (LOCATION PURPOSES ONLY)


- BLACK MASTIC DAMP PROOFING AND ASSOCIATED FLASHING APPLIED TO CMU BLOCK (MAY BE APPLIED TO COLUMNS, BEAMS, DOOR/WINDOW FLASHING AND/OR BRICK LEDGE FLASHING).
- BLACK WINDOW GLAZING PUTTY

ASBESTOS LEGEND (LOCATION PURPOSES ONLY)


- BLACK MASTIC DAMP PROOFING AND ASSOCIATED FLASHING APPLIED TO CMU BLOCK (MAY BE APPLIED TO COLUMNS, BEAMS, DOOR/WINDOW FLASHING AND/OR BRICK LEDGE FLASHING).
- BLACK WINDOW GLAZING PUTTY

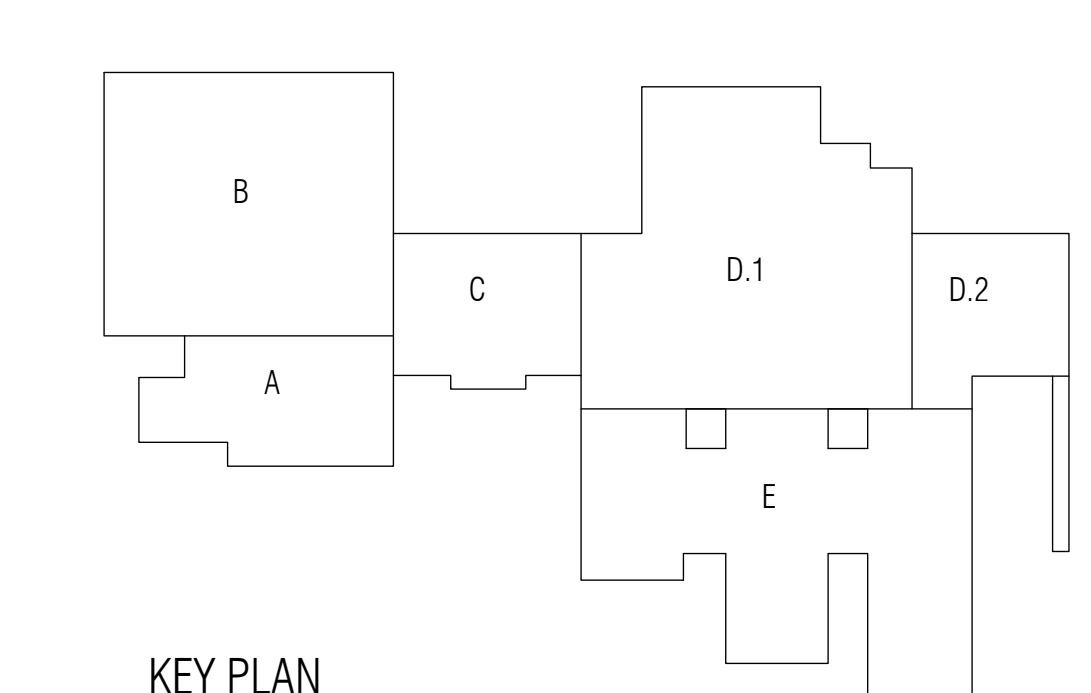

1 OVERALL ROOF ABATEMENT PLAN
SCALE: 3/64" = 1'-0"

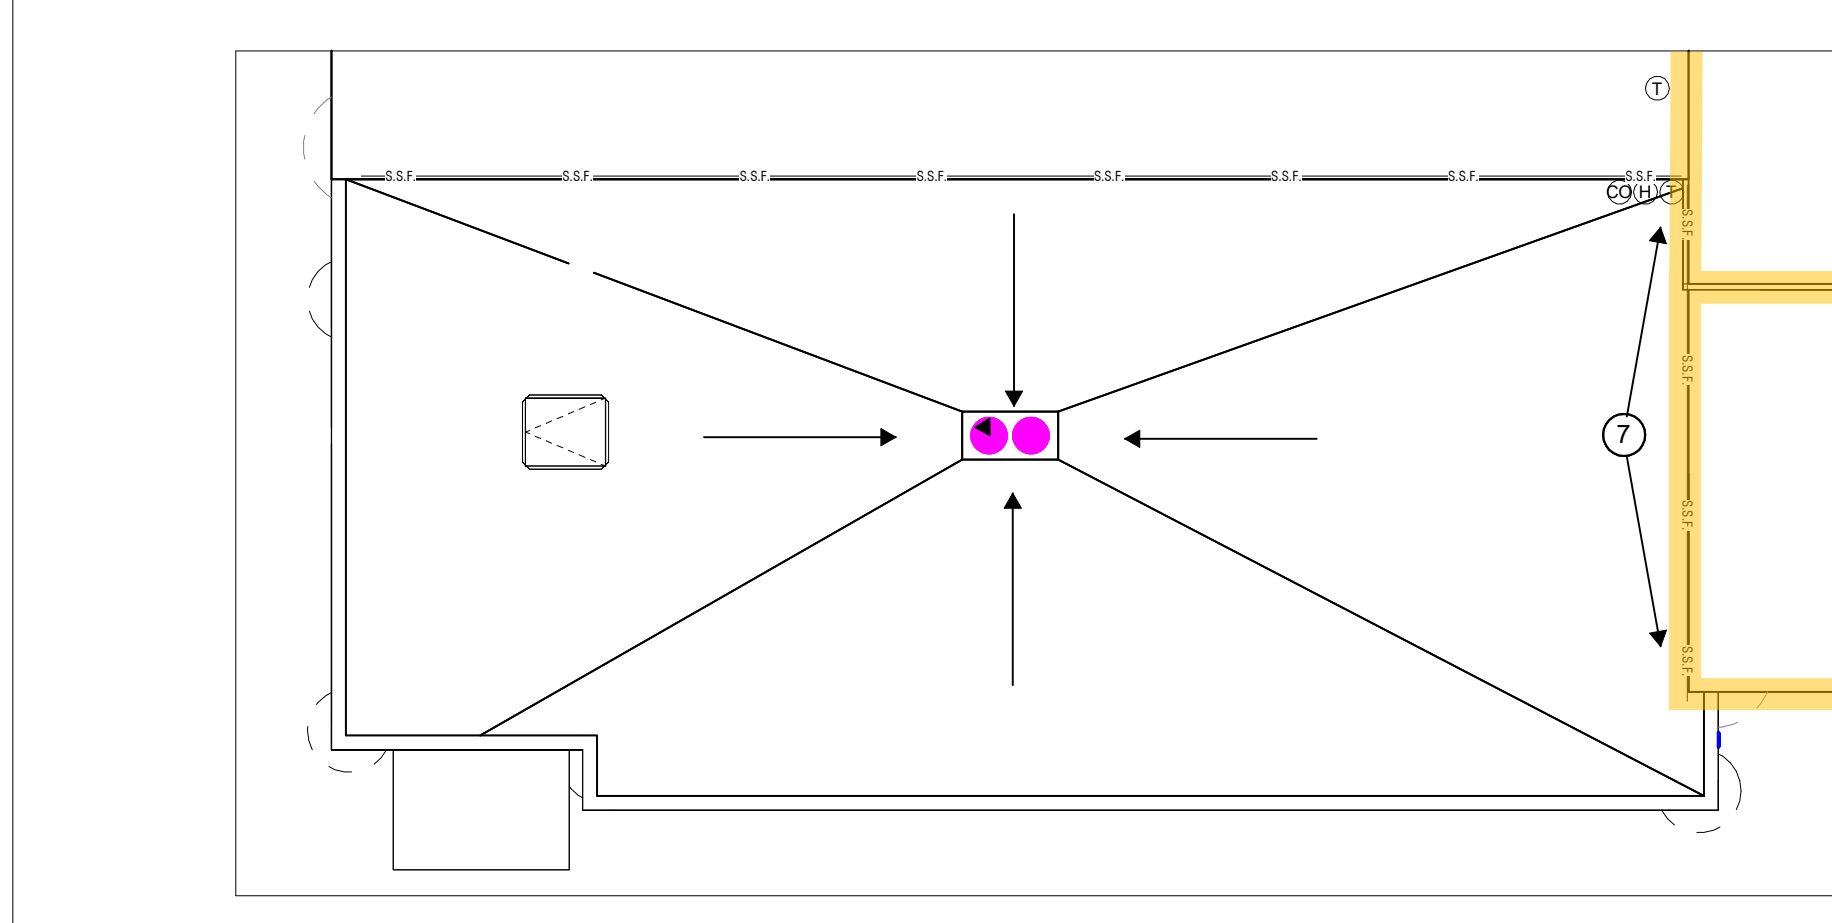

2 ROOF ABATEMENT PLAN AREA A
SCALE: 1/8" = 1'-0"

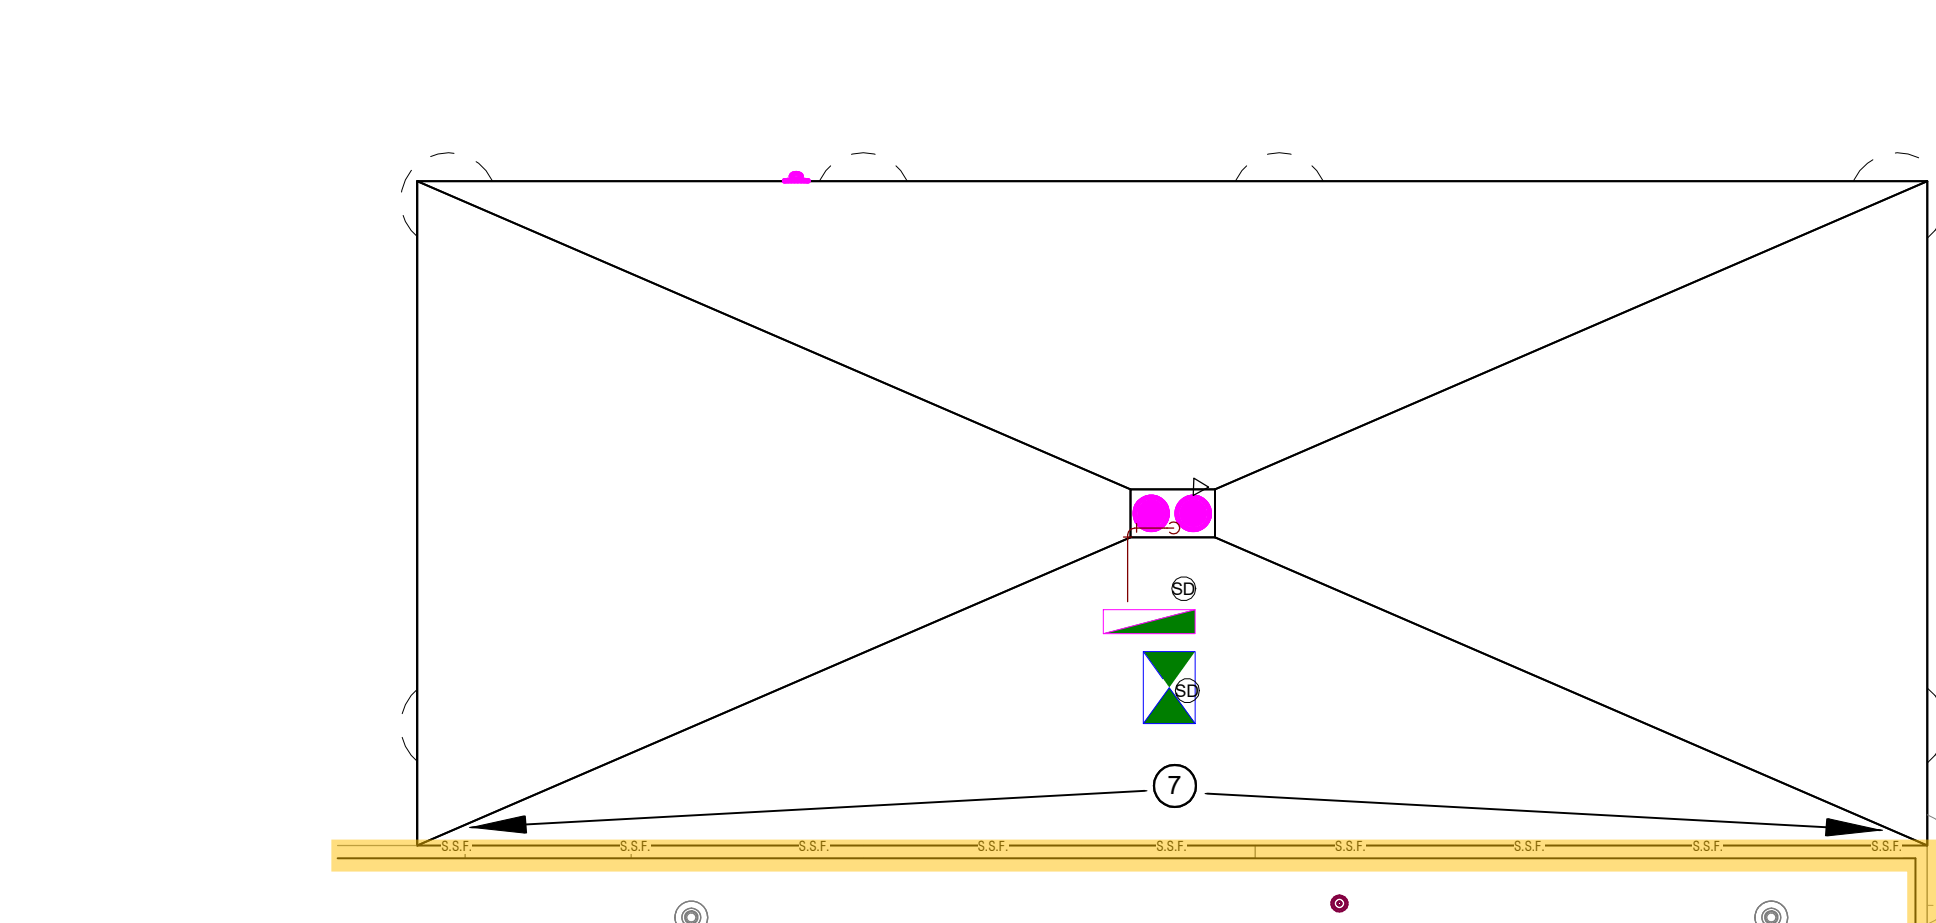

3 ROOF ABATEMENT PLAN AREA D2
SCALE: 1/8" = 1'-0"

Issue For Proposal

Signature
SAM HUFF TDSSH# 105902
SAM.HUFF@EFIGLOBAL.COM
EFI PROJECT#: 029.07283

ISSUED: February 28, 2025

REVISIONS	
Revision No.	Revision Date
ADDENDUM #01	MARCH 6, 2025

Director RA
Designer
Proj. Coord.

Drawn By SH
Quality Control
EFI PROJECT NO.
029.07284
SHEET TITLE
LABAY - UNIT A
ABATEMENT PLAN - LEVEL ONE
SHEET NO.

ABT6.R

2024 Cook, Labay, and Truitt MS Renovation

ABATEMENT PLAN GENERAL NOTES:



1. ABATEMENT PLANS WERE DERIVED FROM EXISTING BUILDING PLANS AND ARE INTENDED TO REASONABLY PRESENT EXISTING CONDITIONS. ABATEMENT CONTRACTOR SHALL VERIFY ACTUAL CONDITIONS AND COORDINATE ABATEMENT AND DEMOLITION WORK.
2. REFERENCE ARCHITECT'S DEMOLITION SPECIFICATIONS AND DRAWINGS FOR DEMOLITION REQUIREMENTS AND EXISTING BUILDING DRAWINGS FOR BUILDING CONSTRUCTION CONDITIONS.
3. THESE DRAWINGS ARE REPRESENTATIVE OF TYPICAL CONDITIONS IN THE BUILDING. HOWEVER, THE LOCATIONS OF ALL ASBESTOS CONTAINING MATERIALS ARE NOT SHOWN. ABATEMENT CONTRACTOR SHALL VERIFY ALL EXISTING CONDITIONS IN THE AREAS TO BE ABATED AND THE LOCATIONS OF ALL ASBESTOS-CONTAINING MATERIALS.
4. ABATEMENT CONTRACTOR SHALL BE RESPONSIBLE FOR ABATEMENT OF ALL ASBESTOS-CONTAINING MATERIALS.
5. THE ASBESTOS ABATEMENT SCOPE OF WORK IS DESCRIBED IN THE ABATEMENT SPECIFICATIONS. THE ASBESTOS ABATEMENT SCOPE OF WORK SHALL ALSO INCLUDE ANY HIDDEN ASBESTOS-CONTAINING MATERIALS THAT MAY BE ASSUMED OR UNCOVERED DURING THE BUILDING SELECTIVE DEMOLITION ACTIVITIES. THE ASBESTOS-CONTAINING MATERIALS IDENTIFIED IN THE BUILDING INCLUDE, AS A MINIMUM, THE FOLLOWING MATERIALS: INTERIOR ASBESTOS-CONTAINING MATERIALS: BLACK WINDOW GLAZING PUTTY AROUND INTERIOR WINDOWS AND FIRE DOORS (ASSUMED ASBESTOS).
6. ABATEMENT CONTRACTOR SHALL BE RESPONSIBLE FOR DETERMINING AND VERIFYING THE ACTUAL QUANTITIES OF ALL ASBESTOS-CONTAINING MATERIALS AND OTHER REGULATED MATERIALS THAT WILL BE ABATED UNDER THE IDENTIFIED SCOPE OF WORK. WHILE SOME OF THE EXISTING AREAS OF ASBESTOS-CONTAINING MATERIALS ARE ACCESSIBLE OR EXPOSED, OTHER AREAS OF ASBESTOS-CONTAINING MATERIALS MAY BE "HIDDEN" (E.G. LOCATED ABOVE CEILINGS; IN WALLS OR CHASES; UNDER CARPET OR OTHER FLOOR FINISH MATERIALS; ABOVE AND/OR UNDER WALLS; MILLWORK, ETC.). ALL "HIDDEN" AREAS OF ASBESTOS-CONTAINING MATERIALS IN AREAS SCHEDULED FOR DEMOLITION IN THE SUBJECT BUILDING SHALL BE UNCOVERED AND ABATED BY THE ABATEMENT CONTRACTOR AS PART OF THE PROJECT SCOPE OF WORK.
7. PERFORM SELECTIVE DEMOLITION OF WALL AREAS, CEILING AREAS, FLOOR AREAS, CHASE AREAS, ETC. AS REQUIRED TO UNCOVER AND LOCATE ALL "HIDDEN" AREAS OF ASBESTOS-CONTAINING MATERIALS IN AREAS SCHEDULED FOR DEMOLITION IN THE SUBJECT BUILDING.

ABATEMENT PLAN KEYED NOTES:

1. BLACK WINDOW GLAZING PUTTY IN THIS AREA IS TO BE ABATED (THAPR - FULL CONTAINMENT) FROM THE WINDOW FRAMING SYSTEM. REFER TO THE ARCHITECTURAL DRAWINGS FOR EXACT SCOPE OF REMOVAL. FIELD VERIFY ALL COMPONENTS TO BE REMOVED.
2. MIRROR MASTIC AND ASSOCIATED MIRROR IN THIS AREA IS TO BE ABATED (THAPR - FULL CONTAINMENT). REFER TO THE ARCHITECTURAL DRAWINGS FOR EXACT SCOPE OF DEMOLITION AND REMOVAL. FIELD VERIFY ALL COMPONENTS TO BE DEMOLISHED.

ASBESTOS LEGEND (LOCATION PURPOSES ONLY)

- BLACK MIRROR MASTIC
- BLACK WINDOW GLAZING PUTTY

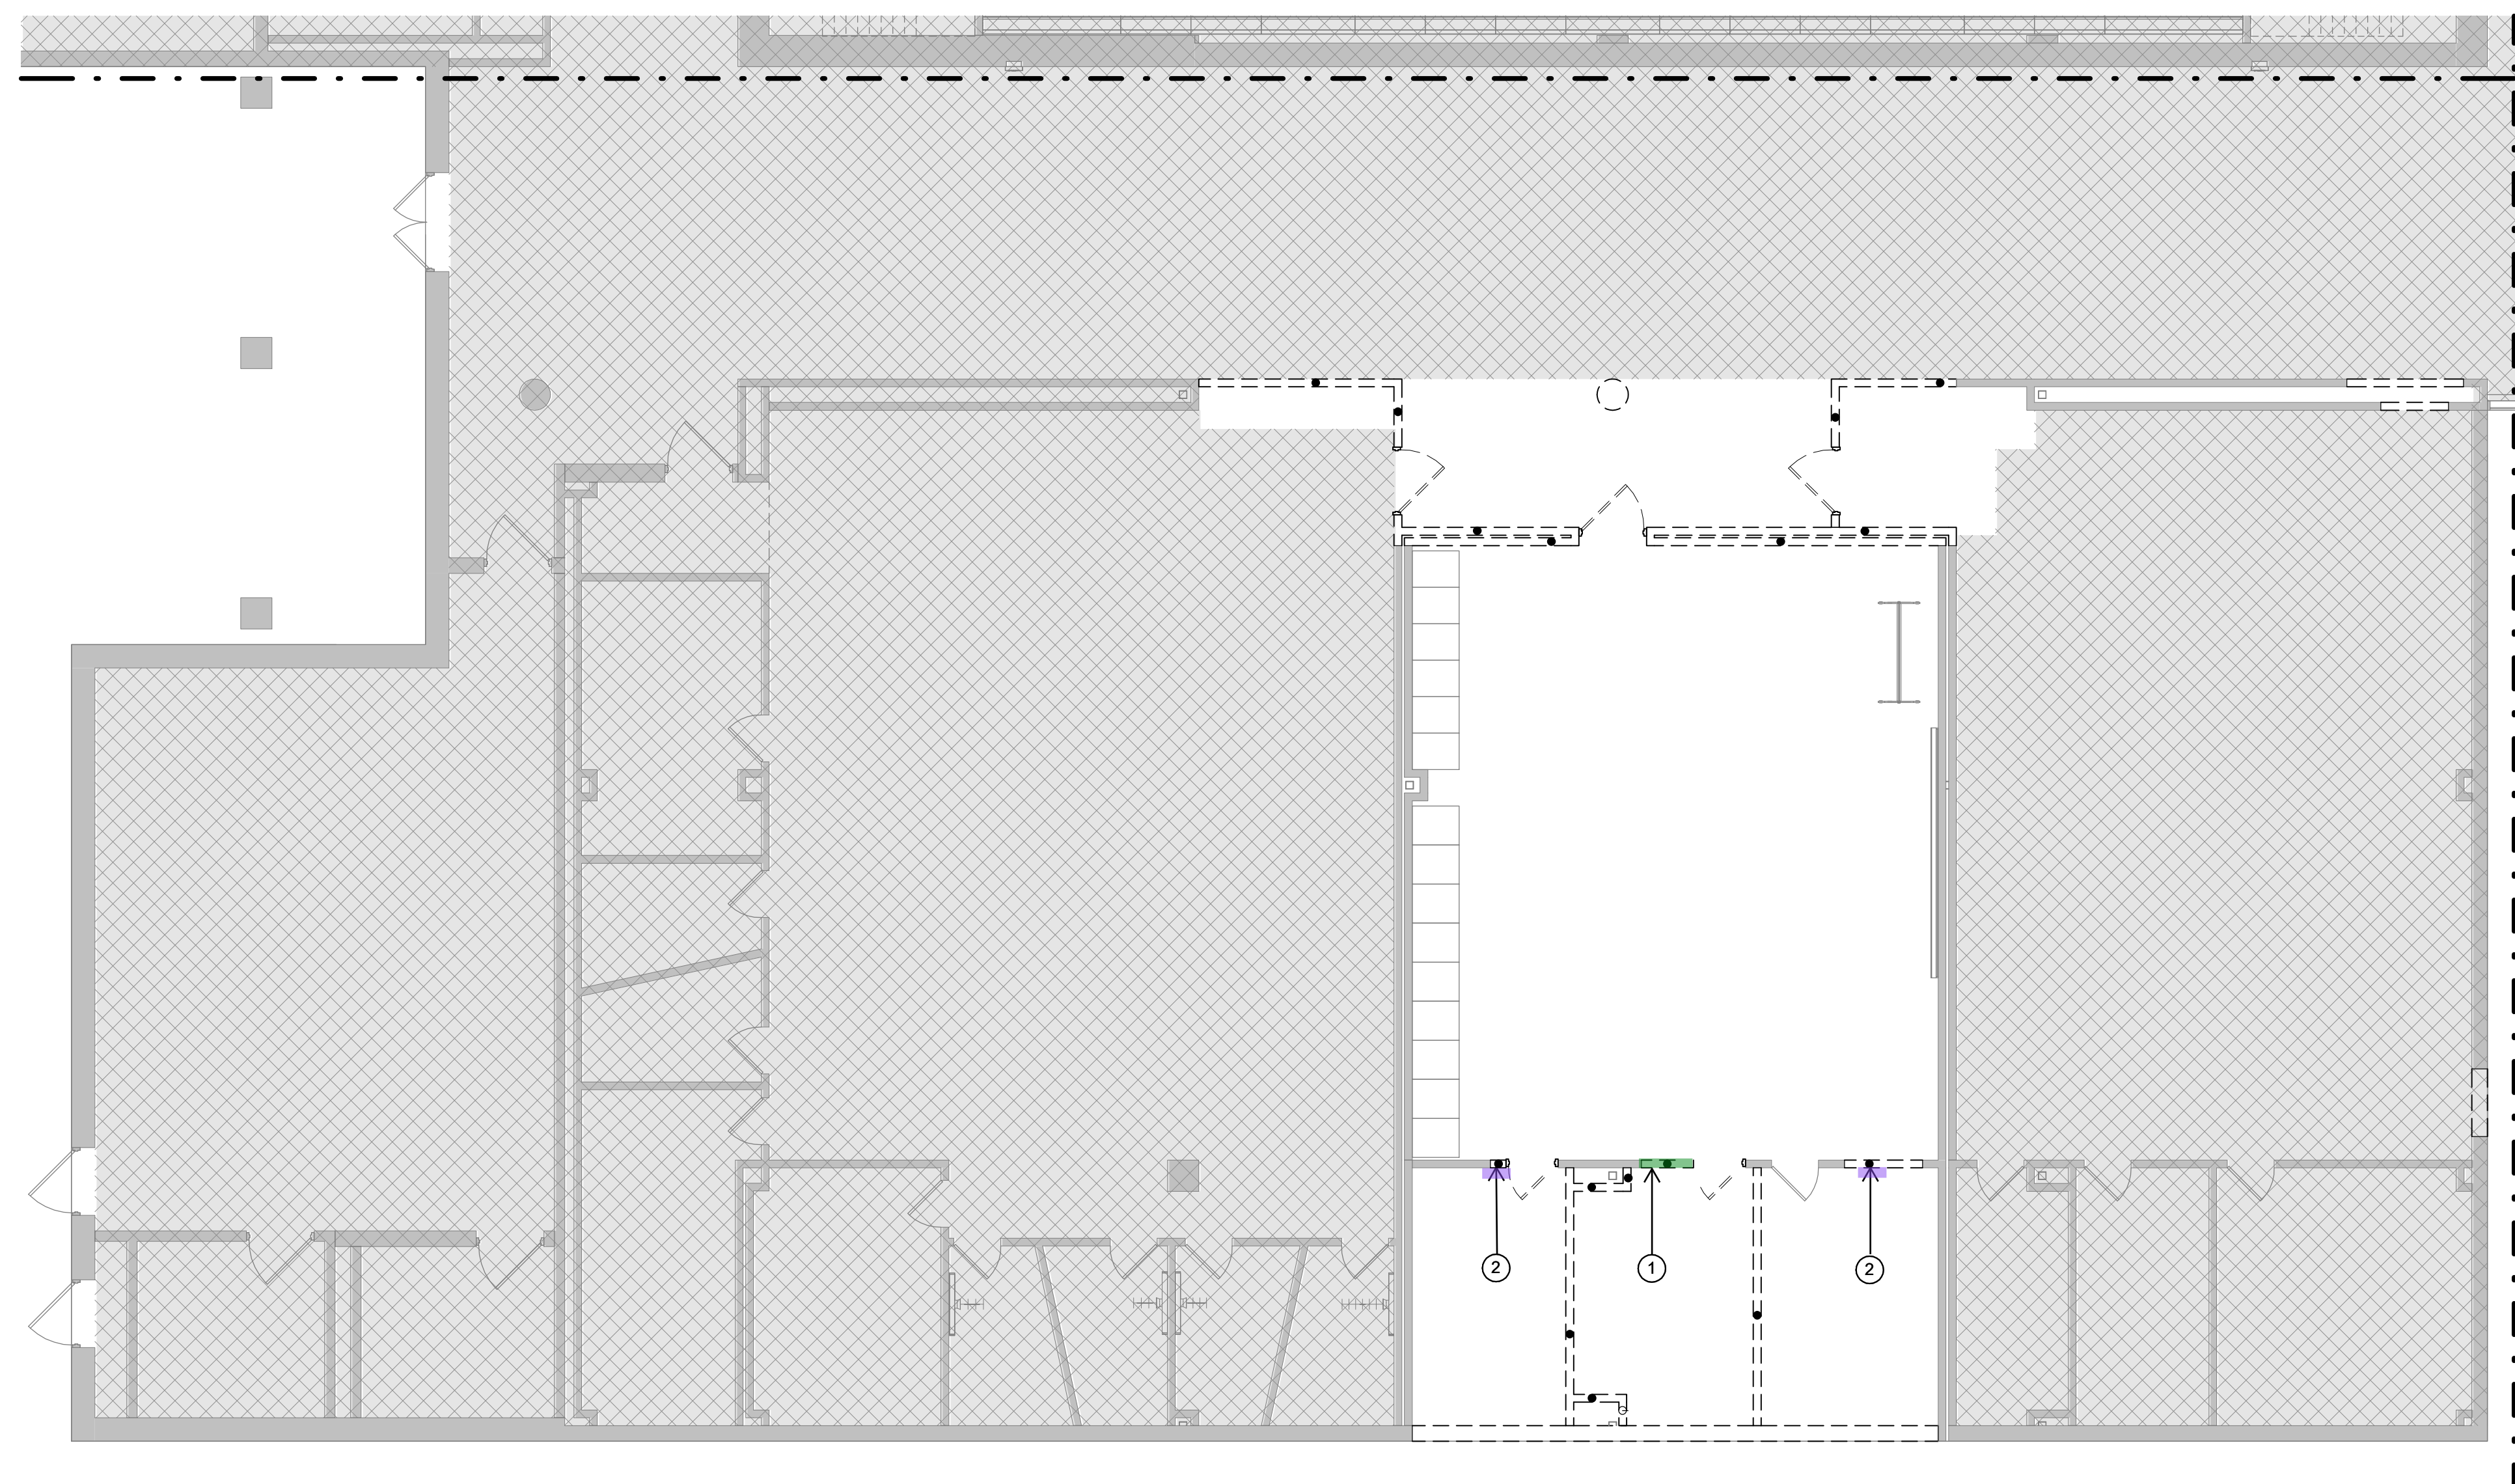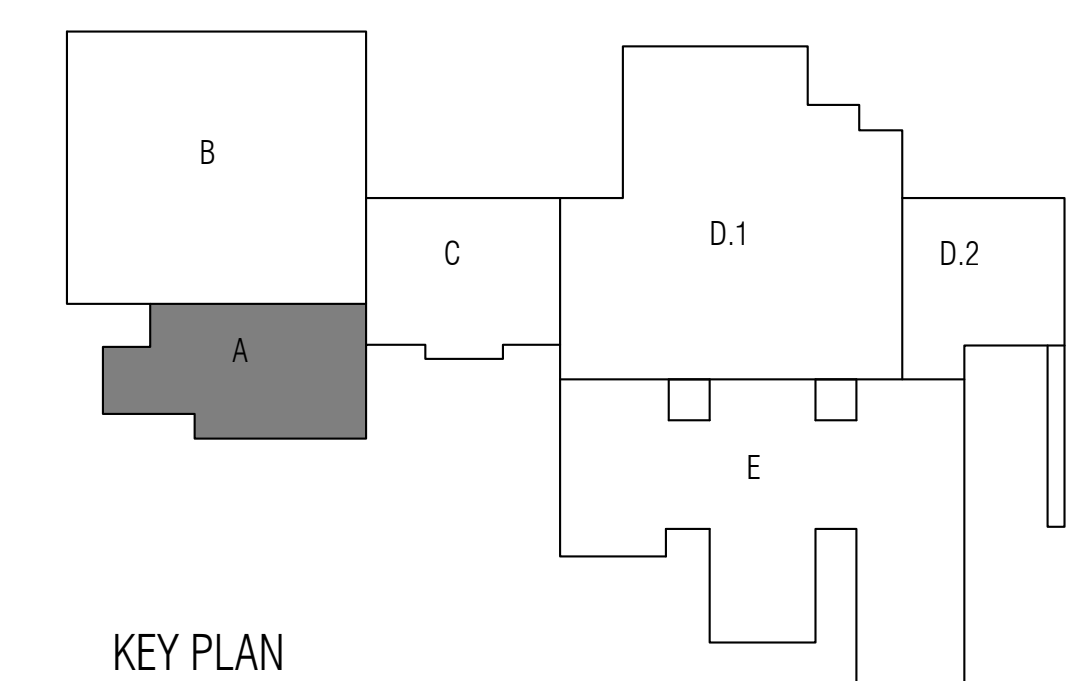

1 UNIT "A" ABATEMENT PLAN - LEVEL ONE
SCALE: 1/8" = 1'-0"

Issue For Proposal

SAM HUFF TDSHS# 105902
SAM.HUFF@EFIGLOBAL.COM
EFI PROJECT#: 029-07285

ISSUED: February 28, 2025

REVISIONS

Revision No.	Revision Date
ADDENDUM #01	MARCH 6, 2025

Director RA
Designer
Proj. Coord.

Drawn By SH
Quality Control

EFI PROJECT NO.

029.07285

SHEET TITLE

TRUITT - UNIT A
ABATEMENT PLAN - LEVEL ONE

SHEET NO.

ABT7.A

2024 Cook, Labay, and Truitt MS Renovation

ABATEMENT PLAN GENERAL NOTES:


1. ABATEMENT PLANS WERE DERIVED FROM EXISTING BUILDING PLANS AND ARE INTENDED TO REASONABLY PRESENT EXISTING CONDITIONS. ABATEMENT CONTRACTOR SHALL VERIFY ACTUAL CONDITIONS AND COORDINATE ABATEMENT AND DEMOLITION WORK.
2. REFERENCE ARCHITECTS' DEMOLITION SPECIFICATIONS AND DRAWINGS FOR DEMOLITION REQUIREMENTS AND EXISTING BUILDING DRAWINGS FOR BUILDING CONSTRUCTION CONDITIONS.
3. THESE DRAWINGS ARE REPRESENTATIVE OF TYPICAL CONDITIONS IN THE BUILDING. HOWEVER, THE LOCATIONS OF ALL ASBESTOS-CONTAINING MATERIALS ARE NOT SHOWN. ABATEMENT CONTRACTOR SHALL VERIFY ALL EXISTING CONDITIONS IN THE AREAS TO BE ABATED AND THE LOCATIONS OF ALL ASBESTOS-CONTAINING MATERIALS.
4. ABATEMENT CONTRACTOR SHALL BE RESPONSIBLE FOR ABATEMENT OF ALL ASBESTOS-CONTAINING MATERIALS.
5. THE ASBESTOS ABATEMENT SCOPE OF WORK IS DESCRIBED IN THE ABATEMENT SPECIFICATIONS. THE ASBESTOS ABATEMENT SCOPE OF WORK SHALL ALSO INCLUDE ANY HIDDEN ASBESTOS-CONTAINING MATERIALS THAT MAY BE ASSUMED OR UNCOVERED DURING THE BUILDING SELECTIVE DEMOLITION ACTIVITIES. THE ASBESTOS-CONTAINING MATERIALS IDENTIFIED IN THE BUILDING INCLUDE, AS A MINIMUM, THE FOLLOWING MATERIALS: INTERIOR ASBESTOS-CONTAINING MATERIALS: BLACK WINDOW GLAZING PUTTY AROUND INTERIOR WINDOWS AND FIRE DOORS (ASSUMED ASBESTOS).
6. ABATEMENT CONTRACTOR SHALL BE RESPONSIBLE FOR DETERMINING AND VERIFYING THE ACTUAL QUANTITIES OF ALL ASBESTOS-CONTAINING MATERIALS AND OTHER REGULATED MATERIALS THAT WILL BE ABATED UNDER THE IDENTIFIED SCOPE OF WORK. WHILE SOME OF THE EXISTING AREAS OF ASBESTOS-CONTAINING MATERIALS ARE ACCESSIBLE OR EXPOSED, OTHER AREAS OF ASBESTOS-CONTAINING MATERIALS MAY BE "HIDDEN" (E.G. LOCATED ABOVE CEILINGS; IN WALLS OR CHASES; UNDER CARPET OR OTHER FLOOR FINISH MATERIALS; ABOVE AND/OR UNDER WALLS, MILLWORK, ETC.). ALL "HIDDEN" AREAS OF ASBESTOS-CONTAINING MATERIALS IN AREAS SCHEDULED FOR DEMOLITION IN THE SUBJECT BUILDING SHALL BE UNCOVERED AND ABATED BY THE ABATEMENT CONTRACTOR AS PART OF THE PROJECT SCOPE OF WORK.
7. PERFORM SELECTIVE DEMOLITION OF WALL AREAS, CEILING AREAS, FLOOR AREAS, CHASE AREAS, ETC. AS REQUIRED TO UNCOVER AND LOCATE ALL "HIDDEN" AREAS OF ASBESTOS-CONTAINING MATERIALS IN AREAS SCHEDULED FOR DEMOLITION IN THE SUBJECT BUILDING.

ABATEMENT PLAN KEYED NOTES:

1. BLACK WINDOW GLAZING PUTTY IN THIS AREA IS TO BE ABATED (THAPR - FULL CONTAINMENT) FROM THE WINDOW FRAMING SYSTEM. REFER TO THE ARCHITECTURAL DRAWINGS FOR EXACT SCOPE OF REMOVAL. FIELD VERIFY ALL COMPONENTS TO BE REMOVED.
2. MIRROR MASTIC AND ASSOCIATED MIRROR IN THIS AREA IS TO BE ABATED (THAPR - FULL CONTAINMENT). REFER TO THE ARCHITECTURAL DRAWINGS FOR EXACT SCOPE OF DEMOLITION AND REMOVAL. FIELD VERIFY ALL COMPONENTS TO BE DEMOLISHED.

ASBESTOS LEGEND (LOCATION PURPOSES ONLY)

- BLACK MIRROR MASTIC
- BLACK WINDOW GLAZING PUTTY

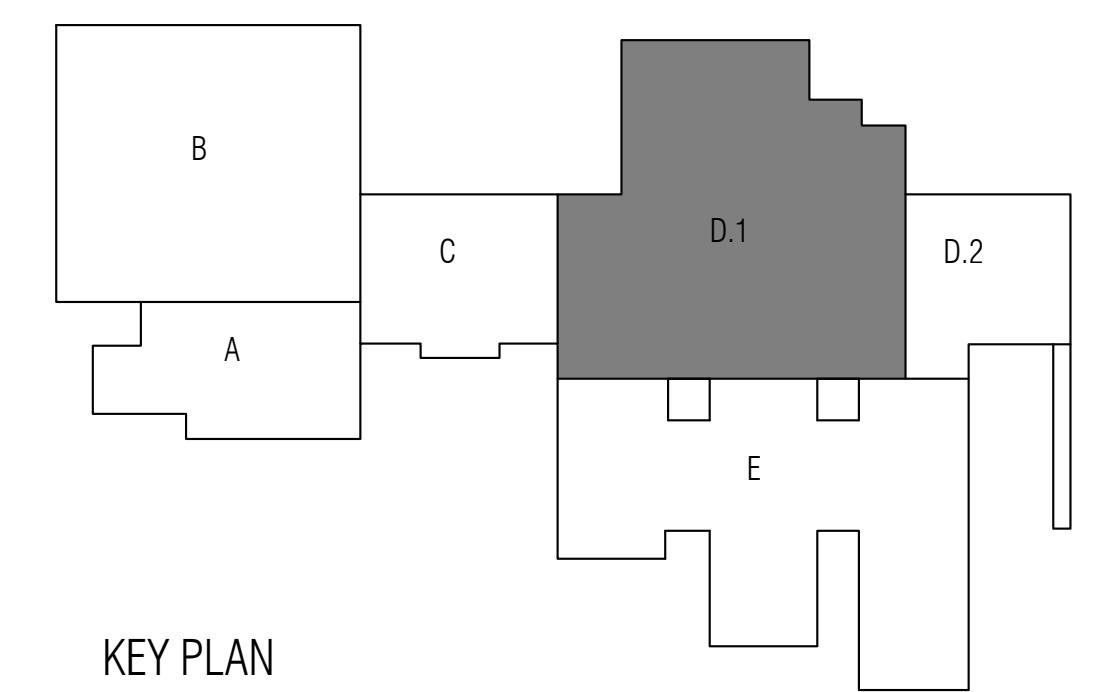

1 UNIT "D.1" ABATEMENT PLAN - LEVEL ONE
SCALE: 1/8" = 1'-0"

Issue For Proposal

[Signature]
SAM HUFF TDSHS# 105902
SAM.HUFF@EFIGLOBAL.COM
EFI PROJECT#: 029-07285

ISSUED: February 28, 2025

REVISIONS	
Revision No.	Revision Date
ADDENDUM #01	MARCH 6, 2025

Director RA
Designer
Proj. Coord.

Drawn By SH
Quality Control

EFI PROJECT NO.
029.07285

SHEET TITLE
TRUITT - UNIT A
ABATEMENT PLAN - LEVEL ONE

SHEET NO.

ABT8.D.1