

**DOCUMENT 00 91 03  
ADDENDUM NO. 3**

PROJECT: 2024 Smith and Spillane MS Renovations  
BID DATE: **Thursday, February 20, 2025 (no Change)**  
FROM: Carolina Weitzman, A.I.A.  
Natex Corporation Architects  
447 Heights Blvd, Houston, TX 77007  
TO: **Prospective Bidders**

This Addendum forms a part of the Bidding Documents and will be incorporated into Contract Documents. Insofar as the Project Manual or Drawings or both are inconsistent, this Addendum governs. Acknowledge receipt of the Addendum by inserting its number into the Proposal Form. **FAILURE TO DO SO WILL SUBJECT BID TO DISQUALIFICATION.**

**PART 1 CHANGES TO PROJECT MANUAL**

1. SECTION 08 71 00 DOOR HARDWARE
  - a. Add section to project manual
2. 28 31 00 INTRUSION DETECTION SYSTEM (IDS)
  - a. Replace this section in its entirety with the attached. Section was omitted in Addendum 02.

**PART 2 CHANGES TO DRAWINGS**

**SMITH MS**

1. M0.03 MECHANICAL DEMOLITION FIRST FLOOR PLAN – AREA ‘C’
  - a. Refer to revised plan for additional demolition in kiln room.
2. M0.04 MECHANICAL DEMOLITION FIRST FLOOR PLAN – AREA ‘D’
  - a. Refer to revised plan for additional ductwork demolition.
3. M1.00 – MECHANICAL SITE PLAN
  - a. FIELD STORAGE – Relocated EF-SB-1.
4. M2.03 MECHANICAL FIRST FLOOR PLAN – AREA ‘C’
  - a. Refer to revised plan for kiln room exhaust.
5. M2.04 MECHANICAL FIRST FLOOR PLAN – AREA ‘D’
  - a. Refer to revised plan for revised ductwork.
6. M3.01 MECHANICAL ENLARGED FLOOR PLAN
  - a. Refer to revised plan for piping to AHU-5D.
7. M4.01 MECHANICAL DETAILS
  - a. Refer to revised plan for kiln exhaust detail.

8. M5.01 MECHANICAL SCHEDULES
  - a. Refer to revised plan for schedule for EF-1.
9. E1.03 – ELECTRICAL SITE PLAN
  - a. FIELD STORAGE –EF-SB-1 Power relocated.
10. E2.01 - ELECTRICAL LIGHTING FIRST FLOOR PLAN -AREA 'A'
  - a. Lighting layout revisions as noted.
11. E2.02 - ELECTRICAL LIGHTING FIRST FLOOR PLAN -AREA 'B'
  - a. Lighting layout revisions as noted.
12. E2.03 - ELECTRICAL LIGHTING FIRST FLOOR PLAN -AREA 'C'
  - a. Lighting layout revisions as noted.
13. E2.04 - ELECTRICAL LIGHTING FIRST FLOOR PLAN -AREA 'D'
  - a. Lighting layout revisions as noted.
14. E2.06 - ELECTRICAL LIGHTING FIRST FLOOR PLAN -AREA 'F'
  - a. Lighting layout revisions as noted.
15. E3.03 - ELECTRICAL POWER FIRST FLOOR PLAN - AREA 'C'
  - a. Power provided for new Kiln EF-1.
16. P1.03 – PLUMBING SITE PLAN
  - a. Refer to attached new sheet for new site sanitary connection.
17. T0.00 – TECHNOLOGY NOTES AND LEGENDS
  - a. Refer to revised plan for fire alarm remote power supply symbol.
18. T1.02 – TECHNOLOGY COMPOSITE 1<sup>ST</sup> FLOOR PLAN
  - a. Refer to revised plan for fire alarm remote power supply locations.
19. T1.03 – TECHNOLOGY COMPOSITE 2<sup>ND</sup> FLOOR PLAN
  - a. Refer to revised plan for fire alarm remote power supply locations.
20. T2.11 – TECHNOLOGY SECOND FLOOR PLAN – AREA 'B'
  - a. Refer to revised plan for additional drop location and ceiling drop clarification.

#### **SPILLANE MS**

1. M0.03 MECHANICAL DEMOLITION FIRST FLOOR PLAN – AREA 'C'
  - a. Refer to revised plan for additional demolition in kiln room.
2. M0.04 MECHANICAL DEMOLITION FIRST FLOOR PLAN – AREA 'D'
  - a. Refer to revised plan for additional ductwork demolition.
3. M1.00 – MECHANICLA SITE PLAN
  - a. FIELD STORAGE – Relocated EF-SB-1.
4. M1.03 MECHANICAL FIRST FLOOR PLAN – AREA 'C'
  - a. Refer to revised plan for kiln room exhaust.

5. M1.04 MECHANICAL FIRST FLOOR PLAN – AREA 'D'
  - a. Refer to revised plan for revised ductwork.
6. M3.01 MECHANICAL DETAILS
  - a. Refer to revised plan for kiln exhaust detail.
7. M4.01 MECHANICAL SCHEDULES
  - a. Refer to revised plan for schedule for EF-1.
8. M5.01 MECHANICAL CONTROLS FIRST FLOOR PLAN – AREA A,B,C,D
  - a. Refer to revised plan for additional controls scope.
9. M5.02 MECHANICAL CONTROLS FIRST FLOOR PLAN – AREA E,F,G,H,J
  - a. Refer to revised plan for additional controls scope.
10. M5.03 MECHANICAL CONTROLS SECOND FLOOR PLAN
  - a. Refer to revised plan for additional controls scope.
11. M5.04 MECHANICAL CONTROLS PLAN – CENTRAL PLANT
  - a. Refer to revised plan for additional controls scope.
12. M5.05 MECHANICAL CONTROLS SCHEDULES
  - a. Refer to new sheet for existing equipment schedules.
13. E1.01 – ELECTRICAL SITE PLAN
  - a. FIELD STORAGE –EF-SB-1 Power relocated.
14. E2.01 - ELECTRICAL LIGHTING FIRST FLOOR PLAN -AREA 'A'
  - a. Lighting layout revisions as noted.
15. E2.02 - ELECTRICAL LIGHTING FIRST FLOOR PLAN -AREA 'B'
  - a. Lighting layout revisions as noted.
16. E2.03 - ELECTRICAL LIGHTING FIRST FLOOR PLAN -AREA 'C'
  - a. Lighting layout revisions as noted.
17. E2.04 - ELECTRICAL LIGHTING FIRST FLOOR PLAN -AREA 'D'
  - a. Lighting layout revisions as noted.
18. E2.06 - ELECTRICAL LIGHTING FIRST FLOOR PLAN -AREA 'F'
  - a. Lighting layout revisions as noted.
19. E2.08 - ELECTRICAL LIGHTING FIRST FLOOR PLAN -AREA 'H'
  - a. Lighting layout revisions as noted.
20. E2.10 - ELECTRICAL LIGHTING SECOND FLOOR PLAN -AREA 'A'
  - a. Lighting layout revisions as noted.
21. E2.11 - ELECTRICAL LIGHTING SECOND FLOOR PLAN -AREA 'B'
  - a. Lighting layout revisions as noted.
22. E3.03 - ELECTRICAL POWER FIRST FLOOR PLAN -AREA 'C'
  - a. Power provided for new Kiln EF-1.

23. E3.06 - ELECTRICAL POWER FIRST FLOOR PLAN -AREA 'F'
  - a. Power provided for electronic trap primer in BOILER C109.
24. E5.02 - ELECTRICAL PANEL SCHEDULES
  - a. Changes made to panel LJ1.
25. T0.00 – TECHNOLOGY NOTES AND LEGENDS
  - a. Refer to revised plan for fire alarm remote power supply symbol.
26. T0.04 – TECHNOLOGY DEMOLITION FIRST FLOOR PLAN – AREA 'D'
  - a. Refer to revised plan for additional drops to be removed in cafeteria.
27. T0.05 – TECHNOLOGY DEMOLITION FIRST FLOOR PLAN – AREA 'E'
  - a. Refer to revised plan for additional drops to be removed.
28. T0.11 – TECHNOLOGY DEMOLITION SECOND FLOOR PLAN – AREA 'B'
  - a. Refer to revised plan for additional drops to be removed.
29. T1.00 – TECHNOLOGY COMPOSITE FLOOR PLANS
  - a. Refer to revised plan for fire alarm remote power supply locations.
30. T2.03 – TECHNOLOGY FIRST FLOOR PLAN – AREA 'C'
  - a. Refer to revised plan for additional drop location and ceiling drop clarification.
31. T2.04 – TECHNOLOGY FIRST FLOOR PLAN – AREA 'D'
  - a. Refer to revised plan for additional drop locations and ceiling drop clarification.
32. T2.05 – TECHNOLOGY FIRST FLOOR PLAN – AREA 'E'
  - a. Refer to revised plan for additional drop location and ceiling drop clarification.


### PART 3 CLARIFICATIONS

### PART 4 PRIOR APPROVALS

1. Section 133419 Pre-Engineered Building – Red Dot Building is an approved manufacturer. Compliance to all other aspects of specification is applies.

#### END OF ADDENDUM NO. 3

APPROVED FOR ISSUE:

  
By M. Carolina Weitzman, principal, NATEX Architects

END OF DOCUMENT

Total No. of Pages to Addendum No.2: 125 pages.



**SECTION 087100**  
**DOOR HARDWARE**

PART 1 - GENERAL

1.1 RELATED DOCUMENTS

- A. Drawings and general provisions of the Contract, including General and Supplementary Conditions and Division 1 Specification Sections, apply to this Section.

1.2 SUMMARY

- A. This Section includes commercial door hardware for the following:
1. Swinging doors.
  2. Other doors to the extent indicated.
- B. Door hardware includes, but is not necessarily limited to, the following:
1. Mechanical door hardware.
  2. Electromechanical door hardware.
  3. Cylinders specified for doors in other sections.
- C. Related Sections:
1. Division 08 Section "Door Hardware Schedule".
  2. Division 08 Section "Hollow Metal Doors and Frames".
  3. Division 08 Section "Interior Aluminum Doors and Frames".
  4. Division 08 Section "Plastic Laminate Faced Wood Doors".
- D. Codes and References: Comply with the version year adopted by the Authority Having Jurisdiction.
1. ANSI A117.1 - Accessible and Usable Buildings and Facilities.
  2. ICC/IBC - International Building Code.
  3. NFPA 70 - National Electrical Code.
  4. NFPA 80 - Fire Doors and Windows.
  5. NFPA 101 - Life Safety Code.
  6. NFPA 105 - Installation of Smoke Door Assemblies.
  7. State Building Codes, Local Amendments.
- E. Standards: All hardware specified herein shall comply with the following industry standards:
1. ANSI/BHMA Certified Product Standards - A156 Series
  2. UL10C – Positive Pressure Fire Tests of Door Assemblies

### 1.3 SUBMITTALS

- A. Product Data: Manufacturer's product data sheets including installation details, material descriptions, dimensions of individual components and profiles, operational descriptions and finishes.
- B. Door Hardware Schedule: Prepared by or under the supervision of supplier, detailing fabrication and assembly of door hardware, as well as procedures and diagrams. Coordinate the final Door Hardware Schedule with doors, frames, and related work to ensure proper size, thickness, hand, function, and finish of door hardware.
  - 1. Format: Comply with scheduling sequence and vertical format in DHI's "Sequence and Format for the Hardware Schedule."
  - 2. Organization: Organize the Door Hardware Schedule into door hardware sets indicating complete designations of every item required for each door or opening. Organize door hardware sets in same order as in the Door Hardware Sets at the end of Part 3. Submittals that do not follow the same format and order as the Door Hardware Sets will be rejected and subject to resubmission.
  - 3. Content: Include the following information:
    - a. Type, style, function, size, label, hand, and finish of each door hardware item.
    - b. Manufacturer of each item.
    - c. Fastenings and other pertinent information.
    - d. Location of door hardware set, cross-referenced to Drawings, both on floor plans and in door and frame schedule.
    - e. Explanation of abbreviations, symbols, and codes contained in schedule.
    - f. Mounting locations for door hardware.
    - g. Door and frame sizes and materials.
    - h. Warranty information for each product.
  - 4. Submittal Sequence: Submit the final Door Hardware Schedule at earliest possible date, particularly where approval of the Door Hardware Schedule must precede fabrication of other work that is critical in the Project construction schedule. Include Product Data, Samples, Shop Drawings of other work affected by door hardware, and other information essential to the coordinated review of the Door Hardware Schedule.
- C. Shop Drawings: Details of electrified access control hardware indicating the following:
  - 1. Wiring Diagrams: Upon receipt of approved schedules, submit detailed system wiring diagrams for power, signaling, monitoring, communication, and control of the access control system electrified hardware. Differentiate between manufacturer-installed and field-installed wiring. Include the following:
    - a. Elevation diagram of each unique access controlled opening showing location and interconnection of major system components with respect to their placement in the respective door openings.

- b. Complete (risers, point-to-point) access control system block wiring diagrams.
    - c. Wiring instructions for each electronic component scheduled herein.
  - 2. Electrical Coordination: Coordinate with related sections the voltages and wiring details required at electrically controlled and operated hardware openings.
- D. Proof of Certification: Provide copy of manufacturer(s) official certification or accreditation document indicating proof of status as a qualified installer of Windstorm assemblies.
- E. Keying Schedule: After a keying meeting with the owner has taken place prepare a separate keying schedule detailing final instructions. Submit the keying schedule in electronic format. Include keying system explanation, door numbers, key set symbols, hardware set numbers and special instructions. Owner must approve submitted keying schedule prior to the ordering of permanent cylinders/cores.
- F. Informational Submittals:
  - 1. Product Test Reports: Indicating compliance with cycle testing requirements, based on evaluation of comprehensive tests performed by manufacturer and witnessed by a qualified independent testing agency.
- G. Operating and Maintenance Manuals: Provide manufacturers operating and maintenance manuals for each item comprising the complete door hardware installation in quantity as required in Division 01, Closeout Submittals.

#### 1.4 QUALITY ASSURANCE

- A. Manufacturers Qualifications: Engage qualified manufacturers with a minimum 5 years of documented experience in producing hardware and equipment similar to that indicated for this Project and that have a proven record of successful in-service performance.
- B. Installer Qualifications: A minimum 3 years documented experience hardware similar in material, design, and extent to that indicated for this Project and whose work has resulted in construction with a record of successful in-service performance.
- C. Door Hardware Supplier Qualifications: Experienced commercial door hardware distributors with a minimum 5 years documented experience supplying hardware installations comparable in material, design, and extent to that indicated for this Project. Supplier recognized as a factory direct distributor by the manufacturers of the primary materials with a warehousing facility in Project's vicinity. Supplier to have on staff a certified Architectural Hardware Consultant (AHC) available during the course of the Work to consult with Contractor, Architect, and Owner concerning both standard and electromechanical door hardware and keying.
- D. Integrated Wiegand, Wireless, and IP-Enabled Access Control Products Supplier Qualifications: Integrated access control products and accessories are required to be supplied and installed through current members of the ASSA ABLOY "Authorized Channel Partner" (ACP) and "Certified Integrator" (CI) programs. Suppliers are to be factory trained, certified prior to project bid, and a direct purchaser of the specified product. Installers are to be factory trained,

certified prior to project bid, and are responsible for commissioning, servicing, and warranting the installed equipment specified for the project.

- E. Source Limitations: Obtain each type and variety of door hardware specified in this section from a single source unless otherwise indicated.
  - 1. Electrified modifications or enhancements made to a source manufacturer's product line by a secondary or third party source will not be accepted.
  - 2. Provide electromechanical door hardware from the same manufacturer as mechanical door hardware, unless otherwise indicated
  
- F. Each unit to bear third party permanent label demonstrating compliance with the referenced standards.
  
- G. Keying Conference: Conduct conference to comply with requirements in Division 01 Section "Project Meetings." Keying conference to incorporate the following criteria into the final keying schedule document:
  - 1. Function of building, purpose of each area and degree of security required.
  - 2. Plans for existing and future key system expansion.
  - 3. Requirements for key control storage and software.
  - 4. Installation of permanent keys, cylinder cores and software.
  - 5. Address and requirements for delivery of keys.
  
- H. Pre-Submittal Conference: Conduct coordination conference in compliance with requirements in Division 01 Section "Project Meetings" with attendance by representatives of Supplier(s), Installer(s), and Contractor(s) to review proper methods and the procedures for receiving, handling, and installing door hardware.
  - 1. Prior to installation of door hardware, conduct a project specific training meeting to instruct the installing contractors' personnel on the proper installation and adjustment of their respective products. Product training to be attended by installers of door hardware (including electromechanical hardware) for aluminum, hollow metal and wood doors. Training will include the use of installation manuals, hardware schedules, templates and physical product samples as required.
  - 2. Inspect and discuss electrical roughing-in, power supply connections, and other preparatory work performed by other trades.
  - 3. Review sequence of operation narratives for each unique access controlled opening.
  - 4. Review and finalize construction schedule and verify availability of materials.
  - 5. Review the required inspecting, testing, commissioning, and demonstration procedures
  
- I. At completion of installation, provide written documentation that components were applied to manufacturer's instructions and recommendations and according to approved schedule.

#### 1.5 DELIVERY, STORAGE, AND HANDLING

- A. Inventory door hardware on receipt and provide secure lock-up and shelving for door hardware delivered to Project site.

- B. Tag each item or package separately with identification related to the final Door Hardware Schedule, and include basic installation instructions with each item or package.
- C. Deliver, as applicable, permanent keys, cylinders, cores and related accessories directly to Owner via registered mail or overnight package service. Instructions for delivery to the Owner shall be established at the "Keying Conference".

#### 1.6 COORDINATION

- A. Templates: Obtain and distribute to the parties involved templates for doors, frames, and other work specified to be factory prepared for installing hardware. Check Shop Drawings of other work to confirm that adequate provisions are made for locating and installing hardware to comply with indicated requirements.
- B. Door Hardware and Electrical Connections: Coordinate the layout and installation of scheduled electrified door hardware and related access control equipment with required connections to source power junction boxes, low voltage power supplies, detection and monitoring hardware, and fire and detection alarm systems.
- C. Door and Frame Preparation: Doors and corresponding frames are to be prepared, reinforced and pre-wired (if applicable) to receive the installation of the specified electrified, monitoring, signaling and access control system hardware without additional in-field modifications.

#### 1.7 WARRANTY

- A. General Warranty: Reference Division 01, General Requirements. Special warranties specified in this Article shall not deprive Owner of other rights Owner may have under other provisions of the Contract Documents and shall be in addition to, and run concurrent with, other warranties made by Contractor under requirements of the Contract Documents.
- B. Warranty Period: Written warranty, executed by manufacturer(s), agreeing to repair or replace components of standard and electrified door hardware that fails in materials or workmanship within specified warranty period after final acceptance by the Owner. Failures include, but are not limited to, the following:
  - 1. Structural failures including excessive deflection, cracking, or breakage.
  - 2. Faulty operation of the hardware.
  - 3. Deterioration of metals, metal finishes, and other materials beyond normal weathering.
  - 4. Electrical component defects and failures within the systems operation.
- C. Standard Warranty Period: One year from date of Substantial Completion, unless otherwise indicated.
- D. Special Warranty Periods:
  - 1. Lifetime for mortise locks and latches.
  - 2. Five years for exit hardware.
  - 3. Ten years for electric latch retraction exit motors

4. Twenty-five years for manual surface door closer bodies.
5. Two years for electromechanical door hardware.
6. Lifetime for SN200 readers.

#### 1.8 MAINTENANCE SERVICE

- A. Maintenance Tools and Instructions: Furnish a complete set of specialized tools and maintenance instructions as needed for Owner's continued adjustment, maintenance, and removal and replacement of door hardware.

#### 1.9 OWNER STOCK – See Attic Stock at the end of Hardware Schedule.

### PART 2 - PRODUCTS

#### 2.1 SCHEDULED DOOR HARDWARE

- A. General: Provide door hardware for each door to comply with requirements in Door Hardware Sets and each referenced section that products are to be supplied under.
- B. Designations: Requirements for quantity, item, size, finish or color, grade, function, and other distinctive qualities of each type of door hardware are indicated in the Door Hardware Sets at the end of Part 3. Products are identified by using door hardware designations, as follows:
- C. Named Manufacturer's Products: Product designation and manufacturer are listed for each door hardware type required for the purpose of establishing requirements. Manufacturers' names are abbreviated in the Door Hardware Schedule.
- D. Substitutions: Requests for substitution and product approval for inclusive mechanical and electromechanical door hardware in compliance with the specifications must be submitted in writing and in accordance with the procedures and time frames outlined in Division 01, Substitution Procedures. Approval of requests is at the discretion of the architect, owner, and their designated consultants.

#### 2.2 HANGING DEVICES

- A. Hinges: ANSI/BHMA A156.1 certified butt hinges with number of hinge knuckles as specified in the Door Hardware Sets.
  1. Quantity: Provide the following hinge quantity, unless otherwise indicated:
    - a. Two Hinges: For doors with heights up to 60 inches.
    - b. Three Hinges: For doors with heights 61 to 90 inches.
    - c. Four Hinges: For doors with heights 91 to 120 inches.
    - d. For doors with heights more than 120 inches, provide 4 hinges, plus 1 hinge for every 30 inches of door height greater than 120 inches.

2. Hinge Size: Provide the following, unless otherwise indicated, with hinge widths sized for door thickness and clearances required:
    - a. Widths up to 3'0": 4-1/2" standard or heavy weight as specified.
    - b. Sizes from 3'1" to 4'0": 5" standard or heavy weight as specified.
  3. Hinge Weight and Base Material: Unless otherwise indicated, provide the following:
    - a. Exterior Doors: Heavy weight, non-ferrous, ball bearing or oil impregnated bearing hinges unless Hardware Sets indicate standard weight.
    - b. Interior Doors: Standard weight, steel, ball bearing or oil impregnated bearing hinges unless Hardware Sets indicate heavy weight.
  4. Hinge Options: Comply with the following where indicated in the Hardware Sets or on Drawings:
    - a. Non-removable Pins: Provide set screw in hinge barrel that, when tightened into a groove in hinge pin, prevents removal of pin while door is closed; for the all out-swinging lockable doors.
  5. Acceptable Manufacturers:
    - a. Hager Companies (HA).
    - b. McKinney Products (MK).
    - c. Stanley Hardware (ST).
- B. Continuous Geared Hinges: ANSI/BHMA A156.26 Grade 1-600 certified continuous geared hinge. with minimum 0.120-inch thick extruded 6060 T6 aluminum alloy hinge leaves and a minimum overall width of 4 inches. Hinges are non-handed, reversible and fabricated to template screw locations. Factory trim hinges to suit door height and prepare for electrical cut-outs.
1. Acceptable Manufacturers:
    - a. McKinney Products (MK).
    - b. Pemko Manufacturing (PE).
    - c. Stanley Hardware (ST).

## 2.3 POWER TRANSFER DEVICES

- A. Concealed Quick Connect Electric Power Transfers: Provide concealed wiring pathway housing mortised into the door and frame for low voltage electrified door hardware. Furnish with Molex™ standardized plug connectors and sufficient number of concealed wires (up to 12) to accommodate the electrified functions specified in the Door Hardware Sets. Connectors plug directly to through-door wiring harnesses for connection to electric locking devices and power supplies. Wire nut connections are not acceptable.
  1. Acceptable Manufacturers:

- a. Pemko Manufacturing (PE) – EL-CEPT Series.
- b. Securitron (SU) - EL-CEPT Series.
- c. Stanley Hardware (ST) EPT-12C Series.

B. Electric Door Wire Harnesses: Provide electric/data transfer wiring harnesses with standardized plug connectors to accommodate up to twelve (12) wires. Connectors plug directly to through-door wiring harnesses for connection to electric locking devices and power supplies. Provide sufficient number and type of concealed wires to accommodate electric function of specified hardware. Provide a connector for through-door electronic locking devices and from hinge to junction box above the opening. Wire nut connections are not acceptable. Determine the length required for each electrified hardware component for the door type, size and construction, minimum of two per electrified opening.

1. Provide one each of the following tools as part of the base bid contract:
  - a. McKinney Products (MK) - Electrical Connecting Kit: QC-R001.
  - b. McKinney Products (MK) - Connector Hand Tool: QC-R003.

## 2.4 DOOR OPERATING TRIM

A. Flush Bolts and Surface Bolts: ANSI/BHMA A156.3 and A156.16, Grade 1, certified.

1. Manual flush bolts to be furnished with top rod of sufficient length to allow bolt location approximately six feet from the floor.
2. Furnish dust proof strikes for bottom bolts.
3. Surface bolts to be minimum 8” in length and U.L. listed for labeled fire doors and U.L. listed for windstorm components where applicable.
4. Provide related accessories (mounting brackets, strikes, coordinators, etc.) as required for appropriate installation and operation.
5. Acceptable Manufacturers:
  - a. Ives (IV).
  - b. Rockwood Manufacturing (RO).
  - c. Trimco (TC).

B. Door Push Plates and Pulls: ANS/BHMA A156.6 certified door pushes and pulls of type and design specified in the Hardware Sets. Coordinate and provide proper width and height as required where conflicting hardware dictates.

1. Push/Pull Plates: Minimum .050 inch thick, size as indicated in hardware sets, with beveled edges, secured with exposed screws unless otherwise indicated.
2. Door Pull and Push Bar Design: Size, shape, and material as indicated in the hardware sets. Minimum clearance of 2 1/2-inches from face of door unless otherwise indicated.
3. Offset Pull Design: Size, shape, and material as indicated in the hardware sets. Minimum clearance of 2 1/2-inches from face of door and offset of 90 degrees unless otherwise indicated.
4. Fasteners: Provide manufacturer's designated fastener type as indicated in Hardware Sets.
5. Acceptable Manufacturers:



- a. Ives (IV).
- b. Rockwood Manufacturing (RO).
- c. Trimco (TC).

## 2.5 CYLINDERS AND KEYING

- A. General: Cylinder manufacturer to have minimum (10) years experience designing secured master key systems and have on record a published security keying system policy.
- B. Source Limitations: Obtain each type of keyed cylinder and keys from the same source manufacturer as locksets and exit devices, unless otherwise indicated.
  1. Acceptable Manufacturers:
    - a. Stanley Best (BE).
    - b. Sargent Cylinder Housings
    - c. No Substitution.
- C. Cylinders: Original manufacturer cylinders complying with the following:
  1. Mortise Type: Threaded cylinders with rings and cams to suit hardware application.
  2. Rim Type: Cylinders with back plate, flat-type vertical or horizontal tailpiece, and raised trim ring.
  3. Bored-Lock Type: Cylinders with tailpieces to suit locks.
  4. Mortise and rim cylinder collars to be solid and recessed to allow the cylinder face to be flush and be free spinning with matching finishes.
  5. Keyway: Match Facility Standard.
- D. Keying System: Each type of lock and cylinders to be factory keyed.
  1. Conduct specified "Keying Conference" to define and document keying system instructions and requirements.
  2. Furnish factory cut, nickel-silver large bow permanently inscribed with a visual key control number as directed by Owner.
  3. Existing System: Key locks to Owner's existing system.
- E. Key Quantity: Provide the following minimum number of keys:
  1. Change Keys per Cylinder: Two (2)
  2. Twenty construction cores
  3. 50 Key Blanks – Best "A" Keyway
  4. **Temporary (green) core keys: 1 key per lockset**
- F. Construction Keying: Provide temporary keyed construction cores. Green Best Cores No Substitution. All Best temporary cores to be returned to the district at the end of the project.
- G. Key Registration List (Bitting List):

1. Provide keying transcript list to Owner's representative in the proper format for importing into key control software.
  2. Provide transcript list in writing or electronic file as directed by the Owner.
- H. Key Control Cabinet: Provide a key control system including envelopes, labels, and tags with self-locking key clips, receipt forms, 3-way visible card index, temporary markers, permanent markers, and standard metal cabinet. Key control cabinet shall have expansion capacity of 150% of the number of locks required for the project. Provide a new cabinet to all new construction projects. Use Lund 1205-B as a basis of design.
1. Acceptable Manufacturers:
    - a. Lund Equipment (LU).
    - b. MMF Industries (MM).
    - c. Telkee (TK).

## 2.6 MECHANICAL LOCKS AND LATCHING DEVICES

- A. Mortise Locksets, Grade 1 (Heavy Duty): ANSI/BHMA A156.13. Locksets are to be manufactured with a corrosion resistant steel case and be field-reversible for handing without disassembly of the lock body.
1. Acceptable Manufacturers
    - a. Sargent Manufacturing (SA) 8200 Series – No substitutions
    - b. Sargent Manufacturing (SA) 10X Series - No substitutions
      - 1) Use at student restrooms or as directed by Cy Fair ISD

## 2.7 AUXILIARY LOCKS

- A. Tubular Deadlocks: Deadlocks to be products of the same source manufacturer and keyway as other specified locksets.
1. Acceptable Manufacturers:
    - a. Marks (MX) - 130 Series.
    - b. Sargent Manufacturing (SA) – 480 Series.

## 2.8 LOCK AND LATCH STRIKES

- A. Strikes: Provide manufacturer's standard strike with strike box for each latch or lock bolt, with curved lip extended to protect frame, finished to match door hardware set, unless otherwise indicated, and as follows:
1. Flat-Lip Strikes: For locks with three-piece antifriction latchbolts, as recommended by manufacturer.

2. Aluminum-Frame Strike Box: Provide manufacturer's special strike box fabricated for aluminum framing.

B. Standards: Comply with the following:

1. Strikes for Mortise Locks and Latches: BHMA A156.13.
2. Strikes for Auxiliary Deadlocks: BHMA A156.5.
3. Dustproof Strikes: BHMA A156.16.

## 2.9 CONVENTIONAL EXIT DEVICES

A. General Requirements: All exit devices specified herein shall meet or exceed the following criteria:

1. At doors not requiring a fire rating, provide devices complying with NFPA 101 and listed and labeled for "Panic Hardware" according to UL305. Provide proper fasteners as required by manufacturer including sex nuts and bolts at openings specified in the Hardware Sets.
2. Where exit devices are required on fire rated doors, provide devices complying with NFPA 80 and with UL labeling indicating "Fire Exit Hardware". Provide devices with the proper fasteners for installation as tested and listed by UL. Consult manufacturer's catalog and template book for specific requirements.
3. Except on fire rated doors, provide exit devices with hex key dogging device to hold the pushbar and latch in a retracted position. Provide optional keyed cylinder dogging on devices where specified in Hardware Sets.
4. Devices must fit flat against the door face with no gap that permits unauthorized dogging of the push bar. The addition of filler strips is required in any case where the door light extends behind the device as in a full glass configuration.
5. Lever Operating Trim: Where exit devices require lever trim, furnish manufacturer's heavy duty escutcheon trim with threaded studs for thru-bolts.
  - a. Lock Trim Design: As indicated in Hardware Sets, provide finishes and designs to match that of the specified locksets.
  - b. Where function of exit device requires a cylinder, provide a cylinder (Rim or Mortise) as specified in Hardware Sets.
6. Rail Sizing: Provide exit device rails factory sized for proper door width application.
7. Through Bolt Installation: For exit devices and trim as indicated (TB) in Door Hardware Sets.
8. Provide Less Dogging (LD) at all exit devices.
9. Add 31- Prefix to all exit devices being provided at two inch aluminum doors.

10. No self-tapping screws allowed.

B. Conventional Push Rail Exit Devices (Heavy Duty): ANSI/BHMA A156.3, Grade 1 certified panic and fire exit hardware devices furnished in the functions specified in the Hardware Sets. Exit device latch to be stainless steel, pullman type, with deadlock feature.

1. Acceptable Manufacturers:

- a. Sargent Manufacturing (SA) - 80 Series.
- b. No Substitution.

C. Tube Steel Removable Mullions: ANSI/BHMA A156.3 removable steel mullions with malleable-iron top and bottom retainers and a primed paint finish.

1. Provide keyed removable feature where specified in the Hardware Sets.
2. Provide stabilizers and mounting brackets as required.
3. Provide electrical quick connection wiring options as specified in the hardware sets.
4. Acceptable Manufacturers:
  - a. Stanley Precision (PR) - 822 Series.
  - b. No Substitution.

## 2.10 INTEGRATED WIEGAND OUTPUT ACCESS CONTROL EXIT DEVICES

A. Wiegand Output Integrated Card Reader Exit Hardware: Wiegand output ANSI 156.3 Grade 1 rim, mortise, and vertical rod exit device hardware with integrated proximity card reader, latchbolt and touchbar monitoring, and request-to-exit signaling, in one complete unit. Hard wired, solenoid driven locking/unlocking control of the lever handle exit trim with 3/4" throw latch bolt. U.L listed and labeled for either panic or "fire exit hardware" for use on up to 3 hour fire rated openings. Available with or without keyed high security cylinder override.

1. Open architecture, hard wired platform supports centralized control of locking units with new or existing Wiegand compatible access control systems. Inside push bar (request-to-exit) signaling and door position (open/closed status) monitoring (via separately connected DPS).
2. Reader supports either HID 125 kHz proximity (up to 39 bits, including Corporate 1000) or 13.56 MHz (2K-32K) iClass® credentials.
3. 12VDC external power supply required for reader, with optional 24VDC operation available with iClass® reader (125 kHz reader is always 12VDC). 24VDC required for solenoid operated exit trim (12VDC if applicable). Fail safe or fail secure options.
4. Installation requires only one cable run from the exit hardware to the access control panel without requirements for additional proprietary lock panel interface boards or modules.
5. Acceptable Manufacturers:
  - a. Sargent Manufacturing (SA) - SN – 56-SN20080 Series Exits. x SPAR04867

- b. Sargent Manufacturing (SA) - SN – SN2008200 Series Locks.
- c. No Substitution.

## 2.11 DOOR CLOSERS

### A. All door closers specified herein shall meet or exceed the following criteria:

1. General: Door closers to be from one manufacturer, matching in design and style, with the same type door preparations and templates regardless of application or spring size. Closers to be non-handed with full sized covers including installation and adjusting information on inside of cover.
2. Standards: Closers to comply with UL-10C for Positive Pressure Fire Test and be U.L. listed for use of fire rated doors.
3. Cycle Testing: Provide closers which have surpassed 15 million cycles in a test witnessed and verified by UL.
4. Size of Units: Comply with manufacturer's written recommendations for sizing of door closers depending on size of door, exposure to weather, and anticipated frequency of use. Where closers are indicated for doors required to be accessible to the physically handicapped, provide units complying with ANSI ICC/A117.1.
5. Closer Arms: Provide heavy duty, forged steel closer arms unless otherwise indicated in Hardware Sets.
6. Closers shall not be installed on exterior or corridor side of doors; where possible install closers on door for optimum aesthetics.
7. Closer Accessories: Provide door closer accessories including custom templates, special mounting brackets, spacers and drop plates, and through-bolt and security type fasteners as required for proper installation.
8. Through Bolt Installation: All door closers are to be installed with (TB) through bolting as indicated in Door Hardware Sets.
9. No self-tapping screws allowed.

### B. Door Closers, Surface Mounted (Heavy Duty): ANSI/BHMA A156.4, Grade 1 surface mounted, heavy duty door closers with complete spring power adjustment, sizes 1 thru 6; and fully operational adjustable according to door size, frequency of use, and opening force. Closers to be rack and pinion type, one piece cast iron or aluminum alloy body construction, with adjustable backcheck and separate non-critical valves for closing sweep and latch speed control. Provide non-handed units standard.

1. Acceptable Manufacturers:
  - a. Sargent Manufacturing (SA) – TB 351 Series.

## 2.12 SURFACE MOUNTED CLOSER HOLDERS

- A. Electromagnetic Door Holders: Certified ANSI A156.15 electromagnetic door holder/releases with a minimum 20 to 40 pounds holding power and single coil construction able to accommodate 12VDC, 24VAC, 24VDC and 120VAC. Coils to be independently wound, employing an integral fuse and armatures to include a positive release button.
1. Acceptable Manufacturers:
    - a. LCN Door Closers (LC) - SEM7800 Series.
    - b. Rixson (RF) - 980/990 Series.
    - c. Sargent Manufacturing (SA) - 1560 Series.

## 2.13 ARCHITECTURAL TRIM

### A. Door Protective Trim

1. General: Door protective trim units to be of type and design as specified below or in the Hardware Sets.
2. Size: Fabricate protection plates (kick, armor, or mop) not more than 2" less than door width (LDW) on stop side of single doors and 1" LDW on stop side of pairs of doors, and not more than 1" less than door width on pull side. Coordinate and provide proper width and height as required where conflicting hardware dictates. Height to be as specified in the Hardware Sets.
3. Protection Plates: ANSI/BHMA A156.6 certified protection plates (kick, armor, or mop), fabricated from the following:
  - a. Stainless Steel: 300 grade, 050-inch thick.
4. Options and fasteners: Provide manufacturer's designated fastener type as specified in the Hardware Sets. Provide countersunk screw holes.
5. Acceptable Manufacturers:
  - a. Ives (IV).
  - b. Rockwood Manufacturing (RO).
  - c. Trimco (TC).

## 2.14 DOOR STOPS AND HOLDERS

- A. General: Door stops and holders to be of type and design as specified below or in the Hardware Sets.
- B. Door Stops and Bumpers: ANSI/BHMA A156.16, Grade 1 certified door stops and wall bumpers. Provide wall bumpers, either convex or concave types with anchorage as indicated,

unless floor or other types of door stops are specified in Hardware Sets. Do not mount floor stops where they will impede traffic. Where floor or wall bumpers are not appropriate, provide overhead type stops and holders.

1. Acceptable Manufacturers:

- a. Ives (IV).
- b. Rockwood Manufacturing (RO).
- c. Trimco (TC).

C. Overhead Door Stops and Holders: ANSI/BHMA A156.6, Grade 1 certified overhead stops and holders to be surface or concealed types as indicated in Hardware Sets. Track, slide, arm and jamb bracket to be constructed of extruded bronze and shock absorber spring of heavy tempered steel. Provide non-handed design with mounting brackets as required for proper operation and function.

1. Acceptable Manufacturers:

- a. Do not use overhead stops/holders

## 2.15 ARCHITECTURAL SEALS

A. General: Thresholds, weatherstripping, and gasket seals to be of type and design as specified below or in the Hardware Sets. Provide continuous weatherstrip gasketing on exterior doors and provide smoke, light, or sound gasketing on interior doors where indicated. At exterior applications provide non-corrosive fasteners and elsewhere where indicated.

B. Smoke Labeled Gasketing: Assemblies complying with NFPA 105 that are listed and labeled by a testing and inspecting agency acceptable to authorities having jurisdiction, for smoke control ratings indicated, based on testing according to UL 1784.

1. Provide smoke labeled perimeter gasketing at all smoke labeled openings.

C. Fire Labeled Gasketing: Assemblies complying with NFPA 80 that are listed and labeled by a testing and inspecting agency acceptable to authorities having jurisdiction, for fire ratings indicated, based on testing according to UL-10C.

1. Provide intumescent seals as indicated to meet UL10C Standard for Positive Pressure Fire Tests of Door Assemblies, and UBC 7-2, Fire Tests of Door Assemblies.

D. No Replaceable Seal Strips allowed: Provide only those units where they can be screw applied..

E. Acceptable Manufacturers:

1. National Guard Products (NG).
2. Pemko Manufacturing (PE).
3. Reese Enterprises, Inc. (RE).

## 2.16 ELECTRONIC ACCESSORIES

- A. Door Position Switches: Door position magnetic reed contact switches specifically designed for use in commercial door applications. On recessed models the contact and magnetic housing snap-lock into a 1" diameter hole. Surface mounted models include wide gap distance design complete with armored flex cabling. Provide SPDT, N/O switches with optional Rare Earth Magnet installation on steel doors with flush top channels.

1. Acceptable Manufacturers:

- a. Provided by Security

- B. Switching Power Supplies: Provide UL listed or recognized filtered and regulated power supplies. Provide single, dual, or multi-voltage units as shown in the hardware sets. Units must be expandable up to eight Class 2 power limited outputs. Units must include the capability to incorporate a battery backup option with integral battery charging capability in addition to operating the DC load in event of line voltage failure. Provide the least number of units, at the appropriate amperage level, sufficient to exceed the required total draw for the specified electrified hardware and access control equipment.

1. Acceptable Manufacturers:

- a. Provided by Security

## 2.17 FABRICATION

- A. Fasteners: Provide door hardware manufactured to comply with published templates generally prepared for machine, wood, and sheet metal screws. Provide screws according to manufacturers recognized installation standards for application intended.

## 2.18 FINISHES

- A. Standard: Designations used in the Hardware Sets and elsewhere indicate hardware finishes complying with ANSI/BHMA A156.18, including coordination with traditional U.S. finishes indicated by certain manufacturers for their products.
- B. Provide quality of finish, including thickness of plating or coating (if any), composition, hardness, and other qualities complying with manufacturer's standards, but in no case less than specified by referenced standards for the applicable units of hardware.
- C. Protect mechanical finishes on exposed surfaces from damage by applying a strippable, temporary protective covering before shipping.



## PART 3 - EXECUTION

### 3.1 EXAMINATION

- A. Examine scheduled openings, with Installer present, for compliance with requirements for installation tolerances, labeled fire door assembly construction, wall and floor construction, and other conditions affecting performance.
- B. Notify architect of any discrepancies or conflicts between the door schedule, door types, drawings and scheduled hardware. Proceed only after such discrepancies or conflicts have been resolved in writing.

### 3.2 PREPARATION

- A. Hollow Metal Doors and Frames: Comply with ANSI/DHI A115 series.
- B. Wood Doors: Comply with ANSI/DHI A115-W series.

### 3.3 INSTALLATION

- A. Install each item of mechanical and electromechanical hardware and access control equipment to comply with manufacturer's written instructions and according to specifications.
  - 1. Installers are to be trained and certified by the manufacturer on the proper installation and adjustment of fire, life safety, and security products including: hanging devices; locking devices; closing devices; and seals.
- B. Mounting Heights: Mount door hardware units at heights indicated in following applicable publications, unless specifically indicated or required to comply with governing regulations:
  - 1. Standard Steel Doors and Frames: DHI's "Recommended Locations for Architectural Hardware for Standard Steel Doors and Frames."
  - 2. Wood Doors: DHI WDHS.3, "Recommended Locations for Architectural Hardware for Wood Flush Doors."
  - 3. Where indicated to comply with accessibility requirements, comply with ANSI A117.1 "Accessibility Guidelines for Buildings and Facilities."
  - 4. Provide blocking in drywall partitions where wall stops or other wall mounted hardware is located.
- C. Integrated Wiegand access control products are required to be installed through current members of the ASSA ABLOY "Certified Integrator" (CI) program.
- D. Retrofitting: Install door hardware to comply with manufacturer's published templates and written instructions. Where cutting and fitting are required to install door hardware onto or into surfaces that are later to be painted or finished in another way, coordinate removal, storage, and reinstallation of surface protective trim units with finishing work specified in Division 9 Sections. Do not install surface-mounted items until finishes have been completed on substrates involved.

- E. Thresholds: Set thresholds for exterior and acoustical doors in full bed of sealant complying with requirements specified in Division 7 Section "Joint Sealants."
- F. Storage: Provide a secure lock up for hardware delivered to the project but not yet installed. Control the handling and installation of hardware items so that the completion of the work will not be delayed by hardware losses before and after installation.
- G. No self-tapping screws allowed.

### 3.4 FIELD QUALITY CONTROL

- A. Field Inspection: Supplier will perform a final inspection of installed door hardware and state in report whether work complies with or deviates from requirements, including whether door hardware is properly installed, operating and adjusted.

### 3.5 ADJUSTING

- A. Initial Adjustment: Adjust and check each operating item of door hardware and each door to ensure proper operation or function of every unit. Replace units that cannot be adjusted to operate as intended. Adjust door control devices to compensate for final operation of heating and ventilating equipment and to comply with referenced accessibility requirements.
- B. Final Adjustment: Installer shall return and make final adjustment of all hardware once all air conditioning test and balance is complete. Final adjustment shall be made while air conditioner system is operating. Coordinate with General Contractor and Owner.

### 3.6 CLEANING AND PROTECTION

- A. Protect all hardware stored on construction site in a covered and dry place. Protect exposed hardware installed on doors during the construction phase. Install any and all hardware at the latest possible time frame.
- B. Clean adjacent surfaces soiled by door hardware installation.
- C. Clean operating items as necessary to restore proper finish. Provide final protection and maintain conditions that ensure door hardware is without damage or deterioration at time of owner occupancy.

### 3.7 DEMONSTRATION

- A. Instruct Owner's maintenance personnel to adjust, operate, and maintain mechanical and electromechanical door hardware.

### 3.8 DOOR HARDWARE SETS

The hardware sets represent the design intent and direction of the owner and architect. They are a guideline only and should not be considered a detailed hardware schedule. Discrepancies, conflicting hardware and missing items should be brought to the attention of the architect with corrections made prior to the bidding process. Omitted items not included in a hardware set should be scheduled with the appropriate additional hardware required for proper application and functionality.

#### A. Manufacturer's Abbreviations:

1. MK - McKinney
2. OT - OTHER
3. PE - Pemko
4. RO - Rockwood
5. PR - Precision
6. MX - Marks
7. SA - Sargent
8. AD - Adams Rite
9. BE - Best Access Systems
10. HS - HES
11. SU - Securitron
12. KD - Keedex
13. LO - Locinox

**\*\*At existing doors / frames, all conditions must be field verified prior to order.**

**At aluminum frames, gasket is by frame manufacturer.**

**\*\*Confirm EPT v/s door loop at all access control locations.**

**\*\*Confirm all fire ratings and provide compliant hardware.**

**Hardware Sets based on plans dated 08/09/2024**

**12/11/2024 – Revisions per 75% Owner’s meeting**

**2/12/2025 – Revisions per 95% Owner’s meeting**

**SMITH MIDDLE SCHOOL HARDWARE SETS**

**Set: 1.0**

Doors: C100A-2

Description: 2N Station - 8510 LT LD

1	Rim Exit SPAR NC-E11	LD 19 TB 43 8510 EO	US32D	SA
1	Balance of hardware	Existing to remain		OT
1	2N Station	2N		OT

**Set: 2.0**

Doors: B111-3

Description: 2N Station - 8804 LD - Sweep

1	Rim Exit SPAR NC-E11	LD 19 TB 43 70 8804 Less Pull	US32D	SA
1	Gasketing	2891APK (head & jambs)		PE
1	Sweep	345ANB x Dr. Width		PE
1	All hardware	Existing to remain		OT
1	2N Station	2N		OT

Notes: Gasketing by door manufacturer at aluminum doors. Existing electric strike to remain.

**Set: 2.1**

Doors: B108-4

Description: 8804 LD - Sweep

1	Rim Exit SPAR NC-E11	LD 19 TB 43 70 8804 Less Pull	US32D	SA
1	Gasketing	2891APK (head & jambs)		PE
1	Sweep	345ANB x Dr. Width		PE
1	All hardware	Existing to remain		OT

Notes: Gasketing by door manufacturer at aluminum doors. Existing electric strike to remain.

**Set: 3.0**

Doors: A004-6

Description: Reader to remain

1	Reader	Existing to remain	26D	SA
1	Balance of hardware	Existing to remain		OT

Notes: Gasketing by the door manufacturer at aluminum doors.

**Set: 3.1**

Doors: E100G-1, E100H-1

Description: Add 8510 LD

1	Rim Exit SPAR NC-E11	LD 19 TB 43 8510 EO	US32D	SA
1	Balance of hardware	Existing to remain		OT

**Set: 3.2**

Doors: C100A-1

Description: Add 8504 / 8510 LD

1	Rim Exit SPAR NC-E11	LD 19 TB 43 8510 EO	US32D	SA
1	Rim Exit SPAR04867/NC-E11	LD 19 TB 43 70 8504 Less Pull	US32D	SA
1	Interchangeable Core	I/CK-7	626	BE
1	Const. Core	7190224	Green	BE
1	Balance of hardware	Existing to remain		OT

**Set: 4.0**

Doors: B113-1

Description: Add Reader - Gasket - Threshold

1	Gasketing	2891APK (head & jambs)		PE
1	Threshold	2005AT MSES25SS X Opening Width		PE
1	Reader	Existing to remain	26D	SA
1	Balance of hardware	Existing to remain		OT

**Set: 5.0**

Doors: B107H-2, D106-2

Description: Add SN200 Exit, Loop, Sweep, Gasket, Threshold

1	Rim Exit x SPAR04867/NC-E11	19 LD TB 43 70 56-SN200-8804	US32D	SA
1	Interchangeable Core	I/CK-7	626	BE
1	Const. Core	7190224	Green	BE
1	Gasketing	2891APK (head & jambs)		PE
1	Sweep	345ANB x Dr. Width		PE
1	Threshold	2005AT MSES25SS X Opening Width		PE
1	ElectroLynx Harness	QC-C1500P		MK
1	ElectroLynx Harness	QC-C***P (length as req'd)		MK
1	Door Loop	DL-2		AK
1	Door Position Switch	By Security.		OT
1	Power Supply	Provided by security		SU
1	Balance of hardware	Existing to remain		OT

**Set: 6.0**

Doors: A109-1, B104-1, B104-2, B110-1, B111-1, D100A-1, D100B-1, D100C-1, D100D-1, D103-2, D104-2, E117-1, E118-1, E129-1, E130-1, E155-1, E156-1, E251-1, E252-1

Description: Add Exit Device-8816- HO Closers

1	Rim Exit Sec CR x SPAR#NC-E11	19 LD TB 43 49 70 8816 ETL	US32D	SA
2	Interchangeable Core	I/CK-7	626	BE
2	Const. Core	7190224	Green	BE
1	Surface Closer	TB 351 PSH	EN	SA
1	Door Stop	481H	US26D	RO
1	Balance of hardware	Existing to remain		OT

Notes: Provide hold open closers at classrooms unless fire rated. No hold open on rated doors.

**Set: 6.1**

Doors: D100L-1, D100L-2, D100L-3, D103-1, D104-1

Description: Add Exit Device-8804- HO Closers

1	Rim Exit SPAR NC-E11	LD 19 TB 43 70 8804 ETL	US32D	SA
2	Interchangeable Core	I/CK-7	626	BE
2	Const. Core	7190224	Green	BE
1	Surface Closer	TB 351 PSH	EN	SA
1	Door Stop	481H	US26D	RO
1	Balance of hardware	Existing to remain		OT

Notes: Provide hold open closers at classrooms unless fire rated. No hold open on rated doors.

**Set: 7.0**

Doors: D106-1

Description: Add Exit Device-8816- ADB

1	Rim Exit Sec CR x SPAR#NC-E11	19 LD TB 43 49 70 8816 ETL	US32D	SA
2	Interchangeable Core	I/CK-7	626	BE
2	Const. Core	7190224	Green	BE
1	Door Bottom	411APKL		PE
1	Balance of hardware	Existing to remain		OT

**Set: 8.0**

Doors: B100-1, B108-1

Description: Add Rated Exit Device-8816/8804- Closers - Thru bolts

1	Rim Exit Rated Sec CR x SPAR#NC-E11	12 LD 19 TB 43 49 70 8816 ETL	US32D	SA
1	Rim Exit SPAR NC-E11	12 LD 19 TB 43 70 8804 ETL	US32D	SA
4	Interchangeable Core	I/CK-7	626	BE
4	Const. Core	7190224	Green	BE
2	Sex Nut & Bolt Kit	SNB134-38	689	NO
2	Door Stop	481H	US26D	RO
1	Balance of hardware	Existing to remain		OT

Notes: Provide hold open closers at classrooms unless fire rated. No hold open on rated doors.

\*\*TB Kit to be used to fill existing pull preps.

**Set: 9.0**

Description: Not Used

1 Set Not Used OT

Notes: Doors are normally closed and secure. Presentation of valid credential will allow entry by pull. Upon loss of power, doors will remain secure. Free egress at all times.

**Set: 10.0**

Doors: E100B-1

Description: Add Pr SN200 Narrow Exit x Less Trim x 8510 - Loop

1	Rim Exit SPAR NC-E11	LD 19 TB 43 8510 EO	US32D	SA
1	Rim Exit xSPAR04867/NC-E11	19 LD TB 43 70 56-SN200-8504 Less Trim		US32D
	SA			
1	Interchangeable Core	I/CK-7	626	BE
1	Const. Core	7190224	Green	BE
2	Door Stop	462	US2C	RO
1	ElectroLynx Harness	QC-C1500P		MK
2	ElectroLynx Harness	QC-C***P (length as req'd)		MK
1	Door Loop	DL-2		AK
1	Power Supply	Provided by security		SU
1	Balance of hardware	Existing to remain		OT

Notes: Doors are normally closed and secure. Presentation of valid credential will allow entry by pull. Upon loss of power, doors will remain secure. Free egress at all times. Reuse existing trim.

**Set: 11.0**

Doors: E100B-2, E100G-2

Description: No Work

1 All hardware Existing to remain OT

**Set: 12.0**

Doors: C101-2

Description: Add Pr SN200 Narrow Exit x Less Trim - Loop - Closers - Dog

1	Rim Exit SPAR NC-E11 Dog	19 TB 43 8510 EO	US32D	SA
1	Rim Exit xSPAR04867/NC-E11	19 LD TB 43 70 56-SN200-8504 Less Trim		US32D
	SA			
1	Interchangeable Core	I/CK-7	626	BE
1	Const. Core	7190224	Green	BE
2	Surface Closer	TB 351 P10	EN	SA
2	Door Stop	462	US2C	RO
1	ElectroLynx Harness	QC-C1500P		MK
2	ElectroLynx Harness	QC-C***P (length as req'd)		MK

1	Door Loop	DL-2	AK
1	Power Supply	Provided by security	SU
1	Balance of hardware	Existing to remain	OT

Notes: Doors are normally closed and secure. Presentation of valid credential will allow entry by pull. Upon loss of power, doors will remain secure. Free egress at all times. Reuse existing trim.

**Set: 12.1**

Doors: D105A-2

Description: Add Pr SN200 Narrow Exit x Less Trim - Loop - Closers - LD

	Rim Exit SPAR NC-E11	LD 19 TB 43 8510 EO	US32D	SA
1	Rim Exit xSPAR04867/NC-E11 SA	19 LD TB 43 70 56-SN200-8504 Less Trim		US32D
1	Interchangeable Core	I/CK-7	626	BE
1	Const. Core	7190224	Green	BE
2	Surface Closer	TB 351 P10	EN	SA
2	Door Stop	462	US2C	RO
1	ElectroLynx Harness	QC-C1500P		MK
2	ElectroLynx Harness	QC-C***P (length as req'd)		MK
1	Door Loop	DL-2		AK
1	Power Supply	Provided by security		SU
1	Balance of hardware	Existing to remain		OT

Notes: Doors are normally closed and secure. Presentation of valid credential will allow entry by pull. Upon loss of power, doors will remain secure. Free egress at all times. Reuse existing trim.

**Set: 13.0**

Doors: E100J-1

Description: Add Sgl SN200 Narrow Exit x Less Trim - Loop

1	Rim Exit xSPAR04867/NC-E11 SA	19 LD TB 43 70 56-SN200-8504 Less Trim		US32D
1	Interchangeable Core	I/CK-7	626	BE
1	Const. Core	7190224	Green	BE
1	Door Stop	462	US2C	RO
1	ElectroLynx Harness	QC-C1500P		MK
2	ElectroLynx Harness	QC-C***P (length as req'd)		MK
1	Door Loop	DL-2		AK
1	Power Supply	Provided by security		SU
1	Balance of hardware	Existing to remain		OT

Notes: Doors are normally closed and secure. Presentation of valid credential will allow entry by pull. Upon loss of power, doors will remain secure. Free egress at all times. Reuse existing trim.

**Set: 13.1**



Doors: E100K-1

Description: Add Sgl 56-8504 Narrow Exit x Less Trim - EPT

Electric Power Transfer	EL-CEPT	630	SU
Rim Exit xSPAR04867/NC-E11	LD 19 TB 43 56 70 8504 Less Pull	US32D	SA
1 Interchangeable Core	I/CK-7	626	BE
1 Const. Core	7190224	Green	BE
1 Door Stop	462	US2C	RO
1 ElectroLynx Harness	QC-C1500P		MK
1 ElectroLynx Harness	QC-C***P (length as req'd)		MK
1 Power Supply	Provided by security		SU
1 Balance of hardware	Existing to remain		OT

Notes: Doors are normally closed and secure. Presentation of valid credential will allow entry by pull. Upon loss of power, doors will remain secure. Free egress at all times. Reuse existing trim.

**Set: 14.0**

Doors: A101-1, E124A-1, E130A-1, E149A-1, E150A-1, E226A-1, E245A-1, E246A-1, E256-1, F101-1

Description: Existing - Add 8204

1 Storeroom/Closet Lock	70 8204 LL	US26D	SA
1 Interchangeable Core	I/CK-7	626	BE
1 Const. Core	7190224	Green	BE
1 Door Stop	481H	US26D	RO
1 Balance of hardware	Existing to remain		OT

**Set: 15.0**

Description: Not Used

1 Set	Not Used		OT
-------	----------	--	----

**Set: 16.0**

Description: Not Used

1 Set	Not Used		OT
-------	----------	--	----

**Set: 17.0**

Doors: E206-2

Description: Existing - Add 8204 - HO Closer - Classroom

1 Storeroom/Closet Lock	70 8204 LL	US26D	SA
1 Interchangeable Core	I/CK-7	626	BE
1 Const. Core	7190224	Green	BE
1 Door Closer w/ HO	TB 351 H (inswing)/ PSH (outswing) As Req	EN	SA
1 Door Stop	481H	US26D	RO
1 Balance of hardware	Existing to remain		OT

**Set: 18.0**

Doors: E112-1, E124-1, E140-1, E149-1, E150-1, E207-2, E226-2, E236-2, E245-2, E246-2  
Description: Existing - Add 8204 - Rated Classroom

1	Storeroom/Closet Lock	70 8204 LL	US26D	SA
1	Interchangeable Core	I/CK-7	626	BE
1	Const. Core	7190224	Green	BE
1	Door Closer	TB 351 O/P9 (type as required)	EN	SA
1	Door Stop	481H	US26D	RO
1	Balance of hardware	Existing to remain		OT

**Set: 19.0**

Doors: E112-2, E124-2, E140-2, E149-2, E150-2, E207-1, E226-1, E236-1, E245-1, E246-1  
Description: Existing - Add 8238 - Rated Classroom

1	Classroom Security Intruder Lock SA	V01 EMB 70 8238 VN1L 90-3/8" Collar	US26D	
2	Interchangeable Core	I/CK-7	626	BE
2	Const. Core	7190224	Green	BE
1	Door Closer	TB 351 O/P9 (type as required)	EN	SA
1	Door Stop	481H	US26D	RO
1	Balance of hardware	Existing to remain		OT

**Set: 20.0**

Doors: A106-1, A107-1, B109-1, D101-1, D102-1, E101-1, E102-1, E105-1, E113-1, E115-1, E125-1, E127-1, E131-1, E133-1, E134-1, E136-1, E138-1, E139-1, E143-1, E145-1, E147-1, E148-1, E151-1, E153-1, E202-1, E203-1, E204-1, E205-1, E206-1, E208-1, E210-1, E212-1, E213-1, E220-1, E222-1, E224-2, E225-1, E227-1, E229-1, E230-1, E232-1, E234-1, E235-1, E239-1, E241-1, E243-1, E244-1, E247-1, E249-1  
Description: Existing - Add 8238 - HO Closer

1	Classroom Security Intruder Lock SA	V01 EMB 70 8238 VN1L 90-3/8" Collar	US26D	
2	Interchangeable Core	I/CK-7	626	BE
2	Const. Core	7190224	Green	BE
1	Door Closer w/ HO	TB 351 H (inswing)/ PSH (outswing) As Req	EN	SA
1	Door Stop	481H	US26D	RO
1	Balance of hardware	Existing to remain		OT

**Set: 20.1**

Doors: A102-1, B103-1  
Description: Existing - Add 8238

1	Classroom Security Intruder Lock SA	V01 EMB 70 8238 VN1L 90-3/8" Collar	US26D	
2	Interchangeable Core	I/CK-7	626	BE
2	Const. Core	7190224	Green	BE
1	Door Stop	481H	US26D	RO
1	Balance of hardware	Existing to remain		OT

**Set: 21.0**

Doors: A100M-2, A102A-1

Description: Existing - Add 8237

1 Classroom Lock	70 8237 LL	US26D	SA
1 Interchangeable Core	I/CK-7	626	BE
1 Const. Core	7190224	Green	BE
1 Door Stop	481H	US26D	RO
1 Balance of hardware	Existing to remain		OT

Notes: Add 31- to lockset at doors over 1 3/4" thick.

**Set: 22.0**

Doors: A100A-1, A100B-1, A100C-1, A100C-2, A100E-1, A100G-1, A100H-1, A100H-2, A103-1, A104-1, A104A-1, A104B-1, A104C-1, A104D-1, A104E-1, A105-1, A105A-1, A105B-1, A105C-1, A105D-1, C105G-1, E106-1, E107-1, E108-1, E110-1, E111-1

Description: Existing - Add 8205

1 Office/Entry Lock	70 8205 LL	US26D	SA
1 Interchangeable Core	I/CK-7	626	BE
1 Const. Core	7190224	Green	BE
1 Door Stop	481H	US26D	RO
1 Balance of hardware	Existing to remain		OT

**Set: 23.0**

Doors: A102B-1

Description: Existing - Add 8215

1 Passage Latch	8215 LL	US26D	SA
1 Door Stop	481H	US26D	RO
1 Balance of hardware	Existing to remain		OT

**Set: 24.0**

Doors: E122-1, E123-1, E217-1, E219-1

Description: Existing - Add 8250 - HO Closer

1 Hotel Guest Lock Lock	V20 LC 8250 VN1L	US26D	SA
1 Interchangeable Core	I/CK-7	626	BE
1 Const. Core	7190224	Green	BE
1 Mortise Cylinder for Hotel Lock	1E-7G4 C208 RP3	626	BE
1 Surface Closer	TB 351 H	EN	SA
1 Door Stop	481H	US26D	RO
1 Balance of hardware	Existing to remain		OT

**Set: 25.0**

Doors: A100K-1, A102C-1, E131B-1

Description: Existing - Add 8265

1 Privacy Lock	V20 8265 VN1L	US26D	SA
----------------	---------------	-------	----

1	Door Stop	481H	US26D	RO
1	Balance of hardware	Existing to remain		OT

**Set: 26.0**

Doors: A106-2, A107-2

Description: Existing Sgl Ext ASF- Add Closer - Stop

1	Surface Closer	TB 351 P10	EN	SA
1	Door Stop	462	US2C	RO
1	Balance of hardware	Existing to remain		OT

**Set: 27.0**

Doors: C101-3

Description: \*\*Pr Ext - ASF - Exit Device- SN200/DT - Mullion - Closer w/Stop Arm -Access Control

1	Continuous Hinge	CFM SLF-HD1 x Dr. Ht.		PE
1	Continuous Hinge	CFM SLF-HD1 PT x Dr. Ht.		PE
1	Electric Power Transfer	EL-CEPT	630	SU
1	Mullion	KR822 (FLK as req)	600	PR
2	Stabilizer	ST989	Dull Black	PR
1	Spacer	MCS822	689	PR
1	Rim Exit xSPAR04867/NC-E11	19 LD TB 43 70 56-SN200-8504 862	US32D	SA
1	Rim Exit x SPAR#NC-E11	19 TB 43 8510 862	US32D	SA
2	Interchangeable Core	I/CK-7	626	BE
1	Rim Cylinder	70 34 X #90 - 1/2	US32D	SA
2	Const. Core	7190224	Green	BE
2	Kit	581-1/ 581-2 as required	EN	SA
2	Surface Closer	TB 351 P10	EN	SA
2	Door Stop	462	US2C	RO
2	Sweep IDF/MDF/Alum	18061CNB x Dr. Width		PE
1	Threshold	2005AT MSES25SS X Opening Width		PE
1	Perimeter Seal	By door mfgr		OT
1	ElectroLynx Harness	QC-C1500P		MK
2	ElectroLynx Harness	QC-C***P (length as req'd)		MK
2	Door Position Switch	By Security.		OT
1	Power Supply	Provided by security		SU

Notes: Operation: Doors normally closed and locked. Valid card at the card reader retracts the latch on the active leaf for entry. Free egress at all times. Door status monitored. Confirm specified hardware is compatible with aluminum door manufacturer.

**Set: 28.0**

Doors: C105-1

Description: \*\*Sgl - ExT -HM - EX FR Exit- 2N Lever- Closer /HO- Access Control - Viewer

1	Continuous Hinge	CFM HD1 x Dr. Ht.		PE
1	Rim Exit 2N SPAR04867/NC-E11	LD 19 TB 43 56 70 8804 ETL	US32D	SA
1	Vandal Resistant Trim	826	US32D	SA

1	Interchangeable Core	I/CK-7	626	BE
1	Const. Core	7190224	Green	BE
1	Surface Closer	TB 351 PSH	EN	SA
1	Gasketing	2891APK (head & jambs)		PE
1	Rain Guard	346C x Frame Width		PE
1	Sweep	345ANB x Dr. Width		PE
1	Sweep IDF/MDF/Alum	18061CNCB x Dr. Width		PE
1	Threshold	2005AT MSES25SS X Opening Width		PE
1	ElectroLynx Harness	QC-C1500P		MK
1	ElectroLynx Harness	QC-C***P (length as req'd)		MK
1	Door Loop	DL-2		AK
1	Door Position Switch	By Security.		OT
1	Power Supply	Provided by security		SU
2	Viewer	622 x door thickness	DCRM	RO
1	Keedex Lock Protector	K12S - SGT		OT

Notes: Operation: Doors normally closed and locked. Valid card at the card reader retracts the latch on the active leaf for entry. Free egress at all times. Door status monitored. Confirm specified hardware is compatible with door manufacturer.

**Set: 29.0**

Doors: C109-2

Description: \*\*Sgl - ExT -HM - Exit- SN200 FSW - Closer /Stop- Access Control

1	Continuous Hinge	CFM SLF-HD1 x Dr. Ht.		PE
1	Rim Exit x SPAR04867/NC-E11	LD 19 TB 43 70 56-SN200-8804 FSW US32D		SA
1	Interchangeable Core	I/CK-7	626	BE
1	Const. Core	7190224	Green	BE
1	Surface Closer	TB 351 PS	EN	SA
1	Door Stop	462	US2C	RO
1	Gasketing	2891APK (head & jambs)		PE
1	Rain Guard	346C x Frame Width		PE
1	Sweep	345ANB x Dr. Width		PE
1	Sweep IDF/MDF/Alum	18061CNCB x Dr. Width		PE
1	Threshold	2005AT MSES25SS X Opening Width		PE
1	ElectroLynx Harness	QC-C1500P		MK
2	ElectroLynx Harness	QC-C***P (length as req'd)		MK
1	Door Loop	DL-2		AK
1	Door Position Switch	By Security.		OT
1	Power Supply	Provided by security		SU

Notes: Operation: Doors normally closed and locked. Valid card at the card reader retracts the latch on the active leaf for entry. Free egress at all times. Door status monitored. Confirm specified hardware is compatible with door manufacturer.

**Set: 30.0**

Doors: B100-4, B101H-2

Description: \*\*Sgl - ExT -HM - Exit- SN200 - Closer /Stop- Access Control - Peep

1	Continuous Hinge	CFM HD1 PT x Dr. Ht.		PE
1	Electric Power Transfer	EL-CEPT	630	SU
1	Rim Exit x SPAR04867/NC-E11	19 LD TB 43 70 56-SN200-8804	US32D	SA
1	Vandal Resistant Trim	826	US32D	SA
1	Interchangeable Core	I/CK-7	626	BE
1	Const. Core	7190224	Green	BE
1	Surface Closer	TB 351 PS	EN	SA
1	Gasketing	2891APK (head & jambs)		PE
1	Rain Guard	346C x Frame Width		PE
1	Sweep	345ANB x Dr. Width		PE
1	Threshold	2005AT MSES25SS X Opening Width		PE
1	ElectroLynx Harness	QC-C1500P		MK
2	ElectroLynx Harness	QC-C***P (length as req'd)		MK
1	Door Position Switch	By Security.		OT
1	Power Supply	Provided by security		SU
2	Viewer	622 x door thickness	DCRM	RO

Notes: Doors are normally closed and secure. Presentation of valid credential will allow entry by pull. Upon loss of power, doors will remain secure. Free egress at all times.

**Set: 31.0**

Doors: B101B-2, C106-2

Description: \*\*Pr Ext - Storeroom/Mechanical - Closer/Stop

2	Continuous Hinge	CFM HD1 x Dr. Ht.		PE
1	Surface Bolt	580-12 @ top only	US26D	RO
1	Storeroom/Closet Lock	70 8204 LL	US26D	SA
1	Interchangeable Core	I/CK-7	626	BE
1	Const. Core	7190224	Green	BE
1	Door Closer	TB 351 PS	EN	SA
1	Astragal Set (2)	18061CNCB x Dr. Ht		PE
1	Gasketing	2891APK (head & jambs)		PE
1	Rain Guard	346C x Frame Width		PE
2	Sweep	345ANB x Dr. Width		PE
1	Threshold	2005AT MSES25SS X Opening Width		PE
2	Door Position Switch	By Security.		OT

Notes: Closer on active leaf.

**Set: 32.0**

Doors: D100L-5

Description: \*\*Sgl - Ext- Mech/Storage/Fire Riser - Closer w/Stop Arm

1	Continuous Hinge	CFM HD1 x Dr. Ht.		PE
1	Storeroom/Closet Lock	70 8204 LL	US26D	SA
1	Interchangeable Core	I/CK-7	626	BE

1	Const. Core	7190224	Green	BE
1	Surface Closer	TB 351 PS	EN	SA
1	Gasketing	2891APK (head & jambs)		PE
1	Rain Guard	346C x Frame Width		PE
1	Sweep	345ANB x Dr. Width		PE
1	Threshold	2005AT MSES25SS X Opening Width		PE
1	Door Position Switch	By Security.		OT

**Set: 33.0**

Doors: A002-1

Description: \*\*Pr Int- ASF - Vest SN200 Exit Device- NL/DT - Mullion - Closer /Stop - Access Control

1	Continuous Hinge	CFM SLF-HD1 x Dr. Ht.		PE
1	Continuous Hinge	CFM SLF-HD1 PT x Dr. Ht.		PE
1	Mullion	KR822 (FLK as req)	600	PR
2	Stabilizer	ST989	Dull Black	PR
1	Spacer	MCS822	689	PR
1	Rim Exit x SPAR04867/NC-E11	19 LD TB 43 70 56-SN200-8804 ETL	US32D	SA
1	Rim Exit - DT x SPAR#NC-E11	19 LD TB 43 8810 ETL	US32D	SA
2	Interchangeable Core	I/CK-7	626	BE
1	Rim Cylinder	70 34 X #90 - 1/2	US32D	SA
2	Const. Core	7190224	Green	BE
2	Kit	581-1/ 581-2 as required	EN	SA
2	Surface Closer	TB 351 P10	EN	SA
2	Door Stop	481H	US26D	RO
1	Perimeter Seal	By door mfr		OT
1	ElectroLynx Harness	QC-C1500P		MK
2	ElectroLynx Harness	QC-C***P (length as req'd)		MK
2	Door Position Switch	By Security.		OT
1	Power Supply	Provided by security		SU

Notes: Operation: Doors normally closed and locked. Valid card at the card reader retracts the latch on the active leaf for entry. Free egress at all times. Door status monitored. Confirm specified hardware is compatible with aluminum door manufacturer.

**Set: 34.0**

Doors: A002-2

Description: \*\*Pr Int- ASF - Vest Exit Device- NL/DT - Mullion - Closer /Stop

2	Continuous Hinge	CFM SLF-HD1 x Dr. Ht.		PE
1	Mullion	KR822 (FLK as req)	600	PR
2	Stabilizer	ST989	Dull Black	PR
1	Spacer	MCS822	689	PR
1	Rim Exit 2N SPAR04867/NC-E11	LD 19 TB 43 56 70 8804 ETL	US32D	SA
1	Rim Exit - DT x SPAR#NC-E11	19 LD TB 43 8810 ETL	US32D	SA
2	Interchangeable Core	I/CK-7	626	BE
1	Rim Cylinder	70 34 X #90 - 1/2	US32D	SA
2	Const. Core	7190224	Green	BE

2	Kit	581-1/ 581-2 as required	EN	SA
2	Surface Closer	TB 351 P10	EN	SA
2	Door Stop	481H	US26D	RO
1	Perimeter Seal	By door mfg		OT

**Set: 35.0**

Doors: C109E-1

Description: \*\*Sgl - Exit Device-Security CL - Closer - STC

3	Hinges	By the STC door manufacturer		OT
1	Rim Exit Sec CR x SPAR#NC-E11	19 LD TB 43 49 70 8816 ETL	US32D	SA
2	Interchangeable Core	I/CK-7	626	BE
2	Const. Core	7190224	Green	BE
1	Door Closer	TB 351 O/P9 (type as required)	EN	SA
1	Door Stop	481H	US26D	RO
1	Gasket, threshold, door bottom	By the STC door manufacturer		OT

Notes: Door hardware is specified for design intent. Confirm hardware compatibility and design meets the door manufacturer's approved assembly testing for the STC level indicated.  
Add 31- to panic if door is over 1 3/4" thick.

**Set: 35.1**

Doors: C109-1

Description: \*\*Sgl - Push/Pull - Closer - STC

3	Hinges	By the STC door manufacturer		OT
1	Push Plate	70E	US32D	RO
1	Pull Plate	111x70C	US32D	RO
1	Door Closer	TB 351 O/P9 (type as required)	EN	SA
1	Door Stop	462	US2C	RO
1	Gasket, threshold, door bottom	By the STC door manufacturer		OT

Notes: Door hardware is specified for design intent. Confirm hardware compatibility and design meets the door manufacturer's approved assembly testing for the STC level indicated.

**Set: 36.0**

Doors: B101G-1, B107G-1

Description: Sgl - Exit Device-Security CL - Closer / HO

3	Hinge (heavy weight)	T4A3786	US26D	MK
1	Rim Exit Sec CR x SPAR#NC-E11	19 LD TB 43 49 70 8816 ETL	US32D	SA
2	Interchangeable Core	I/CK-7	626	BE
2	Const. Core	7190224	Green	BE
1	Surface Closer	TB 351 PSB	EN	SA
1	Door Stop	481H	US26D	RO
1	Gasketing	2891APK (head & jambs)		PE



**Set: 37.0**

Doors: F100-1

Description: Sgl - ASF Exit Device-Security CL - Closer / HO

1	Continuous Hinge	CFM SLF-HD1 x Dr. Ht.		PE
1	Rim Exit Sec CR x SPAR#NC-E11	19 LD TB 43 49 70 8816 ETL	US32D	SA
2	Interchangeable Core	I/CK-7	626	BE
2	Const. Core	7190224	Green	BE
1	Kit	581-1/ 581-2 as required	EN	SA
1	Surface Closer	TB 351 PSH	EN	SA
1	Door Stop	481H	US26D	RO
1	Perimeter Seal	By door mfgr		OT

**Set: 38.0**

Doors: A100-1, A100-2, A100M-1

Description: \*\*Sgl- Int ASF- SN200 Lock- Closer - Access Control

1	Continuous Hinge	CFM SLF-HD1 PT x Dr. Ht.		PE
1	Electric Power Transfer	EL-CEPT	630	SU
1	SN200 Mort Lock	70 SN200-82271 OL	US26D	SA
1	Interchangeable Core	I/CK-7	626	BE
1	Const. Core	7190224	Green	BE
1	Door Closer	TB 351 O/P9 (type as required)	EN	SA
1	Door Stop	481H	US26D	RO
1	ElectroLynx Harness	QC-C1500P		MK
1	ElectroLynx Harness	QC-C***P (length as req'd)		MK
1	Door Position Switch	By Security.		OT
1	Power Supply	Provided by security		SU
1	Gasketing	By the frame manufacturer		OT

Notes: Operation: Door normally closed and secure. Valid card at the card reader will allow entry by trim. Free egress at all times. Door status is monitored. Install reader and cylinder on reception side.

**Set: 39.0**

Doors: C109B-1

Description: \*\*Sgl - Storeroom - Wide

3	Hinge (heavy weight)	T4A3786	US26D	MK
1	Storeroom/Closet Lock	70 8204 LL	US26D	SA
1	Interchangeable Core	I/CK-7	626	BE
1	Const. Core	7190224	Green	BE
1	Door Stop	481H	US26D	RO
3	Silencer	608		RO

**Set: 40.0**

Doors: B101A-3, B107A-3, C109D-1

Description: \*\*Sgl - Classroom

3	Hinge, Full Mortise	TA2714	US26D	MK
1	Classroom Lock	70 8237 LL	US26D	SA
1	Interchangeable Core	I/CK-7	626	BE
1	Const. Core	7190224	Green	BE
1	Door Stop	481H	US26D	RO
1	Silencer	608		RO

**Set: 41.0**

Doors: [A106C-1](#)

Description: \*\*Sgl - Storeroom - closer/stop - Wide

3	Hinge (heavy weight)	T4A3786	US26D	MK
1	Storeroom/Closet Lock	70 8204 LL	US26D	SA
1	Interchangeable Core	I/CK-7	626	BE
1	Const. Core	7190224	Green	BE
1	Surface Closer	TB 351 PS	EN	SA
3	Silencer	608		RO

**Set: 42.0**

Doors: [C109A-1](#), [D104C-1](#)

Description: \*\*Sgl - 8204 - Practice STC

3	Hinges	By the STC door manufacturer		OT
1	Storeroom/Closet Lock	70 8204 LL	US26D	SA
1	Interchangeable Core	I/CK-7	626	BE
1	Const. Core	7190224	Green	BE
1	Door Stop	462	US2C	RO
1	Gasket, threshold, door bottom	By the STC door manufacturer		OT

Notes: Door hardware is specified for design intent. Confirm hardware compatibility and design meets the door manufacturer's approved assembly testing for the STC level indicated.

Add 31- to lockset if door is over 1 3/4" thick.

**Set: 42.1**

Doors: [C109C-1](#)

Description: \*\*Sgl - 8237 - Practice STC

3	Hinges	By the STC door manufacturer		OT
1	Classroom Lock	70 8237 LL	US26D	SA
1	Interchangeable Core	I/CK-7	626	BE
1	Const. Core	7190224	Green	BE
1	Door Stop	462	US2C	RO
1	Gasket, threshold, door bottom	By the STC door manufacturer		OT

Notes: Door hardware is specified for design intent. Confirm hardware compatibility and design meets the door manufacturer's approved assembly testing for the STC level indicated.

Add 31- to lockset if door is over 1 3/4" thick.

**Set: 43.0**

Doors: B101G-2, B107G-2

Description: Sgl - Push Pull - Closer - HO

3	Hinge (heavy weight)	T4A3786	US26D	MK
1	Push Plate	70E	US32D	RO
1	Pull Plate	111x70C	US32D	RO
1	Door Closer w/ HO	TB 351 H (inswing)/ PSH (outswing) As Req	EN	SA
1	Door Stop	481H	US26D	RO
3	Silencer	608		RO

**Set: 43.1**

Doors: B100B-1, B100B-2, B100C-1, B100C-2

Description: \*\*Sgl - Multi Occ RR - Classroom Cyl - Closer

3	Hinge, Full Mortise	TA2714	US26D	MK
1	Classroom Lock	70 10XG37 LL	US26D	SA
1	Interchangeable Core	I/CK-7	626	BE
1	Const. Core	7190224	Green	BE
1	Door Closer w/ HO	TB 351 H (inswing)/ PSH (outswing) As Req	EN	SA
1	Door Stop	481H	US26D	RO
3	Silencer	608		RO

Notes: Confirm door height / hinge quantity required at G1001-1, G1001-2

**Set: 44.0**

Doors: A1003-1, B100-2, B100A-2, B100A-3, B111-2, C104-2, C104-3, C104A-1, C104A-2, C104A-3, D204-1, E100G-3, E161-2, S103-2, S103-3

Description: \*\*OH Coiling Doors - No Work

1	All hardware	Existing to remain		OT
---	--------------	--------------------	--	----

**Set: 45.0**

Doors: D100L-6

Description: \*\*OH Coiling Doors - Motorized

2	Mortise Cylinder	70 42	US32D	SA
2	Interchangeable Core	I/CK-7	626	BE
2	Const. Core	7190224	Green	BE
2	Keyswitch	MK x MKS		SU
1	Balance hardware	by the door manufacturer		OT

Notes: Provide keyswitch on both sides of door.

**Set: 46.0**

Doors: A004-3, A004-4, A004-7, A100D-1, A100F-1, A100J-1, A100L-1, A105E-1, A106A-1, A106A-2, A106B-1, A106B-2, A108-1, A109-2, A109A-1, A109B-1, A109C-1, A110-1, A112-1, B100-3, B100A-1, B101A-1, B101A-2, B101AA-1, B101AB-1, B101B-1, B101C-1, B101H-1, B102-1, B102-2, B104A-1, B105-1, B105-2, B106-1, B107A-1, B107A-2, B107AB-1, B107B-1, B107B-2, B107C-1, B107H-1, B109A-1, B109B-1, B110-2, B110-3, B110A-1, B110A-2, B110B-1, B110C-1, B110D-1, B111-4, B113-2, B114-1, B114-2, B115-1, B117-1, B118-1, B118-A, C100-1, C102-1, C103-1, C104-1, C105A-1, C105B-1, C105C-1, C105D-1, C105E-1, C105F-1, C106-1, C107-1, C107-2, C112-1, C112A-1, C112B-1, C113-1, D100E-1, D101A-1, D101A-2, D101B-1, D102A-1, D103B-1, D103C-1, D104A-1, D104B-1, D105-1, D105A-1, D106A-1, D106B-1, D106C-1, D106D-1, D106E-1, D106F-1, D106G-1, E100-1, E101A-1, E109-1, E111A-1, E111B-1, E111C-1, E112-3, E114-1, E114-2, E114A-1, E116-1, E120-1, E124-3, E126-1, E126-2, E128-1, E128A-1, E131A-1, E131A-2, E131B-2, E132-1, E133A-1, E135-1, E135-2, E135A-1, E137-1, E140-3, E141-1, E142-1, E144-1, E144-2, E144A-1, E146-1, E149-3, E150-3, E152-1, E152-2, E152A-1, E154-1, E158-1, E160-1, E161-1, E200-1, E200A-1, E200B-1, E207-3, E209-1, E209-2, E209A-1, E211-1, E215-1, E221-1, E221-2, E221A-1, E223-1, E225A-1, E226-3, E228-1, E229-2, E229A-1, E231-1, E231-2, E231A-1, E233-1, E236-3, E237-1, E238-1, E240-1, E240-2, E240A-1, E242-1, E245-3, E246A-2, E248-1, E248-2, E248A-1, E250-1, E254-1, F100-3, F100A-1, F100A-2, F100A-3, F100B-1, F101A-1, F102-1, F102A-1, S101-1, S102-1, S102-2, S103-1, S201-1  
Description: No Work

1 All hardware Existing to remain OT

**Set: 47.0**

Doors: Attic

Description: \*\*Attic Stock - EVERY CAMPUS

5 Classroom Security Intruder Lock Body SA		8238	US26D
10 130KB	Thumbturn Kit	26D	SA
50 Interchangeable Core	I/CK-7	626	BE
50 Key Blanks	Best "A" Keyway		BE
12 Regular Hold Open Arm	25-H	EN	SA
12 Parallel Hold Open Arm	25-PSH	EN	SA
4 Electromagnetic Holder	994M 24VAC	689	RF
5 994M Magnetic Parts	Door Armature 994510M	689	RF
5 994M Magnetic Parts	Screw & Backplate 998300	689	RF
5 994M Magnetic Parts	Swivel Armature 900-3	689	RF
5 994M Magnetic Parts	Magnet Assembly 998369-3V	689	RF
5 994M Magnetic Parts	Wall Cover 998315M	689	RF
5 SN200 Reader	52 6027 (Exit/Lock)	26D	SA

Notes: All attic stock ships direct to  
Director of Technical Services  
Cy Fair ISD Lockshop  
11430 Perry Road  
Houston, Texas 77064  
All attic stock to ship directly to Cy Fair from the distributor.  
DO NOT ship to jobsite.

**SPILLANE MIDDLE SCHOOL HARDWARE SETS**

**Set: 1.0**

Doors: C101-2

Description: Add 56-8804 Loop

1	Rim Exit SPAR04867/NC-E11	LD 19 TB 43 56 8804 Less Pull	US32D	SA
1	Interchangeable Core	I/CK-7	626	BE
1	Const. Core	7190224	Green	BE
1	ElectroLynx Harness	QC-C1500P		MK
1	ElectroLynx Harness	QC-C***P (length as req'd)		MK
1	Door Loop	DL-2		AK
1	Door Position Switch	By Security.		OT
1	Power Supply	Provided by security		SU
1	Balance of hardware	Existing to remain		OT

Notes: Gasketing by the door manufacturer at aluminum doors. Doors are normally closed and secure. Presentation of valid credential will allow entry by pull. Upon loss of power, doors will remain secure. Free egress at all times.

**Set: 1.1**

Doors: B100-2, B108-2

Description: Add 8804 Less Trim

1	Rim Exit SPAR NC-E11	LD 19 TB 43 8804 Less Pull	US32D	SA
1	Interchangeable Core	I/CK-7	626	BE
1	Const. Core	7190224	Green	BE
1	Power Supply	Provided by security		SU
1	Balance of hardware	Existing to remain		OT

Notes: Gasketing by the door manufacturer at aluminum doors. Existing electric strike / reader to remain.

**Set: 1.2**

Doors: E100B-1

Description: Add 56-8504 Loop

1	Rim Exit xSPAR04867/NC-E11	LD 19 TB 43 56 8504 Less Pull	US32D	SA
1	Interchangeable Core	I/CK-7	626	BE
1	Const. Core	7190224	Green	BE
1	ElectroLynx Harness	QC-C1500P		MK
1	ElectroLynx Harness	QC-C***P (length as req'd)		MK
1	Door Loop	DL-2		AK
1	Door Position Switch	By Security.		OT
1	Power Supply	Provided by security		SU
1	Balance of hardware	Existing to remain		OT

Notes: Gasketing by the door manufacturer at aluminum doors. Doors are normally closed and secure. Presentation of valid credential will allow entry by pull. Upon loss of power, doors will remain

secure. Free egress at all times.

**Set: 1.3**

Doors: E100G-1

Description: Add 56-8504 Loop x 8510

1	Rim Exit xSPAR04867/NC-E11	LD 19 TB 43 56 8504 Less Pull	US32D	SA
1	Rim Exit SPAR NC-E11	LD 19 TB 43 8510 EO	US32D	SA
1	Interchangeable Core	I/CK-7	626	BE
1	Const. Core	7190224	Green	BE
1	ElectroLynx Harness	QC-C1500P		MK
1	ElectroLynx Harness	QC-C***P (length as req'd)		MK
1	Door Loop	DL-2		AK
1	Door Position Switch	By Security.		OT
1	Power Supply	Provided by security		SU
1	Balance of hardware	Existing to remain		OT

Notes: Gasketing by the door manufacturer at aluminum doors. Doors are normally closed and secure. Presentation of valid credential will allow entry by pull. Upon loss of power, doors will remain secure. Free egress at all times.

**Set: 2.0**

Doors: E100H-1

Description: Add 8510 LD

1	Rim Exit SPAR NC-E11	LD 19 TB 43 8510 EO	US32D	SA
1	Balance of hardware	Existing to remain		OT

**Set: 3.0**

Doors: B107H-1

Description: Add SN200 8804 LT x Loop Threshold

1	Rim Exit x SPAR04867/NC-E11	19 LD TB 43 70 56-SN200-8804	US32D	SA
1	Interchangeable Core	I/CK-7	626	BE
1	Const. Core	7190224	Green	BE
1	Threshold	2005AT MSES25SS X Opening Width		PE
1	ElectroLynx Harness	QC-C1500P		MK
1	ElectroLynx Harness	QC-C***P (length as req'd)		MK
1	Door Loop	DL-2		AK
1	Door Position Switch	By Security.		OT
1	Power Supply	Provided by security		SU
1	Balance of hardware	Existing to remain		OT

**Set: 4.0**

Doors: B101G-1, B104-1, B104-2, B107G-1, B110-1, B111-1, D100A-1, D100B-1, D100C-1, D100D-1, D106-1, E117-1, E118-1, E129-1, E130-1, E155-1, E156-1, E234-1, E235-1, E251-1, E252-1

Description: Add Exit Device-8816- HO Closers

1	Rim Exit Sec CR x SPAR#NC-E11	19 LD 43 49 70 8816 ETL	US32D	SA
2	Interchangeable Core	I/CK-7	626	BE
2	Const. Core	7190224	Green	BE
1	Surface Closer	TB 351 PSH	EN	SA
1	Door Stop	481H	US26D	RO
1	Balance of hardware	Existing to remain		OT

Notes: Provide hold open closers at classrooms unless fire rated. No hold open on rated doors.

**Set: 4.1**

Doors: D100L-1, D100L-2

Description: Add Exit Device-8804- HO Closers

1	Rim Exit NL SPAR#NC-E11	LD 19 TB 43 70 8804 ETL	US32D	SA
2	Interchangeable Core	I/CK-7	626	BE
2	Const. Core	7190224	Green	BE
1	Surface Closer	TB 351 PSH	EN	SA
1	Door Stop	481H	US26D	RO
1	Balance of hardware	Existing to remain		OT

Notes: Provide hold open closers at classrooms unless fire rated. No hold open on rated doors.

**Set: 5.0**

Doors: A004-1, A004-2

Description: Add Exit Device-8816/8804

1	Rim Exit Sec CR x SPAR#NC-E11	LD 19 LD 43 49 70 8816 ETL	US32D	SA
1	Rim Exit NL SPAR#NC-E11	LD 19 43 70 8804 ETL	US32D	SA
3	Interchangeable Core	I/CK-7	626	BE
3	Const. Core	7190224	Green	BE
2	Door Stop	481H	US26D	RO
1	Balance of hardware	Existing to remain		OT

**Set: 6.0**

Doors: D105A-2

Description: Add Pr SN200 Narrow Exit x 8510 x Less Trim - Loop

1	Rim Exit SPAR NC-E11	LD 19 TB 43 8510 EO	US32D	SA
1	Rim Exit xSPAR04867/NC-E11	19 LD TB 43 70 56-SN200-8504 Less Trim	US32D	SA
1	Interchangeable Core	I/CK-7	626	BE
1	Const. Core	7190224	Green	BE
2	Door Stop	462	US2C	RO
1	ElectroLynx Harness	QC-C1500P		MK
2	ElectroLynx Harness	QC-C***P (length as req'd)		MK
1	Door Loop	DL-2		AK
1	Power Supply	Provided by security		SU
1	Balance of hardware	Existing to remain		OT

Notes: Doors are normally closed and secure. Presentation of valid credential will allow entry by pull. Upon loss of power, doors will remain secure. Free egress at all times. Reuse existing trim.

**Set: 7.0**

Doors: C101-3

Description: Add SN200 Narrow Exit 8504 x 8510, Loop

1	Rim Exit SPAR NC-E11	LD 19 TB 43 8510 EO	US32D	SA
1	Rim Exit xSPAR04867/NC-E11	19 LD TB 43 70 56-SN200-8504 Less Trim	US32D	SA
1	Interchangeable Core	I/CK-7	626	BE
1	Const. Core	7190224	Green	BE
2	Door Stop	462	US2C	RO
1	ElectroLynx Harness	QC-C1500P		MK
2	ElectroLynx Harness	QC-C***P (length as req'd)		MK
1	Door Loop	DL-2		AK
1	Power Supply	Provided by security		SU
1	Balance of hardware	Existing to remain		OT

Notes: Doors are normally closed and secure. Presentation of valid credential will allow entry by pull. Upon loss of power, doors will remain secure. Free egress at all times.

**Set: 7.1**

Doors: A109D-2

Description: Add SN200 Narrow Exit 8504 Loop

1	Rim Exit xSPAR04867/NC-E11	19 LD TB 43 70 56-SN200-8504 Less Trim	US32D	SA
1	Interchangeable Core	I/CK-7	626	BE
1	Const. Core	7190224	Green	BE
2	Door Stop	462	US2C	RO
1	ElectroLynx Harness	QC-C1500P		MK
2	ElectroLynx Harness	QC-C***P (length as req'd)		MK
1	Door Loop	DL-2		AK
1	Power Supply	Provided by security		SU
1	Balance of hardware	Existing to remain		OT

Notes: Doors are normally closed and secure. Presentation of valid credential will allow entry by pull. Upon loss of power, doors will remain secure. Free egress at all times.

**Set: 8.0**

Doors: D106-2

Description: Add SN200 Exit, Loop - Peep

1	Rim Exit x SPAR04867/NC-E11	19 LD TB 43 70 56-SN200-8804	US32D	SA
---	-----------------------------	------------------------------	-------	----



1	Interchangeable Core	I/CK-7	626	BE
1	Const. Core	7190224	Green	BE
1	Door Stop	462	US2C	RO
1	Gasketing	2891APK (head & jambs)		PE
1	ElectroLynx Harness	QC-C1500P		MK
2	ElectroLynx Harness	QC-C***P (length as req'd)		MK
1	Door Loop	DL-2		AK
1	Power Supply	Provided by security		SU
1	Balance of hardware	Existing to remain		OT
2	Viewer	622 x door thickness	DCRM	RO

Notes: Doors are normally closed and secure. Presentation of valid credential will allow entry by pull. Upon loss of power, doors will remain secure. Free egress at all times. Reuse existing Trim. Remove cylinder dogging on exiting rail with 68-1375 mounting rail insert

**Set: 9.0**

Doors: D107-2

Description: Add SN200 Lock, Loop

1	SN200 Mort Lock	70 SN200-82271 OL	US26D	SA
1	Interchangeable Core	I/CK-7	626	BE
1	Const. Core	7190224	Green	BE
1	Door Stop	462	US2C	RO
1	ElectroLynx Harness	QC-C1500P		MK
2	ElectroLynx Harness	QC-C***P (length as req'd)		MK
1	Door Loop	DL-2		AK
1	Power Supply	Provided by security		SU
1	Balance of hardware	Existing to remain		OT

Notes: Doors are normally closed and secure. Presentation of valid credential will allow entry by pull. Upon loss of power, doors will remain secure. Free egress at all times. Reuse existing Trim. Remove cylinder dogging on exiting rail with 68-1375 mounting rail insert

**Set: 10.0**

Doors: C100-1, E124A-3, E149A-1, E150A-1, E207A-1, E223-1, E226A-1, E246A-1, E256-1, F101-2

Description: Existing - Add 8204

1	Storeroom/Closet Lock	70 8204 LL	US26D	SA
1	Interchangeable Core	I/CK-7	626	BE
1	Const. Core	7190224	Green	BE
1	Door Stop	481H	US26D	RO
1	Balance of hardware	Existing to remain		OT

**Set: 10.1**

Doors: C108-2, C109-2

Description: Existing - Add 8204 - Surface bolt

1	Surface Bolt	580-12 @ top only	US26D	RO
1	Storeroom/Closet Lock	70 8204 LL	US26D	SA
1	Interchangeable Core	I/CK-7	626	BE
1	Const. Core	7190224	Green	BE
1	Door Stop	481H	US26D	RO
1	Balance of hardware	Existing to remain		OT

**Set: 11.0**

Description: Not Used

1	Set	Not Used		OT
---	-----	----------	--	----

**Set: 12.0**

Doors: E205-2

Description: Existing - Add 8204 - HO Closer - Classroom

1	Storeroom/Closet Lock	70 8204 LL	US26D	SA
1	Interchangeable Core	I/CK-7	626	BE
1	Const. Core	7190224	Green	BE
1	Door Closer w/ HO	TB 351 H (inswing)/ PSH (outswing) As Req	EN	SA
1	Door Stop	481H	US26D	RO
1	Balance of hardware	Existing to remain		OT

**Set: 13.0**

Doors: E112-1, E124-1, E140-1, E149-1, E150-1, E207-2, E226-2, E236-2, E245-2, E246-2

Description: Existing - Add 8204 - Rated Classroom

1	Storeroom/Closet Lock	70 8204 LL	US26D	SA
1	Interchangeable Core	I/CK-7	626	BE
1	Const. Core	7190224	Green	BE
1	Door Closer	TB 351 O/P9 (type as required)	EN	SA
1	Door Stop	481H	US26D	RO
1	Balance of hardware	Existing to remain		OT

**Set: 14.0**

Doors: B109-1, E112-2, E124-2, E140-2, E149-2, E150-2, E207-1, E226-1, E236-1, E245-1, E246-1

Description: Existing - Add 8238 - Rated Classroom

1	Classroom Security Intruder Lock	V01 EMB 70 8238 VN1L 90-3/8" Collar	US26D	SA
2	Interchangeable Core	I/CK-7	626	BE
2	Const. Core	7190224	Green	BE
1	Door Closer	TB 351 O/P9 (type as required)	EN	SA
1	Door Stop	481H	US26D	RO
1	Balance of hardware	Existing to remain		OT

**Set: 15.0**

Doors: A106-1, A107-1, A109-1, D101-1, D102-1, D107A-1, E101-1, E102-1, E105-1, E113-1, E115-1, E125-1, E127-1, E131-1, E133-1, E134-1, E136-1, E138-1, E139-1, E143-1, E145-1, E147-1, E148-1,

E151-1, E153-1, E202-1, E203-1, E204-1, E205-1, E206-1, E208-1, E210-1, E212-1, E213-1, E220-1, E222-1, E224-1, E225-1, E227-1, E229-1, E230-1, E232-1, E239-1, E241-1, E243-1, E244-1, E247-1, E249-1

Description: Existing - Add 8238 - HO Closer

1 Classroom Security Intruder Lock SA	V01 EMB 70 8238 VN1L 90-3/8" Collar		US26D	
2 Interchangeable Core	I/CK-7	626	BE	
2 Const. Core	7190224	Green	BE	
1 Door Closer w/ HO	TB 351 H (inswing)/ PSH (outswing) As Req		EN	SA
1 Door Stop	481H	US26D	RO	
1 Balance of hardware	Existing to remain		OT	

**Set: 15.1**

Doors: A102-1, B103-1

Description: Existing - Add 8238

1 Classroom Security Intruder Lock SA	V01 EMB 70 8238 VN1L 90-3/8" Collar		US26D	
2 Interchangeable Core	I/CK-7	626	BE	
2 Const. Core	7190224	Green	BE	
1 Door Stop	481H	US26D	RO	
1 Balance of hardware	Existing to remain		OT	

**Set: 16.0**

Description: Not Used

1 Set	Not Used		OT	
-------	----------	--	----	--

**Set: 17.0**

Doors: A100A-1, A100B-1, A100B-2, A100C-1, A100C-2, A100E-1, A100F-1, A100G-1, A100H-1, A100H-2, A100M-1, A101-1, A103-1, A104-1, A104-2, A104A-1, A104B-1, A104C-1, A104D-1, A105-1, A105A-1, A105B-1, A105C-1, A105D-1, C105E-1, E106-1, E107-1, E108-1, E110-1, E111-1

Description: Existing - Add 8205

1 Office/Entry Lock	70 8205 LL		US26D	SA
1 Interchangeable Core	I/CK-7	626	BE	
1 Const. Core	7190224	Green	BE	
1 Door Stop	481H	US26D	RO	
1 Balance of hardware	Existing to remain		OT	

**Set: 18.0**

Doors: E122-1, E123-1, E218-1, E219-1

Description: Existing - Add 8250 - HO Closer

1 Hotel Guest Lock Lock	V20 LC 8250 VN1L		US26D	SA
1 Interchangeable Core	I/CK-7	626	BE	
1 Const. Core	7190224	Green	BE	
1 Mortise Cylinder for Hotel Lock	1E-7G4 C208 RP3	626	BE	

1	Surface Closer	TB 351 H	EN	SA
1	Door Stop	481H	US26D	RO
1	Balance of hardware	Existing to remain		OT

**Set: 19.0**

Doors: A100K-1, E131A-1

Description: Existing - Add 8265

1	Privacy Lock	V20 8265 VN1L	US26D	SA
1	Door Stop	481H	US26D	RO
1	Balance of hardware	Existing to remain		OT

**Set: 20.0**

Doors: F100-2

Description: Existing Pr- Add HO Closer

2	Surface Closer	TB 351 PSB	EN	SA
2	Door Stop	481H	US26D	RO
1	Balance of hardware	Existing to remain		OT

**Set: 21.0**

Doors: A106-2, A107-2

Description: \*\*Sgl Ext - ASF - Exit -SN200 ETL- Closer - Access Control

1	Continuous Hinge	CFM SLF-HD1 PT x Dr. Ht.		PE
1	Electric Power Transfer	EL-CEPT	630	SU
1	Rim Exit xSPAR04867/NC-E11	19 LD TB 43 70 56-SN200-8504 ETL	US32D	SA
1	Interchangeable Core	I/CK-7	626	BE
1	Const. Core	7190224	Green	BE
1	Kit	581-1/ 581-2 as required	EN	SA
1	Surface Closer	TB 351 P10	EN	SA
1	Door Stop	462	US2C	RO
1	Sweep IDF/MDF/Alum	18061CNB x Dr. Width		PE
1	Threshold	2005AT MSES25SS X Opening Width		PE
1	Perimeter Seal	By door mfr		OT
1	ElectroLynx Harness	QC-C1500P		MK
2	ElectroLynx Harness	QC-C***P (length as req'd)		MK
1	Door Position Switch	By Security.		OT
1	Power Supply	Provided by security		SU

Notes: Operation: Doors normally closed and locked. Valid card at the card reader retracts the latch on the active leaf for entry. Free egress at all times. Door status monitored. Confirm specified hardware is compatible with aluminum door manufacturer.

**Set: 22.0**

Doors: B115B-1

Description: \*\*Pr Ext - ASF - Exit Device- SN200/DT - Mullion - Closer -Access Control

1	Continuous Hinge	CFM SLF-HD1 x Dr. Ht.		PE
1	Continuous Hinge	CFM SLF-HD1 PT x Dr. Ht.		PE
1	Electric Power Transfer	EL-CEPT	630	SU
1	Mullion	KR822 (FLK as req)	600	PR
2	Stabilizer	ST989	Dull Black	PR
1	Spacer	MCS822	689	PR
1	Rim Exit x SPAR#NC-E11	LD TB 19 43 8510 862	US32D	SA
1	Rim Exit xSPAR04867/NC-E11	19 LD TB 43 70 56-SN200-8504 862	US32D	SA
2	Interchangeable Core	I/CK-7	626	BE
1	Mullion Cylinder	70 34 x 1KB-3	US32D	SA
2	Const. Core	7190224	Green	BE
2	Kit	581-1/ 581-2 as required	EN	SA
2	Surface Closer	TB 351 P10	EN	SA
2	Door Stop	462	US2C	RO
2	Sweep IDF/MDF/Alum	18061CNB x Dr. Width		PE
1	Threshold	2005AT MSES25SS X Opening Width		PE
1	Perimeter Seal	By door mfgr		OT
1	ElectroLynx Harness	QC-C1500P		MK
2	ElectroLynx Harness	QC-C***P (length as req'd)		MK
2	Door Position Switch	By Security.		OT
1	Power Supply	Provided by security		SU

Notes: Operation: Doors normally closed and locked. Valid card at the card reader retracts the latch on the active leaf for entry. Free egress at all times. Door status monitored. Confirm specified hardware is compatible with aluminum door manufacturer.

**Set: 22.1**

Doors: A006-1

Description: \*\*Pr Ext - ASF - Exit Device- SN200/DT -KR Mullion - Closer -Access Control - Dog

1	Continuous Hinge	CFM SLF-HD1 x Dr. Ht.		PE
1	Continuous Hinge	CFM SLF-HD1 PT x Dr. Ht.		PE
1	Electric Power Transfer	EL-CEPT	630	SU
1	Mullion	KR822 (FLK as req)	600	PR
2	Stabilizer	ST989	Dull Black	PR
1	Spacer	MCS822	689	PR
1	Rim Exit xSPAR04867/NC-E11	19 LD TB 43 70 56-SN200-8504 862	US32D	SA
1	Rim Exit x SPAR#NC-E11	19 TB 43 8510 862	US32D	SA
2	Interchangeable Core	I/CK-7	626	BE
1	Rim Cylinder	70 34 X #90 - 1/2	US32D	SA
2	Const. Core	7190224	Green	BE
2	Kit	581-1/ 581-2 as required	EN	SA
2	Surface Closer	TB 351 P10	EN	SA
2	Door Stop	462	US2C	RO
2	Sweep IDF/MDF/Alum	18061CNB x Dr. Width		PE
1	Threshold	2005AT MSES25SS X Opening Width		PE
1	Perimeter Seal	By door mfgr		OT
1	ElectroLynx Harness	QC-C1500P		MK

2	ElectroLynx Harness	QC-C***P (length as req'd)	MK
2	Door Position Switch	By Security.	OT
1	Power Supply	Provided by security	SU

Notes: Operation: Doors normally closed and locked. Valid card at the card reader retracts the latch on the active leaf for entry. Free egress at all times. Door status monitored. Confirm specified hardware is compatible with aluminum door manufacturer.

**Set: 23.0**

Doors: A001-2

Description: \*\*Pr Ext - ASF - Exit Device- 2N/DT - KR Mullion - Closer -Access Control

1	Continuous Hinge	CFM SLF-HD1 x Dr. Ht.	PE
1	Continuous Hinge	CFM SLF-HD1 PT x Dr. Ht.	PE
1	Electric Power Transfer	EL-CEPT	630 SU
1	Mullion	KR822 (FLK as req)	600 PR
2	Stabilizer	ST989	Dull Black PR
1	Spacer	MCS822	689 PR
1	Rim Exit x SPAR#NC-E11	LD TB 19 43 8510 862	US32D SA
1	Rim Exit xSPAR04867/NC-E11	LD 19 TB 43 56 70 8504 862	US32D SA
2	Interchangeable Core	I/CK-7	626 BE
1	Rim Cylinder	70 34 X #90 - 1/2	US32D SA
2	Const. Core	7190224	Green BE
2	Kit	581-1/ 581-2 as required	EN SA
2	Surface Closer	TB 351 P10	EN SA
2	Door Stop	462	US2C RO
2	Sweep IDF/MDF/Alum	18061CNB x Dr. Width	PE
1	Threshold	2005AT MSES25SS X Opening Width	PE
1	Perimeter Seal	By door mfr	OT
1	ElectroLynx Harness	QC-C1500P	MK
1	ElectroLynx Harness	QC-C***P (length as req'd)	MK
2	Door Position Switch	By Security.	OT
1	Power Supply	Provided by security	SU
1	Reader	By Security contractor	OT

Notes: Operation: Doors normally closed and locked. Valid card at the card reader retracts the latch on the active leaf for entry. Free egress at all times. Door status monitored. Confirm specified hardware is compatible with aluminum door manufacturer.

Existing AI phone to remain.

At existing doors and frames, verify all existing conditions and modify hardware as required prior to purchase.

**Set: 24.0**

Doors: A001-1

Description: \*\*Pr Ext - ASF - Exit Device- NL x DT - Mullion - Closer

2	Continuous Hinge	CFM SLF-HD1 x Dr. Ht.		PE	
1	Mullion	KR822 (FLK as req)	600	PR	
2	Stabilizer	ST989	Dull Black		PR
1	Spacer	MCS822	689	PR	
1	Rim Exit x SPAR#NC-E11	LD TB 19 43 8510 862	US32D	SA	
1	Rim Exit xNC-E11	LD 19 TB 43 70 8504 862	US32D	SA	
2	Interchangeable Core	I/CK-7	626	BE	
1	Rim Cylinder	70 34 X #90 - 1/2	US32D	SA	
2	Const. Core	7190224	Green	BE	
2	Kit	581-1/ 581-2 as required	EN	SA	
2	Surface Closer	TB 351 P10	EN	SA	
2	Door Stop	462	US2C	RO	
2	Sweep IDF/MDF/Alum	18061CNB x Dr. Width		PE	
1	Threshold	2005AT MSES25SS X Opening Width		PE	
1	Perimeter Seal	By door mfgr		OT	
2	Door Position Switch	By Security.		OT	

Notes: At existing doors and frames, verify all existing conditions and modify hardware as required prior to purchase.

**Set: 24.1**

Doors: A006-2

Description: \*\*Pr Ext - ASF - Exit Device- NL x DT - Mullion - Closer - Dog

2	Continuous Hinge	CFM SLF-HD1 x Dr. Ht.		PE	
1	Mullion	KR822 (FLK as req)	600	PR	
2	Stabilizer	ST989	Dull Black		PR
1	Spacer	MCS822	689	PR	
1	Rim Exit x SPAR#NC-E11	19 TB 43 8510 862	US32D	SA	
1	Rim Exit xNC-E11	LD 19 TB 43 70 8504 862	US32D	SA	
2	Interchangeable Core	I/CK-7	626	BE	
1	Rim Cylinder	70 34 X #90 - 1/2	US32D	SA	
2	Const. Core	7190224	Green	BE	
2	Kit	581-1/ 581-2 as required	EN	SA	
2	Surface Closer	TB 351 P10	EN	SA	
2	Door Stop	462	US2C	RO	
2	Sweep IDF/MDF/Alum	18061CNB x Dr. Width		PE	
1	Threshold	2005AT MSES25SS X Opening Width		PE	
1	Perimeter Seal	By door mfgr		OT	
2	Door Position Switch	By Security.		OT	

Notes: At existing doors and frames, verify all existing conditions and modify hardware as required prior to purchase.

**Set: 25.0**

Doors: B107B-2

Description: \*\*Pr Ext - Lock- Closer

2	Continuous Hinge	CFM HD1 x Dr. Ht.		PE
1	Surface Bolt	580-12 @ top only	US26D	RO
1	Storeroom/Closet Lock	70 8204 LL	US26D	SA
1	Interchangeable Core	I/CK-7	626	BE
1	Const. Core	7190224	Green	BE
1	Surface Closer	TB 351 P10	EN	SA
2	Door Stop	462	US2C	RO
1	Astragal Set (2)	18061CNB x Dr. Ht		PE
1	Gasketing	2891APK (head & jambs)		PE
1	Rain Guard	346C x Frame Width		PE
2	Sweep	345ANB x Dr. Width		PE
1	Threshold	2005AT MSES25SS X Opening Width		PE
2	Door Position Switch	By Security.		OT

Notes: Closer on active leaf.

**Set: 26.0**

Doors: C105G-1

Description: \*\*Sgl - ExT -HM - EX FR Exit- 2N Lever- Closer/HO - Access Control - Viewer - Keedex

1	Continuous Hinge	CFM HD1 x Dr. Ht.		PE
1	Rim Exit 2N SPAR04867/NC-E11	LD 19 TB 43 56 70 8804 ETL	US32D	SA
1	Vandal Resistant Trim	826	US32D	SA
1	Interchangeable Core	I/CK-7	626	BE
1	Const. Core	7190224	Green	BE
1	Surface Closer	TB 351 PSH	EN	SA
1	Door Stop	462	US2C	RO
1	Gasketing	2891APK (head & jambs)		PE
1	Rain Guard	346C x Frame Width		PE
1	Sweep	345ANB x Dr. Width		PE
1	Sweep IDF/MDF/Alum	18061CNB x Dr. Width		PE
1	Threshold	2005AT MSES25SS X Opening Width		PE
1	ElectroLynx Harness	QC-C1500P		MK
1	ElectroLynx Harness	QC-C***P (length as req'd)		MK
1	Door Loop	DL-2		AK
1	Door Position Switch	By Security.		OT
1	Power Supply	Provided by security		SU
2	Viewer	622 x door thickness	DCRM	RO
1	Keedex Lock Protector	K12S - SGT		OT

Notes: Operation: Doors normally closed and locked. Valid card at the card reader retracts the latch on the active leaf for entry. Free egress at all times. Door status monitored. Confirm specified hardware is compatible with door manufacturer.

**Set: 26.1**

Doors: B111-2

Description: \*\*Sgl - ExT -HM - EX FR Exit- 2N xEx ES Lever- Closer - Access Control - Viewer



1	Continuous Hinge	CFM HD1 x Dr. Ht.		PE
1	Rim Exit SPAR NC-E11	LD 19 TB 43 70 8804 ETL	US32D	SA
1	Vandal Resistant Trim	826	US32D	SA
1	Interchangeable Core	I/CK-7	626	BE
1	Const. Core	7190224	Green	BE
1	Surface Closer	TB 351 P10	EN	SA
1	Door Stop	462	US2C	RO
1	Gasketing	2891APK (head & jambs)		PE
1	Rain Guard	346C x Frame Width		PE
1	Sweep	345ANB x Dr. Width		PE
1	Sweep IDF/MDF/Alum	18061CNB x Dr. Width		PE
1	Threshold	2005AT MSES25SS X Opening Width		PE
1	ElectroLynx Harness	QC-C1500P		MK
1	ElectroLynx Harness	QC-C***P (length as req'd)		MK
1	Door Loop	DL-2		AK
1	Door Position Switch	By Security.		OT
1	Power Supply	Provided by security		SU
2	Viewer	622 x door thickness	DCRM	RO

Notes: Operation: Doors normally closed and locked. Valid card at the card reader retracts the latch on the active leaf for entry. Free egress at all times. Door status monitored. Confirm specified hardware is compatible with door manufacturer.

Existing electric strike to remain- Add doorbell linked to 2N

**Set: 27.0**

Doors: A005-2, B101H-2

Description: \*\*Sgl - ExT -HM - Exit- SN200 - Closer - Access Control

1	Continuous Hinge	CFM HD1 PT x Dr. Ht.		PE
1	Electric Power Transfer	EL-CEPT	630	SU
1	Rim Exit x SPAR04867/NC-E11	19 LD TB 43 70 56-SN200-8804	US32D	SA
1	Vandal Resistant Trim	826	US32D	SA
1	Interchangeable Core	I/CK-7	626	BE
1	Const. Core	7190224	Green	BE
1	Surface Closer	TB 351 P10	EN	SA
1	Door Stop	462	US2C	RO
1	Gasketing	2891APK (head & jambs)		PE
1	Rain Guard	346C x Frame Width		PE
1	Sweep	345ANB x Dr. Width		PE
1	Threshold	2005AT MSES25SS X Opening Width		PE
1	ElectroLynx Harness	QC-C1500P		MK
2	ElectroLynx Harness	QC-C***P (length as req'd)		MK
1	Door Position Switch	By Security.		OT
1	Power Supply	Provided by security		SU
2	Viewer	622 x door thickness	DCRM	RO

Notes: Doors are normally closed and secure. Presentation of valid credential will allow entry by pull. Upon loss of power, doors will remain secure. Free egress at all times.

**Set: 28.0**

Doors: [B101B-2](#)

Description: \*\*Pr Ext - Storeroom/Mechanical - Closer

2	Continuous Hinge	CFM HD1 x Dr. Ht.		PE
1	Surface Bolt	580-12 @ top only	US26D	RO
1	Storeroom/Closet Lock	70 8204 LL	US26D	SA
1	Interchangeable Core	I/CK-7	626	BE
1	Const. Core	7190224	Green	BE
2	Surface Closer	TB 351 P10	EN	SA
2	Door Stop	462	US2C	RO
1	Astragal Set (2)	18061CNB x Dr. Ht		PE
1	Gasketing	2891APK (head & jambs)		PE
1	Rain Guard	346C x Frame Width		PE
2	Sweep	345ANB x Dr. Width		PE
1	Threshold	2005AT MSES25SS X Opening Width		PE
2	Door Position Switch	By Security.		OT

Notes: Closer on active leaf.

**Set: 29.0**

Doors: [S1000-1](#)

Description: \*\*Sgl - Ext- Mech/Storage/Fire Riser - Closer

1	Continuous Hinge	CFM HD1 x Dr. Ht.		PE
1	Storeroom/Closet Lock	70 8204 LL	US26D	SA
1	Interchangeable Core	I/CK-7	626	BE
1	Const. Core	7190224	Green	BE
1	Surface Closer	TB 351 P10	EN	SA
1	Door Stop	462	US2C	RO
1	Gasketing	2891APK (head & jambs)		PE
1	Rain Guard	346C x Frame Width		PE
1	Sweep	345ANB x Dr. Width		PE
1	Threshold	2005AT MSES25SS X Opening Width		PE
1	Door Position Switch	By Security.		OT

**Set: 30.0**

Doors: A002-1

Description: \*\*Pr Int- ASF - Vest SN200 Exit Device- NL/DT - Mullion - Closer /HO - Access Control

1	Continuous Hinge	CFM SLF-HD1 x Dr. Ht.		PE
1	Continuous Hinge	CFM SLF-HD1 PT x Dr. Ht.		PE
1	Mullion	KR822 (FLK as req)	600	PR
2	Stabilizer	ST989	Dull Black	PR
1	Spacer	MCS822	689	PR

1	Rim Exit x SPAR04867/NC-E11	19 LD TB 43 70 56-SN200-8804 ETL	US32D	SA
1	Rim Exit - DT x SPAR#NC-E11	19 LD TB 43 8810 ETL	US32D	SA
2	Interchangeable Core	I/CK-7	626	BE
1	Rim Cylinder	70 34 X #90 - 1/2	US32D	SA
2	Const. Core	7190224	Green	BE
2	Kit	581-1/ 581-2 as required	EN	SA
2	Surface Closer	TB 351 PSH	EN	SA
1	Perimeter Seal	By door mfr		OT
1	ElectroLynx Harness	QC-C1500P		MK
2	ElectroLynx Harness	QC-C***P (length as req'd)		MK
2	Door Position Switch	By Security.		OT
1	Power Supply	Provided by security		SU

Notes: Operation: Doors normally closed and locked. Valid card at the card reader retracts the latch on the active leaf for entry. Free egress at all times. Door status monitored. Confirm specified hardware is compatible with aluminum door manufacturer.

**Set: 31.0**

Doors: A002-2

Description: \*\*Pr Int- ASF - Vest Exit Device- NL/DT- Mullion - Closer /HO

2	Continuous Hinge	CFM SLF-HD1 x Dr. Ht.		PE
1	Mullion	KR822 (FLK as req)	600	PR
2	Stabilizer	ST989	Dull Black	PR
1	Spacer	MCS822	689	PR
1	Rim Exit SPAR NC-E11	LD 19 TB 43 70 8804 ETL	US32D	SA
1	Rim Exit - DT x SPAR#NC-E11	19 LD TB 43 8810 ETL	US32D	SA
2	Interchangeable Core	I/CK-7	626	BE
1	Rim Cylinder	70 34 X #90 - 1/2	US32D	SA
2	Const. Core	7190224	Green	BE
2	Kit	581-1/ 581-2 as required	EN	SA
2	Surface Closer	TB 351 PSH	EN	SA
2	Door Stop	481H	US26D	RO
1	Perimeter Seal	By door mfr		OT

**Set: 31.1**

Doors: A005-1

Description: \*\*Pr Int- ASF - Vest Exit Device- 8813x8813- Mullion - Closer /HO

2	Continuous Hinge	CFM SLF-HD1 x Dr. Ht.		PE
1	Mullion	KR822 (FLK as req)	600	PR
2	Stabilizer	ST989	Dull Black	PR
1	Spacer	MCS822	689	PR
2	Rim Exit x SPAR#NC-E11	LD 19 TB 43 70 8813 ETL	US32D	SA
3	Interchangeable Core	I/CK-7	626	BE
1	Rim Cylinder	70 34 X #90 - 1/2	US32D	SA
3	Const. Core	7190224	Green	BE
2	Kit	581-1/ 581-2 as required	EN	SA

2	Surface Closer	TB 351 PSH	EN	SA
2	Door Stop	481H	US26D	RO
1	Perimeter Seal	By door mfg		OT

**Set: 32.0**

Doors: D103-2, D104-2

Description: \*\*Sgl - Exit Device-Security CL - Closer - STC

3	Hinges	By the STC door manufacturer		OT
1	Rim Exit Sec CR x SPAR#NC-E11	19 LD 43 49 70 8816 ETL	US32D	SA
2	Interchangeable Core	I/CK-7	626	BE
2	Const. Core	7190224	Green	BE
1	Door Closer	TB 351 O/P9 (type as required)	EN	SA
1	Door Stop	462	US2C	RO
1	Gasket, threshold, door bottom	By the STC door manufacturer		OT

Notes: Door hardware is specified for design intent. Confirm hardware compatibility and design meets the door manufacturer's approved assembly testing for the STC level indicated.  
Add 31- to panic devices if doors are over 1 3/4" thick.

**Set: 33.0**

Doors: D103-1, D104-1

Description: \*\*Sgl - Exit Device-NL - Closer - STC - Classroom

3	Hinges	By the STC door manufacturer		OT
1	Rim Exit SPAR NC-E11	LD 19 TB 43 70 8804 ETL	US32D	SA
1	Interchangeable Core	I/CK-7	626	BE
1	Const. Core	7190224	Green	BE
1	Door Closer	TB 351 O/P9 (type as required)	EN	SA
1	Door Stop	462	US2C	RO
1	Gasket, threshold, door bottom	By the STC door manufacturer		OT

Notes: Door hardware is specified for design intent. Confirm hardware compatibility and design meets the door manufacturer's approved assembly testing for the STC level indicated.  
Add 31- to panic devices if doors are over 1 3/4" thick.

**Set: 34.0**

Doors: F100-1

Description: Sgl - ASF Exit Device-Security CL - Closer / HO

1	Continuous Hinge	CFM SLF-HD1 x Dr. Ht.		PE
1	Rim Exit Sec CR x SPAR#NC-E11	19 LD 43 49 70 8816 ETL	US32D	SA
2	Interchangeable Core	I/CK-7	626	BE
2	Const. Core	7190224	Green	BE
1	Kit	581-1/ 581-2 as required	EN	SA
1	Surface Closer	TB 351 PSH	EN	SA
1	Door Stop	481H	US26D	RO

1 Perimeter Seal By door mfgr OT

**Set: 35.0**

Doors: D105A-1

Description: \*\*Pr - Int Classroom Sec CL x NL -Closer - STC

2	Continuous Hinge	CFM HD1 x Dr. Ht.		PE
1	Mullion	KR822 (FLK as req)	600	PR
2	Stabilizer	ST989	Dull Black	PR
1	Spacer	MCS822	689	PR
2	Rim Exit x SPAR#NC-E11	LD 19 TB 43 70 8813 ETL	US32D	SA
3	Interchangeable Core	I/CK-7	626	BE
1	Mullion Cylinder	70 34 x 1KB-3	US32D	SA
3	Const. Core	7190224	Green	BE
2	Door Closer	TB 351 O/P9 (type as required)	EN	SA
2	Door Stop	481H	US26D	RO
1	Gasketing	2891APK (head & jambs)		PE

**Set: 36.0**

Doors: A100-1, A100-2, A100-3

Description: \*\*Sgl- Int ASF- SN200 Lock- Closer - Access Control

1	Continuous Hinge	CFM SLF-HD1 PT x Dr. Ht.		PE
1	Electric Power Transfer	EL-CEPT	630	SU
1	SN200 Mort Lock	70 SN200-82271 OL	US26D	SA
1	Interchangeable Core	I/CK-7	626	BE
1	Const. Core	7190224	Green	BE
1	Door Closer	TB 351 O/P9 (type as required)	EN	SA
1	Door Stop	481H	US26D	RO
1	ElectroLynx Harness	QC-C1500P		MK
1	ElectroLynx Harness	QC-C***P (length as req'd)		MK
1	Door Position Switch	By Security.		OT
1	Power Supply	Provided by security		SU
1	Gasketing	By the frame manufacturer		OT

Notes: Operation: Door normally closed and secure. Valid card at the card reader will allow entry by trim. Free egress at all times. Door status is monitored. Install reader and cylinder on reception side.

**Set: 37.0**

Doors: D103C-1, D104E-1

Description: \*\*Sgl - Storeroom

3	Hinge, Full Mortise	TA2714	US26D	MK
1	Storeroom/Closet Lock	70 8204 LL	US26D	SA
1	Interchangeable Core	I/CK-7	626	BE
1	Const. Core	7190224	Green	BE
1	Door Stop	481H	US26D	RO

3 Silencer 608 RO

**Set: 38.0**

Doors: D104D-1

Description: \*\*Sgl - Storeroom - Wide

3 Hinge (heavy weight)	T4A3786	US26D	MK
1 Storeroom/Closet Lock	70 8204 LL	US26D	SA
1 Interchangeable Core	I/CK-7	626	BE
1 Const. Core	7190224	Green	BE
1 Door Stop	481H	US26D	RO
3 Silencer	608		RO

**Set: 39.0**

Doors: D108-1

Description: \*\*Sgl - Storeroom - Closer - Gasket

3 Hinge, Full Mortise	TA2714	US26D	MK
1 Storeroom/Closet Lock	70 8204 LL	US26D	SA
1 Interchangeable Core	I/CK-7	626	BE
1 Const. Core	7190224	Green	BE
1 Door Closer	TB 351 O/P9 (type as required)	EN	SA
1 Door Stop	481H	US26D	RO
1 Gasketing	2891APK (head & jambs)		PE

**Set: 40.0**

Doors: D103B-1, D104A-1

Description: \*\*Sgl - 8237

3 Hinge, Full Mortise	TA2714	US26D	MK
1 Classroom Lock	70 8237 LL	US26D	SA
1 Interchangeable Core	I/CK-7	626	BE
1 Const. Core	7190224	Green	BE
1 Door Stop	481H	US26D	RO
1 Silencer	608		RO

**Set: 41.0**

Doors: D104C-1

Description: \*\*Sgl - 8204 - Practice STC

3 Hinges	By the STC door manufacturer		OT
1 Storeroom/Closet Lock	70 8204 LL	US26D	SA
1 Interchangeable Core	I/CK-7	626	BE
1 Const. Core	7190224	Green	BE
1 Door Stop	462	US2C	RO
1 Gasket, threshold, door bottom	By the STC door manufacturer		OT

Notes: Door hardware is specified for design intent. Confirm hardware compatibility and design meets the door manufacturer's approved assembly testing for the STC level indicated.

Add 31- to panic devices if doors are over 1 3/4" thick.

**Set: 42.0**

Doors: [D103A-1](#)

Description: \*\*Sgl - 8204 - Practice STC - Rated

3 Hinges	By the STC door manufacturer		OT
1 Storeroom/Closet Lock	<a href="#">70 8204 LL</a>	US26D	SA
1 Interchangeable Core	I/CK-7	626	BE
1 Const. Core	7190224	Green	BE
1 Door Closer	<a href="#">TB 351 O/P9 (type as required)</a>	EN	SA
1 Door Stop	<a href="#">462</a>	US2C	RO
1 Gasket, threshold, door bottom	By the STC door manufacturer		OT

Notes: Door hardware is specified for design intent. Confirm hardware compatibility and design meets the door manufacturer's approved assembly testing for the STC level indicated.

Add 31- to panic devices if doors are over 1 3/4" thick.

**Set: 42.1**

Doors: [D104B-1](#)

Description: \*\*Sgl - 8237- Practice STC - Rated

3 Hinges	By the STC door manufacturer		OT
1 Classroom Lock	<a href="#">70 8237 LL</a>	US26D	SA
1 Interchangeable Core	I/CK-7	626	BE
1 Const. Core	7190224	Green	BE
1 Door Closer	<a href="#">TB 351 O/P9 (type as required)</a>	EN	SA
1 Door Stop	<a href="#">462</a>	US2C	RO
1 Gasket, threshold, door bottom	By the STC door manufacturer		OT

Notes: Door hardware is specified for design intent. Confirm hardware compatibility and design meets the door manufacturer's approved assembly testing for the STC level indicated.

Add 31- to panic devices if doors are over 1 3/4" thick.

**Set: 43.0**

Description: Not Used

1 Set	Not Used		OT
-------	----------	--	----

**Set: 44.0**

Doors: A004-3, B100-1, B100A-2, B100A-3, B111-3, C102-2, C104-1, C104-2, C104-3, C105-2, C105-3, C109-3, E161-2, S103-2, S103-3, S105-3

Description: \*\*OH Coiling Doors - No Work

1 All hardware	Existing to remain		OT
----------------	--------------------	--	----

**Set: 45.0**

Doors: [S1000-2](#)

Description: \*\*OH Coiling Doors - Manual

1 All hardware By the door manufacturer OT

Notes: Verify cylinder type required.

**Set: 46.0**

Doors: A006-3, A006-4, A100D-1, A100HA-1, A100J-1, A100L-1, A102A-1, A102B-1, A102C-1, A106A-1, A106A-2, A106B-1, A106B-2, A106C-1, A106C-2, A108-1, A109A-1, A109B-1, A109C-1, A109C-2, A109D-1, A109E-1, A110-1, A112-1, B100A-1, B100B-1, B100B-2, B100C-1, B100C-2, B101A-1, B101A-2, B101AA-1, B101AB-1, B101B-1, B101C-1, B101G-3, B101H-1, B102-1, B102A-1, B104A-1, B105-1, B105-2, B106-1, B107A-1, B107A-2, B107AA-1, B107AB-1, B107B-1, B107D-1, B107G-2, B107G-3, B107H-2, B108-1, B108B-1, B109A-1, B109B-1, B110-2, B110-3, B110A-1, B110B-1, B110B-2, B110C-1, B110D-1, B112-1, B112A-1, B113-1, B114-1, B115-1, B115-2, B115A-1, B118-1, B118-2, B118A-1, B118B-1, B118B-2, C102-1, C103-1, C105-1, C105A-1, C105B-1, C105BA-1, C105BB-1, C105C-1, C105D-1, C106-1, C107-1, C107-2, C108-1, C109-1, C112-1, C113-1, D100E-1, D101A-1, D101A-2, D101B-1, D102A-1, D105-1, D106A-1, D106B-1, D106C-1, D106D-1, D106E-1, D106F-1, D106G-1, D107-1, E100-1, E100B-2, E100G-2, E100J-1, E100K-1, E101A-1, E109-1, E111A-1, E111B-1, E111C-1, E112-3, E114-1, E114-2, E114A-1, E116-1, E120-1, E124A-1, E124A-2, E126-1, E126-2, E126A-1, E128-1, E131A-2, E132-1, E133A-1, E133B-1, E135-1, E135-2, E135A-1, E137-1, E141-1, E142-1, E144-1, E144-2, E144A-1, E146-1, E149-3, E150-3, E152-1, E152-2, E152A-1, E154-1, E158-1, E160-1, E161-1, E200-1, E200B-2, E200D-1, E207A-2, E207A-3, E209-1, E209-2, E209A-1, E211-1, E216-1, E221-1, E221-2, E221A-1, E226A-2, E226A-3, E228-1, E229-2, E229A-1, E231-1, E231-2, E231A-1, E233-1, E237-1, E238-1, E240-1, E240-2, E240A-1, E242-1, E246A-2, E248-1, E248-2, E248A-1, E250-1, E254-1, F100A-1, F100B-1, F100B-2, F101-1, F101A-1, F101B-1, S101-1, S102-1, [S103-1](#), [S104-1](#), [S105-1](#), [S105-2](#), S-201-1, S-201-2

Description: No Work

1 All hardware Existing to remain OT

**Set: 47.0**

Doors: Attic

Description: \*\*Attic Stock - EVERY CAMPUS

5 Classroom Security Intruder Lock Body SA		8238	US26D
10 130KB	Thumbturn Kit	26D	SA
50 Interchangeable Core	I/CK-7	626	BE
50 Key Blanks	Best "A" Keyway		BE
12 Regular Hold Open Arm	25-H	EN	SA
12 Parallel Hold Open Arm	25-PSH	EN	SA
4 Electromagnetic Holder	<a href="#">994M 24VAC</a>	689	RF
5 994M Magnetic Parts	Door Armature 994510M	689	RF
5 994M Magnetic Parts	Screw & Backplate 998300	689	RF
5 994M Magnetic Parts	Swivel Armature 900-3	689	RF
5 994M Magnetic Parts	Magnet Assembly 998369-3V	689	RF
5 994M Magnetic Parts	Wall Cover 998315M	689	RF



5 SN200 Reader

52 6027 (exit / lock)

26D

SA

Notes: All attic stock ships direct to  
Director of Technical Services  
Cy Fair ISD Lockshop  
11430 Perry Road  
Houston, Texas 77064  
All attic stock to ship directly to Cy Fair from the distributor.  
DO NOT ship to jobsite.

END OF SECTION 087100

END OF SECTION 087100

**SECTION 28 31 00**  
**INTRUSION DETECTION SYSTEM (IDS)**


**PART 1 - GENERAL**

**1.1 RELATED WORK**

- A. The following sections shall associate with this specification as applicable.
  - 1. General Conditions
  - 2. Supplementary Conditions
  - 3. Division 1
  - 4. Division 26 in its entirety.
  - 5. Division 27 in its entirety.
  - 6. Division 28 in its entirety.

**1.2 WORK INCLUDED**

- A. The Contractor shall expand existing microprocessor based Intrusion Detection System (IDS) as specified herein. The IDS shall include, but not be limited to, all control equipment, power supplies, power circuits, signal initiating and signaling devices, conduit, wire, fittings, and all other accessories required to provide a complete and operable system.
- B. IDS devices indicated are for reference and coordination purposes only. The installing contractor shall design and provide a complete system, meeting the requirement of specification. The Contractor shall provide all security system devices required for complete system perimeter coverage acceptable to all governing authorities, Architect and Owner.
- C. The IDS shall include intrusion detection coverage as shown on the system floor plans. Whether shown on the floor plans or not, complete coverage of the following areas shall be included:
  - 1. All access points into the building(s), including but not limited to:
    - a. Doors
    - b. roof hatches
    - c. windows
  - 2. Interior space motion detection at the following locations:
    - a. All level 1 spaces with window and/or doors
    - b. All entrances on any level
- D. The IDS shall be the product of a single manufacturer and consist of, but not be limited to the following:
  - 1. Control Panels
  - 2. Field Devices
  - 3. Enclosures
  - 4. Locks and Keys
  - 6. Power Supplies
  - 7. Accessories required to provide a complete IDS
  - 8. System O and I Manuals
  - 9. System Programming
  - 10. Batteries
  - 11. Wiring
- E. The IDS installer shall be responsible for, but not limited to:
  - 1. Tagging of all conductors and cables at each end.
  - 2. Provision and installation of IDS control panels.
  - 3. Provision and installation of IDS devices.
  - 4. Full coverage of all windows, doors, roof hatches.
  - 6. Preconstruction meeting with Owner's personnel, installing technician and project

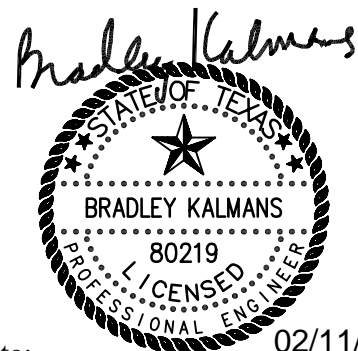

- superintendent.
- F. The contractor shall connect this location to the Owner's monitoring station as designated by the owner.
  - G. The Contractor shall be responsible for identifying requirements for permits, from the local the Local Authority Having Jurisdiction (AHJ), for the installation of the alarm system specified herein and shall assist the Owner in obtaining the relevant alarm permits.
  - H. All conduits and back boxes shall be provided and installed by the project's electrical contractor. In the event that there is no electrical contractor on the project, responsibility will be that of the IDS installer.
  - I. The documents issued for this project are conceptual in nature, including but not limited to specifications and drawings. It shall be the responsibility of the approved installer to furnish a complete and functional system, including the items shown on the drawings, in the specifications, and items not designated in either. The installer's shop drawings and product data submittals shall represent a complete system, and documents accepted do not relieve the installer from being required to provide any materials, equipment, or labor to furnish a complete and functional system as recognized by the Project's Technology Consultant and the Owner.
  - J. Contractor shall integrate all Emergency Eyewash systems into the IDS. Provide cabling connecting both systems. Coordinate with Emergency Eyewash systems contractor.
  - K. Contractor shall connect the Intrusion Detection System to the electrical automatic transfer switch in order to notify the District Police Department when the building is on emergency power. Provide same, connected to existing transfer switch at the existing Commons building, servicing the existing High School buildings. Provide all required cabling and devices for fully functional systems.
  - L. Scope of work includes expanding existing system.

### 1.3 CODES AND STANDARDS

- A. The system shall comply with the applicable Codes and Standards as follows:
  - 1. National Electric Code, Article 760.
  - 2. National Fire Alarm Code (NFPA 72).
  - 3. Life Safety Code (NFPA 101)
- B. Administrative Council for Terminal Attachments (ACTA):
  - 1. ANSI/TIA-968-A-2002 Technical Requirements for Connection of Terminal Equipment to the Telephone Network.
- C. American National Standards Institute (ANSI):
  - 1. ANSI C63.4 Methods of Measurement of Radio-Noise Emissions from Low-Voltage Electrical and Electronic Equipment in the Range of 9 kHz to 40 GHz.
- D. California State Fire Marshal (CSFM):
  - 1. Title 19, California Code of Regulations, Building Material Listing Program (BML).
- E. Federal Communications Commission (FCC):
  - 1. Title 47 C.F.R. Part 15; Class B – Radiated and Conducted Emissions.
  - 2. Title 47 C.F.R. Part 68; rules governing the connection of Terminal Equipment (TE) to the Public Switched Telephone Network (PSTN).
- F. The National Institute of Standards and Technology of the United States of America (NIST):
  - 1. Federal Information Processing Standards Publications 197 (FIPS 197) –Advanced Encryption Standard (AES).

- G. International Organization for Standardization (ISO):
  - 1. 9001 - Quality System.
- H. Underwriters Laboratories, Inc. (UL):
  - 1. UL 50 - Enclosures for Electrical Equipment.
  - 2. UL 294 – Access Control System Units.
  - 3. UL 365 - Police Station Connected Burglar Alarm Units and Systems.
  - 4. UL 609 - Local Burglar Alarm Units and Systems.
  - 5. UL 864 - Control Units System for Fire-Protective Signaling System.
  - 6. UL 985 - Household Fire Warning System Units.
  - 7. UL 1023 - Household Burglar Alarm System Units.
  - 8. UL 1076 – Proprietary Burglar Alarm Units and Systems
  - 9. UL 1610 - Central Station Burglar-Alarm Units.
  - 10. UL 60950-1 - Information Technology Equipment - Safety.
  - 11. UL 636 – Hold up alarms
- I. Local & State Building Codes
- J. Requirements of Local Authorities having Jurisdiction
- K. Requirements of American Disabilities Act (Public law 101-336).
- L. Texas Accessibility Standards (TAS)
- M. State Fire Marshall.
- N. State Insurance Code.

#### 1.4 QUALITY ASSURANCE

- A. Contractor Qualifications:
  - 1. The installing contractor shall be the authorized representative of the IDS authorized/certified to sell, install, and service the proposed manufacturer's equipment. The installing contractor shall have represented the IDS manufacturer's product for at least five (5) years.
  - 2. The installing contractor shall be certified to install and setup the IDS software with Security Engine and Access Engine Modules attached.
  - 3. The installing contractor shall be licensed by the State of Texas as a security services contractor to design, sell, install, and service security alarm systems and access control system.
  - 4. The installing contractor shall provide 24-hour, 365 day per year emergency service with factory trained service technicians.
  - 5. The installing contractor shall have personnel on their staff that has been actively engaged in the business of designing, selling, installing, and servicing security alarm systems for at least ten (10) years.
  - 6. The System Installer must submit to the owner prior to starting any work the factory training certificates for all personnel that will be working on the specified IDS. No person is allowed to work on the IDS without proper manufacturer's certification.

#### 1.5 SUBMITTALS AND CLOSE-OUT

- A. Product Data: Within fourteen (14) days of Notice to Proceed, the system installer shall furnish the following in a single consolidated submittal:
  - 1. Permits: The Contractor shall obtain all required permits and provide copies to the Owner / Architect / Engineer.
  - 2. Product Literature: Complete manufacturer's product literature for all system equipment, power supplies, cable, termination components, cable supports, cable labels, field devices, and other products to be used in the installation. In addition, whenever substitutions for recommended products are made, samples (when

- requested by the Owner/Designer) and the manufacturer's supporting documentation, demonstrating compatibility with other related products shall be included. The submittal shall have some type of distinguishing marker or pointer to indicated what specific product is to be submitted.
3. Construction Schedule: A time-scaled Construction Schedule indicating general project deadlines and specific dates relating to the installation of the cable distribution system.
  4. Specification Compliance: A letter shall be provided stating, by section and subsection, that the system installer complies with the ENTIRE specification section. If the installer intends to deviate from any portion of the specifications, a detailed explanation of reason in which the installer would like to deviate shall be provided in addition to the specification compliance letter. No deviations shall be acceptable until they have been accepted by the project's technology consultant.
  5. Certifications: The System Installer shall submit all of the following certifications and the certifications must contain dates which are valid from the date of proposal and not expirer any sooner than 12 months after substantial completion of the project.
    - a. Manufacturer's Authorized Dealer/Installer Certification: This certification must be held by the proposing/installing contractor and state that the proposing/installing contractor is and authorized dealer/installer of the system specified within the project specifications. The certification must have been obtained by the office that is within a 75-mile radius of the project's location.
    - b. Installer Certification: This certification must be held by at least 25% of the, on-site, staff and be made available at the site if requested by the owner, architect, and/or project's technology consultant.
    - c. Licenses: This includes all licenses required by the state in which the work is being performed, the federal government, local authorities having jurisdiction, and any organization in that governs the specific system
- B. Shop Drawings: Submit the following items, for Owner review and approval, within twenty-eight (28) days of notice to proceed:
1. Proposed circuit routing and circuit grouping plan prepared by a system registered designer. The designer's certification must be current. Identifiable, separate routing shall be shown for both the station cabling and any backbone trunk cabling.
  2. In addition to the cable routing, the submitted drawings shall indicate the following, even if the following is expected to be provided by the project's electrical or general contractor:
    - a. Location of all control equipment and remote power sources
    - b. Locations of all field devices and outlets
    - c. Location of wall penetrations (all penetrations shall be sleeved and contain protective bushings at both ends)
    - d. Location of sleeved wall and/or floor pass-thru
    - e. Size of sleeve at each location installed
    - f. Quantity of cable passing through each sleeve
    - g. Conduit routing, size, quantity, and stub-up locations for any floor mounted outlets or outlets installed in casework.
  3. Drawing Compliance: A letter shall be provided stating that the system installer complies with the entire project drawing, including all general, keyed, and notes to contractor. If the installer intends to deviate from any portion of the

specifications, a detailed explanation of reason in which the installer would like to deviate shall be provided in addition to the specification compliance letter. No deviations shall be acceptable until they have been approved by the project's technology consultant.

- C. Close-out Procedures: For review and acceptance, furnish an electronic copy of the following documents to the Architect / Engineer. Upon acceptance of the submitted close-out documents, provide four (4) copies on an electronic storage media (CD or USD Flash Drive) Labeled with the project name, date of submission, and the name of the submitting firm. Final copies shall be delivered directly to the project's Technology Consultant. The closeout submittals shall include the following and be packaged in a storable container with the physical storage media and any physical items listed:
1. Inspection and Test Reports: During the course of the Project, the System Installer shall maintain an adequate inspection system to ensure that the materials supplied, and the work performed, conform to contract requirements. The System Installer shall provide written documentation that indicates that materials acceptance testing was conducted as specified. The System Installer shall also provide documentation, which indicates that all cable termination testing was completed and that all irregularities were corrected prior to job completion.
  2. Provide complete test reports for all cabling and devices that comprise system as outlined in this document.
  3. Include the Name, address and telephone of the authorized factory representative with a 24-hour emergency service number.
  4. The manual shall also include Manufacturer's data sheets and installation manuals/instructions for all equipment installed and a list of recommended spare parts.
  5. Generic or typical owner's instruction and operation manual shall not be acceptable to fulfill this requirement.
  6. An up-to-date record ("as-built") set of approved shop drawing prints that have been revised to show each and every change made to the system from the original approved shop drawings.
  7. As-built Drawings shall include cable pathways; device locations with correct labeling, control equipment locations, remote power supply locations, cross connect locations, and lightning protection locations. The as-built drawings shall be prepared using AutoCAD 2014 or later.
  8. All drawings must reflect point to point wiring, device address and programmed characteristics as verified in the presence of the engineer and/or the end user unless device addressing is electronically generated, and automatically graphically self-documented by the system.
  9. A copy of the manufacturer's warranty on the installed system.
  10. Any keys to cabinets and/or equipment and special maintenance tools required to repair, maintain, or service the system.
  11. Operating and Maintenance Instructions for all devices within the system. These instructions shall reflect any changes made during the course of construction, and shall be provided to the Owner, for their use, in a three-ring binder labeled with the project name and description. (4 copies)
  12. Upon completion of the work and at a time designated by the Architect or owner, provide formal training sessions for the Owner's operating personnel to include location, operation, and maintenance of all included systems and equipment. Provide a video copy of the training session as well as all sign in and training sign off sheets
  13. One (1) 30" x 42" laminated floor plan sheets illustrating device locations,

system wiring configuration, and cable designation. The System Installer shall provide one complete floor plan sheet at each panel location

## **PART 2 - PRODUCTS**

### **2.1 ACCEPTABLE MANUFACTURERS AND INSTALLERS**

- A. Acceptable Manufacturer: Bosch Security Systems, Inc.; 130 Perinton Parkway; Fairport, NY 14450. ASD. Toll Free Tel: 800-289-0096. Tel: 585-223-4060. Email: request info (presales.support@us.bosch.com). Web: www.boschsecurity.us.
- B. Substitutions: Not permitted.
- C. Requests for substitutions will be considered in accordance with provisions of Division 1

### **2.2 CONTROL COMMUNICATOR (Panel)**

- A. The IDS control panel shall be Bosch Security Systems, Inc., model # B9512G comprising a fully integrated intrusion, fire, and access control system. The control panel shall support the following:
  - 1. The IDS system is capable of being utilized as a combination Intrusion and Fire system per code. Fully integrated intrusion, access and fire functions allow users to interface with 1 system instead of 3
  - 2. Telephone Line Module Interface with programmable options for signaling and supervision.
  - 3. Conettix IP based communication option provides high-speed, secure alarm transport and control.
  - 4. 32 programmable areas with perimeter and interior partitioning.
  - 5. 8 on-board, class B hardwired points with expansion capability for a total of at minimum 500 wired or wireless points.
  - 6. Compatibility with touch-screen color LCD, vacuum fluorescent, ATM style LCD or LED style Alarm Command Centers.
  - 7. Local or remote programming, test, and diagnostic capability via a computer running the Remote Programming Software (RPS).
  - 8. The system shall support the use of an Apple iOS device for control. Functions to include arming, disarming, control of outputs, lock, unlock, cycle and secure access doors.
  - 9. Integrated real time clock, calendar, test timer and programmable scheduling capability for relay control and automatic execution of system functions based on a time / event.
  - 10. Provide 1.4 amps of power for standby operation and 2 amps of alarm power, both rated at 12 VDC.
  - 11. 2 wet-contact relay outputs and 1 Auxiliary wet-contact relay output with expansion capability for up to an additional 128 dry-contact relay outputs.
  - 12. Integrated battery charger with reverse hook up protection, battery supervision and battery deep discharge protection.
  - 13. Supervision of peripheral devices and communications interface(s).
- B. All small installations such as press boxes or tractor sheds shall use Bosch Model #5512 main control panel.
- C. Programmable features shall include:
  - 1. Independently control zones through an independent zone control keypad.
  - 2. Automatic test reports.
  - 3. Selective zone shunting.
  - 4. Custom text on the associated command centers.
- D. Zone Expansion - Expanded to 500 (8 on-board, 492 off-board) individually annunciated

- points of protection through the addition of a two-wire multiplex zone expansion system (ZONEX). Points of protection are annunciated with custom text at the B915 Command Center and they can be reported to a Radionics D6600Receiver.
- E. User Pass Codes – nine hundred ninety-nine (999) user pass codes shall be available to identify the user when arming/disarming the system.
  - F. Protective Circuits shall consist of zones designed for fire and/or panic (holdup, duress, or emergency) and/or burglary and/or supervisory. Each zone represents a protective circuit and shall accommodate normally opened and closed devices with end-of-line resistor supervision. Each of the 500 points are programmable as to whether they are controlled versus 24 hours; interior versus perimeter; instant versus delayed; silent versus audible (and if audible, pulsed or steady); and local or reporting.
    - 1. Additional programmable parameters for each point include the ability to suppress trouble or restoral reports, designate it as a priority zone (system cannot be armed if this point is off-normal), report two separate telephone numbers and provide for automatic shunting of points from the system in the event that the detection device malfunctions and creates numerous false alarms.
    - 2. Each POPIT shall accommodate normally opened and normally closed devices with end-of-line resistor supervisor.
    - 3. Minimum total points, 500.
  - G. Entry/exit delays shall be independently programmable from 10 to 150 seconds. A pre-warn audible shall be coincident with the entry delay.
  - H. Programming of all system functions shall be achievable at system site or remotely via the use of the dial-up telephone network. Minimum programmable functions shall include:
    - 1. User pass codes, entry/exit delay times, master zone personality, day/date/time, telephone numbers, point of protection text labels, and bell time.
    - 2. A programmable system pass code shall be used to prevent unauthorized remote programming attempts.
    - 3. Remote programming capability shall be automatic or require user enabling at the discretion of the user.
  - I. Remote control via the use of the dial-up telephone and owner's local area network shall include:
    - 1. System arming.
    - 2. Reset of audible signals.
    - 3. Activation/deactivation of relay contacts.
    - 4. Interrogation of battery.
    - 5. Zone and armed status.
    - 6. Enable/disable of reporting functions and removing reporting devices for servicing while the remainder of the system is operative.
  - J. Recognitions shall include: UL for central station fire and/or burglary, local burglary and/or fire; FM for fire, California Fire Marshal for fire; and NYBSA for fire.
  - K. Miscellaneous built-in features shall include:
    - 1. Real-time clock.
    - 2. Interrogator.
    - 3. Auto-answer modem.
    - 4. Phone line monitor.
    - 5. Loop start/ground start telephone interface.
    - 6. Auto bell test.
    - 7. Lug-in terminal strips, and user controlled zone bypass.
  - L. Command centers shall be microprocessor-based
    - 1. 16 character illuminated alpha-numeric display.



2. Burglary and fire sounders.
  3. Backlight 15-key touchpad.
  4. Pre-warn tone.
  5. The arming station shall have the ability to annunciate the English language format via the 16 character alphanumeric display by the following:
    - a. Master zone (alarm, service, faulted, and function), POPIT (alarm, service, faulted, missing, extra, function, and location), arm/disarm status (system diagnostics, time/day/date, and userprompts).
  6. Additional features shall include local system test, sensor reset, panic and/or medical and/or duress alarm initiation, independent master zone by-pass with automatic restoration to normal status to next system arming, perimeter watch mode, user changeable pass codes, remote programming initiation, and system/monitoring service test.
  7. Radionics model B915, and shall be functional at each of the locations shown on the floorplans.
  8. Non-school oriented buildings will use Radionics Model B942 Touch Screen Keypads
- M. Modules and Accessories
1. POPEX Module (Zone Expansion B299)
  2. B8103 Main Panel Enclosure & D101 Lock set- one required for the main panel and one for each quadrant of the project receiving a B299.
  3. D9002-5 6 location 3 hole Mounting plate- adapter used for hanging modules in all expansion panels.
  4. B430 Telephone Line Interface
  5. B308 Octo-Relay module - provides eight form "C" dry contact relay outputs for a variety of programmable responses to alarm, trouble and other system conditions.
  6. Auxiliary power supplies as required for powering of motion detectors, Altronix Power Supply (Part # SMP10PM12P8) - one required for each quadrant of the project receiving a B299.

## 2.2 FIELD DEVICES

- A. Ceiling mounted 360 Degree, infrared sensors / microwave motion sensors. Model DS 9370
  1. Bracket for direct mounting to standard 3-1/2" and 4" electrical back boxes.
  2. All units must be adjusted/masked to reduce false signals for the covered area.
  3. Contractor to provide a dedicated POPIT for each motion detector on the project.
- B. Ceiling mounted 200ft Long Range infrared sensor. Model DS794Z
  1. Bracket for direct mounting to standard 3-1/2" and 4" electrical back boxes.
  2. All units must be adjusted/masked to reduce false signals for the covered area.
  3. Contractor to provide a dedicated POPIT for each motion detector on the project
- C. Wall mounted, high performance, Tri Tech PIR/Microwave sensor, Model ISC-CDL1-W15G
  1. Bracket for direct mounting to standard 3-1/2" and 4" electrical back boxes.
  2. All units to have areas of coverage, which would cause false alarm signals to be generated, masked out and adjusted to reduce false signals.
  3. Provide model correct protective wire cage in gymnasiums.
  4. Contractor to provide a dedicated POPIT for each motion detector on the project.
- D. Magnetic Door / Hatch / Overhead Contacts
  1. Where exposed contacts are used they shall be heavy duty switches protected by die cast aluminum housing and the leads shall be encased in steel armor jacket.

- The leads must pass through the back box by the correct size twin screw cable clamp connector.
2. Magnetic Door / Hatch contacts shall be model Sentrol 2505A-L contact
  3. Overhead Roll up contacts shall be model Ademco 958 contact
  4. Contractor to provide a dedicated POPIT for each entry door, set of doors, roof hatch or rollup door on the project.
- E. Glass Break Detector
1. Bracket for direct mounting to standard 3-1/2" and 4" electrical back boxes.
  2. Provide model correct protective wire cage in gymnasiums.
  3. Glass breaks shall be Model GE 5812-RND or Bosch DS-1108DI
  4. Contractor to Provide dedicated POPIT for each room of glass break detectors on the project.
- F. Sirens
1. Shall be installed on Wall / Ceiling within 50 foot of every keypad location.
  2. Wired directly to corresponding relay module and not the main control panel.
  3. Sirens shall be Model SSX-52 Amseco.

## 2.3 WIRING

- A. All wiring shall be by the manufactures (Bosch/Radionics) specifications. All cable is preferred but not limited to be shielded.
- B. Each area of a building shall provide its own Popex Module(s), Power supply(ies) and enclosure(s) in that areas IDF. All areas considered should be at minimum 500ft from the main panel or as otherwise instructed by owner.
- C. All 120v Power shall be furnished by the contractor.
- D. All Security system conduits as show on the drawings shall be furnished by the contractor as part of their scope of work.
- E. Coordination with the electrical contractor is the responsibility of the Security Contractor to ensure all conduit is in place for a complete installation.
- F. All systems shall be connected to an emergency power source as available.
- G. Color code of all security intrusion detection system and access control wiring shall be purple in color.
- H. Approved Products:
  1. 18/2 unshielded:  
Belden #6300UE0071000  
Tappan Wire & Cable, Inc. #P40020.122
  2. 18/4 unshielded:  
Belden #6302UE0071000  
Tappan Wire & Cable, Inc. #P41387.28
  3. 18/6 unshielded:  
Belden #6304UE0071000  
Tappan Wire & Cable, Inc.

## PART 3 - EXECUTION

### 3.1 INSTALLATION

- A. All wiring shall be in accordance with the National Electrical Code, Local Codes, and article 760 of NFPA Standard 70. All wiring sizes shall conform to recommendations of the equipment manufacturer, and as indicated on the engineered shop drawings
- B. All wire shall be UL Listed CL2 for limited energy (300V) applications and shall be installed in conduit. Limited energy MPP wire maybe run open in return air ceiling plenums provided such wire is UL Listed for such applications and is of the low smoke producing fluorocarbon type and complies with NEC Article 760 if so approved by the local authority

- having jurisdiction.
- C. No AC wiring or any other wiring shall be run in the same conduit as security alarm wiring.
  - D. All wire shall be installed in an approved conduit/raceway system (except where permitted by NEC and the local authority having jurisdiction). Maximum conduit "fill" not to exceed 40% per NEC.
  - E. Minimum conduit size shall be 3/4" EMT. Install conduit per engineered shop drawings.
  - F. Systems utilizing open wiring techniques with low smoke plenum cable shall provide conduit in all inaccessible locations such as inside walls, all mechanical / electrical rooms, or other areas where wiring might be exposed or subject to Damage.
  - G. All vertical wiring and all main trunk / riser wiring shall be installed in a complete raceway / conduit system. All riser boxes shall be adequately sized for the number of conductors transversing the respective box as well as the number of terminations required.
  - H. Provide a Green Systimax Category 6 telephone cable from the Master Control Panel to the Telephone Equipment room.
  - I. (2) 18-4 wires will be run from the panel to the prior designated future portable connection location and labeled in plain English on both ends. These spares are to be left above the ceiling with 10ft of slack at minimum.
  - J. Each set of glass breaks that protect one room are to be connected through one POPIT module for point identification of that room.
  - K. Magnetic door contacts protecting separate hallways or entries are to be connected into separate POPIT modules for separate identification.
  - L. Provide and install (1) dedicated POPIT for each device installed on the project including but, not limited to glass break detectors.
  - M. All POPIT Modules shall be installed inside a 4"x4" junction box with a cover to be mounted on the wall nearest to the device the POPIT Module is associated with. All boxes shall be labeled with the appropriate corresponding point contained within.
  - N. Integrate the security system to the remote monitoring station. Provide all hardware and cabling as required. Coordinate with Owner for approved remote monitoring service.
  - O. All POPIT modules on project shall be mounted above drop ceiling in an area easily accessible by an 8 or 6 ft ladder.
  - P. All keypads, sirens and POPEX modules shall have dedicated homeruns from each device to the master control panel. Do not daisy chain keypads or sirens. Chaining of modules is permitted if location serves multiple areas of coverage.
  - Q. All POPIT modules and power supplies are required to be located on as-built drawings delivered to owner at or before substantial completion of project.
  - R. Contractor shall install communication wire from provided exterior connection at freezer/cooler control panels to burglar alarm via POPIT module interface to notify panel should freezer/cooler encounter high temperature condition. Coordinate programming and testing of module with owner.
  - S. All POPEX modules and power supplies shall be installed in IDF closets for that area of coverage with easy accessibility and a dedicated SDI2 homerun to the master control panel not to exceed 500ft.
  - T. All device power runs shall be fused and clearly labeled in plain English at each main power source.
  - U. All Eyewash stations shall have a dedicated POPIT module interface per device on the project and be wired Normally closed for monitoring purposes.
  - V. Any generator on site must be monitored through a dry Normally closed contact connection to a dedicated POPIT module and tested to confirm its function for main

building AC Loss.

### 3.2 CABLE PATHWAYS

#### A. Cable Support:

1. All wire not installed inside conduit or a designated cable tray system shall be installed in a dedicated cable support system for the entire run of each cable. Including, but not limited to service loops.
  - a. Approved Cable Support Manufacturer:  
Panduit Corporation  
Erico/Caddy  
B-Line  
Supports shall be sized appropriately for the number of wires being supported. Reference the manufacturer's specifications for the suggested maximum cables per support size.
2. The approved cable support system shall be attached directly to the building steel at a serviceable height. In the event that the building steel is not 5' of the finished ceiling, the contractor shall provide a dedicated threaded rod extending within 5' of the finished ceiling and mount the cable support hook to the treaded rod.
3. The cable support shall be installed at a maximum of 5' on center.
4. All cable installed shall be attached to the cable support system with plenum rated Velcro and a plenum rated Velcro tie shall be installed between each cable support, to keep wires neatly bundled throughout the entire run. Tie wraps will only be allowed to be used inside the control panels as required to manage the wires within each type of panel.
5. Absolutely no cable, not installed in conduit, will be allowed to be attached directly to the building's steel or supported in any other method than that stated above.
6. It is the responsibility of the installing contractor to coordinate with all other trades on the project to insure that the pathway of this system does not interfere with the installation of the other trades and to prevent the installed product of other trades from putting strain on the installed wiring.

#### B. Conduit / Raceway:

1. All wire shall be installed in an approved conduit/raceway system (except where permitted by NEC and the local authority having jurisdiction). Maximum conduit "fill" shall not exceed 40% per NEC.
2. Conduit and raceway system shall be installed as specified under the general electrical section of the specifications, and per NEC.
3. Minimum conduit size shall be 3/4" EMT. Install conduit per engineered shop drawings.
4. Systems utilizing open wiring techniques with low smoke plenum cable shall provide conduit in all inaccessible locations, inside concealed walls, all mechanical/electrical rooms, or other areas where wiring might be exposed or subject to damage.

### 3.3 SYSTEM OPERATION

#### A. When an alarm condition is detected by any of the alarm initiating devices, the following functions shall occur:

1. The system keypad's interior audible device shall sound until silenced by using proper security code or after system time out.
2. A custom system alarm message shall be displayed on the LCD display. This display will show the alarm device location in plain English. Location and partition custom messages shall be field programmable.

3. The remote signaling tie connection shall be activated at the Owner's approved central security monitoring location and/or other Owner designated location.
4. Printer shall provide printed copy of events recorded in logger. Install adjacent to security panel.

### **3.4 SYSTEM ZONING AND PARTITIONING**

- A. The system shall employ intelligent initiating devices and interface devices capable of being recognized and enunciated at the main system keypad and devices partition keypad.
- B. All zoning/device locations shall be field programmable.
- C. Input control zones shall be coordinated with the owner prior to final programming:

### **3.5 TESTING**

- A. Submit a written test report from an authorized representative of the equipment manufacturer that the system has been 100% tested and approved. Final test shall be witnessed by Owner, Engineer, Electrical Contractor and performed by the equipment supplier. Final test report must be received and acknowledged by the Owner prior to substantial completion.
- B. Provide instruction as to proper use and operation of system, for the Owner's designated personnel.

### **3.6 WARRANTY**

- A. Entire system shall be warranted against defects in materials and workmanship for a period of one (1) year from the date of substantial completion.
- B. Any Extended Manufacturer's Warranty will be provided to the Owner if the Sub-contractor entitled to the job has an agreement for an extended warranty already in place with the Manufacturer.

### **3.7 SOFTWARE**

- A. Provide two electronic copies of the final programming and program software to the Owner's Police Technology Foreman after final approval.

**END OF SECTION**

**Salas O'Brien**  
 salasobrien.com 281-664-1900  
 Houston 10930 W. Sam Houston Pkwy North, Suite 900  
 Houston, TX 77064  
 Registration: F-411  
 Project No: 2024-0029-00

**NATEX**  
 CORPORATION ARCHITECTS  
 www.nateearchitects.com  
 447 Heights Boulevard  
 Houston, TX 77007  
 Phone: 713-975-9525  
 Fax: 713-970-7824

**Coleman Partners**  
 ARCHITECTS  
 colemanpartners.com

3701 Kirby Drive, Suite 830  
 Houston, TX 77098  
 tel: 832-947-1038 fax: 282-214-5365

RENOVATIONS	
+	POINT OF CONNECTION FROM NEW TO EXISTING
□	ITEM TO REMAIN
⊖	ITEM TO BE REMOVED

CONTRACTOR SHALL PROVIDE DEHUMIDIFICATION DURING THE CONSTRUCTION SCHEDULE. THE SCOPE IS TO MAINTAIN ACCEPTABLE HUMIDITY LEVELS WITHIN THE BUILDING. THE REMOVAL OF EXCESS HUMIDITY FROM THE AIR THROUGHOUT THE BUILDING. PROVIDE MOISTURE CONTROL RENTAL EQUIPMENT AND SOLUTION FOR PREVENTING THE LONG-TERM EFFECTS OF MOISTURE LEVEL THAT CAN DAMAGE INTERIOR BUILDING MATERIALS, BOOKS AND ELECTRONIC EQUIPMENT.

CONTRACTOR IS RESPONSIBLE TO PROVIDE ALL REQUIRED POWER GENERATING EQUIPMENT.


**GENERAL NOTES:**

- OWNER SHALL HAVE FIRST RIGHT OF REFUSAL ON ALL EQUIPMENT BEING REMOVED FROM THIS PROJECT. THIS INCLUDES BUT IS NOT LIMITED TO CHILLERS, AIR HANDLING UNITS, FANS, CONDENSING UNITS, BMS CONTROL PANELS, TEMPERATURE SENSORS, AND CONTROL VALVES.
- THESE CONSTRUCTION DRAWINGS ARE DIAGRAMMATIC, AND DO NOT NECESSARILY REFLECT ACTUAL DIMENSIONS. IT IS THE RESPONSIBILITY OF THE CONTRACTOR TO FIELD-VERIFY ALL DIMENSIONS AND COORDINATE PLACEMENT OF ALL EQUIPMENT AND ROUTING OF ALL PIPING AND/OR DUCT SYSTEMS.
- ALL MECHANICAL SYSTEMS SHOWN ON THIS PLAN ARE FROM EXISTING DRAWINGS AND PRELIMINARY FIELD WORK. CONTRACTOR IS RESPONSIBLE FOR FIELD VERIFYING ALL LOCATIONS AND SIZES OF MECHANICAL SYSTEMS PRIOR TO THE START OF WORK.

**DEMOLITION KEYED NOTES:**

- REMOVE EXISTING SUPPLY AIR GRILLE AND DUCTWORK TO POINT INDICATED.
- REMOVE EXISTING RETURN AIR DEVICE.
- EXISTING DUAL DUCT BOX TO REMAIN.
- REMOVE EXISTING EXHAUST FAN ASSOCIATED DUCTWORK, CONTROLS AND ELECTRICAL CONNECTIONS.
- REMOVE EXISTING RETURN AIR TRANSFER.
- REMOVE EXISTING 6" EXHAUST DUCTWORK.

**CONSTRUCTION DOCUMENT**

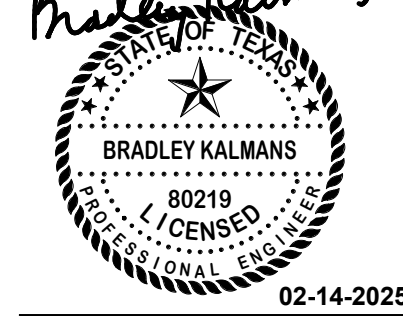


**CIVIL ENGINEER**  
**BROOKS AND SPARKS, INC.**  
 21020 PARK ROW  
 KATY, TX 77449  
 tel: 281-578-9595

**STRUCTURAL ENGINEER**  
**DALLY + ASSOCIATES, INC.**  
 9800 RICHMOND AVE.  
 SUITE 400  
 HOUSTON, TX 77042  
 tel: 713.337.8881

**MEPT ENGINEER**  
**SALAS O'BRIEN**  
 10930 W. SAM HOUSTON PKWY. N.  
 SUITE 900  
 HOUSTON, TX 77064  
 tel: 281.664.1900


**FOOD SERVICE EQUIPMENT**  
**FDP**  
 25317 INTERSTATE 45  
 THE WOODLANDS, TX 77380  
 tel: 281-350-2323

**LANDSCAPE ARCHITECT**  
**LANDESIGN GROUP**  
 17041 EL CAMINO REAL  
 SUITE 204  
 HOUSTON, TX 77058  
 tel: 281.486.4040

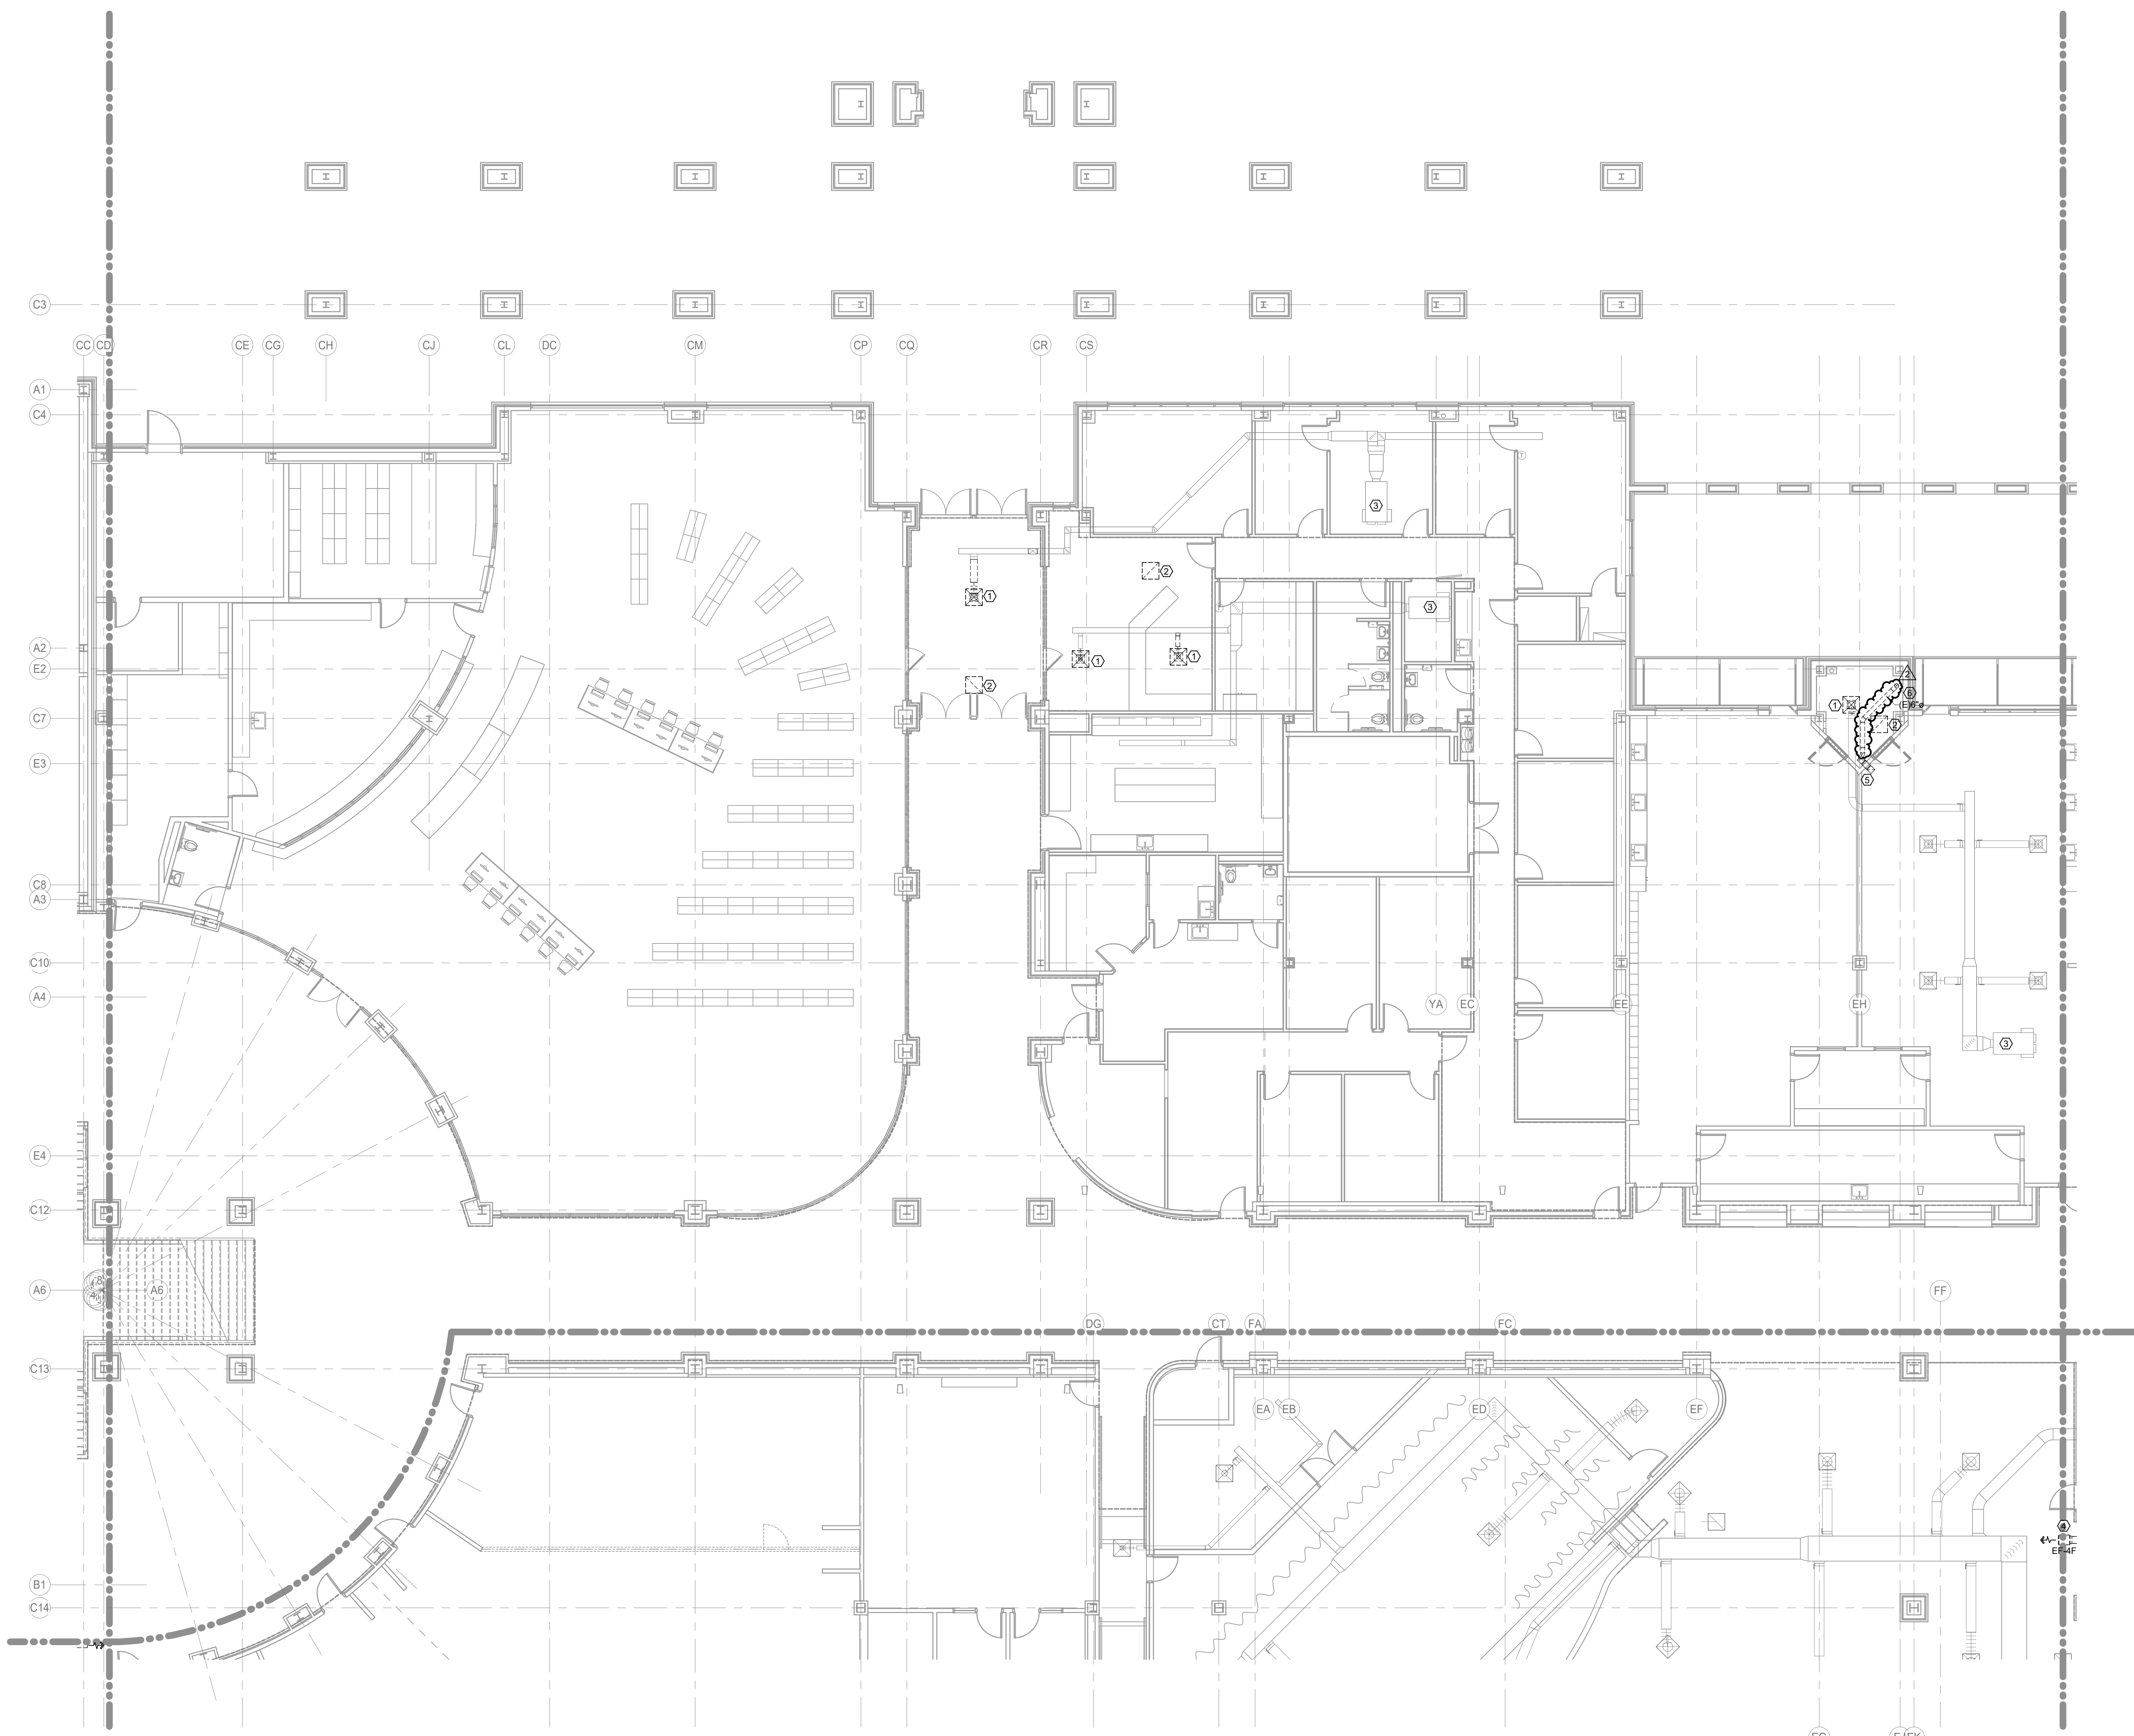

**1 MECHANICAL DEMOLITION FLOOR PLAN - LEVEL 1 - AREA C**  
 Scale: 1/8" = 1'-0"

KEY PLAN:

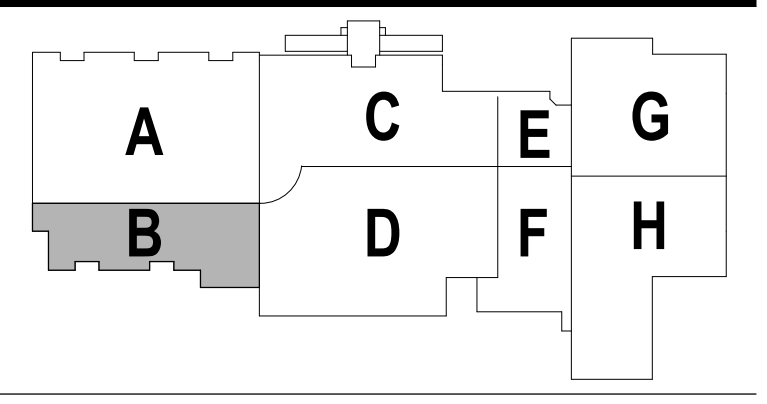

**2024 SMITH & SPILLANE MS RENOVATIONS**  
**SMITH MIDDLE SCHOOL**  
 10300 WARNER SMITH BLVD., CYPRESS, TEXAS 77433  
 CFISD PROJECT NO: 24-02-5751-R-RFP

Revision	Description	Date
2	Addendum 03	02-14-25
1	Submission	

Project Number: 23073  
 Date: 26 JANUARY 2025  
 Drawn By: WHL / KLO

MECHANICAL DEMOLITION FIRST FLOOR PLAN - AREA C

**M0.03**

**Salas O'Brien**  
 salasobrien.com 281-664-1900  
 Houston  
 10930 W. Sam Houston Pkwy North, Suite 900  
 Houston, TX 77064  
 Registration: F-4111  
 Project No: 2024-00209-00

**NATEX**  
 CORPORATION  
 ARCHITECTS  
 www.natexarchitects.com  
 447 Heights Boulevard  
 Houston, TX 77007  
 Phone: 713-975-9525  
 Fax: 713-780-7824

**Coleman Partners**  
 ARCHITECTS  
 colemanpartners.com  
 3701 Kirby Drive, Suite 830  
 Houston, TX 77098  
 tel: 832.947.1038 fax: 282.214.5365

CONSTRUCTION DOCUMENT

**BRADLEY KALMANS**  
 80219  
 02-14-2025

**CIVIL ENGINEER**  
**BROOKS AND SPARKS, INC.**  
 21020 PARK ROW  
 KATY, TX 77449  
 tel: 281.578.9595

**STRUCTURAL ENGINEER**  
**DALLY + ASSOCIATES, INC.**  
 9800 RICHMOND AVE.  
 SUITE 400  
 HOUSTON, TX 77042  
 tel: 713.337.8881

**MEPT ENGINEER**  
**SALAS O'BRIEN**  
 10930 W. SAM HOUSTON PKWY. N.  
 SUITE 900  
 HOUSTON, TX 77064  
 tel: 281.664.1900

**FOOD SERVICE EQUIPMENT**  
**FDP**  
 25317 INTERSTATE 45  
 THE WOODLANDS, TX 77380  
 tel: 281.350.2323

**LANDSCAPE ARCHITECT**  
**LANDESIGN GROUP**  
 17041 EL CAMINO REAL  
 SUITE 204  
 HOUSTON, TX 77058  
 tel: 281.486.4040

RENOVATIONS	
	POINT OF CONNECTION FROM NEW TO EXISTING
	ITEM TO REMAIN
	ITEM TO BE REMOVED

CONTRACTOR SHALL PROVIDE DEHUMIDIFICATION DURING THE CONSTRUCTION SCHEDULE. THE SCOPE IS TO MAINTAIN ACCEPTABLE HUMIDITY LEVELS WITHIN THE BUILDING. THE REMOVAL OF EXCESS HUMIDITY FROM THE AIR THROUGHOUT THE BUILDING. PROVIDE MOISTURE CONTROL RENTAL EQUIPMENT AND SOLUTION FOR PREVENTING THE LONG-TERM EFFECTS OF MOISTURE LEVEL THAT CAN DAMAGE INTERIOR BUILDING MATERIALS, BOOKS AND ELECTRONIC EQUIPMENT.


CONTRACTOR IS RESPONSIBLE TO PROVIDE ALL REQUIRED POWER GENERATING EQUIPMENT.

**GENERAL NOTES:**

- OWNER SHALL HAVE FIRST RIGHT OF REFUSAL ON ALL EQUIPMENT BEING REMOVED FROM THIS PROJECT. THIS INCLUDES BUT IS NOT LIMITED TO CHILLERS, AIR HANDLING UNITS, FANS, CONDENSING UNITS, BACMS CONTROL PANELS, TEMPERATURE SENSORS, AND CONTROL VALVES.
- THESE CONSTRUCTION DRAWINGS ARE DIAGRAMMATIC, AND DO NOT NECESSARILY REFLECT ACTUAL DIMENSIONS. IT IS THE RESPONSIBILITY OF THE CONTRACTOR TO FIELD-VERIFY ALL DIMENSIONS AND COORDINATE PLACEMENT OF ALL EQUIPMENT AND ROUTING OF ALL PIPING AND/OR DUCT SYSTEMS.
- ALL MECHANICAL SYSTEMS SHOWN ON THIS PLAN ARE FROM EXISTING DRAWINGS AND PRELIMINARY FIELD WORK. CONTRACTOR IS RESPONSIBLE FOR FIELD VERIFYING ALL LOCATIONS AND SIZES OF MECHANICAL SYSTEMS PRIOR TO THE START OF WORK.


**DEMOLITION KEYED NOTES:**

- REMOVE EXISTING ROOF MOUNTED UNIT AND ALL ASSOCIATED DUCTWORK, PIPING, CONTROLS AND ELECTRICAL CONNECTIONS.
- REMOVE EXISTING SUPPLY AIR GRILLE AND EXISTING DUCTWORK UP TO INDICATED POINT.
- REMOVE EXISTING RETURN AIR DEVICE.
- REMOVE EXISTING PORTION OF DUCTWORK AS INDICATED. SEE M2.04 FOR MORE INFORMATION.

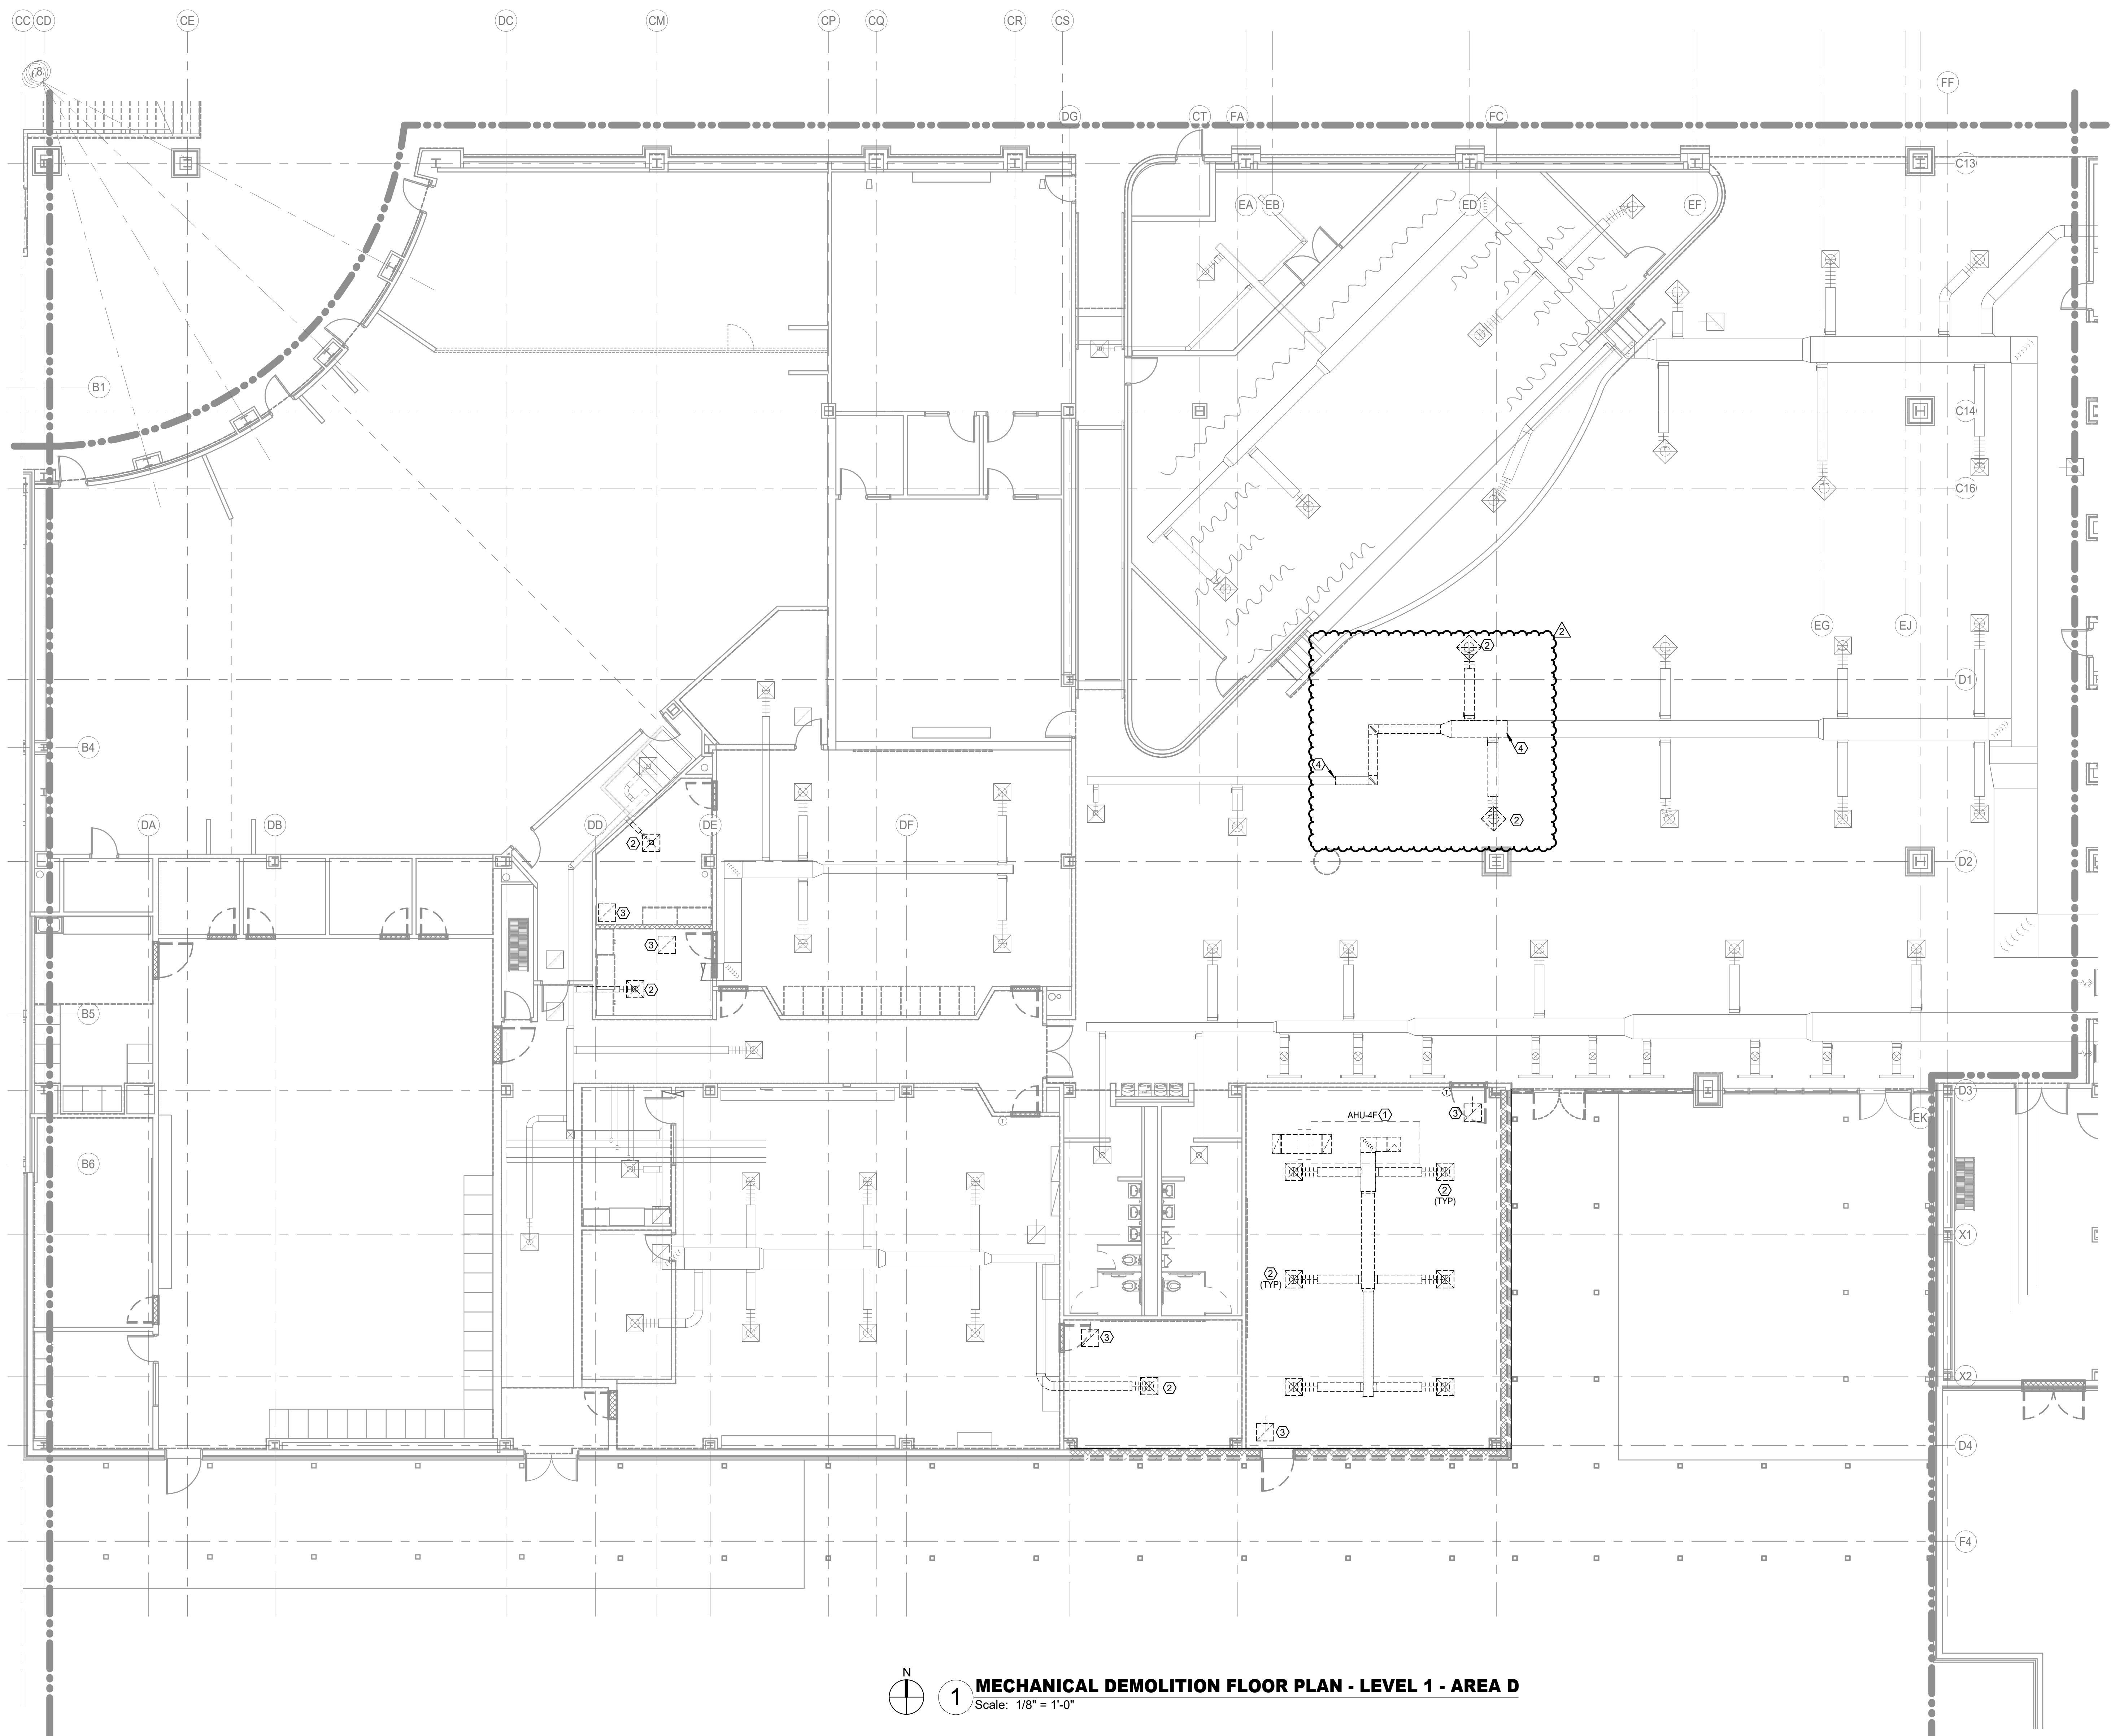

**1 MECHANICAL DEMOLITION FLOOR PLAN - LEVEL 1 - AREA D**  
 Scale: 1/8" = 1'-0"

KEY PLAN:

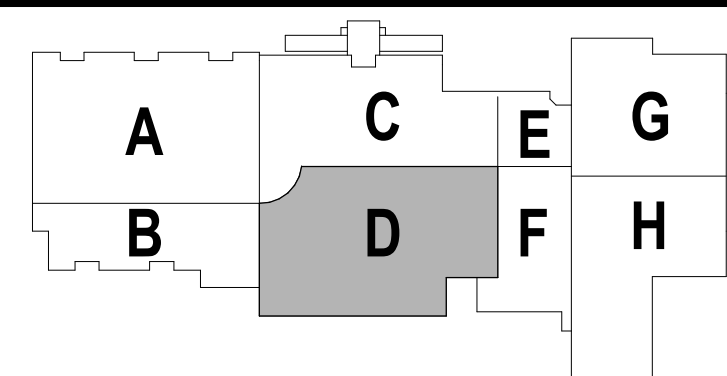

**2024 SMITH & SPILLANE MS RENOVATIONS**  
**SMITH MIDDLE SCHOOL**  
 10300 WARNER SMITH BLVD., CYPRESS, TEXAS 77433  
 CFSID PROJECT NO: 24-02-5751-R-RFP

Revision	Description	Date
2	Addendum 03	02-14-25
1	Original Submission	

Project Number: 23073  
 Date: 26 JANUARY 2025  
 Drawn By: WHL / KLO

MECHANICAL  
 DEMOLITION FIRST  
 FLOOR PLAN - AREA 'D'

**M0.04**



**Salas O'Brien**  
 salesobrien.com 281-664-1900  
 Houston  
 10930 W. Sam Houston Pkwy North, Suite 900  
 Houston, TX 77064  
 Registration: F-411  
 Project No: 2024-0209-00

**NATEX**  
 CORPORATION ARCHITECTS  
 www.natexarchitects.com  
 447 Heights Boulevard  
 Houston, TX 77007  
 Phone: 713-975-9525  
 Fax: 713-780-7824

**Coleman Partners**  
 ARCHITECTS  
 cpa@cpa.com  
 3701 Kirby Drive, Suite 830  
 Houston, TX 77098  
 tel: 832-947-1038 fax: 281-214-5365

CONSTRUCTION DOCUMENT

**BRADLEY KALMANS**  
 80219  
 02-14-2025

**CIVIL ENGINEER**  
**BROOKS AND SPARKS, INC.**  
 21020 PARK ROW  
 KATY, TX 77449  
 tel: 281-578-9595

**STRUCTURAL ENGINEER**  
**DALLY + ASSOCIATES, INC.**  
 9800 RICHMOND AVE.  
 SUITE 400  
 HOUSTON, TX 77042  
 tel: 713.337.8881

**MEPT ENGINEER**  
**SALAS O'BRIEN**  
 10930 W. SAM HOUSTON PKWY. N.  
 SUITE 900  
 HOUSTON, TX 77064  
 tel: 281.664.1900

**FOOD SERVICE EQUIPMENT**  
**FDP**  
 25317 INTERSTATE 45  
 THE WOODLANDS, TX 77380  
 tel: 281-350-2323

**LANDSCAPE ARCHITECT**  
**LANDESIGN GROUP**  
 17041 EL CAMINO REAL  
 SUITE 204  
 HOUSTON, TX 77058  
 tel: 281.486.4040

**2024 SMITH & SPILLANE MS RENOVATIONS**  
**SMITH MIDDLE SCHOOL**  
 10300 WARNER SMITH BLVD., CYPRESS, TEXAS 77433  
 CFISD PROJECT NO: 24-02-5751-R-RFP


Revision	Submission
2	Addendum 03 02-14-25

Project Number: 23073  
 Date: 26 JANUARY 2025  
 Drawn By: WHL / KLO

MECHANICAL SITE PLAN

M1.00

of

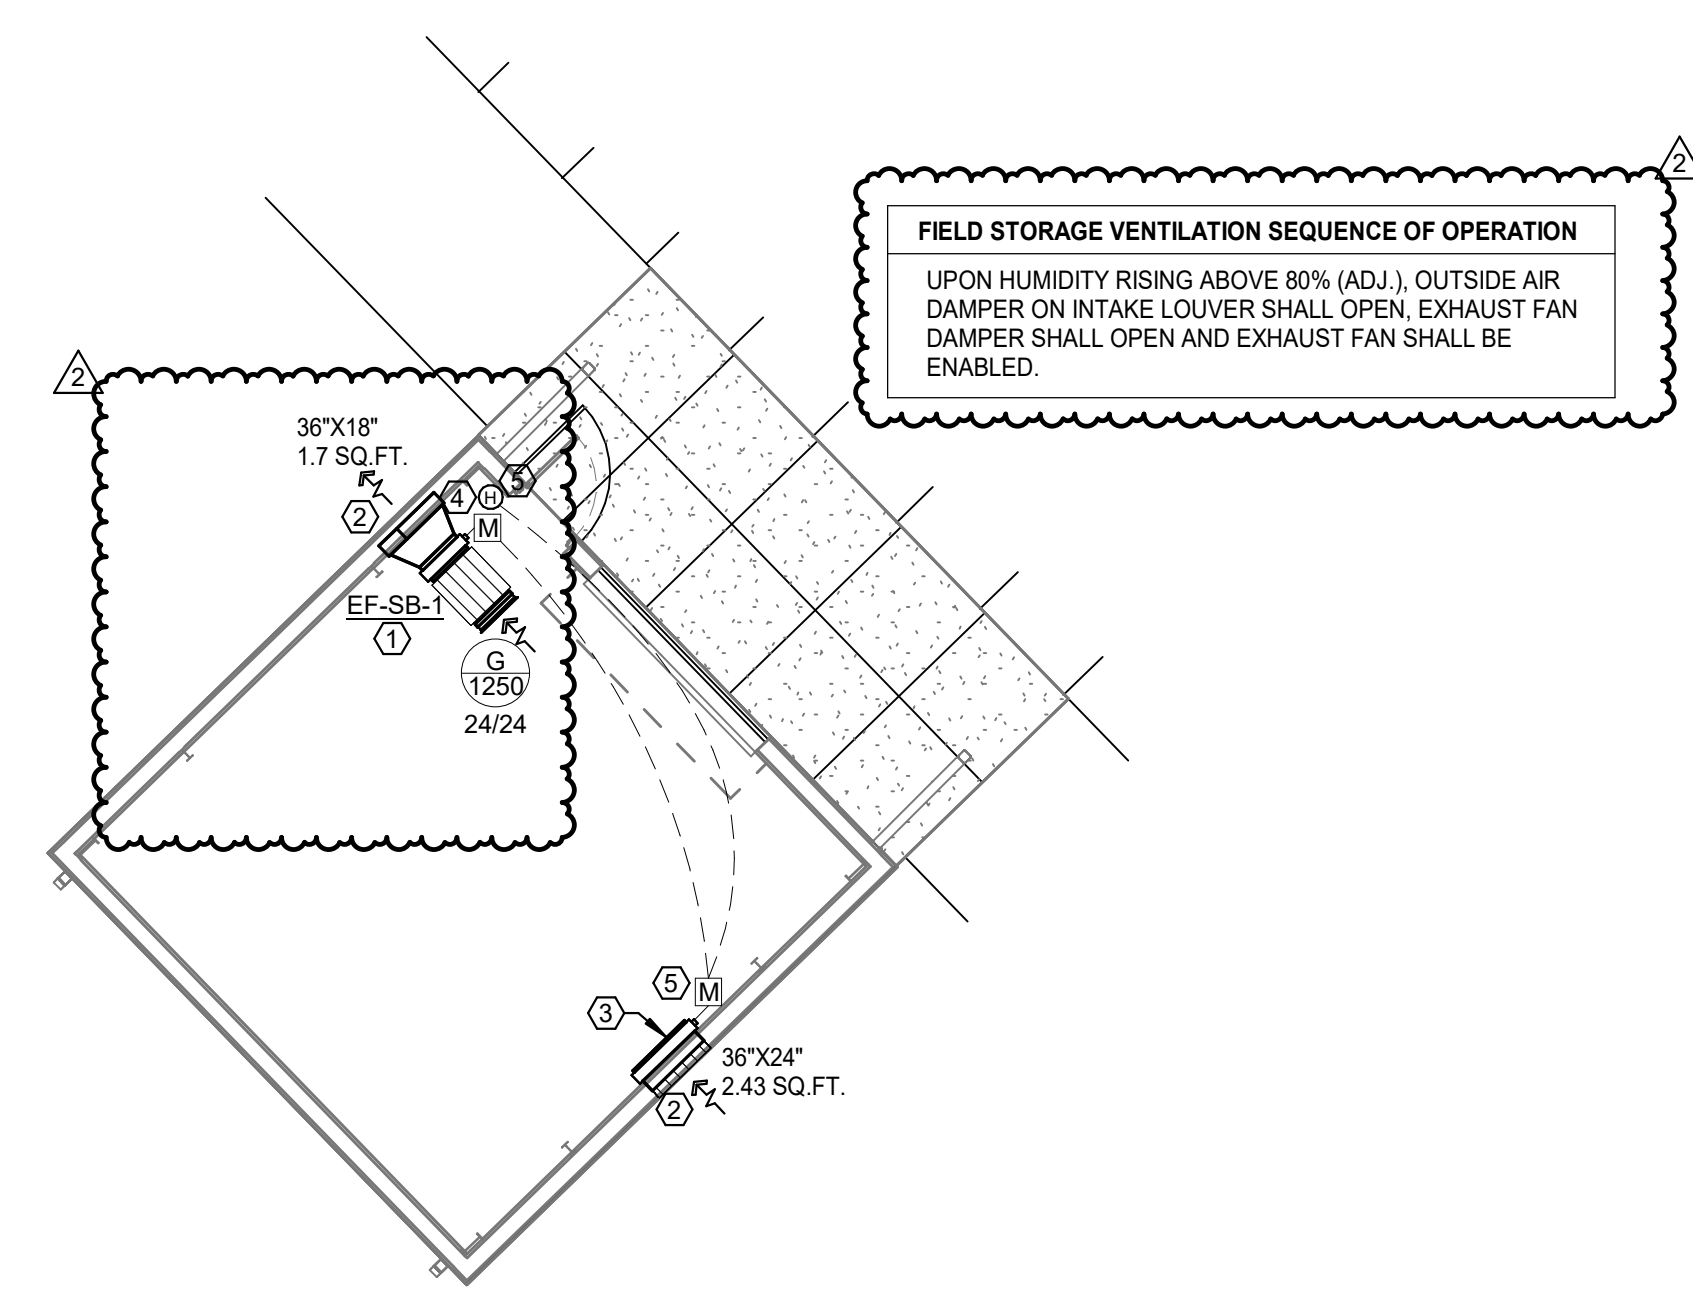

**2 MECHANICAL SITE PLAN - STORAGE BUILDING**  
 Scale: 1/8" = 1'-0"

**FIELD STORAGE VENTILATION SEQUENCE OF OPERATION**  
 UPON HUMIDITY RISING ABOVE 80% (ADJ.), OUTSIDE AIR DAMPER ON INTAKE LOUVER SHALL OPEN, EXHAUST FAN DAMPER SHALL OPEN AND EXHAUST FAN SHALL BE ENABLED.

**RENOVATIONS**

	POINT OF CONNECTION FROM NEW TO EXISTING
	ITEM TO REMAIN
	ITEM TO BE REMOVED


CONTRACTOR SHALL PROVIDE DEHUMIDIFICATION DURING THE CONSTRUCTION SCHEDULE. THE SCOPE IS TO MAINTAIN ACCEPTABLE HUMIDITY LEVELS WITHIN THE BUILDING. THE REMOVAL OF EXCESS HUMIDITY FROM THE AIR THROUGHOUT THE BUILDING. PROVIDE MOISTURE CONTROL, RENTAL EQUIPMENT AND SOLUTION FOR PREVENTING THE LONG-TERM EFFECTS OF MOISTURE LEVEL THAT CAN DAMAGE INTERIOR BUILDING MATERIALS, BOOKS AND ELECTRONIC EQUIPMENT.  
 CONTRACTOR IS RESPONSIBLE TO PROVIDE ALL REQUIRED POWER GENERATING EQUIPMENT.

**GENERAL NOTES:**

- THESE CONSTRUCTION DRAWINGS ARE DIAGRAMMATIC, AND DO NOT NECESSARILY REFLECT ACTUAL DIMENSIONS. IT IS THE RESPONSIBILITY OF THE CONTRACTOR TO FIELD-VERIFY ALL DIMENSIONS AND COORDINATE PLACEMENT OF ALL EQUIPMENT AND ROUTING OF ALL PIPING AND/OR DUCT SYSTEMS.
- ALL MECHANICAL SYSTEMS SHOWN ON THIS PLAN ARE FROM EXISTING DRAWINGS AND PRELIMINARY FIELD WORK. CONTRACTOR IS RESPONSIBLE FOR FIELD VERIFYING ALL LOCATIONS AND SIZES OF MECHANICAL SYSTEMS PRIOR TO THE START OF WORK.

**MECHANICAL KEYED NOTES:**

- VERIFY SERVICE CLEARANCE WITH EQUIPMENT MANUFACTURER. COORDINATE WITH ALL TRADES NOT TO OBSTRUCT.
- PROVIDE WIND-DRIVEN RAIN RESISTANT STATIONARY LOUVER RUSKIN MODEL EME20MD OR APPROVED EQUAL AND MINIMUM FREE AREA AS NOTED. PROVIDE WITH BIRD SCREEN AND PAINT TO MATCH WALL OR AS SPECIFIED BY ARCHITECT.
- SHEET METAL PLENUM ON REAR OF LOUVER WITH MOTORIZED DAMPER.
- PROVIDE WITH LINE VOLTAGE HUMIDITY SENSOR.
- PROVIDE WITH LINE VOLTAGE MOTORIZED DAMPER FOR EXHAUST AND MAKEUP AIR LOUVER.

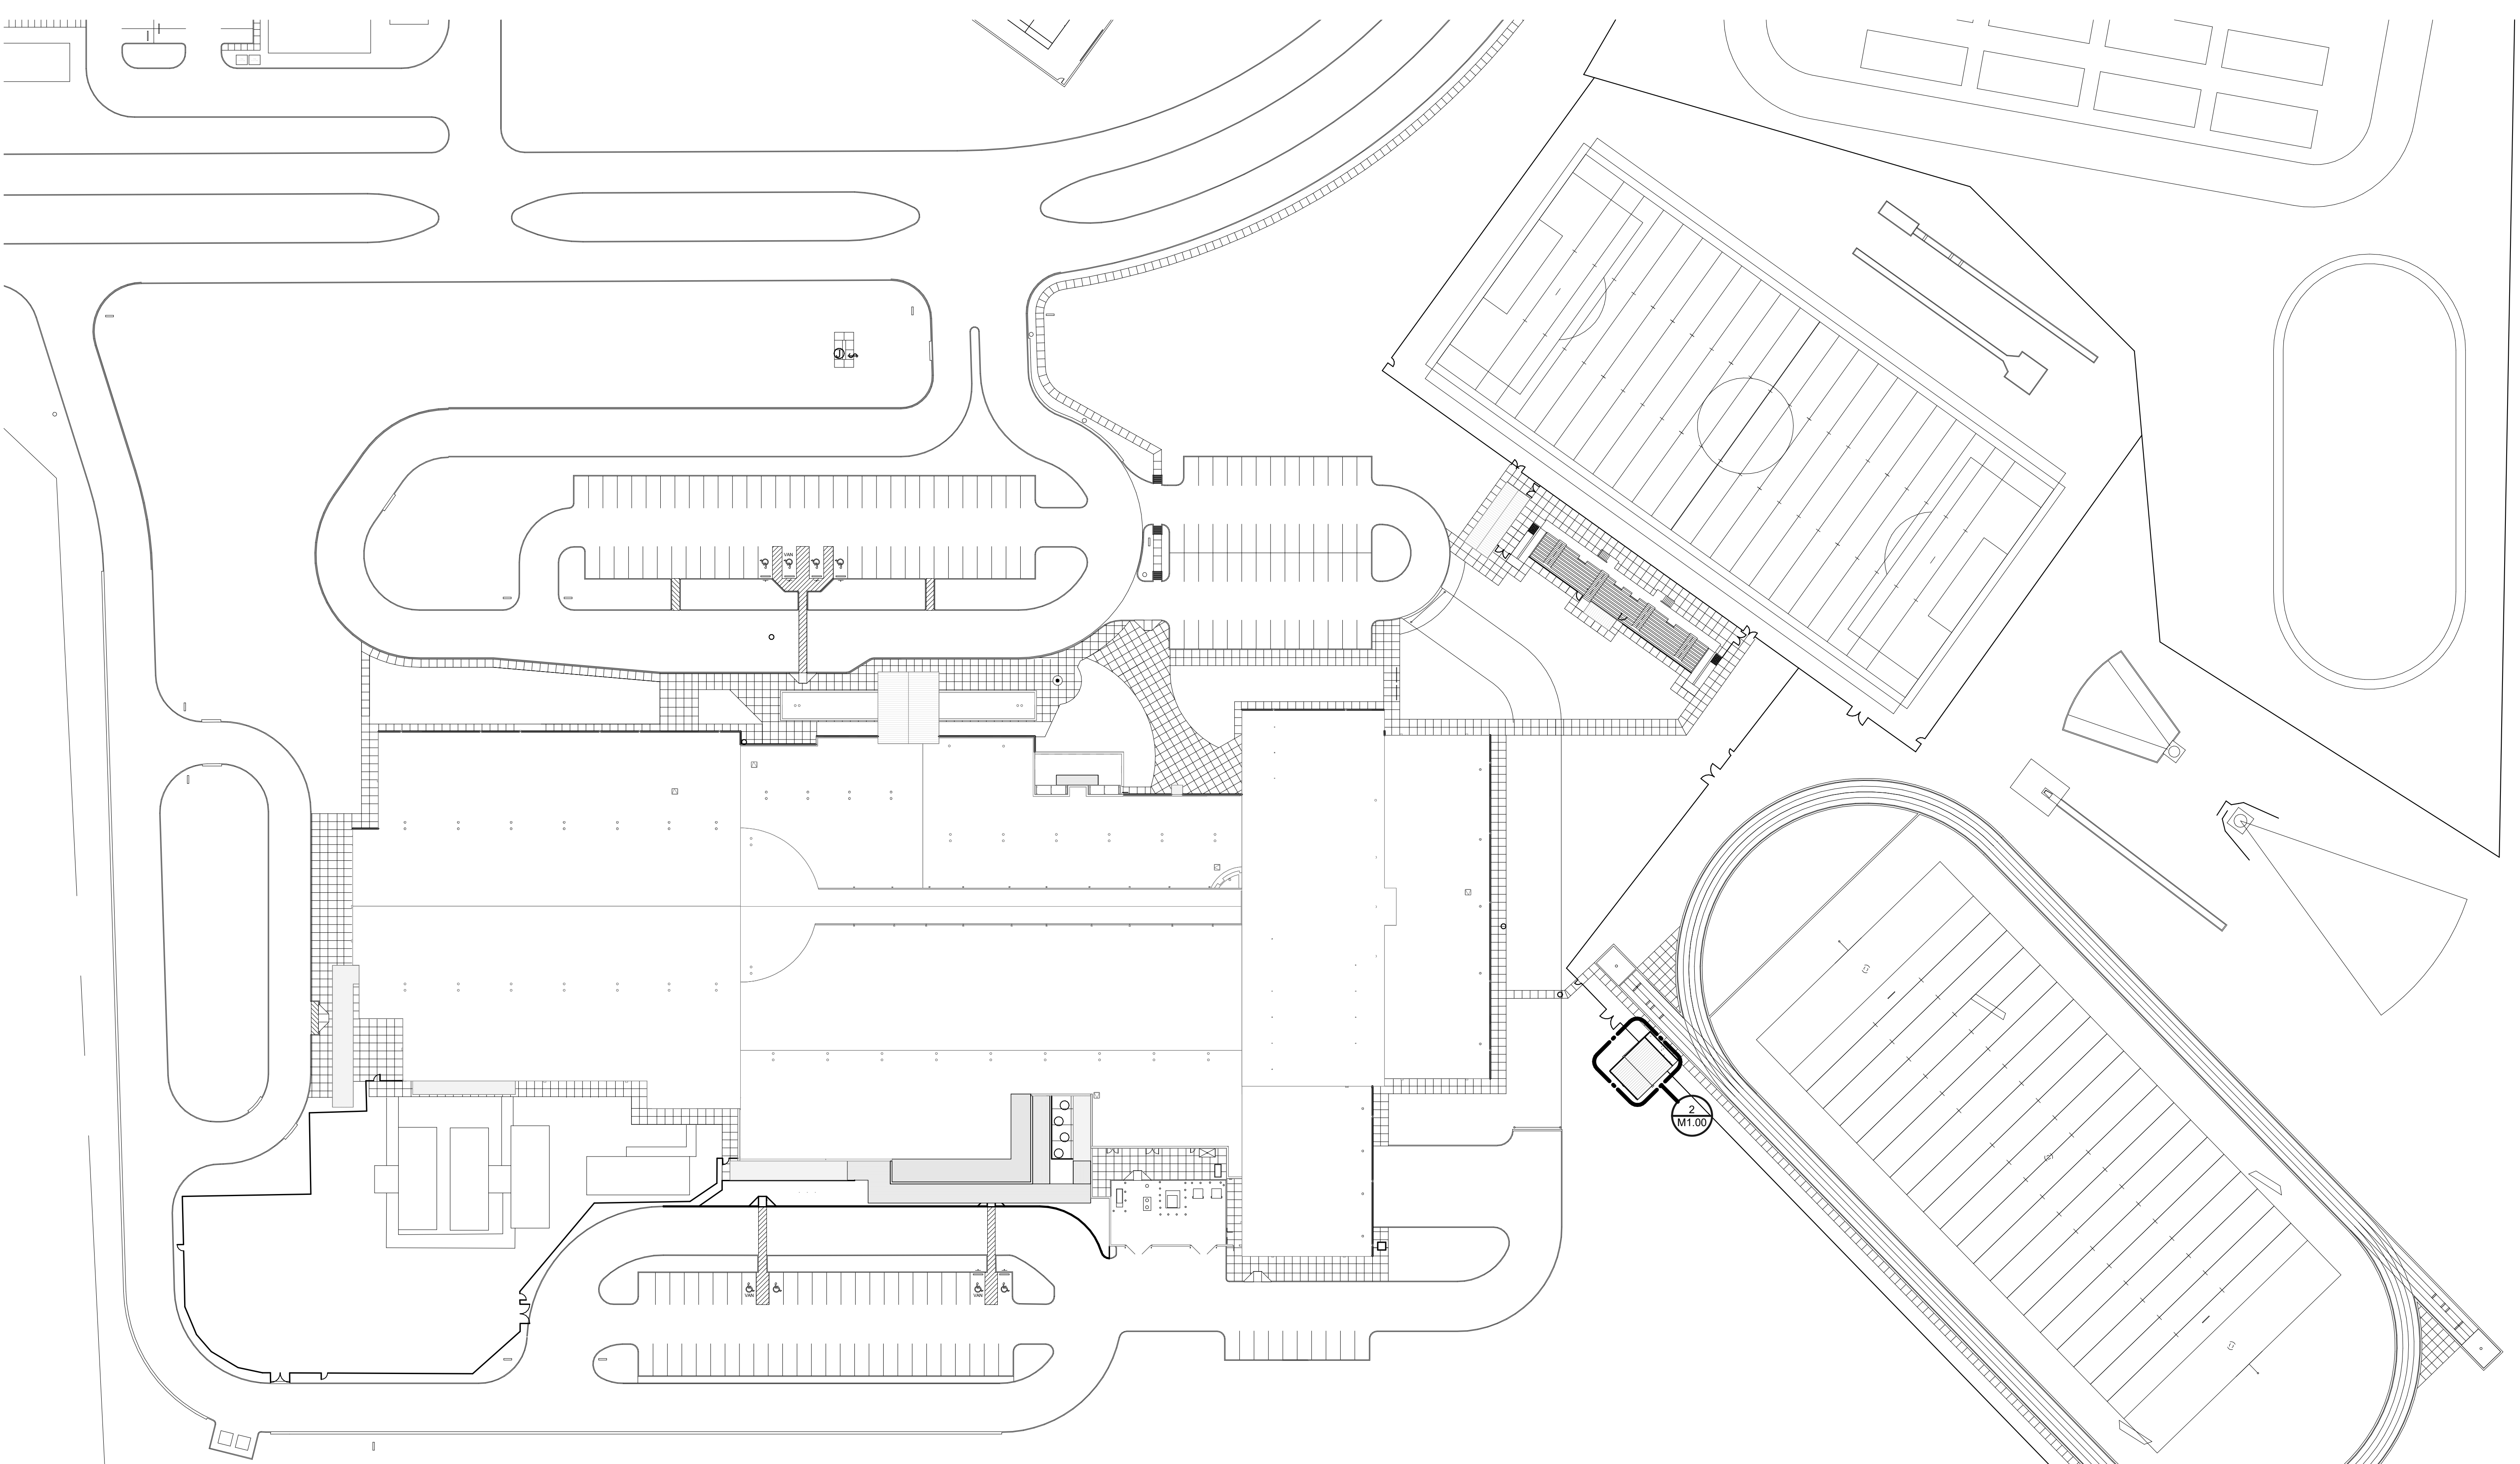

**1 MECHANICAL SITE PLAN**  
 Scale: 1" = 50'-0"

MECHANICAL SITE PLAN

M1.00

of



**RENOVATIONS**

	POINT OF CONNECTION FROM NEW TO EXISTING
	ITEM TO REMAIN
	ITEM TO BE REMOVED

CONTRACTOR SHALL PROVIDE DEHUMIDIFICATION DURING THE CONSTRUCTION SCHEDULE. THE SCOPE IS TO MAINTAIN ACCEPTABLE HUMIDITY LEVELS WITHIN THE BUILDING; THE REMOVAL OF EXCESS HUMIDITY FROM THE AIR THROUGHOUT THE BUILDING. PROVIDE MOISTURE CONTROL RENTAL EQUIPMENT AND SOLUTION FOR PREVENTING THE LONG TERM EFFECTS OF MOISTURE LEVEL THAT CAN DAMAGE INTERIOR BUILDING MATERIALS, BOOKS AND ELECTRONIC EQUIPMENT.


CONTRACTOR IS RESPONSIBLE TO PROVIDE ALL REQUIRED POWER GENERATING EQUIPMENT.

**GENERAL NOTES:**

- THESE CONSTRUCTION DRAWINGS ARE DIAGRAMMATIC AND DO NOT NECESSARILY REFLECT ACTUAL DIMENSIONS. IT IS THE RESPONSIBILITY OF THE CONTRACTOR TO FIELD-VERIFY ALL DIMENSIONS AND COORDINATE PLACEMENT OF ALL EQUIPMENT AND ROUTING OF ALL PIPING AND/OR DUCT SYSTEMS.
- ALL MECHANICAL SYSTEMS SHOWN ON THIS PLAN ARE FROM EXISTING DRAWINGS AND PRELIMINARY FIELD WORK. CONTRACTOR IS RESPONSIBLE FOR FIELD VERIFYING ALL LOCATIONS AND SIZES OF MECHANICAL SYSTEMS PRIOR TO THE START OF WORK.


**MECHANICAL KEYED NOTES:**

- PROVIDE ADDITIONAL FLEX DUCTWORK AS REQUIRED TO INSTALL DIFFUSER IN LOCATION INDICATED.
- AVERAGING TEMPERATURE SENSOR FOR DUAL DUCT BOY INDICATED.
- PROVIDE BMCS MONITORING TEMPERATURE SENSOR AS INDICATED.
- ROUTE KILN ALUMINUM DUCTWORK DOWN ALONG WALL TO 24" A.F.F FOR CONNECTION TO KILN FUME FAN. REFER TO DETAIL.
- ROUTE FAN DISCHARGE DUCT AS SHOWN UP TO GOOSENECK ON ROOF. REUSE EXISTING ROOF OPENING. REFER TO GOOSENECK DETAIL.
- MOUNT KILN FAN TO WALL. REFER TO MANUFACTURER'S INSTALLATION INSTRUCTIONS.
- KILN VENTILATION SHALL BE ENVIROVENT 2 BY SKUTT. PROVIDE KILN WITH ENVIROKILN CONTROLLER AND ALL WIRES WITH SUFFICIENT LENGTH TO MAKE ALL CONNECTIONS AS PER MANUFACTURER RECOMMENDATIONS.
- PROVIDE ALUMINUM FLEX TO CONNECT KILN ALUMINUM DUCT WITH KILN FAN.
- THERMOSTAT SHALL BE SET TO 80°F (ADJUSTABLE).
- PROVIDE HEAT DETECTOR. INTERLOCK WITH KILN TO SHUT OFF POWER SOURCE AT 135°F (ADJUSTABLE). MOUNT HEAT DETECTOR ON CEILING AT LOCATION SHOWN.

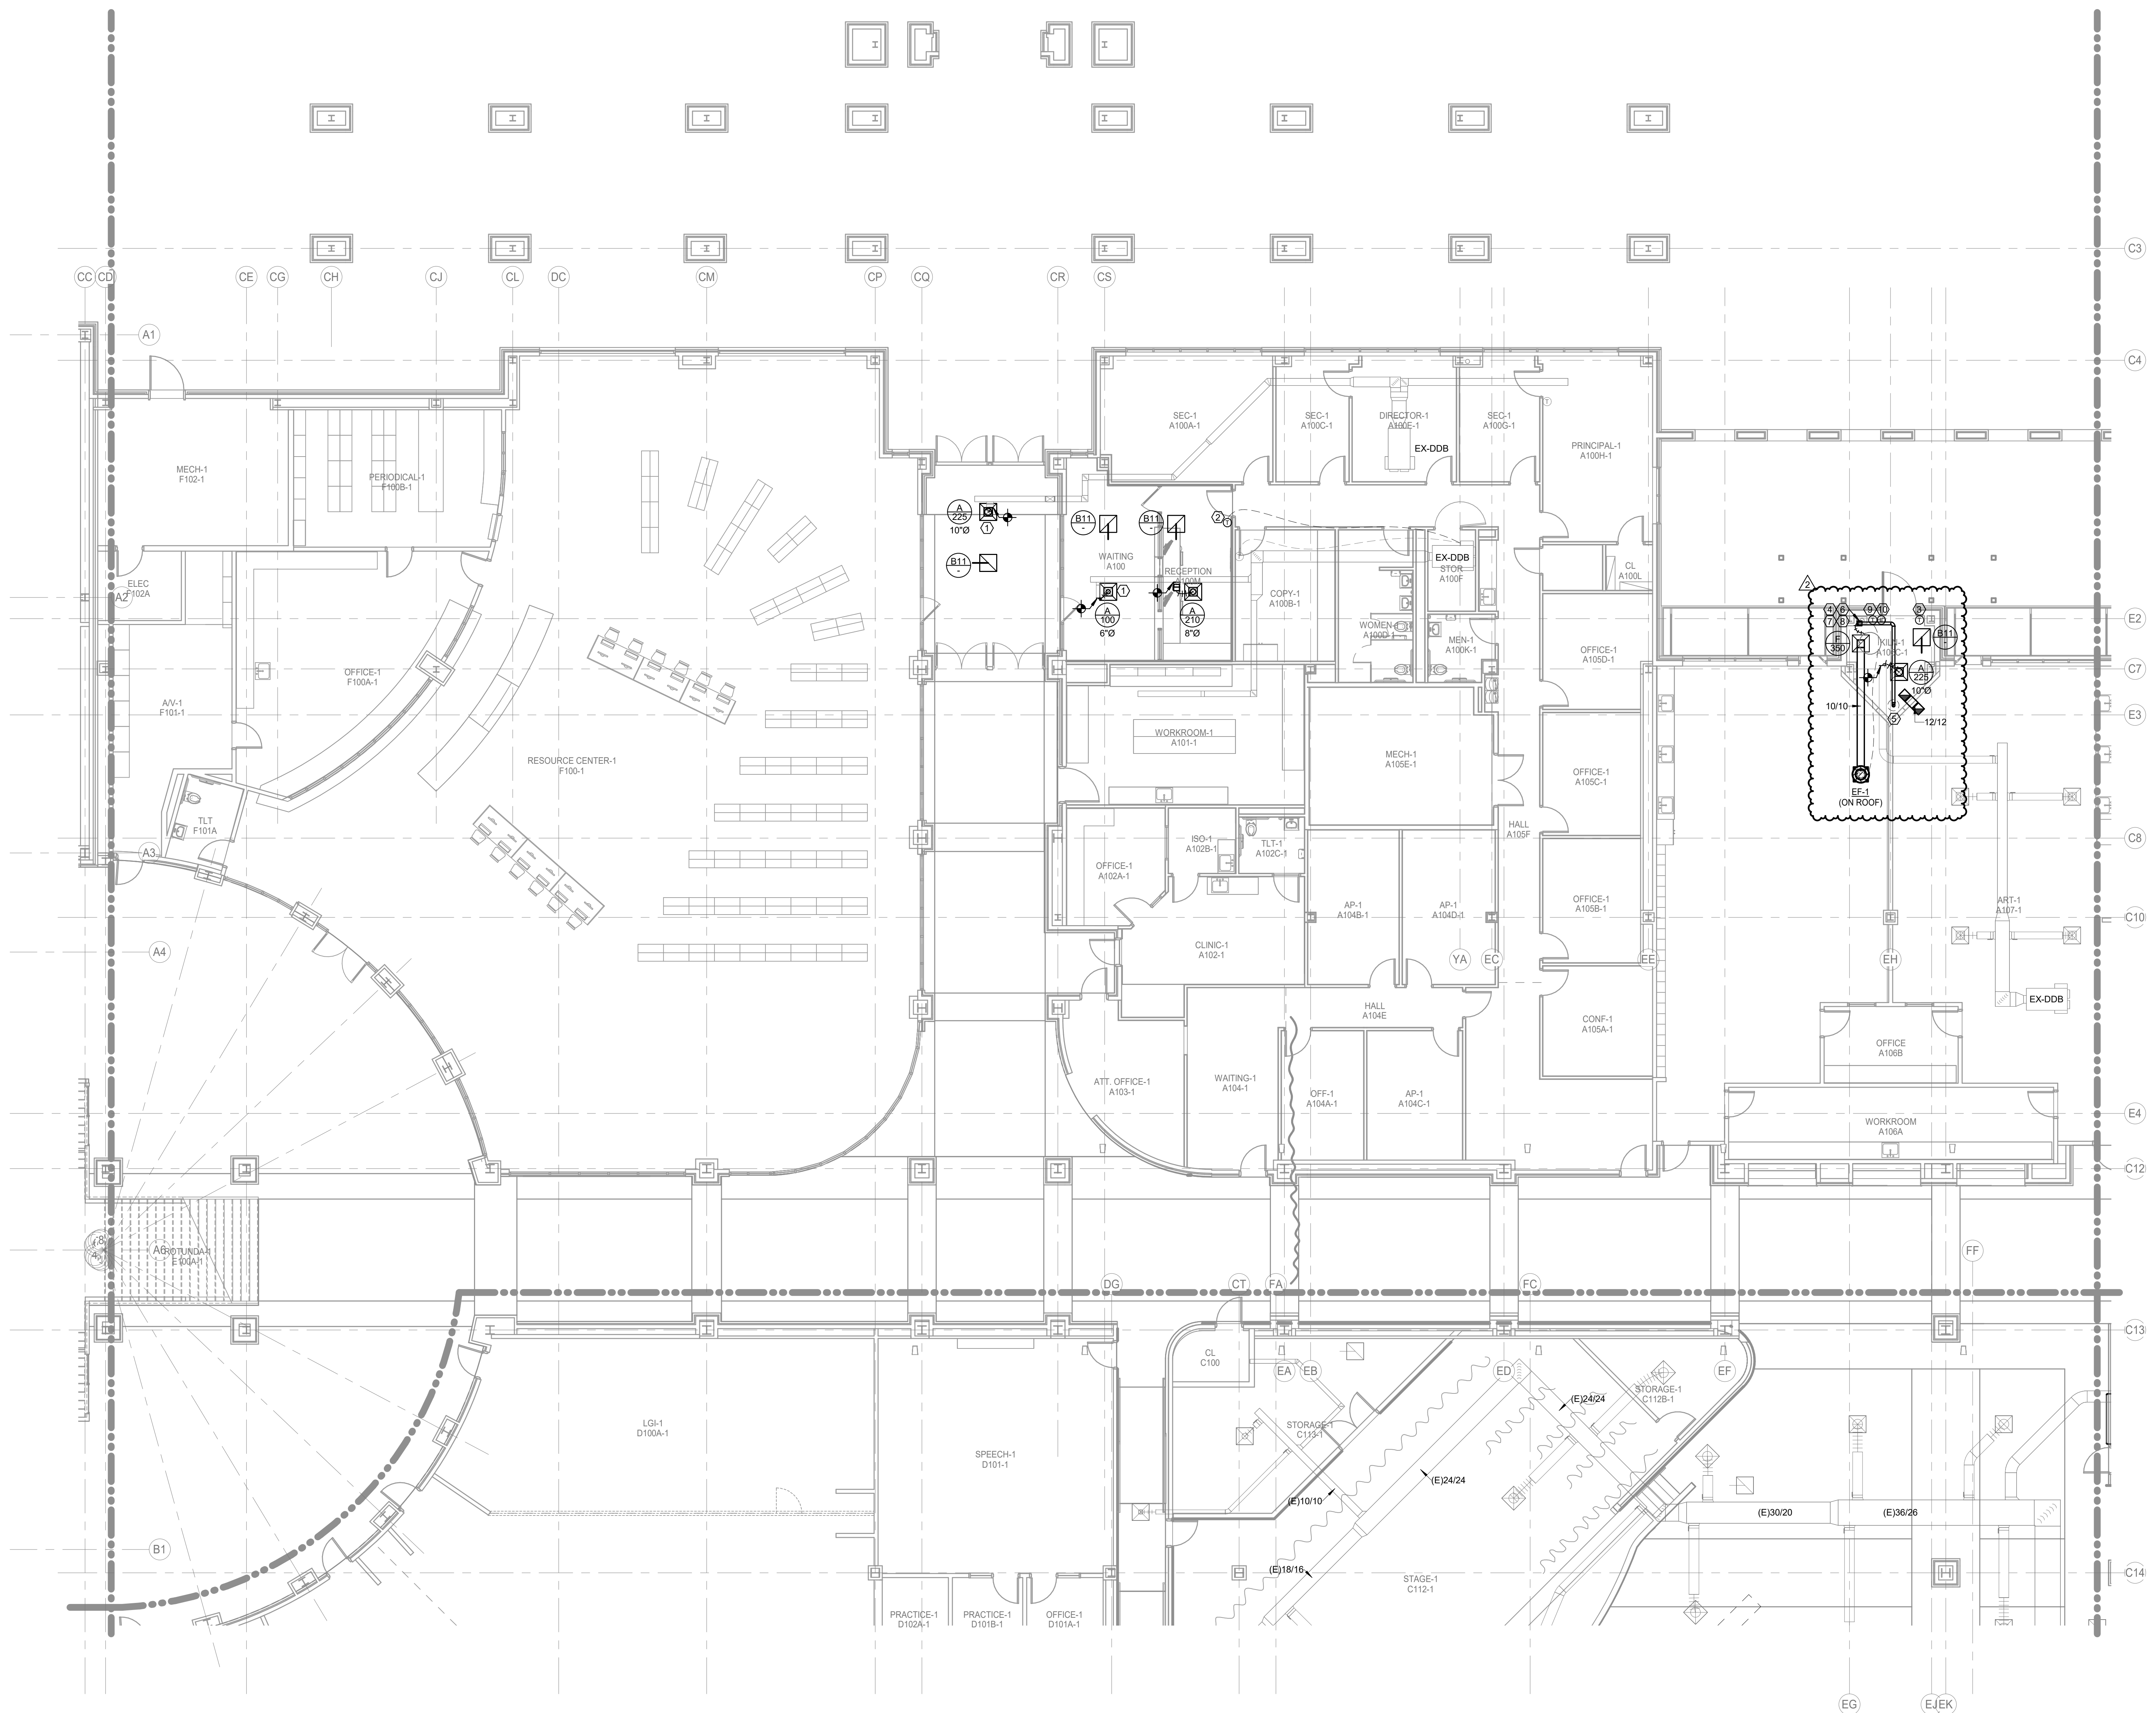

**1 MECHANICAL FLOOR PLAN - LEVEL 1 - AREA C**  
 Scale: 1/8" = 1'-0"

KEY PLAN:

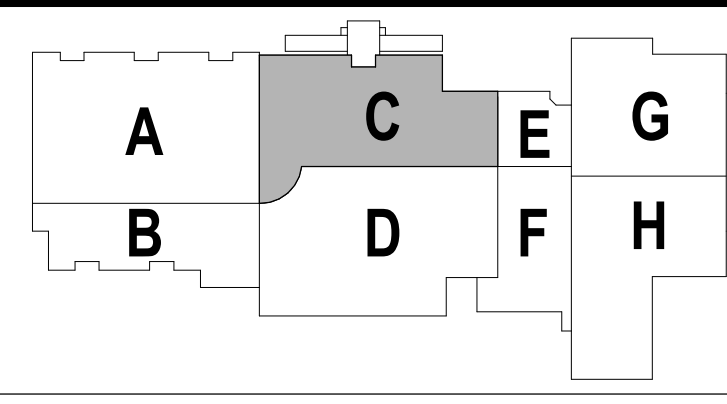

**2024 SMITH & SPILLANE MS RENOVATIONS**  
**SMITH MIDDLE SCHOOL**  
 10300 WARNER SMITH BLVD., CYPRESS, TEXAS 77433  
 CFISD PROJECT NO: 24-02-5751-R-RFP

Project Number:	23073
Date:	26 JANUARY 2025
Drawn By:	WHL / KLO

MECHANICAL FIRST FLOOR PLAN - AREA 'C'

M2.03




**NATEX CORPORATION ARCHITECTS**  
 www.natexarchitects.com  
 447 Heights Boulevard  
 Houston, TX 77007  
 Phone: 713-975-9525  
 Fax: 713-780-7824



3701 Kirby Drive, Suite 830  
 Houston, TX 77098  
 tel: 832-947-1038 fax: 282-214-5365

**CONSTRUCTION DOCUMENT**

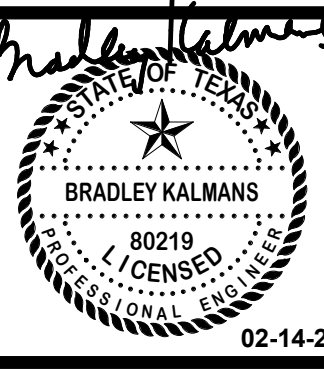

02-14-2025

**CIVIL ENGINEER**

**BROOKS AND SPARKS, INC.**  
 21020 PARK ROW  
 KATY, TX 77449  
 tel: 281-578-9595

**STRUCTURAL ENGINEER**

**DALLY + ASSOCIATES, INC.**  
 9800 RICHMOND AVE.  
 SUITE 400  
 HOUSTON, TX 77042  
 tel: 713-337-8881

**MEPT ENGINEER**

**SALAS O'BRIEN**  
 10930 W. SAM HOUSTON PKWY. N.  
 SUITE 900  
 HOUSTON, TX 77064  
 tel: 281.664.1900

**FOOD SERVICE EQUIPMENT**

**FDP**  
 25317 INTERSTATE 45  
 THE WOODLANDS, TX 77380  
 tel: 281-350-2323

**LANDSCAPE ARCHITECT**

**LANDESIGN GROUP**  
 17041 EL CAMINO REAL  
 SUITE 204  
 HOUSTON, TX 77058  
 tel: 281.486.4040

RENOVATIONS	
	POINT OF CONNECTION FROM NEW TO EXISTING
	ITEM TO REMAIN
	ITEM TO BE REMOVED

CONTRACTOR SHALL PROVIDE DEHUMIDIFICATION DURING THE CONSTRUCTION SCHEDULE. THE SCOPE IS TO MAINTAIN ACCEPTABLE HUMIDITY LEVELS WITHIN THE BUILDING. THE REMOVAL OF EXCESS HUMIDITY FROM THE AIR THROUGHOUT THE BUILDING. PROVIDE MOISTURE CONTROL RENTAL EQUIPMENT AND SOLUTION FOR PREVENTING THE LONG-TERM EFFECTS OF MOISTURE LEVEL THAT CAN DAMAGE INTERIOR BUILDING MATERIALS, BOOKS AND ELECTRONIC EQUIPMENT.


CONTRACTOR IS RESPONSIBLE TO PROVIDE ALL REQUIRED POWER GENERATING EQUIPMENT.

**GENERAL NOTES:**

- THESE CONSTRUCTION DRAWINGS ARE DIAGRAMMATIC, AND DO NOT NECESSARILY REFLECT ACTUAL DIMENSIONS. IT IS THE RESPONSIBILITY OF THE CONTRACTOR TO FIELD VERIFY ALL DIMENSIONS AND COORDINATE PLACEMENT OF ALL EQUIPMENT AND ROUTING OF ALL PIPING AND/OR DUCT SYSTEMS.
- ALL MECHANICAL SYSTEMS SHOWN ON THIS PLAN ARE FROM EXISTING DRAWINGS AND PRELIMINARY FIELD WORK. CONTRACTOR IS RESPONSIBLE FOR FIELD VERIFYING ALL LOCATIONS AND SIZES OF MECHANICAL SYSTEMS PRIOR TO THE START OF WORK.


**MECHANICAL KEYED NOTES:**

- PROVIDE NEW BYPASS PIPING AND VALVES AS SHOWN TO ALLOW FOR ISOLATING THE NEW PIPING FROM THE EXISTING HYDRONIC LOOPS. TESTING, FLUSHING, AND TREATMENT OF NEW PIPING SHALL BE PERFORMED PRIOR TO OPENING THE NEW PIPING TO THE EXISTING HYDRONIC LOOPS. PURGERS OR COMPARABLE COMPANY SHALL PROVIDE ASSISTANCE TO THE MECHANICAL CONTRACTOR TO CONFIRM FLUSHING AND CLEANING AT DESIGN SYSTEM FLOW RATES. CHEMICAL TREATMENT MANUFACTURER SHALL TEST WATER TO CONFIRM COMPLIANCE OF FLUSHING AND TREATMENT OF WATER PRIOR TO OPENING THE NEW PIPING VALVES TO THE EXISTING HYDRONIC LOOP.

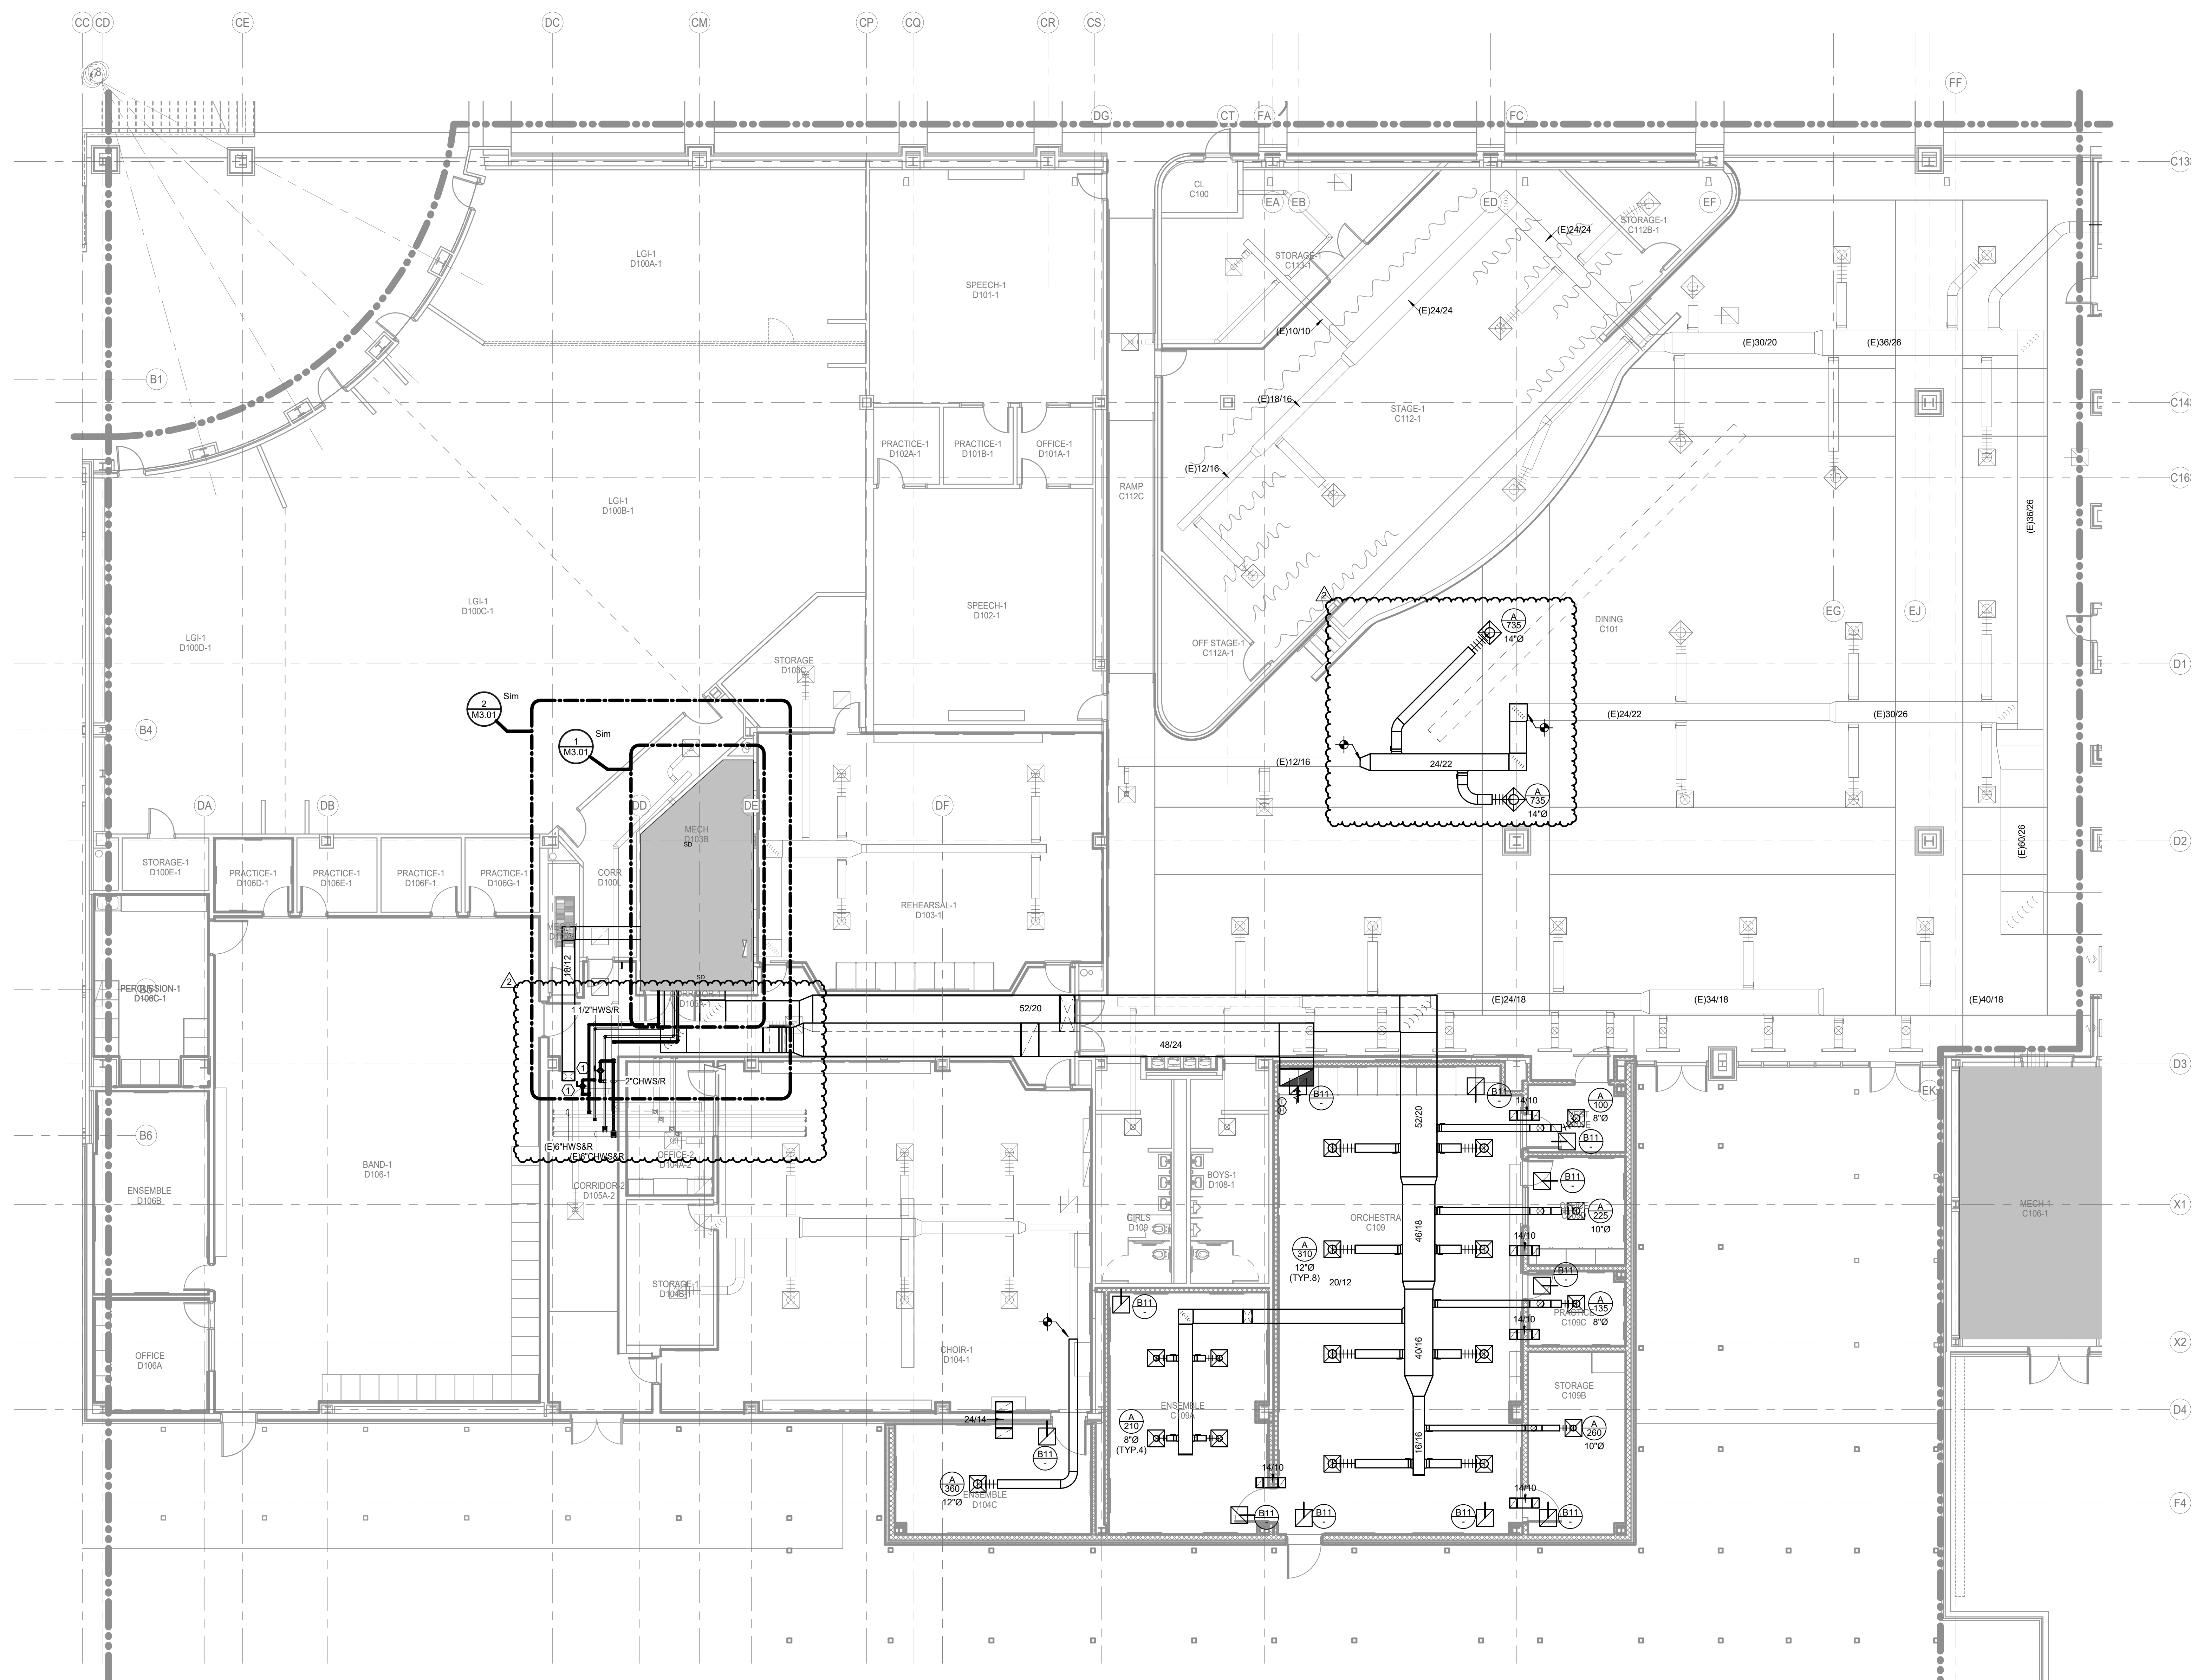

**MECHANICAL FLOOR PLAN - LEVEL 1 - AREA D**  
 Scale: 1/8" = 1'-0"

**KEY PLAN:**

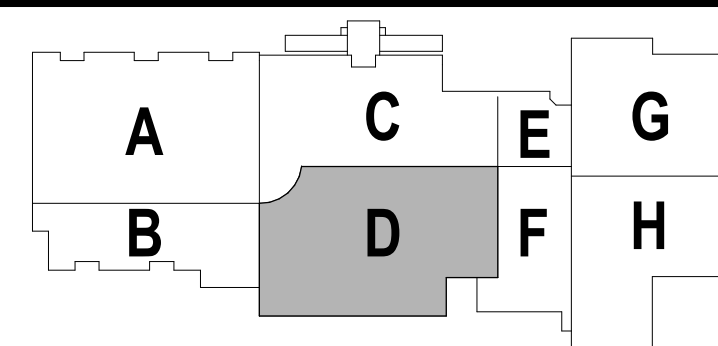


**2024 SMITH & SPILLANE MS RENOVATIONS**  
**SMITH MIDDLE SCHOOL**  
 10300 WARNER SMITH BLVD., CYPRESS, TEXAS 77433  
 CFSID PROJECT NO: 24-02-5751-R-RFP


Project Number:	23073
Date:	26 JANUARY 2025
Drawn By:	WHL / KLO

**MECHANICAL FIRST FLOOR PLAN - AREA 'D'**


**M2.04**

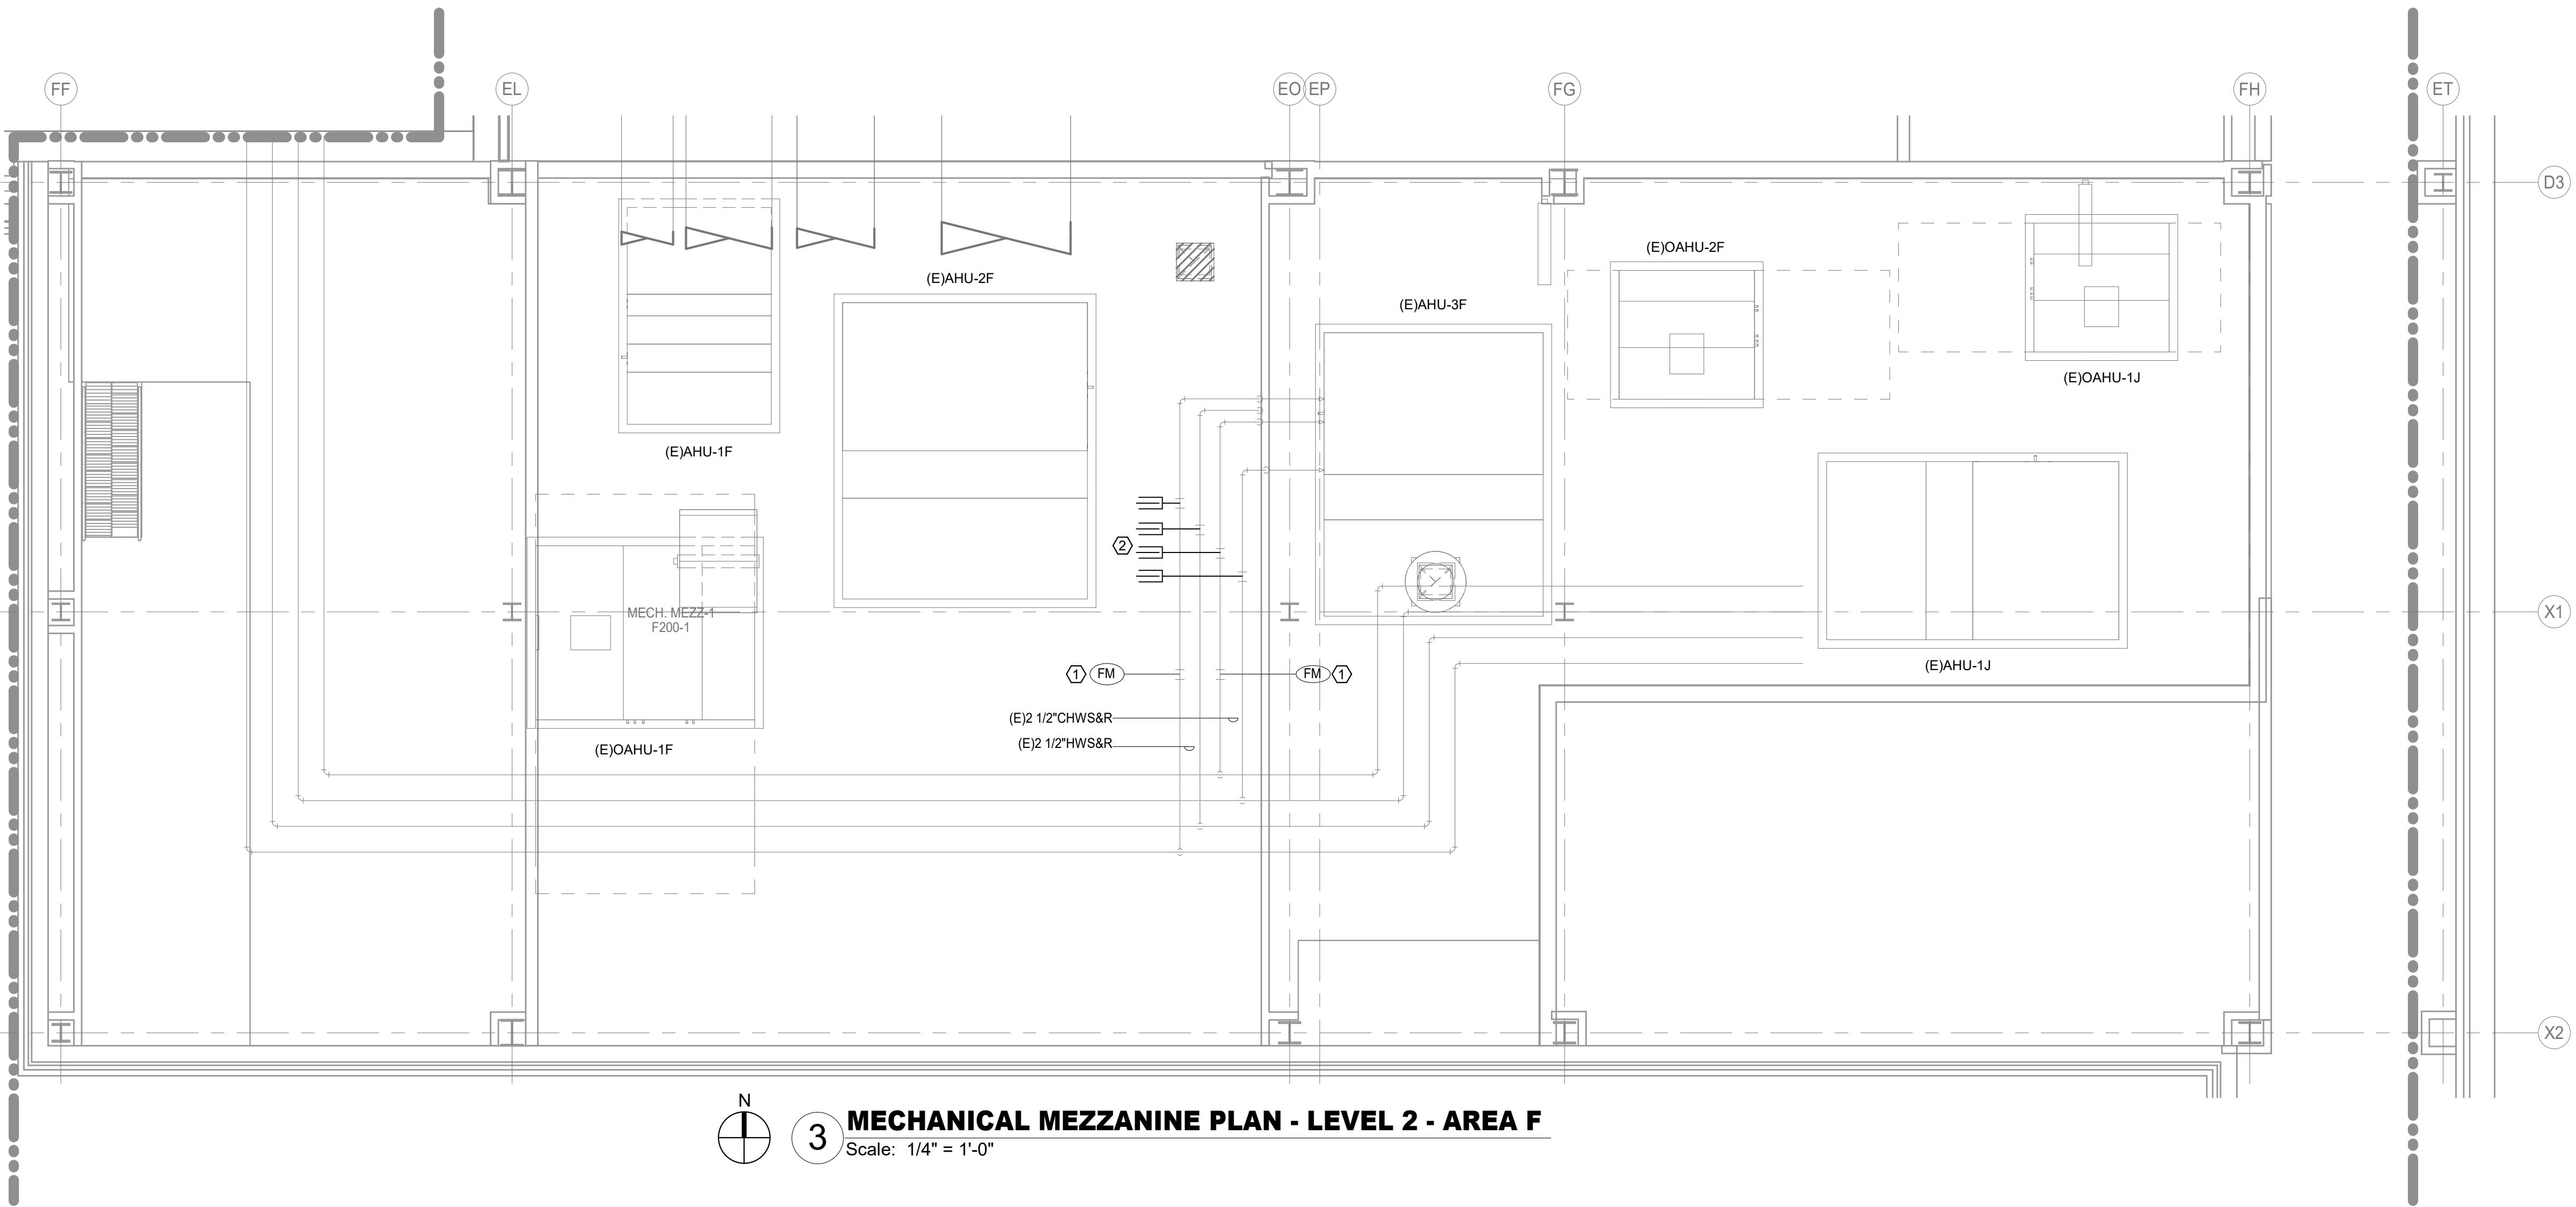

**3 MECHANICAL MEZZANINE PLAN - LEVEL 2 - AREA F**  
Scale: 1/4" = 1'-0"

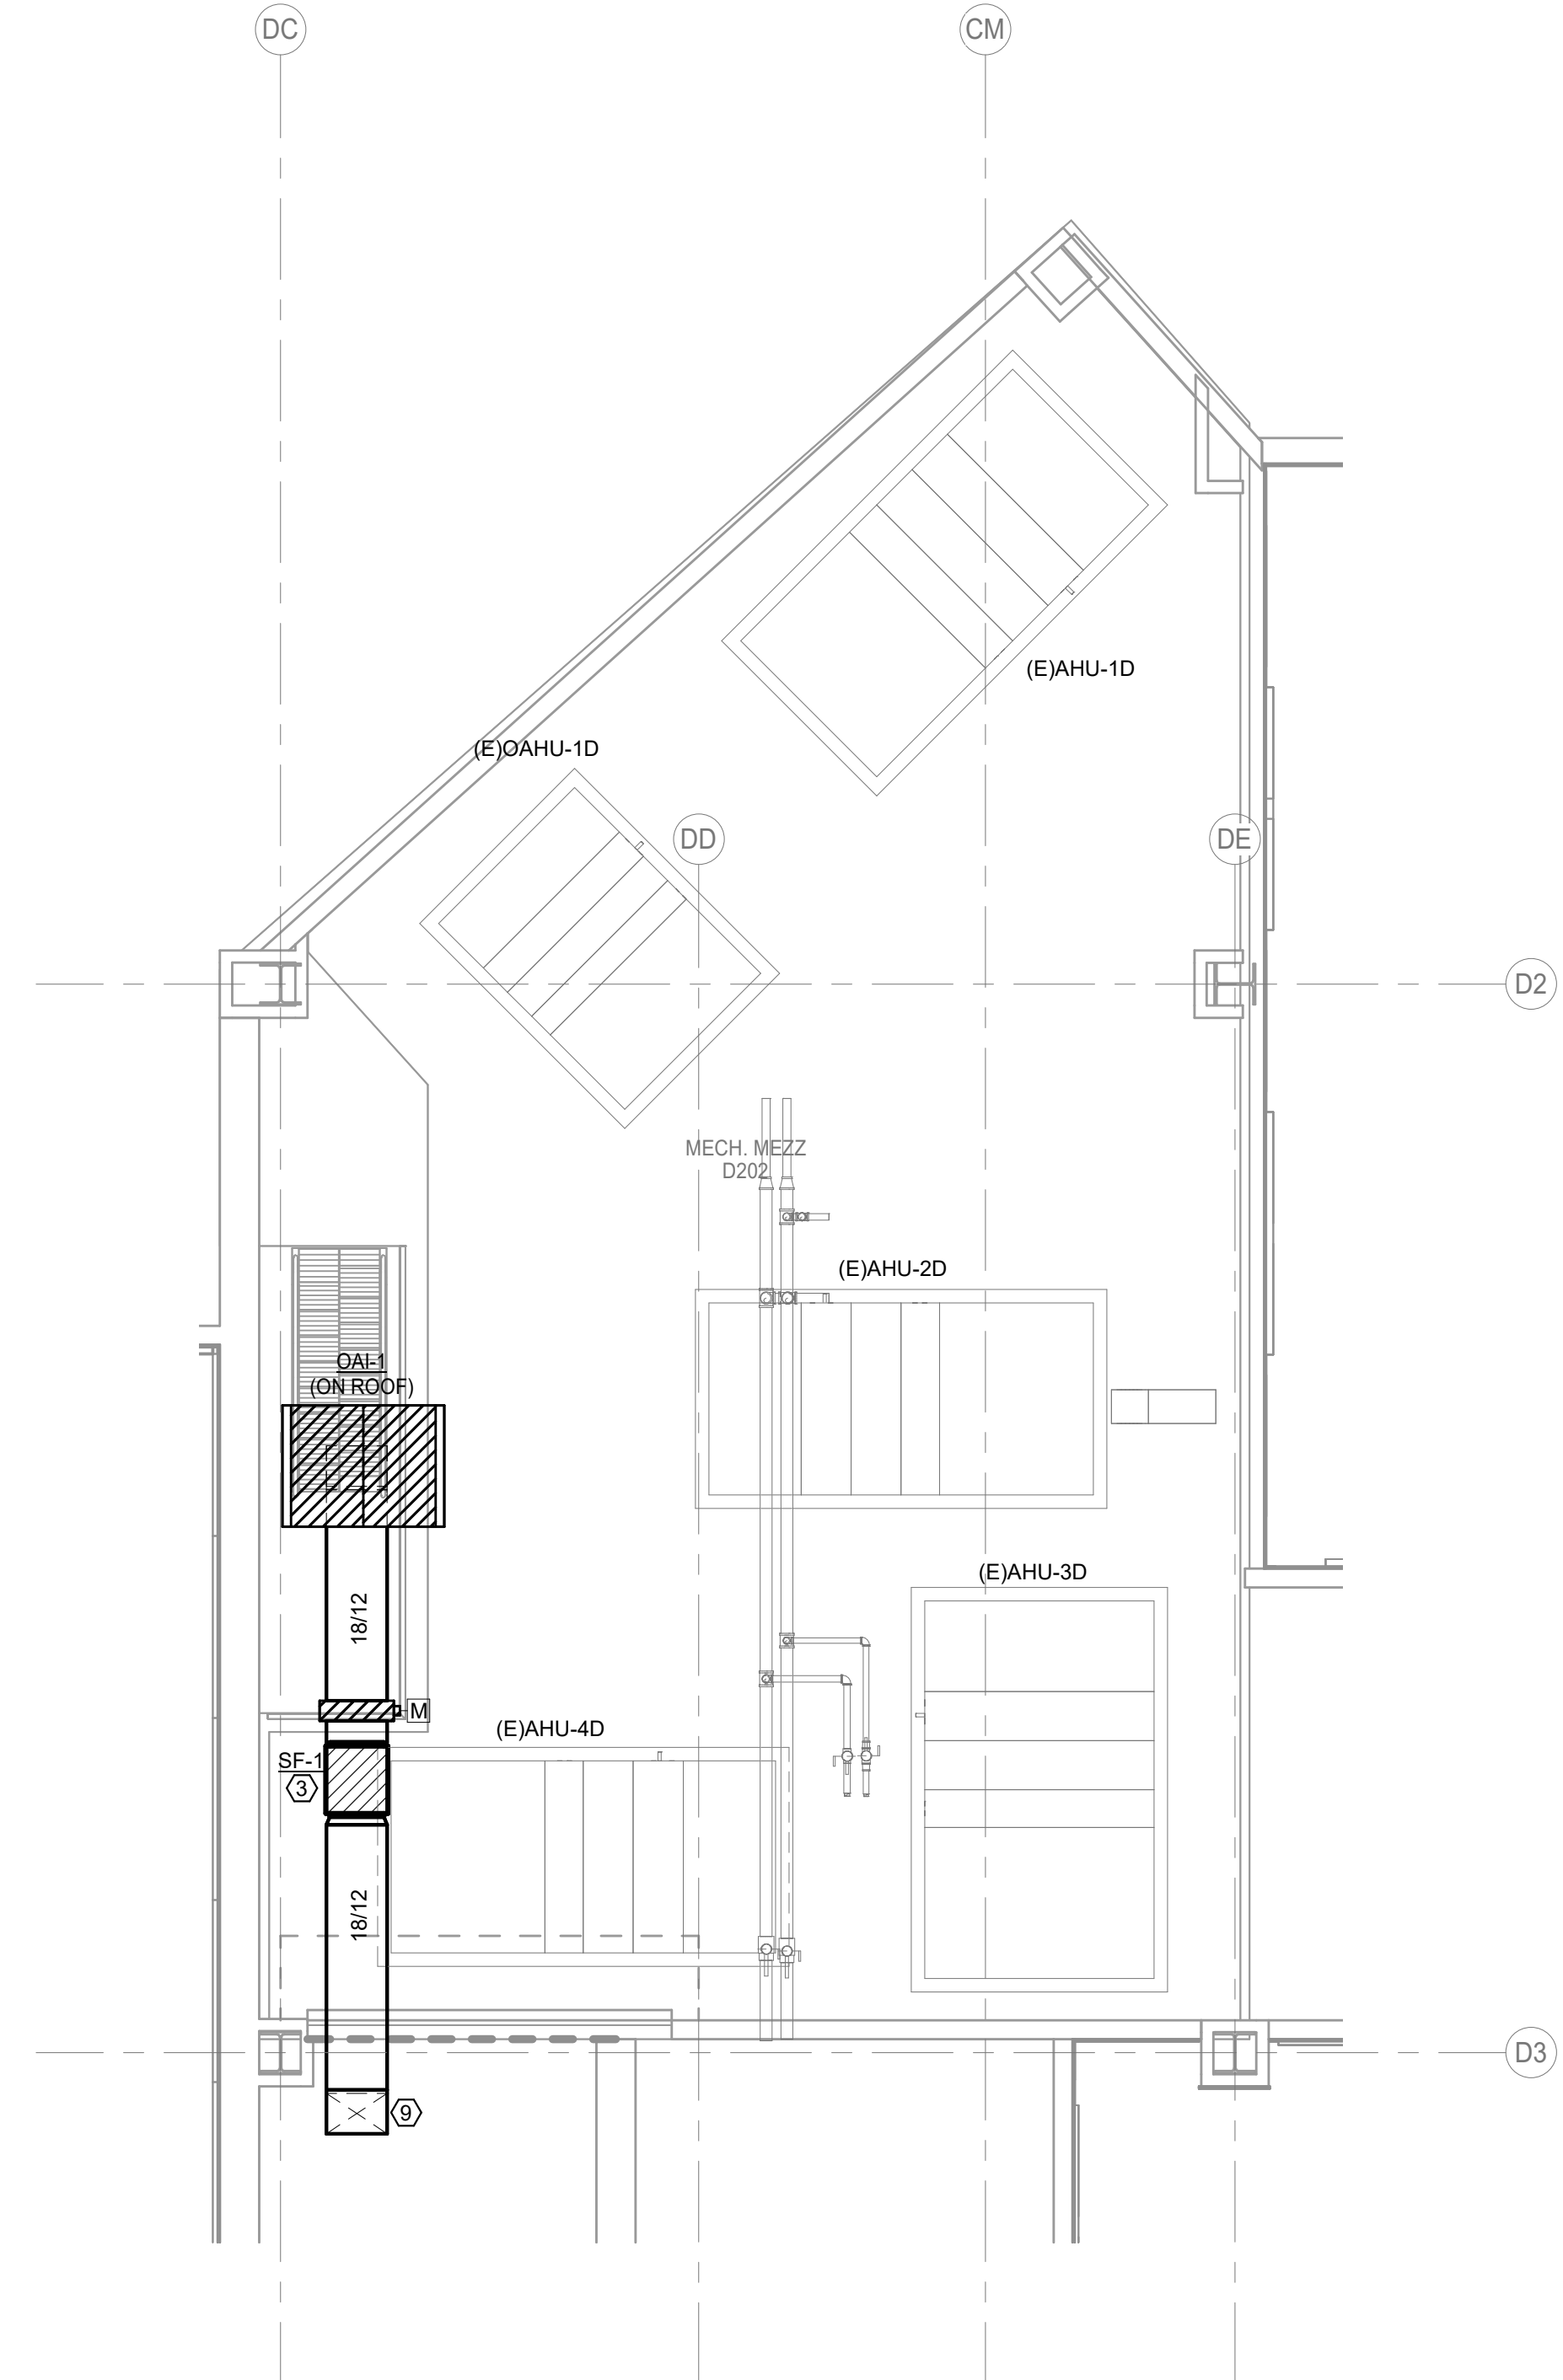

**2 MECHANICAL ENLARGED PLAN - LEVEL 2 - MECH MEZZ**  
Scale: 1/4" = 1'-0"

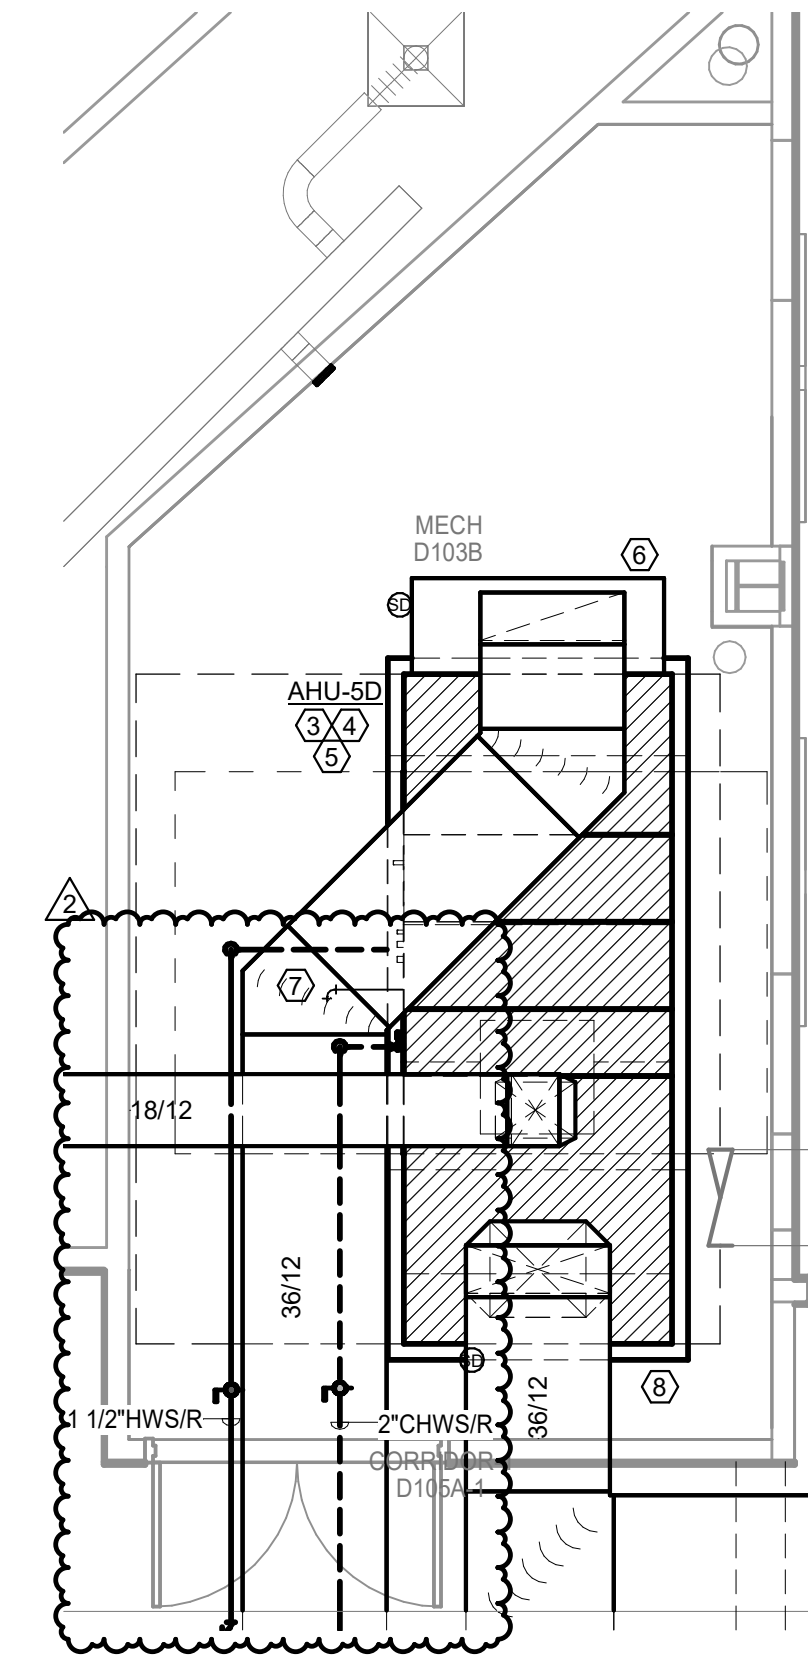

**1 MECHANICAL ENLARGED PLAN - LEVEL 1 - MECH D103B**  
Scale: 1/4" = 1'-0"

**RENOVATIONS**

➔	POINT OF CONNECTION FROM NEW TO EXISTING
□	ITEM TO REMAIN
⊠	ITEM TO BE REMOVED

CONTRACTOR SHALL PROVIDE DEHUMIDIFICATION DURING THE CONSTRUCTION SCHEDULE. THE SCOPE IS TO MAINTAIN ACCEPTABLE HUMIDITY LEVELS WITHIN THE BUILDING. THE REMOVAL OF EXCESS HUMIDITY FROM THE AIR THROUGHOUT THE BUILDING. PROVIDE MOISTURE CONTROL RENTAL EQUIPMENT AND SOLUTION FOR PREVENTING THE LONG-TERM EFFECTS OF MOISTURE LEVEL THAT CAN DAMAGE INTERIOR BUILDING MATERIALS, BOOKS AND ELECTRONIC EQUIPMENT.

CONTRACTOR IS RESPONSIBLE TO PROVIDE ALL REQUIRED POWER GENERATING EQUIPMENT.

**GENERAL NOTES:**

1. THESE CONSTRUCTION DRAWINGS ARE DIAGRAMMATIC, AND DO NOT NECESSARILY REFLECT ACTUAL DIMENSIONS. IT IS THE RESPONSIBILITY OF THE CONTRACTOR TO FIELD-VERIFY ALL DIMENSIONS AND COORDINATE PLACEMENT OF ALL EQUIPMENT AND ROUTING OF ALL PIPING AND/OR DUCT SYSTEMS.
2. ALL MECHANICAL SYSTEMS SHOWN ON THIS PLAN ARE FROM EXISTING DRAWINGS AND PRELIMINARY FIELD WORK. CONTRACTOR IS RESPONSIBLE FOR FIELD VERIFYING ALL LOCATIONS AND SIZES OF MECHANICAL SYSTEMS PRIOR TO THE START OF WORK.

**MECHANICAL KEYED NOTES:**

- ① PROVIDE AND INSTALL FLOW METER IN CHILLED/HOT WATER SUPPLY PIPING TO BE USED IN CALCULATING AND LOGGING THE KITCHEN BTUH USAGE THROUGH THE BMS. METER SHALL BE INSTALLED PER MANUFACTURER'S REQUIREMENTS. REINSULATE PIPING AFTER INSTALLATION IS COMPLETE.
- ② PROVIDE AND INSTALL CHILLED/HOT WATER SUPPLY AND RETURN TEMPERATURE SENSORS TO BE USED IN CALCULATING AND LOGGING THE KITCHEN BTUH USAGE THROUGH THE BMS. REINSULATE PIPING AFTER INSTALLATION IS COMPLETE.
- ③ VERIFY SERVICE CLEARANCE WITH EQUIPMENT MANUFACTURER. COORDINATE WITH ALL TRADES NOT TO OBSTRUCT.
- ④ VERIFY SERVICE CLEARANCE FOR AIR FILTER REMOVAL WITH EQUIPMENT MANUFACTURER. COORDINATE WITH ALL TRADES NOT TO OBSTRUCT.
- ⑤ VERIFY SERVICE CLEARANCE FOR FAN SHAFT AND COIL REMOVAL WITH EQUIPMENT MANUFACTURER. COORDINATE WITH ALL TRADES NOT TO OBSTRUCT.
- ⑥ SHEET METAL PLENUM. FULL SIZE OF UNIT RETURN AIR OPENING. LENGTH AS REQUIRED FOR ALL DUCT CONNECTIONS SHOWN.
- ⑦ ROUTE FULL SIZE CONDENSATE DRAIN PIPE TO NEW FLOOR DRAIN LOCATED IN MECHANICAL ROOM.
- ⑧ PROVIDE 4" THICK CONCRETE HOUSEKEEPING PAD.
- ⑨ ROUTE DUCTWORK DOWN TO LEVEL 1 PLENUM SPACE AND TO AHU-50(A) IN MECHANICAL ROOM.

**Salas O'Brien**  
salasobrien.com 281-664-1900  
Houston 10930 W. Sam Houston Pkwy North, Suite 900 Houston, TX 77064  
Registration: F-4111 Project No: 2024-0209-00

**NATEX CORPORATION ARCHITECTS**  
www.natexarchitects.com  
447 Heights Boulevard Houston, TX 77007 Phone: 713-975-9525 Fax: 713-780-7824

**Coleman Partners ARCHITECTS**  
cpa.com  
3701 Kirby Drive, Suite 830 Houston, TX 77098 tel: 832.947.1038 fax: 282.214.5365

**CONSTRUCTION DOCUMENT**

**BRADLEY KALMANS**  
80219  
CEN  
02-14-2025

**CIVIL ENGINEER BROOKS AND SPARKS, INC.**  
21020 PARK ROW KATY, TX 77449 tel: 281.578.9595

**STRUCTURAL ENGINEER DALLY + ASSOCIATES, INC.**  
9800 RICHMOND AVE. SUITE 400 HOUSTON, TX 77042 tel: 713.337.8881

**MEPT ENGINEER SALAS O'BRIEN**  
10930 W. SAM HOUSTON PKWY. N. SUITE 900 HOUSTON, TX 77064 tel: 281.664.1900

**FOOD SERVICE EQUIPMENT FDP**  
25317 INTERSTATE 45 THE WOODLANDS, TX 77380 tel: 281.350.2323

**LANDSCAPE ARCHITECT LANDESIGN GROUP**  
17041 EL CAMINO REAL SUITE 204 HOUSTON, TX 77058 tel: 281.486.4040


**2024 SMITH & SPILLANE MS RENOVATIONS**  
**SMITH MIDDLE SCHOOL**  
10300 WARNER SMITH BLVD., CYPRESS, TEXAS 77433  
CFISD PROJECT NO: 24-02-5751-R-RFP

Project Number:	23073
Date:	26 JANUARY 2025
Drawn By:	WHL / KLO


MECHANICAL ENLARGED FLOOR PLAN

**M3.01**




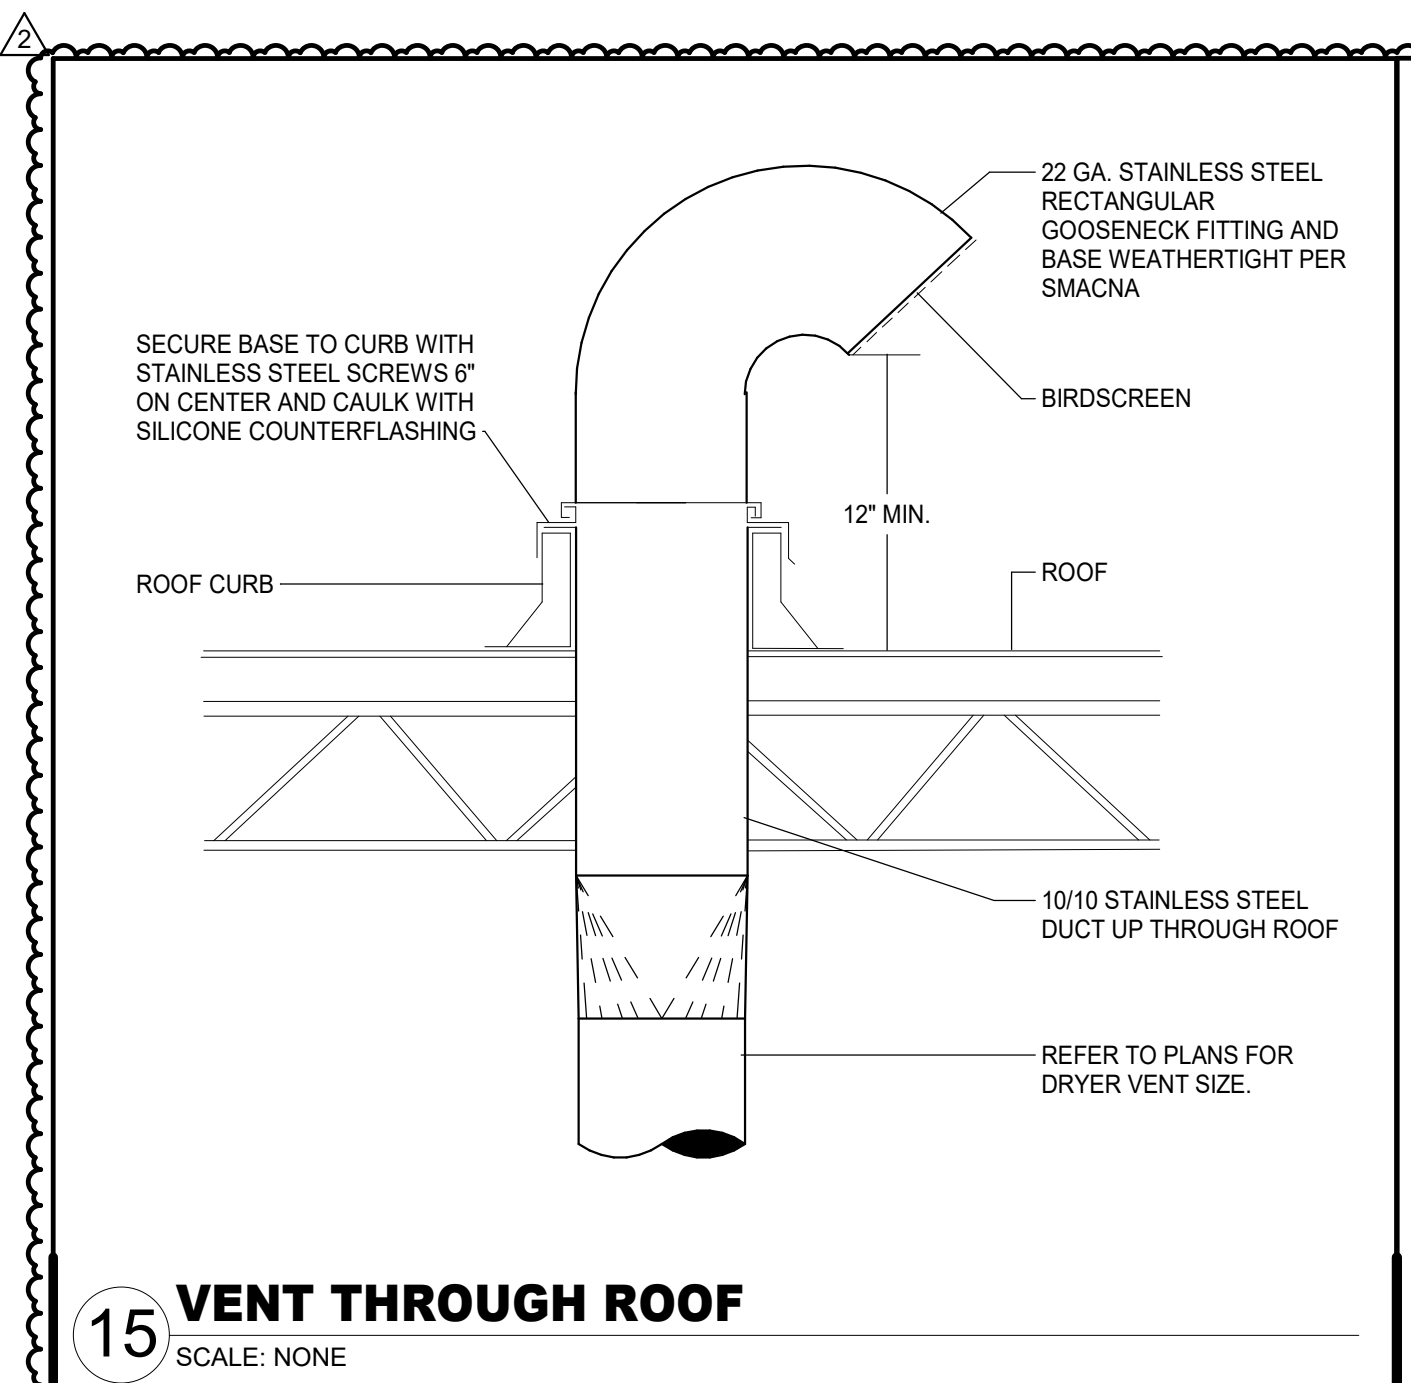


15 VENT THROUGH ROOF  
SCALE: NONE

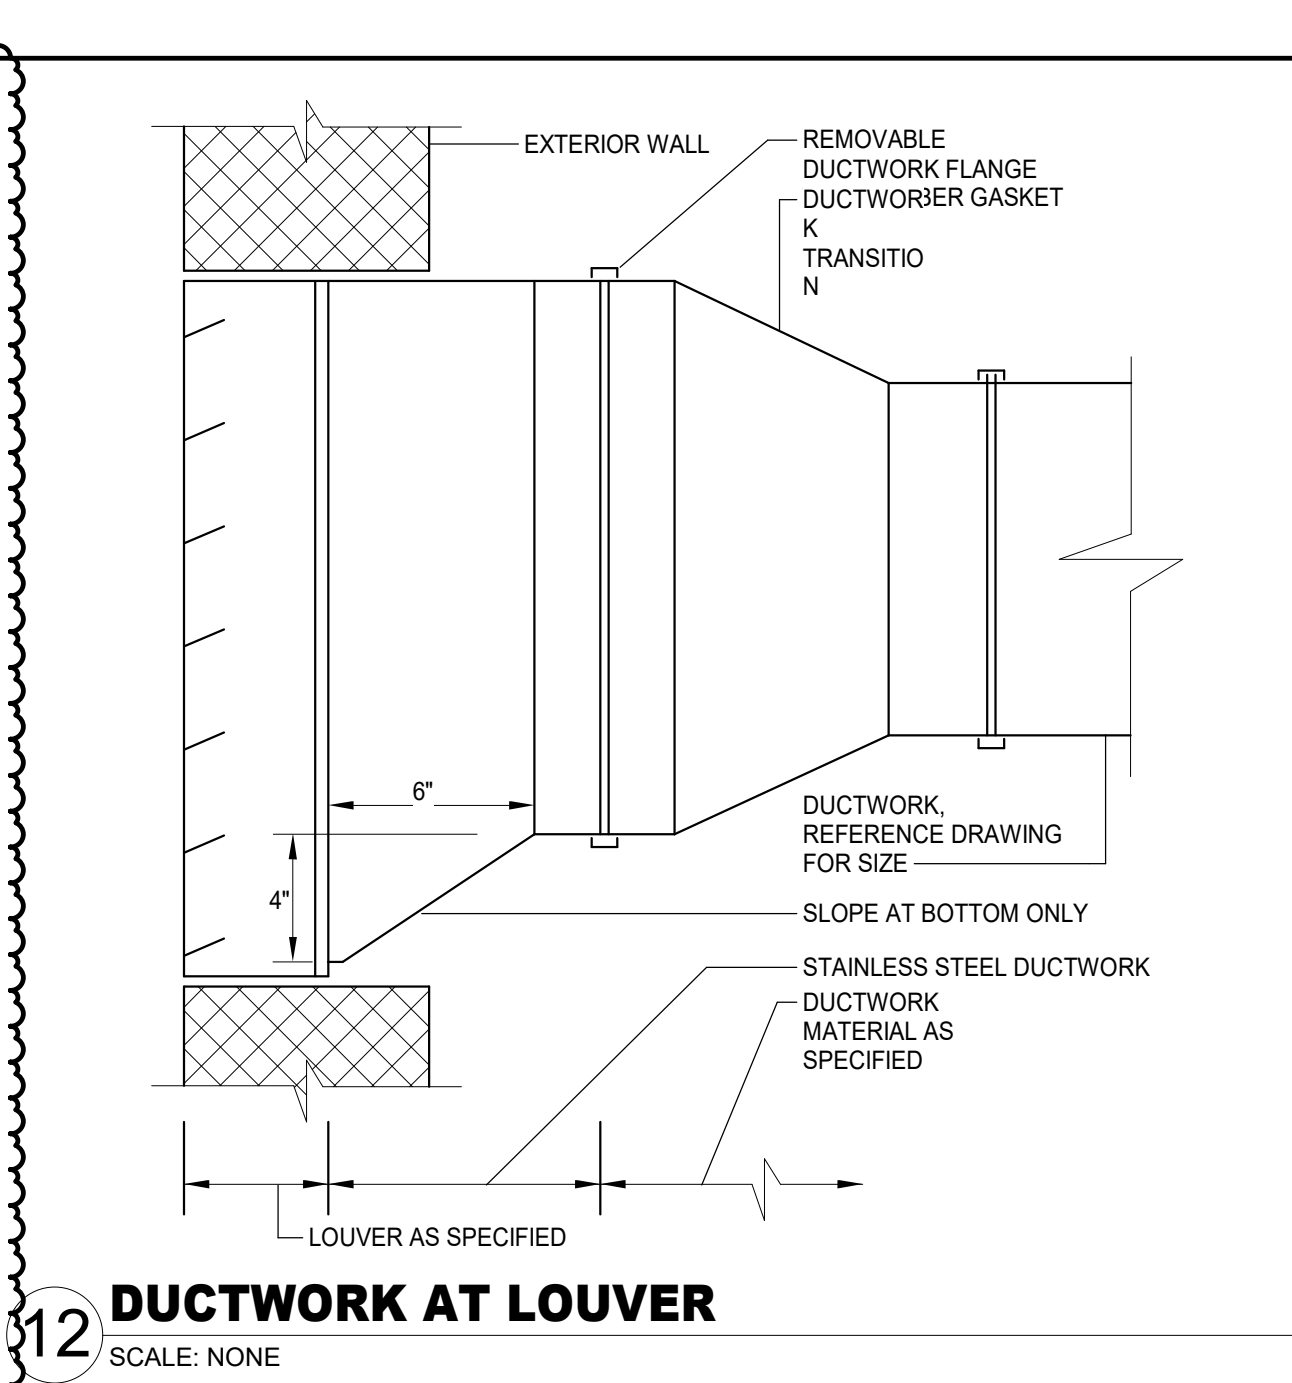



12 DUCTWORK AT LOUVER  
SCALE: NONE

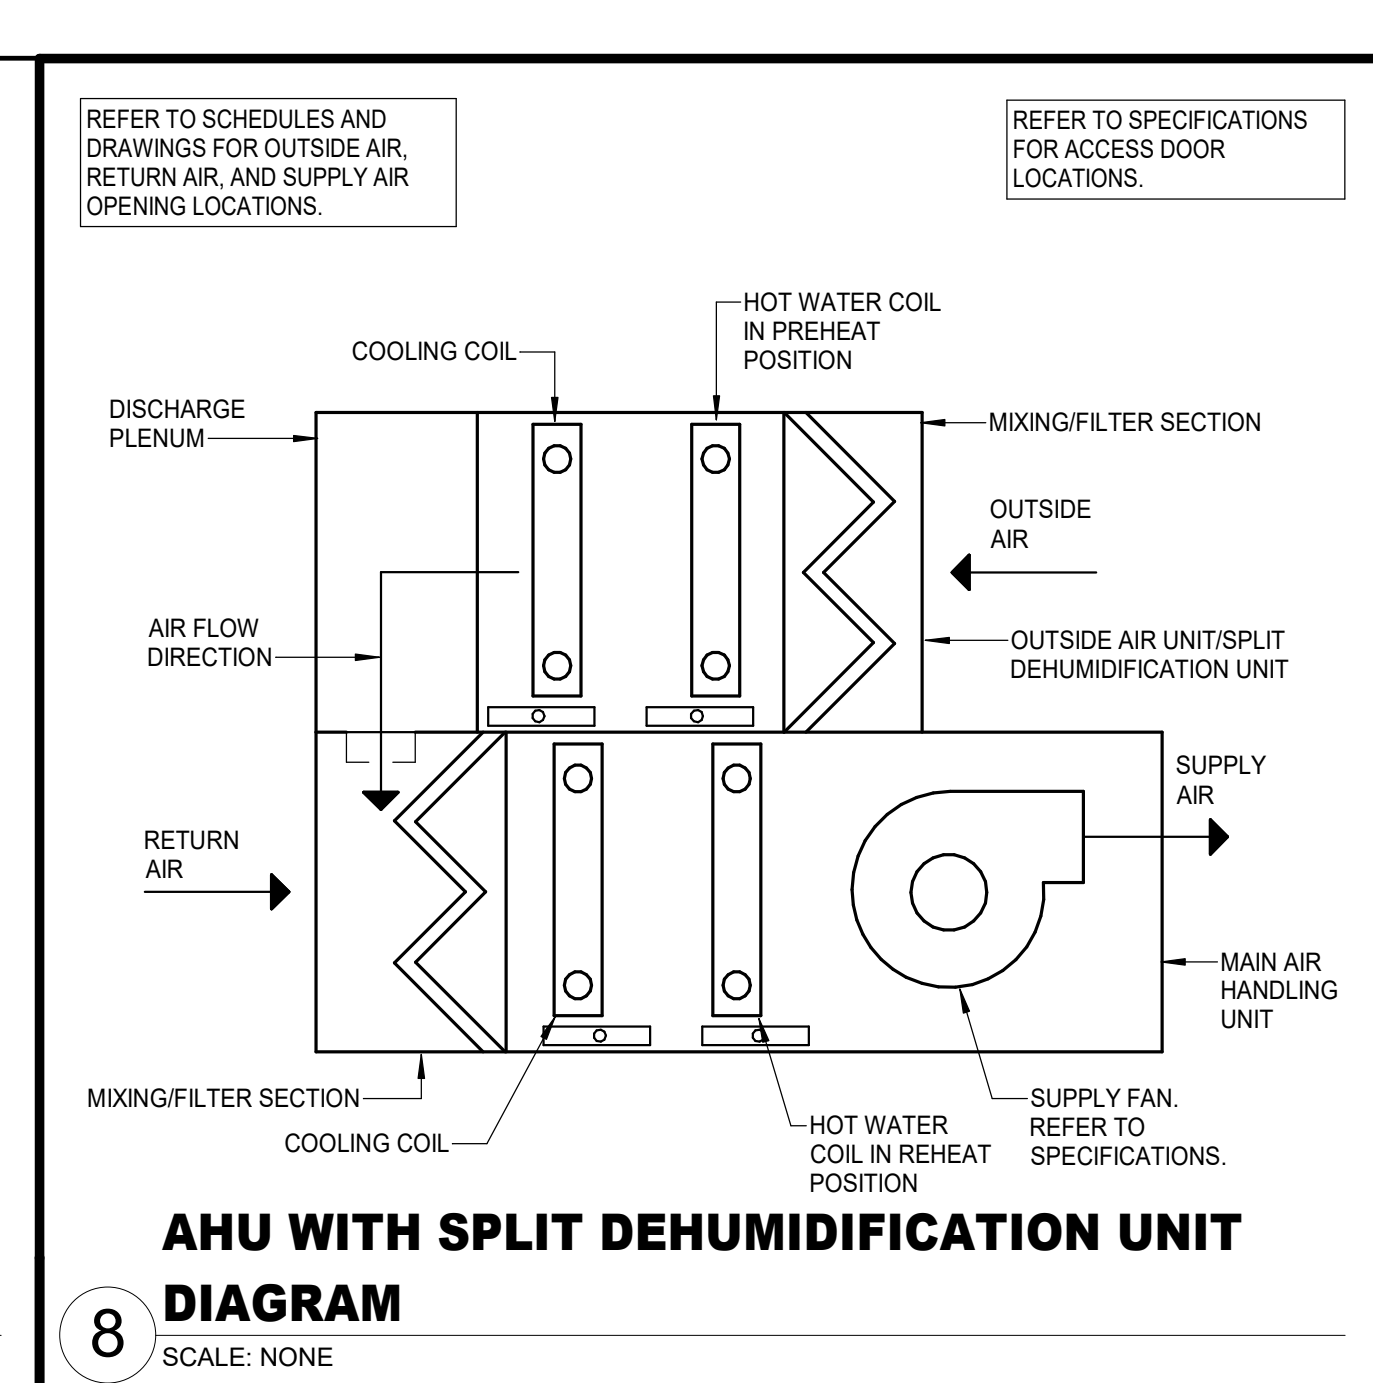


8 AHU WITH SPLIT DEHUMIDIFICATION UNIT  
SCALE: NONE

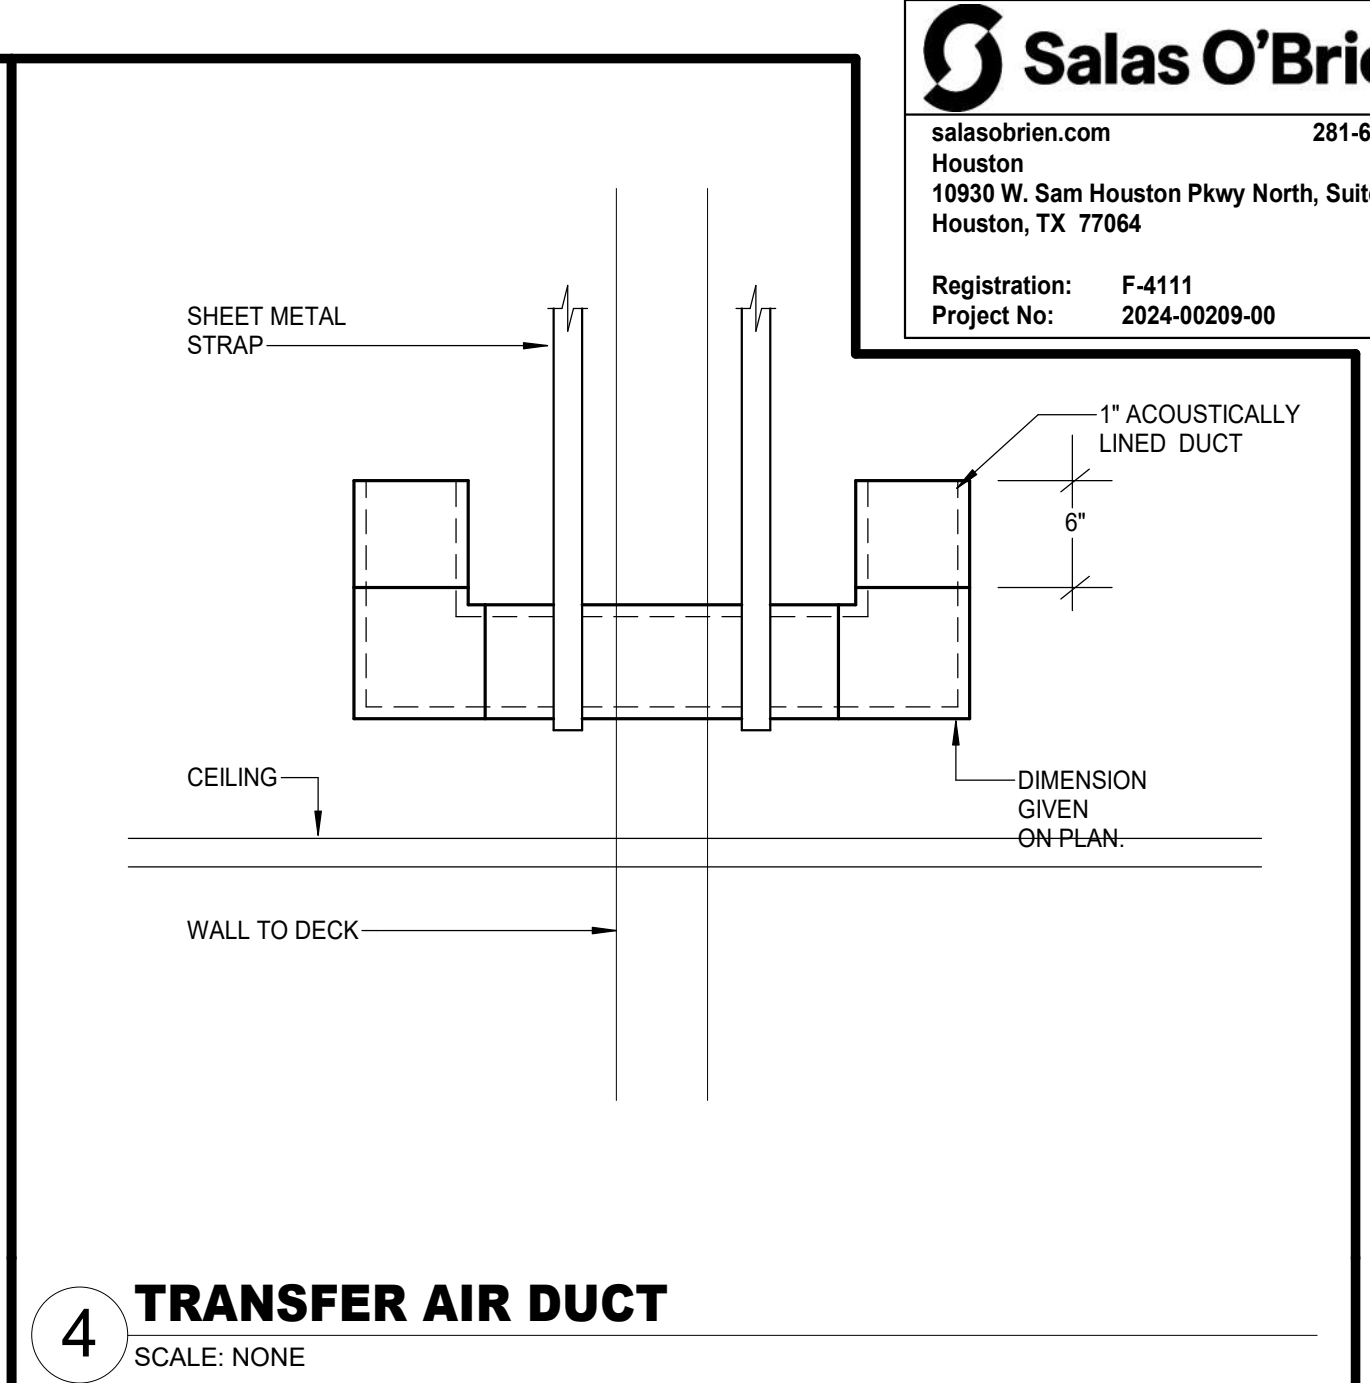


4 TRANSFER AIR DUCT  
SCALE: NONE

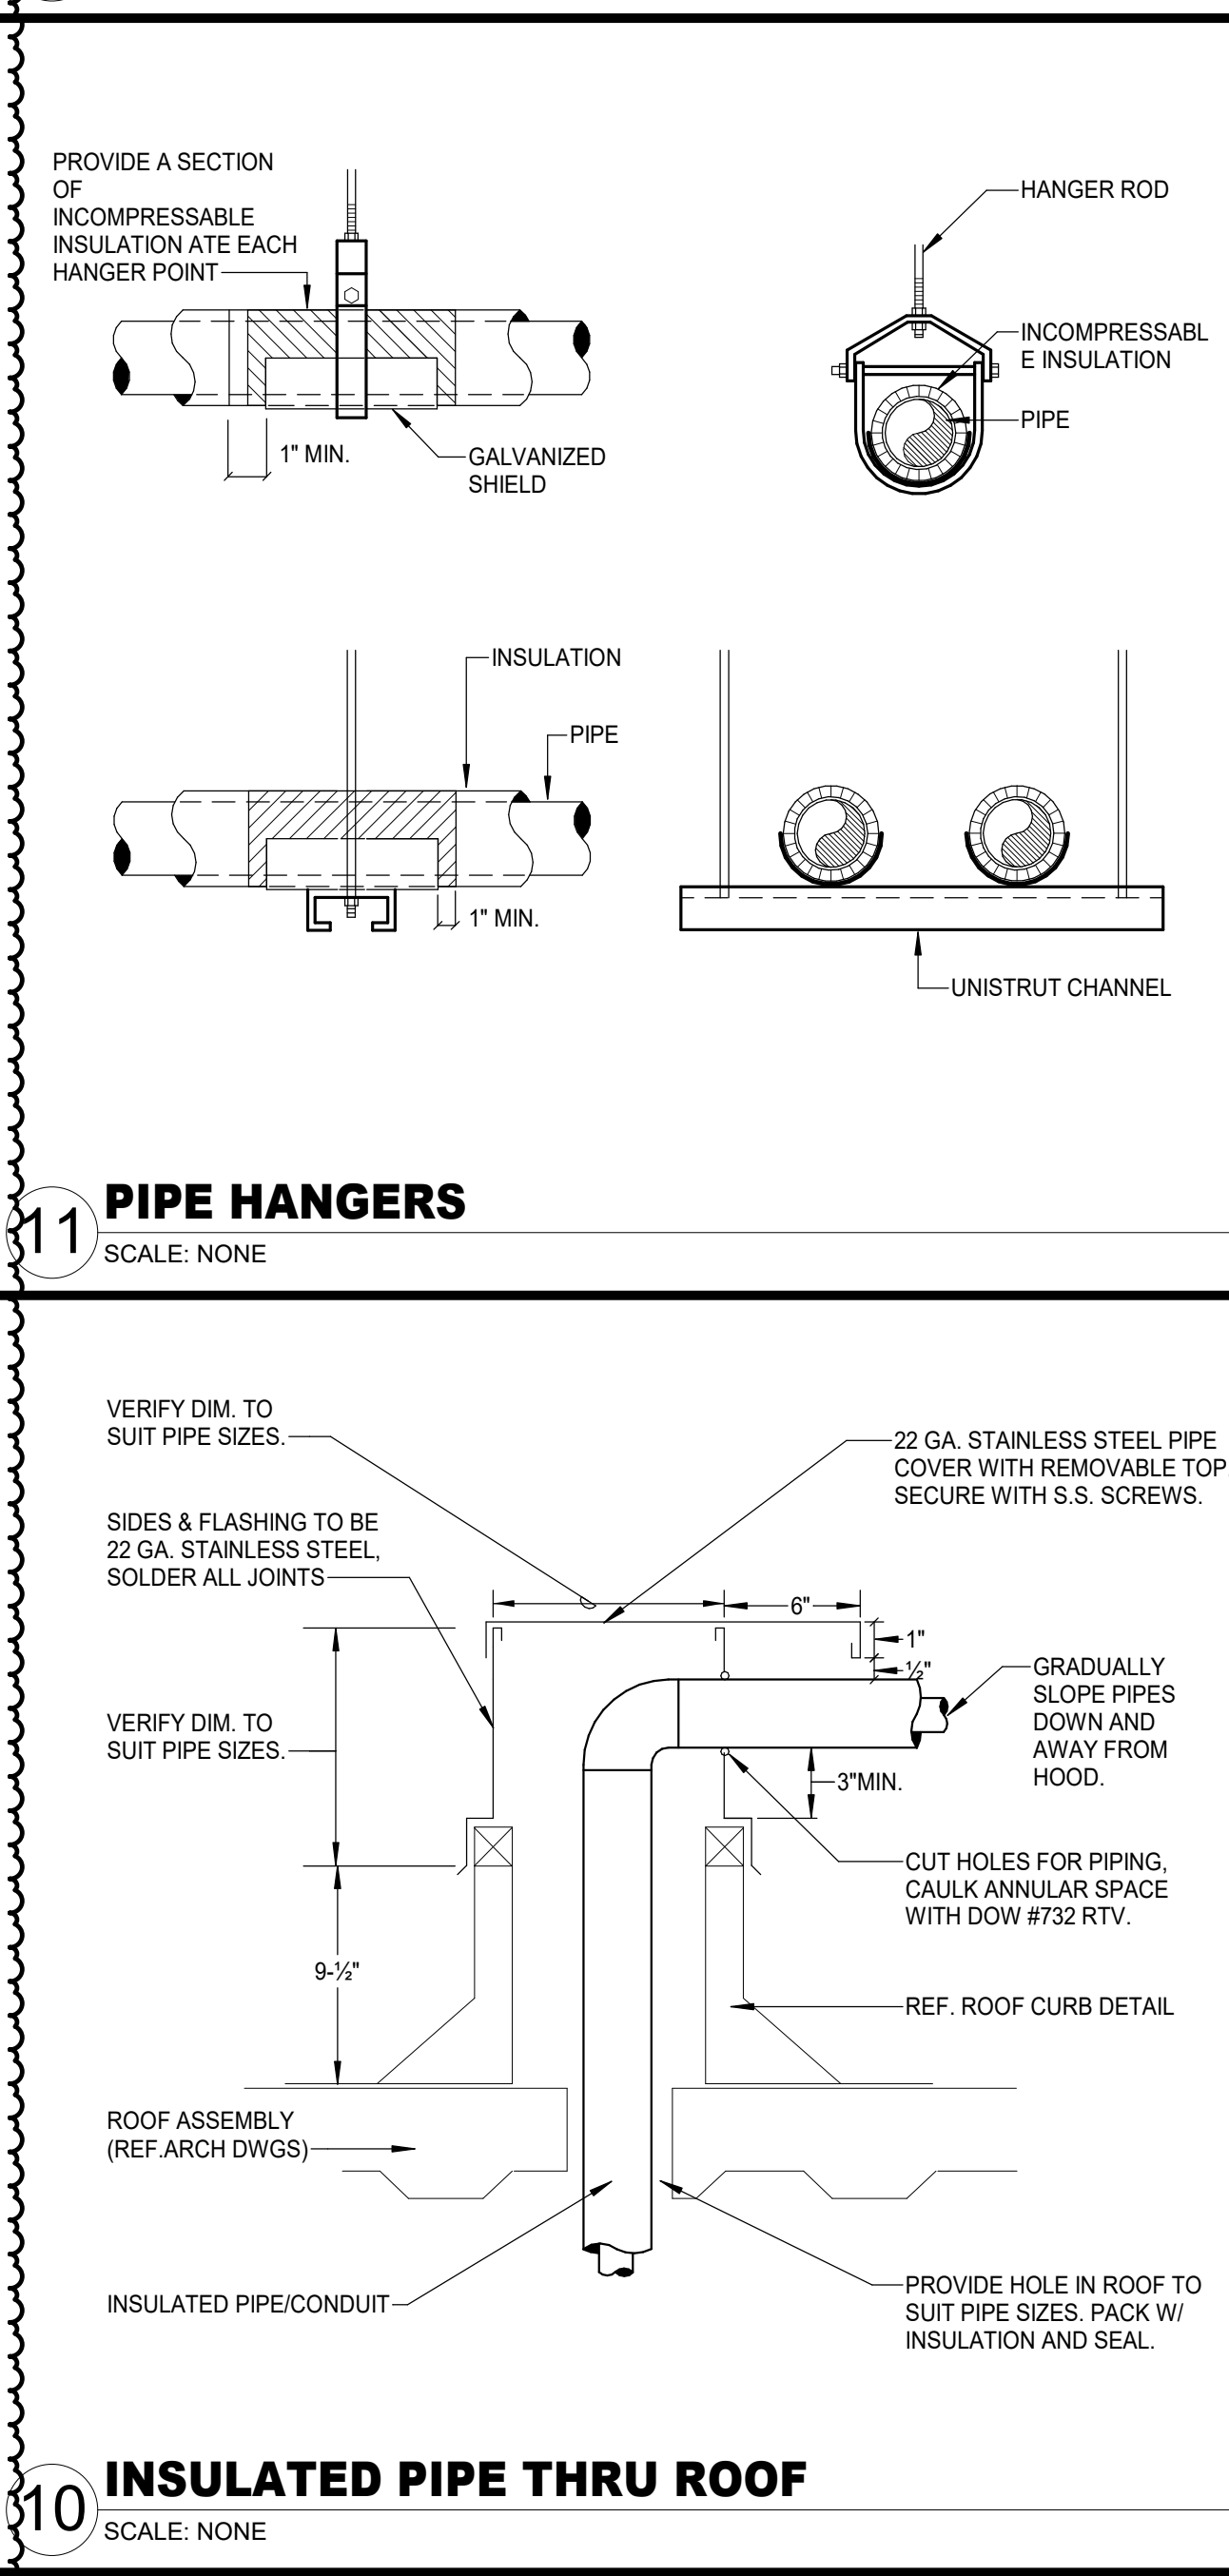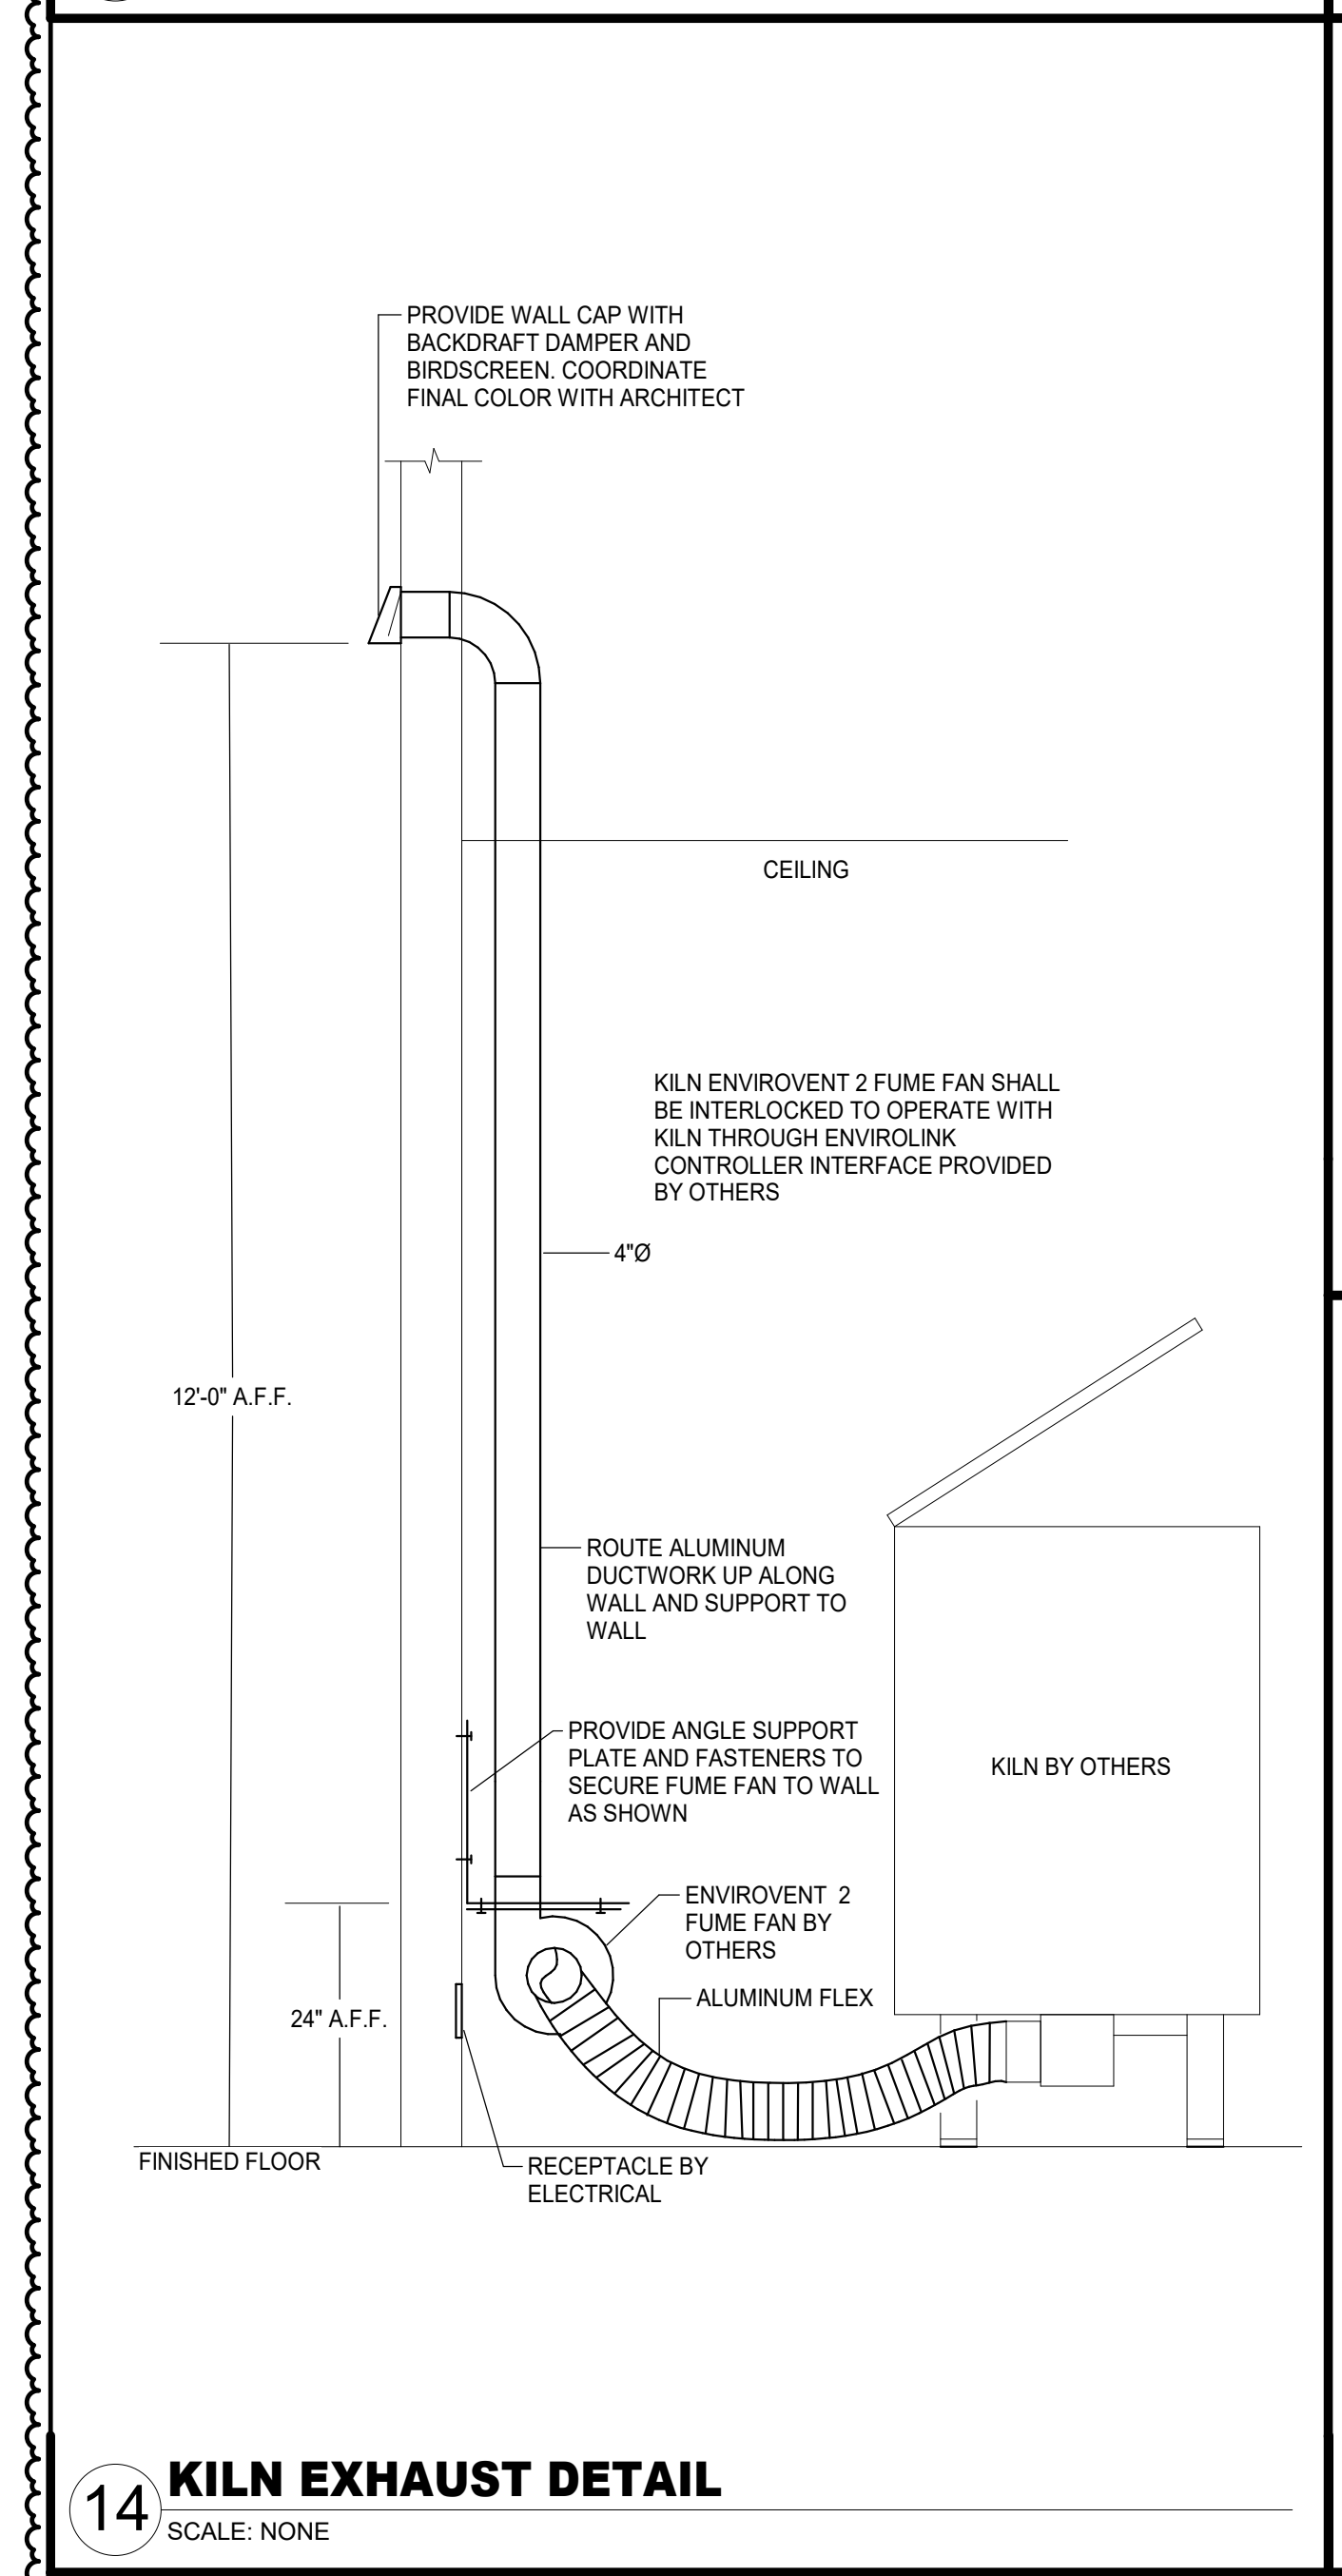


10 INSULATED PIPE THRU ROOF  
SCALE: NONE

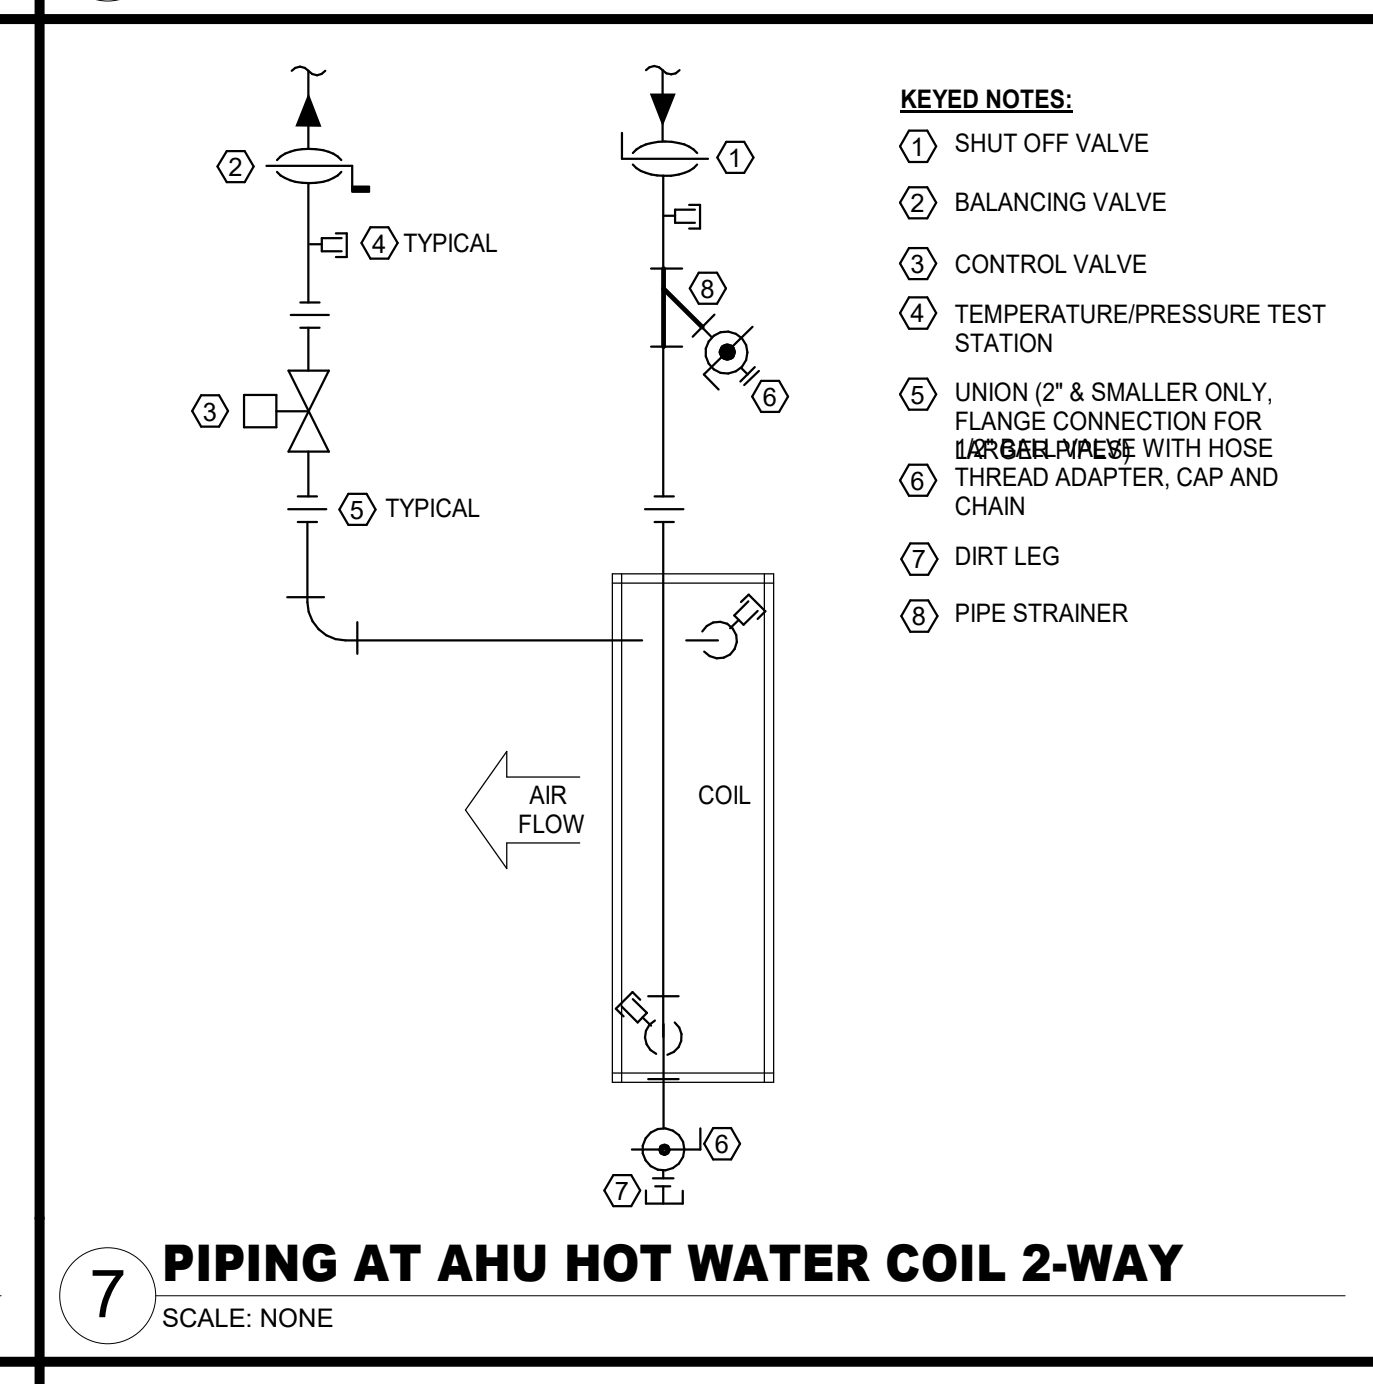


7 PIPING AT AHU HOT WATER COIL 2-WAY  
SCALE: NONE

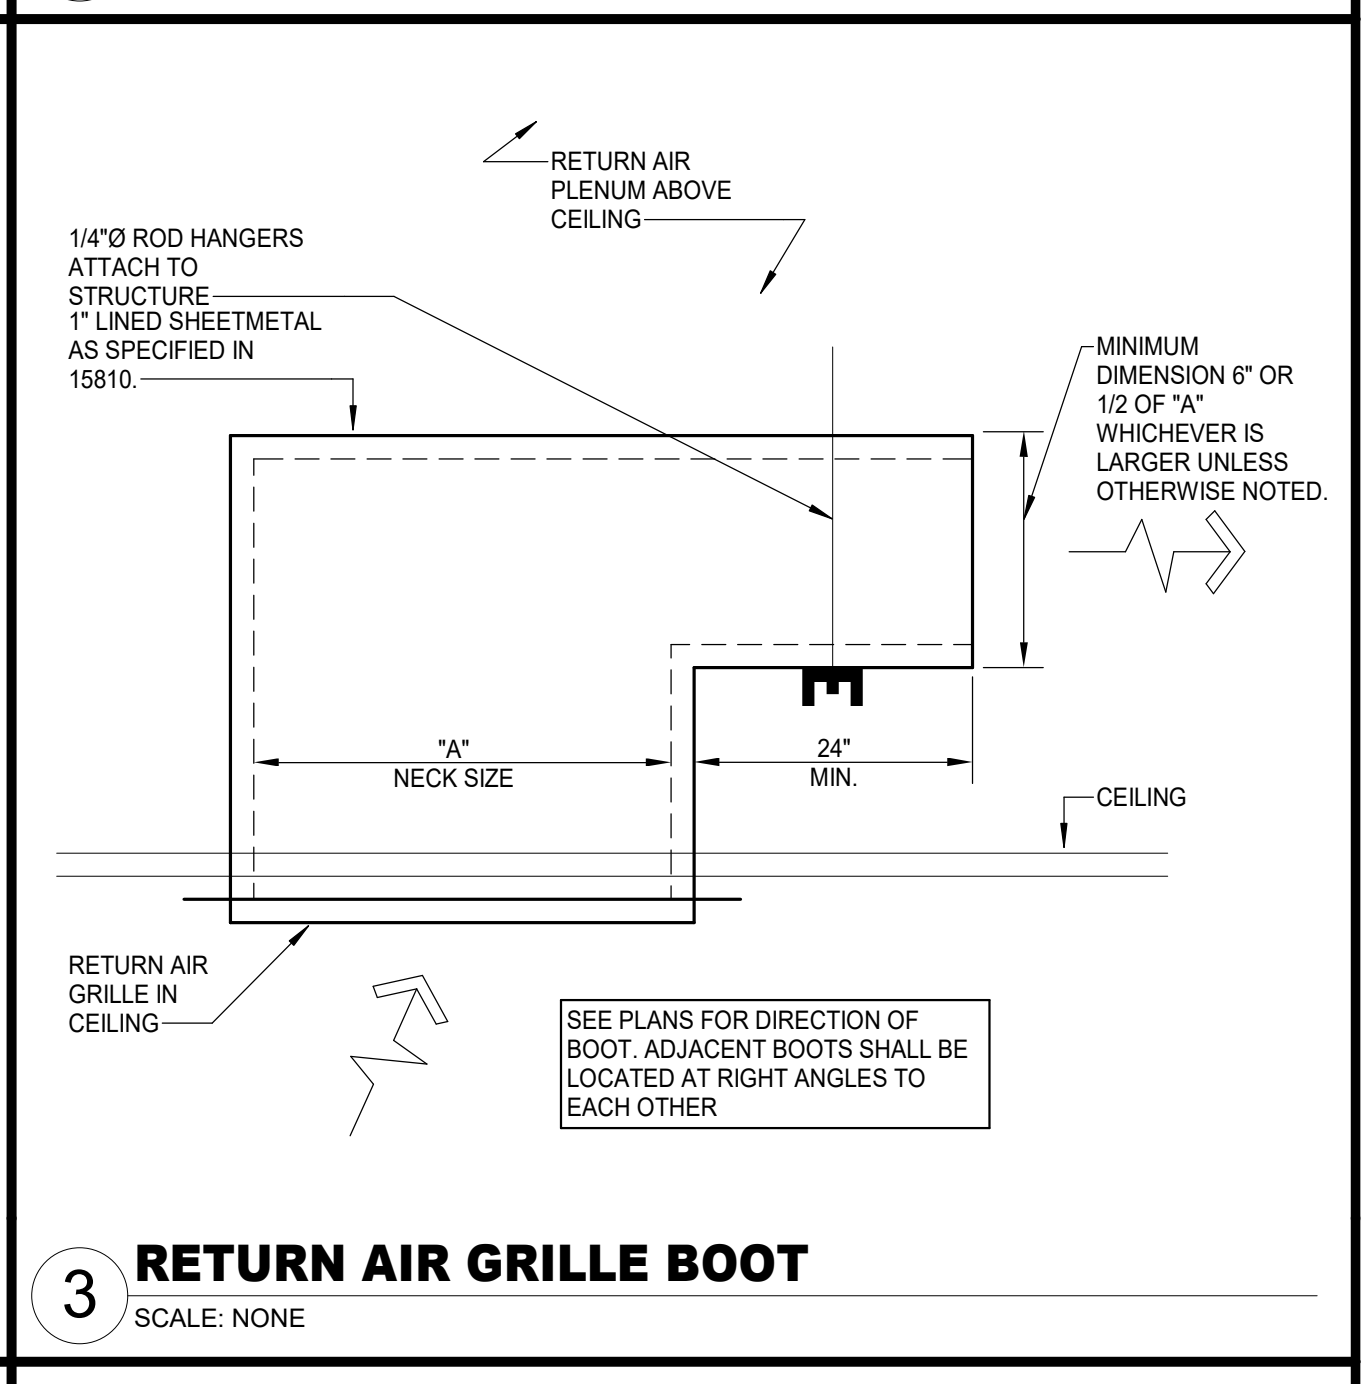


3 RETURN AIR GRILLE BOOT  
SCALE: NONE

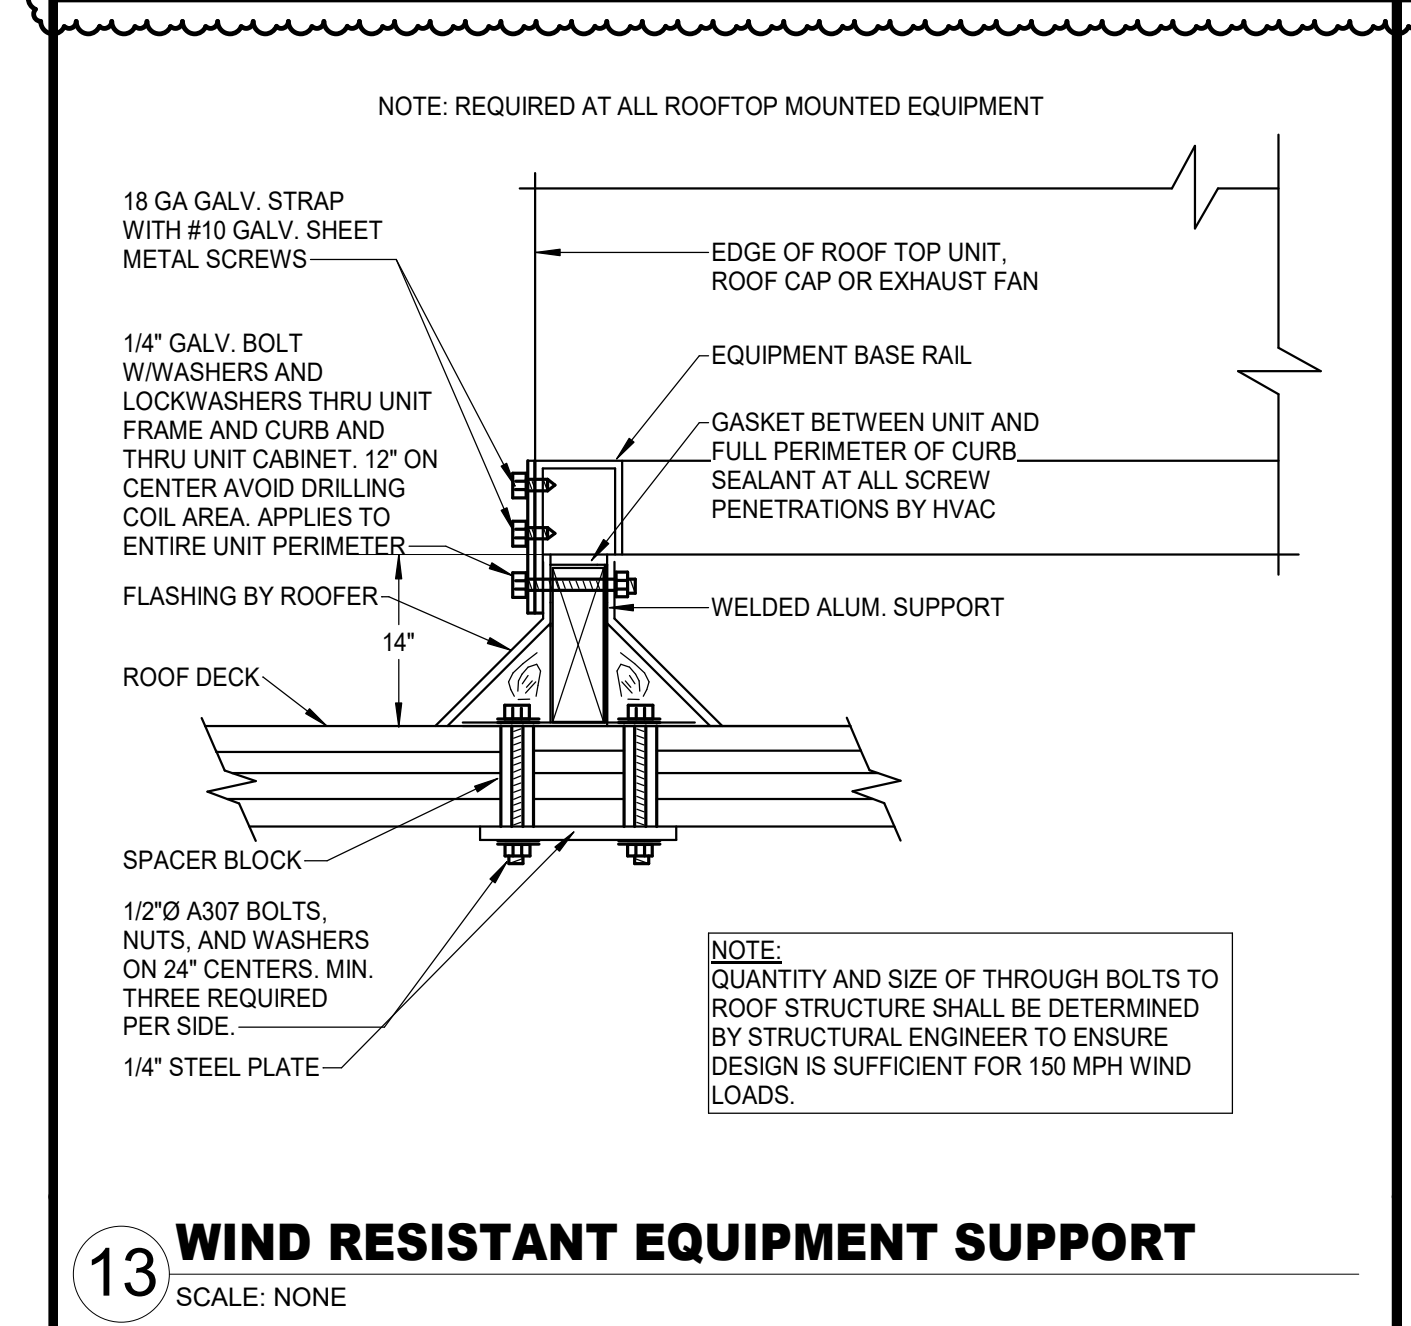


13 WIND RESISTANT EQUIPMENT SUPPORT  
SCALE: NONE

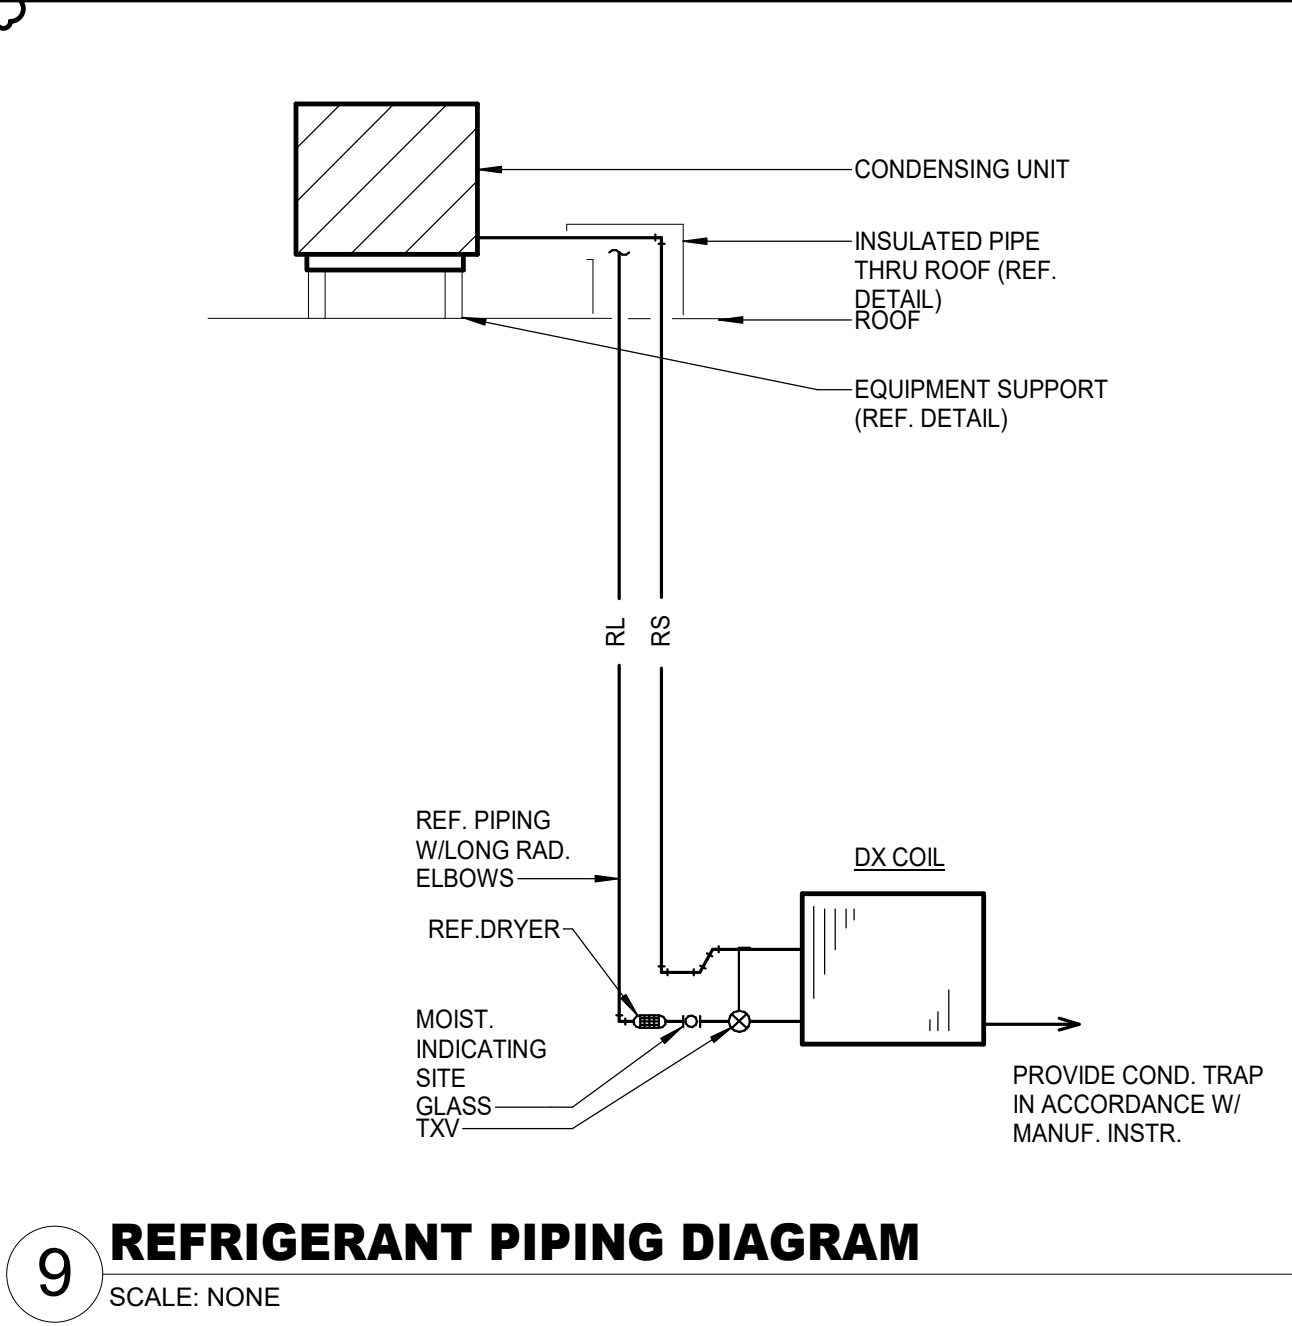


9 REFRIGERANT PIPING DIAGRAM  
SCALE: NONE

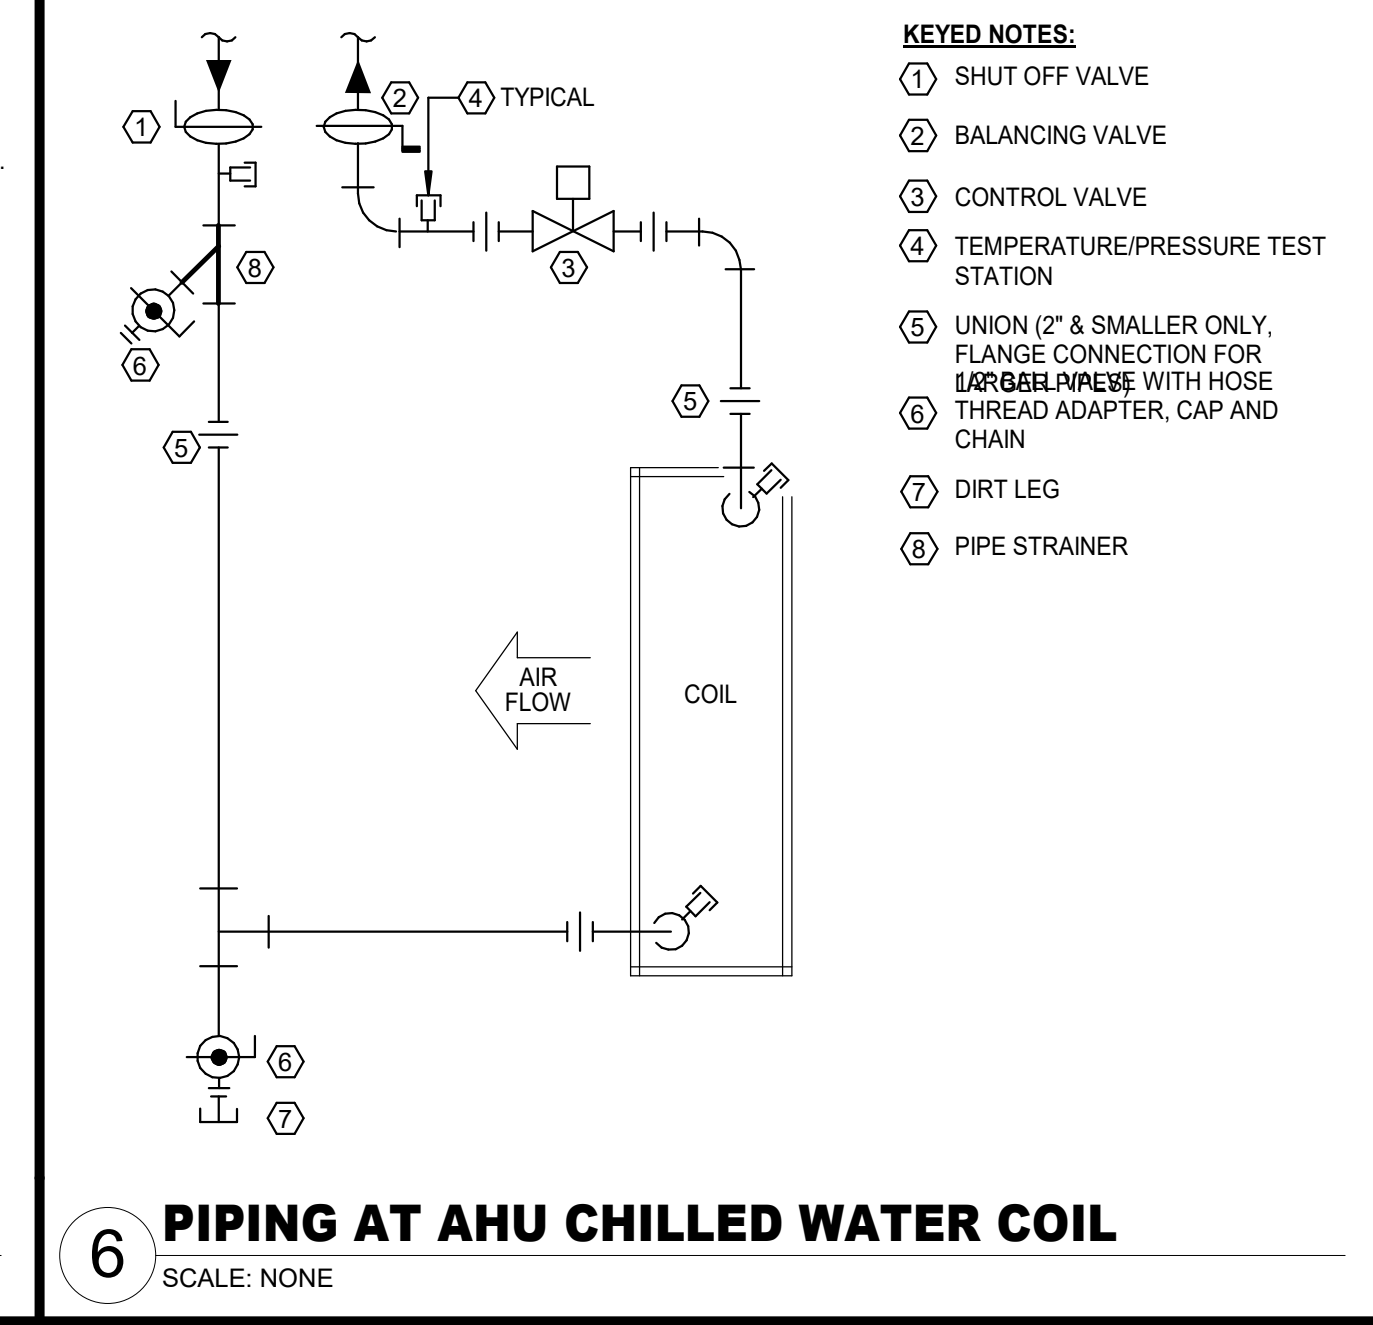


6 PIPING AT AHU CHILLED WATER COIL  
SCALE: NONE

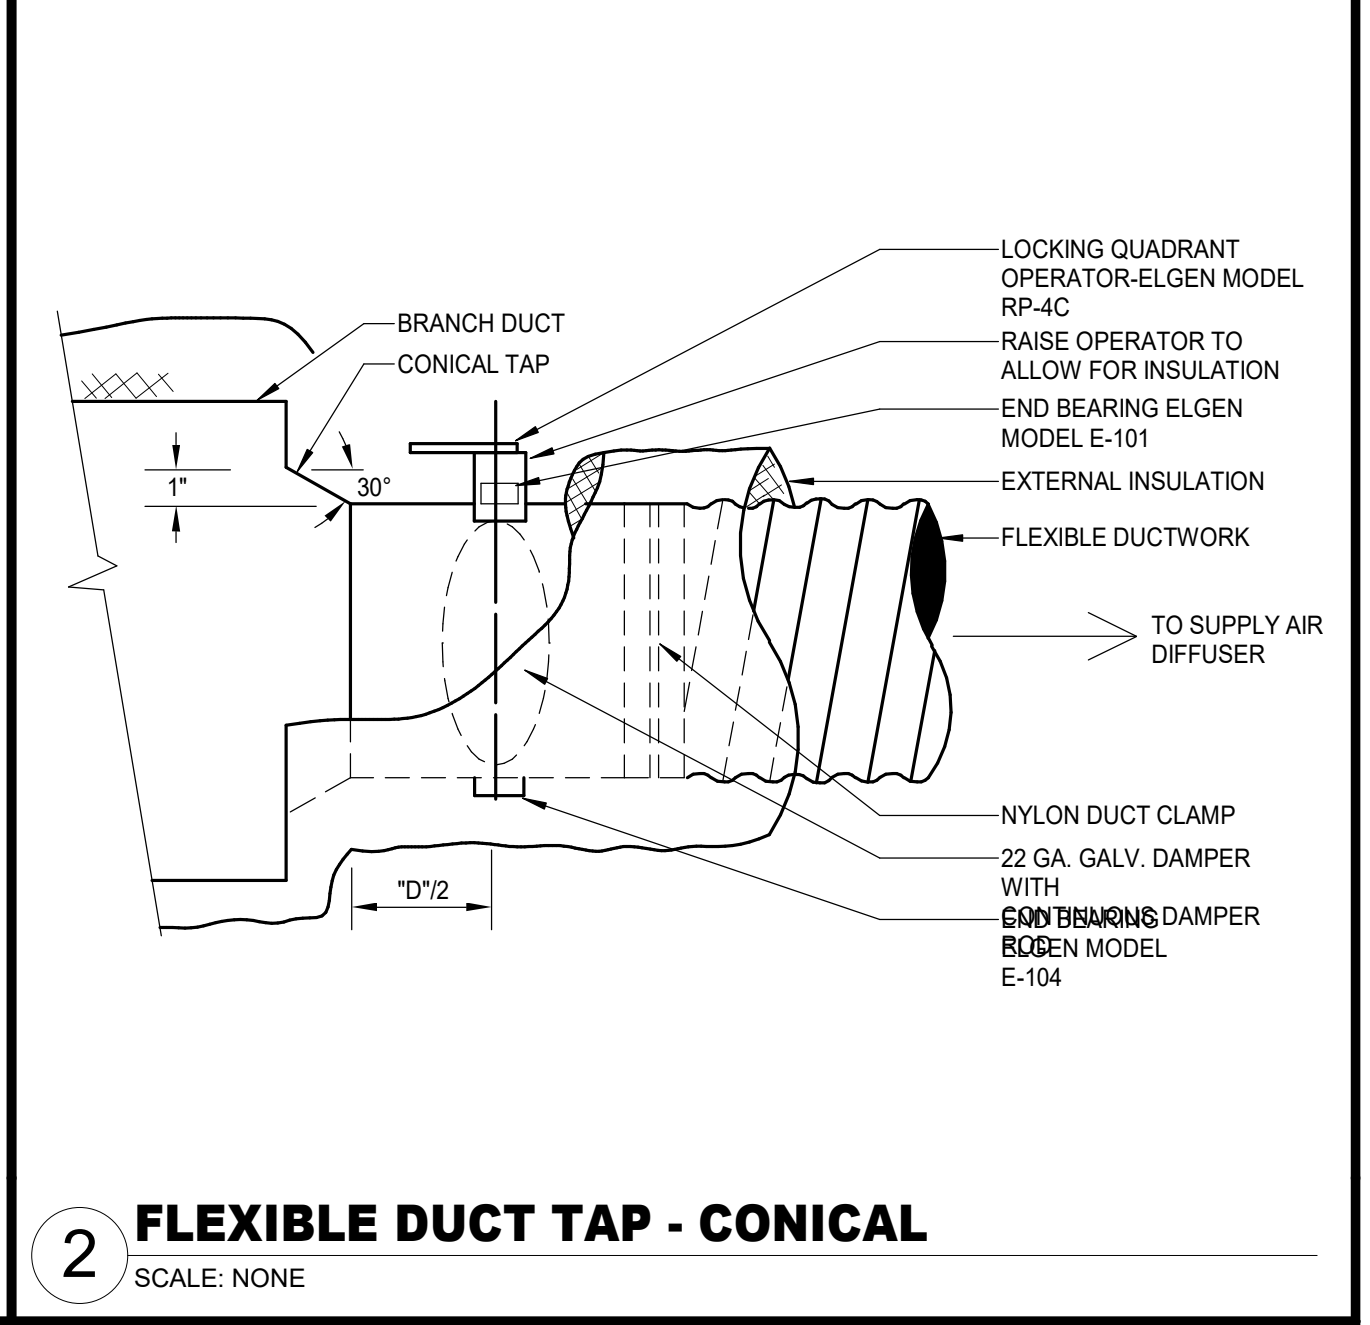

2 FLEXIBLE DUCT TAP - CONICAL  
SCALE: NONE

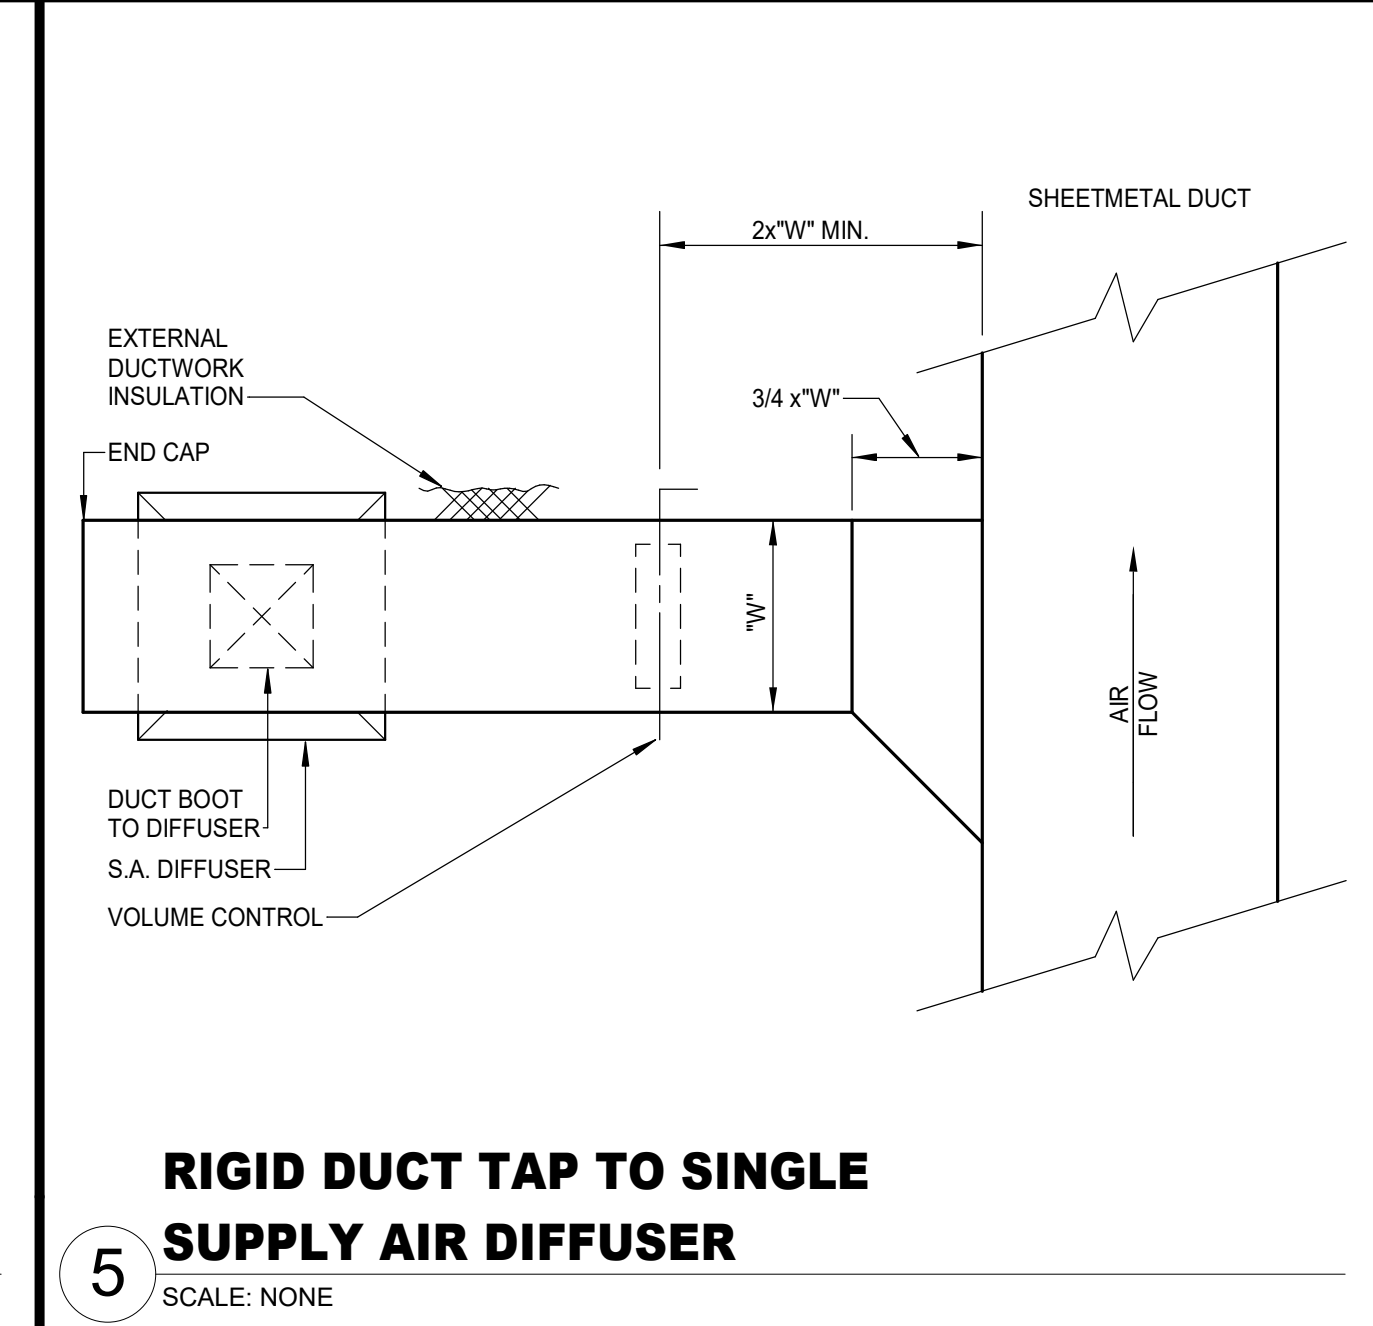

5 RIGID DUCT TAP TO SINGLE SUPPLY AIR DIFFUSER  
SCALE: NONE

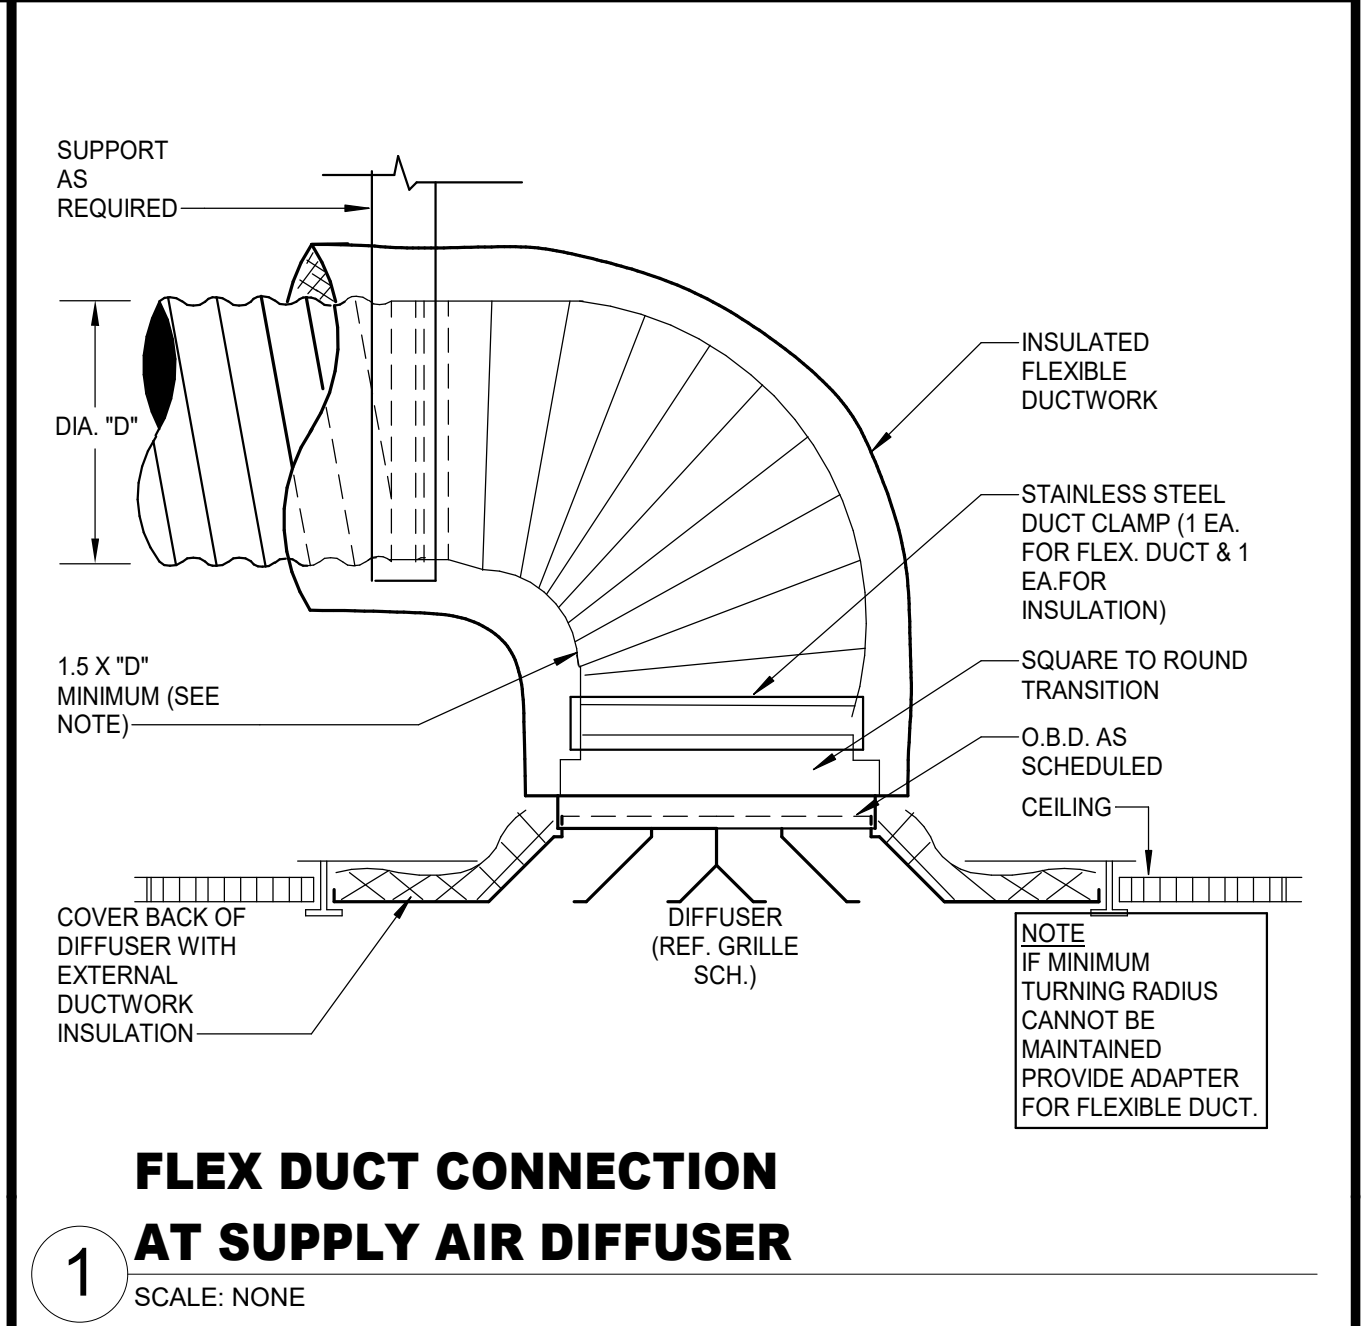

1 FLEX DUCT CONNECTION AT SUPPLY AIR DIFFUSER  
SCALE: NONE

**Salas O'Brien**  
salasobrien.com 281-664-1900  
Houston 10930 W. Sam Houston Pkwy North, Suite 900  
Houston, TX 77064  
Registration: F-4111  
Project No: 2024-0209-00

**NATEX CORPORATION ARCHITECTS**  
www.natexarchitects.com  
447 Heights Boulevard  
Houston, TX 77007  
Phone: 713-975-9525  
Fax: 713-780-7824

**Coleman Partners ARCHITECTS**  
www.colemanpartners.com  
3701 Kirby Drive, Suite 830  
Houston, TX 77098  
Tel: 832-947-1038 Fax: 281-214-5365

**CONSTRUCTION DOCUMENT**  
BRADLEY KALMANS  
80219  
CENTEX  
02-14-2025

**CIVIL ENGINEER BROOKS AND SPARKS, INC.**  
21020 PARK ROW  
KATY, TX 77449  
Tel: 281-578-9595

**STRUCTURAL ENGINEER DALLY + ASSOCIATES, INC.**  
9800 RICHMOND AVE.  
SUITE 400  
HOUSTON, TX 77042  
Tel: 713-337-8881

**MEPT ENGINEER SALAS O'BRIEN**  
10930 W. SAM HOUSTON PKWY. N.  
SUITE 900  
HOUSTON, TX 77064  
Tel: 281.664.1900

**FOOD SERVICE EQUIPMENT FDP**  
25317 INTERSTATE 45  
THE WOODLANDS, TX 77380  
Tel: 281-350-2323

**LANDSCAPE ARCHITECT LANDESGRUP**  
17041 EL CAMINO REAL  
SUITE 204  
HOUSTON, TX 77058  
Tel: 281.486.4040


2024 SMITH & SPILLANE MS RENOVATIONS  
**SMITH MIDDLE SCHOOL**  
10300 WARNER SMITH BLVD., CYPRESS, TEXAS 77433  
CFSID PROJECT NO: 24-02-5751-R-RFP

Revision	Submission
2	Addendum 03 02-14-25

Project Number: 23073  
Date: 26 JANUARY 2025  
Drawn By: WHL / KLO





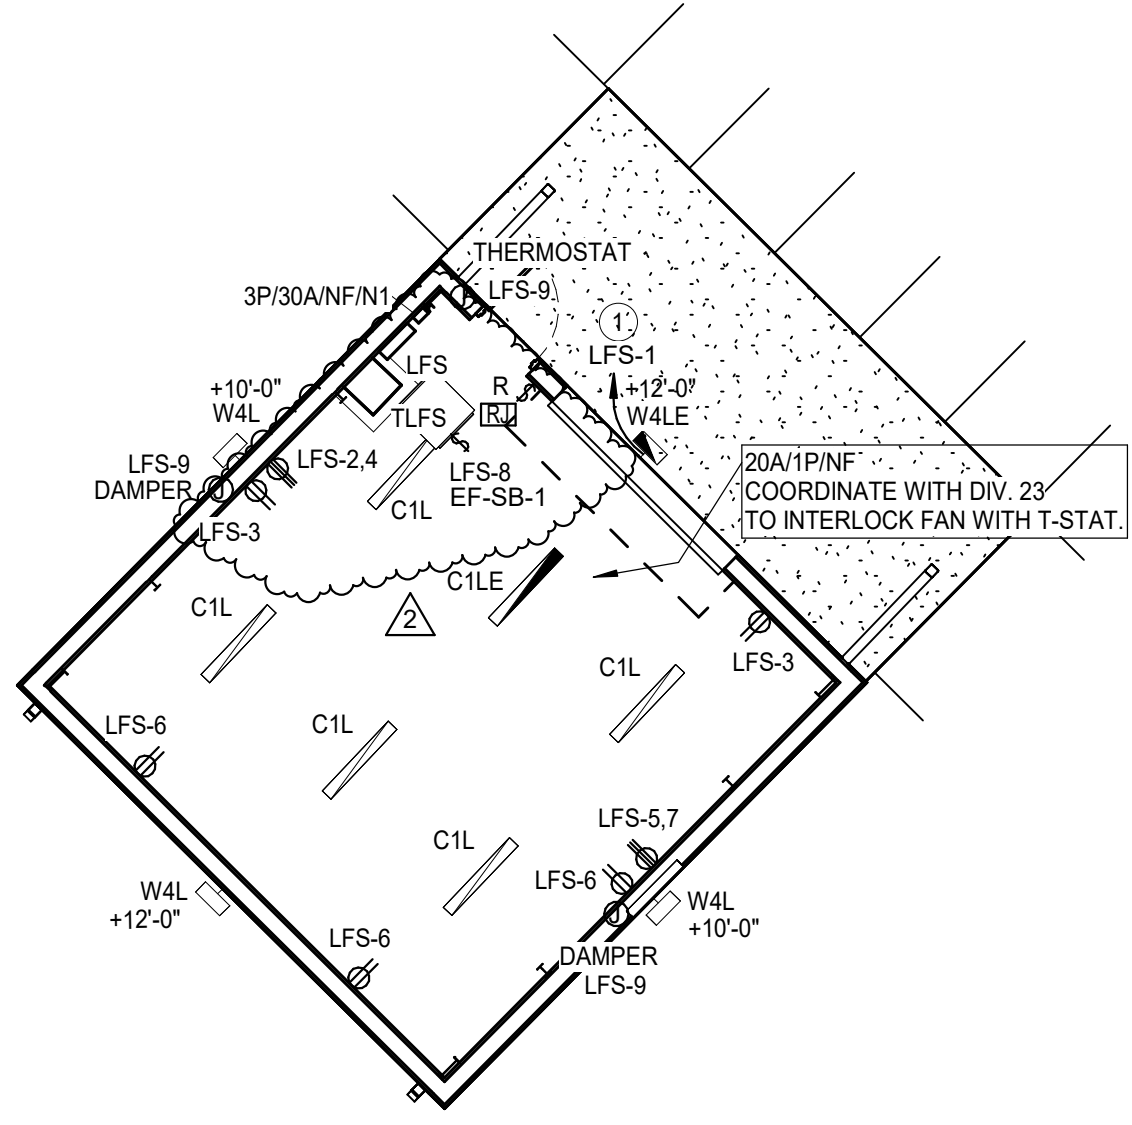

**2 ELECTRICAL FLOOR PLAN - FIELD STORAGE**  
Scale: 1/8" = 1'-0"

- SITE GENERAL NOTES**
- 1 CONTRACTOR TO COORDINATE FINAL LOCATION OF ALL CONDUITS WITH ALL OTHER TRADES.
  - 2 REFER TO CIVIL DRAWINGS FOR FINAL ROUTING AND DEPTH OF ALL UNDERGROUND UTILITIES.
  - 3 REFER TO TECHNOLOGY DRAWINGS, DIVISION 27 AND 28 FOR TELECOMMUNICATIONS PATHWAYS AND OTHER REQUIREMENTS TO BE PROVIDED BY DIVISION 26.
  - 4 PROVIDE PULL WIRES IN ALL EMPTY CONDUITS.

- ELECTRICAL KEYED NOTES**
- 1 CONTROL EXTERIOR LIGHTING WITH PHOTOCELL INTERMATIC HE4236S OR APPROVED EQUAL. LOCATE PHOTOSENSOR SURFACEMOUNTED ON THE NORTH SIDE OF THE BUILDING. LOCATION IS TO BE APPROVED BY OWNER / ARCHITECT.
  - 2 BORE UNDER CONCRETE PATH AS NECESSARY.

**LINE TYPE LEGEND**

---	EXISTING TO REMAIN
- - -	DISCONNECT AND REMOVE
---	NEW WORK

DEMOLITION / EXISTING DRAWINGS ARE BASED ON CASUAL FIELD OBSERVATION, AND WHEN AVAILABLE, EXISTING RECORD DOCUMENTS. REPORT DISCREPANCIES TO ARCHITECT BEFORE DISTURBING EXISTING INSTALLATION, AND IMMEDIATELY AFTER SUCH DISCREPANCIES ARE DISCOVERED. CONTRACTOR TO VERIFY EXISTING CONDITIONS ON FIELD AND NOTIFY ENGINEER IF THERE ARE ANY CONFLICTS BETWEEN EXISTING CONDITIONS AND DRAWINGS PRIOR TO COMMENCEMENT OF WORK. CONTRACTOR SHALL REMOVE SUCH EXISTING WORK AS CALLED FOR ON THE DRAWINGS OR AS REQUIRED TO CLEAR THE AREAS OF NEW CONSTRUCTION.

OWNER OR ITS REPRESENTATIVE SHALL HAVE FIRST RIGHT OF REFUSAL ON ALL EQUIPMENT BEING REMOVED FROM THIS PROJECT. CONTRACTOR TO NOTIFY CAREY RAMSEY WITH DISTRICT PRIOR TO DEMOLITION WORK TO DISCUSS ALL RETURNED ITEMS TO DISTRICT.

**Salas O'Brien**  
salasobrien.com 281-664-1900  
Houston  
10930 W. Sam Houston Pkwy North, Suite 900  
Houston, TX 77064  
Registration: F-4111  
Project No: 2024-00209-00

**NATEX CORPORATION ARCHITECTS**  
www.natearchitects.com  
447 Heights Boulevard  
Houston, TX 77007  
Phone: 713-975-9525  
Fax: 713-780-7824

**Coleman Partners ARCHITECTS**  
www.colemanpartners.com  
3701 Kirby Drive, Suite 830  
Houston, TX 77098  
tel: 832.947.1038 fax: 282.214.5365

**CONSTRUCTION DOCUMENT**

**BRADLEY KALMANS**  
80219  
CENTRAL TEXAS


**CIVIL ENGINEER**  
**BROOKS AND SPARKS, INC.**  
21020 PARK ROW  
KATY, TX 77449  
tel: 281.578.9595

**STRUCTURAL ENGINEER**  
**DALLY + ASSOCIATES, INC.**  
9800 RICHMOND AVE.  
SUITE 400  
HOUSTON, TX 77042  
tel: 713.337.8881

**MEPT ENGINEER**  
**SALAS O'BRIEN**  
10930 W. SAM HOUSTON PKWY. N.  
SUITE 900  
HOUSTON, TX 77064  
tel: 281.664.1900

**FOOD SERVICE EQUIPMENT**  
**FDP**  
25317 INTERSTATE 45  
THE WOODLANDS, TX 77380  
tel: 281.350.2323

**LANDSCAPE ARCHITECT**  
**LANDESIGN GROUP**  
17041 EL CAMINO REAL  
SUITE 204  
HOUSTON, TX 77058  
tel: 281.486.4040

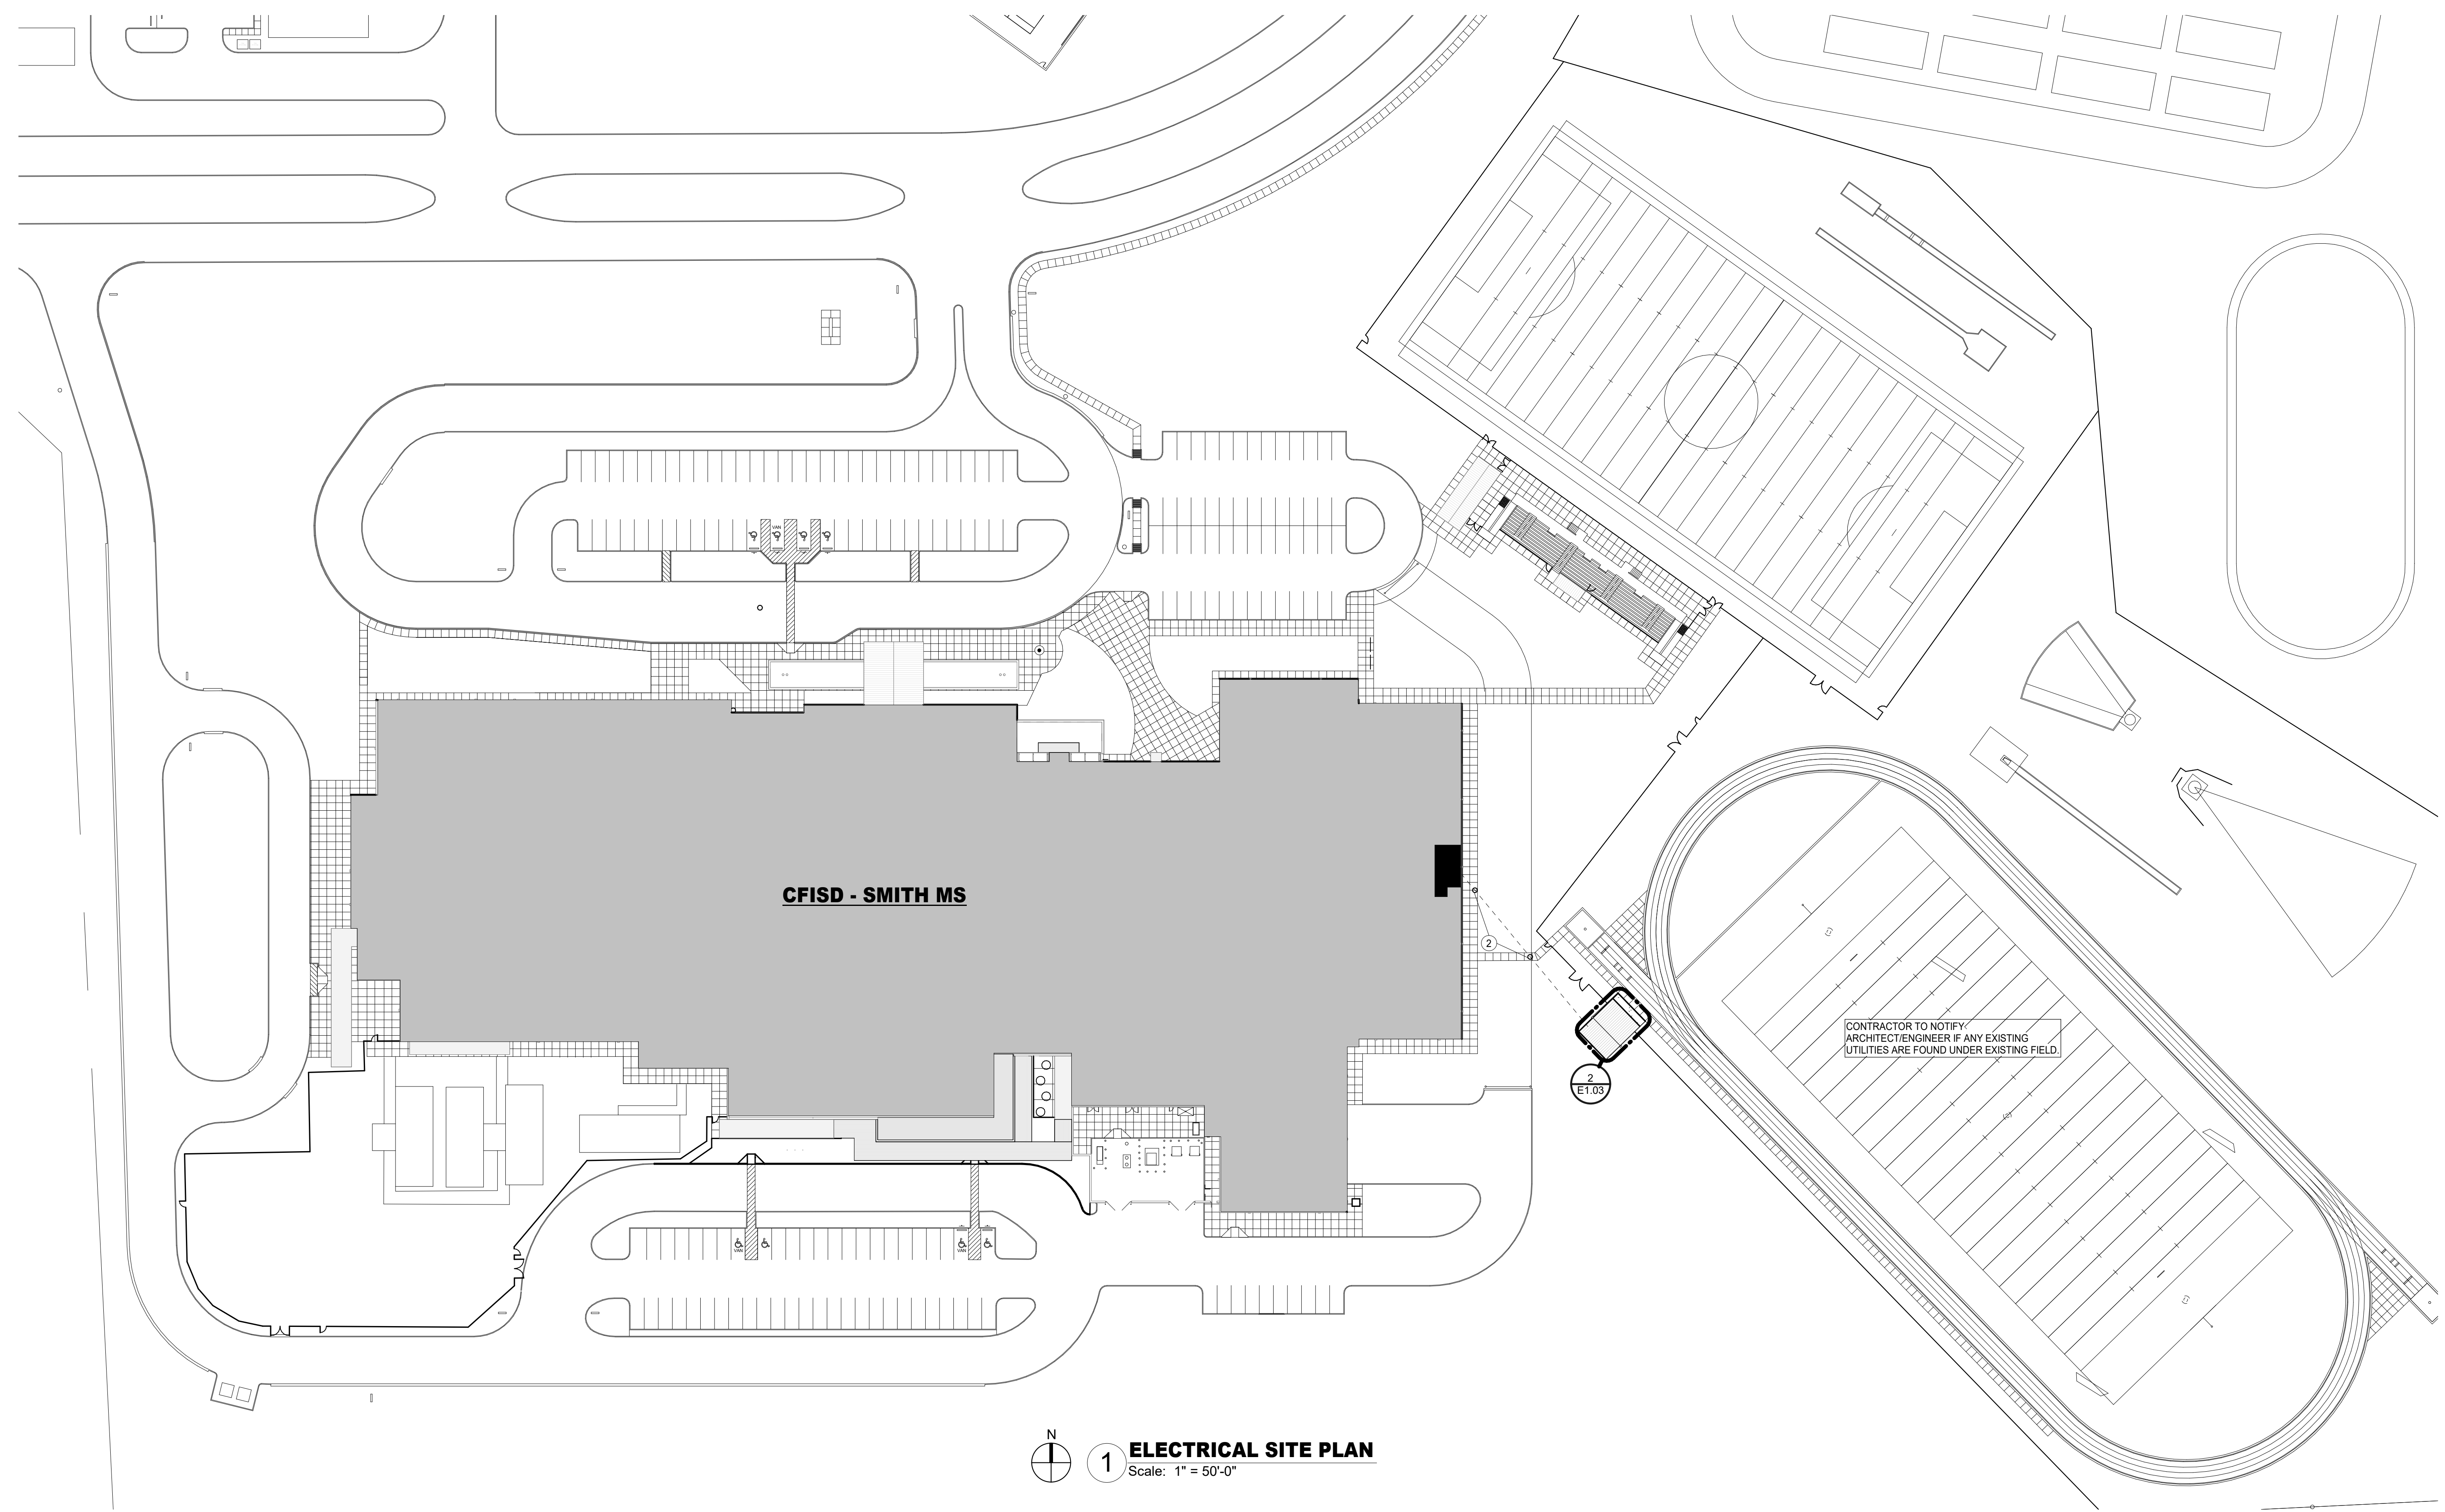

**1 ELECTRICAL SITE PLAN**  
Scale: 1" = 50'-0"

**2024 SMITH & SPILLANE MS RENOVATIONS**  
**SMITH MIDDLE SCHOOL**  
10300 WARNER SMITH BLVD., CYPRESS, TEXAS 77433  
CFISD PROJECT NO: 24-02-5751-R-RFP

2	Addendum 03	02-14-25	Revisions / Submission
---	-------------	----------	------------------------

Project Number: 23073  
Date: 26 JANUARY 2025  
Drawn By: WHL / KLO

ELECTRICAL SITE PLAN

**E1.03**

ELECTRICAL KEYED NOTES

1 INTERCEPT EXISTING NORMAL POWER CIRCUIT HOME RUN AND PROVIDE PER CIRCUIT (1) LISTED UL1008 TRANSFER SWITCH (1) CONTACTOR WITH POLE QUANTITY AS REQUIRED CONTROLLED WITH BMCS. LOCATE ADJACENT TO NORMAL POWER PANEL SERVING THE LOAD. RE-USE EXISTING NORMAL POWER CIRCUIT AND NEW EMERGENCY POWER CIRCUIT AS SHOWN. EXTEND CONDUCTORS / CONDUIT WITH MATCHING SIZE. REFER TO SPECIFICATIONS AND DETAIL SHEETS.



salasobrien.com 281-664-1900
Houston, TX 77007
18850 W. Sam Houston Pkwy North, Suite 900
Houston, TX 77064
Registration: F-4111
Project No: 2024-0029-00

LINE TYPE LEGEND

Table with 2 columns: Line Style, Description. Includes symbols for EXISTING TO REMAIN, DISCONNECT AND REMOVE, and NEW WORK.


CONTRACTOR TO FIELD COORDINATE FINAL LOCATION OF ALL REPLACEMENT AND NEW LIGHTING FIXTURES WITH EXISTING CEILING MOUNTED DEVICES AND TO NOTIFY ENGINEER IF THERE ARE ANY CONFLICTS BETWEEN EXISTING CONDITIONS AND THE NEW LIGHTING LAYOUT PRIOR TO COMMENCEMENT OF WORK.

PROVIDE NEW LIGHTING DEVICES AND SWITCH BOX EXTENSIONS IN ALL AREAS WHERE GYPSUM BOARD OR OTHER WALL COVERING ADDS TO THE THICKNESS OF WALLS. SEE ARCHITECTURAL DRAWINGS FOR AREAS AFFECTED.


PROVIDE (1) MOMENTARY BMCS OVERRIDE TIME-OUT SWITCH FOR BUILDING OCCUPIED/UNOCCUPIED ADJACENT TO OR IN THE BMCS MASTER PANEL (1) MOMENTARY BMCS OVERRIDE TIME-OUT SWITCH FOR EXTERIOR FACADE LIGHTING ON/OFF AND (1) MOMENTARY BMCS OVERRIDE TIME-OUT SWITCH FOR PARKING LOT LIGHTING ON/OFF IN MAIN ELECTRICAL.

LIGHTING GENERAL NOTES

- 1 CONNECT NEW LIGHT FIXTURES TO EXISTING NORMAL POWER CIRCUITS LEFT IN PLACE AFTER DEMOLITION OR NEW AS SHOWN. PROVIDE EMERGENCY CIRCUIT FOR HATCHED FIXTURES AND/OR EXIT SIGNS. EXTEND WIRING WITH MATCHING CONDUCTORS / CONDUIT TO EXISTING LOCATION AND/OR NEW FIXTURES. FIELD VERIFY INSTALLED LOAD NOT TO EXCEED 3000 W @ 277V. TYPICAL.
2 LOCATION OF NEW / REPLACEMENT LIGHT FIXTURES SHALL RE-USE EXISTING J-BOX AND EXISTING LIGHT FIXTURE WHIPS AS PRACTICAL. EXTEND WIRING WITH MATCHING CONDUCTORS / CONDUIT AND PROVIDE NEW J-BOX ABOVE ACCESSIBLE CEILING WITH 1/2" INCH FLEXIBLE STEEL CONDUIT OR STEEL MC CABLE. LENGTH NOT TO EXCEED 6'-FEET. 'DAISY CHAINING' LIGHT FIXTURES INSTALLED FOR LAY-IN CEILING AREAS IS NOT ALLOWED FOR NON-ACCESSIBLE CEILINGS. LIGHT FIXTURE WHIPS SHALL BE 1/2" INCH FLEXIBLE STEEL CONDUIT. LENGTH AS REQUIRED TO MAKE UP TO AN ACCESSIBLE J-BOX. RECESSED LIGHT FIXTURES IN NON-ACCESSIBLE CEILINGS MAY BE DAISY CHAINED USING THE LIGHT FIXTURE'S INTEGRAL UL LISTED J-BOX OR INTERNAL WIRE WAY THAT IS ACCESSIBLE THROUGH FIXTURE FROM BELOW THE CEILING. REFER TO 26 05 33 CONDUIT SYSTEMS.
3 PROVIDE NEW LIGHTING CONTROLS, SENSORS AND ASSOCIATED DEVICES, 20A EMERGENCY LOAD CONTROL RELAYS AND/OR TRANSFER SWITCHES. REFER TO SPECIFICATIONS AND DETAIL SHEETS.
4 LOCATE DIGITAL LIGHTING CONTROLLER AND / OR EMERGENCY LOAD CONTROL RELAY ABOVE ACCESSIBLE CEILING 12" FEET AFF OR BELOW ADJACENT TO SWITCH CONTROLLING THE SPACE. IN NON-ACCESSIBLE AND / OR HIGH CEILING AREAS, LOCATE DIGITAL LIGHTING CONTROLLER IN ADJACENT ANCILLARY AREA WITH ACCESSIBLE CEILING. IN AREAS WITH NO CEILING AND / OR IN EXTERIOR APPLICATIONS LOCATE ADJACENT TO PANEL SERVING THE LOAD. PROVIDE PLASTIC TAP MACHINE TYPED NAME PLATE TO BOTTOM OF CEILING 7" GRID BELOW RELAY LOCATION. WHITE LETTERS ON BLACK BACKGROUND WITH 1/4" HIGH LETTERS OR 1/2" TALL LABEL FOR DIGITAL MODULE. INDICATE AS: DLM.
5 LOCATE DIGITAL LIGHTING CONTROLLER FOR CORRIDORS, GYM AND HIGH CEILING AREAS WITH NO ADJACENT ANCILLARY AREA ADJACENT TO NORMAL POWER PANEL SERVING THE LOAD. PROVIDE LABEL, GRID MARKERS WITH WORKING PER SPECIFICATIONS.
6 LOCATE DIGITAL LIGHTING CONTROLLER FOR INSTRUCTIONAL SPACES AND OFFICES ABOVE ACCESSIBLE CEILING IN CORRIDOR DIRECTLY OUTSIDE OF ENTRY DOOR. PROVIDE LABEL IDENTIFYING ASSOCIATED SPACE, GRID MARKERS WITH WORKING PER SPECIFICATIONS.
7 OCCUPANCY/VACANCY SENSOR AND DAYLIGHTING SENSOR LOCATIONS INDICATE SPACE OR AREA CONTROLLED. CONTRACTOR TO PROVIDE ACTUAL QUANTITIES, TYPES, AND MOUNTING LOCATIONS AS RECOMMENDED BY MANUFACTURER AND IEC-2015 C405.
8 SPACES WITH MULTIPLE OCCUPANCY/VACANCY SENSORS OR WHERE LINE OF SIGHT MAY BE OBSCURED, SHALL BE LINKED TOGETHER FOR SIMULTANEOUS OPERATION WITHIN THE SPACE.
9 CONTRACTOR SHALL MAINTAIN CONSTANT UNSWITCHED CIRCUITS FROM EXISTING SOURCE AND/OR NEW AS SHOWN FOR EMERGENCY FIXTURES, EMERGENCY LOAD RELAYS, TRANSFER SWITCHES AND EXIT SIGNS.
10 COORDINATE LOCATION OF LIGHT FIXTURES IN ALL MECHANICAL AND ELECTRICAL ROOMS WITH MECHANICAL EQUIPMENT, PIPING, AND ALL OTHER TRADES.
11 PROVIDE SEPARATE RACEWAY SYSTEMS FOR LIGHTING CONTROL SYSTEM, CONTROLS WIRING (DIMMERS OR OTHERWISE) SHALL NOT BE INSTALLED IN THE SAME RACEWAY AS LINE VOLTAGE. REFER TO 26 05 33.

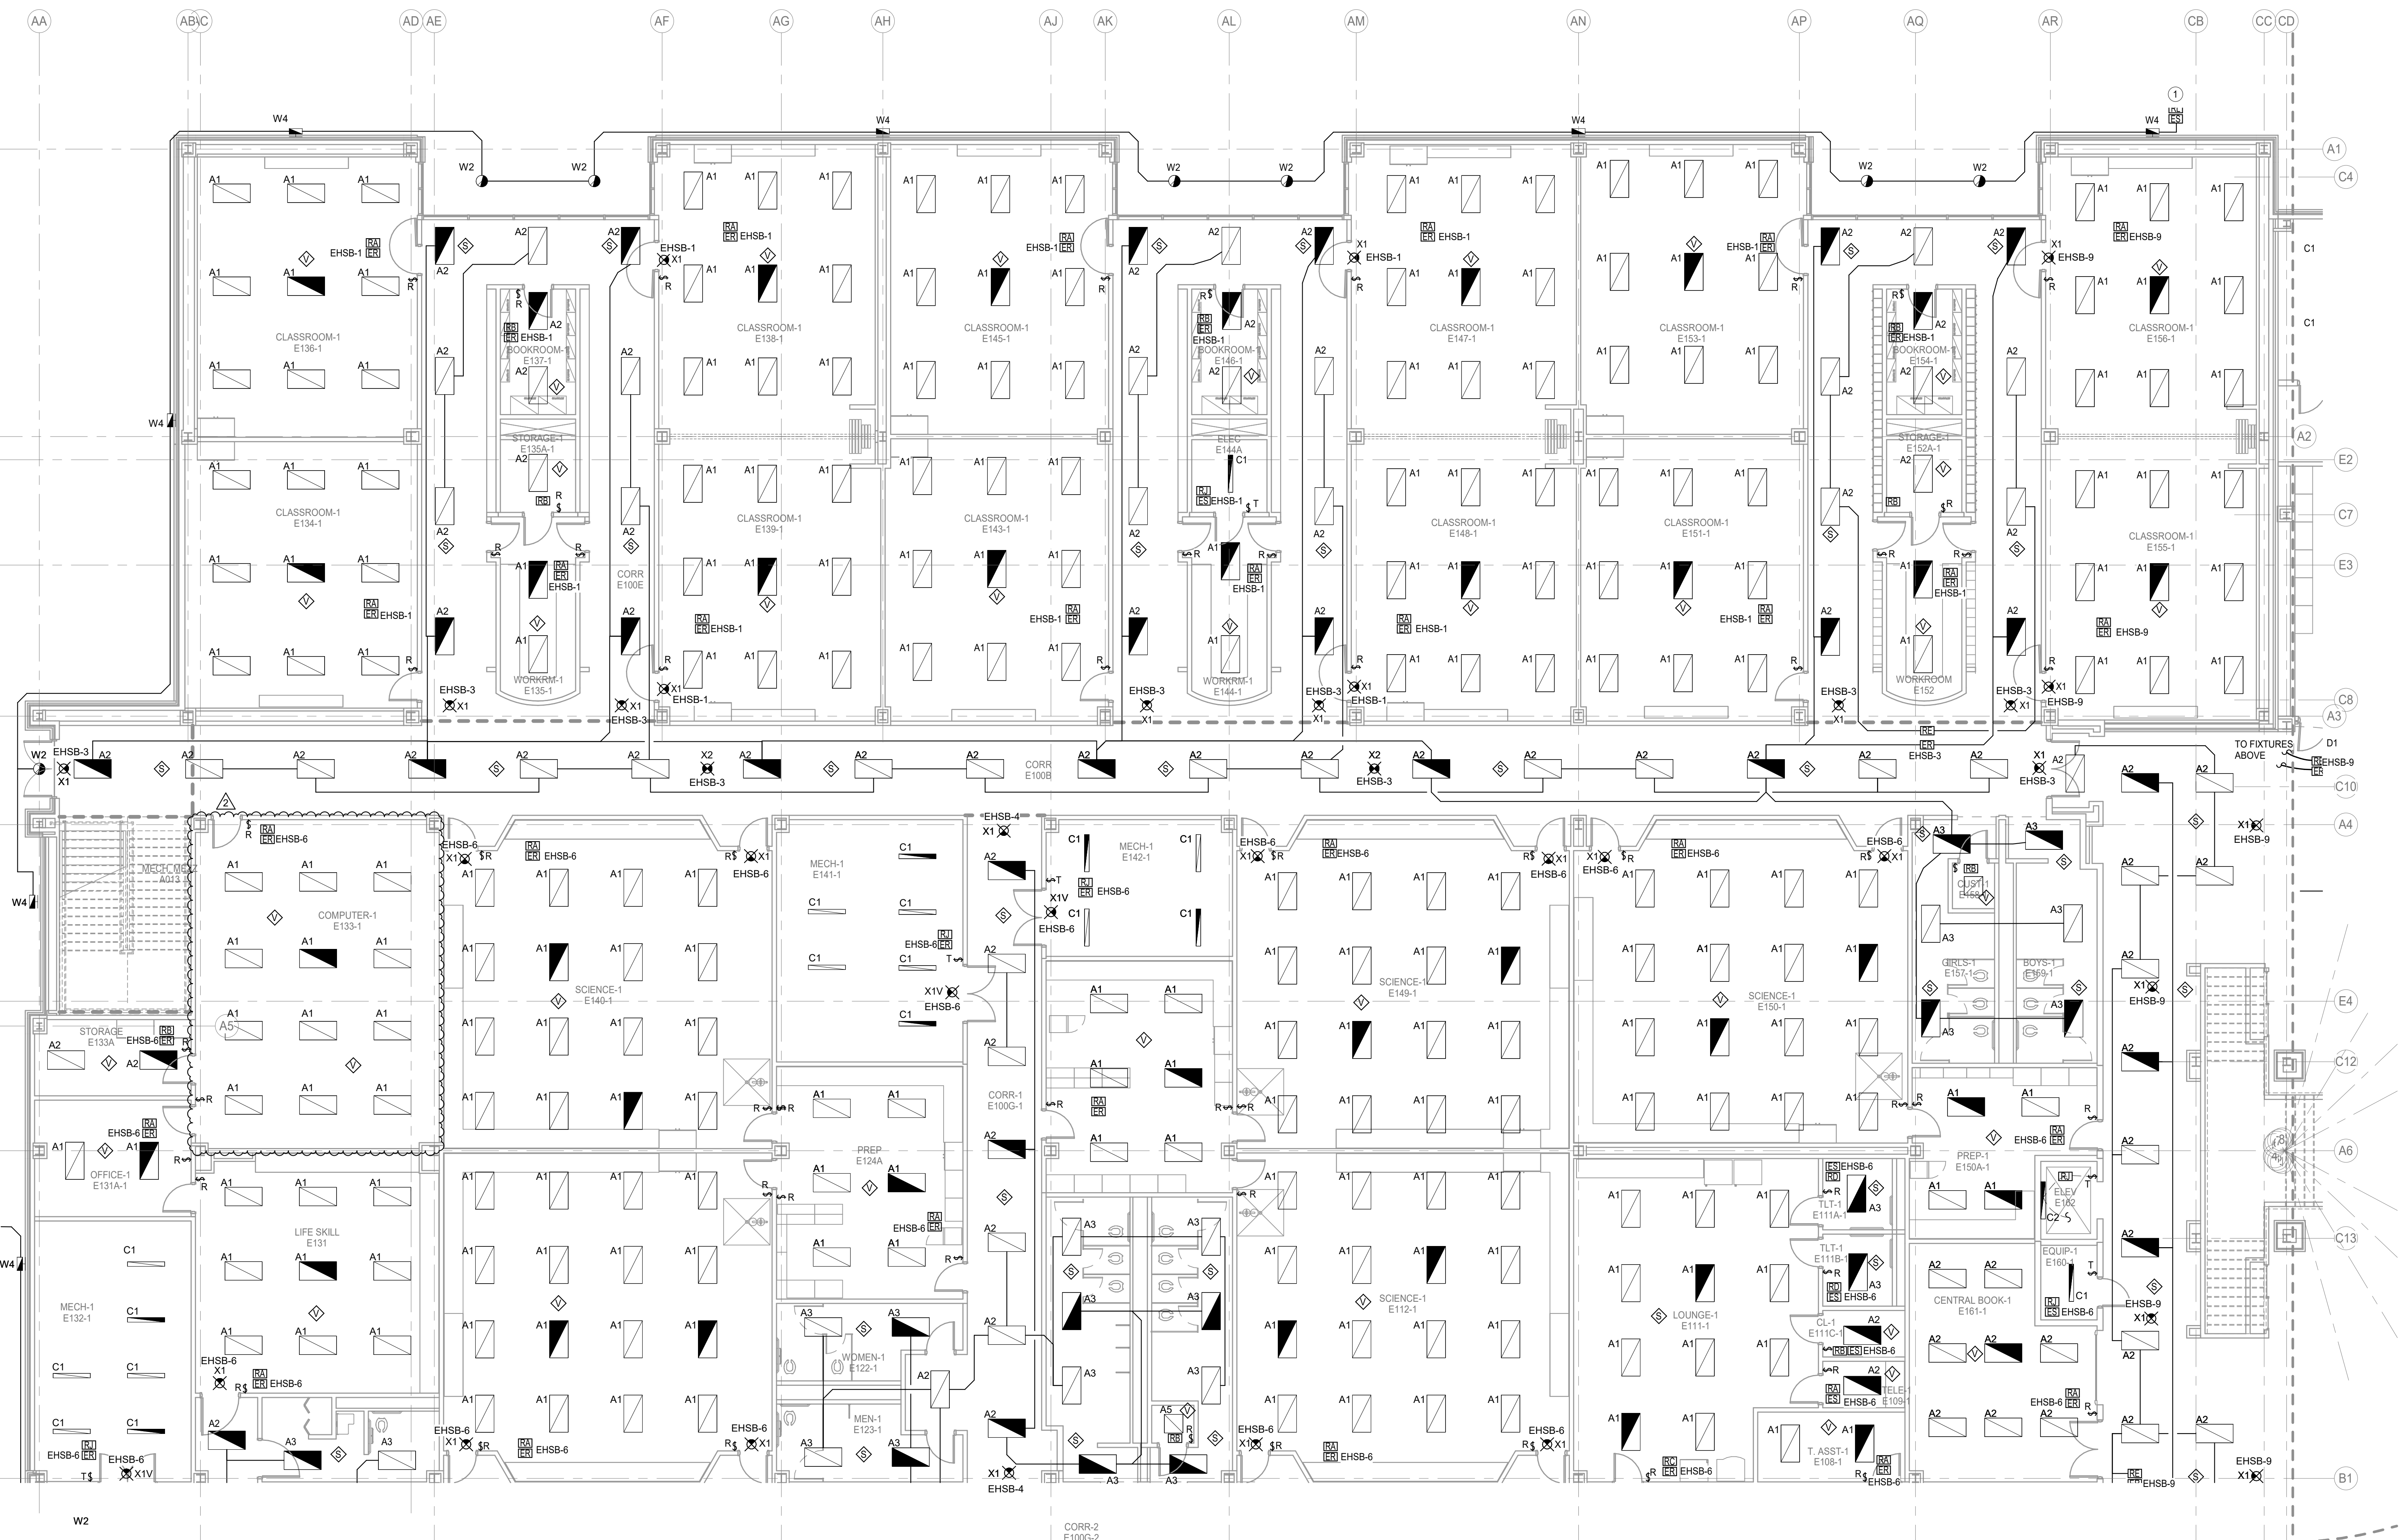

1 ELECTRICAL LIGHTING FLOOR PLAN - LEVEL 1 - AREA A
Scale: 1/8" = 1'-0"

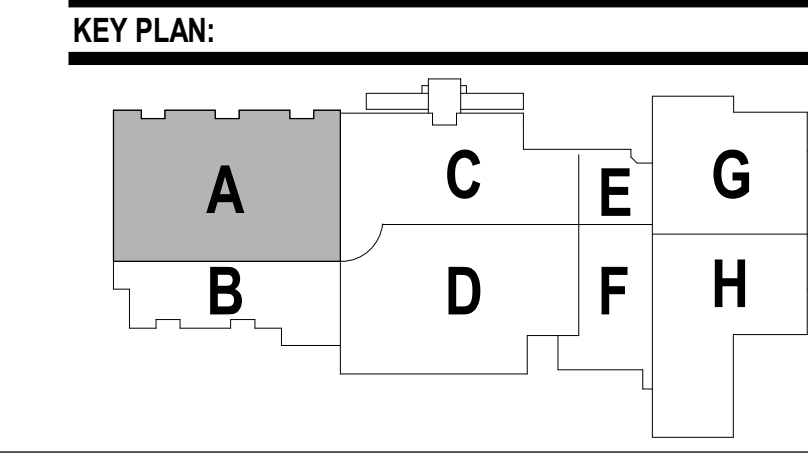


www.natexarchitects.com
447 Heights Boulevard
Houston, TX 77007
Phone: 713-975-9525
Fax: 713-780-7824



3701 Kirby Drive, Suite 830
Houston, TX 77098
Tel: 832-947-1038 fax: 282-214-5365

CONSTRUCTION DOCUMENT

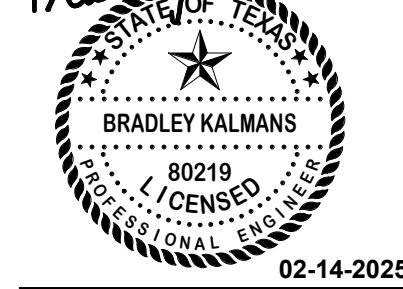

CIVIL ENGINEER
BROOKS AND SPARKS, INC.
21020 PARK ROW
KATY, TX 77449
tel: 281-578-9595

STRUCTURAL ENGINEER
DALLY + ASSOCIATES, INC.
9800 RICHMOND AVE.
SUITE 400
HOUSTON, TX 77042
tel: 713-337-8881

SEPT ENGINEER
SALAS O'BRIEN
10930 W. SAM HOUSTON PKWY. N.
SUITE 900
HOUSTON, TX 77064
tel: 281-664-1900

FOOD SERVICE EQUIPMENT
FDP
25317 INTERSTATE 45
THE WOODLANDS, TX 77380
tel: 281-350-2323

LANDSCAPE ARCHITECT
LANDESIGN GROUP
17041 EL CAMINO REAL
SUITE 204
HOUSTON, TX 77058
tel: 281-486-4040

2024 SMITH & SPILLANE MS RENOVATIONS
SMITH MIDDLE SCHOOL
10300 WARNER SMITH BLVD., CYPRESS, TEXAS 77433
CFSID PROJECT NO: 24-02-5751-R-RFP

Table with 2 columns: Revision Number, Description. Shows revision 2: Addendum 03, 02-14-25, Revisions / Submission.

Project Number: 23073
Date: 26 JANUARY 2025
Drawn By: WHL / KLO

ELECTRICAL LIGHTING
FIRST FLOOR PLAN -
AREA 'A'

E2.01



**Salas O'Brien**  
 salesobrien.com 281-664-1900  
 Houston  
 10930 W. Sam Houston Pkwy North, Suite 900  
 Houston, TX 77064  
 Registration: F-411  
 Project No: 2024-0209-00

**NATEX**  
 CORPORATION  
 ARCHITECTS  
 www.natesearchitects.com  
 447 Heights Boulevard  
 Houston, TX 77007  
 Phone: 713-975-9525  
 Fax: 713-780-7824

**Coleman Partners**  
 ARCHITECTS  
 cpa.com  
 3701 Kirby Drive, Suite 830  
 Houston, TX 77098  
 Tel: 832.947.1038 Fax: 282.214.5365

**CONSTRUCTION DOCUMENT**  
 BRADLEY KALMANS  
 80219  
 02-14-2025

**CIVIL ENGINEER**  
**BROOKS AND SPARKS, INC.**  
 21020 PARK ROW  
 KATY, TX 77449  
 Tel: 281.578.9595

**STRUCTURAL ENGINEER**  
**DALLY + ASSOCIATES, INC.**  
 9800 RICHMOND AVE.  
 SUITE 400  
 HOUSTON, TX 77042  
 Tel: 713.337.8881

**MEPT ENGINEER**  
**SALAS O'BRIEN**  
 10930 W. SAM HOUSTON PKWY. N.  
 SUITE 900  
 HOUSTON, TX 77064  
 Tel: 281.664.1900

**FOOD SERVICE EQUIPMENT**  
**FDP**  
 25317 INTERSTATE 45  
 THE WOODLANDS, TX 77380  
 Tel: 281.350.2323

**LANDSCAPE ARCHITECT**  
**LANDSCAPE GROUP**  
 17041 EL CAMINO REAL  
 SUITE 204  
 HOUSTON, TX 77058  
 Tel: 281.486.4040

**LINE TYPE LEGEND**

	EXISTING TO REMAIN
	DISCONNECT AND REMOVE
	NEW WORK


CONTRACTOR TO FIELD COORDINATE FINAL LOCATION OF ALL REPLACEMENT AND NEW LIGHTING FIXTURES WITH EXISTING CEILING MOUNTED DEVICES AND TO NOTIFY ENGINEER IF THERE ARE ANY CONFLICTS BETWEEN EXISTING CONDITIONS AND THE NEW LIGHTING LAYOUT PRIOR TO COMMENCEMENT OF WORK.

PROVIDE NEW LIGHTING DEVICES AND SWITCH BOX EXTENSIONS IN ALL AREAS WHERE GYPSUM BOARD OR OTHER WALL COVERING ADDS TO THE THICKNESS OF WALLS. SEE ARCHITECTURAL DRAWINGS FOR AREAS AFFECTED.

PROVIDE (1) MOMENTARY BMCS OVERRIDE TIME-OUT SWITCH FOR BUILDING OCCUPIED/UNOCCUPIED ADJACENT TO OR IN THE BMCS MASTER PANEL, (1) MOMENTARY BMCS OVERRIDE TIME-OUT SWITCH FOR EXTERIOR FACADE LIGHTING ON/OFF AND (1) MOMENTARY BMCS OVERRIDE TIME-OUT SWITCH FOR PARKING LOT LIGHTING ON/OFF IN MAIN ELECTRICAL.

**LIGHTING GENERAL NOTES**

- CONNECT NEW LIGHT FIXTURES TO EXISTING NORMAL POWER CIRCUITS LEFT IN PLACE AFTER DEMOLITION OR NEW AS SHOWN. PROVIDE EMERGENCY CIRCUIT FOR HATCHED FIXTURES AND/OR EXIT SIGNS. EXTEND WIRING WITH MATCHING CONDUCTORS / CONDUIT TO EXISTING LOCATION AND/OR NEW FIXTURES. FIELD VERIFY CONNECTED LOAD NOT TO EXCEED 3500 W @ 277V. TYPICAL.
- LOCATION OF NEW / REPLACEMENT LIGHT FIXTURES SHALL RE-USE EXISTING J-BOX AND EXISTING LIGHT FIXTURE WHIPS AS PRACTICAL. EXTEND WIRING WITH MATCHING CONDUCTORS / CONDUIT AND PROVIDE NEW J-BOX ABOVE ACCESSIBLE CEILING WITH 1/2-INCH FLEXIBLE STEEL CONDUIT OR STEEL MC CABLE. LENGTH NOT TO EXCEED 6-FEET. "DAISY CHAINING" LIGHT FIXTURES INSTALLED FOR LAY IN CEILING AREAS IS NOT ALLOWED. FOR NON-ACCESSIBLE CEILINGS, LIGHT FIXTURE WHIPS SHALL BE 1/2-INCH FLEXIBLE STEEL CONDUIT. LENGTH AS REQUIRED TO MAKE A TAP AT AN ACCESSIBLE J-BOX. RECESSED LIGHT FIXTURES IN NON-ACCESSIBLE CEILINGS MAY BE DAISY CHAINED USING THE LIGHT FIXTURE'S INTEGRAL UL LISTED J-BOX OR INTERNAL WIRE WAY THAT IS ACCESSIBLE THROUGH FIXTURE FROM BELOW THE CEILING. REFER TO 26 05 33 CONDUIT SYSTEMS.
- PROVIDE NEW LIGHTING CONTROLS, SENSORS AND ASSOCIATED DEVICES, 20A EMERGENCY LOAD CONTROL RELAYS AND/OR TRANSFER SWITCHES. REFER TO SPECIFICATIONS AND DETAIL SHEETS.
- LOCATE DIGITAL LIGHTING CONTROLLER AND / OR EMERGENCY LOAD CONTROL RELAY ABOVE ACCESSIBLE CEILING 12-FEET AFF OR BELOW ADJACENT TO SWITCH CONTROLLING THE SPACE. IN NON-ACCESSIBLE AND / OR HIGH CEILING AREAS, LOCATE DIGITAL LIGHTING CONTROLLER IN ADJACENT ANCILLARY AREA WITH ACCESSIBLE CEILING. IN AREAS WITH NO CEILING AND / OR IN EXTERIOR APPLICATIONS LOCATE ADJACENT TO PANEL SERVING THE LOAD. PROVIDE PLASTIC TAPE MACHINE TYPED NAME PLATE TO BOTTOM OF CEILING T-GRID BELOW RELAY LOCATION. WHITE LETTERS ON BLACK BACKGROUND WITH 1/4" HIGH LETTERS ON 1/2" TALL LABEL FOR DIGITAL MODULE. INDICATE AS: DLM.
- LOCATE DIGITAL LIGHTING CONTROLLER FOR CORRIDORS, GYM AND HIGH CEILING AREAS WITH NO ADJACENT ANCILLARY AREA ADJACENT TO NORMAL POWER PANEL SERVING THE LOAD. PROVIDE LABEL, GRID MARKERS WITH WORDING PER SPECIFICATIONS.
- LOCATE DIGITAL LIGHTING CONTROLLER FOR INSTRUCTIONAL SPACES AND OFFICES ABOVE ACCESSIBLE CEILING IN CORRIDOR DIRECTLY OUTSIDE OF ENTRY DOOR. PROVIDE LABEL IDENTIFYING ASSOCIATED SPACE. GRID MARKERS WITH WORDING PER SPECIFICATIONS.
- OCCUPANCY/VACANCY SENSOR AND DAYLIGHTING SENSOR LOCATIONS INDICATE SPACE OR AREA CONTROLLED. CONTRACTOR TO PROVIDE ACTUAL QUANTITIES, TYPES, AND MOUNTING LOCATIONS AS RECOMMENDED BY MANUFACTURER AND IECC-2015 C405.
- SPACES WITH MULTIPLE OCCUPANCY/VACANCY SENSORS OR WHERE LINE OF SIGHT MAY BE OBSCURED, SHALL BE LINKED TOGETHER FOR SIMULTANEOUS OPERATION WITHIN THE SPACE.
- CONTRACTOR SHALL MAINTAIN CONSTANT UNSWITCHED CIRCUITS FROM EXISTING SOURCE AND/OR NEW AS SHOWN FOR EMERGENCY FIXTURES, EMERGENCY LOAD RELAYS, TRANSFER SWITCHES AND EXIT SIGNS.
- COORDINATE LOCATION OF LIGHT FIXTURES IN ALL MECHANICAL AND ELECTRICAL ROOMS WITH MECHANICAL AND ELECTRICAL EQUIPMENT, PIPING, AND ALL OTHER TRADES.
- PROVIDE SEPARATE RACEWAY SYSTEMS FOR LIGHTING CONTROL SYSTEM, CONTROLS WIRING (DIMMERS OR OTHERWISE) SHALL NOT BE INSTALLED IN THE SAME RACEWAY AS LINE VOLTAGE. REFER TO 26 05 33.

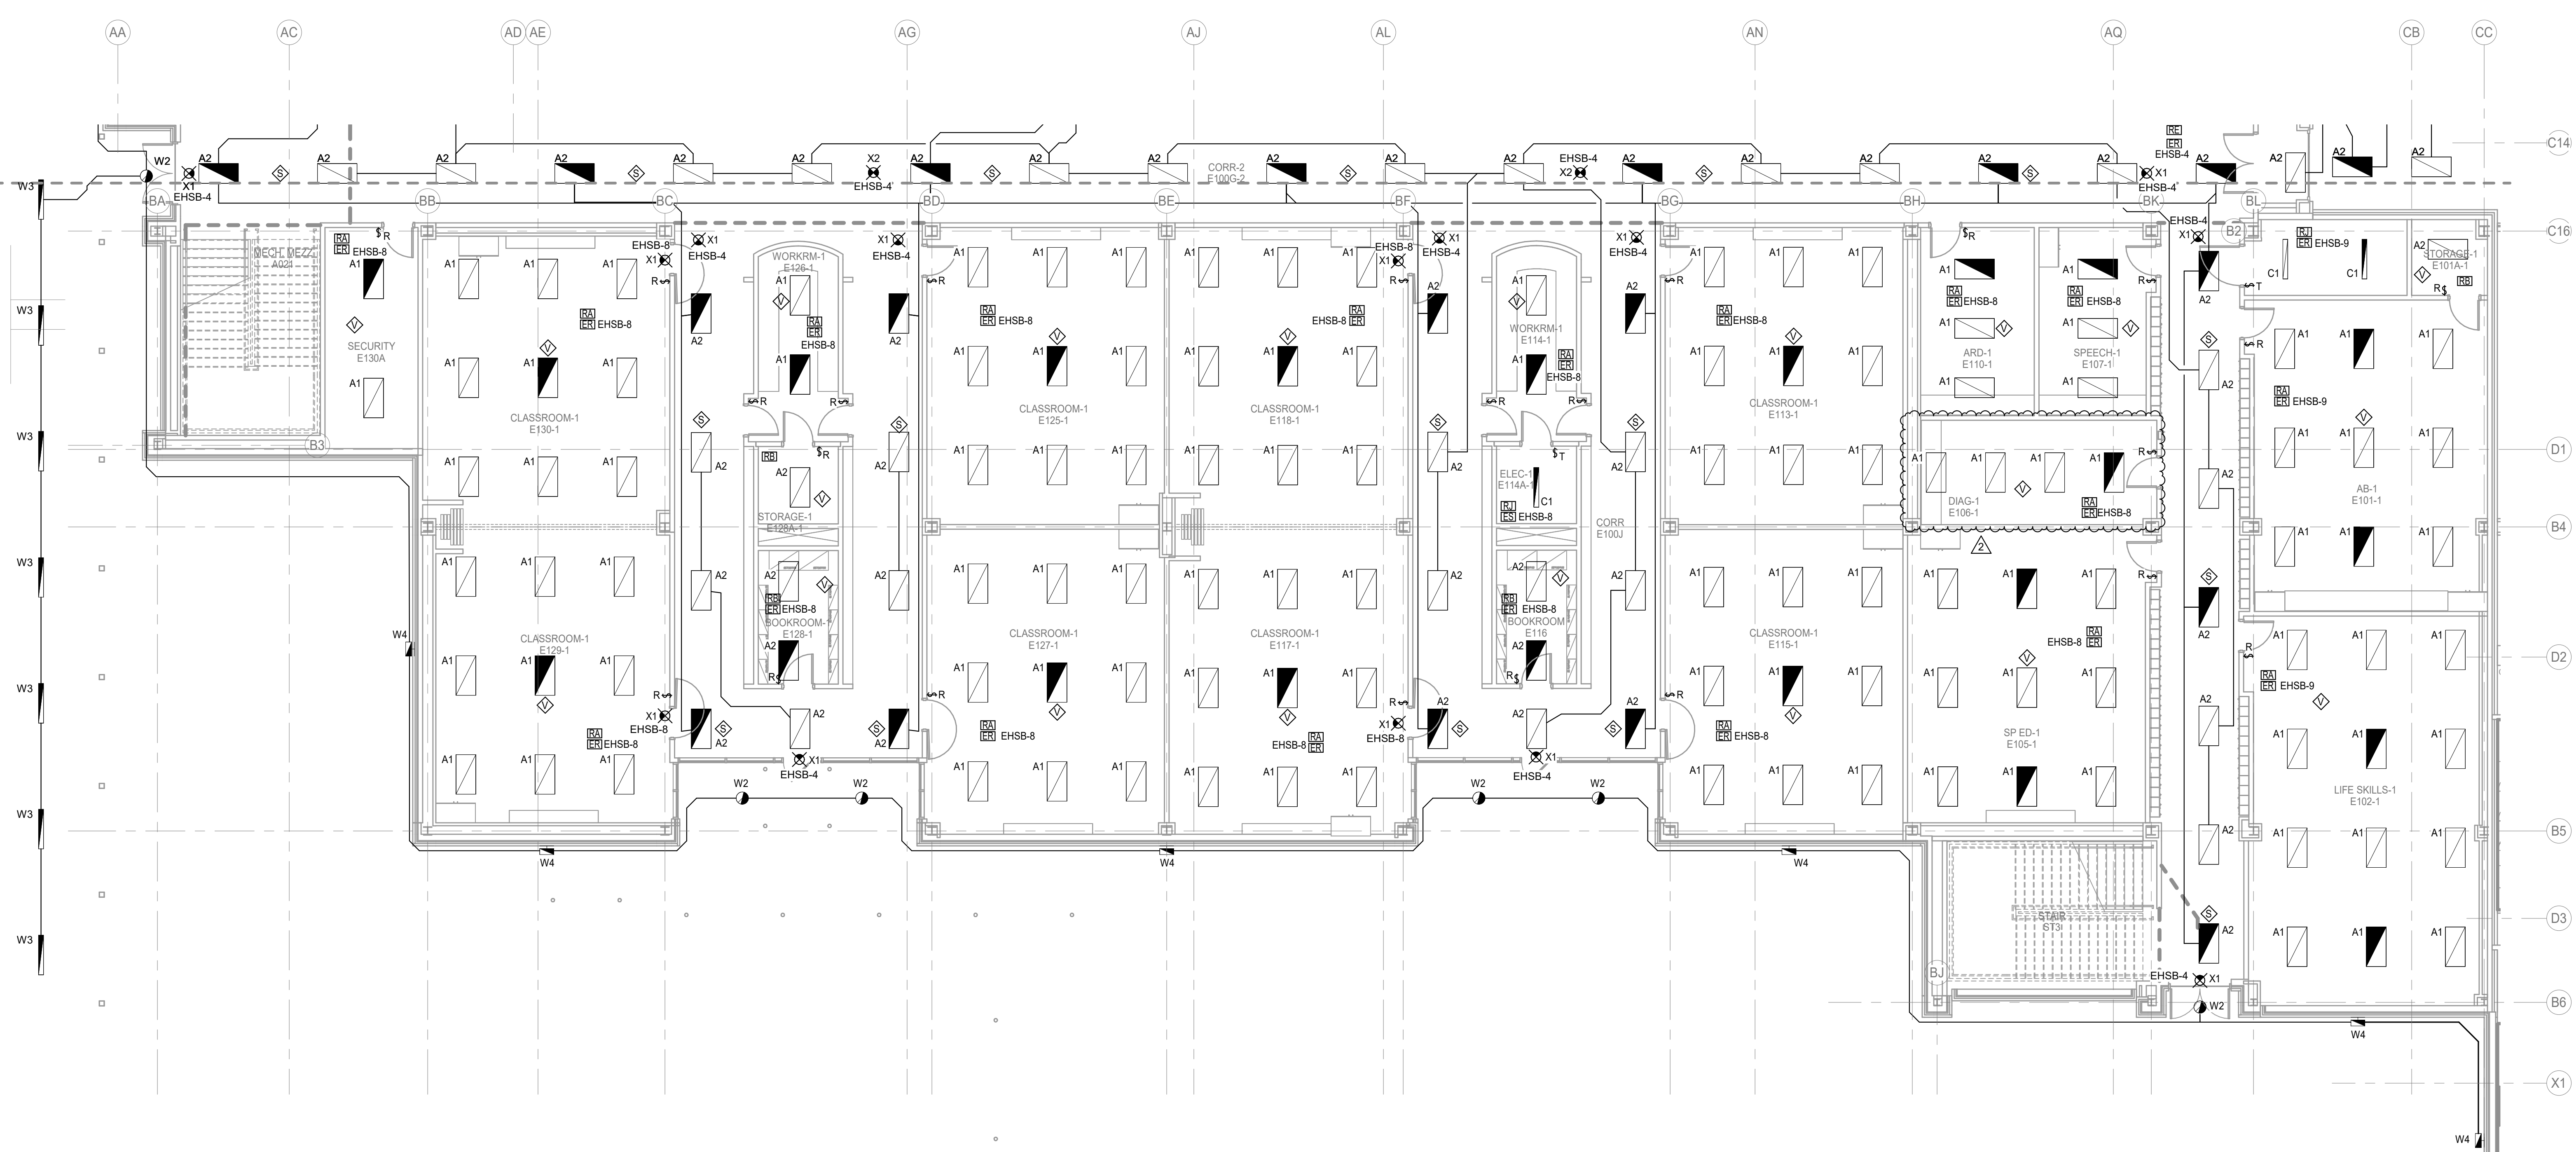

**1 ELECTRICAL LIGHTING FLOOR PLAN - LEVEL 1 - AREA B**  
 Scale: 1/8" = 1'-0"

**KEY PLAN:**

**2024 SMITH & SPILLANE MS RENOVATIONS**  
**SMITH MIDDLE SCHOOL**  
 10300 WARNER SMITH BLVD., CYPRESS, TEXAS 77433  
 CFSID PROJECT NO: 24-02-5751-R-RFP

Project Number: 23073  
 Date: 26 JANUARY 2025  
 Drawn By: WHL / KLO  
**ELECTRICAL LIGHTING**  
**FIRST FLOOR PLAN -**  
**AREA 'B'**  
**E2.02**



### ELECTRICAL KEYED NOTES

1 PROVIDE WALL MOUNTED OCCUPANCY BASED SENSOR.

**Salas O'Brien**  
 salesobrien.com 281-664-1900  
 Houston 10930 W. Sam Houston Pkwy North, Suite 900  
 Houston, TX 77064  
 Registration: F-4111  
 Project No: 2024-00209-00


#### LINE TYPE LEGEND

	EXISTING TO REMAIN
	DISCONNECT AND REMOVE
	NEW WORK

- CONTRACTOR TO FIELD COORDINATE FINAL LOCATION OF ALL REPLACEMENT AND NEW LIGHTING FIXTURES WITH EXISTING CEILING MOUNTED DEVICES AND TO NOTIFY ENGINEER IF THERE ARE ANY CONFLICTS BETWEEN EXISTING CONDITIONS AND THE NEW LIGHTING LAYOUT PRIOR TO COMMENCEMENT OF WORK.
- PROVIDE NEW LIGHTING DEVICES AND SWITCH BOX EXTENSIONS IN ALL AREAS WHERE GYPSUM BOARD OR OTHER WALL COVERING ADDS TO THE THICKNESS OF WALLS. SEE ARCHITECTURAL DRAWINGS FOR AREAS AFFECTED.
- PROVIDE (1) MOMENTARY BMCS OVERRIDE TIME-OUT SWITCH FOR BUILDING OCCUPIED/UNOCCUPIED ADJACENT TO OR IN THE BMCS MASTER PANEL, (1) MOMENTARY BMCS OVERRIDE TIME-OUT SWITCH FOR EXTERIOR FACADE LIGHTING ON/OFF AND (1) MOMENTARY BMCS OVERRIDE TIME-OUT SWITCH FOR PARKING LOT LIGHTING ON/OFF IN MAIN ELECTRICAL.

### LIGHTING GENERAL NOTES


- CONNECT NEW LIGHT FIXTURES TO EXISTING NORMAL POWER CIRCUITS LEFT IN PLACE AFTER DEMOLITION OR NEW AS SHOWN. PROVIDE EMERGENCY CIRCUIT FOR HATCHED FIXTURES AND/OR EXIT SIGNS. EXTEND WIRING WITH MATCHING CONDUCTORS/CONDUIT TO EXISTING LOCATION AND/OR NEW FIXTURES. FIELD VERIFY CONNECTED LOAD NOT TO EXCEED 3500 W @ 277V. TYPICAL.
- LOCATION OF NEW / REPLACEMENT LIGHT FIXTURES SHALL RE-USE EXISTING J-BOX AND EXISTING LIGHT FIXTURE WHIPS AS PRACTICAL. EXTEND WIRING WITH MATCHING CONDUCTORS / CONDUIT AND PROVIDE NEW J-BOX ABOVE ACCESSIBLE CEILING WITH 1/2" INCH FLEXIBLE STEEL CONDUIT OR STEEL MC CABLE LENGTH NOT TO EXCEED 6-FEET. 'DAISY CHAINING' LIGHT FIXTURES INSTALLED FOR LAY-IN CEILING AREAS IS NOT ALLOWED. FOR NON-ACCESSIBLE CEILING, LIGHT FIXTURE WHIPS SHALL BE 1/2" INCH FLEXIBLE STEEL CONDUIT. LENGTH AS REQUIRED TO MAKE A TAP AT AN ACCESSIBLE J-BOX. RECESSED LIGHT FIXTURES IN NON-ACCESSIBLE CEILING MAY BE DAISY CHAINED USING THE LIGHT FIXTURE'S INTEGRAL, UL LISTED J-BOX OR INTERNAL WIRE WAY THAT IS ACCESSIBLE THROUGH FIXTURE FROM BELOW THE CEILING. REFER TO 26 05 33 CONDUIT SYSTEMS.
- PROVIDE NEW LIGHTING CONTROLS, SENSORS AND ASSOCIATED DEVICE LOAD AND CONTROL RELAYS AND/OR TRANSFER SWITCHES. REFER TO SPECIFICATIONS AND DETAIL SHEETS.
- LOCATE DIGITAL LIGHTING CONTROLLER AND / OR EMERGENCY LOAD CONTROL RELAY ABOVE ACCESSIBLE CEILING 12-FEET AFF OR BELOW ADJACENT TO SWITCH CONTROLLING THE SPACE. IN NON-ACCESSIBLE AND / OR HIGH CEILING AREAS, LOCATE DIGITAL LIGHTING CONTROLLER IN ADJACENT ANCILLARY AREA WITH ACCESSIBLE CEILING. IN AREAS WITH NO CEILING AND / OR IN EXTERIOR APPLICATIONS LOCATE ADJACENT TO PANEL SERVING THE LOAD. PROVIDE PLASTIC TAPE MACHINE TYPED NAME PLATE TO BOTTOM OF CEILING T-GRID BELOW RELAY LOCATION. WHITE LETTERS ON BLACK BACKGROUND WITH 1/4" HIGH LETTERS ON 1/2" TALL LABEL FOR DIGITAL MODULE, INDICATE AS D.L.M.
- LOCATE DIGITAL LIGHTING CONTROLLER FOR CORRIDORS, GYM AND HIGH CEILING AREAS WITH NO ADJACENT ANCILLARY AREA ADJACENT TO NORMAL POWER PANEL SERVING THE LOAD. PROVIDE LABEL, GRID MARKERS WITH WORDING PER SPECIFICATIONS.
- LOCATE DIGITAL LIGHTING CONTROLLER FOR INSTRUCTIONAL SPACES AND OFFICES ABOVE ACCESSIBLE CEILING IN CORRIDOR DIRECTLY OUTSIDE OF ENTRY DOOR. PROVIDE LABEL IDENTIFYING ASSOCIATED SPACE, GRID MARKERS WITH WORDING PER SPECIFICATIONS.
- OCCUPANCY/VACANCY SENSOR AND DAYLIGHTING SENSOR LOCATIONS INDICATE SPACE OR AREA CONTROLLED. CONTRACTOR TO PROVIDE ACTUAL QUANTITIES, TYPES, AND MOUNTING LOCATIONS AS RECOMMENDED BY MANUFACTURER AND ICC-2015 C405.
- SPACES WITH MULTIPLE OCCUPANCY/VACANCY SENSORS OR WHERE LINE OF SIGHT MAY BE OBSCURED, SHALL BE LINKED TOGETHER FOR SIMULTANEOUS OPERATION WITHIN THE SPACE.
- CONTRACTOR SHALL MAINTAIN CONSTANT UNSWITCHED CIRCUITS FROM EXISTING SOURCE AND/OR NEW AS SHOWN FOR EMERGENCY FIXTURES. EMERGENCY LOAD RELAYS, TRANSFER SWITCHES AND EXIT SIGNS.
- COORDINATE LOCATION OF LIGHT FIXTURES IN ALL MECHANICAL AND ELECTRICAL ROOMS WITH MECHANICAL EQUIPMENT, PIPING, AND ALL OTHER TRADES.
- PROVIDE SEPARATE RACEWAY SYSTEMS FOR LIGHTING CONTROL SYSTEM CONTROL WIRING (DIMMERS OR OTHERWISE) SHALL NOT BE INSTALLED IN THE SAME RACEWAY AS LINE VOLTAGE. REFER TO 26 05 33.

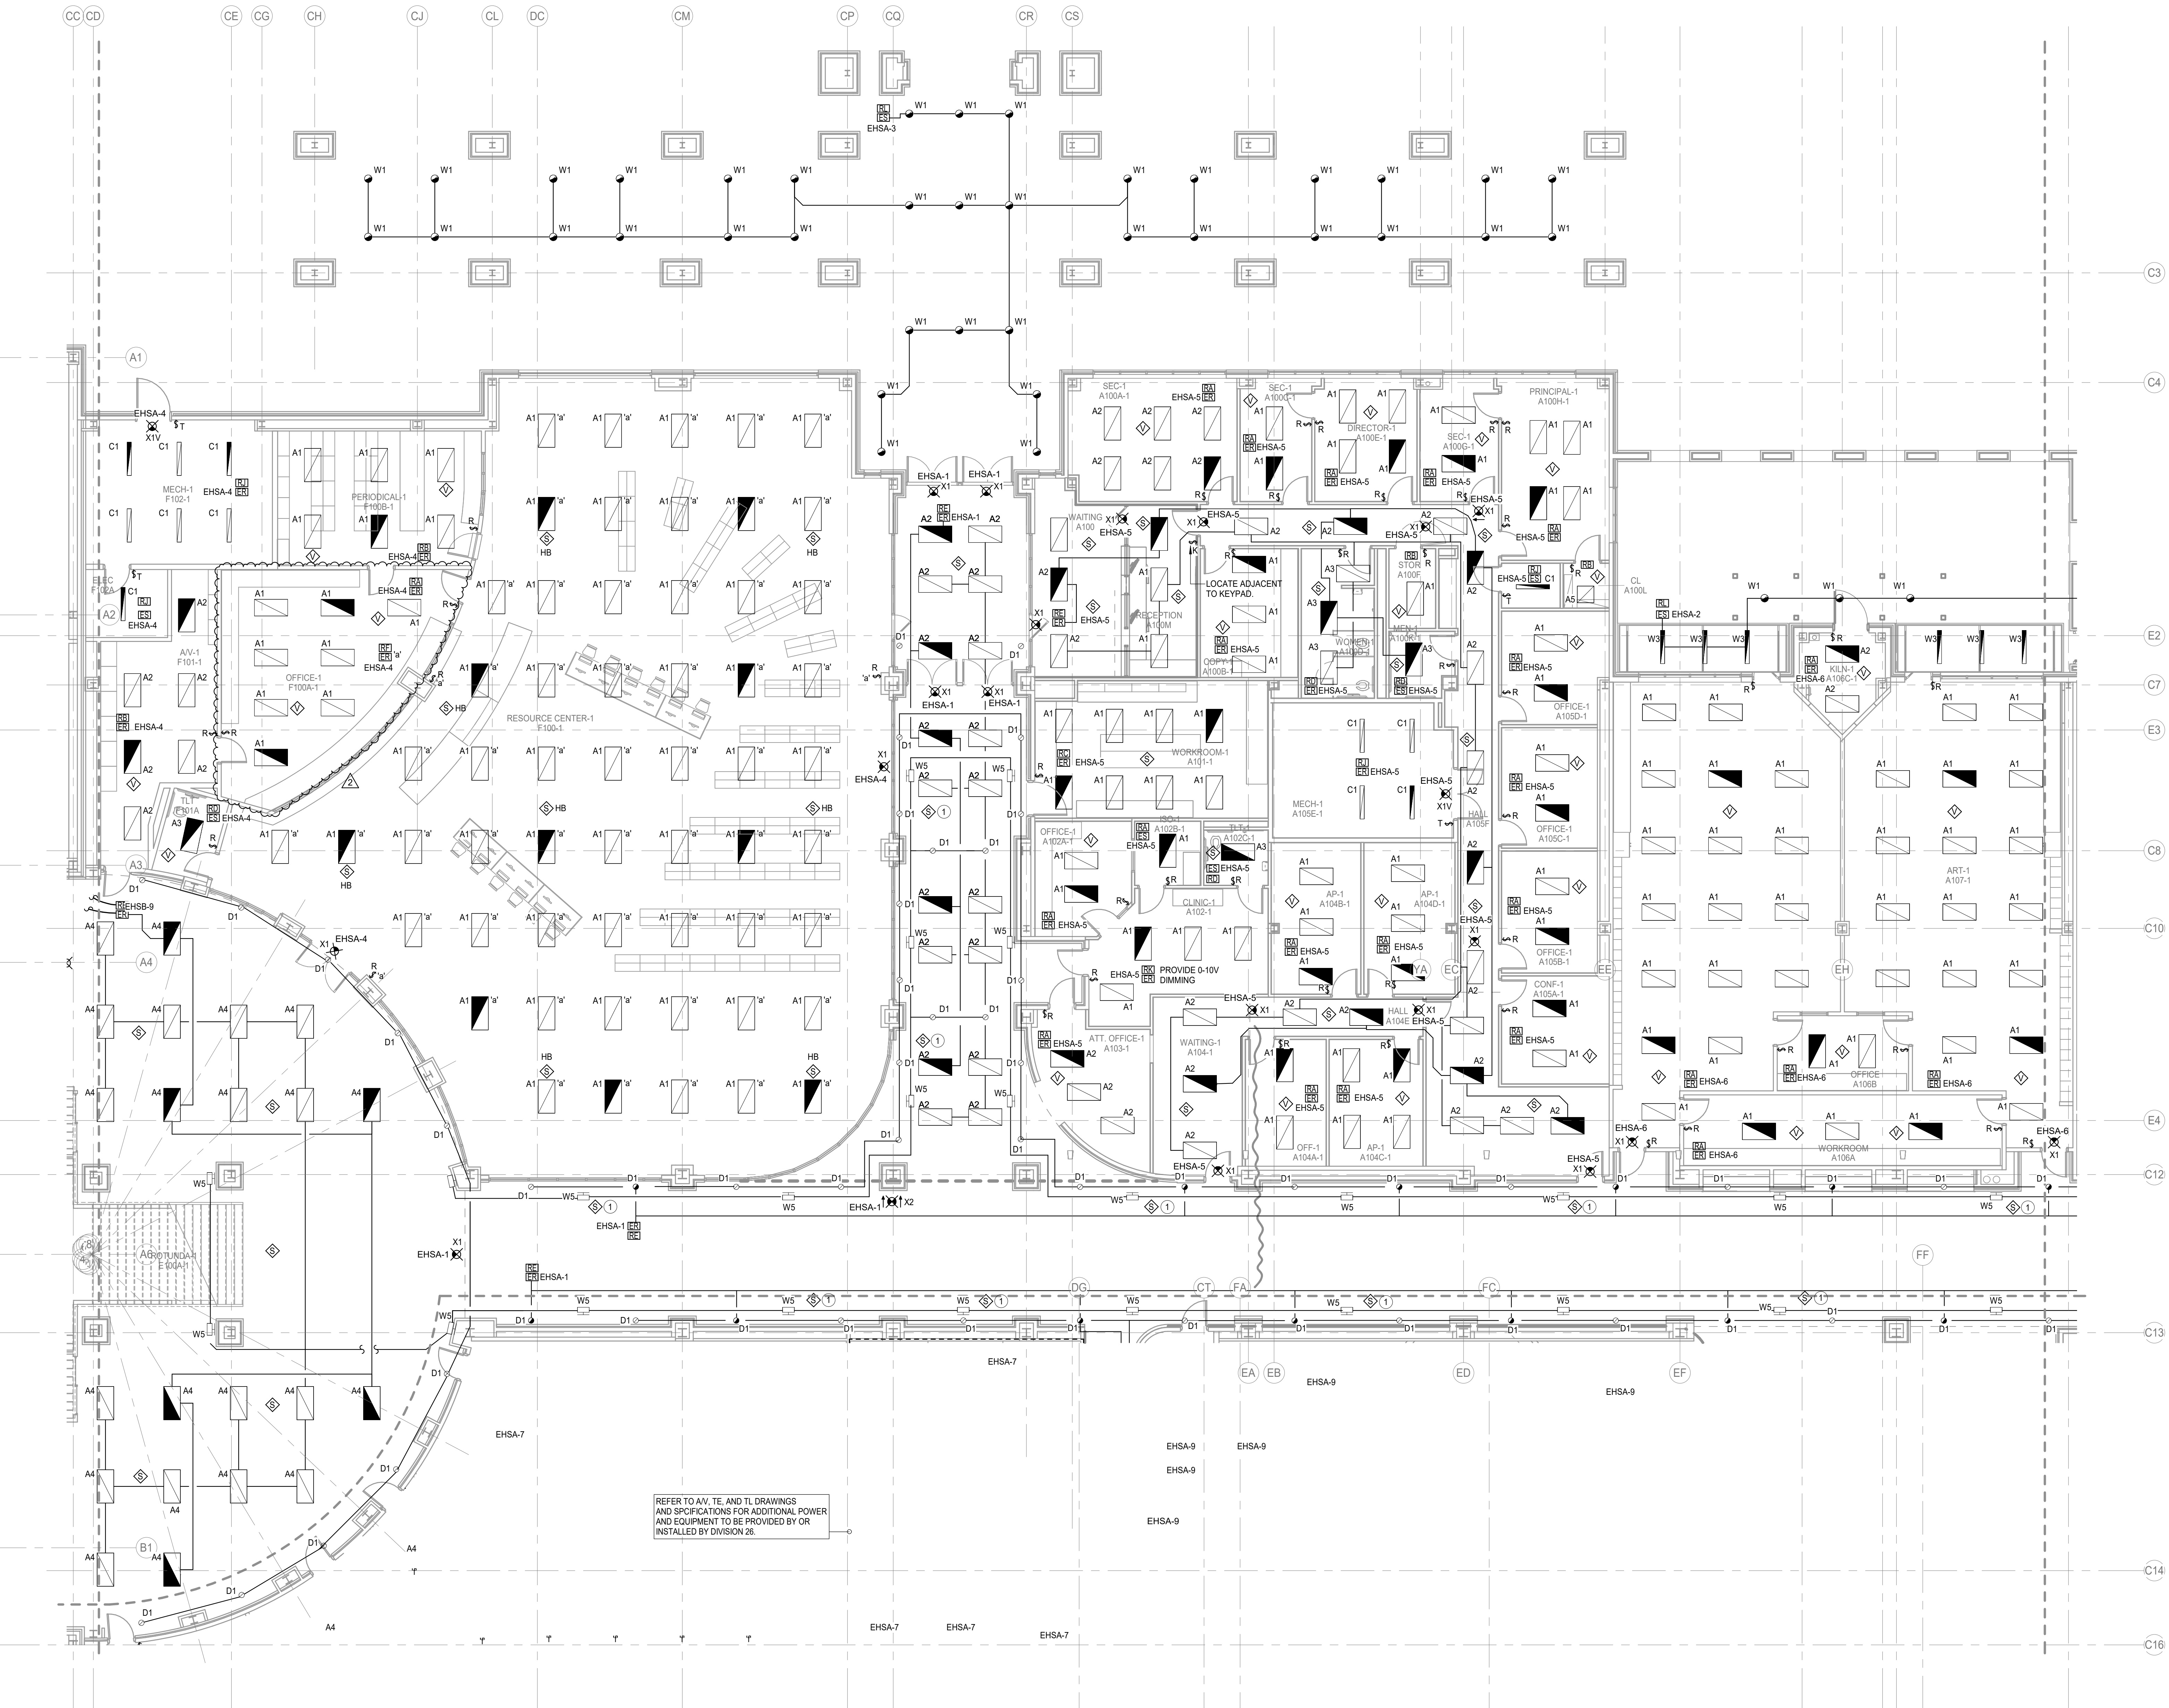

REFER TO A.V.T.E. AND T.L. DRAWINGS AND SPECIFICATIONS FOR ADDITIONAL POWER AND EQUIPMENT TO BE PROVIDED BY OR INSTALLED BY DIVISION 26.

**1 ELECTRICAL LIGHTING FLOOR PLAN - LEVEL 1 - AREA C**  
 Scale: 1/8" = 1'-0"

KEY PLAN:

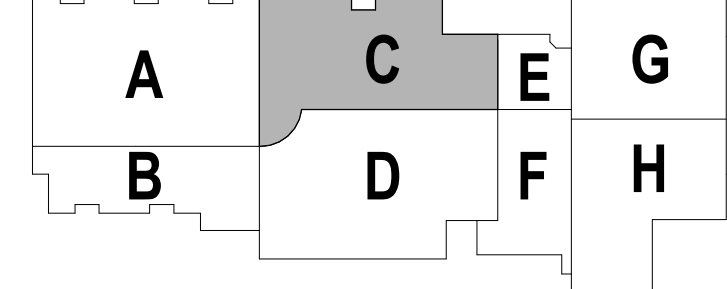

**NATEX CORPORATION ARCHITECTS**  
 www.natearchitects.com  
 447 Heights Boulevard  
 Houston, TX 77007  
 Phone: 713-975-9525  
 Fax: 713-780-7824

**Coleman Partners ARCHITECTS**  
 www.colemanpartners.com  
 3701 Kirby Drive, Suite 830  
 Houston, TX 77098  
 Tel: 832-947-1038 Fax: 282-214-5365

**CONSTRUCTION DOCUMENT**

**BRADLEY KALMANS**  
 80219  
 02-14-2025

**CIVIL ENGINEER**  
**BROOKS AND SPARKS, INC.**  
 21020 PARK ROW  
 KATY, TX 77449  
 Tel: 281-578-9595

**STRUCTURAL ENGINEER**  
**DALLY + ASSOCIATES, INC.**  
 9800 RICHMOND AVE.  
 SUITE 400  
 HOUSTON, TX 77042  
 Tel: 713-337-8881


**MEPT ENGINEER**  
**SALAS O'BRIEN**  
 10930 W. SAM HOUSTON PKWY. N.  
 SUITE 900  
 HOUSTON, TX 77064  
 Tel: 281-664-1900

**FOOD SERVICE EQUIPMENT**  
**FDP**  
 25317 INTERSTATE 45  
 THE WOODLANDS, TX 77380  
 Tel: 281-350-2323

**LANDSCAPE ARCHITECT**  
**LANDESIGN GROUP**  
 17041 EL CAMINO REAL  
 SUITE 204  
 HOUSTON, TX 77058  
 Tel: 281-486-4040

**2024 SMITH & SPILLANE MS RENOVATIONS**  
**SMITH MIDDLE SCHOOL**  
 10300 WARNER SMITH BLVD., CYPRESS, TEXAS 77433  
 CFSID PROJECT NO: 24-02-5751-R-RFP

Project Number: 23073  
 Date: 26 JANUARY 2025  
 Drawn By: WHL / KLO  
 Electrical Lighting  
 FIRST FLOOR PLAN - AREA 'C'  
**E2.03**

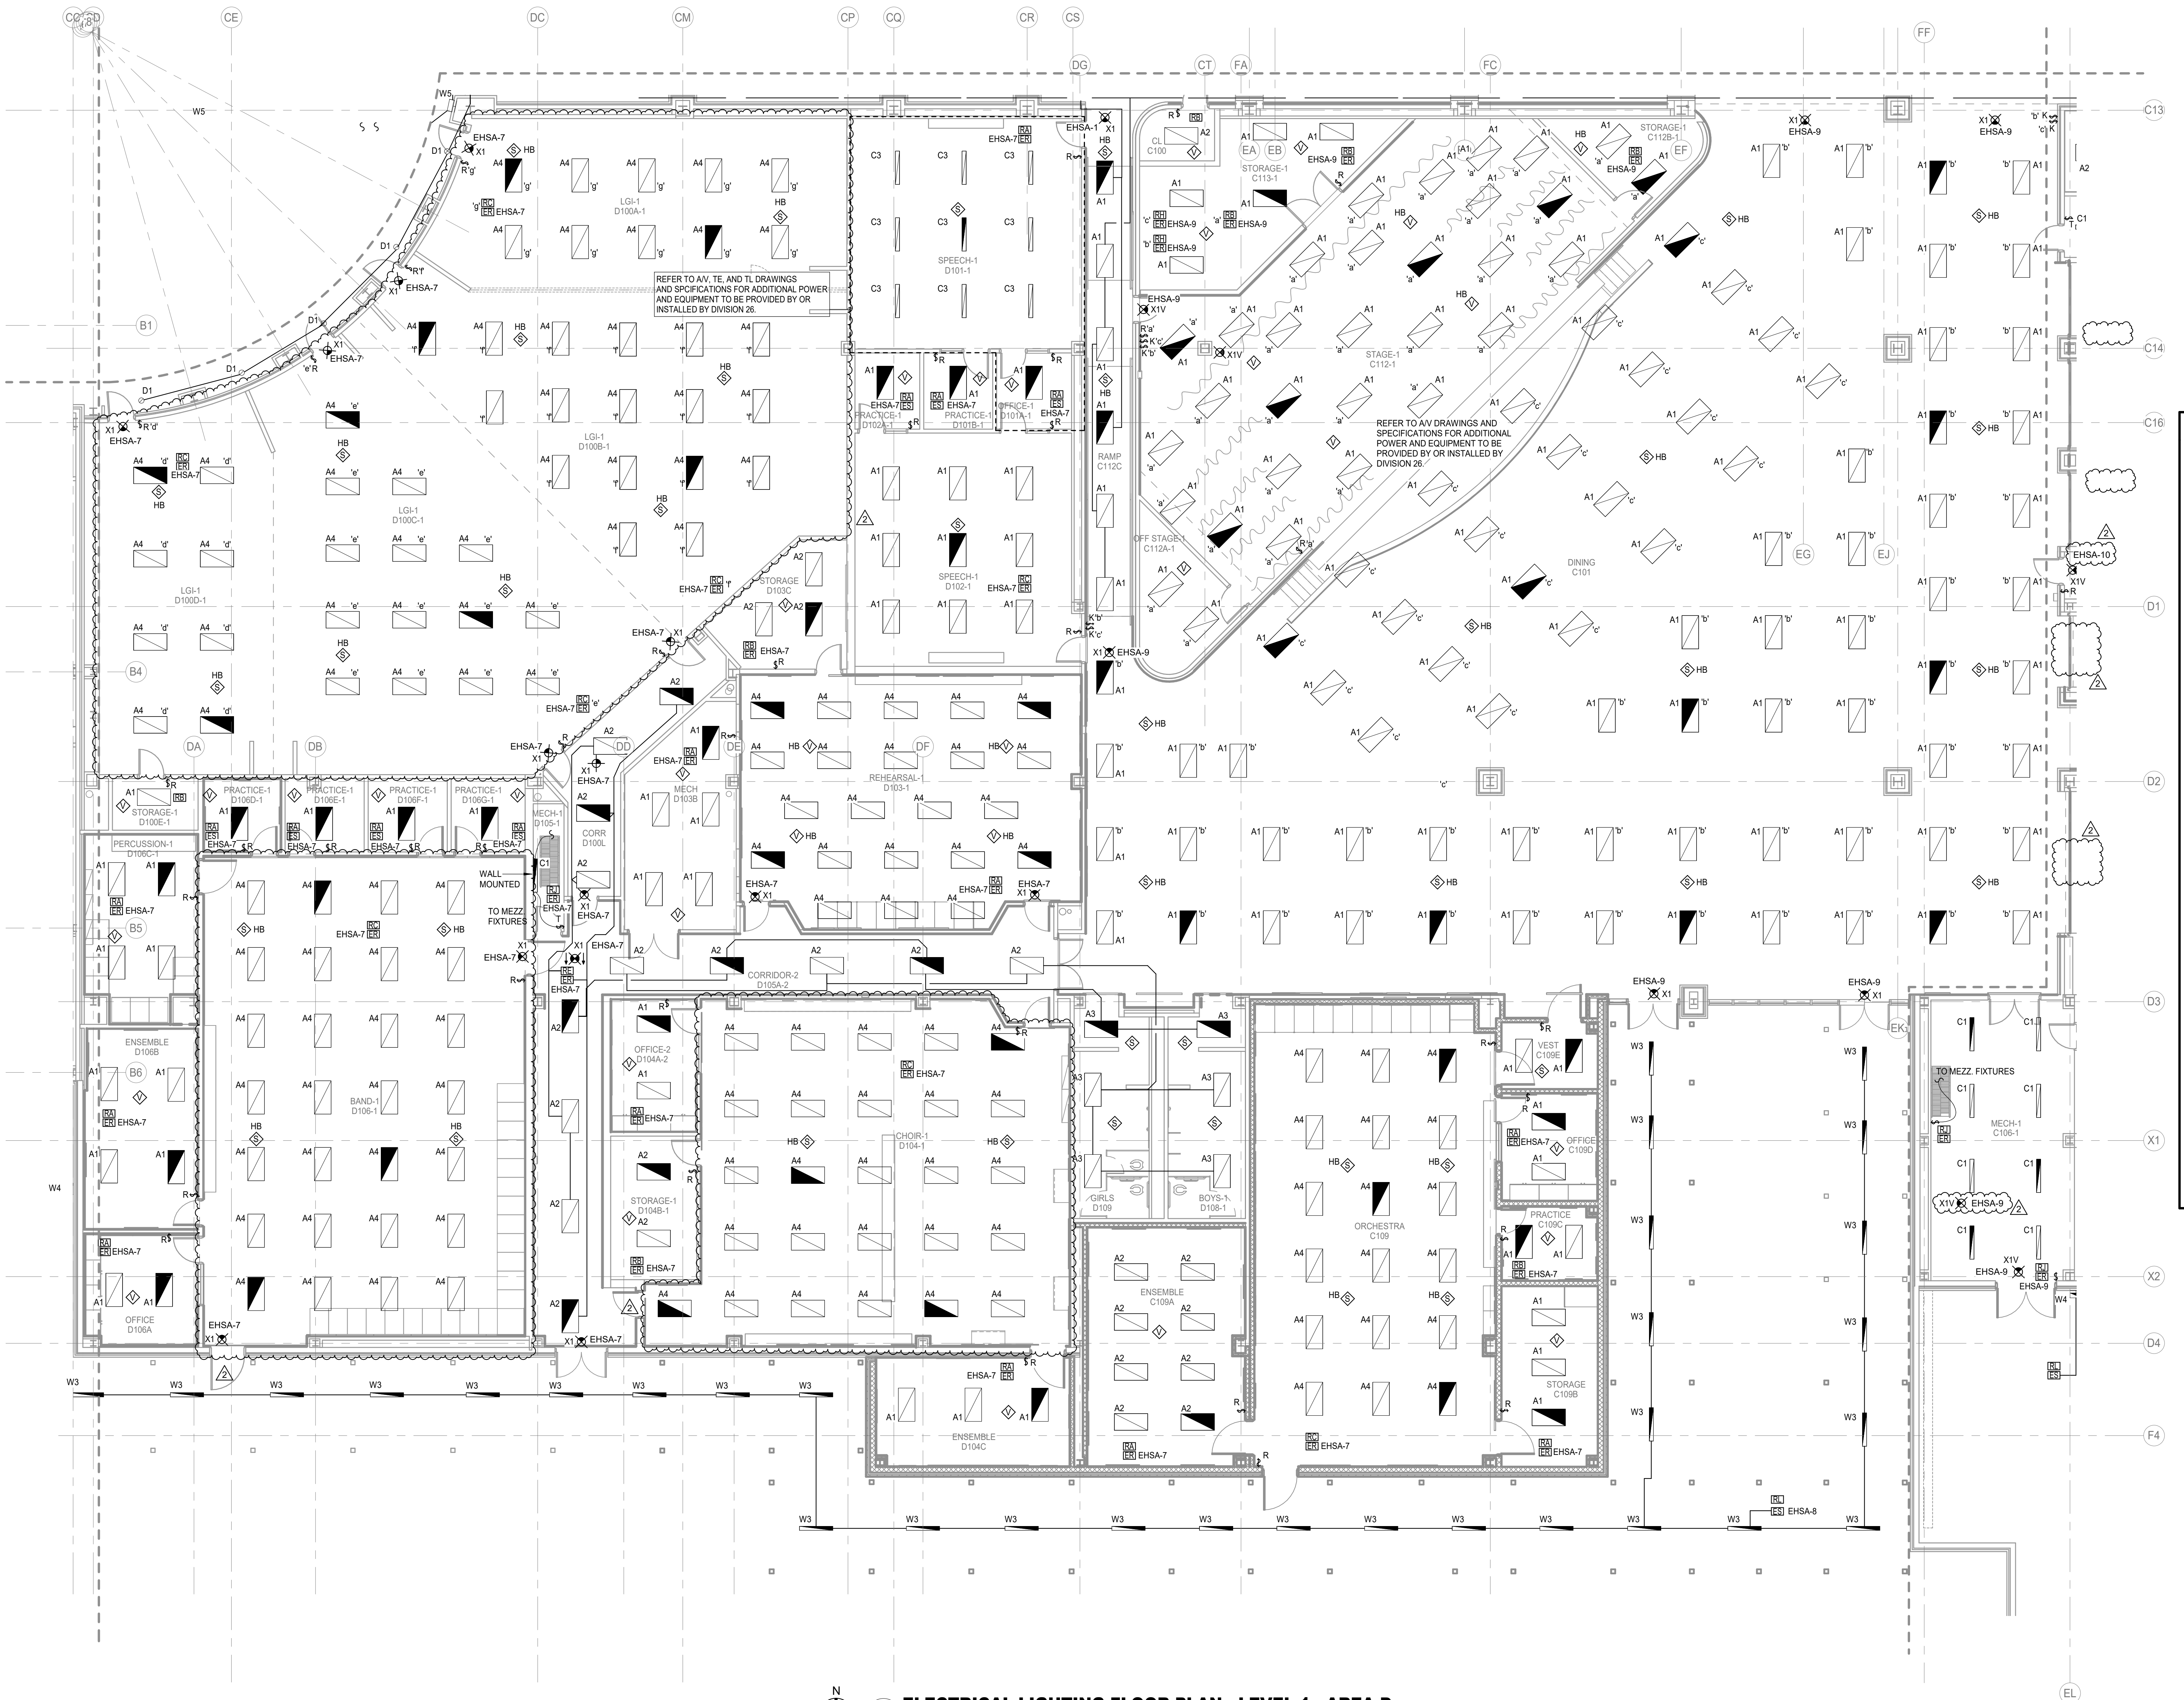

**LINE TYPE LEGEND**

	EXISTING TO REMAIN
	DISCONNECT AND REMOVE
	NEW WORK

CONTRACTOR TO FIELD COORDINATE FINAL LOCATION OF ALL REPLACEMENT AND NEW LIGHTING FIXTURES WITH EXISTING CEILING MOUNTED DEVICES AND TO NOTIFY ENGINEER IF THERE ARE ANY CONFLICTS BETWEEN EXISTING CONDITIONS AND THE NEW LIGHTING LAYOUT PRIOR TO COMMENCEMENT OF WORK.

PROVIDE NEW LIGHTING DEVICES AND SWITCH BOX EXTENSIONS IN ALL AREAS WHERE GYPSUM BOARD OR OTHER WALL COVERING ADDS TO THE THICKNESS OF WALL. SEE ARCHITECTURAL DRAWINGS FOR AREAS AFFECTED.


PROVIDE (1) MOMENTARY BMCS OVERRIDE TIME-OUT SWITCH FOR BUILDING OCCUPIED/UNOCCUPIED ADJACENT TO OR IN THE BMCS MASTER PANEL; (1) MOMENTARY BMCS OVERRIDE TIME-OUT SWITCH FOR EXTERIOR FACADE LIGHTING ON/OFF AND (1) MOMENTARY BMCS OVERRIDE TIME-OUT SWITCH FOR PARKING LOT LIGHTING ON/OFF IN MAIN ELECTRICAL.

**LIGHTING GENERAL NOTES**

- CONNECT NEW LIGHT FIXTURES TO EXISTING NORMAL POWER CIRCUITS LEFT IN PLACE AFTER DEMOLITION OR NEW AS SHOWN. PROVIDE EMERGENCY CIRCUIT FOR HATCHED FIXTURES AND/OR EXISTING LIGHTING. EXTEND WIRING WITH MATCHING CONDUCTORS / CONDUIT AND PROVIDE NEW J-BOX ABOVE ACCESSIBLE CEILING WITH 1/2-INCH FLEXIBLE STEEL CONDUIT OR FLEXIBLE STEEL CONDUIT NOT TO EXCEED 6-FEET. 'DAISY CHAINING' LIGHT FIXTURES INSTALLED FOR LAY-IN CEILING AREAS IS NOT ALLOWED. FOR NON-ACCESSIBLE CEILING, LIGHT FIXTURE WHIPS SHALL BE 1/2-INCH FLEXIBLE STEEL CONDUIT, LENGTH AS REQUIRED TO MAKE A TAP AT AN ACCESSIBLE J-BOX. RECESSED LIGHT FIXTURES IN NON-ACCESSIBLE CEILING MAY BE DAISY CHAINED USING THE LIGHT FIXTURE'S INTEGRAL, UL LISTED J-BOX OR INTERNAL WIRE WAY THAT IS ACCESSIBLE THROUGH FIXTURE FROM BELOW THE CEILING. REFER TO 26 05 33 CONDUIT SYSTEMS.
- PROVIDE NEW LIGHTING CONTROLS, SENSORS AND ASSOCIATED DRIVER LOAD CONTROL RELAYS AND/OR TRANSFER SWITCHES. REFER TO SPECIFICATIONS AND DETAIL SHEETS.
- LOCATE DIGITAL LIGHTING CONTROLLER AND / OR EMERGENCY LOAD CONTROL RELAY ABOVE ACCESSIBLE CEILING 12-FEET AFF OR BELOW ADJACENT TO SWITCH CONTROLLING THE SPACE. IN NON-ACCESSIBLE AND / OR HIGH CEILING AREAS, LOCATE DIGITAL LIGHTING CONTROLLER IN ADJACENT ANCILLARY AREA WITH ACCESSIBLE CEILING. IN AREAS WITH NO CEILING AND / OR IN EXTERIOR APPLICATIONS LOCATE ADJACENT TO PANEL SERVING THE LOAD. PROVIDE PLASTIC TAPE MACHINE TYPED NAME PLATE TO BOTTOM OF CEILING T-GRID BELOW RELAY LOCATION. WHITE LETTERS ON BLACK BACKGROUND WITH 1/4" HIGH LETTERS ON 1/2" TALL LABEL FOR DIGITAL MODULE, INDICATE AS D.I.M.
- LOCATE DIGITAL LIGHTING CONTROLLER FOR CORRIDORS, GYM AND HIGH CEILING AREAS WITH NO ADJACENT ANCILLARY AREA ADJACENT TO NORMAL POWER PANEL SERVING THE LOAD. PROVIDE LABEL, GRID MARKERS WITH WORDING PER SPECIFICATIONS.
- LOCATE DIGITAL LIGHTING CONTROLLER FOR INSTRUCTIONAL SPACES AND OFFICES ABOVE ACCESSIBLE CEILING IN CORRIDOR DIRECTLY OUTSIDE OF ENTRY DOOR. PROVIDE LABEL IDENTIFYING ASSOCIATED SPACE, GRID MARKERS WITH WORDING PER SPECIFICATIONS.
- OCCUPANCY/VACANCY SENSOR AND DAYLIGHTING SENSOR LOCATIONS INDICATE SPACE OR AREA CONTROLLED. CONTRACTOR TO PROVIDE ACTUAL QUANTITIES, TYPES, AND MOUNTING LOCATIONS AS RECOMMENDED BY MANUFACTURER AND ICC-2015 C405.
- SPACES WITH MULTIPLE OCCUPANCY/VACANCY SENSORS OR WHERE LINE OF SIGHT MAY BE OBSCURED, SHALL BE LINKED TOGETHER FOR SIMULTANEOUS OPERATION WITHIN THE SPACE.
- CONTRACTOR SHALL MAINTAIN CONSTANT UNSWITCHED CIRCUITS FROM EXISTING SOURCE AND/OR NEW AS SHOWN FOR EMERGENCY FIXTURES, EMERGENCY LOAD RELAYS, TRANSFER SWITCHES AND EXIT SIGNS.
- COORDINATE LOCATION OF LIGHT FIXTURES IN ALL MECHANICAL AND ELECTRICAL ROOMS WITH MECHANICAL EQUIPMENT, PIPING, AND ALL OTHER TRADES.
- PROVIDE SEPARATE RACEWAY SYSTEMS FOR LIGHTING CONTROL SYSTEM CONTROL WIRING (DIMMERS OR OTHERWISE) SHALL NOT BE INSTALLED IN THE SAME RACEWAY AS LINE VOLTAGE. REFER TO 26 05 33.

**1 ELECTRICAL LIGHTING FLOOR PLAN - LEVEL 1 - AREA D**  
 Scale: 1/8" = 1'-0"


**KEY PLAN:**

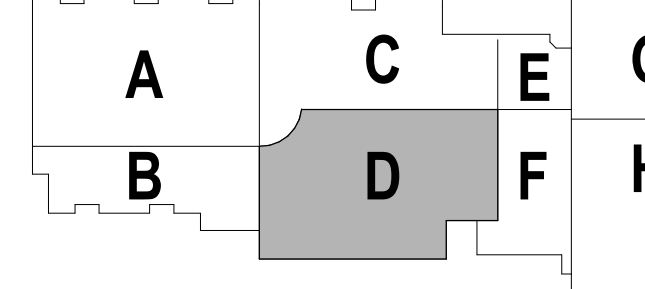



**ELECTRICAL KEYED NOTES**

1 PROVIDE WALL MOUNTED OCCUPANCY BASED SENSOR.

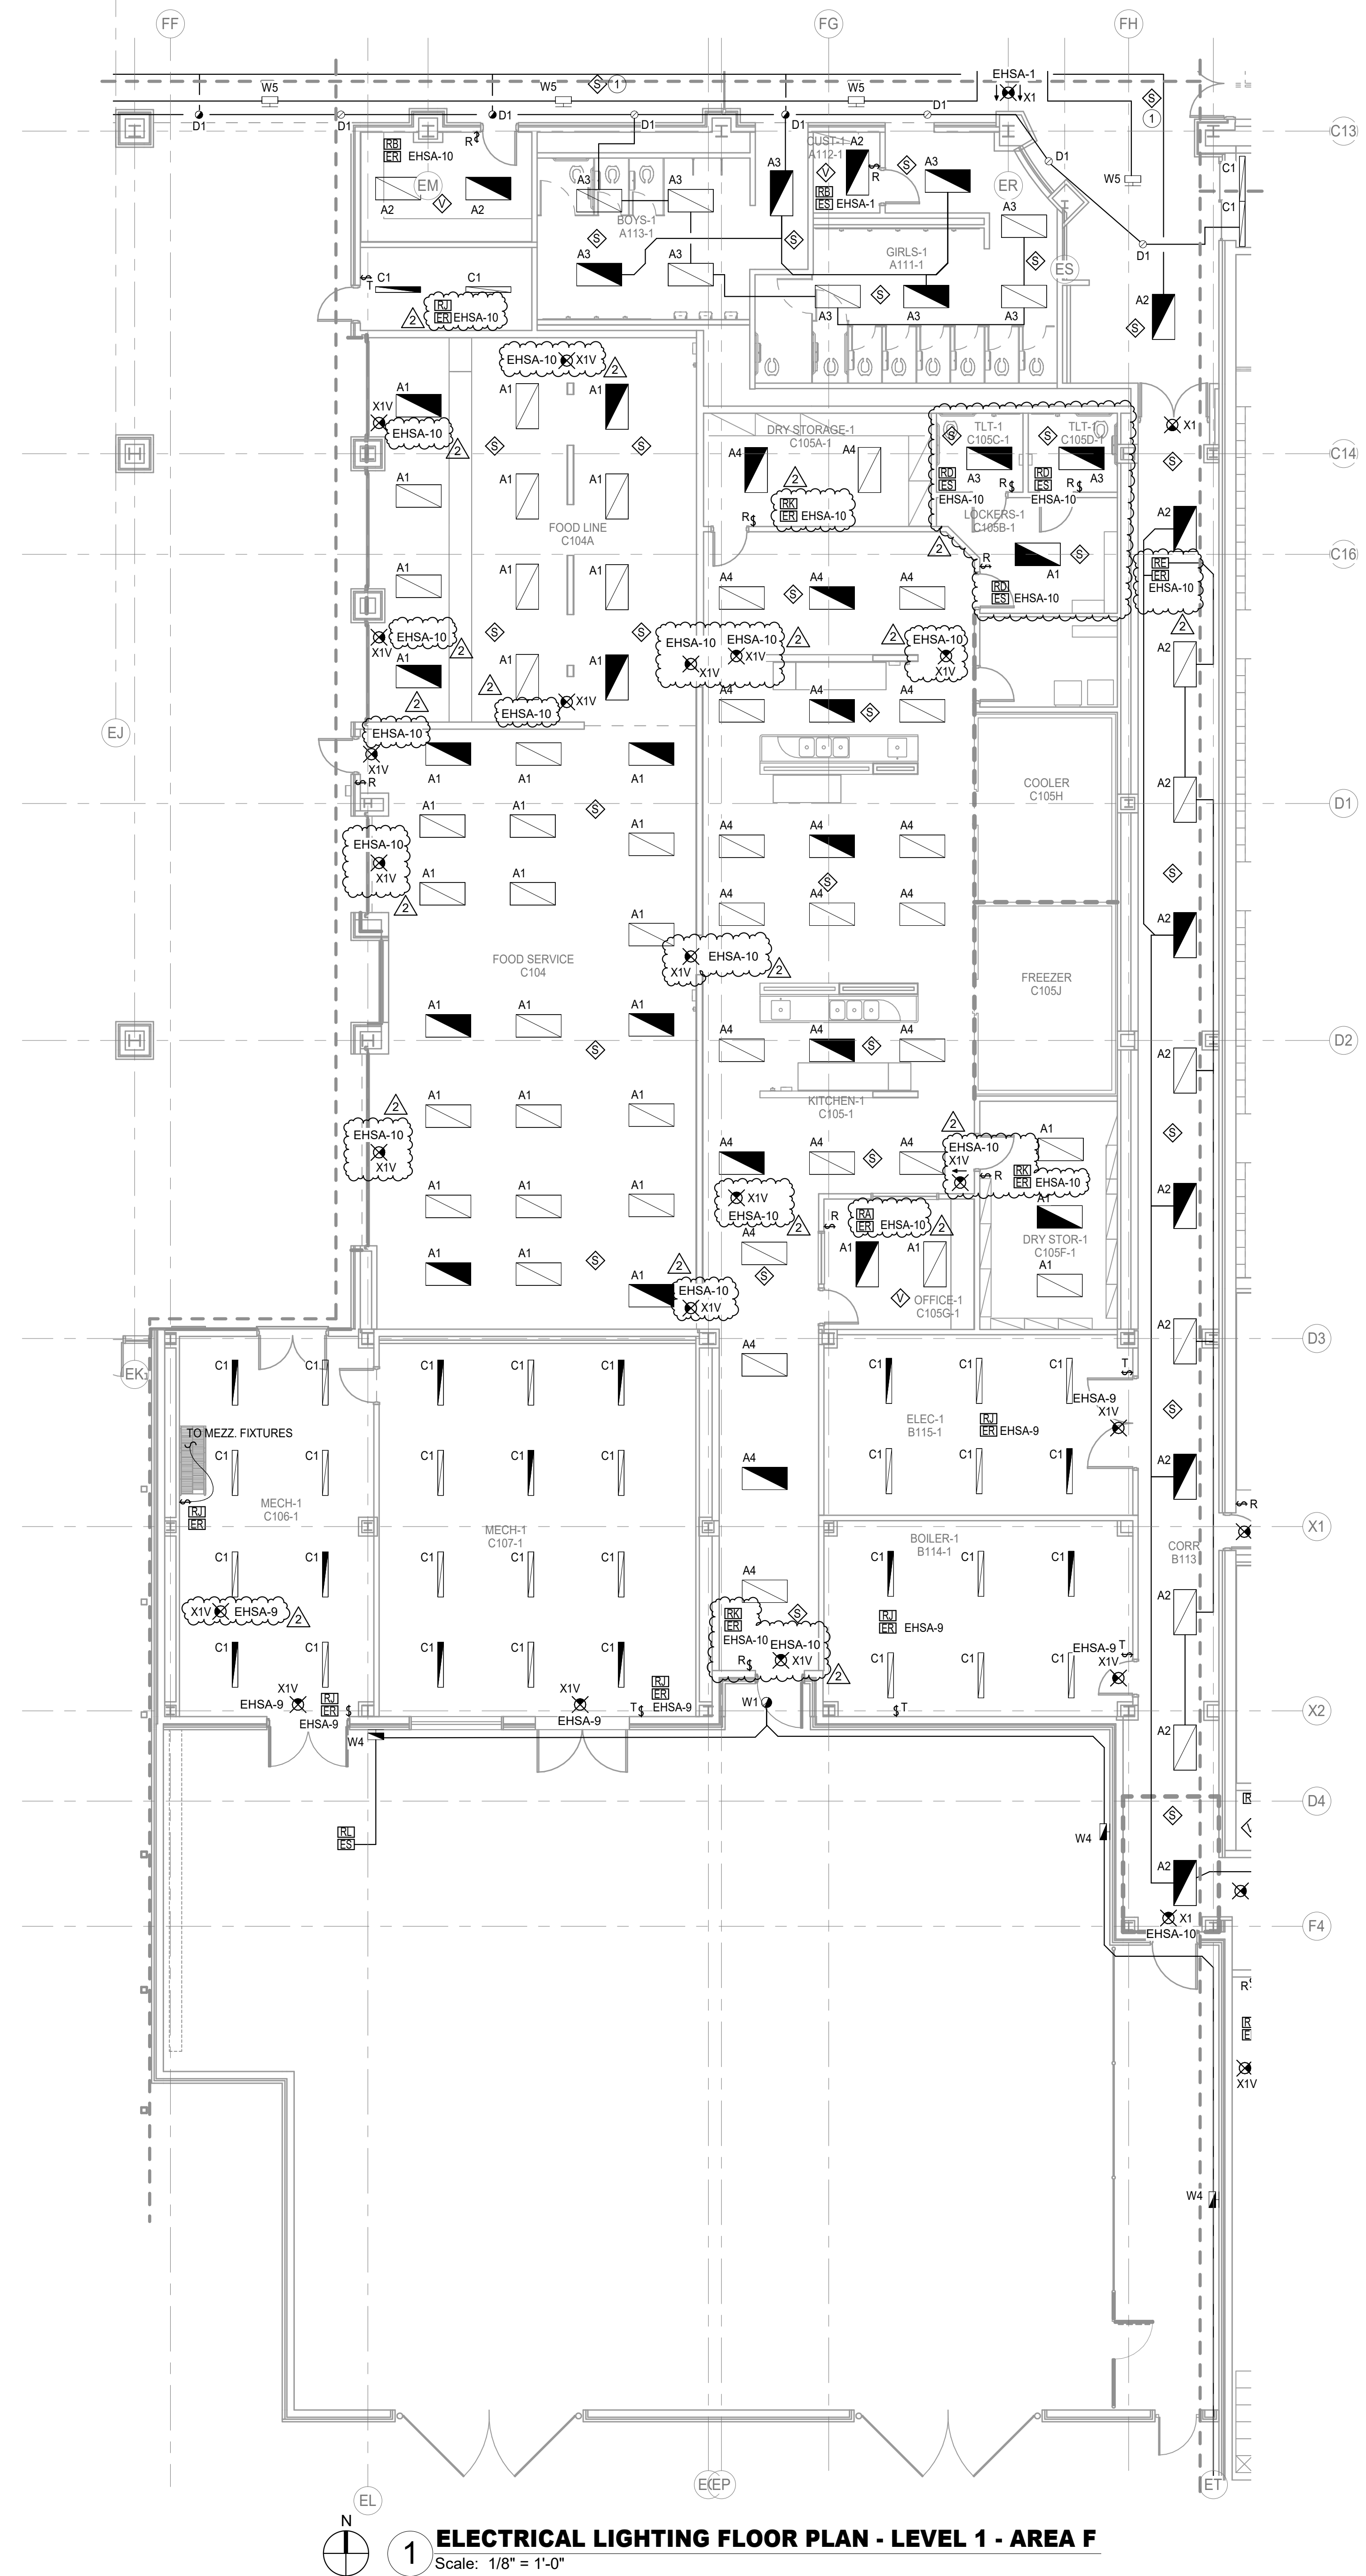

**Salas O'Brien**  
 salesobrien.com 281-664-1900  
 Houston 10930 W. Sam Houston Pkwy North, Suite 900  
 Houston, TX 77064  
 Registration: F-4111  
 Project No: 2024-00209-00

**LINE TYPE LEGEND**

	EXISTING TO REMAIN
	DISCONNECT AND REMOVE
	NEW WORK

CONTRACTOR TO FIELD COORDINATE FINAL LOCATION OF ALL REPLACEMENT AND NEW LIGHTING FIXTURES WITH EXISTING CEILING MOUNTED DEVICES AND TO NOTIFY ENGINEER IF THERE ARE ANY CONFLICTS BETWEEN EXISTING CONDITIONS AND THE NEW LIGHTING LAYOUT PRIOR TO COMMENCEMENT OF WORK.

PROVIDE NEW LIGHTING DEVICES AND SWITCH BOX EXTENSIONS IN ALL AREAS WHERE GYPSUM BOARD OR OTHER WALL COVERING ADDS TO THE THICKNESS OF WALLS. SEE ARCHITECTURAL DRAWINGS FOR AREAS AFFECTED.

PROVIDE (1) MOMENTARY BMCS OVERRIDE TIME-OUT SWITCH FOR BUILDING OCCUPIED/UNOCCUPIED ADJACENT TO OR IN THE BMCS MASTER PANEL, (1) MOMENTARY BMCS OVERRIDE TIME-OUT SWITCH FOR EXTERIOR FACADE LIGHTING ON/OFF AND (1) MOMENTARY BMCS OVERRIDE TIME-OUT SWITCH FOR PARKING LOT LIGHTING ON/OFF IN MAIN ELECTRICAL.

**LIGHTING GENERAL NOTES**

- CONNECT NEW LIGHT FIXTURES TO EXISTING NORMAL POWER CIRCUITS LEFT IN PLACE AFTER DEMOLITION OR NEW AS SHOWN. PROVIDE EMERGENCY CIRCUIT FOR HATCHED FIXTURES AND/OR EXIT SIGNS. EXTEND WIRING WITH MATCHING CONDUCTORS / CONDUIT TO EXISTING LOCATION AND/OR NEW FIXTURES. FIELD VERIFY CONNECTED LOAD NOT TO EXCEED 3500 W @ 277V. TYPICAL.
- LOCATION OF NEW / REPLACEMENT LIGHT FIXTURES SHALL RE-USE EXISTING J-BOX AND EXISTING LIGHT FIXTURE WHIPS AS PRACTICAL. EXTEND WIRING WITH MATCHING CONDUCTORS / CONDUIT AND PROVIDE NEW J-BOX ABOVE ACCESSIBLE CEILING WITH 1/2-INCH FLEXIBLE STEEL CONDUIT OR STEEL MC CABLE LENGTH NOT TO EXCEED 6-FEET. 'DAISY CHAINING' LIGHT FIXTURES INSTALLED FOR LAY-IN CEILING AREAS IS NOT ALLOWED. FOR NON-ACCESSIBLE CEILING, LIGHT FIXTURE WHIPS SHALL BE 1/2-INCH FLEXIBLE STEEL CONDUIT. LENGTH AS REQUIRED TO MAKE A TAP AT AN ACCESSIBLE J-BOX. RECESSED LIGHT FIXTURES IN NON-ACCESSIBLE CEILING MAY BE DAISY CHAINED USING THE LIGHT FIXTURE'S INTEGRAL, UL LISTED J-BOX OR INTERNAL WIREWAY THAT IS ACCESSIBLE THROUGH FIXTURE FROM BELOW THE CEILING. REFER TO 26 05 33 CONDUIT SYSTEMS.
- PROVIDE NEW LIGHTING CONTROLS, SENSORS AND ASSOCIATED DEVICES. 20A EMERGENCY LOAD CONTROL RELAYS AND/OR TRANSFER SWITCHES. REFER TO SPECIFICATIONS AND DETAIL SHEETS.
- LOCATE DIGITAL LIGHTING CONTROLLER AND / OR EMERGENCY LOAD CONTROL RELAY ABOVE ACCESSIBLE CEILING 12-FEET AFF OR BELOW ADJACENT TO SWITCH CONTROLLING THE SPACE. IN NON-ACCESSIBLE AND / OR HIGH CEILING AREAS, LOCATE DIGITAL LIGHTING CONTROLLER IN ADJACENT ANCILLARY AREA WITH ACCESSIBLE CEILING. IN AREAS WITH NO CEILING AND / OR IN EXTERIOR APPLICATIONS LOCATE ADJACENT TO PANEL SERVING THE LOAD. PROVIDE PLASTIC TAPE MACHINE TYPED NAME PLATE TO BOTTOM OF CEILING T-GRID BELOW RELAY LOCATION. WHITE LETTERS ON BLACK BACKGROUND WITH 1/4" HIGH LETTERS ON 1/2" TALL LABEL FOR DIGITAL MODULE. INDICATE AS DLM.
- LOCATE DIGITAL LIGHTING CONTROLLER FOR CORRIDORS, GYM AND HIGH CEILING AREAS WITH NO ADJACENT ANCILLARY AREA ADJACENT TO NORMAL POWER PANEL SERVING THE LOAD. PROVIDE LABEL, GRID MARKERS WITH WORDING PER SPECIFICATIONS.
- LOCATE DIGITAL LIGHTING CONTROLLER FOR INSTRUCTIONAL SPACES AND OFFICES ABOVE ACCESSIBLE CEILING IN CORRIDOR DIRECTLY OUTSIDE OF ENTRY DOOR. PROVIDE LABEL IDENTIFYING ASSOCIATED SPACE. GRID MARKERS WITH WORDING PER SPECIFICATIONS.
- OCCUPANCY/VACANCY SENSOR AND DAYLIGHTING SENSOR LOCATIONS INDICATE SPACE OR AREA CONTROLLED. CONTRACTOR TO PROVIDE ACTUAL QUANTITIES, TYPES, AND MOUNTING LOCATIONS AS RECOMMENDED BY MANUFACTURER AND ICC-2015 C405.
- SPACES WITH MULTIPLE OCCUPANCY/VACANCY SENSORS OR WHERE LINE OF SIGHT MAY BE OBSCURED, SHALL BE LINKED TOGETHER FOR SIMULTANEOUS OPERATION WITHIN THE SPACE.
- CONTRACTOR SHALL MAINTAIN CONSTANT UNSWITCHED CIRCUITS FROM EXISTING SOURCE AND/OR NEW AS SHOWN FOR EMERGENCY FIXTURES. EMERGENCY LOAD RELAYS, TRANSFER SWITCHES AND EXIT SIGNS.
- COORDINATE LOCATION OF LIGHT FIXTURES IN ALL MECHANICAL AND ELECTRICAL ROOMS WITH MECHANICAL EQUIPMENT, PIPING, AND ALL OTHER TRADES.
- PROVIDE SEPARATE RACEWAY SYSTEMS FOR LIGHTING CONTROL SYSTEM CONTROLS WIRING (DIMMERS OR OTHERWISE) SHALL NOT BE INSTALLED IN THE SAME RACEWAY AS LINE VOLTAGE. REFER TO 26 05 33.

**NATEX CORPORATION ARCHITECTS**  
 www.natearchitects.com  
 447 Heights Boulevard  
 Houston, TX 77007  
 Phone: 713-975-9525  
 Fax: 713-780-7824

**Coleman Partners ARCHITECTS**  
 www.colemanpartners.com  
 3701 Kirby Drive, Suite 830  
 Houston, TX 77098  
 tel: 832.947.1038 fax: 282.214.5365

**CONSTRUCTION DOCUMENT**  
 BRADLEY KALMANS  
 80219 / CENSY  
 02-14-2025

**CIVIL ENGINEER BROOKS AND SPARKS, INC.**  
 21020 PARK ROW  
 KATY, TX 77449  
 tel: 281.578.9595

**STRUCTURAL ENGINEER DALLY + ASSOCIATES, INC.**  
 9800 RICHMOND AVE. SUITE 400  
 HOUSTON, TX 77042  
 tel: 713.337.8881

**MEPT ENGINEER SALAS O'BRIEN**  
 10930 W. SAM HOUSTON PKWY. N. SUITE 900  
 HOUSTON, TX 77064  
 tel: 281.664.1900

**FOOD SERVICE EQUIPMENT FDP**  
 25317 INTERSTATE 45  
 THE WOODLANDS, TX 77380  
 tel: 281.350.2323

**LANDSCAPE ARCHITECT LANDESGRUP GROUP**  
 17041 EL CAMINO REAL SUITE 204  
 HOUSTON, TX 77058  
 tel: 281.486.4040


**2024 SMITH & SPILLANE MS RENOVATIONS**  
**SMITH MIDDLE SCHOOL**  
 10300 WARNER SMITH BLVD., CYPRESS, TEXAS 77433  
 CFSID PROJECT NO: 24-02-5751-R-RFP

2	Addendum 03	02-14-25
1	Revisions / Submission	

Project Number: 23073  
 Date: 26 JANUARY 2025  
 Drawn By: WHL / KLO

ELECTRICAL LIGHTING FIRST FLOOR PLAN - AREA 'F'

**E2.06**

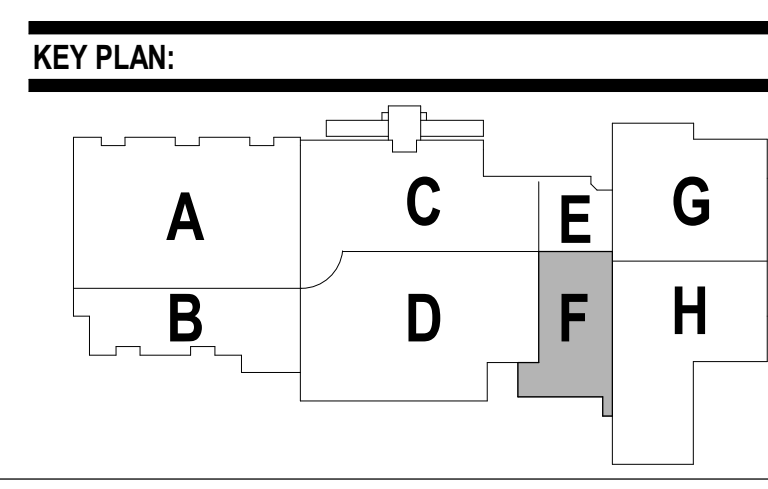

**1 ELECTRICAL LIGHTING FLOOR PLAN - LEVEL 1 - AREA F**  
 Scale: 1/8" = 1'-0"

**LINE TYPE LEGEND**

---	EXISTING TO REMAIN
- - -	DISCONNECT AND REMOVE
---	NEW WORK

WHERE ANY WALL TERMINATES AT THE SAME LOCATION AS AN EXISTING WALL MOUNTED ELECTRICAL AND TECHNOLOGY DEVICE, CONTRACTOR SHALL RELOCATE DEVICE AND EXTEND WIRING AND CONDUIT AS INSTRUCTED BY OWNER OR ITS REPRESENTATIVE.

PROVIDE NEW POWER DEVICES AND SWITCH BOX EXTENSIONS IN ALL AREAS WHERE GYPSUM BOARD OR OTHER WALL COVERING ADDS TO THE THICKNESS OF WALLS. SEE ARCHITECTURAL DRAWINGS FOR AREAS AFFECTED.

TEMPORARILY DISCONNECT AND REMOVE ALL CEILING / WALL MOUNTED ELECTRICAL AND FIRE ALARM DEVICES FOR AREAS THAT REQUIRE CEILING / WALL REMOVALS AND/OR REPLACEMENT, INCLUDING MECHANICAL, TECHNOLOGY, FIRE ALARM, SPRINKLERS AND PLUMBING SCOPE OF WORK. AFTER COMPLETION RELOCATE TO PREVIOUS LOCATION AS REQUIRED.

WHERE ANY EXISTING JUNCTION BOX AND/OR PULLBOX IS LOCATED AT A NEW NON-ACCESSIBLE CEILING AREA, CONTRACTOR SHALL RELOCATE DEVICE AND EXTEND WIRING AND CONDUIT ABOVE NEAREST ACCESSIBLE CEILING AS INSTRUCTED BY OWNER OR ITS REPRESENTATIVE. SEE ARCHITECTURAL DRAWINGS FOR AREAS AFFECTED.


EXISTING RACEWAYS AND LOCATION OF ELECTRICAL OUTLETS ON EXISTING WALLS TO REMAIN SHALL BE RE-USED AS PRACTICAL FOR NEW DEVICES AS PART OF NEW WORK.

**POWER GENERAL NOTES**

- REFER TO TECHNOLOGY DRAWINGS, DIVISION 27 AND 28 FOR TELECOMMUNICATION PATHWAYS AND OTHER ADDITIONAL REQUIREMENTS TO BE PROVIDED AS SPECIFIED IN DIVISION 26.
- WHERE ANY NEW WALL TERMINATES AT THE SAME LOCATION AS AN EXISTING WALL MOUNTED ELECTRICAL AND TECHNOLOGY DEVICE, CONTRACTOR SHALL RELOCATE DEVICE AND EXTEND WIRING AND CONDUIT AS INSTRUCTED BY OWNER OR ITS REPRESENTATIVE.
- WHERE ANY EXISTING JUNCTION BOX AND/OR PULLBOX IS LOCATED AT A NEW NON-ACCESSIBLE CEILING AREA, CONTRACTOR SHALL RELOCATE DEVICE AND EXTEND WIRING AND CONDUIT ABOVE NEAREST ACCESSIBLE CEILING AS INSTRUCTED BY OWNER OR ITS REPRESENTATIVE. SEE ARCHITECTURAL DRAWINGS FOR AREAS AFFECTED.


**ELECTRICAL KEYED NOTES**

- PROVIDE NEW RECEPTACLES AS SHOWN AND CONNECT TO EXISTING CIRCUITS LEFT IN PLACE AFTER DEMOLITION. EXTEND CONDUCTORS / CONDUIT WITH MATCHING SIZE TO NEW LOCATION. FIELD VERIFY CONNECTED LOAD NOT TO EXCEED 1500 W @ 120V.
- DO NOT USE FLEXIBLE CONDUIT IN RECEPTION WALL FOR CONNECTION OF NEW RECEPTACLES. TYPICAL.
- PROVIDE POWER TO NEW KILN RECEPTACLE AND DISCONNECT FROM EXISTING POWER IN THIS SPACE REMAINING AFTER DEMOLITION. EXTEND CONDUIT AND WIRING OF EXISTING SIZE TO NEW DEVICE LOCATION(S). COORDINATE EXACT KILN PLUG CONFIGURATION WITH EXISTING EQUIPMENT AND EXACT RECEPTACLE AND DISCONNECT MOUNTING LOCATION WITH ARCHITECT.
- PROVIDE JUNCTION BOX FOR GARD READER. INSTALL 1" CONDUIT WITH PULL WIRE TO ABOVE ACCESSIBLE CEILING. COORDINATE EXACT LOCATION AND REQUIREMENTS WITH LOW VOLTAGE CONTRACTOR PRIOR TO ELECTRICAL BOUISHIN.
- PROVIDE POWER TO NEW EF FROM EXISTING 208V PANEL LE1. PROVIDE NEW 20A/1P BREAKER WITH #12 WIRE.

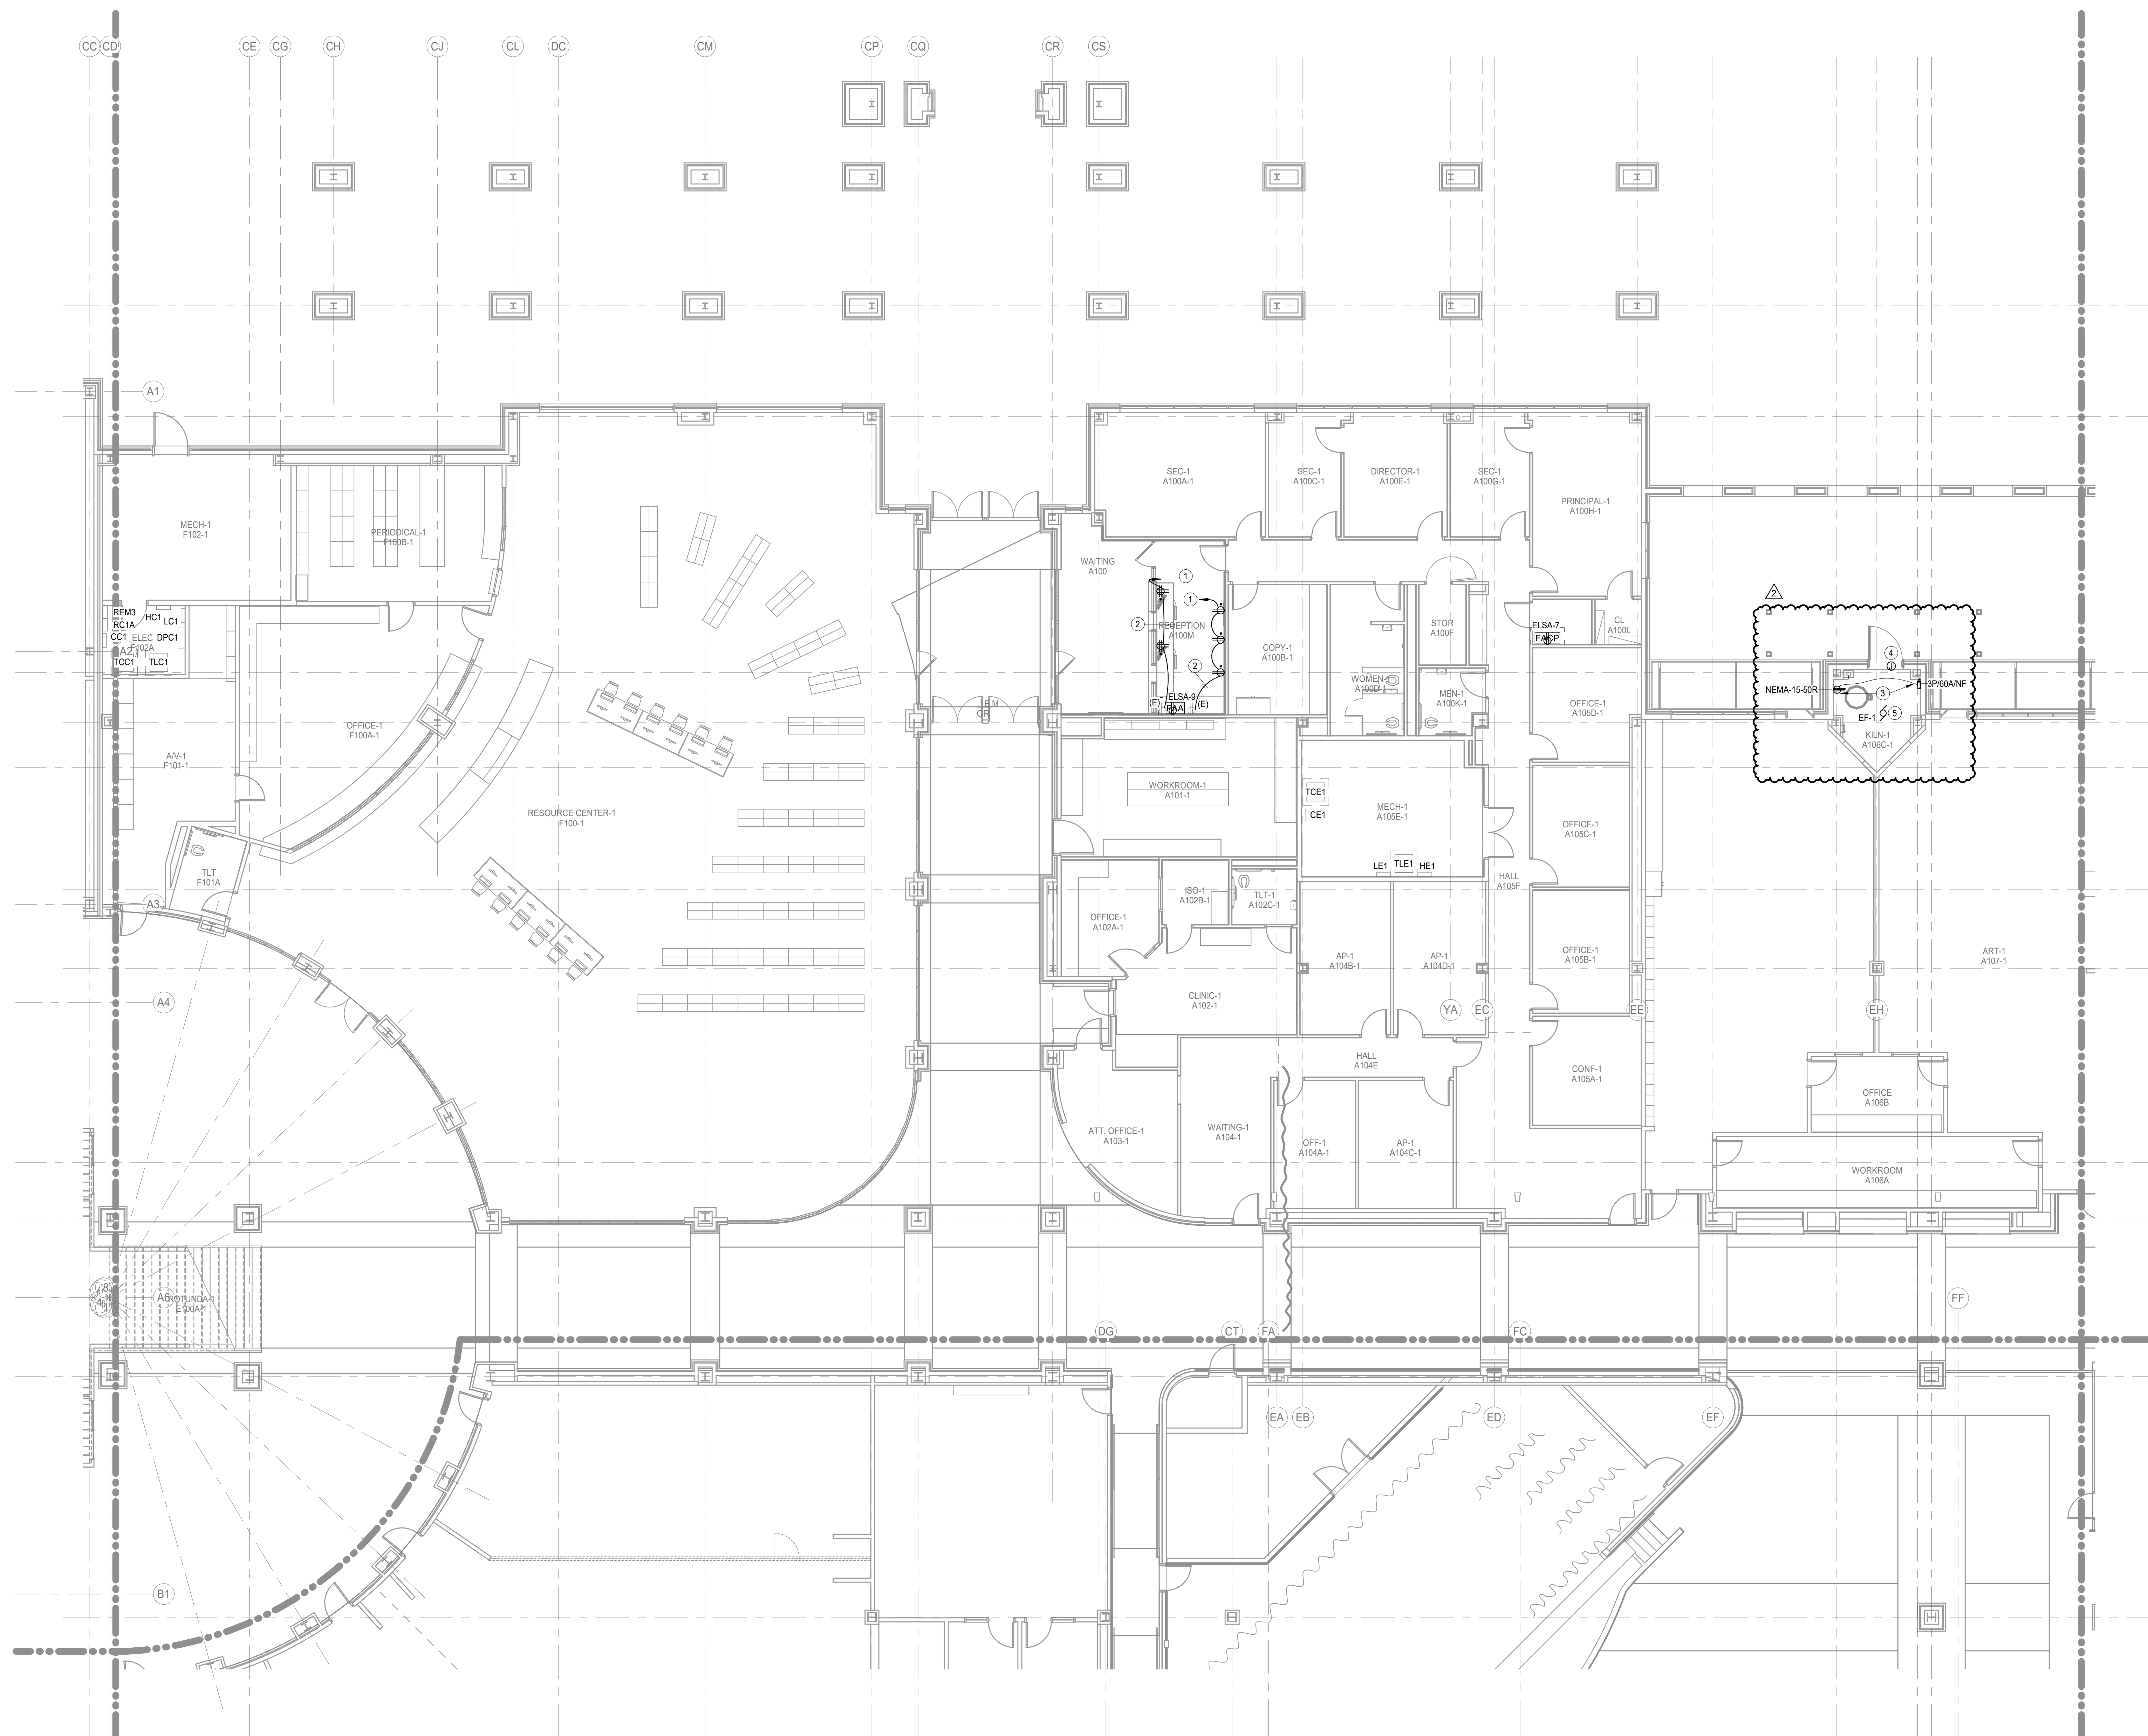

**1 ELECTRICAL POWER FLOOR PLAN - LEVEL 1 - AREA C**  
 Scale: 1/8" = 1'-0"

**KEY PLAN:**

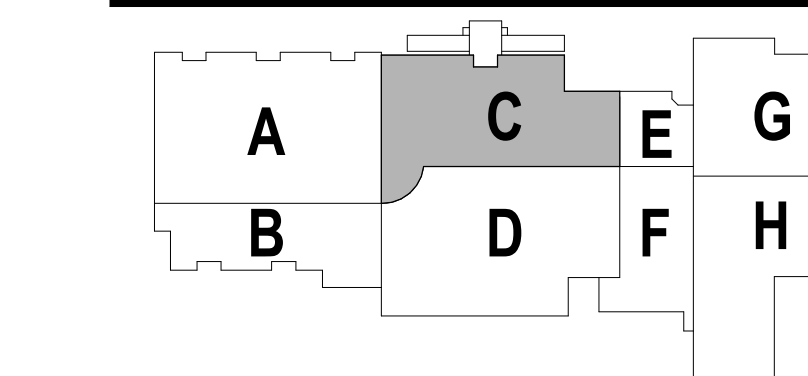

**2024 SMITH & SPILLANE MS RENOVATIONS**  
**SMITH MIDDLE SCHOOL**  
 10300 WARNER SMITH BLVD., CYPRESS, TEXAS 77433  
 CFISD PROJECT NO: 24-02-5751-R-RFP

2	Addendum 03	02-14-25
2	Revisions / Submission	

Project Number: 23073  
 Date: 26 JANUARY 2025  
 Drawn By: WHL / KLO

**ELECTRICAL POWER**  
**FIRST FLOOR PLAN -**  
**AREA 'C'**

**E3.03**



**PLUMBING GENERAL NOTES**

1. IT IS IMPRACTICAL DUE TO THE STREET SEWER, STRUCTURAL FEATURES AND ARRANGEMENT OF BUILDING TO OBTAIN A SLOPE OF 1/4" PER FOOT PIPING 4" THRU 6" SHALL HAVE A SLOPE OF 1/8" PER FOOT BELOW BUILDING TO 5'-0" OUTSIDE OF BUILDING.
2. DO NOT SCALE THE PLUMBING DRAWINGS. REFER TO THE DIMENSIONED ARCHITECTURAL DRAWINGS FOR ALL DIMENSIONAL DATA.
3. REFER TO CIVIL DRAWINGS FOR UTILITY STUB CONTINUATIONS. THIS CONTRACTOR TO MAKE CONNECTIONS AS REQUIRED FROM STUB LOCATIONS TO SITE UTILITIES.
4. INVERT ELEVATIONS LISTED ARE APPROXIMATE. PRIOR TO CONSTRUCTION, COORDINATE FINAL INVERT ELEVATIONS OF BUILDING SANITARY AND STORM OUTFALLS WITH SITE UTILITY CONTRACTOR. MAKE ADJUSTMENTS AS REQUIRED TO ENSURE PROPER CONNECTIONS TO SITE UTILITIES.
5. REFER TO LATEST CIVIL DRAWINGS FOR BUILDING FINISHED FLOOR ELEVATIONS.
6. CONTRACT DRAWINGS ARE BASED ON CASUAL FIELD OBSERVATION, AND WHEN AVAILABLE, EXISTING RECORD DOCUMENTS. CONTRACTOR TO VERIFY AT SITE EXACT LOCATIONS, AND SIZES OF EXISTING PIPING. REPORT DISCREPANCIES TO ARCHITECT BEFORE DISTURBING EXISTING INSTALLATION, AND IMMEDIATELY AFTER SUCH DISCREPANCIES ARE DISCOVERED. CONTRACTOR TO VERIFY EXISTING CONDITIONS IN FIELD AND NOTIFY ENGINEER IF THERE ARE ANY CONFLICTS BETWEEN EXISTING CONDITIONS AND DRAWINGS PRIOR TO COMMENCEMENT OF WORK.
7. THE CONTRACTOR SHALL VISIT THE SITE PRIOR TO SUBMITTAL OF BID TO DETERMINE CONDITIONS AFFECTING THE WORK. ANY ITEMS WHICH ARE NOT COVERED IN THE BID DOCUMENTS OR ANY PROPOSED SUBSTITUTIONS SHALL BE LISTED SEPARATELY AND QUALIFIED IN THE CONTRACTORS BID. SUBMITTAL OF BID SHALL SERVE AS EVIDENCE OF KNOWLEDGE OF EXISTING CONDITIONS AND ANY MODIFICATIONS WHICH ARE REQUIRED TO MEET THE INTENT OF THE DRAWINGS AND SPECIFICATIONS. FAILURE TO VISIT THE SITE DOES NOT RELIEVE THE CONTRACTOR OF RESPONSIBILITY IN PERFORMANCE OF WORK.

**Salas O'Brien**  
 salesobrien.com 281-664-1900  
 Houston  
 10930 W. Sam Houston Pkwy North, Suite 900  
 Houston, TX 77064  
 Registration: F-411  
 Project No: 2024-0029-00

**NATEX**  
 CORPORATION  
 ARCHITECTS  
 www.natearchitects.com  
 447 Heights Boulevard  
 Houston, TX 77007  
 Phone: 713-975-9525  
 Fax: 713-780-7824

**Coleman Partners**  
 ARCHITECTS  
 cpa.com

3701 Kirby Drive, Suite 830  
 Houston, TX 77098  
 tel: 832.947.1038 fax: 281.214.5365

**CONSTRUCTION DOCUMENT**

*Bradley Kalmans*  
 BRADLEY KALMANS  
 80219  
 CEN  
 02-11-2025


**CIVIL ENGINEER**  
**BROOKS AND SPARKS, INC.**  
 21020 PARK ROW  
 KATY, TX 77449  
 tel: 281-578-9595

**STRUCTURAL ENGINEER**  
**DALLY + ASSOCIATES, INC.**  
 9800 RICHMOND AVE.  
 SUITE 400  
 HOUSTON, TX 77042  
 tel: 713.337.8881

**MEPT ENGINEER**  
**SALAS O'BRIEN**  
 10930 W. SAM HOUSTON PKWY. N.  
 SUITE 900  
 HOUSTON, TX 77064  
 tel: 281.664.1900

**FOOD SERVICE EQUIPMENT**  
**FDP**  
 25317 INTERSTATE 45  
 THE WOODLANDS, TX 77380  
 tel: 281-350-2323

**LANDSCAPE ARCHITECT**  
**LANDESIGN GROUP**  
 17041 EL CAMINO REAL  
 SUITE 204  
 HOUSTON, TX 77058  
 tel: 281.486.4040

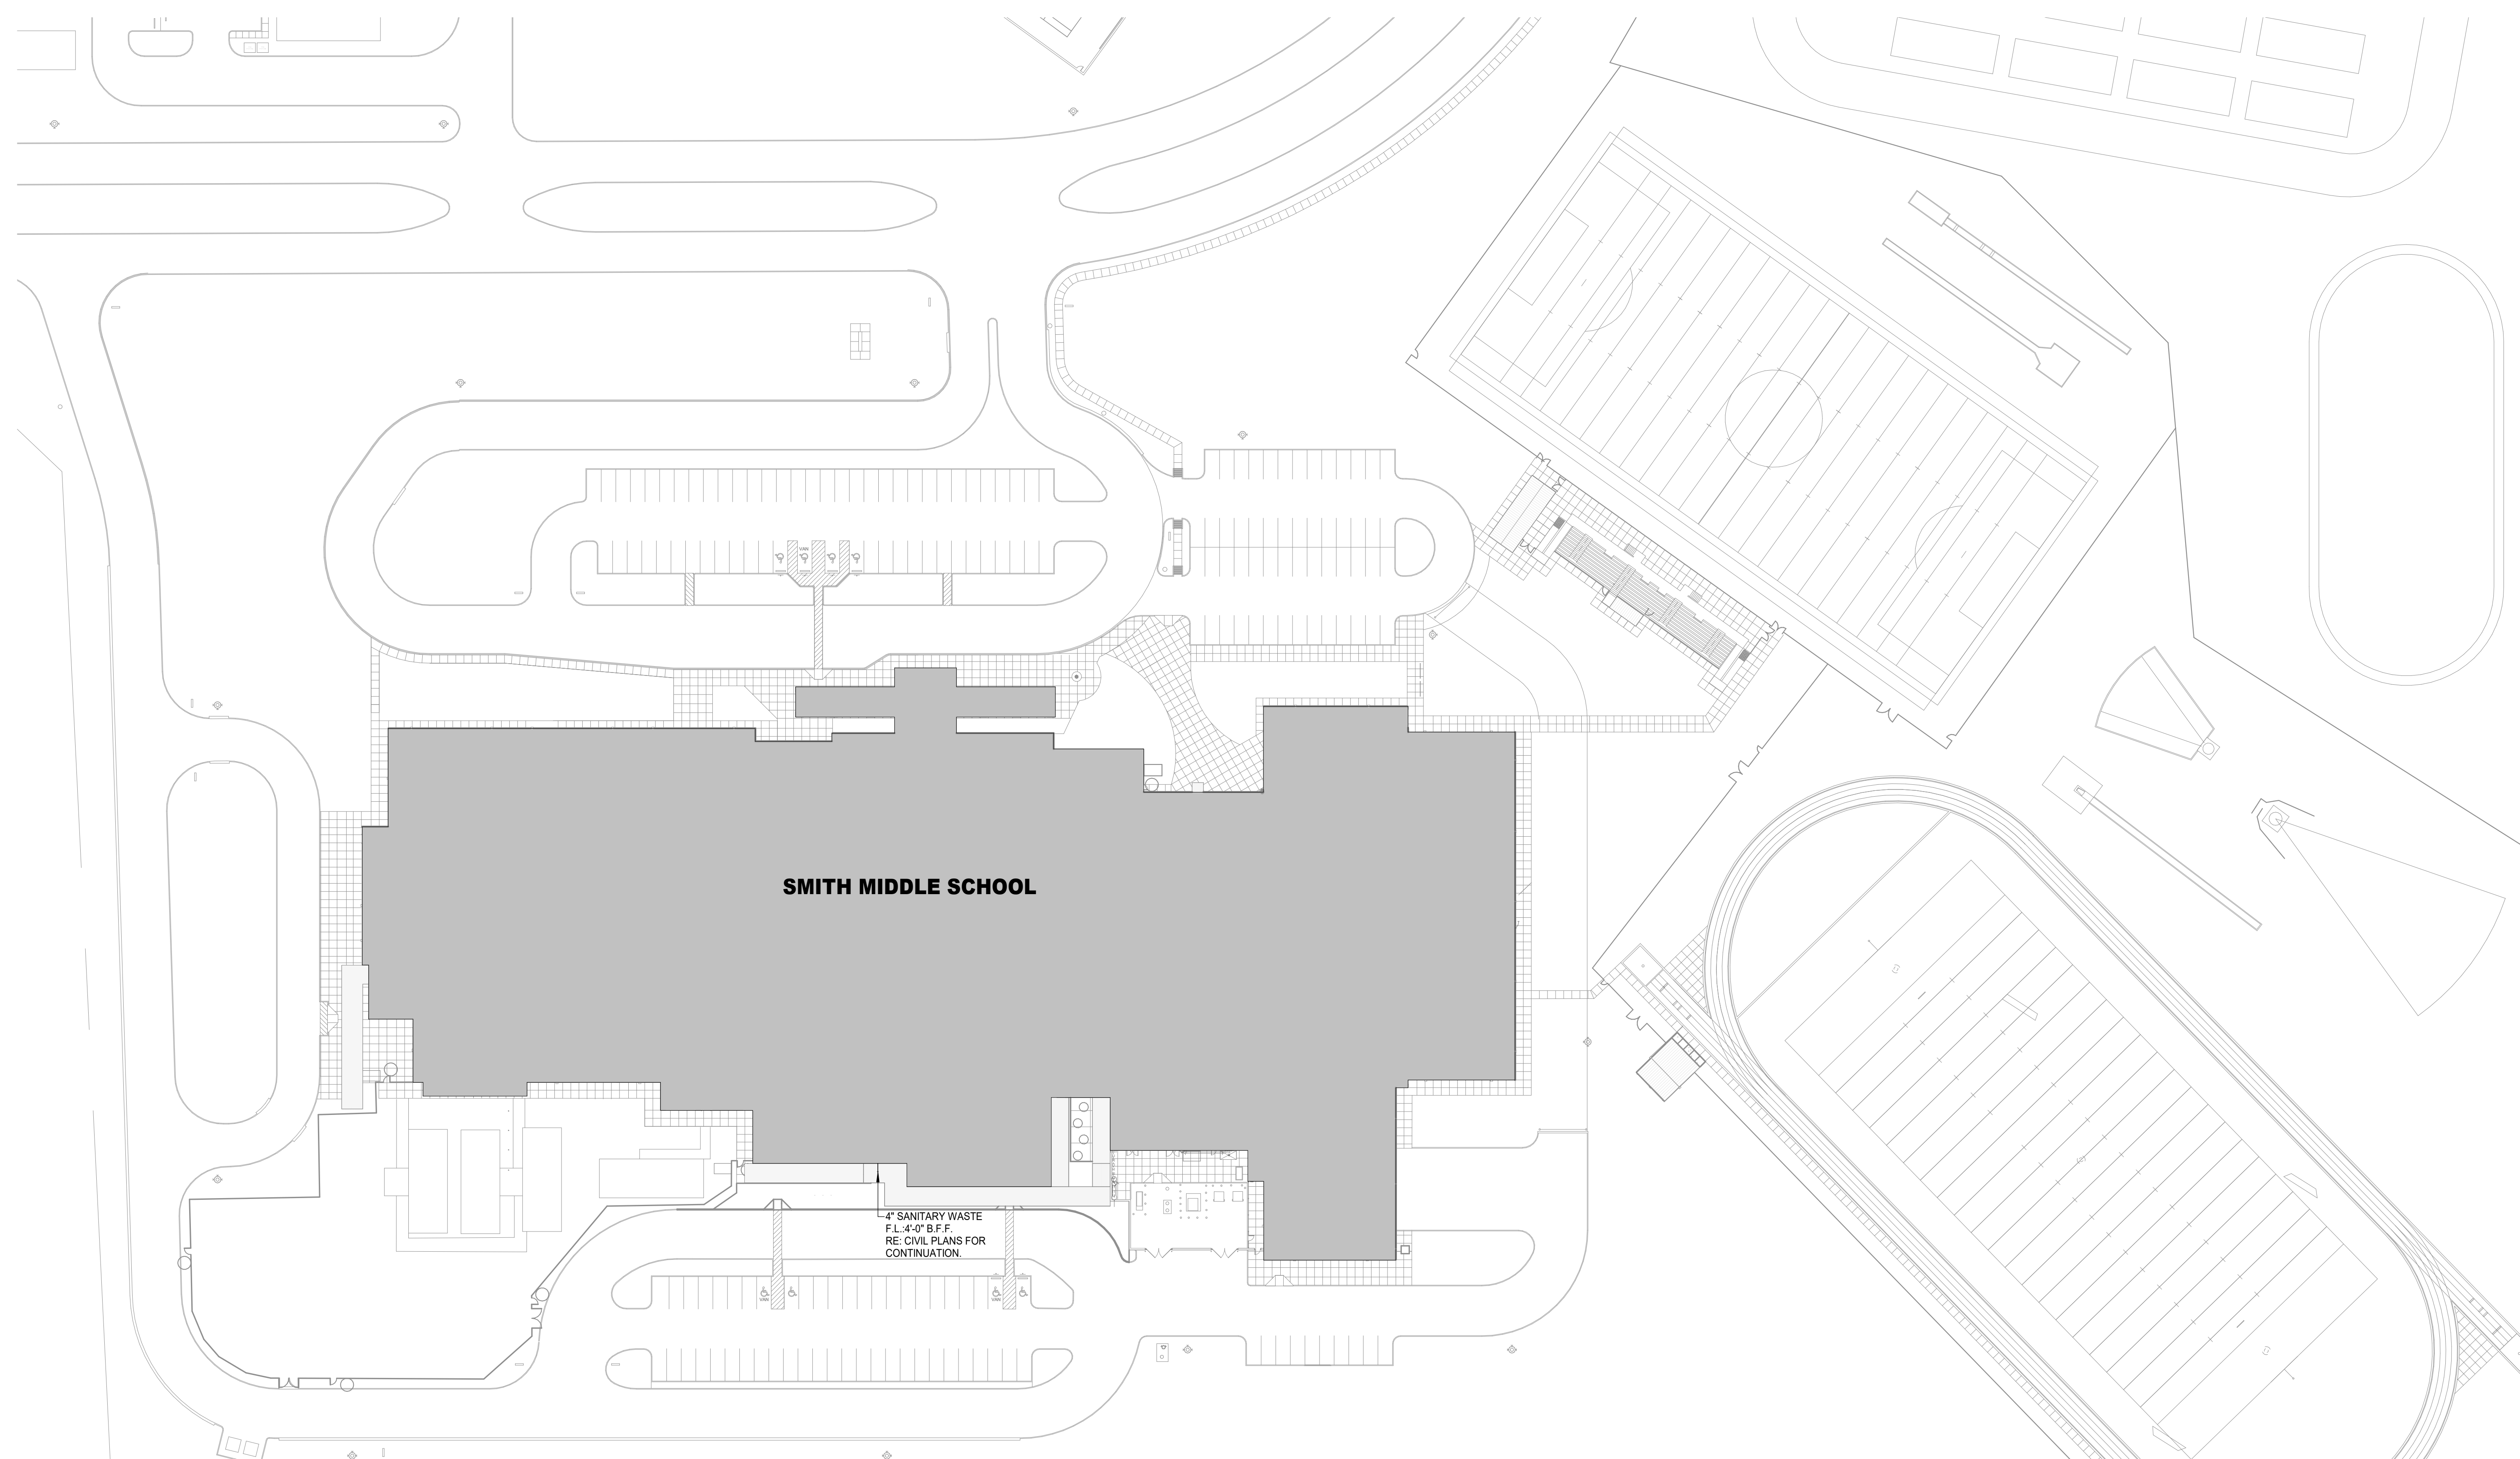

**1 PLUMBING SITE PLAN**  
 Scale: 1" = 50'-0"









**KEY PLAN:**

**2024 SMITH & SPILLANE MS RENOVATIONS**  
**SMITH MIDDLE SCHOOL**  
 10300 WARNER SMITH BLVD., CYPRESS, TEXAS 77433  
 CFSID PROJECT NO: 24-02-5751-R-RFP

2 Addendum 03 02-14-25  
 Revisions / Submission

Project Number: 23073  
 Date: 26 JANUARY 2025  
 Drawn By: WHL / KLO

**PLUMBING SITE PLAN**  
**P1.03**

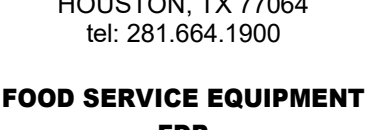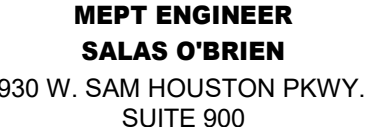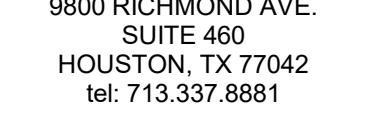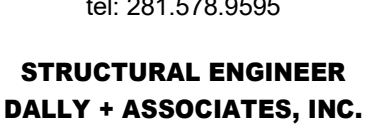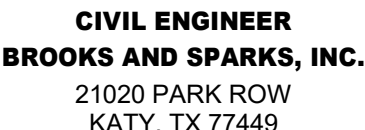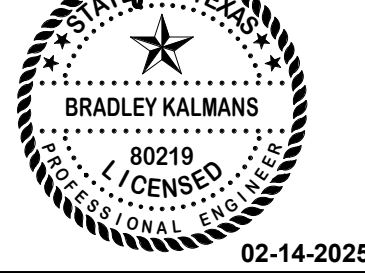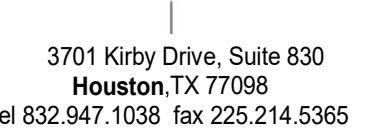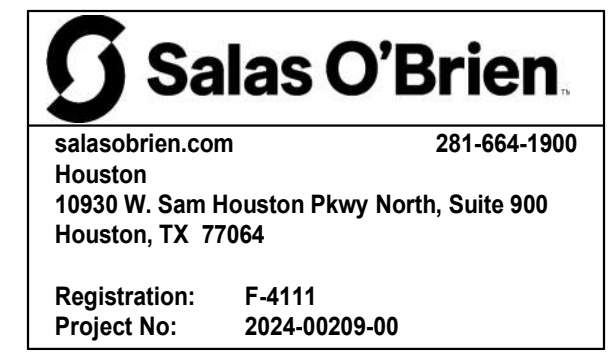

TECHNOLOGY LEGEND - 27 10 00. Table with columns: SYMBOL, DESCRIPTION, ELEVATION, BACK BOX/RACEWAY, NOTES. Includes symbols for wall-mounted network outlets, communications outlets, floor-mounted boxes, and ceiling-mounted outlets.

AUDIO/VIDEO LEGEND - 27 41 16.10. Table with columns: SYMBOL, DESCRIPTION, ELEVATION, BACK BOX/RACEWAY, NOTES. Includes symbols for wall-mounted projectors, ceiling-mounted projectors, flat screen displays, and AV control panels.

LOCAL SOUND SYSTEM LEGEND - 27 41 16.20. Table with columns: SYMBOL, DESCRIPTION, ELEVATION, BACK BOX/RACEWAY, NOTES. Includes symbols for local sound system speakers, control plates, microphone inputs, and auxiliary inputs.

INTERCOM LEGEND - 27 50 00. Table with columns: SYMBOL, DESCRIPTION, ELEVATION, BACK BOX/RACEWAY, NOTES. Includes symbols for intercom communications system head end units, ceiling and wall-mounted intercom speakers, and intercom call buttons.

ACCESS CONTROL LEGEND - 28 10 00 & 28 10 00.05. Table with columns: SYMBOL, DESCRIPTION, ELEVATION, BACK BOX/RACEWAY, NOTES. Includes symbols for access control systems, proximity card readers, door-mounted access controls, and intercom door stations.

VIDEO SURVEILLANCE LEGEND - 28 20 00. Table with columns: SYMBOL, DESCRIPTION, ELEVATION, BACK BOX/RACEWAY, NOTES. Includes symbols for wall corner mount 4-sensor cameras, ceiling-mounted 4-sensor cameras, and 2-sensor cameras.

INTRUSION LEGEND - 28 31 00. Table with columns: SYMBOL, DESCRIPTION, ELEVATION, BACK BOX/RACEWAY, NOTES. Includes symbols for intrusion detection system control panels, keypad, motion detectors, and door contact sensors.

FIRE ALARM - 28 46 00. Table with columns: SYMBOL, DESCRIPTION, ELEVATION, BACK BOX/RACEWAY, NOTES. Includes symbols for fire alarm control panels, alarm annunciator panels, and remote power supplies.

SUBSCRIPTS AND ABBREVIATIONS. Table with columns: TEXT, DESCRIPTION. Lists symbols like WP, AFF, UC, WM, WG and their meanings.

SUBSCRIPTS LEGEND - EXISTING DEVICES. Table with columns: TEXT, DESCRIPTION. Lists symbols like E, D, R and their meanings for existing devices.

NOTES TO CONTRACTOR. List of 3 notes regarding symbol usage, system installation, and grounding requirements.

TECH DEMO PLAN GENERAL NOTES. Section A: Contractor shall provide new ceiling tiles... Section B: Contractor shall have each low voltage system tested... Section C: Contractor shall remove any devices where construction occurs...

RESPONSIBILITY MATRIX. Table with columns: SCOPE ITEM, RESPONSIBILITY (OF, CF, OC), NOTES. Lists items like communications division, audio distribution, flat panel displays, network equipment, etc.

2024 SMITH & SPILLANE MS RENOVATIONS  
SMITH MIDDLE SCHOOL  
10300 WARNER SMITH BLVD., CYPRESS, TEXAS 77433  
CFSID PROJECT NO: 24-02-5751-R-RFP


Revision table with columns: No., Description, Date, By. Shows revisions 1 through 5.

Project Number: 23073  
Date: 26 JANUARY 2025  
Drawn By: WHL / KLO


TECHNOLOGY NOTES & LEGENDS

T0.00



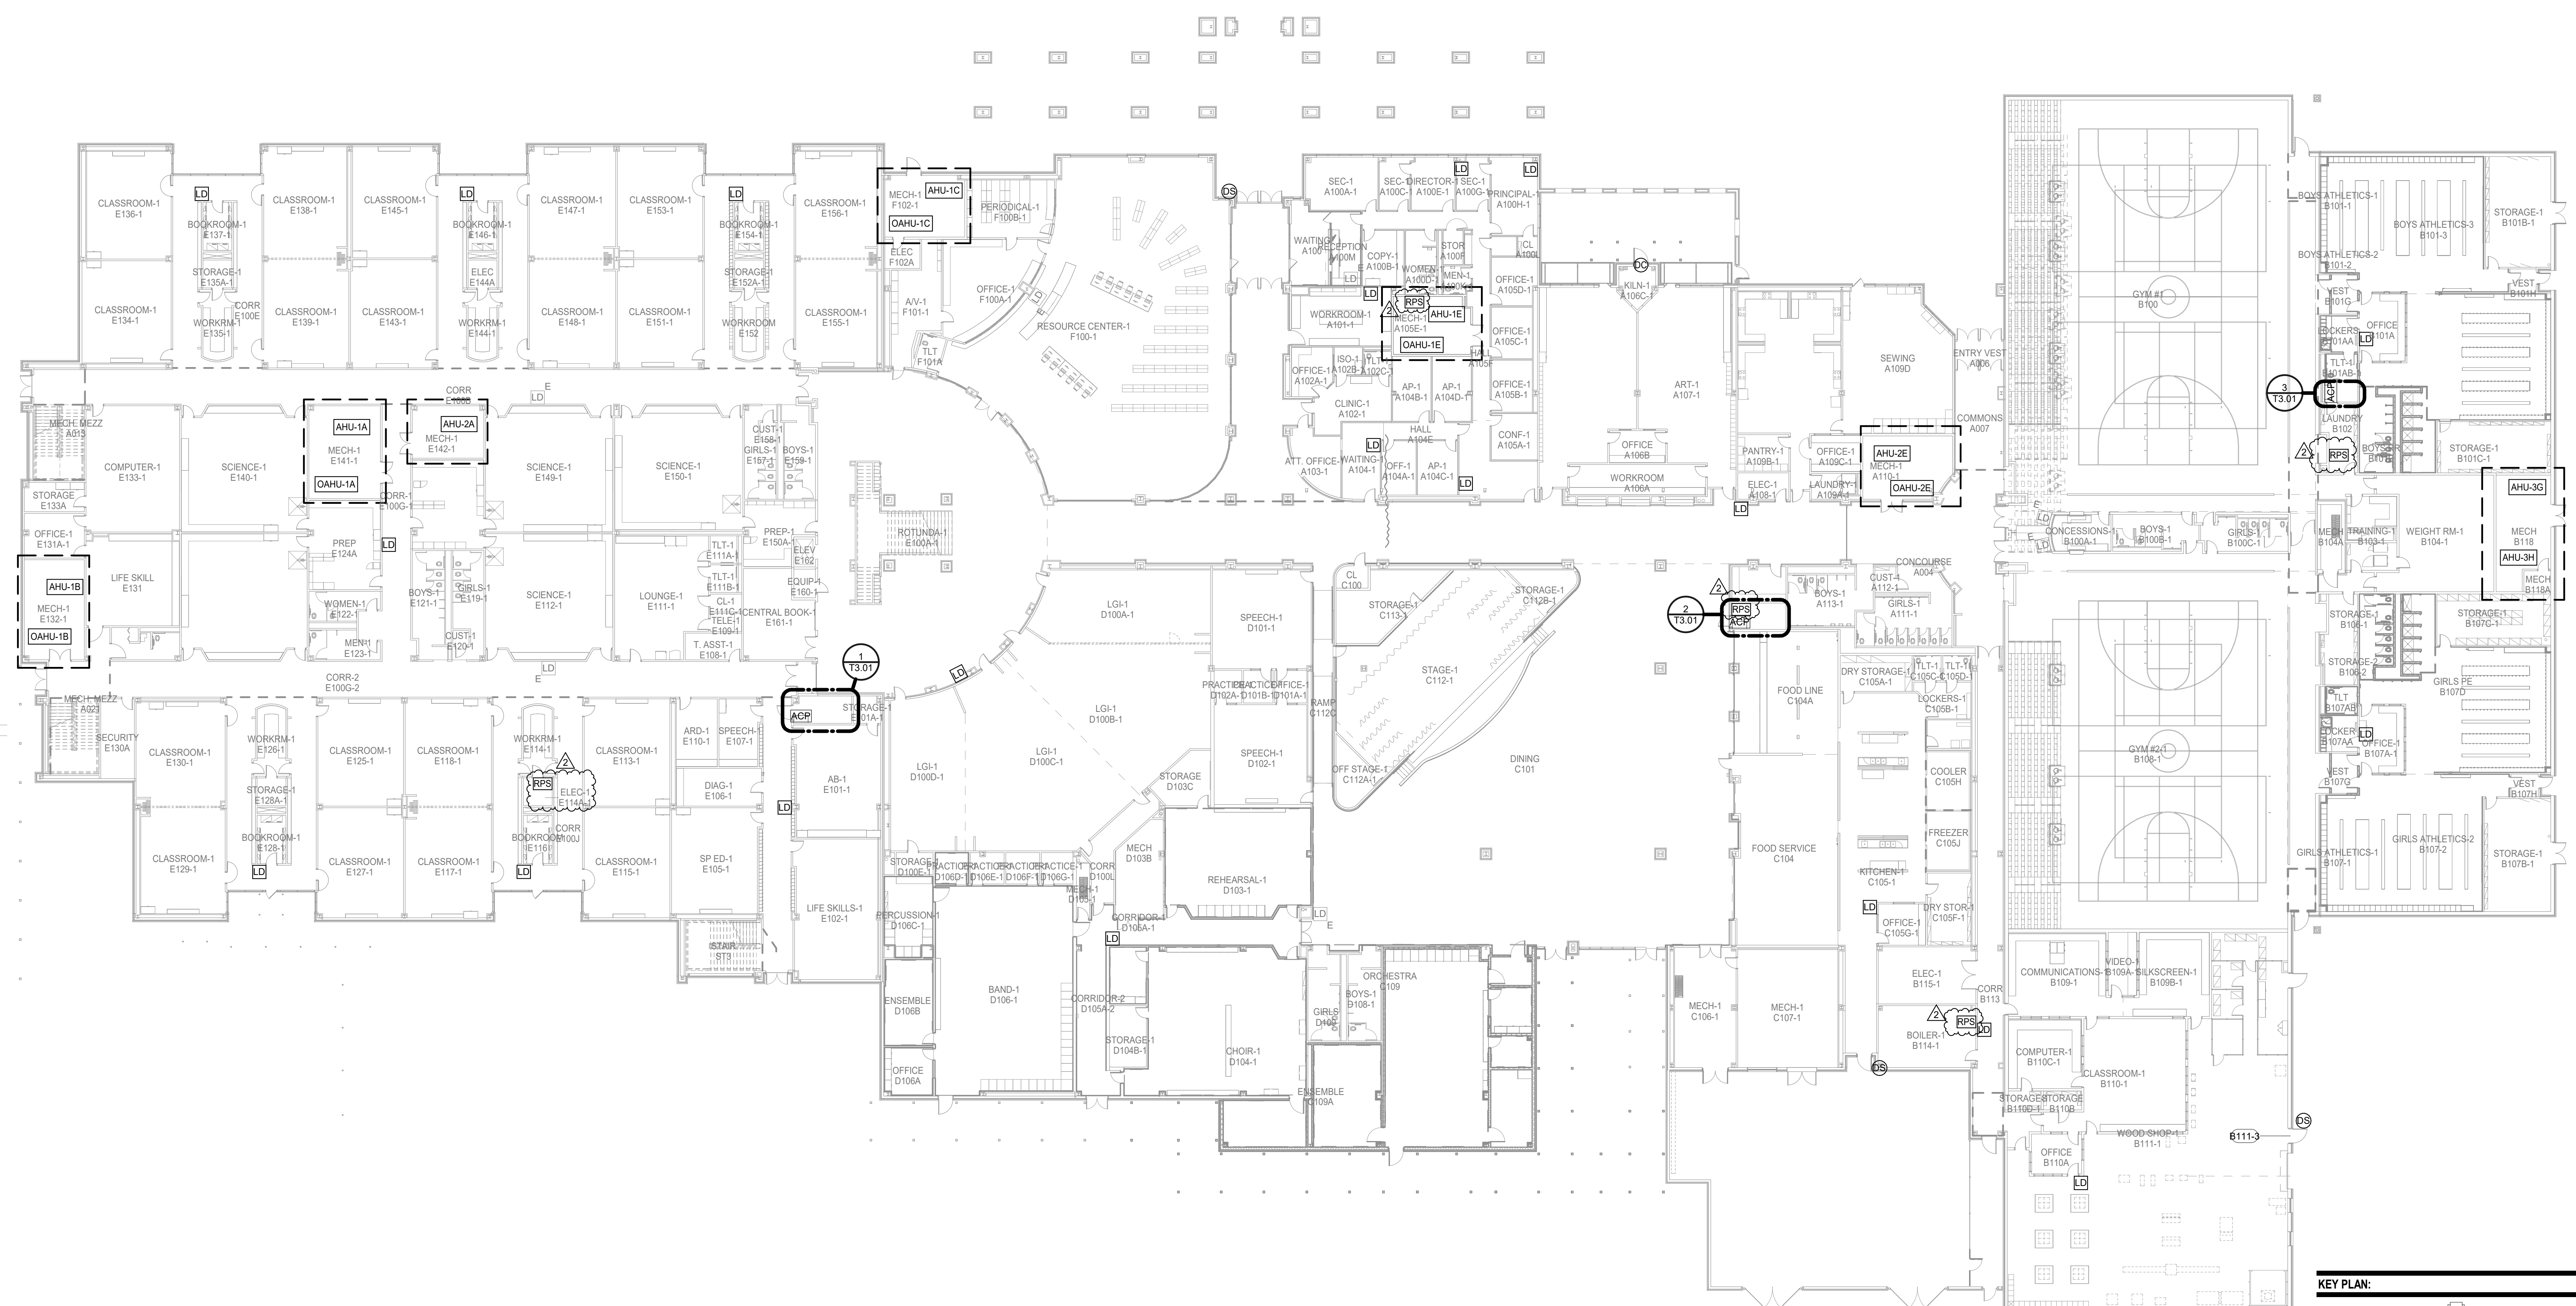

**1 TECHNOLOGY COMPOSITE FLOOR PLAN - LEVEL 1**  
 Scale: 1" = 20'-0"

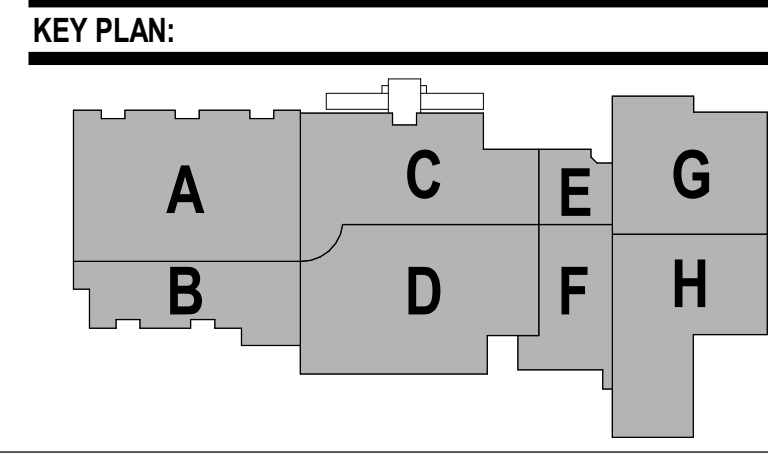


**FIRE ALARM**


A FIRE ALARM SYSTEM IS A PERFORMANCE BASED PER SPECIFICATIONS 28 46 00, CONTRACTOR TO REFERENCE SPECIFICATIONS FOR ADDITIONAL INFORMATION.

B A LICENSED FIRE ALARM PLANNING SUPERINTENDENT CERTIFIED TO A MINIMUM LEVEL 3, IN THE SUBFIELD OF FIRE ALARM SYSTEMS THROUGH THE NATIONAL INSTITUTE FOR CERTIFICATION IN ENGINEERING TECHNOLOGIES (NICET), SHALL PROVIDE PLANS AND CALCULATIONS FOR A MANUAL AND AUTOMATIC FIRE DETECTION AND ALARM SYSTEM TO COMPLY WITH THE BUILDING SPACE LAYOUT, BUILDING OCCUPANCY, CURRENT NFPA 72, LOCAL AND STATE CODE REQUIREMENTS, AND THE FIRE ALARM AND DETECTION SYSTEM SPECIFICATIONS.

C REFERENCE TECHNOLOGY COMPOSITE PLANS FOR EXISTING AHU LOCATIONS. REFERENCE MECHANICAL PLANS FOR ANY NEW AHU LOCATIONS.

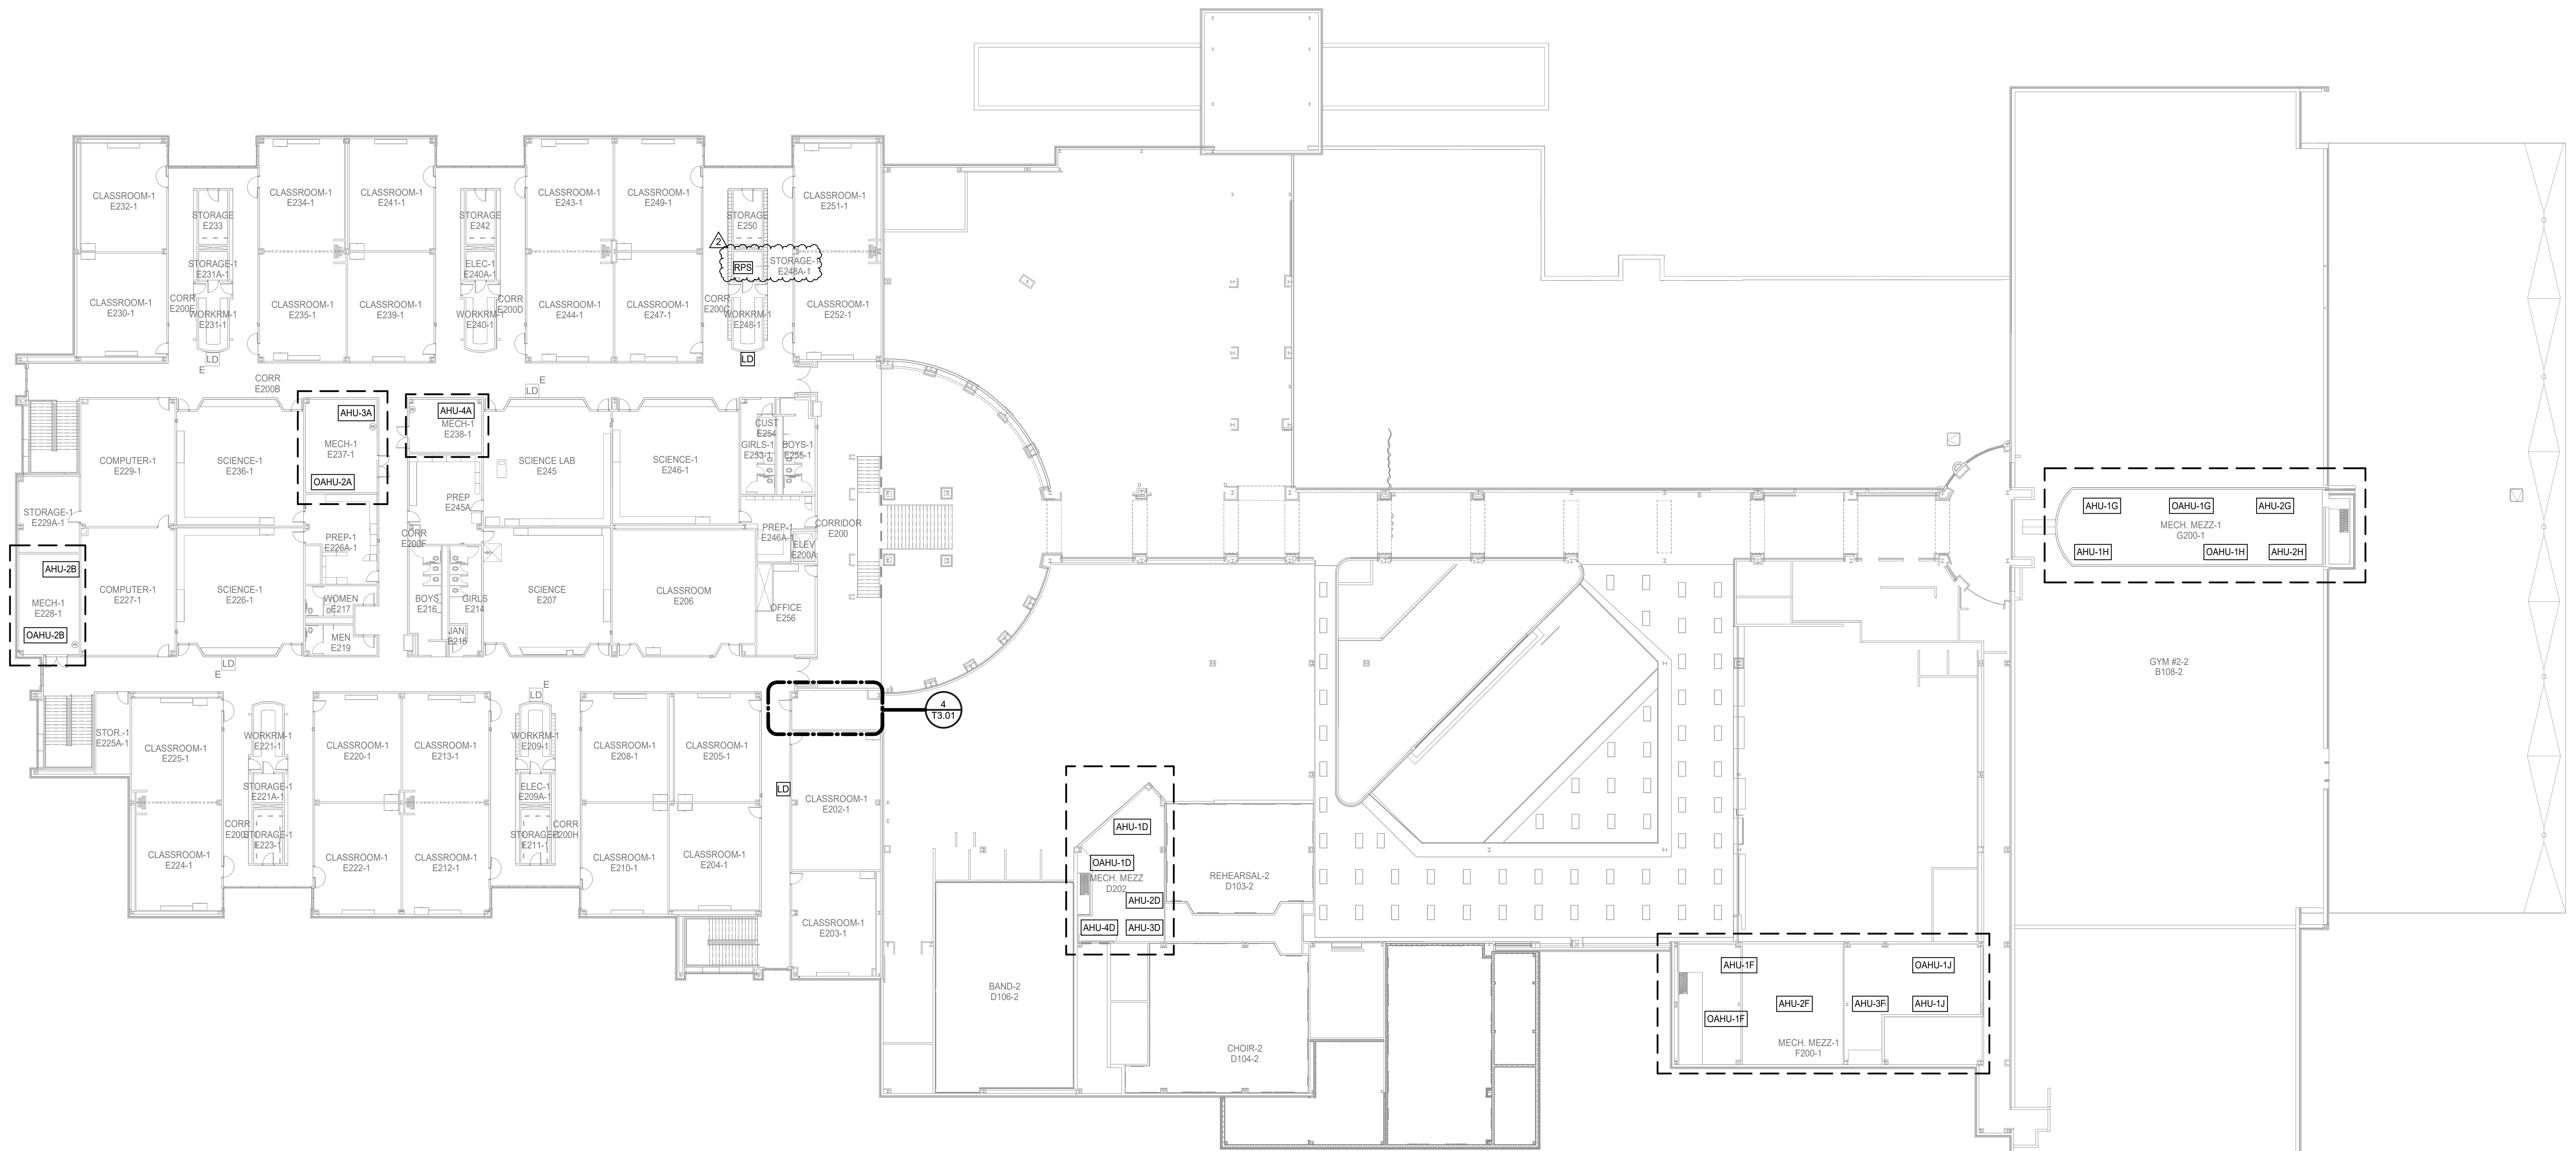

**1 TECHNOLOGY COMPOSITE FLOOR PLAN - LEVEL 2**  
 Scale: 1" = 20'-0"

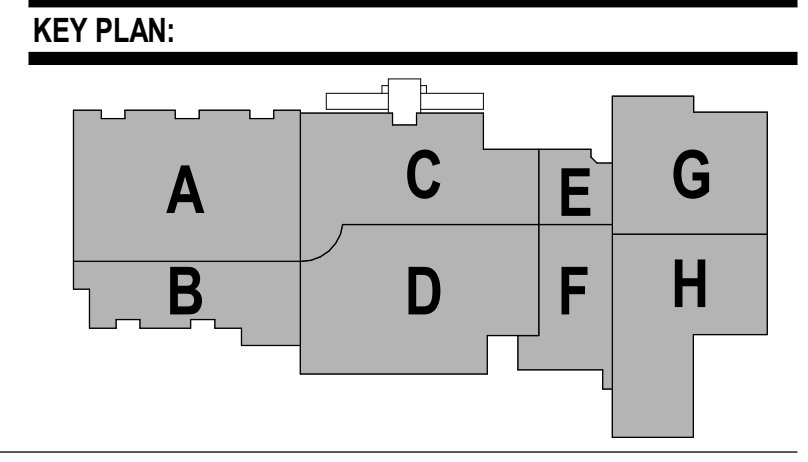

**2024 SMITH & SPILLANE MS RENOVATIONS**  
**SMITH MIDDLE SCHOOL**  
 10300 WARNER SMITH BLVD., CYPRESS, TEXAS 77433  
 CFSID PROJECT NO: 24-02-5751-R-RFP

Revision / Submission	Date
2	26 JANUARY 2025
1	26 JANUARY 2025

Project Number: 23073  
 Date: 26 JANUARY 2025  
 Drawn By: WHL / KLO  
**TECHNOLOGY COMPOSITE 2ND FLOOR PLAN**  
**T1.03**



**FIRE ALARM**

- A FIRE ALARM SYSTEM IS A PERFORMANCE BASED PER SPECIFICATIONS 28 46 00. CONTRACTOR TO REFERENCE SPECIFICATIONS FOR ADDITIONAL INFORMATION.
- B A LICENSED FIRE ALARM PLANNING SUPERINTENDENT CERTIFIED TO A MINIMUM LEVEL 3, IN THE SUBFIELD OF FIRE ALARM SYSTEMS THROUGH THE NATIONAL INSTITUTE FOR CERTIFICATION IN ENGINEERING TECHNOLOGIES (NICE), SHALL PROVIDE PLANS AND CALCULATIONS FOR A MANUAL AND AUTOMATIC FIRE DETECTION AND ALARM SYSTEM TO COMPLY WITH THE BUILDING SPACE LAYOUT, BUILDING OCCUPANCY, CURRENT NFPA 72, LOCAL AND STATE CODE REQUIREMENTS, AND THE FIRE ALARM AND DETECTION SYSTEM SPECIFICATIONS.
- C REFERENCE TECHNOLOGY COMPOSITE PLANS FOR EXISTING AHU LOCATIONS. REFERENCE MECHANICAL PLANS FOR ANY NEW AHU LOCATIONS.

**TECHNOLOGY PLAN GENERAL NOTES**

- A COORDINATE ALL FINAL MOUNTING HEIGHTS, FOR WALL MOUNTED DEVICES, PRIOR TO ROUGH-IN. COORDINATE WITH ARCHITECT, OWNER AND ENGINEER.
- B COORDINATE ALL CEILING DEVICE LOCATIONS WITH ARCHITECTURAL DRAWINGS AND INTERIOR DESIGN CONSULTANT(IF APPLICABLE) PRIOR TO ROUGH-IN.
- C REFERENCE TECHNOLOGY SITE PLAN, COMPOSITE, NOTES & LEGENDS AND DETAILS FOR ADDITIONAL INFORMATION AND DEVICE/OUTLET LOCATIONS.
- D CONTRACTOR TO COORDINATE INTERCOM SPEAKER MOUNTING TYPES WITH ARCHITECTURAL CEILING PLANS PRIOR TO FINAL SPEAKER SELECTION. COORDINATE WITH ENGINEER ON ANY DISCREPANCIES.
- E CONTRACTOR TO COORDINATE ALL DROP LOCATIONS WITH FURNITURE. COORDINATE WITH ARCHITECT AND OWNER FOR MORE INFORMATION.
- F ALL EXISTING LOCKDOWN BUTTONS THAT ARE BEING REUSED SHALL HAVE EXISTING WIRING DEMOLISHED AND REPLACED BY CONTRACTOR. NEW WIRING SHALL BE HOME RUN.
- G NEW DATA CABLING IN EXISTING CLASSROOMS SHALL REUSE EXISTING DATA CABLING RACEWAY AND BACKBOXES. CONTRACTOR TO PROVIDE AND INSTALL NEW FACEPLATES.
- H DATA CABLING TO MECHANICAL ROOMS SHALL BE REPLACED ONE TO ONE. CONTRACTOR TO REUSE EXISTING RACEWAY AND BACKBOXES. PROVIDE AND INSTALL NEW FACEPLATES.

**Salas O'Brien**  
 salasobrien.com 281-664-1900  
 Houston  
 10930 W. Sam Houston Pkwy North, Suite 900  
 Houston, TX 77064  
 Registration: F-4111  
 Project No: 2024-0029-00

**NATEX**  
 CORPORATION  
 ARCHITECTS  
 www.natearchitects.com  
 447 Heights Boulevard  
 Houston, TX 77007  
 Phone: 713-975-9525  
 Fax: 713-780-7824

Coleman Partners  
 ARCHITECTS  
 colemanpartners.com  
 3701 Kirby Drive, Suite 830  
 Houston, TX 77098  
 tel: 832.947.1038 fax: 281.214.5365

**CONSTRUCTION DOCUMENT**  
 CIVIL ENGINEER  
**BROOKS AND SPARKS, INC.**  
 21020 PARK ROW  
 KATY, TX 77449  
 tel: 281.578.9595

**STRUCTURAL ENGINEER**  
**DALLY + ASSOCIATES, INC.**  
 9800 RICHMOND AVE.  
 SUITE 400  
 HOUSTON, TX 77042  
 tel: 713.337.8881

**MEPT ENGINEER**  
**SALAS O'BRIEN**  
 10930 W. SAM HOUSTON PKWY. N.  
 SUITE 900  
 HOUSTON, TX 77064  
 tel: 281.664.1900


**FOOD SERVICE EQUIPMENT**  
**FDP**  
 25317 INTERSTATE 45  
 THE WOODLANDS, TX 77380  
 tel: 281.350.2323

**LANDSCAPE ARCHITECT**  
**LANDESIGN GROUP**  
 17041 EL CAMINO REAL  
 SUITE 204  
 HOUSTON, TX 77058  
 tel: 281.486.4040


**2024 SMITH & SPILLANE MS RENOVATIONS**  
**SMITH MIDDLE SCHOOL**  
 10300 WARNER SMITH BLVD., CYPRESS, TEXAS 77433  
 CFSID PROJECT NO: 24-02-5751-R-RFP

Revision	Description
2	Addendum 03 02-14-25 Revisions / Submission

Project Number: 23073  
 Date: 26 JANUARY 2025  
 Drawn By: WHL / KLO

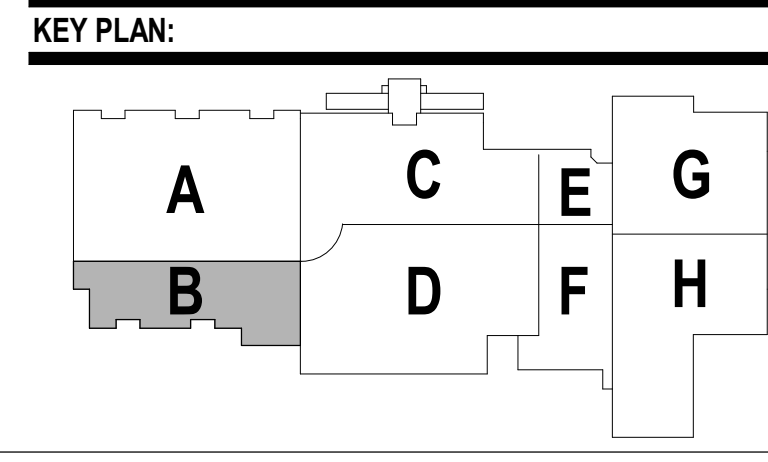

**TECHNOLOGY SECOND FLOOR PLAN - AREA 'B'**  
**T2.11**  
 of

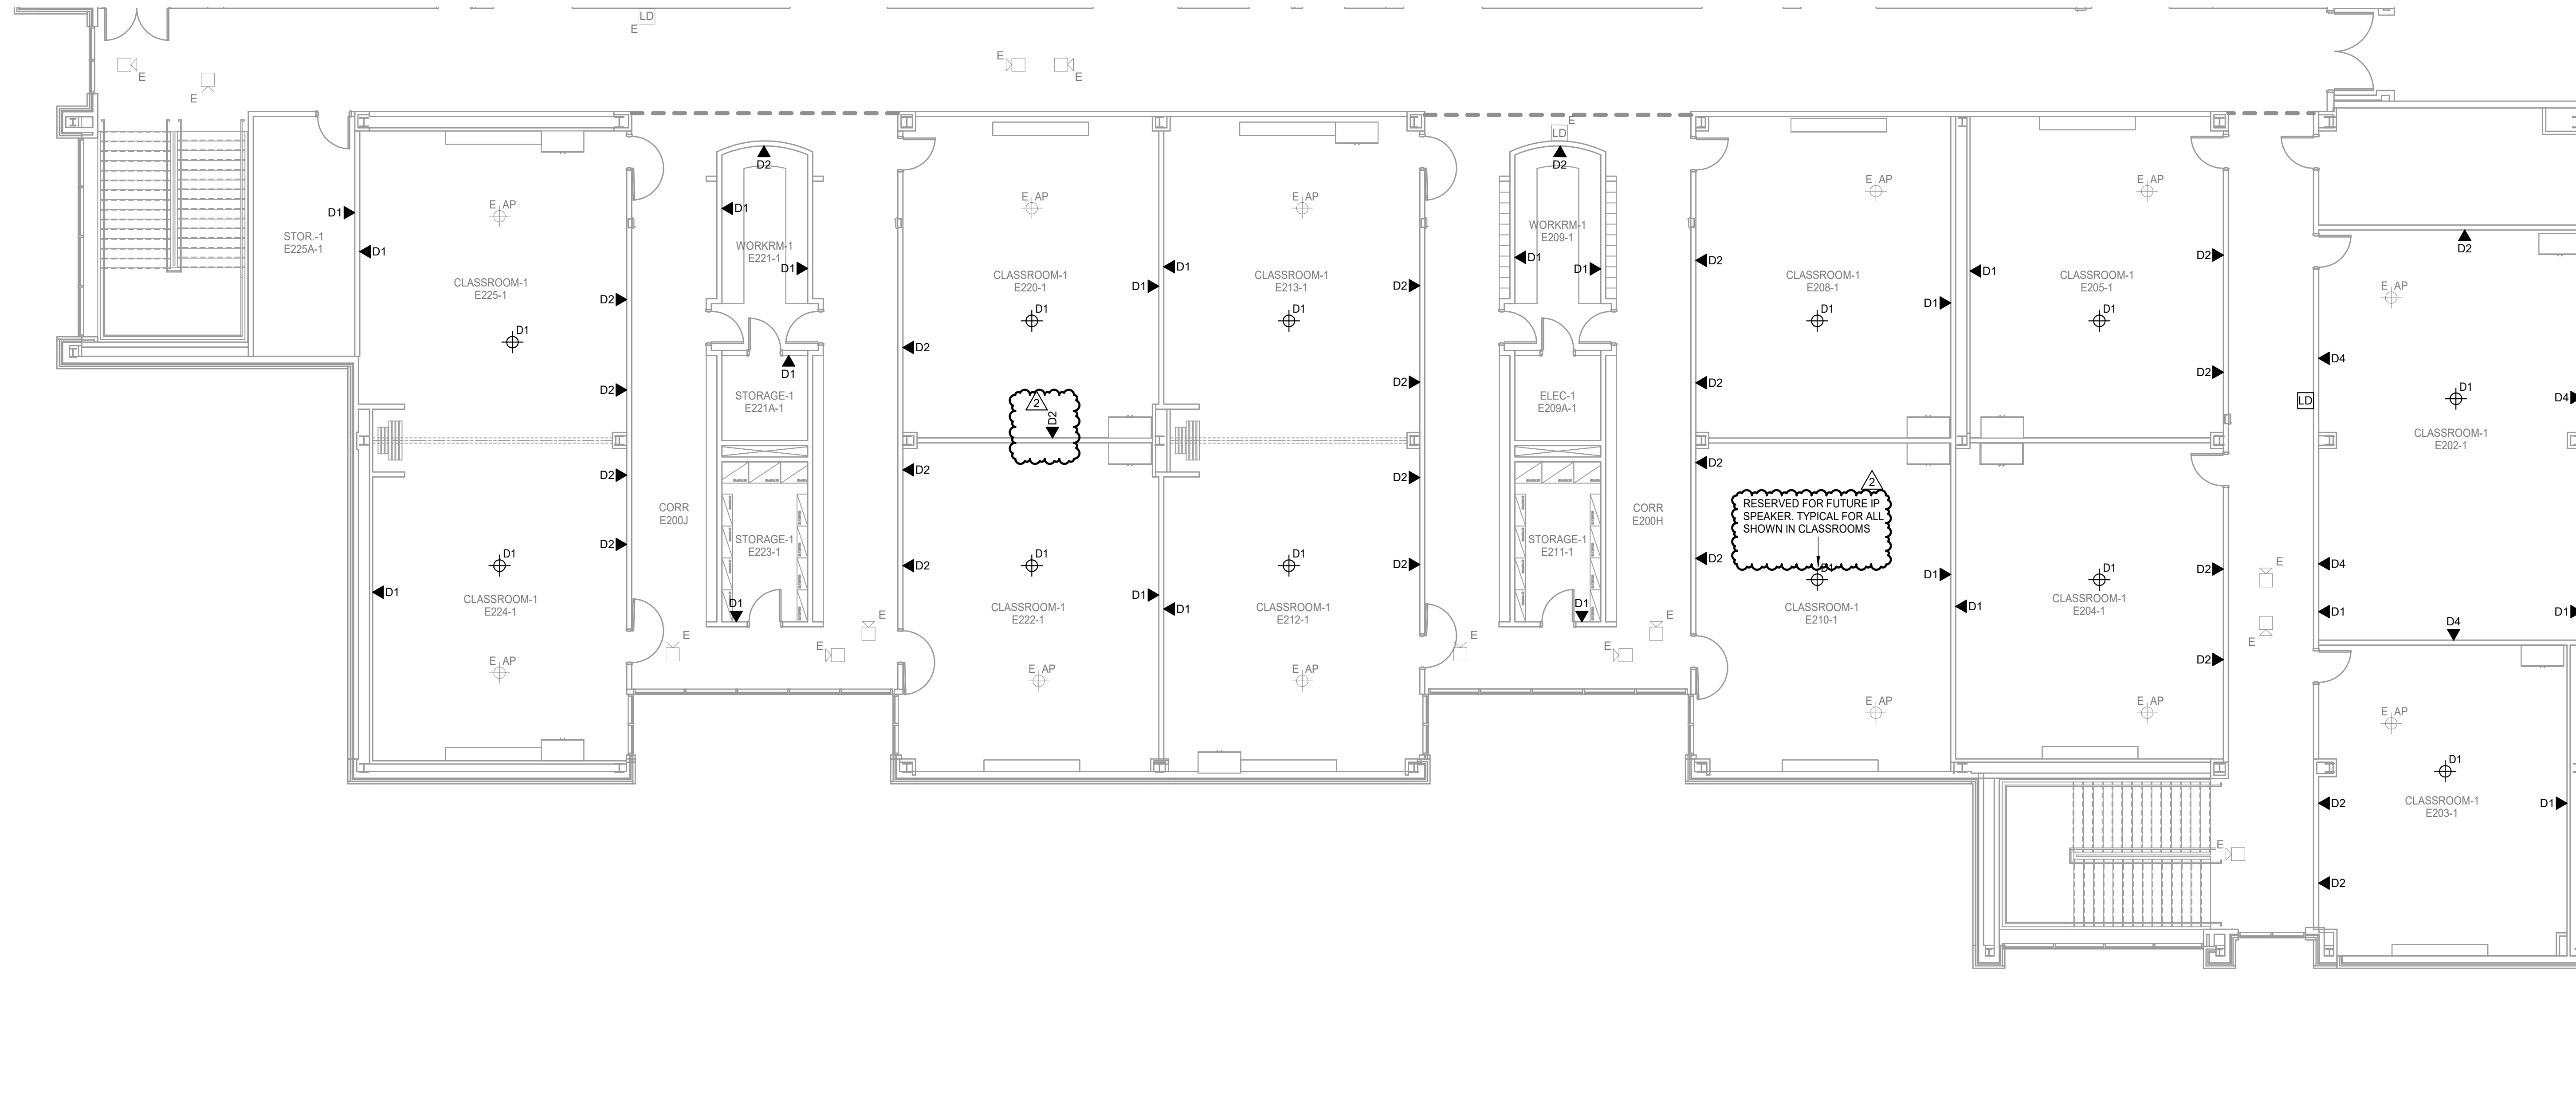

**1 TECHNOLOGY FLOOR PLAN - LEVEL 2 - AREA B**  
 Scale: 1/8" = 1'-0"

**Salas O'Brien**  
 salesobrien.com 281-664-1900  
 Houston 10930 W. Sam Houston Pkwy North, Suite 900  
 Houston, TX 77064  
 Registration: F-4111  
 Project No: 2024-00209-00

**NATEX**  
 CORPORATION  
 ARCHITECTS  
 www.nateearchitects.com  
 447 Heights Boulevard  
 Houston, TX 77007  
 Phone: 713-975-9525  
 Fax: 713-780-7824

**Coleman Partners**  
 ARCHITECTS  
 colemanpartners.com

3701 Kirby Drive, Suite 830  
 Houston, TX 77098  
 tel: 832.947.1038 fax: 281.214.5365

**CONSTRUCTION DOCUMENT**

*Bradley Kalmans*  
 BRADLEY KALMANS  
 80219  
 LICENSED  
 02-14-2025

**CIVIL ENGINEER**  
**BROOKS AND SPARKS, INC.**  
 21020 PARK ROW  
 KATY, TX 77449  
 tel: 281-578-9595

**STRUCTURAL ENGINEER**  
**DALLY + ASSOCIATES, INC.**  
 9800 RICHMOND AVE.  
 SUITE 400  
 HOUSTON, TX 77042  
 tel: 713.337.8881

**MEPT ENGINEER**  
**SALAS O'BRIEN**  
 10930 W. SAM HOUSTON PKWY. N.  
 SUITE 900  
 HOUSTON, TX 77064  
 tel: 281.664.1900

**FOOD SERVICE EQUIPMENT**  
**FDP**  
 25317 INTERSTATE 45  
 THE WOODLANDS, TX 77380  
 tel: 281-350-2323

**LANDSCAPE ARCHITECT**  
**LANDESIGN GROUP**  
 17041 EL CAMINO REAL  
 SUITE 204  
 HOUSTON, TX 77058  
 tel: 281.486.4040

**RENOVATIONS**

+	POINT OF CONNECTION FROM NEW TO EXISTING
□	ITEM TO REMAIN
⊖	ITEM TO BE REMOVED


CONTRACTOR SHALL PROVIDE DEHUMIDIFICATION DURING THE CONSTRUCTION SCHEDULE. THE SCOPE IS TO MAINTAIN ACCEPTABLE HUMIDITY LEVELS WITHIN THE BUILDING. THE REMOVAL OF EXCESS HUMIDITY FROM THE AIR THROUGHOUT THE BUILDING. PROVIDE MOISTURE CONTROL RENTAL EQUIPMENT AND SOLUTION FOR PREVENTING THE LONG-TERM EFFECTS OF MOISTURE LEVEL THAT CAN DAMAGE INTERIOR BUILDING MATERIALS, BOOKS AND ELECTRONIC EQUIPMENT.

CONTRACTOR IS RESPONSIBLE TO PROVIDE ALL REQUIRED POWER GENERATING EQUIPMENT.

- GENERAL NOTES:**
- OWNER SHALL HAVE FIRST RIGHT OF REFUSAL ON ALL EQUIPMENT BEING REMOVED FROM THIS PROJECT. THIS INCLUDES BUT IS NOT LIMITED TO CHILLERS, AIR HANDLING UNITS, FANS, CONDENSING UNITS, BMS CONTROL PANELS, TEMPERATURE SENSORS, AND CONTROL VALVES.
  - THESE CONSTRUCTION DRAWINGS ARE DIAGRAMMATIC, AND DO NOT NECESSARILY REFLECT ACTUAL DIMENSIONS. IT IS THE RESPONSIBILITY OF THE CONTRACTOR TO FIELD-VERIFY ALL DIMENSIONS AND COORDINATE PLACEMENT OF ALL EQUIPMENT AND ROUTING OF ALL PIPING AND/OR DUCT SYSTEMS.
  - ALL MECHANICAL SYSTEMS SHOWN ON THIS PLAN ARE FROM EXISTING DRAWINGS AND PRELIMINARY FIELD WORK. CONTRACTOR IS RESPONSIBLE FOR FIELD VERIFYING ALL LOCATIONS AND SIZES OF MECHANICAL SYSTEMS PRIOR TO THE START OF WORK.


**DEMOLITION KEYED NOTES**

- REMOVE EXISTING SUPPLY AIR GRILLE, EXISTING DUCTWORK SHALL REMAIN AND BE REUSED, MAINTAIN EXISTING BALANCING DAMPER IN EXISTING LOCATION.
- REMOVE EXISTING RETURN AIR DEVICE.
- EXISTING DUAL DUCT BOX TO REMAIN.
- REMOVE EXISTING EXHAUST FAN ASSOCIATED DUCTWORK, CONTROLS AND ELECTRICAL CONNECTIONS.
- SEE 1M0.06 FOR CONTINUATION.
- REMOVE EXISTING RETURN AIR TRANSFER.
- REMOVE EXISTING 6" EXHAUST DUCTWORK.

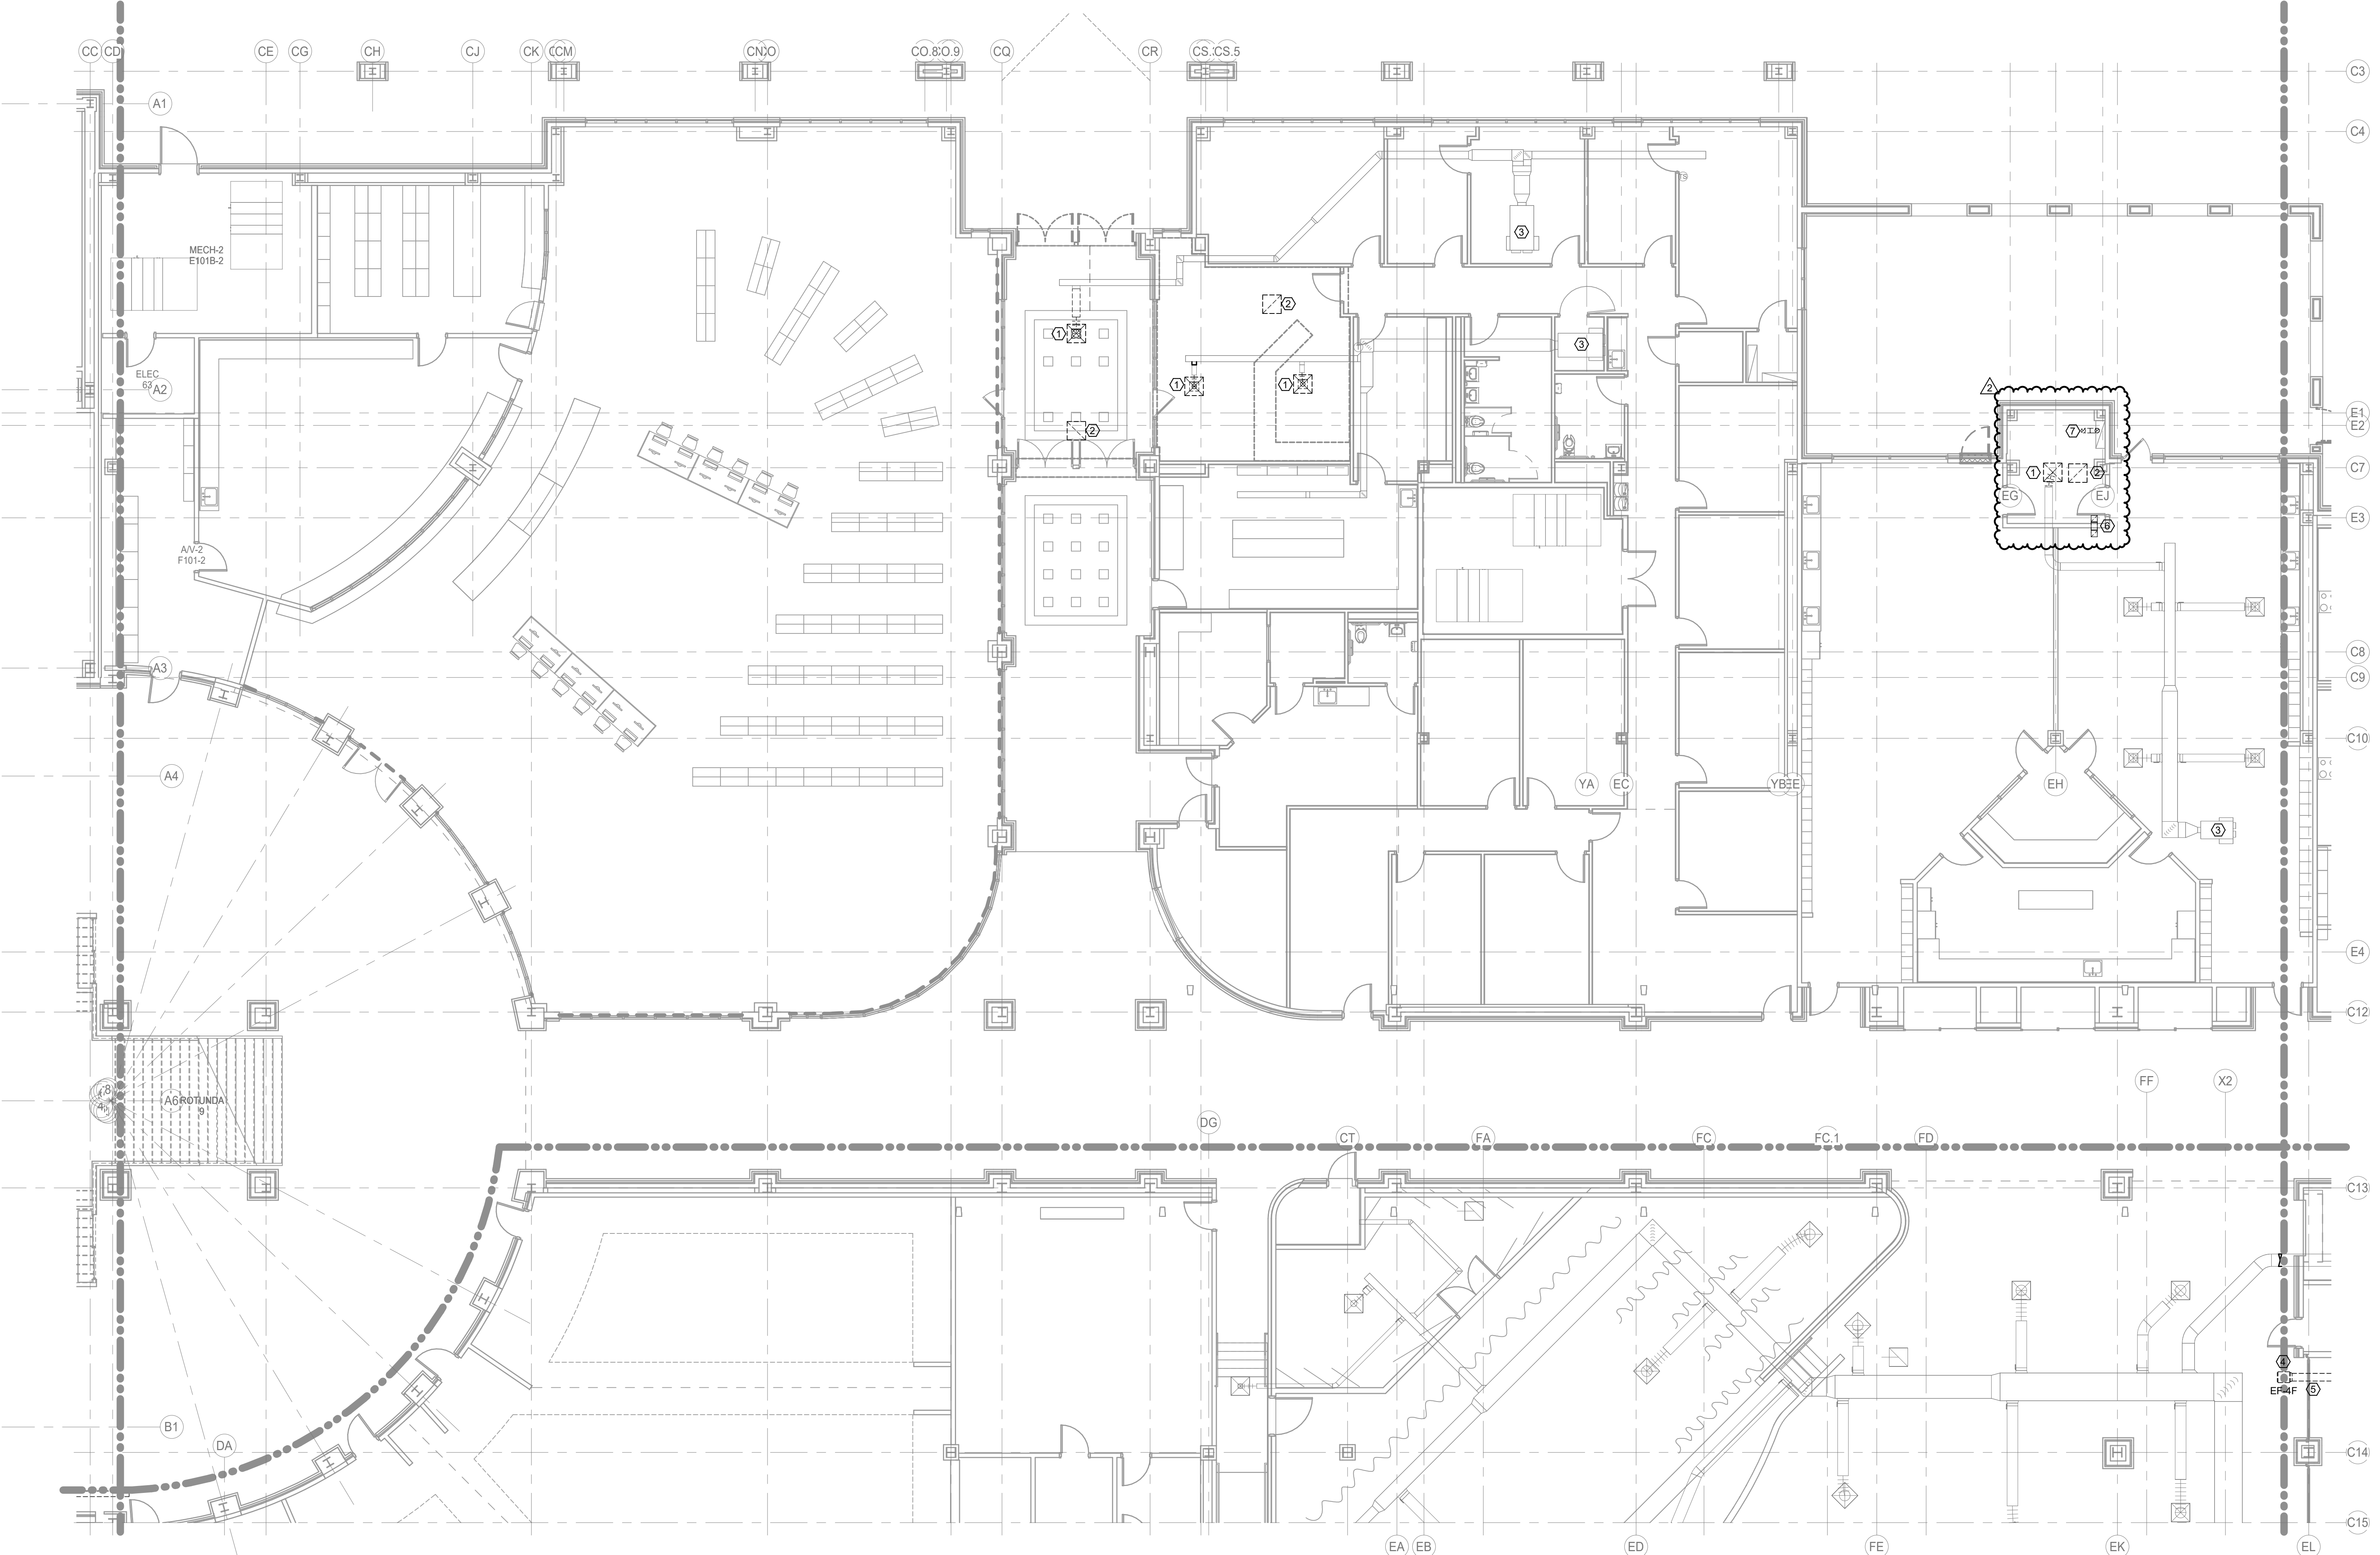

**1 MECHANICAL DEMOLITION FLOOR PLAN - LEVEL 1 - AREA C**  
 Scale: 1/8" = 1'-0"

**KEY PLAN:**

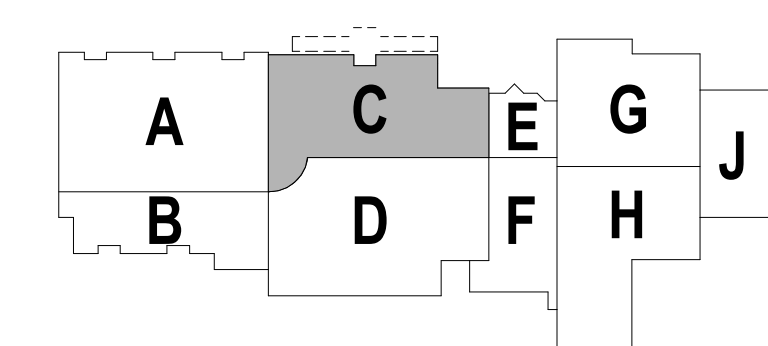

**2024 SMITH & SPILLANE MS RENOVATIONS**  
**SPILLANE MIDDLE SCHOOL**  
 13403 WOODS-SPILLANE BLVD, CYPRESS, TX 77429  
 CFSID PROJECT NO: 24-02-5751-R-RFP

2 Addendum 03 02-14-25  
 Revisions / Submission

Project Number: 23073  
 Date: 26 JANUARY 2025  
 Drawn By: WHL / KLO

**MECHANICAL**  
**DEMOLITION FIRST**  
**FLOOR PLAN - AREA 'C'**  
**M0.03**

**RENOVATIONS**

	POINT OF CONNECTION FROM NEW TO EXISTING
	ITEM TO REMAIN
	ITEM TO BE REMOVED


CONTRACTOR SHALL PROVIDE DEHUMIDIFICATION DURING THE CONSTRUCTION SCHEDULE. THE SCOPE IS TO MAINTAIN ACCEPTABLE HUMIDITY LEVELS WITHIN THE BUILDING. THE REMOVAL OF EXCESS HUMIDITY FROM THE AIR THROUGHOUT THE BUILDING. PROVIDE MOISTURE CONTROL RENTAL EQUIPMENT AND SOLUTION FOR PREVENTING THE LONG-TERM EFFECTS OF MOISTURE LEVEL THAT CAN DAMAGE INTERIOR BUILDING MATERIALS, BOOKS AND ELECTRONIC EQUIPMENT.  
 CONTRACTOR IS RESPONSIBLE TO PROVIDE ALL REQUIRED POWER GENERATING EQUIPMENT.

**GENERAL NOTES:**


- OWNER SHALL HAVE FIRST RIGHT OF REFUSAL ON ALL EQUIPMENT BEING REMOVED FROM THIS PROJECT. THIS INCLUDES BUT IS NOT LIMITED TO CHILLERS, AIR HANDLING UNITS, FANS, CONDENSING UNITS, BMCS CONTROL PANELS, TEMPERATURE SENSORS, AND CONTROL VALVES.
- THESE CONSTRUCTION DRAWINGS ARE DIAGRAMMATIC, AND DO NOT NECESSARILY REFLECT ACTUAL DIMENSIONS. IT IS THE RESPONSIBILITY OF THE CONTRACTOR TO FIELD-VERIFY ALL DIMENSIONS AND COORDINATE PLACEMENT OF ALL EQUIPMENT AND ROUTING OF ALL PIPING AND/OR DUCT SYSTEMS.
- ALL MECHANICAL SYSTEMS SHOWN ON THIS PLAN ARE FROM EXISTING DRAWINGS AND PRELIMINARY FIELD WORK. CONTRACTOR IS RESPONSIBLE FOR FIELD VERIFYING ALL LOCATIONS AND SIZES OF MECHANICAL SYSTEMS PRIOR TO THE START OF WORK.

**DEMOLITION KEYED NOTES**

- REMOVE EXISTING SUPPLY AIR GRILLE AND EXISTING DUCTWORK UP TO INDICATED POINT.
- REMOVE EXISTING RETURN AIR DEVICE.
- REMOVE EXISTING EXHAUST FAN ASSOCIATED DUCTWORK, CONTROLS AND ELECTRICAL CONNECTIONS.
- SEE 1MO.06 FOR CONTINUATION.
- REMOVE EXISTING DUCTWORK BACK TO POINT INDICATED.

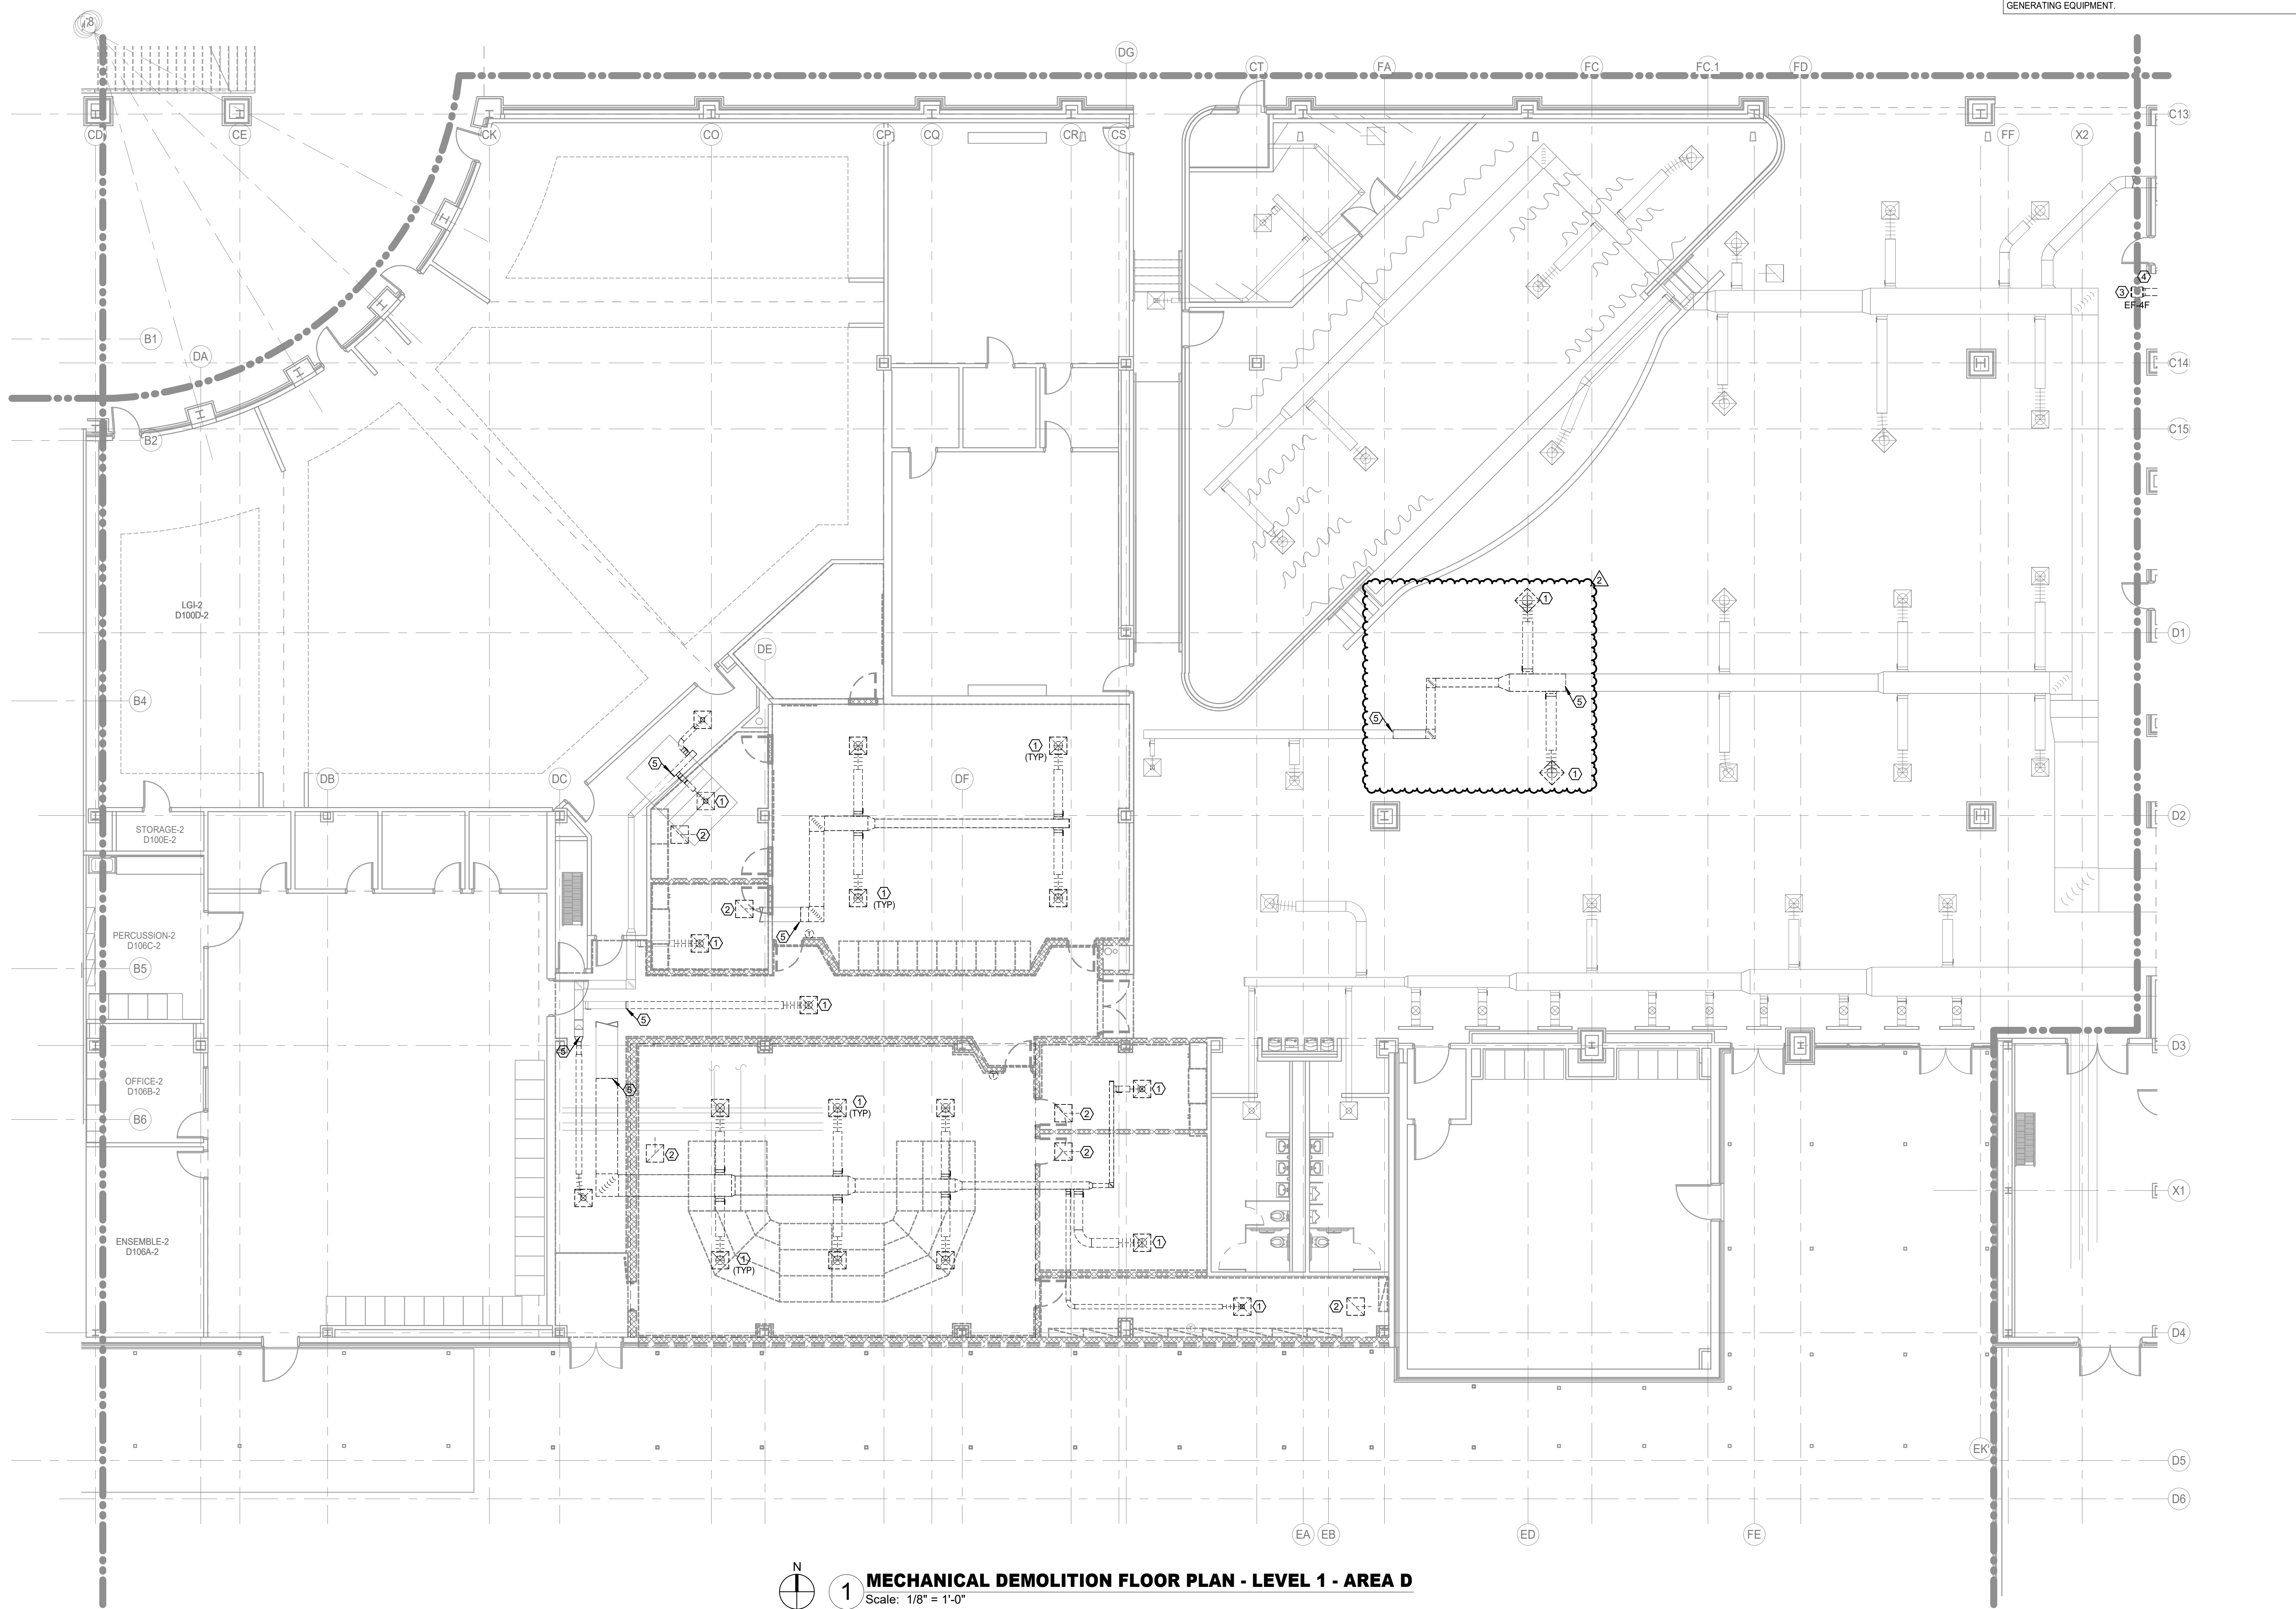

**1 MECHANICAL DEMOLITION FLOOR PLAN - LEVEL 1 - AREA D**  
 Scale: 1/8" = 1'-0"

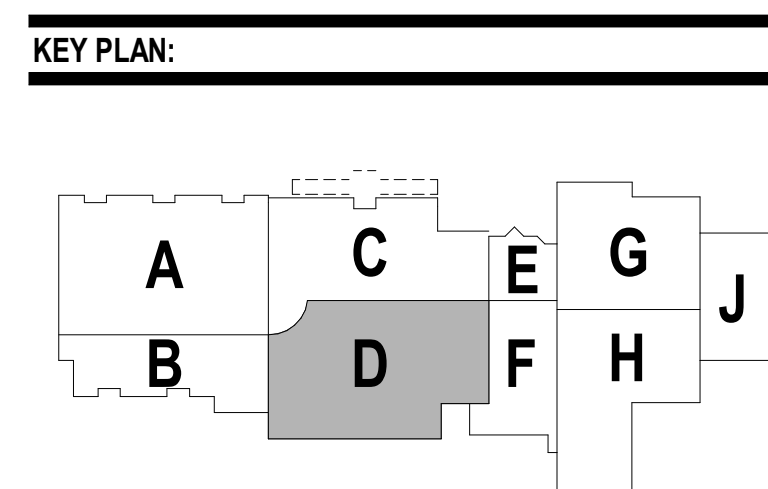

**2024 SMITH & SPILLANE MS RENOVATIONS**  
**SPILLANE MIDDLE SCHOOL**  
 13403 WOODS-SPILLANE BLVD, CYPRESS, TX 77429  
 CFSID PROJECT NO: 24-02-5751-R-RFP

Project Number:	23073
Date:	26 JANUARY 2025
Drawn By:	WHL / KLO
MECHANICAL DEMOLITION FIRST FLOOR PLAN - AREA 'D'	
<b>M0.04</b>	

2 Addendum 03 02-14-25  
 Revisions / Submission



**Salas O'Brien**  
 salasobrien.com 281-664-1900  
 Houston 10930 W. Sam Houston Pkwy North, Suite 900  
 Houston, TX 77064  
 Registration: F-4111  
 Project No: 2024-00209-00

**NATEX**  
 CORPORATION  
 ARCHITECTS  
 www.nateearchitects.com  
 447 Heights Boulevard  
 Houston, TX 77007  
 Phone: 713-975-9525  
 Fax: 713-780-7824

**Coleman Partners**  
 ARCHITECTS  
 cpa.com  
 3701 Kirby Drive, Suite 830  
 Houston, TX 77098  
 Tel: 832-947-1038 Fax: 281-214-5365

**BRADLEY KALMANS**  
 80219  
 5 STAR  
 LICENSED PROFESSIONAL ENGINEER  
 02-14-2025

**CONSTRUCTION DOCUMENT**

**CIVIL ENGINEER**  
**BROOKS AND SPARKS, INC.**  
 21020 PARK ROW  
 KATY, TX 77449  
 tel: 281-578-9595

**STRUCTURAL ENGINEER**  
**DALLY + ASSOCIATES, INC.**  
 9800 RICHMOND AVE.  
 SUITE 400  
 HOUSTON, TX 77042  
 tel: 713-337-8881

**MEPT ENGINEER**  
**SALAS O'BRIEN**  
 10930 W. SAM HOUSTON PKWY. N.  
 SUITE 900  
 HOUSTON, TX 77064  
 tel: 281-664-1900

**FOOD SERVICE EQUIPMENT**  
**FDP**  
 25317 INTERSTATE 45  
 THE WOODLANDS, TX 77380  
 tel: 281-350-2323

**LANDSCAPE ARCHITECT**  
**LANDESIGN GROUP**  
 17041 EL CAMINO REAL  
 SUITE 204  
 HOUSTON, TX 77058  
 tel: 281-486-4040

**GENERAL NOTES:**

1. THESE CONSTRUCTION DRAWINGS ARE DIAGRAMMATIC, AND DO NOT NECESSARILY REFLECT ACTUAL DIMENSIONS. IT IS THE RESPONSIBILITY OF THE CONTRACTOR TO FIELD-VERIFY ALL DIMENSIONS AND COORDINATE PLACEMENT OF ALL EQUIPMENT AND ROUTING OF ALL PIPING AND/OR DUCT SYSTEMS.
2. ALL MECHANICAL SYSTEMS SHOWN ON THIS PLAN ARE FROM EXISTING DRAWINGS AND PRELIMINARY FIELD WORK. CONTRACTOR IS RESPONSIBLE FOR FIELD VERIFYING ALL LOCATIONS AND SIZES OF MECHANICAL SYSTEMS PRIOR TO THE START OF WORK.


**MECHANICAL KEYED NOTES:**

1. VERIFY SERVICE CLEARANCE WITH EQUIPMENT MANUFACTURER. COORDINATE WITH ALL TRADES NOT TO OBSTRUCT.
2. PROVIDE WIND-DRIVEN RAIN RESISTANT STATIONARY LOUVER RUSKR MODEL EMES02MD OR APPROVED EQUAL AND MINIMUM FREE AREA OF AS NOTED. PROVIDE WITH BIRD SCREEN AND PAINT TO MATCH WALL OR AS SPECIFIED BY ARCHITECT.
3. SHEET METAL PLENUM ON REAR OF LOUVER WITH MOTORIZED DAMPER.
4. PROVIDE WITH LINE VOLTAGE HUMIDITY SENSOR.
5. PROVIDE WITH LINE VOLTAGE MOTORIZED DAMPER FOR EXHAUST AND MAKEUP AIR LOUVER.

**RENOVATIONS**


+	POINT OF CONNECTION FROM NEW TO EXISTING
□	ITEM TO REMAIN
⊖	ITEM TO BE REMOVED

CONTRACTOR SHALL PROVIDE DEHUMIDIFICATION DURING THE CONSTRUCTION SCHEDULE. THE SCOPE IS TO MAINTAIN ACCEPTABLE HUMIDITY LEVELS WITHIN THE BUILDING. THE REMOVAL OF EXCESS HUMIDITY FROM THE AIR THROUGHOUT THE BUILDING. PROVIDE MOISTURE CONTROL RENTAL EQUIPMENT AND SOLUTION FOR PREVENTING THE LONG-TERM EFFECTS OF MOISTURE LEVEL THAT CAN DAMAGE INTERIOR BUILDING MATERIALS, BOOKS AND ELECTRONIC EQUIPMENT.  
 CONTRACTOR IS RESPONSIBLE TO PROVIDE ALL REQUIRED POWER GENERATING EQUIPMENT.

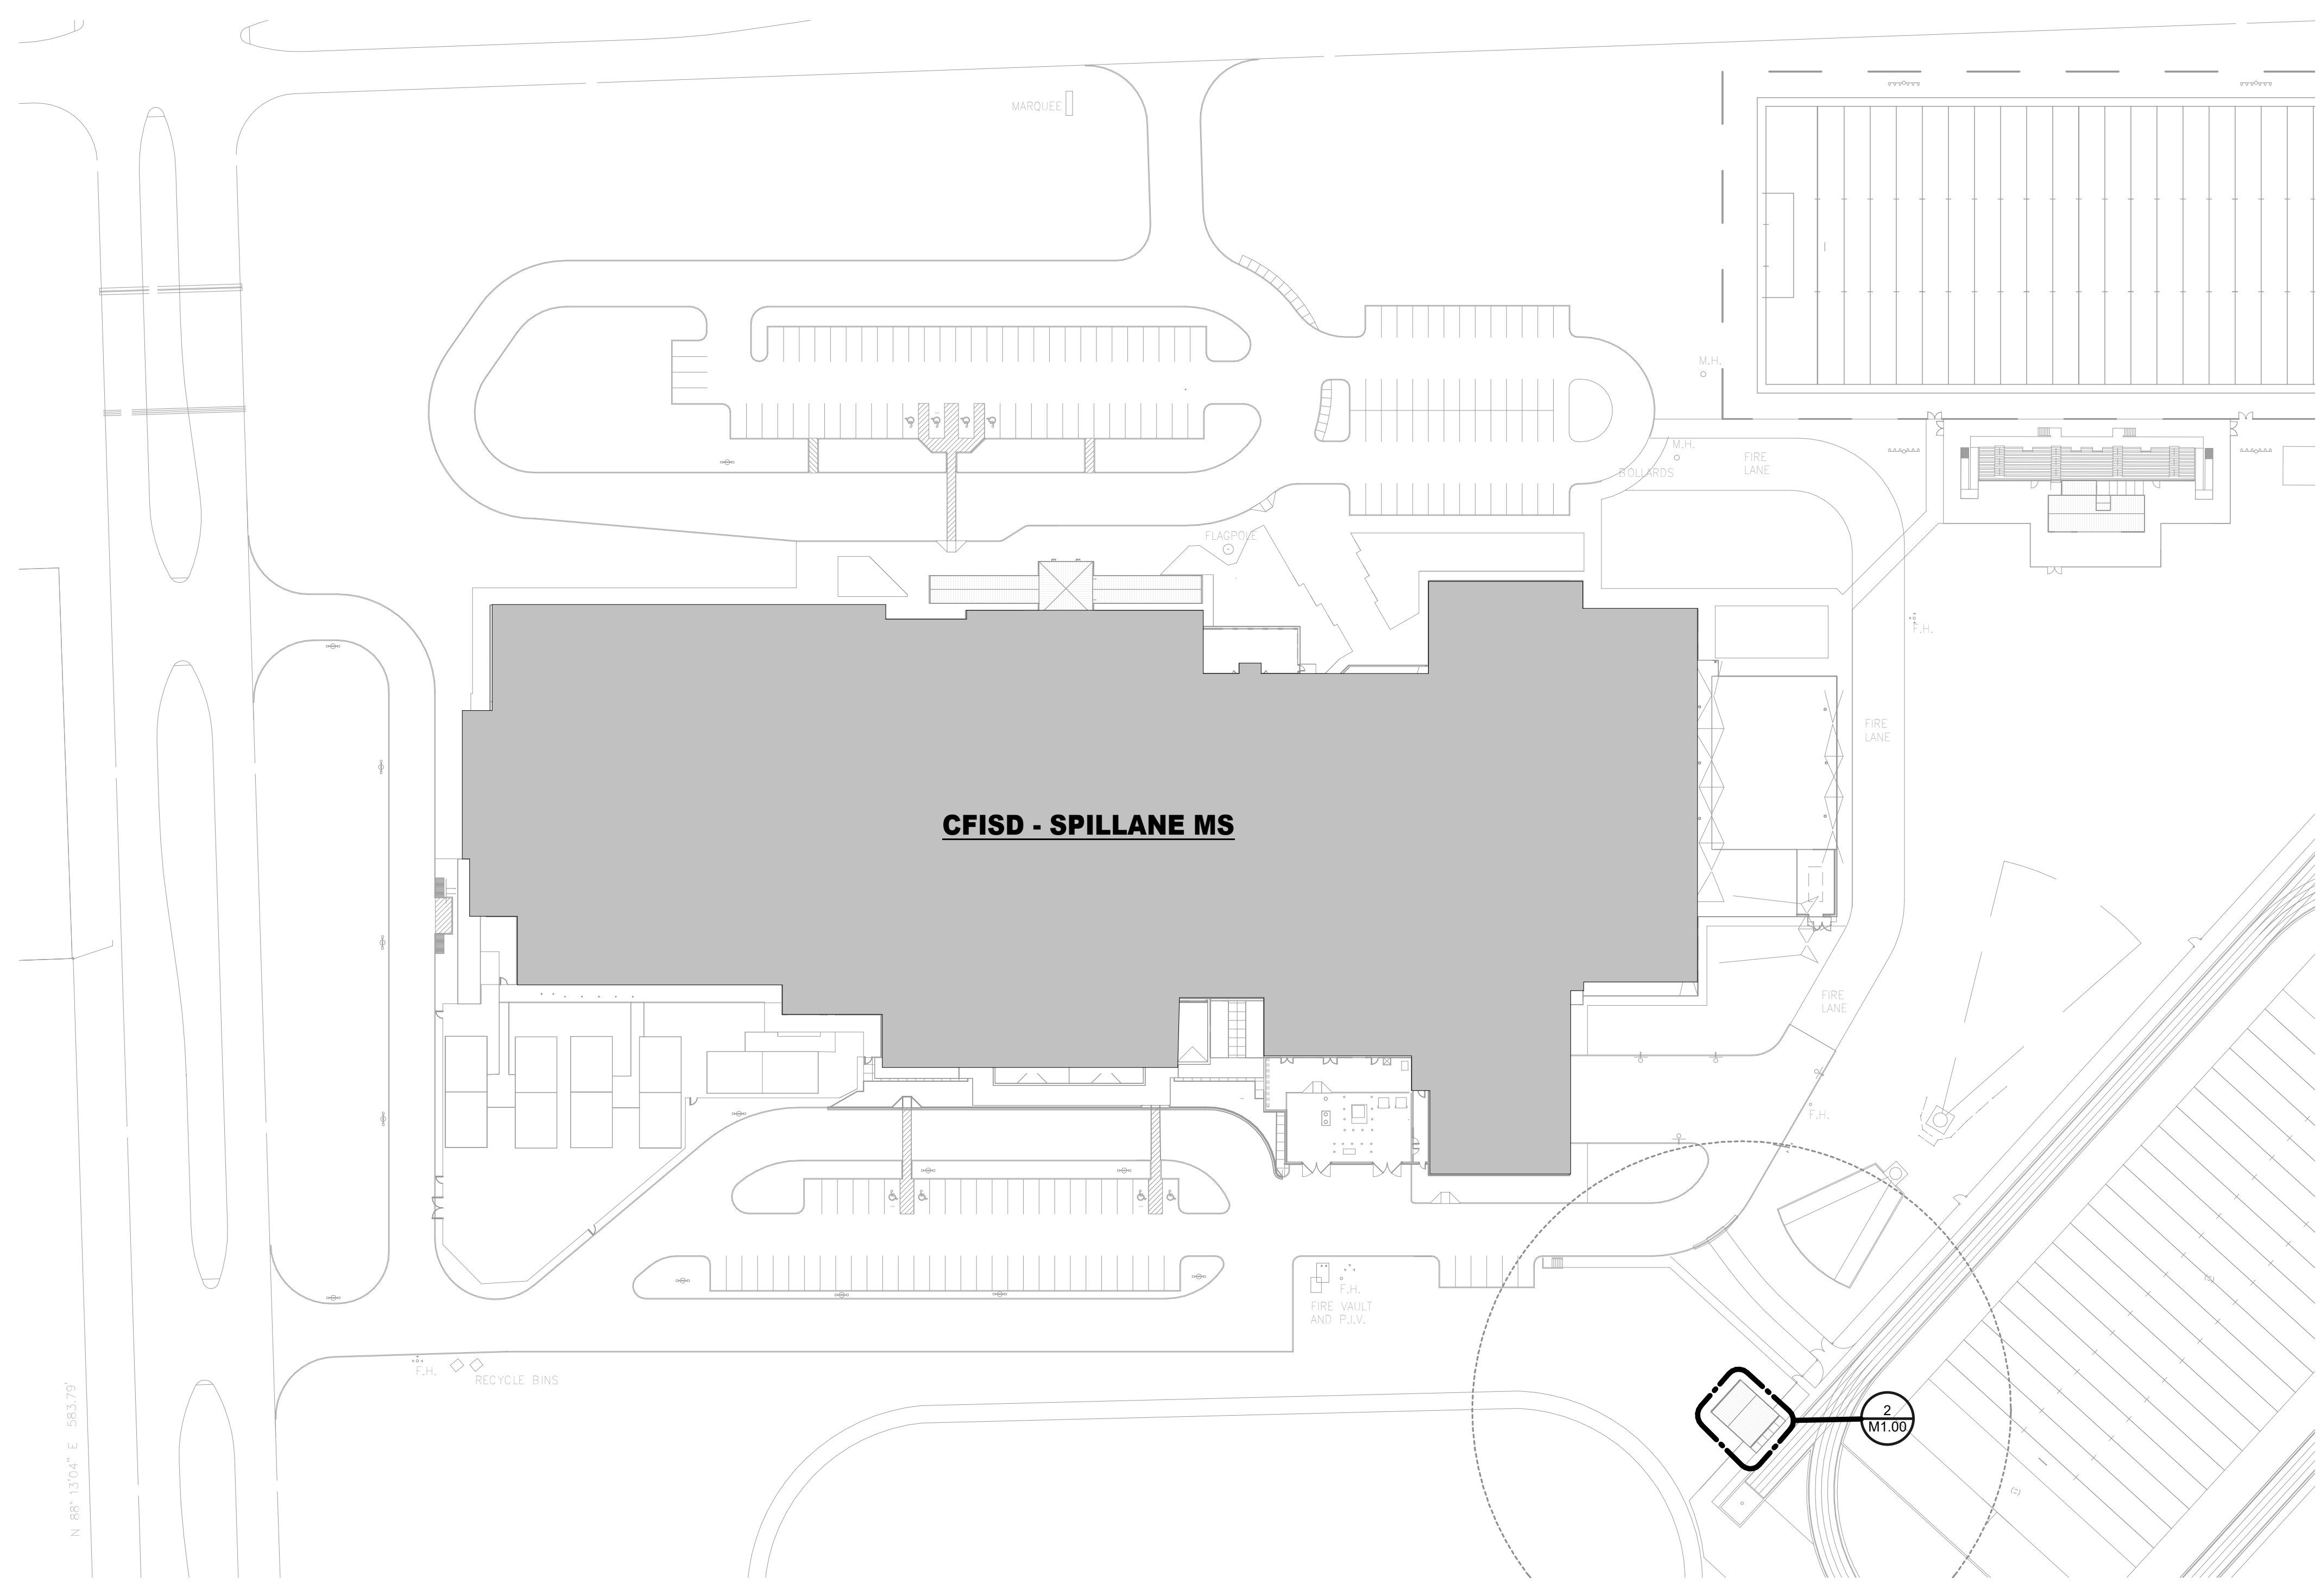

**1 MECHANICAL SITE PLAN**  
 Scale: 1" = 60'-0"

**FIELD STORAGE VENTILATION SEQUENCE OF OPERATION**  
 UPON HUMIDITY RISING ABOVE 80% (ADJ.), OUTSIDE AIR DAMPER ON INTAKE LOUVER SHALL OPEN. EXHAUST FAN DAMPER SHALL OPEN AND EXHAUST FAN SHALL BE ENABLED.

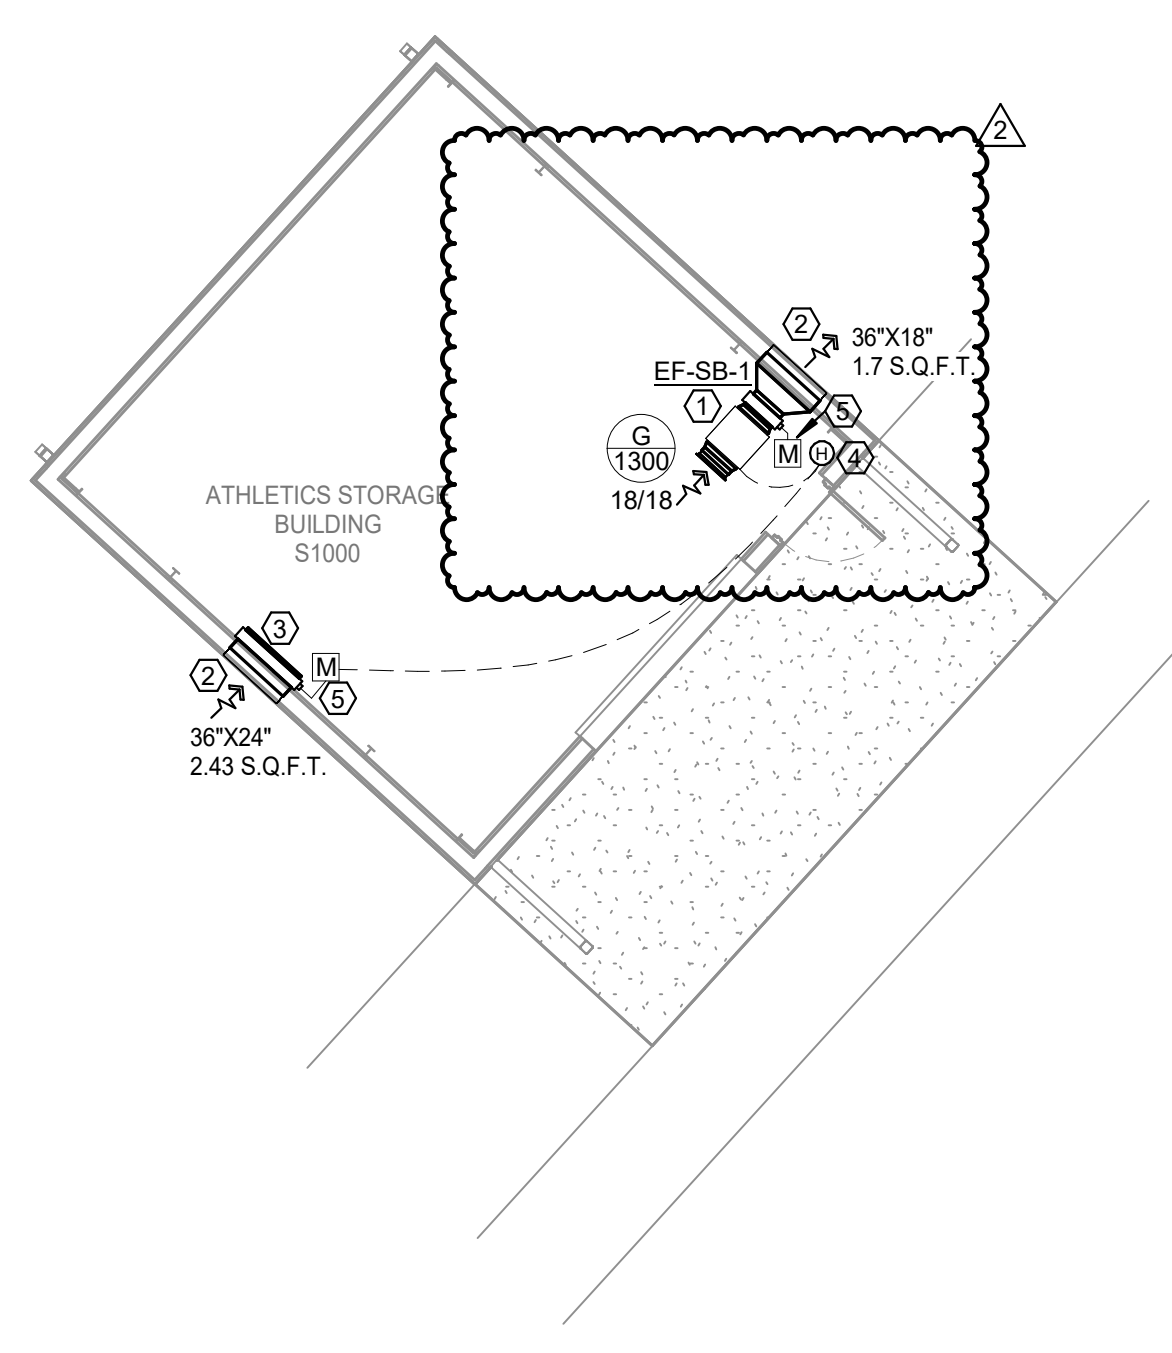

**2 MECHANICAL SITE PLAN - STORAGE BUILDING**  
 Scale: 1/8" = 1'-0"


**2024 SMITH & SPILLANE MS RENOVATIONS**  
**SPILLANE MIDDLE SCHOOL**  
 13403 WOODS-SPILLANE BLVD, CYPRESS, TX 77429  
 CFISD PROJECT NO: 24-02-5751-R-RFP

Project Number:	23073
Date:	26 JANUARY 2025
Drawn By:	WHL / KLO

**MECHANICAL SITE PLAN**


**M1.00**

- GENERAL NOTES:**
1. THESE CONSTRUCTION DRAWINGS ARE DIAGRAMMATIC, AND DO NOT NECESSARILY REFLECT ACTUAL DIMENSIONS. IT IS THE RESPONSIBILITY OF THE CONTRACTOR TO FIELD-VERIFY ALL DIMENSIONS AND COORDINATE PLACEMENT OF ALL EQUIPMENT AND ROUTING OF ALL PIPING AND/OR DUCT SYSTEMS.
  2. ALL MECHANICAL SYSTEMS SHOWN ON THIS PLAN ARE FROM EXISTING DRAWINGS AND PRELIMINARY FIELD WORK. CONTRACTOR IS RESPONSIBLE FOR FIELD VERIFYING ALL LOCATIONS AND SIZES OF MECHANICAL SYSTEMS PRIOR TO THE START OF WORK.
- MECHANICAL KEYED NOTES:**
1. PROVIDE ADDITIONAL FLEX DUCTWORK AS REQUIRED TO INSTALL DIFFUSER IN LOCATION INDICATED.
  2. AVERAGING TEMPERATURE SENSOR FOR DUAL DUCT BOX INDICATED.
  3. PROVIDE BMS MONITORING TEMPERATURE SENSOR AS INDICATED.
  4. ROUTE KILN ALUMINUM DUCTWORK DOWN ALONG WALL TO 24" A.F.F. FOR CONNECTION TO KILN FUME FAN. REFER TO DETAIL.
  5. ROUTE FAN DISCHARGE DUCT AS SHOWN UP TO GOOSENECK ON ROOF. REUSE EXISTING ROOF OPENING. REFER TO GOOSENECK DETAIL.
  6. MOUNT KILN FAN TO WALL. REFER TO MANUFACTURER'S INSTALLATION INSTRUCTIONS.
  7. KILN VENTILATION SHALL BE ENVIRONMENT 2 BY SKUTT. PROVIDE KILN WITH ENVIRLINK CONTROLLER AND ALL WIRES WITH SUFFICIENT LENGTH TO MAKE ALL CONNECTIONS AS PER MANUFACTURER RECOMMENDATIONS.
  8. PROVIDE ALUMINUM FLEX TO CONNECT KILN ALUMINUM DUCT WITH KILN FAN.
  9. THERMOSTAT SHALL BE SET TO 80°F (ADJUSTABLE).
  10. PROVIDE HEAT DETECTOR, INTERLOCK WITH KILN TO SHUT OFF POWER SOURCE AT 157°F (ADJUSTABLE). MOUNT HEAT DETECTOR ON CEILING AT LOCATION SHOWN.

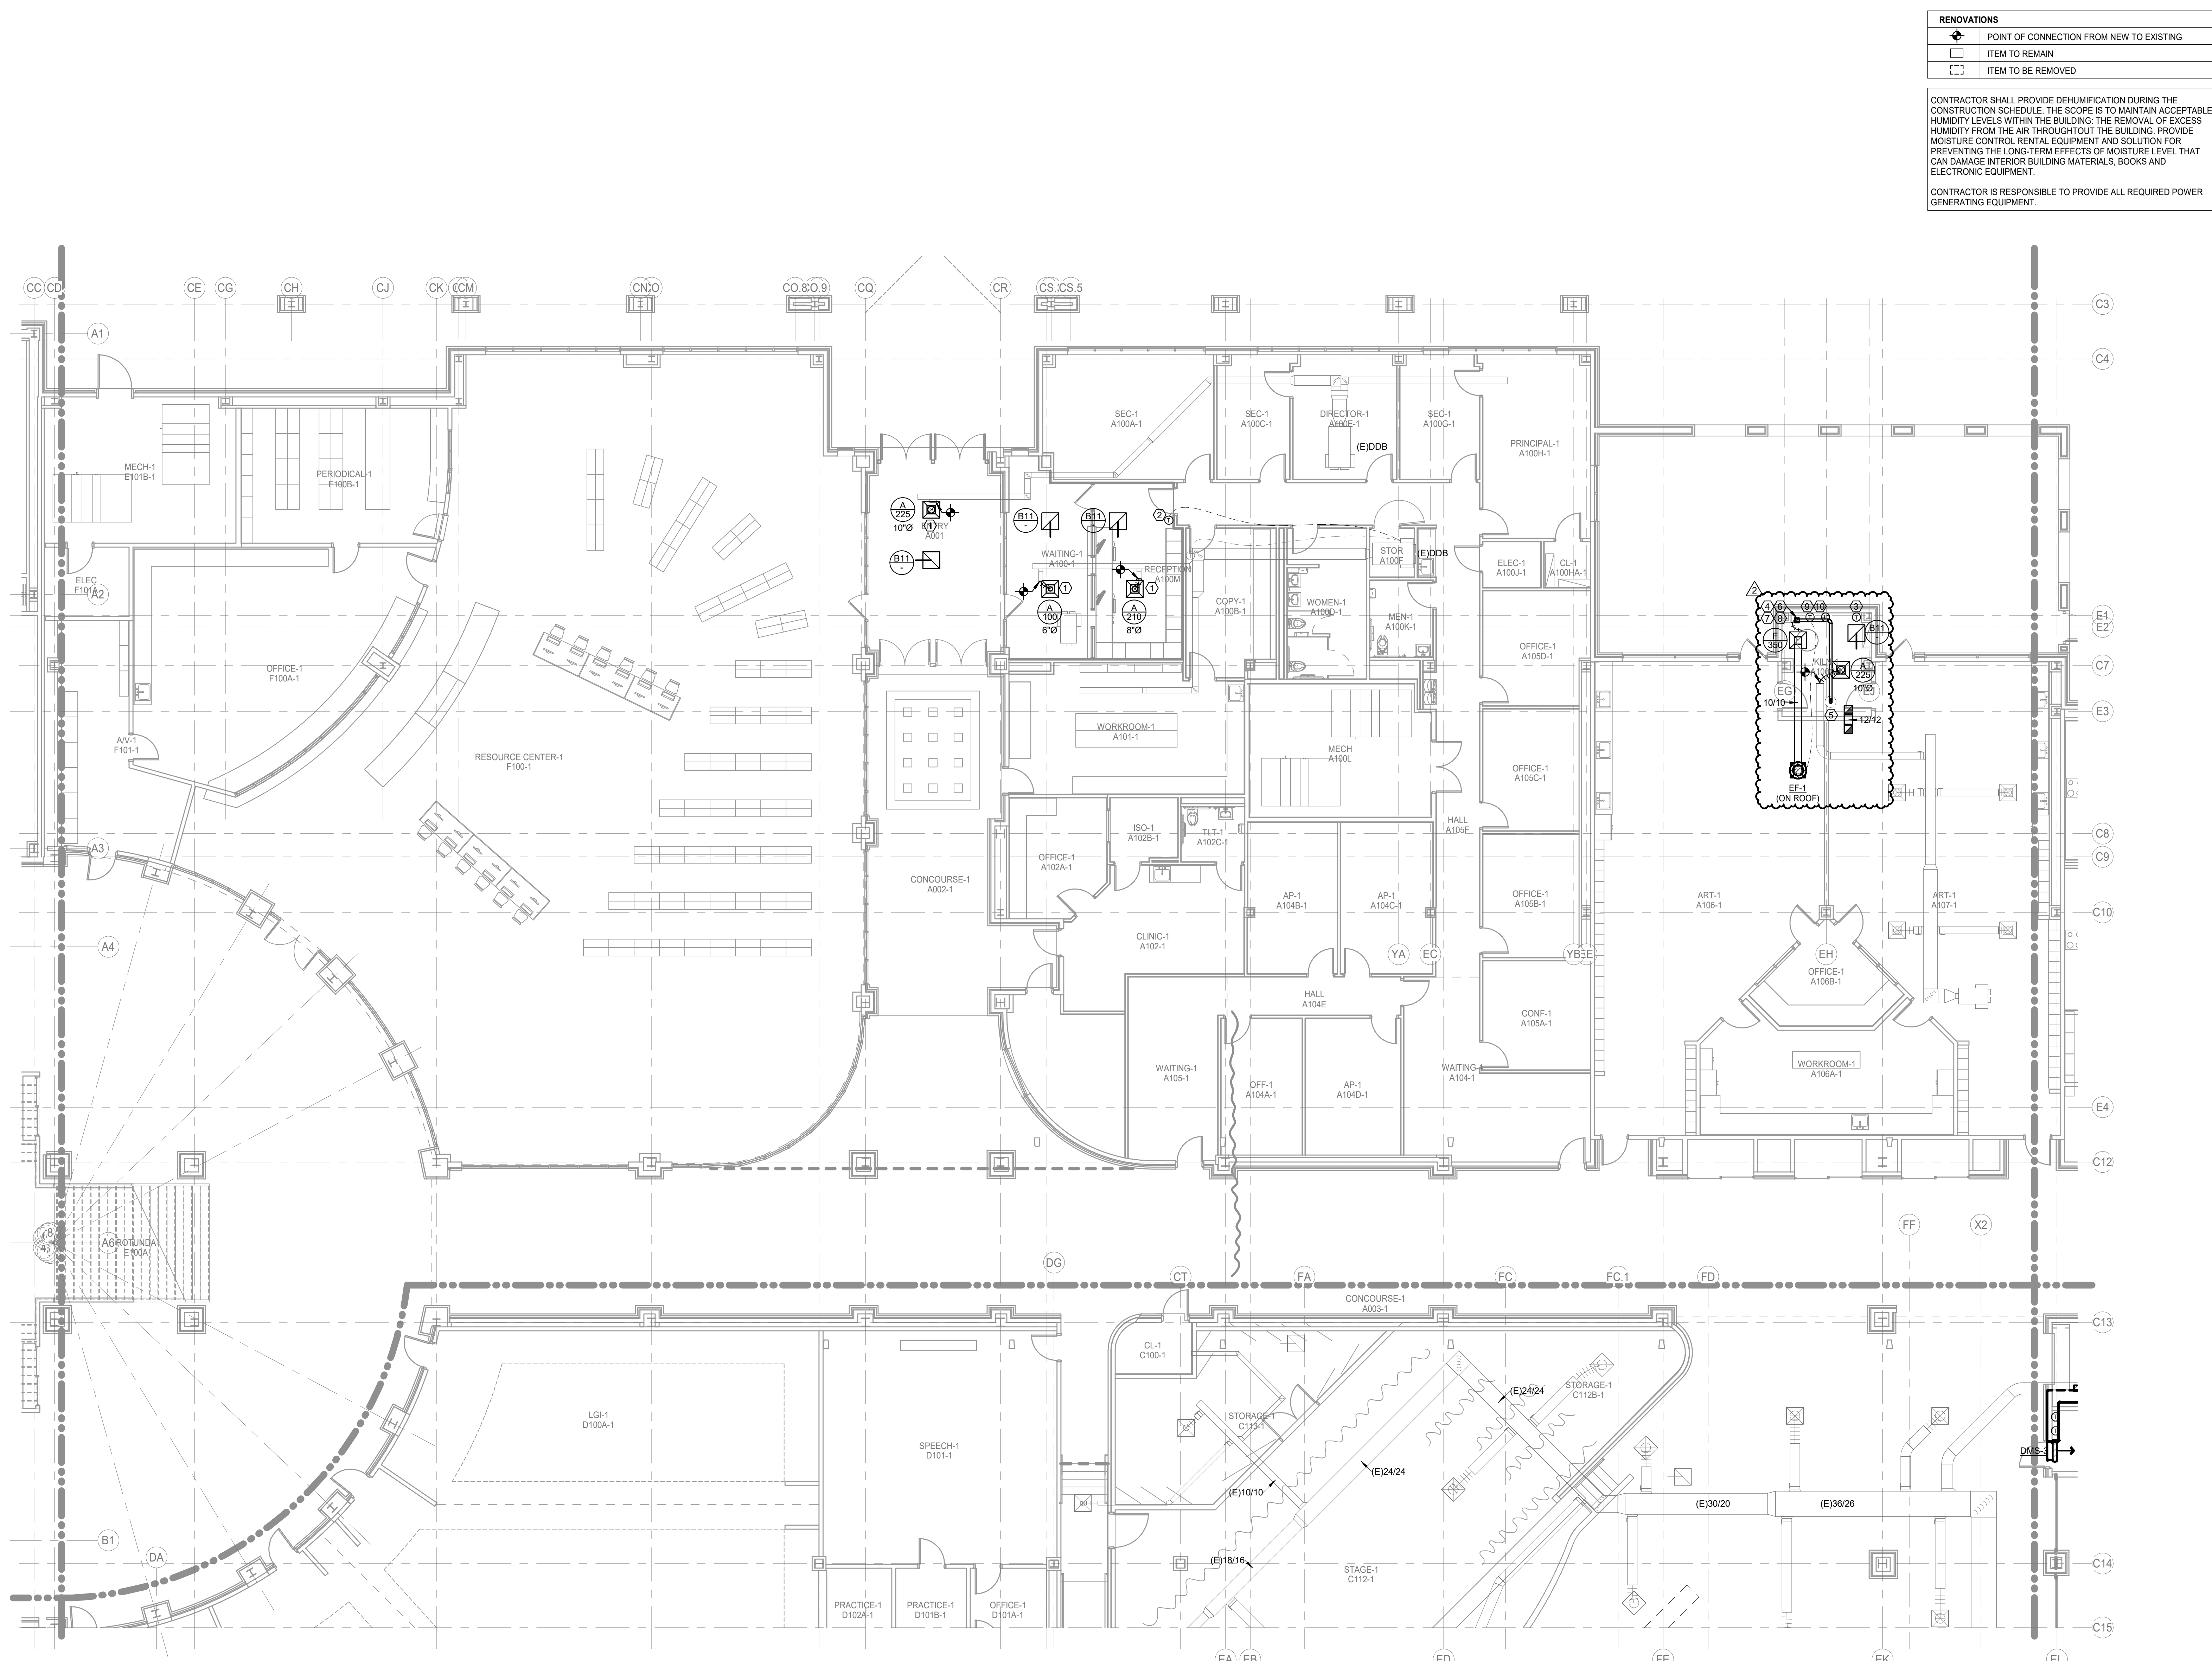

**MECHANICAL FLOOR PLAN - LEVEL 1 - AREA C**  
 Scale: 1/8" = 1'-0"

**KEY PLAN:**

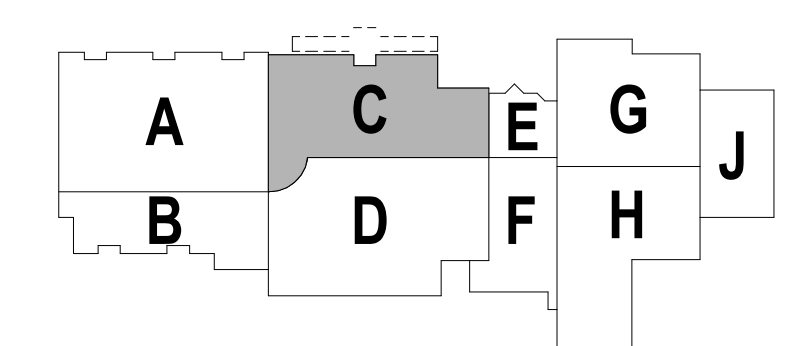

**2024 SMITH & SPILLANE MS RENOVATIONS**  
**SPILLANE MIDDLE SCHOOL**  
 13403 WOODS-SPILLANE BLVD, CYPRESS, TX 77429  
 CFISD PROJECT NO: 24-02-5751-R-RFP

Project Number: 23073  
 Date: 26 JANUARY 2025  
 Drawn By: WHL / KLO

**MECHANICAL FIRST FLOOR PLAN - AREA 'C'**  
**M1.03**



**RENOVATIONS**

➔	POINT OF CONNECTION FROM NEW TO EXISTING
☐	ITEM TO REMAIN
☒	ITEM TO BE REMOVED



CONTRACTOR SHALL PROVIDE DEHUMIDIFICATION DURING THE CONSTRUCTION SCHEDULE. THE SCOPE IS TO MAINTAIN ACCEPTABLE HUMIDITY LEVELS WITHIN THE BUILDING. THE REMOVAL OF EXCESS HUMIDITY FROM THE AIR THROUGHOUT THE BUILDING. PROVIDE MOISTURE CONTROL RENTAL EQUIPMENT AND SOLUTION FOR PREVENTING THE LONG-TERM EFFECTS OF MOISTURE LEVEL THAT CAN DAMAGE INTERIOR BUILDING MATERIALS, BOOKS AND ELECTRONIC EQUIPMENT.  
 CONTRACTOR IS RESPONSIBLE TO PROVIDE ALL REQUIRED POWER GENERATING EQUIPMENT.

**GENERAL NOTES:**

- THESE CONSTRUCTION DRAWINGS ARE DIAGRAMMATIC, AND DO NOT NECESSARILY REFLECT ACTUAL DIMENSIONS. IT IS THE RESPONSIBILITY OF THE CONTRACTOR TO FIELD VERIFY ALL DIMENSIONS AND COORDINATE PLACEMENT OF ALL EQUIPMENT AND ROUTING OF ALL PIPING AND DUCT SYSTEMS.
- ALL MECHANICAL SYSTEMS SHOWN ON THIS PLAN ARE FROM EXISTING DRAWINGS AND PRELIMINARY FIELD WORK. CONTRACTOR IS RESPONSIBLE FOR FIELD VERIFYING ALL LOCATIONS AND SIZES OF MECHANICAL SYSTEMS PRIOR TO THE START OF WORK.

**MECHANICAL KEYED NOTES:**


- VERIFY SERVICE CLEARANCE WITH EQUIPMENT MANUFACTURER. COORDINATE WITH ALL TRADES NOT TO OBSTRUCT.
- VERIFY SERVICE CLEARANCE FOR AIR FILTER REMOVAL WITH EQUIPMENT MANUFACTURER. COORDINATE WITH ALL TRADES NOT TO OBSTRUCT.
- VERIFY SERVICE CLEARANCE FOR FAN SHAFT AND COIL REMOVAL WITH EQUIPMENT MANUFACTURER. COORDINATE WITH ALL TRADES NOT TO OBSTRUCT.
- SHEET METAL PLENUM, FULL SIZE OF UNIT RETURN AIR OPENING. LENGTH AS REQUIRED FOR ALL DUCT CONNECTIONS SHOWN.
- ROUTE FULL SIZE CONDENSATE DRAIN PIPE TO NEW FLOOR DRAIN LOCATED IN MECHANICAL MEZZANINE.
- PROVIDE 4" THICK CONCRETE HOUSEKEEPING PAD.
- PROVIDE WIND-DRIVEN RAIN RESISTANT STATIONARY LOUVER RUSKIN MODEL E8520MD OR APPROVED EQUAL AND MINIMUM FREE AREA OF AS NOTED. PROVIDE WITH BIRD SCREEN AND PAINT TO MATCH WALL OR AS SPECIFIED BY ARCHITECT.
- PROVIDE NEW BYPASS PIPING AND VALVES AS SHOWN TO ALLOW FOR ISOLATING THE NEW PIPING FROM THE EXISTING HYDRONIC LOOPS. TESTING, FLUSHING, AND TREATMENT OF NEW PIPING SHALL BE PERFORMED PRIOR TO OPENING THE NEW PIPING TO THE EXISTING HYDRONIC LOOPS. PURGERITE OR COMPARABLE COMPANY SHALL PROVIDE ASSISTANCE TO THE MECHANICAL CONTRACTOR TO CONFIRM FLUSHING AND CLEANING AT DESIGN SYSTEM FLOW RATES. CHEMICAL TREATMENT MANUFACTURER SHALL TEST WATER TO CONFIRM COMPLIANCE OF FLUSHING AND TREATMENT OF WATER PRIOR TO OPENING THE NEW PIPING VALVES TO THE EXISTING HYDRONIC LOOP.

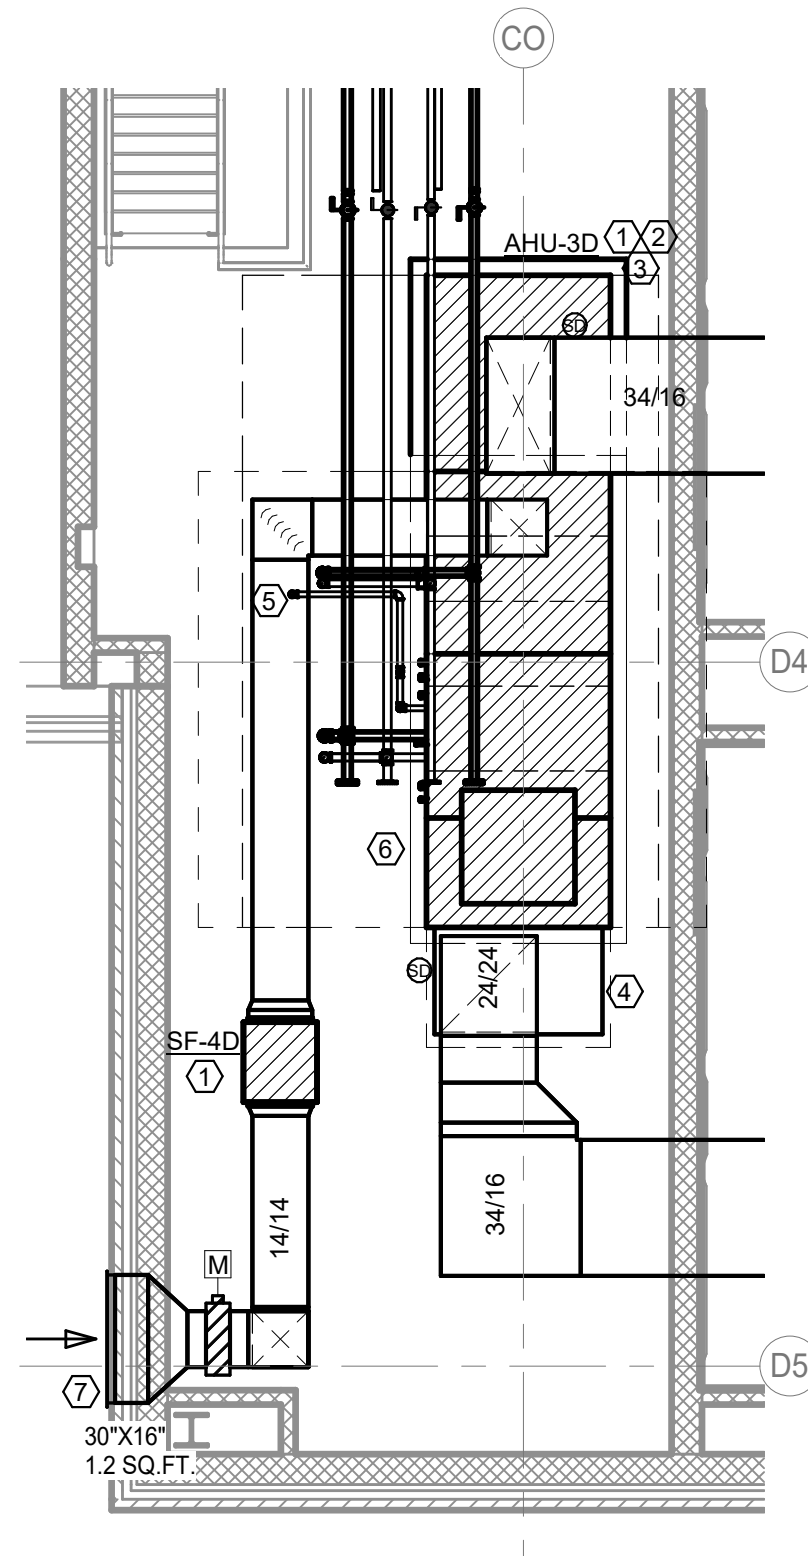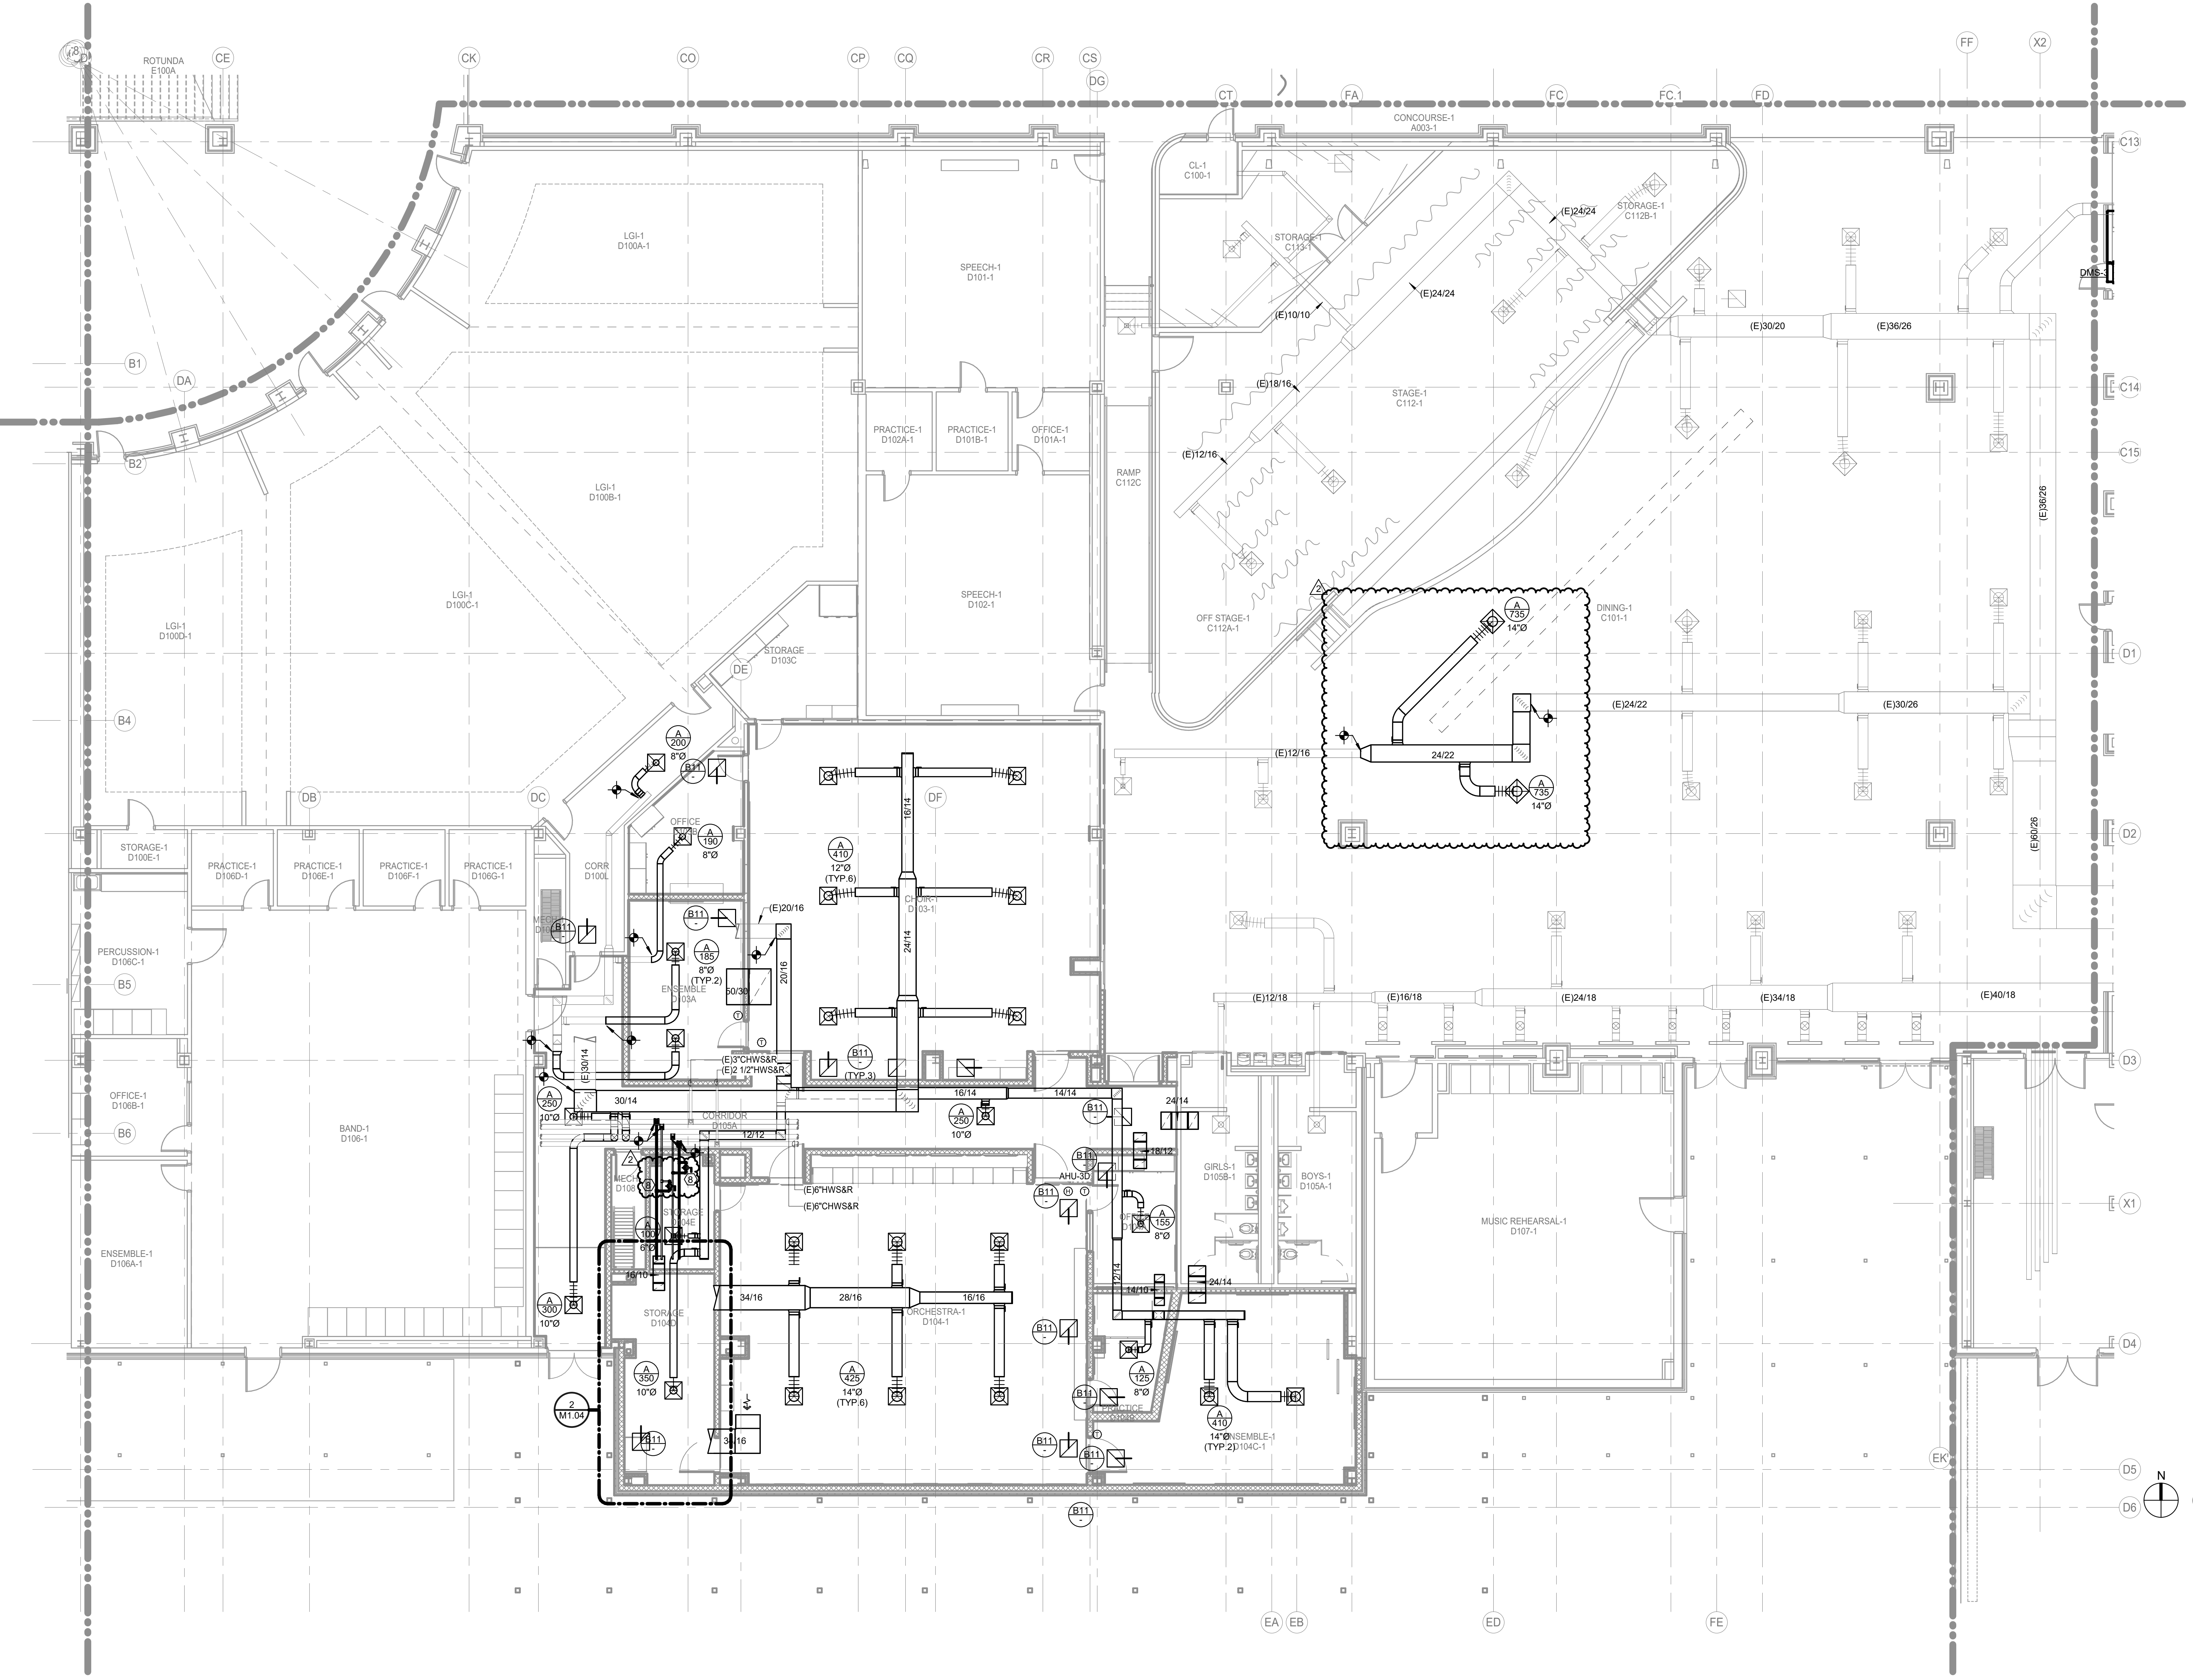

**2 ENLARGED MECHANICAL MEZZANINE**  
 Scale: 1/4" = 1'-0"

**1 MECHANICAL FLOOR PLAN - LEVEL 1 - AREA D**  
 Scale: 1/8" = 1'-0"

**KEY PLAN:**

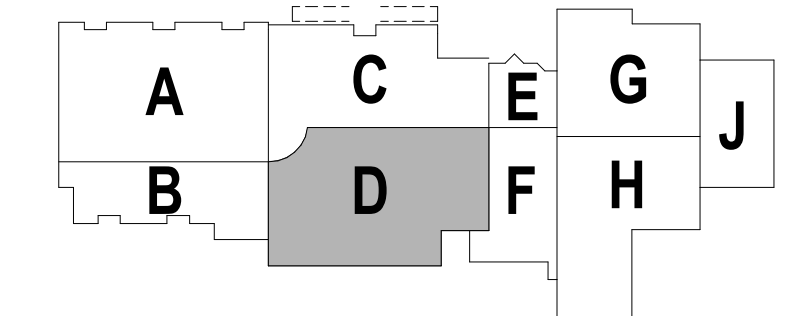

**2024 SMITH & SPILLANE MS RENOVATIONS**  
**SPILLANE MIDDLE SCHOOL**  
 13403 WOODS-SPILLANE BLVD, CYPRESS, TX 77429  
 CFSID PROJECT NO: 24-02-5751-R-RFP

Project Number: 23073  
 Date: 26 JANUARY 2025  
 Drawn By: WHL / KLO

**MECHANICAL FIRST FLOOR PLAN - AREA 'D'**  
**M1.04**

**Salas O'Brien**  
 salesobrien.com 281-664-1900  
 Houston 10930 W. Sam Houston Pkwy North, Suite 900  
 Houston, TX 77064  
 Registration: F-4111  
 Project No: 2024-0209-00

**NATEX**  
 CORPORATION  
 ARCHITECTS  
 www.natearchitects.com  
 447 Heights Boulevard  
 Houston, TX 77007  
 Phone: 713-975-9525  
 Fax: 713-780-7824

**Coleman Partners**  
 ARCHITECTS  
 colemanpartners.com  
 3701 Kirby Drive, Suite 830  
 Houston, TX 77098  
 tel: 832.947.1038 fax: 281.214.5365

**CONSTRUCTION DOCUMENT**  
 02-14-2025

**BRADLEY KALMANS**  
 ARCHITECTS  
 80219  
 CENSUS  
 02-14-2025

**CIVIL ENGINEER**  
**BROOKS AND SPARKS, INC.**  
 21020 PARK ROW  
 KATY, TX 77449  
 tel: 281.578.9595

**STRUCTURAL ENGINEER**  
**DALLY + ASSOCIATES, INC.**  
 9800 RICHMOND AVE.  
 SUITE 400  
 HOUSTON, TX 77042  
 tel: 713.337.8881

**MEPT ENGINEER**  
**SALAS O'BRIEN**  
 10930 W. SAM HOUSTON PKWY. N.  
 SUITE 900  
 HOUSTON, TX 77064  
 tel: 281.664.1900

**FOOD SERVICE EQUIPMENT**  
**FDP**  
 25317 INTERSTATE 45  
 THE WOODLANDS, TX 77380  
 tel: 281.350.2323


**LANDSCAPE ARCHITECT**  
**LANDESIGN GROUP**  
 17041 EL CAMINO REAL  
 SUITE 204  
 HOUSTON, TX 77058  
 tel: 281.486.4040

**2024 SMITH & SPILLANE MS RENOVATIONS**  
**SPILLANE MIDDLE SCHOOL**  
 13403 WOODS-SPILLANE BLVD, CYPRESS, TX 77429  
 CFSID PROJECT NO: 24-02-5751-R-RFP


Project Number: 23073  
 Date: 26 JANUARY 2025  
 Drawn By: WHL / KLO

MECHANICAL DETAILS


**M3.01**

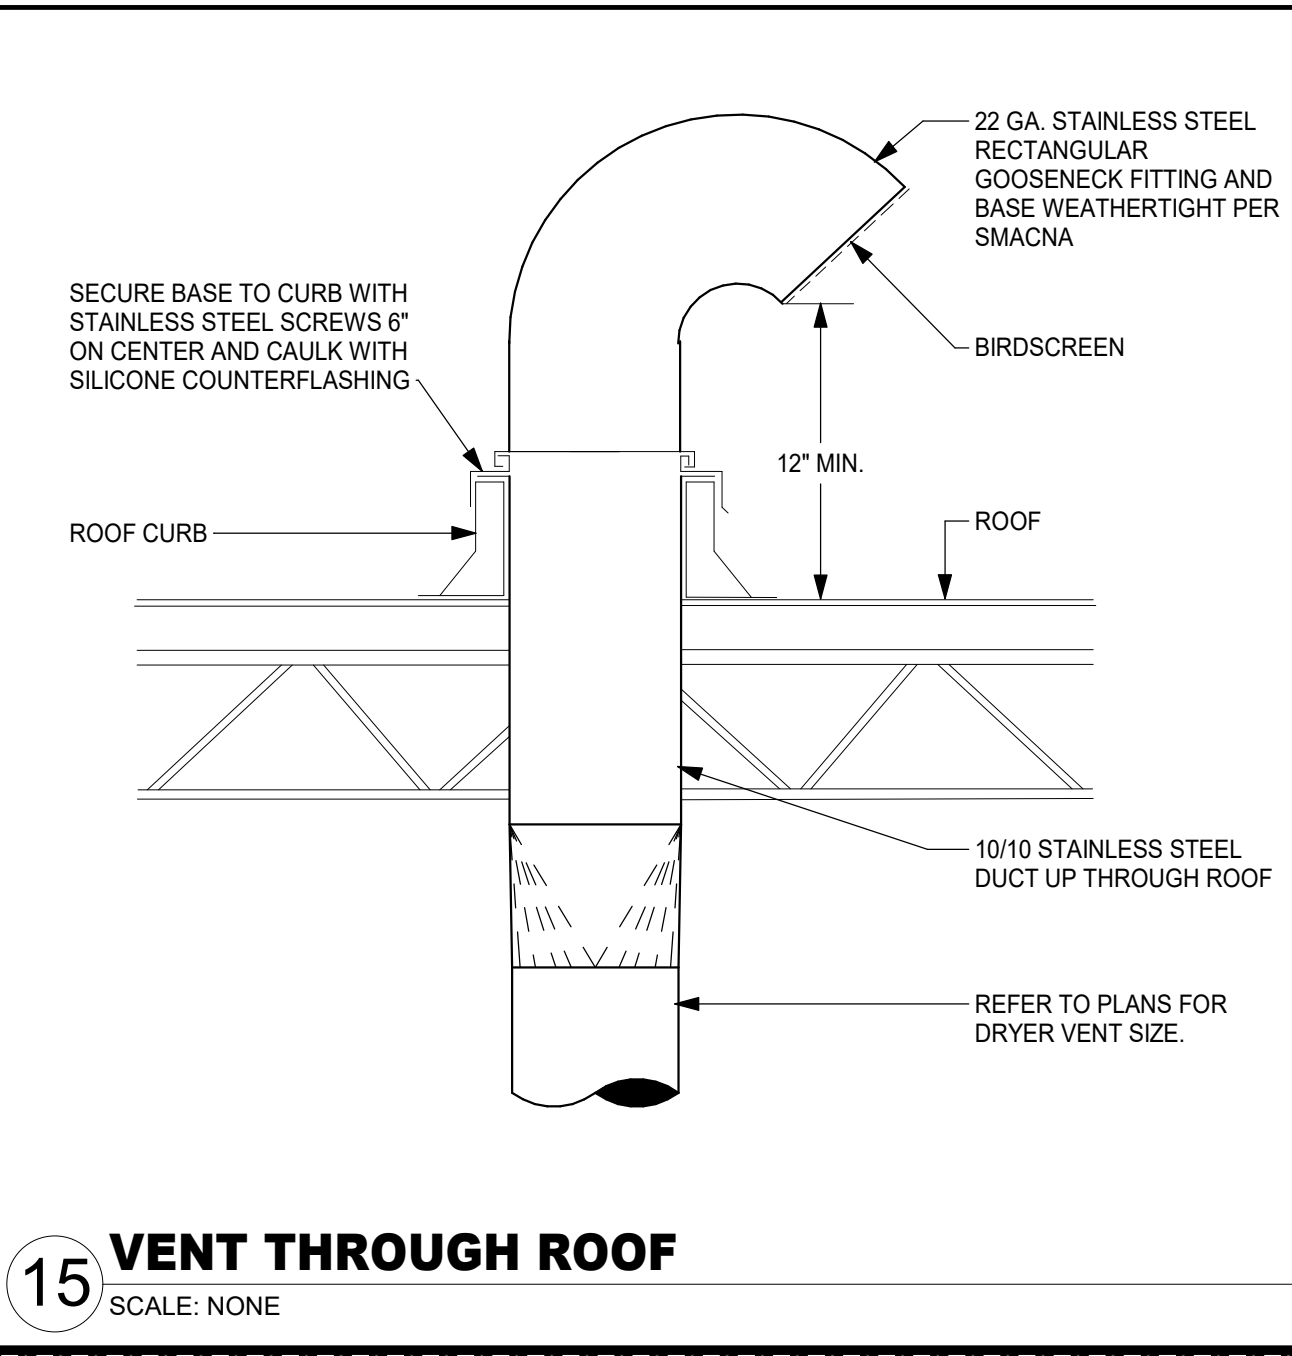


**15 VENT THROUGH ROOF**  
 SCALE: NONE

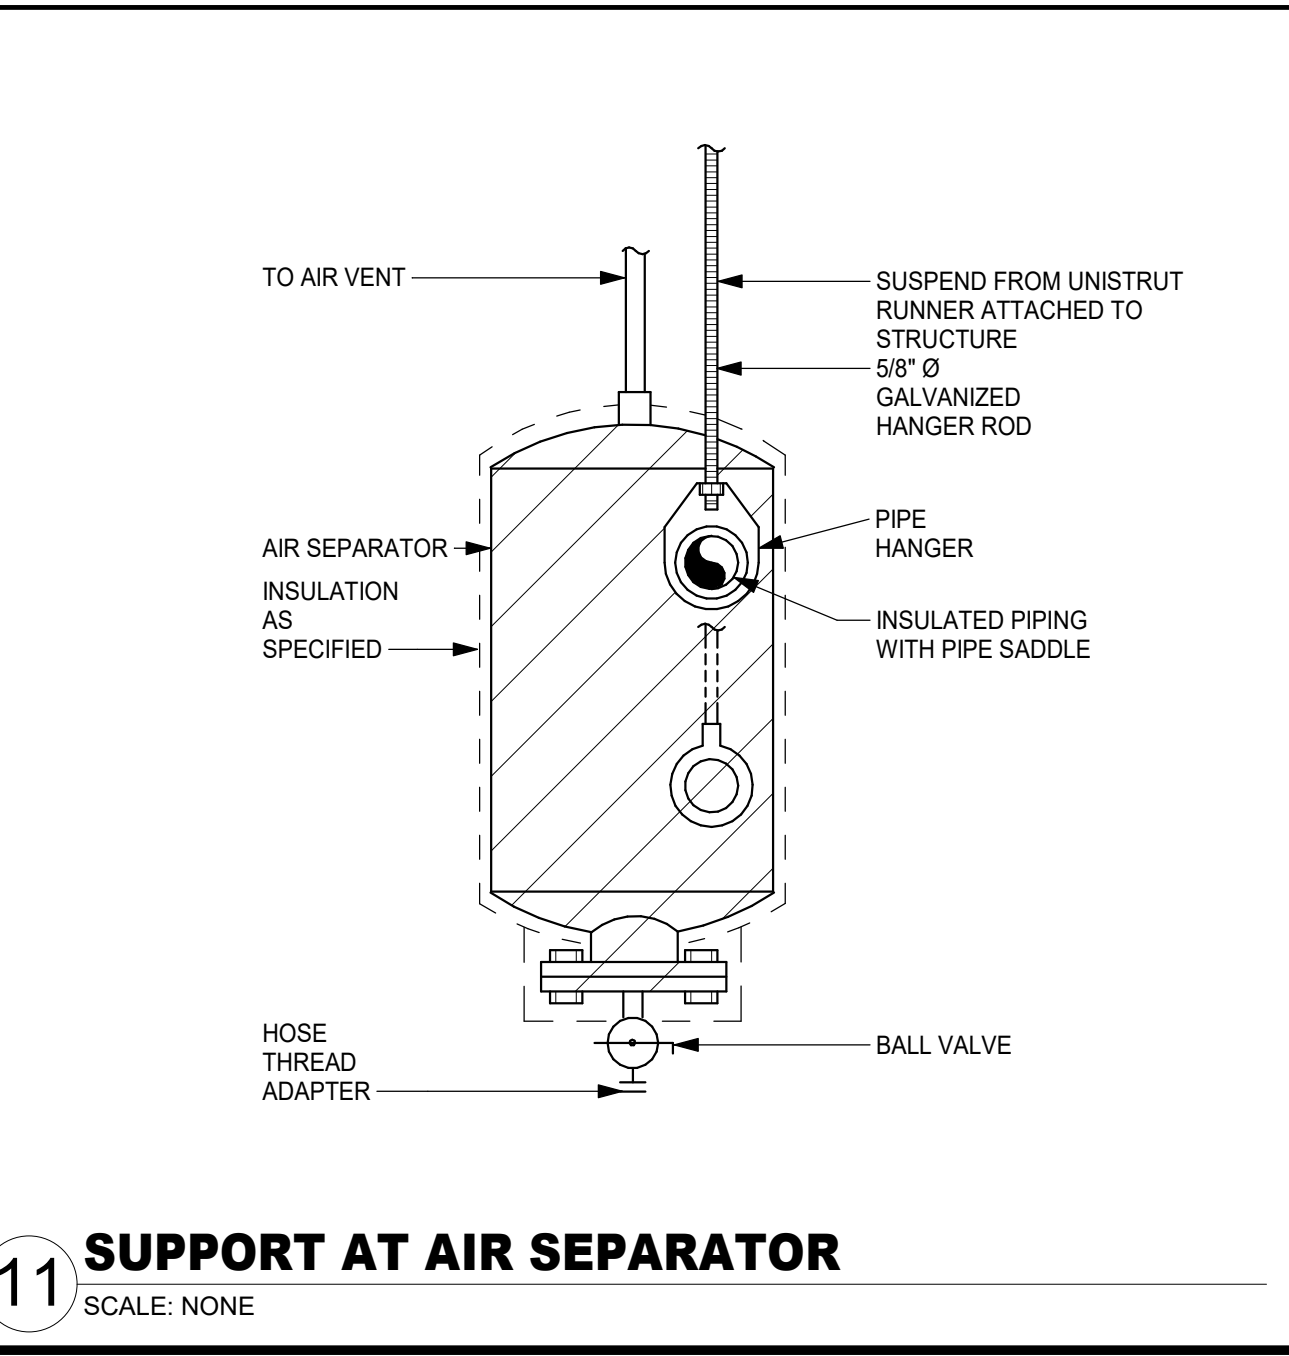


**11 SUPPORT AT AIR SEPARATOR**  
 SCALE: NONE

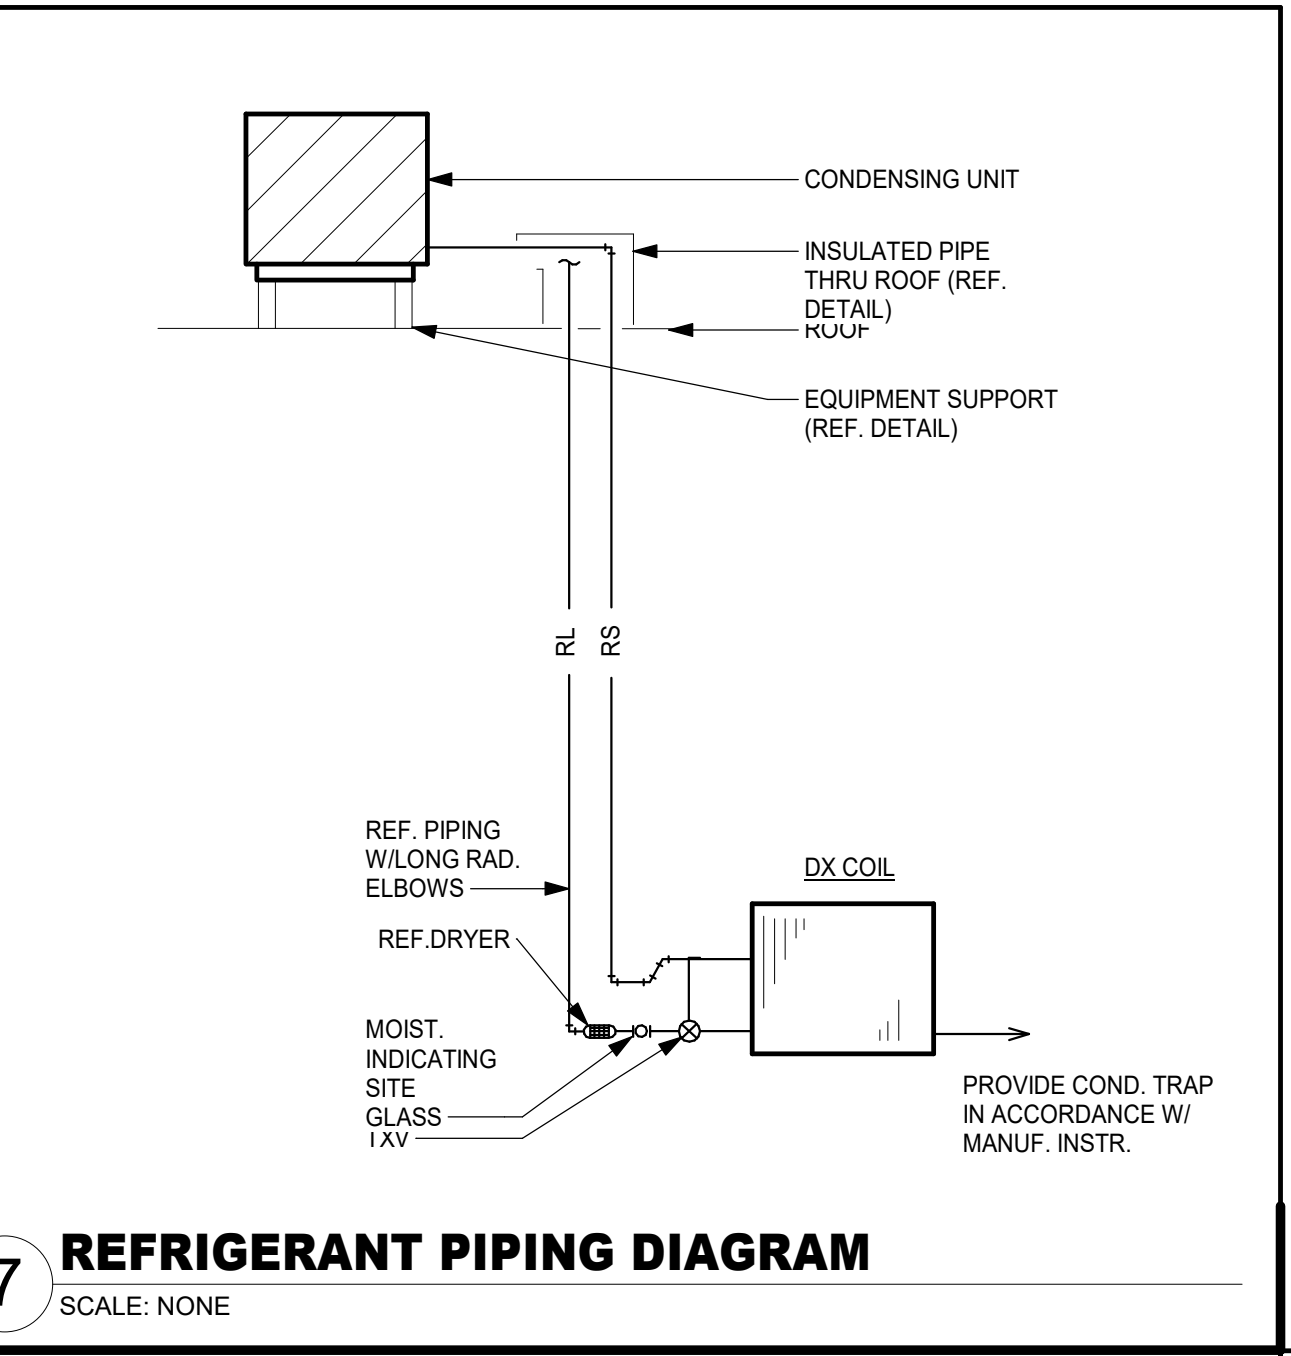


**7 REFRIGERANT PIPING DIAGRAM**  
 SCALE: NONE

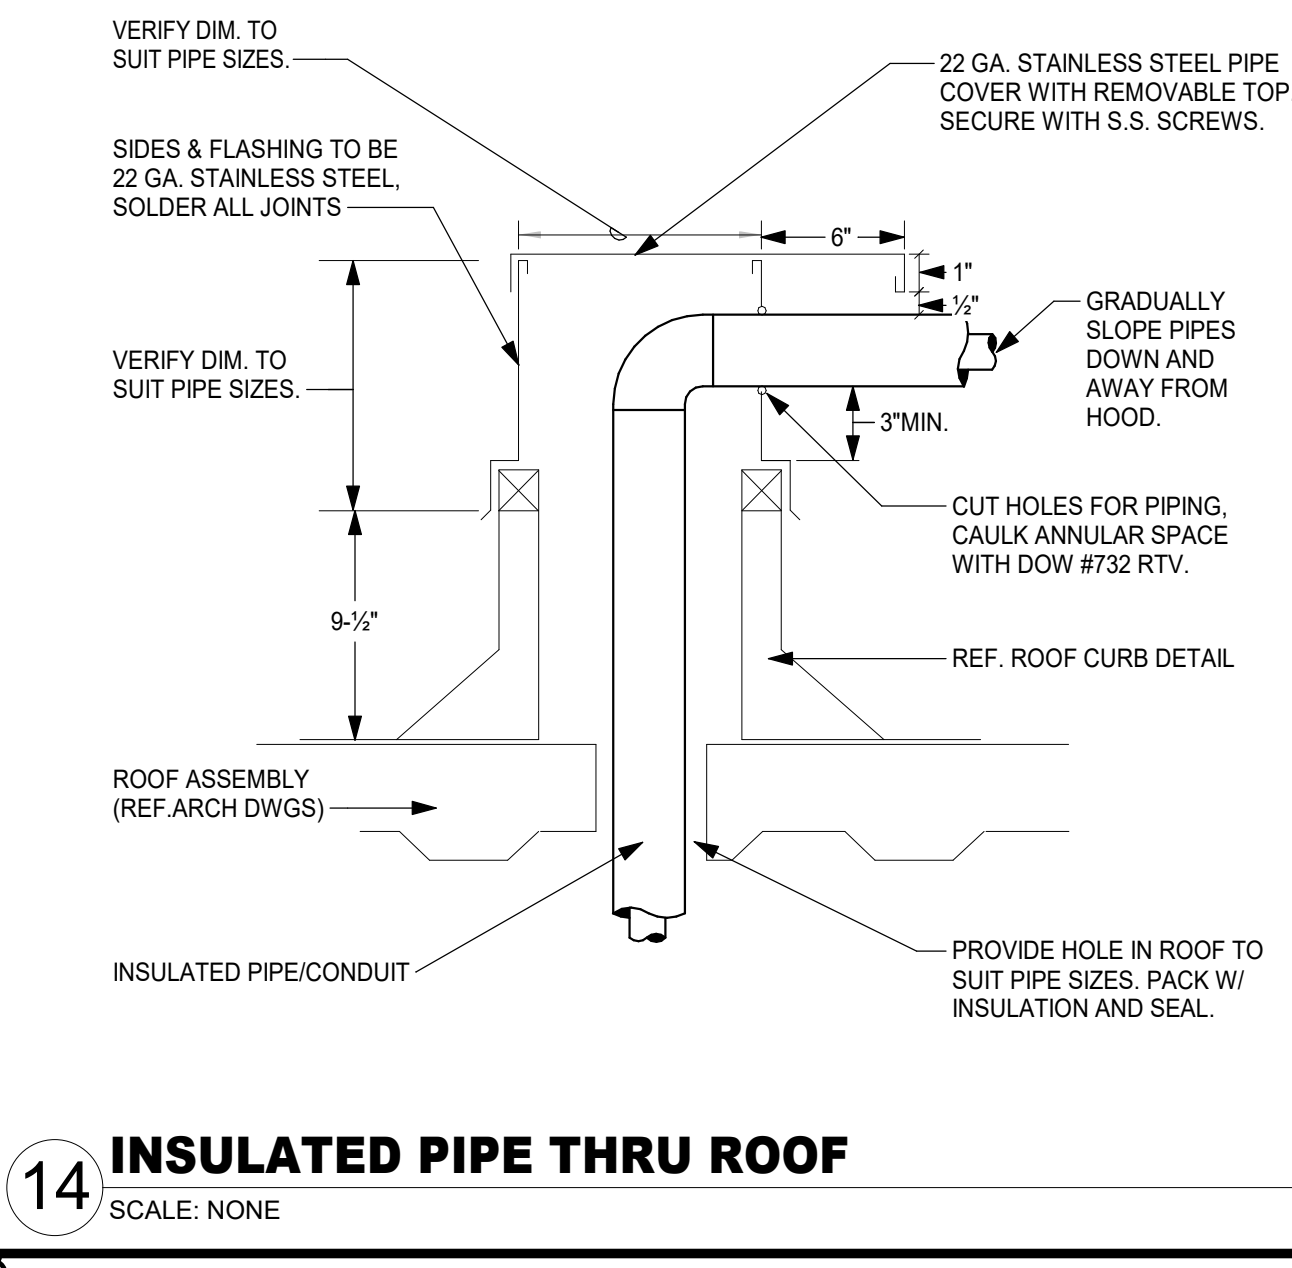


**14 INSULATED PIPE THRU ROOF**  
 SCALE: NONE

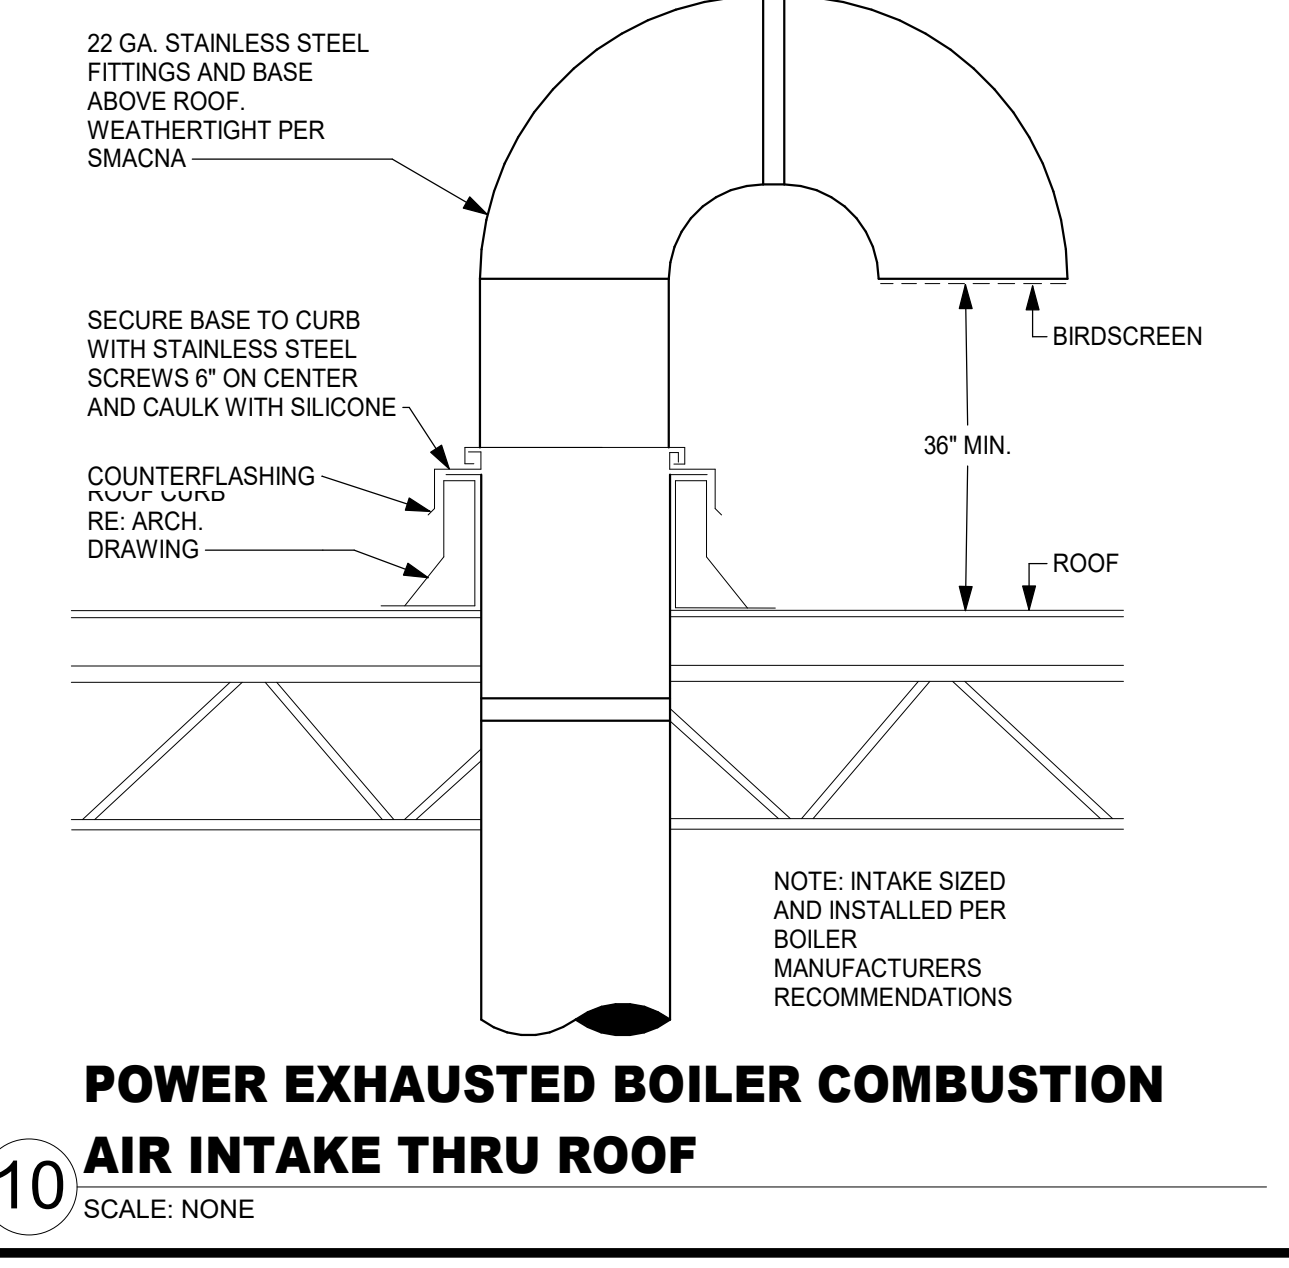


**10 AIR INTAKE THRU ROOF**  
 SCALE: NONE

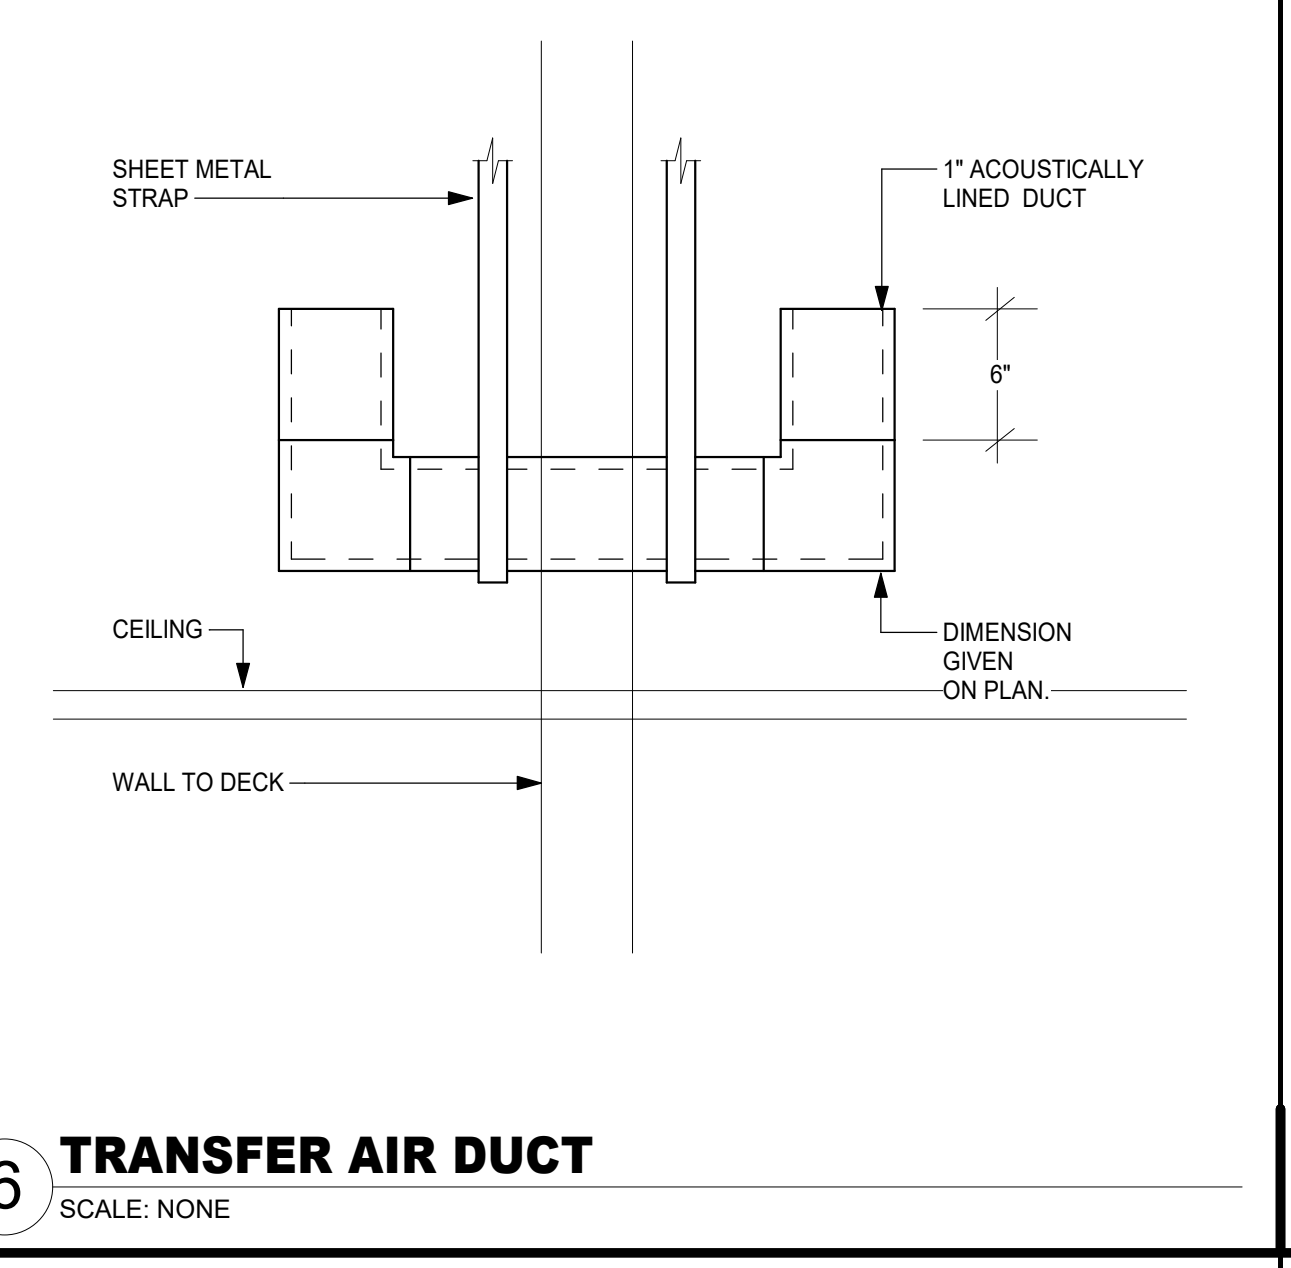


**6 TRANSFER AIR DUCT**  
 SCALE: NONE

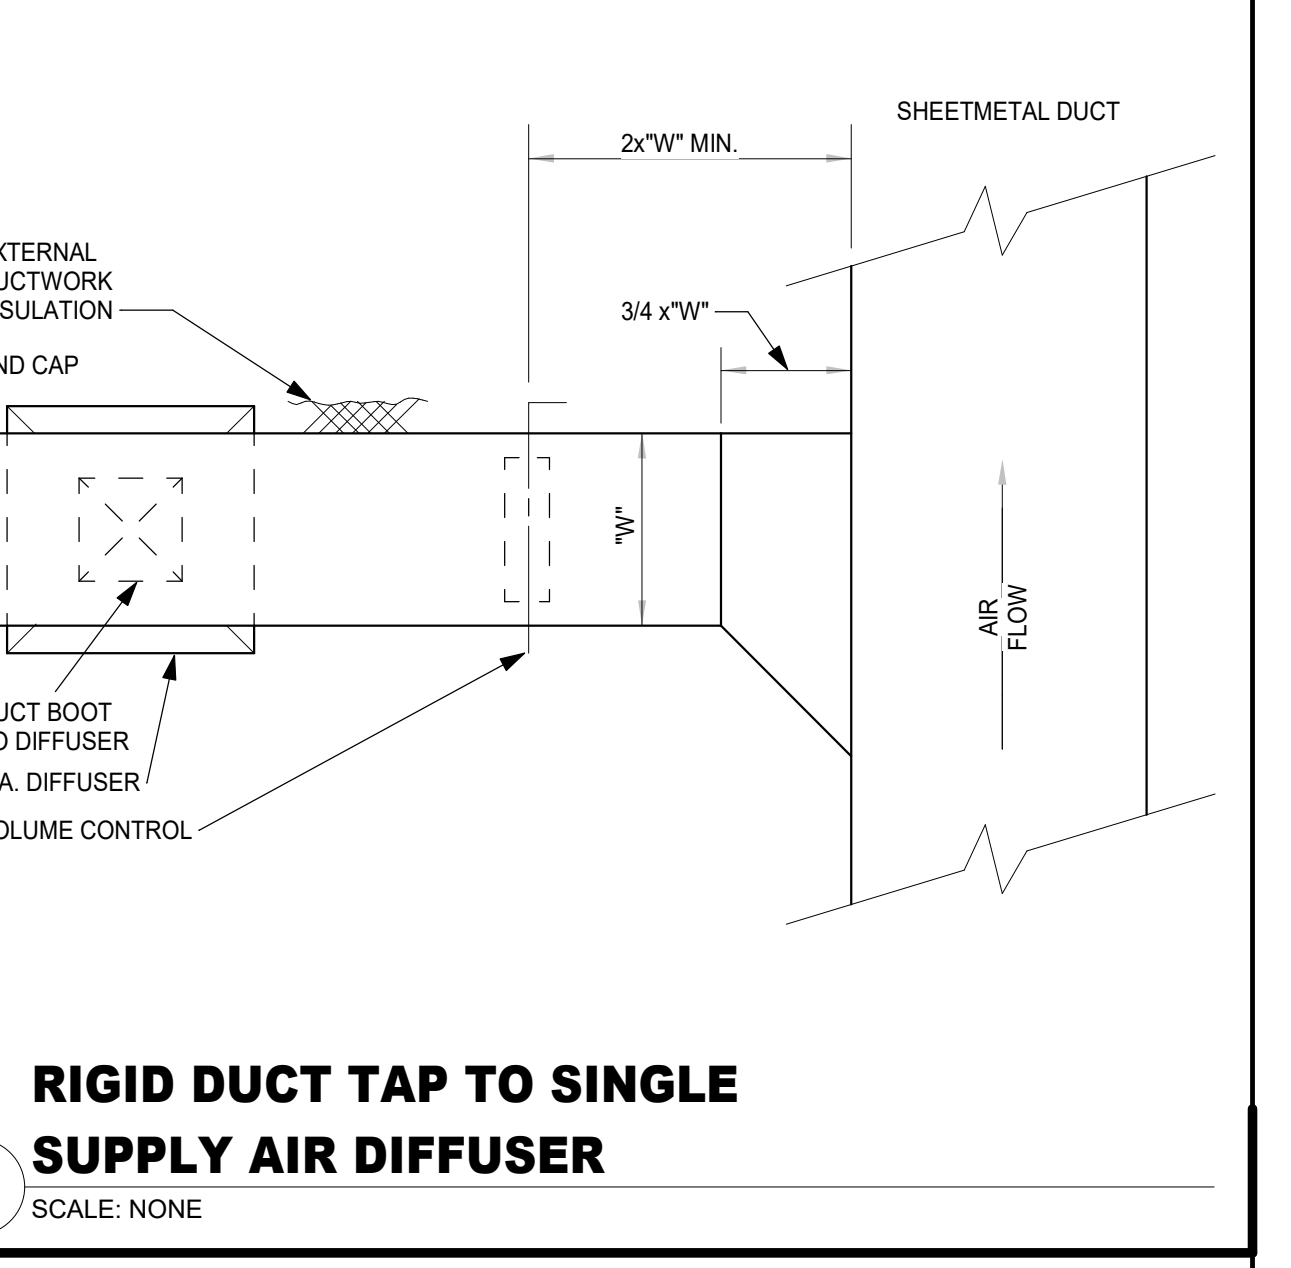


**3 RIGID DUCT TAP TO SINGLE SUPPLY AIR DIFFUSER**  
 SCALE: NONE

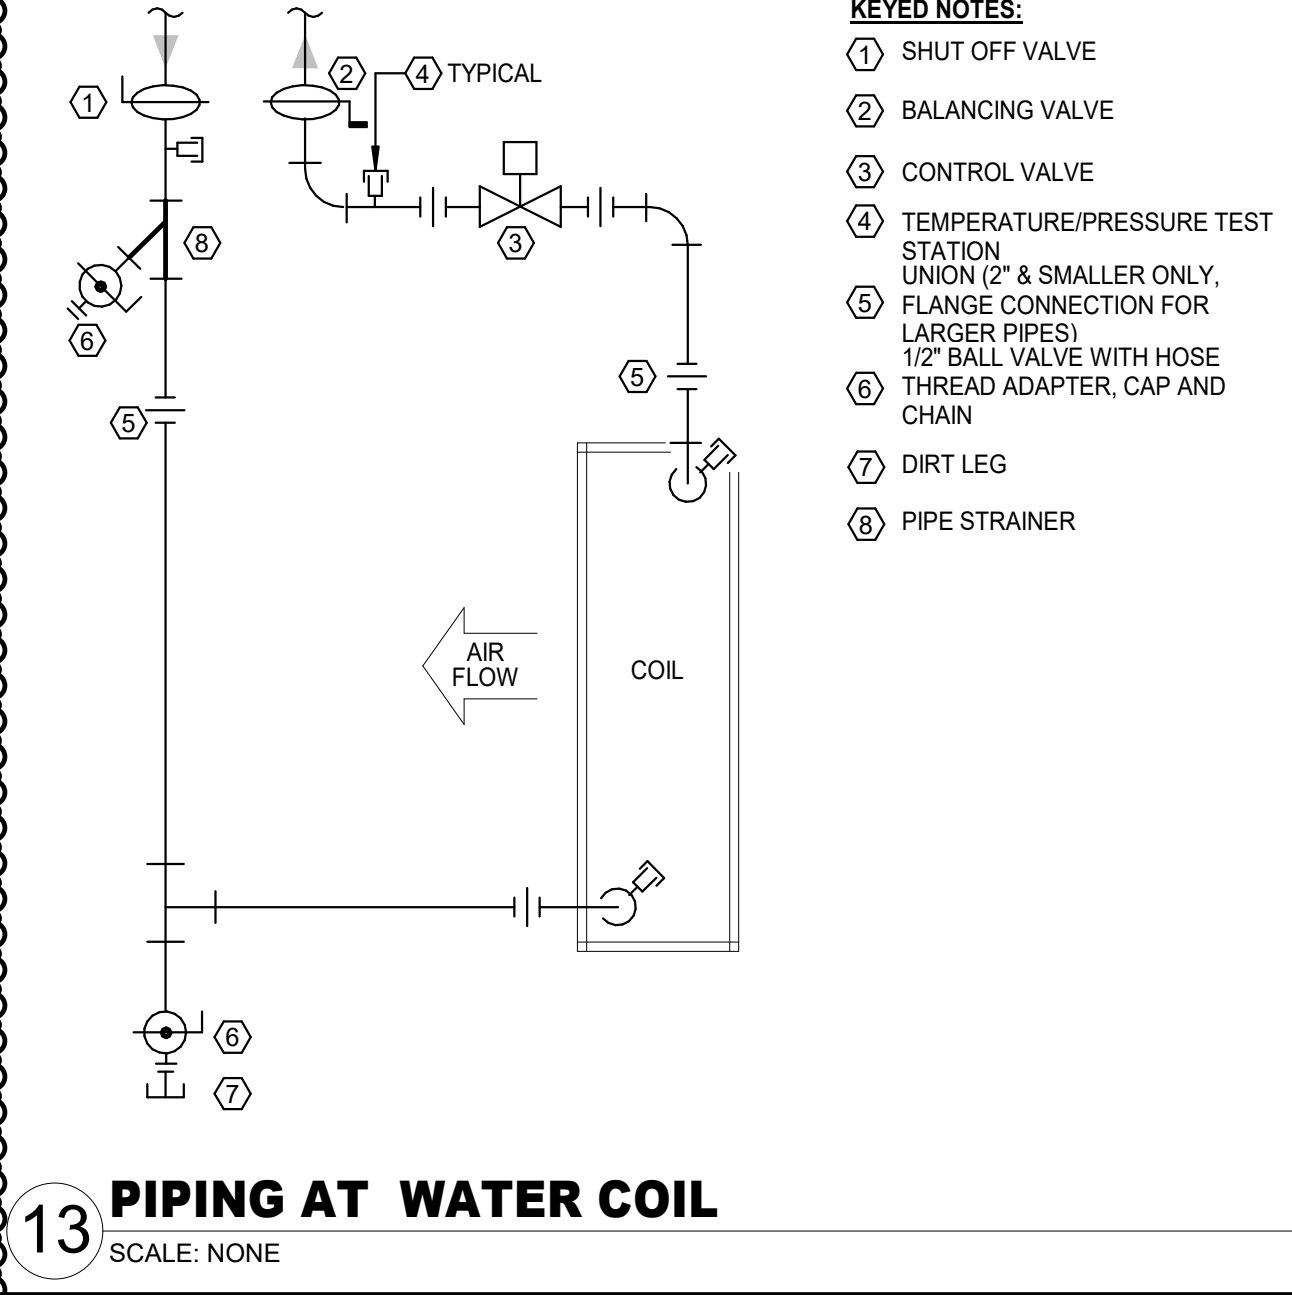


**13 PIPING AT WATER COIL**  
 SCALE: NONE

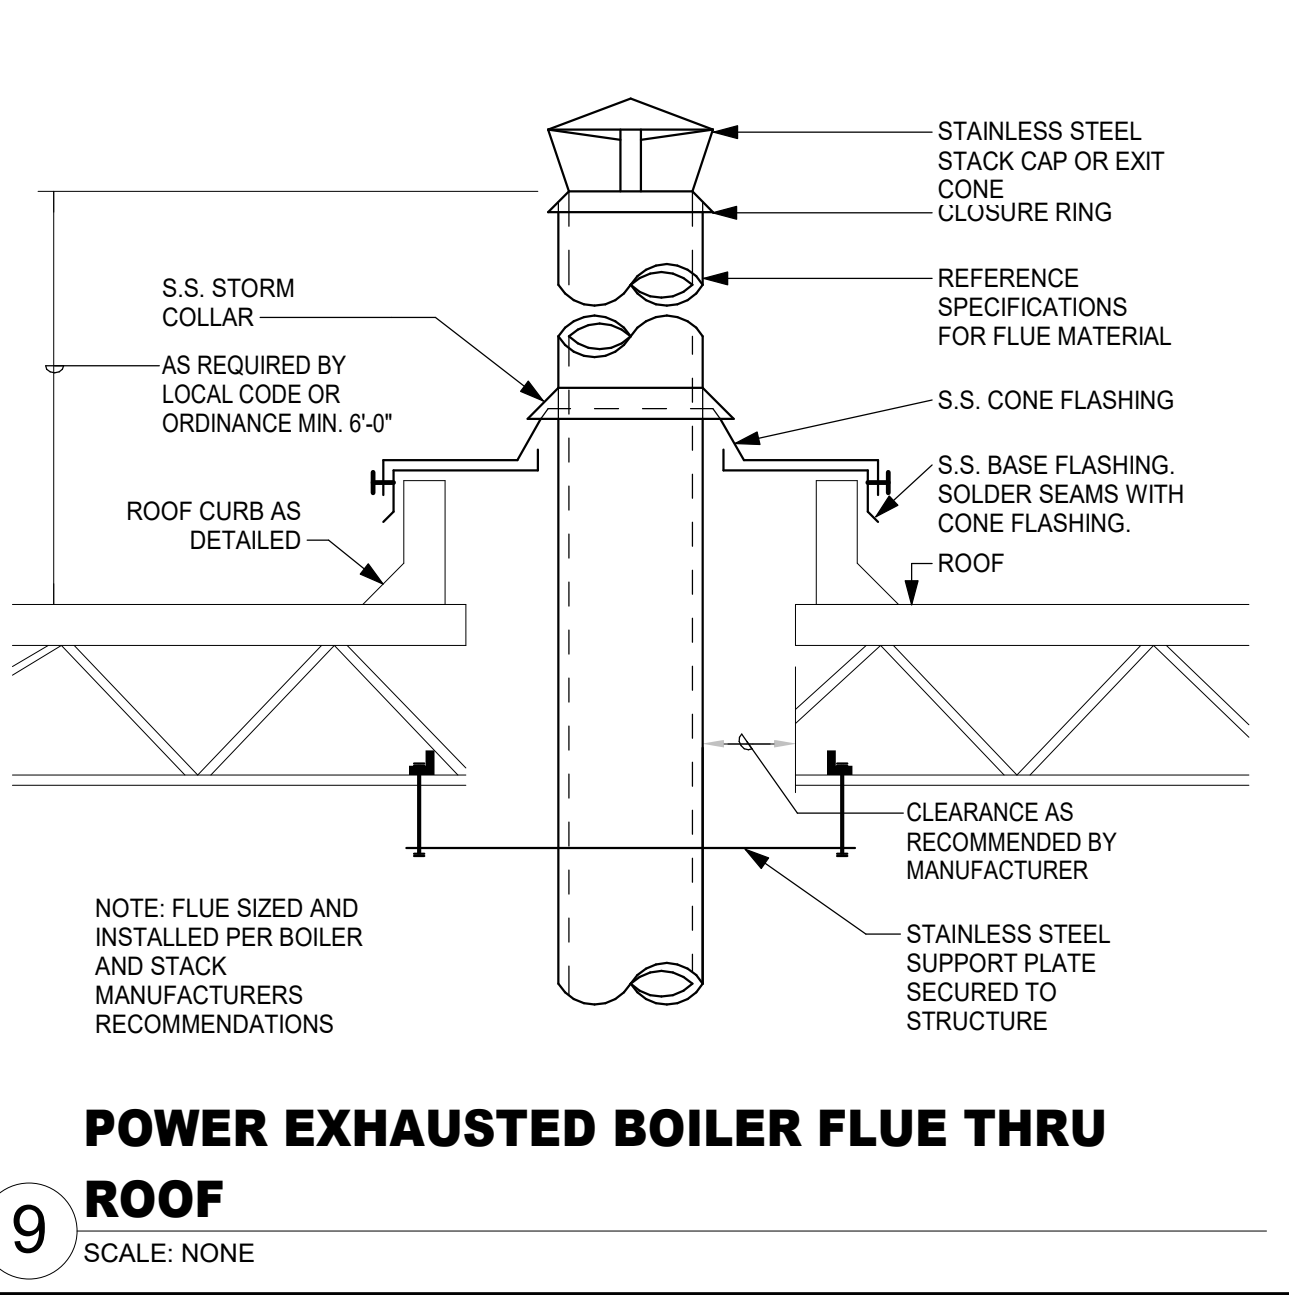


**9 POWER EXHAUSTED BOILER FLUE THRU ROOF**  
 SCALE: NONE

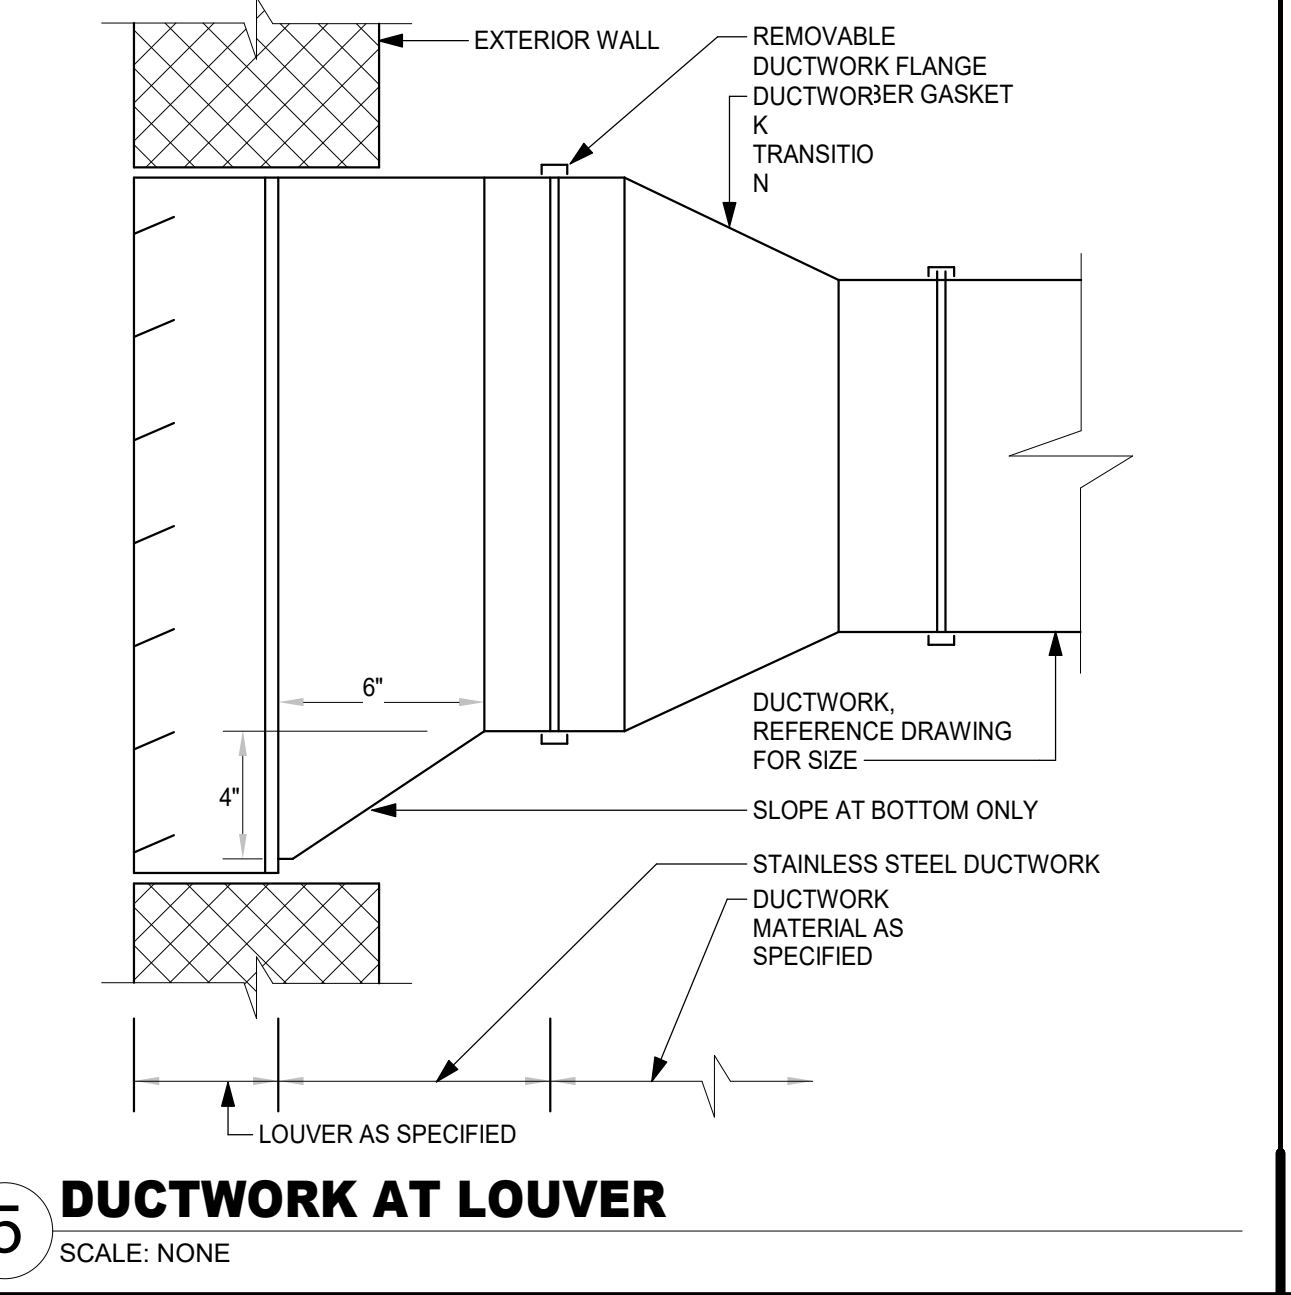


**5 DUCTWORK AT LOUVER**  
 SCALE: NONE

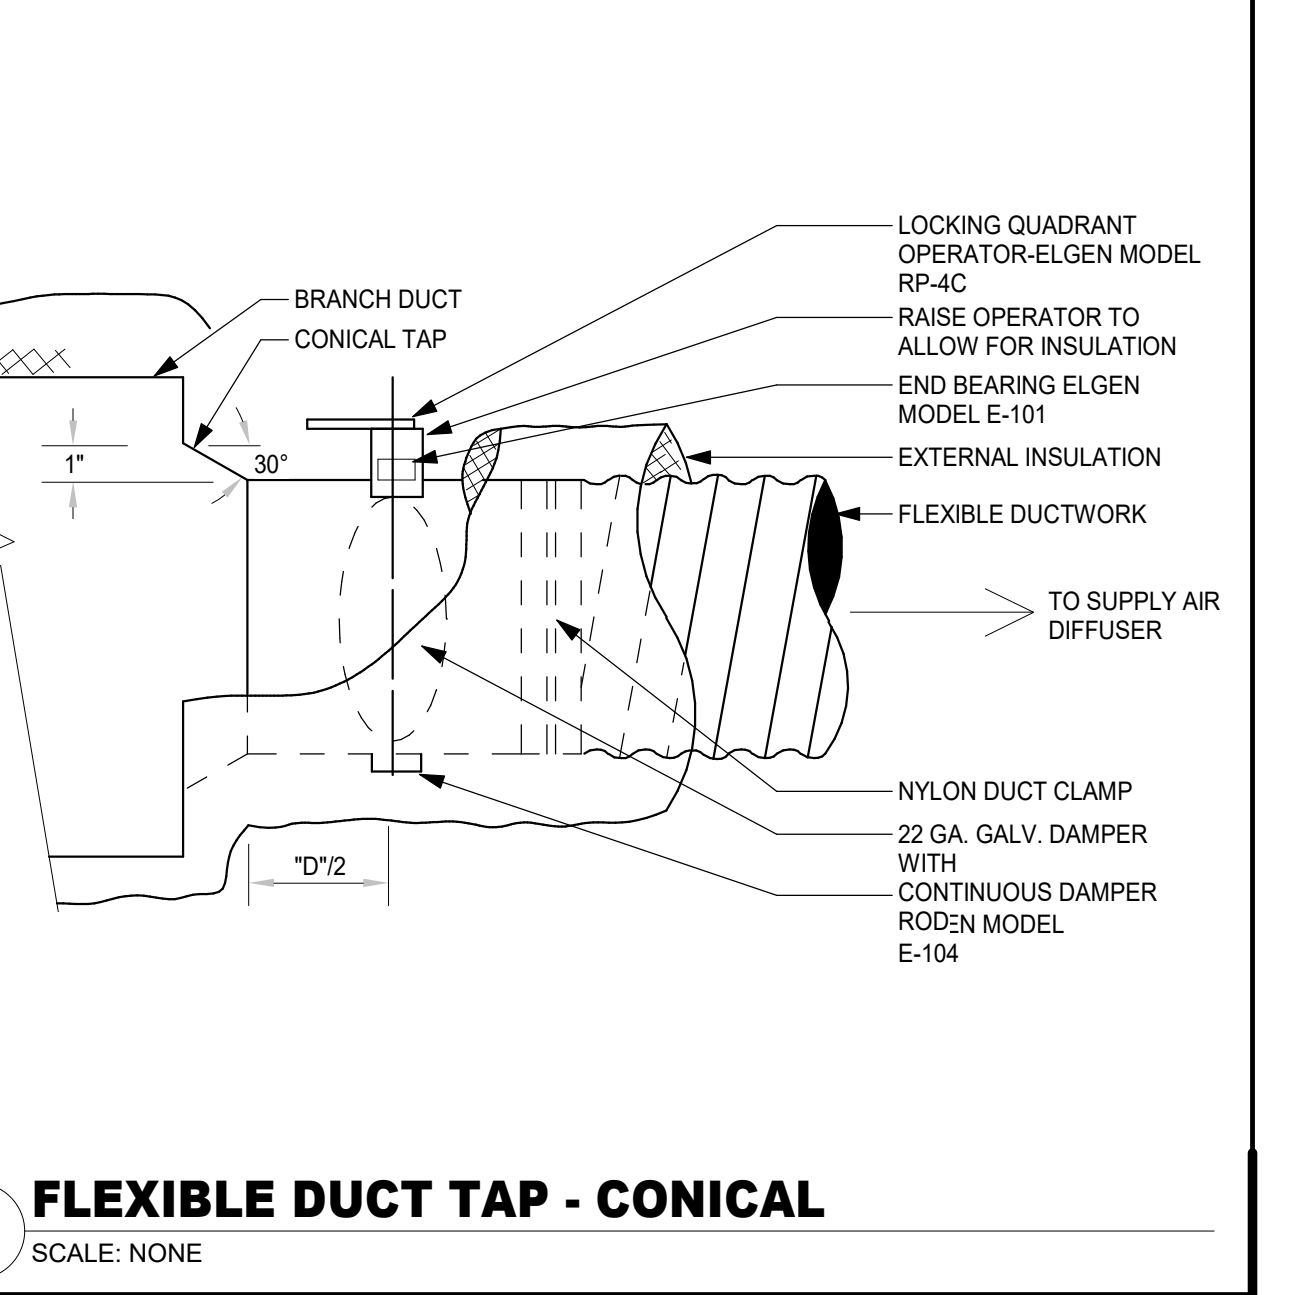


**2 FLEXIBLE DUCT TAP - CONICAL**  
 SCALE: NONE

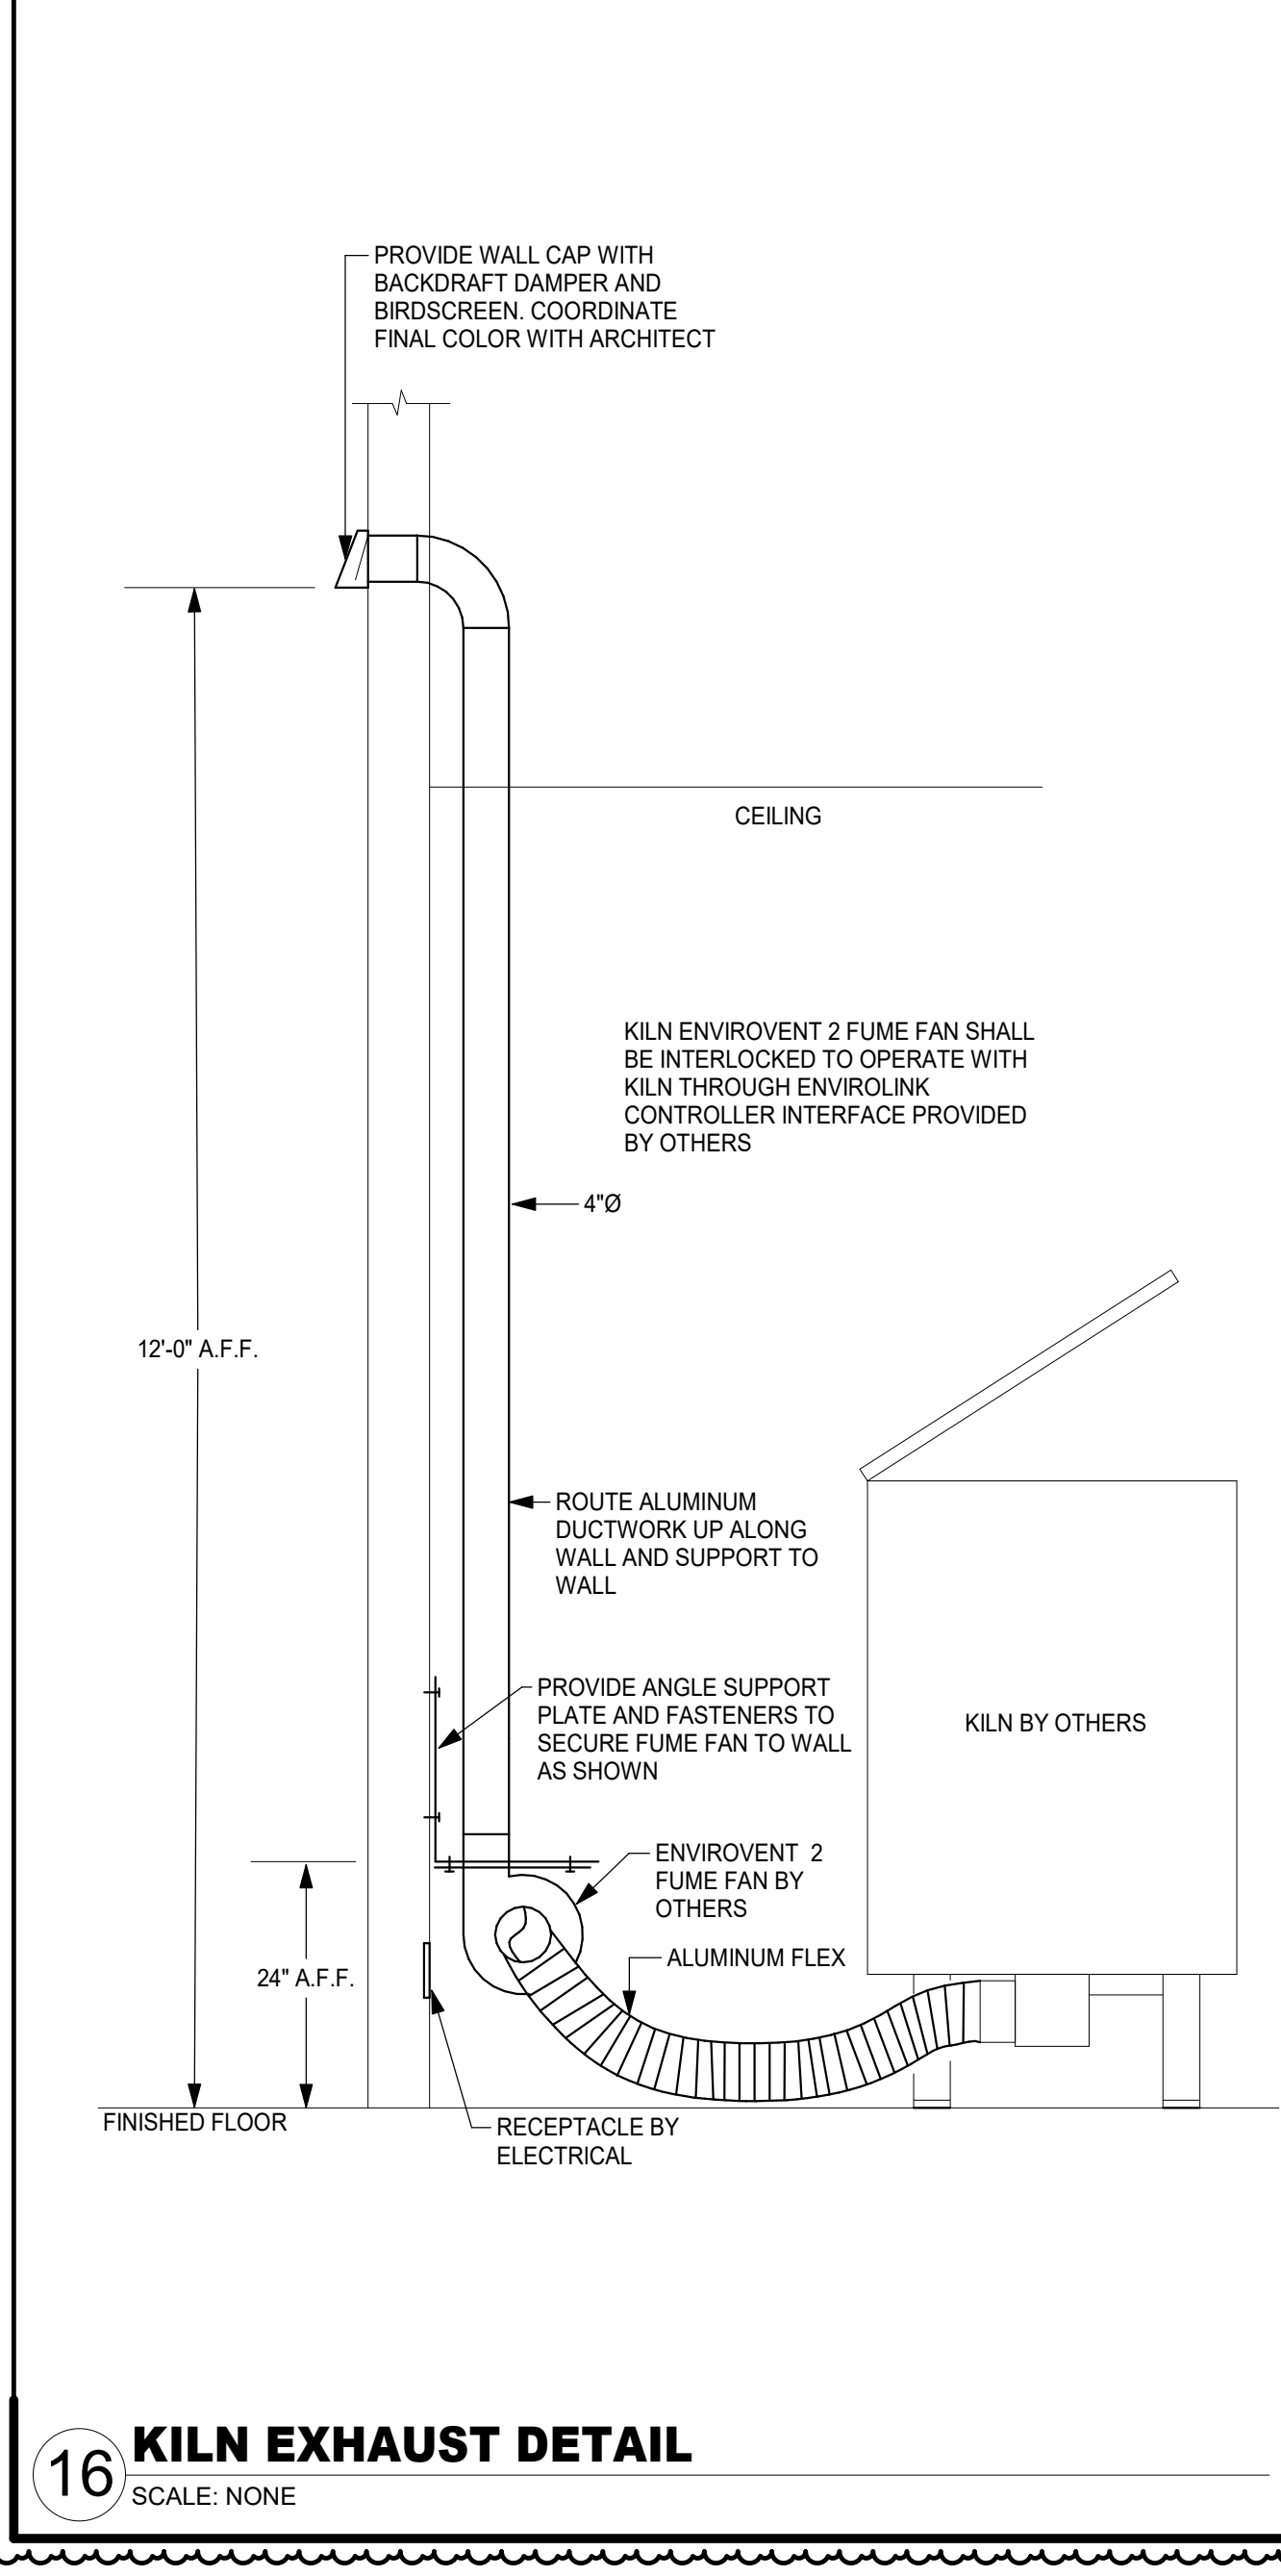


**16 KILN EXHAUST DETAIL**  
 SCALE: NONE

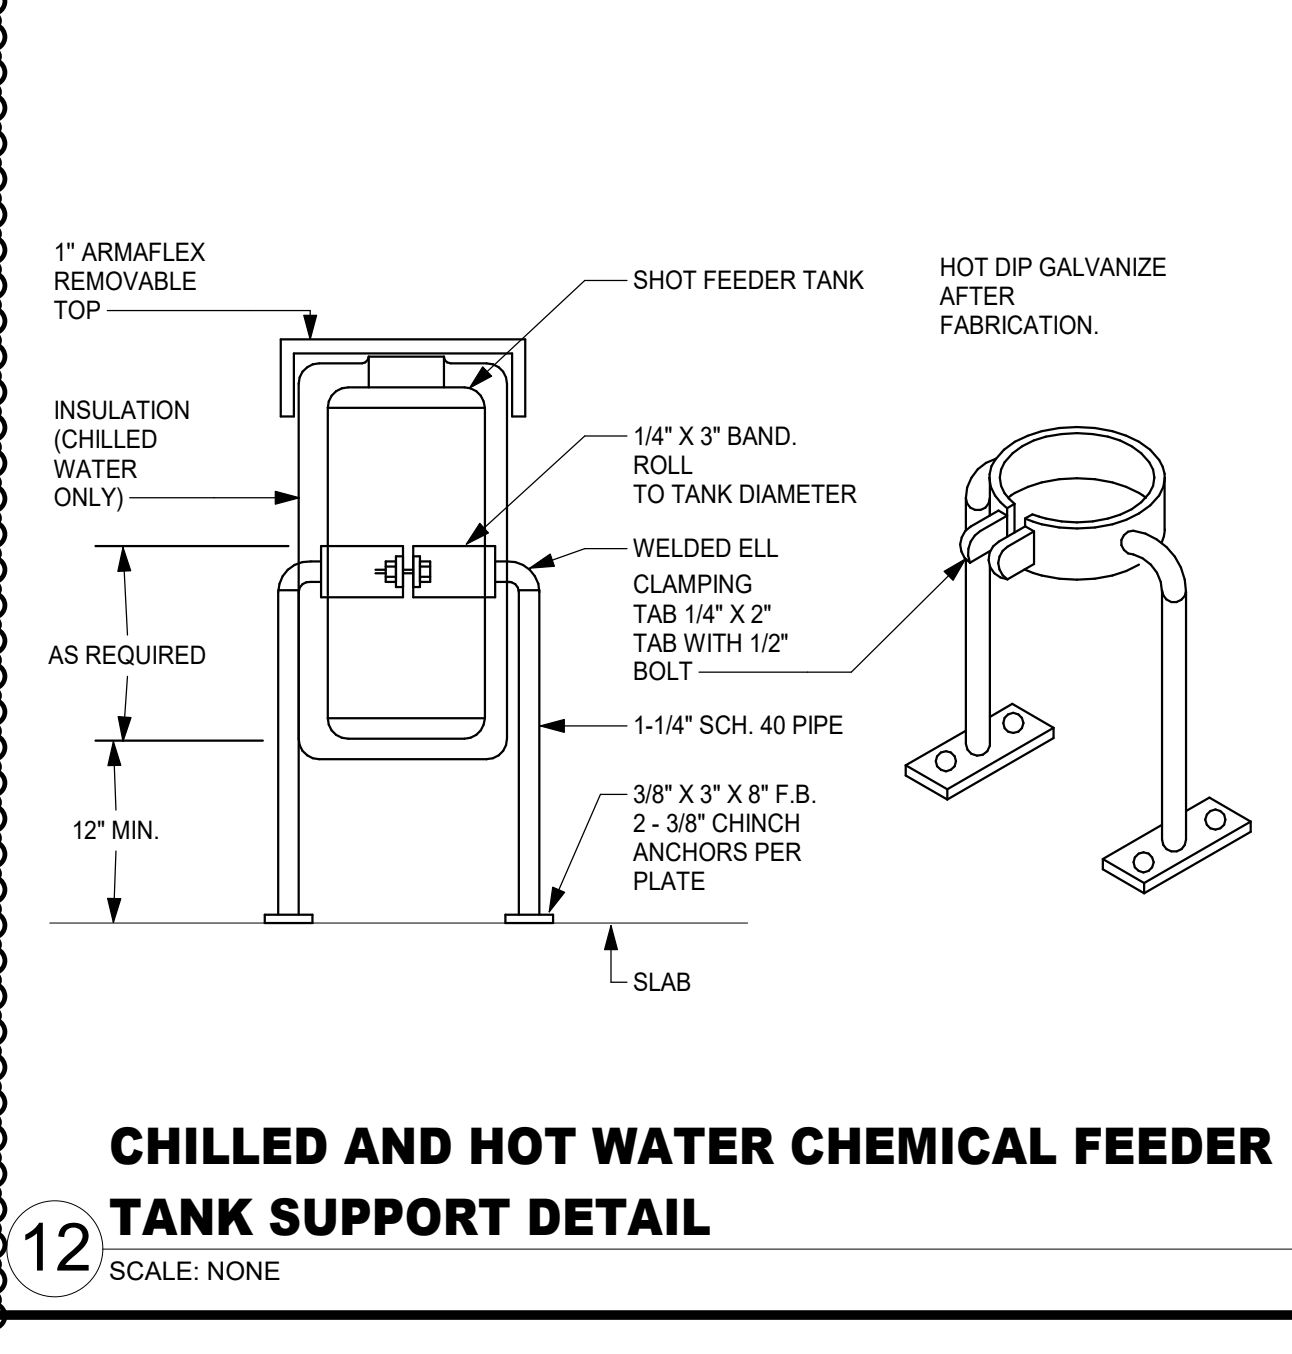


**12 CHILLED AND HOT WATER CHEMICAL FEEDER TANK SUPPORT DETAIL**  
 SCALE: NONE

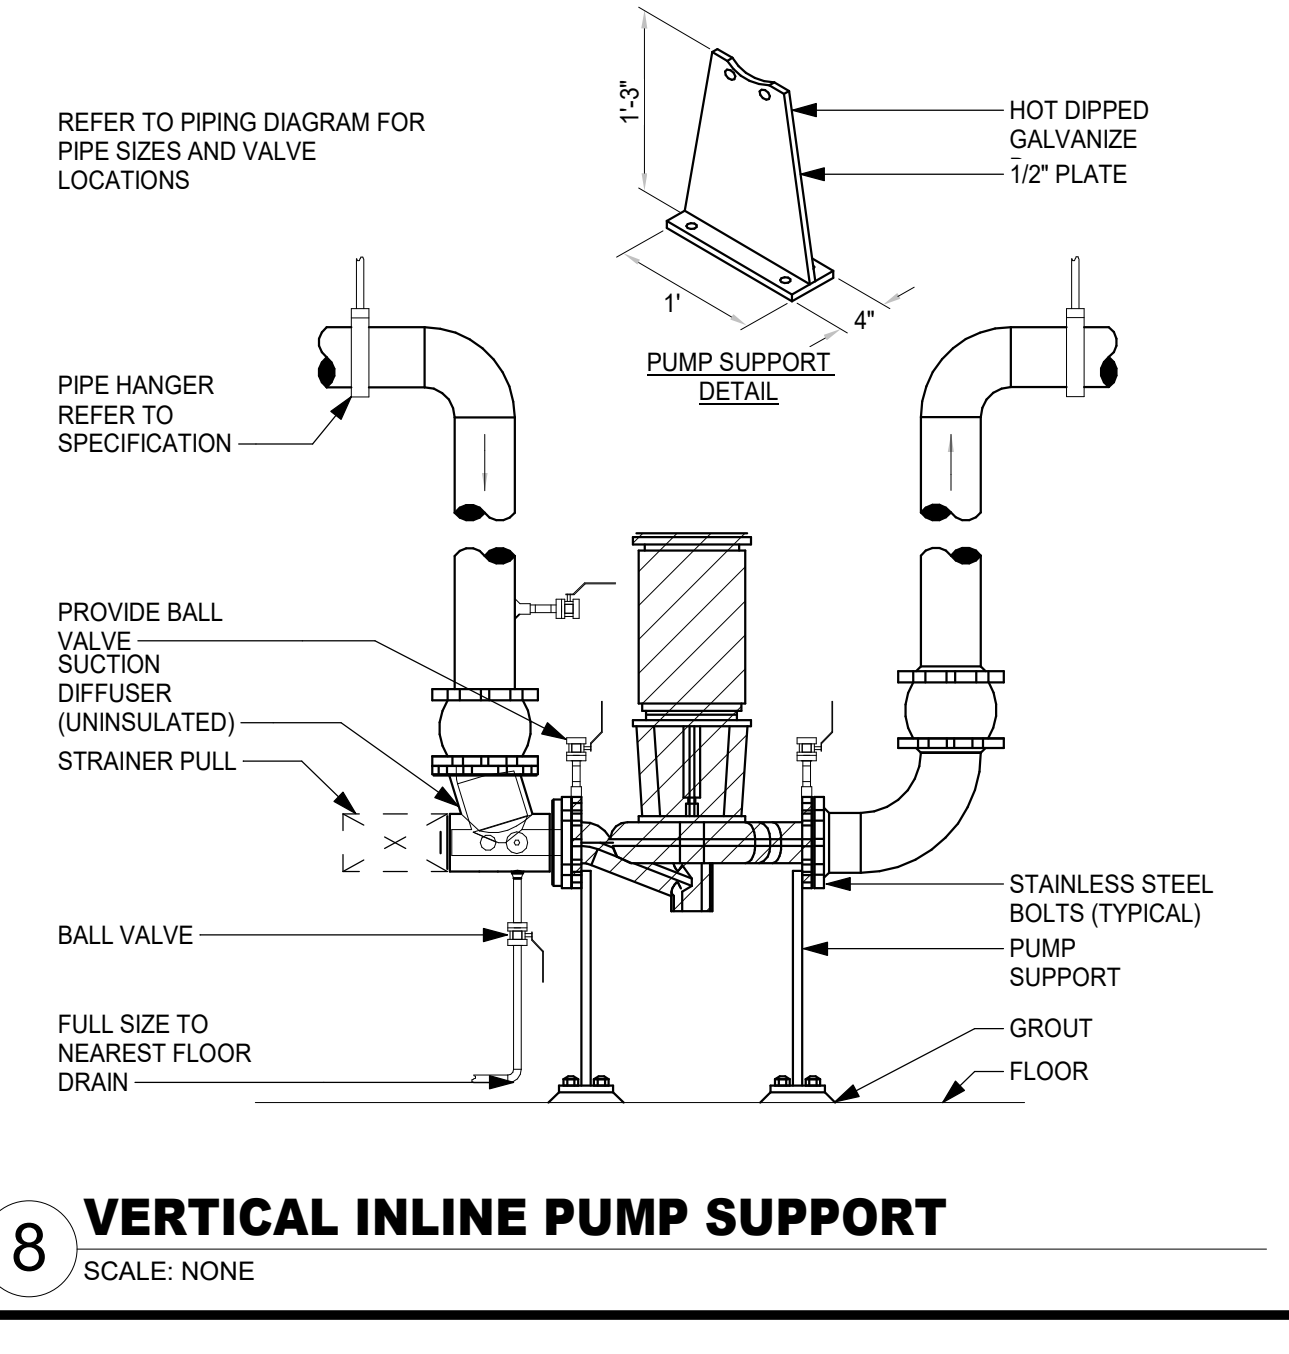

**8 VERTICAL INLINE PUMP SUPPORT**  
 SCALE: NONE

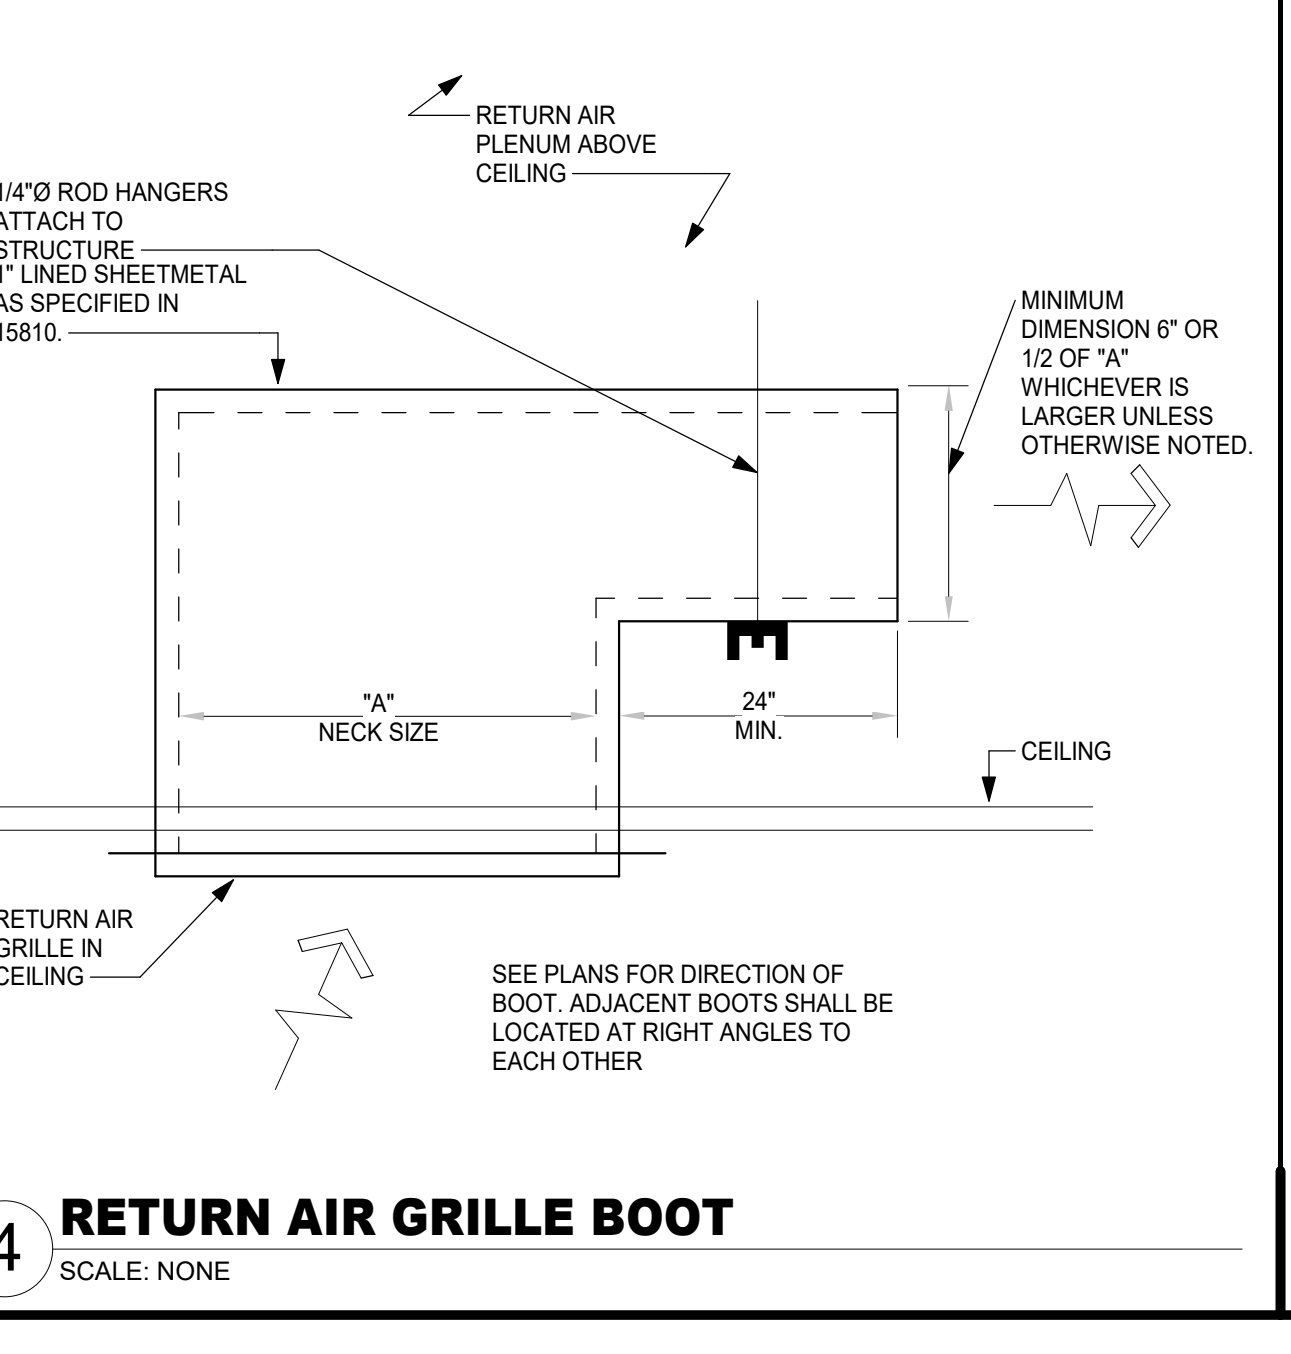

**4 RETURN AIR GRILLE BOOT**  
 SCALE: NONE

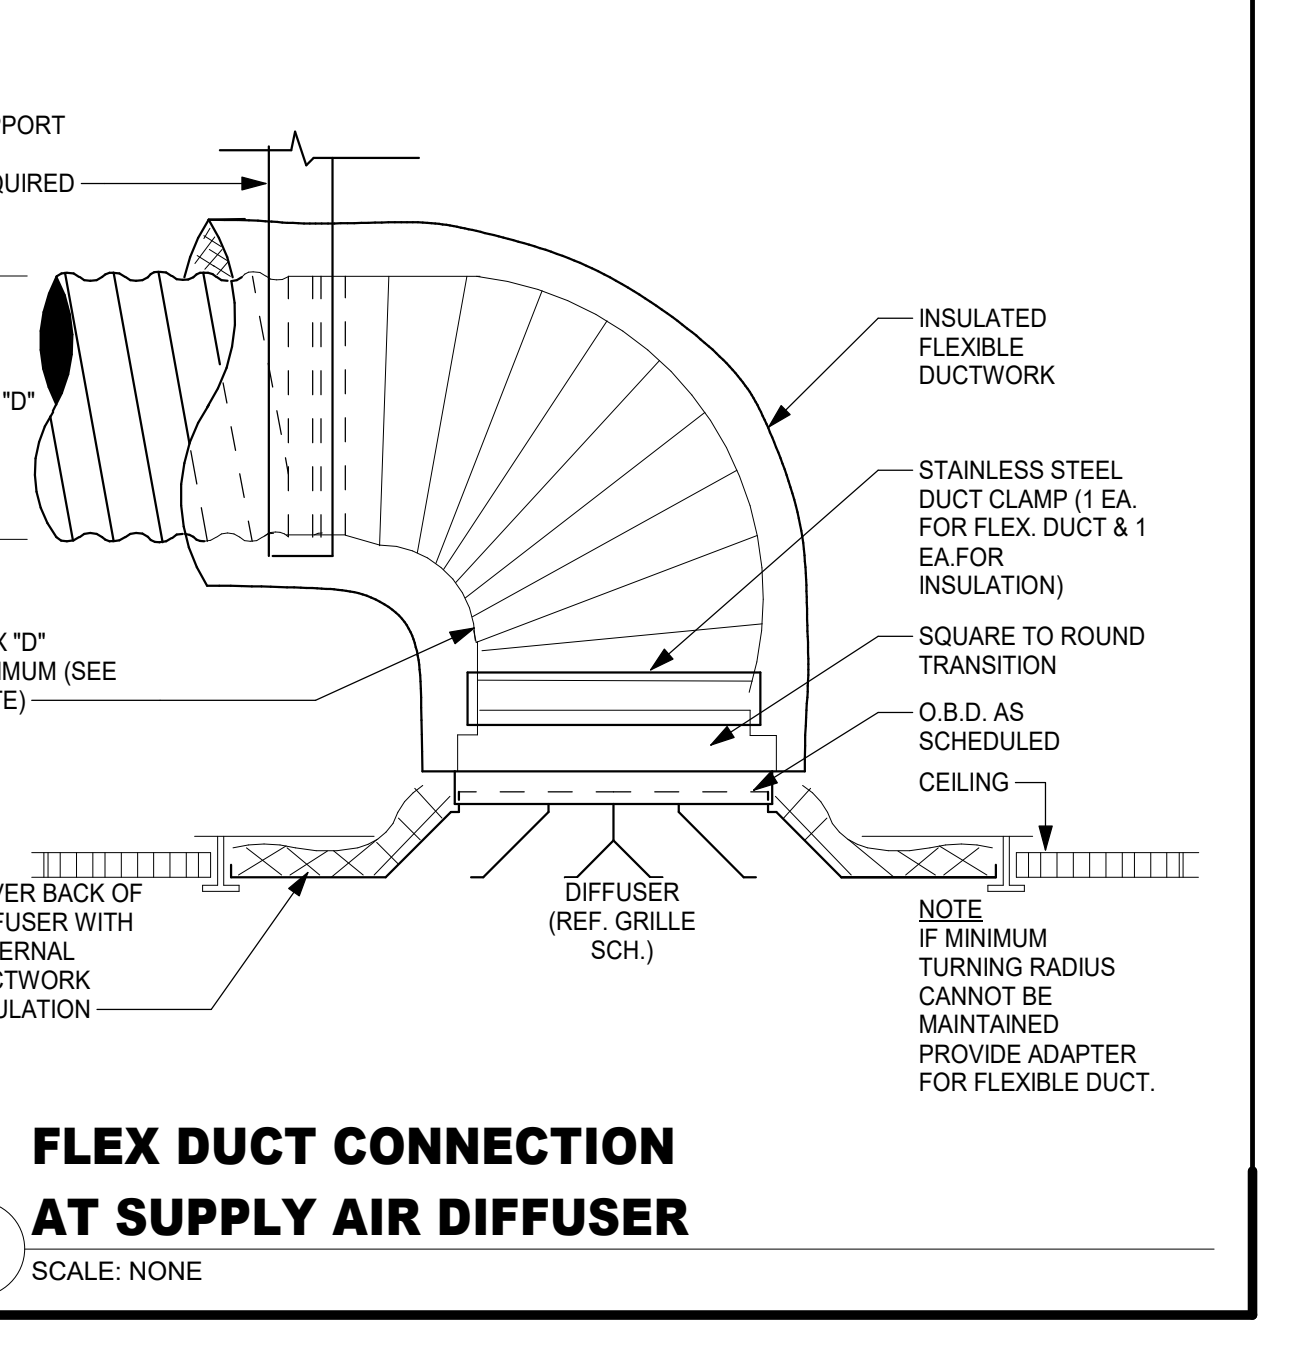

**1 FLEX DUCT CONNECTION AT SUPPLY AIR DIFFUSER**  
 SCALE: NONE



FAN SCHEDULE															
TAG	LOCATION	CFM	EXT. STATIC PRESSURE (IN. W.C.)	MAX RPM	HORSE POWER	CURRENT CHAR.			LOCALLY SWITCHED	INTERLOCK WITH	FAN TYPE	DRIVE TYPE	MANUFACTURER	MODEL NUMBER	REMARKS
						V	P	F							
EF-SB-1	STORAGE BLDG	1300	0.50	1800	0.5	120	1	60	H-STAT	-	INLINE	DIRECT	COOK	SOND	(1,2,3,4,5,6)
SF-4D	MECH MEZZ D201	900	0.50	1800	0.33	120	1	60	-	AHU-3D	INLINE	DIRECT	COOK	SOND	(1,2,3,4)

**GENERAL NOTES:**  
1. EXTERNAL STATIC PRESSURE INCLUDES LOSSES DUE TO DUCTWORK, AIR DEVICES, DAMPERS, AND DUCT MOUNTED HOT WATER COILS WHERE APPLICABLE. DIRTY FILTER AND UNIT CASING MUST BE ADDED TO EXTERNAL STATIC PRESSURE TO OBTAIN TOTAL PRESSURE LOSS. INCREASE HORSEPOWER AS REQUIRED TO MEET YOUR TOTAL PRESSURE LOSS. COORDINATE WITH ELECTRICIAN.  
2. MINIMUM RECOMMENDED CLEARANCE AROUND UNIT IS 12 INCHES ON NON-SERVICE SIDES AND 30 INCHES ON SERVICE SIDES. MAINTAIN MINIMUM CLEARANCE AS REQUIRED TO OPEN ACCESS AND CONTROL DOORS ON UNIT FOR SERVICE, MAINTENANCE, AND INSPECTION. MAINTAIN MINIMUM ELECTRICAL CLEARANCE AS REQUIRED BY NEC.

**REMARKS:**  
1. PROVIDE WITH DISCONNECT.  
2. PROVIDE WITH MOTORIZED DAMPER (BMCS).  
3. PROVIDE WITH FAN SPEED CONTROLLER.  
4. SUSPEND UNIT WITH FOUR THREADED HANGER RODS ATTACHED TO TWO UNISTRUT RUNNERS SECURED TO STRUCTURE. PROVIDE SPRING ISOLATION. REFER TO MANUFACTURER FOR MORE DETAILS.

**5. PROVIDE WITH LINE VOLTAGE MOTORIZED DAMPER FOR EXHAUST AND MAKEUP AIR LOUVER.**

**Salas O'Brien**  
salesobrien.com 281-664-1900  
Houston, TX 77068  
18930 W. Sam Houston Pkwy North, Suite 900  
Houston, TX 77064  
Registration: F-4111  
Project No: 2024-00209-00

**NATEX CORPORATION ARCHITECTS**  
www.natexarchitects.com  
447 Heights Boulevard  
Houston, TX 77007  
Phone: 713-975-8525  
Fax: 713-970-7824

**Coleman Partners ARCHITECTS**  
cpcpartners.com  
3701 Kirby Drive, Suite 830  
Houston, TX 77098  
tel: 832.947.1038 fax: 282.214.5365

**CONSTRUCTION DOCUMENT**  
02-14-2025

**CIVIL ENGINEER BROOKS AND SPARKS, INC.**  
21020 PARK ROW  
KATY, TX 77449  
tel: 281.578.9595

**STRUCTURAL ENGINEER DALLY + ASSOCIATES, INC.**  
9800 RICHMOND AVE.  
SUITE 400  
HOUSTON, TX 77042  
tel: 713.337.8881

**MEPT ENGINEER SALAS O'BRIEN**  
10930 W. SAM HOUSTON PKWY. N.  
SUITE 900  
HOUSTON, TX 77064  
tel: 281.664.1900

**FOOD SERVICE EQUIPMENT FDP**  
25317 INTERSTATE 45  
THE WOODLANDS, TX 77380  
tel: 281.350.2323

**LANDSCAPE ARCHITECT LANDESGRUP**  
17041 EL CAMINO REAL  
SUITE 204  
HOUSTON, TX 77058  
tel: 281.486.4040

2024 SMITH & SPILLANE MS RENOVATIONS  
**SPILLANE MIDDLE SCHOOL**  
13403 WOODS-SPILLANE BLVD, CYPRESS, TX 77429  
CFISD PROJECT NO: 24-02-5751-R-RFP

2	Addendum 03	02-14-25	Revisions / Submission
---	-------------	----------	------------------------

Project Number:	23073
Date:	26 JANUARY 2025
Drawn By:	WHL / KLO

MECHANICAL SCHEDULES

**M4.01**

MARK	FAN				COOLING										HEATING				PIPE SIZE TO COIL (IN.)		REMARKS	
	SUPPLY AIR CFM	OUTSIDE AIR CFM	EXT. STATIC PRESSURE (IN. W.C.)	HORSE POWER	AIR TEMPERATURE (F)			ENTERING WATER		LEAVING WATER		ENTERING AIR		LEAVING AIR		CHILLED WATER	HOT WATER					
					ENTERING DRY BULB	ENTERING WET BULB	LEAVING DRY BULB	LEAVING WET BULB	ENTERING TEMP (F)	GPM	PRESSURE DROP (FT.)	TEMPERATURE (F)	MIN HEATING CAPACITY	ENTERING TEMP (F)	GPM	PRESSURE DROP (FT.)	1 1/4"	1 1/4"				
AHU-3D	2,550	900	0.95	3.0	480	3	60	82.9	68.8	54.5	54.0	42	14.8	15.0	64.0	85.374	180.0	8.6	10.0	1 1/4"	1 1/4"	1,3,4,5,6,7,9,10,11
AHU-3DA	900	900						98.0	79.0	54.5	54.0	42	14.8	15.0	27.0	26.244	150.0	2.7	10.0	1 1/4"	1 1/4"	2,3,6,7,8,10,12

**GENERAL NOTES:**  
1. EXTERNAL STATIC PRESSURE INCLUDES LOSSES DUE TO DUCTWORK, AIR DEVICES, DAMPERS, AND DUCT MOUNTED HOT WATER COILS WHERE APPLICABLE. DIRTY FILTER AND UNIT CASING MUST BE ADDED TO EXTERNAL STATIC PRESSURE TO OBTAIN TOTAL PRESSURE LOSS. INCREASE HORSEPOWER AS REQUIRED TO MEET YOUR TOTAL PRESSURE LOSS. COORDINATE WITH ELECTRICIAN.  
2. MAINTAIN MINIMUM CLEARANCE FOR COIL PULL AS RECOMMENDED BY UNIT MANUFACTURER. MAINTAIN MINIMUM CLEARANCE AS REQUIRED TO OPEN ACCESS AND CONTROL DOORS ON UNIT FOR SERVICE, MAINTENANCE, AND INSPECTION. MAINTAIN MINIMUM ELECTRICAL CLEARANCE AS REQUIRED BY NEC.

**REMARKS:**  
1. VELOCITY NOT TO EXCEED 500 FPM ON COOLING COIL.  
2. VELOCITY NOT TO EXCEED 450 FPM ON COOLING COIL.  
3. PROVIDE HORIZONTAL UNIT.  
4. PROVIDE SINGLE ZONE VARIABLE VOLUME UNIT WITH VARIABLE FREQUENCY DRIVE.  
5. PROVIDE TOP DISCHARGE.  
6. PROVIDE TWO-WAY COOLING CONTROL VALVES.  
7. PROVIDE TWO-WAY HEATING CONTROL VALVES.

**8. PROVIDE HOT WATER COIL IN PRE-HEAT POSITION.**  
9. PROVIDE HOT WATER COIL IN RE-HEAT POSITION.  
10. PROVIDE UNIT WITH ANGLED FILTER SECTION.  
11. SPLIT DEHUMIDIFICATION UNIT TO BE MOUNTED ON TOP OF AHU.  
12. INDICATED SHALL BE STACKED OAU FURNISHED WITH ASSOCIATED AHU (LISTED ABOVE). UNIT INCLUDES ANGLED FILTER MIXING BOX, PREHEAT COIL, ACCESS SPACE, COOLING COIL AND DISCHARGE PLENUM. UNIT DOES NOT HAVE FAN SECTION.

MARK	FAN				AIR TEMPERATURE (F)				COOLING			REMARKS
	SUPPLY AIR CFM	POWER WATTS	CURRENT CHARAC.		ENTERING DRY BULB	ENTERING WET BULB	MIN TOTAL CAPACITY (BTUH)	MIN SENS CAPACITY (BTUH)	MINIMUM EER/SEER			
			V	P						F		
DMS-1	375	35.0	208	60	75.0	62.5	18,000	14,400	15	(1,2,3,4,5)		
DMS-2	750	45.0	208	60	75.0	62.5	34,200	27,360	15	(1,2,3,4,5)		
DMS-3	375	35.0	208	60	75.0	62.5	18,000	14,400	15	(1,2,3,4,5)		

**GENERAL NOTES:**  
1. PROVIDE 8 OUNCE GAS PRESSURE TO BOILER.  
2. MAINTAIN MINIMUM CLEARANCE AROUND A BOILER OF 24 INCHES PER TEXAS BOILER LAW. MAINTAIN MINIMUM CLEARANCE AS REQUIRED TO OPEN ACCESS AND CONTROL DOORS FOR SERVICE, MAINTENANCE AND INSPECTION. MAINTAIN MINIMUM ELECTRICAL CLEARANCE AS REQUIRED BY NEC.

**REMARKS:**  
1. UNIT TO BE INSTALLED PER MANUFACTURER'S INSTALLATION INSTRUCTIONS.  
2. CONTROLLED BY PROGRAMMABLE WIRED THERMOSTAT.  
3. REFRIGERANT LINES TO BE SIZED PER MANUFACTURER'S REQUIREMENTS.  
4. PROVIDE WITH LITTLE GIANT CONDENSATE PUMP MODEL VCMA-20L5-C-PRO, 1/30 HP, 115V/1PH/60HZ, MOUNT PUMP UNDER HIGH WALL UNIT.  
5. INDOOR UNIT IS POWERED FROM OUTDOOR UNIT.

MARK	FAN				AIR TEMPERATURE (F)				COOLING			REMARKS
	MIN. TOTAL CAPACITY (BTUH)	OUTDOOR AIR TEMP (F)	MINIMUM EER/SEER	CURRENT CHARAC.		ENTERING DRY BULB	ENTERING WET BULB	MIN TOTAL CAPACITY (BTUH)	MINIMUM EER/SEER			
				V	P					F		
DMSCU-1	18,000	95	13.0	208	60	DMS-1	(1,2,3)					
DMSCU-2	34,200	95	13.0	208	60	DMS-2	(1,2,3)					
DMSCU-3	18,000	95	13.0	208	60	DMS-3	(1,2,3)					

**GENERAL NOTES:**  
1. MINIMUM RECOMMENDED CLEARANCE AROUND ROOFTOP UNIT IS 12 INCHES ON NON-SERVICE SIDES AND 30 INCHES ON SERVICE SIDES. MAINTAIN MINIMUM CLEARANCE FOR CONDENSER AIR FLOW AS RECOMMENDED BY UNIT MANUFACTURER. MAINTAIN MINIMUM CLEARANCE AS REQUIRED TO OPEN ACCESS AND CONTROL DOORS ON UNIT FOR SERVICE, MAINTENANCE, AND INSPECTION. MAINTAIN MINIMUM ELECTRICAL CLEARANCE AS REQUIRED BY NEC.

**REMARKS:**  
1. PROVIDE WITH LOW AMBIENT CONTROL DOWN TO 20°F.  
2. PROVIDE WITH DISCONNECT SWITCH.  
3. REFRIGERANT LINES TO BE SIZED PER MANUFACTURER'S REQUIREMENTS.

BOILER - FORCED AIR													
MARK	TYPE	MINIMUM GAS INPUT (BTUH)	MINIMUM HEAT OUTPUT (BTUH)	PRESSURE DROP (FT.H2O)	GPM	FLUE SIZE	ELECTRICAL			MANUFACTURER	MODEL NUMBER	REMARKS	
							BLOWER HORSEPOWER	V	P				F
B-2	CONDENSING	3,000,000	2,862,000	15.0	191.0	10	0.50	480	1	60	RAYPAK	XVers	(1,2,3)
B-1	CONDENSING	3,000,000	2,862,000	15.0	191.0	10	0.50	480	1	60	RAYPAK	XVers	(1,2,3)

**GENERAL NOTES:**  
1. PROVIDE 8 OUNCE GAS PRESSURE TO BOILER.  
2. MAINTAIN MINIMUM CLEARANCE AROUND A BOILER OF 24 INCHES PER TEXAS BOILER LAW. MAINTAIN MINIMUM CLEARANCE AS REQUIRED TO OPEN ACCESS AND CONTROL DOORS FOR SERVICE, MAINTENANCE AND INSPECTION. MAINTAIN MINIMUM ELECTRICAL CLEARANCES AS REQUIRED BY NEC.

**REMARKS:**  
1. PROVIDE WITH CIRCULATING PUMP. SIZED BY BOILER MANUFACTURER TO ENSURE CONSTANT FLOW THROUGH BOILER. PUMP TO BE SHIPPED LOOSE. POWER BY ELECTRICAL CONTRACTOR BUT CONTROLLED BY BOILER. CONTRACTOR TO WIRE FROM BOILER PUMP CONTROL CIRCUIT TO PUMP STARTER RELAY.  
2. PROVIDE SEALED COMBUSTION BOILER.  
3. ALL BOILERS MOTORS AND CIRCULATION PUMPS SHALL COMPLY WITH SECTION 23 05 13.

PUMP													
TAG	SERVICE	TYPE	GPM	HEAD (FT.)	MOTOR HORSE POWER	MAX RPM	CURRENT CHARAC.			MANUFACTURER	MODEL NUMBER	REMARKS	
							V	P	F				
SHWP-2	HEATING HOT WATER	VERTICAL INLINE	286	105.00	15	1,800	480	3	60	ARMSTRONG	4300	(1,2,4)	
SHWP-1	HEATING HOT WATER	VERTICAL INLINE	286	105.00	15	1,800	480	3	60	ARMSTRONG	4300	(1,2,4)	
PHWP-2	HEATING HOT WATER	INLINE CIRCULATOR	191	25.00	5	1,800	480	3	60	-	-	(3,4)	
PHWP-1	HEATING HOT WATER	INLINE CIRCULATOR	191	25.00	5	1,800	480	3	60	-	-	(3,4)	

**GENERAL NOTES:**  
1. PUMP IS TO HAVE A NON-OVERLOADING MOTOR.  
2. MINIMUM RECOMMENDED CLEARANCE AROUND A PUMP IS 24 INCHES. MAINTAIN MINIMUM CLEARANCES AS REQUIRED FOR SERVICE, MAINTENANCE, AND INSPECTION.

**REMARKS:**  
1. PROVIDE WITH VARIABLE FREQUENCY DRIVE.  
2. PROVIDE SUCTION DIFFUSER AT PUMP INLET.  
3. PUMP SHALL BE SELECTED BY BOILER MANUFACTURER, WITH DISCONNECT AND STARTER BY ELECTRICAL CONTRACTOR AND CONTROLLED BY BOILER.  
4. PROVIDE PUMPS WITH GAUGE TAPPINGS.

GRILLE									
MARK	SERVICE	TYPE	DAMPER	CONSTRUCTION MATERIAL	FINISH COLOR	MANUFACTURER	MODEL NUMBER	DESCRIPTION	
A	SUPPLY AIR	DIFFUSER	-	STEEL	WHITE	TITUS	TDC	EXPOSED T-BAR CEILING FRAME STYLE WITH 24"x24" CONE FACE. ROUND NECK.	
B	RETURN AIR	DIFFUSER	-	STEEL	WHITE	TITUS	350RL	EXPOSED T-BAR CEILING FRAME STYLE WITH 24"x24" FACE. LOUVERED FACE.	
C	SUPPLY AIR	DIFFUSER	-	STEEL	WHITE	TITUS	TDC	SURFACE MOUNT CEILING FRAME STYLE WITH 22"x22" OR 12"x12" CONE FACE. ROUND NECK.	
D	RETURN AIR	DIFFUSER	-	STEEL	WHITE	TITUS	350RL	SURFACE MOUNT CEILING FRAME STYLE WITH 24"x24" FACE.	
E	EXHAUST AIR	DIFFUSER	-	STEEL	WHITE	TITUS	350RL	EXPOSED T-BAR CEILING FRAME STYLE WITH A 24"x24" OR 12"x12" FACE. PERFORATED FACE.	
ER	RETURN AIR	-	-	-	-	-	-	EXISTING AIR DEVICE SHALL REMAIN. REUSE AND BALANCE TO INDICATED CFM.	
ES	SUPPLY AIR	DIFFUSER	-	-	-	-	-	EXISTING AIR DEVICE SHALL REMAIN. REUSE AND BALANCE TO INDICATED CFM.	
F	EXHAUST AIR	GRILLE	-	STEEL	WHITE	TITUS	350RL	SURFACE MOUNT CEILING FRAME STYLE WITH 22"x22" OR 12"x12" FACE. PERFORATED FACE.	

**GENERAL NOTES:**  
1. DAMPERS NOTED AS 'U.L.' SHALL BE A 'U.L.' CLASSIFIED CEILING RADIATION DAMPER WITH THERMAL BLANKET MOUNTED (1).  
2. COORDINATE FINAL AIR DEVICE LOCATION AND FINISH COLOR WITH ARCHITECT.

**REMARKS:**  
1. N/A

DAMPER						
MARK	ACTUATOR	DUTY	BLADE ACTION	MANUFACTURER	MODEL NUMBER	REMARKS
D-1	MANUAL BALANCING	UNDER 9" WIDE	N/A	N/A	N/A	SEE SMACNA CONSTRUCTION DETAILS REFERENCED "TYPICAL CONSTRUCTION DETAILS FOR LOW VELOCITY DUCTS."
D-2	MANUAL BALANCING	OVER 9" WIDE	OPPOSED	RUSKIN	MD-35	MANUAL DAMPER WITH STANDARD CONSTRUCTION FEATURES AND VENT LOCK #839 LOCKING REGULATOR
D-3	MOTORIZED	OVER 9" WIDE	OPPOSED	RUSKIN	CD-60	LOW LEAKAGE DAMPER WITH BLADE SEALS

**NOTES:**  
N/A - NOT APPLICABLE



**GENERAL NOTES:**

CONTRACTOR SHALL PROVIDE DEHUMIDIFICATION DURING THE CONSTRUCTION SCHEDULE. THE SCOPE IS TO MAINTAIN ACCEPTABLE HUMIDITY LEVELS WITHIN THE BUILDING. THE REMOVAL OF EXCESS HUMIDITY FROM THE AIR THROUGHOUT THE BUILDING. PROVIDE MOISTURE CONTROL RENTAL EQUIPMENT AND SOLUTION FOR PREVENTING THE LONG-TERM EFFECTS OF MOISTURE LEVEL THAT CAN DAMAGE INTERIOR BUILDING MATERIALS, BOOKS AND ELECTRONIC EQUIPMENT.  
 CONTRACTOR IS RESPONSIBLE TO PROVIDE ALL REQUIRED POWER GENERATING EQUIPMENT.


1. THESE CONSTRUCTION DRAWINGS ARE DIAGRAMMATIC AND DO NOT NECESSARILY REFLECT ACTUAL DIMENSIONS. IT IS THE RESPONSIBILITY OF THE CONTRACTOR TO FIELD-VERIFY ALL DIMENSIONS AND COORDINATE PLACEMENT OF ALL EQUIPMENT AND ROUTING OF ALL PIPING AND/OR DUCT SYSTEMS.
2. ALL MECHANICAL SYSTEMS SHOWN ON THIS PLAN ARE FROM EXISTING DRAWINGS AND PRELIMINARY FIELD WORK. CONTRACTOR IS RESPONSIBLE FOR FIELD VERIFYING ALL LOCATIONS AND SIZES OF MECHANICAL SYSTEMS PRIOR TO THE START OF WORK.

**MECHANICAL KEYED NOTES:**

1. PROVIDE NEW DDC TEMPERATURE SENSOR AND CONTROL WIRING. REFER TO SPECIFICATIONS FOR MORE INFORMATION.
2. PROVIDE BMCS MONITORING TEMPERATURE SENSOR AS INDICATED.
3. PROVIDE NEW HUMIDITY SENSOR AT LOCATION SHOWN. REFER TO SPECIFICATIONS FOR MORE INFORMATION.


**EXISTING DUAL DUCT BOX SCHEDULE**

MARK	CFM RANGE	INLET SIZE
1	150-350	6"Ø
2	355-500	7"Ø
3	505-650	8"Ø
4	655-1000	10"Ø
5	1005-1500	12"Ø
6	1505-2200	14"Ø
7	2205-3000	16"Ø

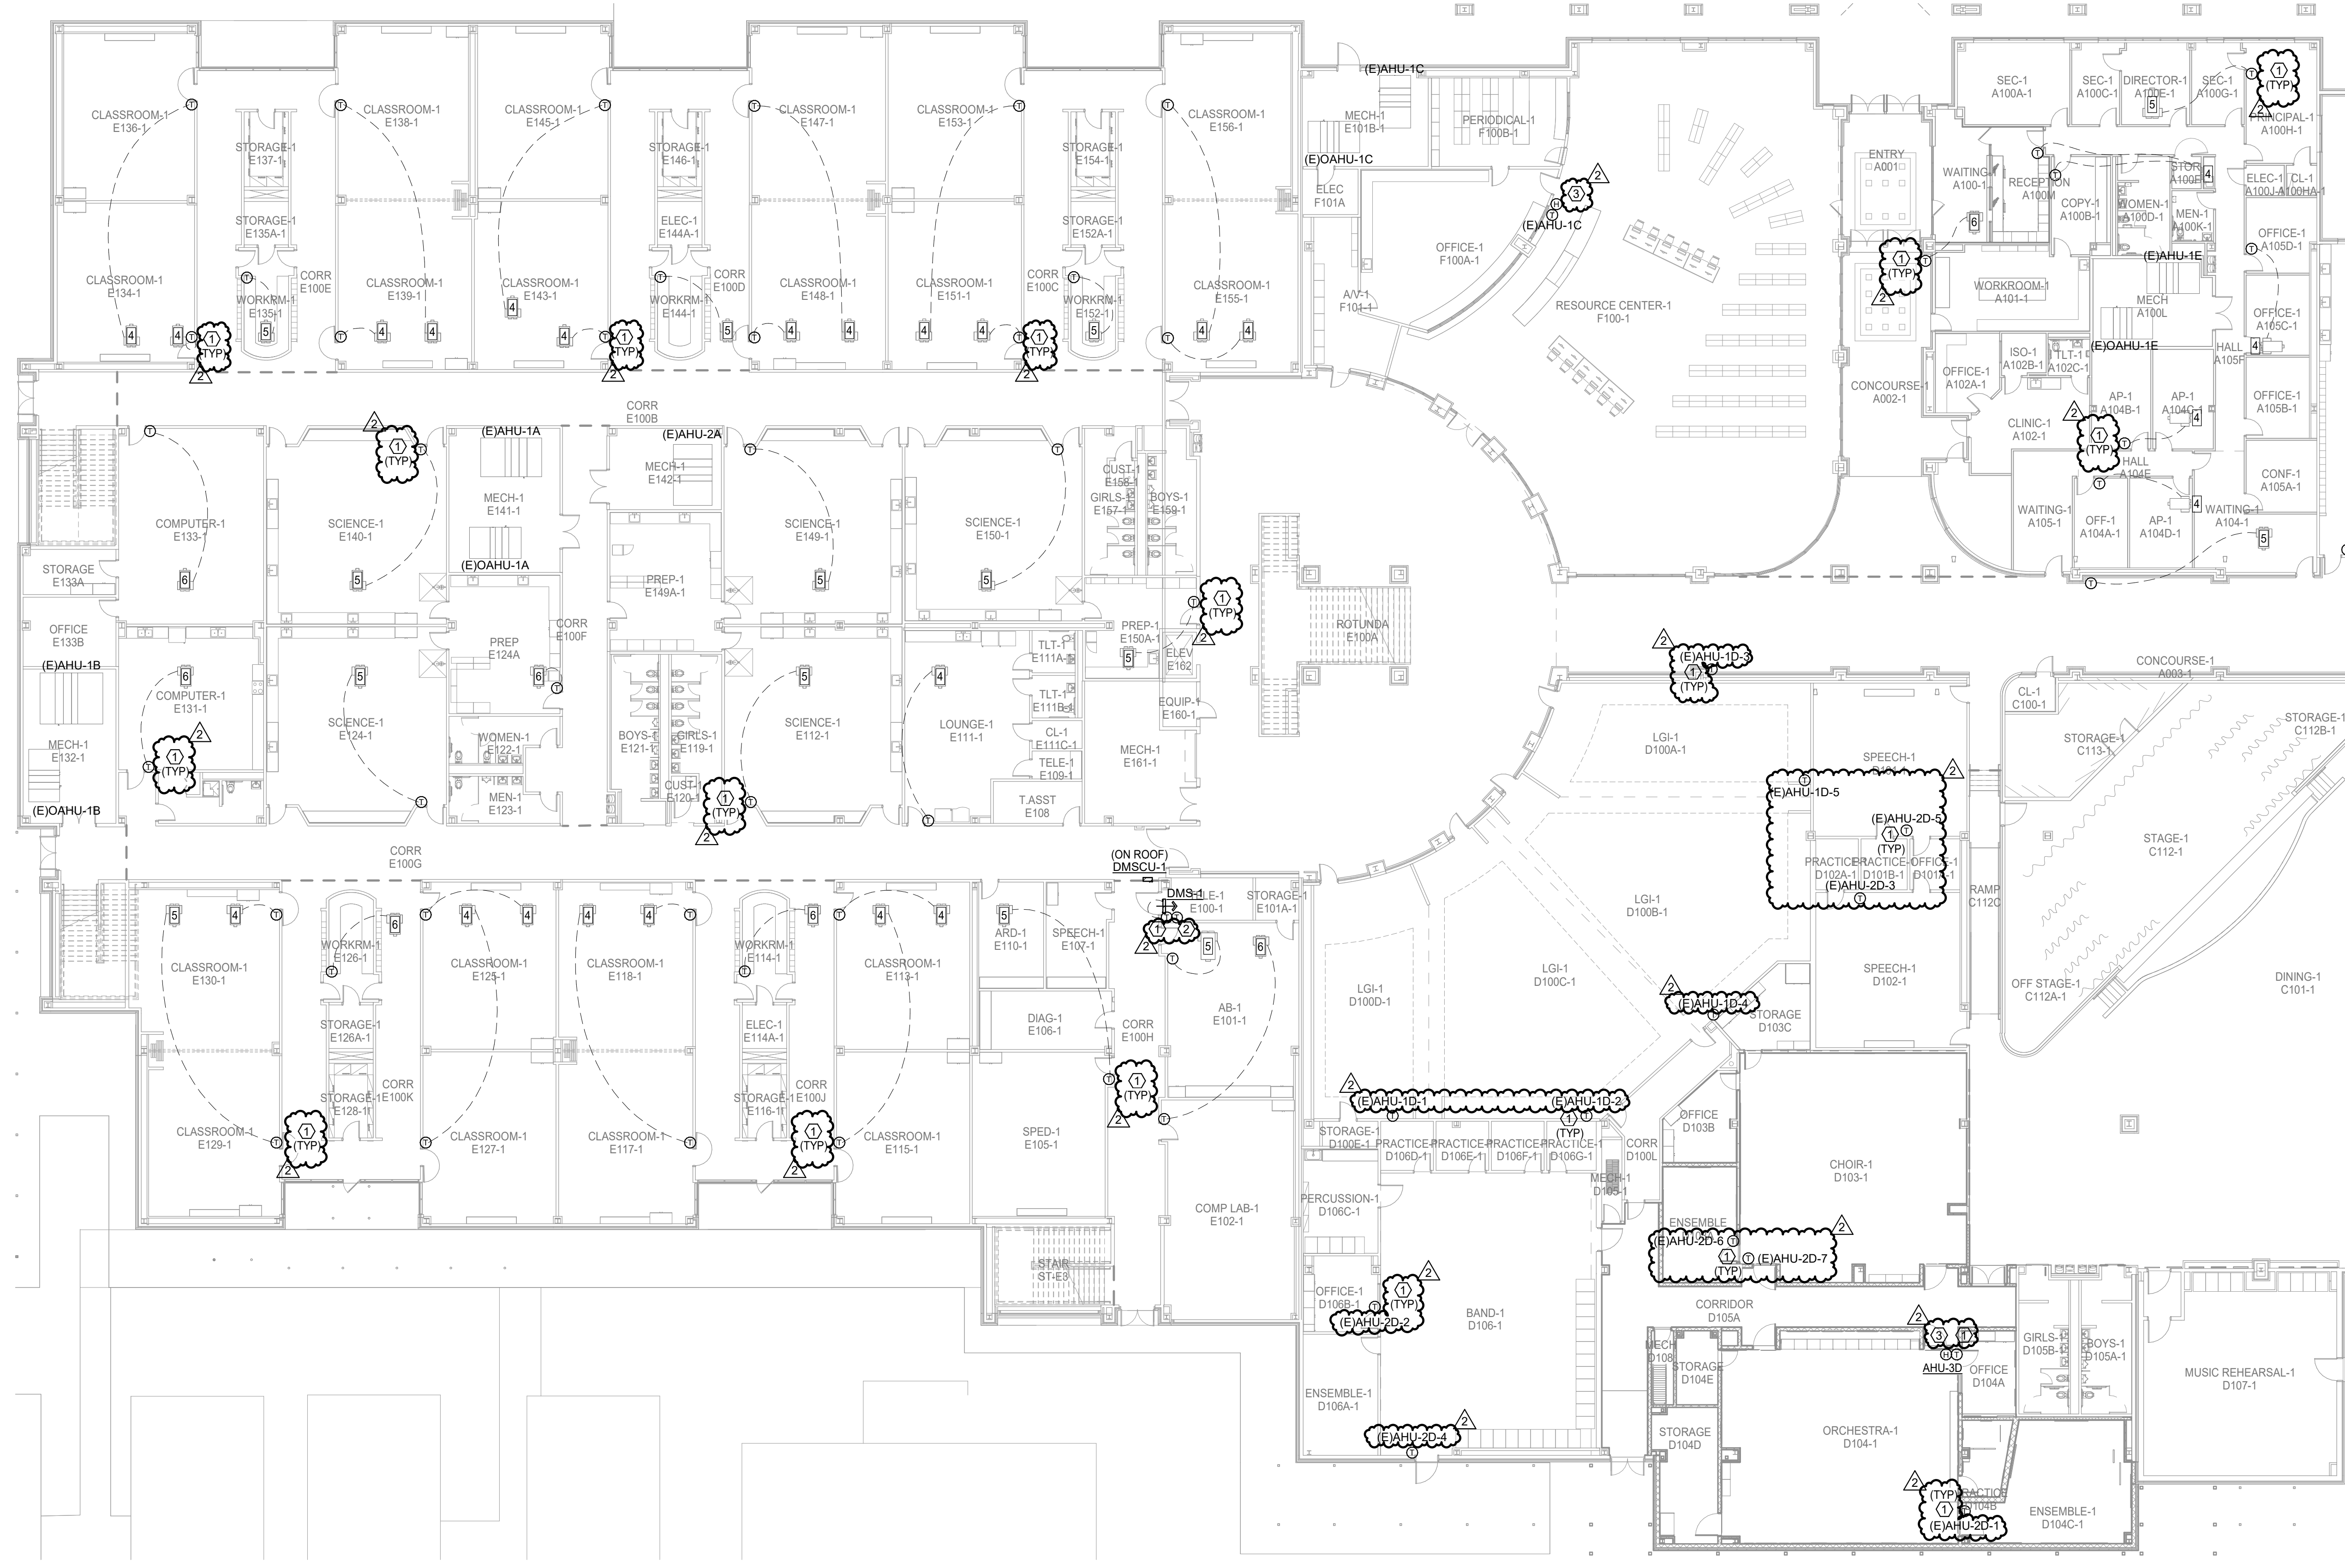

**1 MECHANICAL CONTROLS PLAN - LEVEL 1 - AREA A, B, C, D**  
 Scale: 1/16" = 1'-0"

**KEY PLAN:**

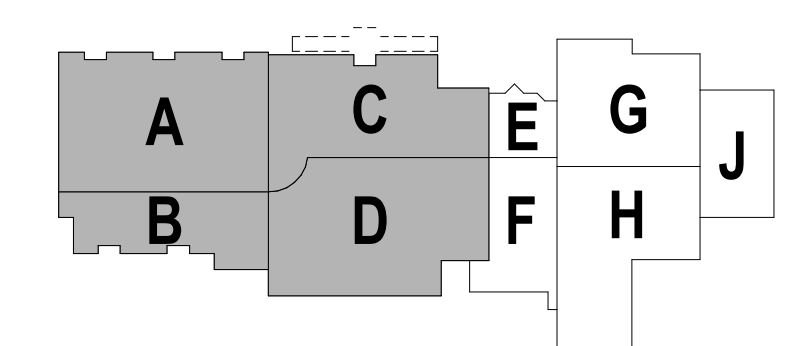

**2024 SMITH & SPILLANE MS RENOVATIONS**  
**SPILLANE MIDDLE SCHOOL**  
 13403 WOODS-SPILLANE BLVD, CYPRESS, TX 77429  
 CFSID PROJECT NO: 24-02-5751-R-RFP

Project Number: 23073  
 Date: 26 JANUARY 2025  
 Drawn By: WHL / KLO  
 MECHANICAL  
 CONTROLS FIRST  
 FLOOR PLAN - AREA A,  
 B, C, D  
**M5.01**

**Salas O'Brien**  
 salesobrien.com 281-664-1900  
 Houston  
 10930 W. Sam Houston Pkwy North, Suite 900  
 Houston, TX 77064  
 Registration: F-411  
 Project No: 2024-0029-00

**NATEX**  
 CORPORATION  
 ARCHITECTS  
 www.natexarchitects.com  
 447 Heights Boulevard  
 Houston, TX 77007  
 Phone: 713-975-9525  
 Fax: 713-780-7824

**Coleman Partners**  
 ARCHITECTS  
 architects.com  
 3701 Kirby Drive, Suite 830  
 Houston, TX 77098  
 tel: 832-947-1038 fax: 282-214-5365

**BRADLEY KALMANS**  
 50219  
 LICENSED PROFESSIONAL ENGINEER  
 02-14-2025

**CONSTRUCTION DOCUMENT**

**CIVIL ENGINEER**  
**BROOKS AND SPARKS, INC.**  
 21020 PARK ROW  
 KATY, TX 77449  
 tel: 281-578-9595

**STRUCTURAL ENGINEER**  
**DALLY + ASSOCIATES, INC.**  
 9800 RICHMOND AVE.  
 SUITE 400  
 HOUSTON, TX 77042  
 tel: 713.337.8881

**MEPT ENGINEER**  
**SALAS O'BRIEN**  
 10930 W. SAM HOUSTON PKWY. N.  
 SUITE 900  
 HOUSTON, TX 77064  
 tel: 281.664.1900

**FOOD SERVICE EQUIPMENT**  
**FDP**  
 25317 INTERSTATE 45  
 THE WOODLANDS, TX 77380  
 tel: 281-350-2323

**LANDSCAPE ARCHITECT**  
**LANDESIGN GROUP**  
 17041 EL CAMINO REAL  
 SUITE 204  
 HOUSTON, TX 77058  
 tel: 281-486-4040

**GENERAL NOTES:**


1. THESE CONSTRUCTION DRAWINGS ARE DIAGRAMMATIC, AND DO NOT NECESSARILY REFLECT ACTUAL DIMENSIONS. IT IS THE RESPONSIBILITY OF THE CONTRACTOR TO FIELD-VERIFY ALL DIMENSIONS AND COORDINATE PLACEMENT OF ALL EQUIPMENT AND ROUTING OF ALL PIPING AND/OR DUCT SYSTEMS. CAN DAMAGE INTERIOR BUILDING MATERIALS, BOOKS AND ELECTRONIC EQUIPMENT.  
 CONTRACTOR IS RESPONSIBLE TO PROVIDE ALL REQUIRED POWER GENERATING EQUIPMENT.

**MECHANICAL KEYED NOTES:**

- ① PROVIDE NEW DDC TEMPERATURE SENSOR AND CONTROL WIRING. REFER TO SPECIFICATIONS FOR MORE INFORMATION.
- ② PROVIDE BMCS MONITORING TEMPERATURE SENSOR AS INDICATED.
- ③ PROVIDE, INSTALL AND STARTUP NEW CARBON MONOXIDE MONITORING SYSTEM. REFER TO SPEC FOR ADDITIONAL INFORMATION.


**EXISTING DUAL DUCT BOX SCHEDULE**

MARK	CFM RANGE	INLET SIZE
1	150-350	6"Ø
2	355-500	7"Ø
3	505-650	8"Ø
4	655-1000	10"Ø
5	1005-1500	12"Ø
6	1505-2200	14"Ø
7	2205-3000	16"Ø

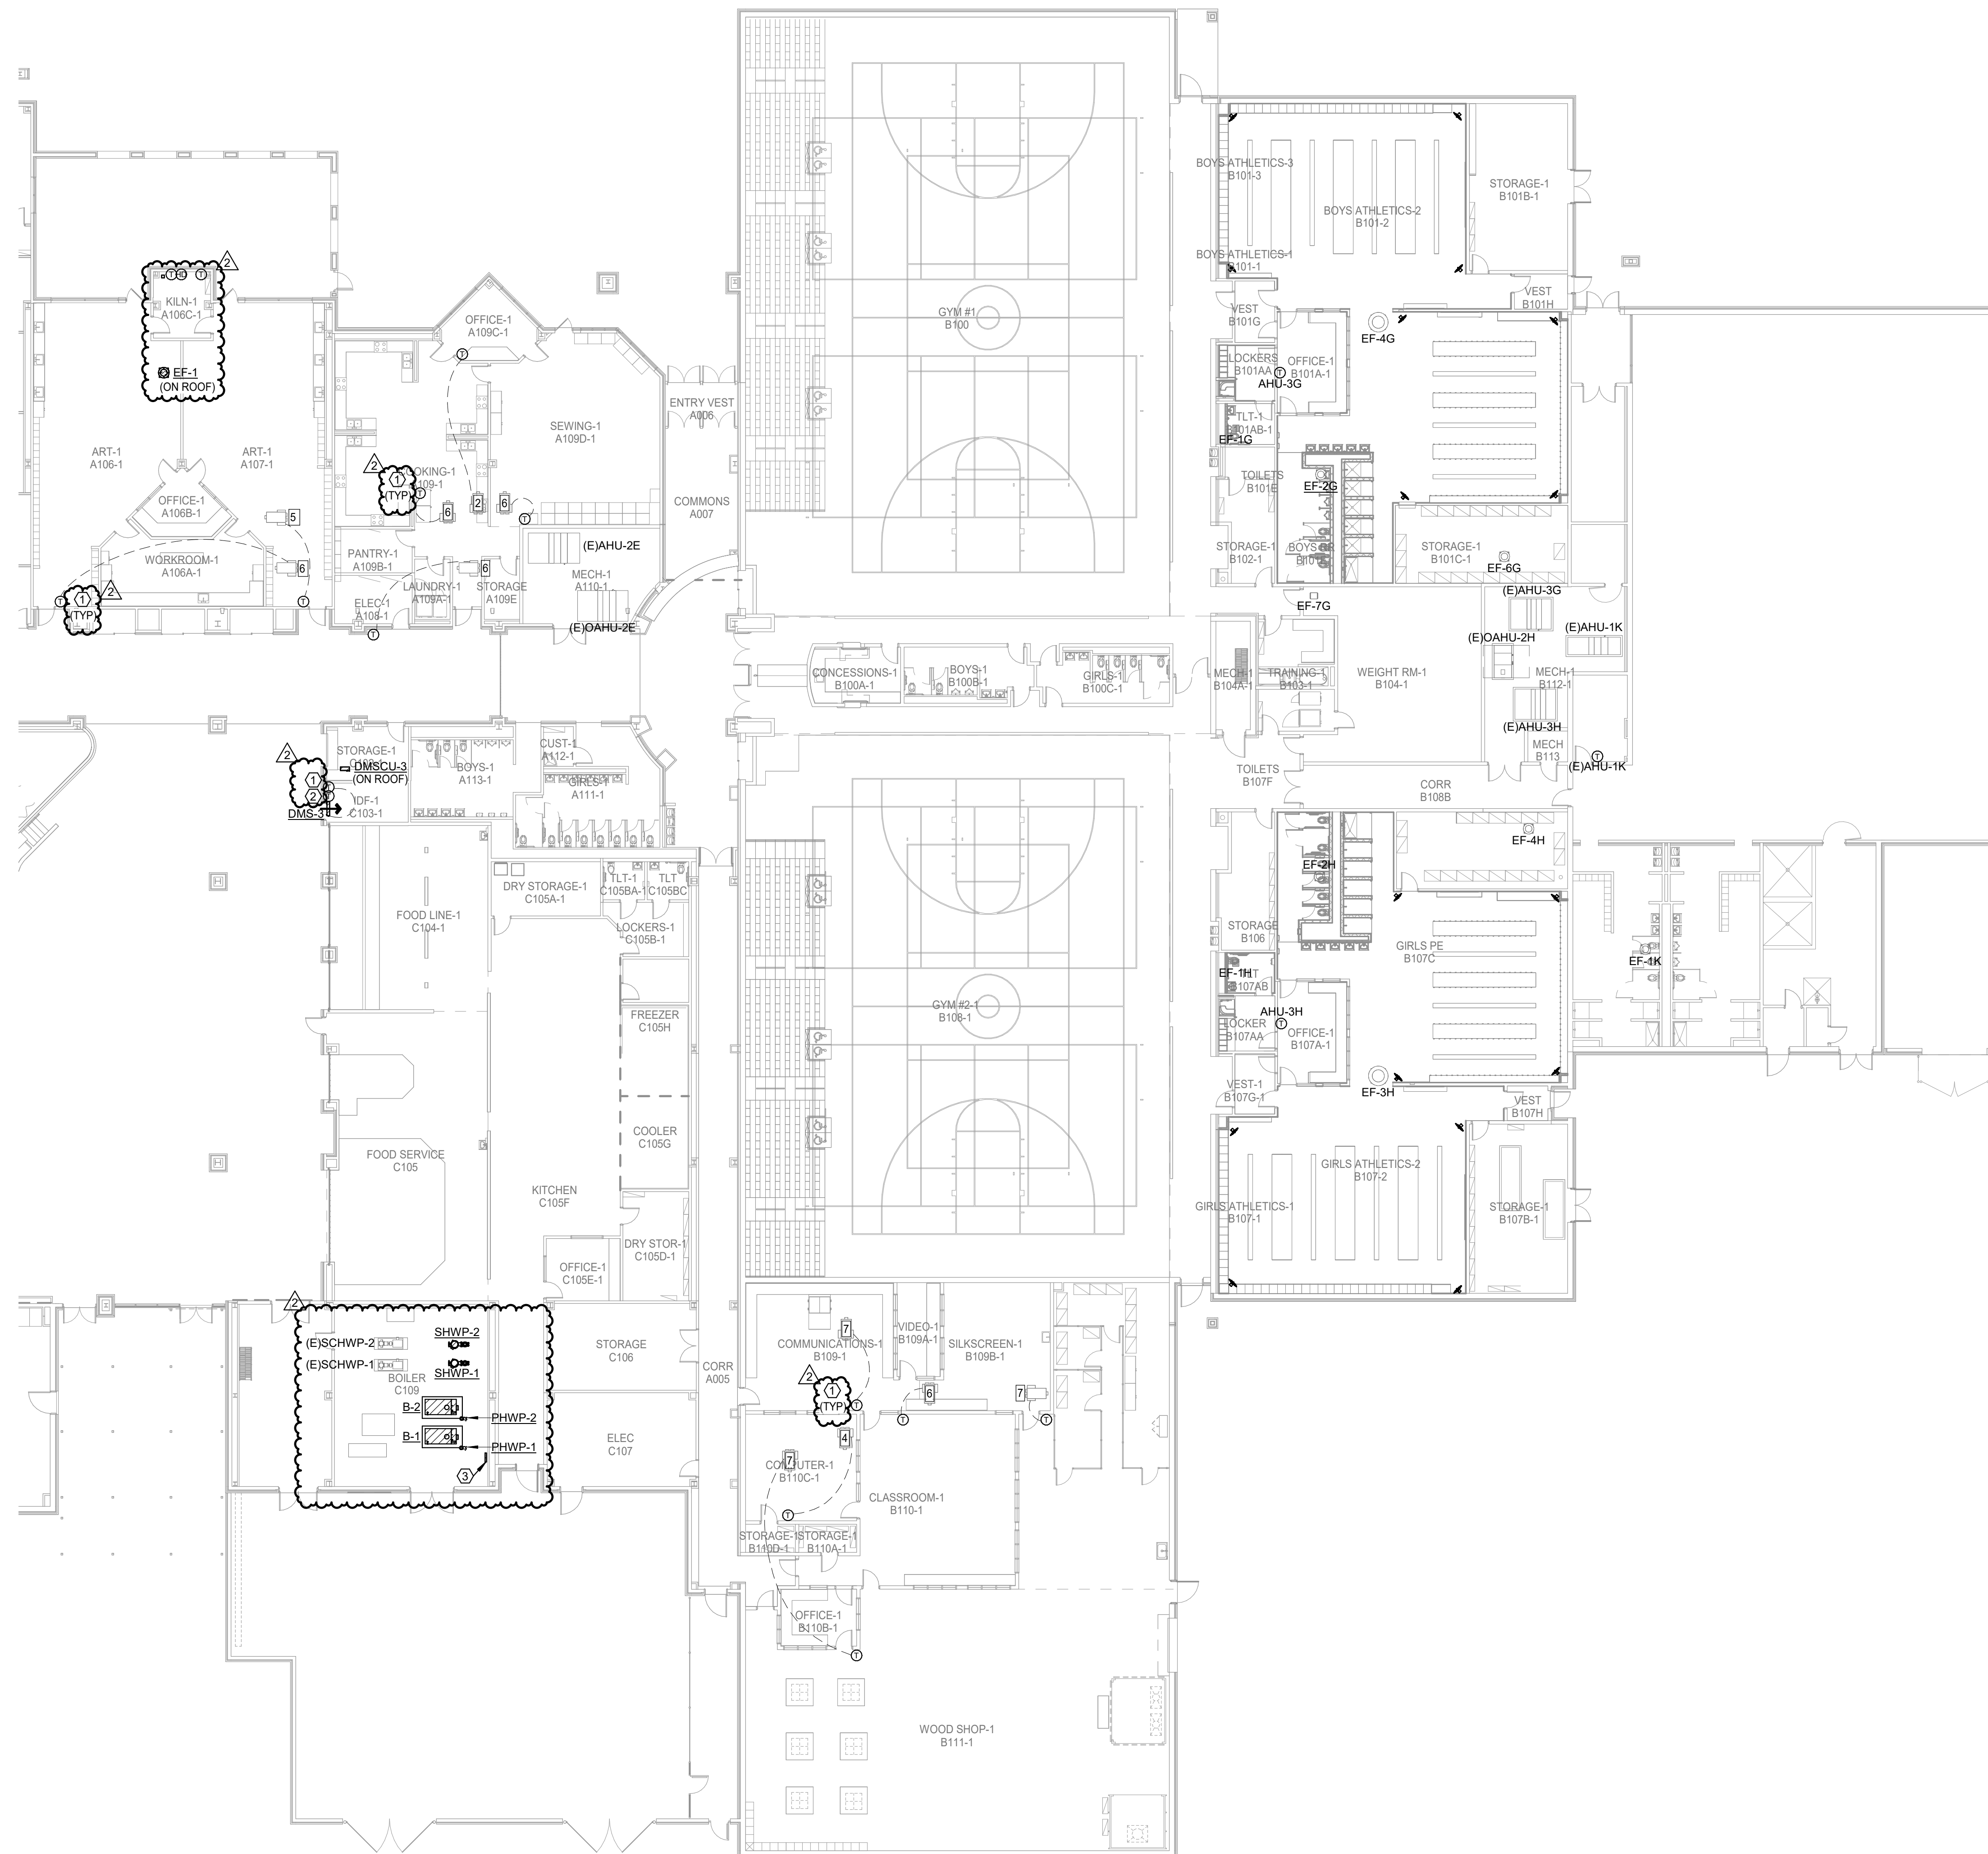

**MECHANICAL CONTROLS PLAN - LEVEL 1 - AREA E, F, G, H, J**  
 Scale: 1/16" = 1'-0"

KEY PLAN:

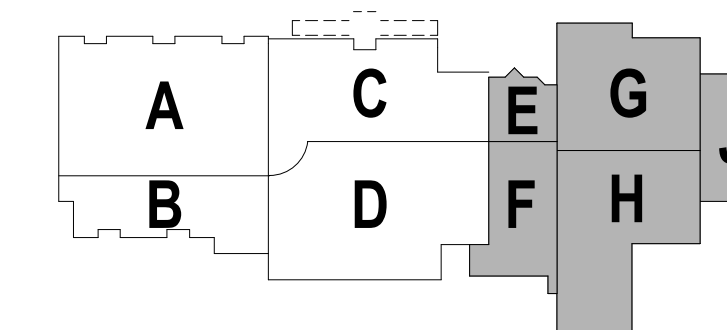

**2024 SMITH & SPILLANE MS RENOVATIONS**  
**SPILLANE MIDDLE SCHOOL**  
 13403 WOODS-SPILLANE BLVD, CYPRESS, TX 77429  
 CFISD PROJECT NO: 24-02-5751-R-RFP

Revision / Submission	Date
2	02-14-25
1	01-28-25

Project Number: 23073  
 Date: 26 JANUARY 2025  
 Drawn By: WHL / KLO

**MECHANICAL**  
 CONTROLS FIRST  
 FLOOR PLAN - AREA E,  
 F, G, H, J

**M5.02**

**Salas O'Brien**  
 salesobrien.com 281-664-1900  
 Houston 10930 W. Sam Houston Pkwy North, Suite 900  
 Houston, TX 77064  
 Registration: F-4111  
 Project No: 2024-00209-00

**NATEX**  
 CORPORATION  
 ARCHITECTS  
 www.natexarchitects.com  
 447 Heights Boulevard  
 Houston, TX 77007  
 Phone: 713-975-8525  
 Fax: 713-780-7824

**Coleman Partners**  
 ARCHITECTS  
 cpa.com  
 3701 Kirby Drive, Suite 830  
 Houston, TX 77098  
 tel: 832-947-1038 fax: 281-214-5365

**CONSTRUCTION DOCUMENT**  
 BRADLEY KALMANS  
 80219  
 LICENSED PROFESSIONAL ENGINEER  
 STATE OF TEXAS  
 02-14-2025

**CIVIL ENGINEER**  
**BROOKS AND SPARKS, INC.**  
 21020 PARK ROW  
 KATY, TX 77449  
 tel: 281-578-9595

**STRUCTURAL ENGINEER**  
**DALLY + ASSOCIATES, INC.**  
 9800 RICHMOND AVE.  
 SUITE 400  
 HOUSTON, TX 77042  
 tel: 713-337-8881

**MEPT ENGINEER**  
**SALAS O'BRIEN**  
 10930 W. SAM HOUSTON PKWY. N.  
 SUITE 900  
 HOUSTON, TX 77064  
 tel: 281.664.1900

**FOOD SERVICE EQUIPMENT**  
**FDP**  
 25317 INTERSTATE 45  
 THE WOODLANDS, TX 77380  
 tel: 281-350-2323

**LANDSCAPE ARCHITECT**  
**LANDESIGN GROUP**  
 17041 EL CAMINO REAL  
 SUITE 204  
 HOUSTON, TX 77058  
 tel: 281-486-4040

CONTRACTOR SHALL PROVIDE DEHUMIDIFICATION DURING THE CONSTRUCTION SCHEDULE. THE SCOPE IS TO MAINTAIN ACCEPTABLE HUMIDITY LEVELS WITHIN THE BUILDING. THE REMOVAL OF EXCESS HUMIDITY FROM THE AIR THROUGHOUT THE BUILDING. PROVIDE MOISTURE CONTROL, RENTAL EQUIPMENT AND SOLUTION FOR PREVENTING THE LONG-TERM EFFECTS OF MOISTURE LEVEL THAT CAN DAMAGE INTERIOR BUILDING MATERIALS, BOOKS AND ELECTRONIC EQUIPMENT.  
 CONTRACTOR IS RESPONSIBLE TO PROVIDE ALL REQUIRED POWER GENERATING EQUIPMENT.

**GENERAL NOTES:**


1. THESE CONSTRUCTION DRAWINGS ARE DIAGRAMMATIC. AND DO NOT NECESSARILY REFLECT ACTUAL DIMENSIONS. IT IS THE RESPONSIBILITY OF THE CONTRACTOR TO FIELD-VERIFY ALL DIMENSIONS AND COORDINATE PLACEMENT OF ALL EQUIPMENT AND ROUTING OF ALL PIPING AND/OR DUCT SYSTEMS.
2. ALL MECHANICAL SYSTEMS SHOWN ON THIS PLAN ARE FROM EXISTING DRAWINGS AND PRELIMINARY FIELD WORK. CONTRACTOR IS RESPONSIBLE FOR FIELD VERIFYING ALL LOCATIONS AND SIZES OF MECHANICAL SYSTEMS PRIOR TO THE START OF WORK.

**EXISTING DUAL DUCT BOX SCHEDULE**

MARK	CFM RANGE	INLET SIZE
1	150-350	6"Ø
2	355-500	7"Ø
3	505-650	8"Ø
4	655-1000	10"Ø
5	1005-1500	12"Ø
6	1505-2200	14"Ø
7	2205-3000	16"Ø


**MECHANICAL KEYED NOTES:**

1. PROVIDE NEW DDC TEMPERATURE SENSOR AND CONTROL WIRING. REFER TO SPECIFICATIONS FOR MORE INFORMATION.
2. PROVIDE BMCS MONITORING TEMPERATURE SENSOR AS INDICATED.
3. PROVIDE AND INSTALL FLOW METER IN CHILLED/HOT WATER SUPPLY PIPING TO BE USED IN CALCULATING AND LOGGING THE KITCHEN BTUH USAGE THROUGH THE BMCS. METER SHALL BE INSTALLED PER MANUFACTURERS REQUIREMENTS. REINSULATE PIPING AFTER INSTALLATION IS COMPLETE.
4. PROVIDE AND INSTALL CHILLED/HOT WATER SUPPLY AND RETURN TEMPERATURE SENSORS TO BE USED IN CALCULATING AND LOGGING THE KITCHEN BTUH USAGE THROUGH THE BMCS. REINSULATE PIPING AFTER INSTALLATION IS COMPLETE.

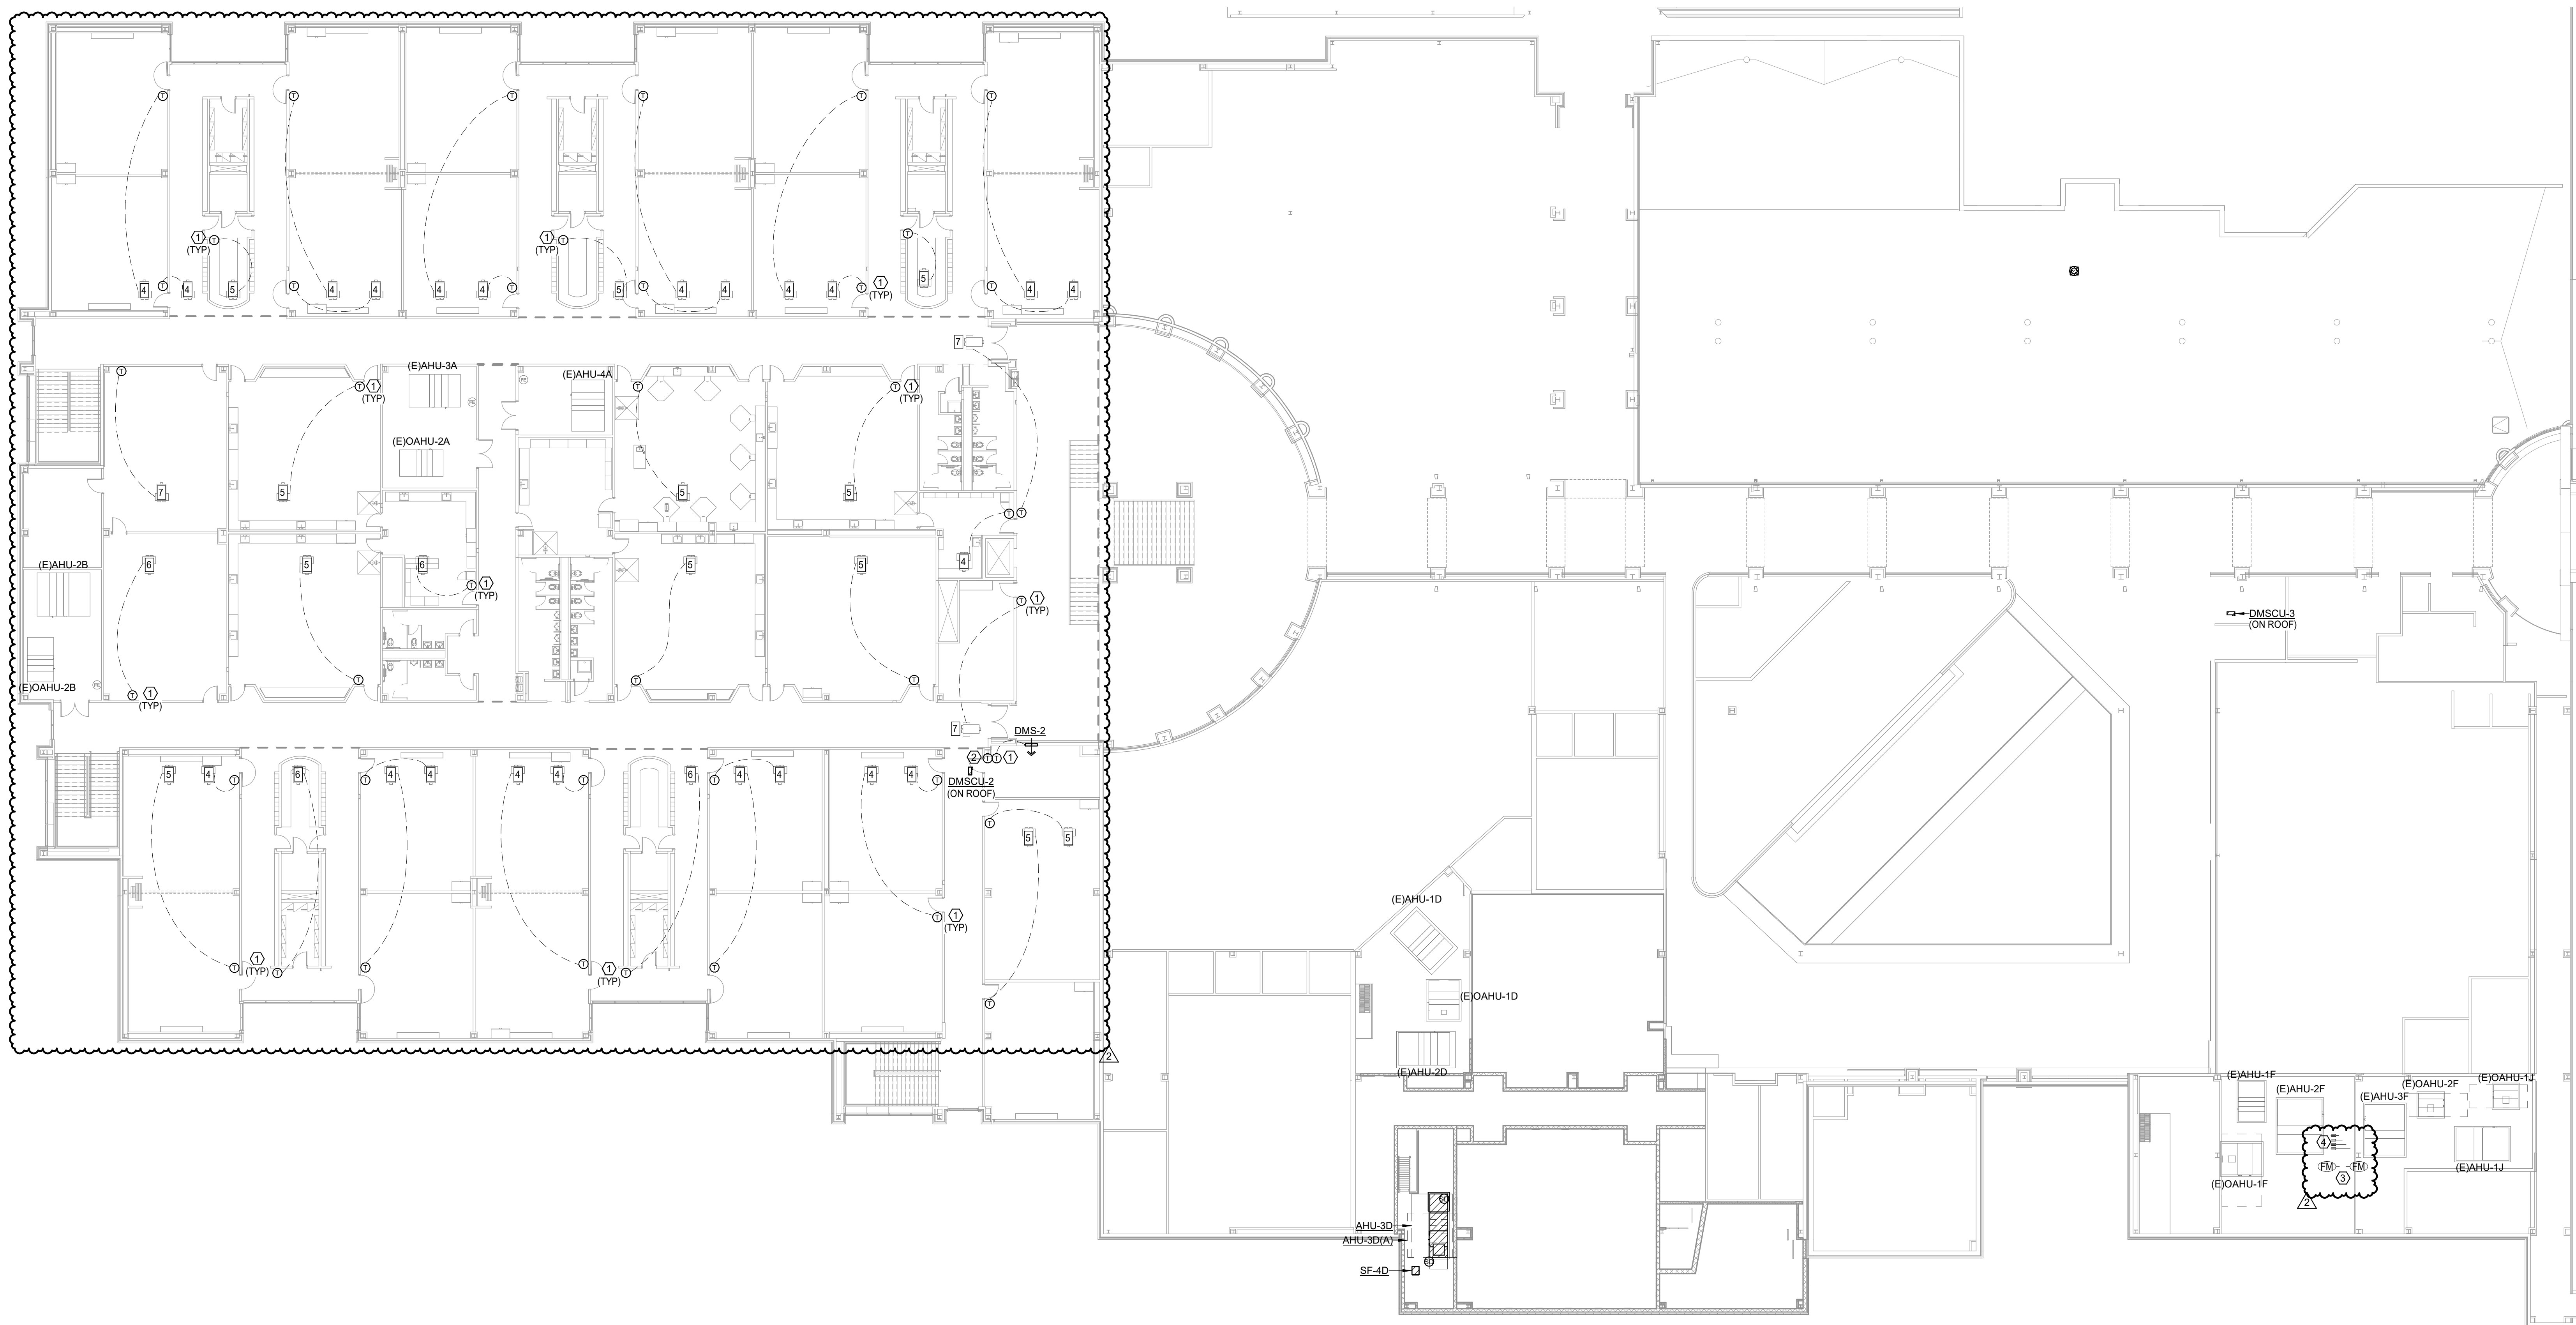

**1 MECHANICAL CONTROLS FLOOR PLAN - LEVEL 2 - AREA A, B, C, D, E, F**  
 Scale: 1/16" = 1'-0"

KEY PLAN:

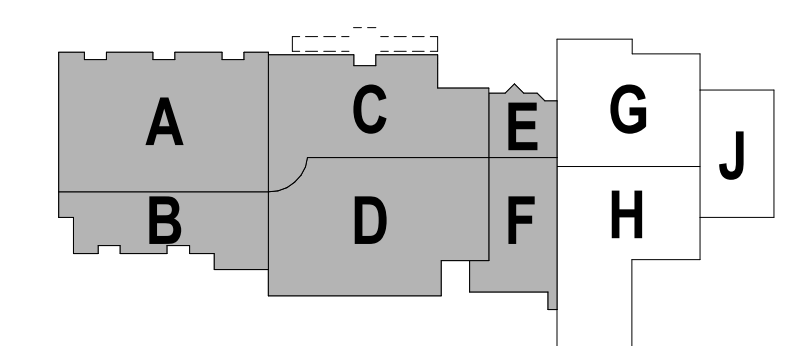

**2024 SMITH & SPILLANE MS RENOVATIONS**  
**SPILLANE MIDDLE SCHOOL**  
 13403 WOODS-SPILLANE BLVD, CYPRESS, TX 77429  
 CFSID PROJECT NO: 24-02-5751-R-RFP

Revisions / Submissions

No.	Description	Date
2	Addendum 03	02-14-25

Project Number: 23073  
 Date: 26 JANUARY 2025  
 Drawn By: WHL / KLO

**MECHANICAL CONTROLS SECOND FLOOR PLAN**  
**M5.03**





**GENERAL NOTES:**

CONTRACTOR SHALL PROVIDE DEHUMIDIFICATION DURING THE CONSTRUCTION SCHEDULE. THE SCOPE IS TO MAINTAIN ACCEPTABLE HUMIDITY LEVELS WITHIN THE BUILDING. THE REMOVAL OF EXCESS HUMIDITY FROM THE AIR THROUGHOUT THE BUILDING. PROVIDE MOISTURE CONTROL RENTAL EQUIPMENT AND SOLUTION FOR PREVENTING THE LONG-TERM EFFECTS OF MOISTURE LEVEL THAT CAN DAMAGE INTERIOR BUILDING MATERIALS, BOOKS AND ELECTRONIC EQUIPMENT.

CONTRACTOR IS RESPONSIBLE TO PROVIDE ALL REQUIRED POWER GENERATING EQUIPMENT.

1. THESE CONSTRUCTION DRAWINGS ARE DIAGRAMMATIC, AND DO NOT NECESSARILY REFLECT ACTUAL DIMENSIONS. IT IS THE RESPONSIBILITY OF THE CONTRACTOR TO FIELD VERIFY ALL DIMENSIONS AND COORDINATE PLACEMENT OF ALL EQUIPMENT AND ROUTING OF ALL PIPING AND/OR DUCT SYSTEMS.

2. ALL MECHANICAL SYSTEMS SHOWN ON THIS PLAN ARE FROM EXISTING DRAWINGS AND PRELIMINARY FIELD WORK. CONTRACTOR IS RESPONSIBLE FOR FIELD VERIFYING ALL LOCATIONS AND SIZES OF MECHANICAL SYSTEMS PRIOR TO THE START OF WORK.

**MECHANICAL KEYED NOTES:**

1. REPLACE EXISTING REFRIGERANT MONITORING STATION AND CONNECT TO BMCS. REFER TO SPEC FOR ADDITIONAL INFORMATION.
2. REPLACE EXISTING SENSORS AT CHILLER AT CONNECT TO BMCS. REFER TO SPEC FOR ADDITIONAL INFORMATION.
3. REPLACE EXISTING SENSORS AT CHILLED WATER PUMP AT CONNECT TO BMCS. REFER TO SPEC FOR ADDITIONAL INFORMATION.
4. REPLACE EXISTING MOTORIZED VALVES AT COOLING TOWER PIPING AND CONNECT TO BMCS. REFER TO SPEC FOR ADDITIONAL INFORMATION.
5. REPLACE EXISTING SENSORS AT CONDENSER WATER PUMP AT CONNECT TO BMCS. REFER TO SPEC FOR ADDITIONAL INFORMATION.


**2024 SMITH & SPILLANE MS RENOVATIONS**  
**SPILLANE MIDDLE SCHOOL**  
 13403 WOODS-SPILLANE BLVD, CYPRESS, TX 77429  
 CFSID PROJECT NO: 24-02-5751-R-RFP

Revision	Description
2	Addendum 03 02-14-25

Project Number: 23073  
 Date: 26 JANUARY 2025  
 Drawn By: WHL / KLO

MECHANICAL CONTROLS PLAN - CENTRAL PLANT

**M5.04**

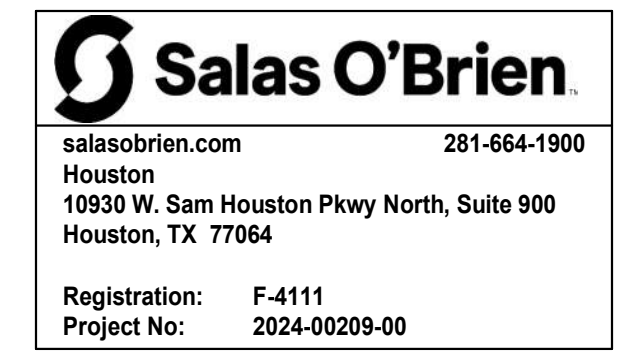

3701 Kirby Drive, Suite 830 Houston, TX 77098

832.947.1038 fax 282.214.5365

21020 PARK ROW KATY, TX 77449

281.578.9595

CIVIL ENGINEER BROOKS AND SPARKS, INC.

21020 PARK ROW KATY, TX 77449

281.578.9595

STRUCTURAL ENGINEER DALLY + ASSOCIATES, INC.

9800 RICHMOND AVE. SUITE 400

HOUSTON, TX 77042

713.337.8881

MEPT ENGINEER SALAS O'BRIEN

10930 W. SAM HOUSTON PKWY. N. SUITE 900

HOUSTON, TX 77064

281.664.1900

FOOD SERVICE EQUIPMENT FDP

25317 INTERSTATE 45 THE WOODLANDS, TX 77380

281.350.2323

LANDSCAPE ARCHITECT LANDESGRUP

17041 EL CAMINO REAL SUITE 204

HOUSTON, TX 77058

281.486.4040

REMARKS:

1. COORDINATE LOCATION WITH OWNER, COMMISSIONING AND ENGINEER.

NOTE: SCHEDULES INCLUDED ON THIS SHEET ARE SUPPLEMENTARY INFORMATION FOR THE NEW EQUIPMENT INSTALLED AS PART OF THE BUILDING RENOVATION. REFER TO BUILDING RENOVATION DRAWINGS FOR ADDITIONAL INFORMATION AND REQUIREMENTS.

2. Addendum 03

2. Addendum 03

(E)AIR HANDLING UNIT table with columns for MARK, TYPE, FAN, COOLING, HEATING, WATER, and PIPE SIZE TO COIL (IN.).

(E)COOLING TOWER table with columns for MARK, ENTERING WATER TEMP (°F), LEAVING WATER TEMP (°F), GPM, TOTAL TONS, AMBIENT WET BULB TEMP (°F), NO. OF CELLS, MOTOR HP (EACH), CURRENT CHARAC., MANUFACTURER, MODEL, and REMARKS.

BOILER SCHEDULE table with columns for MARK, EWT (°F), LWT (°F), GPM, MINIMUM INPUT (MBH), MINIMUM HEATING OUTPUT (MBH), GAS MANIFOLD PRESSURE (PSI), FLUE SIZE (IN. ROUND), BLOWER HP, ELECTRICAL CURRENT (VPHHZ), and REMARKS.

(E)WATER COOLED CHILLER table with columns for MARK, TONS, EVAPORATOR (MAX GPM, MIN GPM, LWT), CONDENSER (FLOW GPM), VALVE TYPE, PIPE SIZE, and REMARKS.

PUMP table with columns for MARK, SERVICE, TYPE, GPM, HEAD (FT.), MOTOR HORSE POWER, CURRENT CHARAC., MANUFACTURER, and MODEL NUMBER.

DUCTLESS MINI-SPLIT - INDOOR UNIT table with columns for MARK, FAN, AIR TEMPERATURE (°F), COOLING, and REMARKS.

DUCTLESS MINI-SPLIT - OUTDOOR UNIT table with columns for MARK, MIN. TOTAL OUTDOOR CAPACITY (BTUH), AIR SEER/HSFPF, MINIMUM (CURRENT CHARAC.), RELATED UNIT MARK, and REMARKS.

SYMBOL LEGEND table with columns for SYMBOL and DESCRIPTION (DISREGARD ITEMS NOT SHOWN ON PLANS).

2024 SMITH & SPILLANE MS RENOVATIONS SPILLANE MIDDLE SCHOOL 13403 WOODS-SPILLANE BLVD, CYPRESS, TX 77429 CFISD PROJECT NO: 24-02-5751-R-RFP

Project information including Project Number: 23073, Date: 26 JANUARY 2025, Drawn By: WHL / KLO, MECHANICAL CONTROLS SCHEDULES, and a large M5.05 stamp.

ELECTRICAL KEYED NOTES	
1	CONTROL EXTERIOR LIGHTING WITH PHOTOCELL INTERMATIC #EK4236S OR APPROVED EQUAL. LOCATE PHOTOSENSOR SURFACEMOUNTED ON THE NORTH SIDE OF THE BUILDING. LOCATION IS TO BE APPROVED BY OWNER / ARCHITECT.
2	BORE UNDER CONCRETE DRIVE
3	APPROXIMATE ROUTE OF KNOWN UNDERGROUND PIPING AND INLETS. CONTRACTOR TO LOCATE EXISTING UNDERGROUND UTILITIES TO AVOID DAMAGE DURING INSTALLATION OF NEW UNDERGROUND ELECTRICAL TO GREENHOUSE.
4	PROVIDE INTERMATIC E1800XX TIME SWITCH AND CONTROL PHOTOCELL OUTSIDE FOR EXTERIOR LIGHTING CIRCUIT.

SITE GENERAL NOTES	
1	CONTRACTOR TO COORDINATE FINAL LOCATION OF ALL CONDUITS WITH ALL OTHER TRADES.
2	REFER TO CIVIL DRAWINGS FOR FINAL ROUTING AND DEPTH OF ALL UNDERGROUND UTILITIES.
3	REFER TO TECHNOLOGY DRAWINGS, DIVISION 27 AND 28 FOR TELECOMMUNICATIONS PATHWAYS AND OTHER REQUIREMENTS TO BE PROVIDED BY DIVISION 28.
4	PROVIDE PULL WIRES IN ALL EMPTY CONDUITS.

**Salas O'Brien**  
 salesobrien.com 281-664-1900  
 Houston, TX 77064  
 10930 W. Sam Houston Pkwy North, Suite 900  
 Houston, TX 77064  
 Registration: F-4111  
 Project No: 2024-00209-00

LINE TYPE LEGEND	
	EXISTING TO REMAIN
	DISCONNECT AND REMOVE
	NEW WORK

DEMOLITION / EXISTING DRAWINGS ARE BASED ON CASUAL FIELD OBSERVATION, AND WHEN AVAILABLE, EXISTING RECORD DOCUMENTS. REPORT DISCREPANCIES TO ARCHITECT BEFORE DISTURBING EXISTING INSTALLATION, AND IMMEDIATELY AFTER SUCH DISCREPANCIES ARE DISCOVERED. CONTRACTOR TO VERIFY EXISTING CONDITIONS ON FIELD AND NOTIFY ENGINEER IF THERE ARE ANY CONFLICTS BETWEEN EXISTING CONDITIONS AND DRAWINGS PRIOR TO COMMENCEMENT OF WORK. CONTRACTOR SHALL REMOVE SUCH EXISTING WORK AS CALLED FOR ON THE DRAWINGS OR AS REQUIRED TO CLEAR THE AREAS OF NEW CONSTRUCTION.

OWNER OR ITS REPRESENTATIVE SHALL HAVE FIRST RIGHT OF REFUSAL ON ALL EQUIPMENT BEING REMOVED FROM THIS PROJECT. CONTRACTOR TO NOTIFY CAREY RAMSEY WITH DISTRICT PRIOR TO DEMOLITION WORK TO DISCUSS ALL RETURNED ITEMS TO DISTRICT.

**NATEX CORPORATION ARCHITECTS**  
 www.natearchitects.com  
 447 Heights Boulevard  
 Houston, TX 77007  
 Phone: 713-975-9525  
 Fax: 713-780-7824

**Coleman Partners ARCHITECTS**  
 www.cpa.com  
 3701 Kirby Drive, Suite 830  
 Houston, TX 77098  
 tel: 832.947.1038 fax: 282.214.5365

**CONSTRUCTION DOCUMENT**

**BRADLEY KALMANS**  
 80219  
 CENSUS  
 02-11-2025


**CIVIL ENGINEER**  
**BROOKS AND SPARKS, INC.**  
 21020 PARK ROW  
 KATY, TX 77449  
 tel: 281.578.9595

**STRUCTURAL ENGINEER**  
**DALLY + ASSOCIATES, INC.**  
 9800 RICHMOND AVE.  
 SUITE 400  
 HOUSTON, TX 77042  
 tel: 713.337.8881


**MEPT ENGINEER**  
**SALAS O'BRIEN**  
 10930 W. SAM HOUSTON PKWY. N.  
 SUITE 900  
 HOUSTON, TX 77064  
 tel: 281.664.1900

**FOOD SERVICE EQUIPMENT**  
**FDP**  
 25317 INTERSTATE 45  
 THE WOODLANDS, TX 77380  
 tel: 281.350.2323

**LANDSCAPE ARCHITECT**  
**LANDESIGN GROUP**  
 17041 EL CAMINO REAL  
 SUITE 204  
 HOUSTON, TX 77058  
 tel: 281.486.4040

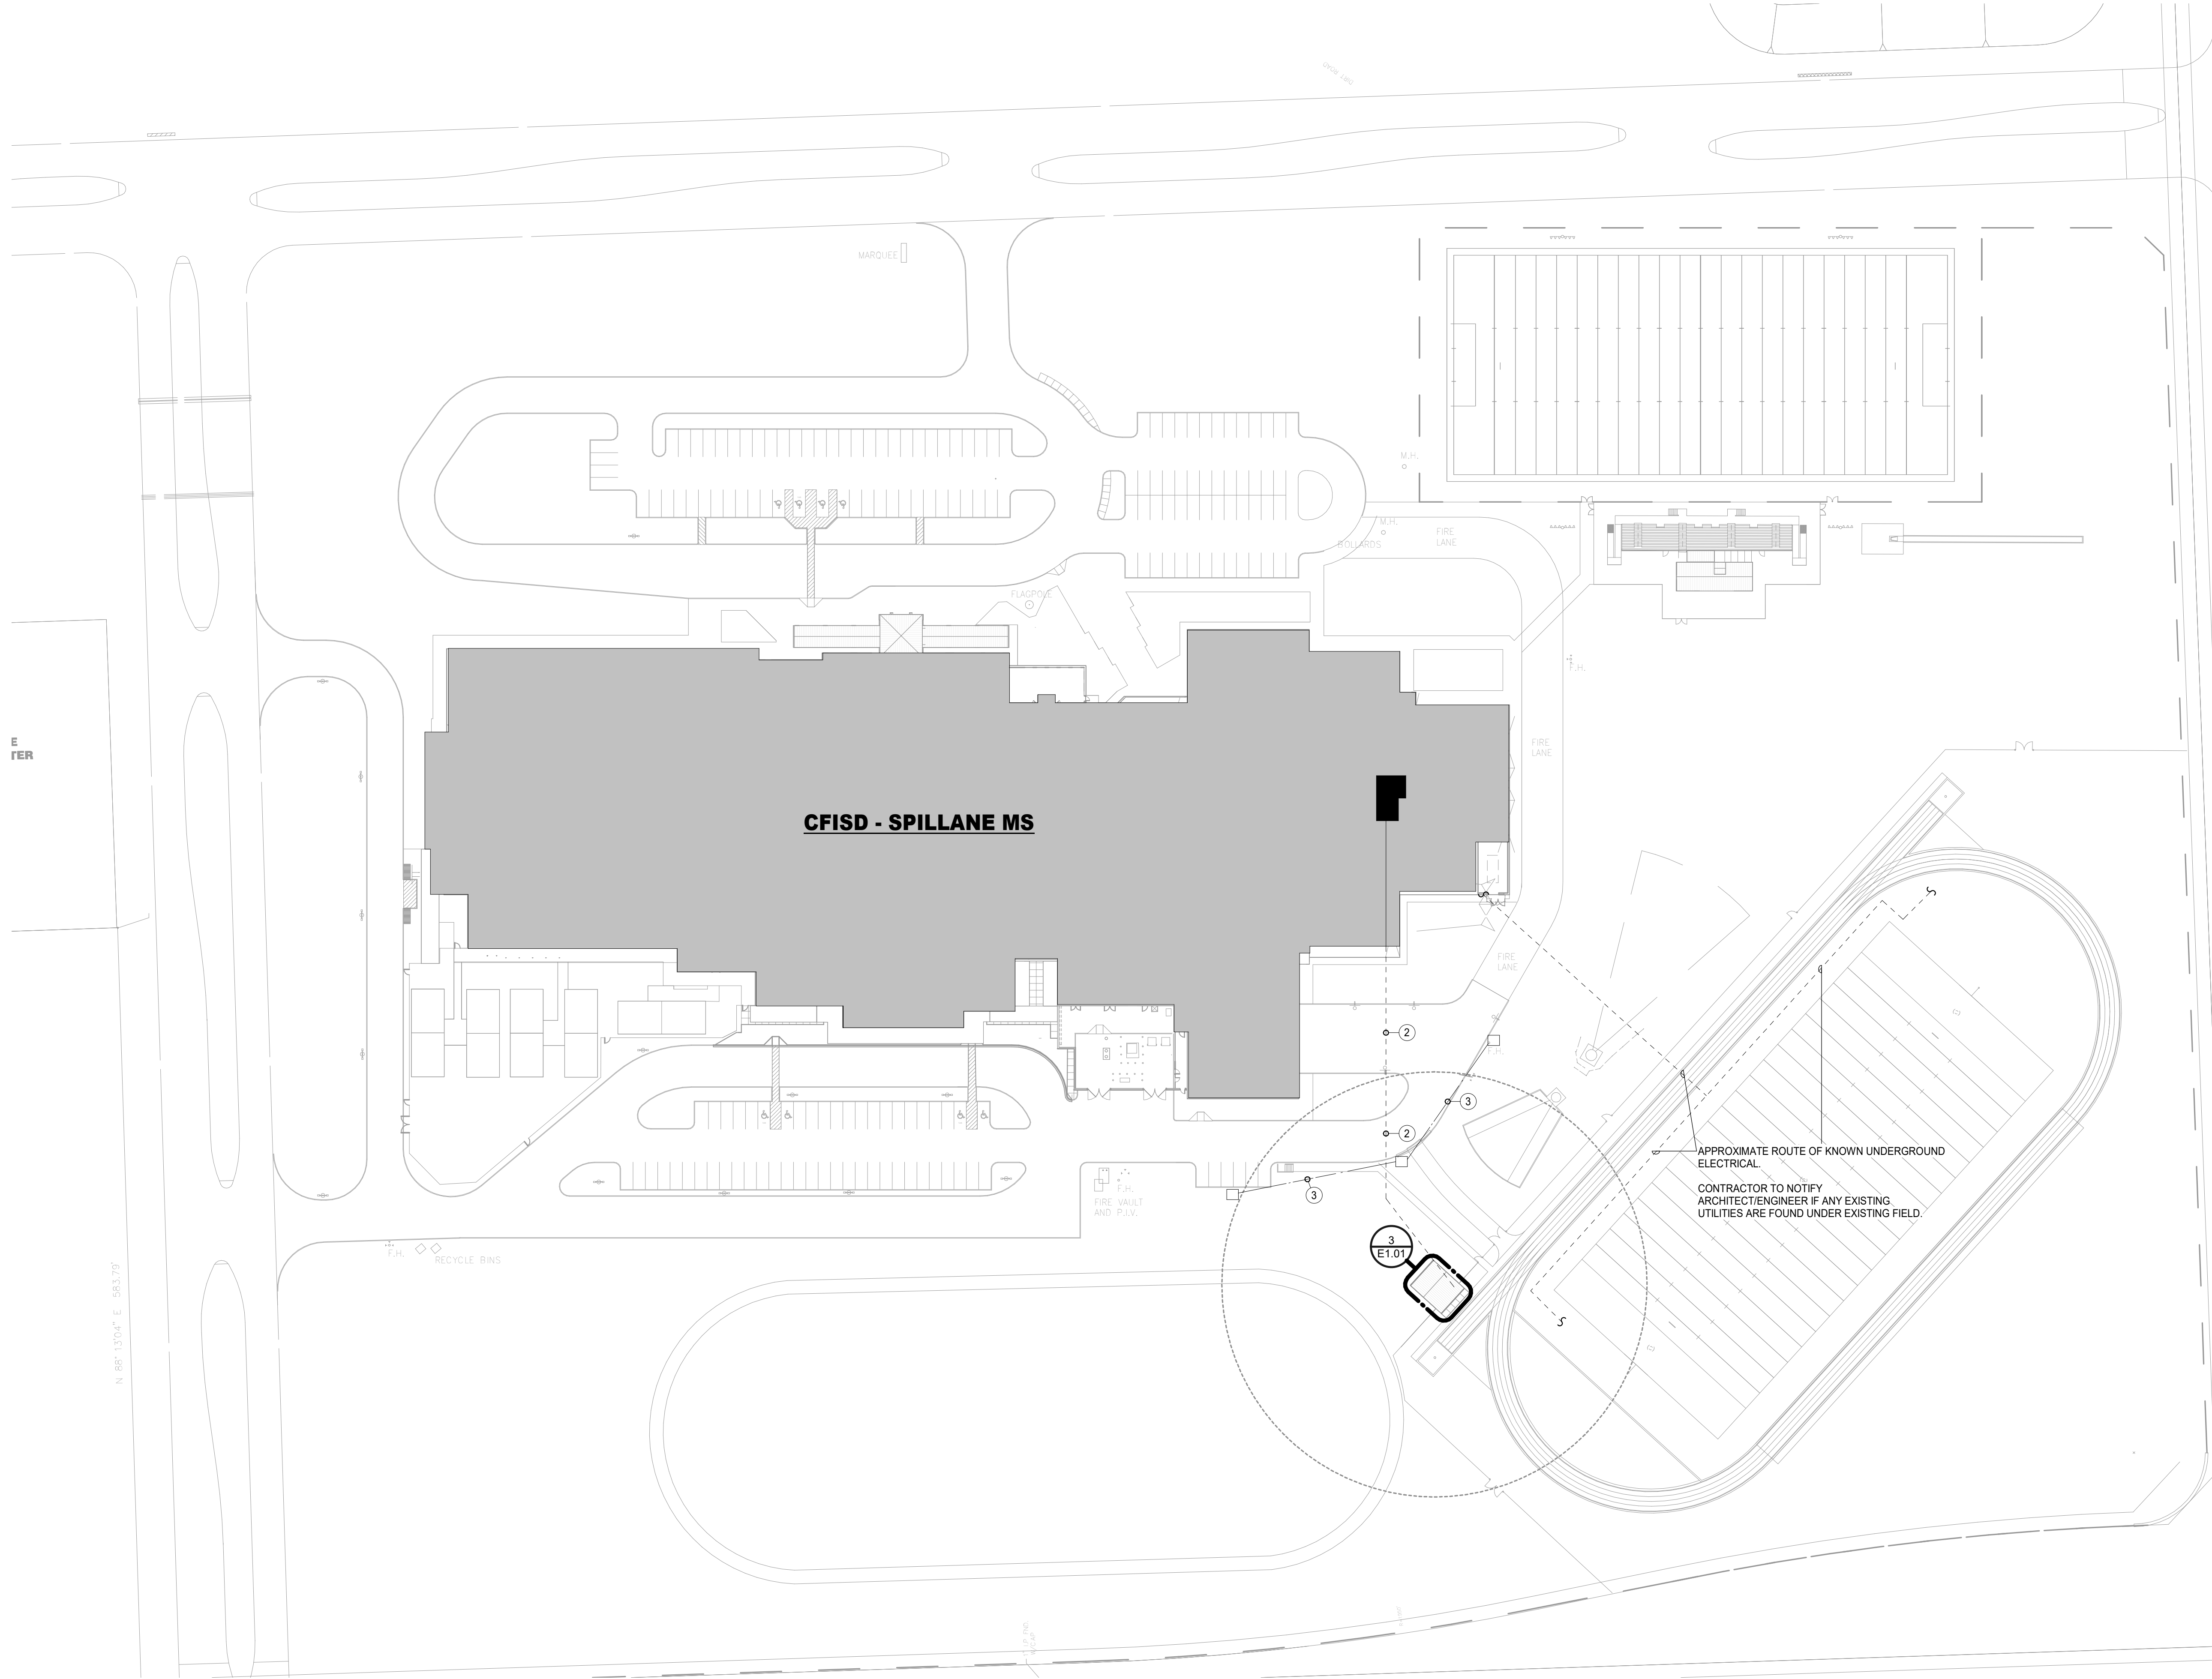

**1 ELECTRICAL SITE PLAN**  
 Scale: 1" = 60'-0"

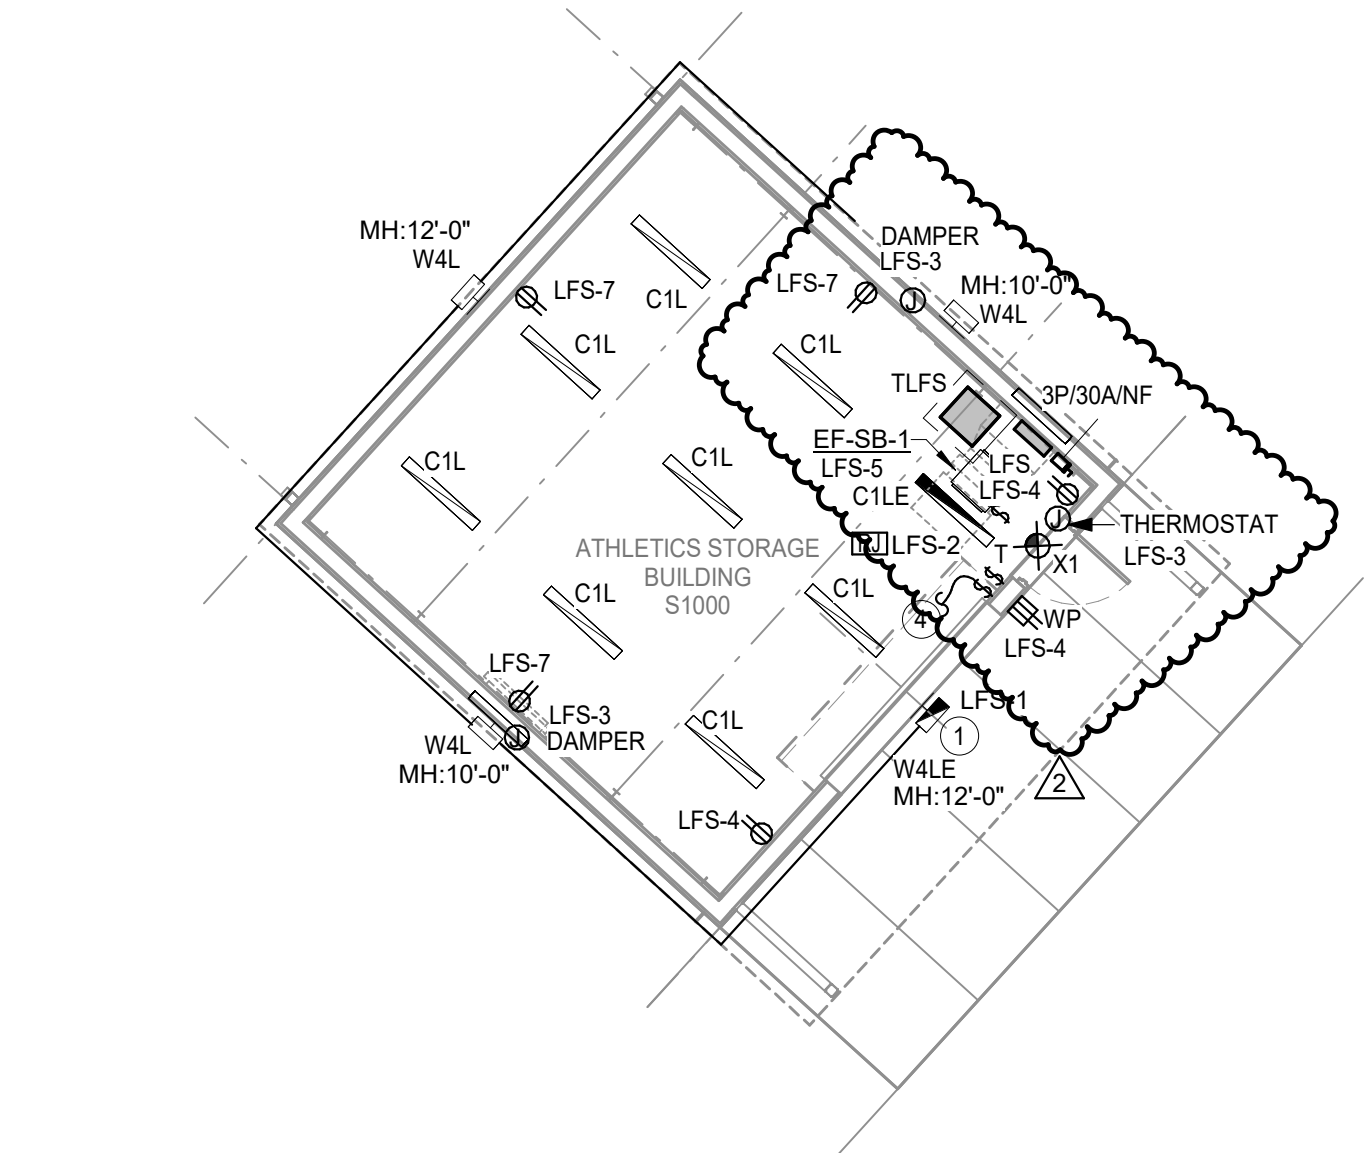

**3 ELECTRICAL FLOOR PLAN - FIELD STORAGE**  
 Scale: 1/8" = 1'-0"

**2024 SMITH & SPILLANE MS RENOVATIONS**  
**SPILLANE MIDDLE SCHOOL**  
 13403 WOODS-SPILLANE BLVD, CYPRESS, TX 77429  
 CFISD PROJECT NO: 24-02-5751-R-RFP

Revision / Submission	Date
2	02-14-25
1	01-28-25

Project Number: 23073  
 Date: 26 JANUARY 2025  
 Drawn By: WHL / KLO



ELECTRICAL KEYED NOTES	
1	LOCATE DIGITAL LIGHTING CONTROLLER AND IF SHOWN, PLENUM RATED, EMERGENCY LOAD CONTROL RELAY / TRANSFER SWITCH ABOVE ACCESSIBLE CEILING IN CORRIDOR / ANCILLARY SPACE DIRECTLY OUTSIDE OF ENTRY DOOR. PROVIDE LABEL IDENTIFYING ASSOCIATED SPACE. GRID MARKERS WITH WORDING PER SPECIFICATIONS. REFER TO DETAILS.
2	LOCATE DIGITAL LIGHTING CONTROLLER AND IF SHOWN, PLENUM RATED, EMERGENCY LOAD CONTROL RELAY / TRANSFER SWITCH WALL MOUNTED ADJACENT TO NORMAL POWER PANEL. PROVIDE LABEL IDENTIFYING ASSOCIATED SPACE WITH WORDING PER SPECIFICATIONS. REFER TO DETAILS.
3	INTERCEPT EXISTING NORMAL POWER CIRCUIT HOME RUN AND PROVIDE PER CIRCUIT (1) LISTED UL1008 TRANSFER SWITCH (1) CONTACTOR WITH POLE QUANTITY AS REQUIRED CONTROLLED WITH BMCS. LOCATE ADJACENT TO NORMAL POWER PANEL SERVING THE LOAD. RE-USE EXISTING NORMAL POWER CIRCUIT AND NEW EMERGENCY POWER CIRCUIT AS SHOWN. EXTEND CONDUCTORS / CONDUIT WITH MATCHING SIZE. REFER TO SPECIFICATIONS AND DETAIL SHEETS.

**Salas O'Brien**  
 salesobrien.com 281-664-1900  
 10930 W. Sam Houston Pkwy North, Suite 900  
 Houston, TX 77064  
 Registration: F-4111  
 Project No: 2024-0029-00

LINE TYPE LEGEND	
	EXISTING TO REMAIN
	DISCONNECT AND REMOVE
	NEW WORK


CONTRACTOR TO FIELD COORDINATE FINAL LOCATION OF ALL REPLACEMENT AND NEW LIGHTING FIXTURES WITH EXISTING CEILING MOUNTED DEVICES. AND TO NOTIFY ENGINEER IF THERE ARE ANY CONFLICTS BETWEEN EXISTING CONDITIONS AND THE NEW LIGHTING LAYOUT PRIOR TO COMMENCEMENT OF WORK.

PROVIDE NEW LIGHTING DEVICES AND SWITCH BOX EXTENSIONS IN ALL AREAS WHERE GYPSUM BOARD OR OTHER WALL COVERING ADDS TO THE THICKNESS OF WALLS. SEE ARCHITECTURAL DRAWINGS FOR AREAS AFFECTED.

PROVIDE (1) MOMENTARY BMCS OVERRIDE TIME-OUT SWITCH FOR BUILDING OCCUPIED/UNOCCUPIED ADJACENT TO OR IN THE BMCS MASTER PANEL, (1) MOMENTARY BMCS OVERRIDE TIME-OUT SWITCH FOR EXTERIOR FACADE LIGHTING ON/OFF AND (1) MOMENTARY BMCS OVERRIDE TIME-OUT SWITCH FOR PARKING LOT LIGHTING ON/OFF IN MAIN ELECTRICAL.


**LIGHTING GENERAL NOTES**

- CONNECT NEW LIGHT FIXTURES TO EXISTING NORMAL POWER CIRCUITS LEFT IN PLACE AFTER DEMOLITION OR NEW AS SHOWN. PROVIDE EMERGENCY CIRCUIT FOR HATCHED FIXTURES AND/OR EXIT SIGNS. EXTEND WIRING WITH MATCHING CONDUCTORS / CONDUIT TO PROVIDE LOCATION AND/OR NEW FIXTURES. FIELD VERIFY CONNECTED LOAD NOT TO EXCEED 3500 W @ 277V, TYPICAL.
- LOCATION OF NEW / REPLACEMENT LIGHT FIXTURES SHALL RE-USE EXISTING J-BOX AND EXISTING LIGHT FIXTURE WHIPS AS PRACTICAL. EXTEND WIRING WITH MATCHING CONDUCTORS / CONDUIT AND PROVIDE NEW J-BOX ABOVE ACCESSIBLE CEILING WITH 1/2-INCH FLEXIBLE STEEL CONDUIT OR STEEL MC CABLE. LENGTH NOT TO EXCEED 6-FEET. "DAISY CHAINING" LIGHT FIXTURES INSTALLED FOR LAY-UP CEILING AREAS IS NOT ALLOWED. FOR NON-ACCESSIBLE CEILINGS, LIGHT FIXTURE WHIPS SHALL BE 1/2-INCH FLEXIBLE STEEL CONDUIT. LENGTH AS REQUIRED TO MAKE A TAP AT AN ACCESSIBLE J-BOX. RECESSED LIGHT FIXTURES IN NON-ACCESSIBLE CEILINGS MAY BE DAISY CHAINED USING THE LIGHT FIXTURE'S INTEGRAL, UL LISTED J-BOX OR INTERNAL WIRE WAY THAT IS ACCESSIBLE THROUGH FIXTURE FROM BELOW THE CEILING. REFER TO 26 05 33 CONDUIT SYSTEMS.
- PROVIDE NEW LIGHTING CONTROLS, SENSORS AND ASSOCIATED DEVICES. 20A EMERGENCY LOAD CONTROL RELAYS AND/OR TRANSFER SWITCHES. REFER TO SPECIFICATIONS AND DETAIL SHEETS.
- LOCATE DIGITAL LIGHTING CONTROLLER AND / OR EMERGENCY LOAD CONTROL RELAY ABOVE ACCESSIBLE CEILING 12-FEET AFF OR BELOW ADJACENT TO SWITCH CONTROLLING THE SPACE. IN NON-ACCESSIBLE AND / OR HIGH CEILING AREAS, LOCATE DIGITAL LIGHTING CONTROLLER IN ADJACENT ANCILLARY AREA WITH ACCESSIBLE CEILING. IN AREAS WITH NO CEILING AND / OR IN EXTERIOR APPLICATIONS LOCATE ADJACENT TO PANEL SERVING THE LOAD. PROVIDE PLASTIC TAPE MACHINE TYPED NAME PLATE TO BOTTOM OF CEILING T-GRID BELOW RELAY LOCATION. WHITE LETTERS ON BLACK BACKGROUND WITH 1/4" HIGH LETTERS ON 1/2" TALL LABEL FOR DIGITAL MODULE. INDICATE AS: DLM.
- LOCATE DIGITAL LIGHTING CONTROLLER FOR CORRIDORS, GYM AND HIGH CEILING AREAS WITH NO ADJACENT ANCILLARY AREA ADJACENT TO NORMAL POWER PANEL SERVING THE LOAD. PROVIDE LABEL, GRID MARKERS WITH WORDING PER SPECIFICATIONS.
- LOCATE DIGITAL LIGHTING CONTROLLER FOR INSTRUTIONAL SPACES AND OFFICES ABOVE ACCESSIBLE CEILING IN CORRIDOR DIRECTLY OUTSIDE OF ENTRY DOOR. PROVIDE LABEL IDENTIFYING ASSOCIATED SPACE. GRID MARKERS WITH WORDING PER SPECIFICATIONS.
- OCCUPANCY/VACANCY SENSOR AND DAYLIGHTING SENSOR LOCATIONS INDICATE SPACE OR AREA CONTROLLED. CONTRACTOR TO PROVIDE ACTUAL QUANTITIES, TYPES, AND MOUNTING LOCATIONS AS RECOMMENDED BY MANUFACTURER AND IECC-2015 C405.
- SPACES WITH MULTIPLE OCCUPANCY/VACANCY SENSORS OR WHERE LINE OF SIGHT MAY BE OBSCURED SHALL BE LINKED TOGETHER FOR SIMULTANEOUS OPERATION WITHIN THE SPACE.
- CONTRACTOR SHALL MAINTAIN CONSTANT UNSWITCHED CIRCUITS FROM EXISTING SOURCE AND/OR NEW AS SHOWN FOR EMERGENCY FIXTURES, EMERGENCY LOAD RELAYS, TRANSFER SWITCHES AND EXIT SIGNS.
- COORDINATE LOCATION OF LIGHT FIXTURES IN ALL MECHANICAL AND ELECTRICAL ROOMS WITH MECHANICAL EQUIPMENT, PIPING, AND ALL OTHER TRADES.
- PROVIDE SEPARATE RACEWAY SYSTEMS FOR LIGHTING CONTROL SYSTEM. CONTROL SYSTEMS WIRING (DIMMERS OR OTHERWISE) SHALL NOT BE INSTALLED IN THE SAME RACEWAY AS LINE VOLTAGE. REFER TO 26 05 33.

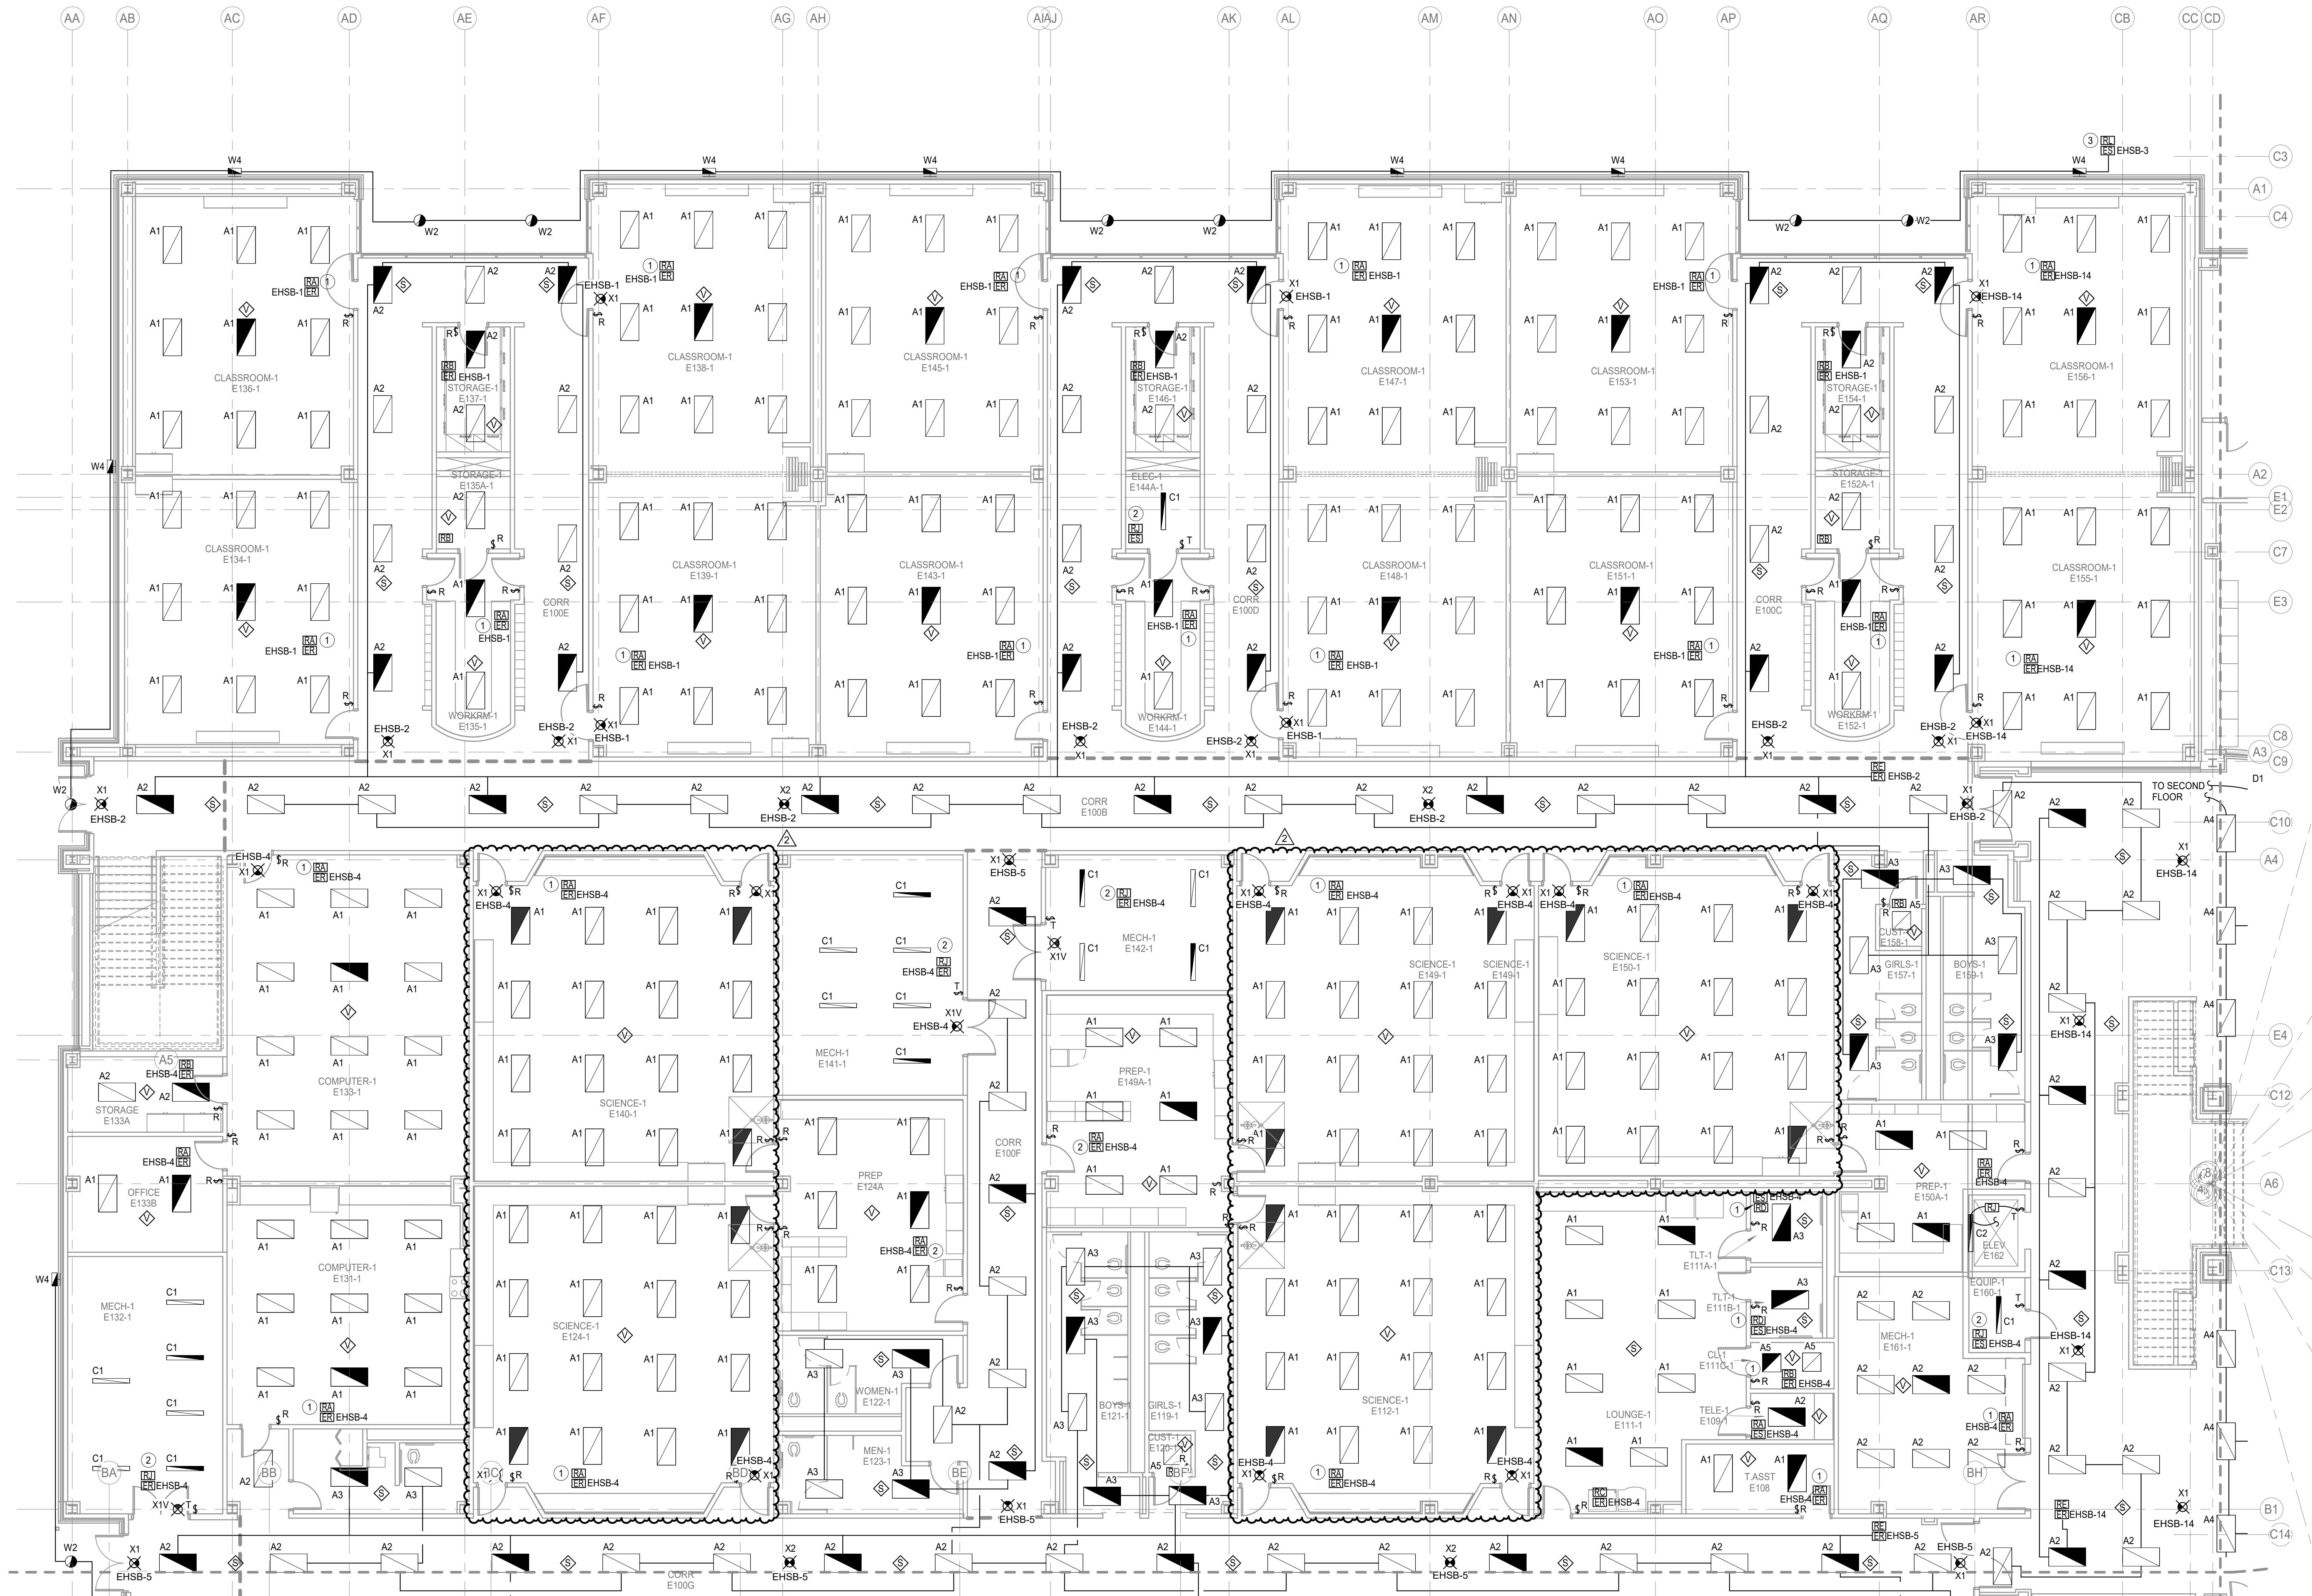

**1 ELECTRICAL LIGHTING FLOOR PLAN - LEVEL 1 - AREA A**  
 Scale: 1/8" = 1'-0"

KEY PLAN:  
 Project Number: 23073  
 Date: 26 JANUARY 2025  
 Drawn By: WHL / KLO

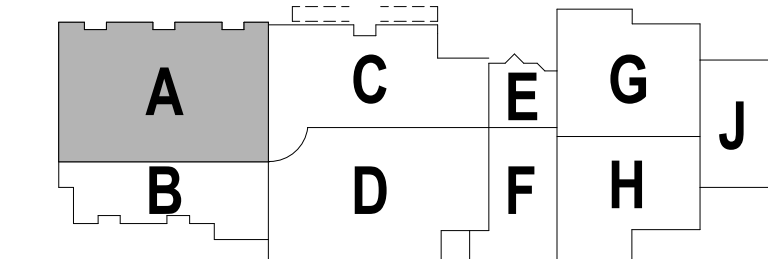

**NATEX CORPORATION ARCHITECTS**  
 www.natearchitects.com  
 447 Heights Boulevard  
 Houston, TX 77007  
 Phone: 713-975-9525  
 Fax: 713-780-7824

**Coleman Partners ARCHITECTS**  
 architects.com  
 3701 Kirby Drive, Suite 830  
 Houston, TX 77098  
 Tel: 832-947-1038 fax: 282-214-5365

CONSTRUCTION DOCUMENT  
 02-11-2025

**CIVIL ENGINEER BROOKS AND SPARKS, INC.**  
 21020 PARK ROW  
 KATY, TX 77449  
 tel: 281-578-9595

**STRUCTURAL ENGINEER DALLY + ASSOCIATES, INC.**  
 9800 RICHMOND AVE.  
 SUITE 400  
 HOUSTON, TX 77042  
 tel: 713-337-8881

**SEPT ENGINEER SALAS O'BRIEN**  
 10930 W. SAM HOUSTON PKWY. N.  
 SUITE 900  
 HOUSTON, TX 77064  
 tel: 281-664-1900

**FOOD SERVICE EQUIPMENT FDP**  
 25317 INTERSTATE 45  
 THE WOODLANDS, TX 77380  
 tel: 281-350-2323

**LANDSCAPE ARCHITECT LANDSCAPE GROUP**  
 17041 EL CAMINO REAL  
 SUITE 204  
 HOUSTON, TX 77058  
 tel: 281-486-4040

**2024 SMITH & SPILLANE MS RENOVATIONS**  
**SPILLANE MIDDLE SCHOOL**  
 13403 WOODS-SPILLANE BLVD, CYPRESS, TX 77429  
 CFSID PROJECT NO: 24-02-5751-R-RFP

Revision	Description
2	Addendum 03 02-14-25
1	Revisions / Submission

Project Number: 23073  
 Date: 26 JANUARY 2025  
 Drawn By: WHL / KLO

ELECTRICAL LIGHTING  
 FIRST FLOOR PLAN -  
 AREA 'A'

**E2.01**

ELECTRICAL KEYED NOTES	
1	LOCATE DIGITAL LIGHTING CONTROLLER AND IF SHOWN, PLENUM RATED, EMERGENCY LOAD CONTROL RELAY / TRANSFER SWITCH ABOVE ACCESSIBLE CEILING IN CORRIDOR / ANCILLARY SPACE DIRECTLY OUTSIDE OF ENTRY DOOR. PROVIDE LABEL IDENTIFYING ASSOCIATED SPACE. GRID MARKERS WITH WORDING PER SPECIFICATIONS. REFER TO DETAILS.
2	LOCATE DIGITAL LIGHTING CONTROLLER AND IF SHOWN, PLENUM RATED, EMERGENCY LOAD CONTROL RELAY / TRANSFER SWITCH WALL MOUNTED ADJACENT TO NORMAL POWER PANEL. PROVIDE LABEL IDENTIFYING ASSOCIATED SPACE WITH WORDING PER SPECIFICATIONS. REFER TO DETAILS.

**Salas O'Brien**  
 salesobrien.com 281-664-1900  
 Houston  
 18930 W. Sam Houston Pkwy North, Suite 900  
 Houston, TX 77064  
 Registration: F-4111  
 Project No: 2024-0209-00

LINE TYPE LEGEND	
	EXISTING TO REMAIN
	DISCONNECT AND REMOVE
	NEW WORK


CONTRACTOR TO FIELD COORDINATE FINAL LOCATION OF ALL REPLACEMENT AND NEW LIGHTING FIXTURES WITH EXISTING CEILING MOUNTED DEVICES. AND TO NOTIFY ENGINEER IF THERE ARE ANY CONFLICTS BETWEEN EXISTING CONDITIONS AND THE NEW LIGHTING LAYOUT PRIOR TO COMMENCEMENT OF WORK.

PROVIDE NEW LIGHTING DEVICES AND SWITCH BOX EXTENSIONS IN ALL AREAS WHERE GYPSUM BOARD OR OTHER WALL COVERINGS ADDS TO THE THICKNESS OF WALLS. SEE ARCHITECTURAL DRAWINGS FOR AREAS AFFECTED.

PROVIDE (1) MOMENTARY BMCS OVERRIDE TIME-OUT SWITCH FOR BUILDING OCCUPIED/UNOCCUPIED ADJACENT TO OR IN THE BMCS MASTER PANEL; (1) MOMENTARY BMCS OVERRIDE TIME-OUT SWITCH FOR EXTERIOR FACADE LIGHTING ON/OFF AND (1) MOMENTARY BMCS OVERRIDE TIME-OUT SWITCH FOR PARKING LOT LIGHTING ON/OFF IN MAIN ELECTRICAL.

**LIGHTING GENERAL NOTES**

- CONNECT NEW LIGHT FIXTURES TO EXISTING NORMAL POWER CIRCUITS LEFT IN PLACE AFTER DEMOLITION OR NEW AS SHOWN. PROVIDE EMERGENCY CIRCUIT FOR HATCHED FIXTURES AND/OR EXIT SIGNS. EXTEND WIRING WITH MATCHING CONDUCTORS / CONDUIT TO EXISTING LOCATION AND/OR NEW FIXTURES. FIELD VERIFY CONNECTED LOAD NOT TO EXCEED 3500 W @ 277V, TYPICAL.
- LOCATION OF NEW / REPLACEMENT LIGHT FIXTURES SHALL RE-USE EXISTING J-BOX AND EXISTING LIGHT FIXTURE WHIPS AS PRACTICAL. EXTEND WIRING WITH MATCHING CONDUCTORS / CONDUIT AND PROVIDE NEW J-BOX ABOVE ACCESSIBLE CEILING WITH 1/2-INCH FLEXIBLE STEEL CONDUIT OR STEEL MC CABLE, LENGTH NOT TO EXCEED 6-FEET. "DAISY CHAINING" LIGHT FIXTURES INSTALLED FOR LAY-IN CEILING AREAS IS NOT ALLOWED. FOR NON-ACCESSIBLE CEILINGS, LIGHT FIXTURE WHIPS SHALL BE 1/2-INCH FLEXIBLE STEEL CONDUIT, LENGTH AS REQUIRED TO MAKE A TAP AT AN ACCESSIBLE J-BOX. RECESSED LIGHT FIXTURES IN NON-ACCESSIBLE CEILINGS MAY BE DAISY CHAINED USING THE LIGHT FIXTURE'S INTEGRAL, UL LISTED J-BOX OR INTERNAL WIRE WAY THAT IS ACCESSIBLE THROUGH FIXTURE FROM BELOW THE CEILING. REFER TO 26 05 33 CONDUIT SYSTEMS.
- PROVIDE NEW LIGHTING CONTROLS, SENSORS AND ASSOCIATED DEVICES. 20A EMERGENCY LOAD CONTROL RELAYS AND/OR TRANSFER SWITCHES. REFER TO SPECIFICATIONS AND DETAIL SHEETS.
- LOCATE DIGITAL LIGHTING CONTROLLER AND / OR EMERGENCY LOAD CONTROL RELAY ABOVE ACCESSIBLE CEILING 12-FEET AFF OR BELOW ADJACENT TO SWITCH CONTROLLING THE SPACE. IN NON-ACCESSIBLE AND / OR HIGH CEILING AREAS, LOCATE DIGITAL LIGHTING CONTROLLER IN ADJACENT ANCILLARY AREA WITH ACCESSIBLE CEILING. IN AREAS WITH NO CEILING AND / OR IN EXTERIOR APPLICATIONS LOCATE ADJACENT TO PANEL SERVING THE LOAD. PROVIDE PLASTIC TAPE MACHINE TYPED NAME PLATE TO BOTTOM OF CEILING T-GRID BELOW RELAY LOCATION. WHITE LETTERS ON BLACK BACKGROUND WITH 1/4" HIGH LETTERS ON 1/2" TALL LABEL FOR DIGITAL MODULE. INDICATE AS: DLM.
- LOCATE DIGITAL LIGHTING CONTROLLER FOR CORRIDORS, GYM AND HIGH CEILING AREAS WITH NO ADJACENT ANCILLARY AREA ADJACENT TO NORMAL POWER PANEL SERVING THE LOAD. PROVIDE LABEL, GRID MARKERS WITH WORDING PER SPECIFICATIONS.
- LOCATE DIGITAL LIGHTING CONTROLLER FOR INSTRUMENTAL SPACES AND OFFICES ABOVE ACCESSIBLE CEILING IN CORRIDOR DIRECTLY OUTSIDE OF ENTRY DOOR. PROVIDE LABEL IDENTIFYING ASSOCIATED SPACE. GRID MARKERS WITH WORDING PER SPECIFICATION.
- OCCUPANCY/VACANCY SENSOR AND DAYLIGHTING SENSOR LOCATIONS INDICATE SPACE OR AREA CONTROLLED. CONTRACTOR TO PROVIDE ACTUAL QUANTITIES, TYPES, AND MOUNTING LOCATIONS AS RECOMMENDED BY MANUFACTURER AND IECC-2015 C405.
- SPACES WITH MULTIPLE OCCUPANCY/VACANCY SENSORS OR WHERE LINE OF SIGHT MAY BE OBSCURED SHALL BE LINKED TOGETHER FOR SIMULTANEOUS OPERATION WITHIN THE SPACE.
- CONTRACTOR SHALL MAINTAIN CONSTANT UNSWITCHED CIRCUITS FROM EXISTING SOURCE AND/OR NEW AS SHOWN FOR EMERGENCY FIXTURES, EMERGENCY LOAD RELAYS, TRANSFER SWITCHES AND EXIT SIGNS.
- COORDINATE LOCATION OF LIGHT FIXTURES IN ALL MECHANICAL AND ELECTRICAL ROOMS WITH MECHANICAL EQUIPMENT, PIPING, AND ALL OTHER TRADES.
- PROVIDE SEPARATE RACEWAY SYSTEMS FOR LIGHTING CONTROL SYSTEM. CONTROL'S WIRING (DIMMERS OR OTHERWISE) SHALL NOT BE INSTALLED IN THE SAME RACEWAY AS LINE VOLTAGE. REFER TO 26 05 33.

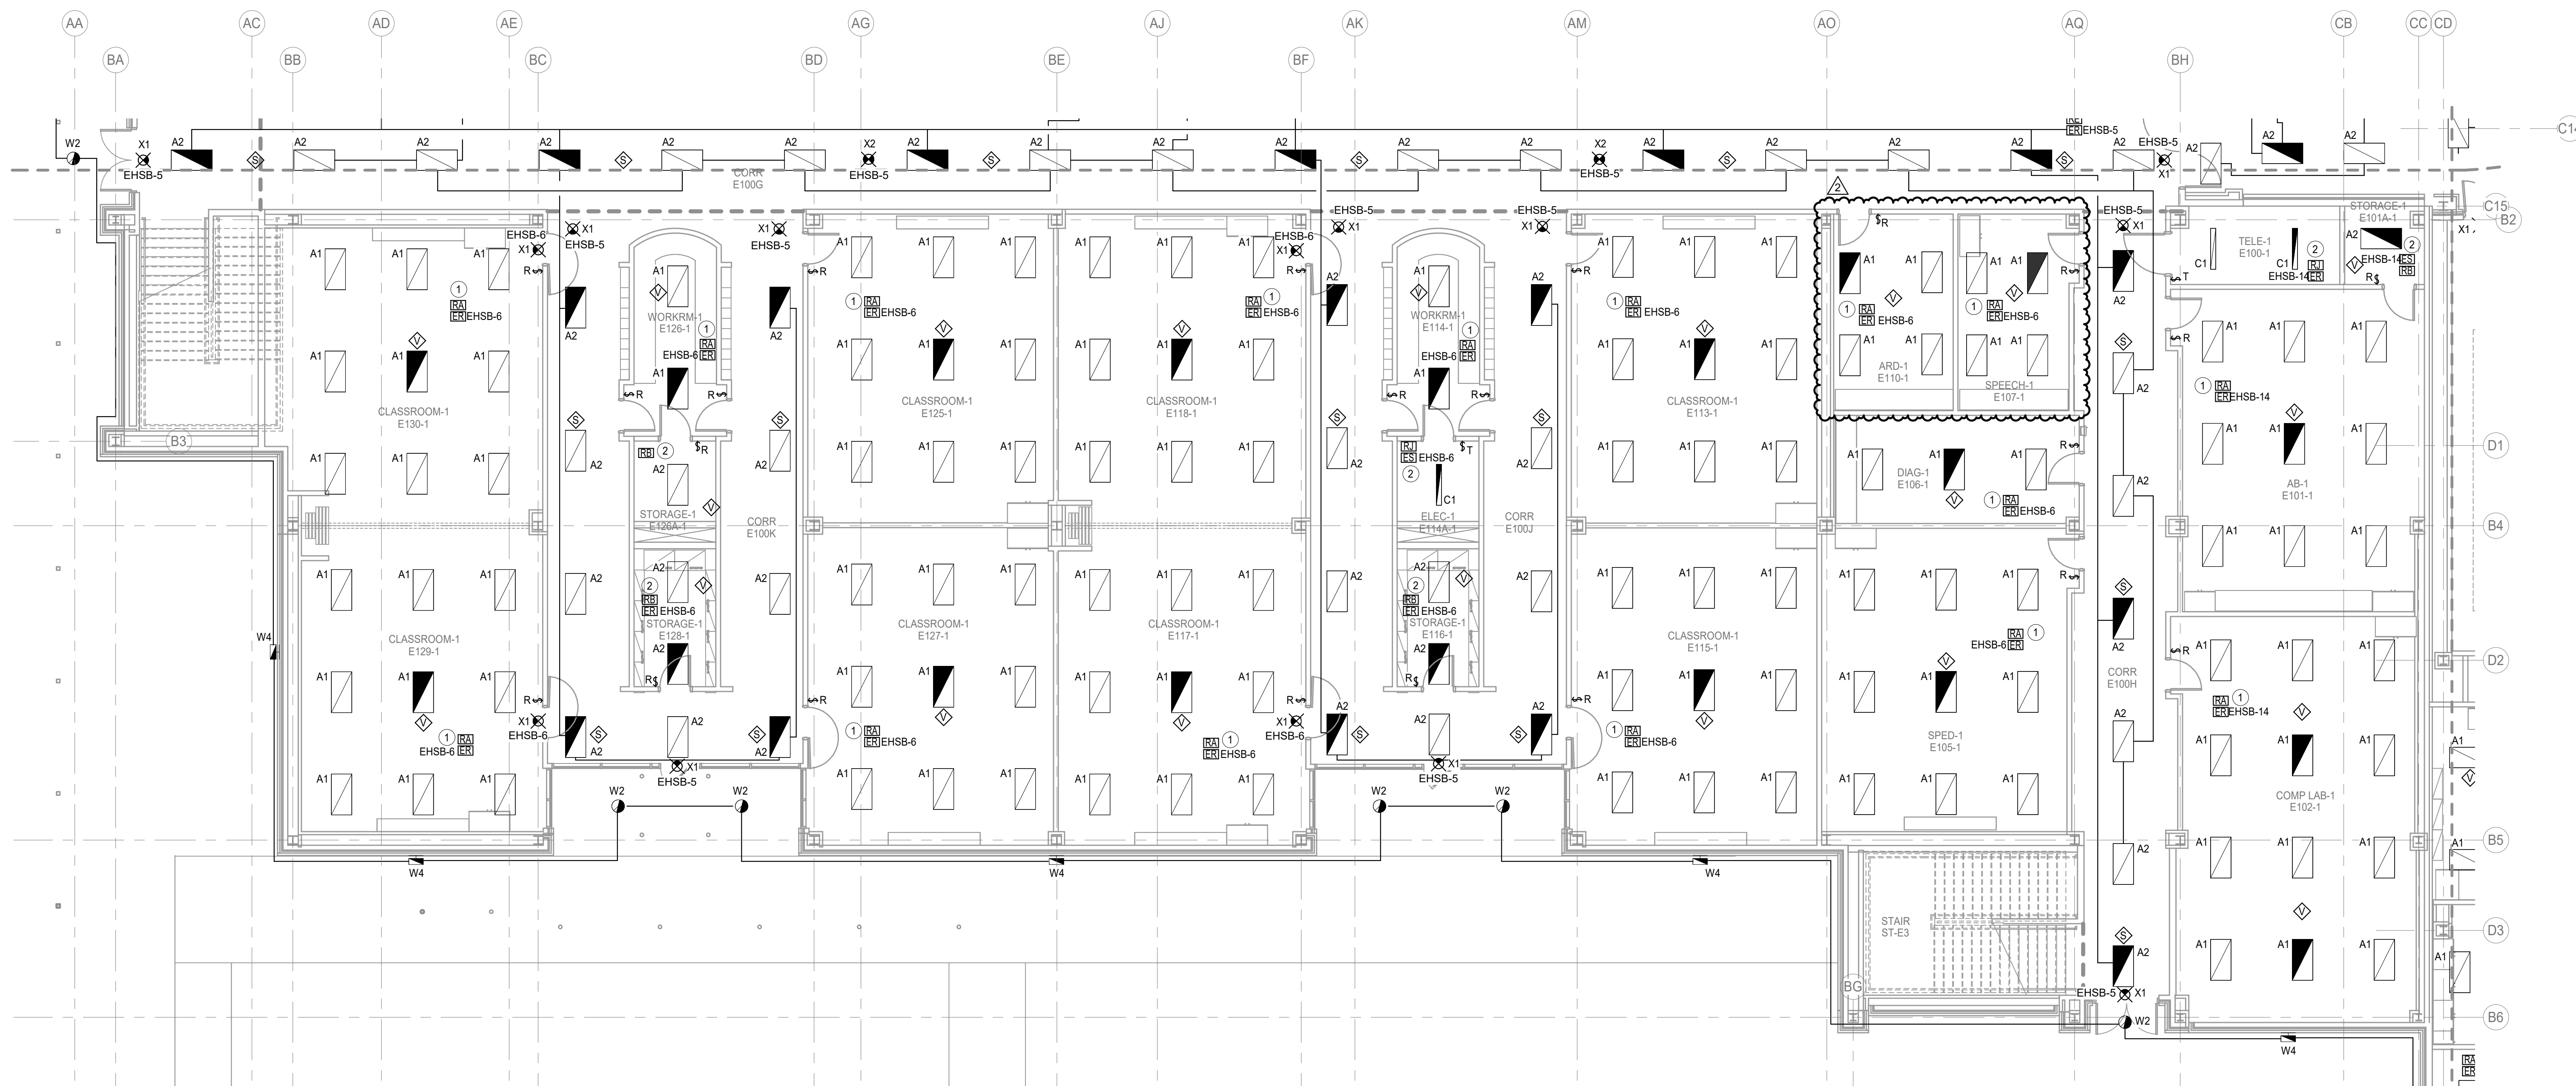

**1 ELECTRICAL LIGHTING FLOOR PLAN - LEVEL 1 - AREA B**  
 Scale: 1/8" = 1'-0"

KEY PLAN:

**NATEX**  
 CORPORATION ARCHITECTS  
 www.nateearchitects.com  
 447 Heights Boulevard  
 Houston, TX 77007  
 Phone: 713-975-9525  
 Fax: 713-780-7824

**Coleman Partners**  
 ARCHITECTS  
 3701 Kirby Drive, Suite 830  
 Houston, TX 77098  
 Tel: 832-947-1038 Fax: 281-214-5365

**CONSTRUCTION DOCUMENT**

**CIVIL ENGINEER**  
**BROOKS AND SPARKS, INC.**  
 21020 PARK ROW  
 KATY, TX 77449  
 Tel: 281-578-9595

**STRUCTURAL ENGINEER**  
**DALLY + ASSOCIATES, INC.**  
 9800 RICHMOND AVE.  
 SUITE 400  
 HOUSTON, TX 77042  
 Tel: 713-337-8881

**MEPT ENGINEER**  
**SALAS O'BRIEN**  
 10930 W. SAM HOUSTON PKWY. N.  
 SUITE 900  
 HOUSTON, TX 77064  
 Tel: 281.664.1900

**FOOD SERVICE EQUIPMENT**  
**FDP**  
 25317 INTERSTATE 45  
 THE WOODLANDS, TX 77380  
 Tel: 281-350-2323

**LANDSCAPE ARCHITECT**  
**LANDESIGN GROUP**  
 17041 EL CAMINO REAL  
 SUITE 204  
 HOUSTON, TX 77058  
 Tel: 281.486.4040

**2024 SMITH & SPILLANE MS RENOVATIONS**  
**SPILLANE MIDDLE SCHOOL**  
 13403 WOODS-SPILLANE BLVD, CYPRESS, TX 77429  
 CFSID PROJECT NO: 24-02-5751-R-RFP

Revision	Submission
2	Addendum 03 02-14-25

Project Number: 23073  
 Date: 26 JANUARY 2025  
 Drawn By: WHL / KLO

**ELECTRICAL LIGHTING**  
**FIRST FLOOR PLAN -**  
**AREA 'B'**

**E2.02**



**LINE TYPE LEGEND**

	EXISTING TO REMAIN
	DISCONNECT AND REMOVE
	NEW WORK

CONTRACTOR TO FIELD COORDINATE FINAL LOCATION OF ALL REPLACEMENT AND NEW LIGHTING FIXTURES WITH EXISTING CEILING MOUNTED DEVICES AND TO NOTIFY ENGINEER IF THERE ARE ANY CONFLICTS BETWEEN EXISTING CONDITIONS AND THE NEW LIGHTING LAYOUT PRIOR TO COMMENCEMENT OF WORK.

PROVIDE NEW LIGHTING DEVICES AND SWITCH BOX EXTENSIONS IN ALL AREAS WHERE GYPSUM BOARD OR OTHER WALL COVERING EXISTS TO THE THICKNESS OF WALL. SEE ARCHITECTURAL DRAWINGS FOR AREAS AFFECTED.


PROVIDE (1) MOMENTARY BMCS OVERRIDE TIME-OUT SWITCH FOR BUILDING OCCUPIED/UNOCCUPIED ADJACENT TO OR IN THE BMCS MASTER PANEL, (1) MOMENTARY BMCS OVERRIDE TIME-OUT SWITCH FOR EXTERIOR FACADE LIGHTING ON/OFF AND (1) MOMENTARY BMCS OVERRIDE TIME-OUT SWITCH FOR PARKING LOT LIGHTING ON/OFF IN MAIN ELECTRICAL.

**LIGHTING GENERAL NOTES**

- CONNECT NEW LIGHT FIXTURES TO EXISTING NORMAL POWER CIRCUITS LEFT IN PLACE AFTER DEMOLITION OR NEW AS SHOWN. PROVIDE EMERGENCY CIRCUIT FOR HATCHED FIXTURES AND/OR EXIT SIGNS. EXTEND WIRING WITH MATCHING CONDUCTORS / CONDUIT TO EXISTING LOCATION AND/OR NEW FIXTURES. FIELD VERIFY CONNECTED LOAD NOT TO EXCEED 3500 W @ 277V. TYPICAL.
- LOCATION OF NEW / REPLACEMENT LIGHT FIXTURES SHALL RE-USE EXISTING J-BOX AND EXISTING LIGHT FIXTURE WHIPS AS PRACTICAL. EXTEND WIRING WITH MATCHING CONDUCTORS / CONDUIT AND PROVIDE NEW J-BOX ABOVE ACCESSIBLE CEILING WITH 1/2-INCH FLEXIBLE STEEL CONDUIT OR STEEL MC CABLE. LENGTH NOT TO EXCEED 6-FEET. "DAISY CHAINING" LIGHT FIXTURES INSTALLED FOR LAY-UP CEILING AREAS IS NOT ALLOWED. FOR NON-ACCESSIBLE CEILINGS, LIGHT FIXTURE WHIPS SHALL BE 1/2-INCH FLEXIBLE STEEL CONDUIT. LENGTH AS REQUIRED TO MAKE A TAP AT AN ACCESSIBLE J-BOX. RECESSED LIGHT FIXTURES IN NON-ACCESSIBLE CEILINGS MAY BE DAISY CHAINED USING THE LIGHT FIXTURE'S INTEGRAL, UL LISTED J-BOX OR INTERNAL WIRE WAY THAT IS ACCESSIBLE THROUGH FIXTURE FROM BELOW THE CEILING. REFER TO 26 05 33 CONDUIT SYSTEMS.
- PROVIDE NEW LIGHTING CONTROLS, SENSORS AND ASSOCIATED DEVICES. 20A EMERGENCY LOAD CONTROL RELAYS AND/OR TRANSFER SWITCHES. REFER TO SPECIFICATIONS AND DETAIL SHEETS.
- LOCATE DIGITAL LIGHTING CONTROLLER AND / OR EMERGENCY LOAD CONTROL RELAY ABOVE ACCESSIBLE CEILING 12-FEET AFF OR BELOW ADJACENT TO SWITCH CONTROLLING THE SPACE. IN NON-ACCESSIBLE AND / OR HIGH CEILING AREAS, LOCATE DIGITAL LIGHTING CONTROLLER AND / OR EMERGENCY LOAD CONTROL RELAY TO BOTTOM OF CEILING T-GRID BELOW RELAY LOCATION. WHITE LETTERS ON BLACK BACKGROUND WITH 1/4" HIGH LETTERS ON 1/2" TALL LABEL FOR DIGITAL MODULE. INDICATE AS: DLM.
- LOCATE DIGITAL LIGHTING CONTROLLER FOR CORRIDORS, GYM AND HIGH CEILING AREAS WITH NO ADJACENT ANCILLARY AREA ADJACENT TO NORMAL POWER PANEL SERVING THE LOAD. PROVIDE LABEL, GRID MARKERS WITH WORDING PER SPECIFICATIONS.
- LOCATE DIGITAL LIGHTING CONTROLLER FOR INSTRUCTIONAL SPACES AND OFFICES ABOVE ACCESSIBLE CEILING IN CORRIDOR DIRECTLY OUTSIDE OF ENTRY DOOR. PROVIDE LABEL IDENTIFYING ASSOCIATED SPACE. GRID MARKERS WITH WORDING PER SPECIFICATIONS.
- OCCUPANCY/VACANCY SENSOR AND DAYLIGHTING SENSOR LOCATIONS INDICATE SPACE OR AREA CONTROLLED. CONTRACTOR TO PROVIDE ACTUAL QUANTITIES, TYPES, AND MOUNTING LOCATIONS AS RECOMMENDED BY MANUFACTURER AND IECC-2015 C405.
- SPACES WITH MULTIPLE OCCUPANCY/VACANCY SENSORS OR WHERE LINE OF SIGHT MAY BE OBSCURED SHALL BE LINKED TOGETHER FOR SIMULTANEOUS OPERATION WITHIN THE SPACE.
- CONTRACTOR SHALL MAINTAIN CONSTANT UNSWITCHED CIRCUITS FROM EXISTING SOURCE AND/OR NEW AS SHOWN FOR EMERGENCY FIXTURES, EMERGENCY LOAD RELAYS, TRANSFER SWITCHES AND EXIT SIGNS.
- COORDINATE LOCATION OF LIGHT FIXTURES IN ALL MECHANICAL AND ELECTRICAL ROOMS WITH MECHANICAL EQUIPMENT, PIPING, AND ALL OTHER TRADES.
- PROVIDE SEPARATE RACEWAY SYSTEMS FOR LIGHTING CONTROL SYSTEM. CONTROL'S WIRING (DIMMERS OR OTHERWISE) SHALL NOT BE INSTALLED IN THE SAME RACEWAY AS LINE VOLTAGE. REFER TO 26 05 33.

**ELECTRICAL KEYED NOTES**

- LOCATE DIGITAL LIGHTING CONTROLLER AND IF SHOWN, PLENUM RATED, EMERGENCY LOAD CONTROL RELAY / TRANSFER SWITCH WALL MOUNTED ADJACENT TO NORMAL POWER PANEL. PROVIDE LABEL IDENTIFYING ASSOCIATED SPACE WITH WORDING PER SPECIFICATIONS. REFER TO DETAILS.
- PROVIDE WALL MOUNTED OCCUPANCY BASED SENSOR.
- INTERCONNECT TIMER SWITCHES FOR SIMULTANEOUS OPERATION.
- INTERCEPT EXISTING NORMAL POWER CIRCUIT HOME RUN AND PROVIDE PER CIRCUIT (1) LISTED UL1088 TRANSFER SWITCH (1) CONTACTOR WITH POLE QUANTITY AS REQUIRED CONTROLLED WITH BMCS. LOCATE ADJACENT TO NORMAL POWER PANEL SERVING THE LOAD. RE-USE EXISTING NORMAL POWER CIRCUIT AND NEW EMERGENCY POWER CIRCUIT AS SHOWN. EXTEND CONDUCTORS / CONDUIT WITH MATCHING SIZE. REFER TO SPECIFICATIONS AND DETAIL SHEETS.
- LOCATE DIGITAL LIGHTING CONTROLLER AND IF SHOWN, PLENUM RATED, EMERGENCY LOAD CONTROL RELAY / TRANSFER SWITCH ABOVE ACCESSIBLE CEILING IN CORRIDOR / ANCILLARY SPACE DIRECTLY OUTSIDE OF ENTRY DOOR. PROVIDE LABEL IDENTIFYING ASSOCIATED SPACE. GRID MARKERS WITH WORDING PER SPECIFICATIONS. REFER TO DETAILS.
- LOCATE DIGITAL LIGHTING CONTROLLER AND IF SHOWN, PLENUM RATED, EMERGENCY LOAD CONTROL RELAY / TRANSFER SWITCH ABOVE CORRIDOR E100L. PROVIDE LABEL IDENTIFYING ASSOCIATED SPACE. GRID MARKERS WITH WORDING PER SPECIFICATIONS. REFER TO DETAILS.

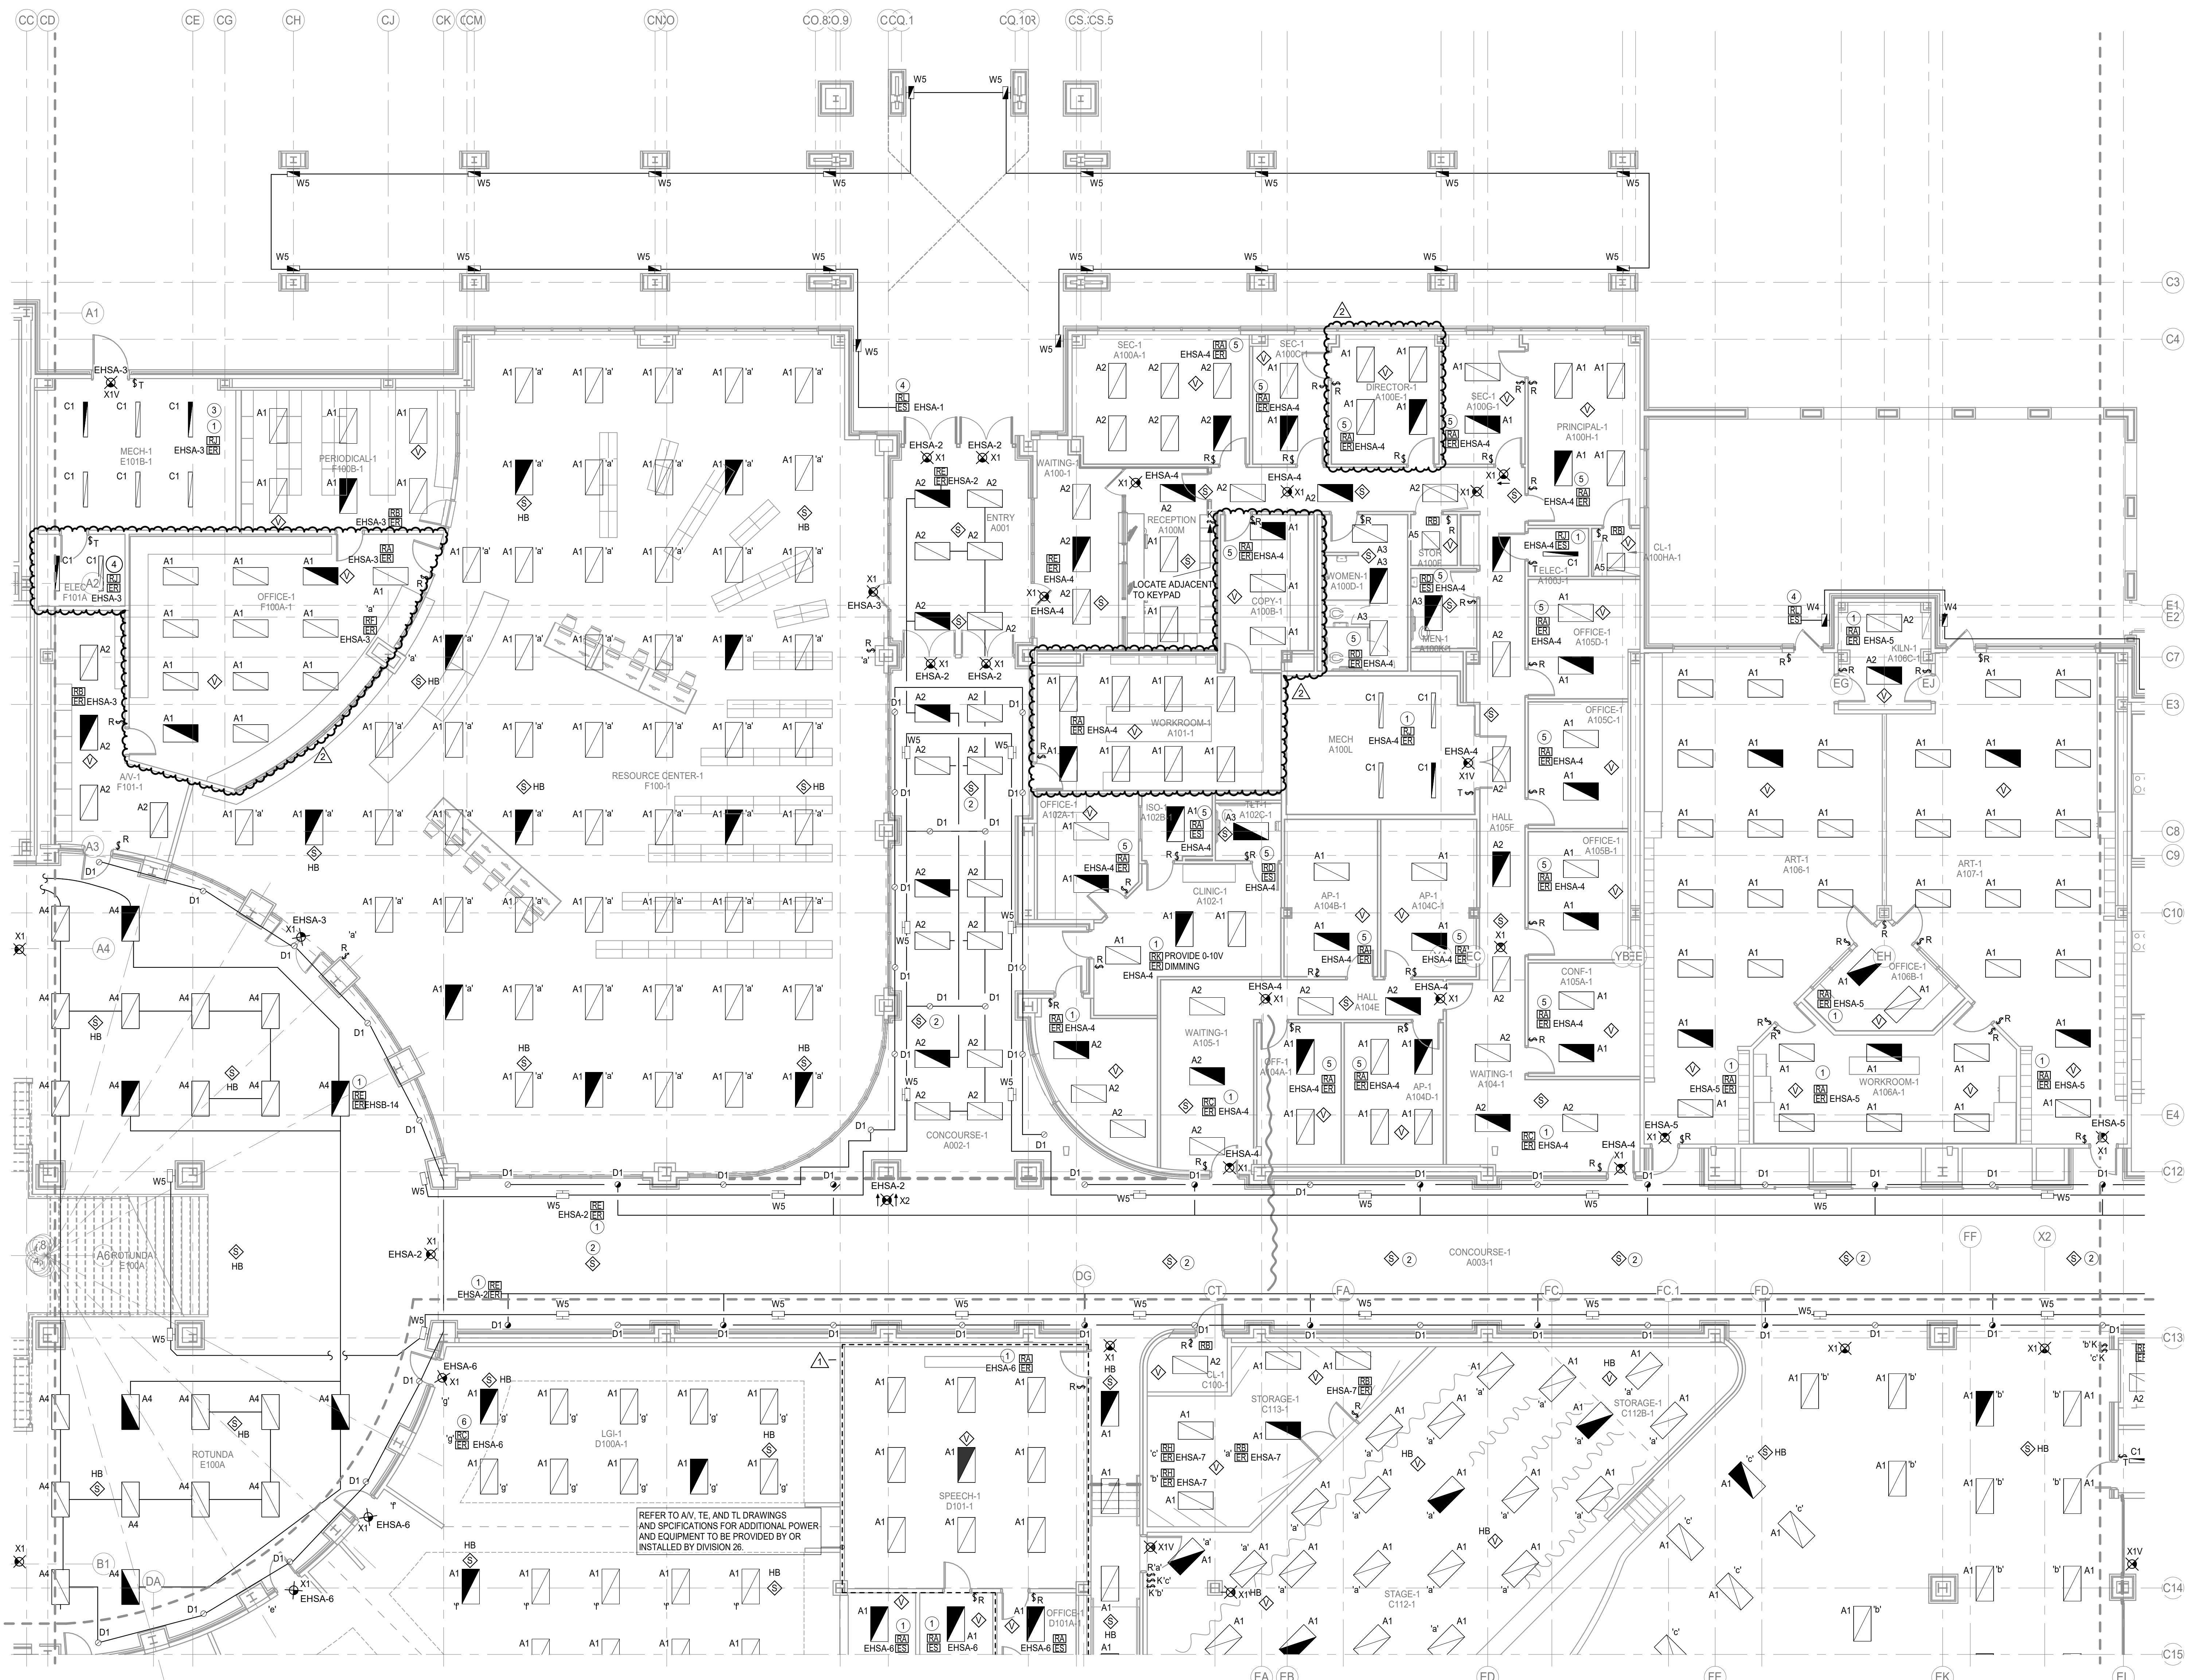

REFER TO AV, TE, AND TL DRAWINGS AND SPECIFICATIONS FOR ADDITIONAL POWER AND EQUIPMENT TO BE PROVIDED BY OR INSTALLED BY DIVISION 26.

**1 ELECTRICAL LIGHTING FLOOR PLAN - LEVEL 1 - AREA C**  
 Scale: 1/8" = 1'-0"

**KEY PLAN:**

**2024 SMITH & SPILLANE MS RENOVATIONS**  
**SPILLANE MIDDLE SCHOOL**  
 13403 WOODS-SPILLANE BLVD, CYPRESS, TX 77429  
 CFSID PROJECT NO: 24-02-5751-R-RFP



**LINE TYPE LEGEND**

	EXISTING TO REMAIN
	DISCONNECT AND REMOVE
	NEW WORK

CONTRACTOR TO FIELD COORDINATE FINAL LOCATION OF ALL REPLACEMENT AND NEW LIGHTING FIXTURES WITH EXISTING CEILING MOUNTED DEVICES AND TO NOTIFY ENGINEER IF THERE ARE ANY CONFLICTS BETWEEN EXISTING CONDITIONS AND THE NEW LIGHTING LAYOUT PRIOR TO COMMENCEMENT OF WORK.

PROVIDE NEW LIGHTING DEVICES AND SWITCH BOX EXTENSIONS IN ALL AREAS WHERE GYPSUM BOARD OR OTHER WALL COVERING ADJACENT TO THICKNESS OF WALL PER ARCHITECTURAL DRAWINGS FOR AREAS AFFECTED.


PROVIDE (1) MOMENTARY BMCS OVERRIDE TIME-OUT SWITCH FOR BUILDING OCCUPIED UNOCCUPIED ADJACENT TO OR IN THE BMCS MASTER PANEL; (1) MOMENTARY BMCS OVERRIDE TIME-OUT SWITCH FOR EXTERIOR FACADE LIGHTING ON/OFF; AND (1) MOMENTARY BMCS OVERRIDE TIME-OUT SWITCH FOR PARKING LOT LIGHTING ON/OFF IN MAIN ELECTRICAL.

**LIGHTING GENERAL NOTES**

- CONNECT NEW LIGHT FIXTURES TO EXISTING NORMAL POWER CIRCUITS LEFT IN PLACE AFTER DEMOLITION OR NEW AS SHOWN. PROVIDE EMERGENCY CIRCUIT FOR HATCHED FIXTURES AND/OR EXT SIGNS. EXTEND WIRING WITH MATCHING CONDUCTORS / CONDUIT TO EXISTING LOCATION AND/OR NEW FIXTURES. FIELD VERIFY CONNECTED LOAD NOT TO EXCEED 3500 W @ 277V. TYPICAL.
- LOCATION OF NEW / REPLACEMENT LIGHT FIXTURES SHALL RE-USE EXISTING J-BOX AND EXISTING LIGHT FIXTURE WHIPS AS PRACTICAL. EXTEND WIRING WITH MATCHING CONDUCTORS / CONDUIT TO EXISTING LOCATION AND/OR NEW FIXTURES. FIELD VERIFY CONNECTED LOAD NOT TO EXCEED 3500 W @ 277V. TYPICAL. FOR NON-ACCESSIBLE CEILING, LIGHT FIXTURE WHIPS SHALL BE 1/2-INCH FLEXIBLE STEEL CONDUIT OR STEEL MC CABLE. LENGTH NOT TO EXCEED 6-FEET. "DAISY CHAINING" LIGHT FIXTURES INSTALLED FOR LAY-IN CEILING AREAS IS NOT ALLOWED. FOR NON-ACCESSIBLE CEILING, LIGHT FIXTURE WHIPS SHALL BE 1/2-INCH FLEXIBLE STEEL CONDUIT. LENGTH AS REQUIRED TO MAKE A TAP AT AN ACCESSIBLE THROUGH FIXTURE. RECESSED LIGHT FIXTURES IN NON-ACCESSIBLE CEILING MAY BE DAISY CHAINED USING THE LIGHT FIXTURE'S INTEGRAL, UL LISTED J-BOX OR INTERNAL WIRE WAY THAT IS ACCESSIBLE THROUGH FIXTURE FROM BELOW THE CEILING. REFER TO 26 05 33 CONDUIT SYSTEMS.
- PROVIDE NEW LIGHTING CONTROLS, SENSORS AND ASSOCIATED DEVICES. 20A EMERGENCY LOAD CONTROL RELAYS AND/OR TRANSFER SWITCHES. REFER TO SPECIFICATIONS AND DETAIL SHEETS.
- LOCATE DIGITAL LIGHTING CONTROLLER AND / OR EMERGENCY LOAD CONTROL RELAY ABOVE ACCESSIBLE CEILING 12-FEET AFF OR BELOW ADJACENT TO SWITCH CONTROLLING THE SPACE. IN NON-ACCESSIBLE AND / OR HIGH CEILING AREAS, LOCATE DIGITAL LIGHTING CONTROLLER IN ADJACENT ANCILLARY AREA WITH ACCESSIBLE CEILING. IN AREAS WITH NO CEILING AND / OR IN EXTERIOR APPLICATIONS LOCATE ADJACENT TO PANEL SERVING THE LOAD. PROVIDE TYPE 135 MACHINE TYPED NAME PLATE TO BOTTOM OF CEILING 1'-GRID BELOW RELAY LOCATION. WHITE LETTERS ON BLACK BACKGROUND WITH 1/4" HIGH LETTERS ON 1/2" TALL LABEL. FOR DIGITAL MODULE, INDICATE AS: DLM.
- LOCATE DIGITAL LIGHTING CONTROLLER FOR CORRIDORS, GYM AND HIGH CEILING AREAS WITH NO ADJACENT ANCILLARY AREA ADJACENT TO NORMAL POWER PANEL SERVING THE LOAD. PROVIDE LABEL, GRID MARKERS WITH WORDING PER SPECIFICATIONS.
- LOCATE DIGITAL LIGHTING CONTROLLER FOR INSTRUCTIONAL SPACES AND ACCESSIBLE CEILING IN CORRIDOR DIRECTLY OUTSIDE OF ENTRY DOOR. PROVIDE LABEL IDENTIFYING ASSOCIATED SPACE, GRID MARKERS WITH WORDING PER SPECIFICATIONS.
- OCCUPANCY/VACANCY SENSOR AND DAYLIGHTING SENSOR LOCATIONS INDICATE SPACE OR AREA CONTROLLED. CONTRACTOR TO PROVIDE ACTUAL QUANTITIES, TYPES, AND MOUNTING LOCATIONS AS RECOMMENDED BY MANUFACTURER AND IECC-2015 C405.
- SPACES WITH MULTIPLE OCCUPANCY/VACANCY SENSORS OR WHERE LINE OF SIGHT MAY BE OBSCURED, SHALL BE LINKED TOGETHER FOR SIMULTANEOUS OPERATION WITHIN THE SPACE.
- CONTRACTOR SHALL MAINTAIN CONSTANT UNSWITCHED CIRCUITS FROM EXISTING SOURCE AND/OR NEW AS SHOWN FOR EMERGENCY FIXTURES, EMERGENCY LOAD RELAYS, TRANSFER SWITCHES AND EXIT SIGNS.
- COORDINATE LOCATION OF LIGHT FIXTURES IN ALL MECHANICAL AND ELECTRICAL ROOMS WITH MECHANICAL EQUIPMENT, PIPING, AND ALL OTHER TRADES.
- PROVIDE SEPARATE RACEWAY SYSTEMS FOR LIGHTING CONTROL SYSTEM. CONTROL WIRING (DIMMERS OR OTHERWISE) SHALL NOT BE INSTALLED IN THE SAME RACEWAY AS LINE VOLTAGE. REFER TO 26 05 33.


**ELECTRICAL KEYED NOTES**

- LOCATE DIGITAL LIGHTING CONTROLLER AND IF SHOWN, PLENUM RATED, EMERGENCY LOAD CONTROL RELAY ABOVE ACCESSIBLE CEILING IN CORRIDOR E100. PROVIDE LABEL IDENTIFYING ASSOCIATED SPACE, GRID MARKERS WITH WORDING PER SPECIFICATIONS. REFER TO DETAILS.
- LOCATE DIGITAL LIGHTING CONTROLLER AND IF SHOWN, PLENUM RATED, EMERGENCY LOAD CONTROL RELAY / TRANSFER SWITCH ABOVE ACCESSIBLE CEILING IN CORRIDOR / ANCILLARY SPACE DIRECTLY OUTSIDE OF ENTRY DOOR. PROVIDE LABEL IDENTIFYING ASSOCIATED SPACE, GRID MARKERS WITH WORDING PER SPECIFICATIONS. REFER TO DETAILS.
- LOCATE DIGITAL LIGHTING CONTROLLER AND AND IF SHOWN, PLENUM RATED, EMERGENCY LOAD CONTROL RELAY / TRANSFER SWITCH MOUNTED ADJACENT TO NORMAL POWER PANEL. PROVIDE LABEL IDENTIFYING ASSOCIATED SPACE WITH WORDING PER SPECIFICATIONS. REFER TO DETAILS.
- INTERCEPT EXISTING NORMAL POWER CIRCUIT HOME RUN AND PROVIDE PER CIRCUIT (1) LISTED UL 100R TRANSFER SWITCH (1) CONTACTOR WITH POLE QUANTITY AS REQUIRED CONTROLLED WITH BMCS. LOCATE ADJACENT TO NORMAL POWER PANEL SERVING THE LOAD. RE-USE EXISTING NORMAL POWER CIRCUIT AND NEW EMERGENCY POWER CIRCUIT AS SHOWN. EXTEND CONDUCTORS / CONDUIT WITH MATCHING SIZE. REFER TO SPECIFICATIONS AND DETAIL SHEETS.

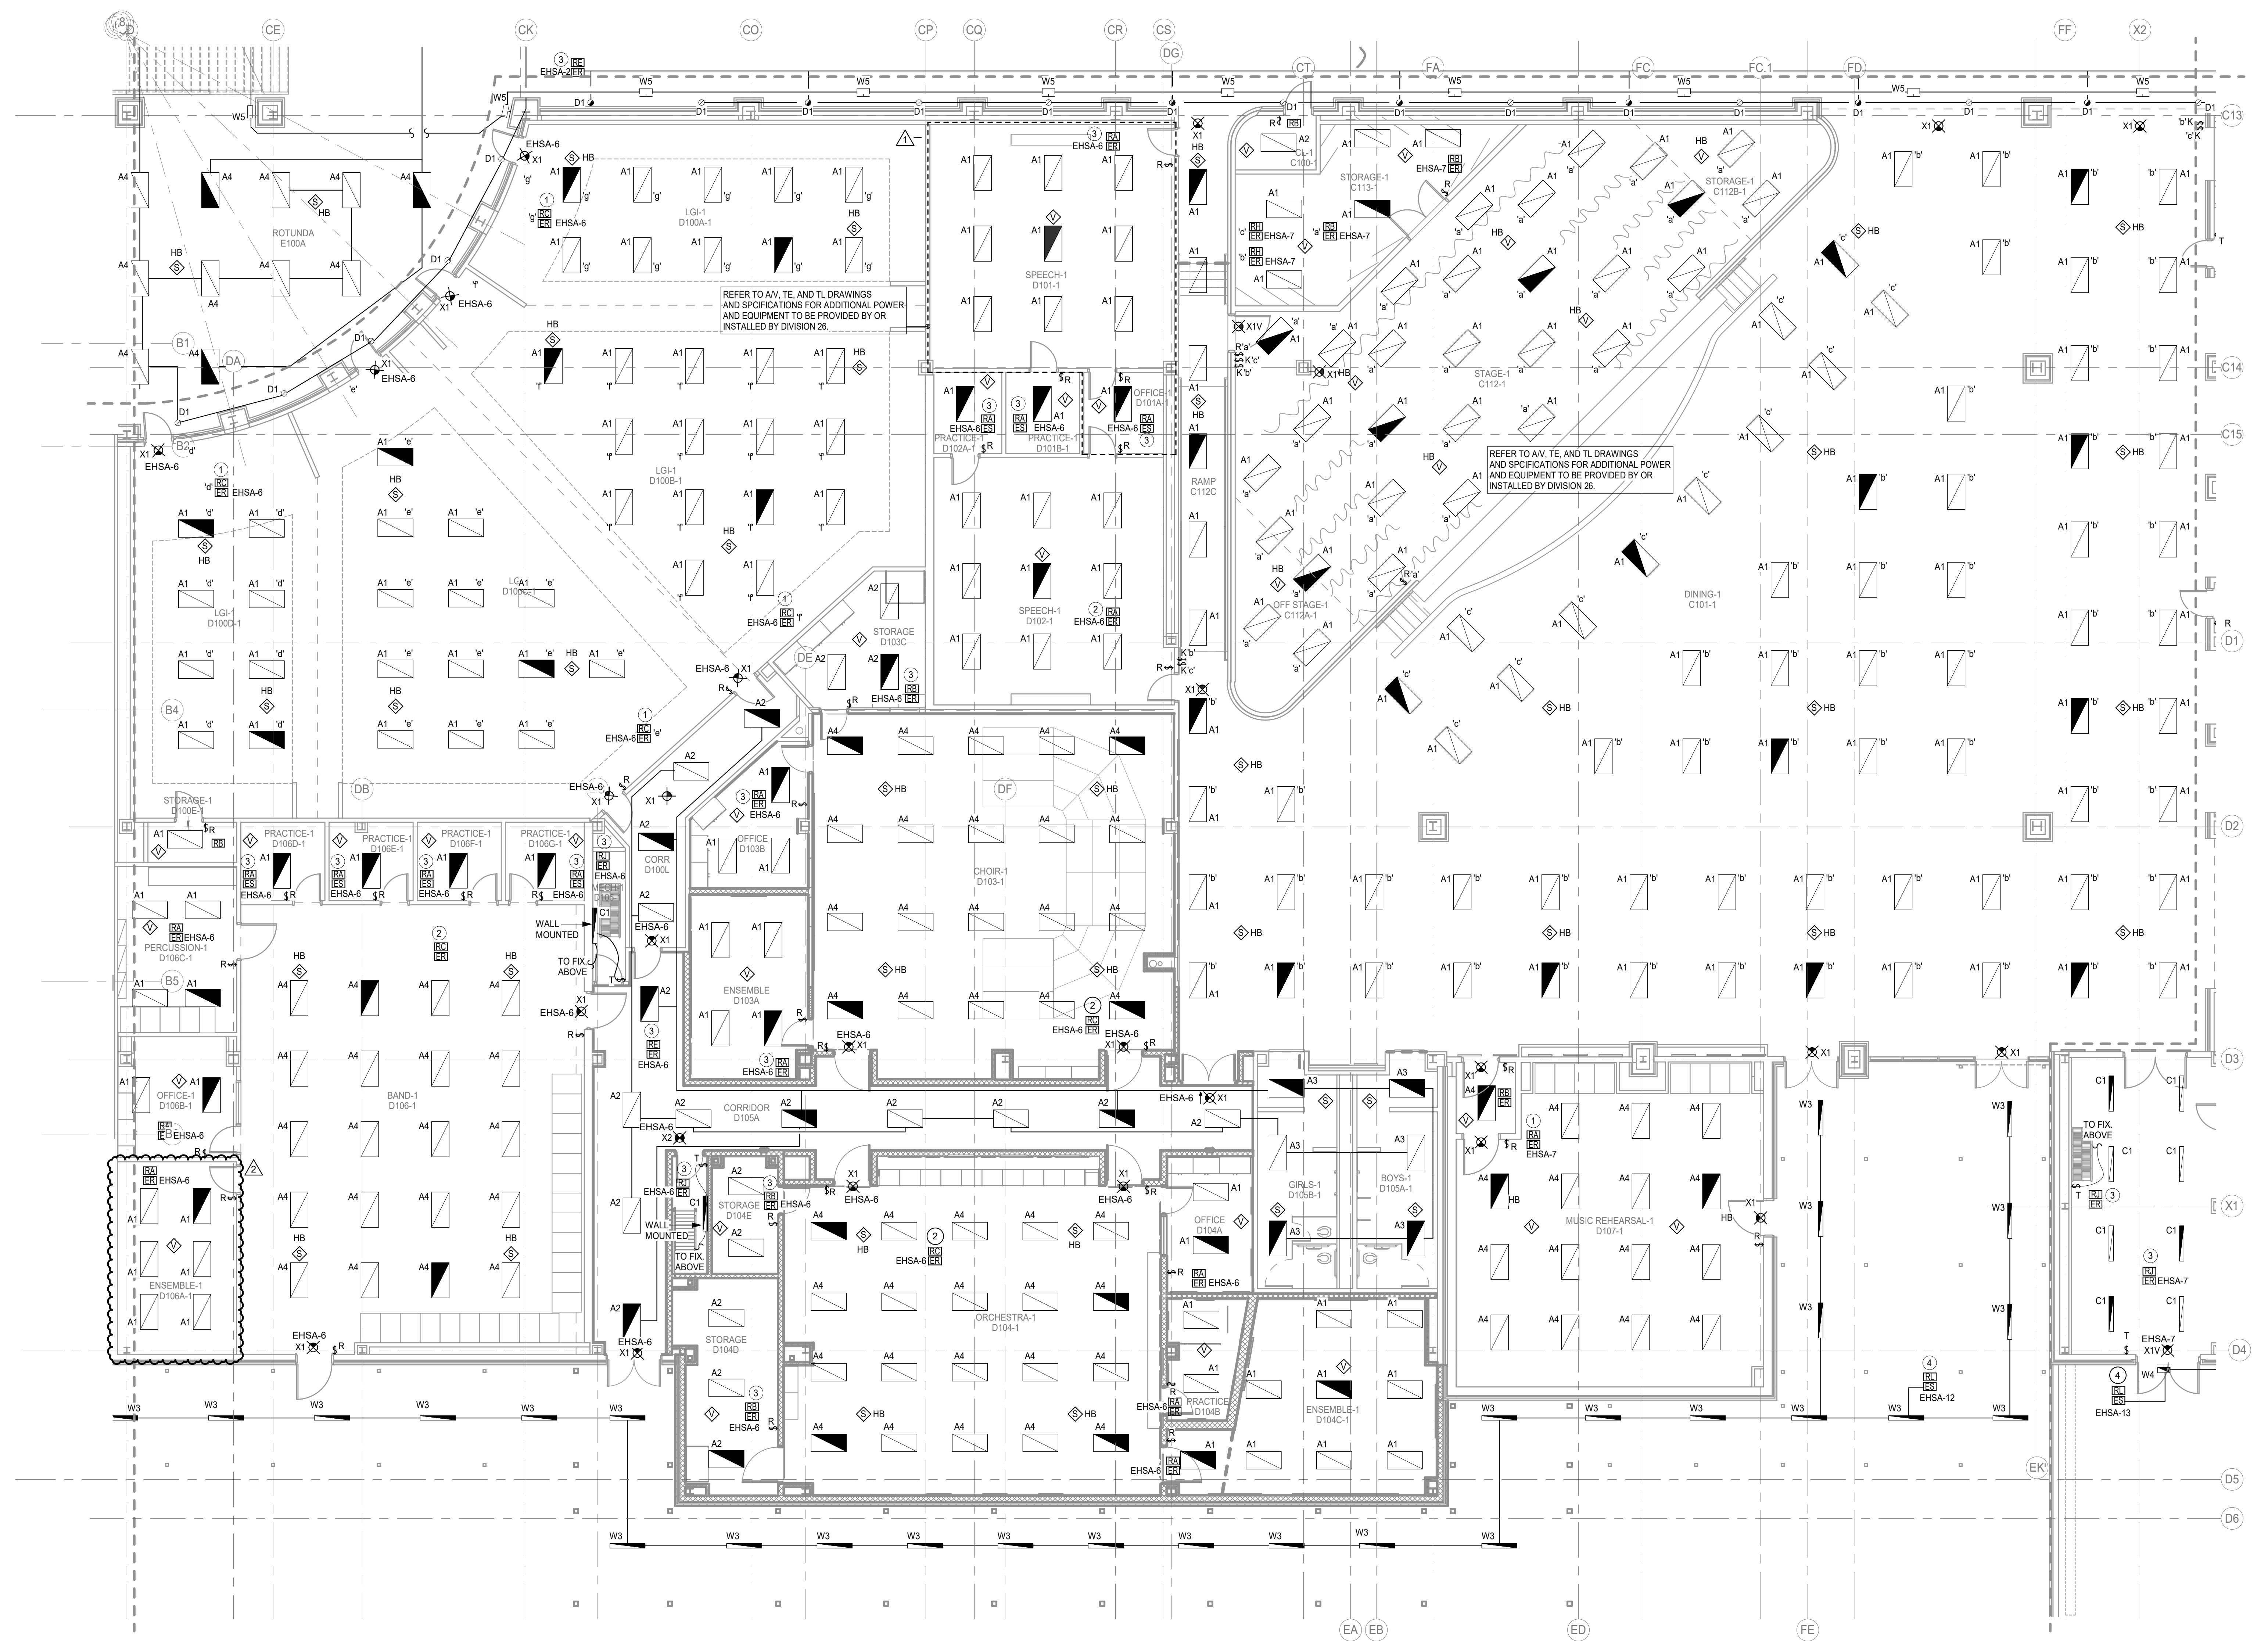

**1 ELECTRICAL LIGHTING FLOOR PLAN - LEVEL 1 - AREA D**  
 Scale: 1/8" = 1'-0"

**KEY PLAN:**

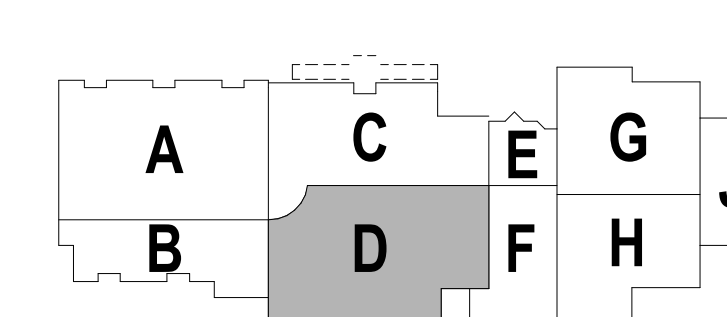

**2024 SMITH & SPILLANE MS RENOVATIONS**  
**SPILLANE MIDDLE SCHOOL**  
 13403 WOODS-SPILLANE BLVD, CYPRESS, TX 77429  
 CFSID PROJECT NO: 24-02-5751-R-RFP

Project Number: 23073  
 Date: 26 JANUARY 2025  
 Drawn By: WHL / KLO  
**ELECTRICAL LIGHTING**  
**FIRST FLOOR PLAN -**  
**AREA 'D'**  
**E2.04**

**LINE TYPE LEGEND**

---	EXISTING TO REMAIN
- - - -	DISCONNECT AND REMOVE
---	NEW WORK

CONTRACTOR TO FIELD COORDINATE FINAL LOCATION OF ALL REPLACEMENT AND NEW LIGHTING FIXTURES WITH EXISTING CEILING MOUNTED DEVICES, AND TO NOTIFY ENGINEER IF THERE ARE ANY CONFLICTS BETWEEN EXISTING CONDITIONS AND THE NEW LIGHTING LAYOUT PRIOR TO COMMENCEMENT OF WORK.

PROVIDE NEW LIGHTING DEVICES AND SWITCH BOX EXTENSIONS IN ALL AREAS WHERE GYPSUM BOARD OR OTHER WALL COVERINGS ADDS TO THE THICKNESS OF WALLS. SEE ARCHITECTURAL DRAWINGS FOR AREAS AFFECTED.


PROVIDE (1) MOMENTARY BMCS OVERRIDE TIME-OUT SWITCH FOR BUILDING OCCUPIED/UNOCCUPIED ADJACENT TO OR IN THE BMCS MASTER PANEL, (1) MOMENTARY BMCS OVERRIDE TIME-OUT SWITCH FOR EXTERIOR FACADE LIGHTING ON/OFF AND (1) MOMENTARY BMCS OVERRIDE TIME-OUT SWITCH FOR PARKING LOT LIGHTING ON/OFF IN MAIN ELECTRICAL.

**LIGHTING GENERAL NOTES**

- CONNECT NEW LIGHT FIXTURES TO EXISTING NORMAL POWER CIRCUITS LEFT IN PLACE AFTER DEMOLITION OR NEW AS SHOWN. PROVIDE EMERGENCY CIRCUIT FOR HATCHED FIXTURES AND/OR EXIT SIGNS. EXTEND WIRING WITH MATCHING CONDUCTORS / CONDUIT TO EXISTING LOCATION AND/OR NEW FIXTURES. FIELD VERIFY CONNECTED LOAD NOT TO EXCEED 3500 W @ 277V, TYPICAL.
- LOCATION OF NEW / REPLACEMENT LIGHT FIXTURES SHALL RE-USE EXISTING J-BOX AND EXISTING LIGHT FIXTURE WHIPS AS PRACTICAL. EXTEND WIRING WITH MATCHING CONDUCTORS / CONDUIT AND PROVIDE NEW J-BOX ABOVE ACCESSIBLE CEILING WITH 1/2-INCH FLEXIBLE STEEL CONDUIT OR STEEL MC CABLE, LENGTH NOT TO EXCEED 6-FEET. "DAISY CHAINING" LIGHT FIXTURES INSTALLED FOR LAY-ON CEILING AREAS IS NOT ALLOWED. FOR NON-ACCESSIBLE CEILINGS, LIGHT FIXTURE WHIPS SHALL BE 1/2-INCH FLEXIBLE STEEL CONDUIT, LENGTH AS REQUIRED TO MAKE A TAP AT AN ACCESSIBLE J-BOX. RECESSED LIGHT FIXTURES IN NON-ACCESSIBLE CEILINGS MAY BE DAISY CHAINED USING THE LIGHT FIXTURE'S INTEGRAL, UL LISTED J-BOX OR INTERNAL WIREWAY THAT IS ACCESSIBLE THROUGH FIXTURE FROM BELOW THE CEILING. REFER TO 26 05 33 CONDUIT SYSTEMS.
- PROVIDE NEW LIGHTING CONTROLS, SENSORS AND ASSOCIATED DEVICES, 20A EMERGENCY LOAD CONTROL RELAYS AND/OR TRANSFER SWITCHES. REFER TO SPECIFICATIONS AND DETAIL SHEETS.
- LOCATE DIGITAL LIGHTING CONTROLLER AND / OR EMERGENCY LOAD CONTROL RELAY ABOVE ACCESSIBLE CEILING 12-FEET AFF OR BELOW ADJACENT TO SWITCH CONTROLLING THE SPACE. IN NON-ACCESSIBLE AND / OR HIGH CEILING AREAS, LOCATE DIGITAL LIGHTING CONTROLLER IN ADJACENT ANCILLARY AREA WITH ACCESSIBLE CEILING. IN AREAS WITH NO CEILING AND / OR IN EXTERIOR APPLICATIONS LOCATE ADJACENT TO PANEL SERVING THE LOAD. PROVIDE PLASTIC TAPE MACHINE TYPED NAME PLATE TO BOTTOM OF CEILING T-GRID BELOW RELAY LOCATION. WHITE LETTERS ON BLACK BACKGROUND WITH 1/4" HIGH LETTERS ON 1/2" TALL LABEL FOR DIGITAL MODULE. INDICATE AS: DLM.
- LOCATE DIGITAL LIGHTING CONTROLLER FOR CORRIDORS, GYM AND HIGH CEILING AREAS WITH NO ADJACENT ANCILLARY AREA ADJACENT TO NORMAL POWER PANEL SERVING THE LOAD. PROVIDE LABEL, GRID MARKERS WITH WORDING PER SPECIFICATIONS.
- LOCATE DIGITAL LIGHTING CONTROLLER FOR INSTRUCTIONAL SPACES AND OFFICES ABOVE ACCESSIBLE CEILING IN CORRIDOR DIRECTLY OUTSIDE OF ENTRY DOOR. PROVIDE LABEL IDENTIFYING ASSOCIATED SPACE, GRID MARKERS WITH WORDING PER SPECIFICATIONS.
- OCCUPANCY/VACANCY SENSOR AND DAYLIGHTING SENSOR LOCATIONS INDICATE SPACE OR AREA CONTROLLED. CONTRACTOR TO PROVIDE ACTUAL QUANTITIES, TYPES, AND MOUNTING LOCATIONS AS RECOMMENDED BY MANUFACTURER AND IECC-2015 C405.
- SPACES WITH MULTIPLE OCCUPANCY/VACANCY SENSORS OR WHERE LINE OF SIGHT MAY BE OBSCURED SHALL BE LINKED TOGETHER FOR SIMULTANEOUS OPERATION WITHIN THE SPACE.
- CONTRACTOR SHALL MAINTAIN CONSTANT UNSWITCHED CIRCUITS FROM EXISTING SOURCE AND/OR NEW AS SHOWN FOR EMERGENCY FIXTURES, EMERGENCY LOAD RELAYS, TRANSFER SWITCHES AND EXIT SIGNS.
- COORDINATE LOCATION OF LIGHT FIXTURES IN ALL MECHANICAL AND ELECTRICAL ROOMS WITH MECHANICAL EQUIPMENT, PIPING, AND ALL OTHER TRADES.
- PROVIDE SEPARATE RACEWAY SYSTEMS FOR LIGHTING CONTROL SYSTEM. CONTROLS WIRING (DIMMERS OR OTHERWISE) SHALL NOT BE INSTALLED IN THE SAME RACEWAY AS LINE VOLTAGE. REFER TO 26 05 33.


**ELECTRICAL KEYED NOTES**

- LIGHTING IN COOLER / FREEZER TO BE FURNISHED WITH EQUIPMENT. FINAL CONNECTION PROVIDED BY DIVISION 26.
- LOCATE DIGITAL LIGHTING CONTROLLER AND IF SHOWN, PLENUM RATED, EMERGENCY LOAD CONTROL RELAY / TRANSFER SWITCH ABOVE ACCESSIBLE CEILING IN CORRIDOR / ANCILLARY SPACE DIRECTLY OUTSIDE OF ENTRY DOOR. PROVIDE LABEL IDENTIFYING ASSOCIATED SPACE, GRID MARKERS WITH WORDING PER SPECIFICATIONS. REFER TO DETAILS.
- LOCATE DIGITAL LIGHTING CONTROLLER AND IF SHOWN, PLENUM RATED, EMERGENCY LOAD CONTROL RELAY / TRANSFER SWITCH SHALL MOUNTED ADJACENT TO NORMAL POWER PANEL. PROVIDE LABEL IDENTIFYING ASSOCIATED SPACE WITH WORDING PER SPECIFICATIONS. REFER TO DETAILS.

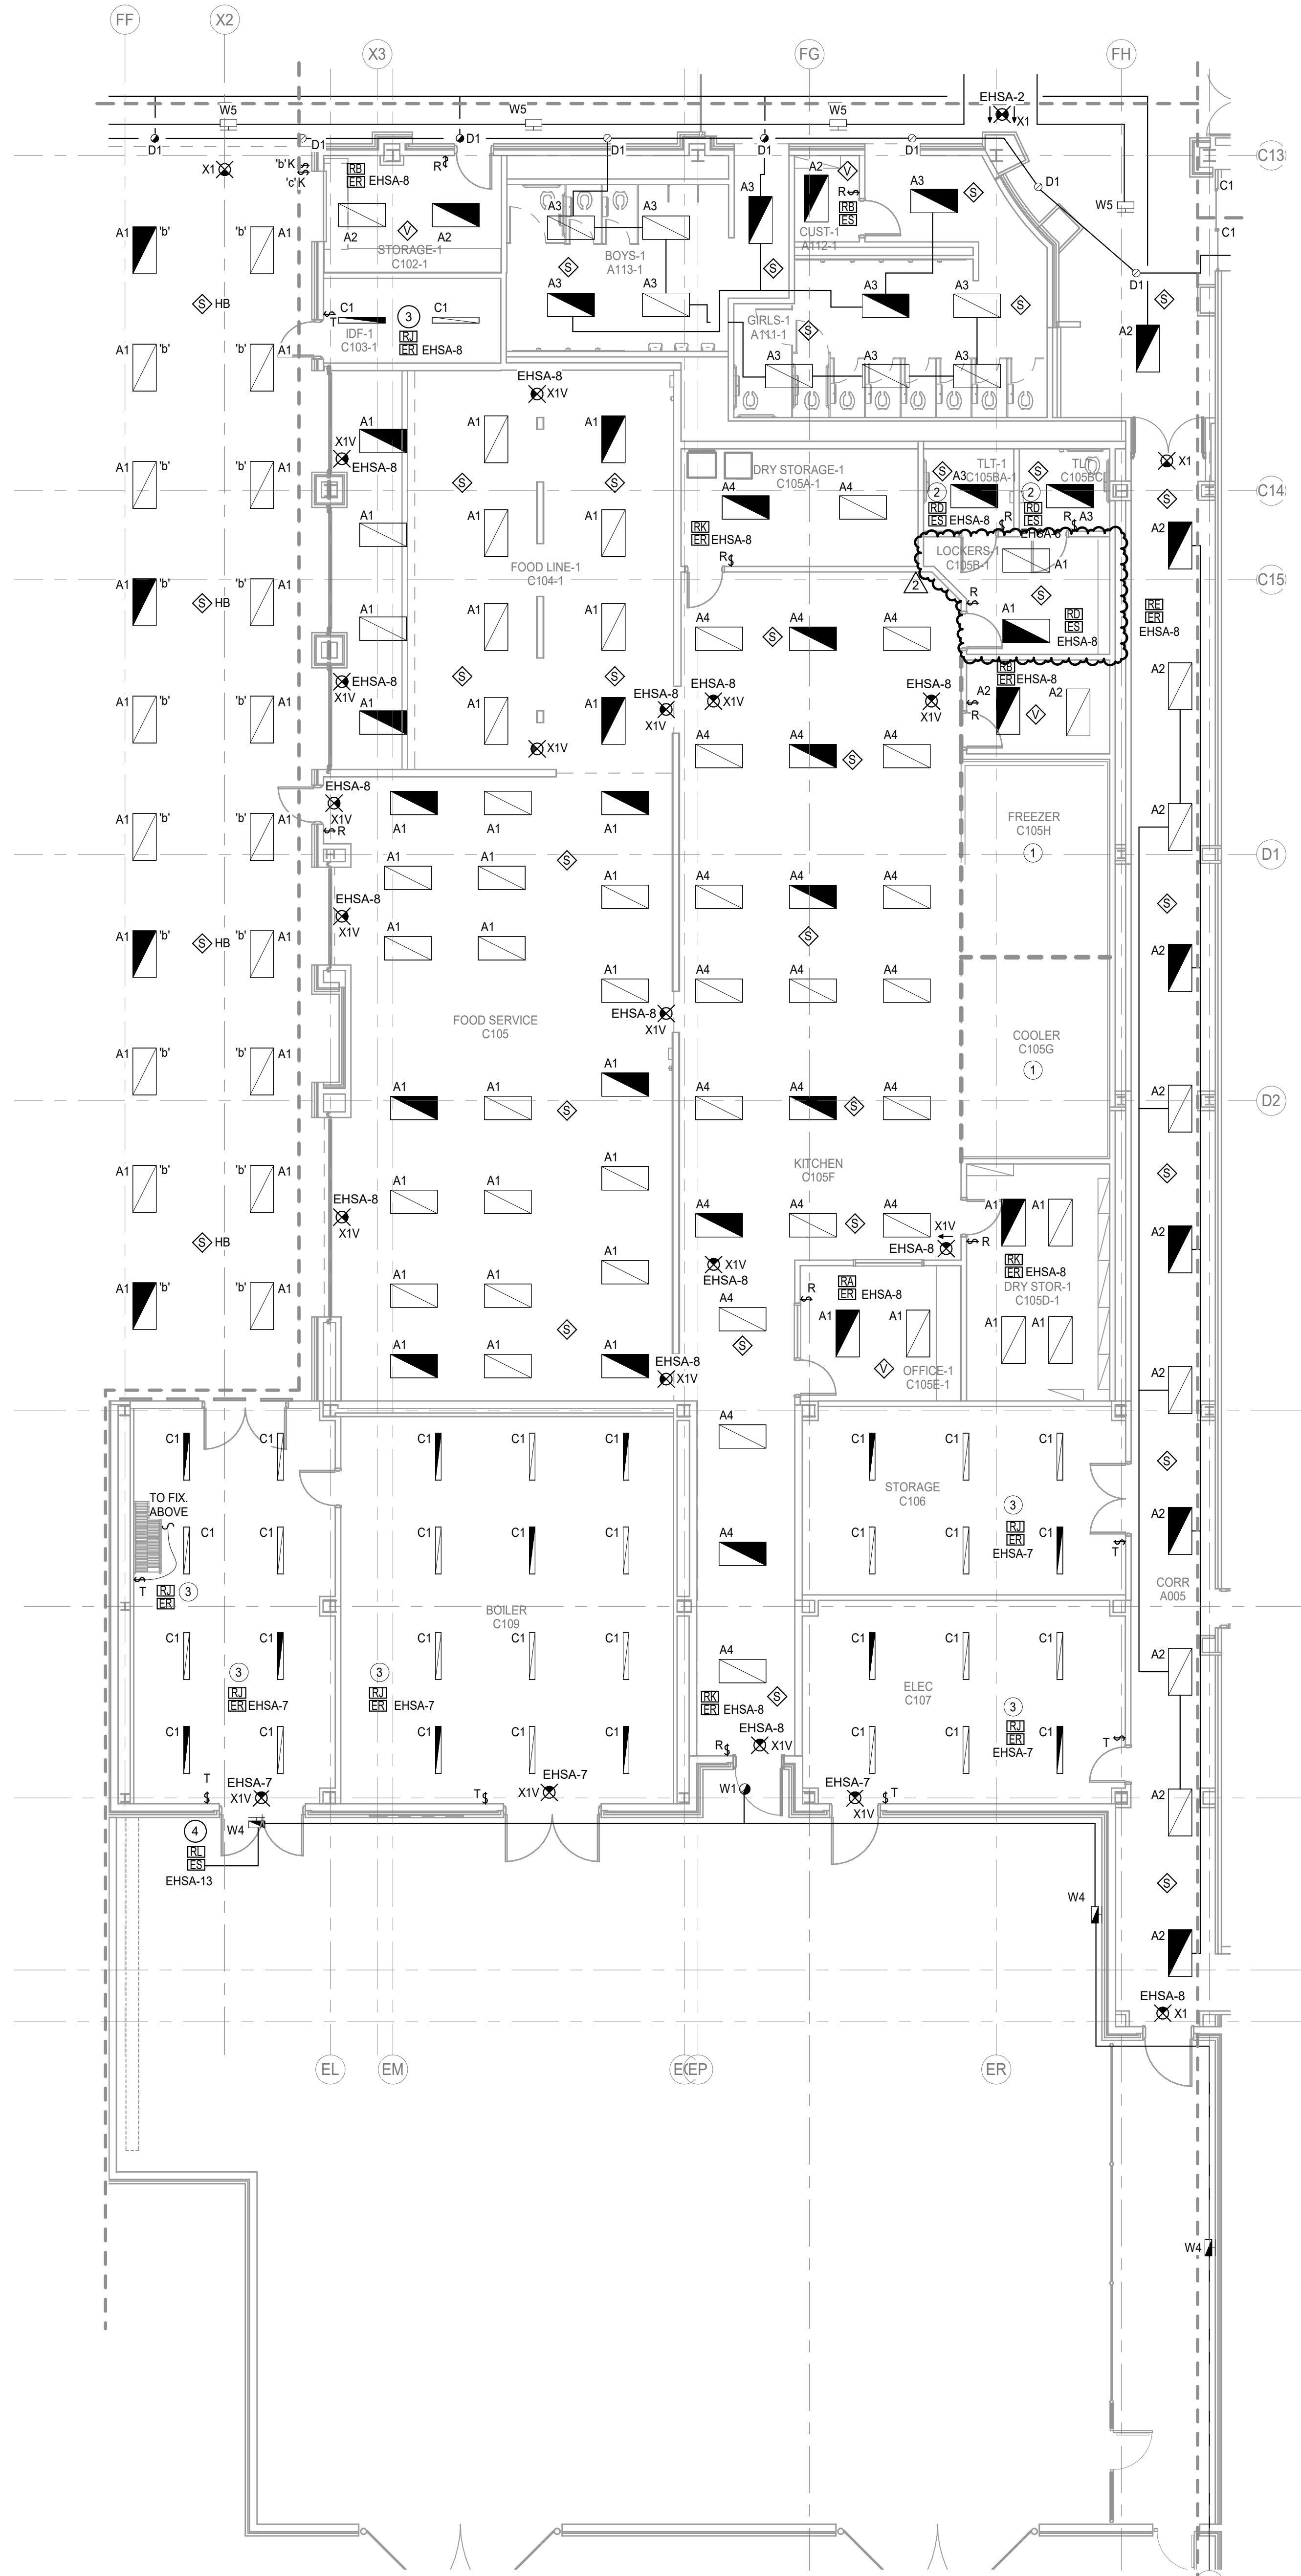

**1 ELECTRICAL LIGHTING FLOOR PLAN - LEVEL 1 - AREA F**  
 Scale: 1/8" = 1'-0"

**KEY PLAN:**

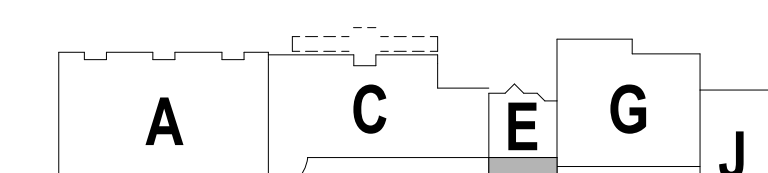

**2024 SMITH & SPILLANE MS RENOVATIONS**  
**SPILLANE MIDDLE SCHOOL**  
 13403 WOODS-SPILLANE BLVD, CYPRESS, TX 77429  
 CFISD PROJECT NO: 24-02-5751-R-RFP


2	Addendum 03	02-11-25
2	Revisions / Submission	

Project Number: 23073  
 Date: 26 JANUARY 2025  
 Drawn By: WHL / KLO

**ELECTRICAL LIGHTING**  
**FIRST FLOOR PLAN -**  
**AREA 'F'**

**E2.06**



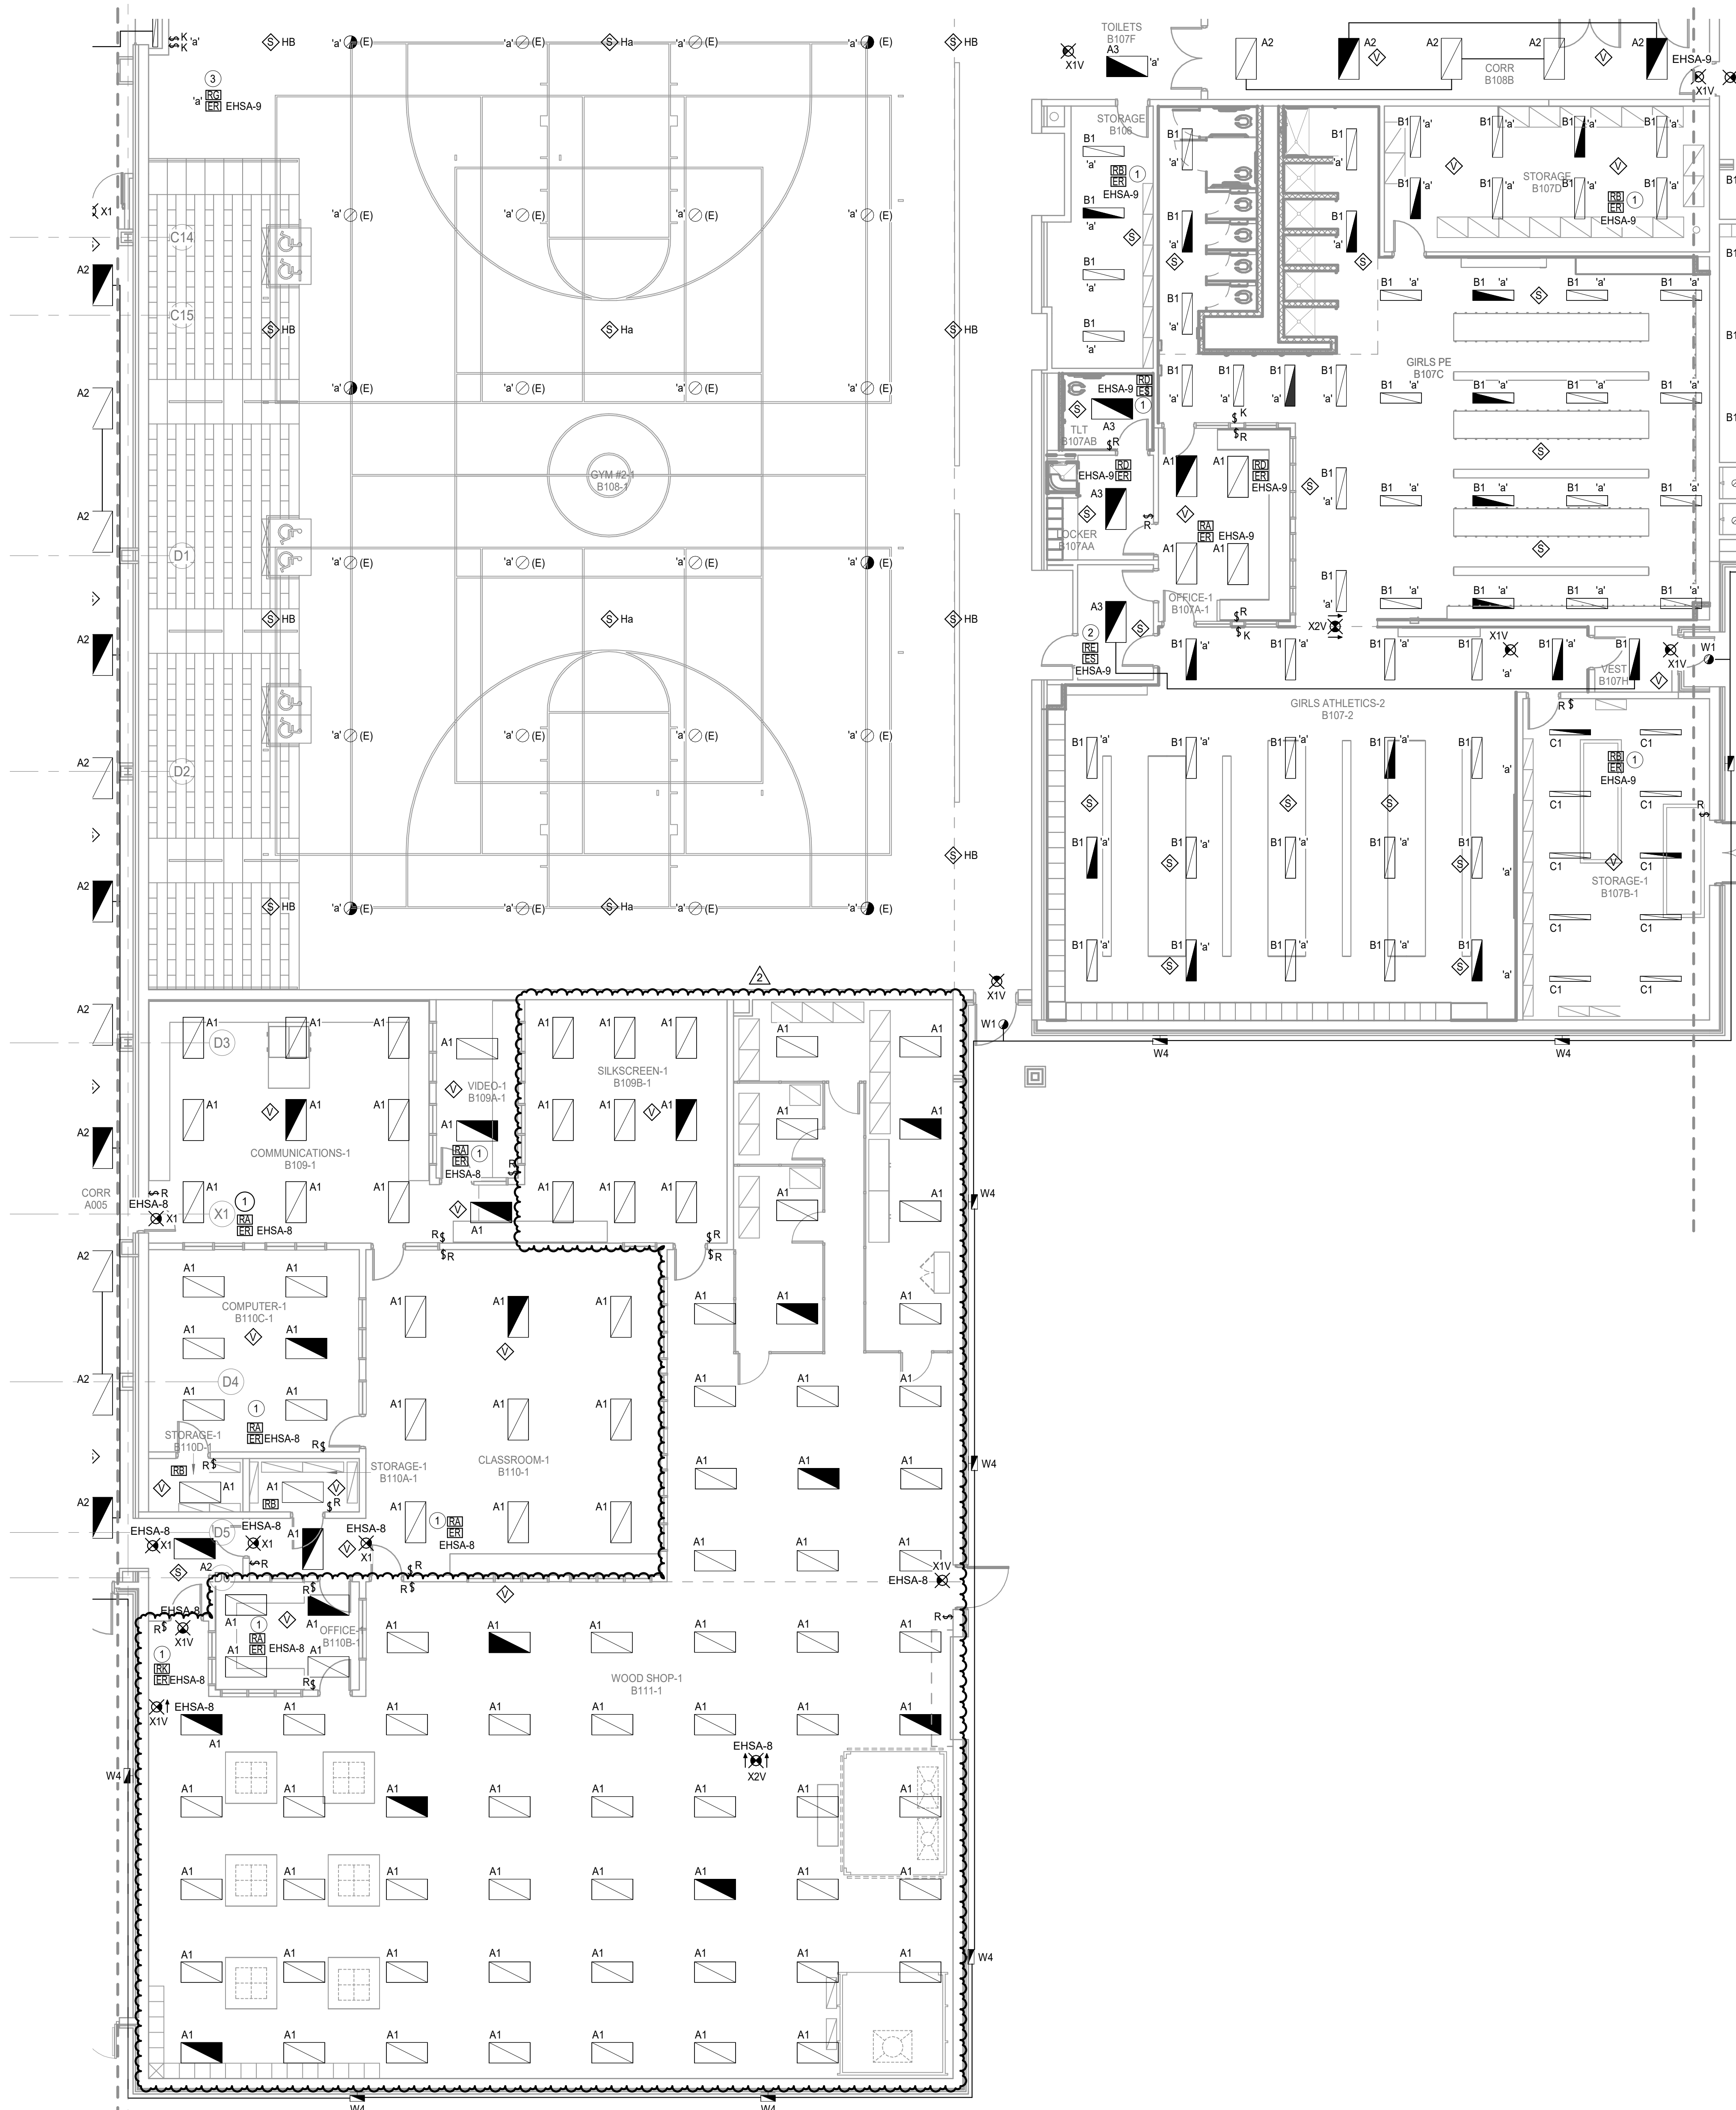

ELECTRICAL KEYED NOTES	
1	<varies>
2	LOCATE DIGITAL LIGHTING CONTROLLER AND IF SHOWN, PLENUM RATED, EMERGENCY LOAD CONTROL RELAY / TRANSFER SWITCH WALL MOUNTED ADJACENT TO NORMAL POWER PANEL. PROVIDE LABEL IDENTIFYING ASSOCIATED SPACE WITH WORDING PER SPECIFICATIONS. REFER TO DETAILS.
3	LOCATE DIGITAL LIGHTING CONTROLLER AND IF SHOWN, PLENUM RATED, EMERGENCY LOAD CONTROL RELAY / TRANSFER SWITCH ABOVE ACCESSIBLE CEILING IN CONCESSIONS B100A. PROVIDE LABEL IDENTIFYING ASSOCIATED SPACE, GRID MARKERS WITH WORDING PER SPECIFICATIONS. REFER TO DETAILS.

LINE TYPE LEGEND	
	EXISTING TO REMAIN
	DISCONNECT AND REMOVE
	NEW WORK

CONTRACTOR TO FIELD COORDINATE FINAL LOCATION OF ALL REPLACEMENT AND NEW LIGHTING FIXTURES WITH EXISTING CEILING MOUNTED DEVICES. AND TO NOTIFY ENGINEER IF THERE ARE ANY CONFLICTS BETWEEN EXISTING CONDITIONS AND THE NEW LIGHTING LAYOUT PRIOR TO COMMENCEMENT OF WORK.

PROVIDE NEW LIGHTING DEVICES AND SWITCH BOX EXTENSIONS IN ALL AREAS WHERE GYPSUM BOARD OR OTHER WALL COVERINGS ADDS TO THE THICKNESS OF WALLS. SEE ARCHITECTURAL DRAWINGS FOR AREAS AFFECTED.

PROVIDE (1) MOMENTARY BMCS OVERRIDE TIME-OUT SWITCH FOR BUILDING OCCUPIED/UNOCCUPIED ADJACENT TO OR IN THE BMCS MASTER PANEL; (1) MOMENTARY BMCS OVERRIDE TIME-OUT SWITCH FOR EXTERIOR FACADE LIGHTING ON/OFF AND (1) MOMENTARY BMCS OVERRIDE TIME-OUT SWITCH FOR PARKING LOT LIGHTING ON/OFF IN MAIN ELECTRICAL.

**LIGHTING GENERAL NOTES**

- CONNECT NEW LIGHT FIXTURES TO EXISTING NORMAL POWER CIRCUITS LEFT IN PLACE AFTER DEMOLITION OR NEW AS SHOWN. PROVIDE EMERGENCY CIRCUIT FOR HATCHED FIXTURES AND/OR EXIT SIGNS. EXTEND WIRING WITH MATCHING CONDUCTORS / CONDUIT TO EXISTING LOCATION AND/OR NEW FIXTURES. FIELD VERIFY CONNECTED LOAD NOT TO EXCEED 3500 W @ 277V. TYPICAL.
- LOCATION OF NEW / REPLACEMENT LIGHT FIXTURES SHALL RE-USE EXISTING J-BOX AND EXISTING LIGHT FIXTURE WHIPS AS PRACTICAL. EXTEND WIRING WITH MATCHING CONDUCTORS / CONDUIT AND PROVIDE NEW J-BOX ABOVE ACCESSIBLE CEILING WITH 1/2-INCH FLEXIBLE STEEL CONDUIT OR STEEL MC CABLE. LENGTH NOT TO EXCEED 6 FEET. "DAISY CHAINING" LIGHT FIXTURES INSTALLED FOR LAY-IN CEILING AREAS IS NOT ALLOWED. FOR NON-ACCESSIBLE CEILINGS, LIGHT FIXTURE WHIPS SHALL BE 1/2-INCH FLEXIBLE STEEL CONDUIT. LENGTH AS REQUIRED TO MAKE A TAP AT AN ACCESSIBLE J-BOX. RECESSED LIGHT FIXTURES IN NON-ACCESSIBLE CEILINGS MAY BE DAISY CHAINED USING THE LIGHT FIXTURE'S INTEGRAL, UL LISTED J-BOX OR INTERNAL WIRE WAY THAT IS ACCESSIBLE THROUGH FIXTURE FROM BELOW THE CEILING. REFER TO 26 05 33 CONDUIT SYSTEMS.
- PROVIDE NEW LIGHTING CONTROLS, SENSORS AND ASSOCIATED DEVICES. 20A EMERGENCY LOAD CONTROL RELAYS AND/OR TRANSFER SWITCHES. REFER TO SPECIFICATIONS AND DETAIL SHEETS.
- LOCATE DIGITAL LIGHTING CONTROLLER AND / OR EMERGENCY LOAD CONTROL RELAY ABOVE ACCESSIBLE CEILING 12 FEET AFF OR BELOW ADJACENT TO SWITCH CONTROLLING THE SPACE. IN NON-ACCESSIBLE AND / OR HIGH CEILING AREAS, LOCATE DIGITAL LIGHTING CONTROLLER IN ADJACENT ANCILLARY AREA WITH ACCESSIBLE CEILING. IN AREAS WITH NO CEILING AND / OR IN EXTERIOR APPLICATIONS LOCATE ADJACENT TO PANEL SERVING THE LOAD. PROVIDE PLASTIC TAPE MACHINE TYPED NAME PLATE TO BOTTOM OF CEILING T-GRID BELOW RELAY LOCATION. WHITE LETTERS ON BLACK BACKGROUND WITH 1/4" HIGH LETTERS ON 1/2" TALL LABEL FOR DIGITAL MODULE. INDICATE AS: DLM.
- LOCATE DIGITAL LIGHTING CONTROLLER FOR CORRIDORS, GYM AND HIGH CEILING AREAS WITH NO ADJACENT ANCILLARY AREA ADJACENT TO NORMAL POWER PANEL SERVING THE LOAD. PROVIDE LABEL, GRID MARKERS WITH WORDING PER SPECIFICATIONS.
- LOCATE DIGITAL LIGHTING CONTROLLER FOR INSTRUCTIONAL SPACES AND OFFICES ABOVE ACCESSIBLE CEILING IN CORRIDOR DIRECTLY OUTSIDE OF ENTRY DOOR. PROVIDE LABEL IDENTIFYING ASSOCIATED SPACE. GRID MARKERS WITH WORDING PER SPECIFICATIONS.
- OCCUPANCY/VACANCY SENSOR AND DAYLIGHTING SENSOR LOCATIONS INDICATE SPACE OR AREA CONTROLLED. CONTRACTOR TO PROVIDE ACTUAL QUANTITIES, TYPES, AND MOUNTING LOCATIONS AS RECOMMENDED BY MANUFACTURER AND IECC-2015 C405.
- SPACES WITH MULTIPLE OCCUPANCY/VACANCY SENSORS OR WHERE LINE OF SIGHT MAY BE OBSCURED SHALL BE LINKED TOGETHER FOR SIMULTANEOUS OPERATION WITHIN THE SPACE.
- CONTRACTOR SHALL MAINTAIN CONSTANT UNSWITCHED CIRCUITS FROM EXISTING SOURCE AND/OR NEW AS SHOWN FOR EMERGENCY FIXTURES, EMERGENCY LOAD RELAYS, TRANSFER SWITCHES AND EXIT SIGNS.
- COORDINATE LOCATION OF LIGHT FIXTURES IN ALL MECHANICAL AND ELECTRICAL ROOMS WITH MECHANICAL EQUIPMENT, PIPING, AND ALL OTHER TRADES.
- PROVIDE SEPARATE RACEWAY SYSTEMS FOR LIGHTING CONTROL SYSTEM. CONTROL'S WIRING (DIMMERS OR OTHERWISE) SHALL NOT BE INSTALLED IN THE SAME RACEWAY AS LINE VOLTAGE. REFER TO 26 05 33.

**Salas O'Brien**  
 salesobrien.com 281-664-1900  
 10930 W. Sam Houston Pkwy North, Suite 900  
 Houston, TX 77064  
 Registration: F-4111  
 Project No: 2024-0209-00

**NATEX**  
 CORPORATION  
 ARCHITECTS  
 www.natearchitects.com  
 447 Heights Boulevard  
 Houston, TX 77007  
 Phone: 713-975-9525  
 Fax: 713-780-7824

**Coleman Partners**  
 ARCHITECTS  
 architects.com  
 3701 Kirby Drive, Suite 830  
 Houston, TX 77098  
 Tel: 832-947-1038 Fax: 281-214-5365

CONSTRUCTION DOCUMENT  
 02-11-2025

**BRADLEY KALMANS**  
 ARCHITECT  
 80219  
 LICENSE  
 02-11-2025

**CIVIL ENGINEER**  
**BROOKS AND SPARKS, INC.**  
 21020 PARK ROW  
 KATY, TX 77449  
 Tel: 281-578-9595

**STRUCTURAL ENGINEER**  
**DALLY + ASSOCIATES, INC.**  
 9800 RICHMOND AVE.  
 SUITE 400  
 HOUSTON, TX 77042  
 Tel: 713-337-8881

**MEPT ENGINEER**  
**SALAS O'BRIEN**  
 10930 W. SAM HOUSTON PKWY. N.  
 SUITE 900  
 HOUSTON, TX 77064  
 Tel: 281.664.1900

**FOOD SERVICE EQUIPMENT**  
**FDP**  
 25317 INTERSTATE 45  
 THE WOODLANDS, TX 77380  
 Tel: 281-350-2323

**LANDSCAPE ARCHITECT**  
**LANDESIGN GROUP**  
 17041 EL CAMINO REAL  
 SUITE 204  
 HOUSTON, TX 77058  
 Tel: 281.486.4040

**2024 SMITH & SPILLANE MS RENOVATIONS**  
**SPILLANE MIDDLE SCHOOL**  
 13403 WOODS-SPILLANE BLVD, CYPRESS, TX 77429  
 CFSID PROJECT NO: 24-02-5751-R-RFP


Revision / Submission	Date
2	02-11-25

Project Number: 23073  
 Date: 26 JANUARY 2025  
 Drawn By: WHL / KLO

**ELECTRICAL LIGHTING**  
**FIRST FLOOR PLAN -**  
**AREA 'H'**

**E2.08**

**1 ELECTRICAL LIGHTING FLOOR PLAN - LEVEL 1 - AREA H**  
 Scale: 1/8" = 1'-0"

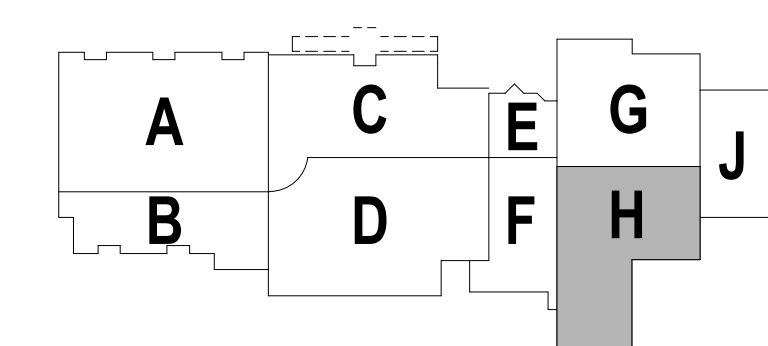

ELECTRICAL KEYED NOTES	
1	LOCATE DIGITAL LIGHTING CONTROLLER AND IF SHOWN, PLENUM RATED, EMERGENCY LOAD CONTROL, RELAY / TRANSFER SWITCH ABOVE ACCESSIBLE CEILING IN CORRIDOR / ANCILLARY SPACE DIRECTLY OUTSIDE OF ENTRY DOOR. PROVIDE LABEL IDENTIFYING ASSOCIATED SPACE, GRID MARKERS WITH WORDING PER SPECIFICATIONS. REFER TO DETAILS.
2	LOCATE DIGITAL LIGHTING CONTROLLER AND IF SHOWN, PLENUM RATED, EMERGENCY LOAD CONTROL, RELAY / TRANSFER SWITCH WALL MOUNTED ADJACENT TO NORMAL POWER PANEL. PROVIDE LABEL IDENTIFYING ASSOCIATED SPACE WITH WORDING PER SPECIFICATIONS. REFER TO DETAILS.

**Salas O'Brien**  
 salesobrien.com 281-664-1900  
 Houston, TX 77007  
 10930 W. Sam Houston Pkwy North, Suite 900  
 Houston, TX 77064  
 Registration: F-111  
 Project No: 2024-0029-00

**NATEX**  
 CORPORATION ARCHITECTS  
 www.nateearchitects.com  
 447 Heights Boulevard  
 Houston, TX 77007  
 Phone: 713-975-9525  
 Fax: 713-780-7824

**Coleman Partners**  
 ARCHITECTS  
 3701 Kirby Drive, Suite 830  
 Houston, TX 77098  
 Tel: 832-947-1038 Fax: 282-214-5365

CONSTRUCTION DOCUMENT

**BRADLEY KALMANS**  
 20219  
 LICENSED PROFESSIONAL ENGINEER  
 02-11-2025

**CIVIL ENGINEER**  
**BROOKS AND SPARKS, INC.**  
 21020 PARK ROW  
 KATY, TX 77449  
 Tel: 281-578-9595

**STRUCTURAL ENGINEER**  
**DALLY & ASSOCIATES, INC.**  
 9800 RICHMOND AVE.  
 SUITE 400  
 HOUSTON, TX 77042  
 Tel: 713-337-8881

**MEPT ENGINEER**  
**SALAS O'BRIEN**  
 10930 W. SAM HOUSTON PKWY. N.  
 SUITE 900  
 HOUSTON, TX 77064  
 Tel: 281-664-1900

**FOOD SERVICE EQUIPMENT**  
**FDP**  
 25317 INTERSTATE 45  
 THE WOODLANDS, TX 77380  
 Tel: 281-350-2323

**LANDSCAPE ARCHITECT**  
**LANDESIGN GROUP**  
 17041 EL CAMINO REAL  
 SUITE 204  
 HOUSTON, TX 77058  
 Tel: 281-486-4040

LINE TYPE LEGEND	
	EXISTING TO REMAIN
	DISCONNECT AND REMOVE
	NEW WORK


CONTRACTOR TO FIELD COORDINATE FINAL LOCATION OF ALL REPLACEMENT AND NEW LIGHTING FIXTURES WITH EXISTING CEILING MOUNTED DEVICES. AND TO NOTIFY ENGINEER IF THERE ARE ANY CONFLICTS BETWEEN EXISTING CONDITIONS AND THE NEW LIGHTING LAYOUT PRIOR TO COMMENCEMENT OF WORK.

PROVIDE NEW LIGHTING DEVICES AND SWITCH BOX EXTENSIONS IN ALL AREAS WHERE GYPSUM BOARD OR OTHER WALL COVERING ADDS TO THE THICKNESS OF WALLS. SEE ARCHITECTURAL DRAWINGS FOR AREAS AFFECTED.

PROVIDE (1) MOMENTARY BMCS OVERRIDE TIME-OUT SWITCH FOR BUILDING OCCUPIED/UNOCCUPIED ADJACENT TO OR IN THE BMCS MASTER PANEL; (1) MOMENTARY BMCS OVERRIDE TIME-OUT SWITCH FOR EXTERIOR FACADE LIGHTING ON/OFF AND (1) MOMENTARY BMCS OVERRIDE TIME-OUT SWITCH FOR PARKING LOT LIGHTING ON/OFF IN MAIN ELECTRICAL.

**LIGHTING GENERAL NOTES**

- CONNECT NEW LIGHT FIXTURES TO EXISTING NORMAL POWER CIRCUITS LEFT IN PLACE AFTER DEMOLITION OR NEW AS SHOWN. PROVIDE EMERGENCY CIRCUIT FOR HATCHED FIXTURES AND/OR EXIT SIGNS. EXTEND WIRING WITH MATCHING CONDUCTORS / CONDUIT TO EXISTING LOCATION AND/OR NEW FIXTURES. FIELD VERIFY CONNECTED LOAD NOT TO EXCEED 3500 W @ 277V. TYPICAL.
- LOCATION OF NEW / REPLACEMENT LIGHT FIXTURES SHALL RE-USE EXISTING J-BOX AND EXISTING LIGHT FIXTURE WHIPS AS PRACTICAL. EXTEND WIRING WITH MATCHING CONDUCTORS / CONDUIT AND PROVIDE NEW J-BOX ABOVE ACCESSIBLE CEILING WITH 1/2-INCH FLEXIBLE STEEL CONDUIT OR STEEL MC CABLE. LENGTH NOT TO EXCEED 6 FEET. "DAISY CHAINING" LIGHT FIXTURES INSTALLED FOR LAY-UP AREAS IS NOT ALLOWED. FOR NON-ACCESSIBLE CEILINGS, LIGHT FIXTURE WHIPS SHALL BE 1/2-INCH FLEXIBLE STEEL CONDUIT. LENGTH AS REQUIRED TO MAKE A TAP AT AN ACCESSIBLE J-BOX. RECESSED LIGHT FIXTURES IN NON-ACCESSIBLE CEILINGS MAY BE DAISY CHAINED USING THE LIGHT FIXTURE'S INTEGRAL, UL LISTED J-BOX OR INTERNAL WIRE WAY THAT IS ACCESSIBLE THROUGH FIXTURE FROM BELOW THE CEILING. REFER TO 26 05 33 CONDUIT SYSTEMS.
- PROVIDE NEW LIGHTING CONTROLS, SENSORS AND ASSOCIATED DEVICES. 20A EMERGENCY LOAD CONTROL RELAYS AND/OR TRANSFER SWITCHES. REFER TO SPECIFICATIONS AND DETAIL SHEETS.
- LOCATE DIGITAL LIGHTING CONTROLLER AND / OR EMERGENCY LOAD CONTROL RELAY ABOVE ACCESSIBLE CEILING 12 FEET AFF OR BELOW ADJACENT TO SWITCH CONTROLLING THE SPACE. IN NON-ACCESSIBLE AND / OR HIGH CEILING AREAS, LOCATE DIGITAL LIGHTING CONTROLLER IN ADJACENT ANCILLARY AREA WITH ACCESSIBLE CEILING. IN AREAS WITH NO CEILING AND / OR IN EXTERIOR APPLICATIONS LOCATE ADJACENT TO PANEL SERVING THE LOAD. PROVIDE PLASTIC TAPE MACHINE TYPED NAME PLATE TO BOTTOM OF CEILING T-GRID BELOW RELAY LOCATION. WHITE LETTERS ON BLACK BACKGROUND WITH 1/4" HIGH LETTERS ON 1/2" TALL LABEL FOR DIGITAL MODULE. INDICATE AS: DLM.
- LOCATE DIGITAL LIGHTING CONTROLLER FOR CORRIDORS, GYM AND HIGH CEILING AREAS WITH NO ADJACENT ANCILLARY AREA ADJACENT TO NORMAL POWER PANEL SERVING THE LOAD. PROVIDE LABEL, GRID MARKERS WITH WORDING PER SPECIFICATIONS.
- LOCATE DIGITAL LIGHTING CONTROLLER FOR INSTRUMENTAL SPACES AND OFFICES ABOVE ACCESSIBLE CEILING IN CORRIDOR DIRECTLY OUTSIDE OF ENTRY DOOR. PROVIDE LABEL IDENTIFYING ASSOCIATED SPACE, GRID MARKERS WITH WORDING PER SPECIFICATIONS.
- OCCUPANCY/VACANCY SENSOR AND DAYLIGHTING SENSOR LOCATIONS INDICATE SPACE OR AREA CONTROLLED. CONTRACTOR TO PROVIDE ACTUAL QUANTITIES, TYPES, AND MOUNTING LOCATIONS AS RECOMMENDED BY MANUFACTURER AND IECC-2015 C405.
- SPACES WITH MULTIPLE OCCUPANCY/VACANCY SENSORS OR WHERE LINE OF SIGHT MAY BE OBSCURED SHALL BE LINKED TOGETHER FOR SIMULTANEOUS OPERATION WITHIN THE SPACE.
- CONTRACTOR SHALL MAINTAIN CONSTANT UNSWITCHED CIRCUITS FROM EXISTING SOURCE AND/OR NEW AS SHOWN FOR EMERGENCY FIXTURES, EMERGENCY LOAD RELAYS, TRANSFER SWITCHES AND EXIT SIGNS.
- COORDINATE LOCATION OF LIGHT FIXTURES IN ALL MECHANICAL AND ELECTRICAL ROOMS WITH MECHANICAL EQUIPMENT, PIPING, AND ALL OTHER TRADES.
- PROVIDE SEPARATE RACEWAY SYSTEMS FOR LIGHTING CONTROL SYSTEM. CONTROL'S WIRING (DIMMERS OR OTHERWISE) SHALL NOT BE INSTALLED IN THE SAME RACEWAY AS LINE VOLTAGE. REFER TO 26 05 33.

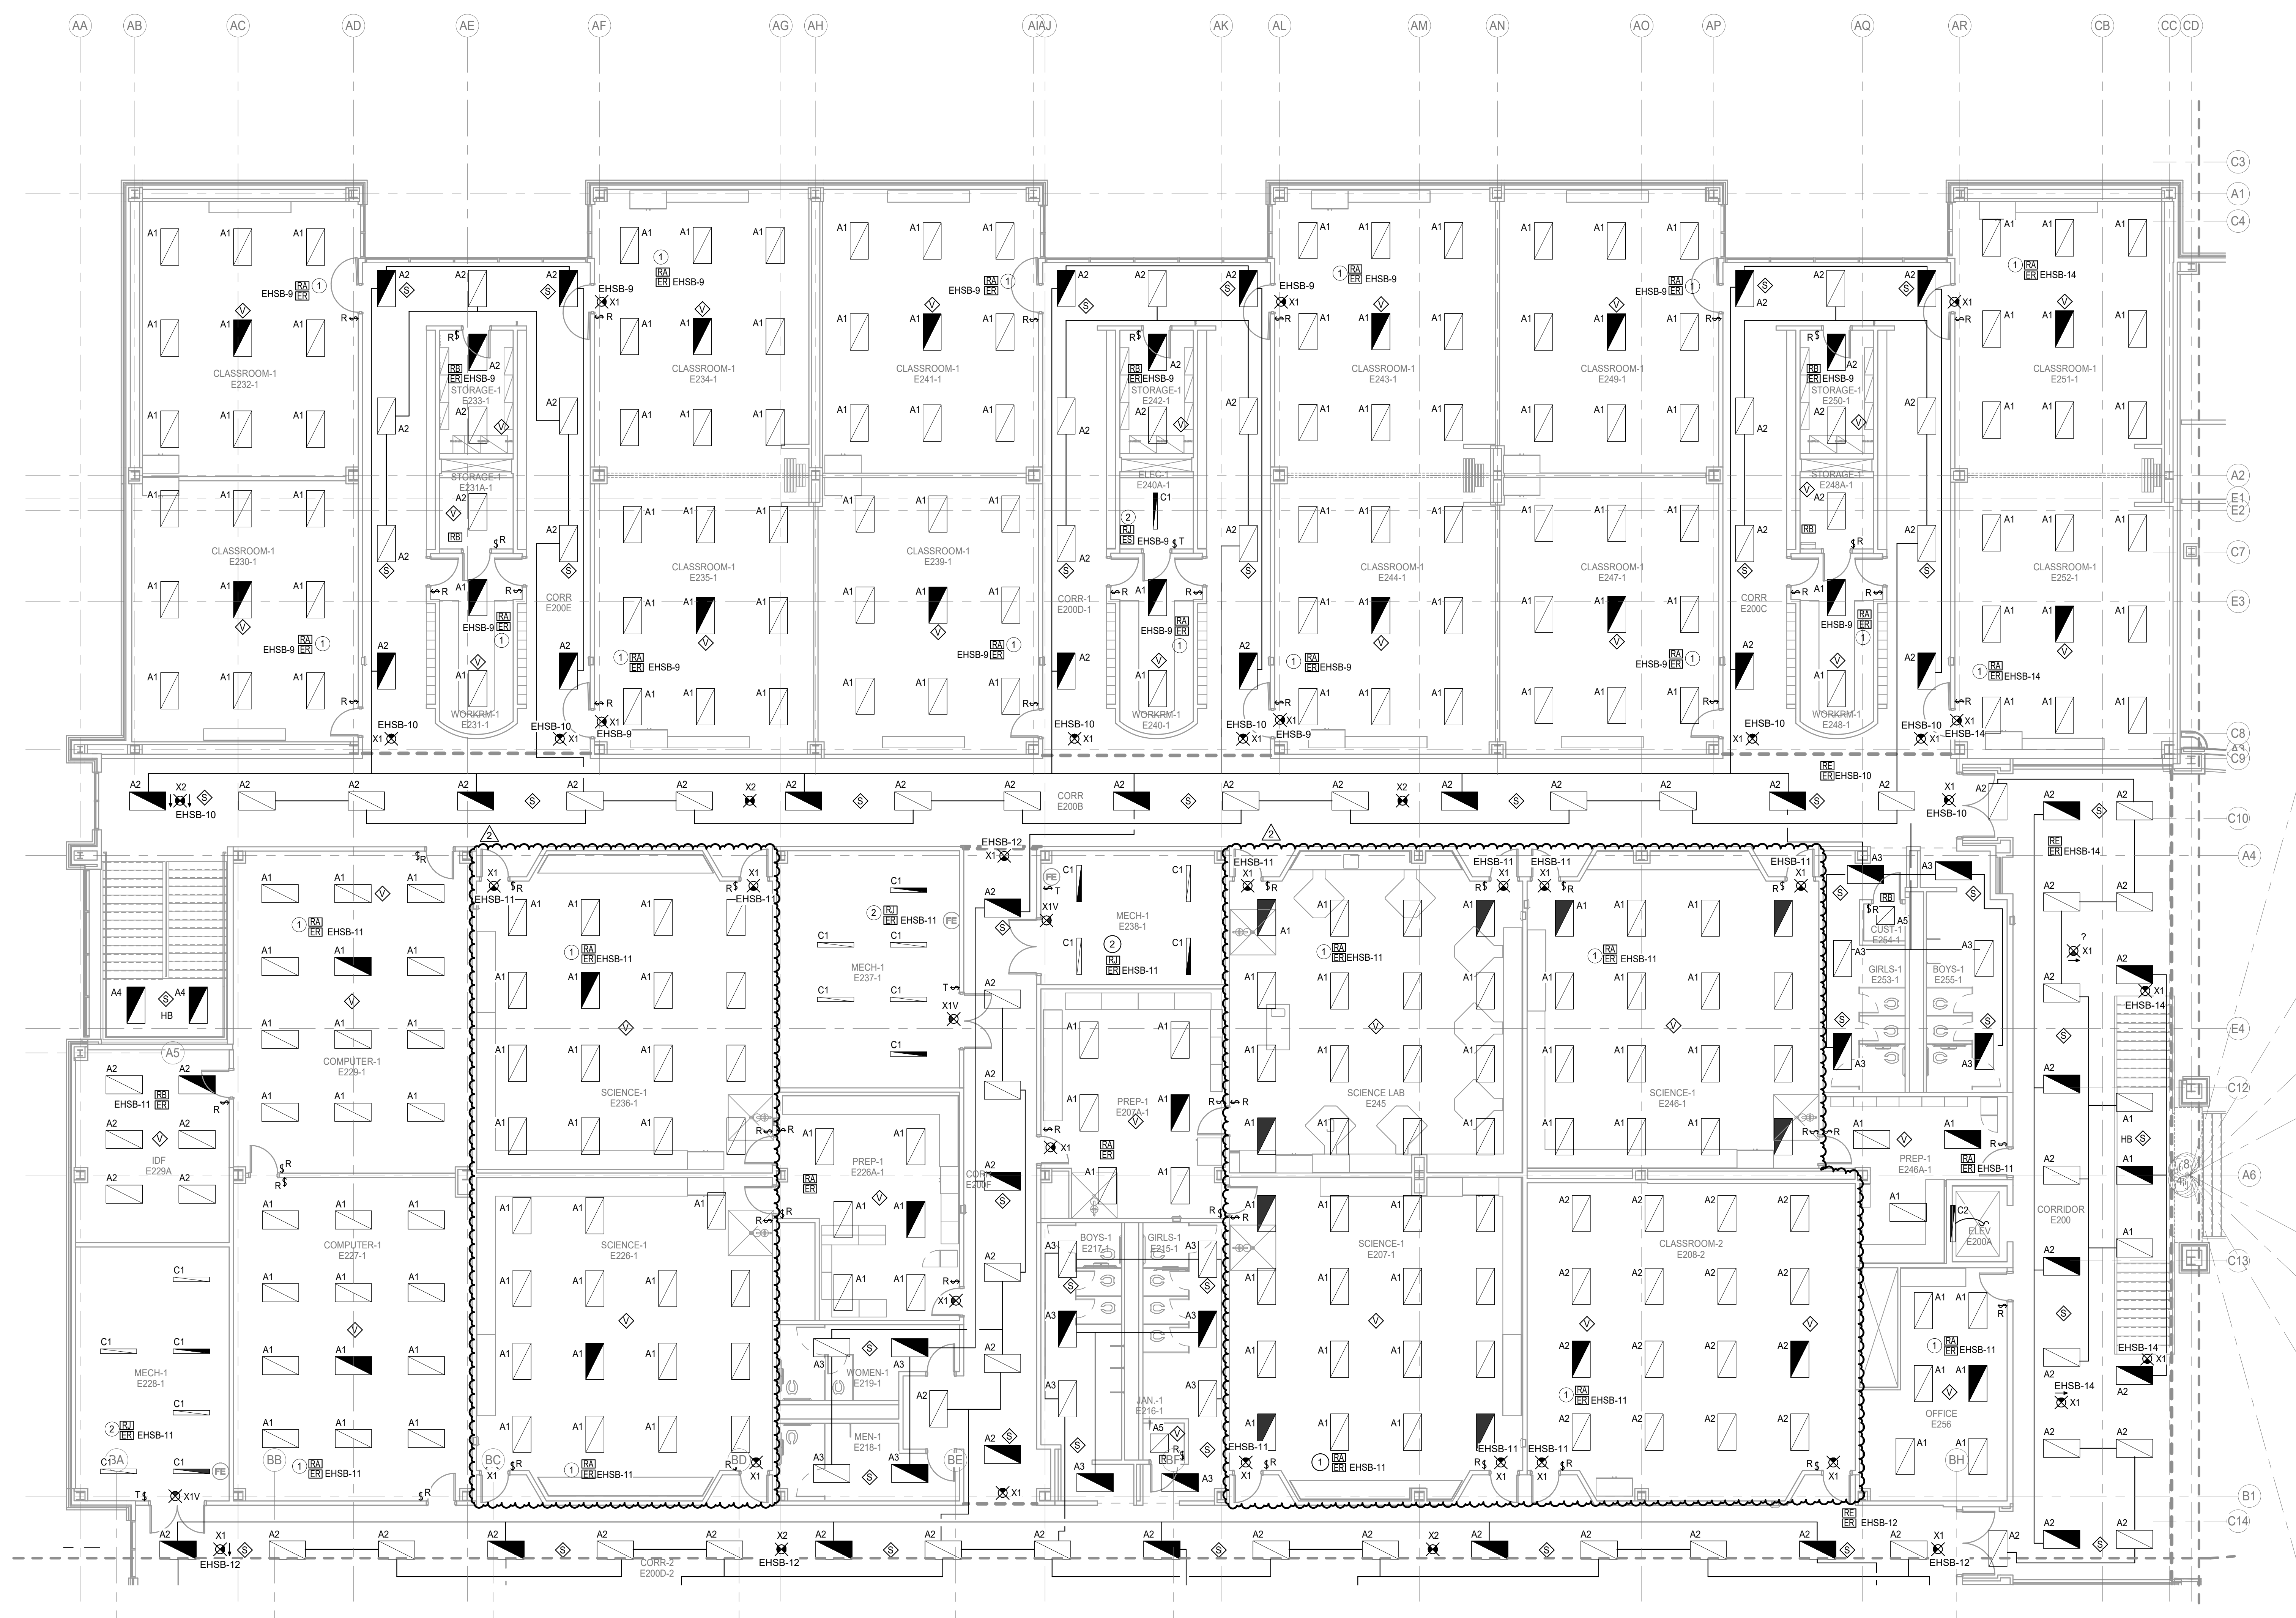

**1 ELECTRICAL LIGHTING FLOOR PLAN - LEVEL 2 - AREA A**  
 Scale: 1/8" = 1'-0"

KEY PLAN:

**2024 SMITH & SPILLANE MS RENOVATIONS**  
**SPILLANE MIDDLE SCHOOL**  
 13403 WOODS-SPILLANE BLVD, CYPRESS, TX 77429  
 CFSID PROJECT NO: 24-02-5751-R-RFP

Project Number: 23073  
 Date: 26 JANUARY 2025  
 Drawn By: WHL / KLO

ELECTRICAL LIGHTING  
 SECOND FLOOR PLAN -  
 AREA 'A'

**E2.10**

Revision	Submission
2	Addendum 03 02-14-25



ELECTRICAL KEYED NOTES	
1	LOCATE DIGITAL LIGHTING CONTROLLER AND IF SHOWN, PLENUM RATED, EMERGENCY LOAD CONTROL RELAY / TRANSFER SWITCH ABOVE ACCESSIBLE CEILING IN CORRIDOR / ANCILLARY SPACE DIRECTLY OUTSIDE OF ENTRY DOOR. PROVIDE LABEL IDENTIFYING ASSOCIATED SPACE. GRID MARKERS WITH WORDING PER SPECIFICATIONS. REFER TO DETAILS.
2	LOCATE DIGITAL LIGHTING CONTROLLER AND IF SHOWN, PLENUM RATED, EMERGENCY LOAD CONTROL RELAY / TRANSFER SWITCH WALL MOUNTED ADJACENT TO NORMAL POWER PANEL. PROVIDE LABEL IDENTIFYING ASSOCIATED SPACE WITH WORDING PER SPECIFICATIONS. REFER TO DETAILS.

**Salas O'Brien**  
 salasobrien.com 281-664-1900  
 Houston  
 18930 W. Sam Houston Pkwy North, Suite 900  
 Houston, TX 77064  
 Registration: F-4111  
 Project No: 2024-0209-00

LINE TYPE LEGEND	
	EXISTING TO REMAIN
	DISCONNECT AND REMOVE
	NEW WORK


CONTRACTOR TO FIELD COORDINATE FINAL LOCATION OF ALL REPLACEMENT AND NEW LIGHTING FIXTURES WITH EXISTING CEILING MOUNTED DEVICES. AND TO NOTIFY ENGINEER IF THERE ARE ANY CONFLICTS BETWEEN EXISTING CONDITIONS AND THE NEW LIGHTING LAYOUT PRIOR TO COMMENCEMENT OF WORK.

PROVIDE NEW LIGHTING DEVICES AND SWITCH BOX EXTENSIONS IN ALL AREAS WHERE GYPSUM BOARD OR OTHER WALL COVERINGS ADDS TO THE THICKNESS OF WALLS. SEE ARCHITECTURAL DRAWINGS FOR AREAS AFFECTED.

PROVIDE (1) MOMENTARY BMCS OVERRIDE TIME-OUT SWITCH FOR BUILDING OCCUPIED/UNOCCUPIED ADJACENT TO OR IN THE BMCS MASTER PANEL; (1) MOMENTARY BMCS OVERRIDE TIME-OUT SWITCH FOR EXTERIOR FACADE LIGHTING ON/OFF AND (1) MOMENTARY BMCS OVERRIDE TIME-OUT SWITCH FOR PARKING LOT LIGHTING ON/OFF IN MAIN ELECTRICAL.


**LIGHTING GENERAL NOTES**

- CONNECT NEW LIGHT FIXTURES TO EXISTING NORMAL POWER CIRCUITS LEFT IN PLACE AFTER DEMOLITION OR NEW AS SHOWN. PROVIDE EMERGENCY CIRCUIT FOR HATCHED FIXTURES AND/OR EXIT SIGNS. EXTEND WIRING WITH MATCHING CONDUCTORS / CONDUIT TO EXISTING LOCATION AND/OR NEW FIXTURES. FIELD VERIFY CONNECTED LOAD NOT TO EXCEED 3500 W @ 277V, TYPICAL.
- LOCATION OF NEW / REPLACEMENT LIGHT FIXTURES SHALL RE-USE EXISTING J-BOX AND EXISTING LIGHT FIXTURE WHIPS AS PRACTICAL. EXTEND WIRING WITH MATCHING CONDUCTORS / CONDUIT AND PROVIDE NEW J-BOX ABOVE ACCESSIBLE CEILING WITH 1/2-INCH FLEXIBLE STEEL CONDUIT OR STEEL MC CABLE. LENGTH NOT TO EXCEED 6 FEET. "DAISY CHAINING" LIGHT FIXTURES INSTALLED FOR LAY-IN CEILING AREAS IS NOT ALLOWED. FOR NON-ACCESSIBLE CEILINGS, LIGHT FIXTURE WHIPS SHALL BE 1/2-INCH FLEXIBLE STEEL CONDUIT. LENGTH AS REQUIRED TO MAKE A TAP AT AN ACCESSIBLE J-BOX. RECESSED LIGHT FIXTURES IN NON-ACCESSIBLE CEILINGS MAY BE DAISY CHAINED USING THE LIGHT FIXTURE'S INTEGRAL, UL LISTED J-BOX OR INTERNAL WIRE WAY THAT IS ACCESSIBLE THROUGH FIXTURE FROM BELOW THE CEILING. REFER TO 26 05 33 CONDUIT SYSTEMS.
- PROVIDE NEW LIGHTING CONTROLS, SENSORS AND ASSOCIATED DEVICES. 20A EMERGENCY LOAD CONTROL RELAYS AND/OR TRANSFER SWITCHES. REFER TO SPECIFICATIONS AND DETAIL SHEETS.
- LOCATE DIGITAL LIGHTING CONTROLLER AND / OR EMERGENCY LOAD CONTROL RELAY ABOVE ACCESSIBLE CEILING 12 FEET AFF OR BELOW ADJACENT TO SWITCH CONTROLLING THE SPACE. IN NON-ACCESSIBLE AND / OR HIGH CEILING AREAS, LOCATE DIGITAL LIGHTING CONTROLLER IN ADJACENT ANCILLARY AREA WITH ACCESSIBLE CEILING. IN AREAS WITH NO CEILING AND / OR IN EXTERIOR APPLICATIONS LOCATE ADJACENT TO PANEL SERVING THE LOAD. PROVIDE PLASTIC TAPE MACHINE TYPED NAME PLATE TO BOTTOM OF CEILING T-GRID BELOW RELAY LOCATION. WHITE LETTERS ON BLACK BACKGROUND WITH 1/4" HIGH LETTERS ON 1/2" TALL LABEL FOR DIGITAL MODULE. INDICATE AS: DLM.
- LOCATE DIGITAL LIGHTING CONTROLLER FOR CORRIDORS, GYM AND HIGH CEILING AREAS WITH NO ADJACENT ANCILLARY AREA ADJACENT TO NORMAL POWER PANEL SERVING THE LOAD. PROVIDE LABEL, GRID MARKERS WITH WORDING PER SPECIFICATIONS.
- LOCATE DIGITAL LIGHTING CONTROLLER FOR INSTRUCTIONAL SPACES AND OFFICES ABOVE ACCESSIBLE CEILING IN CORRIDOR DIRECTLY OUTSIDE OF ENTRY DOOR. PROVIDE LABEL IDENTIFYING ASSOCIATED SPACE. GRID MARKERS WITH WORDING PER SPECIFICATIONS.
- OCCUPANCY/VACANCY SENSOR AND DAYLIGHTING SENSOR LOCATIONS INDICATE SPACE OR AREA CONTROLLED. CONTRACTOR TO PROVIDE ACTUAL QUANTITIES, TYPES, AND MOUNTING LOCATIONS AS RECOMMENDED BY MANUFACTURER AND IECC-2015 C405.
- SPACES WITH MULTIPLE OCCUPANCY/VACANCY SENSORS OR WHERE LINE OF SIGHT MAY BE OBSCURED SHALL BE LINKED TOGETHER FOR SIMULTANEOUS OPERATION WITHIN THE SPACE.
- CONTRACTOR SHALL MAINTAIN CONSTANT UNSWITCHED CIRCUITS FROM EXISTING SOURCE AND/OR NEW AS SHOWN FOR EMERGENCY FIXTURES, EMERGENCY LOAD RELAYS, TRANSFER SWITCHES AND EXIT SIGNS.
- COORDINATE LOCATION OF LIGHT FIXTURES IN ALL MECHANICAL AND ELECTRICAL ROOMS WITH MECHANICAL EQUIPMENT, PIPING, AND ALL OTHER TRADES.
- PROVIDE SEPARATE RACEWAY SYSTEMS FOR LIGHTING CONTROL SYSTEM. CONTROL'S WIRING (DIMMERS OR OTHERWISE) SHALL NOT BE INSTALLED IN THE SAME RACEWAY AS LINE VOLTAGE. REFER TO 26 05 33.

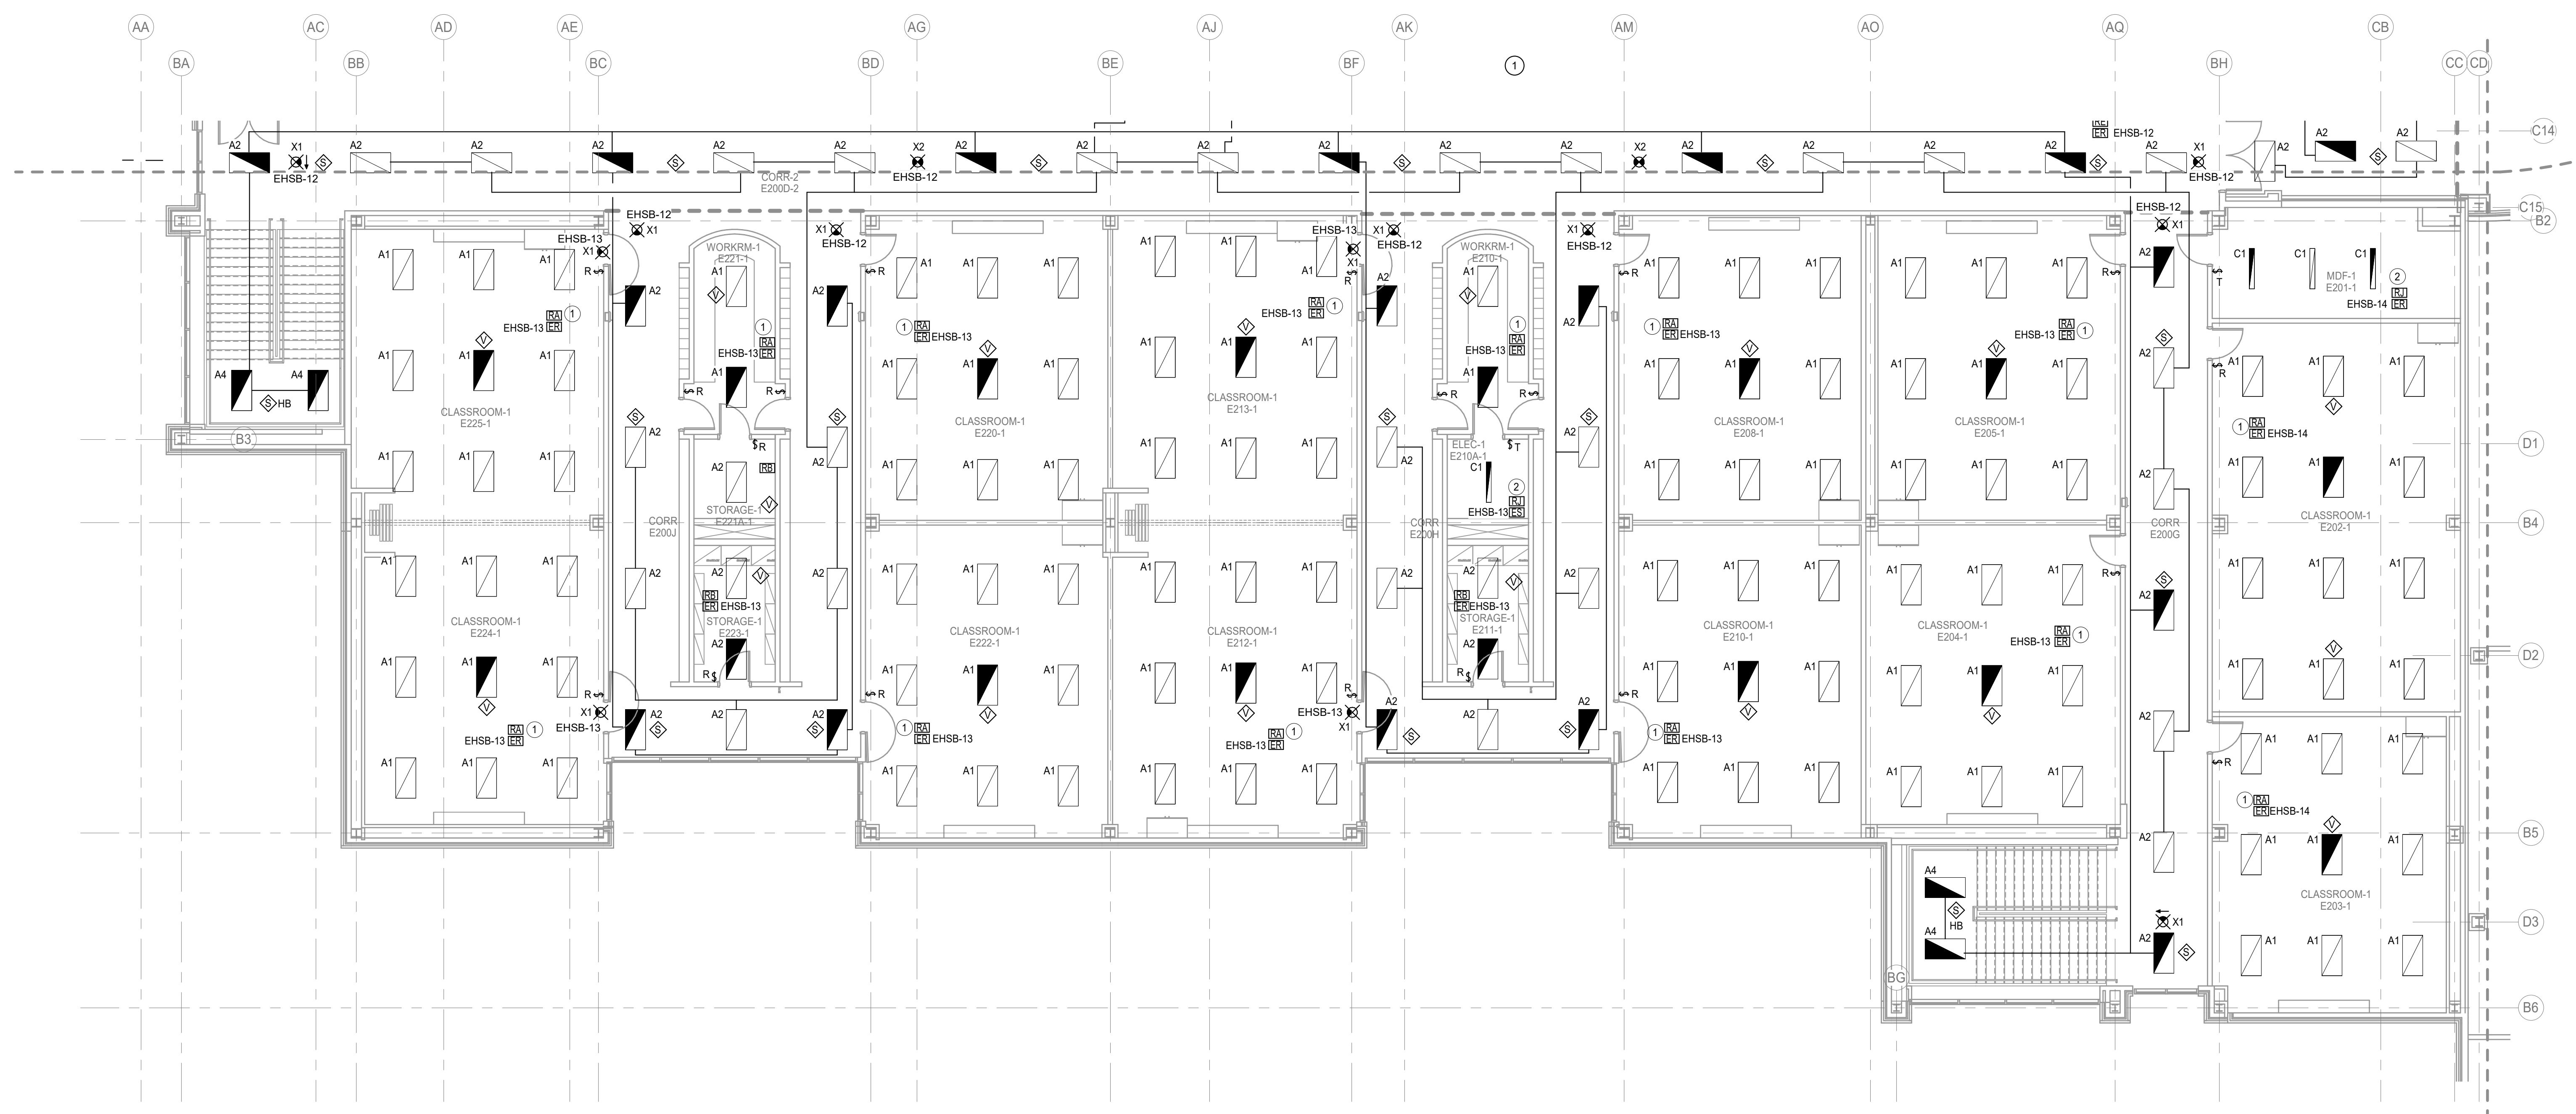

**1 ELECTRICAL LIGHTING FLOOR PLAN - LEVEL 2 - AREA B**  
 Scale: 1/8" = 1'-0"

KEY PLAN:  
 Project Number: 23073  
 Date: 26 JANUARY 2025  
 Drawn By: WHL / KLO

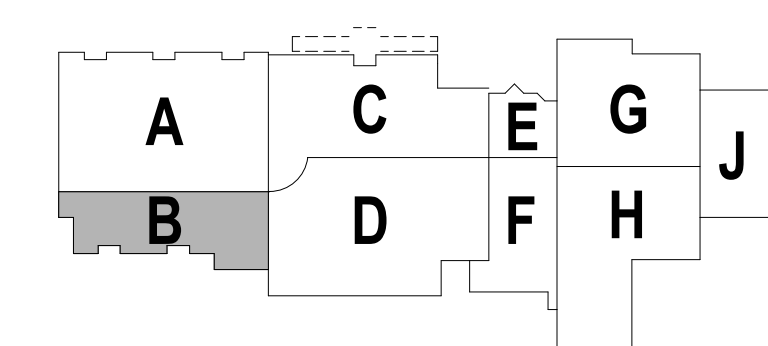

**NATEX**  
 CORPORATION  
 ARCHITECTS  
 www.natearchitects.com  
 447 Heights Boulevard  
 Houston, TX 77007  
 Phone: 713-975-9525  
 Fax: 713-780-7824

**Coleman Partners**  
 ARCHITECTS  
 cpartners.com  
 3701 Kirby Drive, Suite 830  
 Houston, TX 77098  
 Tel: 832.947.1038 Fax: 282.214.5365

CONSTRUCTION DOCUMENT  
 02-11-2025

**BRADLEY KALMANS**  
 ARCHITECT  
 80219  
 CENSUS  
 02-11-2025

**CIVIL ENGINEER**  
**BROOKS AND SPARKS, INC.**  
 21020 PARK ROW  
 KATY, TX 77449  
 Tel: 281.578.9595

**STRUCTURAL ENGINEER**  
**DALLY + ASSOCIATES, INC.**  
 9800 RICHMOND AVE.  
 SUITE 400  
 HOUSTON, TX 77024  
 Tel: 713.337.8881

**MEPT ENGINEER**  
**SALAS O'BRIEN**  
 10930 W. SAM HOUSTON PKWY. N.  
 SUITE 900  
 HOUSTON, TX 77064  
 Tel: 281.664.1900

**FOOD SERVICE EQUIPMENT**  
**FDP**  
 25317 INTERSTATE 45  
 THE WOODLANDS, TX 77380  
 Tel: 281.350.2323

**LANDSCAPE ARCHITECT**  
**LANDESIGN GROUP**  
 17041 EL CAMINO REAL  
 SUITE 204  
 HOUSTON, TX 77058  
 Tel: 281.486.4040

**2024 SMITH & SPILLANE MS RENOVATIONS**  
**SPILLANE MIDDLE SCHOOL**  
 13403 WOODS-SPILLANE BLVD, CYPRESS, TX 77429  
 CFSID PROJECT NO: 24-02-5751-R-RFP

Project Number: 23073  
 Date: 26 JANUARY 2025  
 Drawn By: WHL / KLO  
**ELECTRICAL LIGHTING**  
**SECOND FLOOR PLAN -**  
**AREA 'B'**  
**E2.11**

**Salas O'Brien**  
 salesobrien.com 281-664-1900  
 Houston 10930 W. Sam Houston Pkwy North, Suite 900  
 Houston, TX 77064  
 Registration: F-4111  
 Project No: 2024-0209-00

**NATEX**  
 CORPORATION  
 ARCHITECTS  
 www.nateearchitects.com  
 447 Heights Boulevard  
 Houston, TX 77007  
 Phone: 713-975-9525  
 Fax: 713-780-7824

**Coleman Partners**  
 ARCHITECTS  
 www.colemanpartners.com  
 3701 Kirby Drive, Suite 830  
 Houston, TX 77098  
 Tel: 832-947-1038 Fax: 281-214-5365

**LINE TYPE LEGEND**

---	EXISTING TO REMAIN
- - -	DISCONNECT AND REMOVE
---	NEW WORK

WHERE ANY WALL TERMINATES AT THE SAME LOCATION AS AN EXISTING WALL MOUNTED ELECTRICAL AND TECHNOLOGY DEVICE, CONTRACTOR SHALL RELOCATE DEVICE AND EXTEND WIRING AND CONDUIT AS INSTRUCTED BY OWNER OR ITS REPRESENTATIVE.

PROVIDE NEW POWER DEVICES AND SWITCH BOX EXTENSIONS IN ALL AREAS WHERE GYMnasium BOARD OR OTHER WALL COVERING ADDS TO THE THICKNESS OF WALLS. SEE ARCHITECTURAL DRAWINGS FOR AREAS AFFECTED.

TEMPORARILY DISCONNECT AND REMOVE ALL CEILING / WALL MOUNTED ELECTRICAL AND FIRE ALARM DEVICES FOR AREAS THAT REQUIRE CEILING / WALL REMOVALS AND/OR REPLACEMENT, INCLUDING MECHANICAL, TECHNOLOGY, FIRE ALARM, SPRINKLERS AND PLUMBING SCOPE OF WORK. AFTER COMPLETION RELOCATE TO PREVIOUS LOCATION AS REQUIRED.

WHERE ANY EXISTING JUNCTION BOX AND/OR PULLBOX IS LOCATED AT A NEW NON-ACCESSIBLE CEILING AREA, CONTRACTOR SHALL RELOCATE DEVICE AND EXTEND WIRING AND CONDUIT ABOVE NEAREST ACCESSIBLE CEILING AS INSTRUCTED BY OWNER OR ITS REPRESENTATIVE. SEE ARCHITECTURAL DRAWINGS FOR AREAS AFFECTED.


EXISTING RACEWAYS AND LOCATION OF ELECTRICAL OUTLETS ON EXISTING WALLS TO REMAIN SHALL BE RE-USED AS PRACTICAL FOR NEW DEVICES AS PART OF NEW WORK.

**POWER GENERAL NOTES**

- REFER TO TECHNOLOGY DRAWINGS, DIVISION 27 AND 28 FOR TELECOMMUNICATION PATHWAYS AND OTHER ADDITIONAL REQUIREMENTS TO BE PROVIDED AS SPECIFIED IN DIVISION 26.
- WHERE ANY NEW WALL TERMINATES AT THE SAME LOCATION AS AN EXISTING WALL MOUNTED ELECTRICAL AND TECHNOLOGY DEVICE, CONTRACTOR SHALL RELOCATE DEVICE AND EXTEND WIRING AND CONDUIT AS INSTRUCTED BY OWNER OR ITS REPRESENTATIVE.
- WHERE ANY EXISTING JUNCTION BOX AND/OR PULLBOX IS LOCATED AT A NEW NON-ACCESSIBLE CEILING AREA, CONTRACTOR SHALL RELOCATE DEVICE AND EXTEND WIRING AND CONDUIT ABOVE NEAREST ACCESSIBLE CEILING AS INSTRUCTED BY OWNER OR ITS REPRESENTATIVE. SEE ARCHITECTURAL DRAWINGS FOR AREAS AFFECTED.


**ELECTRICAL KEYED NOTES**

- PROVIDE NEW RECEPTACLES AS SHOWN AND CONNECT TO EXISTING CIRCUITS LEFT IN PLACE AFTER DEMOLITION. EXTEND CONDUCTORS / CONDUIT WITH MATCHING SIZE TO NEW LOCATION. FIELD VERIFY CONNECTED LOAD NOT TO EXCEED 1500VA @ 20A.  
 PROVIDE POWER TO NEW EP FROM EXISTING 200V PANEL LEFT.  
 PROVIDE NEW 20A 1P BREAKER WITH #12 WIRE.

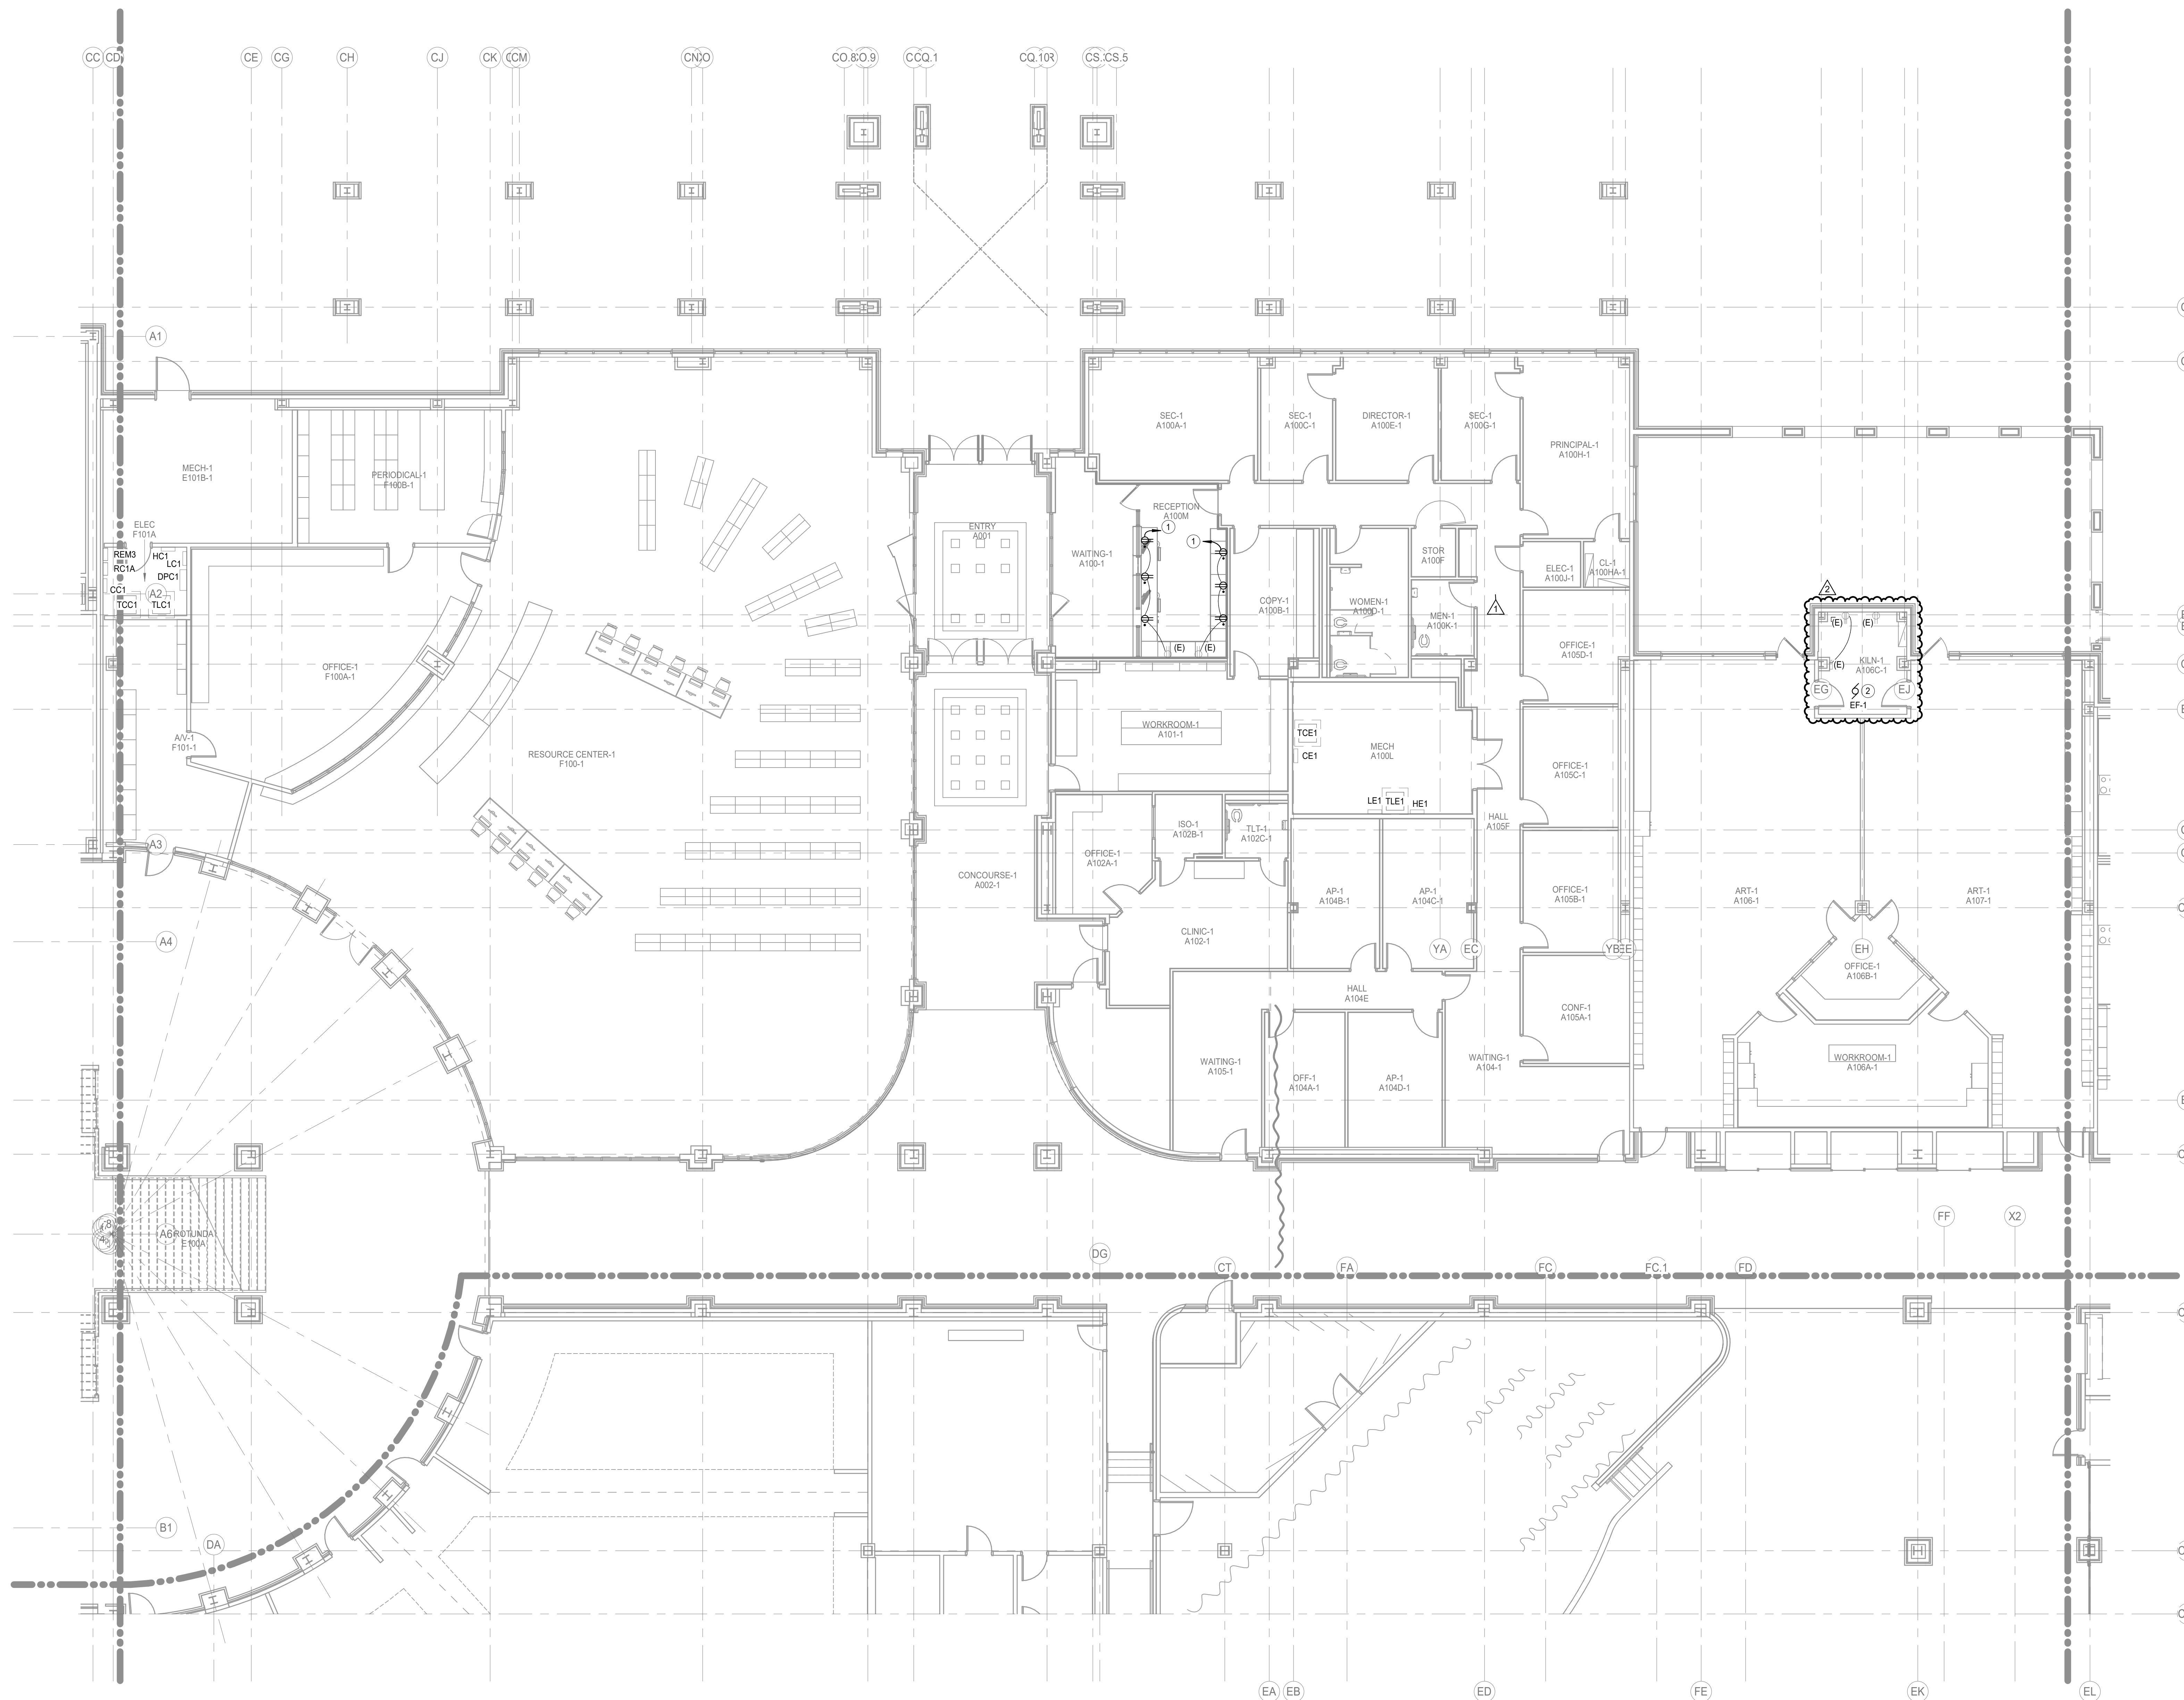

**1 ELECTRICAL POWER FLOOR PLAN - LEVEL 1 - AREA C**  
 Scale: 1/8" = 1'-0"

**KEY PLAN:**

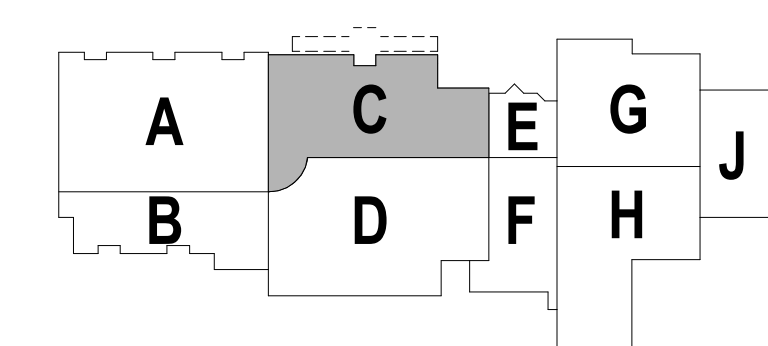

**2024 SMITH & SPILLANE MS RENOVATIONS**  
**SPILLANE MIDDLE SCHOOL**  
 13-403 WOODS-SPILLANE BLVD, CYPRESS, TX 77429  
 CFSID PROJECT NO: 24-02-5751-R-RFP

Project Number: 23073  
 Date: 26 JANUARY 2025  
 Drawn By: WHL / KLO  
**ELECTRICAL POWER FIRST FLOOR PLAN - AREA 'C'**  
**E3.03**

1	02-14-25	02-11-25
2	Addendum 03	Addendum 02

Revisions / Submission



**Salas O'Brien**  
 salasobrien.com 281-664-1900  
 Houston 10930 W. Sam Houston Pkwy North, Suite 900  
 Houston, TX 77064  
 Registration: F-4111  
 Project No: 2024-0209-00

**NATEX**  
 CORPORATION ARCHITECTS  
 www.nateearchitects.com  
 447 Heights Boulevard  
 Houston, TX 77007  
 Phone: 713-975-9525  
 Fax: 713-780-7824

**Coleman Partners**  
 ARCHITECTS  
 www.colemanpartners.com  
 3701 Kirby Drive, Suite 830  
 Houston, TX 77098  
 tel: 832.947.1038 fax: 282.214.5365

3701 Kirby Drive, Suite 830  
 Houston, TX 77098  
 tel: 832.947.1038 fax: 282.214.5365

CONSTRUCTION DOCUMENT

**Bradley Kalmans**  
 ARCHITECT  
 80219  
 CENSUS  
 02-11-2025

**CIVIL ENGINEER**  
**BROOKS AND SPARKS, INC.**  
 21020 PARK ROW  
 KATY, TX 77449  
 tel: 281.578.9595

**STRUCTURAL ENGINEER**  
**DALLY + ASSOCIATES, INC.**  
 9800 RICHMOND AVE.  
 SUITE 400  
 HOUSTON, TX 77042  
 tel: 713.337.8881

**MEPT ENGINEER**  
**SALAS O'BRIEN**  
 10930 W. SAM HOUSTON PKWY. N.  
 SUITE 900  
 HOUSTON, TX 77064  
 tel: 281.664.1900

**FOOD SERVICE EQUIPMENT**  
**FDP**  
 25317 INTERSTATE 45  
 THE WOODLANDS, TX 77380  
 tel: 281.350.2323

**LANDSCAPE ARCHITECT**  
**LANDESIGN GROUP**  
 17041 EL CAMINO REAL  
 SUITE 204  
 HOUSTON, TX 77058  
 tel: 281.486.4040

2024 SMITH & SPILLANE MS RENOVATIONS  
**SPILLANE MIDDLE SCHOOL**  
 13403 WOODS-SPILLANE BLVD, CYPRESS, TX 77429  
 CFSID PROJECT NO: 24-02-5751-R-RFP

2	Addendum 03	02-14-25
2	Revisions	Submission

Project Number: 23073  
 Date: 26 JANUARY 2025  
 Drawn By: WHL / KLO

**ELECTRICAL POWER**  
**FIRST FLOOR PLAN -**  
**AREA 'F'**

**E3.06**

**LINE TYPE LEGEND**

---	EXISTING TO REMAIN
- - -	DISCONNECT AND REMOVE
---	NEW WORK

WHERE ANY WALL TERMINATES AT THE SAME LOCATION AS AN EXISTING WALL MOUNTED ELECTRICAL AND TECHNOLOGY DEVICE, CONTRACTOR SHALL RELOCATE DEVICE AND EXTEND WIRING AND CONDUIT AS INSTRUCTED BY OWNER OR ITS REPRESENTATIVE.

PROVIDE NEW POWER DEVICES AND SWITCH BOX EXTENSIONS IN ALL AREAS WHERE GIMPSUM BOARD OR OTHER WALL COVERING ADDS TO THE THICKNESS OF WALLS. SEE ARCHITECTURAL DRAWINGS FOR AREAS AFFECTED.

TEMPORARILY DISCONNECT AND REMOVE ALL CEILING / WALL MOUNTED ELECTRICAL AND TECHNOLOGY DEVICES FOR AREAS THAT REQUIRE CEILING / WALL REMOVALS AND/OR REPLACEMENT, INCLUDING MECHANICAL, TECHNOLOGY, FIRE ALARM, SPRINKLERS AND PLUMBING SCOPE OF WORK. AFTER COMPLETION RELOCATE TO PREVIOUS LOCATION AS REQUIRED.

WHERE ANY EXISTING JUNCTION BOX AND/OR PULLBOX IS LOCATED AT A NEW NON-ACCESSIBLE CEILING AREA, CONTRACTOR SHALL RELOCATE DEVICE AND EXTEND WIRING AND CONDUIT ABOVE NEAREST ACCESSIBLE CEILING AS INSTRUCTED BY OWNER OR ITS REPRESENTATIVE. SEE ARCHITECTURAL DRAWINGS FOR AREAS AFFECTED.

EXISTING RACEWAYS AND LOCATION OF ELECTRICAL OUTLETS ON EXISTING WALLS TO REMAIN SHALL BE RE-USED AS PRACTICAL FOR NEW DEVICES AS PART OF NEW WORK.

**POWER GENERAL NOTES**



- REFER TO TECHNOLOGY DRAWINGS, DIVISION 27 AND 28 FOR TELECOMMUNICATION PATHWAYS AND OTHER ADDITIONAL REQUIREMENTS TO BE PROVIDED AS SPECIFIED IN DIVISION 28.
- WHERE ANY NEW WALL TERMINATES AT THE SAME LOCATION AS AN EXISTING WALL MOUNTED ELECTRICAL AND TECHNOLOGY DEVICE, CONTRACTOR SHALL RELOCATE DEVICE AND EXTEND WIRING AND CONDUIT AS INSTRUCTED BY OWNER OR ITS REPRESENTATIVE.
- WHERE ANY EXISTING JUNCTION BOX AND/OR PULLBOX IS LOCATED AT A NEW NON-ACCESSIBLE CEILING AREA, CONTRACTOR SHALL RELOCATE DEVICE AND EXTEND WIRING AND CONDUIT ABOVE NEAREST ACCESSIBLE CEILING AS INSTRUCTED BY OWNER OR ITS REPRESENTATIVE. SEE ARCHITECTURAL DRAWINGS FOR AREAS AFFECTED.

**FOODSERVICE GENERAL NOTES**

- ACCESSORIES AND FITTINGS PROVIDED LOOSE WITH FOODSERVICE EQUIPMENT BY SECTION 11 40 00. FIELD INSTALLED BY DIVISION 28.
- STAINLESS STEEL DISCONNECT SWITCH PROVIDED AND INSTALLED BY DIVISION 28.
- DOOR HEATER(S), LIGHT(S), COIL(S), AND PRESSURE RELIEF PORT(S) PRE-WIRED TO JUNCTION BOX AT TOP OF COLD STORAGE ASSEMBLY BY SECTION 11 40 00. FINAL CONNECTION BY DIVISION 28.

**ELECTRICAL KEYED NOTES**

- ROUTE 3/4" TO ASSOCIATED OUTDOOR UNIT ON ROOF. ROUTE PARALLEL WITH REFRIGERATION LINES.
- REFER TO DETAILS FOR RACK RECEPTACLES INSTALLATION. TYPICAL.
- PROVIDE 1" C. FROM REFRIGERATION SYSTEM TO TEMPERATURE MONITOR PANEL.
- LIGHTING IN COOLERS / FREEZERS TO BE FURNISHED WITH EQUIPMENT. FINAL CONNECTION PROVIDED BY DIVISION 28. FIELD COORDINATE EXACT LOCATION WITH CASEWORK INSTALLATION.
- PROVIDE NEW RECEPTACLES AS SHOWN AND CONNECT TO EXISTING CIRCUITS LEFT IN PLACE AFTER DEMOLITION. EXTEND CONDUCTORS / CONDUIT WITH MATCHING SIZE TO NEW LOCATION. FIELD VERIFY CONNECTED LOAD NOT TO EXCEED 1500 W @ 120 V.
- PROVIDE POWER TO NEW ROOFTOP MAINTENANCE RECEPTACLE FROM NEAREST ACCEPTABLE 120V ROOFTOP MAINTENANCE CIRCUIT. EXTEND CONDUCTORS/CONDUIT MATCHING EXISTING SIZE TO NEW RECEPTACLE. FIELD VERIFY CONNECTED LOAD NOT TO EXCEED 1500 W @ 120V OR CONTAIN MORE THAN 8 DEVICES. IF NO ACCEPTABLE CIRCUIT IS AVAILABLE AT ROOF, PROVIDE POWER FROM NEAREST ACCEPTABLE 120V PANEL. PROVIDE NEW 20A/1P BREAKER WITH #12 WIRE TO FEED NEW RECEPTACLE.
- PROVIDE NEW RECEPTACLES AS SHOWN AND CONNECT TO EXISTING CIRCUITS LEFT IN PLACE AFTER DEMOLITION. EXTEND CONDUCTORS / CONDUIT WITH MATCHING SIZE TO NEW LOCATION. FIELD VERIFY CONNECTED LOAD NOT TO EXCEED 1500 W @ 120V.

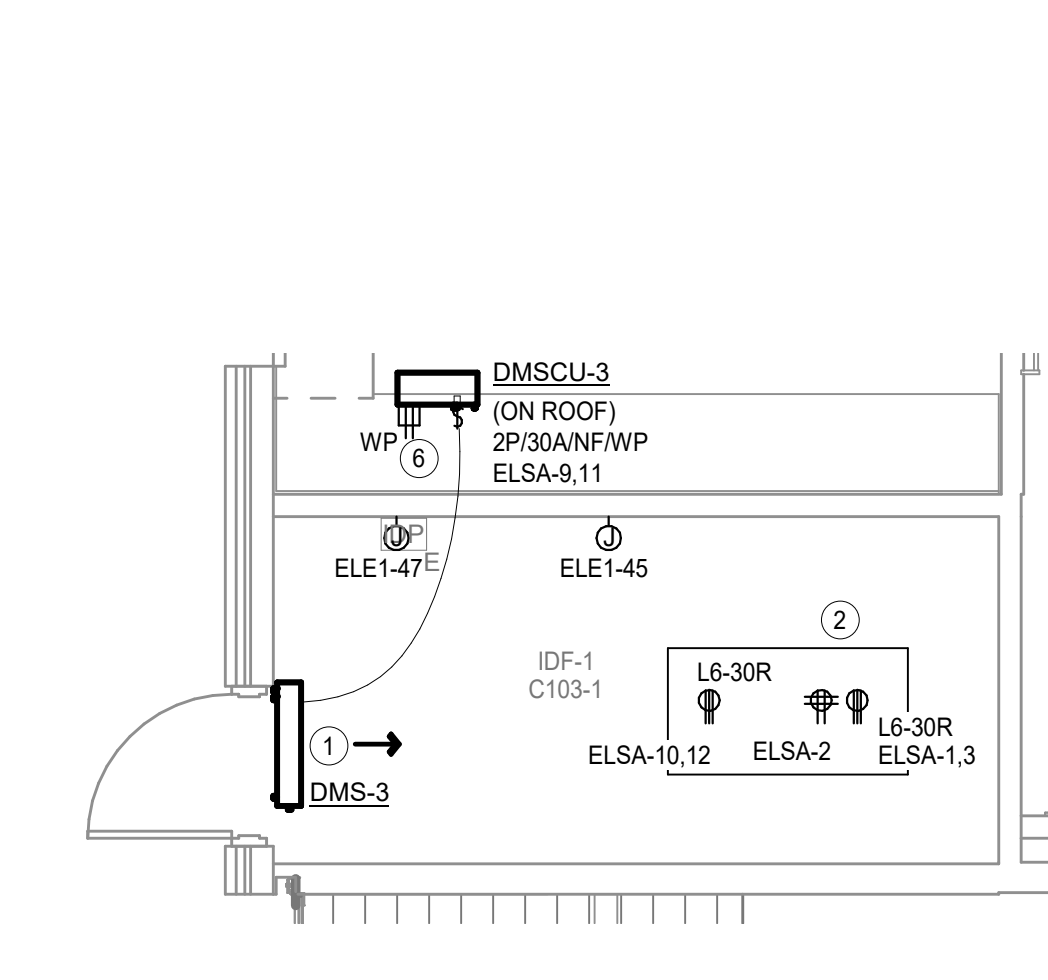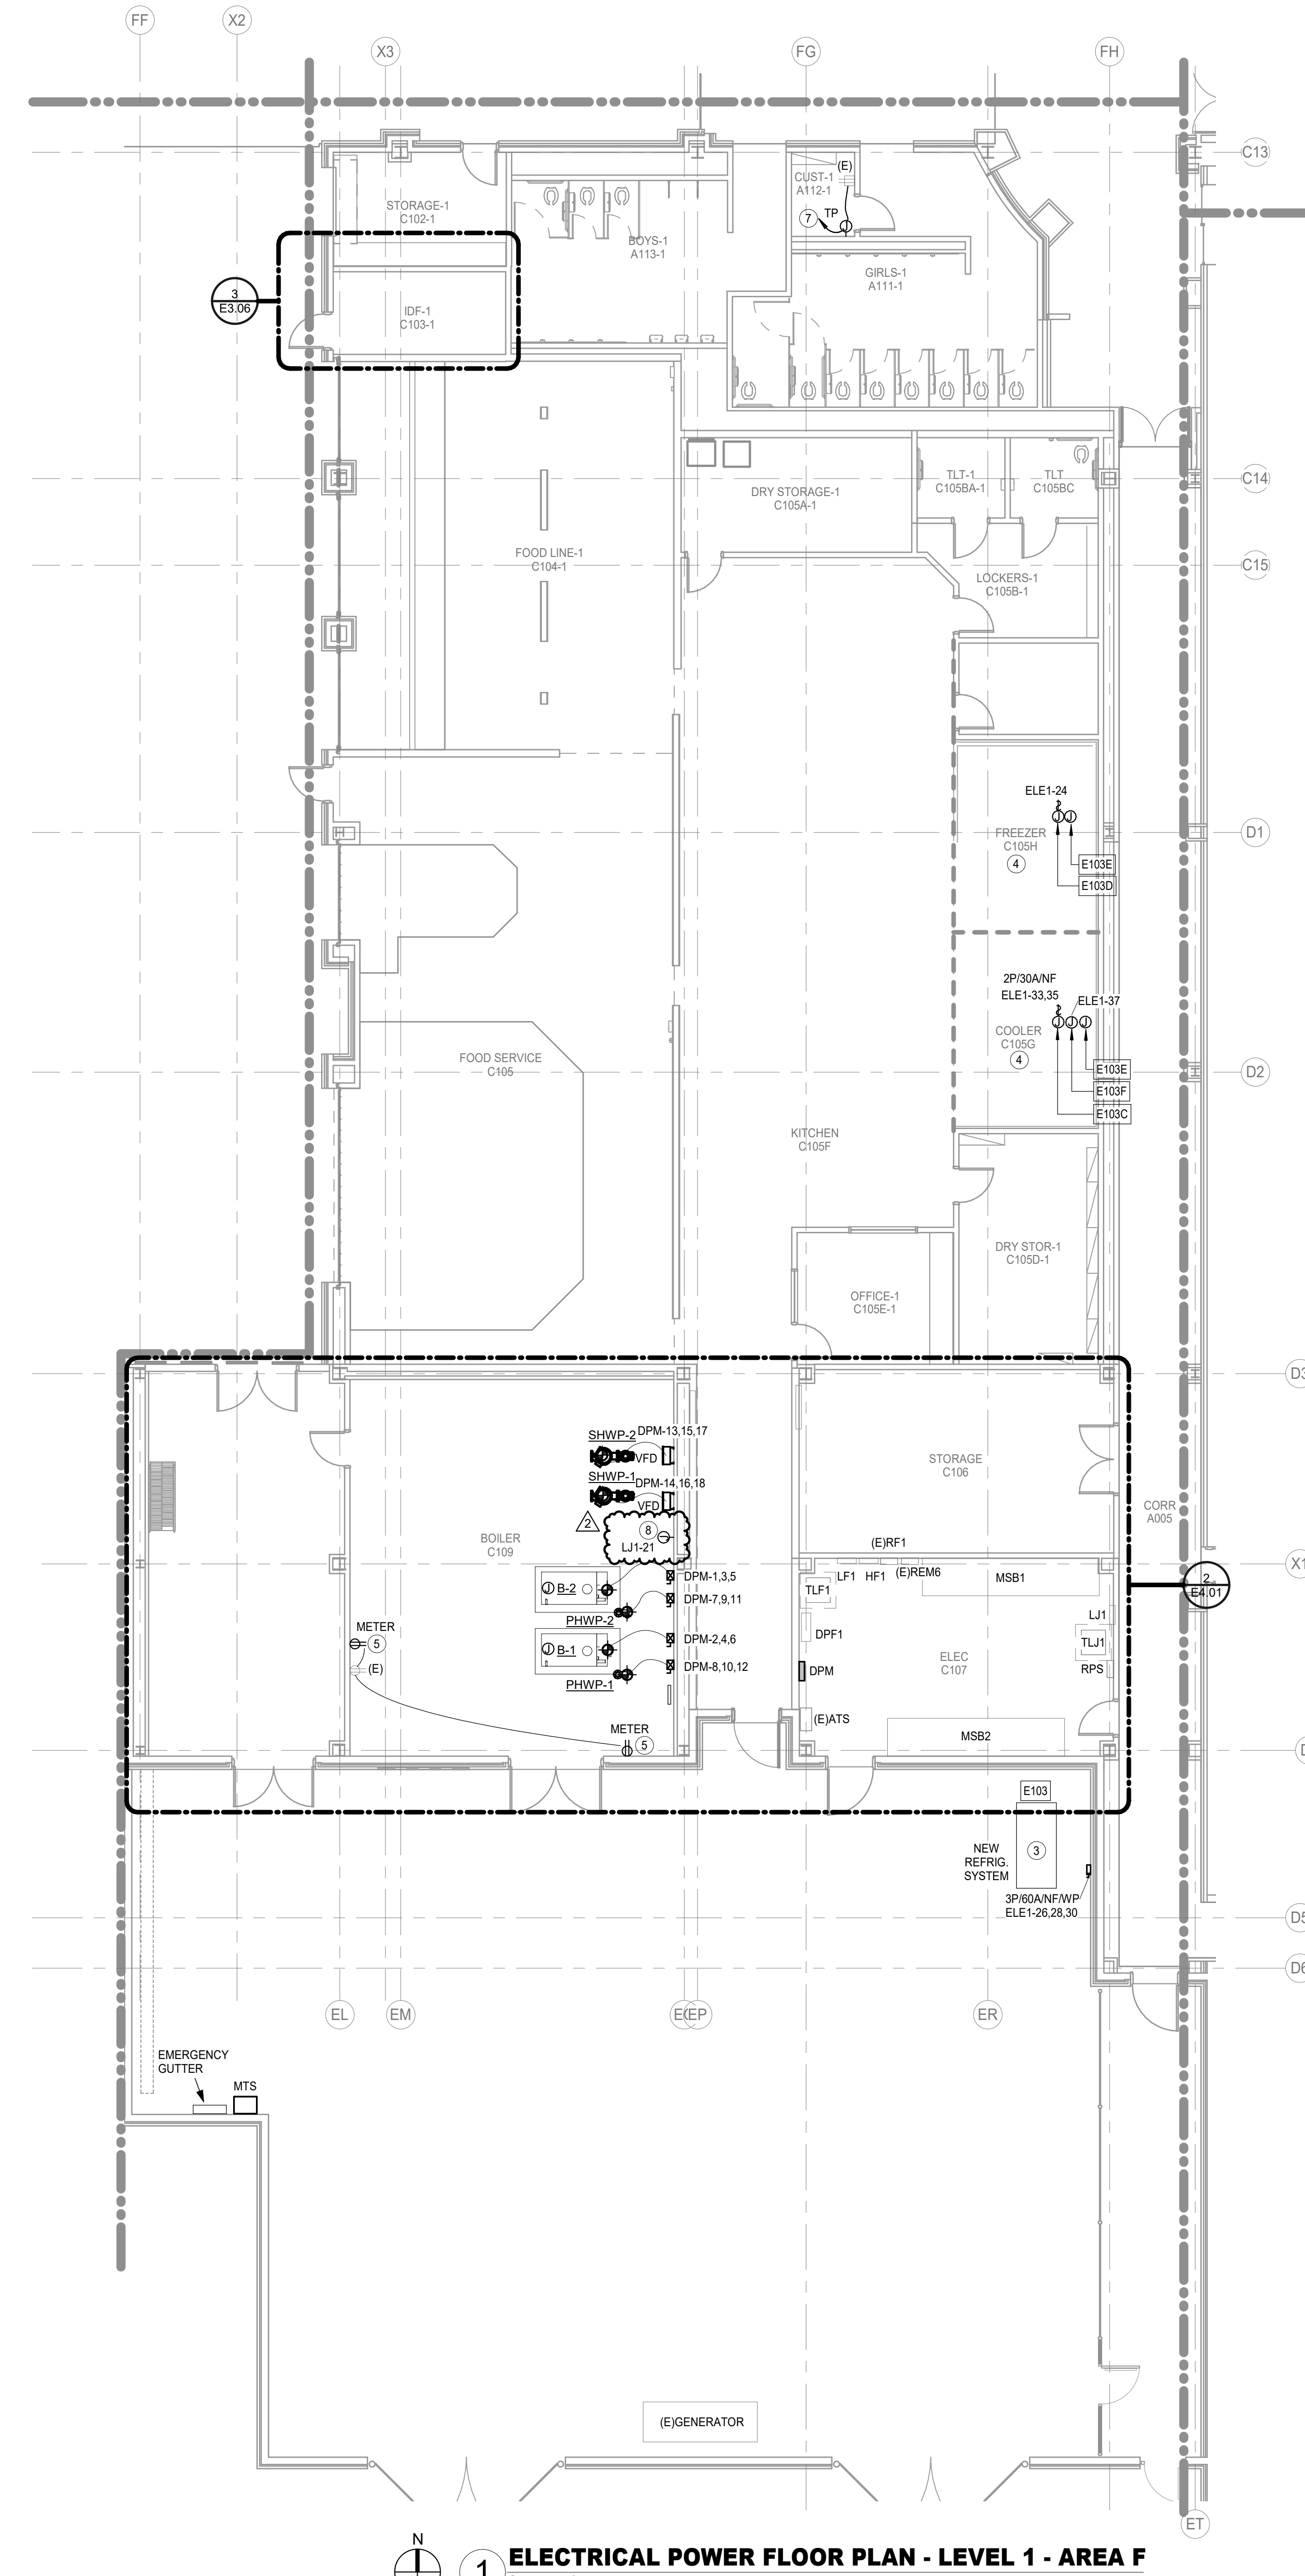

**3 ELECTRICAL POWER FLOOR PLAN - LEVEL 1 - AREA F - IDF-1**  
 Scale: 1/4" = 1'-0"

**1 ELECTRICAL POWER FLOOR PLAN - LEVEL 1 - AREA F**  
 Scale: 1/8" = 1'-0"


**FOOD SERVICE ELECTRICAL SCHEDULE**

E103	JB/DS	38.7A	208	3	REFRIGERATION SYSTEM	VERIFY	VERIFY	BTC: WEATHERPROOF DISCONNECT SWITCH
E103C	JB	18.9A	208	1	FREEZER COIL	CLG	DFA	BTC
E103D	JB	2.7A	120	1	COOLER COIL	CLG	DFA	BTC
E103E	JB	---	---	---	DATA CONNECTION	CLG	DFA	BTC: RUN TO NEAREST IDF / MDF ROOM
E103F	JB	16.0A	120	1	DRAIN LINE HEATER	CLG	DFA	BTC: DEDICATED CIRCUIT

- FOOD ESTABLISHMENT GENERAL NOTES:**
- FOOD SERVICE EQUIPMENT INSTALLATION SHALL BE IN COMPLIANCE WITH APPLICABLE BUILDING AND HEALTH CODES.
  - ALL ELECTRICAL EQUIPMENTS AND DEVICES WITHIN FOOD PREPARATION AND WAREWASH AREAS SHALL BE WEATHERPROOF OR PROVIDED WITH STAINLESS STEEL COVERS/TOPS INCLUDING ELECTRICAL PANELBOARDS.
  - LIGHTING LEVELS SHALL BE A MINIMUM 10 FOOT CANDLES 30-INCHES ABOVE FLOOR, IN WALK-IN REFRIGERATION UNITS AND DRY FOOD STORAGE.
  - LIGHTING LEVELS SHALL BE A MINIMUM 20 FOOT CANDLES AT:
    - A SURFACE WHERE FOOD IS PROVIDED FOR CONSUMER SELF-SERVICE OR WHERE FRESH PRODUCE OR PACKAGED FOODS ARE SOLD OR OFFERED FOR CONSUMPTION.
    - INSIDE EQUIPMENT SUCH AS REFRIG. AND UNDER-COUNTER REFRIGERATOR.
    - 30-INCHES ABOVE FLOOR IN AREAS USED FOR HANDWASHING, WAREWASHING, EQUIPMENT AND UTENSIL STORAGE AND IN TOILET ROOMS.
  - LIGHTING LEVELS SHALL BE A MINIMUM 50 FOOT CANDLES AT ALL SURFACES OF FOOD PREPARATION AND COOKING.
  - CONTRACTOR TO SEAL ALL PENETRATIONS THRU WALK-IN COOLER / FREEZER.


PROVIDE LISTED CLASS A GFCI PROTECTION FOR PERSONNEL FOR (A) ALL SINGLE-PHASE BRANCH RECEPTACLES RATED 150 V TO GROUND OR LESS, 30A OR LESS, AND (B) ALL THREE-PHASE BRANCH RECEPTACLES RATED 150 V TO GROUND OR LESS, 100 A OR LESS LOCATED IN KITCHEN AND ALL AREAS WITH PERMANENT PROVISIONS FOR FOOD PREPARATION, COOKING, AND FOOD SERVING.

DIMENSIONS INDICATED ARE TO BE VERIFIED BY CONTRACTOR AND ADJUSTED AS REQUIRED BY FOODSERVICE EQUIPMENT AND / OR FIELD CONDITIONS.

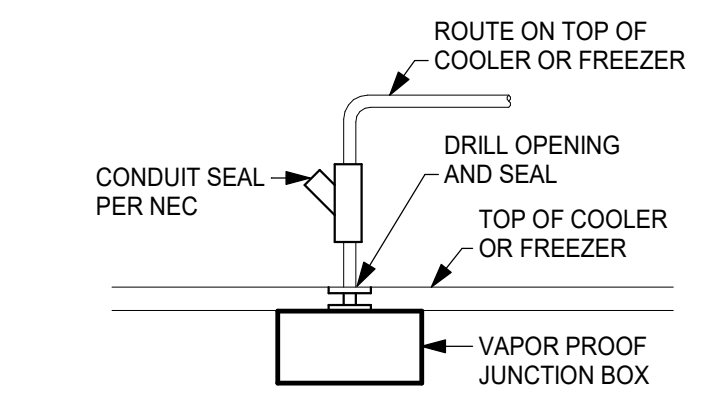

**2 COOLER/FREEZER CONDUIT PENETRATION**  
 Scale: NOT TO SCALE

**KEY PLAN:**

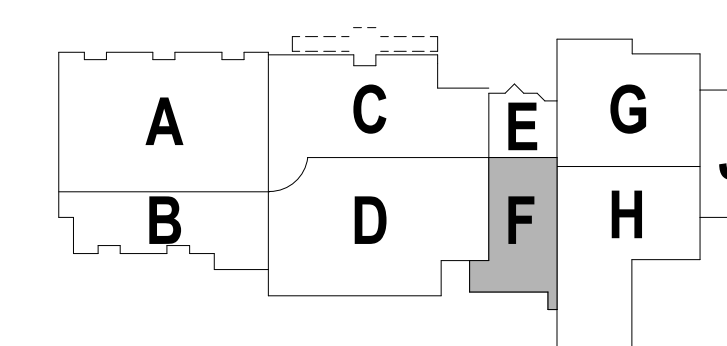





TECHNOLOGY LEGEND - 27 10 00. Table with columns: SYMBOL, DESCRIPTION, ELEVATION, BACK BOX/RACEWAY, NOTES. Includes symbols for network outlets, communications outlets, and ceiling mounted outlets.

ACCESS CONTROL LEGEND - 28 10 00 & 28 10 00.05. Table with columns: SYMBOL, DESCRIPTION, ELEVATION, BACK BOX/RACEWAY, NOTES. Includes symbols for access control panels, door access control, and door release buttons.

SUBSCRIPTS AND ABBREVIATIONS. Table with columns: TEXT, DESCRIPTION. Includes symbols for weather proofing, field elevation, finished floor, underside of canopy, wall mounted, and wire guard.

AUDIO/VIDEO LEGEND - 27 41 16.10. Table with columns: SYMBOL, DESCRIPTION, ELEVATION, BACK BOX/RACEWAY, NOTES. Includes symbols for wall and ceiling mounted projectors, flat screen displays, and interactive displays.

VIDEO SURVEILLANCE LEGEND - 28 20 00. Table with columns: SYMBOL, DESCRIPTION, ELEVATION, BACK BOX/RACEWAY, NOTES. Includes symbols for corner mount, ceiling mount, and 2-sensor cameras.

SUBSCRIPTS LEGEND - EXISTING DEVICES. Table with columns: TEXT, DESCRIPTION. Includes symbols for existing to remain, existing and to be removed, and remove existing device.

NOTES TO CONTRACTOR. List of 3 notes regarding symbol usage, coordination with project electrical contractor, and grounding requirements.

RESPONSIBILITY MATRIX. Table with columns: SCOPE ITEM, RESPONSIBILITY (OFCI, OFCI, OFCI), NOTES. Lists items like communications, audio distribution, and network equipment.

TECH DEMO PLAN GENERAL NOTES

Large table of technical notes for the demo plan, including A through L, covering topics like ceiling tile removal, testing procedures, and removal of existing devices.

LOCAL SOUND SYSTEM LEGEND - 27 41 16.20. Table with columns: SYMBOL, DESCRIPTION, ELEVATION, BACK BOX/RACEWAY, NOTES. Includes symbols for local sound system speakers, control plates, and microphones.


INTRUSION LEGEND - 28 31 00. Table with columns: SYMBOL, DESCRIPTION, ELEVATION, BACK BOX/RACEWAY, NOTES. Includes symbols for intrusion detection system panels, keypads, motion detectors, and door contact devices.

INTERCOM LEGEND - 27 50 00. Table with columns: SYMBOL, DESCRIPTION, ELEVATION, BACK BOX/RACEWAY, NOTES. Includes symbols for intercom communications units, speakers, and call buttons.

FIRE ALARM - 28 46 00. Table with columns: SYMBOL, DESCRIPTION. Includes symbols for fire alarm control panels and existing fire alarm system components.

2024 SMITH & SPILLANE MS RENOVATIONS SPILLANE MIDDLE SCHOOL 13403 WOODS-SPILLANE BLVD, CYPRESS, TX 77429 CFISD PROJECT NO: 24-02-5751-R-RFP




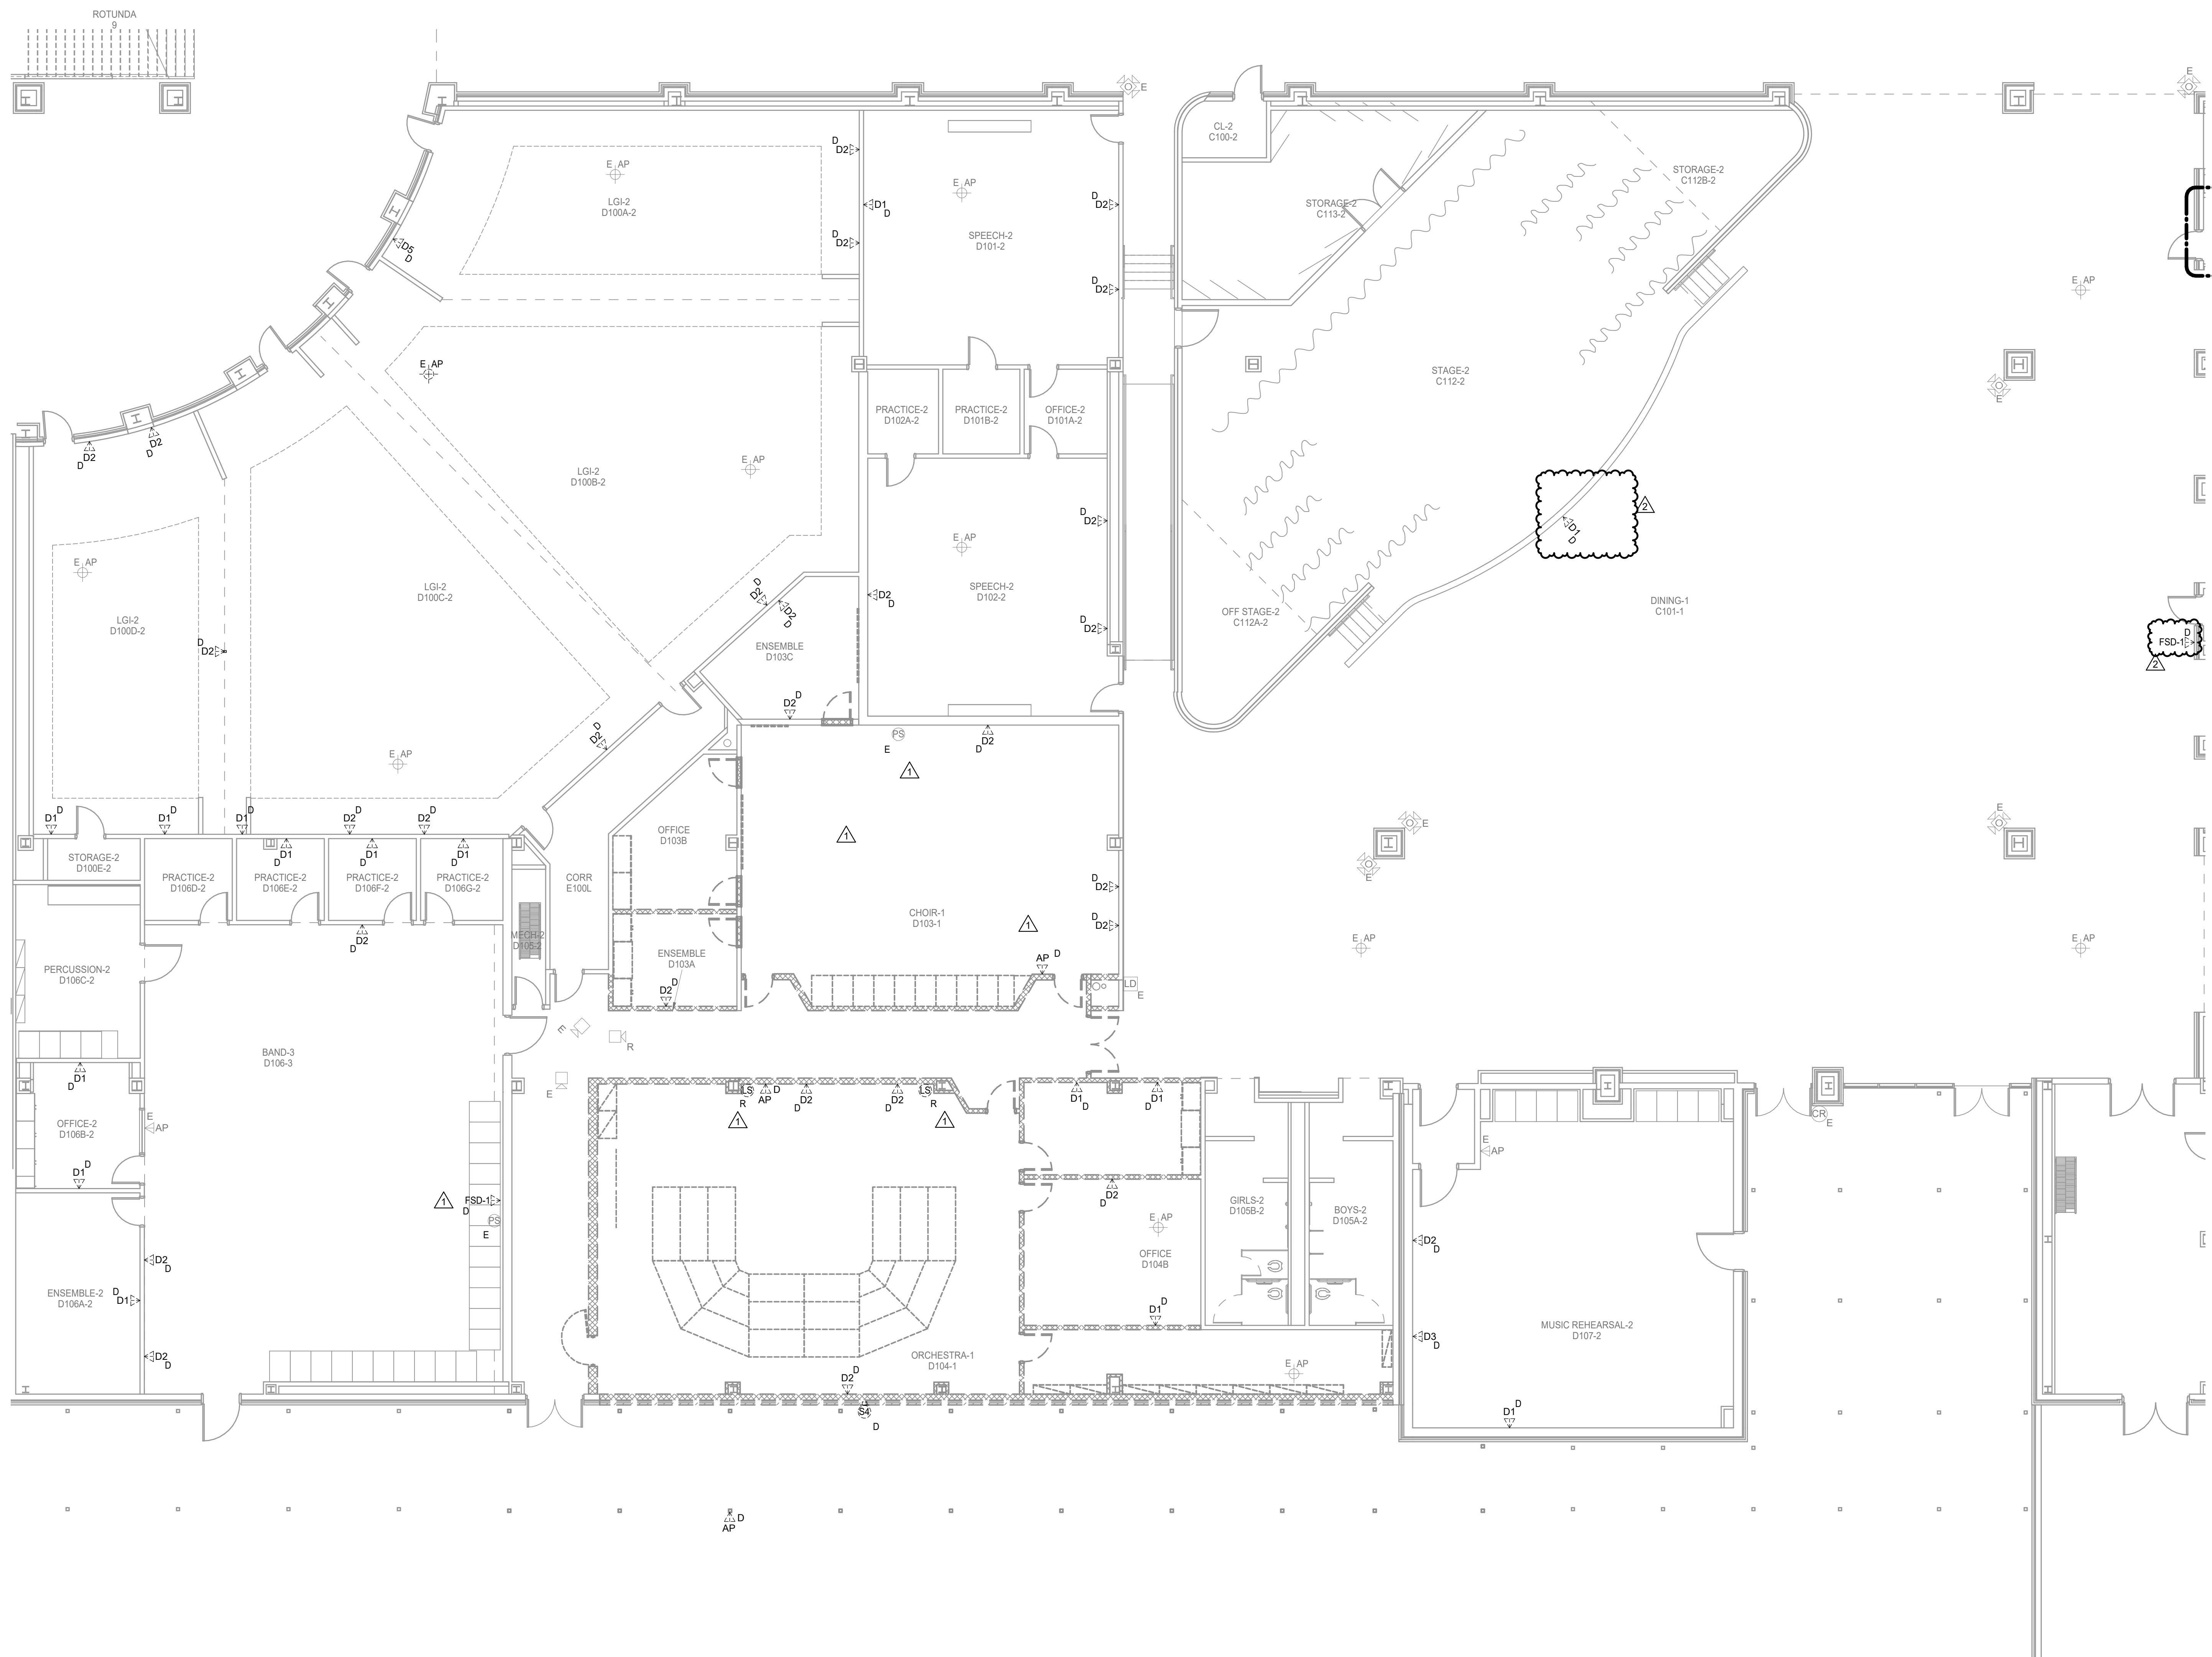

- TECH DEMO PLAN GENERAL NOTES**
- A CONTRACTOR SHALL PROVIDE NEW CEILING TILES IN INSTANCES WHERE CEILING DEVICES ARE REMOVED, REPLACED OR ADDED. CONTRACTOR SHALL COORDINATE WITH ARCHITECT ON CORRECT MANUFACTURER AND MODEL PRIOR TO REMOVAL OF EXISTING TILE.
  - B CONTRACTOR SHALL HAVE EACH LOW VOLTAGE SYSTEM TESTED PRIOR TO THE COMMENCEMENT OF CONSTRUCTION. SYSTEMS SHALL INCLUDE BUT NOT BE LIMITED TO:
    - 1) FIRE ALARM
    - 2) INTERCOM
    - 3) STRUCTURED CABLING
    - 4) INTRUSION DETECTION
    - 5) ACCESS CONTROL
    - 6) VIDEO SURVEILLANCE
 TESTING SHALL INCLUDE THE FUNCTIONALITY OF ALL FIELD DEVICES AND EQUIPMENT. ANY FAILURES OR ITEMS FOUND NOT TO BE FUNCTIONING TO SPECIFICATION, SHALL BE REPORTED PRIOR TO CONSTRUCTION. ANY ITEMS FOUND TO BE IMPROPERLY OR NON-FUNCTIONING UPON THE COMPLETION OF THE PROJECT, SHALL BE REPLACED AND/OR REPAIRED BY THE CONTRACTOR, AT NO ADDITIONAL COST TO THE PROJECT OR THE OWNER.
  - C CONTRACTOR SHALL REMOVE ANY DEVICES WHERE CONSTRUCTION OCCURS TO PREVENT POSSIBLE DAMAGE TO THE DEVICE. REMOVAL OF ANY DEVICES WHICH SUPPORT USER CONNECTION OR OTHER SYSTEMS, SHALL BE COORDINATED WITH THE OWNER PRIOR TO REMOVAL AND/OR TAKING OFF LINE. REMOVAL SHALL CONSIST OF BUT NOT BE LIMITED TO THE FOLLOWING DEVICES AND ASSOCIATED SUPPORT INFRASTRUCTURE:
    - 1) FIRE ALARM DEVICES
    - 2) INTERCOM DEVICES
    - 3) WIRELESS ACCESS POINTS
    - 4) TELEPHONES
    - 5) VIDEO SURVEILLANCE CAMERAS
    - 6) INTRUSION DETECTION DEVICES
    - 7) ACCESS CONTROL DEVICES
    - 8) VIDEO PROJECTION DEVICES
    - 9) VIDEO DISPLAY DEVICES
 ANY DEVICES, NOT BEING REINSTALLED, SHALL BE RETURNED TO THE OWNER.
  - D CONTRACTOR SHALL DOCUMENT THE LOCATION AND ANY ID TAG, MAC ADDRESS, IP ADDRESS, OR BAR CODE OF ANY EXISTING DEVICE THAT IS TO BE REMOVED FROM ITS CURRENT LOCATION. DEVICES THAT ARE TO REMAIN, SHALL BE REINSTALLED IN THE EXACT LOCATION THAT THEY RESIDE IN PRIOR TO CONSTRUCTION, UNLESS NOTED OTHERWISE.
  - E ANY INDIVIDUAL THAT WILL BE REMOVING, RELOCATING, REINSTALLING, AND/OR TAMPERING WITH ANY EXISTING DEVICES, SHALL BE CERTIFIED BY THE MANUFACTURER OF THE SPECIFIC SYSTEM AND/OR LICENSED AS REQUIRED BY THE STATE TO PERFORM WORK ON THE SYSTEM. THE INDIVIDUAL SHALL BE A FULL-TIME EMPLOYEE OF THE FIRM CONTRACTED TO CONDUCT SUCH WORK ON THE PROJECT AND THAT FIRM SHALL ALSO HOLD ANY CERTIFICATIONS AND/OR LICENSES REQUIRED TO CONDUCT WORK ON THE SPECIFIC SYSTEM.
  - F ANY INDIVIDUAL/FIRM THAT WILL BE REMOVING, RELOCATING, REINSTALLING, OR TAMPERING WITH ANY DEVICES, SHALL BE LICENSED BY THE STATE, AS APPLICABLE, AND CERTIFIED BY THE MANUFACTURER OF THE SYSTEM.
  - G ALL CABLING ASSOCIATED WITH DEVICES THAT ARE TO BE DEMOLISHED, SHALL BE REMOVED FROM THE DEVICE LOCATION TO THE CABLES POINT OF ORIGIN. NO CABLE SHALL BE ABANDONED IN PLACE.
  - H ALL EXISTING DEVICES SHOWN ARE EXISTING TO REMAIN. CONTRACTOR TO REMOVE EXISTING DEVICES DURING CONSTRUCTION AND REINSTALL THE DEVICE IN THE SAME LOCATION, UNLESS NOTED OTHERWISE.
  - I REFERENCE EXISTING DEVICE SUBSCRIPT LEGEND ON THE NOTES AND LEGENDS SHEET.
  - J TOPCAT LIGHTSPEED LOCAL SOUND SPEAKERS SHALL BE BAGGED AND SUSPENDED IN THE CEILING DURING CONSTRUCTION. THE CONTRACTOR SHALL COORDINATE WITH THE MANUFACTURER TO NOT VOID THE WARRANTY.  
 TOPCAT LIGHTSPEED SPEAKER, BASE STATION AND ANY OTHER SYSTEM COMPONENTS SHALL BE TAGGED BY CONTRACTOR WITH ROOM NAME AND NUMBER AND BE REINSTALLED IN THE SAME ROOM IT WAS REMOVED FROM.
  - K CONTRACTOR TO COORDINATE WITH CFISS TECHNOLOGY DEPARTMENT PRIOR TO CONSTRUCTION ON WHICH DEVICES ARE TO BE REMOVED BY THE OWNER'S VENDOR IN ORDER TO PREVENT VOID OF WARRANTY.
  - L ALL DEMO DEVICES WITH 'D' SUBSCRIPT SHALL DISCONNECT AND REMOVE EXISTING WIRING DEVICE BACK TO SWITCH PATCH WALL TO MATCH EXISTING.

**1 TECHNOLOGY DEMOLITION FLOOR PLAN - LEVEL 1 - AREA D**  
 Scale: 1/8" = 1'-0"

**KEY PLAN:**

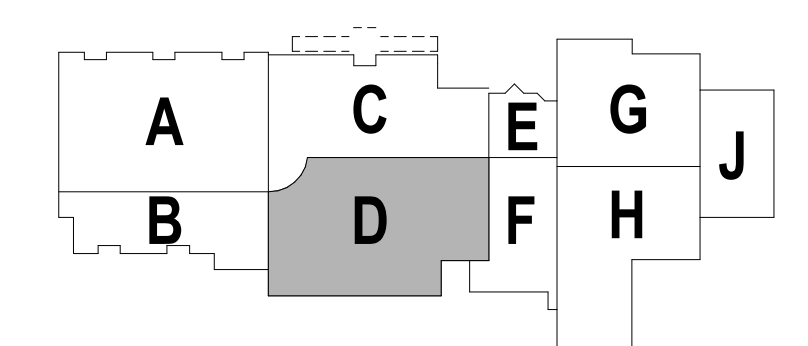

**2024 SMITH & SPILLANE MS RENOVATIONS**  
**SPILLANE MIDDLE SCHOOL**  
 13403 WOODS-SPILLANE BLVD, CYPRESS, TX 77429  
 CFISS PROJECT NO: 24-02-5751-R-RFP


Revision	Description	Date
1	Addendum 03	02-14-25
2	Addendum 02	02-11-25

Project Number: 23073  
 Date: 26 JANUARY 2025  
 Drawn By: WHL / KLO  
**TECHNOLOGY DEMOLITION FIRST FLOOR PLAN - AREA 'D'**  
**T0.04**

**Salas O'Brien**  
 salasobrien.com 281-664-1900  
 Houston 10930 W. Sam Houston Pkwy North, Suite 900  
 Houston, TX 77064  
 Registration: F-4111  
 Project No: 2024-00209-00

**NATEX**  
 CORPORATION  
 ARCHITECTS  
 www.nateearchitects.com  
 447 Heights Boulevard  
 Houston, TX 77007  
 Phone: 713-975-9525  
 Fax: 713-780-7824

**Coleman Partners**  
 ARCHITECTS  
 cpa.com  
 3701 Kirby Drive, Suite 830  
 Houston, TX 77098  
 tel: 832.947.1038 fax: 281.225.214.5365

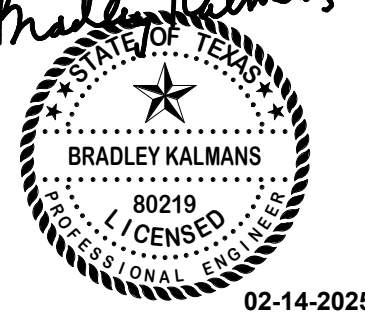**CONSTRUCTION DOCUMENT**  


**CIVIL ENGINEER**  
**BROOKS AND SPARKS, INC.**  
 21020 PARK ROW  
 KATY, TX 77449  
 tel: 281.578.9595


**STRUCTURAL ENGINEER**  
**DALLY + ASSOCIATES, INC.**  
 9800 RICHMOND AVE.  
 SUITE 400  
 HOUSTON, TX 77042  
 tel: 713.337.8881

**MEPT ENGINEER**  
**SALAS O'BRIEN**  
 10930 W. SAM HOUSTON PKWY. N.  
 SUITE 900  
 HOUSTON, TX 77064  
 tel: 281.664.1900

**FOOD SERVICE EQUIPMENT**  
**FDP**  
 25317 INTERSTATE 45  
 THE WOODLANDS, TX 77380  
 tel: 281.350.2323


**LANDSCAPE ARCHITECT**  
**LANDESIGN GROUP**  
 17041 EL CAMINO REAL  
 SUITE 204  
 HOUSTON, TX 77058  
 tel: 281.486.4040

- TECH DEMO PLAN GENERAL NOTES**
- A CONTRACTOR SHALL PROVIDE NEW CEILING TILES IN INSTANCES WHERE CEILING DEVICES ARE REMOVED, REPLACED OR ADDED. CONTRACTOR SHALL COORDINATE WITH ARCHITECT ON CORRECT MANUFACTURER AND MODEL PRIOR TO REMOVAL OF EXISTING TILE.
  - B CONTRACTOR SHALL HAVE EACH LOW VOLTAGE SYSTEM TESTED PRIOR TO THE COMMENCEMENT OF CONSTRUCTION. SYSTEMS SHALL INCLUDE BUT NOT BE LIMITED TO:
    - 1) FIRE ALARM
    - 2) INTERCOM
    - 3) STRUCTURED CABLING
    - 4) INTRUSION DETECTION
    - 5) ACCESS CONTROL
    - 6) AUDIO VIDEO
    - 7) VIDEO SURVEILLANCE
 TESTING SHALL INCLUDE THE FUNCTIONALITY OF ALL FIELD DEVICES AND EQUIPMENT. ANY FAILURES OR ITEMS FOUND NOT TO BE FUNCTIONING TO SPECIFICATION, SHALL BE REPORTED PRIOR TO CONSTRUCTION. ANY ITEMS FOUND TO BE IMPROPERLY OR NON-FUNCTIONING UPON THE COMPLETION OF THE PROJECT, SHALL BE REPLACED AND/OR REPAIRED BY THE CONTRACTOR, AT NO ADDITIONAL COST TO THE PROJECT OR THE OWNER.
  - C CONTRACTOR SHALL REMOVE ANY DEVICES WHERE CONSTRUCTION OCCURS TO PREVENT POSSIBLE DAMAGE TO THE DEVICE. REMOVAL OF ANY DEVICES WHICH SUPPORT USER CONNECTION OR OTHER SYSTEMS, SHALL BE COORDINATED WITH THE OWNER PRIOR TO REMOVAL AND/OR TAKING OFF LINE. REMOVAL SHALL CONSIST OF BUT NOT BE LIMITED TO THE FOLLOWING DEVICES AND ASSOCIATED SUPPORT INFRASTRUCTURE:
    - 1) FIRE ALARM DEVICES
    - 2) INTERCOM DEVICES
    - 3) WIRELESS ACCESS POINTS
    - 4) TELEPHONES
    - 5) VIDEO SURVEILLANCE CAMERAS
    - 6) INTRUSION DETECTION DEVICES
    - 7) ACCESS CONTROL DEVICES
    - 8) VIDEO PROJECTION DEVICES
    - 9) VIDEO DISPLAY DEVICES
 ANY DEVICES, NOT BEING REINSTALLED, SHALL BE RETURNED TO THE OWNER.
  - D CONTRACTOR SHALL DOCUMENT THE LOCATION AND ANY ID TAG, MAC ADDRESS, IP ADDRESS, OR BAR CODE OF ANY EXISTING DEVICE THAT IS TO BE REMOVED FROM ITS CURRENT LOCATION. DEVICES THAT ARE TO REMAIN, SHALL BE REINSTALLED IN THE EXACT LOCATION THAT THEY RESIDE IN PRIOR TO CONSTRUCTION, UNLESS NOTED OTHERWISE.
  - E ANY INDIVIDUAL THAT WILL BE REMOVING, RELOCATING, REINSTALLING, AND/OR TAMPERING WITH ANY EXISTING DEVICES, SHALL BE CERTIFIED BY THE MANUFACTURER OF THE SPECIFIC SYSTEM AND/OR LICENSED AS REQUIRED BY THE STATE TO PERFORM WORK ON THE SYSTEM. THE INDIVIDUAL SHALL BE A FULL-TIME EMPLOYEE OF THE FIRM CONTRACTED TO CONDUCT SUCH WORK ON THE PROJECT AND THAT FIRM SHALL ALSO HOLD ANY CERTIFICATIONS AND/OR LICENSES REQUIRED TO CONDUCT WORK ON THE SPECIFIC SYSTEM.
  - F ANY INDIVIDUAL/FIRM THAT WILL BE REMOVING, RELOCATING, REINSTALLING, OR TAMPERING WITH IN ANY DEVICES, SHALL BE LICENSED BY THE STATE, AS APPLICABLE, AND CERTIFIED BY THE MANUFACTURER OF THE SYSTEM.
  - G ALL CABLING ASSOCIATED WITH DEVICES THAT ARE TO BE DEMOLISHED, SHALL BE REMOVED FROM THE DEVICE LOCATION TO THE CABLES POINT OF ORIGIN. NO CABLE SHALL BE ABANDONED IN PLACE.
  - H ALL EXISTING DEVICES SHOWN ARE EXISTING TO REMAIN. CONTRACTOR TO REMOVE EXISTING DEVICES DURING CONSTRUCTION AND REINSTALL THE DEVICE IN THE SAME LOCATION, UNLESS NOTED OTHERWISE.
  - I REFERENCE EXISTING DEVICE SUBSCRIPT LEGEND ON THE NOTES AND LEGENDS SHEET.
  - J TOPCAT LIGHTSPEED LOCAL SOUND SPEAKERS SHALL BE BAGGED AND SUSPENDED IN THE CEILING DURING CONSTRUCTION. THE CONTRACTOR SHALL COORDINATE WITH THE MANUFACTURER TO NOT VOID THE WARRANTY.  
 TOPCAT LIGHTSPEED SPEAKER, BASE STATION AND ANY OTHER SYSTEM COMPONENTS SHALL BE TAGGED BY CONTRACTOR WITH ROOM NAME AND NUMBER AND BE REINSTALLED IN THE SAME ROOM IT WAS REMOVED FROM.
  - K CONTRACTOR TO COORDINATE WITH CFISD TECHNOLOGY DEPARTMENT PRIOR TO CONSTRUCTION ON WHICH DEVICES ARE TO BE REMOVED BY THE OWNER'S VENDOR IN ORDER TO PREVENT VOID OF WARRANTY.
  - L ALL DEMO DEVICES WITH 'D' SUBSCRIPT SHALL DISCONNECT AND REMOVE EXISTING WIRING DEVICE BACK TO SWITCH PATCH WALL TO MATCH EXISTING.

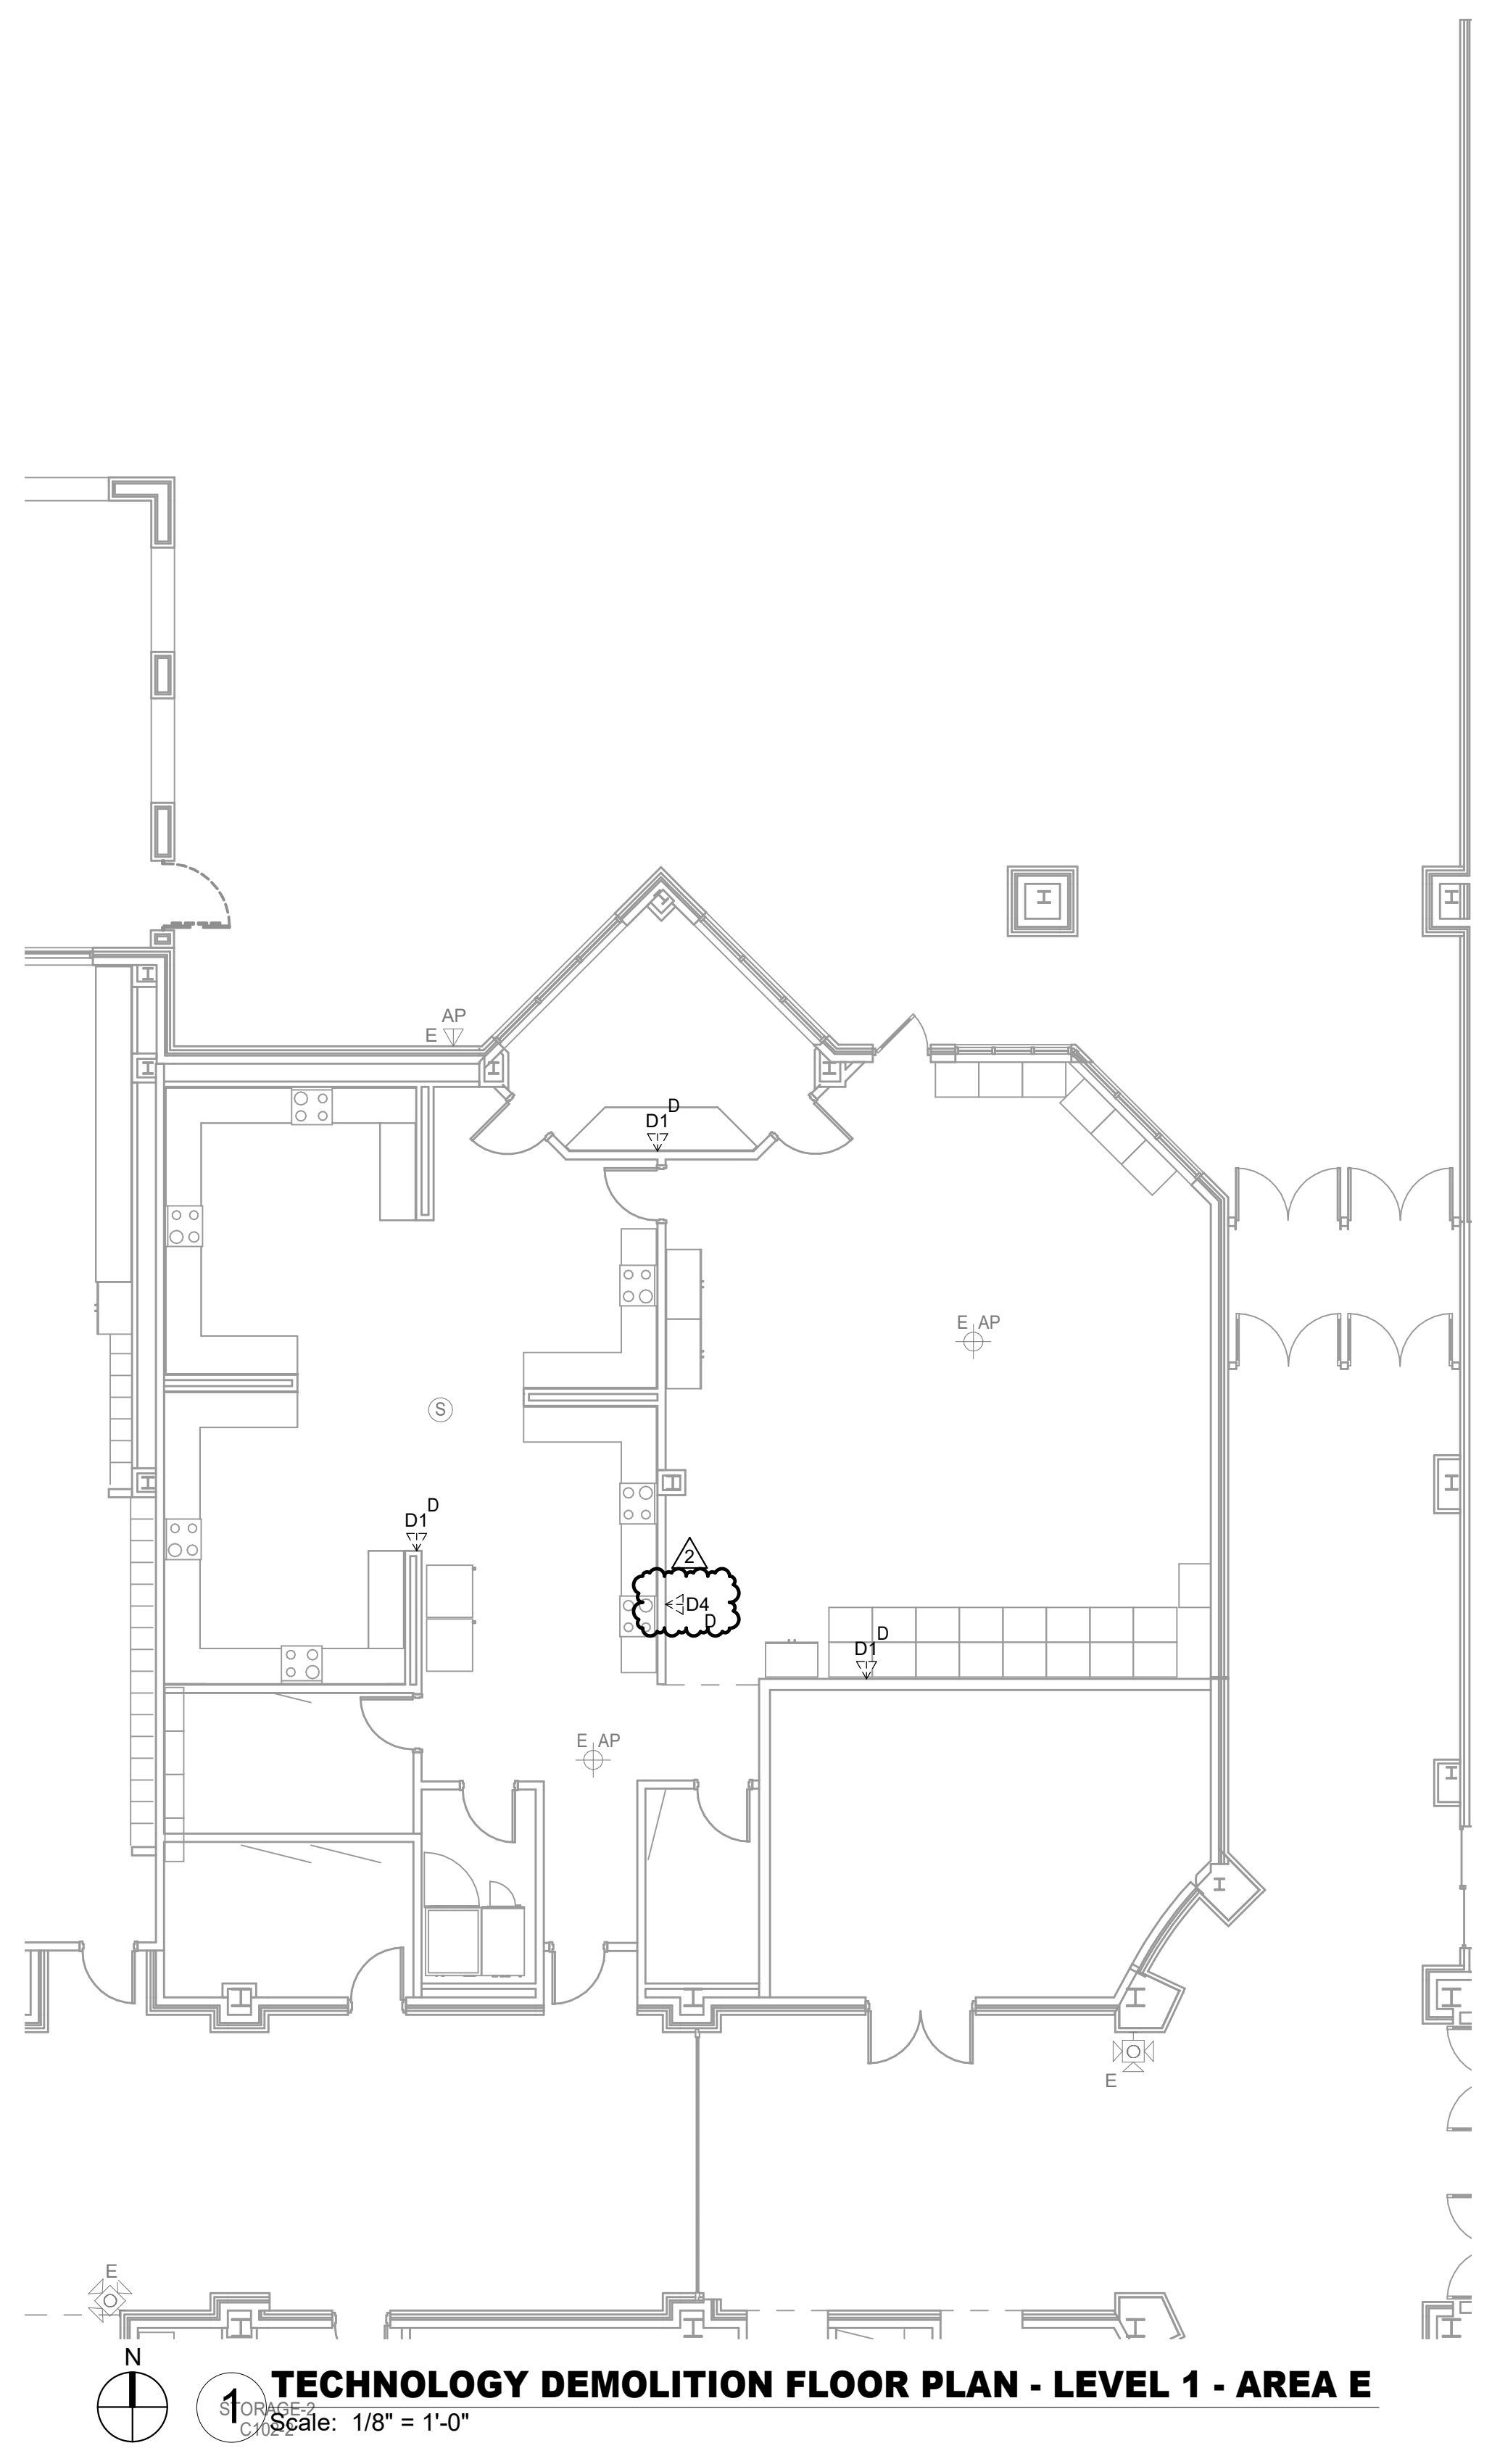

**1** TECHNOLOGY DEMOLITION FLOOR PLAN - LEVEL 1 - AREA E  
 Scale: 1/8" = 1'-0"

**KEY PLAN:**

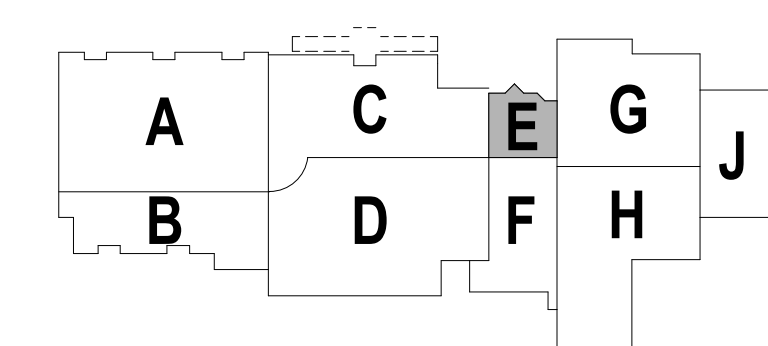

**2024 SMITH & SPILLANE MS RENOVATIONS**  
**SPILLANE MIDDLE SCHOOL**  
 13403 WOODS-SPILLANE BLVD, CYPRESS, TX 77429  
 CFISD PROJECT NO: 24-02-5751-R-RFP

Revision	Submission
2	Addendum 03 02-14-25

Project Number: 23073  
 Date: 26 JANUARY 2025  
 Drawn By: WHL / KLO

TECHNOLOGY  
 DEMOLITION FIRST  
 FLOOR PLAN - AREA 'E'  
**T0.05**  
 of


**TECH DEMO PLAN GENERAL NOTES**

- A CONTRACTOR SHALL PROVIDE NEW CEILING TILES IN INSTANCES WHERE CEILING DEVICES ARE REMOVED, REPLACED OR ADDED. CONTRACTOR SHALL COORDINATE WITH ARCHITECT ON CORRECT MANUFACTURER AND MODEL PRIOR TO REMOVAL OF EXISTING TILE.
- B CONTRACTOR SHALL HAVE EACH LOW VOLTAGE SYSTEM TESTED PRIOR TO THE COMMENCEMENT OF CONSTRUCTION. SYSTEMS SHALL INCLUDE BUT NOT BE LIMITED TO:
  - 1) FIRE ALARM
  - 2) INTERCOM
  - 3) STRUCTURED CABLING
  - 4) INTRUSION DETECTION
  - 5) ACCESS CONTROL
  - 6) AUDIO VIDEO
  - 7) VIDEO SURVEILLANCE
 TESTING SHALL INCLUDE THE FUNCTIONALITY OF ALL FIELD DEVICES AND EQUIPMENT. ANY FAILURES OR ITEMS FOUND NOT TO BE FUNCTIONING TO SPECIFICATION, SHALL BE REPORTED PRIOR TO CONSTRUCTION. ANY ITEMS FOUND TO BE IMPROPERLY OR NON-FUNCTIONING UPON THE COMPLETION OF THE PROJECT, SHALL BE REPLACED AND/OR REPAIRED, BY THE CONTRACTOR, AT NO ADDITIONAL COST TO THE PROJECT OR THE OWNER.
- C CONTRACTOR SHALL REMOVE ANY DEVICES WHERE CONSTRUCTION OCCURS TO PREVENT POSSIBLE DAMAGE TO THE DEVICE. REMOVAL OF ANY DEVICES WHICH SUPPORT USER CONNECTION OR OTHER SYSTEMS, SHALL BE COORDINATED WITH THE OWNER PRIOR TO REMOVAL AND/OR TAKING OFF LINE. REMOVAL SHALL CONSIST OF BUT NOT BE LIMITED TO THE FOLLOWING DEVICES AND ASSOCIATED SUPPORT INFRASTRUCTURE:
  - 1) FIRE ALARM DEVICES
  - 2) INTERCOM DEVICES
  - 3) WIRELESS ACCESS POINTS
  - 4) TELEPHONES
  - 5) VIDEO SURVEILLANCE CAMERAS
  - 6) INTRUSION DETECTION DEVICES
  - 7) ACCESS CONTROL DEVICES
  - 8) VIDEO PROJECTION DEVICES
  - 9) VIDEO DISPLAY DEVICES
 ANY DEVICES, NOT BEING REINSTALLED, SHALL BE RETURNED TO THE OWNER.
- D CONTRACTOR SHALL DOCUMENT THE LOCATION AND ANY ID TAG, MAC ADDRESS, IP ADDRESS, OR BAR CODE OF ANY EXISTING DEVICE THAT IS TO BE REMOVED FROM ITS CURRENT LOCATION. DEVICES THAT ARE TO REMAIN, SHALL BE REINSTALLED IN THE EXACT LOCATION THAT THEY RESIDE IN PRIOR TO CONSTRUCTION, UNLESS NOTED OTHERWISE.
- E ANY INDIVIDUAL THAT WILL BE REMOVING, RELOCATING, REINSTALLING, AND/OR TAMPERING WITH ANY EXISTING DEVICES, SHALL BE CERTIFIED BY THE MANUFACTURER OF THE SPECIFIC SYSTEM AND/OR LICENSED AS REQUIRED BY THE STATE TO PERFORM WORK ON THE SYSTEM. THE INDIVIDUAL SHALL BE A FULL-TIME EMPLOYEE OF THE FIRM CONTRACTED TO CONDUCT SUCH WORK ON THE PROJECT AND THAT FIRM SHALL ALSO HOLD ANY CERTIFICATIONS AND/OR LICENSES REQUIRED TO CONDUCT WORK ON THE SPECIFIC SYSTEM.
- F ANY INDIVIDUAL/FIRM THAT WILL BE REMOVING, RELOCATING, REINSTALLING, OR TAMPERING WITH IN ANY DEVICES, SHALL BE LICENSED BY THE STATE, AS APPLICABLE, AND CERTIFIED BY THE MANUFACTURER OF THE SYSTEM.
- G ALL CABLING ASSOCIATED WITH DEVICES THAT ARE TO BE DEMOLISHED, SHALL BE REMOVED FROM THE DEVICE LOCATION TO THE CABLES POINT OF ORIGIN. NO CABLE SHALL BE ABANDONED IN PLACE.
- H ALL EXISTING DEVICES SHOWN ARE EXISTING TO REMAIN. CONTRACTOR TO REMOVE EXISTING DEVICES DURING CONSTRUCTION AND REINSTALL THE DEVICE IN THE SAME LOCATION, UNLESS NOTED OTHERWISE.
- I REFERENCE EXISTING DEVICE SUBSCRIPT LEGEND ON THE NOTES AND LEGENDS SHEET.
- J TOPCAT LIGHTSPEED LOCAL SOUND SPEAKERS SHALL BE BAGGED AND SUSPENDED IN THE CEILING DURING CONSTRUCTION. THE CONTRACTOR SHALL COORDINATE WITH THE MANUFACTURER TO NOT VOID THE WARRANTY. TOPCAT LIGHTSPEED SPEAKER, BASE STATION AND ANY OTHER SYSTEM COMPONENTS SHALL BE TAGGED BY CONTRACTOR WITH ROOM AND MEAN NUMBER AND BE REINSTALLED IN THE SAME ROOM IT WAS REMOVED FROM.
- K CONTRACTOR TO COORDINATE WITH CFSID TECHNOLOGY DEPARTMENT PRIOR TO CONSTRUCTION ON WHICH DEVICES ARE TO BE REMOVED BY THE OWNER'S VENDOR IN ORDER TO PREVENT VOID OF WARRANTY.
- L CONTRACTOR SHALL FIELD VERIFY ALL SECONDARY CLOCK LOCATIONS. REMOVE ALL SECONDARY CLOCKS. PROVIDE NEW CLOCKS IN RECEPTION, CAFETERIA, LIBRARY, GYM AND CLINIC IN THE SAME LOCATIONS. RETURN ALL OTHER SECONDARY CLOCKS TO OWNER. HEAD END MASTER CLOCK IS TO BE REPLACED. CONTRACTOR TO REFERENCE ARCHITECTURAL DRAWINGS AND SPECIFICATIONS FOR PATCH AND PAINT INSTRUCTIONS.
- M ALL DEMO DEVICES WITH 'D' SUBSCRIPT SHALL DISCONNECT AND REMOVE EXISTING WIRING DEVICE BACK TO SWITCH, PATCH WALL TO MATCH EXISTING.
- N DEMOLISHED WORKSTATION OUTLETS THAT ONLY CONTAIN VOICE SHALL HAVE CABLING DEMOLISHED AND RECEIVE A NEW CONTRACTOR PROVIDED BLANK FACEPLATE UNLESS NOTED OTHERWISE. THIS SHALL EXCLUDE VOICE OUTLETS BEING USED FOR LIFE SAFETY PURPOSES.



**1 TECHNOLOGY DEMOLITION FLOOR PLAN - LEVEL 2 - AREA B**  
 Scale: 1/8" = 1'-0"

**KEY PLAN:**

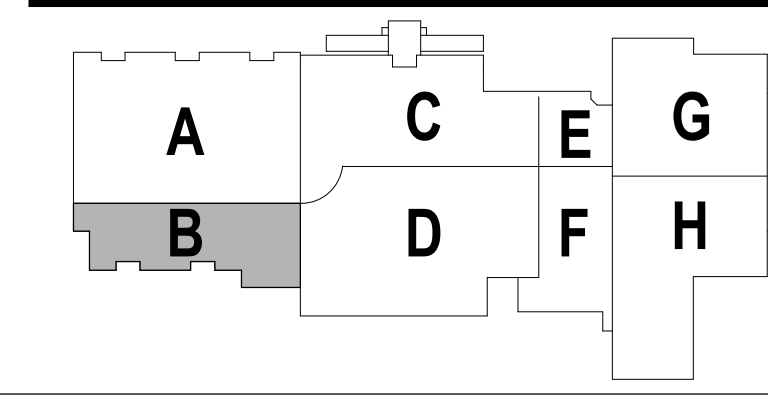



**Salas O'Brien**  
 salesobrien.com 281-664-1900  
 Houston 10930 W. Sam Houston Pkwy North, Suite 900  
 Houston, TX 77064  
 Registration: F-411  
 Project No: 2024-0029-00

**NATEX**  
 CORPORATION  
 ARCHITECTS  
 www.natearchitects.com  
 447 Heights Boulevard  
 Houston, TX 77007  
 Phone: 713-975-9525  
 Fax: 713-780-7824

**Coleman Partners**  
 ARCHITECTS  
 @cparch.com  
 3701 Kirby Drive, Suite 830  
 Houston, TX 77098  
 tel: 832-947-1038 fax: 281-214-5365

CONSTRUCTION DOCUMENT

*Bradley Kalmans*  
 BRADLEY KALMANS  
 ARCHITECT  
 80219  
 CENSUS  
 02-14-2025


**CIVIL ENGINEER**  
**BROOKS AND SPARKS, INC.**  
 21020 PARK ROW  
 KATY, TX 77449  
 tel: 281-578-9595

**STRUCTURAL ENGINEER**  
**DALLY + ASSOCIATES, INC.**  
 9800 RICHMOND AVE.  
 SUITE 400  
 HOUSTON, TX 77042  
 tel: 713.337.8881

**MEPT ENGINEER**  
**SALAS O'BRIEN**  
 10930 W. SAM HOUSTON PKWY. N.  
 SUITE 900  
 HOUSTON, TX 77064  
 tel: 281.664.1900


**FOOD SERVICE EQUIPMENT**  
**FDP**  
 25317 INTERSTATE 45  
 THE WOODLANDS, TX 77380  
 tel: 281-350-2323

**LANDSCAPE ARCHITECT**  
**LANDESIGN GROUP**  
 17041 EL CAMINO REAL  
 SUITE 204  
 HOUSTON, TX 77058  
 tel: 281-486-4040

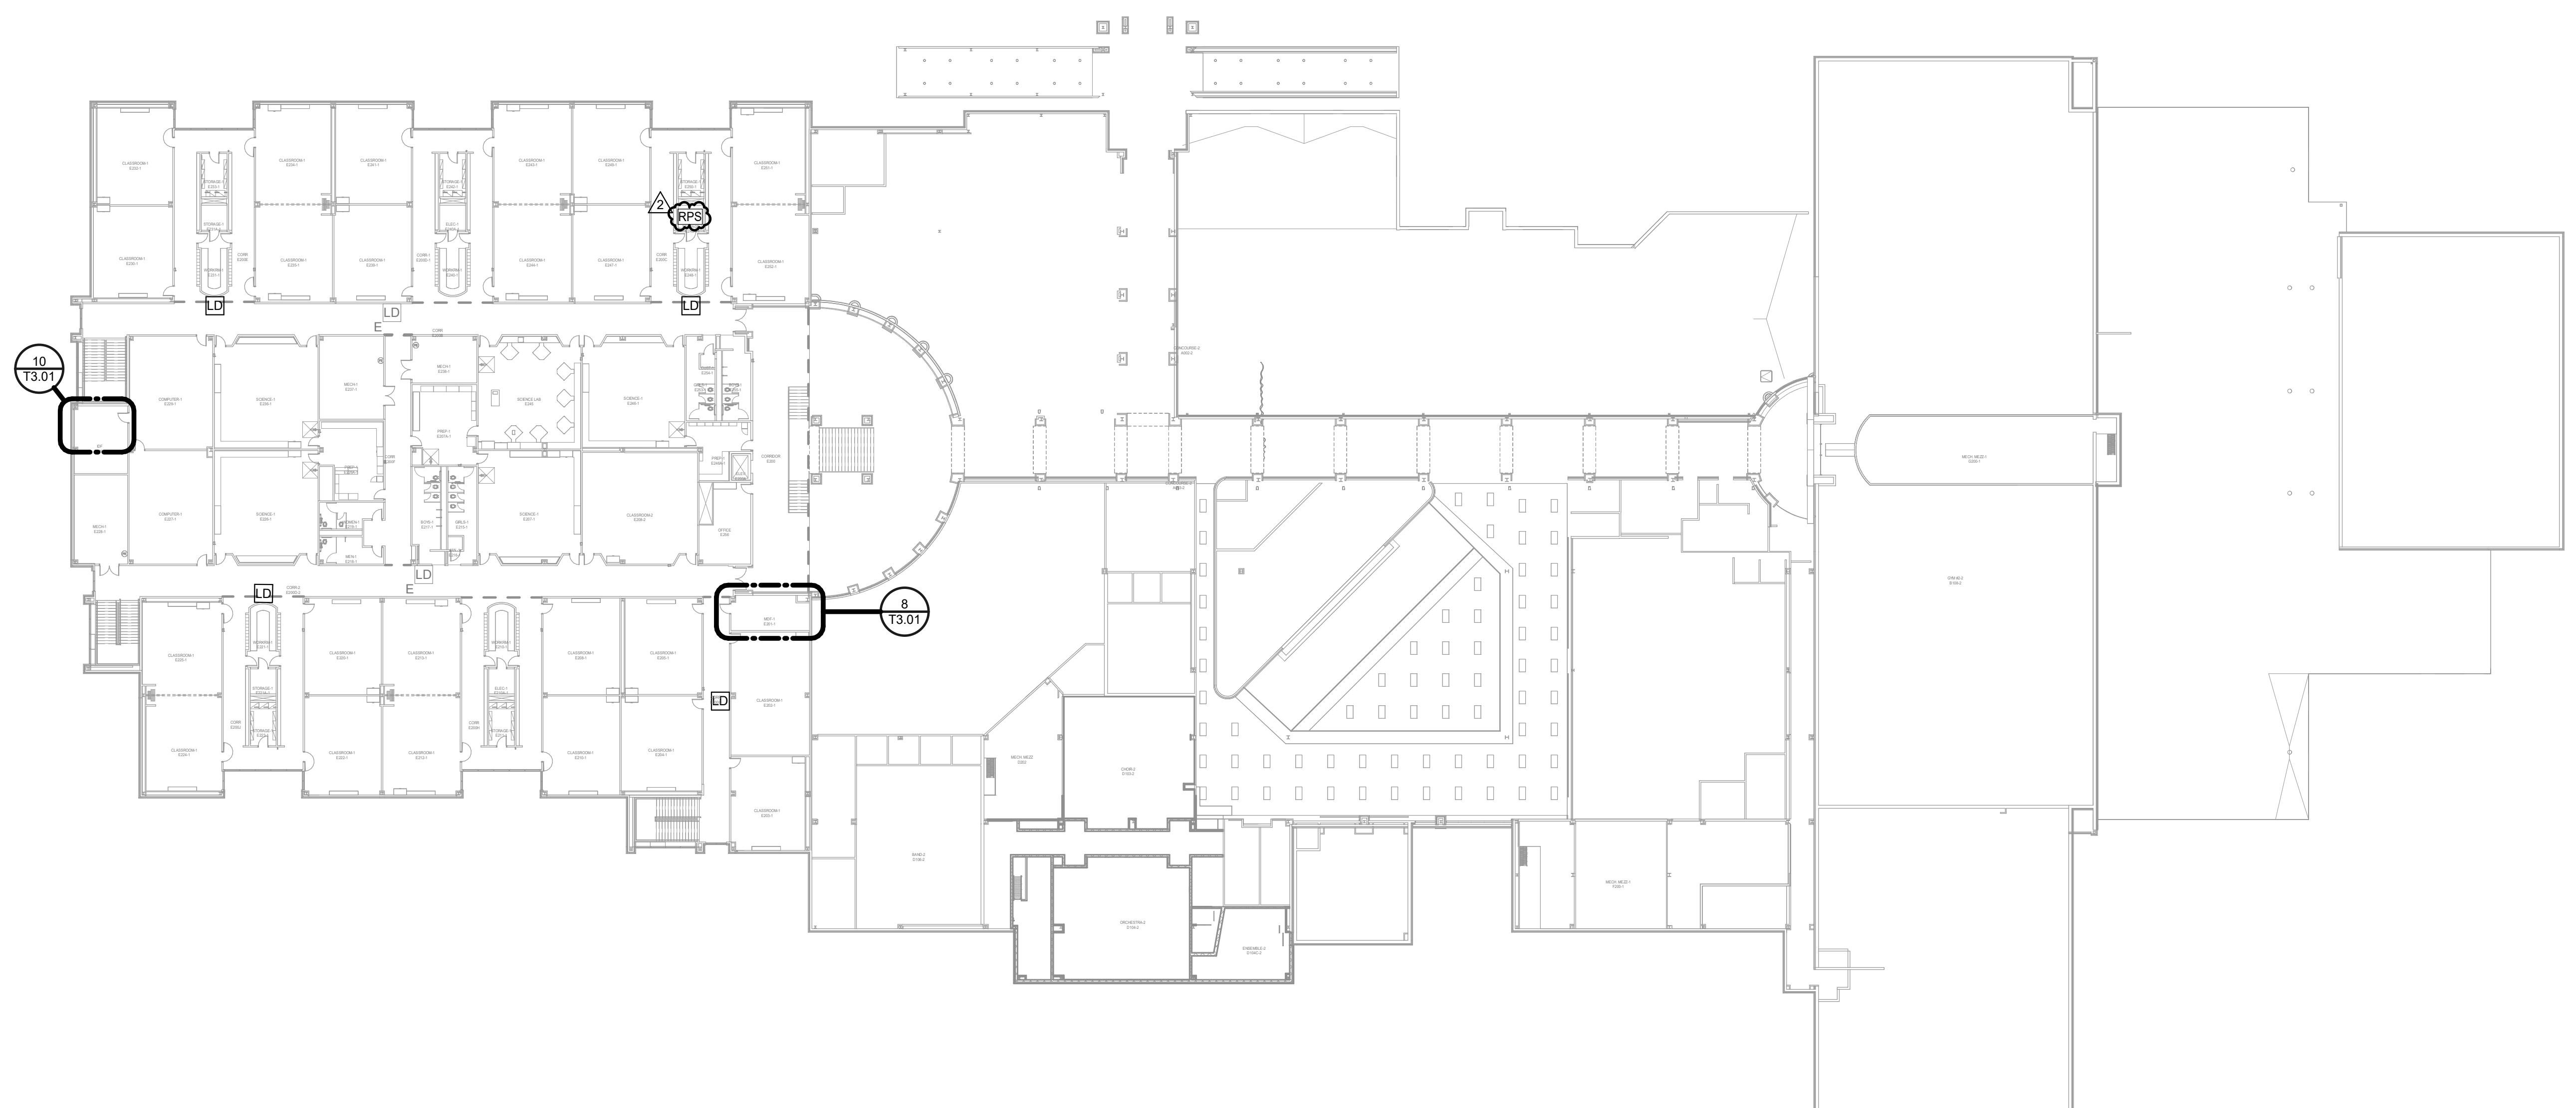


**2 TECHNOLOGY COMPOSITE FLOOR PLAN - LEVEL 2**  
 Scale: 1" = 30'-0"

**TECH COMPOSITE KEY NOTES**  
 1 INDICATES DEAF EDUCATION CLASSROOMS. EXISTING INTERCOM STROBE LIGHTS ARE TO REMAIN. EXISTING STROBES AND WIRING SHALL BE PROTECTED THROUGHOUT CONSTRUCTION.

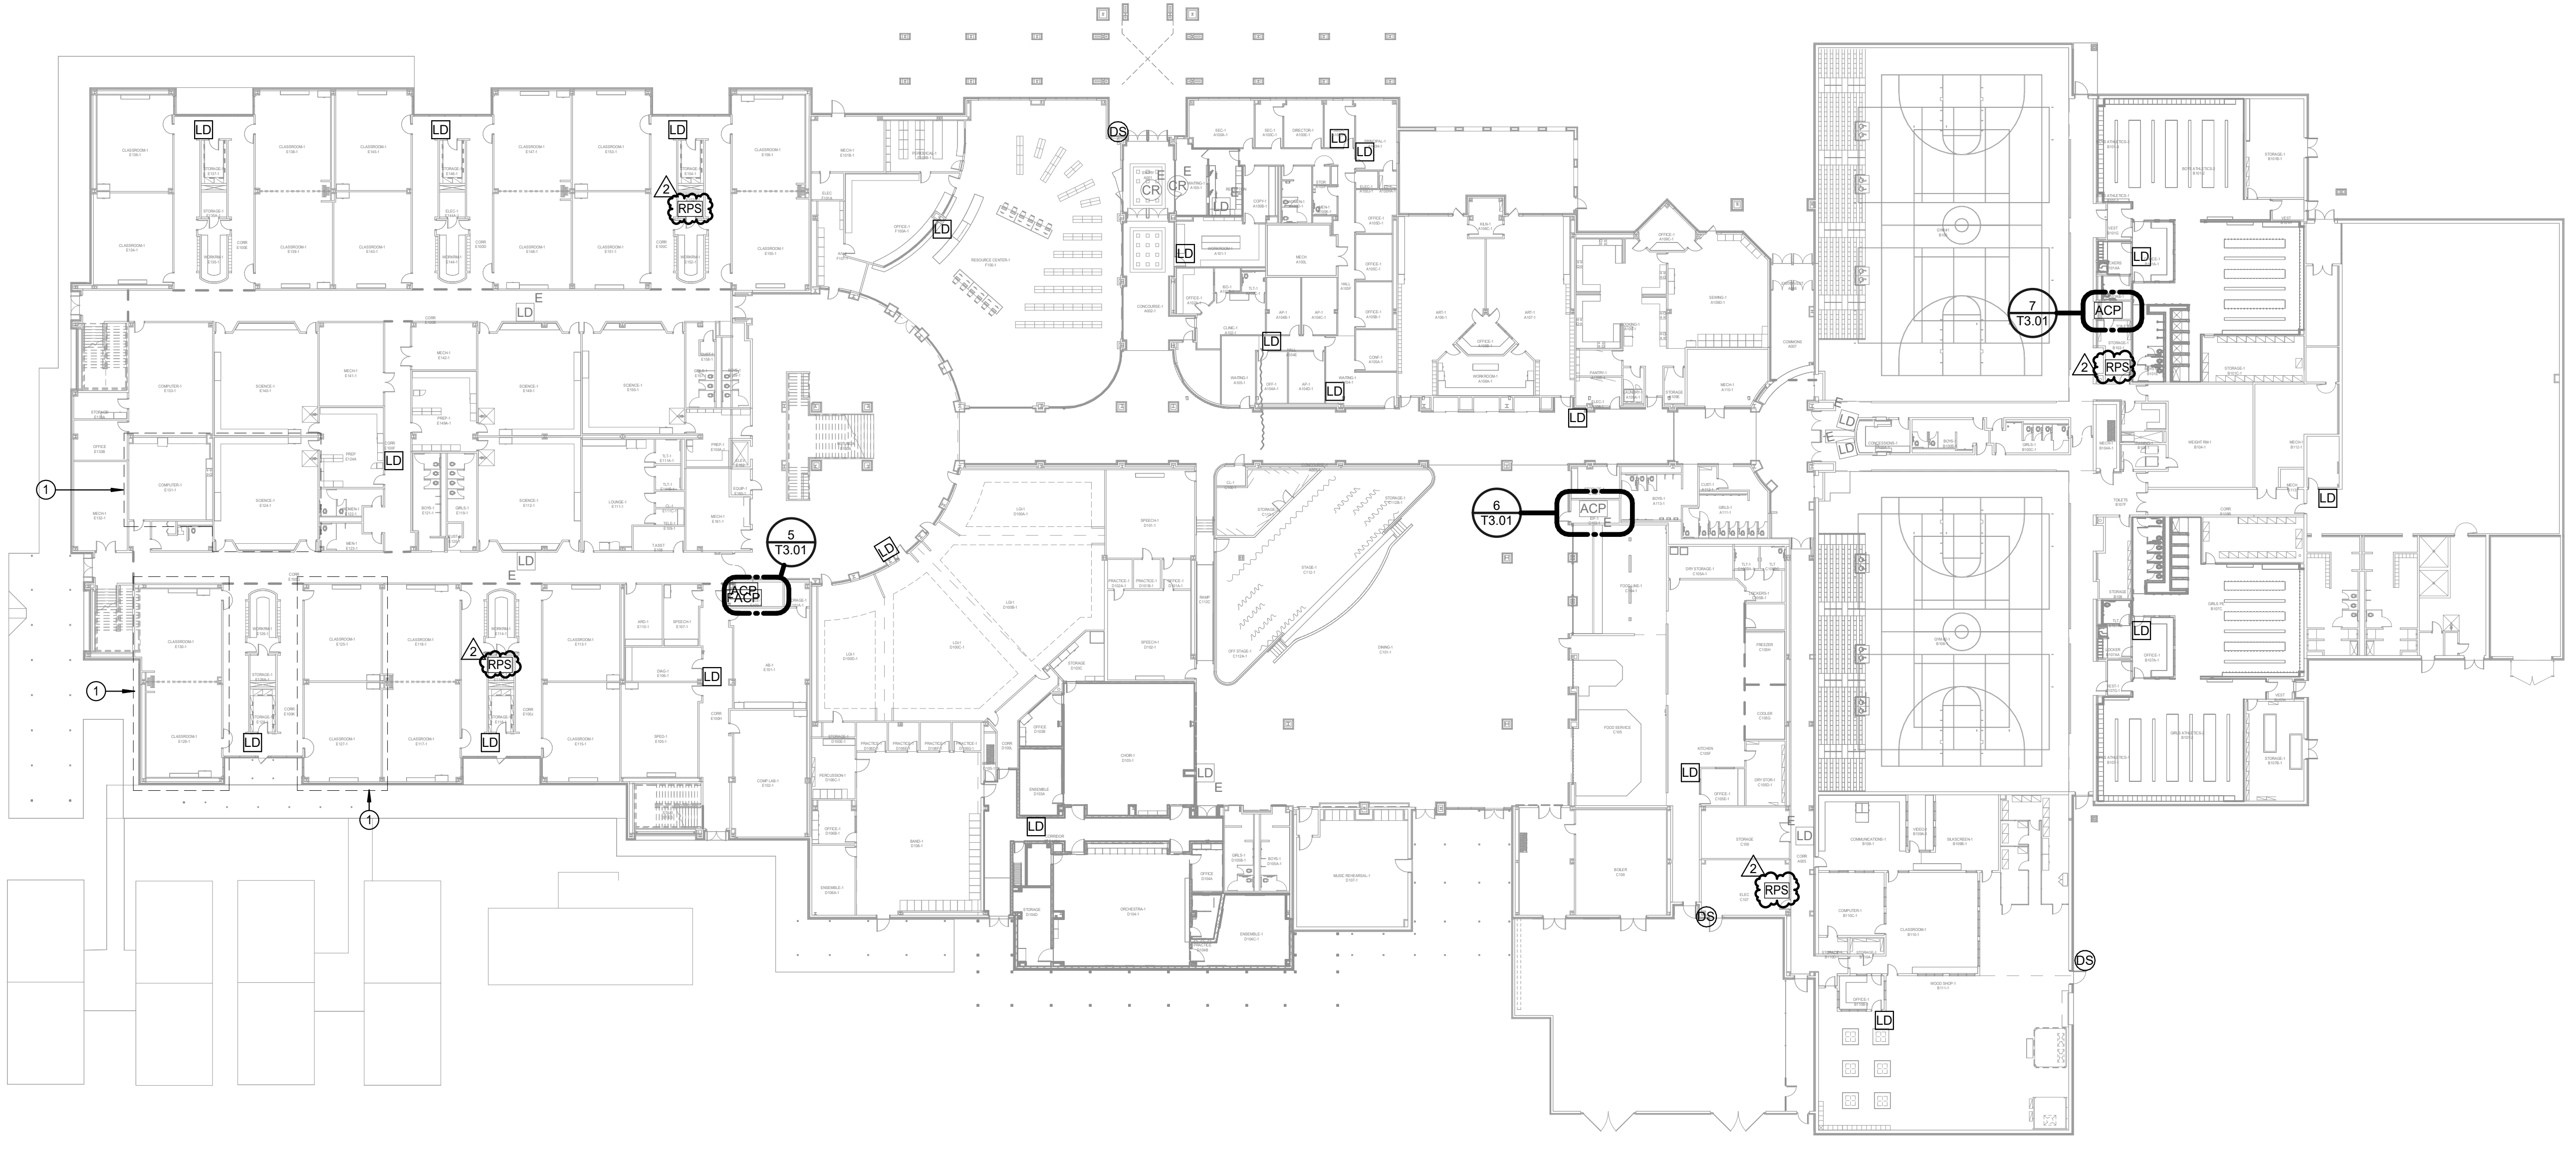

**1 TECHNOLOGY COMPOSITE FLOOR PLAN - LEVEL 1**  
 Scale: 1" = 30'-0"

KEY PLAN:

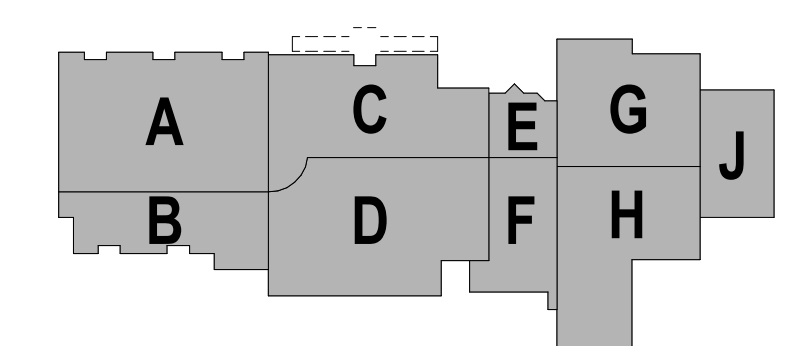


**2024 SMITH & SPILLANE MS RENOVATIONS**  
**SPILLANE MIDDLE SCHOOL**  
 13403 WOODS-SPILLANE BLVD, CYPRESS, TX 77429  
 CFSID PROJECT NO: 24-02-5751-R-RFP

Revision	Submission
2	Addendum 03 02-14-25

Project Number: 23073  
 Date: 26 JANUARY 2025  
 Drawn By: WHL / KLO

TECHNOLOGY COMPOSITE FLOOR PLANS

T1.00

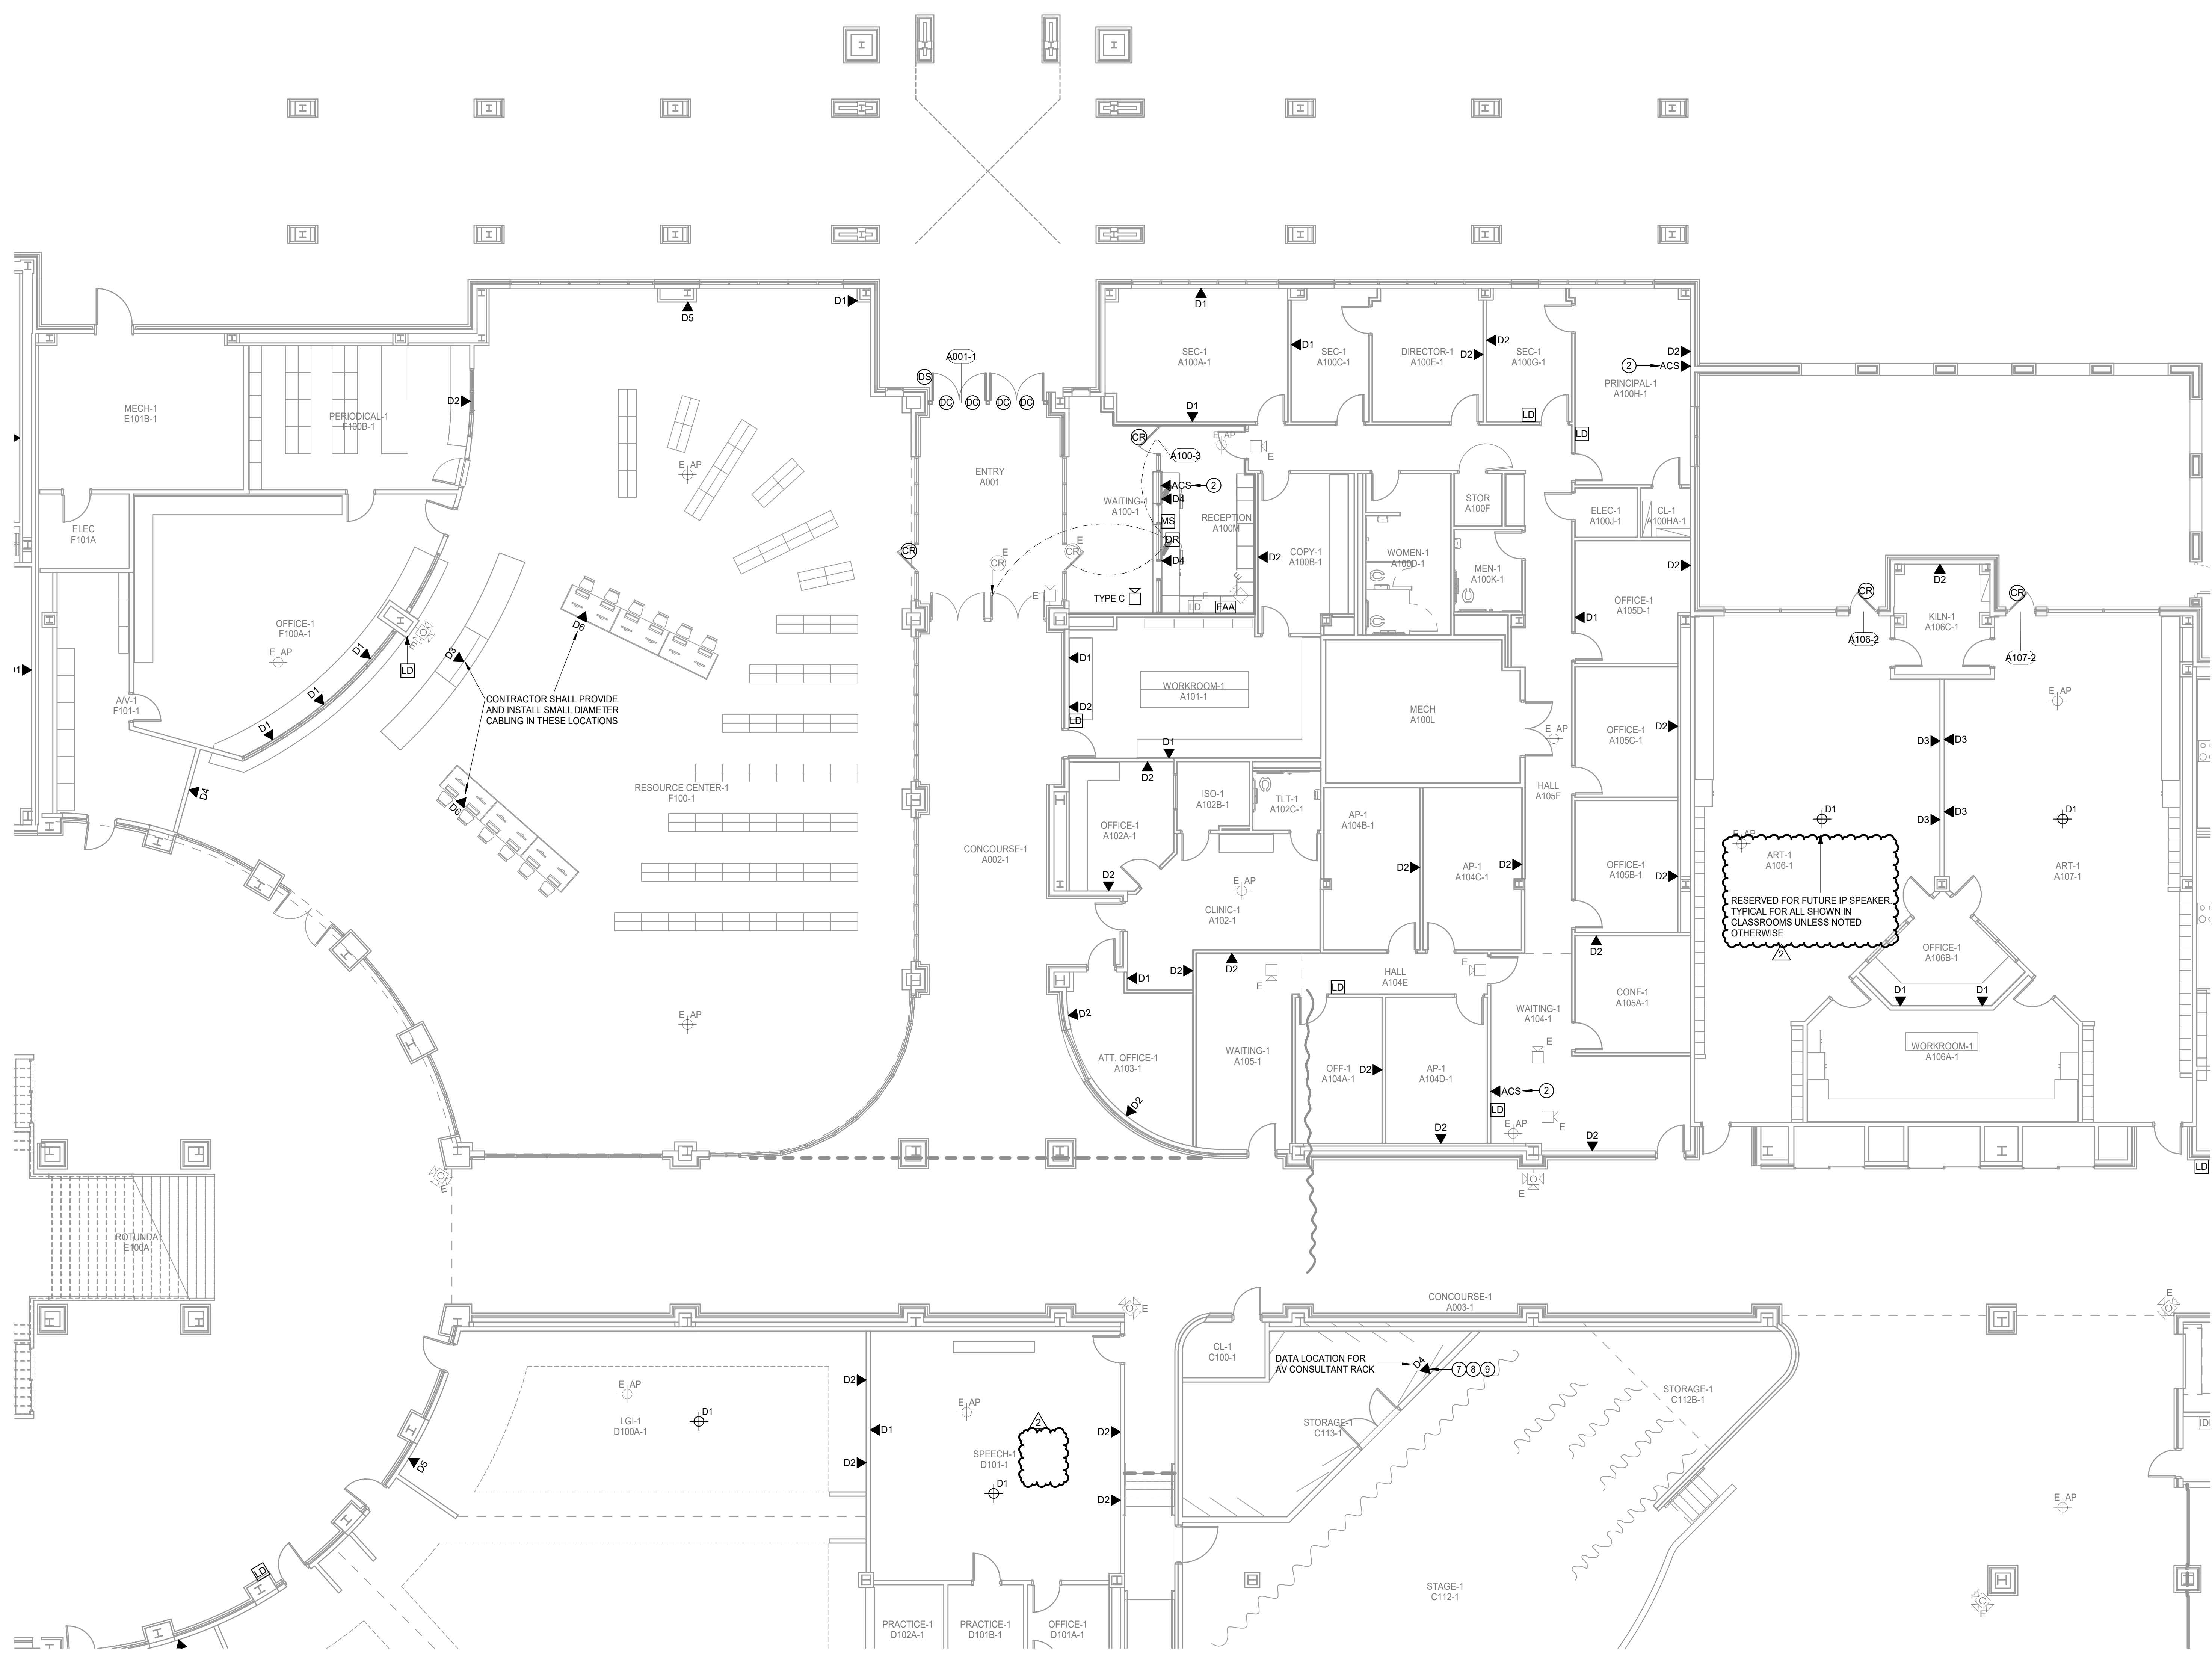

**FIRE ALARM**

A FIRE ALARM SYSTEM IS A PERFORMANCE BASED PER SPECIFICATIONS 28 46 00. CONTRACTOR TO REFERENCE SPECIFICATIONS FOR ADDITIONAL INFORMATION.

B A LICENSED FIRE ALARM PLANNING SUPERINTENDENT CERTIFIED TO A MINIMUM LEVEL 3, IN THE SUBFIELD OF FIRE ALARM SYSTEMS THROUGH THE NATIONAL INSTITUTE FOR CERTIFICATION IN ENGINEERING TECHNOLOGIES (NICE3), SHALL PROVIDE PLANS AND CALCULATIONS FOR A MANUAL AND AUTOMATIC FIRE DETECTION AND ALARM SYSTEM TO COMPLY WITH THE BUILDING SPACE LAYOUT, BUILDING OCCUPANCY, CURRENT NFPA 72, LOCAL AND STATE CODE REQUIREMENTS, AND THE FIRE ALARM AND DETECTION SYSTEM SPECIFICATIONS.

C REFERENCE MECHANICAL PLANS FOR AHU LOCATIONS.

**TECHNOLOGY PLAN GENERAL NOTES**

A COORDINATE ALL FINAL MOUNTING HEIGHTS, FOR WALL MOUNTED DEVICES, PRIOR TO ROUGH-IN. COORDINATE WITH ARCHITECT, OWNER AND ENGINEER.

B COORDINATE ALL CEILING DEVICE LOCATIONS WITH ARCHITECTURAL DRAWINGS AND INTERIOR DESIGN CONSULTANT (IF APPLICABLE) PRIOR TO ROUGH-IN.

C REFERENCE TECHNOLOGY SITE PLAN, COMPOSITE PLANS, NOTES & LEGENDS AND DETAILS FOR ADDITIONAL INFORMATION AND DEVICE/OUTLET LOCATIONS.

D CONTRACTOR TO COORDINATE INTERCOM SPEAKER MOUNTING TYPES WITH ARCHITECTURAL CEILING PLANS PRIOR TO FINAL SPEAKER SELECTION. COORDINATE WITH ENGINEER ON ANY DISCREPANCIES.

E CONTRACTOR TO COORDINATE ALL DROP LOCATIONS WITH FURNITURE. COORDINATE WITH ARCHITECT AND OWNER FOR MORE INFORMATION.

F ALL EXISTING LOCKDOWN BUTTONS THAT ARE BEING REUSED SHALL HAVE EXISTING WIRING DEMOLISHED AND REPLACED BY CONTRACTOR.

G NEW DATA CABLING IN EXISTING CLASSROOMS SHALL REUSE EXISTING DATA CABLING RACEWAY AND BACKBOXES. CONTRACTOR TO PROVIDE AND INSTALL NEW FACEPLATES.

H DATA CABLING TO MECHANICAL ROOMS SHALL BE REPLACED ONE TO ONE. CONTRACTOR TO REUSE EXISTING RACEWAY AND BACKBOXES. PROVIDE AND INSTALL NEW FACEPLATES.

**TECHNOLOGY PLAN KEYED NOTES**

1 INDICATED NETWORK CONNECTION IS RESERVED FOR DEAF EDUCATION PROGRAM LED INDICATOR. CONTRACTOR TO COORDINATE EXISTING LOCATION.

2 EXISTING DEAF EDUCATION PROGRAM DEVICES AND WIRING ARE EXISTING TO REMAIN AND SHALL BE PROTECTED THROUGHOUT CONSTRUCTION.

3 INTERCOM SYSTEM DEVICE CABLING SHALL BE HOME RUN TO INTERCOM SYSTEM HEAD END LOCATED IN ELEC A100J.

4 THE DESIGNATED TELEPHONE OUTLET SHALL BE RESERVED FOR THE ELEVATOR EMERGENCY CALL. CONTRACTOR TO ROUTE A CABLE FROM THE NEAREST MIP/IDF TO THE ELEVATOR CONTROL EQUIPMENT. TERMINATE THE CABLE AT THE ELEVATOR CONTROL EQUIPMENT AND CROSS-CONNECT TO THE ELEVATOR TELEPHONE TRAVEL CABLE. COORDINATE EXACT LOCATION, TERMINATION, AND CROSS-CONNECT WITH THE ELEVATOR INSTALLER.

5 COORDINATE ALL REQUIREMENTS AND FINAL LOCATION WITH ELEVATOR INTEGRATOR PRIOR TO INSTALLATION.

6 DATA OUTLET DEDICATED FOR EMPLOYEE TIME-IN/TIME-OUT TO BE MOUNTED 48" A.F.F. COORDINATE LOG ACCESS RIGHTS WITH OWNER PRIOR TO PROGRAMMING.

7 NETWORK OUTLET RESERVED FOR AV SYSTEM HEAD END RACK. COORDINATE WITH AV CONSULTANT DRAWINGS ON FINAL AV RACK LOCATION.

8 FIRE ALARM CONTRACTOR TO PROVIDE A CONTACT CLOSURE TO THE AUDIO-VISIO RACK FOR EMERGENCY MUTING OF AUDIO SYSTEM WHEN SYSTEM IS IN ALARM.

9 INTERCOM CONTRACTOR TO PROVIDE A CONTACT CLOSURE TO THE AUDIO-VISIO RACK FOR LOCKDOWN EMERGENCY MUTING OF AUDIO SYSTEM WHEN SYSTEM IS IN ALARM.

10 NETWORK OUTLET RESERVED FOR COOLER AND FREEZER MONITORING.

**1 TECHNOLOGY FLOOR PLAN - LEVEL 1 - AREA C**  
 Scale: 1/8" = 1'-0"

**KEY PLAN:**

**2024 SMITH & SPILLANE MS RENOVATIONS**  
**SPILLANE MIDDLE SCHOOL**  
 13403 WOODS-SPILLANE BLVD, CYPRESS, TX 77429  
 CFSID PROJECT NO: 24-02-5751-R-RFP

Revision	Submission
2	Addendum 03 02-14-25

Project Number: 23073  
 Date: 26 JANUARY 2025  
 Drawn By: WHL / KLO

**TECHNOLOGY FIRST FLOOR PLAN - AREA 'C'**  
**T2.03**



**TECHNOLOGY PLAN KEYED NOTES**

- INDICATED NETWORK CONNECTION IS RESERVED FOR DEAF EDUCATION PROGRAM LED INDICATOR. CONTRACTOR TO COORDINATE EXISTING LOCATION.
- EXISTING DEAF EDUCATION PROGRAM DEVICES AND WIRING ARE EXISTING TO REMAIN AND SHALL BE PROTECTED THROUGHOUT CONSTRUCTION.
- INTERCOM SYSTEM DEVICE CABLE SHALL BE HOME RUN TO INTERCOM SYSTEM HEAD END LOCATED IN ELEC A100J.
- THE DESIGNATED TELEPHONE OUTLET SHALL BE RESERVED FOR THE ELEVATOR EMERGENCY CALL. CONTRACTOR TO ROUTE A CABLE FROM THE NEAREST MOW/IFC TO THE ELEVATOR CONTROL EQUIPMENT. TERMINATE THE CABLE AT THE ELEVATOR CONTROL EQUIPMENT AND CROSS-CONNECT TO THE ELEVATOR TELEPHONE TRAVEL CABLE. COORDINATE EXACT LOCATION, TERMINATION, AND CROSS-CONNECT WITH THE ELEVATOR INSTALLER.
- COORDINATE ALL REQUIREMENTS AND FINAL LOCATION WITH ELEVATOR INTEGRATOR PRIOR TO INSTALLATION.
- DATA OUTLET DEDICATED FOR EMPLOYEE TIME-IN/TIME-OUT TO BE MOUNTED 48"-A.F.F. COORDINATE LOG ACCESS RIGHTS WITH OWNER PRIOR TO PROGRAMMING.
- NETWORK OUTLET RESERVED FOR AV SYSTEM HEAD END RACK. COORDINATE WITH AV CONSULTANT DRAWINGS ON FINAL AV RACK LOCATION.
- FIRE ALARM CONTRACTOR TO PROVIDE A CONTACT CLOSURE TO THE AUDIO-VIDEO RACK FOR EMERGENCY MUTING OF AUDIO SYSTEM WHEN SYSTEM IS IN ALARM.
- INTERCOM CONTRACTOR TO PROVIDE A CONTACT CLOSURE TO THE AUDIO-VIDEO RACK FOR LOCKDOWN EMERGENCY MUTING OF AUDIO SYSTEM WHEN SYSTEM IS IN ALARM.
- NETWORK OUTLET RESERVED FOR COOLER AND FREEZER MONITORING.

**FIRE ALARM**

- A FIRE ALARM SYSTEM IS A PERFORMANCE BASED PER SPECIFICATIONS 28 46 00. CONTRACTOR TO REFERENCE SPECIFICATIONS FOR ADDITIONAL INFORMATION.
- A LICENSED FIRE ALARM PLANNING SUPERINTENDENT CERTIFIED TO A MINIMUM LEVEL 3, IN THE SUBFIELD OF FIRE ALARM SYSTEMS THROUGH THE NATIONAL INSTITUTE FOR CERTIFICATION IN ENGINEERING TECHNOLOGIES (NICET), SHALL PROVIDE PLANS AND CALCULATIONS FOR A MANUAL AND AUTOMATIC FIRE DETECTION AND ALARM SYSTEM TO COMPLY WITH THE BUILDING SPACE LAYOUT, BUILDING OCCUPANCY, CURRENT NFPA 72, LOCAL AND STATE CODE REQUIREMENTS, AND THE FIRE ALARM AND DETECTION SYSTEM SPECIFICATIONS.
- REFERENCE MECHANICAL PLANS FOR AHU LOCATIONS.

**TECHNOLOGY PLAN GENERAL NOTES**

- A COORDINATE ALL FINAL MOUNTING HEIGHTS, FOR WALL MOUNTED DEVICES, PRIOR TO ROUGH-IN. COORDINATE WITH ARCHITECT, OWNER AND ENGINEER.
- B COORDINATE ALL CEILING DEVICE LOCATIONS WITH ARCHITECTURAL DRAWINGS AND INTERIOR DESIGN CONSULTANT (IF APPLICABLE) PRIOR TO ROUGH-IN.
- C REFERENCE TECHNOLOGY SITE PLAN, COMPOSITE PLANS, NOTES & LEGENDS AND DETAILS FOR ADDITIONAL INFORMATION AND DEVICE/OUTLET LOCATIONS.
- D CONTRACTOR TO COORDINATE INTERCOM SPEAKER MOUNTING TYPES WITH ARCHITECTURAL CEILING PLANS PRIOR TO FINAL SPEAKER SELECTION. COORDINATE WITH ENGINEER ON ANY DISCREPANCIES.
- E CONTRACTOR TO COORDINATE ALL DROP LOCATIONS WITH FURNITURE. COORDINATE WITH ARCHITECT AND OWNER FOR MORE INFORMATION.
- F ALL EXISTING LOCKDOWN BUTTONS THAT ARE BEING REUSED SHALL HAVE EXISTING WIRING DEMOLISHED AND REPLACED BY CONTRACTOR.
- G NEW DATA CABLE IN EXISTING CLASSROOMS SHALL REUSE EXISTING DATA CABLE RACEWAY AND BACKBOXES. CONTRACTOR TO PROVIDE AND INSTALL NEW FACEPLATES.
- H DATA CABLE TO MECHANICAL ROOMS SHALL BE REPLACED ONE TO ONE. CONTRACTOR TO REUSE EXISTING RACEWAY AND BACKBOXES. PROVIDE AND INSTALL NEW FACEPLATES.

**Salas O'Brien**  
 salesobrien.com 281-664-1900  
 Houston 10930 W. Sam Houston Pkwy North, Suite 900  
 Houston, TX 77064  
 Registration: F-4111  
 Project No: 2024-0209-00

**NATEX CORPORATION ARCHITECTS**  
 www.natesarchitects.com  
 447 Heights Boulevard  
 Houston, TX 77007  
 Phone: 713-975-9525  
 Fax: 713-780-7824

**Coleman Partners ARCHITECTS**  
 www.colemanpartners.com  
 3701 Kirby Drive, Suite 830  
 Houston, TX 77098  
 tel: 832-947-1038 fax: 281-214-5365

**CIVIL ENGINEER BROOKS AND SPARKS, INC.**  
 21020 PARK ROW  
 KATY, TX 77449  
 tel: 281-578-9595

**STRUCTURAL ENGINEER DALLY + ASSOCIATES, INC.**  
 9800 RICHMOND AVE.  
 SUITE 400  
 HOUSTON, TX 77042  
 tel: 713-337-8881

**MEPT ENGINEER SALAS O'BRIEN**  
 10930 W. SAM HOUSTON PKWY. N.  
 SUITE 900  
 HOUSTON, TX 77064  
 tel: 281-664-1900

**FOOD SERVICE EQUIPMENT FDP**  
 25317 INTERSTATE 45  
 THE WOODLANDS, TX 77380  
 tel: 281-350-2323

**LANDSCAPE ARCHITECT LANDESIGN GROUP**  
 17041 EL CAMINO REAL  
 SUITE 204  
 HOUSTON, TX 77058  
 tel: 281-486-4040


**2024 SMITH & SPILLANE MS RENOVATIONS**  
**SPILLANE MIDDLE SCHOOL**  
 13403 WOODS-SPILLANE BLVD, CYPRESS, TX 77429  
 CFSID PROJECT NO: 24-02-5751-R-RFP

1	2	3	4
2	1	1	1
2	1	1	1
2	1	1	1


Project Number: 23073  
 Date: 26 JANUARY 2025  
 Drawn By: WHL / KLO

TECHNOLOGY FIRST FLOOR PLAN - AREA 'D'

**T2.04**

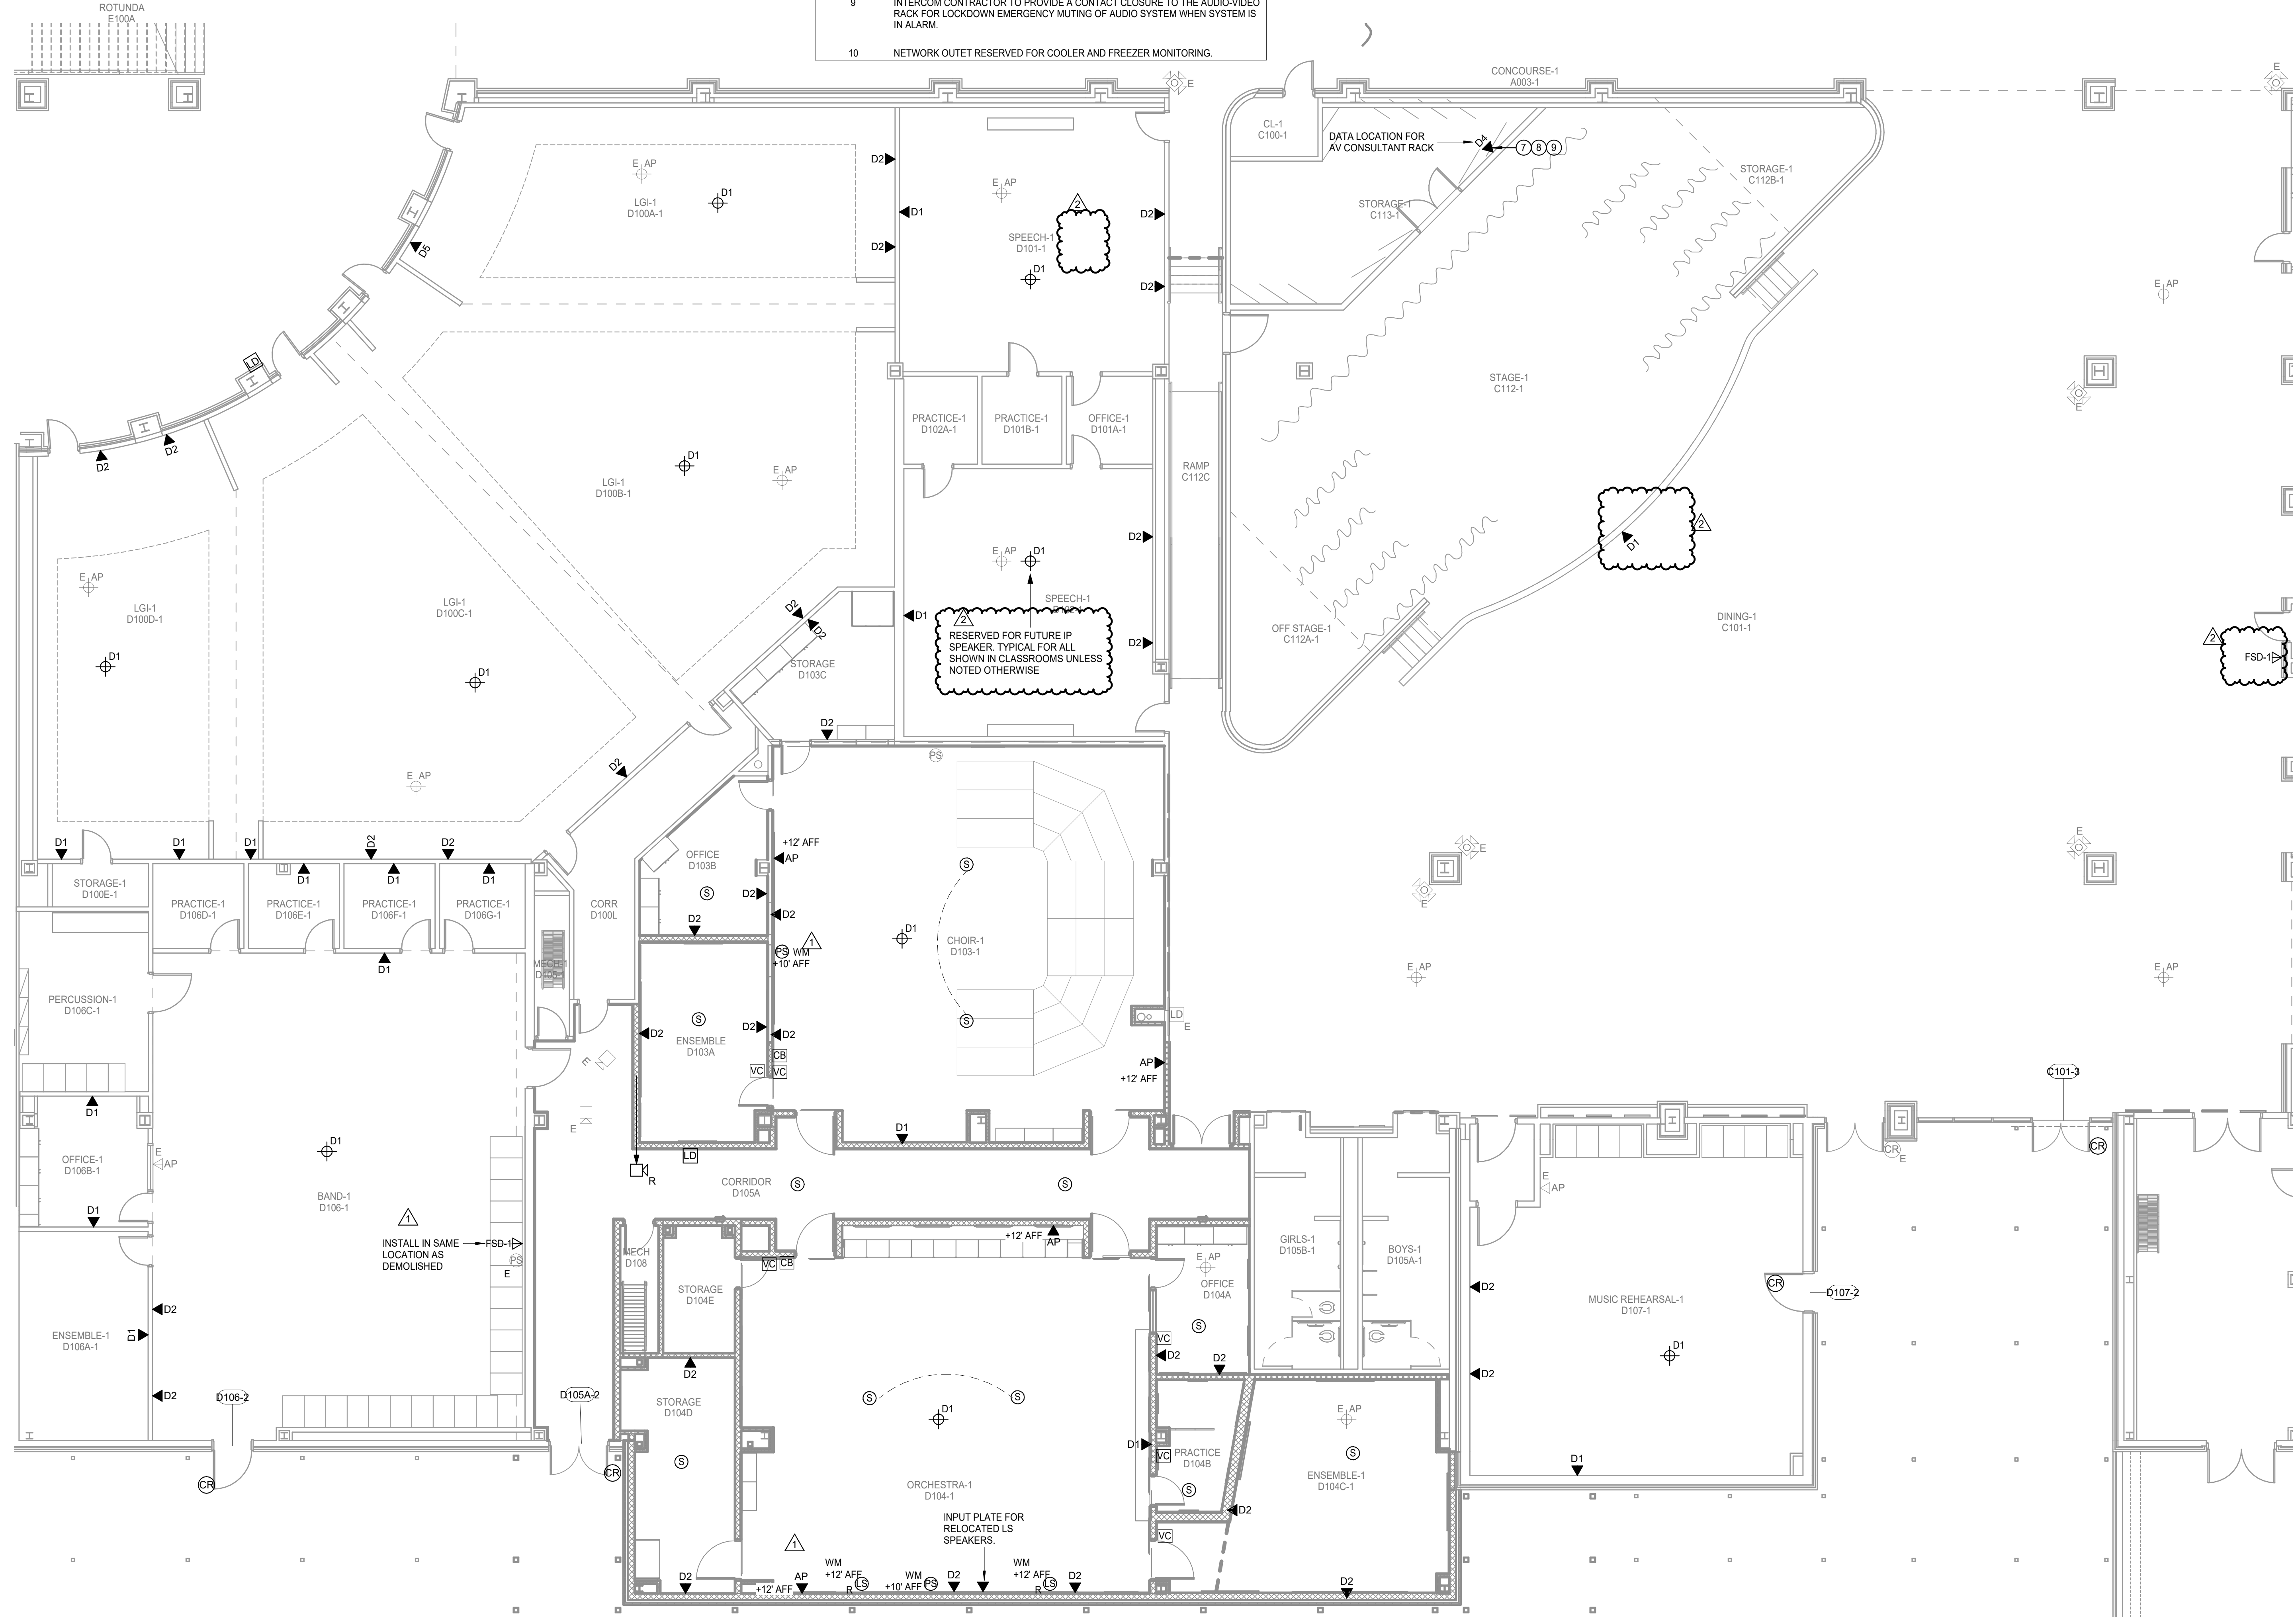

**1 TECHNOLOGY FLOOR PLAN - LEVEL 1 - AREA D**  
 Scale: 1/8" = 1'-0"

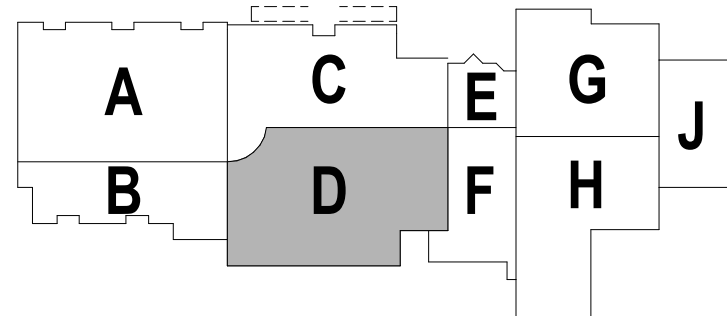

KEY PLAN:


FIRE ALARM	
A	FIRE ALARM SYSTEM IS A PERFORMANCE BASED PER SPECIFICATIONS 28.46.00, CONTRACTOR TO REFERENCE SPECIFICATIONS FOR ADDITIONAL INFORMATION.
B	A LICENSED FIRE ALARM PLANNING SUPERINTENDENT CERTIFIED TO A MINIMUM LEVEL 3 IN THE SUBFIELD OF FIRE ALARM SYSTEMS THROUGH THE NATIONAL INSTITUTE FOR CERTIFICATION IN ENGINEERING TECHNOLOGIES (NICET), SHALL PROVIDE PLANS AND CALCULATIONS FOR A MANUAL AND AUTOMATIC FIRE DETECTION AND ALARM SYSTEM TO COMPLY WITH THE BUILDING SPACE LAYOUT, BUILDING OCCUPANCY, CURRENT NFPA 72, LOCAL AND STATE CODE REQUIREMENTS, AND THE FIRE ALARM AND DETECTION SYSTEM SPECIFICATIONS.
C	REFERENCE MECHANICAL PLANS FOR AHU LOCATIONS.

TECHNOLOGY PLAN GENERAL NOTES	
A	COORDINATE ALL FINAL MOUNTING HEIGHTS, FOR WALL MOUNTED DEVICES, PRIOR TO ROUGH-IN. COORDINATE WITH ARCHITECT, OWNER AND ENGINEER.
B	COORDINATE ALL CEILING DEVICE LOCATIONS WITH ARCHITECTURAL DRAWINGS AND INTERIOR DESIGN CONSULTANT (IF APPLICABLE) PRIOR TO ROUGH-IN.
C	REFERENCE TECHNOLOGY SITE PLAN, COMPOSITE PLANS, NOTES & LEGENDS AND DETAILS FOR ADDITIONAL INFORMATION AND DEVICE/OUTLET LOCATIONS.
D	CONTRACTOR TO COORDINATE INTERCOM SPEAKER MOUNTING TYPES WITH ARCHITECTURAL CEILING PLANS PRIOR TO FINAL SPEAKER SELECTION. COORDINATE WITH ENGINEER ON ANY DISCREPANCIES.
E	CONTRACTOR TO COORDINATE ALL DROP LOCATIONS WITH FURNITURE. COORDINATE WITH ARCHITECT AND OWNER FOR MORE INFORMATION.
F	ALL EXISTING LOCKDOWN BUTTONS THAT ARE BEING REUSED SHALL HAVE EXISTING WIRING DEMOLISHED AND REPLACED BY CONTRACTOR.
G	NEW DATA CABLING IN EXISTING CLASSROOMS SHALL REUSE EXISTING DATA CABLING RACEWAY AND BACKBOXES. CONTRACTOR TO PROVIDE AND INSTALL NEW FACEPLATES.
H	DATA CABLING TO MECHANICAL ROOMS SHALL BE REPLACED ONE TO ONE. CONTRACTOR TO REUSE EXISTING RACEWAY AND BACKBOXES. PROVIDE AND INSTALL NEW FACEPLATES.

**Salas O'Brien**  
 salesobrien.com 281-664-1900  
 Houston  
 10930 W. Sam Houston Pkwy North, Suite 900  
 Houston, TX 77064  
 Registration: F-4111  
 Project No: 2024-00209-00

**NATEX**  
 CORPORATION  
 ARCHITECTS  
 www.natexarchitects.com  
 447 Heights Boulevard  
 Houston, TX 77007  
 Phone: 713-975-9525  
 Fax: 713-780-7824

**Coleman Partners**  
 ARCHITECTS  
 colemanpartners.com  
 3701 Kirby Drive, Suite 830  
 Houston, TX 77098  
 tel: 832-947-1038 fax: 225-214-5365

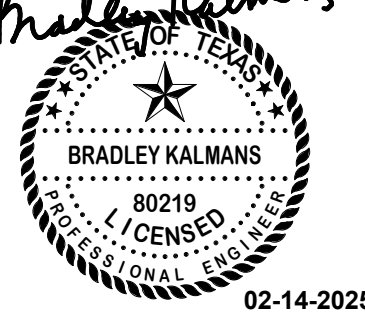**CONSTRUCTION DOCUMENT**  


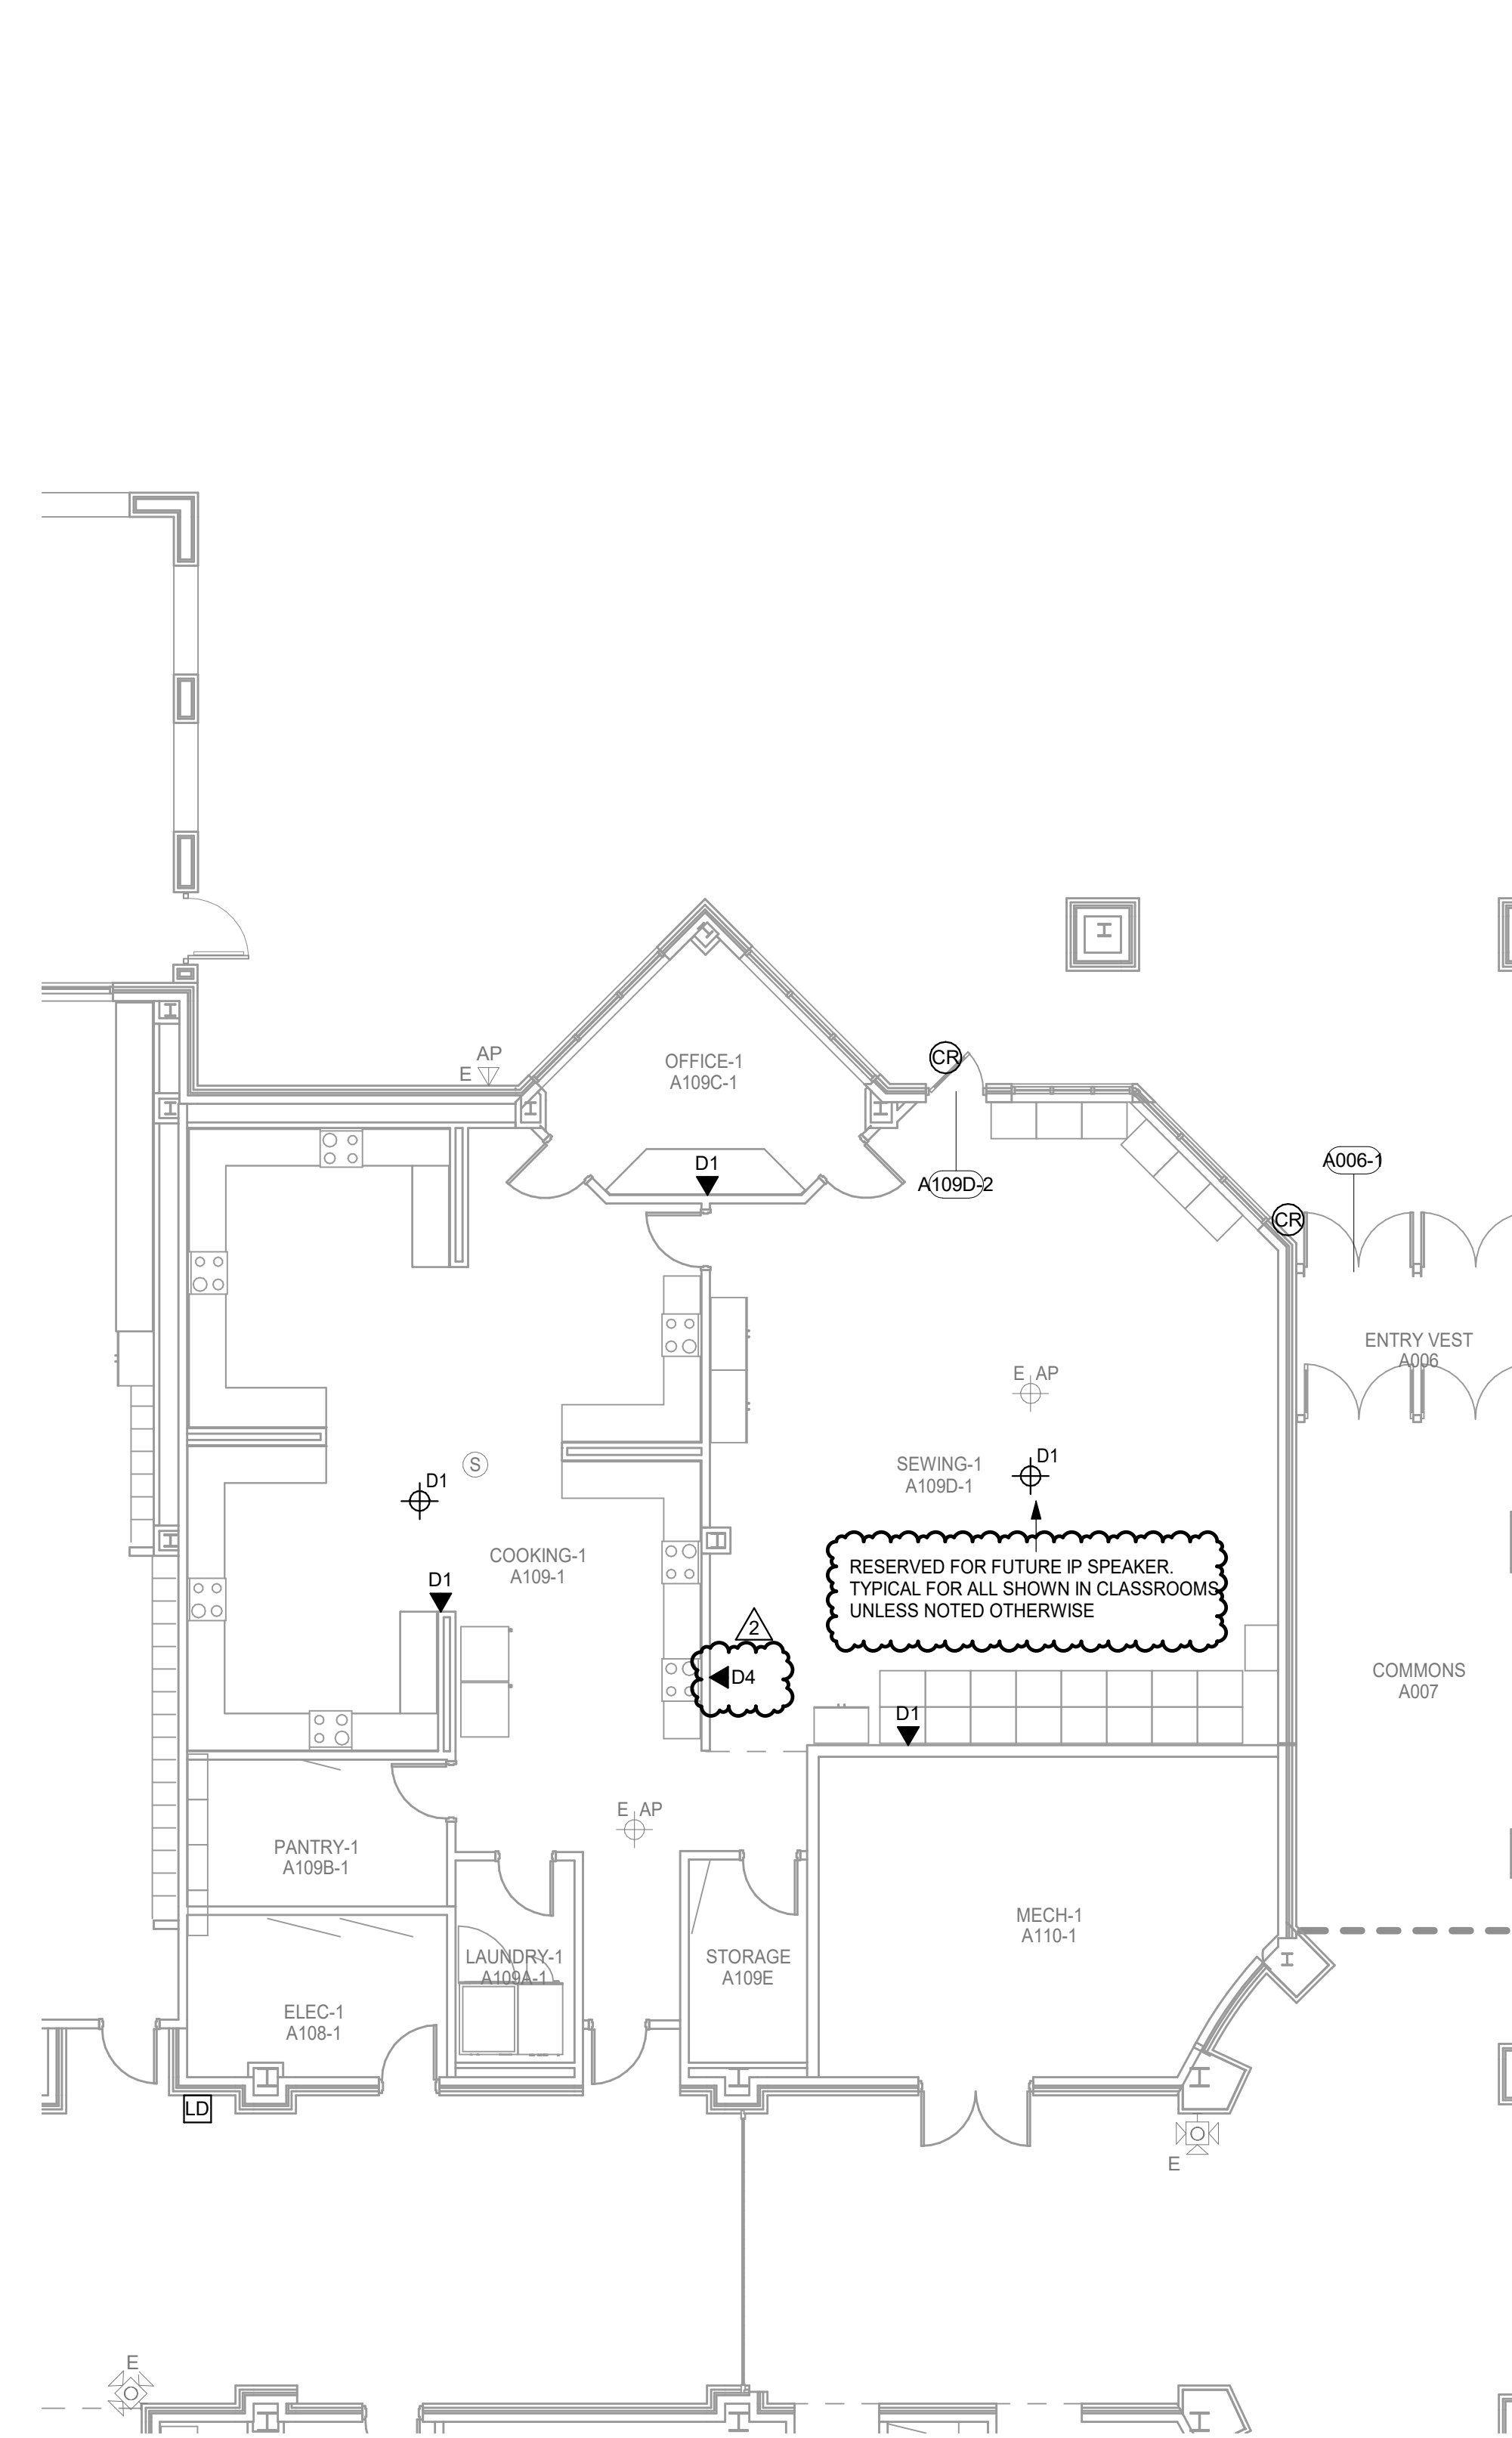
**CIVIL ENGINEER**  
**BROOKS AND SPARKS, INC.**  
 21020 PARK ROW  
 KATY, TX 77449  
 tel: 281-578-9595

**STRUCTURAL ENGINEER**  
**DALLY + ASSOCIATES, INC.**  
 9800 RICHMOND AVE.  
 SUITE 400  
 HOUSTON, TX 77042  
 tel: 713.337.8881

**MEPT ENGINEER**  
**SALAS O'BRIEN**  
 10930 W. SAM HOUSTON PKWY. N.  
 SUITE 900  
 HOUSTON, TX 77064  
 tel: 281.664.1900

**FOOD SERVICE EQUIPMENT**  
**FDP**  
 25317 INTERSTATE 45  
 THE WOODLANDS, TX 77380  
 tel: 281-350-2323


**LANDSCAPE ARCHITECT**  
**LANDESIGN GROUP**  
 17041 EL CAMINO REAL  
 SUITE 204  
 HOUSTON, TX 77058  
 tel: 281-486-4040



**1 TECHNOLOGY FLOOR PLAN - LEVEL 1 - AREA E**  
 Scale: 1/8" = 1'-0"

**KEY PLAN:**

Project Number:	23073
Date:	26 JANUARY 2025
Drawn By:	WHL / KLO

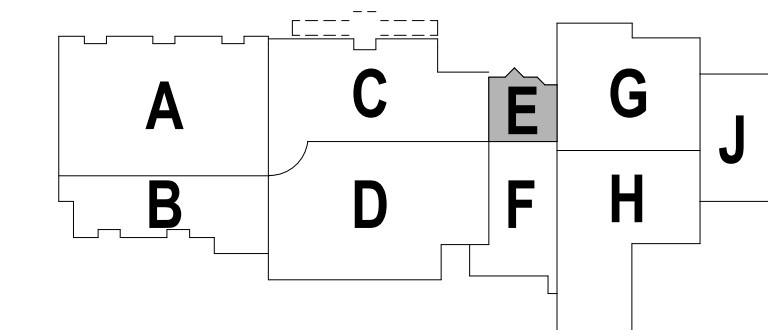

**2024 SMITH & SPILLANE MS RENOVATIONS**  
**SPILLANE MIDDLE SCHOOL**  
 13403 WOODS-SPILLANE BLVD, CYPRESS, TX 77429  
 CFSID PROJECT NO: 24-02-5751-R-RFP

Revision	Submission
2	Addendum 03 02-14-25

Project Number:	23073
Date:	26 JANUARY 2025
Drawn By:	WHL / KLO

**TECHNOLOGY FIRST FLOOR PLAN - AREA 'E'**  
**T2.05**