

11 Greenway Plaza Suite 2210 Houston, Texas 77046-1104 Telephone: 713/965-0608 Fax: 713/961-4571

ADDENDUM NO. 02 January 17, 2025

To Drawings and Specifications dated December 18, 2024.

HUMBLE HIGH SCHOOL ADDITIONS AND RENOVATIONS – PHASE TWO FOR HUMBLE I.S.D.

Prepared by:

PBK 11 Greenway Plaza, 22nd Floor Houston, TX 77046-1104 PBK Project No: 220537

Notice to Bidders

- A. Receipt of this Addendum shall be acknowledged on the Bid Form.
- B. This Addendum forms part of the Contract documents for the above referenced project and shall be incorporated integrally therewith.
- C. Each bidder shall make necessary adjustments and submit his proposal with full knowledge of all modifications, clarifications, and supplemental data included therein. Where provisions of the following supplemental data differ from those of the original Contract Documents, this Addendum shall govern.

GENERAL

- Item No. 1 Note that the campus radio antenna system and IP cameras are removed from the contractor's project scope since these items are owner furnished owner installed.
- Item No. 2 In existing areas of the school where new lighting controls are added, the contractor shall remove the existing controls. The removed controls shall be retained and turned over to the owner. The utilization of the existing conduit and boxes for the existing is acceptable.
- Item No. 3 As part of the Base Bid, the head-in is existing and is to remain. All new devices shall be tied back to the existing head-in. For pricing for Alternates 2, 3, and 7, the head-in is existing and is to remain. No new head-in is required. All devices for these alternates are to be removed and reinstalled per the Technology General Notes.
- Item No. 4 This line item is associated with all foundation sheets, the grade beam schedule, and all grade beam details. Per the Geotech report, the spread footings must bear a minimum of six feet below existing natural grade. To account for this, we believe the footings should bear roughly seven feet below finish floor. We have adjusted the depths of the grade beams to push the footings to bear at seven feet below finish floor. Refer to the updated grade beam schedule in this addendum. We are not re-issuing all foundation sheets for this change, but it shall be generally understood that the current -3-'6" value shown at each footing will become -5'-4" to achieve a bottom of footing of -7'-0" below FF. Please note this additional depth may cause OSHA-style benching of the soil excavations. The general contractor shall account for any added cost or time associated with this additional footing, grade beam, and pilaster depth. The grade beam schedule has been updated to represent the deeper grade beams at all
- locations. Where possible, the width of the grade beam has been narrowed and reduced the reinforcement. Refer to the revised grade beam schedule on sheet S-302 in this addendum.
 The Geotech report highly recommends for the contractor to utilize a seal slab two to four inches thick made from lean concrete (approx. 300 to 500 psi) at the base of each footing. They believe that due to moisture in the soil at the bottom of the footing excavations may be difficult to construct without a seal slab to protect the base soils. All bidders shall account for a two inch to four inch lean concrete seal slab unreinforced at the base of each and every footing.

Item No. 7 There are a few locations within the drawings where utilities such as plumbing, storm, sanitary, electrical, etc. are running just below the grade beams. As a result of the increased depth noted above, some of these utilities may clash with the bottom of grade beams. Where these occur, the structural engineer will allow shallowing of the grade beams to miss the utility. In these instances, the footing will remain low - and a 24"x24" pilaster will be added to the footing to receive the shallower grade beam. The pilaster will run full height between the footing and the bottom of slab. The pilaster will be reinforced per the typical pilaster detail with #6 bars vertically and 10 inch on center around the perimeter and ties.

SPECIFICATIONS

Item No. 8 Section 00 40 00: Competitive Sealed Proposal Form: Replace section in its entirety.

- Item No. 9 Section 01 21 00: Allowances: Add allowance as follows:
 - Asbestos Remediation Allowance: D.

1.

\$200,000.00 Contactor shall include the amount indicated above in his Base Proposal for the cost of asbestos remediation.

Item No. 10	Section 02 82 00: Asbestos Remediation: Add section in its entirety.
Item No. 11	Section 08 71 00: Door Hardware: Replace section in its entirety.
Item No. 12	Section 08 71 00: Door Hardware - Alternate: Add section in its entirety.
Item No. 13	Section 10 14 00: Graphics: Replace section in its entirety.
Item No. 14	Section 10 51 13: Metal Lockers and Benches: Replace section in its entirety.
Item No. 15	Section 12 66 13: Telescoping Bleachers: Replace section in its entirety.
Item No. 16	Section 14 24 00: Hydraulic Elevator: Replace section in its entirety.
Item No. 17	Section 27 10 00: Structured Cabling System: Add section in its entirety.
Item No. 18	Section 27 32 43: Campus Radio Antenna System: Omit section in its entirety.
Item No. 19	Section 28 23 00: IP Security Camera System: Omit section in its entirety.

DRAWINGS

Item No. 20	Check C 004: Deplese sheet in its entirety
	Sheet G-001: Replace sheet in its entirety.
Item No. 21	Sheet G-061: Omit detail 04.
Item No. 22	Sheet AD001: Replace sheet in its entirety.
Item No. 23	Sheet AD002: Replace sheet in its entirety.
Item No. 24	Sheet AD101A: Replace sheet in its entirety.
Item No. 25	Sheet AD101B: Replace sheet in its entirety.
Item No. 26	Sheet AD101C: Replace sheet in its entirety.
Item No. 27	Sheet AD101E: Replace sheet in its entirety.
Item No. 28	Sheet AD101F: Replace sheet in its entirety.
Item No. 29	Sheet AD101G: Replace sheet in its entirety.
Item No. 30	Sheet AD101K: Replace sheet in its entirety.
Item No. 31	Sheet AD101N: Replace sheet in its entirety.
Item No. 32	Sheet AD102A: Replace sheet in its entirety.
Item No. 33	Sheet AD102B: Replace sheet in its entirety.
Item No. 34	Sheet AD102F: Replace sheet in its entirety.
Item No. 35	Sheet AD102G: Replace sheet in its entirety.
Item No. 36	Sheet C 200.1: Replace sheet in its entirety.
Item No. 37	Sheet C 300: Replace sheet in its entirety.
Item No. 38	Sheet L-101: Replace sheet in its entirety.
Item No. 39	Sheet L-102: Replace sheet in its entirety.
Item No. 40	Sheet S-302: Replace sheet in its entirety.
Item No. 41	Sheet A-001: Replace sheet in its entirety.
Item No. 42	Sheet A-101B: Replace sheet in its entirety.
Item No. 43	Sheet A-101C: Replace sheet in its entirety.
Item No. 58	Sheet A-441: Replace sheet in its entirety.
Item No. 59	Sheet A-442: Replace sheet in its entirety.
Item No. 60	Sheet A-443: Replace sheet in its entirety.
Item No. 61	Sheet A-444: Replace sheet in its entirety.
Item No. 62	Sheet A-445: Replace sheet in its entirety.
Item No. 63	Sheet A-446: Add sheet in its entirety.
Item No. 64	Sheet A-501: Replace sheet in its entirety.
Item No. 65	Sheet A-527: Replace sheet in its entirety.
Item No. 66	Sheet A-710: Replace sheet in its entirety.
Item No. 67	Sheet AF101B: Replace sheet in its entirety.
Item No. 68	Sheet AF101H: Replace sheet in its entirety.
Item No. 69	Sheet AF101J: Replace sheet in its entirety.
Item No. 70	Sheet AF101K: Replace sheet in its entirety.
Item No. 71	Sheet AF101U: On the finish plan, provide flooring type RF-1 in rooms 2400B and 2400C (in lieu of PFT-2).
Item No. 72	Sheet AF102B: On the finish plan and schedule, provide flooring type CPT-2 in room 3119 (in lieu of RF-1 or CS-1).
Item No. 73	Sheet E-201J: Replace sheet in its entirety.
Item No. 74	Sheet E-201S: Replace sheet in its entirety.
Item No. 75	Sheet E-703: Replace sheet in its entirety.

QUESTIONS

Item No. 76	At the start of the hardware sets there is a heading stating "Hardware Sets based on plans dated 3-6-2024 - Issued for Proposal". The plan sheets that are in the link provided are dated 12-18-2024 Issue for Proposal. For bidding, should I use these hardware sets with the heading based on IFP 3-6-24? If so, are these the Base Only sets? It looks like the same Hardware Set number is used for Base and Alternates, which is not matching up. The Table of Contents list 087100 Door Hardware and 087100 Door Hardware – Alternate. Should there be two sections of Hardware Sets? Answer: Refer to the door hardware specification sections included in this addendum.
Item No. 77	The plumbing demo drawings (please reference PD101A) show to demolish the fixtures and the carriers where as the architectural demo drawings show to pull the fixtures and reinstall. Please clarify which is correct. Answer: Refer to the following revised sheets included in this addendum: A-001, AD001, AD002, AD101B, AD101C, AD101E, AD101F, AD101G, AD101K, AD101N, AD102A, AD102G, A-101B, A-101C, A-101E, A-101F, A-101G, A- 101K, A-101N, A-102A, and A-102G.
Item No. 78	I saw no OHDs here but there is a spec for folding gates When I look in the plans I see the below in area H – can you confirm they want one large side folding gate to cover this +/- 90' wide space? Answer: Refer to the following revised sheets included in this addendum: A- 101H.1, A-527, and A-710.
Item No. 79	Please provide an asbestos report for the renovation portion of this work? If there is not one, will the owner be doing an asbestos survey to see if there is asbestos Or could you please provide an allowance line for asbestos removal so that everyone has the same information? Answer: Humble ISD will provide any surveys required, and the general contractor will handle the abatement. See this addendum for an abatement allowance and a specification section for this abatement.

Item No. 80	I am trying to find out about the Alternate Hardware Sets that are missing within the specifications. Do you know if this is still in the making of being released? Answer: Refer to the door hardware specification section for the alternates included in this addendum.
Item No. 81	1.Durning the walk through a discussion of reusing some of the existing elevator
	components came up. Will a bid of a Modernization of the existing elevator be exemptible? 2.Otis is the only manufacture accepted in the specification. Are other
	elevator manufactures acceptable. Answer: 1. The scope of this project is a complete
	replacement of the existing elevator, as shown in the construction documents. A modernization
	of the existing elevator is not acceptable. 2. Refer to the elevator specification section included in this addendum.
Item No. 82	The room finish schedule specifies WT-1/WT-2/WT-3 for the walls in restrooms 1118 and
	1119, but elevations in detail 21 on sheet A-441 do not show this. Answer: Refer to revised
	sheet A-441 included in this addendum.
Item No. 83	The room finish schedule specifies WT-1/WT-2/WT-3, but the elevations only show WT-1 and WT-2. Answer: Refer to the following revised sheets included in this addendum: A-442, A-443, A-444, and A-445.
Item No. 84	For restroom Coach 2815: Which walls will receive wall tile? Answer: Refer to revised sheet
101110.04	AF101K included in this addendum.
Item No. 85	Revise the room finish schedule for the restrooms in Area K, Level 1. Answer: Refer to revised sheet A-445 included in this addendum.
Item No. 86	Rooms 2400C and 2400B: The room finish schedule specifies RF-1, but the finish plan shows PFT-2. Answer: Provide RF-1 as scheduled.
Item No. 87	Storage 3119: The room finish schedule specifies CS-1, but the finish plan shows RF-1.
	Answer: Provide carpet CPT-2 finish in this room.
Item No. 88	Can LockersMFG be an approved lockers manufacturer for this project? Answer: Refer to the locker specification section included in this addendum.

Attachments include 154 additional sheets and ends with drawing E-703 dated 01/17/25.



DOCUMENT 00 40 00 - COMPETITIVE SEALED PROPOSAL FORM

This Document is for reference, the actual Proposal Form will have to be filled out via lonwave.

HUMBLE HIGH SCHOOL ADDITIONS AND RENOVATIONS PHASE TWO HUMBLE DISTRICT INDEPENDENT SCHOOL DISTRICT

Submitted by: _____

Phone No.: Date:

Board of Trustees To: Humble Independent School District 1703 Wilson Rd. Building B Humble, Texas 77396

Having examined Proposal and Contract Documents prepared by PBK, Inc., dated December 18, 2024, and having examined site conditions, the undersigned proposes to furnish all labor, equipment and materials and perform all work for the completion of the above-named project for the sum indicated below.

In submitting his Proposal, the undersigned agrees to the following:

- 1. Base Proposal to be submitted via lonwave by January 23, 2025, and this signed document to be submitted post-bid.
- 2. Hold proposal open for acceptance 90 days.
- 3. Accept right of Owner to reject any or all proposals, to waive formalities and to accept proposal which Owner considers most advantageous.
- 4. Enter into and execute the contract, if awarded, for the Base Proposal and accepted Alternate Proposals.
- 5. Complete work in accordance with the Contract Documents within the stipulated contract time.
- 6. By signing, the undersigned affirms that, to the best of his knowledge, the Proposals have been arrived at independently and is submitted without collusion with anyone to obtain information or gain any favoritism that would in any way limit competition or give an unfair advantage over respondents in the award of this proposal.

BASE PROPOSAL Ι.

Undersigned agrees to complete the Work for the lump sum amount of:

1.1 Humble High School Additions and Renovations Phase Two

_____Dollars \$_____ (Amount in figures)

(Amount written in words governs)

П. **ALLOWANCES**

Undersigned certifies that the specified allowances are included in the Base Proposal and agrees that any unexpended balance of allowance sums will revert to Owner in the final settlement of the contract.

1.	Owner's Contingency	\$1,500,000.00
2.	First Responder Antenna System	\$1,143,112.00

111.

3.	Super Graphics		\$80,000.00
4.	Asbestos Remediation		\$200,000.00
UNIT	PRICES		
1. L	Init Price 1: Removal of unsatisfactory soil and replacement	with satisfac	tory soil material
ADD	(Amount written in words governs)	Dollars \$	(Amount in figures)
2.			
L	Init Price 2: Rock excavation and replacement with satisfacto	ory soil mate	erial
ADD	(Amount written in words governs)	Dollars \$	(Amount in figures)
3.			(Amount in figures)
L	Init Price 3: Cutting and patching of concrete floor slabs		
ADD	(Amount written in words governs)	Dollars \$	Amount in figures
4.	(Amount written in words governs)		(Amount in figures
L	Init Price 4: Concrete		
ADD	(Amount written in words governs)	Dollars \$	(Amount in figures)
5.	(Amount written in words governs)		(Amount in figures)
L	Jnit Price 5: Select fill		
ADD	(Amount written in words governs)	Dollars \$	(Amount in figures)
6.	(Amount written in words governs)		(Amount in figures)
L	Init Price 6: Spread Footing (Add)		
ADD		Dollars \$	(Amount in figures)
7.	(Amount written in words governs)		(Amount in figures)
L	Init Price 7: Spread Footing (Deduct)		
ADD	(Amount written in words governs)	Dollars \$	(Amount in figures)
8.	(Amount written in words governs)		(Amount in figures)
	Init Price 8: Existing Pier Demo Condition 1 (Overlap with Ne	w Pier)	
ADD		Dollars \$	(Amount in figures)
9.	(Amount written in words governs)		(Amount in figures)
	Init Price 9: Existing Pier Demo Condition 2 (No Conflict with	New Piers)	
ADD		Dollars \$	
	(Amount written in words governs)		(Amount in figures)

10. Unit Price 10: Grade Beam (Add)		
ADD(Amount written in words governs)	Dollars \$_	(Amount in figures)
11. Unit Price 11: Grade Beam (Deduct)		
ADD(Amount written in words governs)	Dollars \$_	(Amount in figures)
12. Unit Price 12: Miscellaneous and Structural Steel		
ADD(Amount written in words governs)	Dollars \$_	(Amount in figures)
(Amount written in words governs)		(Amount in rigules)

IV. CONTRACT TIME

Undersigned agrees to begin Work upon Notice to Proceed, and be Substantially Complete by July 15, 2026. A schedule is to be uploaded on lonWave that must include the following milestone dates.

In addition, the undersigned will agree to meet Milestone completion dates for completion of the Foundation, Structural Steel, Building Envelope and Roof, and HVAC Start Up to be submitted at Bid Time and Date via lonwave.

IV. **ADDENDA**

Undersigned acknowledges receipt of Addenda Nos. dated _____, 20__.

۷. **ALTERNATES**

If the Owner accepts any or all of the Alternates, the undersigned agrees to modify the Base Proposal as stipulated below:

Alternate No. 1: Synthetic Turf Outdoor Work Area at Athletics Courtyard Α.

ADD	Dollars \$
(Amount written in words governs)	(Amount in figures)

Β. Alternate No. 2: Existing Ceilings and Lights Replacement

> _____ _Dollars \$_ ADD___ (Amount written in words governs)

(Amount in figures)

C. Alternate No. 3: Science Labs Renovation

> COMPETITIVE SEALED PROPOSAL FORM 00 40 00 - 3

	ADD	Dollars	\$
	ADD(Amount written in words governs)		\$(Amount in figures)
D.	Alternate No. 4: Existing Flooring Replacement		
	ADD	Dollars	\$
	ADD(Amount written in words governs)		<pre>\$(Amount in figures)</pre>
E.	Alternate No. 5: Existing Doors Replacement		
	ADD(Amount written in words governs)	Dollars	<pre>\$(Amount in figures)</pre>
	(Amount written in words governs)		(Amount in figures)
F.	Alternate No. 6: Irrigation and Sod		
	ADD(Amount written in words governs)	Dollars	<pre>\$(Amount in figures)</pre>
	(Amount written in words governs)		(Amount in figures)
G.	Alternate No. 7: Area H Corridor Renovation		
	ADD	Dollars	\$
	ADD(Amount written in words governs)		(Amount in figures)
H.	Alternate No. 8A: Direct Digital Controls – Reliable C	controls (Basis c	of Design)
	ADD(Amount written in words governs)	Dollars	\$
	(Amount written in words governs)		(Amount in figures)
I.	Alternate No. 8B: Direct Digital Controls - Alerton		
	ADD(Amount written in words governs)	Dollars	\$
	(Amount written in words governs)		(Amount in figures)
J.	Alternate No. 9: High Capacity Packaged, Outdoor, (Trane – Horizon Model	Central Station A	Air Handling Units –
	ADD	Dollars	\$
	(Amount written in words governs)		(Amount in figures)
K.	Alternate No. 10: Base Bid Adjustment (if any) – This a be added to/ deducted from the Base Proposal in the an error in their Base Proposal amount.		
	ADD	Dollars	\$
	ADD(Amount written in words governs)		(Amount in figures)

VI. CHANGES IN THE WORK

Undersigned understands that changes in the work shall be performed in accordance with the Supplementary Conditions.

PBK Architects Project No. 220537 CSP No. 2025-09

VII. LIQUIDATED DAMAGES

Undersigned understands that liquidated damages as defined in the Supplementary Conditions will be included in the form of Agreement between Owner and Contractor and that the contractor will be bound thereto.

It is understood that the right is reserved by the Owner to reject any or all proposals, or waive any informalities in the proposal process.

Authorized Signature

Title

(Seal, if a Corporation) State whether Corporation, Partnership or Individual

Name of Contracting Firm

Address

Telephone

Date

END OF DOCUMENT 00 40 00

SECTION 02 82 00 - ASBESTOS REMEDIATION

PART 1 - GENERAL

1.1 RELATED DOCUMENTS

<u>A.</u> <u>Drawings and general provisions of the Contract, including General and Supplementary</u> Conditions and Division 01 Specification Sections, apply to this Section.

1.2 SUMMARY

- <u>A.</u> <u>Section Includes: Requirements including but not limited to:</u>
 - 1. Asbestos material abatement and disposal.
 - 2. Accessories necessary for complete removal.

1.3 SUBMITTAL

<u>A.</u> <u>Submit copy of the signed waste manifests indicating the place, time and exact quantity of asbestos, received by an approved landfill.</u>

1.4 QUALITY ASSURANCE

A. Qualifications: Entity having minimum 5 years documented experience, holding required current licenses for the removal, transport, and disposal and related activities relative to the work, having the required personal protective equipment and respirators for abatement operations, with current liability insurance, and who employs workers fully trained and knowledgeable in the removal of hazardous materials.

1.5 STOP ASBESTOS REMOVAL

- <u>A.</u> If a verbal or written Stop Asbestos Removal Order is given, immediately stop asbestos removal and maintain HEPA filtered negative pressure air flow in the containment and adequately wet any exposed ACM.
 - 1. Do not resume asbestos removal activity until authorized to do so in writing.
 - 2. <u>A stop asbestos removal order may be issued at any time it is determined that abatement</u> <u>conditions/activities are not within regulatory requirements or that an imminent hazard</u> <u>exists to human health or the environment.</u>
 - 3. <u>Work stoppage will continue until conditions have been corrected.</u>

PART 2 - MATERIALS

Not used.

PART 3 - EXECUTION

3.1 REMEDIATION

- A. <u>The Owner has conducted an asbestos survey and has determined that asbestos may be present</u> in areas where work will be performed. The survey is made available for review.
 - 1. <u>As part of the work, the Owner requires asbestos removal to be performed under the construction contract.</u>
 - 2. <u>Asbestos may be present in vinyl tile under architectural woodwork or covered by, but not</u> encapsulated, carpet materials and other types of flooring.
 - 3. Asbestos may be present in the ductwork above the ceiling panels.
 - 4. If asbestos is found, stop work in the area and engage an asbestos removal firm to remediate the asbestos from the area. Do not resume work in the affected areas until the

abatement is complete and authorization to proceed with work in the affected areas is given. Work in areas not affected by asbestos may continue.

- B. Assume responsibility and liability for compliance with applicable Federal, State, and Local regulations related to the asbestos abatement work.
 - 1. <u>Provide and maintain training, accreditations, medical exams, medical records, personal</u> protective equipment (PPE) including respiratory protection including respirator fit testing, as required by applicable Federal, State and Local regulations.
 - 2. <u>Post required notices prior to the commencement of the work.</u>
 - 3. Restrict access to containment areas to authorized, trained, and protected personnel.
 - 4. <u>Prepare and post an emergency plan in clean room and equipment room of the decontamination unit.</u>
 - 5. <u>Do not permit workers to eat, drink, smoke, chew gum or tobacco, or break the protection</u> of the respiratory protection system in the work area.
- <u>C.</u> <u>Entering and Existing Procedures:</u> <u>Establish procedures for entering and existing containment area.</u> Provide personnel decontainment unknit with disposable coveralls, head covers, and clean respirators. Provide shower room between personnel decontainment area and equipment room.
- <u>D.</u> <u>Decontamination Procedures: Establish procedures for decontamination upon leaving containment are in accordance with federal and state regulations.</u>
- E. <u>Provide negative pressure filtration systems to complete exchange air 4 time per hour.</u> Provide standby system in the event of a machine failure or emergency.
 - 1. <u>Continuously monitor and record the pressure differential between the work area and the building outside of the work area.</u>
- <u>F.</u> <u>Prepare the Affected Area: Remove furnishings and materials to the extent necessary to remediate the asbestos.</u>
- <u>G.</u> <u>Containment of Areas: Provide a secure containment work area in accordance with federal and state regulations. Avoid damage to existing partitions and ceilings scheduled to remain to the extent possible.</u>
 - 1. Establish critical barriers over each opening into the work area.
 - 2. Close out vents and air ducts to prevent particulates from entering the HVAC system.
- H. Debris: Place contaminated debris in a designated location within the containment area.
 - 1. <u>Place debris in minimum 6 mil poly bags before removing from contaminated areas. Pass</u> <u>Clean or decontaminate bags and pass and pass through a double 6 mil flap doorway into</u> <u>another bag or fiber drum. Remove to disposal dumpster/gondola/vehicle. Do not permit</u> <u>unprotected personnel to come in contact with contaminated bags.</u>
 - 2. <u>Remove and dispose of contaminated debris legally.</u>
- I. <u>Testing: Perform required tests and inspections upon completion of the work. Collect air samples</u> and analyze in accordance with regulations. Upon satisfactory conclusion of testing, remove critical barriers.
- J. <u>After thorough decontamination, complete asbestos abatement work upon meeting the regulated</u> <u>area clearance criteria and fulfilling the following:</u>
 - 1. Remove equipment, materials, and debris from the project area.
 - 2. Package and dispose asbestos waste as required.
 - 3. Repair or replace all interior finishes damaged during the abatement work.
 - 4. Fulfill other project closeout requirements as specified elsewhere in this specification.

3.2 CERTIFICATE OF COMPLETION BY CONTRACTOR

<u>A.</u> <u>Submit a signed Certificate of Completion at the completion of the abatement and decontamination of the regulated area.</u>

END OF SECTION 02 82 00

SECTION 08 71 00 - DOOR HARDWARE

PART 1 - GENERAL

1.1 <u>RELATED DOCUMENTS</u>

A. <u>Drawings and general provisions of the Contract, including General and Supplementary</u> <u>Conditions and Division 1 Specification Sections, apply to this Section.</u>

1.2 <u>SUMMARY</u>

- A. <u>This Section includes commercial door hardware for the following:</u>
 - 1. Swinging doors.
 - 2. Other doors to the extent indicated.
- B. <u>Door hardware includes, but is not necessarily limited to, the following:</u>
 - 1. <u>Mechanical door hardware.</u>
 - 2. <u>Electromechanical door hardware.</u>
 - 3. <u>Automatic operators.</u>
 - 4. Cylinders specified for doors in other sections.
- C. <u>Related Sections:</u>
 - 1. <u>Division 08 Section "Hollow Metal Doors and Frames".</u>
 - 2. Division 08 Section "Flush Wood Doors".
 - 3. Division 08 Section "Aluminum-Framed Entrances and Storefronts".
 - 4. Division 08 Section "Automatic Door Operators".
 - 5. Division 28 Section "Access Control Hardware Devices".
- D. <u>Codes and References: Comply with the version year adopted by the Authority Having</u> Jurisdiction.
 - 1. ANSI A117.1 Accessible and Usable Buildings and Facilities.
 - 2. ICC/IBC International Building Code.
 - 3. NFPA 70 National Electrical Code.
 - 4. NFPA 80 Fire Doors and Windows.
 - 5. NFPA 101 Life Safety Code.
 - 6. NFPA 105 Installation of Smoke Door Assemblies.
 - 7. <u>UL/ULC and CSA C22.2 Standards for Automatic Door Operators Used on Fire and</u> <u>Smoke Barrier Doors and Systems of Doors.</u>
 - 8. <u>State Building Codes, Local Amendments.</u>
- E. <u>Standards: All hardware specified herein shall comply with the following industry standards:</u>
 - 1. ANSI/BHMA Certified Product Standards A156 Series

2. <u>UL10C – Positive Pressure Fire Tests of Door Assemblies</u>

1.3 <u>SUBMITTALS</u>

- A. <u>Product Data: Manufacturer's product data sheets including installation details, material descriptions, dimensions of individual components and profiles, operational descriptions and finishes.</u>
- B. <u>Door Hardware Schedule: Prepared by or under the supervision of supplier, detailing fabrication</u> and assembly of door hardware, as well as procedures and diagrams. Coordinate the final Door Hardware Schedule with doors, frames, and related work to ensure proper size, thickness, hand, function, and finish of door hardware.
 - 1. Format: Comply with scheduling sequence and vertical format in DHI's "Sequence and Format for the Hardware Schedule."
 - 2. Organization: Organize the Door Hardware Schedule into door hardware sets indicating complete designations of every item required for each door or opening. Organize door hardware sets in same order as in the Door Hardware Sets at the end of Part 3. Submittals that do not follow the same format and order as the Door Hardware Sets will be rejected and subject to resubmission.
 - 3. <u>Content: Include the following information:</u>
 - a. <u>Type, style, function, size, label, hand, and finish of each door hardware item.</u>
 - b. Manufacturer of each item.
 - c. <u>Fastenings and other pertinent information.</u>
 - d. <u>Location of door hardware set, cross-referenced to Drawings, both on floor plans</u> and in door and frame schedule.
 - e. Explanation of abbreviations, symbols, and codes contained in schedule.
 - f. Mounting locations for door hardware.
 - g. Door and frame sizes and materials.
 - h. <u>Warranty information for each product.</u>
 - 4. <u>Submittal Sequence: Submit the final Door Hardware Schedule at earliest possible date,</u> particularly where approval of the Door Hardware Schedule must precede fabrication of other work that is critical in the Project construction schedule. Include Product Data, Samples, Shop Drawings of other work affected by door hardware, and other information essential to the coordinated review of the Door Hardware Schedule.
- C. <u>Shop Drawings: Details of electrified access control hardware indicating the following:</u>
 - 1. <u>Wiring Diagrams: Upon receipt of approved schedules, submit detailed system wiring diagrams for power, signaling, monitoring, communication, and control of the access control system electrified hardware. Differentiate between manufacturer-installed and field-installed wiring. Include the following:</u>
 - a. <u>Elevation diagram of each unique access controlled opening showing location and</u> <u>interconnection of major system components with respect to their placement in the</u> <u>respective door openings.</u>
 - b. <u>Complete (risers, point-to-point) access control system block wiring diagrams.</u>
 - c. <u>Wiring instructions for each electronic component scheduled herein.</u>

- 2. <u>Electrical Coordination: Coordinate with related sections the voltages and wiring details</u> required at electrically controlled and operated hardware openings.
- D. <u>Proof of Certification: Provide copy of manufacturer(s) official certification or accreditation</u> document indicating proof of status as a qualified and authorized provider of the primary Integrated Wiegand Access Control Products.
- E. Keying Schedule: After a keying meeting with the owner has taken place prepare a separate keying schedule detailing final instructions. Submit the keying schedule in electronic format. Include keying system explanation, door numbers, key set symbols, hardware set numbers and special instructions. Owner must approve submitted keying schedule prior to the ordering of permanent cylinders/cores.
- F. Informational Submittals:
 - 1. <u>Product Test Reports: Indicating compliance with cycle testing requirements, based on</u> <u>evaluation of comprehensive tests performed by manufacturer and witnessed by a</u> <u>qualified independent testing agency.</u>
- G. <u>Operating and Maintenance Manuals: Provide manufacturers operating and maintenance</u> <u>manuals for each item comprising the complete door hardware installation in quantity as</u> <u>required in Division 01, Closeout Procedures.</u>

1.4 QUALITY ASSURANCE

- A. <u>Manufacturers Qualifications: Engage qualified manufacturers with a minimum 5 years of documented experience in producing hardware and equipment similar to that indicated for this Project and that have a proven record of successful in-service performance.</u>
- B. <u>Installer Qualifications: A minimum 3 years documented experience installing both standard and electrified door hardware similar in material, design, and extent to that indicated for this Project and whose work has resulted in construction with a record of successful in-service performance.</u>
- C. Door Hardware Supplier Qualifications: Experienced commercial door hardware distributors with a minimum 5 years documented experience supplying both mechanical and electromechanical hardware installations comparable in material, design, and extent to that indicated for this Project. Supplier recognized as a factory direct distributor by the manufacturers of the primary materials with a warehousing facility in Project's vicinity. Supplier to have on staff a certified Architectural Hardware Consultant (AHC) available during the course of the Work to consult with Contractor, Architect, and Owner concerning both standard and electromechanical door hardware and keying.
- D. Integrated Wiegand, Wireless, and IP-Enabled Access Control Products Supplier Qualifications: Integrated access control products and accessories are required to be supplied and installed through current members of the ASSA ABLOY "Authorized Channel Partner" (ACP) and "Certified Integrator" (CI) programs. Suppliers are to be factory trained, certified prior to project bid, and a direct purchaser of the specified product. Installers are to be factory trained, certified prior to project bid, and are responsible for commissioning, servicing, and warranting the installed equipment specified for the project.
- E. <u>Source Limitations: Obtain each type and variety of door hardware specified in this section from</u> <u>a single source unless otherwise indicated.</u>

- 1. <u>Electrified modifications or enhancements made to a source manufacturer's product line</u> by a secondary or third party source will not be accepted.
- 2. <u>Provide electromechanical door hardware from the same manufacturer as mechanical door hardware, unless otherwise indicated.</u>
- F. Each unit to bear third party permanent label demonstrating compliance with the referenced standards.
- G. <u>Keying Conference: Conduct conference to comply with requirements in Division 01 Section</u> <u>"Project Meetings." Keying conference to incorporate the following criteria into the final keying</u> <u>schedule document:</u>
 - 1. Function of building, purpose of each area and degree of security required.
 - 2. <u>Plans for existing and future key system expansion.</u>
 - 3. <u>Requirements for key control storage and software.</u>
 - 4. Installation of permanent keys, cylinder cores and software.
 - 5. Address and requirements for delivery of keys.
- H. <u>Pre-Submittal Conference: Conduct coordination conference in compliance with requirements in</u> <u>Division 01 Section "Project Meetings" with attendance by representatives of Supplier(s),</u> <u>Installer(s), and Contractor(s) to review proper methods and the procedures for receiving,</u> <u>handling, and installing door hardware.</u>
 - 1. Prior to installation of door hardware, conduct a project specific training meeting to instruct the installing contractors' personnel on the proper installation and adjustment of their respective products. Product training to be attended by installers of door hardware (including electromechanical hardware) for aluminum, hollow metal and wood doors. Training will include the use of installation manuals, hardware schedules, templates and physical product samples as required.
 - 2. <u>Inspect and discuss electrical roughing-in, power supply connections, and other preparatory work performed by other trades.</u>
 - 3. <u>Review sequence of operation narratives for each unique access controlled opening.</u>
 - 4. <u>Review and finalize construction schedule and verify availability of materials.</u>
 - 5. <u>Review the required inspecting, testing, commissioning, and demonstration procedures</u>
- I. <u>At completion of installation, provide written documentation that components were applied to</u> <u>manufacturer's instructions and recommendations and according to approved schedule.</u>

1.5 DELIVERY, STORAGE, AND HANDLING

- A. <u>Inventory door hardware on receipt and provide secure lock-up and shelving for door hardware</u> <u>delivered to Project site. Do not store electronic access control hardware, software or</u> <u>accessories at Project site without prior authorization.</u>
- B. <u>Tag each item or package separately with identification related to the final Door Hardware</u> Schedule, and include basic installation instructions with each item or package.
- C. <u>Deliver, as applicable, permanent keys, cylinders, cores, access control credentials, software</u> and related accessories directly to Owner via registered mail or overnight package service. Instructions for delivery to the Owner shall be established at the "Keying Conference".

1.6 <u>COORDINATION</u>

- A. <u>Templates: Obtain and distribute to the parties involved templates for doors, frames, and other</u> work specified to be factory prepared for installing standard and electrified hardware. Check Shop Drawings of other work to confirm that adequate provisions are made for locating and installing hardware to comply with indicated requirements.
- B. <u>Door Hardware and Electrical Connections: Coordinate the layout and installation of scheduled</u> <u>electrified door hardware and related access control equipment with required connections to</u> <u>source power junction boxes, low voltage power supplies, detection and monitoring hardware,</u> <u>and fire and detection alarm systems.</u>
- C. <u>Door and Frame Preparation: Doors and corresponding frames are to be prepared, reinforced</u> and pre-wired (if applicable) to receive the installation of the specified electrified, monitoring, signaling and access control system hardware without additional in-field modifications.

1.7 <u>WARRANTY</u>

- A. <u>General Warranty: Reference Division 01, General Requirements. Special warranties specified</u> in this Article shall not deprive Owner of other rights Owner may have under other provisions of the Contract Documents and shall be in addition to, and run concurrent with, other warranties made by Contractor under requirements of the Contract Documents.
- B. <u>Warranty Period: Written warranty, executed by manufacturer(s), agreeing to repair or replace</u> <u>components of standard and electrified door hardware that fails in materials or workmanship</u> <u>within specified warranty period after final acceptance by the Owner. Failures include, but are</u> <u>not limited to, the following:</u>
 - 1. <u>Structural failures including excessive deflection, cracking, or breakage.</u>
 - 2. Faulty operation of the hardware.
 - 3. Deterioration of metals, metal finishes, and other materials beyond normal weathering.
 - 4. <u>Electrical component defects and failures within the systems operation.</u>
- C. <u>Standard Warranty Period: One year from date of Substantial Completion, unless otherwise</u> indicated.
- D. <u>Special Warranty Periods:</u>
 - 1. <u>Ten years for mortise locks and latches.</u>
 - 2. Five years for exit hardware.
 - 3. <u>Twenty five years for manual overhead door closer bodies.</u>
 - 4. Five years for motorized electric latch retraction exit devices.
 - 5. <u>Two years for electromechanical door hardware.</u>

1.8 MAINTENANCE SERVICE

A. <u>Maintenance Tools and Instructions: Furnish a complete set of specialized tools and</u> <u>maintenance instructions as needed for Owner's continued adjustment, maintenance, and</u> <u>removal and replacement of door hardware.</u>

PART 2 - PRODUCTS

2.1 SCHEDULED DOOR HARDWARE

- A. <u>General: Provide door hardware for each door to comply with requirements in Door Hardware</u> Sets and each referenced section that products are to be supplied under.
- B. <u>Designations: Requirements for quantity, item, size, finish or color, grade, function, and other</u> <u>distinctive qualities of each type of door hardware are indicated in the Door Hardware Sets at</u> <u>the end of Part 3. Products are identified by using door hardware designations, as follows:</u>
 - 1. <u>Named Manufacturer's Products: Product designation and manufacturer are listed for</u> each door hardware type required for the purpose of establishing requirements. <u>Manufacturers' names are abbreviated in the Door Hardware Schedule.</u>
- C. <u>Substitutions: Requests for substitution and product approval for inclusive mechanical and</u> <u>electromechanical door hardware in compliance with the specifications must be submitted in</u> <u>writing and in accordance with the procedures and time frames outlined in Division 01,</u> <u>Substitution Procedures. Approval of requests is at the discretion of the architect, owner, and</u> <u>their designated consultants.</u>

2.2 HANGING DEVICES

- A. <u>Hinges: ANSI/BHMA A156.1 certified butt hinges with number of hinge knuckles and other</u> options as specified in the Door Hardware Sets.
 - 1. Quantity: Provide the following hinge quantity:
 - a. <u>Two Hinges: For doors with heights up to 60 inches.</u>
 - b. <u>Three Hinges: For doors with heights 61 to 90 inches.</u>
 - c. Four Hinges: For doors with heights 91 to 120 inches.
 - d. <u>For doors with heights more than 120 inches, provide 4 hinges, plus 1 hinge for</u> <u>every 30 inches of door height greater than 120 inches.</u>
 - e. Four hinges at 4'0" wide doors
 - f. Four hinges at aluminum doors.
 - 2. <u>Hinge Size: Provide the following, unless otherwise indicated, with hinge widths sized for</u> <u>door thickness and clearances required:</u>
 - a. <u>Widths up to 3'0": 4-1/2" standard or heavy weight as specified.</u>
 - b. <u>Sizes from 3'1" to 4'0": 5" standard or heavy weight as specified.</u>
 - 3. <u>Hinge Weight and Base Material: Unless otherwise indicated, provide the following:</u>
 - a. <u>Exterior Doors: Heavy weight, non-ferrous, ball bearing or oil impregnated bearing</u> <u>hinges unless Hardware Sets indicate standard weight.</u>
 - b. Interior Doors: Standard weight, steel, ball bearing or oil impregnated bearing hinges unless Hardware Sets indicate heavy weight.
 - 4. <u>Hinge Options: Comply with the following:</u>
 - a. <u>Non-removable Pins: Provide set screw in hinge barrel that, when tightened into a groove in hinge pin, prevents removal of pin while door is closed; for the all out-swinging lockable doors.</u>

- 5. <u>Manufacturers:</u>
 - a. <u>McKinney Products; ASSA ABLOY Architectural Door Accessories (MK) TA</u> <u>Series.</u>

2.3 POWER TRANSFER DEVICES

- A. Concealed Quick Connect Electric Power Transfers: Provide concealed wiring pathway housing mortised into the door and frame for low voltage electrified door hardware. Furnish with Molex ™ standardized plug connectors and sufficient number of concealed wires (up to 12) to accommodate the electrified functions specified in the Door Hardware Sets. Connectors plug directly to through-door wiring harnesses for connection to electric locking devices and power supplies. Wire nut connections are not acceptable.
 - 1. Manufacturers:
 - a. <u>Securitron (SU) EL-CEPT Series.</u>
- B. Electric Door Wire Harnesses: Provide electric/data transfer wiring harnesses with standardized plug connectors to accommodate up to twelve (12) wires. Connectors plug directly to through-door wiring harnesses for connection to electric locking devices and power supplies. Provide sufficient number and type of concealed wires to accommodate electric function of specified hardware. Provide a connector for through-door electronic locking devices and from hinge to junction box above the opening. Wire nut connections are not acceptable. Determine the length required for each electrified hardware component for the door type, size and construction, minimum of two per electrified opening.
 - 1. <u>Provide one each of the following tools as part of the base bid contract:</u>
 - a. <u>McKinney Products; ASSA ABLOY Architectural Door Accessories (MK) -</u> <u>Electrical Connecting Kit: QC-R001.</u>
 - b. <u>McKinney Products</u>; <u>ASSA ABLOY Architectural Door Accessories (MK) -</u> <u>Connector Hand Tool: QC-R003.</u>
 - 2. <u>Manufacturers:</u>
 - a. <u>McKinney Products; ASSA ABLOY Architectural Door Accessories (MK) QC-C</u> <u>Series.</u>

2.4 DOOR OPERATING TRIM

- A. <u>Door Push Plates and Pulls: ANSI/BHMA A156.6 certified door pushes and pulls of type and design specified in the Hardware Sets. Coordinate and provide proper width and height as required where conflicting hardware dictates.</u>
 - 1. <u>Push/Pull Plates: Minimum .050 inch thick, size as indicated in hardware sets, with beveled edges, secured with exposed screws unless otherwise indicated.</u>
 - 2. <u>Door Pull and Push Bar Design: Size, shape, and material as indicated in the hardware sets. Minimum clearance of 2 1/2-inches from face of door unless otherwise indicated.</u>
 - 3. Offset Pull Design: Size, shape, and material as indicated in the hardware sets. Minimum clearance of 2 1/2-inches from face of door and offset of 90 degrees unless otherwise indicated.

- 4. <u>Fasteners: Provide manufacturer's designated fastener type as indicated in Hardware Sets.</u>
- 5. <u>Manufacturers:</u>
 - a. <u>Rockwood Products; ASSA ABLOY Architectural Door Accessories (RO).</u>

2.5 CYLINDERS AND KEYING

- A. <u>General: Cylinder manufacturer to have minimum (10) years experience designing secured</u> <u>master key systems and have on record a published security keying system policy.</u>
 - 1. Manufacturers:
 - a. Sargent Manufacturing (SA).
 - b. <u>No Substitution.</u>
- B. <u>Cylinders: Original manufacturer cylinders complying with the following:</u>
 - 1. Mortise Type: Threaded cylinders with rings and cams to suit hardware application.
 - 2. <u>Rim Type: Cylinders with back plate, flat-type vertical or horizontal tailpiece, and raised</u> trim ring.
 - 3. Bored-Lock Type: Cylinders with tailpieces to suit locks.
 - 4. <u>Mortise and rim cylinder collars to be solid and recessed to allow the cylinder face to be flush and be free spinning with matching finishes.</u>
 - 5. Keyway: Match Facility Standard.
 - 6. At integrated access control locks and exits, permanent cores to be provided by 087100.
- C. <u>Permanent Cores: Manufacturer's standard; finish face to match lockset; complying with the following:</u>
 - 1. <u>Interchangeable Cores: Core insert, removable by use of a special key; usable with other</u> <u>manufacturers' cylinders.</u>
- D. Keying System: Each type of lock and cylinders to be factory keyed.
 - 1. <u>Conduct specified "Keying Conference" to define and document keying system</u> <u>instructions and requirements.</u>
 - 2. <u>Furnish factory cut, nickel-silver large bow permanently inscribed with a visual key control</u> <u>number as directed by Owner.</u>
 - 3. Existing System: Field verify and key locks to match Owner's existing system.
- E. Key Quantity: Provide the following minimum number of keys:
 - 1. Change Keys per Cylinder: Three (3).
 - 2. <u>Master Keys (per Master Key Level/Group): Five (5).</u>
 - 3. Construction Keys (where required): Ten (10).
 - 4. Construction Control Keys (where required): Two (2).
 - 5. Permanent Control Keys (where required): Two (2).

- F. <u>Construction Keying: Provide temporary keyed construction cores.</u> Contractor is responsible for removing construction cores and installing permanent cores. Credit to be provided to the owner once the construction cores are removed.
- G. Key Registration List (Bitting List):
 - 1. <u>Provide keying transcript list to Owner's representative in the proper format for importing</u> into key control software.
 - 2. <u>Provide transcript list in writing or electronic file as directed by the Owner.</u>
- H. <u>Key Control Cabinet: Provide a key control system including envelopes, labels, and tags with self-locking key clips, receipt forms, 3-way visible card index, temporary markers, permanent markers, and standard metal cabinet. Key control cabinet shall have expansion capacity of 150% of the number of locks required for the project.</u>
 - 1. Manufacturers:
 - a. Lund Equipment (LU).
 - b. <u>MMF Industries (MM).</u>
 - C. <u>Telkee (TK).</u>
- I. <u>Key Control Software: Provide one network version of "Key Wizard" branded key management</u> software package that includes one year of technical support and upgrades to software at no charge. Provide factory key system formatted for importing into "Key Wizard" software.

2.6 <u>MECHANICAL LOCKS AND LATCHING DEVICES</u>

- A. <u>Mortise Locksets, Grade 1 (Heavy Duty): ANSI/BHMA A156.13, Series 1000, Operational</u> <u>Grade 1 certified. Locksets are to be manufactured with a corrosion resistant steel case and be</u> <u>field-reversible for handing without disassembly of the lock body.</u>
 - 1. <u>Manufacturers:</u>
 - a. Sargent Manufacturing (SA) 8200 Series.
 - b. <u>No Substitution.</u>

2.7 INTEGRATED WIRED OUTPUT LOCKING DEVICES – MULTI-CLASS READER

- A. Integrated Wired Output Multi-Class Mortise Locks: Wiegand or Open Supervised Device Protocol (OSDP) output ANSI A156.13, Grade 1, mortise lockset with integrated card reader with or without keypad option, request-to-exit signaling, door position status switch, and latchbolt monitoring in one complete unit. Hard wired, solenoid driven locking/unlocking control of the lever handle trim, 3/4" deadlocking anti-friction latch, and 1" case-hardened steel deadbolt. Lock is U.L listed and labeled for use on up to 3 hour fire rated openings. Available with or without keyed high security cylinder override.
 - 1. Open architecture, hard wired platform supports centralized control of locking units with new or existing Wiegand or OSDP compatible access control systems. Latchbolt monitoring and door position switch act in conjunction to report door-in-frame (DPS) and door latched (door closed and latched) conditions.
 - 2. Integrated reader supports the following credentials:
 - a. <u>125kHz proximity credentials: HID, AWID, Indala, and EM4102.</u>

- b. <u>13.56 MHz proximity credentials: HID Secure Identity Object™ (SIO) on iCLASS</u> Seos, HID iCLASS, HID iCLASS SE/SR, MIFARE Classic, DESFire EV1 and EV2.
- C. <u>2.4 GHz credentials: Secure Identity Object™ (SIO) on Mobile IDs (Bluetooth</u> <u>Smart)</u>
- d. <u>ISO14443A/B (PIV-compatible Transparent FASC-N read) available with</u> <u>pivCLASS variant</u>
- e. <u>NFC-enabled mobile phones</u>
- f. PIN code only or PIN + credential with keypad option.
- 3. <u>12VDC external power supply required for reader and lock, with optional 24VDC lock</u> solenoid. Fail safe or fail secure options.
- 4. <u>Energy Efficient Design: Provide lock bodies which have a holding current draw of 500mA maximum, and can operate on either 12 or 24 volts. Locks are to be field configurable for fail safe or fail secure operation.</u>
- 5. <u>Support end-of-line resistors contained within the lock case.</u>
- 6. <u>Installation requires only one cable run from the lock to the access control panel without</u> requirements for additional proprietary lock panel interface boards or modules.
- 7. <u>Installation to include manufacturer's access control panel interface board or module</u> where required for Wiegand or OSDP output protocol.
- 8. <u>Manufacturers:</u>
 - a. <u>Sargent Manufacturing (SA) SN200 8200 Series.</u>
 - b. <u>No Substitution.</u>

2.8 LOCK AND LATCH STRIKES

- A. <u>Strikes: Provide manufacturer's standard strike with strike box for each latch or lock bolt, with curved lip extended to protect frame, finished to match door hardware set, unless otherwise indicated, and as follows:</u>
 - 1. <u>Flat-Lip Strikes: For locks with three-piece antifriction latchbolts, as recommended by</u> <u>manufacturer.</u>
 - 2. Extra-Long-Lip Strikes: For locks used on frames with applied wood casing trim.
 - 3. <u>Aluminum-Frame Strike Box: Provide manufacturer's special strike box fabricated for aluminum framing.</u>
 - 4. <u>Double-lipped strikes: For locks at double acting doors. Furnish with retractable stop for</u> rescue hardware applications.
- B. <u>Standards: Comply with the following:</u>
 - 1. Strikes for Mortise Locks and Latches: BHMA A156.13.
 - 2. <u>Strikes for Bored Locks and Latches: BHMA A156.2.</u>
 - 3. <u>Strikes for Auxiliary Deadlocks: BHMA A156.36.</u>
 - 4. Dustproof Strikes: BHMA A156.16.

2.9 <u>CONVENTIONAL EXIT DEVICES</u>

- A. <u>General Requirements: All exit devices specified herein shall meet or exceed the following criteria:</u>
 - 1. <u>At doors not requiring a fire rating, provide devices complying with NFPA 101 and listed</u> and labeled for "Panic Hardware" according to UL305. Provide proper fasteners as

required by manufacturer including sex nuts and bolts at openings specified in the Hardware Sets.

- 2. Where exit devices are required on fire rated doors, provide devices complying with NFPA 80 and with UL labeling indicating "Fire Exit Hardware". Provide devices with the proper fasteners for installation as tested and listed by UL. Consult manufacturer's catalog and template book for specific requirements.
- 3. Except on fire rated doors, provide exit devices with hex key dogging device to hold the pushbar and latch in a retracted position. Provide optional keyed cylinder dogging on devices where specified in Hardware Sets.
- 4. Devices must fit flat against the door face with no gap that permits unauthorized dogging of the push bar. The addition of filler strips is required in any case where the door light extends behind the device as in a full glass configuration.
- 5. Energy Efficient Design: Provide lock bodies which have a holding current draw of 15mA maximum, and can operate on either 12 or 24 volts. Locks are to be field configurable for fail safe or fail secure operation.
- 6. <u>Motorized Electric Latch Retraction: Devices with an electric latch retraction feature must</u> use motors which have a maximum current draw of 600mA. Solenoid driven latch retraction is not acceptable.
- 7. <u>Lever Operating Trim: Where exit devices require lever trim, furnish manufacturer's heavy</u> <u>duty escutcheon trim with threaded studs for thru-bolts.</u>
 - a. <u>Lock Trim Design: As indicated in Hardware Sets, provide finishes and designs to</u> <u>match that of the specified locksets.</u>
 - b. <u>Where function of exit device requires a cylinder, provide a cylinder (Rim or</u> <u>Mortise) as specified in Hardware Sets.</u>
- 8. <u>Vertical Rod Exit Devices: Where surface or concealed vertical rod exit devices are used</u> <u>at interior openings, provide as less bottom rod (LBR) unless otherwise indicated.</u> <u>Provide dust proof strikes where thermal pins are required to project into the floor.</u>
- 9. <u>Narrow Stile Applications: At doors constructed with narrow stiles, or as specified in</u> <u>Hardware Sets, provide devices designed for maximum 2" wide stiles.</u>
- 10. Dummy Push Bar: Nonfunctioning push bar matching functional push bar.
- 11. Rail Sizing: Provide exit device rails factory sized for proper door width application.
- 12. <u>Through Bolt Installation: For exit devices and trim as indicated in Door Hardware Sets.</u>
- B. <u>Conventional Push Rail Exit Devices (Heavy Duty): ANSI/BHMA A156.3, Grade 1 certified panic</u> and fire exit hardware devices furnished in the functions specified in the Hardware Sets. Exit device latch to be stainless steel, pullman type, with deadlock feature.
 - 1. Manufacturers:
 - a. <u>Sargent Manufacturing (SA) 80 Series.</u>
 - b. <u>No Substitution.</u>

- C. <u>Tube Steel Removable Mullions: ANSI/BHMA A156.3 removable steel mullions with malleable-</u> iron top and bottom retainers and a primed paint finish.
 - 1. <u>Provide keyed removable feature where specified in the Hardware Sets.</u>
 - 2. <u>Provide stabilizers and mounting brackets as required.</u>
 - 3. <u>Provide electrical quick connection wiring options as specified in the hardware sets.</u>
 - 4. Manufacturers:
 - a. Sargent Manufacturing (SA) 980S Series.

2.10 INTEGRATED WIRED OUTPUT EXIT DEVICES - MULTI-CLASS READER

- A. Integrated Wired Output Multi-Class Exit Hardware: Wiegand output ANSI 156.3 Grade 1 rim, mortise, and vertical rod exit device hardware with integrated card reader with or without keypad option, latchbolt and touchbar monitoring, and request-to-exit signaling, in one complete unit. Hard wired, solenoid driven locking/unlocking control of the lever handle exit trim with 3/4" throw latch bolt. U.L listed and labeled for either panic or "fire exit hardware" for use on up to 3 hour fire rated openings. Available with or without keyed high security cylinder override.
 - 1. <u>Open architecture, hard wired platform supports centralized control of locking units with</u> <u>new or existing Wiegand or OSDP compatible access control systems. Inside push bar</u> <u>(request-to-exit) signaling and door position (open/closed status) monitoring (via</u> <u>separately connected DPS).</u>
 - 2. Integrated reader supports the following credentials:
 - a. <u>125kHz proximity credentials: HID, AWID, Indala, and EM4102.</u>
 - b. <u>13.56 MHz proximity credentials: HID Secure Identity Object™ (SIO) on iCLASS</u> Seos, HID iCLASS, HID iCLASS SE/SR, MIFARE Classic, DESFire EV1 and EV2.
 - C. <u>2.4 GHz credentials: Secure Identity Object™ (SIO) on Mobile IDs (Bluetooth</u> <u>Smart)</u>
 - d. <u>ISO14443A/B (PIV-compatible Transparent FASC-N read) available with</u> <u>pivCLASS variant</u>
 - e. <u>NFC-enabled mobile phones</u>
 - f. <u>PIN code only or PIN + credential with keypad option</u>
 - 3. <u>12VDC external power supply required for reader. 24VDC required for solenoid operated</u> <u>exit trim. Fail safe or fail secure options.</u>
 - 4. <u>Installation requires only one cable run from the exit hardware to the access control panel</u> without requirements for additional proprietary lock panel interface boards or modules.
 - 5. <u>Competitor Alternates Allowed Option: Installation to include manufacturer's access</u> <u>control panel interface board or module where required for Wiegand or OSDP output</u> <u>protocol.</u>
 - 6. <u>Manufacturers:</u>
 - a. <u>Sargent Manufacturing (SA) SN200 80 Series.</u>
 - b. <u>No Substitution.</u>

2.11 DOOR CLOSERS

- A. <u>All door closers specified herein shall meet or exceed the following criteria:</u>
 - 1. <u>General: Door closers to be from one manufacturer, matching in design and style, with the same type door preparations and templates regardless of application or spring size.</u> <u>Closers to be non-handed with full sized covers including installation and adjusting information on inside of cover.</u>
 - 2. <u>Standards: Closers to comply with UL-10C for Positive Pressure Fire Test and be U.L.</u> <u>listed for use of fire rated doors.</u>
 - 3. <u>Cycle Testing: Provide closers which have surpassed 15 million cycles in a test</u> witnessed and verified by UL.
 - 4. <u>Size of Units: Comply with manufacturer's written recommendations for sizing of door</u> <u>closers depending on size of door, exposure to weather, and anticipated frequency of</u> <u>use. Where closers are indicated for doors required to be accessible to the physically</u> <u>handicapped, provide units complying with ANSI ICC/A117.1.</u>
 - 5. <u>Closer Arms: Provide heavy duty, forged steel closer arms unless otherwise indicated in</u> <u>Hardware Sets.</u>
 - 6. <u>Closers shall not be installed on exterior or corridor side of doors; where possible install</u> <u>closers on door for optimum aesthetics.</u>
 - 7. <u>Closer Accessories: Provide door closer accessories including custom templates, special</u> <u>mounting brackets, spacers and drop plates as required for proper installation. Provide</u> <u>through-bolt and security type fasteners as specified in the hardware sets.</u>
- B. <u>Door Closers, Surface Mounted (Heavy Duty): ANSI/BHMA A156.4, Grade 1 surface mounted, heavy duty door closers with complete spring power adjustment, sizes 1 thru 6; and fully operational adjustable according to door size, frequency of use, and opening force. Closers to be rack and pinion type, one piece cast iron or aluminum alloy body construction, with adjustable backcheck and separate non-critical valves for closing sweep and latch speed control. Provide non-handed units standard.</u>
 - 1. <u>Manufacturers:</u>
 - a. <u>Sargent Manufacturing (SA) 351 Series.</u>
 - b. <u>No Substitution.</u>

2.12 ELECTROHYDRAULIC DOOR OPERATORS

- A. <u>General: Provide low energy operators of size recommended by manufacturer for door size,</u> weight, and movement; for condition of exposure; and for compliance with UL 325. Coordinate operator mechanisms with door operation, hinges, and activation devices.
 - 1. <u>Fire-Rated Doors: Provide door operators for fire-rated door assemblies that comply with</u> NFPA 80 for fire-rated door components and are listed and labeled by a qualified testing <u>agency.</u>

- B. <u>Standard: Certified ANSI/BHMA A156.19.</u>
- C. <u>Performance Requirements:</u>
 - 1. Opening Force if Power Fails: Not more than 15 lbf required to release a latch if provided, not more than 30 lbf required to manually set door in motion, and not more than 15 lbf required to fully open door.
 - 2. <u>Entrapment Protection: Not more than 15 lbf required to prevent stopped door from closing or opening.</u>
- D. <u>Configuration: Surface mounted or in-ground as required. Door operators to control single</u> <u>swinging and pair of swinging doors.</u>
- E. <u>Operation: Power opening and spring closing operation capable of meeting ANSI A117.1</u> accessibility guideline. Provide time delay for door to remain open before initiating closing cycle as required by ANSI/BHMA A156.19. When not in automatic mode, door operator to function as manual door closer with fully adjustable opening and closing forces, with or without electrical power.
- F. <u>Features: Operator units to have full feature adjustments for door opening and closing force and speed, backcheck, motor assist acceleration from 0 to 30 seconds, time delay, vestibule interface delay, obstruction recycle, and hold open time from 0 up to 30 seconds.</u>
- G. <u>Provide outputs and relays on board the operator to allow for coordination of exit device latch</u> retraction, electric strikes, magnetic locks, card readers, safety and motion sensors and <u>specified auxiliary contacts.</u>
- H. <u>Brackets and Reinforcements: Manufacturer's standard, fabricated from aluminum with</u> nonferrous shims for aligning system components.
- I. <u>Manufacturers: Subject to compliance with requirements, provide products by one of the following:</u>
 - 1. Norton Door Controls (NO) 6000 Series.

2.13 ARCHITECTURAL TRIM

- A. <u>Door Protective Trim</u>
 - 1. <u>General: Door protective trim units to be of type and design as specified below or in the Hardware Sets.</u>
 - Size: Fabricate protection plates (kick, armor, or mop) not more than 2" less than door width (LDW) on stop side of single doors and 1" LDW on stop side of pairs of doors, and not more than 1" less than door width on pull side. Coordinate and provide proper width and height as required where conflicting hardware dictates. Height to be as specified in the Hardware Sets.
 - 3. <u>Where plates are applied to fire rated doors with the top of the plate more than 16" above the bottom of the door, provide plates complying with NFPA 80. Consult manufacturer's catalog and template book for specific requirements for size and applications.</u>

- 4. <u>Protection Plates: ANSI/BHMA A156.6 certified protection plates (kick, armor, or mop),</u> <u>fabricated from the following:</u>
 - a. <u>Stainless Steel: 300 grade, 050-inch thick.</u>
- 5. <u>Options and fasteners: Provide manufacturer's designated fastener type as specified in</u> <u>the Hardware Sets. Provide countersunk screw holes.</u>
- 6. <u>Manufacturers:</u>
 - a. <u>Rockwood Products; ASSA ABLOY Architectural Door Accessories (RO).</u>

2.14 DOOR STOPS AND HOLDERS

- A. <u>General: Door stops and holders to be of type and design as specified below or in the Hardware</u> <u>Sets.</u>
- B. Door Stops and Bumpers: ANSI/BHMA A156.16, Grade 1 certified door stops and wall bumpers. Provide wall bumpers, either convex or concave types with anchorage as indicated, unless floor or other types of door stops are specified in Hardware Sets. Do not mount floor stops where they will impede traffic. Where floor or wall bumpers are not appropriate, provide overhead type stops and holders.
 - 1. Manufacturers:
 - a. <u>Rockwood Products; ASSA ABLOY Architectural Door Accessories (RO).</u>

2.15 ARCHITECTURAL SEALS

- A. <u>General: Thresholds, weatherstripping, and gasket seals to be of type and design as specified</u> <u>below or in the Hardware Sets. Provide continuous weatherstrip gasketing on exterior doors and</u> <u>provide smoke, light, or sound gasketing on interior doors where indicated. At exterior</u> <u>applications provide non-corrosive fasteners and elsewhere where indicated.</u>
- B. <u>Smoke Labeled Gasketing: Assemblies complying with NFPA 105 that are listed and labeled by</u> a testing and inspecting agency acceptable to authorities having jurisdiction, for smoke control ratings indicated, based on testing according to UL 1784.
 - 1. Provide smoke labeled perimeter gasketing at all smoke labeled openings.
- C. <u>Fire Labeled Gasketing: Assemblies complying with NFPA 80 that are listed and labeled by a testing and inspecting agency acceptable to authorities having jurisdiction, for fire ratings indicated, based on testing according to UL-10C.</u>
 - 1. <u>Provide intumescent seals as indicated to meet UL10C Standard for Positive Pressure</u> <u>Fire Tests of Door Assemblies, and NPFA 252, Standard Methods of Fire Tests of Door</u> <u>Assemblies.</u>
- D. <u>Sound-Rated Gasketing: Assemblies that are listed and labeled by a testing and inspecting agency, for sound ratings indicated.</u>

- E. <u>Replaceable Seal Strips: Provide only those units where resilient or flexible seal strips are easily</u> replaceable and readily available from stocks maintained by manufacturer.
- F. <u>Manufacturers:</u>
 - 1. Pemko Products; ASSA ABLOY Architectural Door Accessories (PE).

2.16 ELECTRONIC ACCESSORIES

- A. <u>Door Position Switches: Door position magnetic reed contact switches specifically designed for</u> <u>use in commercial door applications. On recessed models the contact and magnetic housing</u> <u>snap-lock into a 1" diameter hole. Surface mounted models include wide gap distance design</u> <u>complete with armored flex cabling. Provide SPDT, N/O switches with optional Rare Earth</u> <u>Magnet installation on steel doors with flush top channels.</u>
 - 1. Manufacturers:
 - a. <u>Securitron (SU) DPS Series.</u>
- B. <u>Power Supplies</u>
 - 1. By security contractor

2.17 FABRICATION

A. <u>Fasteners: Provide door hardware manufactured to comply with published templates generally</u> prepared for machine, wood, and sheet metal screws. Provide screws according to manufacturers recognized installation standards for application intended.

2.18 <u>FINISHES</u>

- A. <u>Standard: Designations used in the Hardware Sets and elsewhere indicate hardware finishes</u> complying with ANSI/BHMA A156.18, including coordination with traditional U.S. finishes indicated by certain manufacturers for their products.
- B. <u>Provide quality of finish, including thickness of plating or coating (if any), composition, hardness,</u> and other qualities complying with manufacturer's standards, but in no case less than specified by referenced standards for the applicable units of hardware
- C. <u>Protect mechanical finishes on exposed surfaces from damage by applying a strippable,</u> temporary protective covering before shipping.

PART 3 - EXECUTION

3.1 <u>EXAMINATION</u>

- A. Examine scheduled openings, with Installer present, for compliance with requirements for installation tolerances, labeled fire door assembly construction, wall and floor construction, and other conditions affecting performance.
- B. <u>Notify architect of any discrepancies or conflicts between the door schedule, door types,</u> <u>drawings and scheduled hardware.</u> Proceed only after such discrepancies or conflicts have <u>been resolved in writing.</u>

3.2 <u>PREPARATION</u>

- A. Hollow Metal Doors and Frames: Comply with ANSI/DHI A115 series.
- B. <u>Wood Doors: Comply with ANSI/DHI A115-W series.</u>
- C. Install each item of mechanical and electromechanical hardware and access control equipment to comply with manufacturer's written instructions and according to specifications.
 - 1. Installers are to be trained and certified by the manufacturer on the proper installation and adjustment of fire, life safety, and security products including: hanging devices; locking devices; closing devices; and seals.
 - 2. <u>All quick connection below the ceiling to be made by hardware installer at the time of installation.</u>
- D. <u>Mounting Heights: Mount door hardware units at heights indicated in following applicable publications, unless specifically indicated or required to comply with governing regulations:</u>
 - 1. <u>Standard Steel Doors and Frames: DHI's "Recommended Locations for Architectural</u> <u>Hardware for Standard Steel Doors and Frames."</u>
 - 2. <u>Wood Doors: DHI WDHS.3, "Recommended Locations for Architectural Hardware for</u> <u>Wood Flush Doors."</u>
 - 3. <u>Where indicated to comply with accessibility requirements, comply with ANSI A117.1</u> <u>"Accessibility Guidelines for Buildings and Facilities."</u>
 - 4. <u>Provide blocking in drywall partitions where wall stops or other wall mounted hardware is located.</u>
- E. Retrofitting: Install door hardware to comply with manufacturer's published templates and written instructions. Where cutting and fitting are required to install door hardware onto or into surfaces that are later to be painted or finished in another way, coordinate removal, storage, and reinstallation of surface protective trim units with finishing work specified in Division 9 Sections. Do not install surface-mounted items until finishes have been completed on substrates involved.
- F. <u>Thresholds: Set thresholds for exterior and acoustical doors in full bed of sealant complying with</u> requirements specified in Division 7 Section "Joint Sealants."
- G. <u>Storage: Provide a secure lock up for hardware delivered to the project but not yet installed.</u> <u>Control the handling and installation of hardware items so that the completion of the work will</u> <u>not be delayed by hardware losses before and after installation.</u>

3.3 FIELD QUALITY CONTROL

A. <u>Field Inspection (Punch-Out Report): Reference Division 01 Section "Closeout Procedures".</u> <u>Final inspect installed door hardware and state in report whether work complies with or deviates</u> <u>from specification requirements, including whether door hardware is properly installed,</u> <u>operating and adjusted.</u>

3.4 <u>ADJUSTING</u>

A. <u>Initial Adjustment: Adjust and check each operating item of door hardware and each door to</u> <u>ensure proper operation or function of every unit. Replace units that cannot be adjusted to</u> <u>operate as intended. Adjust door control devices to compensate for final operation of heating</u> <u>and ventilating equipment and to comply with referenced accessibility requirements.</u>

3.5 CLEANING AND PROTECTION

- A. <u>Protect all hardware stored on construction site in a covered and dry place. Protect exposed</u> hardware installed on doors during the construction phase. Install any and all hardware at the latest possible time frame.
- B. <u>Clean adjacent surfaces soiled by door hardware installation.</u>
- C. <u>Clean operating items as necessary to restore proper finish. Provide final protection and</u> <u>maintain conditions that ensure door hardware is without damage or deterioration at time of</u> <u>owner occupancy.</u>

3.6 DEMONSTRATION

A. <u>Instruct Owner's maintenance personnel to adjust, operate, and maintain mechanical and electromechanical door hardware.</u>

3.7 DOOR HARDWARE SETS

- A. The hardware sets represent the design intent and direction of the owner and architect. They are a guideline only and should not be considered a detailed hardware schedule. Discrepancies, conflicting hardware and missing items should be brought to the attention of the architect with corrections made prior to the bidding process. Omitted items not included in a hardware set should be scheduled with the appropriate additional hardware required for proper application and functionality.
 - 1. Quantities listed are for each pair of doors, or for each single door.
 - 2. <u>The supplier is responsible for handing and sizing all products.</u>
 - 3. <u>Where multiple options for a piece of hardware are given in a single line item, the supplier</u> shall provide the appropriate selection for the material and application.

- 4. <u>At existing openings with new hardware the supplier shall field inspect existing conditions</u> prior to the submittal stage to verify the specified hardware will work as required. Provide alternate solutions and proposals as needed.
- B. <u>Manufacturer's Abbreviations:</u>

1. MK - McKinney	
2. SA - SARGENT	
3. RO - Rockwood	
4. NO - Norton	
5. PE - Pemko	
6. OT - Other	
7. SU - Securitron	

Hardware Sets

<u>Set: 1.0</u> <u>Doors: 4132A, 4132B</u> Description: Exterior Alum Pair - NL x DT

$T/1 \wedge 3386 / 1 / 2'' \times / 1 / 2'' (NIPP)$	U\$32D	MK
<u>L9805</u>	0528	SA
16 TB 43 72 8804 862	US32D	SA
16 TB 43 72 8810 862	US32D	SA
72 980C1	US26D	SA
7P-7300B	US15	SA
TB 351 CPS brkt/spacer as req	EN	SA
351D as required	EN	SA
581-2	EN	SA
346C		PE
3452AV		PE
2005AT		PE
By door mfgr		OT
DPS-M-BK		SU
	16 TB 43 72 8810 862 72 980C1 7P-7300B TB 351 CPS brkt/spacer as req 351D as required 581-2 346C 3452AV 2005AT By door mfgr	L980S US28 16 TB 43 72 8804 862 US32D 16 TB 43 72 8810 862 US32D 72 980C1 US26D 7P-7300B US15 TB 351 CPS brkt/spacer as req EN 351D as required EN 581-2 EN 3452AV 2005AT By door mfgr EN

Notes: Confirm hardware compatibility with aluminum door manufacturer. Wide stile required.

Set: 2.0

Doors: 1127, 4149A, 4149B, 9100, A1026A Description: Exterior Alum Pair - Access Control

7 Hinge (heavy weight)	T4A3386 4 1/2" x 4 1/2" (NRP)	US32D	MK
1 Hinge, Full Mortise, Hvy Wt	T4A3386 QC* 4-1/2" x 4-1/2"	US32D	MK
1 Electric Power Transfer	EL-CEPT	630	SU

1 Removable Mullion	L980S	US28	SA
1 Rim Exit Device	TB 43 72 56-SN200-8804 862	US32D	SA
1 Rim Exit Device, Dummy	16 TB 43 55 8810 862	US32D	SA
1 Mullion Cylinder	72 980C1	US26D	SA
4 Small Format Inter Core	7P-7300B	US15	SA
2 Surface Closer	TB 351 CPS brkt/spacer as req	EN	SA
2 Drop Plate	351D as required	EN	SA
2 Kit	581-2	EN	SA
1 Rain Guard	346C		PE
2 Sweep	3452AV		PE
1 Lip Threshold	2005AT		PE
1 Perimeter Seal	By door mfgr		OT
3 Elec Cables - Exit to Hinge	QC-CxxxP		MK
2 Elec Cables - Hinge to Above	QC-C1500P		MK
1 Power	By Security		OT

Notes: Timer is by security contractor where required.

Doors are normally closed and secure. Presentation of valid credential will allow entry by pull. Upon loss of power, doors will remain secure. Free egress at all times. EL-CEPT on active leaf.

Confirm hardware compatibility with aluminum door manufacturer. Wide stile required.

Set: 3.0 Doors: 1126B, 4133B, 4133C Description: Exterior HM Pair - Exit

-			
6 Hinge (heavy weight)	T4A3386 4 1/2" x 4 1/2" (NRP)	US32D	MK
1 Removable Mullion	L980S	PC	SA
1 Rim Exit Device, Storeroom	16 TB 43 72 8804 862	US32D	SA
1 Rim Exit Device, Dummy	16 TB 43 72 8810 862	US32D	SA
1 Mullion Cylinder	72 980C1	US26D	SA
4 Small Format Inter Core	7P-7300B	US15	SA
2 Surface Closer	TB 351 CPS brkt/spacer as req	EN	SA
1 Astragal Set (2)	18041CNB		PE
1 Rain Guard	346C		PE
1 Perimeter Seal	2891APK		PE
2 Sweep	3452AV		PE
1 Lip Threshold	2005AT		PE

Notes: Confirm hardware compatibility with door manufacturer. Wide stile required.

Set: 4.0

Doors: 9110, 9121, 9122A, 9131 Description: Exterior Sgl Alum Exit - Access Control

4 Hinge (heavy weight)	T4A3386 4 1/2" x 4 1/2" (NRP)	US32D	MK
1 Electric Power Transfer	EL-CEPT	630	SU
1 Rim Exit Device	TB 43 72 56-SN200-8804 862	US32D	SA

1 Small Format Inter Core	7P-7300B	US15	SA
1 Surface Closer	TB 351 CPS brkt/spacer as req	EN	SA
1 Kit	581-2	EN	SA
1 Rain Guard	346C		PE
1 Sweep	3452AV		PE
1 Lip Threshold	2005AT		PE
1 Perimeter Seal	By door mfgr		OT
1 Elec Cables - Exit to Hinge	QC-CxxxP		MK
1 Elec Cables - Hinge to Above	QC-C1500P		MK
1 Position Switch	DPS-M-BK		SU
1 Power	By Security		OT

Notes: Timer is by security contractor where required.

Doors are normally closed and secure. Presentation of valid credential will allow entry by pull. Upon loss of power, doors will remain secure. Free egress at all times.

Confirm hardware compatibility with aluminum door manufacturer. Wide stile required.

Set: 5.0 Doors: 4146A Description: Exterior HM Exit

3 Hinge (heavy weight)	T4A3386 4 1/2" x 4 1/2" (NRP)	US32D	MK
1 Rim Exit Device, Storeroom	16 TB 43 72 8804 FSW	US32D	SA
2 Small Format Inter Core	7P-7300B	US15	SA
1 Surface Closer	TB 351 CPS brkt/spacer as req	EN	SA
1 Rain Guard	346C		PE
1 Perimeter Seal	2891APK		PE
1 Sweep	3452AV		PE
1 Lip Threshold	2005AT		PE
1 Position Switch	DPS-M-BK		SU

Set: 6.0

Doors: 4147, A129B Description: Exterior HM - Lock - DPS

3 Hinge (heavy weight)	T4A3386 4 1/2" x 4 1/2" (NRP)	US32D	MK
1 Storeroom/Closet Lock	72 8204 LNJ	US26D	SA
1 Small Format Inter Core	7P-7300B	US15	SA
1 Surface Closer	TB 351 CPS brkt/spacer as req	EN	SA
1 Rain Guard	346C		PE
1 Perimeter Seal	2891APK		PE
1 Sweep	3452AV		PE
1 Lip Threshold	2005AT		PE
1 Position Switch	DPS-M-BK		SU

Set: 7.0

Doors: 9101 Description: Vest Alum Sgl - Exit

4 Hinge (heavy weight)	T4A3786 4 1/2" x 4 1/2"	US26D	MK
1 Rim Exit Device, Storeroom	16 TB 43 72 8804 862	US32D	SA
2 Small Format Inter Core	7P-7300B	US15	SA
1 Surface Closer	TB 351 CPS brkt/spacer as req	EN	SA
1 Kit	581-2	EN	SA
1 Perimeter Seal	By door mfgr		OT

Notes: Buzzer if required is by security contractor.

Set: 8.0

_

Doors: A4100A

Description: Pair Alum - Corr / Gym / Cafeteria - MHO

T4A3786 4 1/2" x 4 1/2"	US26D	MK
L980S	US28	SA
16 TB 43 72 8813 ETJ	US32D	SA
72 980C1	US26D	SA
7P-7300B	US15	SA
TB 351 O / PS as req	EN	SA
581-2	EN	SA
990 Series	689	RF
By door mfgr		OT
	L980S 16 TB 43 72 8813 ETJ 72 980C1 7P-7300B TB 351 O / PS as req 581-2 990 Series	L980S US28 16 TB 43 72 8813 ETJ US32D 72 980C1 US26D 7P-7300B US15 TB 351 O / PS as req EN 581-2 EN 990 Series 689

Notes: Doors are held open. Upon loss of power or signal from fire control, doors will close and latch. Wiring is by others

Set: 10.0

Doors: 4139A Description: Pair Storage Closer

6 Hinge, Full Mortise	TA2714 4 1/2" x 4 1/2"	US26D	MK
1 Dust Proof Strike	570	US26D	RO
2 Flush Bolt	555 - 12"/72" A.F.F.	US26D	RO
1 Storeroom/Closet Lock	72 8204 LNJ	US26D	SA
1 Small Format Inter Core	7P-7300B	US15	SA
2 Door Closer	TB 351 O / PS as req	EN	SA
2 Silencer	608		RO

<u>-</u> .

Set: 12.0 Doors: 4133A, 4133D, 4146B Description: *Pair - Corr/Gym/Classroom

6 Hinge (heavy weight)	T4A3786 4 1/2" x 4 1/2"	US26D	MK
1 Removable Mullion	L980S	PC	SA
2 Rim Exit Device, Classroom	16 TB 43 72 8813 ETJ	US32D	SA
1 Mullion Cylinder	72 980C1	US26D	SA
5 Small Format Inter Core	7P-7300B	US15	SA

2 Surface Closer	TB 351 CPS brkt/spacer as req	EN	SA
1 Astragal Set (2)	18041CNB		PE
1 Perimeter Seal	S88BL		PE

Set: 13.0

_

Doors: 2810

Description: *Sgl - Corr/Gym - 4'

4 Hinge (heavy weight)	T4A3786 4 1/2" x 4 1/2"	US26D	MK
1 Rim Exit Device, Classroom	16 TB 43 72 8813 ETJ	US32D	SA
2 Small Format Inter Core	7P-7300B	US15	SA
1 Surface Closer	TB 351 CPS brkt/spacer as req	EN	SA
1 Perimeter Seal	S88BL		PE

Set: 14.0

Doors: A1015, A1021

Description: Pair - Corr/Gym/Classroom - MHO

6 Hinge (heavy weight)	T4A3786 4 1/2" x 4 1/2"	US26D	MK
1 Removable Mullion	L980S	PC	SA
2 Rim Exit Device, Classroom	16 TB 43 72 8813 ETJ	US32D	SA
1 Mullion Cylinder	72 980C1	US26D	SA
5 Small Format Inter Core	7P-7300B	US15	SA
2 Surface Closer	TB 351 CPS brkt/spacer as req	EN	SA
2 Electromagnetic Holder	990 Series	689	RF
1 Astragal Set (2)	18041CNB		PE
1 Perimeter Seal	<u>S88BL</u>		PE

Notes: Doors are held open. Upon loss of power or signal from fire control, doors will close and latch. Wiring is by others.

Set: 15.0

Doors: 1126A, 3132 Description: Pair Stair

6 Hinge (heavy weight)	T4A3786 4 1/2" x 4 1/2"	US26D	MK
1 Removable Mullion	12-L980	PC	SA
2 Rim Exit Device, Passage	12 TB 43 8815 ETJ	US32D	SA
1 Mullion Cylinder	72 980C1	US26D	SA
1 Small Format Inter Core	7P-7300B	US15	SA
2 Surface Closer	TB 351 CPS brkt/spacer as req	EN	SA
2 Perimeter Seal	S88BL		PE

Set: 17.0

Doors: 1116C, 1125B, 1129, 3115C, 9114, 9117, 9128, 9138, 2161A Description: Storage

3 Hinge, Full Mortise	TA2714 4 1/2" x 4 1/2"	US26D	MK
5 mige, i un mortise	1112/11/1/2 A 11/2	00200	1/111

1 Storeroom/Closet Lock	72 8204 LNJ	US26D	SA
1 Small Format Inter Core	7P-7300B	US15	SA
1 Door Stop	481	US26D	RO
3 Silencer	608		RO

-

Set: 19.0

Doors: 1120, 1213A, 3119, 3128, 4135, 4136, 4137, 4138, 9130 Description: Storage - Closer

3 Hinge, Full Mortise	TA2714 4 1/2" x 4 1/2"	US26D	MK
1 Storeroom/Closet Lock	72 8204 LNJ	US26D	SA
1 Small Format Inter Core	7P-7300B	US15	SA
1 Door Closer	TB 351 O / PS as req	EN	SA
1 Door Stop	481	US26D	RO
3 Silencer	608		RO

Set: 20.0

Doors: 4139B, 9101B Description: Storage - Closer - 4'

4 Hinge (heavy weight)	T4A3786 4 1/2" x 4 1/2"	US26D	MK
1 Storeroom/Closet Lock	72 8204 LNJ	US26D	SA
1 Small Format Inter Core	7P-7300B	US15	SA
1 Door Closer	TB 351 O	EN	SA
1 Door Stop	481	US26D	RO
3 Silencer	608		RO

-

Set: 22.0

Doors: 1043, 1113C, 3112C, 3127, 3130, 4134, 9118, 9119, 9120, 9124 Description: Storage - Closer - Gasket

3 Hinge, Full Mortise	TA2714 4 1/2" x 4 1/2"	US26D	MK
1 Storeroom/Closet Lock	72 8204 LNJ	US26D	SA
1 Small Format Inter Core	7P-7300B	US15	SA
1 Door Closer	TB 351 O / PS as req	EN	SA
1 Door Stop	481	US26D	RO
1 Perimeter Seal	S88BL		PE

Set: 24.0

Doors: 9116

Description: Storage -Dutch- OH Stop

4 Hinge, Full Mortise	TA2714 4 1/2" x 4 1/2"	US26D	MK
1 Dutch Door Bolt	630-4	US26D	RO
1 Storeroom/Closet Lock	72 8204 LNJ	US26D	SA
1 Small Format Inter Core	7P-7300B	US15	SA
1 Concealed Overhead Stop	690S	US26D	SA

1 Door Stop	481	US26D	RO
3 Silencer	608		RO

Set: 25.0

Doors: 1125A, 1125C, 1125D, 1125E, 1125F, 4143, 4144, 9105, 9108, 9109, 9112, 9113, 9133, 9135, 9136

Description: Office

3 Hinge, Full Mortise	TA2714 4 1/2" x 4 1/2"	US26D	MK
1 Office/Entry Lock	72 8205 LNJ	US26D	SA
1 Small Format Inter Core	7P-7300B	US15	SA
1 Door Stop	481	US26D	RO
3 Silencer	608		RO

Set: 26.0

Doors: 1115A, 1115B, 1117A, 1117B, 3114A, 3114B, 3116A, 3116B, 9115 Description: *Large Classroom / Media Typical- Exit

3 Hinge (heavy weight)	T4A3786 4 1/2" x 4 1/2"	US26D	MK
1 Rim Exit Device, Classroom	16 TB 43 72 8813 ETJ	US32D	SA
1 Small Format Inter Core	7P-7300B	US15	SA
1 Surface Closer	TB 351 CPS brkt/spacer as req	EN	SA
3 Silencer	608		RO

Set: 27.0

Doors: 9126, 9137 Description: Classroom

3 Hinge, Full Mortise	TA2714 4 1/2" x 4 1/2"	US26D	MK
1 Classroom Lock	72 8237 LNJ	US26D	SA
1 Small Format Inter Core	7P-7300B	US15	SA
1 Door Stop	481	US26D	RO
3 Silencer	608		RO

_

<u>Set: 29.0</u> Doors: 1114A, 1114B, 1121, 1122, 1123, 1124, 1125, 1128, 1164, 1214A, 1214B, 3113A, 3113B, 3121, 3122, 3123, 3124, 3126, 3213A, 3213B, 9102, 9103 Description: *Typical Classroom/ Corridor - Closer

3 Hinge, Full Mortise	TA2714 4 1/2" x 4 1/2"	US26D	MK
1 Classroom Lock	72 8237 LNJ	US26D	SA
1 Small Format Inter Core	7P-7300B	US15	SA
1 Door Closer	TB 351 O / PS as req	EN	SA
1 Door Stop	481	US26D	RO
3 Silencer	608		RO

Set: 32.0

Doors: 1213, 9111, 9122B

Description: Classroom - Closer

3 Hinge, Full Mortise	TA2714 4 1/2" x 4 1/2"	US26D	MK
1 Classroom Lock	72 8237 LNJ	US26D	SA
1 Small Format Inter Core	7P-7300B	US15	SA
1 Door Closer	TB 351 O	EN	SA
3 Silencer	608		RO

Set: 32.1

Doors: 2400H Description: Replace Lockset - Locker

1 Classroom Lock	72 8237 LNJ	US26D	SA
1 Small Format Inter Core	7P-7300B	US15	SA

Notes: Existing lock must be field verified prior to purchase. This set is for design intent only.

Set: 33.0

Doors: 9132 Description: Alum Office- Closer

4 Hinge, Full Mortise	TA2714 4 1/2" x 4 1/2"	US26D	MK
1 Classroom Lock	72 8237 LNJ	US26D	SA
1 Small Format Inter Core	7P-7300B	US15	SA
1 Door Closer	TB 351 O	EN	SA
1 Door Stop	481	US26D	RO
1 Perimeter Seal	By door mfgr		OT

Notes: Confirm hardware compatibility with aluminum door manufacturer. Wide stile required.

<u>Set: 36.0</u> <u>Doors: 1113A, 1113B, 1116A, 1116B, 3112A, 3112B, 3115A, 3115B</u> Description: Prep

3 Hinge, Full Mortise	TA2714 4 1/2" x 4 1/2"	US26D	MK
1 Classroom Lock	72 8237 LNJ	US26D	SA
1 Small Format Inter Core	7P-7300B	US15	SA
1 Door Stop	481	US26D	RO
3 Silencer	608		RO

⁻

_

Set: 38.0

Doors: 1118, 1119, 2815, 2841, 3117, 3118, 4141, 4142A2, 4142B2, 4143A, 4144A, 4145B, 4145C, 4148 <u>4148</u> Description: Shared Restroom/Locker / Dressing P/P

⁻

3 Hinge, Full Mortise	TA2714 4 1/2" x 4 1/2"	US26D	MK
1 Push Plate	70E	US32D	RO
1 Pull Plate	111x70C	US32D	RO
1 Door Closer	TB 351 O / PS as req	EN	SA
1 Door Stop	481	US26D	RO
1 Perimeter Seal	S88BL		PE

_

_

Doors: 4142A1, 4142B1, 4145A, 4145D Description: Locker - Closer - DB

) MK
) SA
SA
RO
RO
SA
PE

Set: 41.0 Doors: 9107, 9125, 9129 Description: Int Restroom / Admin area

3 Hinge, Full Mortise	TA2714 4 1/2" x 4 1/2"	US26D	MK
1 Privacy Set w/ Indicator	49 8265 LNJ	US26D	SA
1 Door Closer	TB 351 O / PS as req	EN	SA
1 Door Stop	481	US26D	RO
1 Perimeter Seal	S88BL		PE

Set: 42.0

Doors: 9106 Description: Class Restroom

3 Hinge, Full Mortise	TA2714 4 1/2" x 4 1/2"	US26D	MK
1 Privacy Set w/ Indicator	49 8265 LNJ	US26D	SA
1 Door Stop	481	US26D	RO
1 Perimeter Seal	S88BL		PE

Set: 43.0

-

Doors: 9127, 9134 Description: Isolation / Exam

3 Hinge, Full Mortise	TA2714 4 1/2" x 4 1/2"	US26D	MK
1 Passage Set	8215 LNJ	US26D	SA
1 Door Stop	481	US26D	RO
3 Silencer	608		RO

-

-

-

END OF SECTION 08 71 00

SECTION 08 71 00 - DOOR HARDWARE - ALTERNATE

PART 1 - GENERAL

1.1 RELATED DOCUMENTS

A. <u>Drawings and general provisions of the Contract, including General and Supplementary</u> <u>Conditions and Division 1 Specification Sections, apply to this Section.</u>

1.2 <u>SUMMARY</u>

- A. This Section includes commercial door hardware for the following:
 - 1. <u>Swinging doors.</u>
 - 2. <u>Other doors to the extent indicated.</u>
- B. <u>Door hardware includes, but is not necessarily limited to, the following:</u>
 - 1. <u>Mechanical door hardware.</u>
 - 2. <u>Electromechanical door hardware.</u>
 - 3. <u>Automatic operators.</u>
 - 4. Cylinders specified for doors in other sections.
- C. <u>Related Sections:</u>
 - 1. Division 08 Section "Hollow Metal Doors and Frames".
 - 2. Division 08 Section "Flush Wood Doors".
 - 3. Division 08 Section "Aluminum-Framed Entrances and Storefronts".
 - 4. Division 08 Section "Automatic Door Operators".
 - 5. Division 28 Section "Access Control Hardware Devices".
- D. <u>Codes and References: Comply with the version year adopted by the Authority Having</u> Jurisdiction.
 - 1. ANSI A117.1 Accessible and Usable Buildings and Facilities.
 - 2. <u>ICC/IBC International Building Code.</u>
 - 3. NFPA 70 National Electrical Code.
 - 4. NFPA 80 Fire Doors and Windows.
 - 5. NFPA 101 Life Safety Code.
 - 6. NFPA 105 Installation of Smoke Door Assemblies.
 - 7. <u>UL/ULC and CSA C22.2 Standards for Automatic Door Operators Used on Fire and</u> <u>Smoke Barrier Doors and Systems of Doors.</u>
 - 8. <u>State Building Codes, Local Amendments.</u>
- E. <u>Standards: All hardware specified herein shall comply with the following industry standards:</u>
 - 1. ANSI/BHMA Certified Product Standards A156 Series
 - 2. <u>UL10C Positive Pressure Fire Tests of Door Assemblies</u>

1.3 <u>SUBMITTALS</u>

- A. <u>Product Data: Manufacturer's product data sheets including installation details, material descriptions, dimensions of individual components and profiles, operational descriptions and finishes.</u>
- B. <u>Door Hardware Schedule: Prepared by or under the supervision of supplier, detailing fabrication</u> and assembly of door hardware, as well as procedures and diagrams. Coordinate the final Door Hardware Schedule with doors, frames, and related work to ensure proper size, thickness, hand, function, and finish of door hardware.
 - 1. Format: Comply with scheduling sequence and vertical format in DHI's "Sequence and Format for the Hardware Schedule."
 - 2. Organization: Organize the Door Hardware Schedule into door hardware sets indicating complete designations of every item required for each door or opening. Organize door hardware sets in same order as in the Door Hardware Sets at the end of Part 3. Submittals that do not follow the same format and order as the Door Hardware Sets will be rejected and subject to resubmission.
 - 3. <u>Content: Include the following information:</u>
 - a. <u>Type, style, function, size, label, hand, and finish of each door hardware item.</u>
 - b. Manufacturer of each item.
 - C. <u>Fastenings and other pertinent information.</u>
 - d. <u>Location of door hardware set, cross-referenced to Drawings, both on floor plans</u> and in door and frame schedule.
 - e. Explanation of abbreviations, symbols, and codes contained in schedule.
 - f. Mounting locations for door hardware.
 - g. Door and frame sizes and materials.
 - h. <u>Warranty information for each product.</u>
 - 4. <u>Submittal Sequence: Submit the final Door Hardware Schedule at earliest possible date,</u> particularly where approval of the Door Hardware Schedule must precede fabrication of other work that is critical in the Project construction schedule. Include Product Data, Samples, Shop Drawings of other work affected by door hardware, and other information essential to the coordinated review of the Door Hardware Schedule.
- C. <u>Shop Drawings: Details of electrified access control hardware indicating the following:</u>
 - 1. <u>Wiring Diagrams: Upon receipt of approved schedules, submit detailed system wiring diagrams for power, signaling, monitoring, communication, and control of the access control system electrified hardware. Differentiate between manufacturer-installed and field-installed wiring. Include the following:</u>
 - a. <u>Elevation diagram of each unique access controlled opening showing location and</u> <u>interconnection of major system components with respect to their placement in the</u> <u>respective door openings.</u>
 - b. <u>Complete (risers, point-to-point) access control system block wiring diagrams.</u>
 - c. <u>Wiring instructions for each electronic component scheduled herein.</u>
 - 2. <u>Electrical Coordination: Coordinate with related sections the voltages and wiring details</u> required at electrically controlled and operated hardware openings.

- D. <u>Proof of Certification: Provide copy of manufacturer(s) official certification or accreditation</u> document indicating proof of status as a qualified and authorized provider of the primary Integrated Wiegand Access Control Products.
- E. Keying Schedule: After a keying meeting with the owner has taken place prepare a separate keying schedule detailing final instructions. Submit the keying schedule in electronic format. Include keying system explanation, door numbers, key set symbols, hardware set numbers and special instructions. Owner must approve submitted keying schedule prior to the ordering of permanent cylinders/cores.
- F. Informational Submittals:
 - 1. <u>Product Test Reports: Indicating compliance with cycle testing requirements, based on</u> <u>evaluation of comprehensive tests performed by manufacturer and witnessed by a</u> <u>qualified independent testing agency.</u>
- G. <u>Operating and Maintenance Manuals: Provide manufacturers operating and maintenance</u> <u>manuals for each item comprising the complete door hardware installation in quantity as</u> <u>required in Division 01, Closeout Procedures.</u>

1.4 QUALITY ASSURANCE

- A. <u>Manufacturers Qualifications: Engage qualified manufacturers with a minimum 5 years of documented experience in producing hardware and equipment similar to that indicated for this Project and that have a proven record of successful in-service performance.</u>
- B. <u>Installer Qualifications: A minimum 3 years documented experience installing both standard and electrified door hardware similar in material, design, and extent to that indicated for this Project and whose work has resulted in construction with a record of successful in-service performance.</u>
- C. <u>Door Hardware Supplier Qualifications: Experienced commercial door hardware distributors with</u> <u>a minimum 5 years documented experience supplying both mechanical and electromechanical</u> <u>hardware installations comparable in material, design, and extent to that indicated for this</u> <u>Project. Supplier recognized as a factory direct distributor by the manufacturers of the primary</u> <u>materials with a warehousing facility in Project's vicinity. Supplier to have on staff a certified</u> <u>Architectural Hardware Consultant (AHC) available during the course of the Work to consult</u> <u>with Contractor, Architect, and Owner concerning both standard and electromechanical door</u> <u>hardware and keying.</u>
- D. Integrated Wiegand, Wireless, and IP-Enabled Access Control Products Supplier Qualifications: Integrated access control products and accessories are required to be supplied and installed through current members of the ASSA ABLOY "Authorized Channel Partner" (ACP) and "Certified Integrator" (CI) programs. Suppliers are to be factory trained, certified prior to project bid, and a direct purchaser of the specified product. Installers are to be factory trained, certified prior to project bid, and are responsible for commissioning, servicing, and warranting the installed equipment specified for the project.
- E. <u>Source Limitations: Obtain each type and variety of door hardware specified in this section from</u> <u>a single source unless otherwise indicated.</u>
 - 1. <u>Electrified modifications or enhancements made to a source manufacturer's product line</u> by a secondary or third party source will not be accepted.

- 2. <u>Provide electromechanical door hardware from the same manufacturer as mechanical door hardware, unless otherwise indicated.</u>
- F. Each unit to bear third party permanent label demonstrating compliance with the referenced standards.
- G. <u>Keying Conference: Conduct conference to comply with requirements in Division 01 Section</u> <u>"Project Meetings." Keying conference to incorporate the following criteria into the final keying</u> <u>schedule document:</u>
 - 1. Function of building, purpose of each area and degree of security required.
 - 2. Plans for existing and future key system expansion.
 - 3. Requirements for key control storage and software.
 - 4. Installation of permanent keys, cylinder cores and software.
 - 5. Address and requirements for delivery of keys.
- H. <u>Pre-Submittal Conference: Conduct coordination conference in compliance with requirements in</u> <u>Division 01 Section "Project Meetings" with attendance by representatives of Supplier(s),</u> <u>Installer(s), and Contractor(s) to review proper methods and the procedures for receiving,</u> <u>handling, and installing door hardware.</u>
 - 1. Prior to installation of door hardware, conduct a project specific training meeting to instruct the installing contractors' personnel on the proper installation and adjustment of their respective products. Product training to be attended by installers of door hardware (including electromechanical hardware) for aluminum, hollow metal and wood doors. Training will include the use of installation manuals, hardware schedules, templates and physical product samples as required.
 - 2. <u>Inspect and discuss electrical roughing-in, power supply connections, and other preparatory work performed by other trades.</u>
 - 3. Review sequence of operation narratives for each unique access controlled opening.
 - 4. <u>Review and finalize construction schedule and verify availability of materials.</u>
 - 5. Review the required inspecting, testing, commissioning, and demonstration procedures
- I. <u>At completion of installation, provide written documentation that components were applied to</u> <u>manufacturer's instructions and recommendations and according to approved schedule.</u>

1.5 DELIVERY, STORAGE, AND HANDLING

- A. <u>Inventory door hardware on receipt and provide secure lock-up and shelving for door hardware delivered to Project site. Do not store electronic access control hardware, software or accessories at Project site without prior authorization.</u>
- B. <u>Tag each item or package separately with identification related to the final Door Hardware</u> Schedule, and include basic installation instructions with each item or package.
- C. <u>Deliver, as applicable, permanent keys, cylinders, cores, access control credentials, software</u> and related accessories directly to Owner via registered mail or overnight package service. Instructions for delivery to the Owner shall be established at the "Keying Conference".

1.6 <u>COORDINATION</u>

- A. <u>Templates: Obtain and distribute to the parties involved templates for doors, frames, and other</u> work specified to be factory prepared for installing standard and electrified hardware. Check Shop Drawings of other work to confirm that adequate provisions are made for locating and installing hardware to comply with indicated requirements.
- B. <u>Door Hardware and Electrical Connections: Coordinate the layout and installation of scheduled</u> <u>electrified door hardware and related access control equipment with required connections to</u> <u>source power junction boxes, low voltage power supplies, detection and monitoring hardware,</u> <u>and fire and detection alarm systems.</u>
- C. <u>Door and Frame Preparation: Doors and corresponding frames are to be prepared, reinforced</u> and pre-wired (if applicable) to receive the installation of the specified electrified, monitoring, signaling and access control system hardware without additional in-field modifications.

1.7 <u>WARRANTY</u>

- A. <u>General Warranty: Reference Division 01, General Requirements. Special warranties specified</u> in this Article shall not deprive Owner of other rights Owner may have under other provisions of the Contract Documents and shall be in addition to, and run concurrent with, other warranties made by Contractor under requirements of the Contract Documents.
- B. <u>Warranty Period: Written warranty, executed by manufacturer(s), agreeing to repair or replace</u> <u>components of standard and electrified door hardware that fails in materials or workmanship</u> <u>within specified warranty period after final acceptance by the Owner. Failures include, but are</u> <u>not limited to, the following:</u>
 - 1. <u>Structural failures including excessive deflection, cracking, or breakage.</u>
 - 2. Faulty operation of the hardware.
 - 3. Deterioration of metals, metal finishes, and other materials beyond normal weathering.
 - 4. <u>Electrical component defects and failures within the systems operation.</u>
- C. <u>Standard Warranty Period: One year from date of Substantial Completion, unless otherwise</u> indicated.
- D. <u>Special Warranty Periods:</u>
 - 1. <u>Ten years for mortise locks and latches.</u>
 - 2. Five years for exit hardware.
 - 3. <u>Twenty five years for manual overhead door closer bodies.</u>
 - 4. Five years for motorized electric latch retraction exit devices.
 - 5. <u>Two years for electromechanical door hardware.</u>

1.8 MAINTENANCE SERVICE

A. <u>Maintenance Tools and Instructions: Furnish a complete set of specialized tools and</u> <u>maintenance instructions as needed for Owner's continued adjustment, maintenance, and</u> <u>removal and replacement of door hardware.</u>

PART 2 - PRODUCTS

2.1 SCHEDULED DOOR HARDWARE

- A. <u>General: Provide door hardware for each door to comply with requirements in Door Hardware</u> <u>Sets and each referenced section that products are to be supplied under.</u>
- B. <u>Designations: Requirements for quantity, item, size, finish or color, grade, function, and other</u> <u>distinctive qualities of each type of door hardware are indicated in the Door Hardware Sets at</u> <u>the end of Part 3. Products are identified by using door hardware designations, as follows:</u>
 - 1. <u>Named Manufacturer's Products: Product designation and manufacturer are listed for</u> each door hardware type required for the purpose of establishing requirements. <u>Manufacturers' names are abbreviated in the Door Hardware Schedule.</u>
- C. <u>Substitutions: Requests for substitution and product approval for inclusive mechanical and</u> <u>electromechanical door hardware in compliance with the specifications must be submitted in</u> <u>writing and in accordance with the procedures and time frames outlined in Division 01,</u> <u>Substitution Procedures. Approval of requests is at the discretion of the architect, owner, and</u> <u>their designated consultants.</u>

2.2 HANGING DEVICES

- A. <u>Hinges: ANSI/BHMA A156.1 certified butt hinges with number of hinge knuckles and other</u> options as specified in the Door Hardware Sets.
 - 1. Quantity: Provide the following hinge quantity:
 - a. <u>Two Hinges: For doors with heights up to 60 inches.</u>
 - b. <u>Three Hinges: For doors with heights 61 to 90 inches.</u>
 - c. Four Hinges: For doors with heights 91 to 120 inches.
 - d. <u>For doors with heights more than 120 inches, provide 4 hinges, plus 1 hinge for</u> <u>every 30 inches of door height greater than 120 inches.</u>
 - e. Four hinges at 4'0" wide doors
 - f. Four hinges at aluminum doors.
 - 2. <u>Hinge Size: Provide the following, unless otherwise indicated, with hinge widths sized for</u> <u>door thickness and clearances required:</u>
 - a. <u>Widths up to 3'0": 4-1/2" standard or heavy weight as specified.</u>
 - b. <u>Sizes from 3'1" to 4'0": 5" standard or heavy weight as specified.</u>
 - 3. <u>Hinge Weight and Base Material: Unless otherwise indicated, provide the following:</u>
 - a. <u>Exterior Doors: Heavy weight, non-ferrous, ball bearing or oil impregnated bearing</u> <u>hinges unless Hardware Sets indicate standard weight.</u>
 - b. Interior Doors: Standard weight, steel, ball bearing or oil impregnated bearing hinges unless Hardware Sets indicate heavy weight.
 - 4. <u>Hinge Options: Comply with the following:</u>
 - a. <u>Non-removable Pins: Provide set screw in hinge barrel that, when tightened into a groove in hinge pin, prevents removal of pin while door is closed; for the all out-swinging lockable doors.</u>

- 5. <u>Manufacturers:</u>
 - a. <u>McKinney Products; ASSA ABLOY Architectural Door Accessories (MK) TA</u> <u>Series.</u>

2.3 POWER TRANSFER DEVICES

- A. Concealed Quick Connect Electric Power Transfers: Provide concealed wiring pathway housing mortised into the door and frame for low voltage electrified door hardware. Furnish with Molex ™ standardized plug connectors and sufficient number of concealed wires (up to 12) to accommodate the electrified functions specified in the Door Hardware Sets. Connectors plug directly to through-door wiring harnesses for connection to electric locking devices and power supplies. Wire nut connections are not acceptable.
 - 1. Manufacturers:
 - a. <u>Securitron (SU) EL-CEPT Series.</u>
- B. Electric Door Wire Harnesses: Provide electric/data transfer wiring harnesses with standardized plug connectors to accommodate up to twelve (12) wires. Connectors plug directly to through-door wiring harnesses for connection to electric locking devices and power supplies. Provide sufficient number and type of concealed wires to accommodate electric function of specified hardware. Provide a connector for through-door electronic locking devices and from hinge to junction box above the opening. Wire nut connections are not acceptable. Determine the length required for each electrified hardware component for the door type, size and construction, minimum of two per electrified opening.
 - 1. <u>Provide one each of the following tools as part of the base bid contract:</u>
 - a. <u>McKinney Products; ASSA ABLOY Architectural Door Accessories (MK) -</u> <u>Electrical Connecting Kit: QC-R001.</u>
 - b. <u>McKinney Products</u>; <u>ASSA ABLOY Architectural Door Accessories (MK) -</u> <u>Connector Hand Tool: QC-R003.</u>
 - 2. Manufacturers:
 - a. <u>McKinney Products; ASSA ABLOY Architectural Door Accessories (MK) QC-C</u> <u>Series.</u>

2.4 DOOR OPERATING TRIM

- A. <u>Door Push Plates and Pulls: ANSI/BHMA A156.6 certified door pushes and pulls of type and design specified in the Hardware Sets. Coordinate and provide proper width and height as required where conflicting hardware dictates.</u>
 - 1. <u>Push/Pull Plates: Minimum .050 inch thick, size as indicated in hardware sets, with beveled edges, secured with exposed screws unless otherwise indicated.</u>
 - 2. <u>Door Pull and Push Bar Design: Size, shape, and material as indicated in the hardware</u> sets. Minimum clearance of 2 1/2-inches from face of door unless otherwise indicated.
 - 3. <u>Offset Pull Design: Size, shape, and material as indicated in the hardware sets. Minimum clearance of 2 1/2-inches from face of door and offset of 90 degrees unless otherwise indicated.</u>

- 4. <u>Fasteners: Provide manufacturer's designated fastener type as indicated in Hardware Sets.</u>
- 5. <u>Manufacturers:</u>
 - a. <u>Rockwood Products; ASSA ABLOY Architectural Door Accessories (RO).</u>

2.5 CYLINDERS AND KEYING

- A. <u>General: Cylinder manufacturer to have minimum (10) years experience designing secured</u> <u>master key systems and have on record a published security keying system policy.</u>
 - 1. Manufacturers:
 - a. Sargent Manufacturing (SA).
 - b. <u>No Substitution.</u>
- B. <u>Cylinders: Original manufacturer cylinders complying with the following:</u>
 - 1. Mortise Type: Threaded cylinders with rings and cams to suit hardware application.
 - 2. <u>Rim Type: Cylinders with back plate, flat-type vertical or horizontal tailpiece, and raised</u> trim ring.
 - 3. Bored-Lock Type: Cylinders with tailpieces to suit locks.
 - 4. <u>Mortise and rim cylinder collars to be solid and recessed to allow the cylinder face to be</u> <u>flush and be free spinning with matching finishes.</u>
 - 5. Keyway: Match Facility Standard.
 - 6. At integrated access control locks and exits, permanent cores to be provided by 087100.
- C. <u>Permanent Cores: Manufacturer's standard; finish face to match lockset; complying with the following:</u>
 - 1. <u>Interchangeable Cores: Core insert, removable by use of a special key; usable with other</u> <u>manufacturers' cylinders.</u>
- D. Keying System: Each type of lock and cylinders to be factory keyed.
 - 1. <u>Conduct specified "Keying Conference" to define and document keying system</u> <u>instructions and requirements.</u>
 - 2. <u>Furnish factory cut, nickel-silver large bow permanently inscribed with a visual key control</u> <u>number as directed by Owner.</u>
 - 3. Existing System: Field verify and key locks to match Owner's existing system.
- E. Key Quantity: Provide the following minimum number of keys:
 - 1. Change Keys per Cylinder: Three (3).
 - 2. <u>Master Keys (per Master Key Level/Group): Five (5).</u>
 - 3. Construction Keys (where required): Ten (10).
 - 4. Construction Control Keys (where required): Two (2).
 - 5. <u>Permanent Control Keys (where required): Two (2).</u>

- F. <u>Construction Keying: Provide temporary keyed construction cores.</u> Contractor is responsible for removing construction cores and installing permanent cores. Credit to be provided to the owner once the construction cores are removed.
- G. Key Registration List (Bitting List):
 - 1. <u>Provide keying transcript list to Owner's representative in the proper format for importing</u> into key control software.
 - 2. Provide transcript list in writing or electronic file as directed by the Owner.
- H. <u>Key Control Cabinet: Provide a key control system including envelopes, labels, and tags with self-locking key clips, receipt forms, 3-way visible card index, temporary markers, permanent markers, and standard metal cabinet. Key control cabinet shall have expansion capacity of 150% of the number of locks required for the project.</u>
 - 1. Manufacturers:
 - a. Lund Equipment (LU).
 - b. <u>MMF Industries (MM).</u>
 - C. <u>Telkee (TK).</u>
- I. <u>Key Control Software: Provide one network version of "Key Wizard" branded key management</u> software package that includes one year of technical support and upgrades to software at no charge. Provide factory key system formatted for importing into "Key Wizard" software.

2.6 MECHANICAL LOCKS AND LATCHING DEVICES

- A. <u>Mortise Locksets, Grade 1 (Heavy Duty): ANSI/BHMA A156.13, Series 1000, Operational</u> <u>Grade 1 certified. Locksets are to be manufactured with a corrosion resistant steel case and be</u> <u>field-reversible for handing without disassembly of the lock body.</u>
 - 1. <u>Manufacturers:</u>
 - a. Sargent Manufacturing (SA) 8200 Series.
 - b. <u>No Substitution.</u>

2.7 INTEGRATED WIRED OUTPUT LOCKING DEVICES – MULTI-CLASS READER

- A. Integrated Wired Output Multi-Class Mortise Locks: Wiegand or Open Supervised Device Protocol (OSDP) output ANSI A156.13, Grade 1, mortise lockset with integrated card reader with or without keypad option, request-to-exit signaling, door position status switch, and latchbolt monitoring in one complete unit. Hard wired, solenoid driven locking/unlocking control of the lever handle trim, 3/4" deadlocking anti-friction latch, and 1" case-hardened steel deadbolt. Lock is U.L listed and labeled for use on up to 3 hour fire rated openings. Available with or without keyed high security cylinder override.
 - 1. Open architecture, hard wired platform supports centralized control of locking units with new or existing Wiegand or OSDP compatible access control systems. Latchbolt monitoring and door position switch act in conjunction to report door-in-frame (DPS) and door latched (door closed and latched) conditions.
 - 2. Integrated reader supports the following credentials:
 - a. <u>125kHz proximity credentials: HID, AWID, Indala, and EM4102.</u>

- b. <u>13.56 MHz proximity credentials: HID Secure Identity Object™ (SIO) on iCLASS</u> Seos, HID iCLASS, HID iCLASS SE/SR, MIFARE Classic, DESFire EV1 and EV2.
- C. <u>2.4 GHz credentials: Secure Identity Object™ (SIO) on Mobile IDs (Bluetooth</u> <u>Smart)</u>
- d. <u>ISO14443A/B (PIV-compatible Transparent FASC-N read) available with</u> <u>pivCLASS variant</u>
- e. <u>NFC-enabled mobile phones</u>
- f. PIN code only or PIN + credential with keypad option.
- 3. <u>12VDC external power supply required for reader and lock, with optional 24VDC lock</u> solenoid. Fail safe or fail secure options.
- 4. <u>Energy Efficient Design: Provide lock bodies which have a holding current draw of 500mA maximum, and can operate on either 12 or 24 volts. Locks are to be field configurable for fail safe or fail secure operation.</u>
- 5. <u>Support end-of-line resistors contained within the lock case.</u>
- 6. <u>Installation requires only one cable run from the lock to the access control panel without</u> requirements for additional proprietary lock panel interface boards or modules.
- 7. <u>Installation to include manufacturer's access control panel interface board or module</u> where required for Wiegand or OSDP output protocol.
- 8. <u>Manufacturers:</u>
 - a. <u>Sargent Manufacturing (SA) SN200 8200 Series.</u>
 - b. <u>No Substitution.</u>

2.8 LOCK AND LATCH STRIKES

- A. <u>Strikes: Provide manufacturer's standard strike with strike box for each latch or lock bolt, with curved lip extended to protect frame, finished to match door hardware set, unless otherwise indicated, and as follows:</u>
 - 1. <u>Flat-Lip Strikes: For locks with three-piece antifriction latchbolts, as recommended by</u> manufacturer.
 - 2. Extra-Long-Lip Strikes: For locks used on frames with applied wood casing trim.
 - 3. <u>Aluminum-Frame Strike Box: Provide manufacturer's special strike box fabricated for aluminum framing.</u>
 - 4. <u>Double-lipped strikes: For locks at double acting doors. Furnish with retractable stop for</u> rescue hardware applications.
- B. <u>Standards: Comply with the following:</u>
 - 1. Strikes for Mortise Locks and Latches: BHMA A156.13.
 - 2. <u>Strikes for Bored Locks and Latches: BHMA A156.2.</u>
 - 3. <u>Strikes for Auxiliary Deadlocks: BHMA A156.36.</u>
 - 4. Dustproof Strikes: BHMA A156.16.

2.9 CONVENTIONAL EXIT DEVICES

- A. <u>General Requirements: All exit devices specified herein shall meet or exceed the following criteria:</u>
 - 1. <u>At doors not requiring a fire rating, provide devices complying with NFPA 101 and listed</u> and labeled for "Panic Hardware" according to UL305. Provide proper fasteners as

required by manufacturer including sex nuts and bolts at openings specified in the Hardware Sets.

- 2. Where exit devices are required on fire rated doors, provide devices complying with NFPA 80 and with UL labeling indicating "Fire Exit Hardware". Provide devices with the proper fasteners for installation as tested and listed by UL. Consult manufacturer's catalog and template book for specific requirements.
- 3. Except on fire rated doors, provide exit devices with hex key dogging device to hold the pushbar and latch in a retracted position. Provide optional keyed cylinder dogging on devices where specified in Hardware Sets.
- 4. Devices must fit flat against the door face with no gap that permits unauthorized dogging of the push bar. The addition of filler strips is required in any case where the door light extends behind the device as in a full glass configuration.
- 5. Energy Efficient Design: Provide lock bodies which have a holding current draw of 15mA maximum, and can operate on either 12 or 24 volts. Locks are to be field configurable for fail safe or fail secure operation.
- 6. <u>Motorized Electric Latch Retraction: Devices with an electric latch retraction feature must</u> use motors which have a maximum current draw of 600mA. Solenoid driven latch retraction is not acceptable.
- 7. <u>Lever Operating Trim: Where exit devices require lever trim, furnish manufacturer's heavy</u> <u>duty escutcheon trim with threaded studs for thru-bolts.</u>
 - a. <u>Lock Trim Design: As indicated in Hardware Sets, provide finishes and designs to</u> <u>match that of the specified locksets.</u>
 - b. <u>Where function of exit device requires a cylinder, provide a cylinder (Rim or</u> <u>Mortise) as specified in Hardware Sets.</u>
- 8. <u>Vertical Rod Exit Devices: Where surface or concealed vertical rod exit devices are used</u> <u>at interior openings, provide as less bottom rod (LBR) unless otherwise indicated.</u> <u>Provide dust proof strikes where thermal pins are required to project into the floor.</u>
- 9. <u>Narrow Stile Applications: At doors constructed with narrow stiles, or as specified in</u> <u>Hardware Sets, provide devices designed for maximum 2" wide stiles.</u>
- 10. Dummy Push Bar: Nonfunctioning push bar matching functional push bar.
- 11. Rail Sizing: Provide exit device rails factory sized for proper door width application.
- 12. <u>Through Bolt Installation: For exit devices and trim as indicated in Door Hardware Sets.</u>
- B. <u>Conventional Push Rail Exit Devices (Heavy Duty): ANSI/BHMA A156.3, Grade 1 certified panic</u> and fire exit hardware devices furnished in the functions specified in the Hardware Sets. Exit device latch to be stainless steel, pullman type, with deadlock feature.
 - 1. Manufacturers:
 - a. <u>Sargent Manufacturing (SA) 80 Series.</u>
 - b. <u>No Substitution.</u>

- C. <u>Tube Steel Removable Mullions: ANSI/BHMA A156.3 removable steel mullions with malleable-</u> iron top and bottom retainers and a primed paint finish.
 - 1. <u>Provide keyed removable feature where specified in the Hardware Sets.</u>
 - 2. <u>Provide stabilizers and mounting brackets as required.</u>
 - 3. <u>Provide electrical quick connection wiring options as specified in the hardware sets.</u>
 - 4. Manufacturers:
 - a. Sargent Manufacturing (SA) 980S Series.

2.10 INTEGRATED WIRED OUTPUT EXIT DEVICES - MULTI-CLASS READER

- A. Integrated Wired Output Multi-Class Exit Hardware: Wiegand output ANSI 156.3 Grade 1 rim, mortise, and vertical rod exit device hardware with integrated card reader with or without keypad option, latchbolt and touchbar monitoring, and request-to-exit signaling, in one complete unit. Hard wired, solenoid driven locking/unlocking control of the lever handle exit trim with 3/4" throw latch bolt. U.L listed and labeled for either panic or "fire exit hardware" for use on up to 3 hour fire rated openings. Available with or without keyed high security cylinder override.
 - 1. <u>Open architecture, hard wired platform supports centralized control of locking units with</u> <u>new or existing Wiegand or OSDP compatible access control systems. Inside push bar</u> <u>(request-to-exit) signaling and door position (open/closed status) monitoring (via</u> <u>separately connected DPS).</u>
 - 2. Integrated reader supports the following credentials:
 - a. <u>125kHz proximity credentials: HID, AWID, Indala, and EM4102.</u>
 - b. <u>13.56 MHz proximity credentials: HID Secure Identity Object™ (SIO) on iCLASS</u> Seos, HID iCLASS, HID iCLASS SE/SR, MIFARE Classic, DESFire EV1 and EV2.
 - C. <u>2.4 GHz credentials: Secure Identity Object™ (SIO) on Mobile IDs (Bluetooth</u> <u>Smart)</u>
 - d. <u>ISO14443A/B (PIV-compatible Transparent FASC-N read) available with</u> <u>pivCLASS variant</u>
 - e. <u>NFC-enabled mobile phones</u>
 - f. <u>PIN code only or PIN + credential with keypad option</u>
 - 3. <u>12VDC external power supply required for reader. 24VDC required for solenoid operated</u> <u>exit trim. Fail safe or fail secure options.</u>
 - 4. <u>Installation requires only one cable run from the exit hardware to the access control panel</u> without requirements for additional proprietary lock panel interface boards or modules.
 - 5. <u>Competitor Alternates Allowed Option: Installation to include manufacturer's access</u> <u>control panel interface board or module where required for Wiegand or OSDP output</u> <u>protocol.</u>
 - 6. <u>Manufacturers:</u>
 - a. <u>Sargent Manufacturing (SA) SN200 80 Series.</u>
 - b. <u>No Substitution.</u>

2.11 DOOR CLOSERS

- A. <u>All door closers specified herein shall meet or exceed the following criteria:</u>
 - 1. <u>General: Door closers to be from one manufacturer, matching in design and style, with the same type door preparations and templates regardless of application or spring size.</u> <u>Closers to be non-handed with full sized covers including installation and adjusting information on inside of cover.</u>
 - 2. <u>Standards: Closers to comply with UL-10C for Positive Pressure Fire Test and be U.L.</u> <u>listed for use of fire rated doors.</u>
 - 3. <u>Cycle Testing: Provide closers which have surpassed 15 million cycles in a test</u> witnessed and verified by UL.
 - 4. <u>Size of Units: Comply with manufacturer's written recommendations for sizing of door</u> <u>closers depending on size of door, exposure to weather, and anticipated frequency of</u> <u>use. Where closers are indicated for doors required to be accessible to the physically</u> <u>handicapped, provide units complying with ANSI ICC/A117.1.</u>
 - 5. <u>Closer Arms: Provide heavy duty, forged steel closer arms unless otherwise indicated in</u> <u>Hardware Sets.</u>
 - 6. <u>Closers shall not be installed on exterior or corridor side of doors; where possible install</u> <u>closers on door for optimum aesthetics.</u>
 - 7. <u>Closer Accessories: Provide door closer accessories including custom templates, special</u> <u>mounting brackets, spacers and drop plates as required for proper installation. Provide</u> <u>through-bolt and security type fasteners as specified in the hardware sets.</u>
- B. <u>Door Closers, Surface Mounted (Heavy Duty): ANSI/BHMA A156.4, Grade 1 surface mounted,</u> heavy duty door closers with complete spring power adjustment, sizes 1 thru 6; and fully operational adjustable according to door size, frequency of use, and opening force. Closers to be rack and pinion type, one piece cast iron or aluminum alloy body construction, with adjustable backcheck and separate non-critical valves for closing sweep and latch speed control. Provide non-handed units standard.
 - 1. Manufacturers:
 - a. <u>Sargent Manufacturing (SA) 351 Series.</u>
 - b. <u>No Substitution.</u>

2.12 ELECTROHYDRAULIC DOOR OPERATORS

- A. <u>General: Provide low energy operators of size recommended by manufacturer for door size,</u> weight, and movement; for condition of exposure; and for compliance with UL 325. Coordinate operator mechanisms with door operation, hinges, and activation devices.
 - 1. <u>Fire-Rated Doors: Provide door operators for fire-rated door assemblies that comply with</u> NFPA 80 for fire-rated door components and are listed and labeled by a qualified testing <u>agency.</u>

- B. <u>Standard: Certified ANSI/BHMA A156.19.</u>
- C. <u>Performance Requirements:</u>
 - 1. Opening Force if Power Fails: Not more than 15 lbf required to release a latch if provided, not more than 30 lbf required to manually set door in motion, and not more than 15 lbf required to fully open door.
 - 2. <u>Entrapment Protection: Not more than 15 lbf required to prevent stopped door from closing or opening.</u>
- D. <u>Configuration: Surface mounted or in-ground as required. Door operators to control single</u> <u>swinging and pair of swinging doors.</u>
- E. <u>Operation: Power opening and spring closing operation capable of meeting ANSI A117.1</u> accessibility guideline. Provide time delay for door to remain open before initiating closing cycle as required by ANSI/BHMA A156.19. When not in automatic mode, door operator to function as manual door closer with fully adjustable opening and closing forces, with or without electrical power.
- F. <u>Features: Operator units to have full feature adjustments for door opening and closing force and speed, backcheck, motor assist acceleration from 0 to 30 seconds, time delay, vestibule interface delay, obstruction recycle, and hold open time from 0 up to 30 seconds.</u>
- G. <u>Provide outputs and relays on board the operator to allow for coordination of exit device latch</u> retraction, electric strikes, magnetic locks, card readers, safety and motion sensors and <u>specified auxiliary contacts.</u>
- H. <u>Brackets and Reinforcements: Manufacturer's standard, fabricated from aluminum with</u> nonferrous shims for aligning system components.
- I. <u>Manufacturers: Subject to compliance with requirements, provide products by one of the following:</u>
 - 1. Norton Door Controls (NO) 6000 Series.

2.13 ARCHITECTURAL TRIM

- A. <u>Door Protective Trim</u>
 - 1. <u>General: Door protective trim units to be of type and design as specified below or in the Hardware Sets.</u>
 - Size: Fabricate protection plates (kick, armor, or mop) not more than 2" less than door width (LDW) on stop side of single doors and 1" LDW on stop side of pairs of doors, and not more than 1" less than door width on pull side. Coordinate and provide proper width and height as required where conflicting hardware dictates. Height to be as specified in the Hardware Sets.
 - 3. <u>Where plates are applied to fire rated doors with the top of the plate more than 16" above the bottom of the door, provide plates complying with NFPA 80. Consult manufacturer's catalog and template book for specific requirements for size and applications.</u>

- 4. <u>Protection Plates: ANSI/BHMA A156.6 certified protection plates (kick, armor, or mop),</u> <u>fabricated from the following:</u>
 - a. <u>Stainless Steel: 300 grade, 050-inch thick.</u>
- 5. <u>Options and fasteners: Provide manufacturer's designated fastener type as specified in</u> <u>the Hardware Sets. Provide countersunk screw holes.</u>
- 6. <u>Manufacturers:</u>
 - a. <u>Rockwood Products; ASSA ABLOY Architectural Door Accessories (RO).</u>

2.14 DOOR STOPS AND HOLDERS

- A. <u>General: Door stops and holders to be of type and design as specified below or in the Hardware</u> <u>Sets.</u>
- B. Door Stops and Bumpers: ANSI/BHMA A156.16, Grade 1 certified door stops and wall bumpers. Provide wall bumpers, either convex or concave types with anchorage as indicated, unless floor or other types of door stops are specified in Hardware Sets. Do not mount floor stops where they will impede traffic. Where floor or wall bumpers are not appropriate, provide overhead type stops and holders.
 - 1. Manufacturers:
 - a. Rockwood Products; ASSA ABLOY Architectural Door Accessories (RO).

2.15 ARCHITECTURAL SEALS

- A. <u>General: Thresholds, weatherstripping, and gasket seals to be of type and design as specified</u> <u>below or in the Hardware Sets. Provide continuous weatherstrip gasketing on exterior doors and</u> <u>provide smoke, light, or sound gasketing on interior doors where indicated. At exterior</u> <u>applications provide non-corrosive fasteners and elsewhere where indicated.</u>
- B. <u>Smoke Labeled Gasketing: Assemblies complying with NFPA 105 that are listed and labeled by</u> a testing and inspecting agency acceptable to authorities having jurisdiction, for smoke control ratings indicated, based on testing according to UL 1784.
 - 1. <u>Provide smoke labeled perimeter gasketing at all smoke labeled openings.</u>
- C. <u>Fire Labeled Gasketing: Assemblies complying with NFPA 80 that are listed and labeled by a</u> testing and inspecting agency acceptable to authorities having jurisdiction, for fire ratings indicated, based on testing according to UL-10C.
 - 1. <u>Provide intumescent seals as indicated to meet UL10C Standard for Positive Pressure</u> <u>Fire Tests of Door Assemblies, and NPFA 252, Standard Methods of Fire Tests of Door</u> <u>Assemblies.</u>
- D. <u>Sound-Rated Gasketing: Assemblies that are listed and labeled by a testing and inspecting agency, for sound ratings indicated.</u>

- E. <u>Replaceable Seal Strips: Provide only those units where resilient or flexible seal strips are easily</u> replaceable and readily available from stocks maintained by manufacturer.
- F. <u>Manufacturers:</u>
 - 1. <u>Pemko Products; ASSA ABLOY Architectural Door Accessories (PE).</u>

2.16 ELECTRONIC ACCESSORIES

- A. <u>Door Position Switches: Door position magnetic reed contact switches specifically designed for</u> <u>use in commercial door applications. On recessed models the contact and magnetic housing</u> <u>snap-lock into a 1" diameter hole. Surface mounted models include wide gap distance design</u> <u>complete with armored flex cabling. Provide SPDT, N/O switches with optional Rare Earth</u> <u>Magnet installation on steel doors with flush top channels.</u>
 - 1. Manufacturers:
 - a. <u>Securitron (SU) DPS Series.</u>
- B. <u>Power Supplies</u>
 - 1. By security contractor

2.17 FABRICATION

A. <u>Fasteners: Provide door hardware manufactured to comply with published templates generally</u> prepared for machine, wood, and sheet metal screws. Provide screws according to manufacturers recognized installation standards for application intended.

2.18 FINISHES

- A. <u>Standard: Designations used in the Hardware Sets and elsewhere indicate hardware finishes</u> <u>complying with ANSI/BHMA A156.18, including coordination with traditional U.S. finishes</u> <u>indicated by certain manufacturers for their products.</u>
- B. <u>Provide quality of finish, including thickness of plating or coating (if any), composition, hardness,</u> and other qualities complying with manufacturer's standards, but in no case less than specified by referenced standards for the applicable units of hardware
- C. <u>Protect mechanical finishes on exposed surfaces from damage by applying a strippable,</u> temporary protective covering before shipping.

PART 3 - EXECUTION

3.1 EXAMINATION

- A. Examine scheduled openings, with Installer present, for compliance with requirements for installation tolerances, labeled fire door assembly construction, wall and floor construction, and other conditions affecting performance.
- B. <u>Notify architect of any discrepancies or conflicts between the door schedule, door types,</u> <u>drawings and scheduled hardware. Proceed only after such discrepancies or conflicts have</u> <u>been resolved in writing.</u>

3.2 PREPARATION

- A. Hollow Metal Doors and Frames: Comply with ANSI/DHI A115 series.
- B. <u>Wood Doors: Comply with ANSI/DHI A115-W series.</u>
- C. Install each item of mechanical and electromechanical hardware and access control equipment to comply with manufacturer's written instructions and according to specifications.
 - 1. Installers are to be trained and certified by the manufacturer on the proper installation and adjustment of fire, life safety, and security products including: hanging devices; locking devices; closing devices; and seals.
 - 2. <u>All quick connection below the ceiling to be made by hardware installer at the time of installation.</u>
- D. <u>Mounting Heights: Mount door hardware units at heights indicated in following applicable publications, unless specifically indicated or required to comply with governing regulations:</u>
 - 1. <u>Standard Steel Doors and Frames: DHI's "Recommended Locations for Architectural</u> <u>Hardware for Standard Steel Doors and Frames."</u>
 - 2. <u>Wood Doors: DHI WDHS.3, "Recommended Locations for Architectural Hardware for</u> <u>Wood Flush Doors."</u>
 - 3. <u>Where indicated to comply with accessibility requirements, comply with ANSI A117.1</u> <u>"Accessibility Guidelines for Buildings and Facilities."</u>
 - 4. <u>Provide blocking in drywall partitions where wall stops or other wall mounted hardware is located.</u>
- E. Retrofitting: Install door hardware to comply with manufacturer's published templates and written instructions. Where cutting and fitting are required to install door hardware onto or into surfaces that are later to be painted or finished in another way, coordinate removal, storage, and reinstallation of surface protective trim units with finishing work specified in Division 9 Sections. Do not install surface-mounted items until finishes have been completed on substrates involved.
- F. <u>Thresholds: Set thresholds for exterior and acoustical doors in full bed of sealant complying with</u> requirements specified in Division 7 Section "Joint Sealants."
- G. <u>Storage: Provide a secure lock up for hardware delivered to the project but not yet installed.</u> <u>Control the handling and installation of hardware items so that the completion of the work will</u> <u>not be delayed by hardware losses before and after installation.</u>

3.3 FIELD QUALITY CONTROL

A. <u>Field Inspection (Punch-Out Report): Reference Division 01 Section "Closeout Procedures".</u> <u>Final inspect installed door hardware and state in report whether work complies with or deviates</u> <u>from specification requirements, including whether door hardware is properly installed,</u> <u>operating and adjusted.</u>

3.4 ADJUSTING

A. <u>Initial Adjustment: Adjust and check each operating item of door hardware and each door to</u> <u>ensure proper operation or function of every unit. Replace units that cannot be adjusted to</u> <u>operate as intended. Adjust door control devices to compensate for final operation of heating</u> <u>and ventilating equipment and to comply with referenced accessibility requirements.</u>

3.5 CLEANING AND PROTECTION

- A. <u>Protect all hardware stored on construction site in a covered and dry place. Protect exposed</u> hardware installed on doors during the construction phase. Install any and all hardware at the latest possible time frame.
- B. <u>Clean adjacent surfaces soiled by door hardware installation.</u>
- C. <u>Clean operating items as necessary to restore proper finish. Provide final protection and</u> <u>maintain conditions that ensure door hardware is without damage or deterioration at time of</u> <u>owner occupancy.</u>

3.6 DEMONSTRATION

A. <u>Instruct Owner's maintenance personnel to adjust, operate, and maintain mechanical and electromechanical door hardware.</u>

3.7 DOOR HARDWARE SETS

- A. The hardware sets represent the design intent and direction of the owner and architect. They are a guideline only and should not be considered a detailed hardware schedule. Discrepancies, conflicting hardware and missing items should be brought to the attention of the architect with corrections made prior to the bidding process. Omitted items not included in a hardware set should be scheduled with the appropriate additional hardware required for proper application and functionality.
 - 1. Quantities listed are for each pair of doors, or for each single door.
 - 2. <u>The supplier is responsible for handing and sizing all products.</u>
 - 3. <u>Where multiple options for a piece of hardware are given in a single line item, the supplier</u> shall provide the appropriate selection for the material and application.

- 4. <u>At existing openings with new hardware the supplier shall field inspect existing conditions</u> prior to the submittal stage to verify the specified hardware will work as required. Provide alternate solutions and proposals as needed.
- B. <u>Manufacturer's Abbreviations:</u>

1. MK - McKinney	
2. SA - SARGENT	
3. RO - Rockwood	
4. NO - Norton	
5. PE - Pemko	
6. OT - Other	
7. SU - Securitron	

Hardware Sets

<u>Set: 8.0</u>

Doors: 1200, 3200 Description: Pair Alum - Corr / Gym / Cafeteria - MHO

8 Hinge (heavy weight)	T4A3786 4 1/2" x 4 1/2"	US26D	MK
1 Removable Mullion	L980S	US28	SA
2 Rim Exit Device, Classroom	16 TB 43 72 8813 ETJ	US32D	SA
1 Mullion Cylinder	72 980C1	US26D	SA
5 Small Format Inter Core	7P-7300B	US15	SA
2 Door Closer	TB 351 O / PS as req	EN	SA
2 Kit	581-2	EN	SA
2 Electromagnetic Holder	990 Series	689	RF
1 Perimeter Seal	By door mfgr		OT

Notes: Doors are held open. Upon loss of power or signal from fire control, doors will close and latch. Wiring is by others.

Set: 9.0

Doors: 1170, 1222, 3102, 3131, 3201, 3231 Description: Pair Mech/Elec - Outswing

6 Hinge, Full Mortise	TA2714 4 1/2" x 4 1/2"	US26D	MK
1 Dust Proof Strike	570	US26D	RO
2 Flush Bolt	555 - 12"/72" A.F.F.	US26D	RO
1 Storeroom/Closet Lock	72 8204 LNJ	US26D	SA
1 Small Format Inter Core	7P-7300B	US15	SA
1 Surface Closer	351 PS	EN	SA
1 Astragal	355CS		PE
1 Perimeter Seal	S88BL		PE

<u>Set: 10.0</u> Doors: 6110, 7127

Description: Pair Storage Closer

6 Hinge, Full Mortise	TA2714 4 1/2" x 4 1/2"	US26D	MK
1 Dust Proof Strike	570	US26D	RO
2 Flush Bolt	555 - 12"/72" A.F.F.	US26D	RO
1 Storeroom/Closet Lock	72 8204 LNJ	US26D	SA
1 Small Format Inter Core	7P-7300B	US15	SA
2 Door Closer	TB 351 O / PS as req	EN	SA
2 Silencer	608		RO

Set: 11.0

Doors: 7145

Description: Pair Storage Inswing

6 Hinge, Full Mortise	TA2714 4 1/2" x 4 1/2"	US26D	MK
1 Dust Proof Strike	570	US26D	RO
2 Flush Bolt	555 - 12"/72" A.F.F.	US26D	RO
1 Storeroom/Closet Lock	72 8204 LNJ	US26D	SA
1 Small Format Inter Core	7P-7300B	US15	SA
2 Door Stop	481	US26D	RO
2 Silencer	608		RO

Set: 12.0

Doors: 2120B, 2120, 2140B, 2150A, 2156, 3100, 7101D, 7101E, 7121C, 7121D, 7122, 7128D, 7128E, 7128F, 7140A, 7150A

Description: *Pair - Corr/Gym/Classroom

6 Hinge (heavy weight)	T4A3786 4 1/2" x 4 1/2"	US26D	MK
1 Removable Mullion	L980S	PC	SA
2 Rim Exit Device, Classroom	16 TB 43 72 8813 ETJ	US32D	SA
1 Mullion Cylinder	72 980C1	US26D	SA
5 Small Format Inter Core	7P-7300B	US15	SA
2 Surface Closer	TB 351 CPS brkt/spacer as req	EN	SA
1 Astragal Set (2)	18041CNB		PE
1 Perimeter Seal	S88BL		PE

Set: 12.1 Doors: 7128G, 7140B

Description: *Pair - Passage Exit

6 Hinge (heavy weight)	T4A3786 4 1/2" x 4 1/2"	US26D	MK
1 Removable Mullion	L980S	PC	SA
2 Rim Exit Device, Passage	16 TB 43 8815 ETJ	US32D	SA
1 Mullion Cylinder	72 980C1	US26D	SA
3 Small Format Inter Core	7P-7300B	US15	SA
2 Surface Closer	TB 351 CPS brkt/spacer as req	EN	SA

1 Astragal Set (2)	18041CNB	PE
1 Perimeter Seal	S88BL	PE

Set: 14.0

Doors: 1200A, 2150, 1210B Description: Pair - Corr/Gym/Classroom - MHO

6 Hinge (heavy weight)	T4A3786 4 1/2" x 4 1/2"	US26D	MK
1 Removable Mullion	L980S	PC	SA
2 Rim Exit Device, Classroom	16 TB 43 72 8813 ETJ	US32D	SA
1 Mullion Cylinder	<u>72 980C1</u>	US26D	SA
5 Small Format Inter Core	7P-7300B	US15	SA
2 Surface Closer	TB 351 CPS brkt/spacer as req	EN	SA
2 Electromagnetic Holder	990 Series	689	RF
1 Astragal Set (2)	18041CNB		PE
1 Perimeter Seal	S88BL		PE

Notes: Doors are held open. Upon loss of power or signal from fire control, doors will close and latch. Wiring is by others.

Set: 16.0

Doors: ST-05 Description: Sgl Stair

3 Hinge (heavy weight)	T4A3786 4 1/2" x 4 1/2"	US26D	MK
1 Rim Exit Device, Passage	12 TB 43 8815 ETJ	US32D	SA
1 Door Closer	TB 351 O / PS as req	EN	SA
1 Door Stop	481	US26D	RO
1 Perimeter Seal	S88BL		PE

Set: 17.0

Doors: 1213E, 1218A, 1161A, 1165B, 1167B, A2104, 2104, 2108, 2116A, 2116B, 2122, 2126A, 2126B, 2161B, 3125A, 3152, 3156, 3172, 3176, 3225A, 3252, 3256, 3272, 3276, 6123B, 7101B, 7101C, 7104A, 7105A, 7121B, 7126A, 7126B, 7152, 7247

Description: Storage

3 Hinge, Full Mortise	TA2714 4 1/2" x 4 1/2"	US26D	MK
1 Storeroom/Closet Lock	72 8204 LNJ	US26D	SA
1 Small Format Inter Core	7P-7300B	US15	SA
1 Door Stop	481	US26D	RO
3 Silencer	608		RO

Set: 18.0

Doors: 7142A, 7142B Description: Storage - 4'

$4 \text{ U}^{1}_{1} = 4 \frac{1}{2} $	_			
$\frac{4 \text{ Hinge (neavy weight)}}{14A3/8641/2} = \frac{14A3/8641/2}{12} = \frac{12}{12} $	4 Hinge (heavy weight)	T4A3786 4 1/2" x 4 1/2"	US26D M	K

1 Storeroom/Closet Lock	72 8204 LNJ	US26D	SA
1 Small Format Inter Core	7P-7300B	US15	SA
1 Door Stop	481	US26D	RO
3 Silencer	608		RO

Set: 19.0

Doors: 1163, 1165, 1205, 2112B, 2130, 2143, 2310A, 3101, 3124C, 3125B, 3224A, 3225B, 3226, 3261, 3262, 6102, 6108A, 7103A, 7103B, 7112, 7113

Description: Storage - Closer

3 Hinge, Full Mortise	TA2714 4 1/2" x 4 1/2"	US26D	MK
1 Storeroom/Closet Lock	72 8204 LNJ	US26D	SA
1 Small Format Inter Core	7P-7300B	US15	SA
1 Door Closer	TB 351 O / PS as req	EN	SA
1 Door Stop	481	US26D	RO
3 Silencer	608		RO
	481	US26D	

-

Set: 21.0

Doors: 2140A, 2141

Description: Storage - Closer - Gasket - Wide

3 Hinge (heavy weight)	T4A3786 4 1/2" x 4 1/2"	US26D	MK
1 Storeroom/Closet Lock	72 8204 LNJ	US26D	SA
1 Small Format Inter Core	7P-7300B	US15	SA
1 Door Closer	TB 351 O / PS as req	EN	SA
1 Door Stop	481	US26D	RO
1 Perimeter Seal	S88BL		PE

Set: 21.1

Doors: 7111, 2157 Description: Storage - Closer - Gasket -4'

4 Hinge (heavy weight)	T4A3786 4 1/2" x 4 1/2"	US26D	MK
1 Storeroom/Closet Lock	72 8204 LNJ	US26D	SA
1 Small Format Inter Core	7P-7300B	US15	SA
1 Door Closer	TB 351 O / PS as req	EN	SA
1 Door Stop	481	US26D	RO
1 Perimeter Seal	S88BL		PE

Set: 22.0

Doors: 1113C, 2112A, 2142, 2152, 2161, 3111, 3140, 3154, 3174, 3210, 3226A, 3226B, 3240, 3254, 3274, 3112A, 3112B, 3112C, 6122 Description: Storage - Closer - Gasket

3 Hinge, Full Mortise	TA2714 4 1/2" x 4 1/2"	US26D	MK
1 Storeroom/Closet Lock	72 8204 LNJ	US26D	SA
1 Small Format Inter Core	7P-7300B	US15	SA
1 Door Closer	TB 351 O / PS as req	EN	SA

1 Door Stop	481	US26D	RO
1 Perimeter Seal	S88BL		PE

Set: 22.1

Doors: 7249 Description: Storage - Closer - Gasket - STC

3	Hinges	By the STC Door Manufacturer		OT
1	Storeroom/Closet Lock	72 8204 LNJ	US26D	SA
1	Small Format Inter Core	7P-7300B	US15	SA
1	Door Closer	TB 351 O / PS as req	EN	SA
1	Door Stop	481	US26D	RO
1	Gasket, threshold, door bott	tomBy the STC Door Manufacturer		OT

Notes: At existing doors and frames, verify all existing conditions and modify hardware as required prior to purchase.

Door hardware is specified for design intent. Confirm hardware compatibility and design meets the door manufacturer's approved assembly testing for the STC level indicated. Set: 23.0 Doors: 1211, 2103C

Description: Storage - Closer/stop - Gasket

3 Hinge, Full Mortise	TA2714 4 1/2" x 4 1/2"	US26D	MK
1 Storeroom/Closet Lock	72 8204 LNJ	US26D	SA
1 Small Format Inter Core	7P-7300B	US15	SA
1 Surface Closer	351 PS	EN	SA
1 Perimeter Seal	S88BL		PE

Set: 25.0

_

Doors: 1213A, 1213B, 1213C, 1213D, 1216A, 1218C, 1220A, 2115A, 2121A, 2121B, 2106, 2159A, 2160, 3151, 3153, 3155, 3171, 3173, 3175, 3251, 3253, 3255, 3271, 3273, 3275, 6111, 6123A, 7101A, 7102, 7104B, 7104C, 7121A, 7129, 7130, 7141, 7143, 7151, 7241, 7242 Description: Office

3 Hinge, Full Mortise	TA2714 4 1/2" x 4 1/2"	US26D	MK
1 Office/Entry Lock	72 8205 LNJ	US26D	SA
1 Small Format Inter Core	7P-7300B	US15	SA
1 Door Stop	481	US26D	RO
3 Silencer	608		RO

Set: 25.1

Doors: 7241, 7242 Description: Office - STC

3	Hinges	By the STC Door Manufacturer		OT
1	Office/Entry Lock	72 8205 LNJ	US26D	SA

1	Small Format Inter Core	7P-7300B	US15	SA
1	Door Stop	481	US26D	RO
1	Gasket, threshold, door bottom	By the STC Door Manufacturer		OT

Notes: At existing doors and frames, verify all existing conditions and modify hardware as required prior to purchase.

Door hardware is specified for design intent. Confirm hardware compatibility and design meets the door manufacturer's approved assembly testing for the STC level indicated. Set: 26.0

Doors: 1113A, 1113B, 3104A, 3104B, 3106A, 3106B, 3133A, 3133B, 3135A, 3135B, 3160, 3203A, 3203B, 3205A, 3205B, 3233A, 3233B, 3235A, 3235B, 6105A, 6105B, 7126, 7126C Description: *Large Classroom / Media Typical- Exit

3 Hinge (heavy weight)	T4A3786 4 1/2" x 4 1/2"	US26D	MK
1 Rim Exit Device, Classroom	16 TB 43 72 8813 ETJ	US32D	SA
1 Small Format Inter Core	7P-7300B	US15	SA
1 Surface Closer	TB 351 CPS brkt/spacer as req	EN	SA
3 Silencer	608		RO

Set: 27.0

Doors: 1167A, 3178A, 3178B, 3258B, 3278, 3112A, 3112B Description: Classroom

3 Hinge, Full Mortise	TA2714 4 1/2" x 4 1/2"	US26D	MK
1 Classroom Lock	72 8237 LNJ	US26D	SA
1 Small Format Inter Core	7P-7300B	US15	SA
1 Door Stop	481	US26D	RO
3 Silencer	608		RO

Set: 28.0

Doors: 2107 Description: Classroom - Closer - Vestibule - 4'

4 Hinge (heavy weight)	T4A3786 4 1/2" x 4 1/2"	US26D	MK
1 Classroom Lock	72 8237 LNJ	US26D	SA
1 Small Format Inter Core	7P-7300B	US15	SA
1 Door Closer	TB 351 O / PS as req	EN	SA
1 Door Stop	481	US26D	RO
1 Perimeter Seal	S88BL		PE

Notes: Insure egress is allowed from vestibule.

Set: 29.0

Doors: 1114A, 1114B, 1213, 1214, 1214A, 1214B, 1216, 1217, 1162, 1166, 1167, 1172, 1212, 1215, 1218, 1219, 1220, 2126, 2158, 2159, 3103, 3105, 3107, 3108, 3109, 3113, 3113A, 3113B, 3213A, 3213B, 3114, 3115, 3122, 3128, 3132, 3134, 3136, 3137, 3138, 3142, 3143, 3144, 3157C, 3157D, 3202, 3204,

<u>3206, 3207, 3208, 3212, 3213, 3214, 3222, 3228, 3232, 3237, 3238, 3242, 3243, 3244, 3260, 3263, 7103, 7104, 7105, 7246B</u>

Description: *Typical Classroom/ Corridor - Closer

3 Hinge, Full Mortise	TA2714 4 1/2" x 4 1/2"	US26D	MK
1 Classroom Lock	72 8237 LNJ	US26D	SA
1 Small Format Inter Core	7P-7300B	US15	SA
1 Door Closer	TB 351 O / PS as req	EN	SA
1 Door Stop	481	US26D	RO
3 Silencer	608		RO

Set: 30.0

Doors: 3126

Description: Pair Classroom/ Corridor - Closer - Inswing

6 Hinge, Full Mortise	TA2714 4 1/2" x 4 1/2"	US26D	MK
1 Dust Proof Strike	570	US26D	RO
1 Automatic Flush Bolts	2842/2942	US26D	RO
1 Classroom Lock	72 8237 LNJ	US26D	SA
1 Small Format Inter Core	7P-7300B	US15	SA
1 Coordinator	2672	US28	RO
2 Mounting Bracket	2601AB	US28	RO
2 Door Closer	TB 351 O / PS as req	EN	SA
2 Door Stop	481	US26D	RO
2 Silencer	608		RO

Set: 31.0

Doors: 1161, 7155

Description: *Typical Classroom/ Corridor - Closer - 4'

4 Hinge (heavy weight)	T4A3786 4 1/2" x 4 1/2"	US26D	MK
1 Classroom Lock	72 8237 LNJ	US26D	SA
1 Small Format Inter Core	7P-7300B	US15	SA
1 Door Closer	TB 351 O / PS as req	EN	SA
1 Door Stop	481	US26D	RO
3 Silencer	608		RO

Set: 32.0

Doors: 2102, 2116, 3150, 3158, 3170, 3177C, 3177D, 3250, 3257C, 3257D, 3258A, 3270, 3277C, 3277D Description: Classroom - Closer

3 Hinge, Full Mortise	TA2714 4 1/2" x 4 1/2"	US26D	MK
1 Classroom Lock	72 8237 LNJ	US26D	SA
1 Small Format Inter Core	7P-7300B	US15	SA
1 Door Closer	TB 351 O	EN	SA
3 Silencer	608		RO

Set: 34.0

Doors: 3103A, 3108A, 3109A, 3115A, 3132A, 3136A, 3138A, 3144A, 3202A, 3207A, 3208A, 3214A, 3232A, 3237A, 3238A, 3244A Description: Passage - Between Classrooms

3 Hinge, Full Mortise	TA2714 4 1/2" x 4 1/2"	US26D	MK
1 Passage Set	8215 LNJ	US26D	SA
1 Door Stop	481	US26D	RO
3 Silencer	608		RO

Set: 35.0

Doors: 3124A, 3124B, 3124D, 3124E, 3224B, 3224C, 3224D, 3224E Description: Prep - OH Stop

3 Hinge, Full Mortise	TA2714 4 1/2" x 4 1/2"	US26D	MK
1 Classroom Lock	72 8237 LNJ	US26D	SA
1 Small Format Inter Core	7P-7300B	US15	SA
1 Concealed Overhead Stop	690S	US26D	SA
3 Silencer	608		RO

-

Set: 37.0

Doors: 6123C Description: Laundry - 4'

4 Hinge (heavy weight)	T4A3786 4 1/2" x 4 1/2"	US26D	MK
1 Classroom Lock	72 8237 LNJ	US26D	SA
1 Small Format Inter Core	7P-7300B	US15	SA
1 Door Stop	481	US26D	RO
3 Silencer	608		RO

Set: 38.0

Doors: 1203, 1204, 2111, 2113, 2123, 2124, 2154, 2155, 3110, 3112, 3139, 3141, 3209, 3211, 3239, 3241, 6103, 6104, 6107, 6109, 6123D, 6123E, 7128A, 7131A, 7246A Description: Shared Restroom/Locker / Dressing P/P

3 Hinge, Full Mortise	TA2714 4 1/2" x 4 1/2"	US26D	MK
1 Push Plate	70E	US32D	RO
1 Pull Plate	111x70C	US32D	RO
1 Door Closer	TB 351 O / PS as req	EN	SA
1 Door Stop	481	US26D	RO
1 Perimeter Seal	S88BL		PE

Set: 38.1

Doors: 6123 Description: Shared Restroom/Locker / Dressing P/P - 4'

4 Hinge (heavy weight) T4A3786 4 1/2" x 4 1/2" US26D MK	-			
	4 Hinge (heavy weight)	T4A3786 4 1/2" x 4 1/2"	US26D	MK

1 Push Plate	70E	US32D	RO
1 Pull Plate	111x70C	US32D	RO
1 Door Closer	TB 351 O / PS as req	EN	SA
1 Door Stop	481	US26D	RO
1 Perimeter Seal	S88BL		PE

Set: 39.0

_

Doors: 7131B, A2105 Description: Locker - Closer - DB

3 Hinge, Full Mortise	TA2714 4 1/2" x 4 1/2"	US26D	MK
1 Public Toilet Deadlock	72 4878	US26D	SA
1 Small Format Inter Core	7P-7300B	US15	SA
1 Push Plate	70E	US32D	RO
1 Pull Plate	111x70C	US32D	RO
1 Door Closer	TB 351 O / PS as req	EN	SA
1 Perimeter Seal	S88BL		PE

Set: 40.0

Doors: 1169, 1171, 2105A, 2105B Description: Staff Restroom - Inswing

3 Hinge, Full Mortise	TA2714 4 1/2" x 4 1/2"	US26D	MK
1 Storeroom Deadbolt Lock	50 72 8251 LNJ	US26D	SA
1 Small Format Inter Core	7P-7300B	US15	SA
1 Door Closer	TB 351 O	EN	SA
1 Door Stop	481	US26D	RO
1 Perimeter Seal	S88BL		PE

Set: 41.0

Doors: 3157A, 3157B, 3177A, 3177B, 3257A, 3257B, 3277A, 3277B, 6111A, 7123, 7124 Description: Int Restroom / Admin area

3 Hinge, Full Mortise	TA2714 4 1/2" x 4 1/2"	US26D	MK
1 Privacy Set w/ Indicator	49 8265 LNJ	US26D	SA
1 Door Closer	TB 351 O / PS as req	EN	SA
1 Door Stop	481	US26D	RO
1 Perimeter Seal	S88BL		PE

Set: 42.0 Doors: 1165A, 1163A Description: Class Restroom

- 3 Hinge, Full Mortise	TA2714 4 1/2" x 4 1/2"	US26D	MK
1 Privacy Set w/ Indicator	49 8265 LNJ	US26D	SA
1 Door Stop	481	US26D	RO
1 Perimeter Seal			
Set: 44.0			
Doors: 1219B, 1219C, 1220B, 1220	C, 7125, 7144, 7153, 7154		

Description: Practice- Sound Seals

3 Hinge, Full Mortise	TA2714 4 1/2" x 4 1/2"	US26D	MK
1 Passage Set	8215 LNJ	US26D	SA
1 Door Stop	481	US26D	RO
2 Seal @ Jambs	350CSR		PE
1 Seal @ Head	2891APK		PE
1 Mortised Auto Door Bottom	420APKL		PE

Set: 44.1

Doors: 7243, 7244, 7245, 7248 Description: Practice- STC

3 Hinges	By the STC Door Manufacturer		OT
1 Passage Set	8215 LNJ	US26D	SA
1 Door Stop	481	US26D	RO
1 Gasket, threshold, door bottom	By the STC Door Manufacturer		OT

Notes: At existing doors and frames, verify all existing conditions and modify hardware as required prior to purchase.

Set: 46.0

Doors: G01 Description: *Gate - Panic

1 Hinges	By the door manufacturer		OT
1 Exit Device - SPAR#NCE35	WH CPC TB 43 72 8804	US32D	SA
1 Vandal Resistant Trim	826	US32D	SA
1 Small Format Inter Core	7P-7300B	US15	SA
1 Balance hardware	by the door manufacturer		OT

Notes: Power and wiring is by others.

END OF SECTION 08 71 00

SECTION 10 14 00 - GRAPHICS

PART 1 - GENERAL

1.1 RELATED DOCUMENTS

A. Drawings and general provisions of the Contract, including General and Supplementary Conditions and other Division 01 Specification Sections, apply to this Section.

1.2 SUMMARY

- A. Section Includes: Requirements including but not limited to:
 - 1. Panel signs.
 - 2. Room identification signs.
 - 3. Field applied, vinyl character signs.
 - 4. Cast character for exterior signage.
 - 5. Handicap parking signs.
 - 6. Accessories necessary for a complete installation.

1.3 SUBMITTALS

- A. Product Data: Technical data for each type of signage.
- B. Signage Shop Drawings: Submit fabrication and installation details and attachments to other Work.
 - 1. Show sign mounting heights, locations of supplementary supports to be provided by others, and accessories.
 - 2. Show message list, typestyles, graphic elements, including raised characters and Braille, and layout for each sign at least half size.
- C. Dedication Plaque Shop Drawings: Submit fabrication and installation details and attachments to other Work.
 - 1. Indicating materials, sizes, and finishes, details of fabrication and installation, fasteners and hardware, attachments, related and adjacent Work.
 - 2. Rubbing of actual pattern of cast metal plaque for Architect's approval prior to casting.
- D. Certifications: Submit letter of certification from manufacturer that installer and manufacturer is in compliance and meets specified requirements.
- E. Samples:
 - 1. One (1) 6 inch x 6 inch sample of cast metal plaque material with specified finish.
 - 2. One (1) 4 inch actual sample of cast metal letter in specified letter style and finish.
 - 3. One (1) actual sample of each type room identification sign with specified finish.

1.4 QUALITY ASSURANCE

- A. Regulatory Requirements:
 - 1. Building Code/City Code: Comply with building code and local ordinances for exterior signage.
 - 2. Accessibility Requirements: Comply with applicable requirements.
 - a. U.S. Architectural and Transportation Barriers Compliance Board Americans with Disabilities Act Accessibility Guidelines for Buildings and Facilities (ADAAG) 2010.
 - b. ICC/ANSI A117.1 Accessible and Useable Building and Facilities.
 - c. Texas Accessibility Standards (TAS) 2012.

GRAPHICS 10 14 00 - 1

- B. Installer Qualifications: Installer has minimum 5 Years documented experience in the manufacture of signage and who employs installers and supervisors trained and approved in installation methods for each type of signage.
- C. Thermal Movements: For exterior fabricated channel dimensional characters, allow for thermal movements from ambient and surface temperature changes.
 - 1. Temperature Change: 120 degrees F (67 degrees C), ambient; 180 degrees F (100 degrees C), material surfaces.

1.5 FIELD CONDITIONS

A. Field Measurements: Verify locations of anchorage devices and electrical service embedded in permanent construction by other installers by field measurements before fabrication, and indicate measurements on Shop Drawings.

1.6 WARRANTY

- A. Written warranty signed by manufacturer in which manufacturer agrees to repair or replace components of signs that fail in materials or workmanship within specified warranty period.
 - 1. Failures include, but are not limited to, the following:
 - a. Deterioration of finishes beyond normal weathering.
 - b. Deterioration of embedded graphic image.
 - c. Separation or delamination of sheet materials and components.
 - 2. Warranty Period: Five years from date of Substantial Completion.

PART 2 - PRODUCTS

2.1 MATERIALS

- A. Basis of Design Manufacturer: South Texas Graphics; (713) 467-4499. Other manufacturers shall have a minimum of five (5) years experience manufacturing products meeting or exceeding those specified and shall comply with Division 1 requirements for substitutions in order to be considered.
 - 1. A.R.K. Ramos Architectural Signage Systems; (405) 235-5505.
 - 2. InPro Corporation (IPC); (800) 222-5566.
 - 3. ProWorx Architectural Signage; (713) 666-3131.
 - 4. Riot Creative Imaging; (713) 988-9200.
 - 5. Stanley Signature Signs; (281) 395-6106.
 - 6. The Southwell Co.; (210) 223-1831.
 - 7. Aria Signs; (713) 259-3737.
- B. Aluminum Castings: ASTM B 26/B 26M, alloy and temper recommended by sign manufacturer for casting process used and for type of use and finish indicated.
- C. Aluminum Sheet and Plate: ASTM B 209 (ASTM B 209M), alloy and temper recommended by aluminum producer and finisher for type of use and finish indicated.
- D. Aluminum Extrusions: ASTM B 221 (ASTM B 221M), alloy and temper recommended by aluminum producer and finisher for type of use and finish indicated.
- E. Acrylic Sheet: ASTM D 4802, category standard with manufacturer for each sign, Type UVF (UV filtering).
- F. Plastic Laminate Sheet: NEMA LD 3, general purpose HGS grade, 0.048-inch (1.2-mm) nominal thickness.

- G. Vinyl Film: UV resistant vinyl film of nominal thickness indicated, with pressure sensitive, permanent adhesive on back; die cut to form characters or images indicated and suitable for exterior applications.
- H. Paints and Coatings for Sheet Materials: Inks, dyes, and paints that are recommended by manufacturer for optimum adherence to surface and are UV and water resistant for colors and exposure indicated.
- I. Accessories:
 - 1. Fasteners and Anchors: As necessary for secure anchorage of signage, noncorrosive and compatible with each material joined, and complying with the following:
 - a. Use concealed fasteners and anchors unless indicated to be exposed.
 - b. Exposed Metal Fastener Components: Fabricated from same basic metal and finish of fastened metal unless otherwise indicated.
 - 2. Sign Mounting Fasteners:
 - a. Concealed Studs: Concealed (blind), threaded studs welded or brazed to back of sign material or screwed into back of sign assembly, unless otherwise indicated.
 - 3. Adhesive: Recommended by sign manufacturer.
 - 4. Two Face Tape: High bond, foam core tape, 0.045 inch (1.14 mm) thick, with adhesive on both sides.
 - 5. Bituminous Paint: Cold applied asphalt emulsion complying with ASTM D 1187.

2.2 SIGNAGE

- A. General:
 - 1. Constructed of one (1) or two (2) high pressure laminate in colors selected by Architect, laminated to an 1/8" inch thick acrylic backer.
 - 2. Signage shall have radius or square corners with square cut edges painted a color as selected by Architect / Owner.
 - 3. Demarcation lines, if any, can be raised 1/32" inch to match copy or engraved and infilled with a color as selected by Architect / Owner.
 - 4. Signs shall comply with all state and federal codes, including but not limited to, the 2012 ADA and TAS requirements.
 - 5. Refer to drawings for details of types, dimensions, colors, graphic layouts and mounting/height specifications.
- B. Room Numbers, Symbols, Lower or Secondary Copy, and Pictograms:
 - 1. Copy shall be matte finished acrylic, raised /32" inch of a color contrasting to the face laminate.
 - 2. Characters and pictograms shall be chemically welded to the acrylic backing, through the face laminate, to assure permanent adhesion.
 - 3. Room numbers and restroom copy shall be copy shall be accompanied by Grade II Braille by means of 'VisiTouch DuraDot System'. Glass or metallic 'DuraDots' shall have .059 inch surface diameter with body of sphere pressure secured below face laminate. Routed boxes or glued on dots are not acceptable.
 - 4. Secondary copy shall be a minimum of 5/8" inch high, matte finished acrylic, raised 1/32" inch san serif font.
 - 5. Acceptable ADA compliant fonts are Arial, Helvetica, Optima, Futura as selected by Architect, in all caps.
- C. Restroom Pictograms:
 - 1. Pictograms shall appear on a minimum 6" inch, unobstructed square.
- D. Window (Slotted) Signs:

- 1. Window / Slotted signs shall be open at both ends for changeable insert provided by Owner. Window shall be a non-glare Lexan acrylic lens, with an exposed color laminate behind in color as selected by Architect/Owner.
- E. Fasteners and Accessories:
 - 1. 1/8" inch thick, double-sided foam tape of type recommended to suite application and commercial grade silicone sealant.
 - 2. Back-up plates shall be supplied, when shown or required, for signage mounted on glass.
- F. Provide all materials required for a complete installation.
- G. Approved manufacturers:
 - 1. Signage:
 - a. Basis of Design: South Texas Graphic Specialties, Inc. Houston, TX 713.467.4499.
 - b. Refer to 2.1.A. of Section 10 14 00 for approved manufacturers.
 - 2. Plastic Laminate:
 - a. WilsonArt International, Temple, TX 800.433.3222
 - b. Nevamar Company, LLC, Shelton, CT 877.726.6526
 - c. Formica, 1.800.367.6422
 - d. Pionite, Shelton, CT 203.925.1556
- H. Cast Characters: Characters with uniform faces, sharp corners, and precisely formed lines and profiles:
 - 1. Character Material: Cast aluminum.
 - 2. Character Height: Indicated on Drawings.
 - 3. Finishes:
 - a. Baked Enamel or Powder Coat Finish: Color to match school colors and logo.
 - b. Overcoat: Baked on clear coating.
 - 4. Mounting: Concealed studs.
 - 5. Typeface: Selected by Architect.
- I. Field Applied, Vinyl Character Sign: Prespaced characters die cut from 3 mil to 3.5 mil (0.076 mm to 0.089 mm) thick, weather resistant vinyl film with release liner on the back and carrier film on the front for on site alignment and application.
 - 1. Manufacturers: Subject to compliance with requirements, provide products by one of the following:
 - a. Allen Markings.
 - b. APCO Graphics, Inc.
 - c. Mohawk Sign Systems.
 - d. Seton Identification Products.
 - 2. Size: Indicated on Drawings.
 - 3. Substrate: Indicated on Drawings.
- J. Handicap Signs:
 - 1. Signage Materials: 0.080 inch thick aluminum or galvanized steel sign with 1-1/2 inch silk screen upper case letters, copy and border. Signs shall have 1-1/2 inch radius at corners typically. Sizes shall be as shown on drawings or required by authorities having jurisdiction.
 - 2. Post Materials: Provided by Section 05 50 00, Metal Fabrications.
 - 3. Graphics:

- a. Accessibility ("Handicapped Parking") signs with lettering and graphics as detailed. All Work shall comply with local codes, ADA, and TAS standards ands requirements.
- 4. Accessories:
 - a. Sign Mounting Hardware: Provide sign mounting hardware of galvanized steel of type and size instructed by manufacturer to suit intended use.
 - b. Provide concrete footings of 3,000 psi compressive strength at 28 days, unless noted or directed otherwise.
 - c. Provide all materials required for signage and proper installation.
- K. Illegally Parking Signs in Accessible Spaces:
 - 1. Sign for Illegally parking in a paved accessible parking space.
 - 2. Minimum state "Violaters Subject to Fine and Towing" in a letter height of at least one inch.
 - 3. Mounted on a pole, post, wall or freestanding board as shown on the Drawings.
 - 4. No more than eight (8) inches below a sign required by ADA and TAS standards.
 - 5. Installed so bottom edge of sign is no lower than 48 inches and no higher than 80 inches above ground level.
- L. Door Vinyl Numbers:
 - 1. Composition: 11 inch x 13 inch white background with 8 inch black reflective numbering located on the transom above and outside door.
 - 2. Material: Vinyl.
 - 3. Font: Arial.
 - 4. Sequence: Start at main entry working clockwise. The Main Entry is door number 1, then next clockwise is 2, and so on.
 - 5. Locations: At multiple doors, add one TWO door sign and number in the vicinity. Do not number doors that cannot access the rest of the building.
- M. Driveway Entrance Paint and Signs:
 - 1. Composition: Entry drives are 24 inches diameter blue with 20 inches white number with striping paint, start with main entrance and work clockwise Each driveway needs to also have a sign, the size of a speed limit sign, with entry number matching the concrete drive number and below the driveway number the cardinal direction of that driveway, i.e. N for North drive, SE for Southeast drive, etc. The driveways signs will be galvanized steel with 3M[™] Diamond Grade[™] DG³ Reflective Sign Sheeting or comparable product with black number and letter and white background, similar to speed limit sign. The sign to be 12"W and 24"H. The letters on the sign to be 10" High and the number to be 10" High.
 - 2. Font: Arial.
 - 3. Location: Each driveway entrance numbered with paint on the concrete entrance. Refer to Section 09 90 00.

2.3 FABRICATION

- A. Provide sign assemblies according to requirements indicated.
 - 1. Preassemble signs and assemblies in the shop to greatest extent possible. Disassemble signs and assemblies as necessary for shipping and handling limitations. Clearly mark units for reassembly and installation; apply markings in locations concealed from view after final assembly.
 - 2. Mill joints to a tight, hairline fit. Form assemblies and joints exposed to weather to resist water penetration and retention.
 - 3. Comply with AWS for recommended practices in welding and brazing. Provide welds and brazes behind finished surfaces without distorting or discoloring exposed side. Clean exposed welded and brazed connections of flux, and dress exposed and contact surfaces.
 - 4. Conceal connections if possible; otherwise, locate connections where they are inconspicuous.
 - 5. Internally brace signs for stability and for securing fasteners.

- 6. Provide rebates, lugs, and brackets necessary to assemble components and to attach to existing Work. Drill and tap for required fasteners. Use concealed fasteners where possible; use exposed fasteners that match sign finish.
- 7. Castings: Fabricate castings free of warp, cracks, blowholes, pits, scale, sand holes, and other defects that impair appearance or strength. Grind, wire brush, sandblast, and buff castings to remove seams, gate marks, casting flash, and other casting marks before finishing.
- B. Brackets: Fabricate brackets, fittings, and hardware for bracket mounted signs to suit sign construction and mounting conditions indicated. Modify brackets as necessary.
 - 1. Aluminum Brackets: Factory finish brackets with baked enamel or powder coat finish to match sign background color color unless otherwise indicated.

2.4 FINISH REQUIREMENTS

- A. Protect mechanical finishes on exposed surfaces from damage by applying a strippable, temporary protective covering before shipping.
- B. Appearance of Finished Work: Noticeable variations in same piece are not acceptable. Variations in appearance of adjoining components are acceptable if they are within the range of approved Samples and are assembled or installed to minimize contrast.
- C. Directional Finishes: Run grain with long dimension of each piece and perpendicular to long dimension of finished trim or border surface unless otherwise indicated.
- D. Organic, Anodic, and Chemically Produced Finishes: Apply to formed metal after fabrication but before applying contrasting polished finishes on raised features unless otherwise indicated.
- E. Aluminum Finishes:
 - 1. Clear Anodic Finish: AAMA 611, Class I, 0.018 mm or thicker.
 - 2. Baked Enamel or Powder Coat Finish: AAMA 2603 except with a minimum dry film thickness of 1.5 mils (0.04 mm). Comply with coating manufacturer's written instructions for cleaning, conversion coating, and applying and baking finish.

PART 3 - EXECUTION

3.1 EXAMINATION

- A. Examine substrates, areas, and conditions for compliance with requirements for installation tolerances and other conditions affecting performance of signage Work. Verify sign support surfaces are within tolerances to accommodate signs without gaps or irregularities between backs of signs and support surfaces unless otherwise indicated.
- B. Proceed with installation after correcting unsatisfactory conditions.

3.2 INSTALLATION

- A. Install signs using mounting methods indicated and according to manufacturer's written instructions.
 - 1. Install signs level, plumb, true to line, and at locations and heights indicated, with sign surfaces free of distortion and other defects in appearance.
 - 2. Install signs so they do not protrude or obstruct according to the accessibility standard.
 - 3. Interior Wall Signs: Install signs on walls adjacent to latch side of door where applicable. Where not indicated or possible, such as double doors, install signs on nearest adjacent

walls. Locate to allow approach within 3 inches (75 mm) of sign without encountering protruding objects or standing within swing of door.

- a. Comply with all applicable accessibility requirements for mounting height and location of each sign.
- 4. Before installation, verify sign surfaces are clean and free of materials or debris that impair installation.
- 5. Corrosion Protection: Coat concealed surfaces of exterior aluminum in contact with grout, concrete, masonry, wood, or dissimilar metals, with a heavy coat of bituminous paint.
- B. Mounting Methods:
 - 1. Concealed Studs: Using a template, drill holes in substrate aligning with studs on back of sign. Remove loose debris from hole and substrate surface.
 - a. Masonry Substrates: Fill holes with adhesive. Leave recess space in hole for displaced adhesive. Place sign in position and push until flush to surface, embedding studs in holes. Temporarily support sign in position until adhesive fully sets.
 - b. Thin or Hollow Surfaces: Place sign in position and flush to surface, install washers and nuts on studs projecting through opposite side of surface, and tighten.
 - 2. Brackets: Remove loose debris from substrate surface and install backbar or bracket supports in position so that signage is correctly located and aligned.
 - 3. Shim Plate Mounting: Provide 1/8 inch (3 mm) thick, concealed aluminum shim plates with predrilled and countersunk holes, at locations indicated, and where other direct mounting methods are impractical. Attach plate with fasteners and anchors suitable for secure attachment to substrate. Attach signs to plate using method specified above.
- C. Field Applied, Vinyl Character Signs: Clean and dry substrate. Align sign characters in final position before removing release liner. Remove release liner in stages, and apply and firmly press characters into final position. Press from the middle outward to obtain good bond without blisters or fishmouths. Remove carrier film without disturbing applied vinyl film.
- D. Signs Mounted on Glass: Provide opaque sheet matching sign material and finish onto opposite side of glass to conceal back of sign.

3.3 ADJUSTING AND CLEANING

- A. Remove and replace damaged or deformed signs and signs that do not comply with specified requirements. Replace signs with damaged or deteriorated finishes or components that cannot be successfully repaired by finish touchup or similar minor repair procedures.
- B. Remove temporary protective coverings and strippable films as signs are installed.
- C. On completion of installation, clean exposed surfaces of signs according to manufacturer's written instructions, and touch up minor nicks and abrasions in finish. Maintain signs in a clean condition during construction and protect from damage until acceptance by Owner.

END OF SECTION 10 14 00

SECTION 10 51 13 - METAL LOCKERS AND BENCHES

PART 1 - GENERAL

1.1 RELATED DOCUMENTS

A. Drawings and general provisions of the Contract, including General and Supplementary Conditions and other Division 01 Specification Sections, apply to this Section.

1.2 SUMMARY

- A. Section Includes: Requirements including but not limited to:
 - 1. Welded corridor lockers.
 - 2. Wooden Locker room benches.
 - 3. Accessories necessary for a complete installation.

1.3 SUBMITTALS

- B. Product Data:
 - 1. Manufacturer's schedules, charts, literature, and illustrations to indicate the performance, fabrication procedures, product variations, and accessories.
 - 2. Manufacturer's installation instructions.
- C. Shop Drawings: Indicate size, material, and finish. Show location and installation procedures. Include details of joints, attachments and clearances.
- D. Locker/Lock Schedule: Schedule indicating locker number, serial number of the lock installed, key number, or combinations as applicable, for each locker. Submit schedule in spread sheet format. Submit three hard copies and one electronic file.
- E. Sample: Provide half size locker samples to Architect for approval showing all fasteners and door types for locks.

1.4 QUALITY ASSURANCE

- A. Regulatory Requirements:
 - 1. Accessibility Requirements: Comply with applicable requirements.
 - a. U.S. Architectural and Transportation Barriers Compliance Board Americans with Disabilities Act Accessibility Guidelines for Buildings and Facilities (ADAAG) 2010.
 - b. ICC/ANSI A117.1 Accessible and Useable Building and Facilities.
 - c. Texas Accessibility Standards (TAS) 2012.
- B. Source Limitations: Obtain metal lockers and accessories from single source from single locker manufacturer.
 - 1. Obtain locks from single lock manufacturer.
- C. Preinstallation Conference: Conduct conference at site.

1.5 WARRANTY

A. Warrant the work specified herein for ten (10) years against becoming unserviceable or causing an objectionable appearance resulting from either defective or nonconforming materials or workmanship.

- B. Defects shall include, but not be limited to, the following:
 - 1. Rapid deterioration of finish.
 - 2. Loose or missing parts.
 - 3. Non-functioning components and mechanisms.
 - 4. Rust, delamination, warp, rot or breakage.

PART 2 - PRODUCTS

2.1 MATERIALS

- A. Manufacturers: Subject to compliance with requirements, provide products by one of the following:
 - 1. ASI Storage Solutions, Inc., Memphis, TN (901) 312-6195
 - 2. DeBourgh Manufacturing Co., LaJunta, CO; (800) 328-8829
 - 3. Lockers MFG, Batesville, MS; (662) 338-4340.
 - 4. Superior Lockers as manufactured by List Industries, Inc. Deerfield Beach, FL; (800) 776-1342.
 - 5. Penco Products, Inc., Oaks, PA; (800) 562-1000
 - 6. Republic Storage Systems Co., Inc., Canton, OH; (800) 477-1255.
 - 7. WEC Manufacturing, Germantown, TN; (901) 367-3923.
- B. Locker: All welded construction; double tier:
 - 1. Material: Prime, high grade Class I mild annealed, cold-rolled steel.
 - 2. General Construction: Pre-assembled, welded seams and joints. Bolts, screws or rivets used in the assembly of the locker bodies are not permitted. Welds shall be free of burrs.
 - 3. Body: 16 gauge, flanged.
 - 4. Backs: 18 gauge, one-piece
 - 5. Door Frame: 16 gauge, channels or angles, with continuous door strike. Multiple tiered assemblies shall have intermediate cross frame welded to vertical framing members.
 - 6. Door: 14 gauge formed door constructed of single piece cold rolled steel with staggered 7/16 inch wide by 15/16 inch diamond perforations. Full channel shaped on lock side, formed channel formation on hinge side, right angle shaped on horizontal sides.
 - 7. Hinges: Two (2) inches high minimum, five (5) knuckle, full loop, tight pin. Weld to door and frame. Two (2) per door for lockers 42 inches high or less; three (3) per door for lockers over 42 inches high.
 - 8. Latching: one-piece, pre-lubricated spring steel, completely contained within the lock bar under tension to provide rattle-free operation. Provide three (3) latching points for lockers over 42 inches in height and two (2) latching points on for all tiered lockers 42 inches and under in height.
 - 9. Pre-Locking Device: Lockers shall be equipped with a positive automatic pre-locking device whereby the locker may be locked while the door is open and then closed without unlocking and without damaging the locking mechanism.
 - 10. Handles: Recessed, stainless steel with non-protruding lifting trigger.
 - 11. Number Plates: Aluminum with etched figures at least 3/8 inches high, attached near top of door with two (2) aluminum rivets. Number plates shall be in order as directed by the Architect.
 - 12. Finish: Baked enamel. Colors shall be as selected by Architect from manufacturer's standard colors. Lockers shall be painted inside and outside with the same color.
 - 13. Fasteners/Anchors: Provide fasteners and anchors of type, size and finish as recommended by manufacturer for attaching or anchoring lockers to walls and floor.
 - 14. Free-Standing Lockers: Provide front and end closed bases.
 - 15. Base: Lockers shall rest on bases as detailed on drawings.
 - 16. Locks: Master Lock Built-In Combination Locks with five (5) Master / Control keys and metal dial. Furnish locker/lock schedule as specified in Paragraph 1.2, D above.
 - 17. Top Closures, Closure Strips, and Fillers: Provide where shown, factory fabricated and finished to match lockers, unless noted otherwise.

C. Accessible Locker: Accessible lockers with recessed handles, single tier or the lower opening of double tier locker. Locker bottom shall be a minimum of 15 inches off the floor, or an extra shelf placed 15 inches off the floor with bottom or shelf turned down to close resultant opening.

2.3 LOCKER TYPES

- A. <u>Type "A" Athletic Lockers: 15 inches W by 15 inches D by 72 inches H. Welded athletic lockers</u>, double tier with a sloped top and four (4) inch high CMU base. Colors shall be as selected by Architect from manufacturer's standard colors.
- B. <u>Type "B" Athletic Lockers: 18 inches W by 18 inches D by 72 inches H. Welded athletic lockers,</u> single tier with a sloped top and four (4) inch high CMU base. Colors shall be as selected by Architect from manufacturer's standard colors.
- C. Type "C" Athletic <u>Theater Lockers: 1 foot 6 inches by 1 foot inches</u>.<u>12 inches W by 18 inches D</u> <u>by 60 inches H.</u> Welded <u>theater locker</u>, <u>single tier</u> Deluxe Collegiate Lockers without doors and with combination lock with and four (4) inch high CMU base. Colors shall be as selected by Architect from manufacturer's standard colors.

2.4 LOCKER ROOM BENCHES

- A. Benches:
 - 1. Bench Material: Shall be laminated hardwood maple.
 - 2. Size: Shall be 9-1/2 inches deep x 1-1/4 inch thick x lengths as shown on drawings.
 - 3. Finish: Manufacturer's two (2) coat clear acrylic finish.
- B. Pedestals:
 - 1. Manufacturer's heavy-duty cast iron pedestal supports not more than 6 feet-0 inches o.c., with provisions for attaching pedestals to bottom of bench and anchoring pedestals to floor.
 - 2. Height: 17-3/4 inches. 17-1/2 inches to meet ADA requirements.
 - 3. Finish: Manufacturer's baked enamel finish in selected color by Architect to match lockers, unless noted otherwise.
- C. Anchorages: Provide screw fasteners for attaching each pedestal to bottom of bench and two (2) suitable anchors per pedestal for anchoring pedestals to floor.

2.5 OTHER MATERIALS:

A. Provide other materials, not specifically described but required for a complete and proper locker installation.

PART 3 - EXECUTION

3.1 INSTALLATION

- A. Assemble and install lockers plumb, level, and flush in the locations shown on the drawings in accordance with the manufacturer's instructions. Lockers shall have no sharp metal edges.
- B. Install and anchor lockers to the floor and wall as instructed by the manufacturer.
- C. Install sloping hoods, metal fillers, end panels and trim to close openings, and accessories where shown on drawings or required to complete installation. Install using concealed fasteners. Provide flush hairline joints against adjacent surfaces.

D. Ensure number plates are installed in order directed by the Architect.

3.2 ADJUST AND CLEAN

- A. Adjust doors and latches to operate without binding and positive latching and automatic locking.
- B. Touch up marred finishes on lockers with manufacturer's supplied paint.

END OF SECTION 10 51 13

SECTION 12 66 13 - TELESCOPING BLEACHERS

PART 1 - GENERAL

1.1 RELATED DOCUMENTS

A. Drawings and general provisions of the Contract, including General and Supplementary Conditions and other Division 01 Specification Sections, apply to this Section.

1.2 WORK INCLUDED

A. Manufacture, deliver and install Telescopic Seating Systems in accordance with applicable codes, the following specifications, and approved drawings.

1.2 RELATED WORK BY OTHERS

- A. Adequate floor levelness and strength for operation of telescopic seating.
- B. Adequate wall strength for attachment and operation of wall attached telescopic seating.
- C. Electrical wiring within the building as required for power operated telescopic seating.
- D. Scoreboard controller connections and microphone jacks mounted in first step of bleacher riser boards.

1.3 SYSTEM DESCRIPTION

- A. Telescopic seating system shall be multiple tiered seating rows comprised of seat and deck components, risers, and supportive understructure.
- B. Telescopic seating shall be operable on the telescopic principle, stacking vertically in minimum floor area when not in use.
- C. The first moving row, on manual sections, shall be secured with release lever. All other rows shall be mechanically locked, operable only upon unlocking and cycling of first row. Power sections shall be secured with mechanical locks as well as the power system, operable upon activating the pendant control.

1.4 QUALITY ASSURANCE

- A. Design Load Criteria (Structural): International Building Code Standard: Comply with requirements of IBC / ICC 300, Chapter 4 "Standard for Bleachers, Folding and Telescopic Seating and Grandstands Assembly Seating," except where other requirements are indicated by the architect/owner.
- B. Partial Loading Requirements: Telescopic seating governed by IBC 2018, ICC-300 2017, NFPA 102 2016 or NFPA 5000 2018 shall all comply with ASCE 2016, Section 4.3.3 Partial Loading.
- C. Texas Accessibility Standards (TAS).
- D. Manufacturer: Company specializing in telescopic seating with a minimum of 25 years' experience in manufacturing telescopic seating.
- E. Engineer Qualifications: Manufacturer to employ a registered, licensed Professional Engineer to certify that the equipment to be supplied meets or exceeds the design criteria of this specification.
- F. Installation: Shall be handled directly by the manufacturer or by a factory certified installation subcontractor.
- G. Product Liability: Certification of insurance coverage of not less than \$5,000,000.
- H. Welding Processes: To be performed by certified professional welding operators in accordance with American Welding Society – Certified Welding Fabricator, (AWS-CWF), D1,1 "Structural Welding Code-Steel."

I. Product Improvements: Equipment provided shall incorporate manufacturer's design improvements and materials current at time of shipment, provided that such improvements and materials are consistent with the intent of these specifications.

1.5 SUBMITTALS

- A. Bid Submittals
 - 1. Manufacturer's descriptive literature and specifications.
 - 2. List of deviations from these specifications, if any.
 - 3. Certification of Insurance.
- B. Job Submittals
 - 1. Shop Drawings showing all equipment to be furnished with details of accessories to be supplied including necessary electrical service to be provided by others. All electrical submittals must include U.L. listing number.
 - 2. Samples of material and color finish as requested by Architect.
 - a. Submit two (2) 18 inch long samples of seat boards.
 - 3. Warranty, operation and maintenance instructions to the owner upon completion.

1.6 DESIGN CRITERIA

- A. Telescopic seating shall be designed to support, in addition to its own weight, and the weight of added accessories, a uniformly distributed live load of not less than 100 lbs. per sq. ft. (4.8 kN per sq. m.) of gross horizontal projection. Seat boards and footrest shall be designed for a live load of not less than 120 lbs. per linear foot (1.751 kN per linear m).
- B. Sway force applied to seats shall be 24 lbs. per linear ft. (350 N per linear m.) parallel to the seats and 10 lbs. per linear ft. (146 N per linear m.) perpendicular to the seats. Sway forces shall not be considered simultaneously applied.
- C. Railings, posts and sockets designed to withstand the following forces applied separately.
- D. Handrails shall be designed and constructed for:
 - 1. A concentrated load of 200 lbs. (890 N) applied at any point and in any direction.
 - 2. A uniform load of 50 lbs. per ft. (730 N/m) applied in any direction.

The concentrated and uniform loading conditions shall not be required to be applied simultaneously.

- E. Guards shall be designed and constructed for:
 - A concentrated load of 200 lbs. (890 N/m) applied at any point and in any direction along the top railing member and; a uniform load of 50 lbs. per ft. (730 N/m) applied horizontally at the required guardrail height and simultaneous uniform load of 100 lbs. per ft. (1460 N/m) applied vertically downward at the top of the guardrail. The concentrated and uniform loading conditions shall not be required to be applied simultaneously.
- F. American Institute of Steel Construction (AISC), American Iron and Steel Institute (AISI) and Aluminum Association (AA) design criteria shall be the basis for calculation of member sizes and connections.
- G. Wood members shall be designed in accordance with National Forest Products Association, (NFOPA), and National Design Specification for Wood Construction.

1.7 WARRANTY

A. The manufacturer shall warrant all work performed under these specifications to be free of defects for a period of one year.

TELESCOPING BLEACHERS 12 66 13 -2

- B. All understructure components shall be warranted for a period of ten years.
- C. Any materials found to be defective within this period will be replaced at no cost to the owner. This warranty shall not include replacements required by Acts of God, war, vandalism, flood, fire, calamity or deliberate abuse or misuse of the equipment.

PART 2 - PRODUCTS

2.1 ACCEPTABLE MANUFACTURERS

- A. Basis of Design: VersaTract Telescopic Seating System as manufactured by Irwin Seating Company - Telescopic Division, Altamont, IL 62411 or equal, subject to prior approval and strict compliance with these specifications. Other manufacturers must have a minimum of five (5) years experience manufacturing equivalent products to those specified and comply with Division 1 requirements regarding substitutions to be considered.
 - 1. Hussey Seating Co., North Berwick, ME; (207) 676-2271.
 - 2. Folding Bleacher Co., Subsidiary of Irwin Seating Company, Altamont, IL; (618) 483-6157
 - 3. Interkal, Inc., Kalamazoo, MI; (616) 349-1521

2.2 MATERIALS

- A. Seating Area: 1 Group, 91 Feet 6 Inches Long, 4 Rows High, Wall Attached, Electrically Operated.
- B. Dimensions:
 - 1. Overall height: 3 Feet 4 Inches
 - 2. Open depth: 7 Feet 7-1/8 Inches
 - 3. Closed depth: 3 Feet 7-1/8 Inches
 - 4. Row Spacing: 24 Inches
 - 5. Rise per row: 10 Inches

2.3 FABRICATION

- A. Understructure System:
 - Steel supports and rolling frames shall be constructed from formed steel of the size and shape necessary to support the design loads. All support bracing shall begin at Row 2 and be of diagonal or "knee" type for rigidity. Diagonal bracing to be minimum 1 1/2" x 1 1/2" 14-gauge square tubing. Bracing fabricated from open-sided channel, angle iron or flat strap "X" type bracing is unacceptable.
 - 2. Wheels shall not be less than 5" diameter x 1 3/8" non-marring soft rubber face to protect wood or synthetic floor surfaces. Each operating row shall have a minimum of 6 wheels.
 - 3. Each fully skirted wheel channel shall be formed 12-gauge steel and continuously in contact with adjacent channels by means of an Integral Alignment System (IAS) and include nylon glides to eliminate any metal to metal contact. The IAS maintains proper alignment between adjacent wheel channels for smooth and consistent operation while eliminating the potential for accidental row separation. Wheel channel alignment systems with metal to metal contact requiring periodic lubrication or that utilizes a guide rod system that can be bent or damaged will not be acceptable.
 - 4. Each cantilever arm shall be triple-formed 10-gauge steel, securely welded to the post assembly and include a nylon cantilever pad to ensure smooth operation. The cantilever pad shall also provide a firm base when in the occupied position and provide a solid feel when walked on.

- 5. Vertical columns shall be high tensile steel structural tube to meet design criteria. Minimum column size to be 2" x 3" 14-gauge structural tube, welded to a 2' wide wheel channel using 360 degrees of weldment.
- 6. Deck support members shall be double formed 14-gauge steel and connect the front nosing and rear riser members. Each deck support shall include a unique dual-purpose roller that provides smooth support during operation. The deck support roller shall also include a 3/4" wide shoulder that's encapsulated by the deck support on the row above in order to maintain proper upper alignment while delivering consistent, repeatable operation.
- B. Seat Systems:
 - 1. Infinity Seat: Supply plastic modular 18" individual seats in 10" deep models. Seating to be scuff resistant injection molded high density polyethylene plastic.
 - a. Seat modules supplied shall be of a high aesthetic design using multiple textures, style lines and a waterfall front. The rear of the seat shall be slightly curved to eliminate the straight line appearance and include a moderate seat contour and texture to enhance spectator comfort.
 - b. Seating design shall be molded to achieve a finished end appearance without the use of end caps. The rear of the seat shall include a smooth wall allowing for the deck to be easily swept clean without obstruction.
 - c. Seat heights shall be maintained at a minimum of 16 3/4". Lower seat heights which detour from spectator comfort will not be accepted.
 - d. Foot space shall be maximized for spectator comfort and provide a minimum of 22" when measured with a 10" module and 21" with a 12" module.
 - e. Each seat to be designed with the capability of using seat numbers and row letters at the aisle locations. Seat numbers to be stylishly designed using a radius corner to enhance the aesthetic value of the seat. Seat numbers and row letters shall be recessed into the seat to protect against any vandalism.
 - f. Select seating colors from manufacturer's 15 standard colors. Custom colors available as an option.
 - g. Securely fasten each seat to the nose beam using a 10-gauge formed steel bracket and locking hardware. Adjacent seating shall be interlocked together along the full perimeter eliminating any fore or aft movement or the potential of any pinching hazard.
 - h. Seat modules shall be designed to support a uniform load of 600 lbs per seat and a concentrated load of 150 lbs over 4 square inches.
- C. Deck System:
 - 1. Clear Coat decking shall be finished using a two-pass UV topcoat process for maximum appearance and durability. Each of the two finishing cycles shall consist of a pass through the clear polyurethane roller coating, followed by a UV activation process permanently setting the finish. Each plywood panel shall be constructed from AC grade 5-ply western fir plywood with a high quality Radiata Pine face ply in strict compliance with U.S. Product Standard PS 195. Plywood shall be supported along the front and back edge for maximum rigidity and designed in a manner that allows 3 plies to run front to back for increased deck strength. Each plywood panel shall be connected using a tongue and groove splice leaving the deck clean and free of any tripping or cleaning obstructions. Plywood using a single coat of finish or applied without the UV setting process that will show wear faster is unacceptable. Decking shall be secured in place by the encapsulation of the rear riser and mechanical fasteners along the front edge. Finish thickness to be 5/8".

TELESCOPING BLEACHERS 12 66 13 -4

- D. Nosing:
 - 1. Nosing shall be one piece, formed, 14-gauge steel with a minimum G-60 pre-galvanized finish.
- E. Rear Risers:
 - 1. Rear riser shall be one piece, formed, 14-gauge steel with a minimum G-60 pregalvanized finish.
- F. Finish: For rust resistance in standard conditions all painted surfaces shall be finished in textured Epoxy Powder Coated Semi-Gloss Black.

2.4 ACCESSORIES

- A. Aisles shall be footrest level 48 inches wide to provide 3 aisles. Aisles at the footrest level shall include non-slip treads on the top front edge.
- B. Intermediate aisle steps shall be provided. Steps are permanently attached closed design. Steps shall be constructed from 14 ga. steel, finished in a Black powder coated epoxy, and designed to eliminate any possible toe catch between the top of the intermediate step and the bottom of the nose beam per ADA or other applicable codes. Front step shall be removable and interlock to the front row eliminating any possibility of accidental disengagement, and store on the front row when not in use.
- C. Aisle handrails.
 - Smart Rail aisle handrails shall be provided for 22" to 26" row spacing. Aisle railings shall quickly and easily rotate 90 degrees to the locked position and store parallel to the front of the aisle. Railings that require removal from the pocket or the use of tools for storage will not be acceptable. Aisle railings shall be an individual rail design, located on every other row starting at row two (2). Railing to be constructed of 1 1/2" 11 ga. round steel tubing, finished in a textured powder coated epoxy. For safety, railings designed without a full return of the handrail will not be acceptable.
- D. Wheel Chair Seating Areas.
 - 1. Recoverable wheel chair spaces with recoverable rail shall be provided at the section joint location or section length as shown on plans. An integral support on row two shall be provided to eliminate structural damage to the understructure during the operation and use of the system. Recoverable seating areas do not require front railings for support.
- E. End rails.
 - 1. End rails of the self-storing type, finished with textured epoxy powder-coated black enamel, shall be provided at the open ends of the group. End rails shall start at row three and be constructed from 1" square tubing to meet all national building codes. Railings with flexible uprights that can be expanded beyond the 4" sphere are not acceptable.
- F. End panels of plywood and supports shall be provided to enclose the open ends of the group in the closed position. End panels shall enclose the space between the wall and the back of the self-storing end rails. End panels to be constructed from Panelam or clear coat plywood.
- G. Scorer's table shall be 8' long x 18" wide and feature a speckled grey blow molded top. Table to include cantilevered folding legs designed to fit within the seating row without the need for mounting sockets, or for use on the floor in front of the stand.
- H. Seat level rear filler panels up to 21" deep used to close openings between top row seat and wall. Provide adequate support structure below the closure panel that will allow for spectators to safely stand in this area. Closure panel to match the deck surface.
- N. Infinity Seat Spacer.

- Infinity seat spacers shall be supplied as indicated on architectural drawings. Seat spacers to be 4 1/2" wide with a contoured shape matching that of the adjacent seat modules, and available in 15 matching or contrasting standard colors. Seat spacers to be constructed using the same material, design, durability and attachment method as the Infinity seat module.
- 2. Infinity seat spacers shall be supplied as indicated on architectural drawings. Seat spacers to be 6" wide with a contoured shape matching that of the adjacent seat modules, and available in 15 matching or contrasting standard colors. Seat spacers to be constructed using the same material, design, durability and attachment method as the Infinity seat module.

2.5 PROPULSION SYSTEM

- A. Friction Power: Integra Drive System (IDS) shall be furnished on each seating group to open and close the telescopic units. Each individual section shall include 2 IDS friction drive systems integrated into the first moving row of understructure to achieve smooth and efficient operation. Operation of the seating shall be accomplished with the use of a walk along pendant control.
 - Each IDS power system shall include large 6 1/2" diameter friction rollers to develop tractive force adequate to open and close the system. Each roller to include non-marring 1/2" thick rubber covering.
 - 2. Electrical motors for each section shall be heavy-duty and high efficiency gear reduction motors. The shaft diameter for the gear motor and rollers shall be a minimum of 1" and be connected by a 1" schedule 40 drive shaft.
 - 3. All roller chain and sprockets used throughout the drive system shall be a minimum of #40 in size. Each drive unit shall be designed to include a safety shroud around the chain and sprocket for overall safety.
 - 4. The power units shall develop tractive forces adequate to operate the seating units under normal conditions but inadequate to operate should significant obstacles be encountered.
- B. Manufacturer shall provide all wiring from power source within bleacher seating including Key Switch control. Key Switch control shall be wall mounted with controls to open and close the system. Electrical contractor shall provide a 60 HZ power source (as specified below) to the Key Switch wall location. Amperage to be as specified by seating manufacturer depending on the number of power units required. For wall-attached installations, power source to terminate in a surface mounted junction box above floor. All electrical parts and wiring shall be installed in complete accord with the National Electric Code. U.L. Listing FHJU.E479554.

Supply power system with 208/230V, 5 wire 3-phase system.

PART 3 - EXECUTION

3.1 REVIEWS AND APPROVALS

A. Shop drawings shall be approved and job site field measurements taken prior to installation and telescopic gym seating shall be installed in conformance therewith.

3.2 SURFACE CONDITIONS

- A. Examine the areas and conditions under which Work of this Section will be performed.
- B. Verify flooring is level and rear wall is plumb within 1/8 inch in 8 feet-0 inches.
- C. Bring discrepancies and unsatisfactory conditions to the attention of the Architect and do not proceed until such discrepancies and unsatisfactory conditions are corrected.

3.3 INSTALLATION

A. The installation of the telescopic gym seating will be handled directly by the manufacturer or by a factory authorized installation subcontractor qualified to perform the installation function.

3.3 PROTECTION

- A. The manufacturer's representative shall transmit instructions in both operation and maintenance to the owner.
- B. Maintenance and operation of the telescopic gym seating shall be the responsibility of the owner or his duly authorized representative, and shall include the following:
 - 1. During operation of the telescopic gym seating, the opening and closing shall be supervised by responsible personnel who will assure that the operation is in accordance with the manufacturer's instructions.
 - 2. Only attachments specifically approved by the manufacturer for the specific installation shall be attached to the telescopic gym seating.
 - 3. An annual inspection and required maintenance of all telescopic gym seating shall be performed to assure safe conditions. At least bi-annually, the inspection shall be performed by a Professional Engineer or factory service personnel.

END OF SECTION 12 66 13

SECTION 14 24 00 - HYDRAULIC ELEVATOR

PART 1 - GENERAL

1.1 RELATED DOCUMENTS

A. Drawings and general provisions of the Contract, including General and Supplementary Conditions and other Division 01 Specification Sections, apply to this Section.

1.2 SUMMARY

- A. Section includes: Requirements including but not limited to:
 - 1. Hydraulic passenger elevators.
 - 2. Equipment, machines, controls, systems and devices necessary for operation.
 - 3. Materials and accessories necessary to complete the elevator installation.

1.3 **DEFINITIONS**

- A. Defective Elevator Work: Operation or control system failure, including excessive malfunctions; performances below specified ratings; excessive wear; unusual deterioration or aging of materials or finishes; unsafe conditions; need for excessive maintenance; abnormal noise or vibration; and similar unusual, unexpected, and unsatisfactory conditions.
- B. Definitions in ASME A17.1/CSA B44 apply to work.
- C. Service Elevator: A passenger elevator that is also used to carry freight.

1.4 SUBMITTALS

- A. Product Data: Technical data including capacities, sizes, performances, operations, safety features, finishes, and similar information. Include product data for car enclosures; hoistway entrances; and operation, control, and signal systems.
- B. Shop Drawings: Submit plans, elevations, sections, and large scale details indicating service at each landing; machine room layout; coordination with building structure; relationships with other construction; and locations of equipment.
 - 1. Include large scale layout of car control station.
 - 2. Indicate maximum dynamic and static loads imposed on building structure at points of support as well as maximum and average power demands.
- C. Manufacturer Certificates: Signed by elevator manufacturer, certifying that hoistway, pit, and machine room layout and dimensions, shown on Drawings, and electrical service, shown and specified, are adequate for elevator system being provided.
- D. Submittals:
 - 1. Inspection and Acceptance Certificates and Operating Permits: As required by authorities having jurisdiction for normal, unrestricted elevator use.
 - 2. Set of service tools.
 - 3. Provide one electronic copy and two hard copies of manuals and inspection reports. Provide two complete printed sets of service, parts, schematic diagrams and adjustment manuals. Prints required by state code for each elevator.
 - 4. Provide four copies of independent service keys. Provide 4 factory cut keys for every lock on each elevator and label use. Provide two extra copies of the independent service key for a total of 6 keys.

- 5. Final inspection by the state inspector shall have a School District representative present to observe. Complete the final documentation for the State Inspection and return to the School District Maintenance Department.
 - a. The Owner shall apply for the operation/inspection certificate provided by the State Inspector. Cost of the state inspection shall be paid by the elevator subcontractor/ manufacturer.
- E. Operation and Maintenance Data: Submit for elevators to include in emergency, operation, and maintenance manuals and parts list, with recommended parts inventory.
- F. Inspection and Acceptance Certificates and Operating Permits: Required by authorities having jurisdiction for normal, unrestricted elevator use.
- G. Continuing Maintenance Proposal: Submit a continuing maintenance proposal from Installer to Owner, in the form of a two year maintenance agreement, starting on date initial maintenance service is concluded. State services, obligations, conditions, and terms for agreement period and for future renewal options. Maintenance agreement includes but is not limited to:
 - 1. Systematic examination, adjustment, and lubrication of all elevator equipment.
 - 2. Repair or replacement of electrical and mechanical parts of the elevator installation as required, using only the genuine standard parts approved for the original installation.
 - 3. Maintenance work as required during regular working hours and regular working days, but with emergency callback service available at all times during this maintenance period.

1.5 QUALITY ASSURANCE

- A. Regulatory Requirements:
 - 1. Building Code: Comply with applicable provisions of the IBC and the Elevator Code.
 - 2. Elevator Standard: Comply with ASME A17.1/CSA B44.
 - 3. Fire Rated Hoistway Entrance Assemblies: Door and frame assemblies complying with NFPA 80 that are listed and labeled by a testing and inspecting agency acceptable to authorities having jurisdiction, for fire protection ratings indicated, based on testing at as close to neutral pressure as possible according to NFPA 252 and IBC.
 - 4. Accessibility Requirements: Comply with applicable requirements.
 - a. U.S. Architectural and Transportation Barriers Compliance Board Americans with Disabilities Act Accessibility Guidelines for Buildings and Facilities (ADAAG) 2010.
 - b. ICC/ANSI A117.1 Accessible and Useable Building and Facilities.
 - c. Texas Accessibility Standards (TAS) 2012.
- B. Manufacturer/Installer Qualifications: Elevator manufacturer having minimum 10 years documented experience who is trained and approved by manufacturer, including but not limited to:
 - 1. Manufacturer of the power unit, controller, signal fixtures, door operators cab, entrances, and other major parts of the elevator operating equipment.
 - 2. Primary and major equipment components are manufactured in the United States and are not be an assembled system.
 - 3. Documented, ongoing quality assurance program.
- C. Source Limitations: Obtain elevators through one source from a single manufacturer.
 - 1. Provide major elevator components, including pump and tank units, plunger-cylinder assemblies, controllers, signal fixtures, door operators, car frames, cabs, and entrances, manufactured by a single manufacturer.
- D. Inspection and Testing: Elevator Installer shall obtain and pay for required inspections, tests, permits and fees for elevator installation.
 - 1. Arrange for inspections and make required tests.
 - 2. Deliver documentation to the Owner upon completion and acceptance of elevator work.

1.6 DELIVERY, STORAGE, AND HANDLING

A. Deliver, store, and handle materials, components and equipment in manufacturer protective packaging. Store materials, components, and equipment off of ground, under cover, and in a dry location.

1.7 COORDINATION

- A. Coordinate dimensions with structure, walls, and adjacent features.
- B. Coordinate installation of sleeves, block outs, elevator equipment with integral anchors, and other items embedded in concrete or masonry for elevator equipment. Furnish templates, sleeves, elevator equipment with integral anchors, and installation instructions and deliver to Project site in time for installation.
- C. Furnish well casing and coordinate delivery with related excavation work.
- D. Coordinate locations and dimensions of other work specified that relates to hydraulic elevators, including pit ladders; sumps and floor drains in pits; entrance subsills; electrical service; and electrical outlets, lights, and switches in hoistways, pits, and machine rooms.

1.8 WARRANTY

- A. Written warranty signed by manufacturer in which manufacturer agrees to repair, restore, or replace elevator work that fails in materials or workmanship within specified warranty period.
 - 1. Failures include, but are not limited to, operation or control system failure, including excessive malfunctions; performances below specified ratings; excessive wear; unusual deterioration or aging of materials or finishes; unsafe conditions; need for excessive maintenance; abnormal noise or vibration; and similar unusual, unexpected, and unsatisfactory conditions.
 - 2. Warranty Period: 2 year(s) from date of Substantial Completion.

PART 2 - PRODUCTS

2.1 MATERIALS

- A. Manufacturer: Hydrofit by Otis Elevator <u>or equivalent product approved by Addendum prior to the</u> <u>date of the Proposal Submissions. Manufacturers listed whose product meets or exceed the</u> <u>specifications may be used on the Project. Other manufacturers must have a minimum of five (5)</u> <u>years experience manufacturing products meeting or exceeding the specifications and comply</u> with Division 1 requirements regarding substitutions in order to be considered
 - 1. Kone Elevators.
 - 2. Thyssen Krupp.
 - 3. Schindler Elevator Corporation.
- B. Elevator System: Machine roomless, holeless hydraulic elevator system with standard components included in elevator systems necessary for complete system.
- C. Elevator Description:
 - 1. Rated Load: 2500 lb.
 - 2. Rated Speed: 125 fpm.
 - 3. Operation System: Single automatic operation.
 - 4. Stops: 2.
 - 5. Openings: Front and Rear.
 - 6. Travel: <u>9'-3" 160</u> inches.

- 7. Clear Inside Dimensions: 6' 5 9/16" x 4' 4 1/8".
- 8. Cab Height: 93 inches.
- 9. Clear Cab Height: 7'-4 5/16" (2243 mm)
- 10. Entrance Type and Width: Single Slide 3'6".
- 11. Entrance Height: 84 inches.
- 12. Main Power Supply: 480 volts \pm 5% of normal, three-phase, with a separate equipment grounding conductor.
- 13. Operation: Simplex Collective Operation: Using a microprocessor-based controller, operation shall be automatic by means of the car and hall buttons. If all calls in the system have been answered, the car shall park at the last landing served.
- 14. Car Lighting Power Supply: 120 volts, single-phase, 15 amps, 60 Hz.
- 15. Car Enclosures:
 - a. Front Walls (Return Panels): Satin stainless steel, No. 4 finish with integral car door frames.
 - b. Car Fixtures: Satin stainless steel, No. 4 finish.
 - c. Side and Rear Wall Panels: Satin stainless steel, No. 4 finish.
 - d. Reveals: Black.
 - e. Door Faces (Interior): Satin stainless steel, No. 4 finish.
 - f. Door Sills: Nickel silver.
 - g. Ceiling: Luminous ceiling.
 - h. Handrails: 1/2 inch by 2 inches (13 by 50 mm) rectangular, at rear of car.
 - i. Floor prepared to receive resilient tile flooring to match existing flooring in adjacent corridor.
- 16. Hoistway Entrances:
 - a. Type: Single speed center opening.
 - b. Frames: Satin stainless steel, No. 4 finish.
 - c. Doors: Satin stainless steel, No. 4 finish.
 - d. Sills: Nickel silver.
- 17. Hall Fixtures: Satin stainless steel, No. 4 finish.
- 18. Additional Requirements:
 - a. Provide inspection certificate in each car, mounted under acrylic cover with frame made from satin stainless steel, No. 4 finish.
 - b. Provide hooks for protective pads and one complete set of full height protective pads.

2.2 SYSTEMS AND COMPONENTS

- A. Pump Units: Positive displacement type with a maximum of 10 percent variation between no load and full load and with minimum pulsations.
 - 1. Pump shall be submersible type with submersible squirrel cage induction motor, and shall be suspended inside oil tank from vibration isolation mounts.
 - 2. Motor shall have solid state starting.
 - 3. Motor shall have variable voltage, variable frequency control.
- B. Hydraulic Silencers: System shall have hydraulic silencer containing pulsation absorbing material in blowout proof housing at pump unit.
- C. Piping: Size, type, and weight of piping as recommended by elevator manufacturer, with flexible connectors to minimize sound and vibration transmissions from power unit.
 - 1. Cylinder units shall be connected with dielectric couplings.
 - 2. Casing for Underground Piping: Schedule 40 PVC pipe complying with ASTM D 1785, joined with PVC fittings complying with ASTM D 2466 and solvent cement complying with ASTM D 2564.

- D. Hydraulic Fluid: Nontoxic, biodegradable, fire resistant fluid, made from vegetable oil with antioxidant, anticorrosive, antifoaming, and metal passivating additives, that is approved by elevator manufacturer for use with elevator equipment.
- E. Inserts: Furnish required concrete and masonry inserts and similar anchorage devices for installing guide rails, machinery, and other components of elevator work. Device installation is specified Section 055000.
- F. Protective Cylinder Casing: PVC or HDPE pipe casing complying with ASME A17.1/CSA B44, of sufficient size to provide not less than 1 inch (25 mm) clearance from cylinder and extending above pit floor. Casing shall have means of monitoring effectiveness to comply with ASME A17.1/CSA B44.
- G. Corrosion Protective Filler: A nontoxic, petroleum based gel formulated for filling the space between hydraulic cylinder and protective casing. Filler shall be electrically nonconductive, displace or absorb water, and gel or solidify at temperatures below 60 degrees F (16 degrees C).
- H. Car Frame and Platform: Welded steel units.
- I. Guides: Roller guides; provide guides at top and bottom of car frame.

2.3 OPERATION SYSTEMS

- A. Provide standard microprocessor operation system required to provide type of operation indicated.
- B. Auxiliary Operations:
 - 1. Single Car Standby Powered Lowering: On activation of standby power, car is lowered to the lowest floor, opens its doors, and shuts down.
 - 2. Automatic Operation of Lights and Fan: When elevator is stopped and unoccupied with doors closed, lighting, ventilation fan, and cab displays are de-energized after 5 minutes and are re-energized before car doors open.

2.4 DOOR REOPENING DEVICES

- A. Infrared Array: Provide door-reopening device with uniform array of 36 or more microprocessorcontrolled, infrared light beams projecting across car entrance. Interruption of one or more light beams shall cause doors to stop and reopen.
- B. Nudging Feature: After car doors are prevented from closing for predetermined adjustable time, through activating door-reopening device, a loud buzzer shall sound and doors shall begin to close at reduced kinetic energy.

2.5 CAR ENCLOSURES

- A. Provide steel framed car enclosures with nonremovable wall panels, with **r**emovable car roof, access doors, power door operators, and ventilation.
 - 1. Provide standard railings complying with ASME A17.1/CSA B44 on car tops where required by ASME A17.1/CSA B44.
- B. Materials and Finishes: Standards, but not less than the following:
 - 1. Subfloor: Exterior, underlayment grade plywood, not less than 5/8 inch (15.9 mm) nominal thickness.
 - 2. Floor Finish: Refer to Section 096500.

- 3. Stainless Steel Wall Panels: Flush, formed metal construction; fabricated from stainless steel sheet.
- 4. Fabricate car with recesses and cutouts for signal equipment.
- 5. Fabricate car door frame integrally with front wall of car.
- 6. Stainless Steel Doors: Flush, hollow metal construction; fabricated from stainless steel sheet or by laminating stainless steel sheet to exposed faces and edges of enameled or powder coated steel doors using adhesive that fully bonds metal to metal without telegraphing or oil-canning.
- 7. Sight Guards: Provide sight guards on car doors.
- 8. Sills: Extruded or machined metal, with grooved surface, 1/4 inch (6.4 mm) thick.
- 9. Luminous Ceiling: Fluorescent light fixtures and ceiling panels of translucent acrylic or other permanent rigid plastic.
- 10. Light Fixture Efficiency: Not less than 35 lumens/W.
- 11. Ventilation Fan Efficiency: Not less than 3.0 cfm/W (1.4 L/s per W).

2.6 HOISTWAY ENTRANCES

- A. Hoistway Entrance Assemblies: Horizontal sliding, door and frame hoistway entrances complete with track systems, hardware, sills, and accessories. Frame size and profile shall accommodate hoistway wall construction.
 - 1. Where gypsum board wall construction is indicated, frames shall be self supporting with reinforced head sections.
- B. Fire Rated Hoistway Entrance Assemblies: Door and frame assemblies shall comply with NFPA 80 and be listed and labeled by a testing and inspecting agency acceptable to authorities having jurisdiction based on testing at as close-to-neutral pressure as possible according to NFPA 252 or UL 10B.
 - 1. Fire Protection Rating: 1 hour with 30 minute temperature rise of 450 degrees F (250 degrees C).
- C. Materials and Fabrication: Standard, but not less than the following:
 - 1. Steel Subframes: Formed from cold or hot rolled steel sheet, with factory applied enamel or powder coat finish or rust resistant primer. Fabricate to receive applied finish as indicated.
 - 2. Stainless Steel Frames: Formed from stainless steel sheet.
 - 3. Stainless Steel Doors: Flush, hollow metal construction; fabricated from stainless steel sheet or by laminating stainless steel sheet to exposed faces and edges of enameled or powder coated steel doors using adhesive that fully bonds metal to metal without telegraphing or oil canning.
 - 4. Sight Guards: Provide sight guards on doors matching door edges.
 - 5. Sills: Extruded or machined metal, with grooved surface, 1/4 inch (6.4 mm) thick.
 - 6. Nonshrink, Nonmetallic Grout: Factory packaged, nonstaining, noncorrosive, nongaseous grout complying with ASTM C 1107/C 1107M.

2.7 SIGNAL EQUIPMENT

- A. Provide hall call and car call buttons that light when activated and remain lit until call has been fulfilled. Provide vandal resistant buttons and lighted elements illuminated with LEDs.
- B. Car Control Stations: Provide recessed or semirecessed car control stations. Mount in return panel adjacent to car door unless otherwise indicated.
 - 1. Mark buttons and switches for required use or function. Use both tactile symbols and Braille.
 - 2. Provide "No Smoking" sign matching car control station, either integral with car control station or mounted adjacent to it, with text and graphics as required by authorities having jurisdiction.

- C. Emergency Communication System: Two way voice communication system, with visible signal, which dials preprogrammed number of monitoring station and does not require handset use. System is contained in flush mounted cabinet, with identification, instructions for use, and battery backup power supply.
- D. Firefighters' Two Way Telephone Communication Service: Provide flush mounted cabinet and required conductors in traveling cable for firefighters' two way telephone communication service.
- E. Car Position Indicator: Provide digital type car position indicator, located above car door or above car control station. Provide audible signal to indicate to passengers that car is either stopping at or passing each of the floors served. Include travel direction arrows if not provided in car-control station.
- F. Hall Push Button Stations: Provide one hall push button station at each landing.
 - 1. Provide units with flat faceplate for mounting with body of unit recessed in wall.
 - 2. Equip units with buttons for calling elevator and for indicating applicable direction of travel.
- G. Hall Lanterns: Units with illuminated arrows; however, provide single arrow at terminal landings. Provide the following:
 - 1. Wall mounted units, for mounting above entrance frames.
- H. Hall Annunciator: With each hall lantern, provide audible signals indicating car arrival and direction of travel. Signals sound once for up and twice for down.
 - 1. At manufacturer's option, audible signals may be placed on cars.
- I. Hall Position Indicators: Provide digital display type position indicators, located above hoistway entrance at ground floor.
 - 1. Provide units with flat faceplate for mounting and with body of unit recessed in wall.
 - 2. Integrate ground floor hall lanterns with hall position indicators.
- J. Standby Power Elevator Selector Switches: Provide switches, required by ASME A17.1/CSA B44, where indicated. Adjacent to switches, provide illuminated signal that indicates when normal power supply has failed.
- K. Fire Command Center Annunciator Panel: Provide panel containing illuminated position indicators for each elevator, clearly labeled with elevator designation; include illuminated signal that indicates when elevator is operational and when it is at the designated emergency return level with doors open. Provide standby power elevator selector switch(es), required by ASME A17.1/CSA B44, adjacent to position indicators. Provide illuminated signal that indicates when normal power supply has failed.
- L. Emergency Pictorial Signs: Fabricate from materials matching hall push button stations, with text and graphics as required by authorities having jurisdiction, indicating that in case of fire, elevators are out of service and exits should be used instead. Provide one sign at each hall push-button station unless otherwise indicated.

2.8 FINISH MATERIALS

- A. Cold Rolled Steel Sheet: ASTM A 1008/A 1008M, commercial steel, Type B, exposed, matte finish.
- B. Hot Rolled Steel Sheet: ASTM A 1011/A 1011M, commercial steel, Type B, pickled.
- C. Stainless Steel Sheet: ASTM A 240/A 240M, Type 304.

- D. Textured Stainless Steel Sheet: ASTM A 240/A 240M, Type 304, with embossed texture rolled into exposed surface.
- E. Stainless Steel Bars: ASTM A 276, Type 304.
- F. Stainless Steel Tubing: ASTM A 554, Grade MT 304.
- G. Aluminum Extrusions: ASTM B 221 (ASTM B 221M), Alloy 6063.
- H. Nickel Silver Extrusions: ASTM B 151/B 151M, Alloy UNS No. C74500 or No. C77600.

PART 3 - EXECUTION

3.1 EXAMINATION

- A. Examine elevator areas for compliance with requirements for installation tolerances and other conditions affecting performance of the Work. Verify critical dimensions and examine supporting structure and other conditions under which elevator work is to be installed.
- B. Prepare written report listing conditions detrimental to performance of the work.
- C. Proceed with installation after correcting unsatisfactory conditions.

3.2 INSTALLATION

- A. Install cylinder plumb and accurately centered for elevator car position and travel. Anchor securely in place, supported at pit floor and braced at intervals as needed to maintain alignment. Anchor cylinder guides at spacing needed to maintain alignment and avoid overstressing guides.
- B. Welded Construction: Provide welded connections for installing elevator work where bolted connections are not required for subsequent removal or for normal operation, adjustment, inspection, maintenance, and replacement of worn parts. Comply with AWS workmanship and welding operator qualification standards.
- C. Sound Isolation: Mount rotating and vibrating equipment on vibration-isolating mounts to minimize vibration transmission to structure and structure-borne noise due to elevator system.
- D. Install piping above the floor, where possible. Install underground piping in casing.
 1. Excavate for piping and backfill encased piping according to applicable requirements.
- E. Lubricate operating parts of systems recommended by manufacturers.
- F. Alignment: Coordinate installation of hoistway entrances with installation of elevator guide rails for accurate alignment of entrances with car. Where possible, delay installation of sills and frames until car is operable in shaft. Reduce clearances to minimum, safe, workable dimension at each landing.
- G. Leveling Tolerance: 1/4 inch (6 mm), up or down, regardless of load and travel direction.
- H. Set sills flush with finished floor surface at landing. Fill space under sill solidly with nonshrink, nonmetallic grout.
- I. Locate hall signal equipment for elevators as follows unless otherwise indicated:

- 1. Place hall lanterns either above or beside hoistway entrance.
- 2. Mount hall lanterns at a minimum of 72 inches (1829 mm) above finished floor.

3.3 FIELD QUALITY CONTROL

- A. Acceptance Testing: On completion of elevator installation and before permitting elevator use (either temporary or permanent), perform acceptance tests as required and recommended by ASME A17.1/CSA B44 and by governing regulations and agencies.
- B. Advise Owner, Architect, and authorities having jurisdiction in advance of dates and times that tests are to be performed on elevators.

3.4 **PROTECTION**

A. Temporary Use: Do not use elevator for construction purposes:

3.5 DEMONSTRATION

- A. Engage a factory authorized service representative to train Owner's maintenance personnel to operate, adjust, and maintain elevator.
- B. Check operation of elevator with Owner's personnel present before date of Substantial Completion and again not more than one month before end of warranty period. Determine that operation systems and devices are functioning properly.

3.6 MAINTENANCE

- A. Initial Maintenance Service: Beginning at Substantial Completion, maintenance service shall include 24 months' full maintenance by skilled employees of elevator Installer. Include monthly preventive maintenance, repair or replacement of worn or defective components, lubrication, cleaning, and adjusting as required for proper elevator operation. Parts and supplies shall be manufacturer's authorized replacement parts and supplies.
 - 1. Perform maintenance during normal working hours.
 - 2. Perform emergency callback service during normal working hours with response time of two hours or less.

END OF SECTION 14 24 00

SECTION 27 10 00- STRUCTURED CABLING SYSTEM

CONDITIONS OF THE CONTRACT AND DIVISION 1, as applicable, apply to this Section.

PART 1 - GENERAL

1.1 DESCRIPTION

- A. Summary of Work:
 - Provide a complete and tested cable distribution system for data interconnections (Local Area Network). The data distribution system shall include fully terminated unshielded twisted pair cables, fiber optic cabling, raceways, conduit, UTP termination devices, data communications outlets, fiber enclosures, patch panels, patch cables, network racks, and other incidental and miscellaneous premises wiring system hardware as required for a complete and usable system. The installation shall comply with all applicable codes and standards in effect at the job site and as indicated in the Drawings and Specifications.

1.2 QUALITY ASSURANCE

- A. Acceptable manufacturers:
 - 1. The equipment/products described herein, and furnished per these specifications shall be the product of one manufacturer. All references to model numbers and other detailed descriptive data is intended to establish standards of design performance, and quality, as required.
 - 2. Acceptable product shall be a complete category 6 solution as manufactured by CommScope/Uniprise. No other product will be accepted.
- B. Installer Qualifications:
 - 1. The Data Cable System Installer shall be licensed and shall meet all applicable regulations of the State of Texas and Department of Labor insofar as they apply to this type of system. The proposer shall be a firm normally employed in the low voltage and data cabling industry and shall provide a reference list of five (5) large-scale projects and contact names confirming successful Category 6 premises wiring system installations.
 - 2 The Data Cable System Installer shall be a CommScope/Uniprise certified, local area, V.A.R. (Value Added Reseller) and must hold current V.A.R. certification.
- C. Pre-Construction Meeting:
 - 1. The successful Contractor shall attend a mandatory pre-construction meeting with individuals deemed necessary by the Owner's representative prior to the start of the work.
- D. Acceptance:
 - 1. The Owner's representative reserves the right to reject all or a portion of the work performed, either on technical or aesthetic grounds.
- E. Warranty:
 - 1. The selected system installer shall be a certified installing contractor of product and hold current certification. Contractor shall be shall provide an end-to-end performance warranty of not less than twenty (25) years on all products installed. The proposer shall provide current certification documentation. The performance warranty shall be issued by the manufacturer and shall warrant that ALL Enhanced Category 6 cable links have been tested bi-directionally (end to end)

using a Level 2 tester, per TSB-67, and that all test results conform to the most current TIA/EIA-568-A and/or TSB-67 Link values.

- 2. The warranty will also cover singlemode fiber optic cabling. Performance testing shall be conducted in accordance with ANSI/EIA/TIA-526-14 Standard, method B.
- 3. The warranty will stipulate that all products used in this installation meet the prescribed mechanical and transmission specifications for such products as described in ISO/IEC 11801, ANSI/TIA/EIA-568-A, or EN 50173. Quality and workmanship evaluation shall be solely by the Owner/Designer and designated representatives.

1.3 **REGULATORY REQUIREMENTS**

- A. Standards: All work shall be performed in accordance with the latest revisions of the following standards and codes:
 - 1. Latest Local Codes and Amendments
 - 2. 2015 or current National Electrical Code
- B. Other References:

O anor		
1.	TIA/EIA-568-A	Commercial Building Telecommunications Wiring Standard
2.	EIA/TIA-569	Commercial Building Standard for Telecommunication Pathways and Spaces.
3.	TIA/EIA-606	The Administration Standard for the Telecommunications Infrastructure of Commercial Buildings.
4.	TIA/EIA-607	Commercial Building Grounding and Bonding Requirements for Telecommunications.
5.	EIA/TIA 455-A	Standard Test Procedure for Fiber Optic Fibers, Cables, Transducers, Sensors, Connecting and Terminating Devices and Other Fiber Optic Components.
6.	TIA/EIA TSB 67	Transmission Performance Specification for Field Testing of Unshielded Twisted-Pair Cabling Systems.
7.	TIA/EIA TSB 72	Centralized Optical Fiber Cabling Guidelines
8.	ISO/IEC 11801	Generic Cabling Standard
9.	EN 50173	Generic Cabling Standards for Customer Premises
10.	ANSI/EIA/TIA 526-14	Optical Power Loss Measurements of Installed singlemode Fiber Cable Plan.

- C. Governing Codes and Conflicts:
 - 1. If the requirements of these specifications or the Project Drawings exceed those of the governing codes and regulations, then the requirements of these specifications and the Drawings shall govern. However, nothing in the Drawings or Specifications shall be construed to permit work not conforming to all governing codes and regulations.

1.4 ABBREVIATIONS

- A. The following abbreviations are used in this document:
 - DC Direct Current
 - IDF Intermediate Distribution Frame
 - MDF Main Distribution Frame
 - PBX Private Branch Exchange
 - UTP Unshielded Twisted Pair

1.5 SUBMITTALS

- A. Project Initiation:
 - 1. Within fourteen (14) days of Notice to Proceed, the data network system installer shall furnish the following in a single consolidated submittal:
 - a. Permits: The Contractor shall obtain all required permits and provide copies to the Owner/Architect/Engineer.
 - b. Product Literature: Complete manufacturer's product literature for all cable, patch panels, cross-connect blocks, cable supports, cable labels, outlet devices, and other products to be used in the installation. In addition, whenever substitutions for recommended products are made, samples (when requested by the Owner/Designer) and the manufacturer's supporting documentation demonstrating compatibility with other related products shall be included.
 - c. Construction Schedule: A time-scaled Construction Schedule, using Construction Management, indicating general project deadlines and specific dates relating to the installation of the cable distribution system.
 - d. Testing: Proposed Contractor Enhanced Category 6 UTP cable test result forms, fiber optic cable test result forms and a list of instrumentation to be used for systems testing.
 - e. Spec Compliance. Submit a line by line item compliance statement indicating that the products being submitted comply with the specified equipment and indicate which products deviate from the specifications.
- B. Shop Drawings:

1.

- Submit the following items, for Owner review and approval, within twenty-eight (28) days of notice to proceed:
 - a. Proposed circuit routing and circuit grouping plan prepared by a BICSI certified RCDD (Registered Communications Distribution Designer). The RCDD certification must be current.
 - b. Conformance: For items which are being provided exactly as specified, provide a letter stating the item description and model number, and that it is being provided as specified. For items which are not as specified, provide standard manufacturer's cut sheets or other descriptive information and a written description detailing the reason for the substitution.
- C. Project Completion:
 - 1. As a condition for project acceptance, the Contractor shall submit the following for review and approval:
 - a. Samples: Complete manufacturer's product literature and samples (if requested) for all pre-approved substitutions to the recommended products made during the course of the Project.
 - b. Inspection and Test Reports: During the course of the project, the Contractor shall maintain an adequate inspection system to insure that the materials supplied and the work performed conform to Contract requirements. The contractor shall provide written documentation that indicates that materials acceptance testing was conducted as specified. The Contractor shall also provide documentation, which indicates that all cable termination testing was completed and that all irregularities were corrected prior to job completion.
 - c. Operating and Maintenance Instructions: Operating and maintenance instructions for all devices within the system. These instructions shall reflect any changes made during the course of construction, and shall be

provided to the Owner for their use in a three-ring binder labeled with the project name and description (4 copies).

As-Built Drawings: As-built drawings will include cable pathways, data d. outlet locations with correct labeling and MDF location. The as-built drawings will be prepared using AutoCAD version 14 or later. Provide the Owner with one mylar plot of each drawing and two blue line prints of each drawing. Provide the Owner with electronic versions of the as-builts on USB or CD Rom.

PART 2 - PRODUCTS

2.1 GENERAL

- А Installation: The cabling shall be installed per requirements of the manufacturer and the Project Documents utilizing materials meeting all applicable TIA/EIA standards. The Contractor is responsible for providing all incidental and/or miscellaneous hardware not explicitly specified below as required for a complete and operational system.
- Materials: Materials shall be as listed or shall be approved equivalent products of other B. manufacturers meeting the intent and quality level of the TIA/EIA specifications. All approved equivalent products will be published by addendum ten days prior to proposal for Architect/Engineer to review.
- C. Testing: All installed cabling shall be tested 100% good after installation by the Contractor.
- D. Ratings: All products shall be new and brought to the job site in the original manufacturer's packaging. Electrical components (including innerduct) shall bear the Underwriter's Laboratories label. All communications cable shall bear flammability testing ratings as follows:
 - **Communications Cable** CM
 - CMP Plenum Rated Communications Cable
 - CMR **Riser-Rated Communications Cable**
- E. Initial Cable Inspection: The Contractor shall inspect all cable prior to installation to verify that it is identified properly on the reel identification label, that it is of the proper gauge, containing the correct number of pairs, etc. Note any buckling of the jacket that would indicate possible problems. Damaged cable or any other components failing to meet specifications shall not be used in the installation.
- F. Cable Lubricants: Lubricants specifically designed for installing communications cable may be used to reduce pulling tension as necessary when pulling cable into conduit. 1.
 - **Approved Products**

а.	Twisted-pair cable:	Dyna-Blue American Polywater
b.	Optical Fiber cable:	Optic Lube

Ideal

- Fire Wall Sealant: Any penetration through firewalls (including those in sleeves) will be G. resealed with an Underwriter Laboratories (UL) approved sealant. 1.
 - **Approved Products**
 - 3M or a.
 - b. Pre-approved equal

2.2 DATA CLOSET (MDF/IDF) CATEGORY 6 TERMINATION HARDWARE

А Equipment Racks:

> Provide and install equipment racks in locations indicated on the attached drawings for the following areas.

For all MDF/IDF locations:

Contractor shall provide and install new floor mounted rack systems where indicated on plans. Refer to floor plan and enlarged MDF/IDF room layouts for number or racks to provide at each location.

- 19", 4 post floor mounted rack Hoffman E4DR19FM45U 1.
- 2. 19". 2-post floor mounted rack - Hoffman - EDR19FM45U
- B. **Distribution Rack/Cabinet Grounding:**

All Racks and/or Cabinets shall be individually grounded using stranded #6 AWG insulated copper conductor, from the rack to the telecommunication ground bus bar, with copper compression lugs at both ends of the grounding wire. DAISY CHAINING RACKS TOGETHER WILL NOT BE ACCEPTED. Provide all required bonding materials and hardware and bond to building grounding electrode subsystem at building electrical service entrance. 1.

- Approved Products –Grounding Compression Lugs
 - Hoffman #DGCL61 a.
- 2. Approved Products – Wall Mount Bus Bar (one pre MDF/IDF location)
 - Hoffman #DGTB412 а
- C. Category 6 Patch Panels: The Category 6 data station cable shall be terminated on Category 6 RJ45 patch panels with circuit board construction, T568B terminations. Patch panels shall be 19-inch rack mountable. Patch panels shall terminate all copper telecommunications circuits on the entire project. Furnish units that adhere to the performance requirements TIA/EIA-568A standards.
 - a. Approved Products:
 - Category 6 Patch Panels 48-Port patch panels shall be Uniprise UNP-6a. DM-2U-48. Provide the quantity required to terminate 120% of all category 6 workstations and IP telephone circuits on the entire project.
 - Category 6 Patch Panels 48-Port patch panels shall be Uniprise UNP-6b. DM-2U-48. Provide the quantity required to terminate 120% of all Category 6 wireless access point circuits on the entire project.
 - Category 6 Patch Panels 48-Port patch panels shall be Uniprise UNP-6-C. DM-2U-48. Provide the quantity required to terminate 120% of all category 6 IP Camera circuits on the entire project.
 - Category 5E Patch Panels 24-Port patch panels shall be Uniprise d. Product No. CPP-5E-DM-1U. Provide one (1) patch panel at each end of every twenty-five (25) pairs of copper tie cable installed on the entire project.
- Cable Management Panels D.

Provide cable management panels as required for horizontal and vertical cable management. Provide vertical wire management on ends and in between all racks on entire project. All vertical cable managers on the entire project shall be 8" wide management.

1. Approved Products

Vertical – CommScope, Front and Rear, #VCM-DS-84-8B with covers on front and back.

Provide Velcro straps for cable dressing in MDF/IDF rooms.

- E Rack/Cabinet Electrical:
 - 1. A power distribution strip shall be installed vertically at the back of each data rack and/or cabinet.

Approved Products

- a. Hoffman Eaton EPBZ97 120V 15A.
- b. Provide a PDU offset bracket for each PDU installed.
- c. Vertical Cable Manager, 8": Commscope # VCM-DS-84-8B. Provide as required.
- F. Network Rack Patch Cables: Cabling Contractor shall provide, for the owner's installation, (1) – Category 6 patch cable for each data drop on entire project. These cables will provide connectivity from the front of the network patch panels to the, owner provided, network equipment. The patch cables are to be "FACTORY" terminated properly with RJ-45 connections on each end with the proper pin-out assignments per project configuration.
 - 1. Approved Products:
 - a. 1' Category 6 Patch Cable, Uniprise # UC1BBB2-0ZF001 (blue in color for all connections)
 - b. 6' Category 6 Patch Cable, Uniprise # UC1BBB2-0ZF006 (blue in color for all connections)
 - c. Contractor to provide patch cables for each system as indicated:
 - 1) 95% 1'
 - 2) 5% 6'

2.3 CABLE ROUTING/PATHWAY

A Cable Tray: Metal cable tray shall be provided to affix to the top of all floor mount racks. Cable tray shall be used to brace racks to walls and to route cable from walls to racks in communication closets.

Provide Tubular Stringer Style $-1 \frac{1}{2}$ " Boxed ladder type cable runway for communications pathway shown on plans

- 1. Approved Products:
 - a. Universal Cable Runway: Commscope #760085647 / CRSLR-10L12W (black). Provide vertically down wall and horizontally torack.
 - b. Cable Runway 90° Vertical Bend: Commscope # 760085530 / CR90FCB-12W (black), Provide for each transition from vertical wall run to horizontal run.
 - c. Ladder Rack Inside Curved Section, 12": Commscope # 760085688 / CR901CB-12W (black). Provide as required.
 - d. Ladder Rack Outside Curved Section, 12": Commscope # 760086082 / CR900CB-12W (black). Provide as required.
 - e. Rack to Runway Mounting Plate: Commscope # 760084053 / CRR2RRMK (black). Provide one each per rack.
 - f. Wall Angle Support Kit, 12": Commscope # 760084145 / CR612WRSK (black). Provide as required per ladder tray and wall junction.
 - g. Ladder Tray Triangle Support Bracket, 12": Commscope # 760084095 / CRTWSBK-12W (black). Provide as required.
 - h. End Cap Kit (2 caps): Commscope # 760084012 / CRPECK (black). Provide as required per exposed end of ladder tray

- i. Ladder Tray Junction Splice Kit: Commscope # 760084046 / CRTJSK (black). Provide as required per junction.
- j. Ladder Rack, Butt Splice Kit: Commscope # 760083899 / CRBSK (black). Provide as required.
- k. Ladder Tray Radius Drop Kit, 12": Commscope # 760083949 / CRDK6W (black). Provide as required.
- I. Ladder Rack Retaining Post Kit: Commscope # 760083972 / CRRP6H. Provide as required.
- m. Vertical Wall Bracket: Commscope # 760084137 / CRVWBK. Provide as required.
- n. And all applicable installation accessories.
- o. Provide all grounding required per NEC. Coordinate ground bus location with electrical installer.
- B. Cable Support System: All low voltage cabling shall be installed and supported with J-hooks or cable saddles at 5'-0" intervals unless installed in conduit. Do not exceed manufacture recommendation for the quantity of cables supported in an individual support.
- C. All cable bundles shall be grouped together using plenum rated Velcro for the entire run above and below the ceilings.

2.4 STATION WIRING

- A Wire: The data and voice wire provided for all outlets shall be (Category 6) unshielded twisted pair, four-pair, 24 AWG solid copper conductor, meeting the intent and quality level of the TIA/EIA-568-A Commercial Building Wiring Standard. Refer to floor plan and data outlet legend for number of active data ports to specified faceplates.
 - 1. Approved Products: For all voice and data connections:
 - a. Plenum-Rated LAN Cable (blue color for all circuits on the entire project)
 - 1) Uniprise CS34P ETL, Plenum rated, Category 6
 - 2) 1000' reel, Uniprise # UN874049914/10 / CS34P BLU C6 4/23 U/UTP CPK 1KFT
 - 3) 3000' reel, Uniprise # UN884017284/30 / CS34R BLU C6 4/23 U/UTP RL 3KFT
- B. Testing: The Category 6 four-pair UTP cable must be UL Performance Level tested. Each 1000 or 3000 foot spool shall be new, have a WebTrak® number on it, and must be individually tested with test results available at <u>http://www.uniprisesolutions.com/webtrak</u> "SHORTS" WILL NOT BE ALLOWED AND IF DISCOVERED, CONTRACTOR WILL <u>BE REQUIRED TO REMOVE ALL CABLE AND REINSTALL AT NO ADDITIONAL</u> <u>COST TO OWNER.</u>
- C. Rating: Cable installed in conduit shall be non-plenum rated. Cable not installed in conduit shall be plenum rated if installed in plenum ceiling space, non plenum rated otherwise.

2.5 STATION HARDWARE

1. Station Hardware, data wiring for security cameras shall be lime green in color from camera back to the network patch panel. Patch cables shall also be lime green for all security camera network connections. It is the responsibility of the data cabling contractor to install the data cabling from the camera back to the MDF/IDF closet.

- 2. Station Hardware, data wiring for access control modules shall be purple in color from access control module back to the network patch panel. Patch cables shall also be purple for all access control module network connections. It is the responsibility of the data cabling contractor to install the data cabling from the access control module (card reader locations) back to the MDF/IDF closet.
- A. Flush Mount Jacks: Flush mount jacks shall be high quality Category 6 RJ45 modular jacks with circuit board construction and 110-type IDC terminals. Jacks shall meet EIA/TIA TSB40 recommendations for Category 6 connecting hardware.
 - 1. Approved Products:
 - a. Category 6 Commscope, Uniprise Modular Jack # 760237778 / UNJ600-BL (blue for all drops on the entire project)
- B. Faceplates: Faceplates shall be a 4-port, flush mounted, stainless in color for RJ45 outlets at all locations.
 - 1. Provide wall mounted handset faceplates where applicable for wall mounted phone. Refer to floor plan for locations.
 - 2. Mounting Straps (where applicable)
 - 3. Provide blank inserts for all unused ports. Systimax #M20AP-262, white in color.
- C. Workstation Patch Cables: Cabling Contractor shall provide owner with (1) Category 6 Uniprise patch cable for each data drop on entire project. Each cable will be **"FACTORY"** terminated properly with RJ45 connections on each end with appropriate pin-out assignments per project configuration.
 - 1. Approved Products:
 - a. 10' Category 6 Patch Cable, Uniprise # UNC10G-BL (blue in color for all connections).
 - b. 15' Category 6 Patch Cable, Uniprise # UNC10G-BL (blue in color for all connections).
 - 2. Contractor to provide patch cables for each system as indicated:
 - a. 90% 10'
 - b. 10% 15'
 - 3. Contractor to provide patch cables for each system at station and patch panel as indicated:
 - a. Wireless gray
 - b. Camera lime green
 - c. Data blue
 - d. Security purple

PART 3 - EXECUTION

3.1 GENERAL

- A Fire Wall Penetrations: The contractor shall avoid penetration of fire-rated walls and floors wherever possible. Where penetrations are necessary, they shall be sleeved with metallic conduit and resealed with an Underwriter Laboratories (UL) approved sealant. Contractor shall also seal all floor, ceiling and wall penetrations in fire or smoke barriers and in the wiring closet.
- B. Allowable Cable Bend Radius and Pull Tension: In general, communications cable cannot tolerate sharp bends or excessive pull tension during installation. Refer to the cable manufacturers allowable bend radius and pull tension data for the maximum

allowable limits.

- C. Cable Lubricants: After installation, exposed cable and other surfaces must be cleaned free of lubricant residue.
- D. Pull Strings: Provide pull strings in all new conduits, including all conduits with cable installed as part of this contract. Pull test is not to exceed 200 pounds. Data and video cables can be pulled together with pull strings.
- E. Conduit Fill: Conduit fill shall not exceed 40%.
- F. Damage:
 - 1. The Contractor shall replace or rework cables showing evidence of improper handling including stretches, kinks, short radius bends, over-tightened bindings, loosely twisted and over-twisted pairs at terminals and cable sheath removed too far (over 1-1/2 inches).
 - 2. The Contractor shall replace any damaged ceiling tiles that are broken during cable installation.

G. Clean Up:

All clean up activity related to work performed will be the responsibility of the Contractor and must be completed daily before leaving the facility.

3.2 DOCUMENTATION

A Labels:

The Contractor will label all outlets using permanent/legible typed or machine engraved labels approved by the Owner (no handwritten labels permitted). Label patch panels in the wiring closet to match those on the corresponding data outlets. The font shall be at least on-eighth inch (1/8") in height, block. All labels shall correspond to as-builts and to final test reports.

Contractor shall coordinate labeling with owner prior to beginning of labeling for entire project to ensure district standards are followed and existing building nomenclature is kept in place.

B. Floor Plan: A floor plan clearly labeled with all outlet jack numbers shall be included in the as-built plans.

3.3 EQUIPMENT RACK CONFIGURATION

- A Equipment Racks: Equipment racks shall be assembled and mounted in locations shown on the Drawings and as detailed. Each rack shall be securely mounted to the floor and braced to the wall with cable tray in accordance with the manufacturer's instructions and recommendations. Racks shall be mounted such that the side rails are plumb with vertical cable management panels. Racks to be located such that future expansion can occur without relocating existing racks. Racks shall be grounded in accordance with NEC requirements.
- B. Wire Management Components: Horizontal cable management panels shall be installed directly above and below each patch panel, also 2 per each 48 port patch panel should be left at site to accommodate the switch gear when they are installed. Vertical cable management panels shall be installed on each side of the rack. In instances where more than one rack is installed in a single location, vertical cable management shall be installed between the racks and on either side.

- C. Cable Placement: Cable installation in the Wiring Closet must conform to the Project Drawings. All cabling shall be routed so as to avoid interference with any other service or system, operation, or maintenance location. Avoid crossing area horizontally just above or below any riser conduit. Lay and dress cables to allow other cables to enter the conduit/riser without difficulty at a later time by maintaining a working distance from these openings.
- D. Cable Routing: Cable shall be routed as close as possible to the ceiling, floor or corners to ensure that adequate wall or backboard space is available for current and future equipment. All cable runs within the Wiring Closet shall be horizontal or vertical within the constraints of minimum cable bending radii. Minimum bend radius shall be observed. Cables shall not be tie-wrapped to electrical conduit or other equipment.
- E. Installation: All incoming cables shall be routed on the cable tray and neatly dressed down to the patch panels.
- F. Hardware: Provide rack and jack panel hardware as required for all data station wiring.

3.4 STATION WIRING INSTALLATION

- A General:
 - 1. Cabling between wiring closet and workstation locations shall be made as individual home runs. No intermediate punch down blocks or splices may be installed or utilized between the wiring closet and the communications outlet at the workstation location.
 - 2. All cable must be handled with care during installation so as not to change performance specifications. Factory twists of each individual pair must be maintained up to the connection points at both ends of the cable. There shall never be more than one and one-half inches of unsheathed Category 6 UTP cable at either the wiring closet or the workstation termination locations.
- B. Exposed Cable:
 - 1. All cabling shall be installed inside walls or ceiling spaces whenever possible. Exposed station cable will only be run where indicated on the Drawings.
 - 2. Additional exposed cable runs will require Owner approval, and will only be allowed when no other options exist.
- C. Placement: All cabling and associated hardware shall be placed so as to make efficient use of available space. All cabling and associated hardware shall be placed so as not to impair the Owner's efficient use of their full capacity.
- D. Cable Routes:
 - 1. All cabling placed in ceiling areas must be in conduit or D ring supports. Cable supports shall be permanently anchored to building structure or substrates. Provide attachment hardware and anchors designed for the structure to which attached and that are suitably sized to carry the weight of the cables to be supported. Do not route cable through webbing of structural steel. Cabling must be supported in dedicated supports intended to support cabling as described in this section.
 - 2. Attaching cable to pipes or other mechanical items is not permitted. Communications cable shall be rerouted so as to provide a minimum of 18 inches spacing from light fixtures, sources of heat, power feeder conduits and EMI sources. Cabling shall not be attached to ceiling. Grid support wires. Cable runs shall be parallel or perpendicular to building structure. Multiple cables to be

bundled together every 6 feet.

3.5 STATION HARDWARE

- A Flush Mount Jacks: Flush mount jacks shall be mounted in a faceplate with backbox.
- B. Placement: Where possible, the communications outlet shall be located so that its centerline is 18 inches above floor level or 12 inches above permanent bench surfaces. Outlets shall not be mounted on temporary, movable, or removable surfaces, doors, or access hatches.
- C. RJ-45 Jack Pin Assignments:
 - 1. Pin connections for data station cable outlets and patch panels shall match EIA/TIA 568 modular jack wiring recommendation T568B.
 - 2. Pin connections at data jack panels shall match pin connections at outlets (straight through wiring).

3.6 CABLE TESTING REQUIREMENTS

- A Notification: The Owner and Engineer shall be notified one week prior to any testing so that the testing may be witnessed.
- B. Inspection: Before requesting a final inspection, the Contractor shall perform a series of end-to-end installation performance tests. The Contractor shall submit for approval a proposal describing the test procedures, test result forms and timetable for all copper and fiber optic cabling.
- C. Procedures: Trained personnel shall perform all testing. Acceptance of the test procedures discussed below is predicated on the Contractor's use of the recommended products and adherence to the inspection requirements and practices set forth. Acceptance of the completed installation will be evaluated in the context of each of these factors.
- D. Errors: When errors are found, the source of each shall be determined, corrected and the cable retested. All defective components shall be replaced and retested. Re-test results must be provided on Owner approved forms and witnessed by Owner.
- E. Twisted Pair Cable Testing:
 - At a minimum, the Contractor shall test all station drop cable pairs from Data Closet termination patch panels to outlet device RJ45 jacks. Enhanced Category 6 products shall be tested for compliance to ANSI/TIA/EIA 568A and ISO/IES 11801 for a Enhanced Category 6 rated installation. Test equipment used shall meet TIA/EIA TSB-67, Level II accuracy. Further, the contractor shall have a copy of TSB-67 in their possession and be familiar with its contents.
 - 2. Each wire/pair shall be tested at both ends for the following:
 - a. Wire map (pin to pin connectivity)
 - b. Length (in feet)
 - c. Attenuation
 - d. Near end cross talk (NEXT)
 - e. Power Sum
 - 3. Test equipment shall provide an electronic and printed record of these tests.
 - 4. Test results for each Enhanced Category 6 four-pair UTP cable must be submitted with identification to match labels on all patch panel ports and RJ45 jacks and must match as-builts associated with that cable.
- F. Testing: Once installed the cabling will be tested for continuity, shorts and grounds.

- 1. Cabling:
 - a. Continuity 100% continuity testing is required and will be tested from the MDF/IDF location to each classroom drop. A checklist of each cable and test performed on that cable will be submitted once the testing has been completed.
 - b. Shorts No cable shorts will be permitted on the system. If a short is detected, the connector or cable will be repaired or replaced.
 - c. Grounds No direct ground on the center conductor of the AVDN cables are permitted.
- 2. System:
 - a. Continuity As tested in the above testing requirements.
 - b. Power Readings A power reading will be required at each drop of each of the cabling systems. A +3 dB to a +7 dB is required at each drop with a common feed signal of + 15 dB into the head end amplifier. These measurements to be taken with an approved field strength meter of know calibration. Test measurements to be performed at low channel, mid-band channel, and high channel to determine cable slope.
 - c. Signal Quality A standard receiver, typical of those used in the system, shall randomly be connected to 10% of the outlets across the system and tuned to a reference channel of known quality. No visible indication of cochannel interference, noise, ghosting, or beat interference may be observed.
 - d. Carrier to Noise Carrier to Noise shall be measured at random outlets representing an average cross section of the drops with an approved field strength meter by the following process. With normal operating levels the field set shall be tuned to each channels visual carrier and the level recorded. The input signal to the head end amplifier shall be removed and the input of the amplifier terminated with a short. Each channel shall be re-measured and the noise levels recorded. The Carrier to Noise measurement is the difference of the two figures.
 - e. Documentation of Results All recorded measurements are to be tabulated and included in the systems documentation manual for reference during maintenance of the system.

3.7 INSPECTION

A General: Conformance to the installation practices covered above are to be verified when completed. In some cases, the Owner/Designer may inspect before acceptance.

END OF SECTION

FOR BL	G-001
UEBEAN	
I LABEL	
ING/OCR:	

		GENERAL
G-0	002	DRAWING INDEX GENERAL PROJECT INFORMATION
		CODE ANALYSIS AND 1ST FLOOR LIFE SAFETY PLAN 2ND FLOOR LIFE SAFETY PLAN
G-(050	ACCESSIBILITY GUIDELINES
		SIGNAGE DETAILS SIGNAGE DETAILS
		FIRE RATED ASSEMBLIES
		ARCHITECTURE DEMOLITION
	CHITECTURAL SITE I D101	DEMOLITION SITE PLAN - DEMOLITION - COMPOSITE
		ENLARGED SITE PLAN - DEMOLITION ENLARGED SITE PLAN - DEMOLITION
AR	CHITECTURAL DEMC	
		1ST LEVEL - DEMO PLAN - COMPOSITE 1ST LEVEL - DEMO PLAN - COMPOSITE - ALTERNATE #04
		2ND LEVEL - DEMO PLAN - COMPOSITE
		2ND LEVEL - DEMO PLAN - COMPOSITE - ALTERNATE #04 1ST LEVEL - DEMO CEILING PLAN - COMPOSITE
		1ST LEVEL - DEMO CEILING PLAN - COMPOSITE - ALTERNATE #02
		2ND LEVEL - DEMO CEILING PLAN - COMPOSITE 2ND LEVEL - DEMO CEILING PLAN - COMPOSITE - ALTERNATE #02
		1ST LEVEL - DEMOLITION FLOOR PLAN - COMPOSITE - ALTERNATE #02
		1ST LEVEL - DEMOLITION FLOOR PLAN - AREA A - ALTERNATE #05 1ST LEVEL - DEMOLITION FLOOR PLAN - AREA B
		1ST LEVEL - DEMOLITION FLOOR PLAN - AREA B 1ST LEVEL - DEMOLITION FLOOR PLAN - AREA B - ALTERNATE #05
<u>1</u> AD		1ST LEVEL - DEMOLITION FLOOR PLAN - AREA C
		1ST LEVEL - DEMOLITION FLOOR PLAN - AREA C - ALTERNATE #05 1ST LEVEL - DEMOLITION FLOOR PLAN - AREA D - ALTERNATE #05
AD	101E	1ST LEVEL - DEMOLITION FLOOR PLAN - AREA E
		1ST LEVEL - DEMOLITION FLOOR PLAN - AREA E - ALTERNATE #05 1ST LEVEL - DEMOLITION FLOOR PLAN - AREA F
AD	0101F.1	1ST LEVEL - DEMOLITION FLOOR PLAN - AREA F - ALTERNATE #05
		1ST LEVEL - DEMOLITION FLOOR PLAN - AREA G 1ST LEVEL - DEMOLITION FLOOR PLAN - AREA G - ALTERNATE #05
		1ST LEVEL - DEMOLITION FLOOR PLAN - AREA G - ALTERNATE #05 1ST LEVEL - DEMOLITION FLOOR PLAN - AREA G - ALTERNATE #03
		1ST LEVEL - DEMOLITION FLOOR PLAN - AREA H
		1ST LEVEL - DEMOLITION FLOOR PLAN - AREA H - ALTERNATE #08 1ST LEVEL - DEMOLITION FLOOR PLAN - AREA J
		2ND LEVEL - DEMOLITION FLOOR PLAN - AREA G 2ND LEVEL - DEMOLITION FLOOR PLAN - AREA G - ALTERNATE #05
AD	102G.2	2ND LEVEL - DEMOLITION FLOOR PLAN - AREA G - ALTERNATE #03 2ND LEVEL - DEMOLITION FLOOR PLAN - AREA N - ALTERNATE #05
<u>1\</u>	001	CIVIL NOTES, INDEX, AND LEGEND
CC	002A	SURVEY (FOR INFORMATION ONLY)
		SURVEY (FOR INFORMATION ONLY) OVERALL SITE PLAN
CC	004	FIRE SAFETY APPARATUS PLAN
		EROSION CONTROL PLAN EROSION CONTROL DETAILS
		EROSION CONTROL DETAILS DEMOLITION PLAN (AREAS J & L)
C 1	101	SITE PLAN (AREAS J & L)
		DRAINAGE AND UTILITY PLAN (AREAS J & L) GRADING AND PAVING PLAN (AREAS J & L)
C 1	104	DRAINAGE AREA MAP (AREAS J & L)
		DEMOLITION PLAN (AREA S) DEMOLITION PLAN (AREA S)
		DEMOLITION PLAN (AREA S) SITE PLAN (AREA S)
C 2	201.2	SITE PLAN (AREA S)
		DRAINAGE AND UTILITY PLAN (AREA S) DRAINAGE AND UTILITY PLAN (AREA S)
C 2	203.1	GRADING AND PAVING PLAN (ÀREA S)
		GRADING AND PAVING PLAN (AREA S) DRAINAGE AREA MAP (AREA S)
		DRAINAGE AREA MAP (AREA S) DRAINAGE AREA MAP (AREA S)
	300	DEMOLITION PLAN (AREA B)
		SITE PLAN (AREA B) DRAINAGE AND UTILITY PLAN (AREA B)
C3	303	GRADING AND PAVING PLAN (AREA B)
		DRAINAGE AREA MAP (AREA B) DETAILS
		DETAILS DETAILS
C 4	403	DETAILS
		TRAFFIC SIGNAL & FLASHER PLAN TRAFFIC SIGNAL & FLASHER PLAN
	503	TRAFFIC SIGNAL & FLASHER PLAN
	504	TRAFFIC SIGNAL & FLASHER PLAN
C 5 C 5		TRAFFIC SIGNAL & FLASHER PLAN
C 5 C 5	505 506	TRAFFIC SIGNAL & FLASHER PLAN TRAFFIC SIGNAL & FLASHER PLAN
C 5 C 5	505 506	
C 5 C 5	505 506	TRAFFIC SIGNAL & FLASHER PLAN

	LANDSCAPE	
L-101	LANDSCAPE PLAN	
L-102	LANDSCAPE PLAN	
L-103	LANDSCAPE PLAN	
L-201	IRRIGATION PLAN ALTERNATE #06	
L-202	IRRIGATION PLAN ALTERNATE #06	
L-203	IRRIGATION PLAN ALTERNATE #06	
L-204	IRRIGATION PLAN ALTERNATE #06	

CHECKED BY: Checker DRAWN BY: Author Plot Stamp: 1/15/2025 10:17:50 AM

VOLUME 1

	STRUCTURE		ARCHITECTUR
S-000	3D VIEW & SHEET LIST	A-102G	2ND LEVEL - FLOOR PLAN - AREA G
S-010	GENERAL NOTES	A-102G.1	2ND LEVEL - FLOOR PLAN - AREA G - A
S-011	GENERAL NOTES	A-102G.2	2ND LEVEL - FLOOR PLAN - AREA G - A
S-012	GENERAL NOTES	A-102J A-102N.1	2ND LEVEL - CLEARSTORY PLAN - ARE 2ND LEVEL - FLOOR PLAN - AREA N - A
S-013	GENERAL SUBGRADE NOTES AND TYP DETAILS	A-102N.1	2ND LEVEL - CLEARSTORY PLAN - ARE
5-101	COMPOSITE FOUNDATION PLAN	A-201A.1	1ST LEVEL - CEILING PLAN - AREA A - A
S-101B S-101J	FOUNDATION PLAN - AREA B	A-201B	1ST LEVEL - CEILING PLAN - AREA B
-101J -101K	FOUNDATION PLAN - AREA J FOUNDATION PLAN - AREA K	A-201B.1	1ST LEVEL - CEILING PLAN - AREA B - /
101K 101L	FOUNDATION PLAN - AREA L	A-201C.1	1ST LEVEL - CEILING PLAN - AREA C - J
-101E	FOUNDATION PLAN - AREA S	A-201D.1	1ST LEVEL - CEILING PLAN - AREA D - J
-102	COMPOSITE INTERMEDIATE/ LOW ROOF FRAMING PLAN	A-201E.1	1ST LEVEL - CEILING PLAN - AREA E - A
102B	SECOND FLOOR FRAMING PLAN - AREA B	A-201F.1	1ST LEVEL - CEILING PLAN - AREA F - /
102G	SECOND FLOOR FRAMING PLAN - AREA G	A-201G.1	1ST LEVEL - CEILING PLAN - AREA G -
-102H	SECOND FLOOR FRAMING PLAN - AREA H	A-201H	1ST LEVEL - CEILING PLAN - AREA H
·102J	INTERMEDIATE FRAMING PLAN - AREA J	A-201J	1ST LEVEL - CEILING PLAN - AREA J
-102K	LOW ROOF FRAMING PLAN - AREA K	A-201K	1ST LEVEL - CEILING PLAN - AREA K
102L	LOW ROOF FRAMING PLAN - AREA L	A-201L	1ST LEVEL - CEILING PLAN - AREA L
102S	LOW ROOF FRAMING PLAN - AREA S	A-201L.1 A-201M.1	1ST LEVEL - CEILING PLAN - AREA L - / 1ST LEVEL - CEILING PLAN - AREA M -
103	COMPOSITE MID ROOF FRAMING PLAN	A-201N.1	1ST LEVEL - CEILING PLAN - AREA M -
103B	ROOF FRAMING PLAN - AREA B	A-201P.1	1ST LEVEL - CEILING PLAN - AREA N -
103G	ROOF FRAMING PLAN - AREA G	A-2019.1	1ST LEVEL - CEILING PLAN - AREA P -
103J	MID ROOF FRAMING PLAN - AREA J	A-2013 A-202A	2ND LEVEL - CEILING PLAN - AREA 3
103S	HIGH ROOF FRAMING PLAN - AREA S	A-202A A-202B	2ND LEVEL - CEILING PLAN - AREA A - 2ND LEVEL - CEILING PLAN - AREA B
104	COMPOSITE ROOF FRAMING PLAN	A-202B A-202B.1	2ND LEVEL - CEILING PLAN - AREA B 2ND LEVEL - CEILING PLAN - AREA B -
104J	ROOF FRAMING PLAN - AREA J	A-2025.1 A-202F.1	2ND LEVEL - CEILING PLAN - AREA F - 2ND LEVEL - CEILING PLAN - AREA F - 2
300	GENERAL CONCRETE AND STL REINF NOTES AND TYP DETAILS	A-202G.1	2ND LEVEL - CEILING PLAN - AREA G -
301	GENERAL SLAB-ON-GRADE NOTES AND TYP DETAILS	A-202N.1	2ND LEVEL - CEILING PLAN - AREA N -
302	GENERAL GRADE BEAM NOTES AND TYP DETAILS	A-203	CEILING DETAILS
302A	GENERAL GRADE BEAM NOTES AND TYP DETAILS	A-301	NEW ROOF PLAN - COMPOSITE
303	GENERAL FOUNDATION NOTES AND TYP DETAILS GENERAL FOUNDATION NOTES AND TYP DETAILS	A-301B	ROOF PLAN - AREA B
304 205	GENERAL FOUNDATION NOTES AND TYP DETAILS GENERAL EXISTING FOUNDATION NOTES AND TYP DETAILS	A-301H	ROOF PLAN - AREAS H, J AND K
305 310	FOUNDATION DETAILS	A-301M	ROOF PLAN - AREAS M, N, & P
.310 .311	FOUNDATION DETAILS	A-301S	ROOF PLAN - AREA S
.313	FOUNDATION DETAILS	A-322	DETAILS - ROOF
314	FOUNDATION DETAILS (CMU)	A-323	ROOF DETAILS
-315	EXIST FOUNDATION DETAILS	A-401	ENLARGED - FLOOR PLANS
316	EXIST FOUNDATION DETAILS	A-402	ENLARGED - FLOOR PLANS
-320	SITE ITEMS FOUNDATION SECTIONS AND DETAILS	A-403	ENLARGED - FLOOR PLANS
-400	GENERAL CMU NOTES AND TYP DETAILS	A-420	ENLARGED STAIR PLANS, SECTIONS &
-401	GENERAL CMU NOTES AND TYP DETAILS	A-421	ENLARGED STAIR DETAILS
402	MISC CMU DETAILS	A-431	ELEVATOR PLANS, SECTION & DETAIL
403	MISC CMU DETAILS	A-441	ENLARGED - RESTROOM ELEVATIONS
404	MISC CMU DETAILS	A-442	ENLARGED - RESTROOM ELEVATIONS
500	GENERAL STEEL NOTES AND TYP DETAILS	A-443	ENLARGED - RESTROOM ELEVATIONS
501	GENERAL STEEL NOTES AND TYP DETAILS	A-444	ENLARGED - RESTROOM ELEVATIONS
-502	GENERAL STEEL NOTES AND TYP DETAILS	A-445	ENLARGED - RESTROOM ELEVATIONS
503	GENERAL STEEL CONNECTION NOTES AND TYP DETAILS	<u>/2</u> <u>A-446</u>	ÉNLARGED - RESTROOM ELEVATIONS
504	GENERAL COMPOSITE STEEL NOTES AND TYP DETAILS	A-451	ENLARGED - COMP GYM STRIPPING P
505	GENERAL COMPOSITE STEEL NOTES AND TYP DETAILS	A-501	ELEVATIONS - EXTERIOR
506	GENERAL STEEL NOTES AND TYP DETAILS	A-502 A-511	ELEVATIONS - EXTERIOR CASEWORK ELEVATIONS
507	GENERAL STEEL NOTES AND TYP DETAILS	A-512	CASEWORK ELEVATIONS
508	GENERAL STEEL NOTES AND TYP DETAILS	A-512 A-513	CASEWORK ELEVATIONS
509	GENERAL EXISTING FRAMING NOTES AND TYP DETAILS	A-515	CASEWORK ELEVATIONS CASEWORK ELEVATIONS AND DETAIL
510	COMPOSITE FRAMING DETAILS	A-527	ELEVATIONS - INTERIOR
511	COMPOSITE FRAMING DETAILS	A-528	ELEVATIONS - INTERIOR
512	COMPOSITE FRAMING DETAILS	A-601	SECTIONS - BUILDING
520	ROOF FRAMING DETAILS	A-621	SECTIONS - WALL
-521	ROOF FRAMING DETAILS	A-622	SECTIONS - WALL
522 522	ROOF FRAMING DETAILS	A-623	SECTIONS - WALL
523 524	ROOF FRAMING DETAILS	A-624	SECTIONS - WALL
524 525	BUILDING SECTIONS BUILDING SECTIONS	A-625	SECTIONS - WALL
-525 -526	BUILDING SECTIONS	A-626	SECTIONS - WALL
-526 -527	ROOF FRAMING DETAILS	A-627	SECTIONS - WALL
-527 -600	TYPICAL WIND BRACING ELEVATIONS	A-628	SECTIONS - WALL
-601	TYPICAL WIND BRACING ELEVATIONS	A-701	DETAILS - PLAN EXTERIOR
-601 -602	TYPICAL WIND BRACING ELEVATIONS	A-702	DETAILS - PLAN EXTERIOR
5-602 5-610	TYPICAL WIND BRACING ELEVATIONS	A-710	DETAILS - PLAN INTERIOR
S-700	TYPICAL LADDER DETAILS	A-721	DETAILS - WALL SECTIONS
D101B	FIRST FLOOR DEMO PLAN - AREA B	A-722	DETAILS - WALL SECTIONS
D101B	FIRST FLOOR DEMO PLAN - AREA H	A-801A	PARTITION TYPES
D10111	SECOND FLOOR DEMO PLAN - AREA B	A-801B	PARTITION TYPES
D102B D103B	ROOF DEMO PLAN - AREA B	A-804	DOOR PANEL AND FRAME TYPES
		A-810	WINDOW AND LOUVER TYPES
		A-811	WINDOW AND LOUVER TYPES
		A-831	DETAILS - DOOR AND WINDOW- EXTER
		A-832	DETAILS - DOOR AND WINDOW- INTER
	ARCHITECTURE	INTERIOR FINISHES	
		AF100	FINISH SCHEDULE

ARCHITECTURE

ARCHITECTURAL SITE PLAN

ARCHITECTURAL SITE

AS101

∕1∖___

AS201	ENLARGED SITE PLAN
AS301	DETAILS - SITE
AS302	DETAILS - SITE
ARCHITECTURAL	
A-001	1ST LEVEL - FLOOR PLAN - COMPOSITE
A-002	2ND LEVEL - FLOOR PLAN - COMPOSITE
A-021	1ST LEVEL - CEILING PLAN - COMPOSITE
A-022	2ND LEVEL - CEILING PLAN - COMPOSITE
A-101A	1ST LEVEL - FLOOR PLAN - AREA A
A-101A.1	1ST LEVEL - FLOOR PLAN - AREA A - ALTERNATE #05
A-101B	1ST LEVEL - FLOOR PLAN - AREA B
A-101B.1	1ST LEVEL - FLOOR PLAN - AREA B - ALTERNATE #05
A-101C	1ST LEVEL - FLOOR PLAN - AREA C
A-101C.1	1ST LEVEL - FLOOR PLAN - AREA C - ALTERNATE #05
A-101D.1	1ST LEVEL - FLOOR PLAN - AREA D - ALTERNATE #05
A-101E	1ST LEVEL - FLOOR PLAN - AREA E
A-101E.1	1ST LEVEL - FLOOR PLAN - AREA E - ALTERNATE #05
A-101F	1ST LEVEL - FLOOR PLAN - AREA F
A-101F.1	1ST LEVEL - FLOOR PLAN - AREA F - ALTERNATE #05
A-101G	1ST LEVEL - FLOOR PLAN - AREA G
A-101G.1	1ST LEVEL - FLOOR PLAN - AREA G - ALTERNATE #05
A-101G.2	1ST LEVEL - FLOOR PLAN - AREA G - ALTERNATE #03
A-101H	1ST LEVEL - FLOOR PLAN - AREA H
 A-101H.1	1ST LEVEL - FLOOR PLAN - AREA H.1 - ALTERNATE #07
A-101J	1ST LEVEL - FLOOR PLAN - AREA J
A-101K	1ST LEVEL - FLOOR PLAN - AREA K
A-101K.1	1ST LEVEL - FLOOR PLAN - AREA K ALTERNATE #01
A-101L	1ST LEVEL - FLOOR PLAN - AREA L
A-101M.1	1ST LEVEL - FLOOR PLAN - AREA M ALTERNATE #05
A-101N	1ST LEVEL - FLOOR PLAN - AREA N
A-101N.1	1ST LEVEL - FLOOR PLAN - AREA N - ALTERNATE #05
A-101P.1	1ST LEVEL - FLOOR PLAN - AREA P ALTERNATE #05
A-101S	1ST LEVEL - FLOOR PLAN - AREA S
A-101S.1	OWNER FURNISHED CONTRACTOR INSTALLED ITEMS
A-101S.2	OWNER FURNISHED CONTRACTOR INSTALLED ITEMS
A-101U	1ST LEVEL - FLOOR PLAN - AREA U
A-102A	2ND LEVEL - FLOOR PLAN - AREA A
A-102A.1	2ND LEVEL - FLOOR PLAN - AREA A ALTERNATE #05
A-102B	2ND LEVEL - FLOOR PLAN - AREA B
A-102B.1	2ND LEVEL - FLOOR PLAN - AREA B ALTERNATE #05
A-102C	2ND LEVEL - FLOOR PLAN - AREA C
A-102F.1	2ND LEVEL - FLOOR PLAN - AREA F - ALTERNATE #05

A-102G	2ND LEVEL - FLOOR PLAN - AREA G
A-102G.1 A-102G.2	2ND LEVEL - FLOOR PLAN - AREA G - ALTERNATE #05 2ND LEVEL - FLOOR PLAN - AREA G - ALTERNATE #03
A-102J	2ND LEVEL - PLOOR PLAN - AREA G - ALTERNATE #03 2ND LEVEL - CLEARSTORY PLAN - AREA J
A-102N.1	2ND LEVEL - FLOOR PLAN - AREA N - ALTERNATE #05
A-102S	2ND LEVEL - CLEARSTORY PLAN - AREA S
A-201A.1 A-201B	1ST LEVEL - CEILING PLAN - AREA A - ALTERNATE #02 1ST LEVEL - CEILING PLAN - AREA B
A-201B.1	1ST LEVEL - CEILING PLAN - AREA B 1ST LEVEL - CEILING PLAN - AREA B - ALTERNATE #02
A-201C.1	1ST LEVEL - CEILING PLAN - AREA C - ALTERNATE #02
A-201D.1	1ST LEVEL - CEILING PLAN - AREA D - ALTERNATE #02
A-201E.1	1ST LEVEL - CEILING PLAN - AREA E - ALTERNATE #02
A-201F.1 A-201G.1	1ST LEVEL - CEILING PLAN - AREA F - ALTERNATE #02 1ST LEVEL - CEILING PLAN - AREA G - ALTERNATE #02
A-201H	1ST LEVEL - CEILING PLAN - AREA H
A-201J	1ST LEVEL - CEILING PLAN - AREA J
A-201K	1ST LEVEL - CEILING PLAN - AREA K
A-201L A-201L.1	1ST LEVEL - CEILING PLAN - AREA L 1ST LEVEL - CEILING PLAN - AREA L - ALTERNATE #02
A-201M.1	1ST LEVEL - CEILING PLAN - AREA M - ALTERNATE #02
A-201N.1	1ST LEVEL - CEILING PLAN - AREA N - ALTERNATE #02
A-201P.1	1ST LEVEL - CEILING PLAN - AREA P - ALTERNATE #02 1ST LEVEL - CEILING PLAN - AREA S
A-201S A-202A	2ND LEVEL - CEILING PLAN - AREA S 2ND LEVEL - CEILING PLAN - AREA A - ALTERNATE #02
A-202B	2ND LEVEL - CEILING PLAN - AREA B
A-202B.1	2ND LEVEL - CEILING PLAN - AREA B - ALTERNATE #02
A-202F.1 A-202G.1	2ND LEVEL - CEILING PLAN - AREA F - ALTERNATE #02 2ND LEVEL - CEILING PLAN - AREA G - ALTERNATE #02
A-2020.1 A-202N.1	2ND LEVEL - CEILING PLAN - AREA G - ALTERNATE #02 2ND LEVEL - CEILING PLAN - AREA N - ALTERNATE #02
A-203	CEILING DETAILS
A-301	NEW ROOF PLAN - COMPOSITE
A-301B A-301H	ROOF PLAN - AREA B ROOF PLAN - AREAS H, J AND K
A-301M	ROOF PLAN - AREAS M, J AND K ROOF PLAN - AREAS M, N, & P
A-301S	ROOF PLAN - AREA S
A-322	DETAILS - ROOF
A-323 A-401	ROOF DETAILS ENLARGED - FLOOR PLANS
A-401 A-402	ENLARGED - FLOOR PLANS
A-403	ENLARGED - FLOOR PLANS
A-420	ENLARGED STAIR PLANS, SECTIONS & DETAILS
A-421 A-431	ENLARGED STAIR DETAILS ELEVATOR PLANS, SECTION & DETAILS
A-441	ENLARGED - RESTROOM ELEVATIONS
A-442	ENLARGED - RESTROOM ELEVATIONS
A-443 A-444	ENLARGED - RESTROOM ELEVATIONS ENLARGED - RESTROOM ELEVATIONS
A-444 A-445	ENLARGED - RESTROOM ELEVATIONS ENLARGED - RESTROOM ELEVATIONS
A-446	ENLARGED - RESTROOM ELEVATIONS
A-451 A-501	ENLARGED - COMP GYM STRIPPING PLAN ELEVATIONS - EXTERIOR
A-301	
A-502	ELEVATIONS - EXTERIOR
A-502 A-511	ELEVATIONS - EXTERIOR CASEWORK ELEVATIONS
A-511 A-512	CASEWORK ELEVATIONS CASEWORK ELEVATIONS
A-511 A-512 A-513	CASEWORK ELEVATIONS CASEWORK ELEVATIONS CASEWORK ELEVATIONS
A-511 A-512	CASEWORK ELEVATIONS CASEWORK ELEVATIONS
A-511 A-512 A-513 A-515 A-527 A-528	CASEWORK ELEVATIONS CASEWORK ELEVATIONS CASEWORK ELEVATIONS CASEWORK ELEVATIONS AND DETAILS ELEVATIONS - INTERIOR ELEVATIONS - INTERIOR
A-511 A-512 A-513 A-515 A-527 A-528 A-601	CASEWORK ELEVATIONS CASEWORK ELEVATIONS CASEWORK ELEVATIONS CASEWORK ELEVATIONS AND DETAILS ELEVATIONS - INTERIOR ELEVATIONS - INTERIOR SECTIONS - BUILDING
A-511 A-512 A-513 A-515 A-527 A-528	CASEWORK ELEVATIONS CASEWORK ELEVATIONS CASEWORK ELEVATIONS CASEWORK ELEVATIONS AND DETAILS ELEVATIONS - INTERIOR ELEVATIONS - INTERIOR
A-511 A-512 A-513 A-515 A-527 A-528 A-601 A-621 A-622 A-623	CASEWORK ELEVATIONS CASEWORK ELEVATIONS CASEWORK ELEVATIONS CASEWORK ELEVATIONS AND DETAILS ELEVATIONS - INTERIOR ELEVATIONS - INTERIOR SECTIONS - BUILDING SECTIONS - WALL SECTIONS - WALL
A-511 A-512 A-513 A-515 A-527 A-528 A-601 A-621 A-622 A-623 A-624	CASEWORK ELEVATIONS CASEWORK ELEVATIONS CASEWORK ELEVATIONS CASEWORK ELEVATIONS AND DETAILS ELEVATIONS - INTERIOR ELEVATIONS - INTERIOR SECTIONS - BUILDING SECTIONS - WALL SECTIONS - WALL SECTIONS - WALL SECTIONS - WALL
A-511 A-512 A-513 A-515 A-527 A-528 A-601 A-621 A-621 A-622 A-623 A-624 A-625	CASEWORK ELEVATIONS CASEWORK ELEVATIONS CASEWORK ELEVATIONS CASEWORK ELEVATIONS AND DETAILS ELEVATIONS - INTERIOR ELEVATIONS - INTERIOR SECTIONS - BUILDING SECTIONS - WALL SECTIONS - WALL
A-721 A-722 A-801A A-801B A-804	CASEWORK ELEVATIONS CASEWORK ELEVATIONS CASEWORK ELEVATIONS AND DETAILS ELEVATIONS - INTERIOR ELEVATIONS - INTERIOR SECTIONS - BUILDING SECTIONS - WALL SECTIONS - WALL DETAILS - PLAN EXTERIOR DETAILS - PLAN INTERIOR DETAILS - PLAN INTERIOR DETAILS - WALL SECTIONS DETAILS - WALL SECTIONS DETAILS - WALL SECTIONS PARTITION TYPES PARTITION TYPES PARTITION TYPES
A-511 A-512 A-513 A-515 A-527 A-528 A-601 A-621 A-622 A-623 A-624 A-625 A-626 A-625 A-626 A-627 A-628 A-701 A-702 A-710 A-721 A-722 A-801A A-801B A-804 A-810	CASEWORK ELEVATIONS CASEWORK ELEVATIONS CASEWORK ELEVATIONS AND DETAILS CASEWORK ELEVATIONS AND DETAILS ELEVATIONS - INTERIOR ELEVATIONS - INTERIOR SECTIONS - BUILDING SECTIONS - WALL SECTIONS - WALL DETAILS - PLAN EXTERIOR DETAILS - PLAN EXTERIOR DETAILS - PLAN INTERIOR DETAILS - PLAN INTERIOR DETAILS - WALL SECTIONS PARTITION TYPES PARTITION TYPES DOOR PANEL AND FRAME TYPES WINDOW AND LOUVER TYPES
A-511 A-512 A-513 A-515 A-527 A-528 A-601 A-621 A-622 A-623 A-624 A-625 A-626 A-625 A-626 A-627 A-628 A-701 A-702 A-710 A-702 A-710 A-721 A-722 A-801A A-801B A-804 A-810 A-811	CASEWORK ELEVATIONS CASEWORK ELEVATIONS CASEWORK ELEVATIONS AND DETAILS ELEVATIONS - INTERIOR ELEVATIONS - INTERIOR SECTIONS - BUILDING SECTIONS - WALL SECTIONS - WALL SECTIO
A-511 A-512 A-513 A-515 A-527 A-528 A-601 A-621 A-622 A-623 A-624 A-625 A-626 A-625 A-626 A-627 A-628 A-701 A-702 A-710 A-721 A-722 A-801A A-801B A-804 A-810	CASEWORK ELEVATIONS CASEWORK ELEVATIONS CASEWORK ELEVATIONS AND DETAILS CASEWORK ELEVATIONS AND DETAILS ELEVATIONS - INTERIOR ELEVATIONS - INTERIOR SECTIONS - BUILDING SECTIONS - WALL SECTIONS - WALL DETAILS - PLAN EXTERIOR DETAILS - PLAN EXTERIOR DETAILS - PLAN INTERIOR DETAILS - PLAN INTERIOR DETAILS - WALL SECTIONS PARTITION TYPES PARTITION TYPES DOOR PANEL AND FRAME TYPES WINDOW AND LOUVER TYPES
A-511 A-512 A-513 A-515 A-527 A-528 A-601 A-621 A-621 A-622 A-623 A-624 A-625 A-626 A-627 A-626 A-627 A-628 A-701 A-702 A-710 A-702 A-710 A-721 A-722 A-801A A-801B A-801B A-804 A-810 A-811 A-831 A-832 INTERIOR FINISHES	CASEWORK ELEVATIONS CASEWORK ELEVATIONS CASEWORK ELEVATIONS AND DETAILS ELEVATIONS - INTERIOR ELEVATIONS - INTERIOR SECTIONS - BUILDING SECTIONS - WALL SECTIONS - WALL DETAILS - PLAN EXTERIOR DETAILS - PLAN EXTERIOR DETAILS - PLAN INTERIOR DETAILS - VALL SECTIONS DETAILS - WALL SECTIONS PARTITION TYPES PARTITION TYPES DOOR PANEL AND FRAME TYPES WINDOW AND LOUVER TYPES DETAILS - DOOR AND WINDOW- EXTERIOR DETAILS - DOOR AND WINDOW- INTERIOR
A-511 A-512 A-513 A-515 A-527 A-528 A-601 A-621 A-621 A-622 A-623 A-624 A-625 A-626 A-625 A-626 A-627 A-628 A-701 A-702 A-710 A-702 A-710 A-710 A-721 A-722 A-801A A-801B A-802B A-801B A-802B	CASEWORK ELEVATIONS CASEWORK ELEVATIONS CASEWORK ELEVATIONS CASEWORK ELEVATIONS AND DETAILS ELEVATIONS - INTERIOR ELEVATIONS - INTERIOR SECTIONS - BUILDING SECTIONS - WALL SECTIONS - WALL DETAILS - PLAN EXTERIOR DETAILS - PLAN EXTERIOR DETAILS - PLAN INTERIOR DETAILS - PLAN INTERIOR DETAILS - WALL SECTIONS PARTITION TYPES PARTITION TYPES PARTITION TYPES DOOR PANEL AND FRAME TYPES WINDOW AND LOUVER TYPES WINDOW AND LOUVER TYPES DETAILS - DOOR AND WINDOW- EXTERIOR DETAILS - DOOR AND WINDOW- INTERIOR
A-511 A-512 A-513 A-515 A-527 A-528 A-601 A-621 A-621 A-622 A-623 A-624 A-625 A-626 A-627 A-626 A-627 A-628 A-701 A-702 A-710 A-702 A-710 A-721 A-722 A-801A A-801B A-801B A-804 A-810 A-811 A-831 A-832 INTERIOR FINISHES	CASEWORK ELEVATIONS CASEWORK ELEVATIONS CASEWORK ELEVATIONS AND DETAILS ELEVATIONS - INTERIOR ELEVATIONS - INTERIOR SECTIONS - BUILDING SECTIONS - WALL SECTIONS - WALL DETAILS - PLAN EXTERIOR DETAILS - PLAN EXTERIOR DETAILS - PLAN INTERIOR DETAILS - VALL SECTIONS DETAILS - WALL SECTIONS PARTITION TYPES PARTITION TYPES DOOR PANEL AND FRAME TYPES WINDOW AND LOUVER TYPES DETAILS - DOOR AND WINDOW- EXTERIOR DETAILS - DOOR AND WINDOW- INTERIOR
A-511 A-512 A-513 A-515 A-527 A-528 A-601 A-621 A-621 A-622 A-623 A-624 A-625 A-626 A-627 A-626 A-627 A-628 A-701 A-702 A-710 A-702 A-710 A-721 A-722 A-801A A-801B A-801B A-801B A-801B A-801B A-811 A-831 A-832 INTERIOR FINISHES AF100 AF101B AF101B.1 AF101F.1	CASEWORK ELEVATIONS CASEWORK ELEVATIONS CASEWORK ELEVATIONS AND DETAILS ELEVATIONS - INTERIOR ELEVATIONS - INTERIOR SECTIONS - BUILDING SECTIONS - WALL SECTIONS - WALL SECTIO
A-511 A-512 A-513 A-515 A-527 A-528 A-601 A-621 A-621 A-622 A-623 A-624 A-625 A-626 A-627 A-626 A-627 A-628 A-701 A-702 A-710 A-702 A-710 A-702 A-710 A-721 A-722 A-801A A-801B A-804 A-801B A-804 A-810 A-811 A-831 A-831 A-832 INTERIOR FINISHES AF100 AF101B AF101B.1 AF101F.1 AF101F.1 AF101G	CASEWORK ELEVATIONS CASEWORK ELEVATIONS CASEWORK ELEVATIONS AND DETAILS ELEVATIONS - INTERIOR ELEVATIONS - INTERIOR SECTIONS - BUILDING SECTIONS - WALL SECTIONS - WALL SECTIO
A-511 A-512 A-513 A-515 A-527 A-528 A-601 A-621 A-621 A-622 A-623 A-624 A-625 A-626 A-627 A-626 A-627 A-628 A-701 A-702 A-710 A-702 A-710 A-721 A-722 A-801A A-801B A-801B A-801B A-801B A-801B A-811 A-831 A-832 INTERIOR FINISHES AF100 AF101B AF101B.1 AF101F.1	CASEWORK ELEVATIONS CASEWORK ELEVATIONS CASEWORK ELEVATIONS AND DETAILS ELEVATIONS - INTERIOR ELEVATIONS - INTERIOR SECTIONS - BUILDING SECTIONS - WALL SECTIONS - WALL SECTIO
A-511 A-512 A-513 A-515 A-527 A-528 A-601 A-621 A-622 A-623 A-624 A-625 A-626 A-625 A-626 A-627 A-628 A-701 A-702 A-710 A-702 A-710 A-702 A-710 A-721 A-722 A-801A A-801B A-801B A-801B A-801B A-801B A-801B A-801B A-801B A-810 A-811 A-831 A-832 INTERIOR FINISHES AF100 AF101B.1 AF101B.1 AF101F.1 AF101G.1 AF101H AF101H AF101J	CASEWORK ELEVATIONS CASEWORK ELEVATIONS CASEWORK ELEVATIONS CASEWORK ELEVATIONS AND DETAILS ELEVATIONS - INTERIOR ELEVATIONS - INTERIOR SECTIONS - BUILDING SECTIONS - WALL SECTIONS - WALL DETAILS - PLAN EXTERIOR DETAILS - PLAN EXTERIOR DETAILS - PLAN INTERIOR DETAILS - PLAN INTERIOR DETAILS - WALL SECTIONS DETAILS - WALL SECTIONS PARTITION TYPES PARTITION TYPES PARTITION TYPES DOOR PANEL AND FRAME TYPES WINDOW AND LOUVER TYPES WINDOW AND LOUVER TYPES DETAILS - DOOR AND WINDOW- EXTERIOR DETAILS - DOOR AND WINDOW- INTERIOR DETAILS - DOOR AND WINDOW- INTERIOR TIST LEVEL - FINISH PLAN - AREA B 1ST LEVEL - FINISH PLAN - AREA A - ALTERNATE #04 1ST LEVEL - FINISH PLAN - AREA G 1ST LEVEL - FINISH PLAN - AREA G 1ST LEVEL - FINISH PLAN - AREA A - ALTERNATE #04 1ST LEVEL - FINISH PLAN - AREA A - ALTERNATE #04 1ST LEVEL - FINISH PLAN - AREA A G 1ST LEVEL - FINISH PLAN - AREA A G 1ST LEVEL - FINISH PLAN - AREA A G 1ST LEVEL - FINISH PLAN - AREA A G
A-511 A-512 A-513 A-515 A-527 A-528 A-601 A-621 A-622 A-623 A-624 A-625 A-626 A-627 A-626 A-627 A-628 A-701 A-702 A-701 A-702 A-710 A-702 A-710 A-721 A-722 A-801A A-810 A-811 A-801B A-804 A-810 A-811 A-831 A-831 A-832 INTERIOR FINISHES AF100 AF101B AF101B.1 AF101F.1 AF101F.1 AF101G AF101J AF101J AF101J AF101J AF101J AF101J	CASEWORK ELEVATIONS CASEWORK ELEVATIONS CASEWORK ELEVATIONS ASEWORK ELEVATIONS AND DETAILS ELEVATIONS - INTERIOR ELEVATIONS - INTERIOR SECTIONS - BUILDING SECTIONS - WALL SECTIONS - PLAN EXTERIOR DETAILS - PLAN EXTERIOR DETAILS - PLAN EXTERIOR DETAILS - DOOR AND FRAME TYPES WINDOW AND LOUVER TYPES WINDOW AND LOUVER TYPES WINDOW AND LOUVER TYPES WINDOW AND LOUVER TYPES DETAILS - DOOR AND WINDOW- EXTERIOR DETAILS - DOOR AND WINDOW- INTERIOR FINISH SCHEDULE 1ST LEVEL - FINISH PLAN - AREA B 1ST LEVEL - FINISH PLAN - AREA B 1ST LEVEL - FINISH PLAN - AREA B 1ST LEVEL - FINISH PLAN - AREA G 1ST LEVEL - FINISH PLAN - AREA G 1ST LEVEL - FINISH PLAN - AREA G 1ST LEVEL - FINISH PLAN - AREA H 1ST LEVEL - FINISH PLAN - AREA J 1ST LEVEL - FINISH PLAN - AREA J
A-511 A-512 A-513 A-515 A-527 A-528 A-601 A-621 A-622 A-623 A-624 A-625 A-626 A-627 A-626 A-627 A-628 A-701 A-702 A-701 A-702 A-710 A-702 A-710 A-721 A-722 A-801A A-801B A-804 A-801B A-804 A-810 A-811 A-831 A-831 A-832 INTERIOR FINISHES AF100 AF101B AF101B.1 AF101F.1 AF101G AF101G AF101J AF101K AF101K AF101K AF101L	CASEWORK ELEVATIONS CASEWORK ELEVATIONS CASEWORK ELEVATIONS ASEWORK ELEVATIONS AND DETAILS ELEVATIONS - INTERIOR ELEVATIONS - INTERIOR SECTIONS - BUILDING SECTIONS - WALL SECTIONS - PLAN EXTERIOR DETAILS - PLAN EXTERIOR DETAILS - PLAN INTERIOR DOOR PANEL AND FRAME TYPES WINDOW AND LOUVER TYPES DOOR PANEL AND FRAME TYPES WINDOW AND LOUVER TYPES DOOR PANEL AND FRAME TYPES WINDOW AND LOUVER TYPES DETAILS - DOOR AND WINDOW- EXTERIOR DETAILS - DOOR AND WINDOW- INTERIOR FINISH SCHEDULE 1ST LEVEL - FINISH PLAN - AREA B 1ST LEVEL - FINISH PLAN - AREA B 1ST LEVEL - FINISH PLAN - AREA B 1ST LEVEL - FINISH PLAN - AREA G 1ST LEVEL - FINISH PLAN - AREA G 1ST LEVEL - FINISH PLAN - AREA G 1ST LEVEL - FINISH PLAN - AREA A 1ST LEVEL - FINISH PLAN - AREA A 1ST LEVEL - FINISH PLAN - AREA J 1ST LEVEL - FINISH PLAN - AREA K 1ST LEVEL - FINISH PLAN - AREA K 1ST LEVEL - FINISH PLAN - AREA K 1ST LEVEL - FINISH PLAN - AREA K
A-511 A-512 A-513 A-515 A-527 A-528 A-601 A-621 A-622 A-623 A-624 A-625 A-626 A-627 A-626 A-627 A-628 A-701 A-702 A-701 A-702 A-710 A-702 A-710 A-721 A-722 A-801A A-810 A-811 A-801B A-804 A-810 A-811 A-831 A-831 A-832 INTERIOR FINISHES AF100 AF101B AF101B.1 AF101F.1 AF101F.1 AF101G AF101J AF101J AF101J AF101J AF101J AF101J	CASEWORK ELEVATIONS CASEWORK ELEVATIONS CASEWORK ELEVATIONS ASEWORK ELEVATIONS AND DETAILS ELEVATIONS - INTERIOR ELEVATIONS - INTERIOR SECTIONS - BUILDING SECTIONS - WALL SECTIONS - PLAN EXTERIOR DETAILS - PLAN EXTERIOR DETAILS - PLAN EXTERIOR DETAILS - DOOR AND FRAME TYPES WINDOW AND LOUVER TYPES WINDOW AND LOUVER TYPES WINDOW AND LOUVER TYPES WINDOW AND LOUVER TYPES DETAILS - DOOR AND WINDOW- EXTERIOR DETAILS - DOOR AND WINDOW- INTERIOR FINISH SCHEDULE 1ST LEVEL - FINISH PLAN - AREA B 1ST LEVEL - FINISH PLAN - AREA B 1ST LEVEL - FINISH PLAN - AREA B 1ST LEVEL - FINISH PLAN - AREA G 1ST LEVEL - FINISH PLAN - AREA G 1ST LEVEL - FINISH PLAN - AREA G 1ST LEVEL - FINISH PLAN - AREA H 1ST LEVEL - FINISH PLAN - AREA J 1ST LEVEL - FINISH PLAN - AREA J
A-511 A-512 A-513 A-515 A-527 A-528 A-601 A-621 A-622 A-623 A-624 A-625 A-626 A-627 A-628 A-701 A-702 A-701 A-702 A-710 A-710 A-721 A-722 A-801A A-801B A-804 A-810 A-811 A-831 A-831 A-831 A-832 INTERIOR FINISHES AF100 AF101B AF101B.1 AF101F.1 AF101F.1 AF101H AF101J AF101H AF101J AF101L AF101N.1 AF101P.1 AF101P.1 AF101S	CASEWORK ELEVATIONS CASEWORK ELEVATIONS CASEWORK ELEVATIONS AND DETAILS ELEVATIONS - INTERIOR ELEVATIONS - INTERIOR SECTIONS - BUILDING SECTIONS - BUILDING SECTIONS - WALL SECTIONS - PLAN EXTERIOR DETAILS - PLAN INTERIOR DETAILS - WALL SECTIONS PARTITION TYPES PARTITION TYPES DOOR PANEL AND FRAME TYPES WINDOW AND LOUVER TYPES WINDOW AND LOUVER TYPES DOOR PANEL AND FRAME TYPES WINDOW AND LOUVER TYPES DETAILS - DOOR AND WINDOW- INTERIOR DETAILS - DOOR AND WINDOW- INTERIOR SECTIONS - WALL SI LEVEL - FINISH PLAN - AREA B 1ST LEVEL - FINISH PLAN - AREA B 1ST LEVEL - FINISH PLAN - AREA B 1ST LEVEL - FINISH PLAN - AREA G 1ST LEVEL - FINISH PLAN - AREA G 1ST LEVEL - FINISH PLAN - AREA G 1ST LEVEL - FINISH PLAN - AREA A 1ST LEVEL - FINISH PLAN - ARE
A-511 A-512 A-513 A-515 A-527 A-528 A-601 A-621 A-622 A-623 A-624 A-625 A-626 A-627 A-628 A-701 A-702 A-701 A-702 A-710 A-721 A-702 A-710 A-721 A-722 A-801A A-801B A-804 A-801B A-804 A-810 A-811 A-831 A-831 A-832 INTERIOR FINISHES AF100 AF101B AF101B.1 AF101B.1 AF101B.1 AF101G AF101G AF101G AF101J AF101H AF101J AF101L AF101L AF101N.1 AF101S AF101S AF101U	CASEWORK ELEVATIONS CASEWORK ELEVATIONS CASEWORK ELEVATIONS AND DETAILS ELEVATIONS - INTERIOR ELEVATIONS - INTERIOR SECTIONS - BUILDING SECTIONS - BUILDING SECTIONS - WALL SECTIONS - PLAN EXTERIOR DETAILS - PLAN INTERIOR DETAILS - VALL SECTIONS PARTITION TYPES PARTITION TYPES DOOR PANEL AND FRAME TYPES WINDOW AND LOUVER TYPES WINDOW AND LOUVER TYPES DOOR PANEL AND FRAME TYPES WINDOW AND LOUVER TYPES DETAILS - DOOR AND WINDOW- INTERIOR DETAILS - DOOR AND WINDOW- INTERIOR DETAILS - DOOR AND WINDOW- INTERIOR SECTIONS - WALL SIT LEVEL - FINISH PLAN - AREA B 1ST LEVEL - FINISH PLAN - AREA B 1ST LEVEL - FINISH PLAN - AREA G 1ST LEVEL - FINISH PLAN - AREA G 1ST LEVEL - FINISH PLAN - AREA G 1ST LEVEL - FINISH PLAN - AREA A 1ST LEVEL - FINISH PLAN - AREA S 1ST LEVEL - FINISH PLAN - AREA S
A-511 A-512 A-513 A-515 A-527 A-528 A-601 A-621 A-622 A-623 A-624 A-625 A-626 A-627 A-628 A-701 A-702 A-710 A-702 A-710 A-721 A-722 A-801A A-801B A-804 A-801B A-804 A-810 A-811 A-831 A-831 A-832 INTERIOR FINISHES AF100 AF101B AF101B.1 AF101B.1 AF101B.1 AF101B.1 AF101B.1 AF101C.1 AF101H AF101J AF101H AF101J AF101L AF101N.1 AF101L AF101N.1 AF101S AF101U AF102A	CASEWORK ELEVATIONS CASEWORK ELEVATIONS CASEWORK ELEVATIONS AND DETAILS ELEVATIONS - INTERIOR ELEVATIONS - INTERIOR SECTIONS - BUILDING SECTIONS - BUILDING SECTIONS - WALL SECTIONS - PLAN EXTERIOR DETAILS - PLAN INTERIOR DETAILS - WALL SECTIONS PARTITION TYPES PARTITION TYPES DOOR PANEL AND FRAME TYPES WINDOW AND LOUVER TYPES WINDOW AND LOUVER TYPES DOOR PANEL AND FRAME TYPES WINDOW AND LOUVER TYPES DETAILS - DOOR AND WINDOW- INTERIOR DETAILS - DOOR AND WINDOW- INTERIOR SECTIONS - WALL SI LEVEL - FINISH PLAN - AREA B 1ST LEVEL - FINISH PLAN - AREA B 1ST LEVEL - FINISH PLAN - AREA B 1ST LEVEL - FINISH PLAN - AREA G 1ST LEVEL - FINISH PLAN - AREA G 1ST LEVEL - FINISH PLAN - AREA G 1ST LEVEL - FINISH PLAN - AREA A 1ST LEVEL - FINISH PLAN - ARE
A-511 A-512 A-513 A-515 A-527 A-528 A-601 A-621 A-622 A-623 A-624 A-625 A-626 A-627 A-628 A-701 A-702 A-701 A-702 A-710 A-721 A-702 A-710 A-721 A-722 A-801A A-801B A-804 A-801B A-804 A-810 A-811 A-831 A-831 A-832 INTERIOR FINISHES AF100 AF101B AF101B.1 AF101B.1 AF101B.1 AF101G AF101G AF101G AF101J AF101H AF101J AF101L AF101L AF101N.1 AF101S AF101S AF101U	CASEWORK ELEVATIONS CASEWORK ELEVATIONS CASEWORK ELEVATIONS AND DETAILS ELEVATIONS - INTERIOR ELEVATIONS - INTERIOR SECTIONS - BUILDING SECTIONS - BUILDING SECTIONS - WALL SECTIONS - PLAN EXTERIOR DETAILS - PLAN EXTERIOR DETAILS - PLAN EXTERIOR DETAILS - PLAN EXTERIOR DETAILS - WALL SECTIONS DETAILS - DOOR AND WINDOW- EXTERIOR DETAILS - DOOR AND WINDOW- EXTERIOR DETAILS - DOOR AND WINDOW- INTERIOR DETAILS - FINISH PLAN - AREA B 1ST LEVEL - FINISH PLAN - AREA B 1ST LEVEL - FINISH PLAN - AREA A 1ST LEVEL - FINISH PLAN - AREA
A-511 A-512 A-513 A-515 A-527 A-528 A-601 A-621 A-622 A-623 A-624 A-625 A-626 A-627 A-626 A-627 A-628 A-701 A-702 A-701 A-702 A-710 A-721 A-702 A-710 A-721 A-722 A-801A A-801B A-804 A-801B A-804 A-810 A-811 A-831 A-832 INTERIOR FINISHES AF100 AF101B AF101B.1 AF101B.1 AF101B.1 AF101B AF101B.1 AF101B AF101B AF101C AF101C AF101C AF101C AF101C AF101L AF101L AF101L AF101L AF101N.1 AF101S AF102A AF102B AF102B AF102B AF102B	CASEWORK ELEVATIONS CASEWORK ELEVATIONS CASEWORK ELEVATIONS AND DETAILS ELEVATIONS - INTERIOR ELEVATIONS - INTERIOR SECTIONS - WALL SECTIONS - WALL DETAILS - PLAN EXTERIOR DETAILS - WALL SECTIONS PARTITION TYPES PARTITION TYPES PARTITION TYPES PARTITION TYPES DOOR PANEL AND FRAME TYPES WINDOW AND LOUVER TYPES WINDOW AND LOUVER TYPES DETAILS - DOOR AND WINDOW- EXTERIOR DETAILS - DOOR AND WINDOW- INTERIOR DETAILS - DOOR AND WINDOW - INTERIOR FINISH SCHEDULE 1ST LEVEL - FINISH PLAN - AREA B - ALTERNATE #04 1ST LEVEL - FINISH PLAN - AREA G 1ST LEVEL - FINISH PLAN - AREA M 1ST LEVEL - FINISH PLAN - AREA M
A-511 A-512 A-513 A-515 A-527 A-528 A-601 A-621 A-621 A-622 A-623 A-624 A-625 A-626 A-627 A-626 A-627 A-628 A-701 A-702 A-710 A-702 A-710 A-721 A-722 A-801A A-801B A-804 A-801B A-804 A-810 A-811 A-831 A-831 A-832 INTERIOR FINISHES AF100 AF101B.1 AF101B.1 AF101B.1 AF101B.1 AF101B.1 AF101B.1 AF101B AF101B.1 AF101B AF101B.1 AF101C.1 AF100.2 AF100.2 AF100.2 AF10.2 AF10.2 AF10.2 AF10.2 AF10.2 AF10.2 A	CASEWORK ELEVATIONS CASEWORK ELEVATIONS CASEWORK ELEVATIONS CASEWORK ELEVATIONS AND DETAILS ELEVATIONS - INTERIOR ELEVATIONS - INTERIOR SECTIONS - WALL SECTIONS - WALL SECTONS - WALL SECTO
A-511 A-512 A-513 A-515 A-527 A-528 A-601 A-621 A-622 A-623 A-624 A-625 A-626 A-627 A-628 A-701 A-702 A-701 A-702 A-710 A-721 A-702 A-710 A-721 A-722 A-801A A-801B A-804 A-810 A-811 A-801B A-804 A-810 A-811 A-832 INTERIOR FINISHES AF100 AF101B AF101B.1 AF101B AF101B.1 AF101B AF101G AF101G AF101G AF101G AF101G AF101L AF101L AF101L AF101L AF101N.1 AF101S AF102A AF102A AF102B AF102B AF102B AF102B AF102B.1	CASEWORK ELEVATIONS CASEWORK ELEVATIONS CASEWORK ELEVATIONS AND DETAILS ELEVATIONS - INTERIOR ELEVATIONS - INTERIOR SECTIONS - WALL SECTIONS - WALL DETAILS - PLAN EXTERIOR DETAILS - WALL SECTIONS PARTITION TYPES PARTITION TYPES PARTITION TYPES PARTITION TYPES DOOR PANEL AND FRAME TYPES WINDOW AND LOUVER TYPES WINDOW AND LOUVER TYPES DETAILS - DOOR AND WINDOW- EXTERIOR DETAILS - DOOR AND WINDOW- INTERIOR DETAILS - DOOR AND WINDOW - INTERIOR FINISH SCHEDULE 1ST LEVEL - FINISH PLAN - AREA B - ALTERNATE #04 1ST LEVEL - FINISH PLAN - AREA G 1ST LEVEL - FINISH PLAN - AREA M 1ST LEVEL - FINISH PLAN - AREA M
A-511 A-512 A-513 A-515 A-527 A-528 A-601 A-621 A-622 A-623 A-624 A-625 A-626 A-627 A-626 A-627 A-628 A-701 A-702 A-710 A-702 A-710 A-712 A-702 A-710 A-721 A-722 A-801A A-801B A-804 A-810 A-811 A-831 A-831 A-832 INTERIOR FINISHES AF100 AF101B AF101B.1 AF101F.1 AF101F.1 AF101F.1 AF101G AF101G.1 AF101H AF101J AF101L AF101L AF101N.1 AF101N.1 AF101N.1 AF101P.1 AF102A AF102B AF102B.1 AF102B.1 AF102F.1 AF102G	CASEWORK ELEVATIONS CASEWORK ELEVATIONS CASEWORK ELEVATIONS CASEWORK ELEVATIONS AND DETAILS ELEVATIONS - INTERIOR ELEVATIONS - INTERIOR SECTIONS - BUILDING SECTIONS - WALL SECTIONS - PLAN ENTERIOR - SECTIONS - WALL SECTIONS - PLAN - AREA B - ALTERNATE #04 1ST LEVEL - FINISH PLAN - AREA A - ALTERNATE #04 2ND LEVEL - FINISH PLAN - AREA A - ALTERNATE #04 2ND LEVEL - FINISH PLAN - AREA A - ALTERNATE #04 2ND LEVEL - FINISH PLAN - AREA B - ALTERNATE #04 2ND LEVEL - FINISH PLAN - AREA B - ALTERNATE #04 2ND LEVEL - FINISH PLAN - AREA B - ALTERNATE #04 2ND LEVEL - FINISH PLAN - AREA A - ALTERNATE #04 2ND LEVEL - FINISH PLAN - AREA B - ALTE

ARCHITECTURE

VOLUME 2

	MECHANICAL
M-001	MECHANICAL GENERAL NOTES AND LEGENDS
MD-101.1	1ST LEVEL MECHANICAL DEMO PLAN - ALTERNATE 2
MD-101B	1ST LEVEL MECHANICAL DEMO PLAN - AREA B
MD-101G	1ST LEVEL MECHANICAL DEMO PLAN - AREA G
MD-102.1	2ND LEVEL MECHANICAL DEMO PLAN - ALTERNATE 2
MD-102A	2ND LEVEL MECHANICAL DEMO PLAN - AREA A
MD-102B	2ND LEVEL MECHANICAL DEMO PLAN - AREA B
MD-102G	2ND LEVEL MECHANICAL DEMO PLAN - AREA G
M-101	1ST LEVEL MECHANICAL PLAN - COMPOSITE
M-101A.1	1ST LEVEL MECHANICAL PLAN - AREA A - ALTERNATE 2
M-101B	1ST LEVEL MECHANICAL PLAN - AREA B
M-101B.1	1ST LEVEL MECHANICAL PLAN - AREA B - ALTERNATE 2
M-101C.1	1ST LEVEL MECHANICAL PLAN - AREA C - ALTERNATE 2
M-101D.1	1ST LEVEL MECHANICAL PLAN - AREA D - ALTERNATE 2
M-101E.1	1ST LEVEL MECHANICAL PLAN - AREA E - ALTERNATE 2
M-101F.1	1ST LEVEL MECHANICAL PLAN - AREA F - ALTERNATE 2
M-101G	1ST LEVEL MECHANICAL PLAN - AREA G - ALTERNATE 3
M-101G.1	1ST LEVEL MECHANICAL PLAN - AREA G - ALTERNATE 2
M-101J	1ST LEVEL MECHANICAL PLAN - AREA J
M-101K	1ST LEVEL MECHANICAL PLAN - AREA K
M-101K.1	1ST LEVEL MECHANICAL PLAN - AREA K - ALTERNATE 2
M-101L	1ST LEVEL MECHANICAL PLAN - AREA L
M-101L.1	1ST LEVEL MECHANICAL PLAN - AREA L - ALTERNATE 2
M-101M.1	1ST LEVEL MECHANICAL PLAN - AREA M - ALTERNATE 2
M-101N.1	1ST LEVEL MECHANICAL PLAN - AREA N - ALTERNATE 2
M-101P.1	1ST LEVEL MECHANICAL PLAN - AREA P - ALTERNATE 2
M-101S	1ST LEVEL MECHANICAL PLAN - AREA S
M-102	2ND LEVEL MECHANICAL PLAN - COMPOSITE
M-102A	2ND LEVEL MECHANICAL PLAN - AREA A
M-102A.1	2ND LEVEL MECHANICAL PLAN - AREA A - ALTERNATE 2
M-102B	2ND LEVEL MECHANICAL PLAN - AREA B
M-102B.1	2ND LEVEL MECHANICAL PLAN - AREA B - ALTERNATE 2
M-102D.1	2ND LEVEL MECHANICAL PLAN - AREA D - ALTERNATE 2
M-102F.1	2ND LEVEL MECHANICAL PLAN - AREA F - ALTERNATE 2
M-102G	2ND LEVEL MECHANICAL PLAN - AREA G
M-102G.1	2ND LEVEL MECHANICAL PLAN - AREA G - ALTERNATE 2
M-102J	2ND LEVEL MECHANICAL PLAN - AREA J
M-102N.1	2ND LEVEL MECHANICAL PLAN - AREA N - ALTERNATE 2
M-201	
M-202	MECHANICAL ENLARGED PLANS
M-301	
M-401	
M-402	
M-501	
M-502 M-503	MECHANICAL SCHEDULES MECHANICAL SCHEDULES - ALTERNATE 3
M-601	
M-602 M-603	MECHANICAL DETAILS MECHANICAL DETAILS
WI-005	MECHANICAL DETAILS
	ELECTRICAL
ED101.2	1ST LEVEL POWER DEMO PLAN - ALTERNATE 2

			P-703
ED101.2	1ST LEVEL POWER DEMO PLAN - ALTERNATE 2		
ED101G.3	1ST LEVEL POWER DEMO PLAN - AREA G - ALTERNATE 3		
ED101J	1ST LEVEL POWER DEMO PLAN - AREA J		
ED101K ED101U	1ST LEVEL POWER DEMO PLAN - AREA K 1ST LEVEL POWER DEMO PLAN - AREA U		
ED1010	2ND LEVEL POWER DEMO PLAN - ALTERNATE 2		
ED102G.3	2ND LEVEL POWER DEMO PLAN - AREA G - ALTERNATE 3		
ES-101	ELECTRICAL SITE PLAN		
E 4044			T-001
E-101A	1ST LEVEL POWER PLAN - AREA A		TD-101J
E-101B E-101C	1ST LEVEL POWER PLAN - AREA B 1ST LEVEL POWER PLAN - AREA C		TD-101K
E-101C	IST LEVEL POWER PLAN - AREA C IST LEVEL POWER PLAN - AREA E		TF-101A.1
E-101F	1ST LEVEL POWER PLAN - AREA F		TF-101B
E-101G	1ST LEVEL POWER PLAN - AREA G		TF-101B.1
E-101G.3	1ST LEVEL POWER PLAN - AREA G ALTERNATE #3		TF-101C.1
E-101J	1ST LEVEL POWER PLAN - AREA J		TF-101D.1
E-101K	1ST LEVEL POWER PLAN - AREA K		TF-101E.1
E-101K.1	1ST LEVEL POWER PLAN - AREA K ALTERNATE #1		TF-101F.1
E-101L	1ST LEVEL POWER PLAN - AREA L		TF-101G TF-101G.1
E-101N	1ST LEVEL POWER PLAN - AREA N		TF-101G.1 TF-101G.2
E-101R	1ST LEVEL POWER PLAN - AREA R		TF-101G.2
E-101S	1ST LEVEL POWER PLAN - AREA S		TF-101K
E-101U			TF-101K.2
E-102A E-102B	2ND LEVEL POWER PLAN - AREA A 2ND LEVEL POWER PLAN - AREA B		TF-101L
E-102G	2ND LEVEL POWER PLAN - AREA G		TF-101L.1
E-102G.3	2ND LEVEL POWER PLAN - AREA G ALTERNATE #3		TF-101M.1
E-103B	ELECTRICAL ROOF PLAN - AREA B		TF-101N.1
E-103G	ELECTRICAL ROOF PLAN - AREA G		TF-101P.1
E-103J	ELECTRICAL ROOF PLAN - AREA J		TF-101S
E-103S	ELECTRICAL ROOF PLAN - AREA S		TF-102A.1
E-201A	1ST LEVEL LIGHTING PLAN - AREA A		TF-102B
E-201A.2	1ST LEVEL LIGHTING PLAN - AREA A - ALTERNATE 2		TF-102B.1 TF-102C.1
E-201B	1ST LEVEL LIGHTING PLAN - AREA B		TF-102C.1 TF-102D.1
E-201B.2	1ST LEVEL LIGHTING PLAN - AREA B - ALTERNATE 2		TF-102D.1
E-201C	1ST LEVEL LIGHTING PLAN - AREA C		TF-102G
E-201C.2 E-201D	1ST LEVEL LIGHTING PLAN - AREA C - ALTERNATE 2 1ST LEVEL LIGHTING PLAN - AREA D		TF-102G.1
E-201D E-201D.2	IST LEVEL LIGHTING PLAN - AREA D IST LEVEL LIGHTING PLAN - AREA D - ALTERNATE 2		TF-102G.2
E-201E.2	1ST LEVEL LIGHTING PLAN - AREA E - ALTERNATE 2	\wedge	TF-102N.1
E-201F.2	1ST LEVEL LIGHTING PLAN - AREA F - ALTERNATE 2	<u></u>	TN-101A
E-201G.2	1ST LEVEL LIGHTING PLAN - AREA G - ALTERNATE 2		TN-101B
E-201G.3	1ST LEVEL LIGHTING PLAN - AREA G - ALTERNATE 3		TN-101B.1
E-201G.8	1ST LEVEL LIGHTING PLAN - AREA G - ALTERNATE 8		TN-101E.2
E-201H	1ST LEVEL LIGHTING PLAN - AREA H		TN-101G TN-101G.1
E-201J	1ST LEVEL LIGHTING PLAN - AREA J		TN-101G.1 TN-101G.2
E-201K	1ST LEVEL LIGHTING PLAN - AREA K		TN-101G.3
E-201L	1ST LEVEL LIGHTING PLAN - AREA L		TN-101J
E-201L.2 E-201M.2	1ST LEVEL LIGHTING PLAN - AREA L - ALTERNATE 2 1ST LEVEL LIGHTING PLAN - AREA M - ALTERNATE 2		TN-101K
E-201N.2	1ST LEVEL LIGHTING PLAN - AREA N - ALTERNATE 2		TN-101L
E-201P.2	1ST LEVEL LIGHTING PLAN - AREA P - ALTERNATE 2		TN-101L.1
E-201S	1ST LEVEL LIGHTING PLAN - AREA S		TN-101P.2
E-202A.2	2ND LEVEL LIGHTING PLAN - AREA A - ALTERNATE 2		TN-101S
E-202B	2ND LEVEL LIGHTING PLAN - AREA B		TN-101T
E-202B.2	2ND LEVEL LIGHTING PLAN - AREA B - ALTERNATE 2		TN-102A.1
E-202C	2ND LEVEL LIGHTING PLAN - AREA C		TN-102A.2 TN-102B
E-202F.2	2ND LEVEL LIGHTING PLAN - AREA F - ALTERNATE 2	\wedge	TN-102B TN-102B.1
E-202G.2	2ND LEVEL LIGHTING PLAN - AREA G - ALTERNATE 2	<u> </u>	TN-102B.1 TN-102F.2
E-202G.3	2ND LEVEL LIGHTING PLAN - AREA G - ALTERNATE 3 2ND LEVEL LIGHTING PLAN - AREA H		TN-102G.1
E-202H E-202N.2	2ND LEVEL LIGHTING PLAN - AREA H 2ND LEVEL LIGHTING PLAN - AREA N - ALTERNATE 2		TN-102G.2
E-202N.2 E-502	ELECTRICAL RISER DIAGRAM		TN-102G.3
E-601	ELECTRICAL SYMBOL LEGEND AND CONTACTOR SCHEDULE	1\	TN-102N.1
E-602	ELECTRICAL DETAILS		TS-101
E-701	ELECTRICAL PANEL SCHEDULES		
E-702	ELECTRICAL PANEL SCHEDULES		
E-703	ELECTRICAL PANEL SCHEDULES		

	PLUMBING
PU-101J	1ST LEVEL UNDERFLOOR PLUMBING PLAN - AREA J
PU-101K	1ST LEVEL UNDERFLOOR PLUMBING PLAN - AREA K
PU-101L	1ST LEVEL UNDERFLOOR PLUMBING PLAN - AREA L
PU-101M	1ST LEVEL UNDERFLOOR PLUMBING PLAN - AREA M
PU-101Q	1ST LEVEL UNDERFLOOR PLUMBING PLAN - AREA Q
PU-101S	1ST LEVEL UNDERFLOOR PLUMBING PLAN - AREA S
P-101	1ST LEVEL PLUMBING PLAN - COMPOSITE
P-101A	1ST LEVEL PLUMBING PLAN - AREA A
P-101A.1	1ST LEVEL PLUMBING PLAN - AREA A - ALTERNATE 2
P-101B	1ST LEVEL PLUMBING PLAN - AREA B
P-101B.1	1ST LEVEL PLUMBING PLAN - AREA B - ALTERNATE 2
P-101D.1	1ST LEVEL PLUMBING PLAN - AREA D - ALTERNATE 2
P-101E.1	1ST LEVEL PLUMBING PLAN - AREA E - ALTERNATE 2
P-101F	1ST LEVEL PLUMBING PLAN - AREA F
P-101F.1	1ST LEVEL PLUMBING PLAN - AREA F - ALTERNATE 2
P-101G	1ST LEVEL PLUMBING PLAN - AREA G
P-101G.1	1ST LEVEL PLUMBING PLAN - AREA G - ALTERNATE 2
P-101H	1ST LEVEL PLUMBING PLAN - AREA H
P-101J	1ST LEVEL PLUMBING PLAN - AREA J
P-101K	1ST LEVEL PLUMBING PLAN - AREA K
P-101L	1ST LEVEL PLUMBING PLAN - AREA L
P-101L.1	1ST LEVEL PLUMBING PLAN - AREA L - ALTERNATE 2
P-102S	2ND LEVEL PLUMBING PLAN - AREA S
P-301	PLUMBING ROOF PLAN
P-401	ENLARGED PLANS AREA B
P-402	ENLARGED PLANS AREA B
P-403	ENLARGED PLANS AREA G
P-404	ENLARGED PLANS AREA G1
P-405	ENLARGED PLANS AREA G2
P-500	PLUMBING EQUIPMENT SCHEDULE
P-601	PLUMBING DETAILS
P-602	PLUMBING DETAILS
P-603	PLUMBING DETAILS
P-701	PLUMBING RISER DIAGRAMS AREA B - DOMESTIC WATER
P-702	PLUMBING RISER DIAGRAM AREA B - WASTE & VENT
P-703	PLUMBING RISER DIAGRAM AREA B - NATURAL GAS


TECHNOLOGY


TECHNOLOGY SYSTEM NOTES AND LEGENDS
1ST LEVEL TECHNOLOGY DEMO PLAN - AREA J
1ST LEVEL FIRE ALARM DEMO PLAN - AREA K
1ST LEVEL FIRE ALARM PLAN - AREA A ATLERNATE 2
1ST LEVEL FIRE ALARM PLAN - AREA B
1ST LEVEL FIRE ALARM PLAN - AREA B ATLERNATE 2
1ST LEVEL FIRE ALARM PLAN - AREA C ATLERNATE 2
1ST LEVEL FIRE ALARM PLAN - AREA D ATLERNATE 2
1ST LEVEL FIRE ALARM PLAN - AREA E ATLERNATE 2
1ST LEVEL FIRE ALARM PLAN - AREA F ATLERNATE 2
1ST LEVEL FIRE ALARM PLAN - AREA G
1ST LEVEL FIRE ALARM PLAN - AREA G ATLERNATE 2
1ST LEVEL FIRE ALARM PLAN - AREA G ATLERNATE 3
1ST LEVEL FIRE ALARM PLAN - AREA J
1ST LEVEL FIRE ALARM PLAN - AREA K
1ST LEVEL FIRE ALARM PLAN - AREA K ATLERNATE 2
1ST LEVEL FIRE ALARM PLAN - AREA L
1ST LEVEL FIRE ALARM PLAN - AREA L ATLERNATE 2
1ST LEVEL FIRE ALARM PLAN - AREA M ATLERNATE 2
2ND LEVEL TECHNOLOGY PLAN - AREA G - ALTERNATE 2
2ND LEVEL TECHNOLOGY PLAN - AREA G - ALTERNATE 2 2ND LEVEL TECHNOLOGY PLAN - AREA G - ALTERNATE 3
2ND LEVEL TECHNOLOGY PLAN - AREA G - ALTERNATE 5
2ND LEVEL TECHNOLOGY PLAN - AREA N - ALTERNATE 2
TECHNOLOGY SITE PLAN

PLUMBING


E-703

P-000	PLUMBING COVER SHEET
PS-101	PLUMBING SITE PLAN
PD101.1	1ST LEVEL PLUMBING DEMO PLAN - ALTERNATE 2
PD101A	1ST LEVEL PLUMBING DEMO PLAN - AREA A
PD101B	1ST LEVEL PLUMBING DEMO PLAN - AREA B
PD101D	1ST LEVEL PLUMBING DEMO PLAN - AREA D
PD101E	1ST LEVEL PLUMBING DEMO PLAN - AREA E
2D101F	1ST LEVEL PLUMBING DEMO PLAN - AREA F
2D101G	1ST LEVEL PLUMBING DEMO PLAN - AREA G
PD101H	1ST LEVEL PLUMBING DEMO PLAN - AREA H
PD101K	1ST LEVEL PLUMBING DEMO PLAN - AREA K
PD101M	1ST LEVEL PLUMBING DEMO PLAN - AREA M
PD101N	1ST LEVEL PLUMBING DEMO PLAN - AREA N
PD101P	1ST LEVEL PLUMBING DEMO PLAN - AREA P
2D101R	1ST LEVEL PLUMBING DEMO PLAN - AREA R
PD102.1	2ND LEVEL PLUMBING DEMO PLAN - ALTERNATE 2
PD102A	2ND LEVEL PLUMBING DEMO PLAN - AREA A
PD102B	2ND LEVEL PLUMBING DEMO PLAN - AREA B
2D102F	2ND LEVEL PLUMBING DEMO PLAN - AREA F
PD102G	2ND LEVEL PLUMBING DEMO PLAN - AREA G
PD102H	2ND LEVEL PLUMBING DEMO PLAN - AREA H
PU-101A	1ST LEVEL UNDERFLOOR PLUMBING PLAN - AREA A
PU-101B	1ST LEVEL UNDERFLOOR PLUMBING PLAN - AREA B
PU-101F	1ST LEVEL UNDERFLOOR PLUMBING PLAN - AREA F
PU-101G	1ST LEVEL UNDERFLOOR PLUMBING PLAN - AREA G
PU-101H	1ST LEVEL UNDERFLOOR PLUMBING PLAN - AREA H

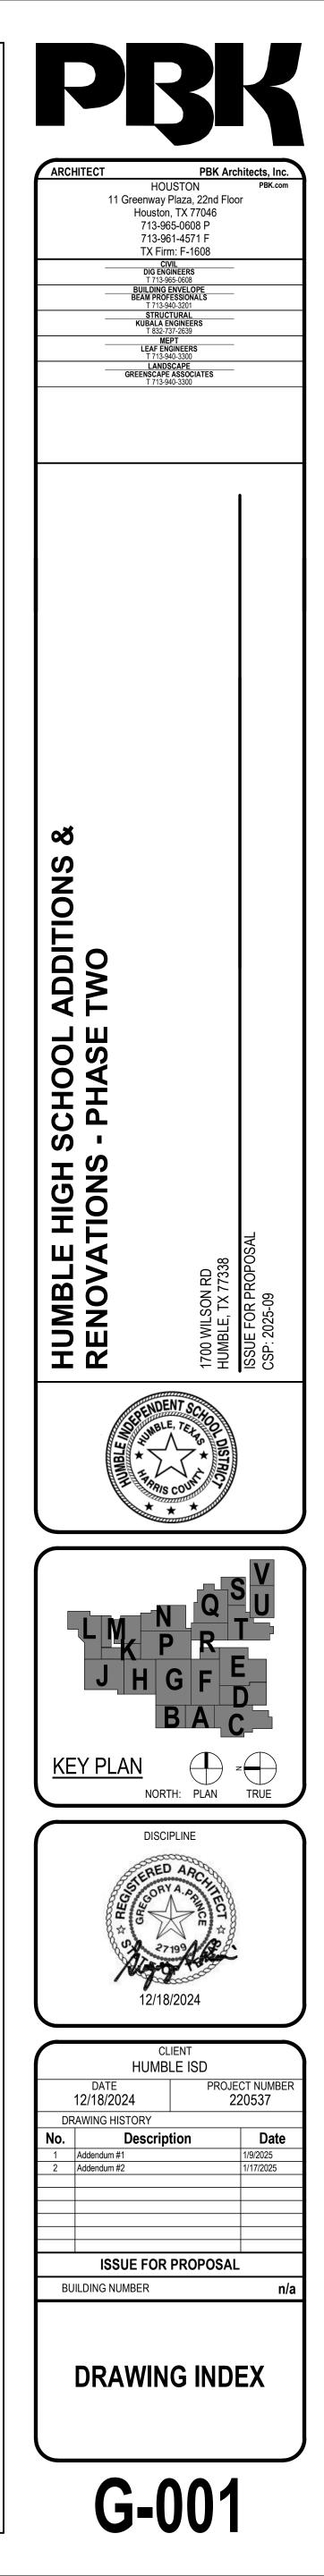


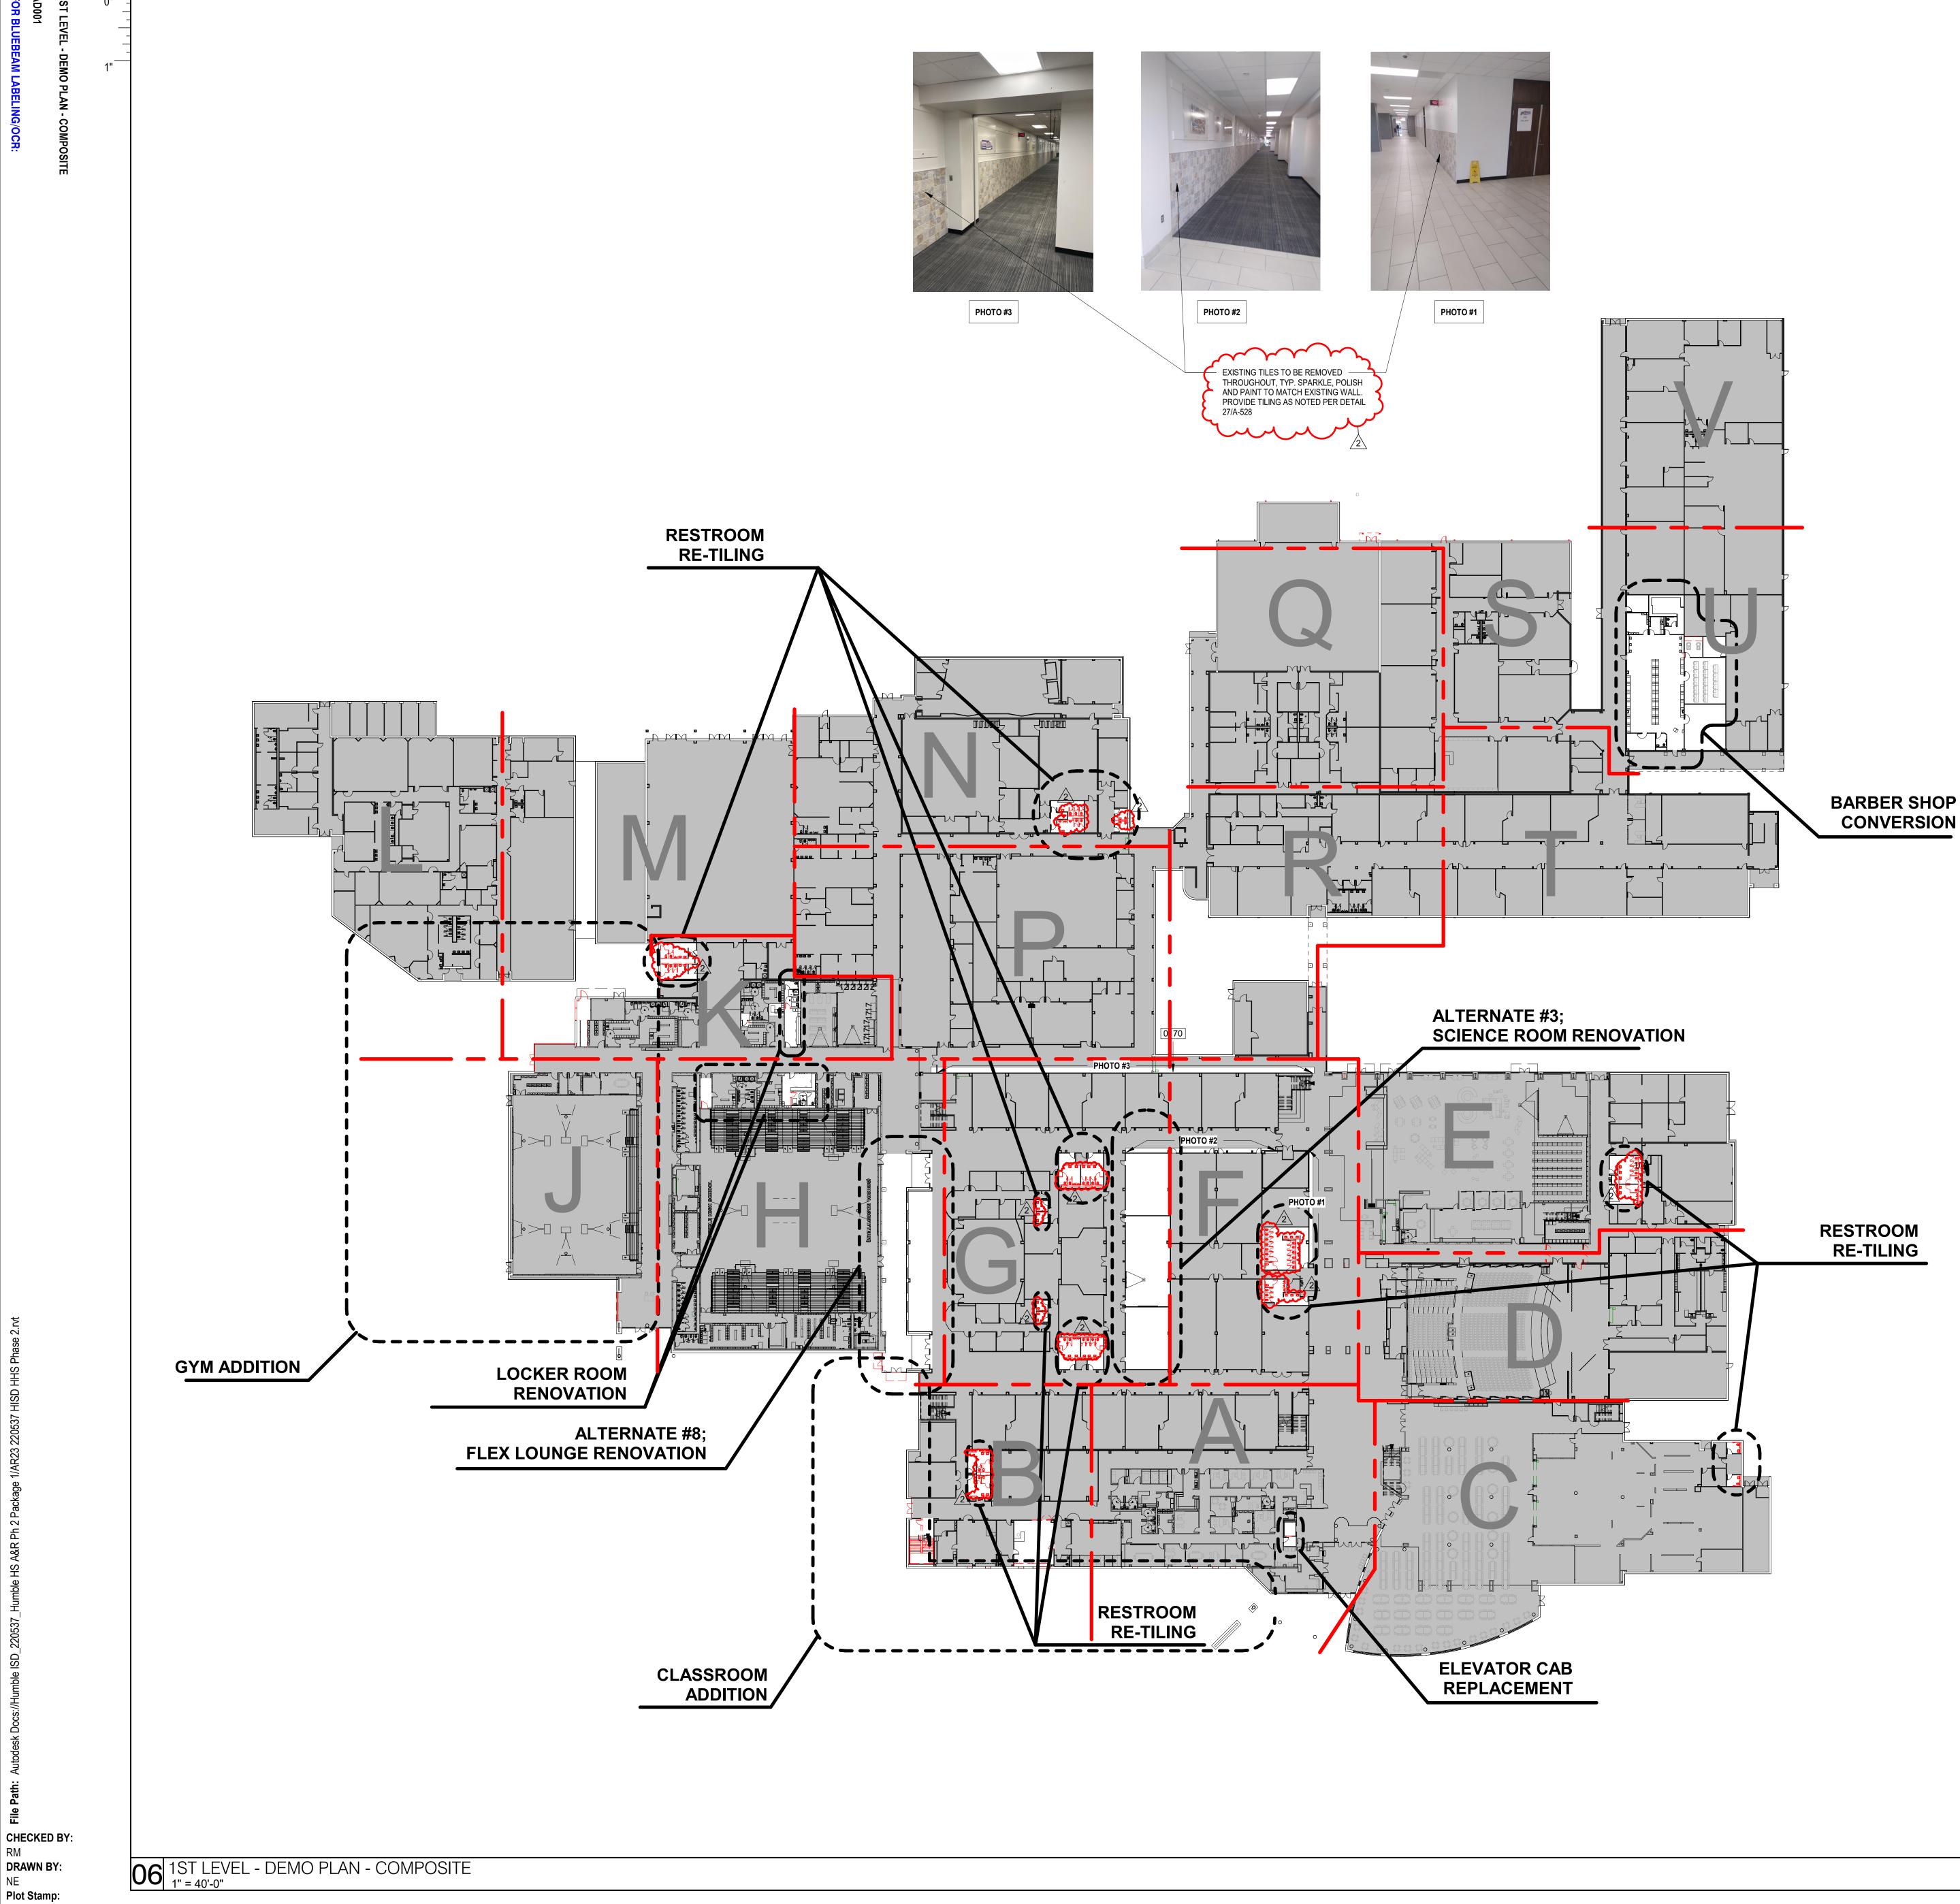

1/16/2025 5:29:17 PM

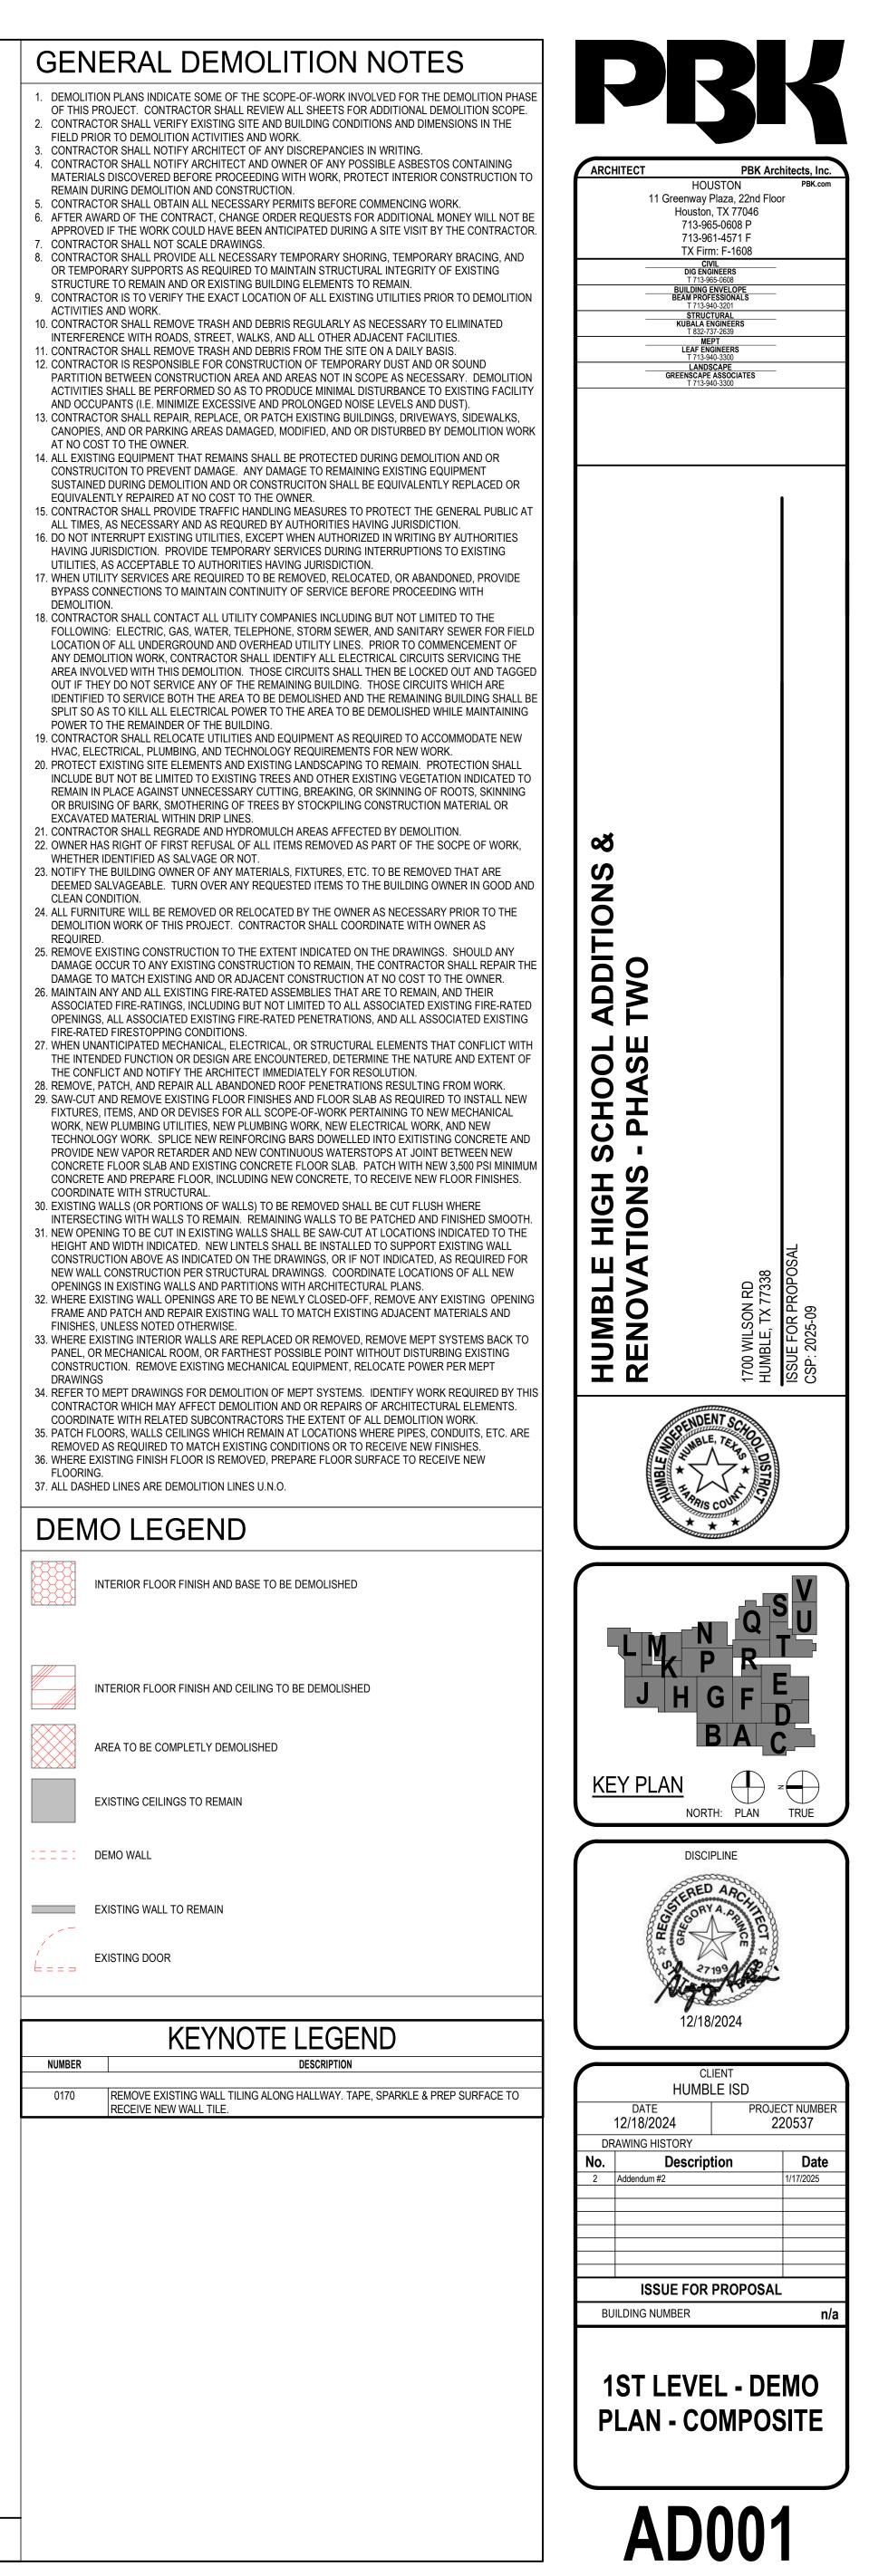


	KEYNOTE LEGEND
NUMBER	DESCRIPTION
	REMOVE EXISTING WALL TILING ALONG HALLWAY. TAPE, SPARKLE & PREP SURFACE RECEIVE NEW WALL TILE.

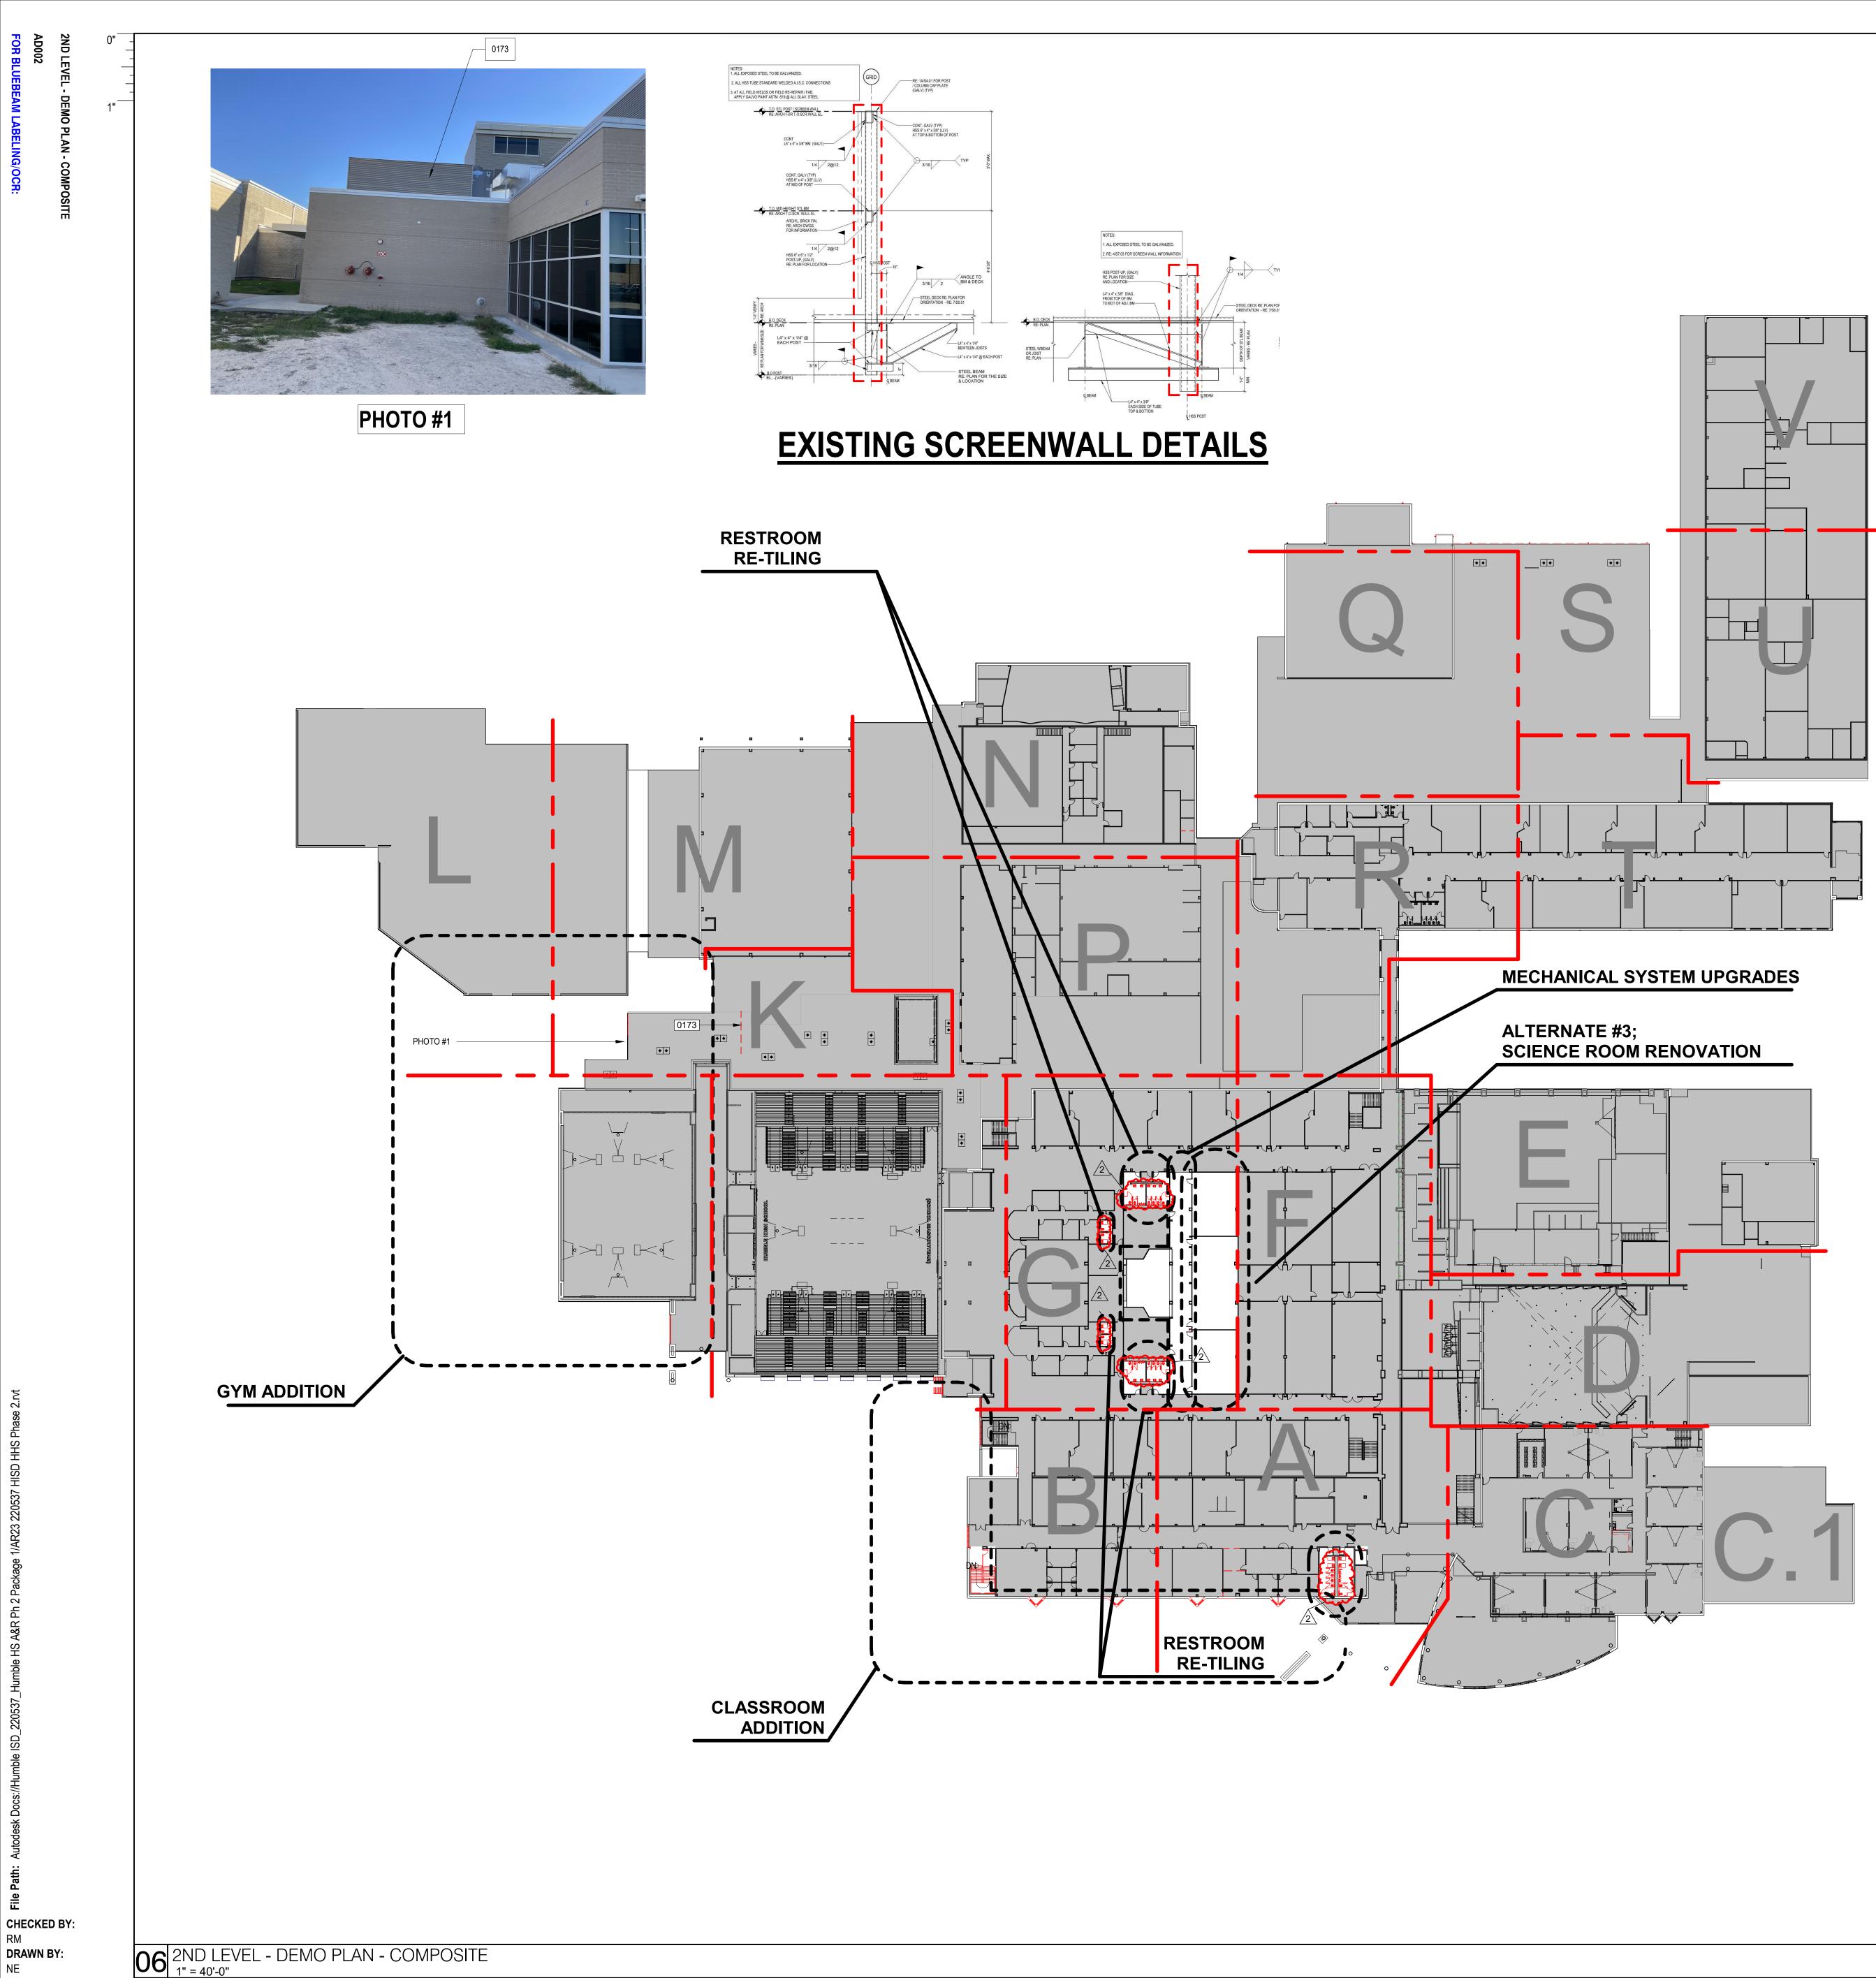


RM NE


Plot Stamp: 1/14/2025 3:15:52 PM

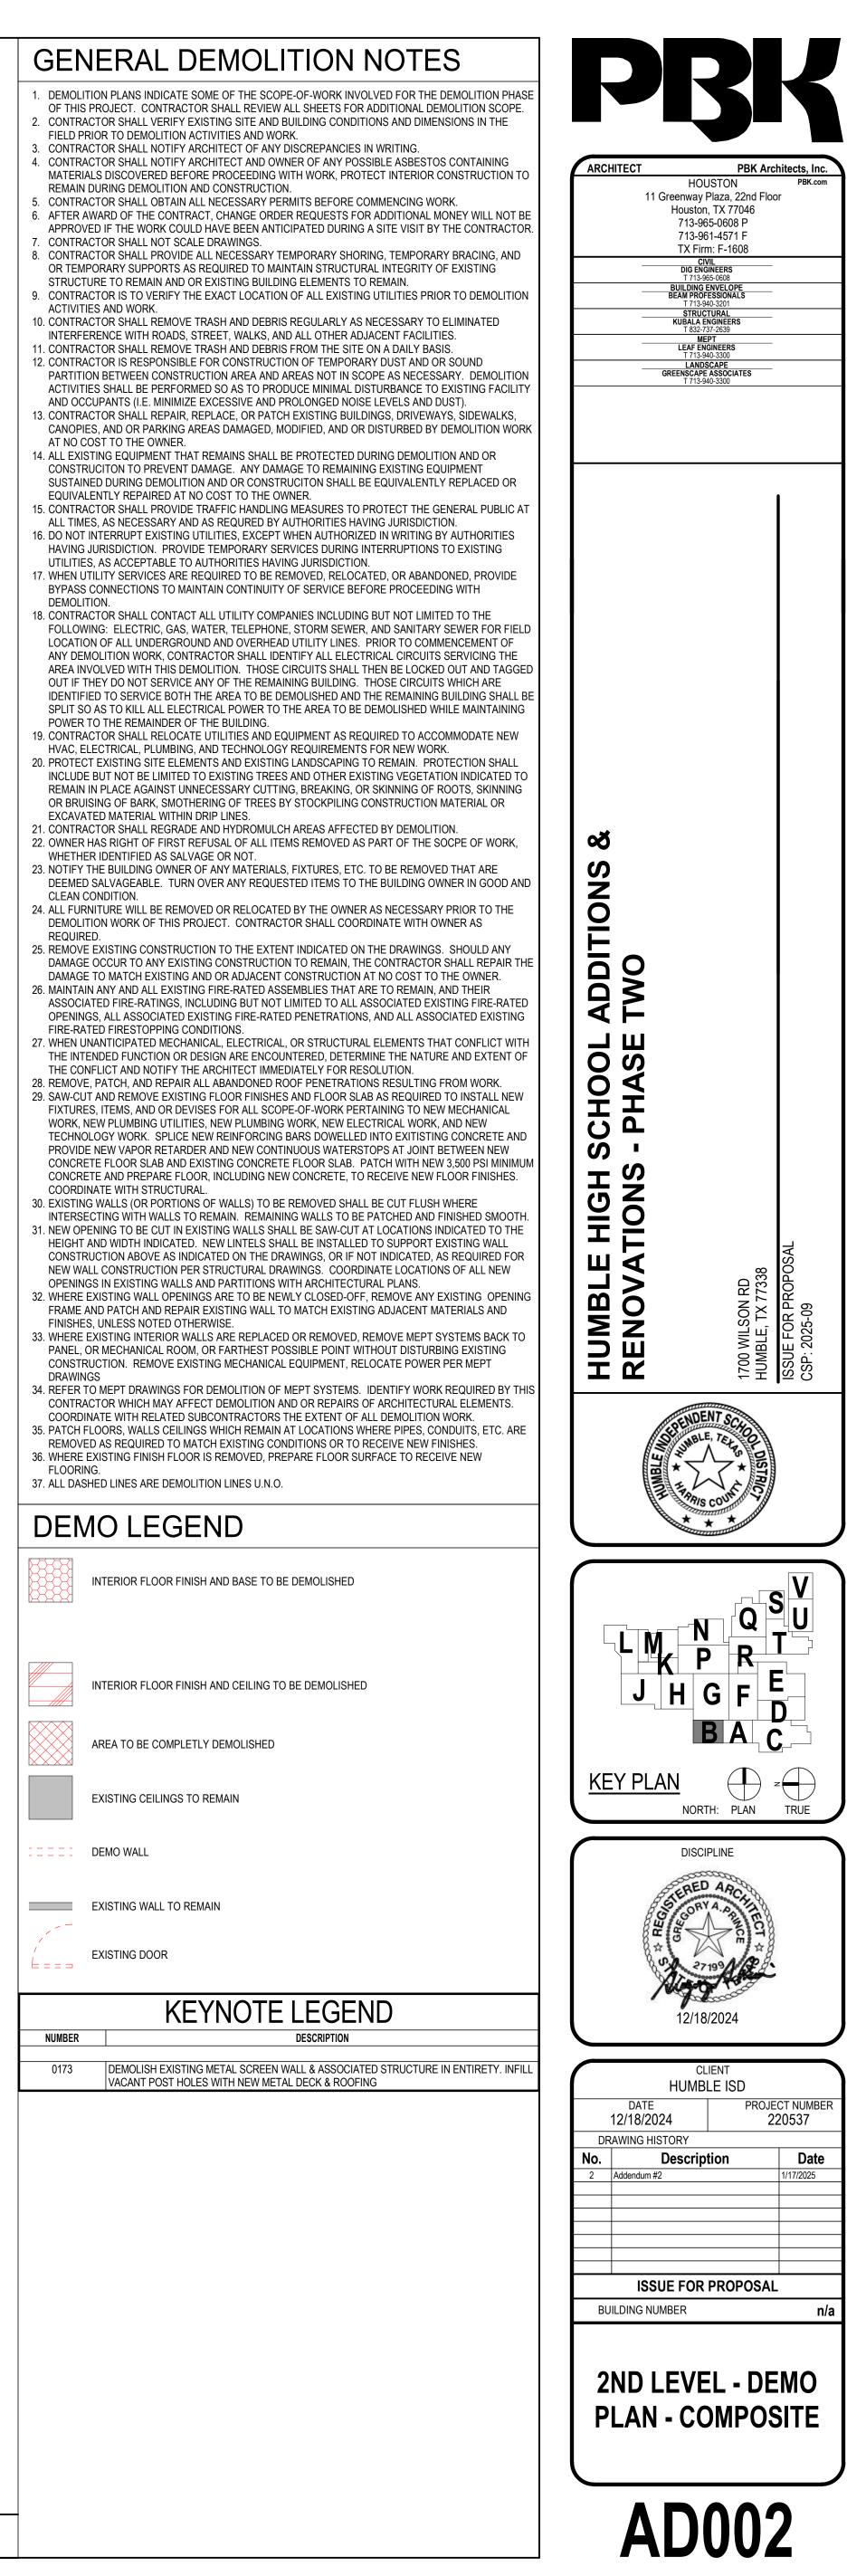


MBER	DESCRIPTION
	DEMOLISH EXISTING METAL SCREEN WALL & ASSOCIATED STRUCTURE IN ENTIRET VACANT POST HOLES WITH NEW METAL DECK & ROOFING

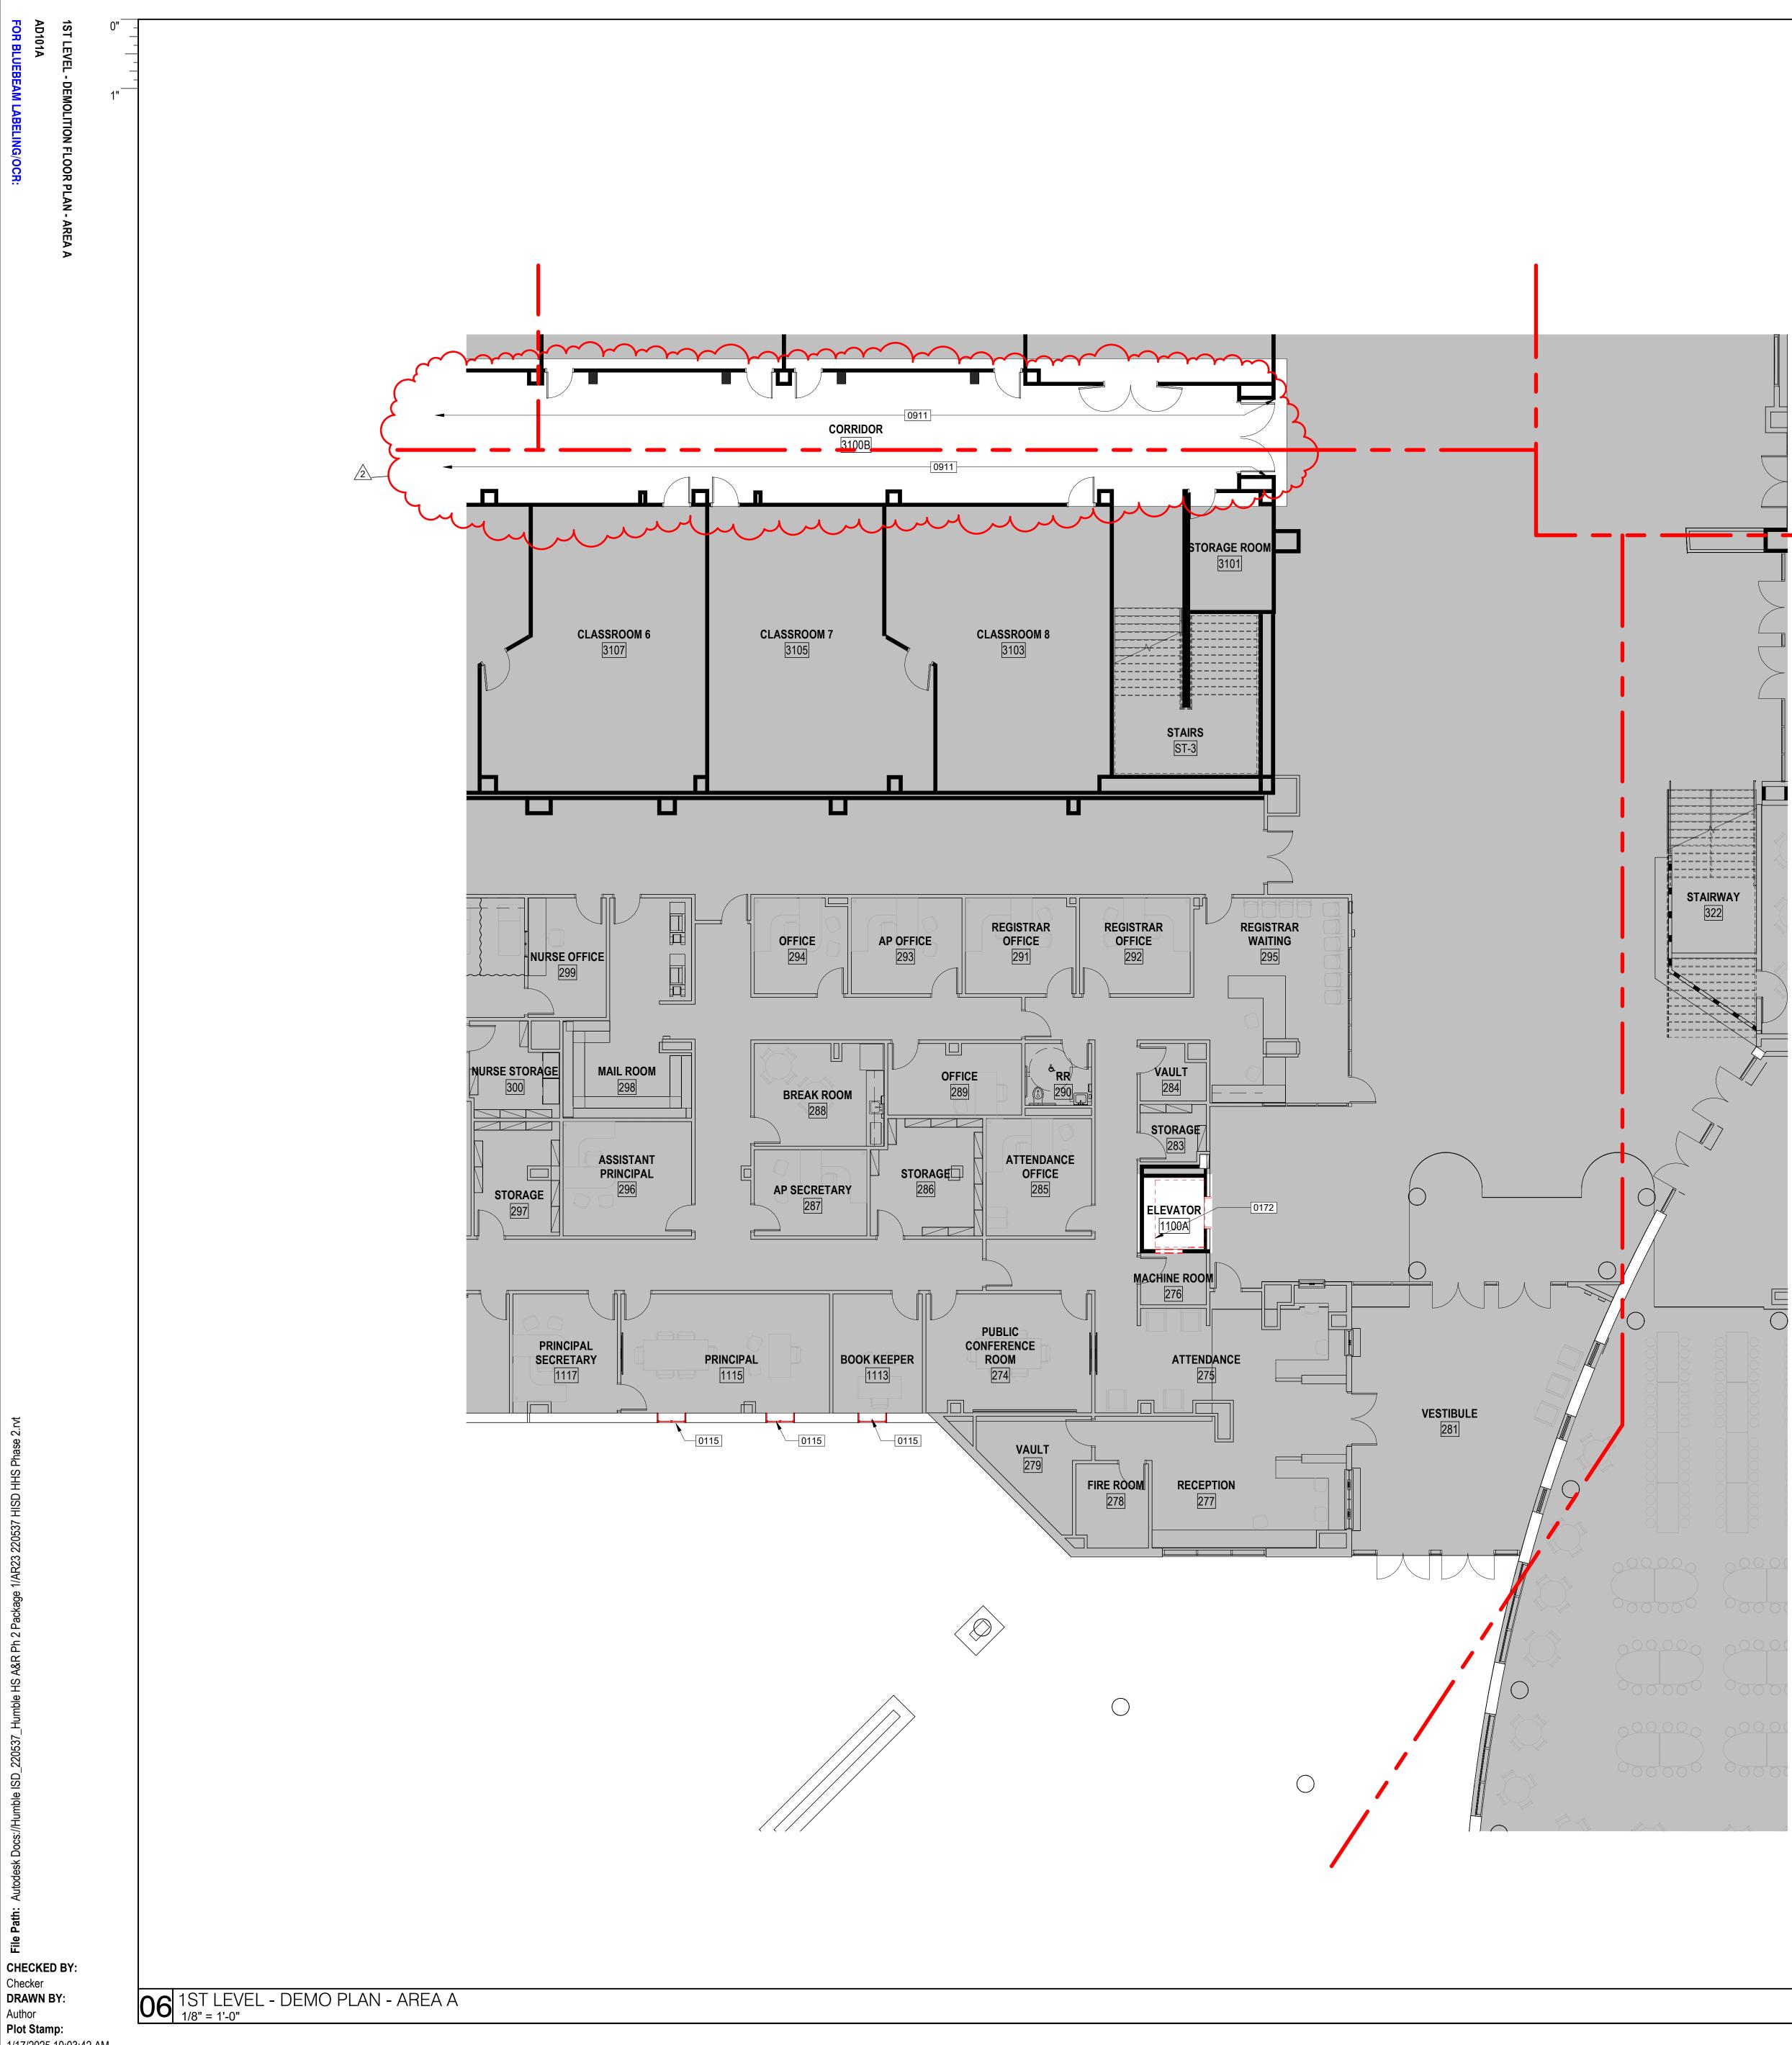

Checker Author 1/17/2025 10:03:42 AM

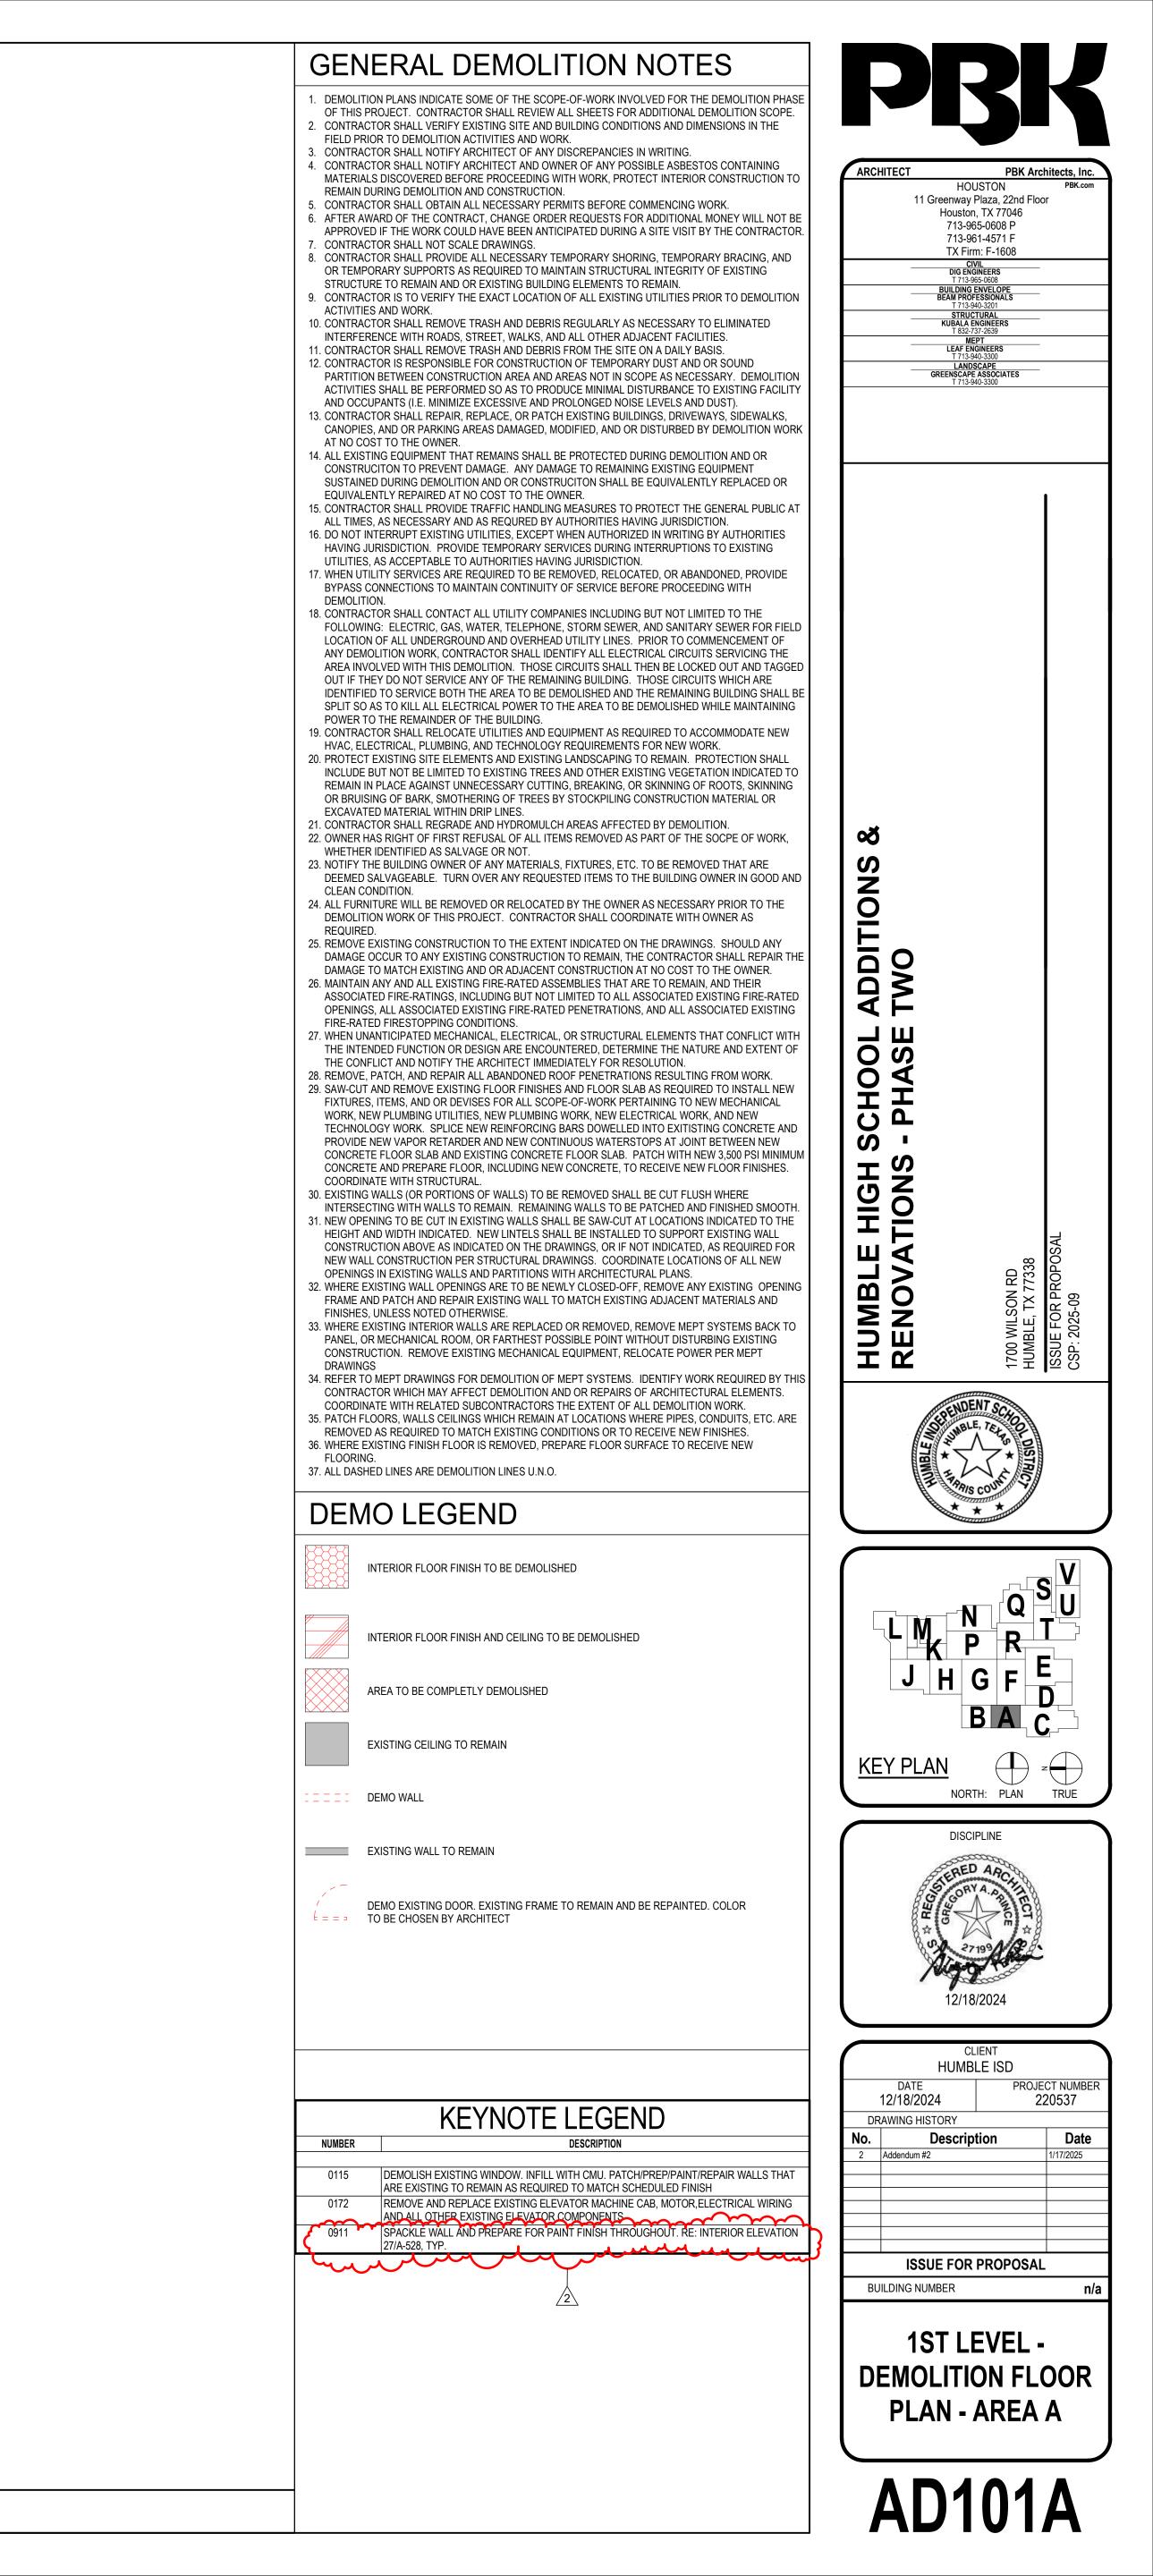


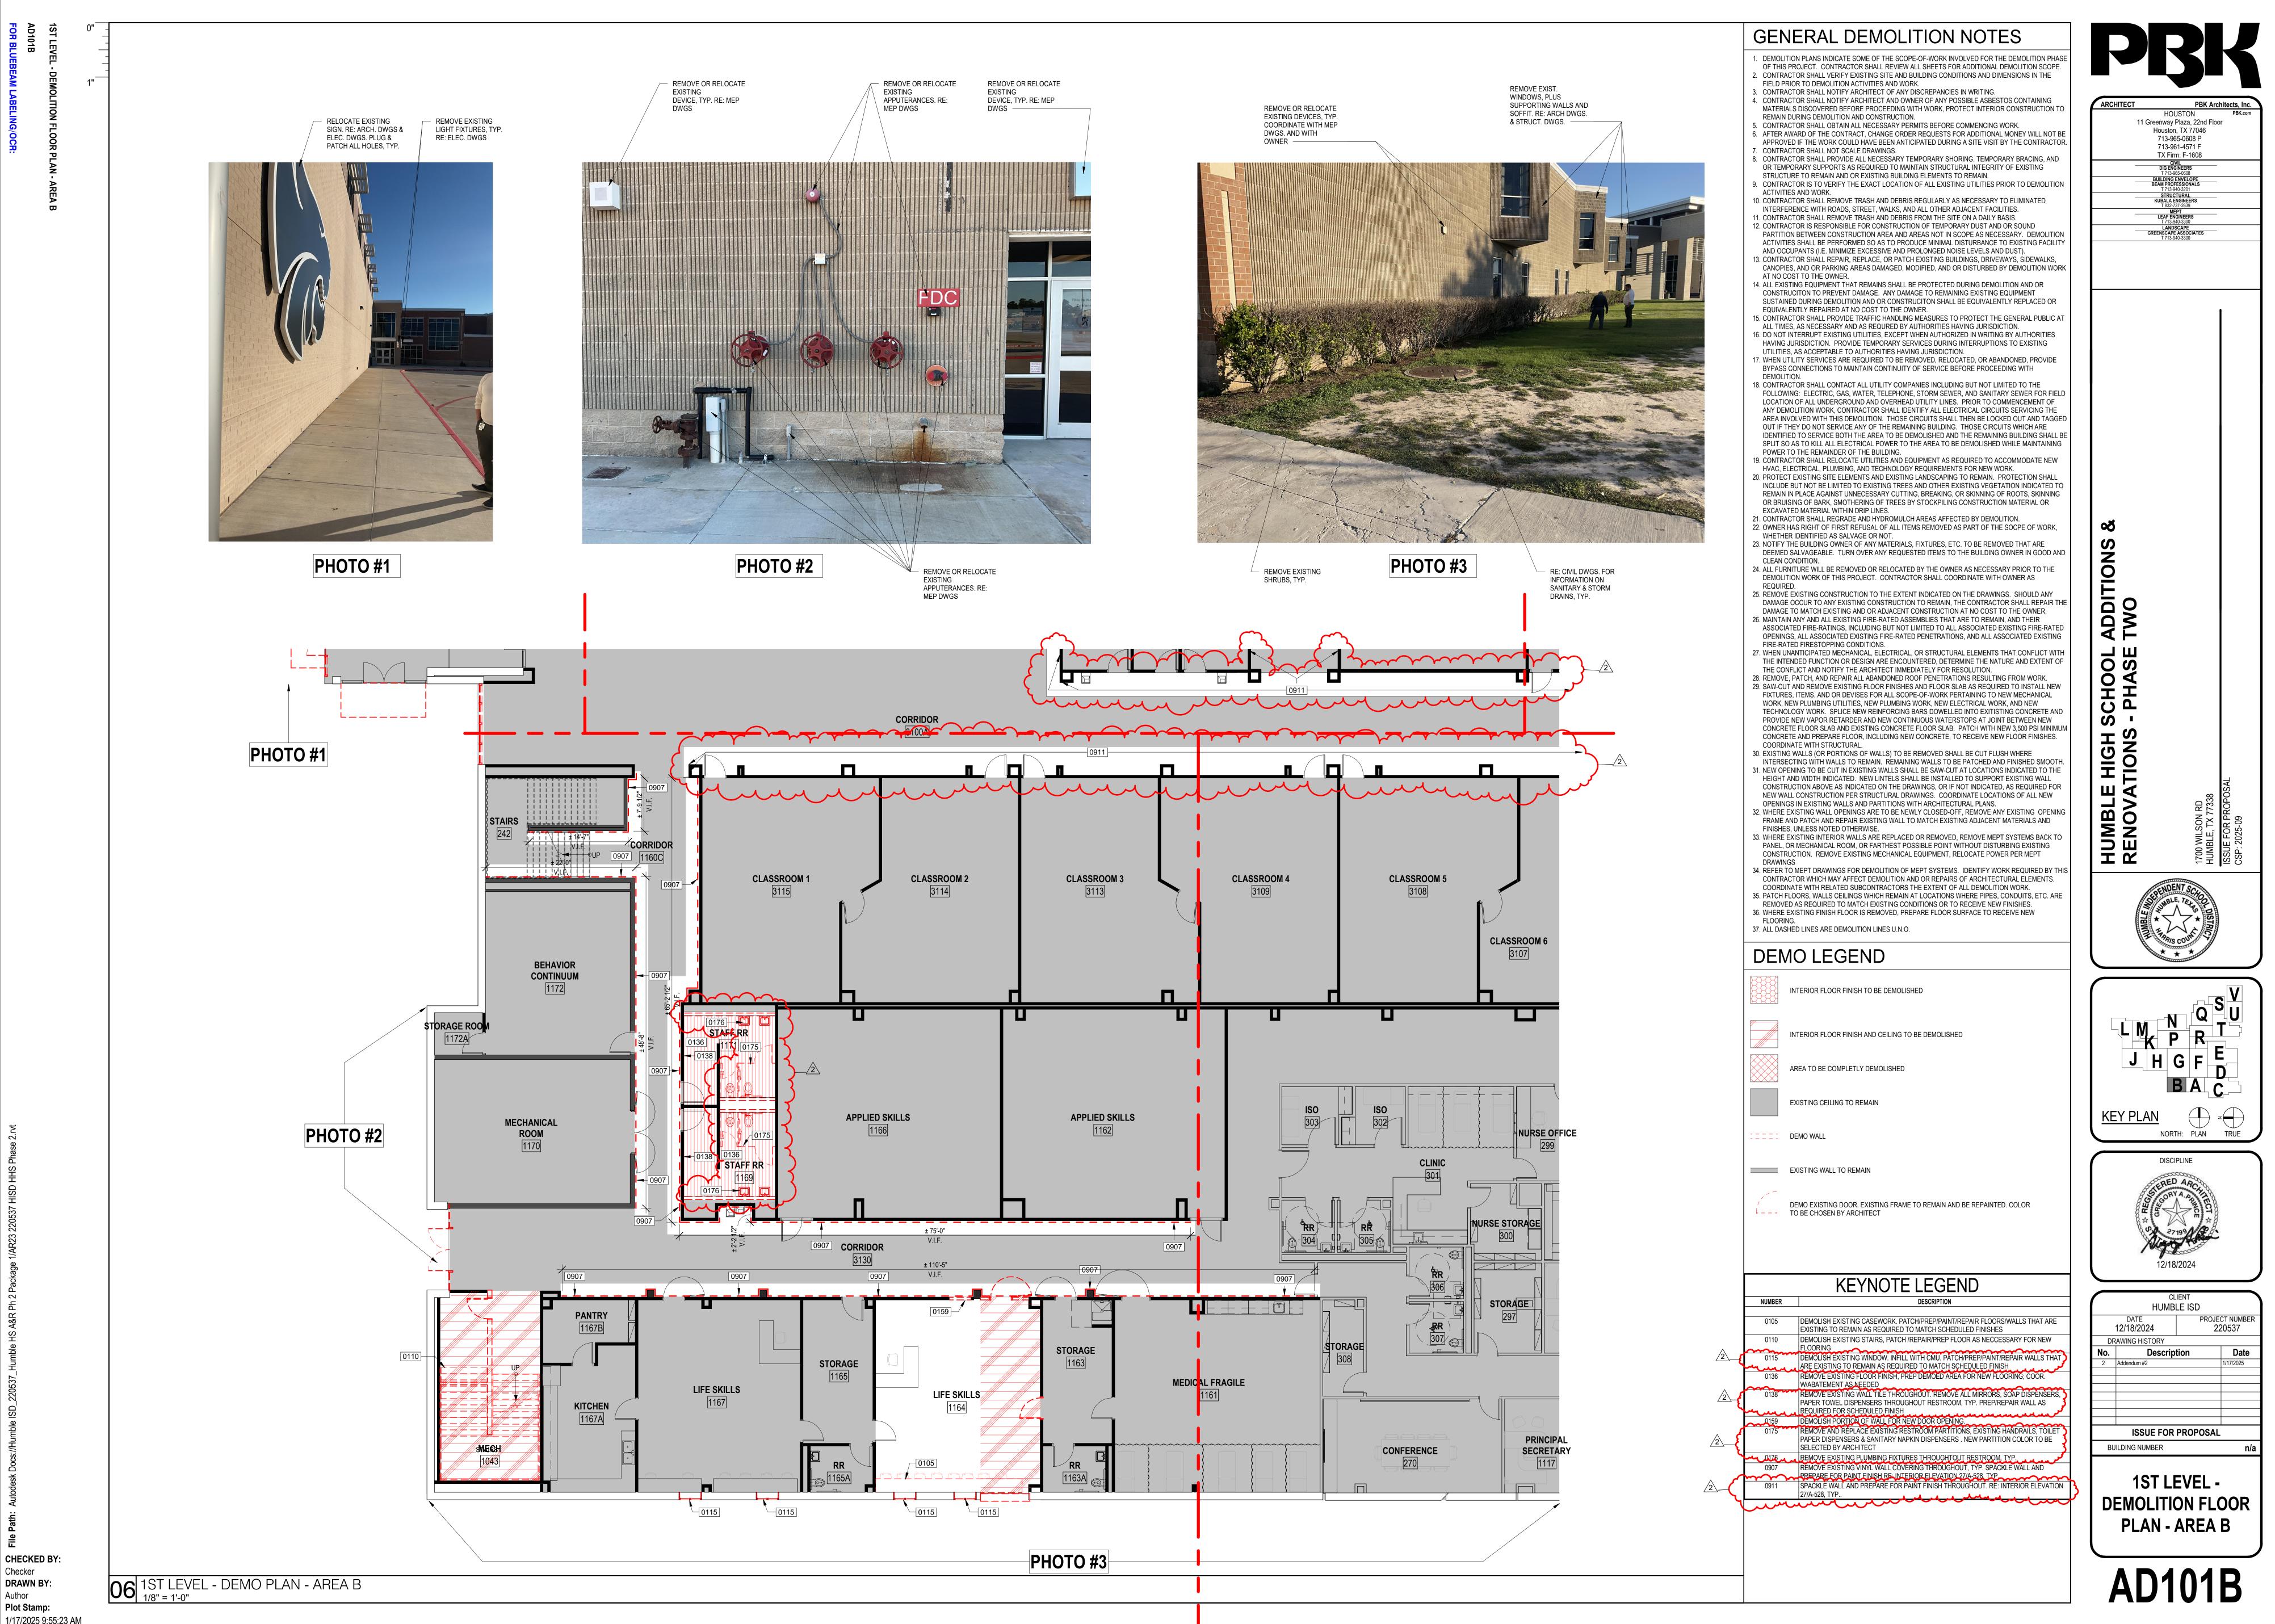

Checker Author


1/17/2025 9:55:23 AM




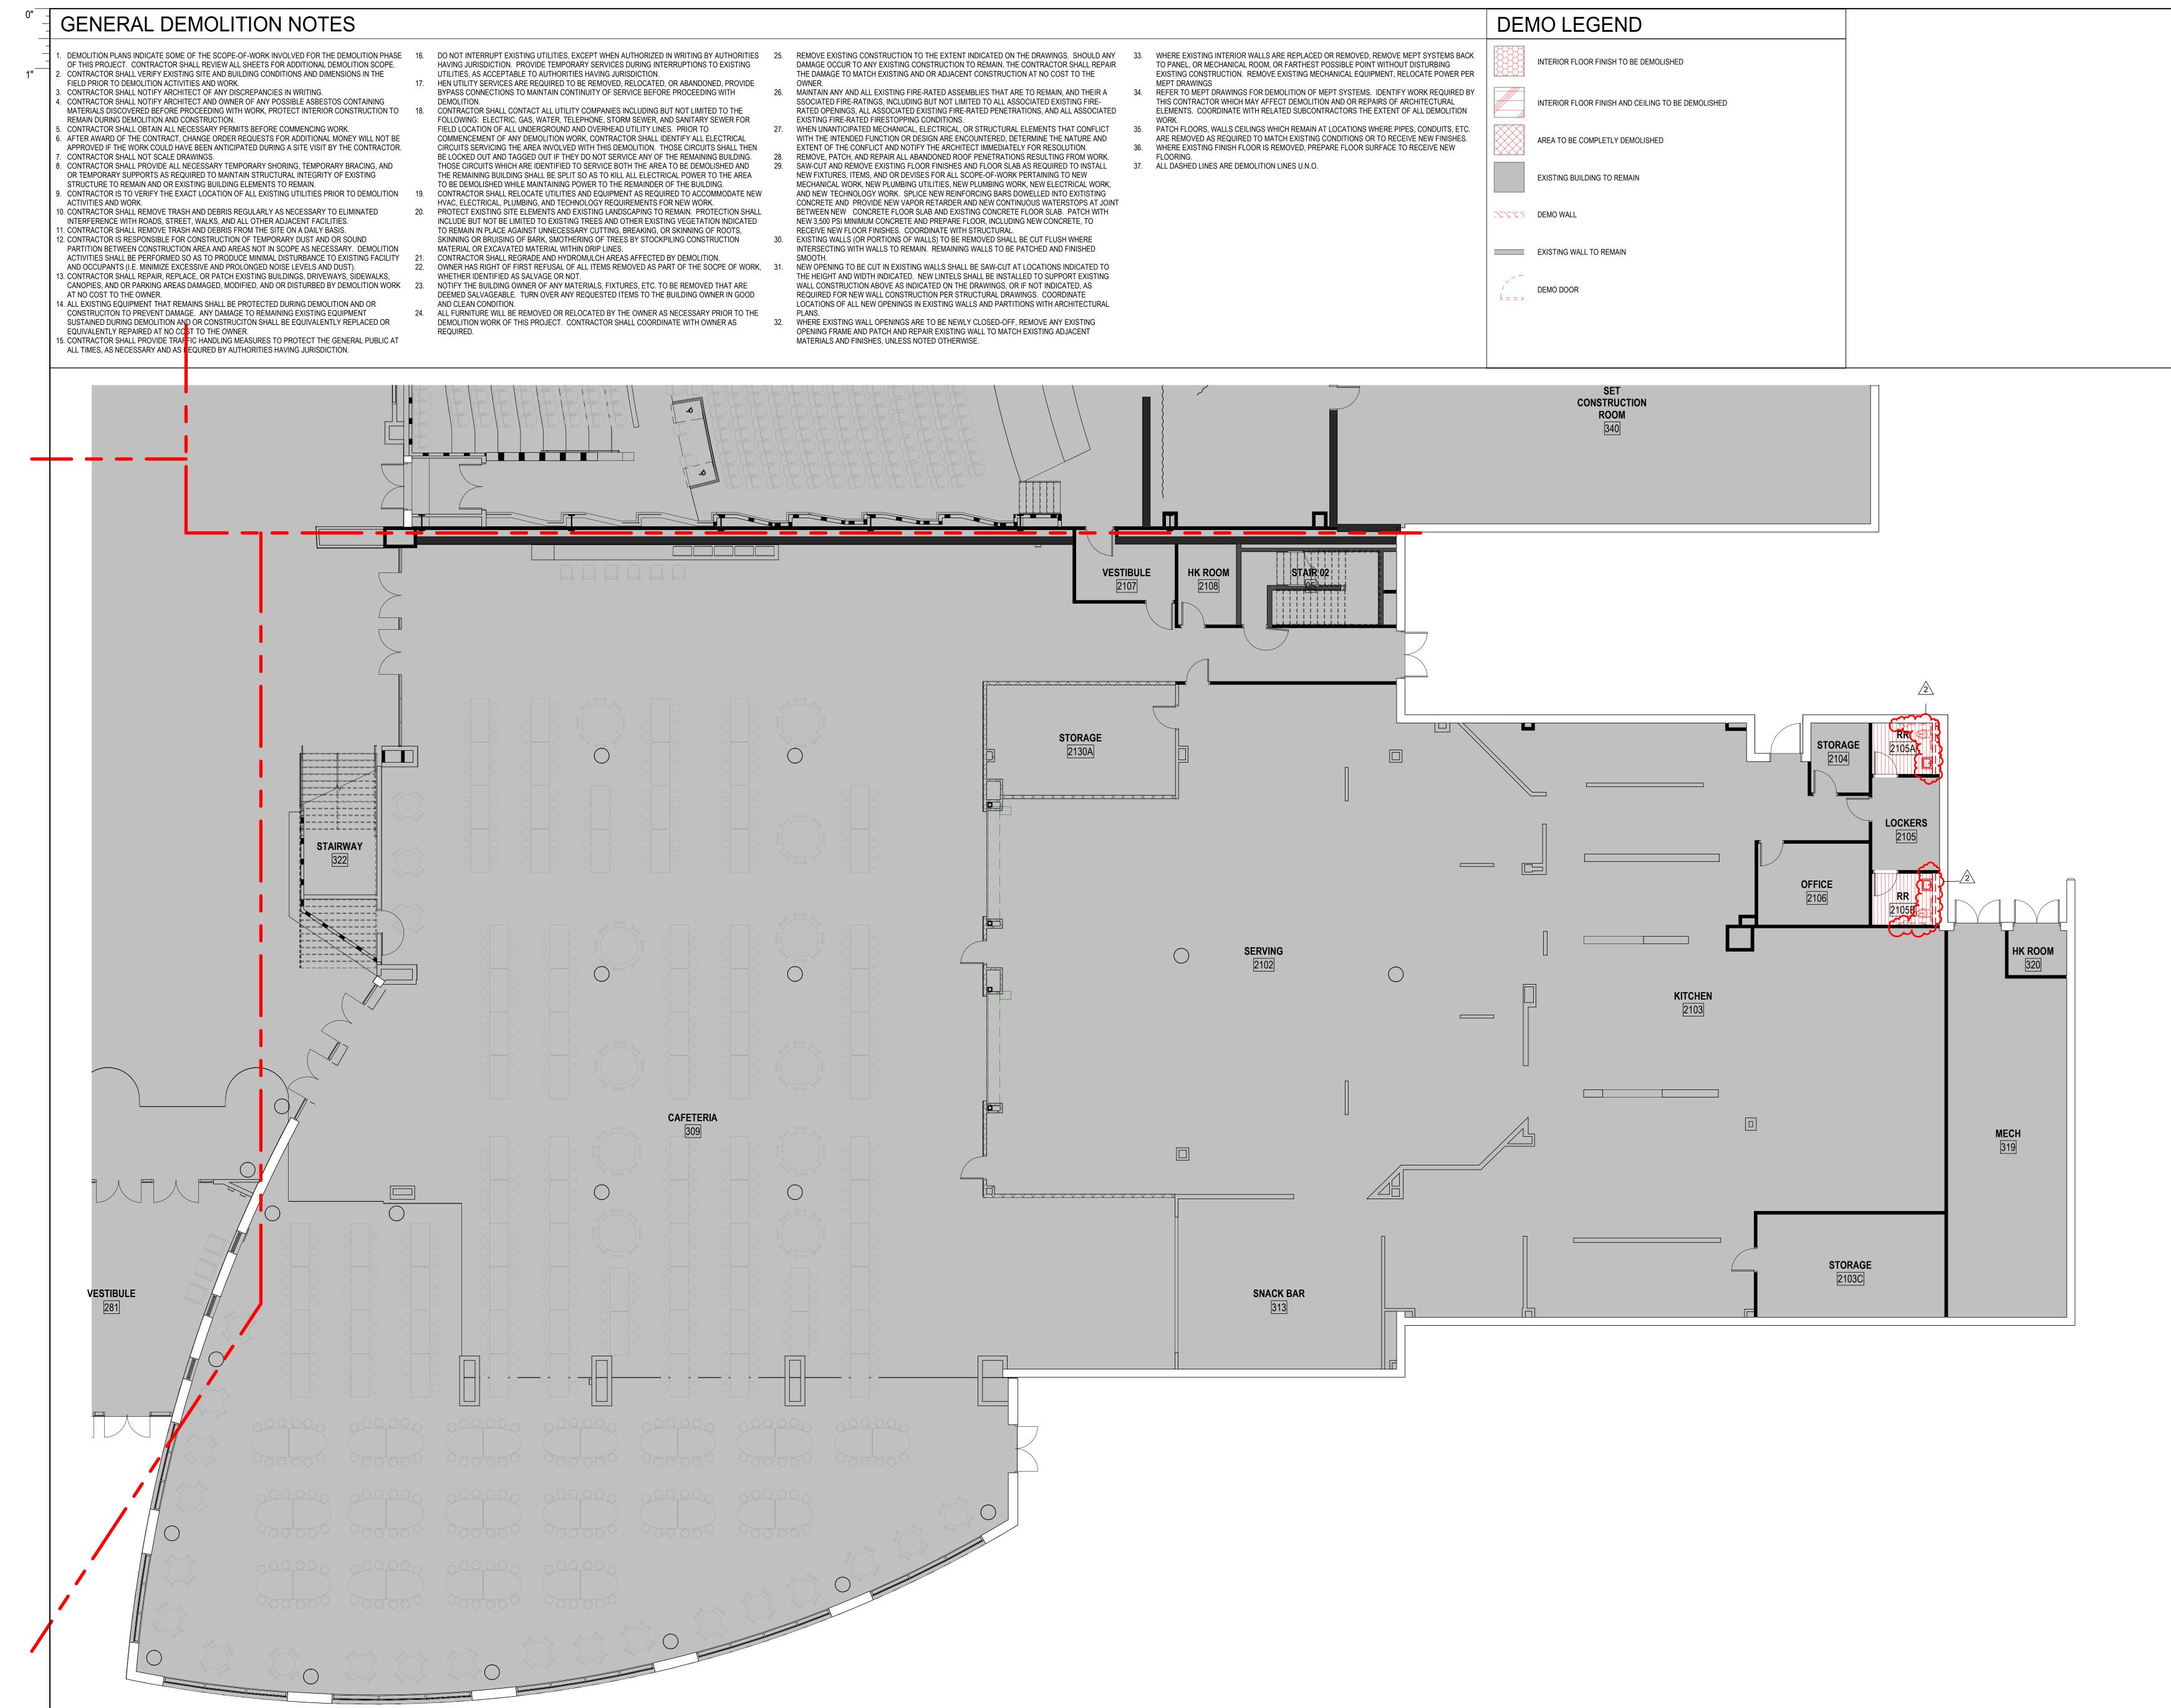

CHECKED BY: Checker DRAWN BY: Author Plot Stamp: 1/14/2025 4:44:31 PM

06 1ST LEVEL - DEMO PLAN - AREA C

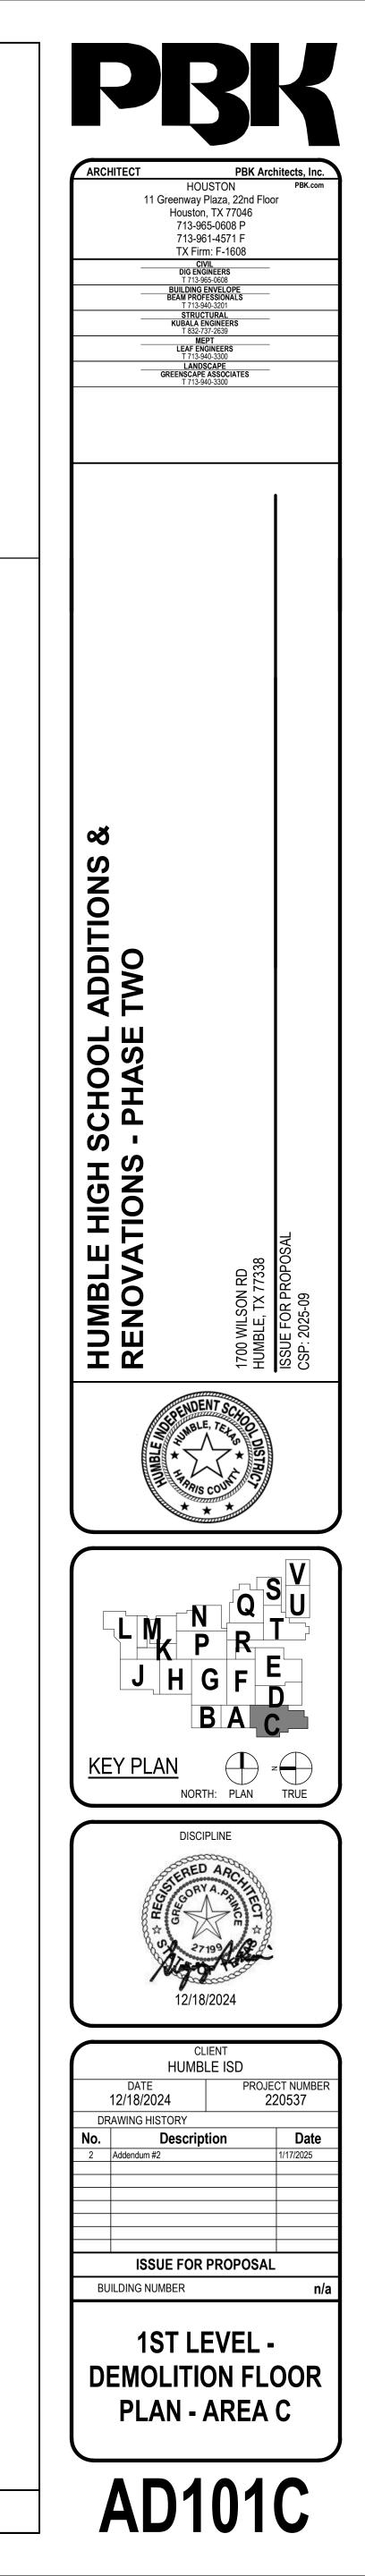

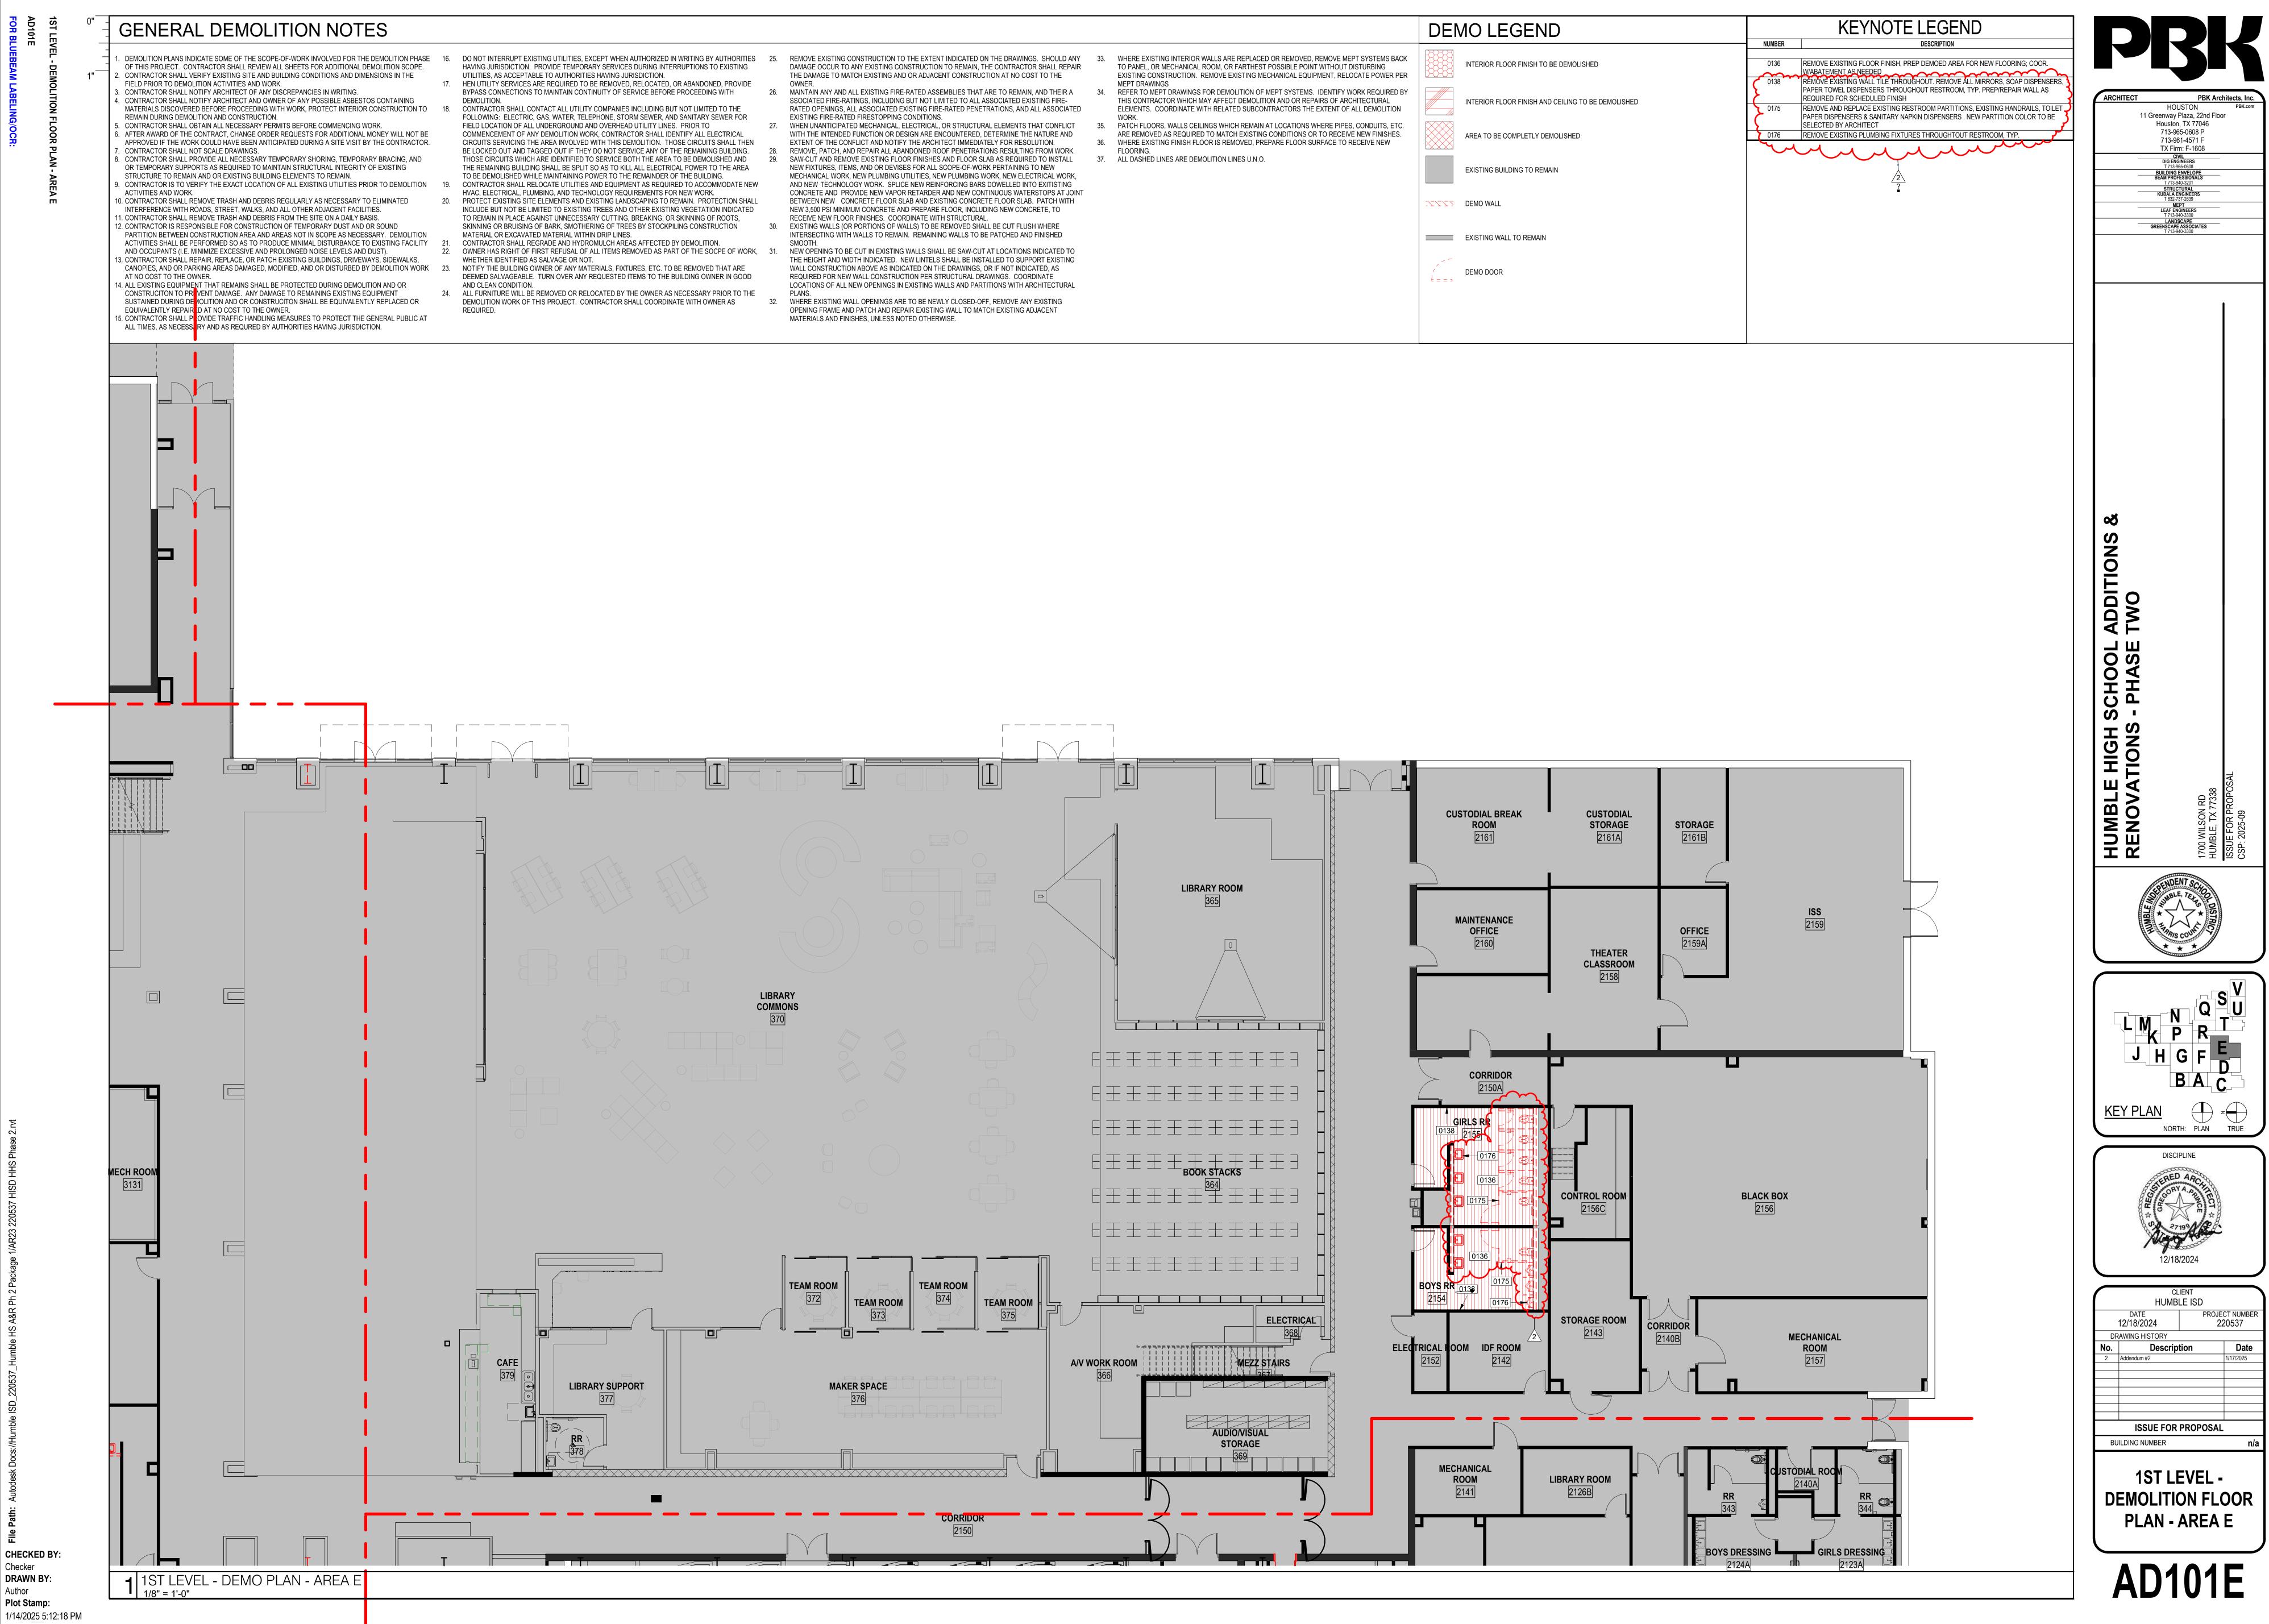


Checker


DRAWN BY: Author Plot Stamp: 1/14/2025 5:12:18 PM

AD1(

WRITING BY AUTHORITIES RUPTIONS TO EXISTING	25.	REMOVE EXISTING CONSTRUCTION TO THE EXTENT INDICATED ON THE DRAWINGS. SHOULD ANY DAMAGE OCCUR TO ANY EXISTING CONSTRUCTION TO REMAIN, THE CONTRACTOR SHALL REPAIR THE DAMAGE TO MATCH EXISTING AND OR ADJACENT CONSTRUCTION AT NO COST TO THE	33.	WHERE EXISTING INTERIOR WALLS ARE REPLACED OR REMOVED, REMOVE MEPT TO PANEL, OR MECHANICAL ROOM, OR FARTHEST POSSIBLE POINT WITHOUT DIS EXISTING CONSTRUCTION. REMOVE EXISTING MECHANICAL EQUIPMENT, RELOCA
R ABANDONED, PROVIDE		OWNER.		MEPT DRAWINGS
PROCEEDING WITH	26.	MAINTAIN ANY AND ALL EXISTING FIRE-RATED ASSEMBLIES THAT ARE TO REMAIN, AND THEIR A	34.	REFER TO MEPT DRAWINGS FOR DEMOLITION OF MEPT SYSTEMS. IDENTIFY WOR
NOT LIMITED TO THE		SSOCIATED FIRE-RATINGS, INCLUDING BUT NOT LIMITED TO ALL ASSOCIATED EXISTING FIRE- RATED OPENINGS, ALL ASSOCIATED EXISTING FIRE-RATED PENETRATIONS, AND ALL ASSOCIATED		THIS CONTRACTOR WHICH MAY AFFECT DEMOLITION AND OR REPAIRS OF ARCHIT ELEMENTS. COORDINATE WITH RELATED SUBCONTRACTORS THE EXTENT OF ALL
SANITARY SEWER FOR		EXISTING FIRE-RATED FIRESTOPPING CONDITIONS.		WORK.
PRIOR TO	27.	WHEN UNANTICIPATED MECHANICAL, ELECTRICAL, OR STRUCTURAL ELEMENTS THAT CONFLICT	35.	PATCH FLOORS, WALLS CEILINGS WHICH REMAIN AT LOCATIONS WHERE PIPES, C
NTIFY ALL ELECTRICAL		WITH THE INTENDED FUNCTION OR DESIGN ARE ENCOUNTERED, DETERMINE THE NATURE AND		ARE REMOVED AS REQUIRED TO MATCH EXISTING CONDITIONS OR TO RECEIVE N
SE CIRCUITS SHALL THEN		EXTENT OF THE CONFLICT AND NOTIFY THE ARCHITECT IMMEDIATELY FOR RESOLUTION.	36.	WHERE EXISTING FINISH FLOOR IS REMOVED, PREPARE FLOOR SURFACE TO REC
E REMAINING BUILDING.	28.	REMOVE, PATCH, AND REPAIR ALL ABANDONED ROOF PENETRATIONS RESULTING FROM WORK.		FLOORING.
O BE DEMOLISHED AND	29.	SAW-CUT AND REMOVE EXISTING FLOOR FINISHES AND FLOOR SLAB AS REQUIRED TO INSTALL	37.	ALL DASHED LINES ARE DEMOLITION LINES U.N.O.
AL POWER TO THE AREA		NEW FIXTURES, ITEMS, AND OR DEVISES FOR ALL SCOPE-OF-WORK PERTAINING TO NEW		
F THE BUILDING.		MECHANICAL WORK, NEW PLUMBING UTILITIES, NEW PLUMBING WORK, NEW ELECTRICAL WORK, AND NEW TECHNOLOGY WORK. SPLICE NEW REINFORCING BARS DOWELLED INTO EXITISTING		
NEW WORK.		CONCRETE AND PROVIDE NEW VAPOR RETARDER AND NEW CONTINUOUS WATERSTOPS AT JOINT		
		BETWEEN NEW CONCRETE FLOOR SLAB AND EXISTING CONCRETE FLOOR SLAB. PATCH WITH		
G VEGETATION INDICATED		NEW 3,500 PSI MINIMUM CONCRETE AND PREPARE FLOOR, INCLUDING NEW CONCRETE, TO		
SKINNING OF ROOTS,		RECEIVE NEW FLOOR FINISHES. COORDINATE WITH STRUCTURAL.		
ING CONSTRUCTION	30.	EXISTING WALLS (OR PORTIONS OF WALLS) TO BE REMOVED SHALL BE CUT FLUSH WHERE		
		INTERSECTING WITH WALLS TO REMAIN. REMAINING WALLS TO BE PATCHED AND FINISHED		
Y DEMOLITION.		SMOOTH.		
T OF THE SOCPE OF WORK,	31.	NEW OPENING TO BE CUT IN EXISTING WALLS SHALL BE SAW-CUT AT LOCATIONS INDICATED TO		
BE REMOVED THAT ARE		THE HEIGHT AND WIDTH INDICATED. NEW LINTELS SHALL BE INSTALLED TO SUPPORT EXISTING WALL CONSTRUCTION ABOVE AS INDICATED ON THE DRAWINGS, OR IF NOT INDICATED, AS		
JILDING OWNER IN GOOD		REQUIRED FOR NEW WALL CONSTRUCTION PER STRUCTURAL DRAWINGS. COORDINATE		
		LOCATIONS OF ALL NEW OPENINGS IN EXISTING WALLS AND PARTITIONS WITH ARCHITECTURAL		
ECESSARY PRIOR TO THE		PLANS.		
TE WITH OWNER AS	32.	WHERE EXISTING WALL OPENINGS ARE TO BE NEWLY CLOSED-OFF, REMOVE ANY EXISTING		
		OPENING FRAME AND PATCH AND REPAIR EXISTING WALL TO MATCH EXISTING ADJACENT		
		MATERIALS AND FINISHES, UNLESS NOTED OTHERWISE.		

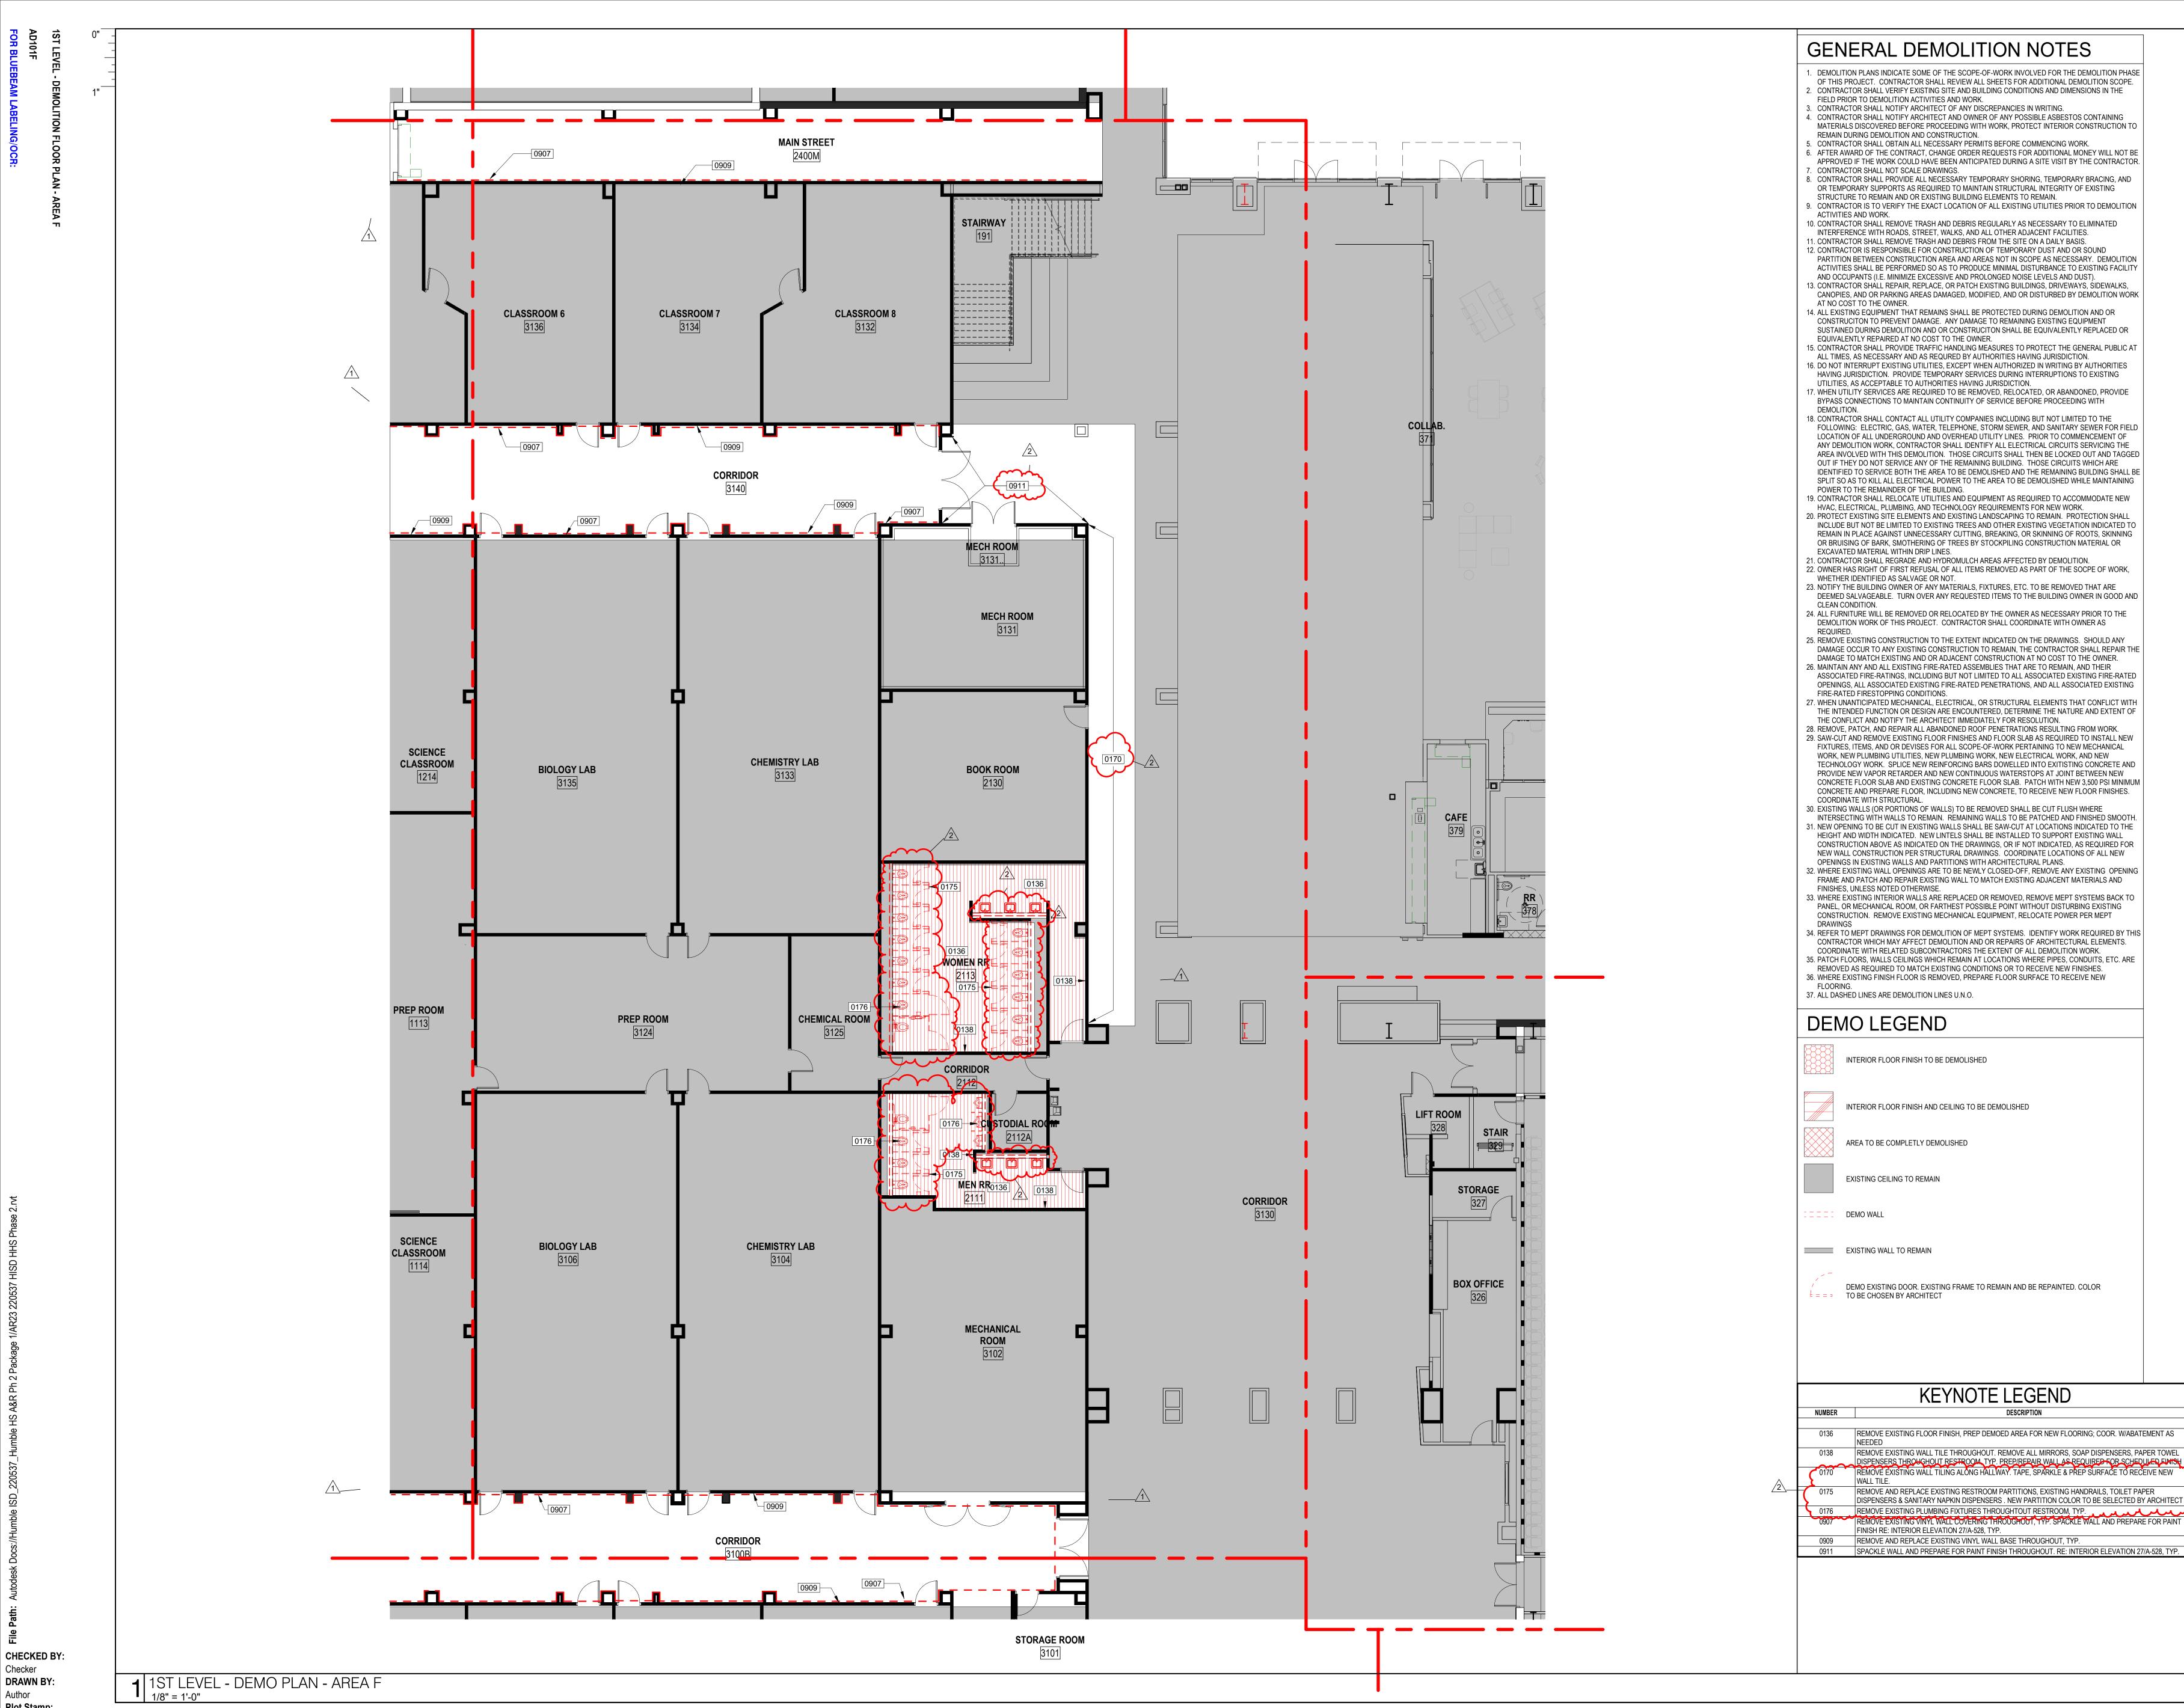



Autnor Plot Stamp: 1/17/2025 10:15:24 AM

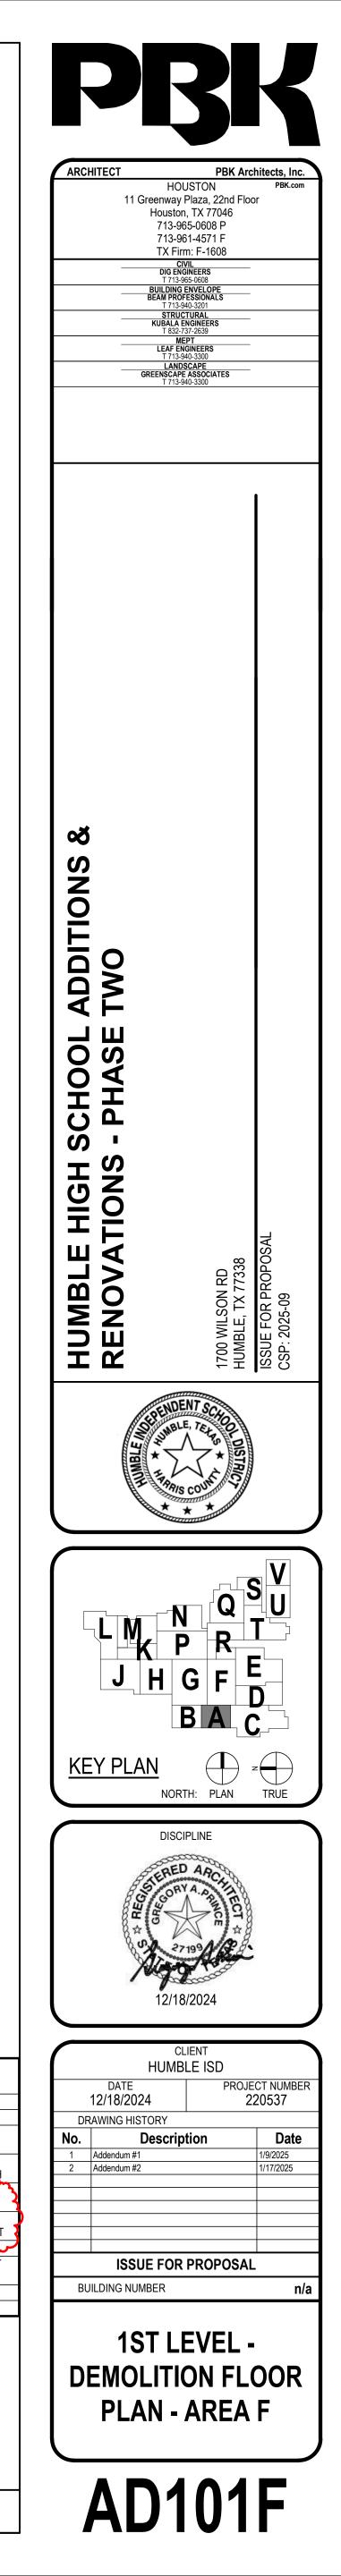




	GENERAL DEMOLITION NOTES
	 DEMOLITION PLANS INDICATE SOME OF THE SCOPE-OF-WORK INVOLVED FOR THE DEMOLITION PHASE OF THIS PROJECT. CONTRACTOR SHALL REVIEW ALL SHEETS FOR ADDITIONAL DEMOLITION SCOPE. CONTRACTOR SHALL VERIFY EXISTING SITE AND BUILDING CONDITIONS AND DIMENSIONS IN THE
	 FIELD PRIOR TO DEMOLITION ACTIVITIES AND WORK. CONTRACTOR SHALL NOTIFY ARCHITECT OF ANY DISCREPANCIES IN WRITING. CONTRACTOR SHALL NOTIFY ARCHITECT AND OWNER OF ANY POSSIBLE ASBESTOS CONTAINING
	 MATERIALS DISCOVERED BEFORE PROCEEDING WITH WORK, PROTECT INTERIOR CONSTRUCTION TO REMAIN DURING DEMOLITION AND CONSTRUCTION. CONTRACTOR SHALL OBTAIN ALL NECESSARY PERMITS BEFORE COMMENCING WORK. AFTER AWARD OF THE CONTRACT, CHANGE ORDER REQUESTS FOR ADDITIONAL MONEY WILL NOT BE
	 APPROVED IF THE WORK COULD HAVE BEEN ANTICIPATED DURING A SITE VISIT BY THE CONTRACTOR CONTRACTOR SHALL NOT SCALE DRAWINGS. CONTRACTOR SHALL PROVIDE ALL NECESSARY TEMPORARY SHORING, TEMPORARY BRACING, AND
	OR TEMPORARY SUPPORTS AS REQUIRED TO MAINTAIN STRUCTURAL INTEGRITY OF EXISTING STRUCTURE TO REMAIN AND OR EXISTING BUILDING ELEMENTS TO REMAIN. 9. CONTRACTOR IS TO VERIFY THE EXACT LOCATION OF ALL EXISTING UTILITIES PRIOR TO DEMOLITION
	ACTIVITIES AND WORK. 10. CONTRACTOR SHALL REMOVE TRASH AND DEBRIS REGULARLY AS NECESSARY TO ELIMINATED INTERFERENCE WITH ROADS, STREET, WALKS, AND ALL OTHER ADJACENT FACILITIES.
	 CONTRACTOR SHALL REMOVE TRASH AND DEBRIS FROM THE SITE ON A DAILY BASIS. CONTRACTOR IS RESPONSIBLE FOR CONSTRUCTION OF TEMPORARY DUST AND OR SOUND PARTITION BETWEEN CONSTRUCTION AREA AND AREAS NOT IN SCOPE AS NECESSARY. DEMOLITION ACTIVITIES SHALL BE PERFORMED SO AS TO PRODUCE MINIMAL DISTURBANCE TO EXISTING FACILITY
	ACTIVITIES SHALL BE PERFORMED SO AS TO PRODUCE MINIMAL DISTORBANCE TO EXISTING FACILITY AND OCCUPANTS (I.E. MINIMIZE EXCESSIVE AND PROLONGED NOISE LEVELS AND DUST). 13. CONTRACTOR SHALL REPAIR, REPLACE, OR PATCH EXISTING BUILDINGS, DRIVEWAYS, SIDEWALKS, CANOPIES, AND OR PARKING AREAS DAMAGED, MODIFIED, AND OR DISTURBED BY DEMOLITION WORK
SROOM 6 3136	AT NO COST TO THE OWNER. 14. ALL EXISTING EQUIPMENT THAT REMAINS SHALL BE PROTECTED DURING DEMOLITION AND OR CONSTRUCITON TO PREVENT DAMAGE. ANY DAMAGE TO REMAINING EXISTING EQUIPMENT
	SUSTAINED DURING DEMOLITION AND OR CONSTRUCITON SHALL BE EQUIVALENTLY REPLACED OR EQUIVALENTLY REPAIRED AT NO COST TO THE OWNER. 15. CONTRACTOR SHALL PROVIDE TRAFFIC HANDLING MEASURES TO PROTECT THE GENERAL PUBLIC AT
	ALL TIMES, AS NECESSARY AND AS REQURED BY AUTHORITIES HAVING JURISDICTION. 16. DO NOT INTERRUPT EXISTING UTILITIES, EXCEPT WHEN AUTHORIZED IN WRITING BY AUTHORITIES HAVING JURISDICTION. PROVIDE TEMPORARY SERVICES DURING INTERRUPTIONS TO EXISTING UTILITIES, AS ACCEPTABLE TO AUTHORITIES HAVING JURISDICTION.
	 17. WHEN UTILITY SERVICES ARE REQUIRED TO BE REMOVED, RELOCATED, OR ABANDONED, PROVIDE BYPASS CONNECTIONS TO MAINTAIN CONTINUITY OF SERVICE BEFORE PROCEEDING WITH DEMOLITION.
	 CONTRACTOR SHALL CONTACT ALL UTILITY COMPANIES INCLUDING BUT NOT LIMITED TO THE FOLLOWING: ELECTRIC, GAS, WATER, TELEPHONE, STORM SEWER, AND SANITARY SEWER FOR FIELD LOCATION OF ALL UNDERGROUND AND OVERHEAD UTILITY LINES. PRIOR TO COMMENCEMENT OF
	ANY DEMOLITION WORK, CONTRACTOR SHALL IDENTIFY ALL ELECTRICAL CIRCUITS SERVICING THE AREA INVOLVED WITH THIS DEMOLITION. THOSE CIRCUITS SHALL THEN BE LOCKED OUT AND TAGGED OUT IF THEY DO NOT SERVICE ANY OF THE REMAINING BUILDING. THOSE CIRCUITS WHICH ARE
	IDENTIFIED TO SERVICE BOTH THE AREA TO BE DEMOLISHED AND THE REMAINING BUILDING SHALL BI SPLIT SO AS TO KILL ALL ELECTRICAL POWER TO THE AREA TO BE DEMOLISHED WHILE MAINTAINING POWER TO THE REMAINDER OF THE BUILDING.
	 CONTRACTOR SHALL RELOCATE UTILITIES AND EQUIPMENT AS REQUIRED TO ACCOMMODATE NEW HVAC, ELECTRICAL, PLUMBING, AND TECHNOLOGY REQUIREMENTS FOR NEW WORK. PROTECT EXISTING SITE ELEMENTS AND EXISTING LANDSCAPING TO REMAIN. PROTECTION SHALL
	INCLUDE BUT NOT BE LIMITED TO EXISTING TREES AND OTHER EXISTING VEGETATION INDICATED TO REMAIN IN PLACE AGAINST UNNECESSARY CUTTING, BREAKING, OR SKINNING OF ROOTS, SKINNING OR BRUISING OF BARK, SMOTHERING OF TREES BY STOCKPILING CONSTRUCTION MATERIAL OR EXCAVATED MATERIAL WITHIN DRIP LINES.
	 21. CONTRACTOR SHALL REGRADE AND HYDROMULCH AREAS AFFECTED BY DEMOLITION. 22. OWNER HAS RIGHT OF FIRST REFUSAL OF ALL ITEMS REMOVED AS PART OF THE SOCPE OF WORK, WHETHER IDENTIFIED AS SALVAGE OR NOT.
	23. NOTIFY THE BUILDING OWNER OF ANY MATERIALS, FIXTURES, ETC. TO BE REMOVED THAT ARE DEEMED SALVAGEABLE. TURN OVER ANY REQUESTED ITEMS TO THE BUILDING OWNER IN GOOD AND CLEAN CONDITION.
	24. ALL FURNITURE WILL BE REMOVED OR RELOCATED BY THE OWNER AS NECESSARY PRIOR TO THE DEMOLITION WORK OF THIS PROJECT. CONTRACTOR SHALL COORDINATE WITH OWNER AS REQUIRED.
	 25. REMOVE EXISTING CONSTRUCTION TO THE EXTENT INDICATED ON THE DRAWINGS. SHOULD ANY DAMAGE OCCUR TO ANY EXISTING CONSTRUCTION TO REMAIN, THE CONTRACTOR SHALL REPAIR THE DAMAGE TO MATCH EXISTING AND OR ADJACENT CONSTRUCTION AT NO COST TO THE OWNER. 26. MAINTAIN ANY AND ALL EXISTING FIRE-RATED ASSEMBLIES THAT ARE TO REMAIN, AND THEIR
	ASSOCIATED FIRE-RATINGS, INCLUDING BUT NOT LIMITED TO ALL ASSOCIATED EXISTING FIRE-RATED OPENINGS, ALL ASSOCIATED EXISTING FIRE-RATED PENETRATIONS, AND ALL ASSOCIATED EXISTING FIRE-RATED FIRESTOPPING CONDITIONS.
	27. WHEN UNANTICIPATED MECHANICAL, ELECTRICAL, OR STRUCTURAL ELEMENTS THAT CONFLICT WITH THE INTENDED FUNCTION OR DESIGN ARE ENCOUNTERED, DETERMINE THE NATURE AND EXTENT OF THE CONFLICT AND NOTIFY THE ARCHITECT IMMEDIATELY FOR RESOLUTION.
	 28. REMOVE, PATCH, AND REPAIR ALL ABANDONED ROOF PENETRATIONS RESULTING FROM WORK. 29. SAW-CUT AND REMOVE EXISTING FLOOR FINISHES AND FLOOR SLAB AS REQUIRED TO INSTALL NEW FIXTURES, ITEMS, AND OR DEVISES FOR ALL SCOPE-OF-WORK PERTAINING TO NEW MECHANICAL
	WORK, NEW PLUMBING UTILITIES, NEW PLUMBING WORK, NEW ELECTRICAL WORK, AND NEW TECHNOLOGY WORK. SPLICE NEW REINFORCING BARS DOWELLED INTO EXITISTING CONCRETE AND PROVIDE NEW VAPOR RETARDER AND NEW CONTINUOUS WATERSTOPS AT JOINT BETWEEN NEW CONCRETE FLOOR SLAB AND EXISTING CONCRETE FLOOR SLAB. PATCH WITH NEW 3,500 PSI MINIMUM
	CONCRETE AND PREPARE FLOOR, INCLUDING NEW CONCRETE, TO RECEIVE NEW FLOOR FINISHES. COORDINATE WITH STRUCTURAL. 30. EXISTING WALLS (OR PORTIONS OF WALLS) TO BE REMOVED SHALL BE CUT FLUSH WHERE
	INTERSECTING WITH WALLS TO REMAIN. RÉMAINING WALLS TO BE PATCHED AND FINISHED SMOOTH. 31. NEW OPENING TO BE CUT IN EXISTING WALLS SHALL BE SAW-CUT AT LOCATIONS INDICATED TO THE HEIGHT AND WIDTH INDICATED. NEW LINTELS SHALL BE INSTALLED TO SUPPORT EXISTING WALL
	CONSTRUCTION ABOVE AS INDICATED ON THE DRAWINGS, OR IF NOT INDICATED, AS REQUIRED FOR NEW WALL CONSTRUCTION PER STRUCTURAL DRAWINGS. COORDINATE LOCATIONS OF ALL NEW OPENINGS IN EXISTING WALLS AND PARTITIONS WITH ARCHITECTURAL PLANS.
	 WHERE EXISTING WALL OPENINGS ARE TO BE NEWLY CLOSED-OFF, REMOVE ANY EXISTING OPENING FRAME AND PATCH AND REPAIR EXISTING WALL TO MATCH EXISTING ADJACENT MATERIALS AND FINISHES, UNLESS NOTED OTHERWISE. WHERE EXISTING INTERIOR WALLS ARE REPLACED OR REMOVED, REMOVE MEPT SYSTEMS BACK TO
	PANEL, OR MECHANICAL ROOM, OR FARTHEST POSSIBLE POINT WITHOUT DISTURBING EXISTING CONSTRUCTION. REMOVE EXISTING MECHANICAL EQUIPMENT, RELOCATE POWER PER MEPT DRAWINGS
	34. REFER TO MEPT DRAWINGS FOR DEMOLITION OF MEPT SYSTEMS. IDENTIFY WORK REQUIRED BY THIS CONTRACTOR WHICH MAY AFFECT DEMOLITION AND OR REPAIRS OF ARCHITECTURAL ELEMENTS. COORDINATE WITH RELATED SUBCONTRACTORS THE EXTENT OF ALL DEMOLITION WORK.
	 35. PATCH FLOORS, WALLS CEILINGS WHICH REMAIN AT LOCATIONS WHERE PIPES, CONDUITS, ETC. ARE REMOVED AS REQUIRED TO MATCH EXISTING CONDITIONS OR TO RECEIVE NEW FINISHES. 36. WHERE EXISTING FINISH FLOOR IS REMOVED, PREPARE FLOOR SURFACE TO RECEIVE NEW FLOORING
	FLOORING. 37. ALL DASHED LINES ARE DEMOLITION LINES U.N.O.
	DEMO LEGEND
	INTERIOR FLOOR FINISH TO BE DEMOLISHED
	INTERIOR FLOOR FINISH AND CEILING TO BE DEMOLISHED
	AREA TO BE COMPLETLY DEMOLISHED
	EXISTING CEILING TO REMAIN
	EXISTING WALL TO REMAIN
	DEMO EXISTING DOOR. EXISTING FRAME TO REMAIN AND BE REPAINTED. COLOR TO BE CHOSEN BY ARCHITECT
	KEYNOTE LEGEND
	NUMBER DESCRIPTION
	0136 REMOVE EXISTING FLOOR FINISH, PREP DEMOED AREA FOR NEW FLOORING; COOR. W/ABATEMENT AS NEEDED 0138 REMOVE EXISTING WALL TILE THROUGHOUT. REMOVE ALL MIRRORS, SOAP DISPENSERS,
	PAPER TOWEL DISPENSERS THROUGHOUT RESTROOM, TYP. PREP/REPAIR WALL AS REQUIRED FOR SCHEDULED FINISH 0170 REMOVE EXISTING WALL TILING ALONG HALLWAY. TAPE, SPARKLE & PREP SURFACE TO
	RECEIVE NEW WALL TILE. 0175 REMOVE AND REPLACE EXISTING RESTROOM PARTITIONS, EXISTING HANDRAILS, TOILET PAPER DISPENSERS & SANITARY NAPKIN DISPENSERS . NEW PARTITION COLOR TO BE
	SELECTED BY ARCHITECT 0176 REMOVE EXISTING PLUMBING FIXTURES THROUGHTOUT RESTROOM, TYP. 0911 SPACKLE WALL AND PREPARE FOR PAINT FINISH THROUGHOUT. RE: INTERIOR ELEVATION
	27/A-528, TYP.

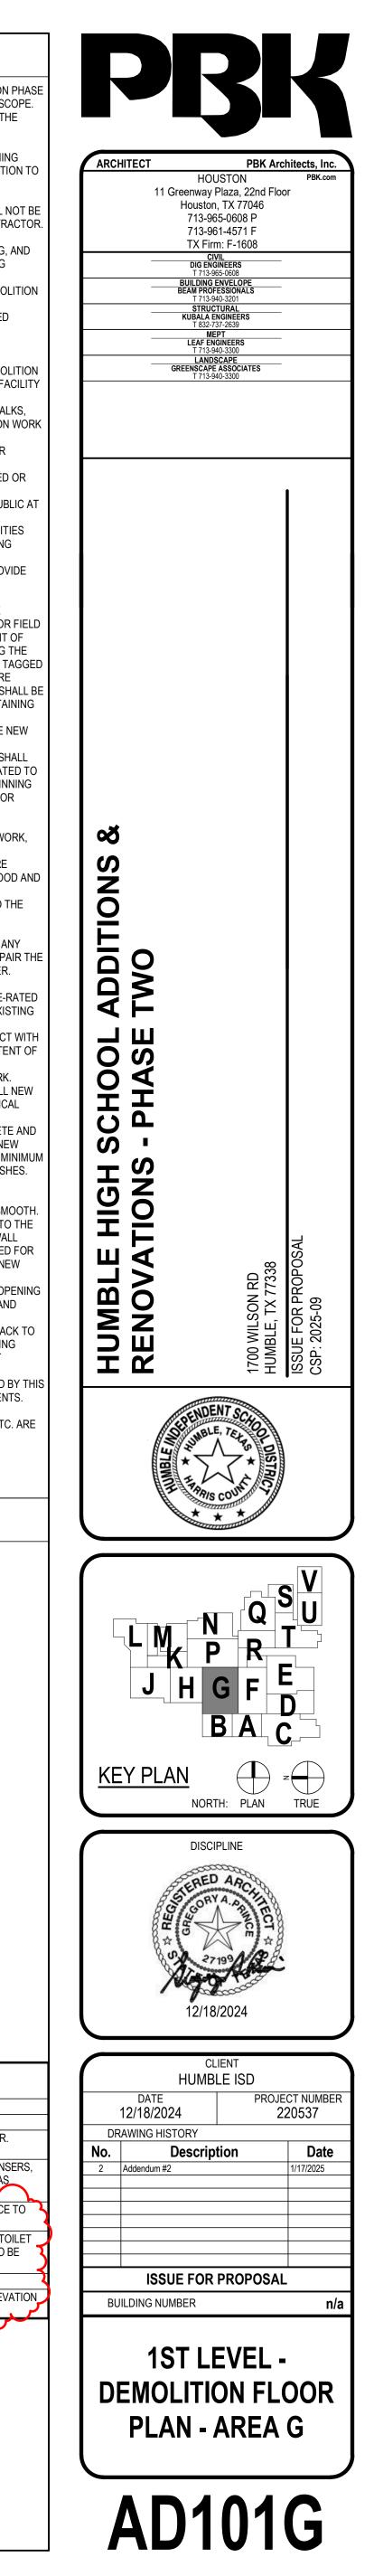

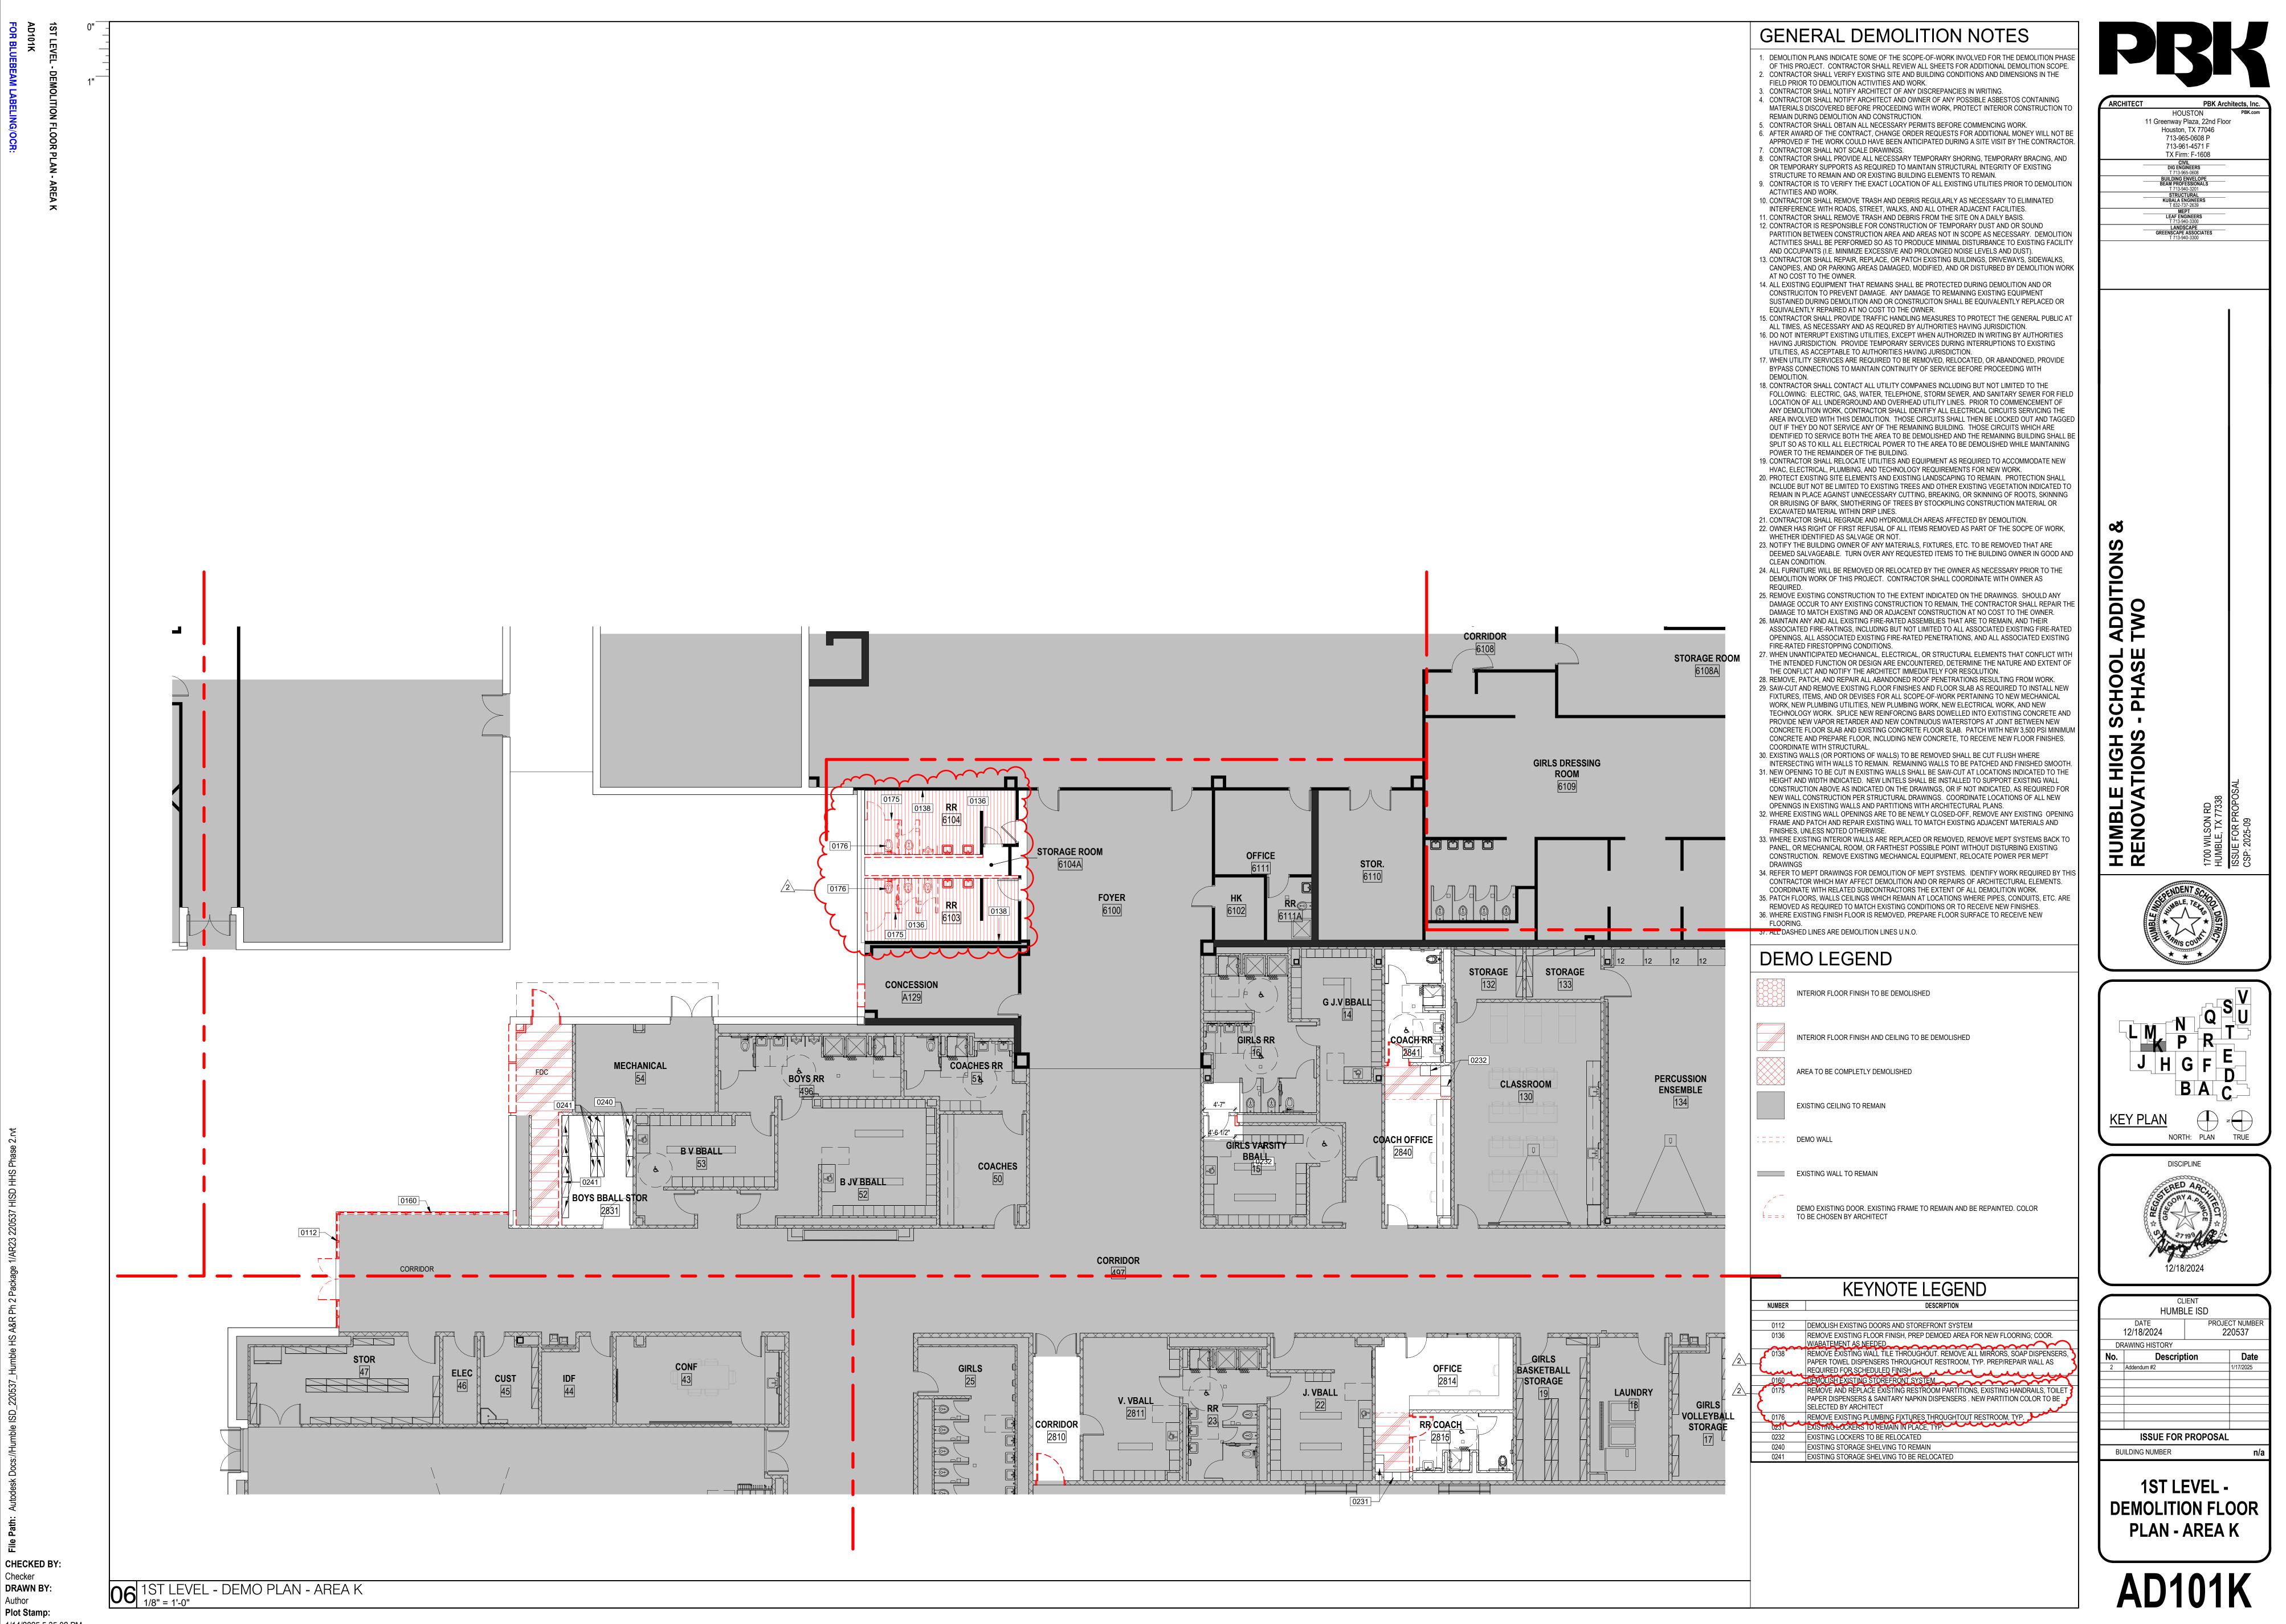


Plot Stamp: 1/14/2025 5:35:02 PM

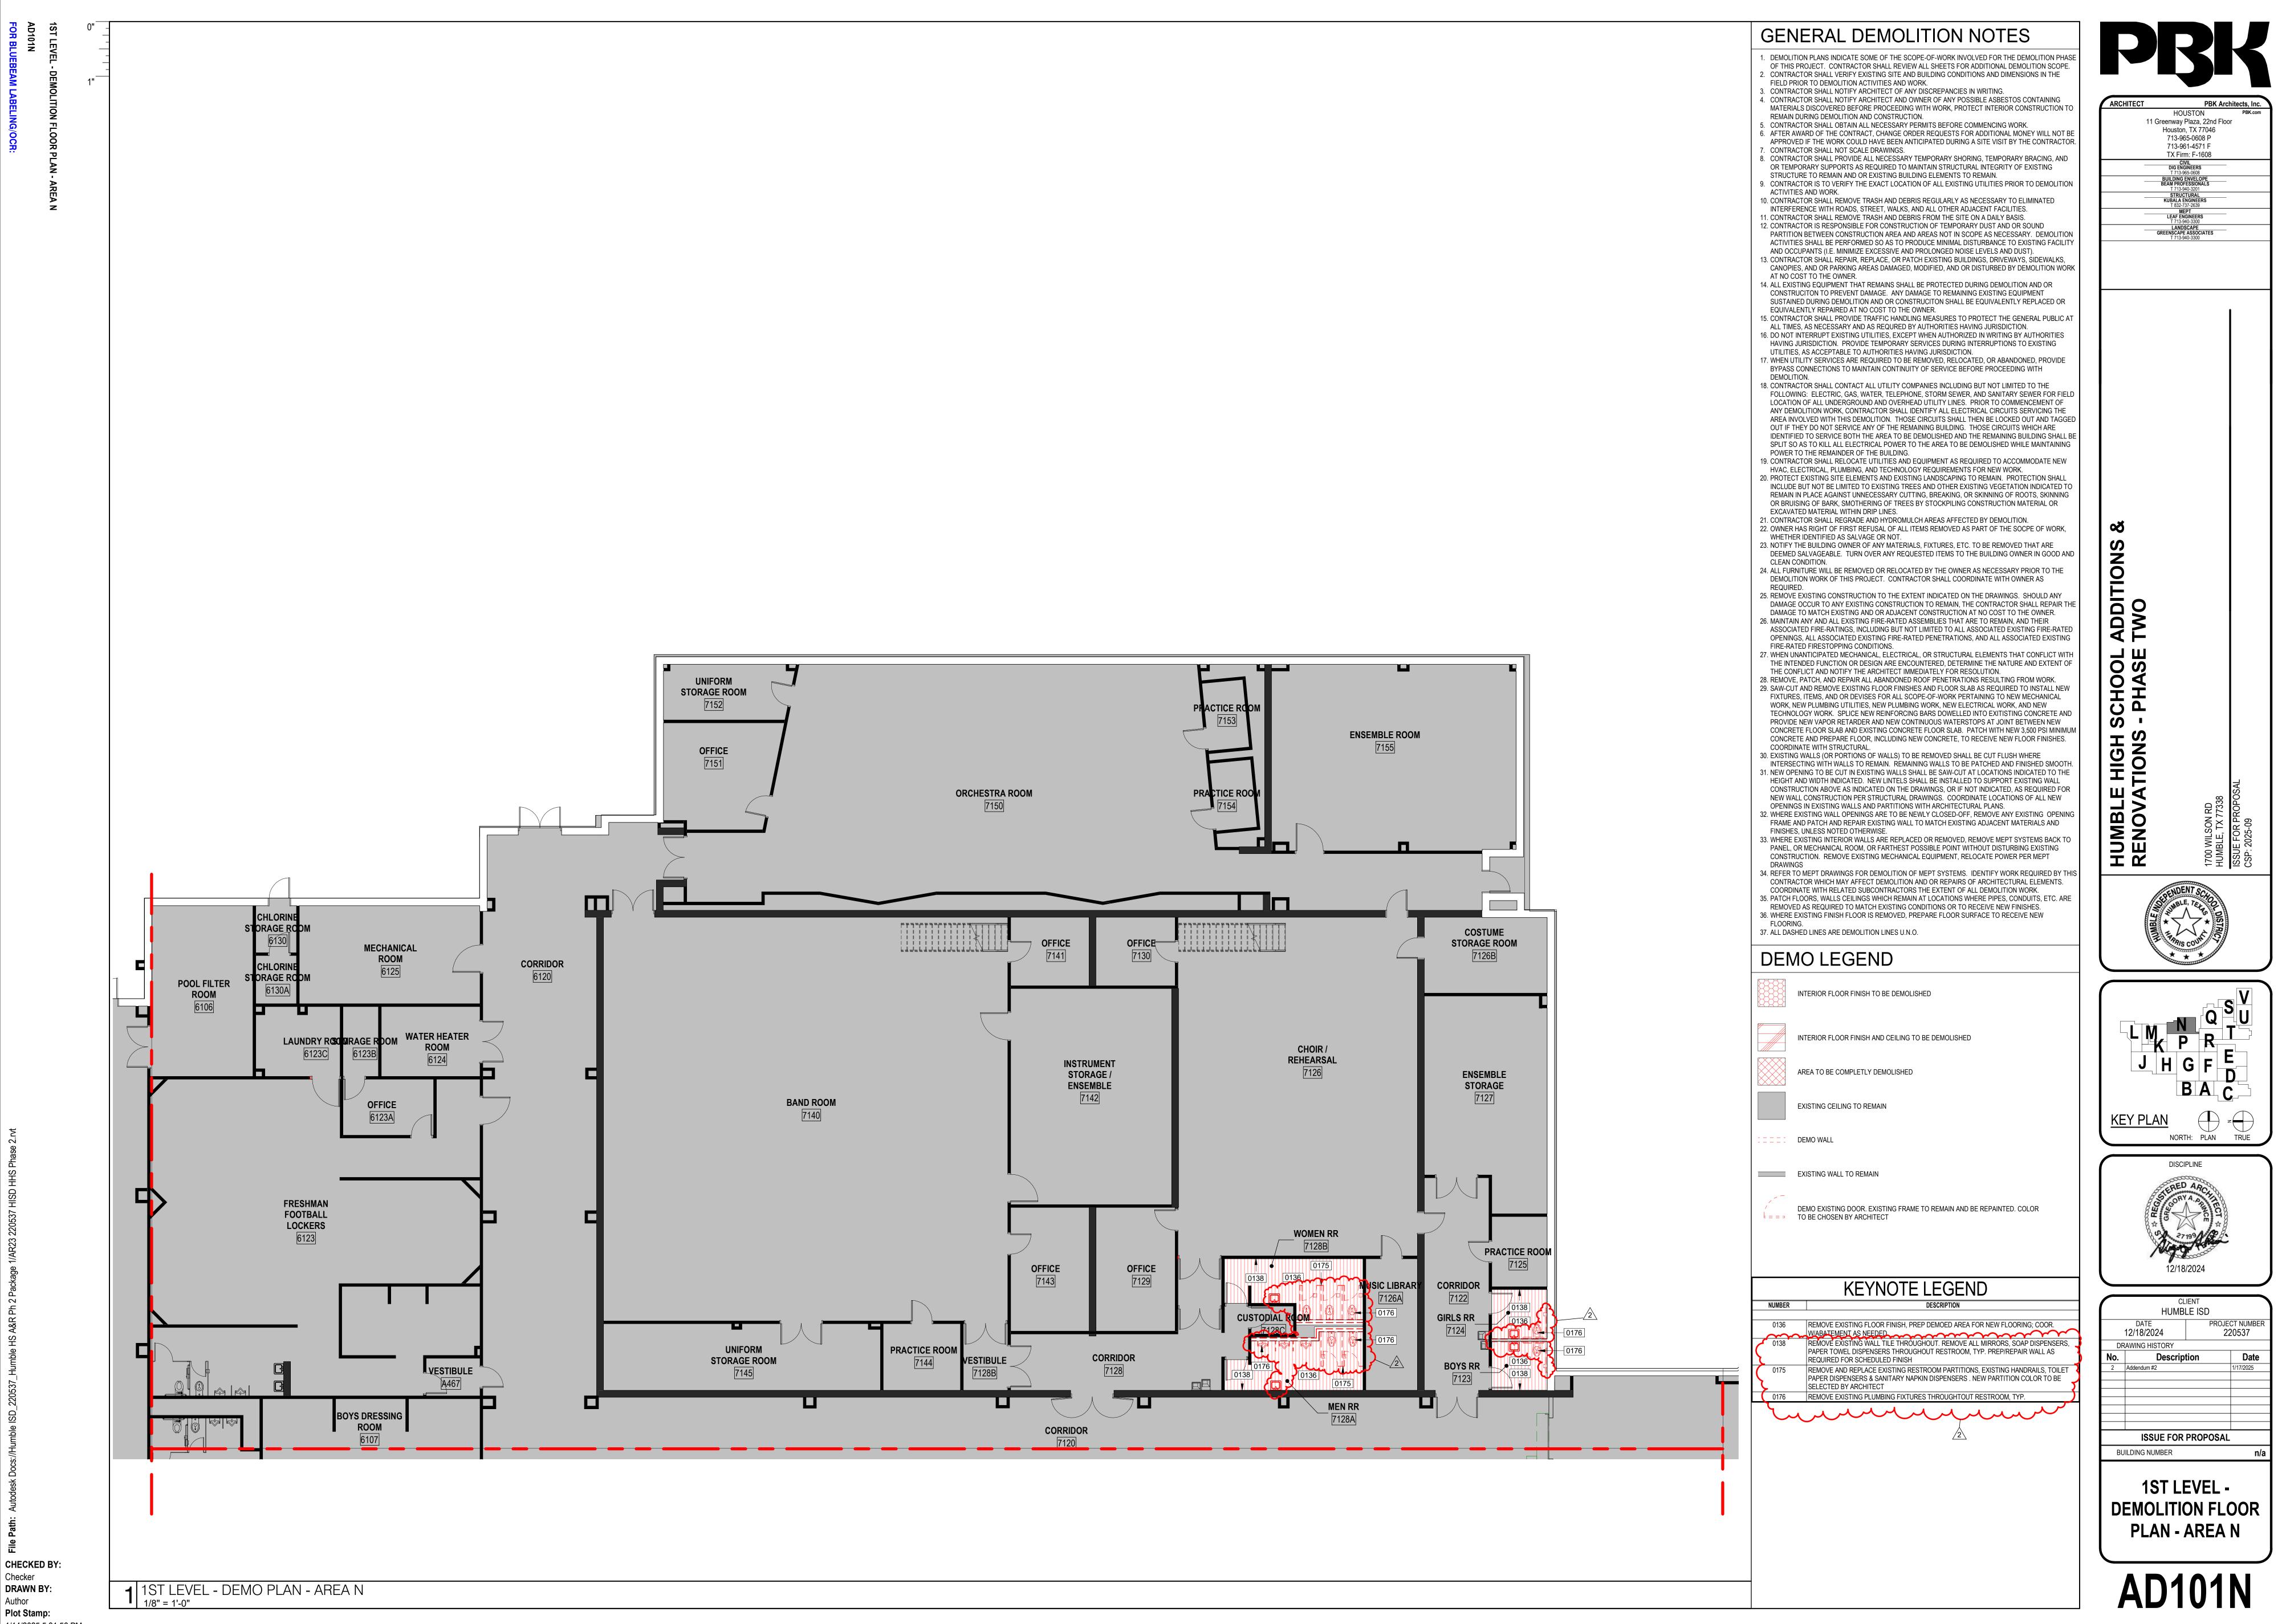


Author Plot Stamp:


1/14/2025 5:31:56 PM

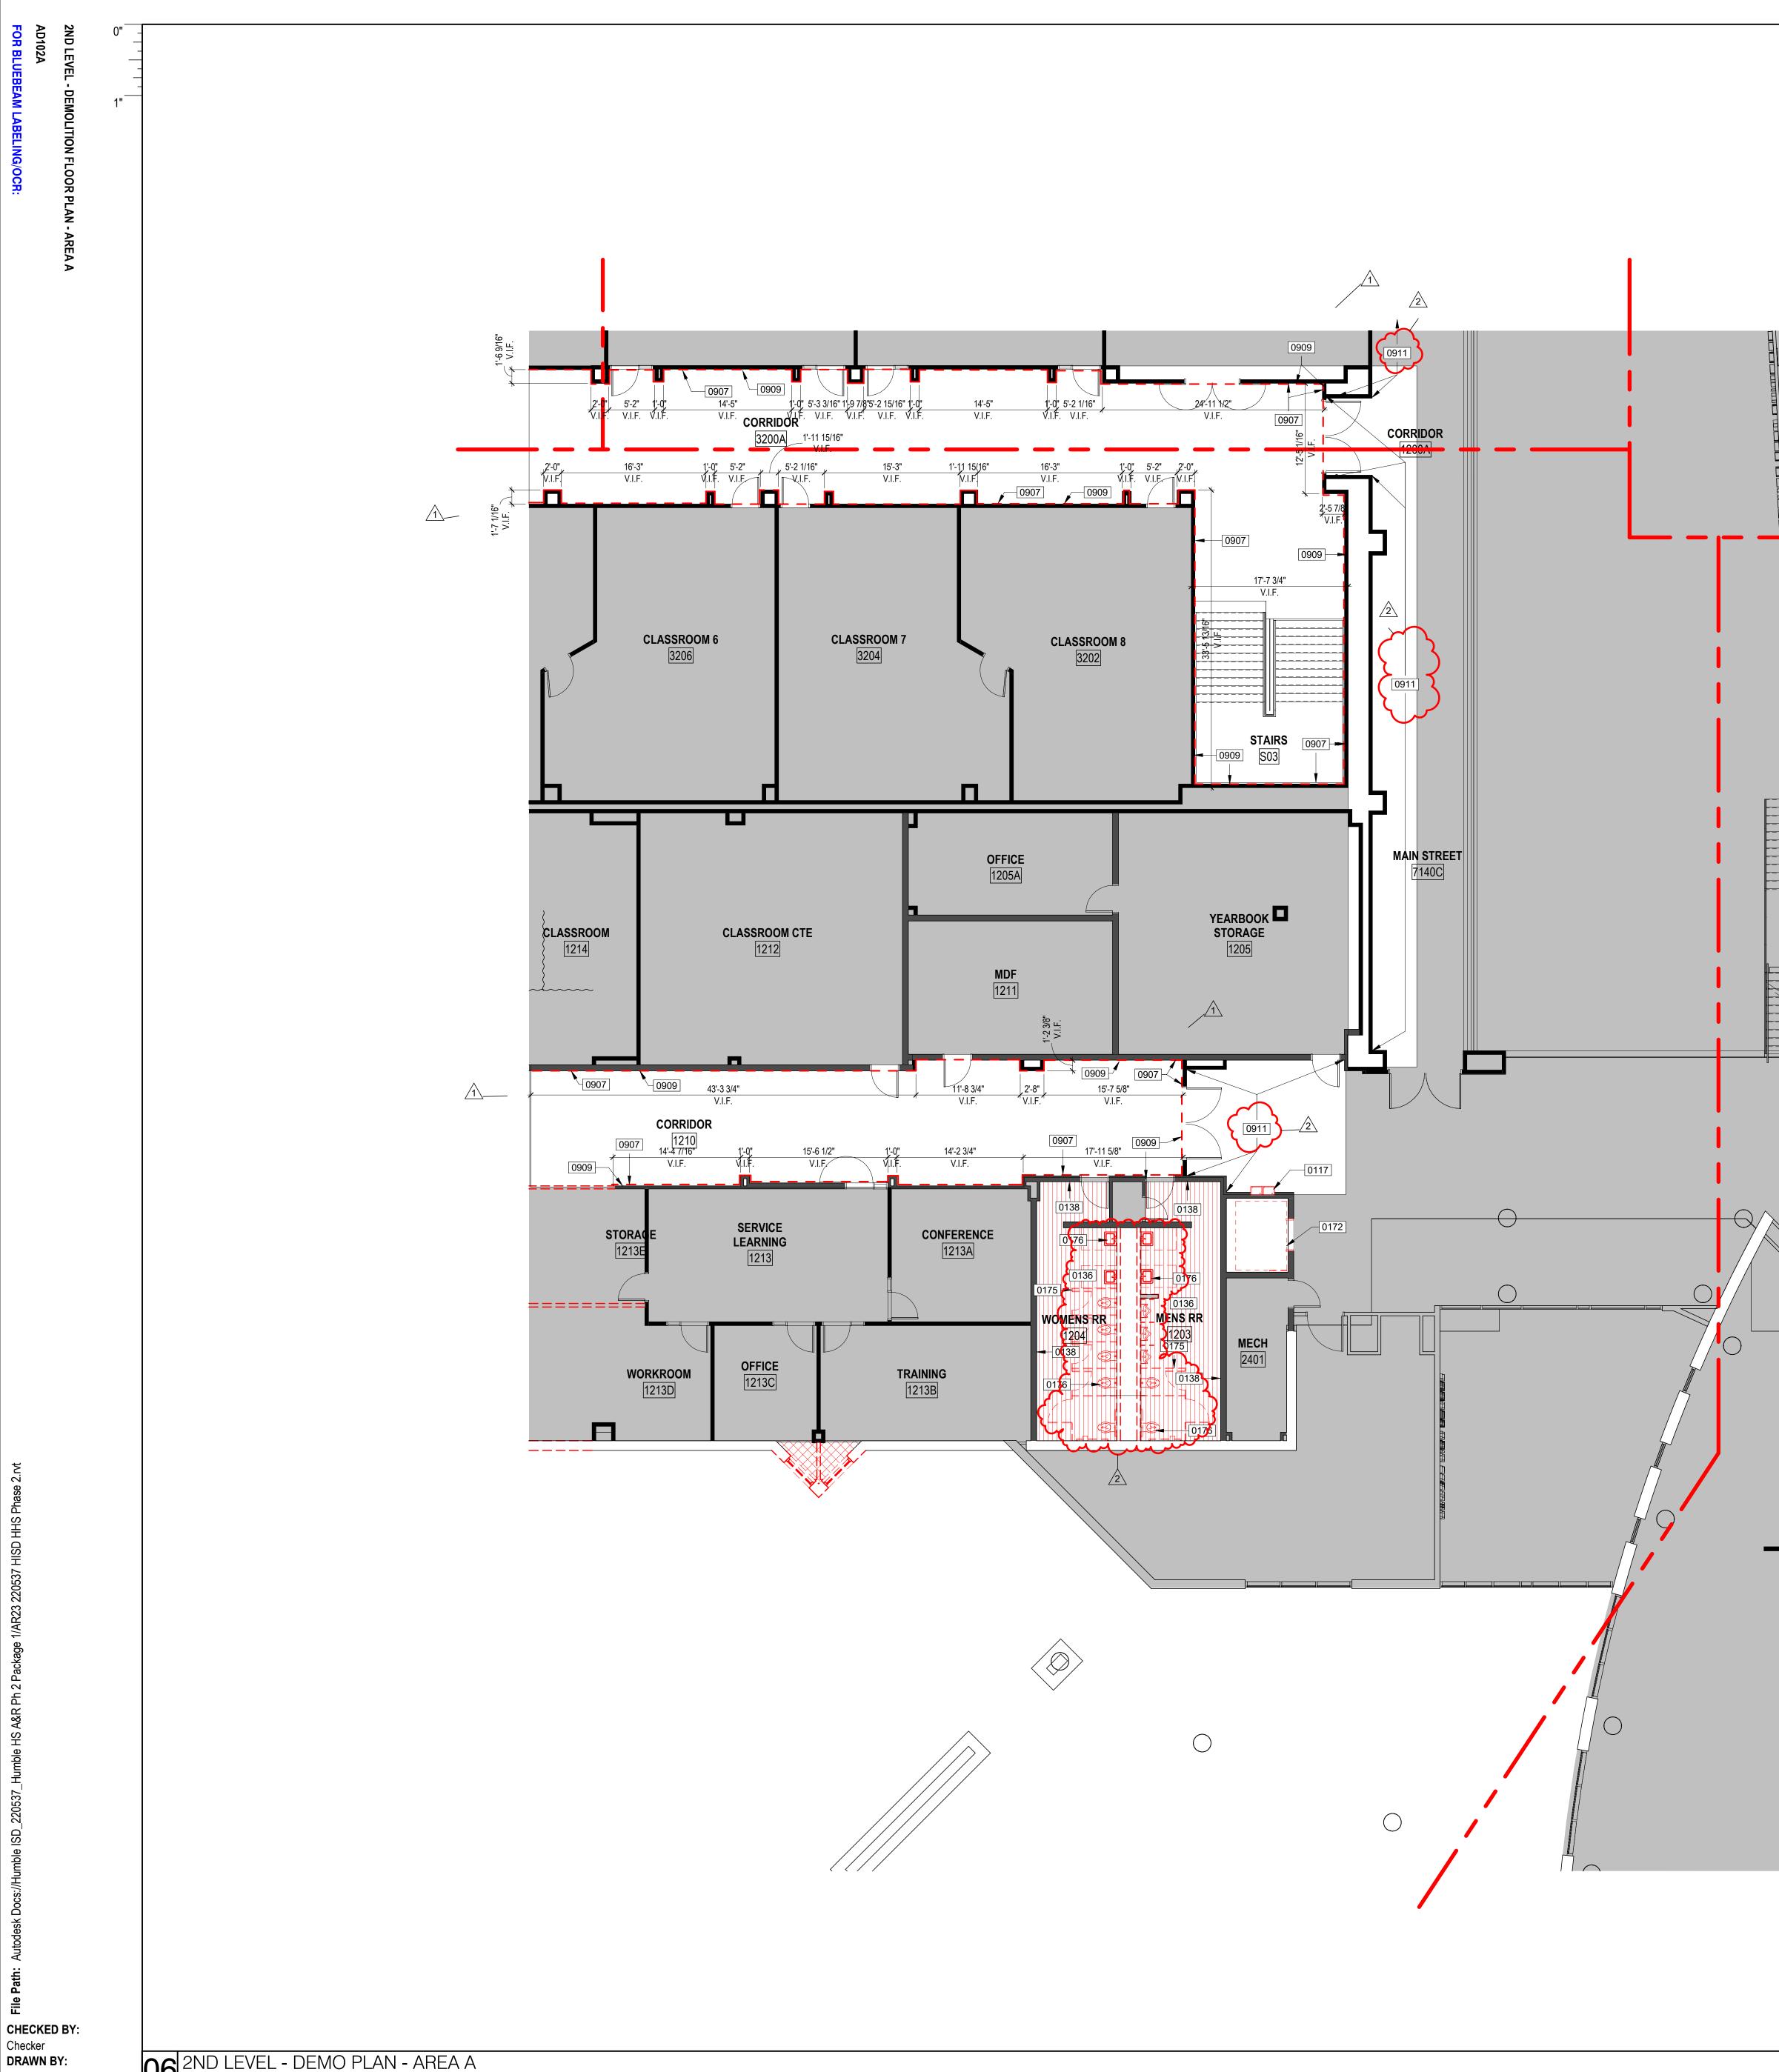


Author Plot Stamp: 1/17/2025 12:02:27 PM 06 2ND LEVEL - DEMO PLAN - AREA A

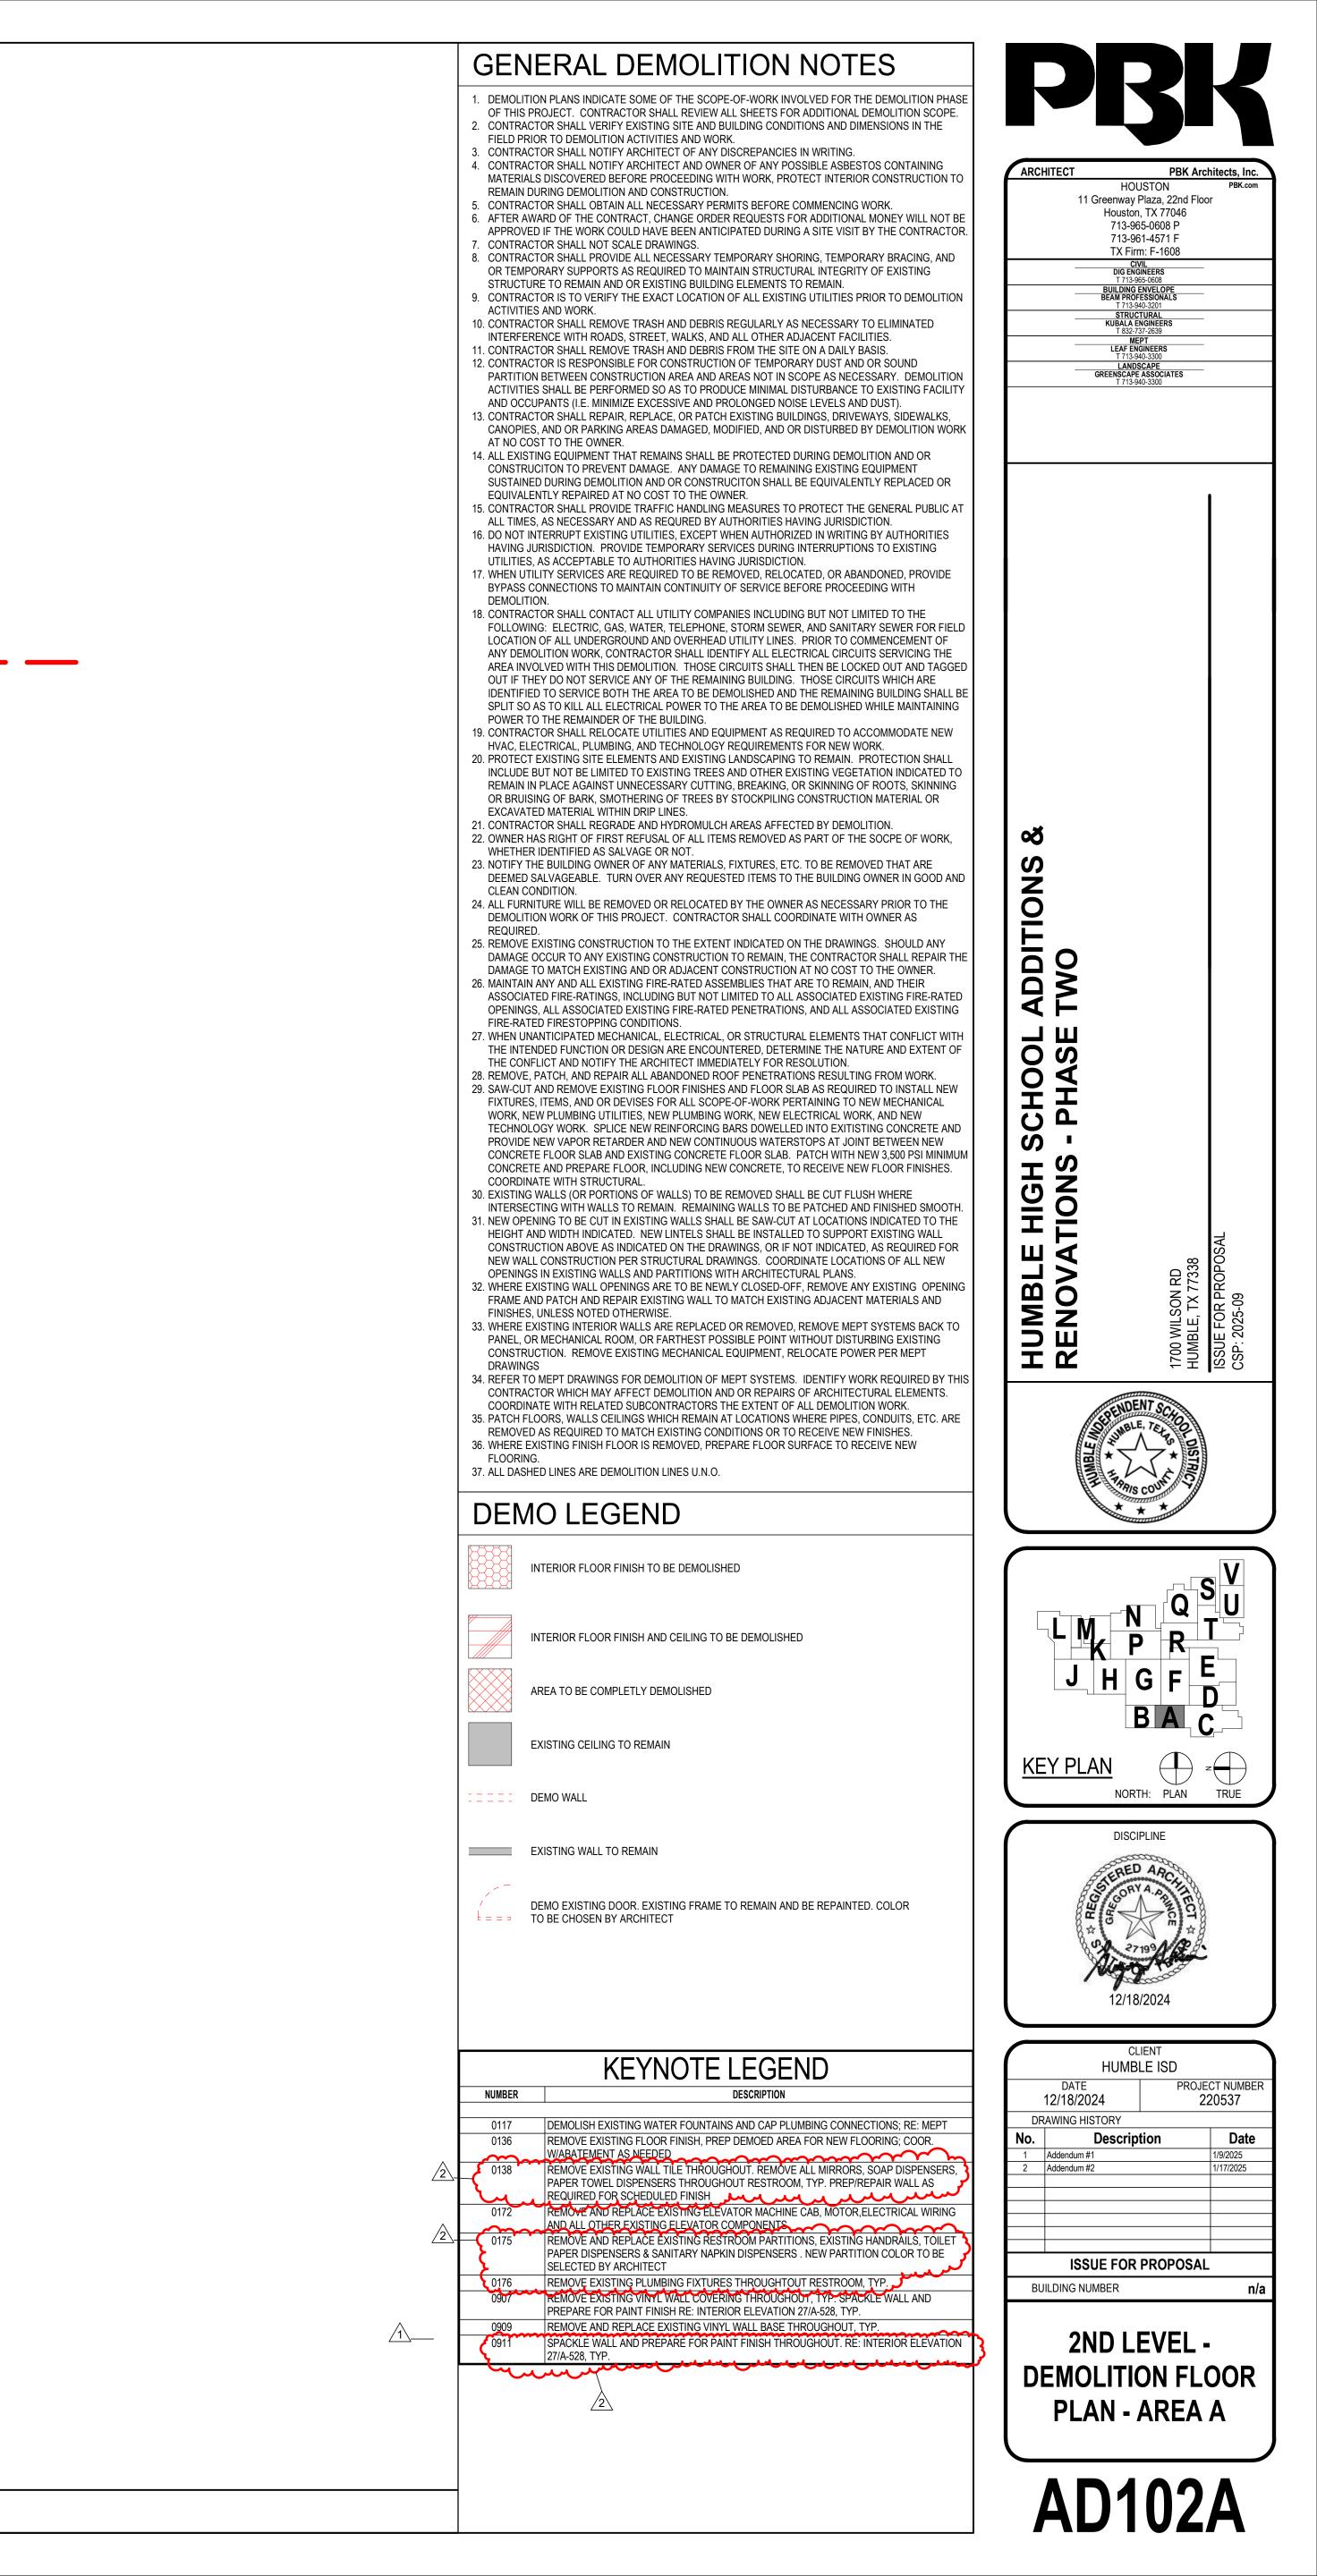



0

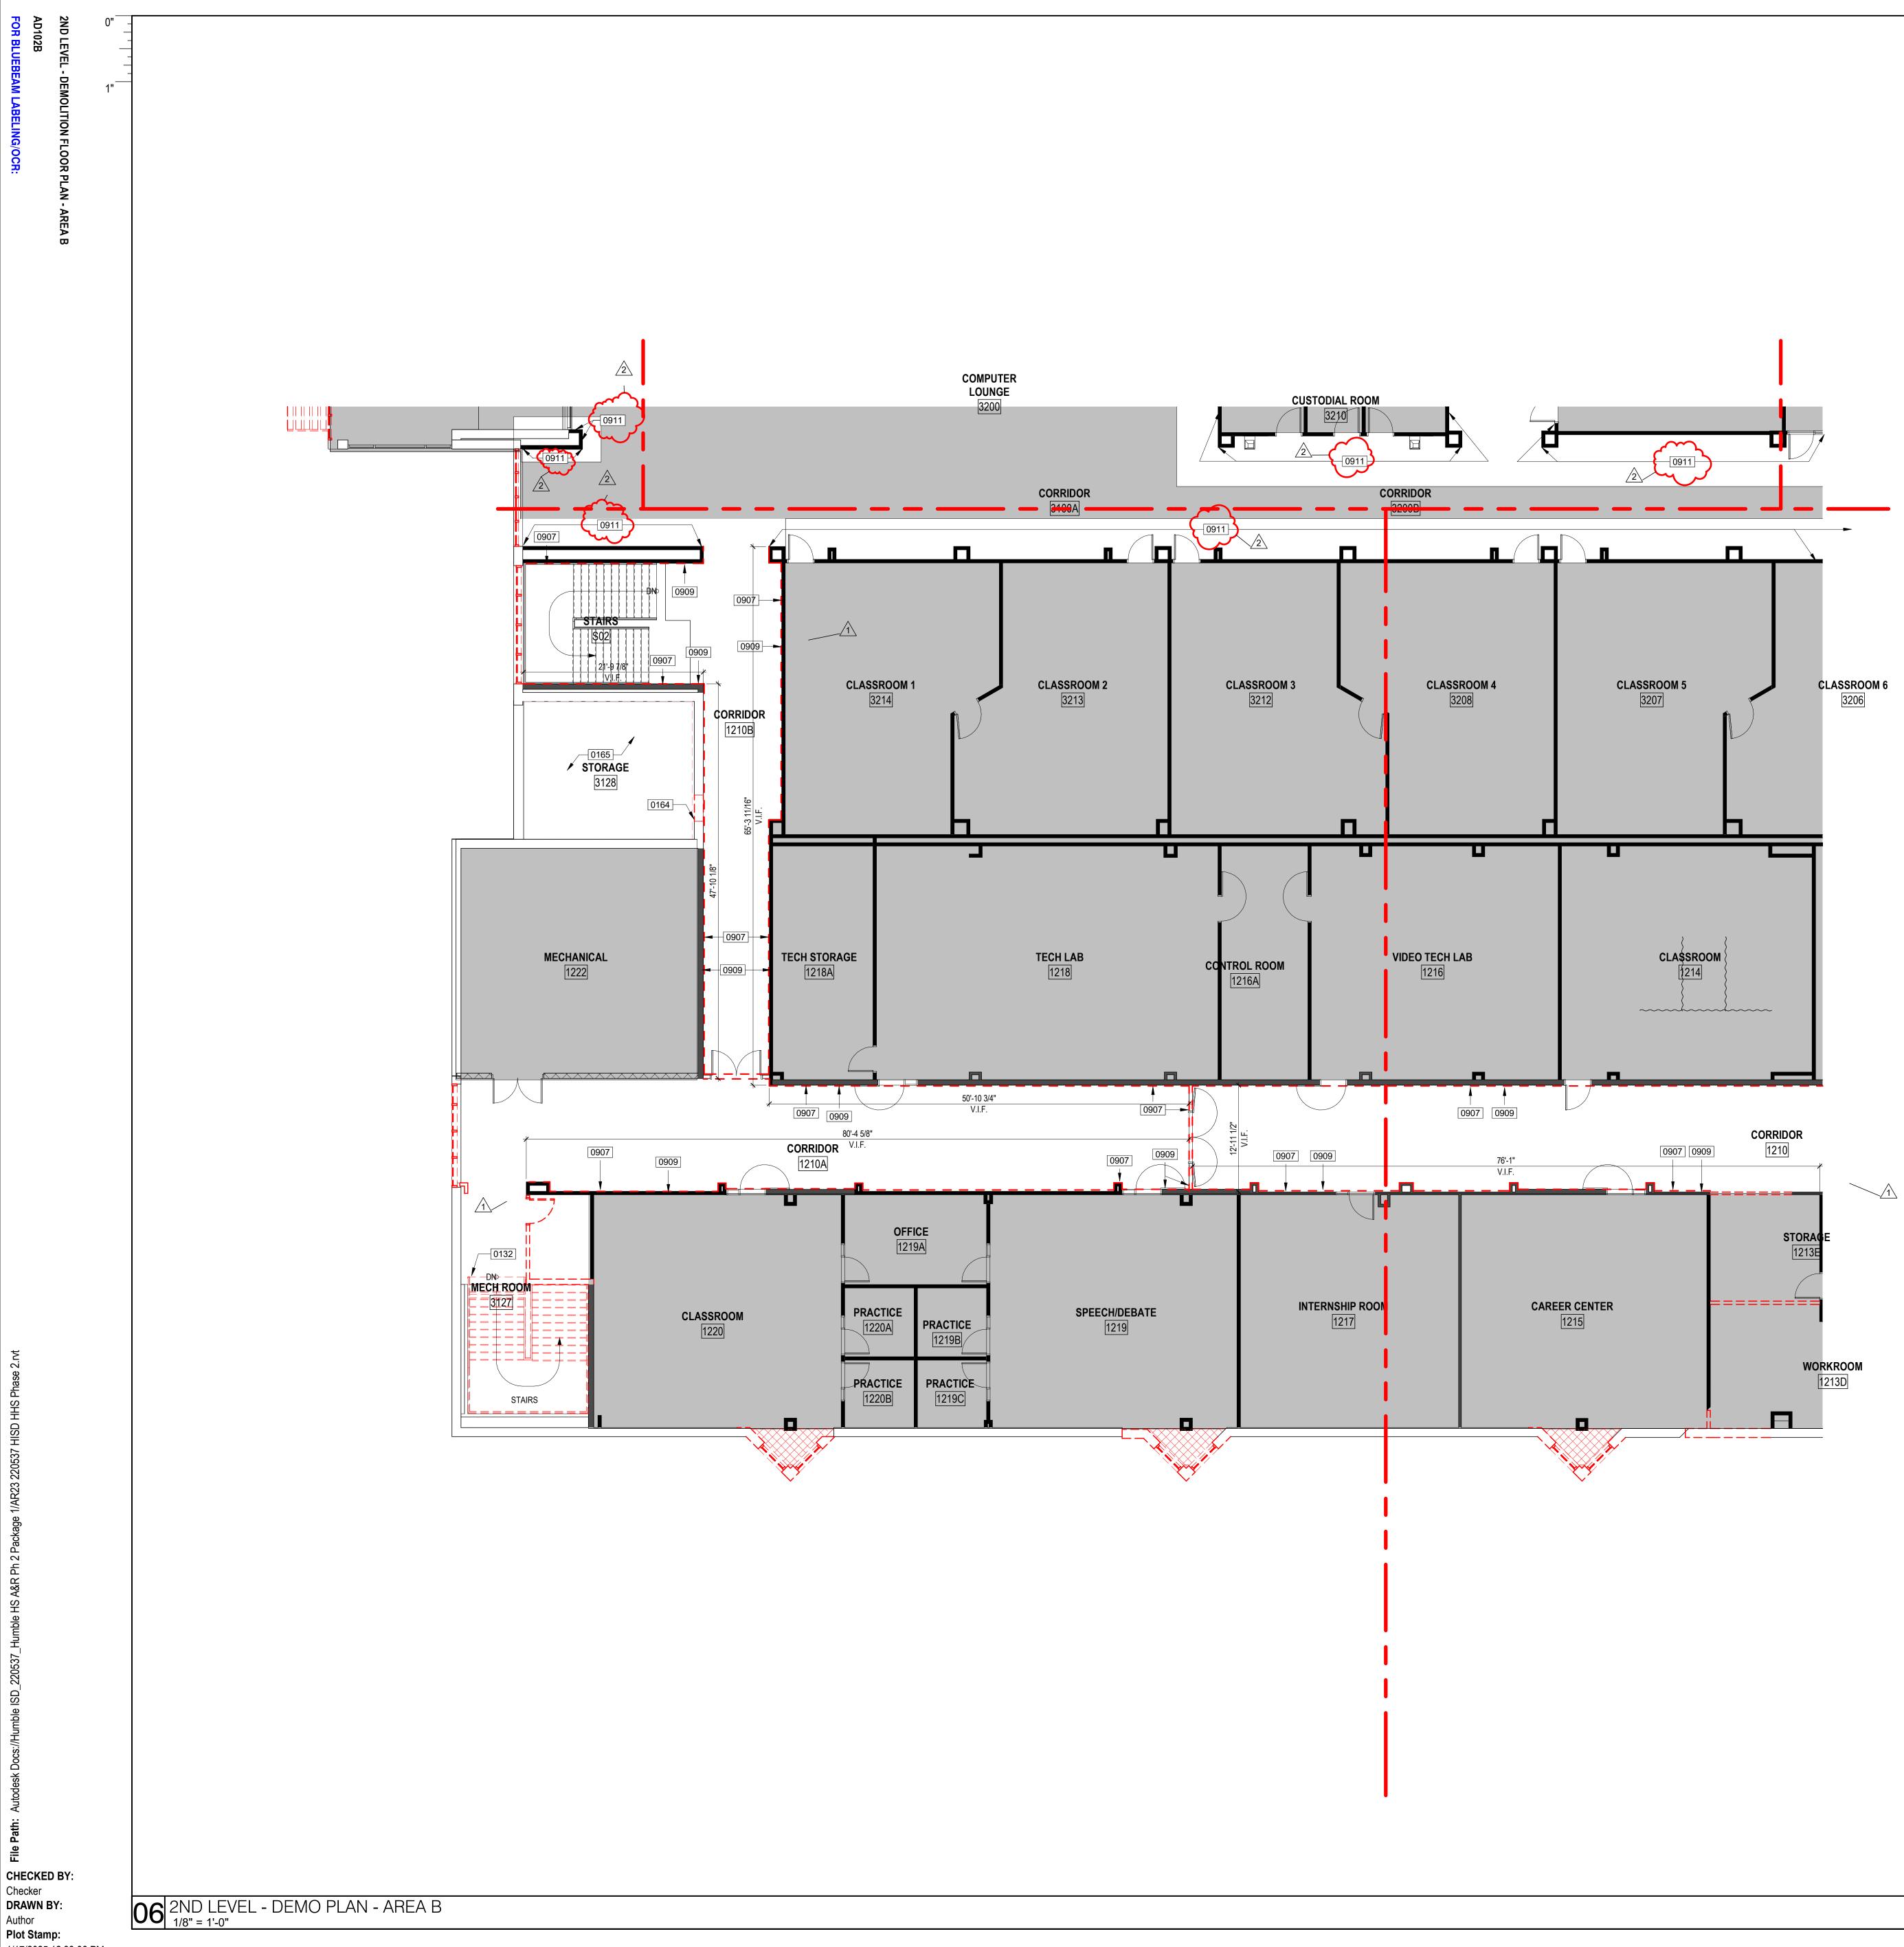


Checker Author 1/17/2025 12:33:06 PM

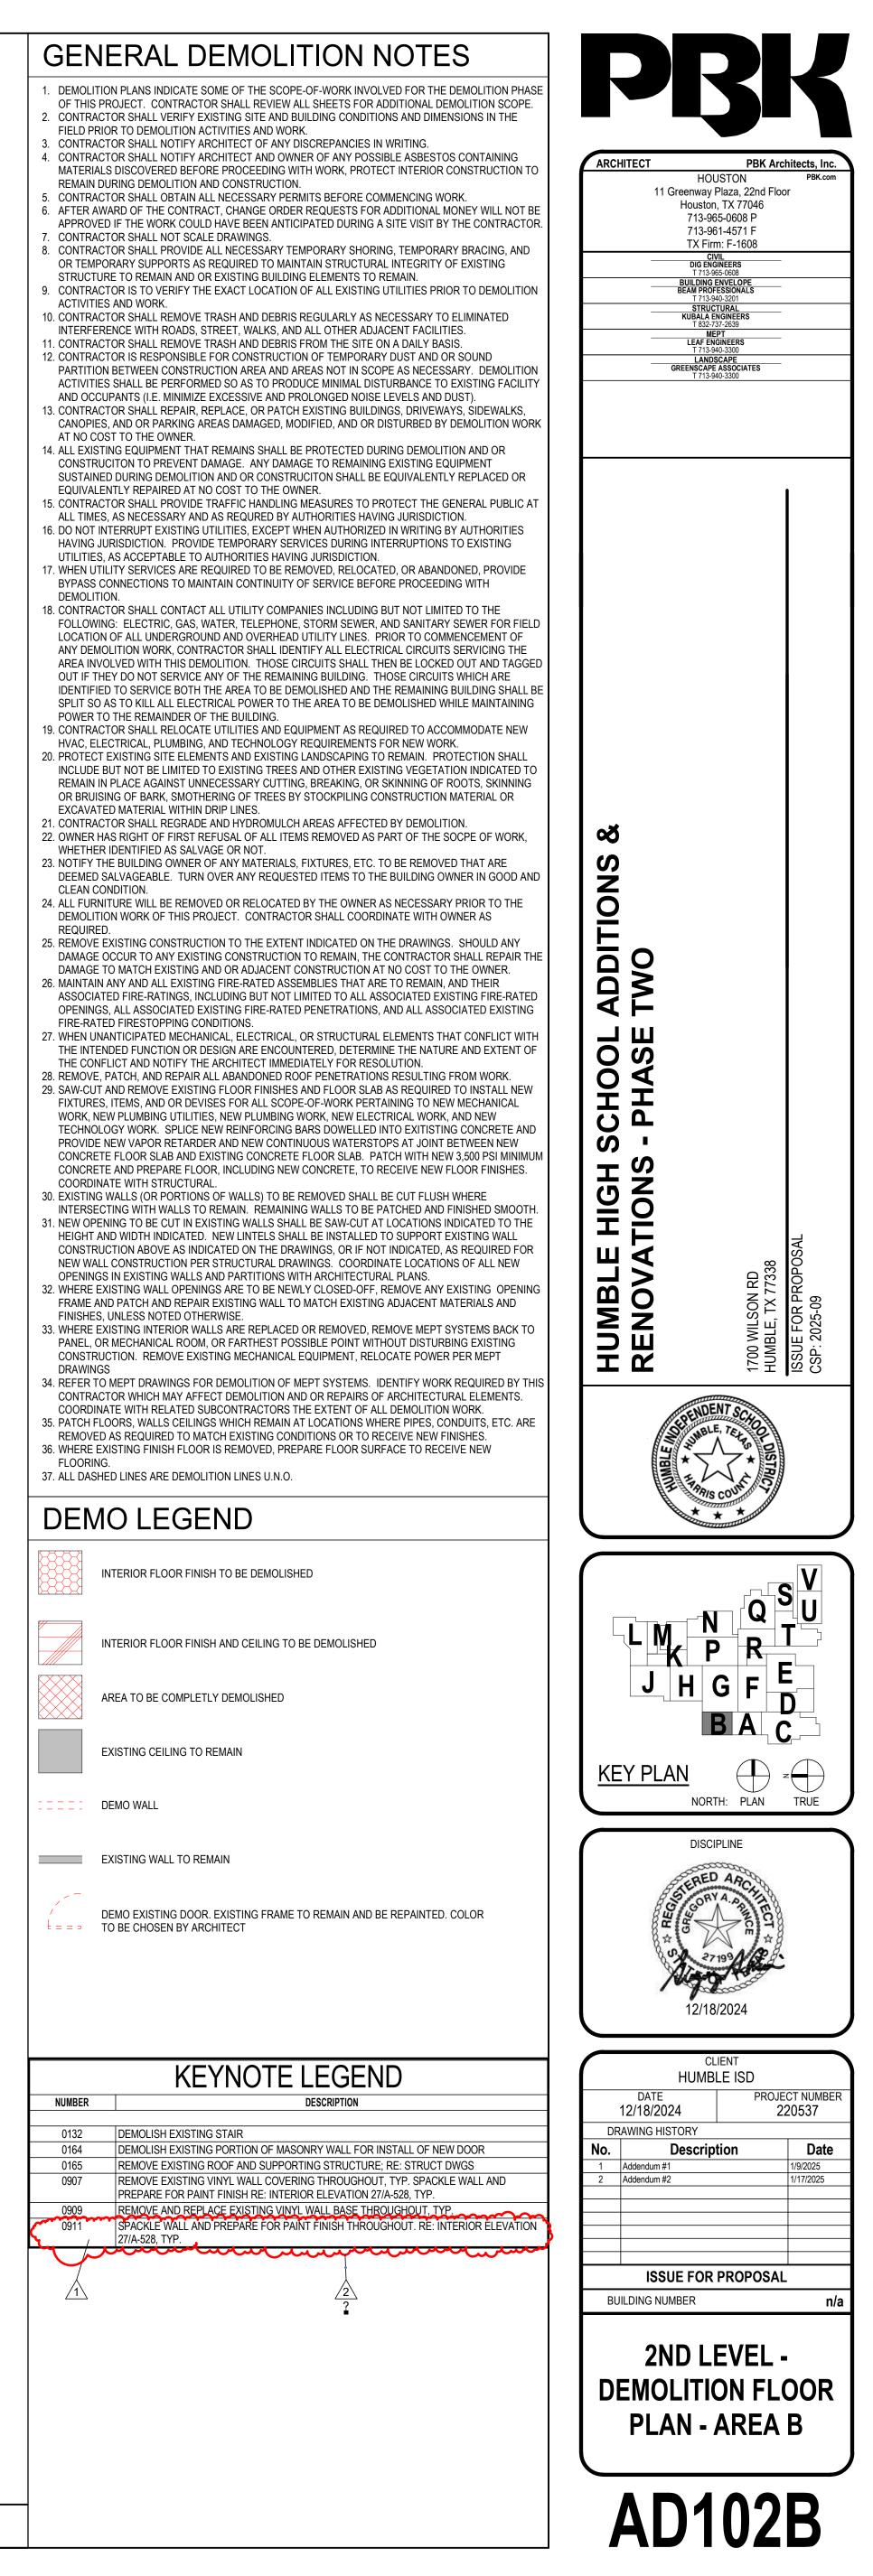


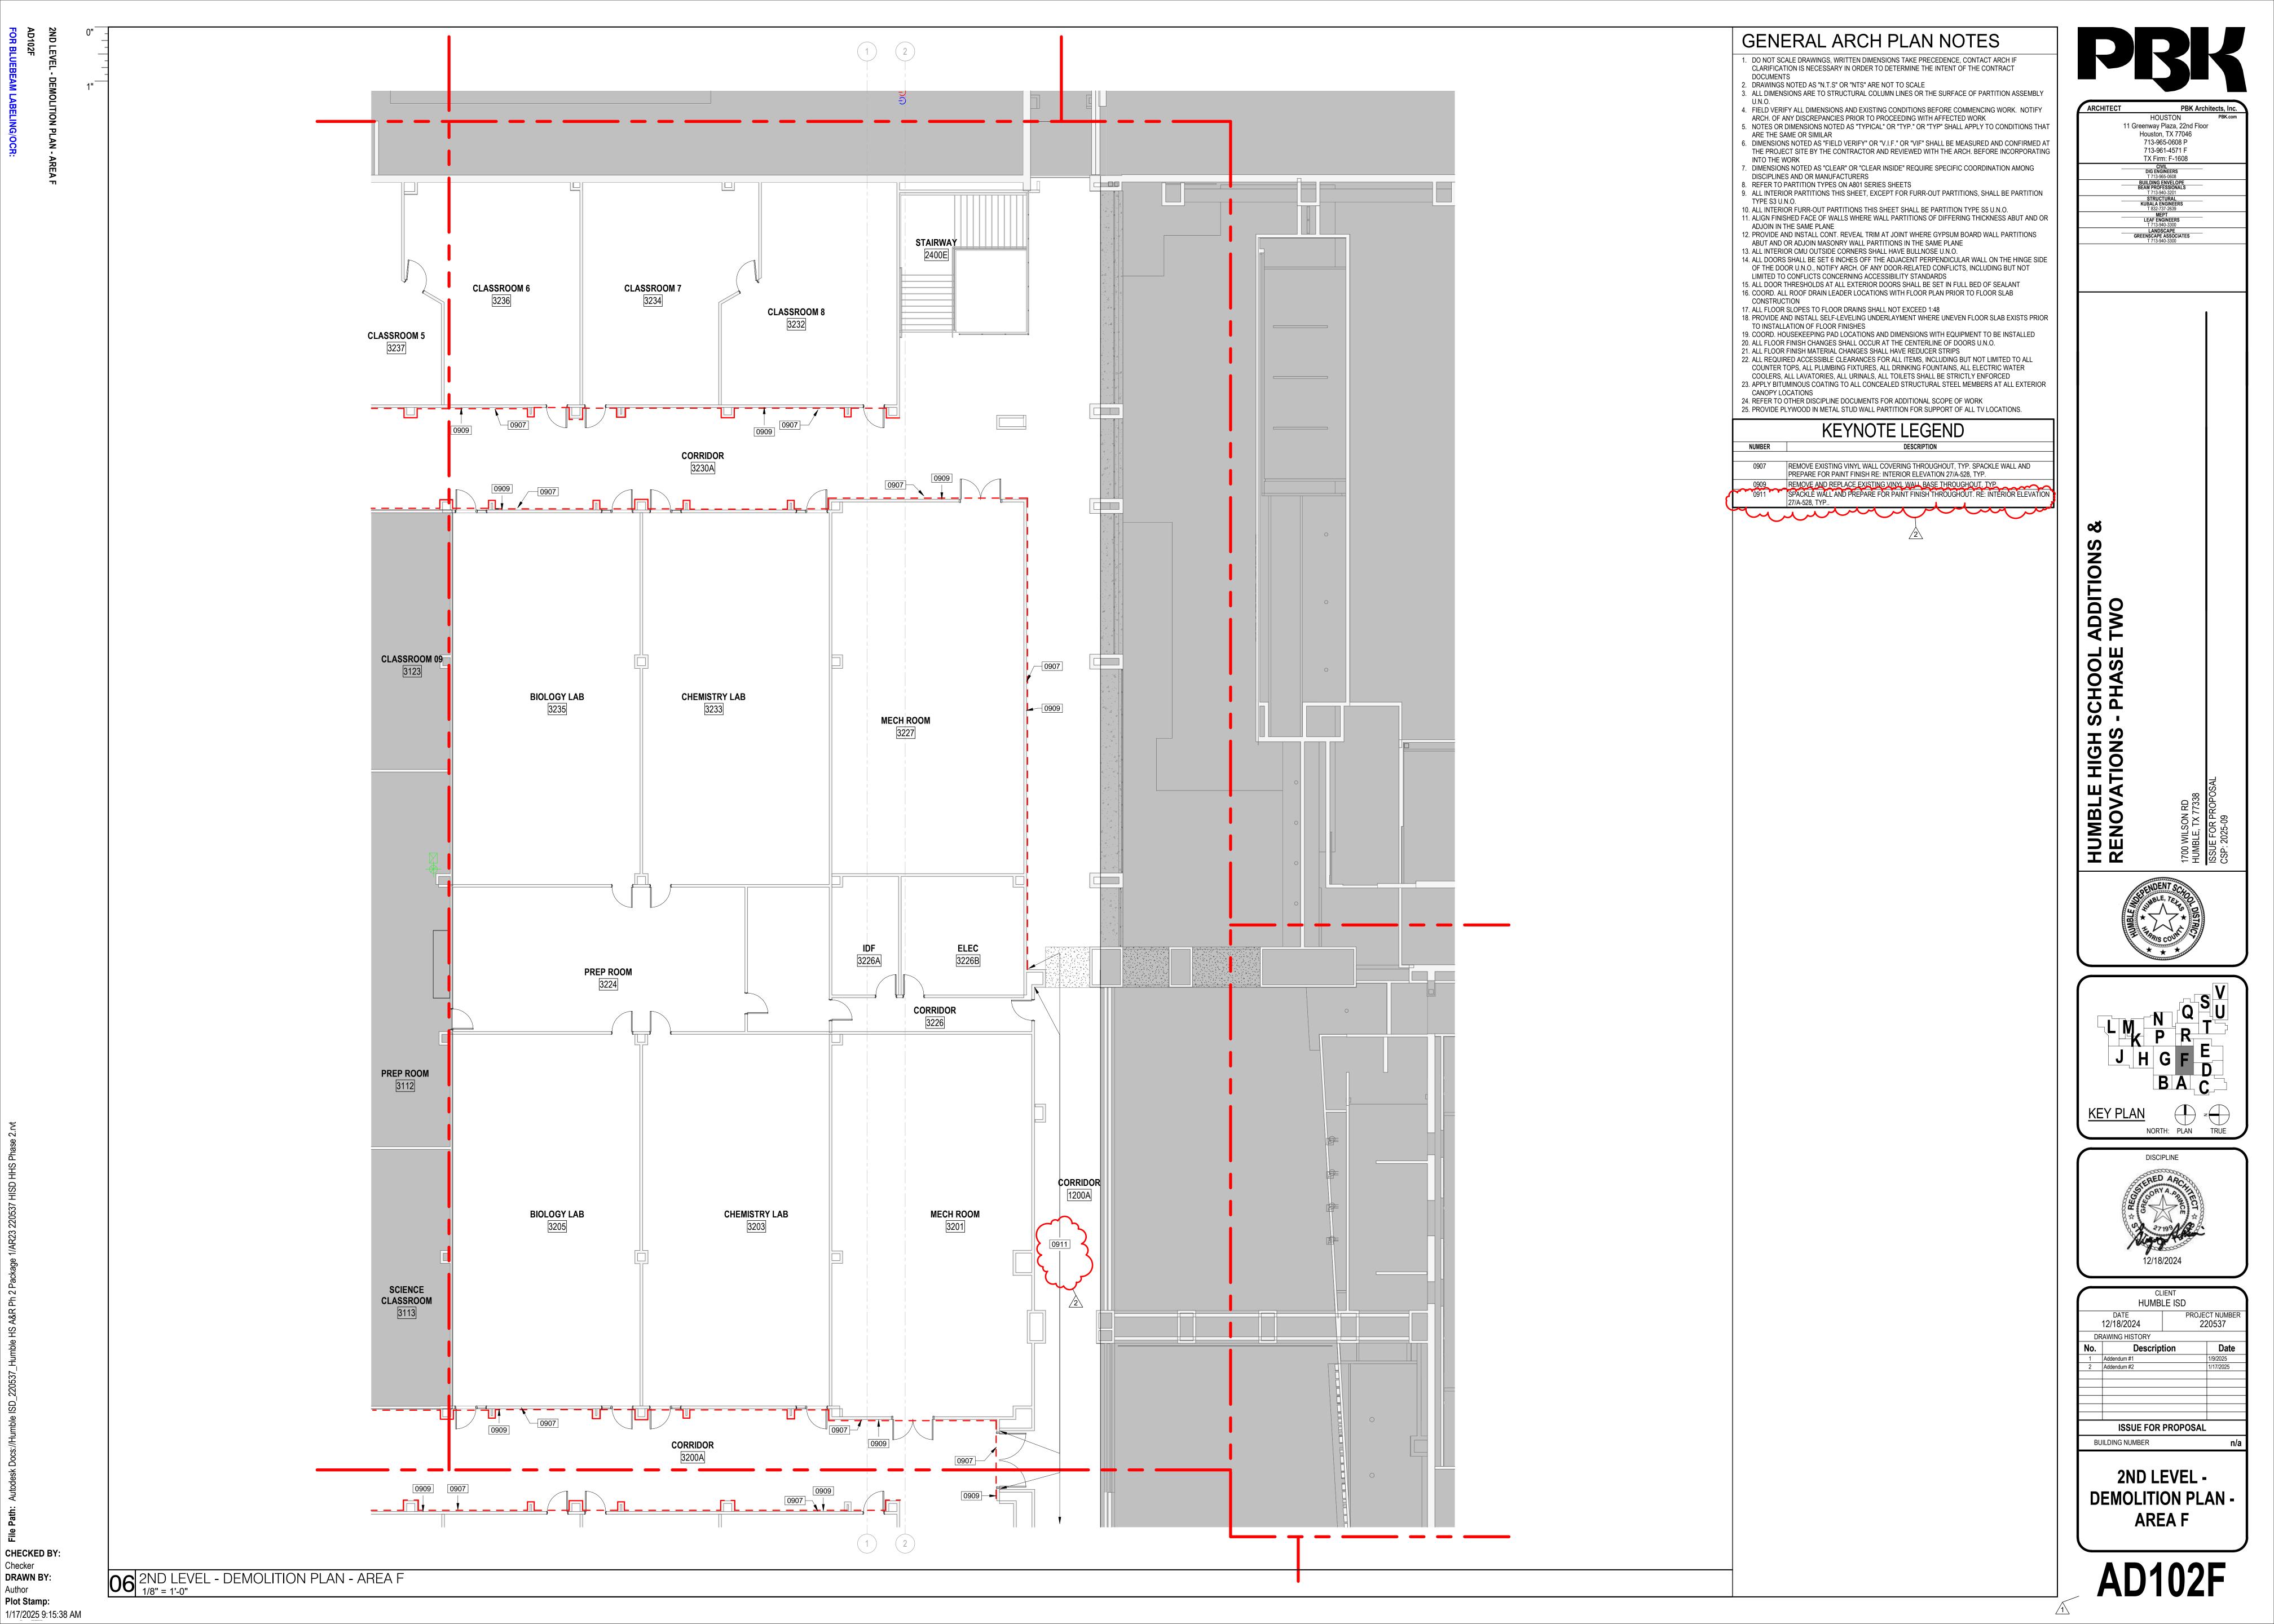


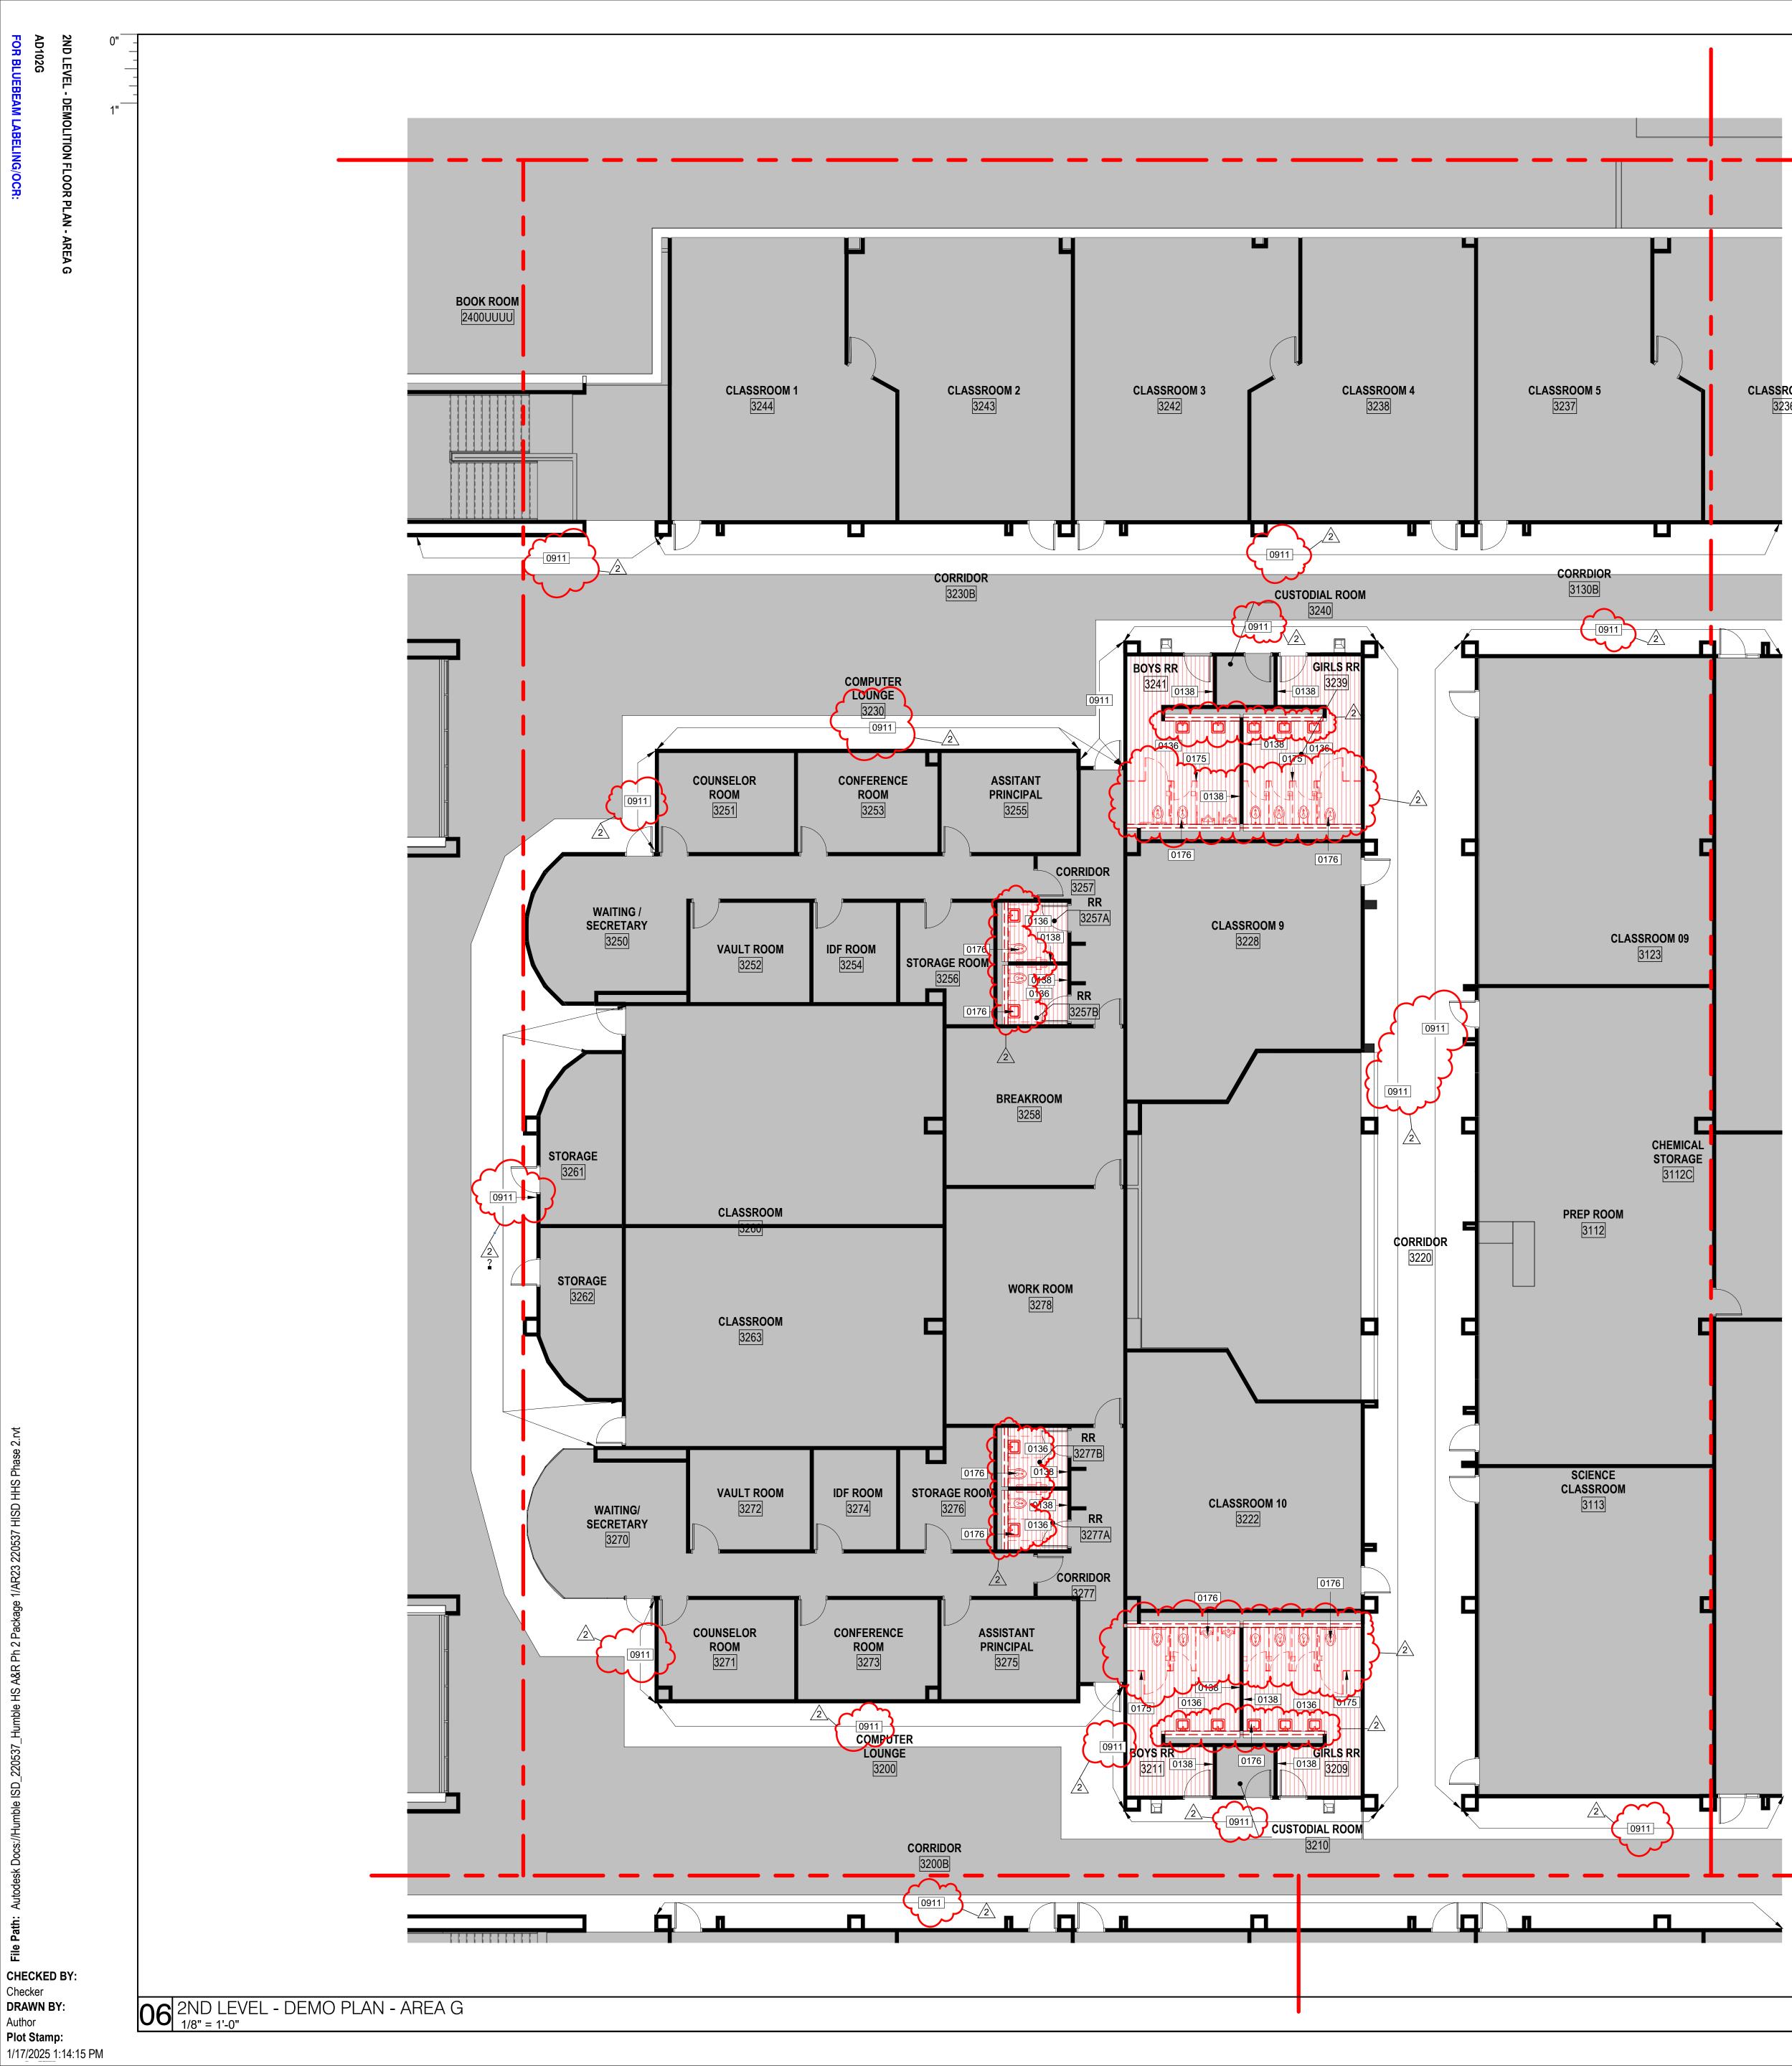


GENERAL DEMOLITION NOTES
 DEMOLITION PLANS INDICATE SOME OF THE SCOPE-OF-WORK INVOLVED FOR THE DEMOLITION FOR THIS PROJECT. CONTRACTOR SHALL REVIEW ALL SHEETS FOR ADDITIONAL DEMOLITION SCORE. CONTRACTOR SHALL VERIFY EXISTING SITE AND BUILDING CONDITIONS AND DIMENSIONS IN THE FIELD PRIOR TO DEMOLITION ACTIVITIES AND WORK. CONTRACTOR SHALL NOTIFY ARCHITECT OF ANY DISCREPANCIES IN WRITING.
 CONTRACTOR SHALL NOTIFY ARCHITECT AND OWNER OF ANY POSSIBLE ASBESTOS CONTAINING MATERIALS DISCOVERED BEFORE PROCEEDING WITH WORK, PROTECT INTERIOR CONSTRUCTION REMAIN DURING DEMOLITION AND CONSTRUCTION. CONTRACTOR SHALL OBTAIN ALL NECESSARY PERMITS BEFORE COMMENCING WORK.
 AFTER AWARD OF THE CONTRACT, CHANGE ORDER REQUESTS FOR ADDITIONAL MONEY WILL NO APPROVED IF THE WORK COULD HAVE BEEN ANTICIPATED DURING A SITE VISIT BY THE CONTRA CONTRACTOR SHALL NOT SCALE DRAWINGS. CONTRACTOR SHALL PROVIDE ALL NECESSARY TEMPORARY SHORING, TEMPORARY BRACING, A
 OR TEMPORARY SUPPORTS AS REQUIRED TO MAINTAIN STRUCTURAL INTEGRITY OF EXISTING STRUCTURE TO REMAIN AND OR EXISTING BUILDING ELEMENTS TO REMAIN. 9. CONTRACTOR IS TO VERIFY THE EXACT LOCATION OF ALL EXISTING UTILITIES PRIOR TO DEMOLI ACTIVITIES AND WORK.
 10. CONTRACTOR SHALL REMOVE TRASH AND DEBRIS REGULARLY AS NECESSARY TO ELIMINATED INTERFERENCE WITH ROADS, STREET, WALKS, AND ALL OTHER ADJACENT FACILITIES. 11. CONTRACTOR SHALL REMOVE TRASH AND DEBRIS FROM THE SITE ON A DAILY BASIS. 12. CONTRACTOR IS RESPONSIBLE FOR CONSTRUCTION OF TEMPORARY DUST AND OR SOUND
PARTITION BETWEEN CONSTRUCTION AREA AND AREAS NOT IN SCOPE AS NECESSARY. DEMOL ACTIVITIES SHALL BE PERFORMED SO AS TO PRODUCE MINIMAL DISTURBANCE TO EXISTING FAC AND OCCUPANTS (I.E. MINIMIZE EXCESSIVE AND PROLONGED NOISE LEVELS AND DUST).
 CONTRACTOR SHALL REPAIR, REPLACE, OR PATCH EXISTING BUILDINGS, DRIVEWAYS, SIDEWALK CANOPIES, AND OR PARKING AREAS DAMAGED, MODIFIED, AND OR DISTURBED BY DEMOLITION AT NO COST TO THE OWNER. ALL EXISTING EQUIPMENT THAT REMAINS SHALL BE PROTECTED DURING DEMOLITION AND OR
CONSTRUCITON TO PREVENT DAMAGE. ANY DAMAGE TO REMAINING EXISTING EQUIPMENT SUSTAINED DURING DEMOLITION AND OR CONSTRUCITON SHALL BE EQUIVALENTLY REPLACED (EQUIVALENTLY REPAIRED AT NO COST TO THE OWNER. 15. CONTRACTOR SHALL PROVIDE TRAFFIC HANDLING MEASURES TO PROTECT THE GENERAL PUBL
ALL TIMES, AS NECESSARY AND AS REQURED BY AUTHORITIES HAVING JURISDICTION. 16. DO NOT INTERRUPT EXISTING UTILITIES, EXCEPT WHEN AUTHORIZED IN WRITING BY AUTHORITIE HAVING JURISDICTION. PROVIDE TEMPORARY SERVICES DURING INTERRUPTIONS TO EXISTING UTILITIES, AS ACCEPTABLE TO AUTHORITIES HAVING JURISDICTION.
 17. WHEN UTILITY SERVICES ARE REQUIRED TO BE REMOVED, RELOCATED, OR ABANDONED, PROVI BYPASS CONNECTIONS TO MAINTAIN CONTINUITY OF SERVICE BEFORE PROCEEDING WITH DEMOLITION. 18. CONTRACTOR SHALL CONTACT ALL UTILITY COMPANIES INCLUDING BUT NOT LIMITED TO THE
FOLLOWING: ELECTRIC, GAS, WATER, TELEPHONE, STORM SEWER, AND SANITARY SEWER FOR LOCATION OF ALL UNDERGROUND AND OVERHEAD UTILITY LINES. PRIOR TO COMMENCEMENT O ANY DEMOLITION WORK, CONTRACTOR SHALL IDENTIFY ALL ELECTRICAL CIRCUITS SERVICING T
AREA INVOLVED WITH THIS DEMOLITION. THOSE CIRCUITS SHALL THEN BE LOCKED OUT AND TA OUT IF THEY DO NOT SERVICE ANY OF THE REMAINING BUILDING. THOSE CIRCUITS WHICH ARE IDENTIFIED TO SERVICE BOTH THE AREA TO BE DEMOLISHED AND THE REMAINING BUILDING SHA SPLIT SO AS TO KILL ALL ELECTRICAL POWER TO THE AREA TO BE DEMOLISHED WHILE MAINTAIN
 POWER TO THE REMAINDER OF THE BUILDING. 19. CONTRACTOR SHALL RELOCATE UTILITIES AND EQUIPMENT AS REQUIRED TO ACCOMMODATE N HVAC, ELECTRICAL, PLUMBING, AND TECHNOLOGY REQUIREMENTS FOR NEW WORK. 20. PROTECT EXISTING SITE ELEMENTS AND EXISTING LANDSCAPING TO REMAIN. PROTECTION SHA
INCLUDE BUT NOT BE LIMITED TO EXISTING TREES AND OTHER EXISTING VEGETATION INDICATE REMAIN IN PLACE AGAINST UNNECESSARY CUTTING, BREAKING, OR SKINNING OF ROOTS, SKINN OR BRUISING OF BARK, SMOTHERING OF TREES BY STOCKPILING CONSTRUCTION MATERIAL OR
 EXCAVATED MATERIAL WITHIN DRIP LINES. 21. CONTRACTOR SHALL REGRADE AND HYDROMULCH AREAS AFFECTED BY DEMOLITION. 22. OWNER HAS RIGHT OF FIRST REFUSAL OF ALL ITEMS REMOVED AS PART OF THE SOCPE OF WOI WHETHER IDENTIFIED AS SALVAGE OR NOT.
 23. NOTIFY THE BUILDING OWNER OF ANY MATERIALS, FIXTURES, ETC. TO BE REMOVED THAT ARE DEEMED SALVAGEABLE. TURN OVER ANY REQUESTED ITEMS TO THE BUILDING OWNER IN GOOD CLEAN CONDITION. 24. ALL FURNITURE WILL BE REMOVED OR RELOCATED BY THE OWNER AS NECESSARY PRIOR TO THE OWNER AS NECESSARY PRIO
DEMOLITION WORK OF THIS PROJECT. CONTRACTOR SHALL COORDINATE WITH OWNER AS REQUIRED. 25. REMOVE EXISTING CONSTRUCTION TO THE EXTENT INDICATED ON THE DRAWINGS. SHOULD AN
 DAMAGE OCCUR TO ANY EXISTING CONSTRUCTION TO REMAIN, THE CONTRACTOR SHALL REPAINDED DAMAGE TO MATCH EXISTING AND OR ADJACENT CONSTRUCTION AT NO COST TO THE OWNER. 26. MAINTAIN ANY AND ALL EXISTING FIRE-RATED ASSEMBLIES THAT ARE TO REMAIN, AND THEIR ASSOCIATED FIRE-RATINGS, INCLUDING BUT NOT LIMITED TO ALL ASSOCIATED EXISTING FIRE-RATIONS.
OPENINGS, ALL ASSOCIATED EXISTING FIRE-RATED PENETRATIONS, AND ALL ASSOCIATED EXIS FIRE-RATED FIRESTOPPING CONDITIONS. 27. WHEN UNANTICIPATED MECHANICAL, ELECTRICAL, OR STRUCTURAL ELEMENTS THAT CONFLICT THE INTENDED FUNCTION OR DESIGN ARE ENCOUNTERED, DETERMINE THE NATURE AND EXTEN
THE CONFLICT AND NOTIFY THE ARCHITECT IMMEDIATELY FOR RESOLUTION. 28. REMOVE, PATCH, AND REPAIR ALL ABANDONED ROOF PENETRATIONS RESULTING FROM WORK. 29. SAW-CUT AND REMOVE EXISTING FLOOR FINISHES AND FLOOR SLAB AS REQUIRED TO INSTALL N
FIXTURES, ITEMS, AND OR DEVISES FOR ALL SCOPE-OF-WORK PERTAINING TO NEW MECHANICA WORK, NEW PLUMBING UTILITIES, NEW PLUMBING WORK, NEW ELECTRICAL WORK, AND NEW TECHNOLOGY WORK. SPLICE NEW REINFORCING BARS DOWELLED INTO EXITISTING CONCRETE PROVIDE NEW VAPOR RETARDER AND NEW CONTINUOUS WATERSTOPS AT JOINT BETWEEN NEW
CONCRETE FLOOR SLAB AND EXISTING CONCRETE FLOOR SLAB. PATCH WITH NEW 3,500 PSI MII CONCRETE AND PREPARE FLOOR, INCLUDING NEW CONCRETE, TO RECEIVE NEW FLOOR FINISH COORDINATE WITH STRUCTURAL. 30. EXISTING WALLS (OR PORTIONS OF WALLS) TO BE REMOVED SHALL BE CUT FLUSH WHERE
INTERSECTING WITH WALLS TO REMAIN. RÉMAINING WALLS TO BE PATCHED AND FINISHED SMC 31. NEW OPENING TO BE CUT IN EXISTING WALLS SHALL BE SAW-CUT AT LOCATIONS INDICATED TO HEIGHT AND WIDTH INDICATED. NEW LINTELS SHALL BE INSTALLED TO SUPPORT EXISTING WAL
CONSTRUCTION ABOVE AS INDICATED ON THE DRAWINGS, OR IF NOT INDICATED, AS REQUIRED NEW WALL CONSTRUCTION PER STRUCTURAL DRAWINGS. COORDINATE LOCATIONS OF ALL NEV OPENINGS IN EXISTING WALLS AND PARTITIONS WITH ARCHITECTURAL PLANS. 32. WHERE EXISTING WALL OPENINGS ARE TO BE NEWLY CLOSED-OFF, REMOVE ANY EXISTING OPE
 FRAME AND PATCH AND REPAIR EXISTING WALL TO MATCH EXISTING ADJACENT MATERIALS AND FINISHES, UNLESS NOTED OTHERWISE. 33. WHERE EXISTING INTERIOR WALLS ARE REPLACED OR REMOVED, REMOVE MEPT SYSTEMS BACK PANEL, OR MECHANICAL ROOM, OR FARTHEST POSSIBLE POINT WITHOUT DISTURBING EXISTING
CONSTRUCTION. REMOVE EXISTING MECHANICAL EQUIPMENT, RELOCATE POWER PER MEPT DRAWINGS 34. REFER TO MEPT DRAWINGS FOR DEMOLITION OF MEPT SYSTEMS. IDENTIFY WORK REQUIRED B
CONTRACTOR WHICH MAY AFFECT DEMOLITION AND OR REPAIRS OF ARCHITECTURAL ELEMENT COORDINATE WITH RELATED SUBCONTRACTORS THE EXTENT OF ALL DEMOLITION WORK. 35. PATCH FLOORS, WALLS CEILINGS WHICH REMAIN AT LOCATIONS WHERE PIPES, CONDUITS, ETC. REMOVED AS REQUIRED TO MATCH EXISTING CONDITIONS OR TO RECEIVE NEW FINISHES.
 36. WHERE EXISTING FINISH FLOOR IS REMOVED, PREPARE FLOOR SURFACE TO RECEIVE NEW FLOORING. 37. ALL DASHED LINES ARE DEMOLITION LINES U.N.O.
DEMO LEGEND
INTERIOR FLOOR FINISH TO BE DEMOLISHED
INTERIOR FLOOR FINISH AND CEILING TO BE DEMOLISHED
AREA TO BE COMPLETLY DEMOLISHED
EXISTING CEILING TO REMAIN
EXISTING WALL TO REMAIN
DEMO EXISTING DOOR. EXISTING FRAME TO REMAIN AND BE REPAINTED. COLOR
L = = 3 TO BE CHOSEN BY ARCHITECT
KEYNOTE LEGEND
NUMBER DESCRIPTION 0136 REMOVE EXISTING FLOOR FINISH, PREP DEMOED AREA FOR NEW FLOORING; COOR.
0138 W/ABATEMENT AS NEEDED 0138 REMOVE EXISTING WALL TILE THROUGHOUT. REMOVE ALL MIRRORS, SOAP DISPENSE PAPER TOWEL DISPENSERS THROUGHOUT RESTROOM, TYP. PREP/REPAIR WALL AS
0175 REMOVE AND REPLACE EXISTING RESTROOM PARTITIONS, EXISTING HANDRAILS, TO PAPER DISPENSERS & SANITARY NAPKIN DISPENSERS . NEW PARTITION COLOR TO B
SELECTED BY ARCHITECT 0176 REMOVE EXISTING PLUMBING FIXTURES THROUGHTOUT RESTROOM, TYP. 0911 SPACKLE WALL AND PREPARE FOR PAINT FINISH THROUGHOUT. RE: INTERIOR ELEVA 27/A-528, TYP.

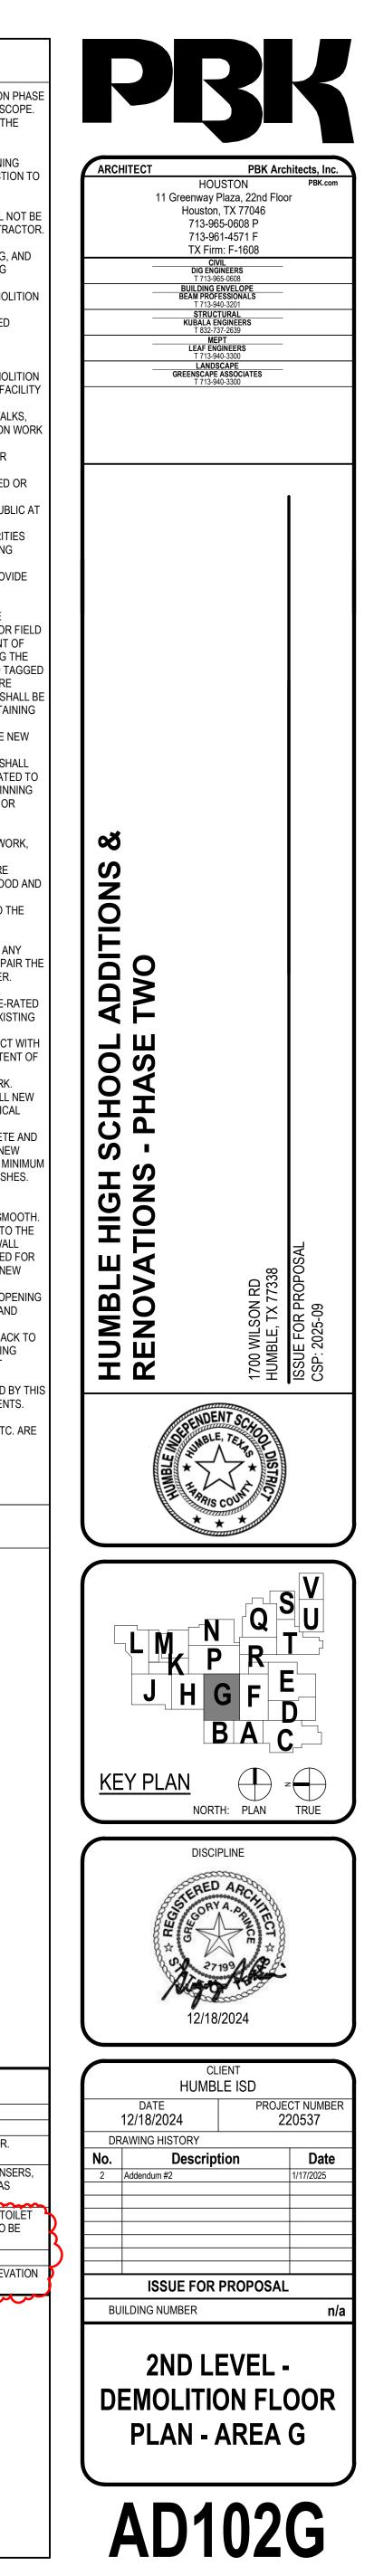


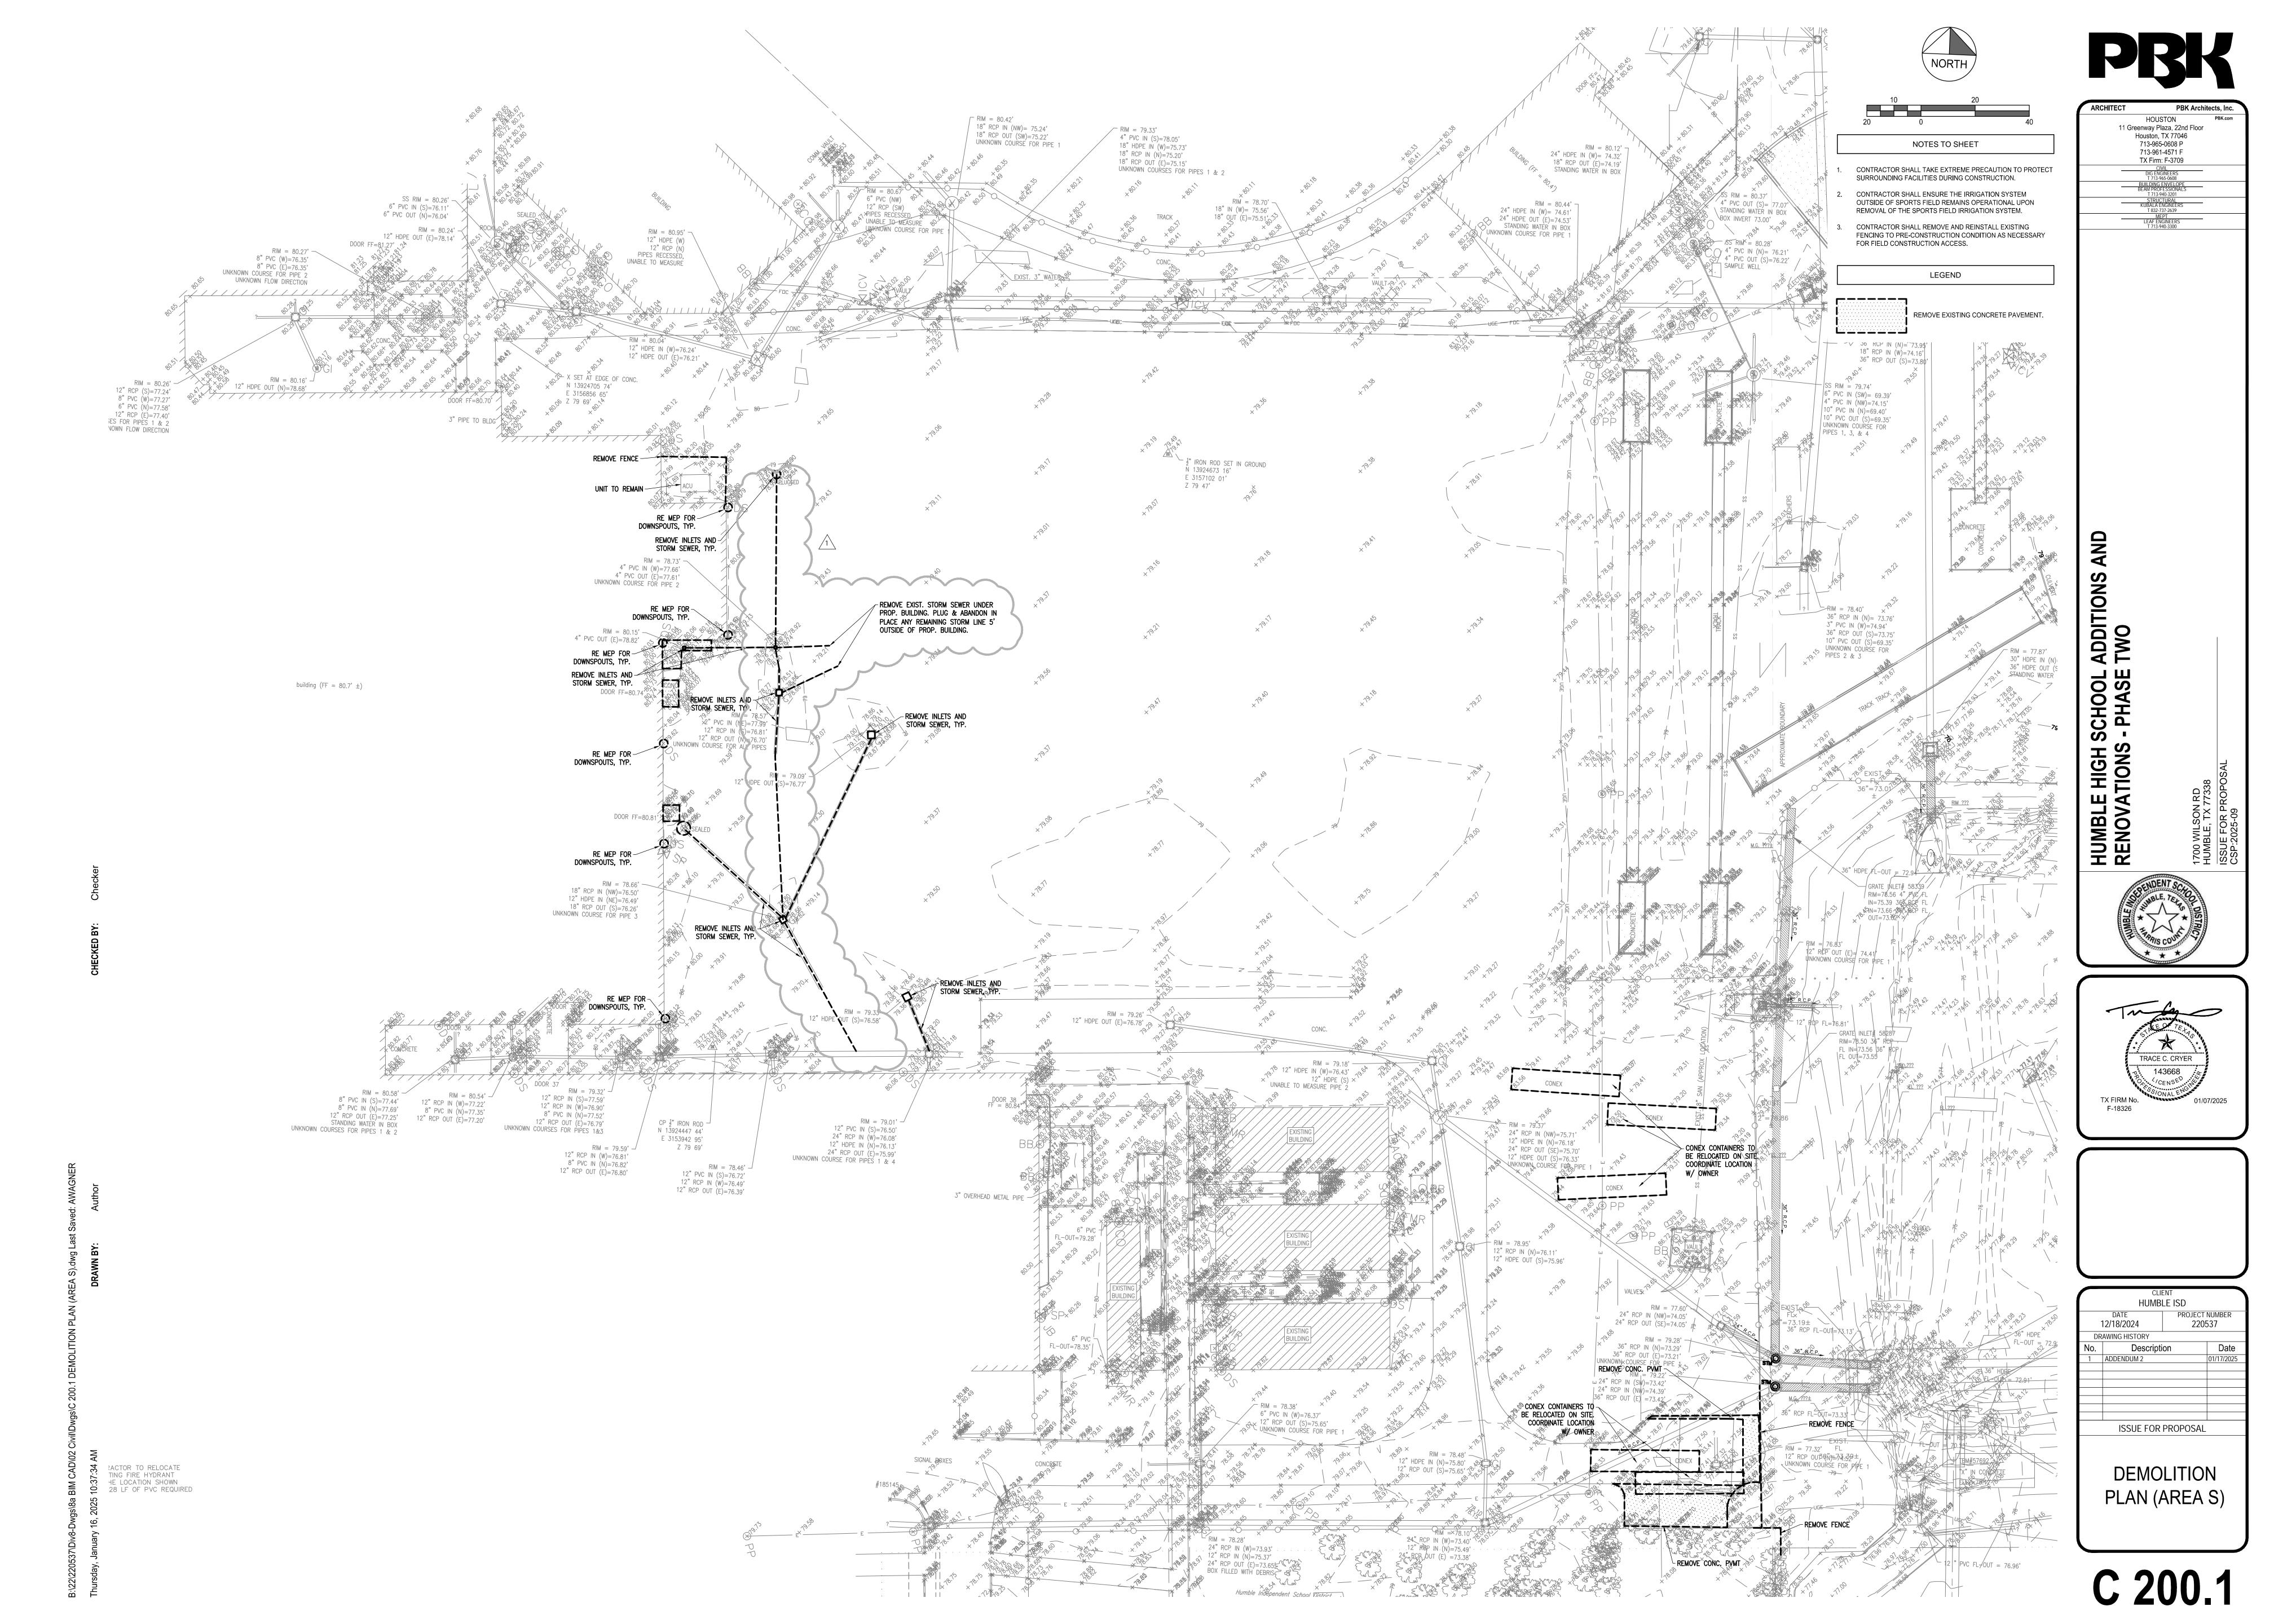


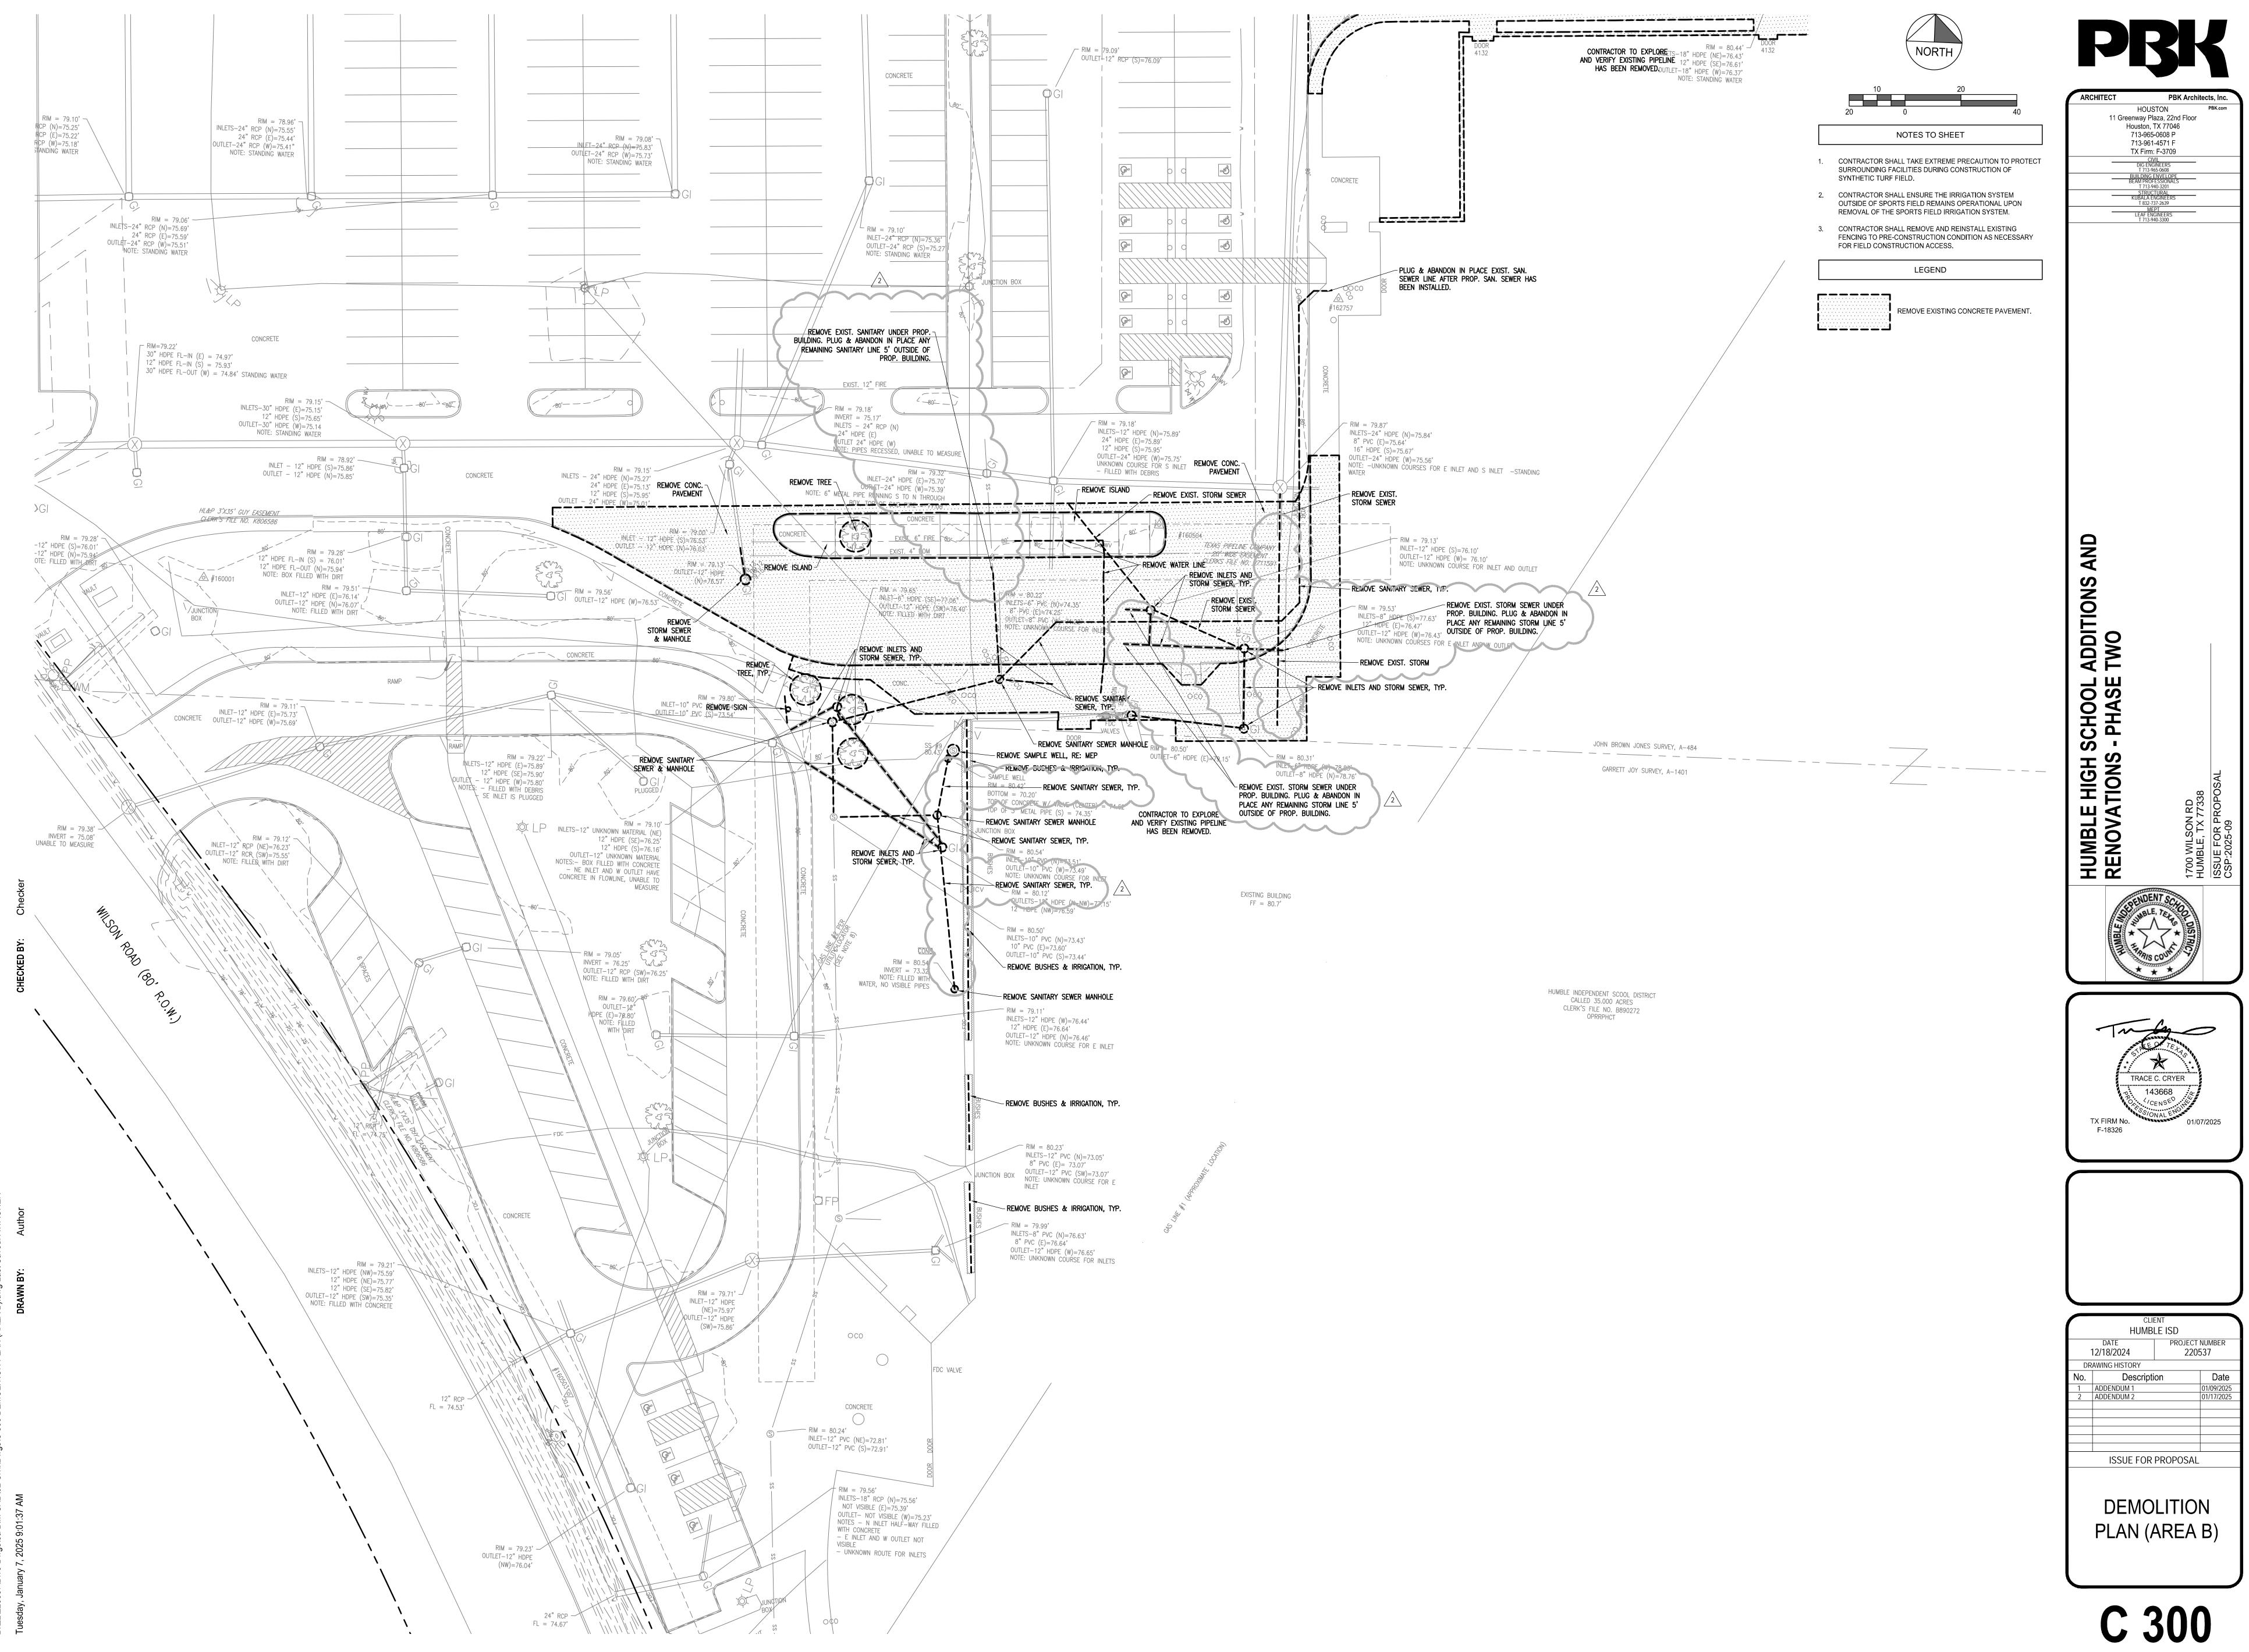


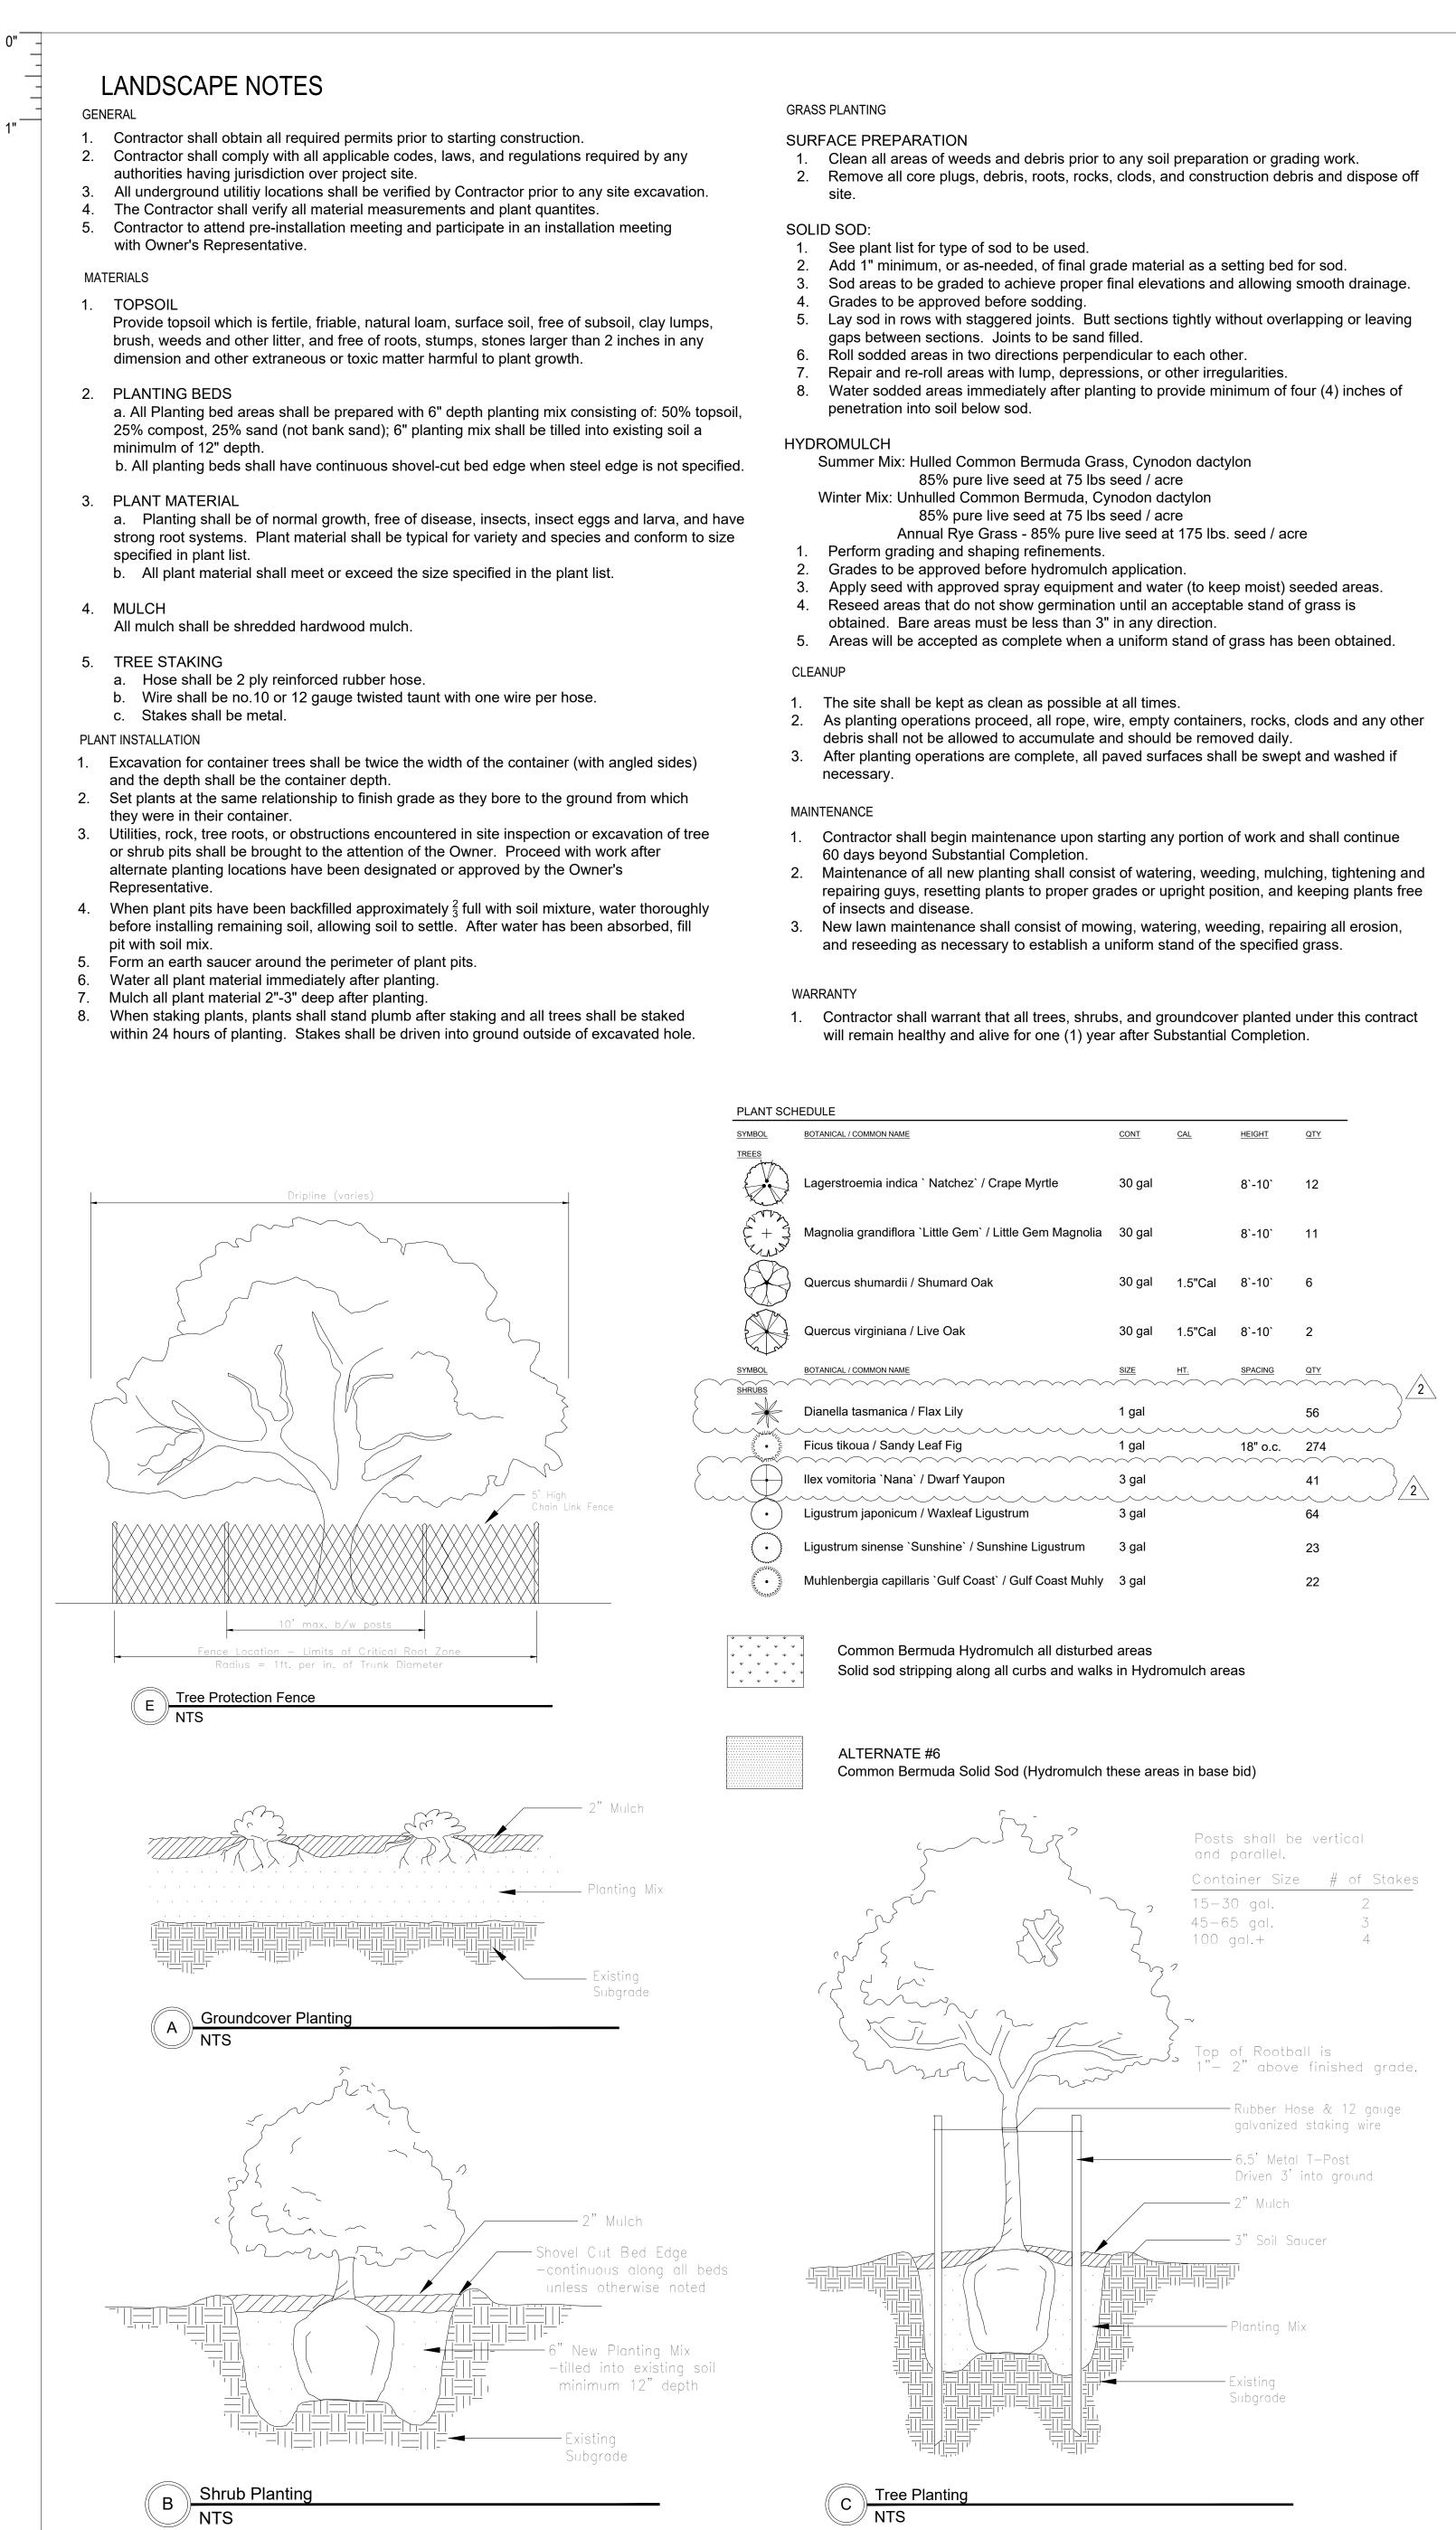


	CONT	CAL	HEIGHT	ΩΤΥ
chez` / Crape Myrtle	30 gal		8`-10`	12
Gem` / Little Gem Magnolia	30 gal		8`-10`	11
ard Oak	30 gal	1.5"Cal	8`-10`	6
Dak	30 gal	1.5"Cal	8`-10`	2
	SIZE	<u>нт.</u>	SPACING	
.ily	1 gal		~ ~ ~ ~	56
Fig	1 gal		18" o.c.	274
arf Yaupon	3 gal			
kleaf Ligustrum	3 gal			64
ne` / Sunshine Ligustrum	3 gal			23
ulf Coast` / Gulf Coast Muhly	3 gal			22

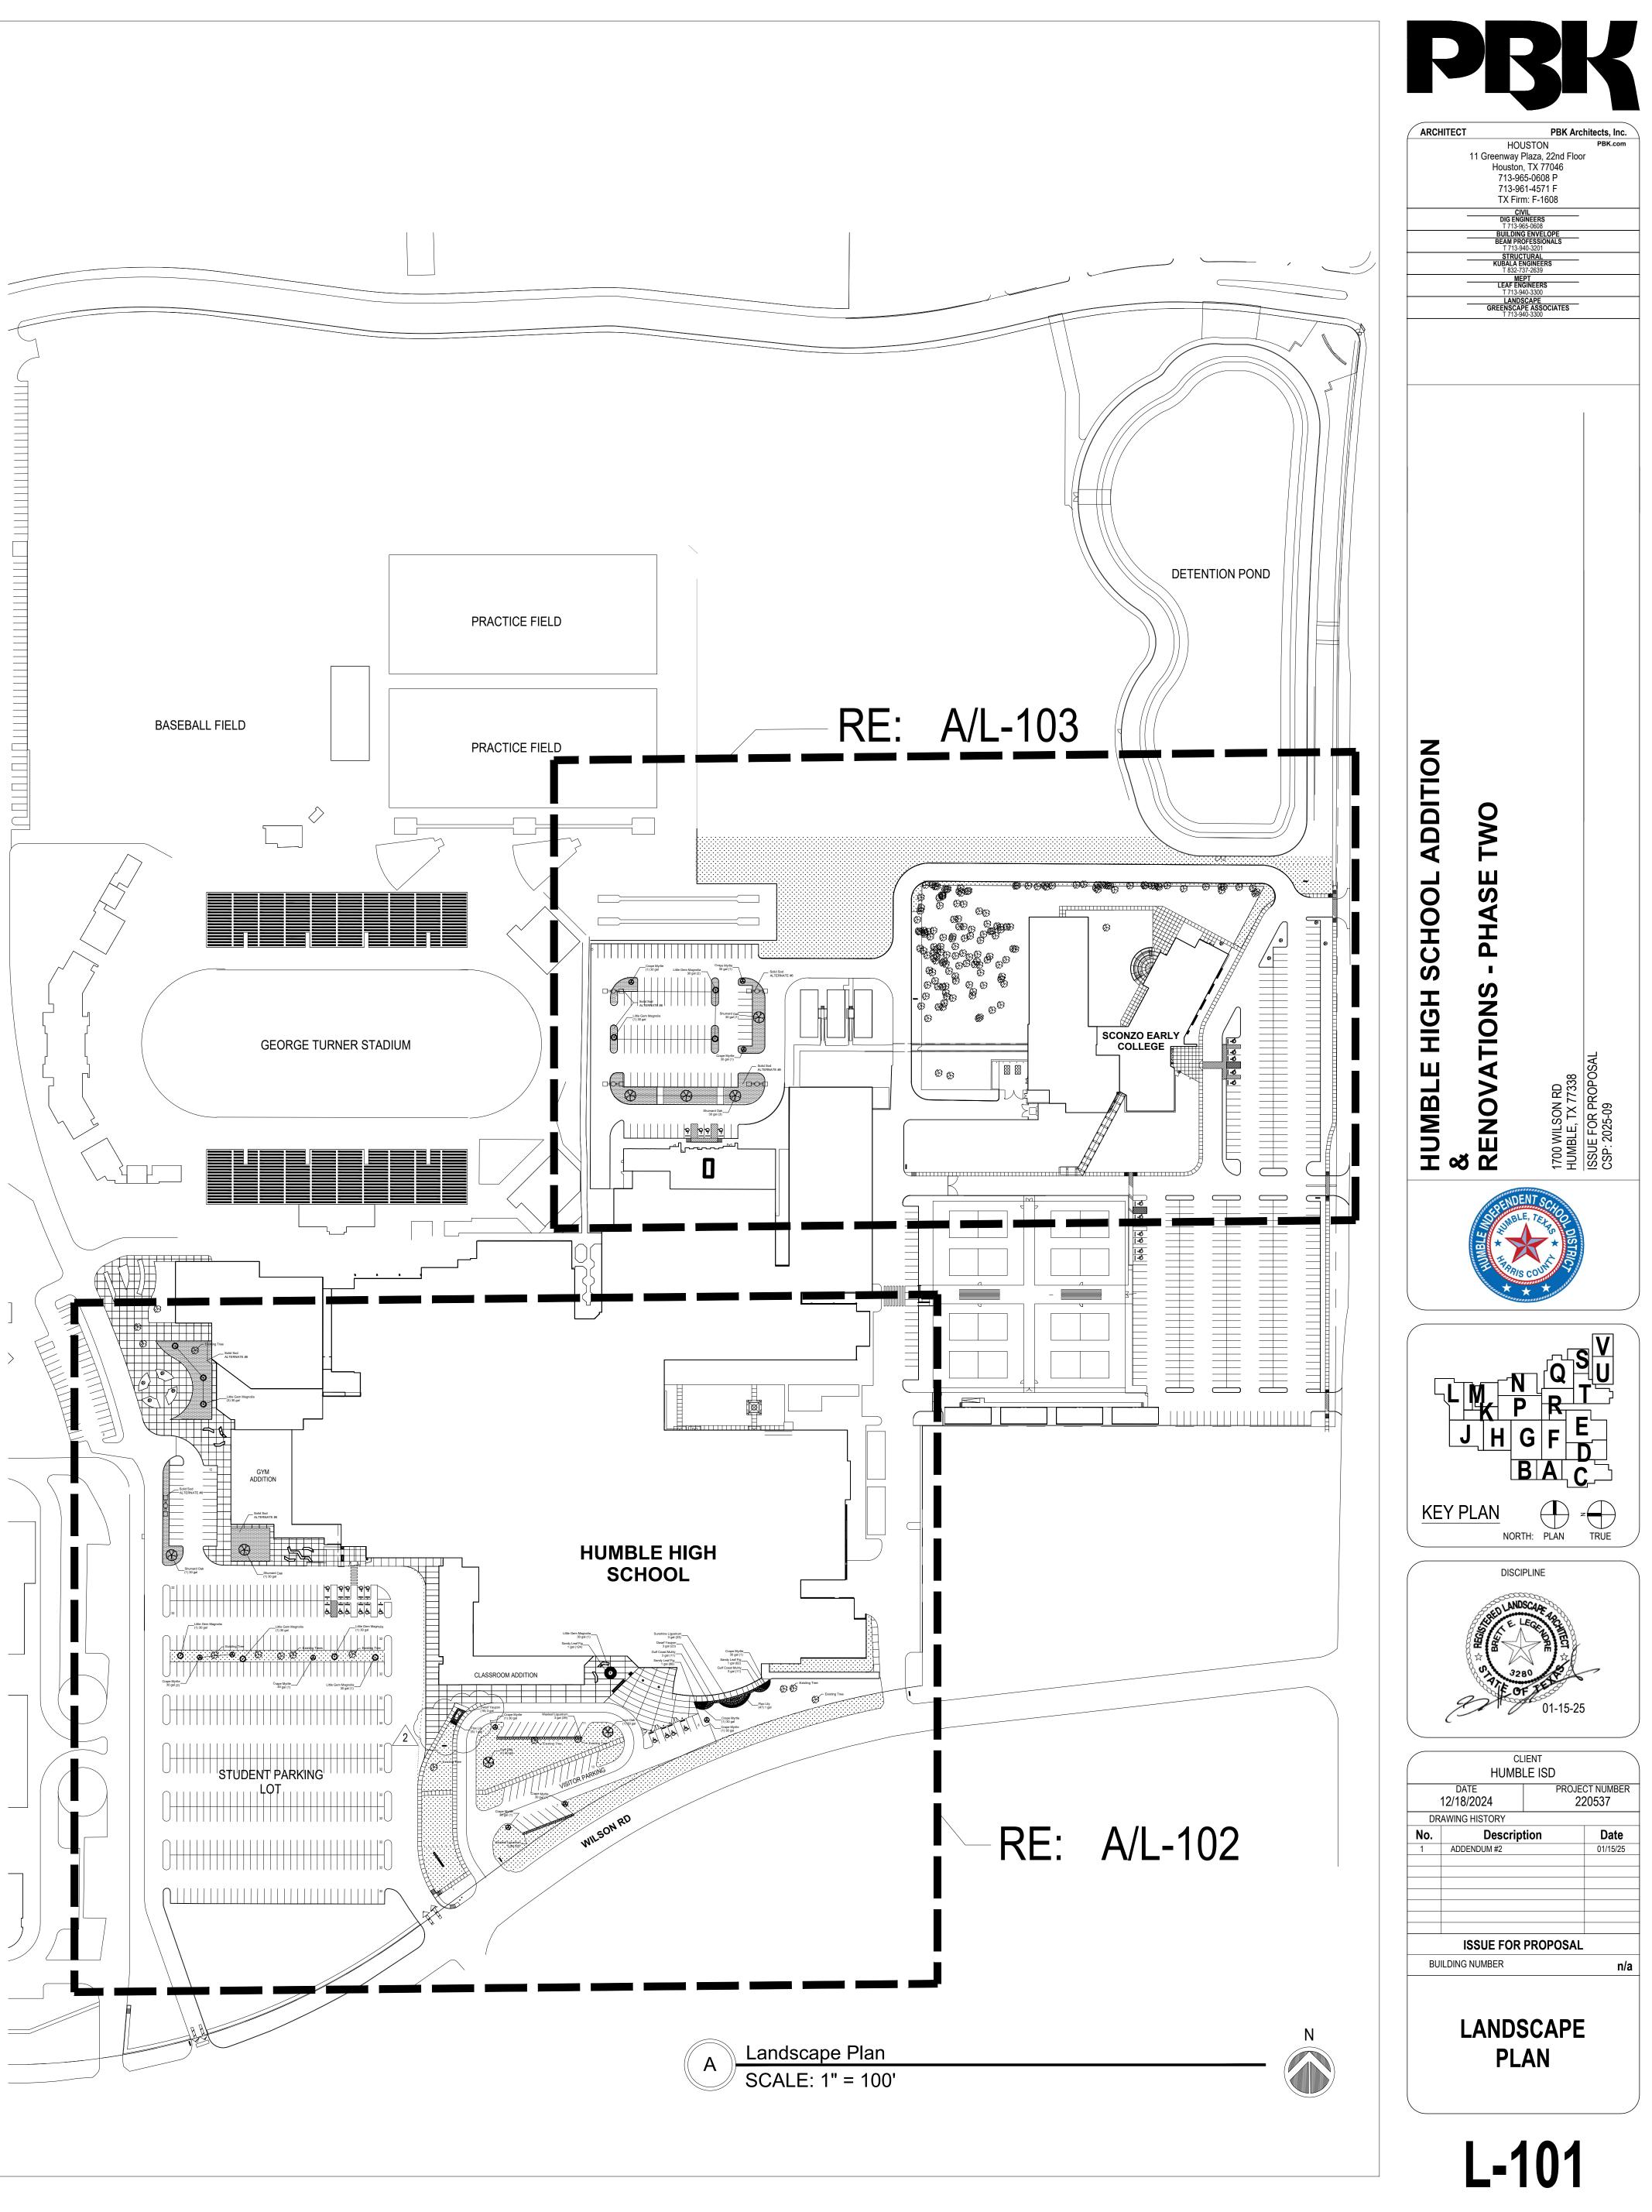

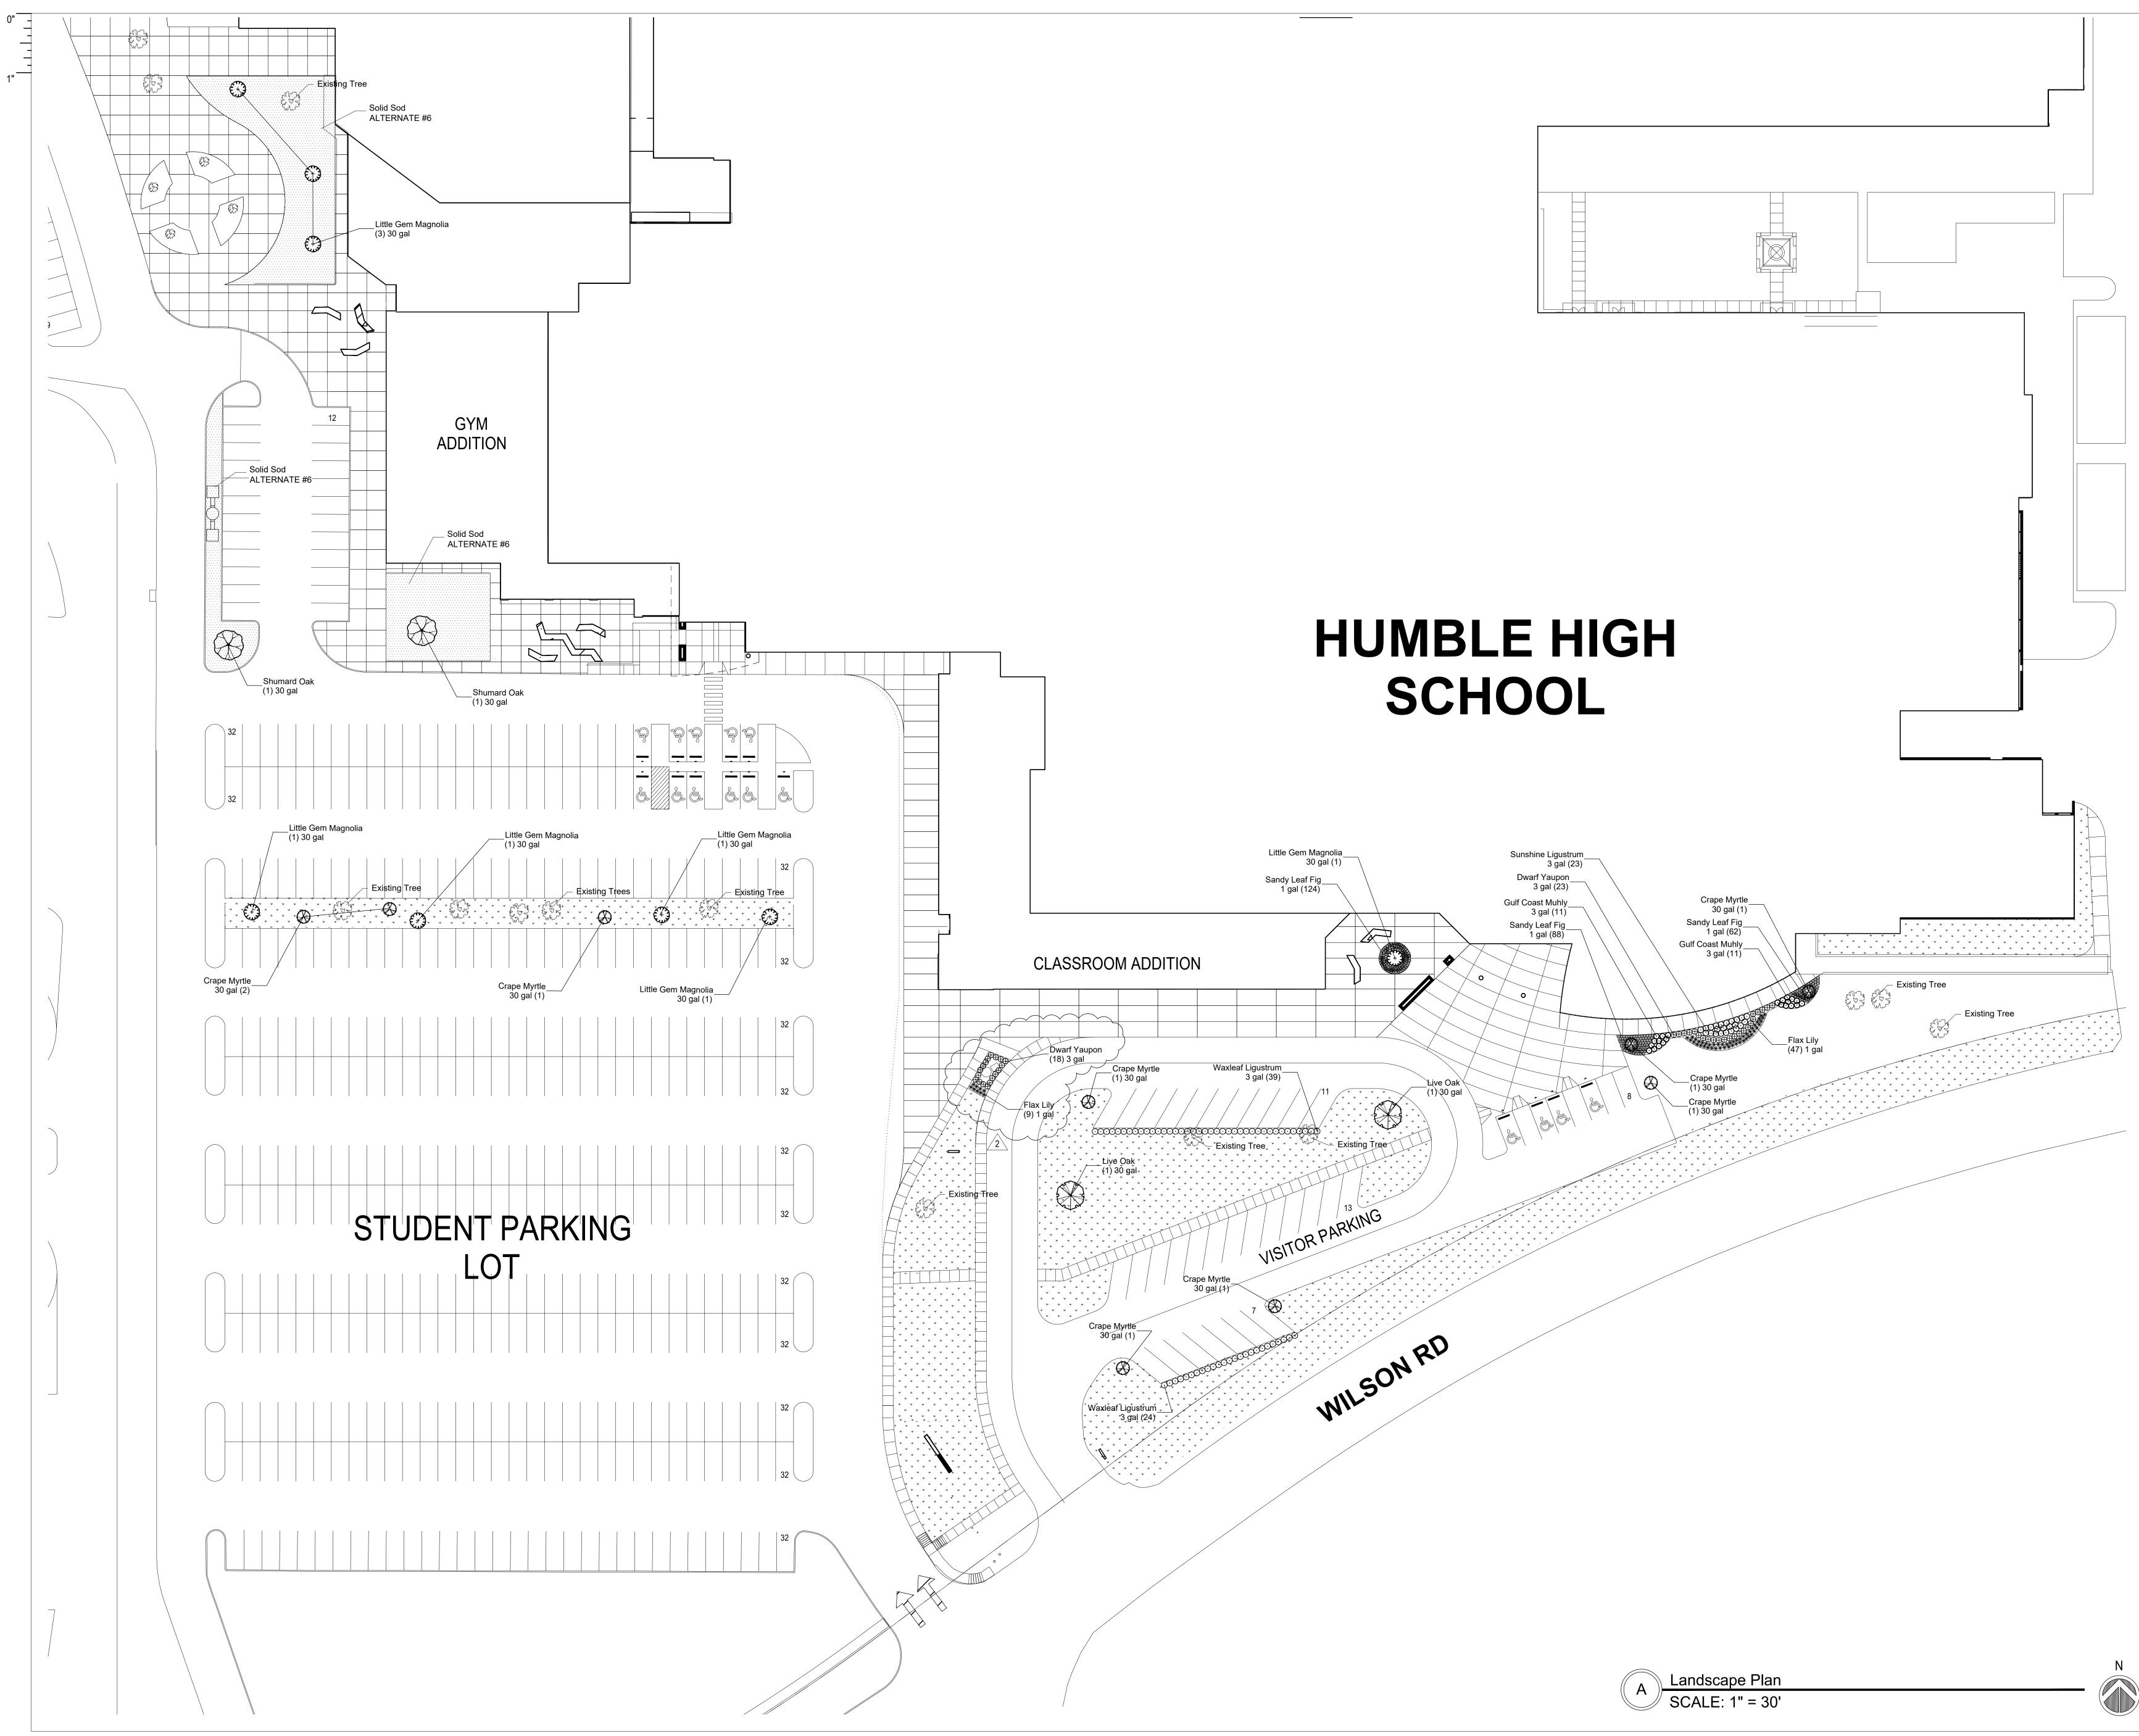

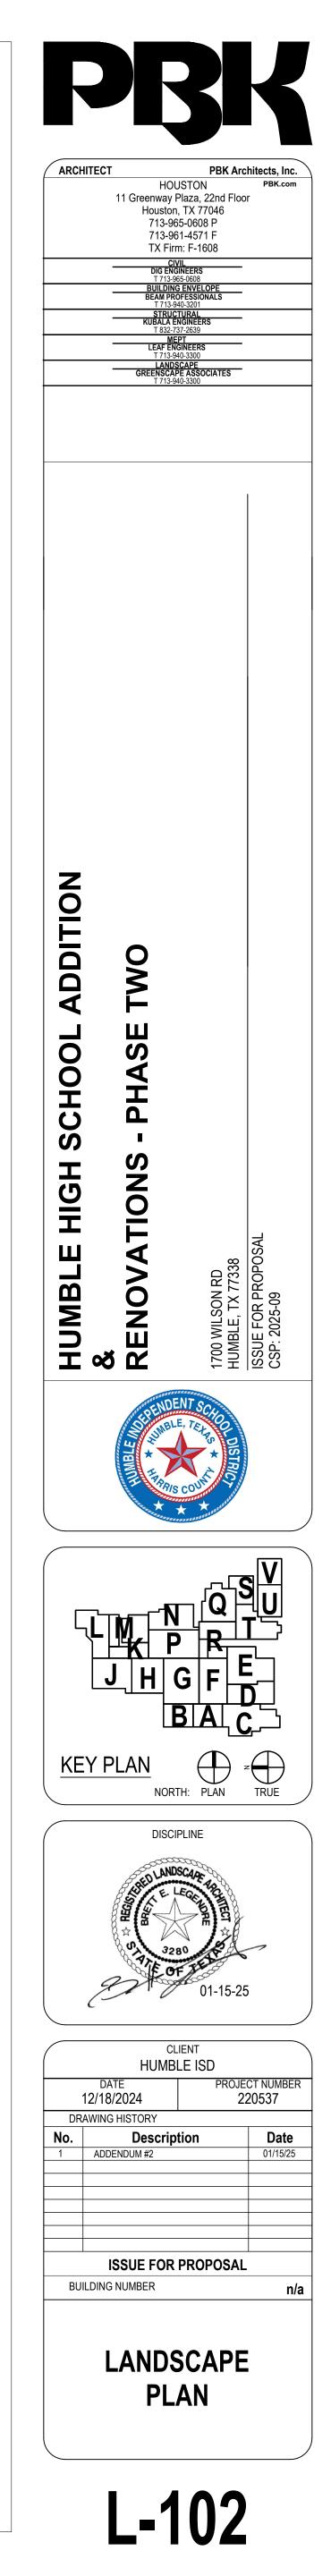

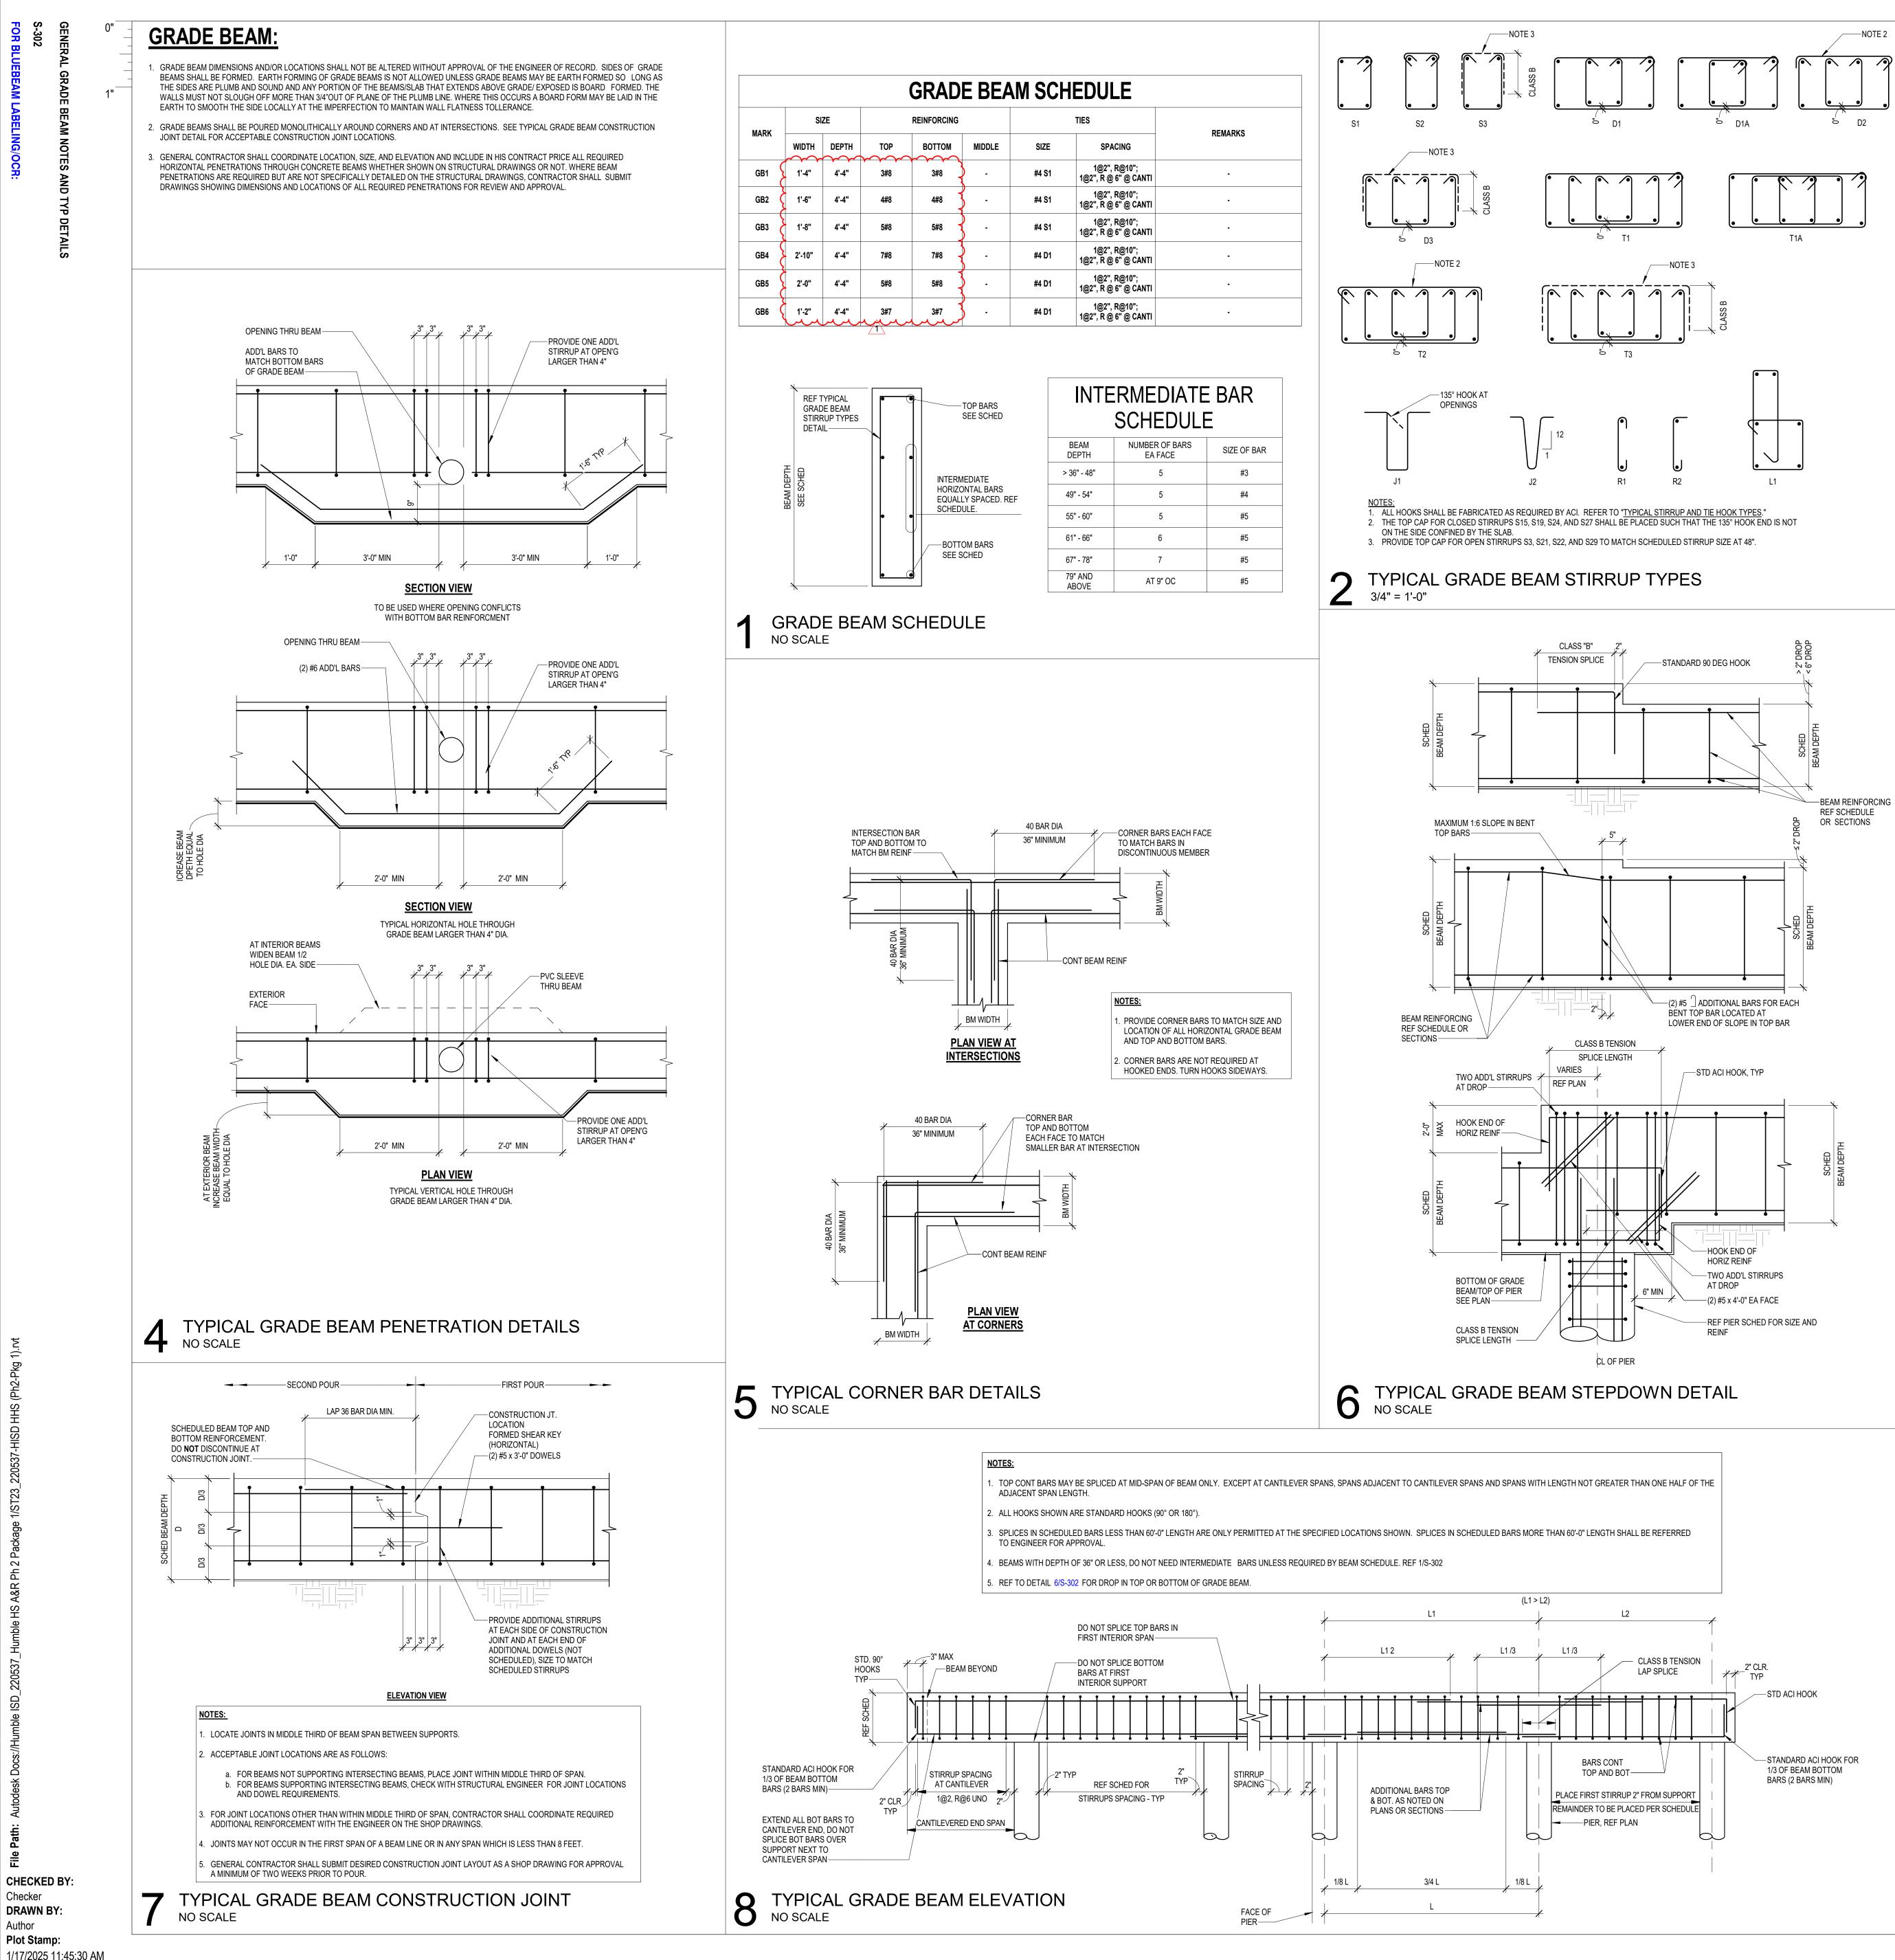

Plot Stamp: 1/17/2025 11:45:30 AM






- a. FOR BEAMS NOT SUPPORTING INTERSECTING BEAMS LOCATE PENETRATIONS WITHIN TWO FEET EITHER SIDE OF BEAM MIDSPAN. b. FOR BEAMS SUPPORTING INTERSECTING BEAMS CHECK WITH STRUCTURAL ENGINEER.

2-#5 TOP AND BOTTOM AT BEAMS WITH 2-LEG STIRRUPS.


SPACING, UNLESS DETAILED OTHERWISE ON THE STRUCTURAL DRAWINGS.

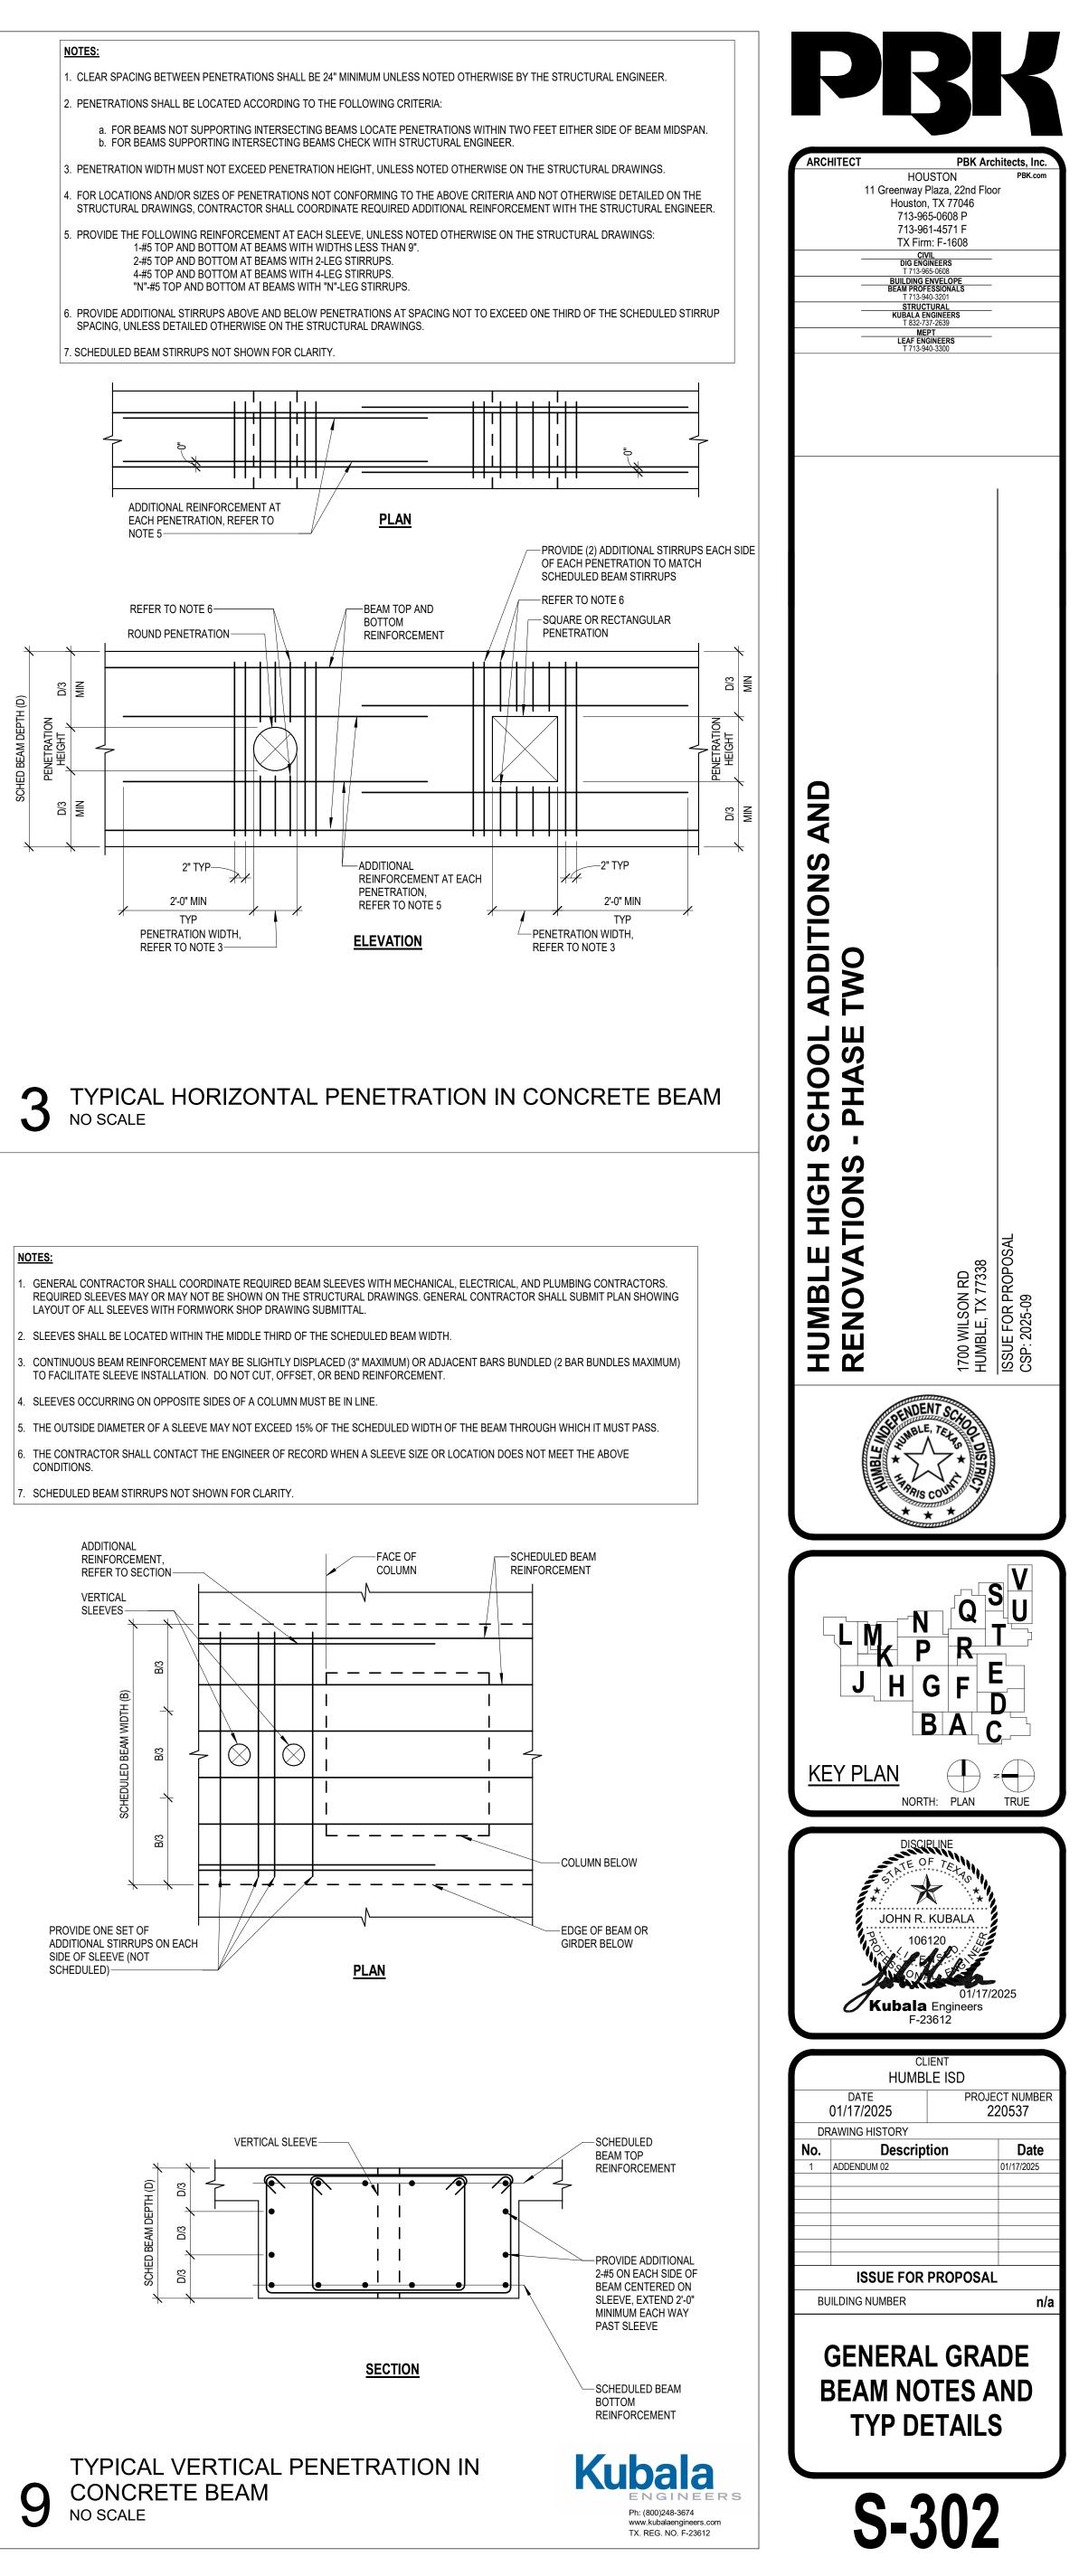



NOTES:

- GENERAL CONTRACTOR SHALL COORDINATE REQUIRED BEAM SLEEVES WITH MECHANICAL, ELECTRICAL, AND PLUMBING CONTRACTORS. REQUIRED SLEEVES MAY OR MAY NOT BE SHOWN ON THE STRUCTURAL DRAWINGS. GENERAL CONTRACTOR SHALL SUBMIT PLAN SHOWING LAYOUT OF ALL SLEEVES WITH FORMWORK SHOP DRAWING SUBMITTAL.
- SLEEVES SHALL BE LOCATED WITHIN THE MIDDLE THIRD OF THE SCHEDULED BEAM WIDTH
- CONTINUOUS BEAM REINFORCEMENT MAY BE SLIGHTLY DISPLACED (3" MAXIMUM) OR ADJACENT BARS BUNDLED (2 BAR BUNDLES MAXIMUM) TO FACILITATE SLEEVE INSTALLATION. DO NOT CUT, OFFSET, OR BEND REINFORCEMENT.
- SLEEVES OCCURRING ON OPPOSITE SIDES OF A COLUMN MUST BE IN LINE.
- THE OUTSIDE DIAMETER OF A SLEEVE MAY NOT EXCEED 15% OF THE SCHEDULED WIDTH OF THE BEAM THROUGH WHICH IT MUST PASS.

- CONDITIONS.

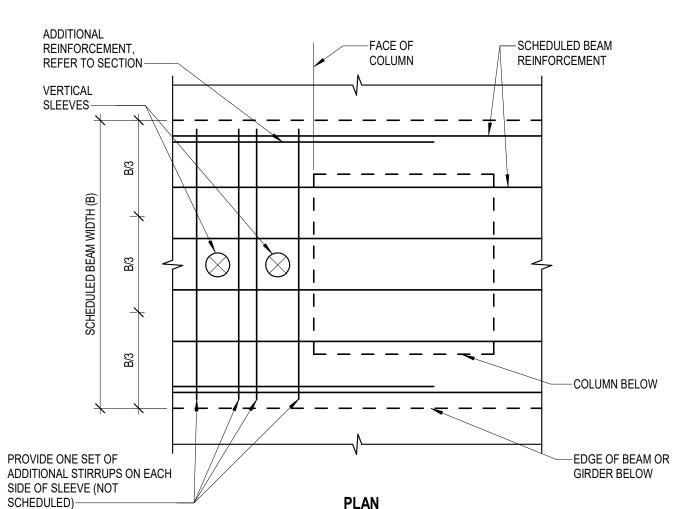


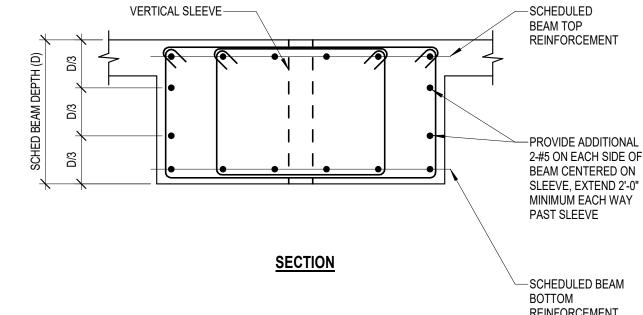

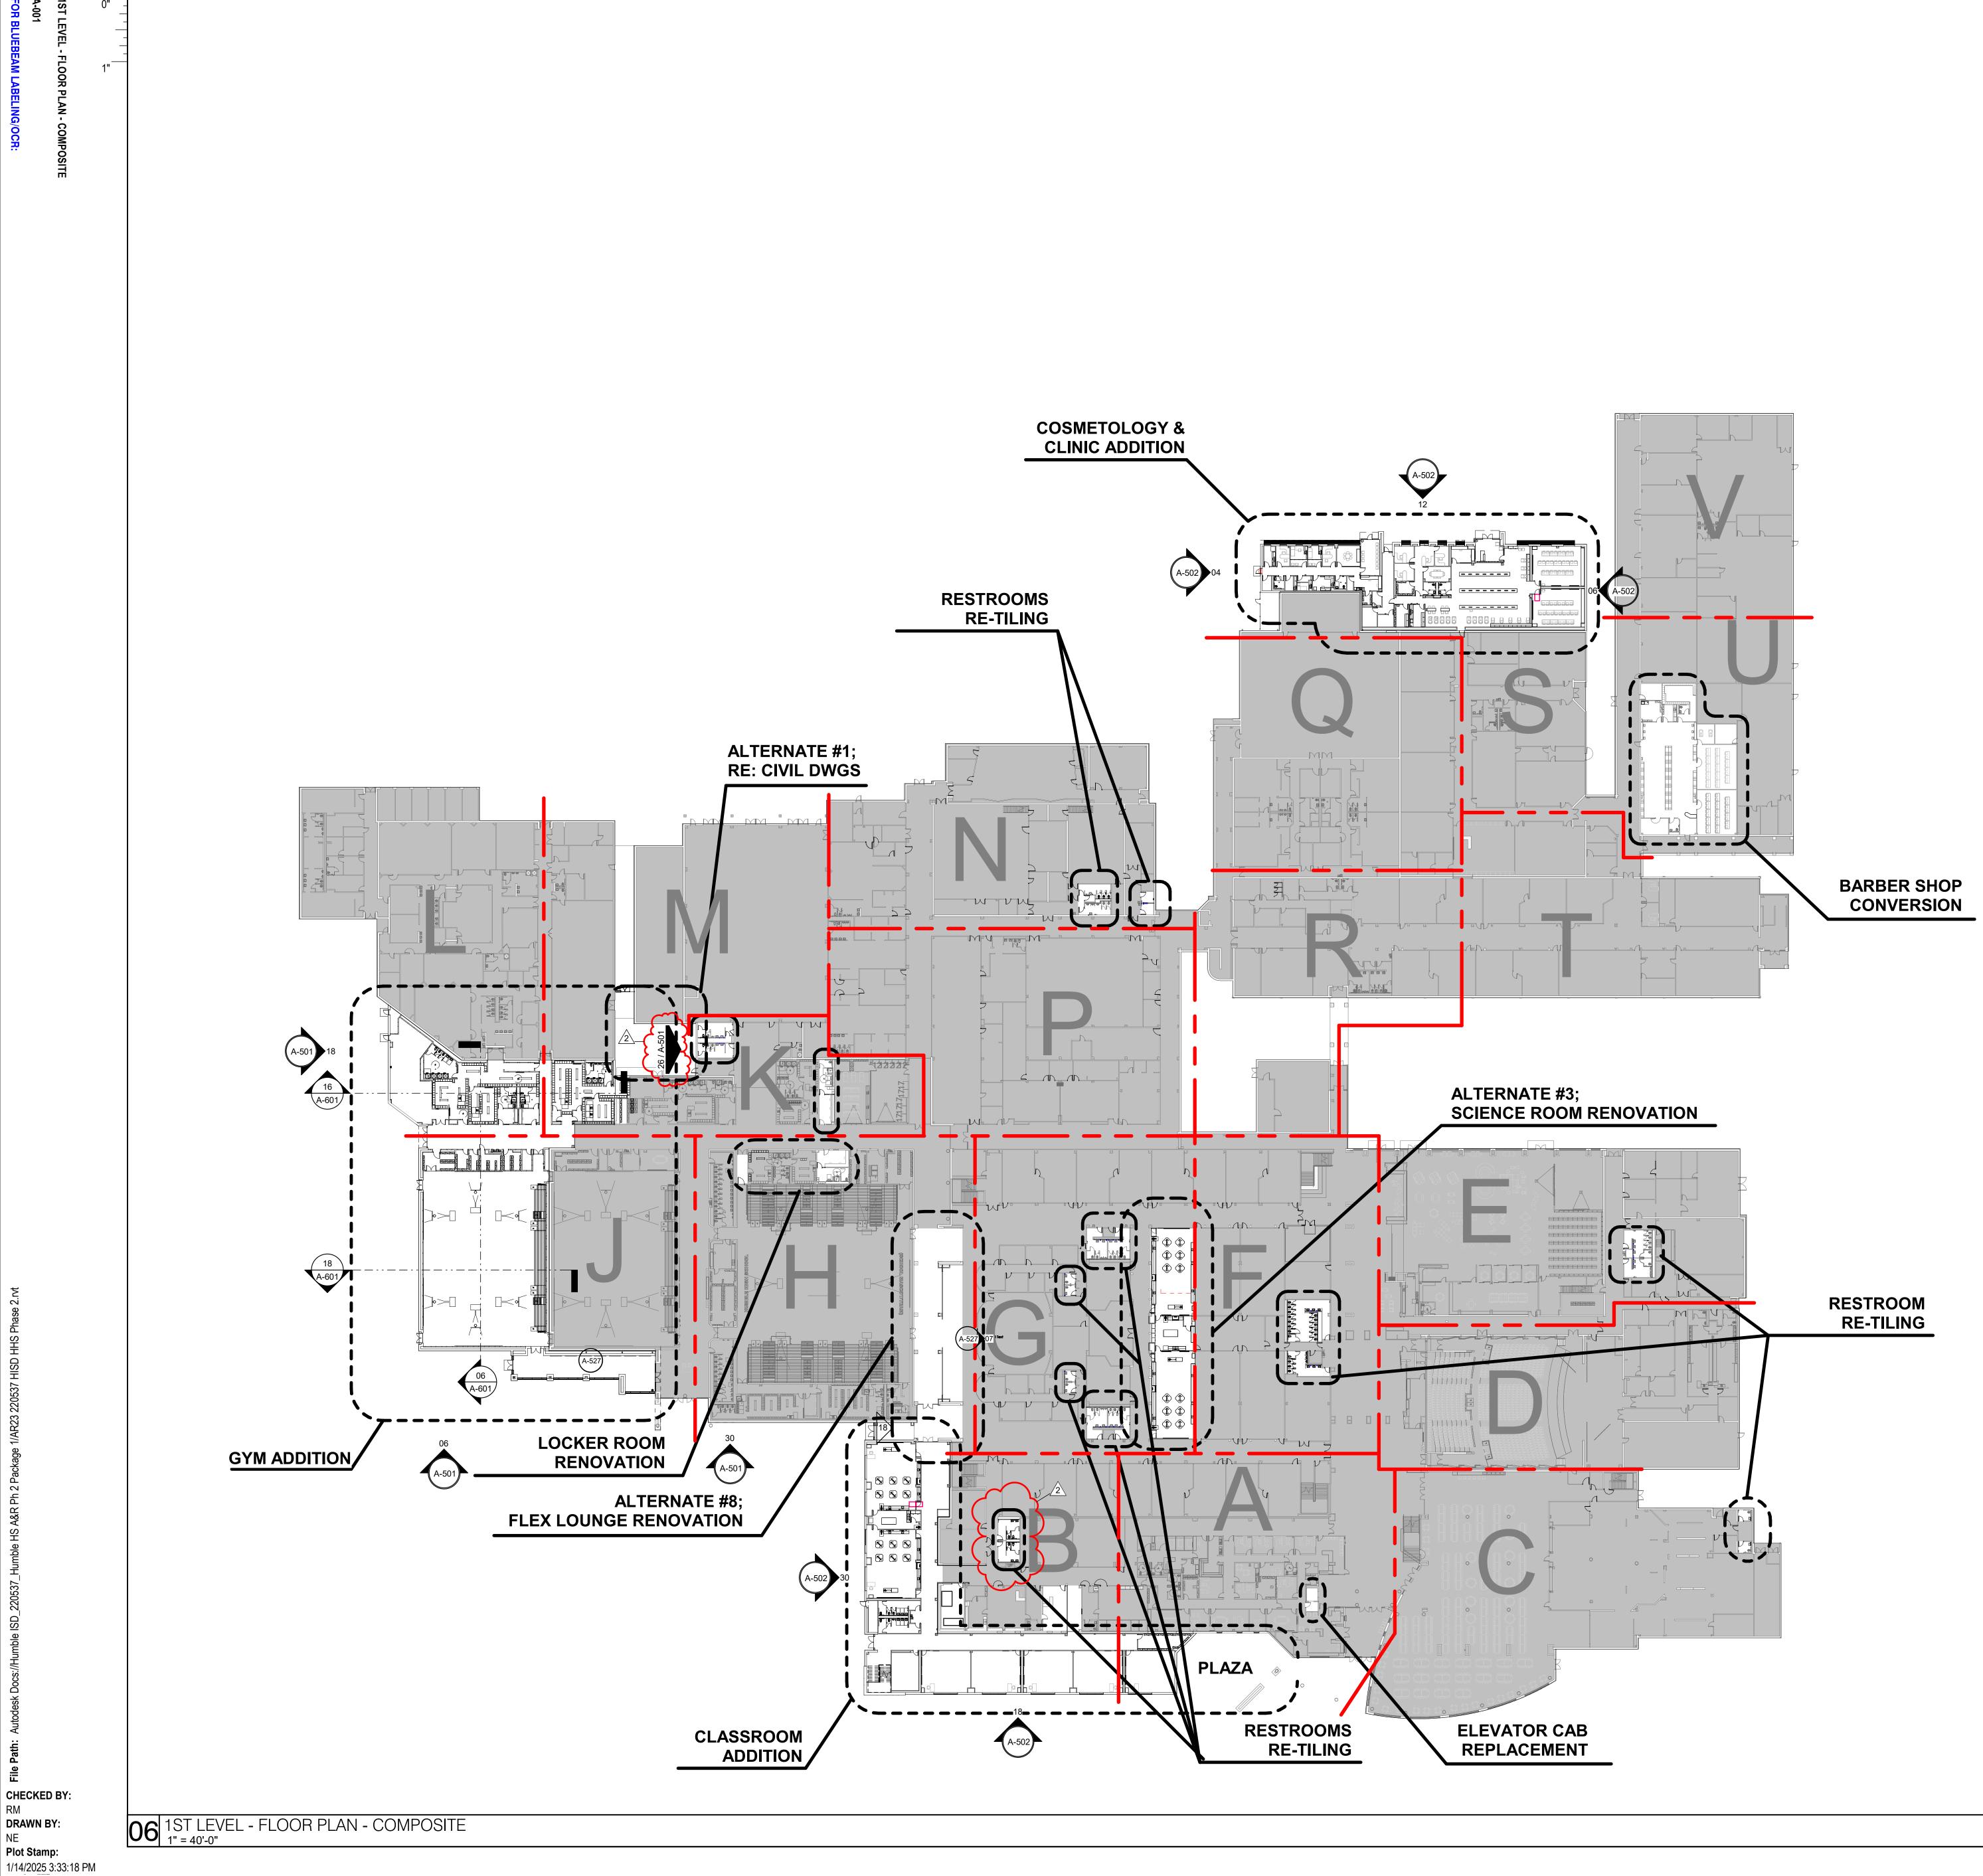

GENERAL ARCH PLAN NOTES

- 1. DO NOT SCALE DRAWINGS, WRITTEN DIMENSIONS TAKE PRECEDENCE, CONTACT ARCH IF CLARIFICATION IS NECESSARY IN ORDER TO DETERMINE THE INTENT OF THE CONTRACT
- DOCUMENTS 2. DRAWINGS NOTED AS "N.T.S" OR "NTS" ARE NOT TO SCALE 3. ALL DIMENSIONS ARE TO STRUCTURAL COLUMN LINES OR THE SURFACE OF PARTITION ASSEMBLY
- U.N.O. 4. FIELD VERIFY ALL DIMENSIONS AND EXISTING CONDITIONS BEFORE COMMENCING WORK. NOTIFY ARCH. OF ANY DISCREPANCIES PRIOR TO PROCEEDING WITH AFFECTED WORK
- 5. NOTES OR DIMENSIONS NOTED AS "TYPICAL" OR "TYP." OR "TYP" SHALL APPLY TO CONDITIONS THAT ARE THE SAME OR SIMILAR
- 6. DIMENSIONS NOTED AS "FIELD VERIFY" OR "V.I.F." OR "VIF" SHALL BE MEASURED AND CONFIRMED AT THE PROJECT SITE BY THE CONTRACTOR AND REVIEWED WITH THE ARCH. BEFORE INCORPORATING
- INTO THE WORK . DIMENSIONS NOTED AS "CLEAR" OR "CLEAR INSIDE" REQUIRE SPECIFIC COORDINATION AMONG
- DISCIPLINES AND OR MANUFACTURERS 8. REFER TO PARTITION TYPES ON A801 SERIES SHEETS 9. ALL INTERIOR PARTITIONS THIS SHEET, EXCEPT FOR FURR-OUT PARTITIONS, SHALL BE PARTITION
- TYPE S3 U.N.O. 10. ALL INTERIOR FURR-OUT PARTITIONS THIS SHEET SHALL BE PARTITION TYPE S5 U.N.O. 11. ALIGN FINISHED FACE OF WALLS WHERE WALL PARTITIONS OF DIFFERING THICKNESS ABUT AND OR ADJOIN IN THE SAME PLANE
- 12. PROVIDE AND INSTALL CONT. REVEAL TRIM AT JOINT WHERE GYPSUM BOARD WALL PARTITIONS ABUT AND OR ADJOIN MASONRY WALL PARTITIONS IN THE SAME PLANE
- 13. ALL INTERIOR CMU OUTSIDE CORNERS SHALL HAVE BULLNOSE U.N.O. 14. ALL DOORS SHALL BE SET 6 INCHES OFF THE ADJACENT PERPENDICULAR WALL ON THE HINGE SIDE
- OF THE DOOR U.N.O., NOTIFY ARCH. OF ANY DOOR-RELATED CONFLICTS, INCLUDING BUT NOT LIMITED TO CONFLICTS CONCERNING ACCESSIBILITY STANDARDS 15. ALL DOOR THRESHOLDS AT ALL EXTERIOR DOORS SHALL BE SET IN FULL BED OF SEALANT 16. COORD. ALL ROOF DRAIN LEADER LOCATIONS WITH FLOOR PLAN PRIOR TO FLOOR SLAB
- CONSTRUCTION 17. ALL FLOOR SLOPES TO FLOOR DRAINS SHALL NOT EXCEED 1:48 18. PROVIDE AND INSTALL SELF-LEVELING UNDERLAYMENT WHERE UNEVEN FLOOR SLAB EXISTS PRIOR TO INSTALLATION OF FLOOR FINISHES 19. COORD. HOUSEKEEPING PAD LOCATIONS AND DIMENSIONS WITH EQUIPMENT TO BE INSTALLED
- 20. ALL FLOOR FINISH CHANGES SHALL OCCUR AT THE CENTERLINE OF DOORS U.N.O. 21. ALL FLOOR FINISH MATERIAL CHANGES SHALL HAVE REDUCER STRIPS 22. ALL REQUIRED ACCESSIBLE CLEARANCES FOR ALL ITEMS. INCLUDING BUT NOT LIMITED TO ALL
- COUNTER TOPS, ALL PLUMBING FIXTURES, ALL DRINKING FOUNTAINS, ALL ELECTRIC WATER COOLERS, ALL LAVATORIES, ALL URINALS, ALL TOILETS SHALL BE STRICTLY ENFORCED
- 23. APPLY BITUMINOUS COATING TO ALL CONCEALED STRUCTURAL STEEL MEMBERS AT ALL EXTERIOR CANOPY LOCATIONS 24. REFER TO OTHER DISCIPLINE DOCUMENTS FOR ADDITIONAL SCOPE OF WORK
- 25. PROVIDE PLYWOOD IN METAL STUD WALL PARTITION FOR SUPPORT OF ALL TV LOCATIONS.

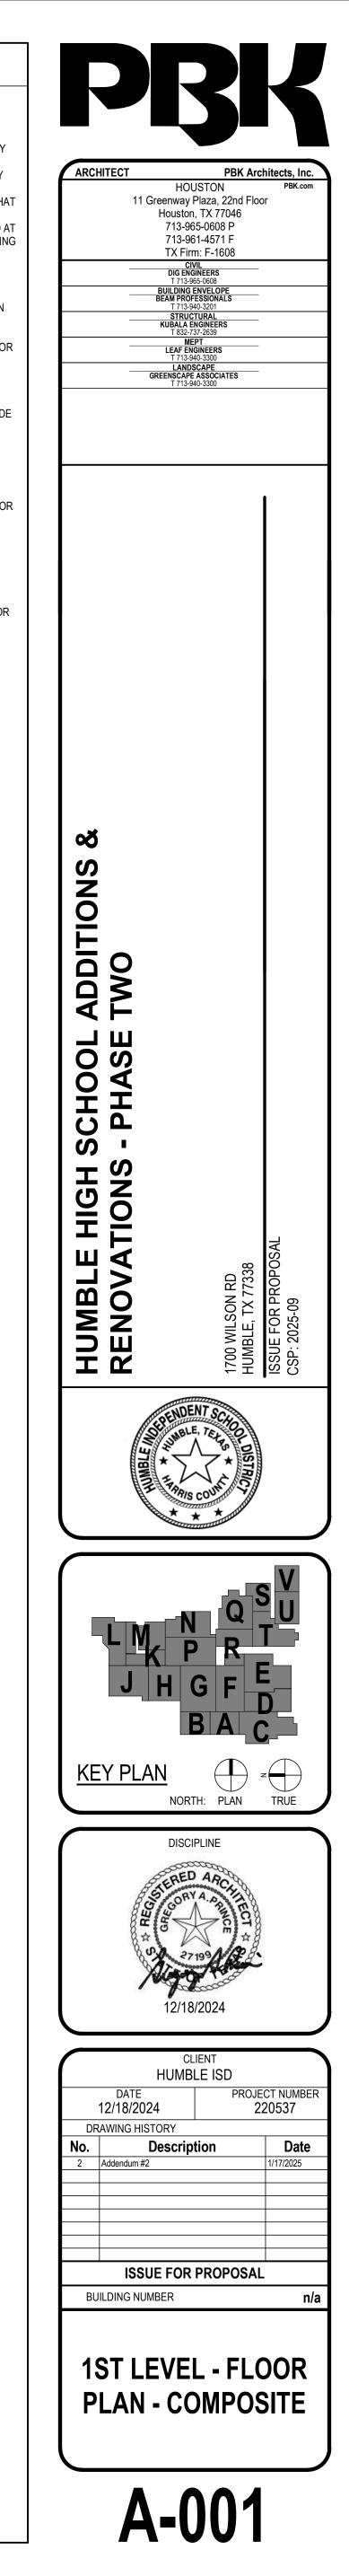



1ST LEVEL A-101B FOR BLUE I LABELING/OCR:

DATA PANEL	DOOR SCHEDULE AREA B	FRAME	STOREFRONT SCHEDULE AREA B	GENERAL ARCH PLAN NOTES
MARK NAME WIDTH HEIGHT ELEVATION THK 1043 MECH 3'-0" 6'-10" F 13/4" 1115A SCIENCE CLASSROOM 01 3'-0" 6'-10" NV-1 13/4"	" SCPL PLAM 001 HM PAINTED B-21/A-832 07/A-832 02/A-832 22.0	MARK WIDTH HEIGHT ELEVATION 1115A 15'-0" 7'-0" TYPE 1 1115B 15'-0" 7'-0" TYPE 1	ION MATERIAL FINISH SILL HEAD JAMB REMARKS 12 AL CLR. ANOD. 06/A-831 12/A-831 03/A-831 PROVIDE 14 MIL SECURITY FILM ON EXTERIOR AND INTERIOR. P SPECIFIED 12 AL CLR. ANOD. 06/A-831 12/A-831 03/A-831 PROVIDE 14 MIL SECURITY FILM ON EXTERIOR AND INTERIOR. P 12 AL CLR. ANOD. 06/A-831 12/A-831 03/A-831 PROVIDE 14 MIL SECURITY FILM ON EXTERIOR AND INTERIOR. P	1. DO NOT SCALE DRAWINGS, WRITTEN DIMENSIONS TAKE PRECEDENCE, CONTACT ARCH IF CLARIFICATION IS NECESSARY IN ORDER TO DETERMINE THE INTENT OF THE CONTRACT DOCUMENTS 2. DRAWINGS NOTED AS "N.T.S" OR "NTS" ARE NOT TO SCALE
1115B SCIENCE CLASSROOM 01 3'-0" 6'-10" NV-1 1 3/4" 1116A PREP 3'-0" 6'-10" F 1 3/4" 1116B PREP 3'-0" 6'-10" F 1 3/4"	SCPL PLAM HM PAINTED H-21/A-832 07/A-832 02/A-832 26.0 "SCPL PLAM 001 HM PAINTED - 07/A-832 02/A-832 36.0 "SCPL PLAM 001 HM PAINTED - 07/A-832 02/A-832 36.0	1117A 15'-0" 7'-0" TYPE 1 1117B 15'-0" 7'-0" TYPE 1	SPECIFIED	U.N.O. ROVIDE BLINDS AS ROVIDE BLINDS AS COVIDE BLINDS AS COVI
1116C CHEMICAL STORAGE 3'-0" 6'-10" F 1 3/4" 1117A SCIENCE CLASSROOM 02 3'-0" 6'-10" NV-1 1 3/4" 1117B SCIENCE CLASSROOM 02 3'-0" 6'-10" NV-1 1 3/4" 1117B SCIENCE CLASSROOM 02 3'-0" 6'-10" NV-1 1 3/4" 1118 GIRLS 3'-0" 6'-10" F 1 3/4"	SCPL PLAM HM PAINTED H-21/A-832 07/A-832 02/A-832 26.0 "SCPL PLAM HM PAINTED H-21/A-832 07/A-832 02/A-832 26.0	1121 15'-0" 7'-0" TYPE 1 1122 15'-0" 7'-0" TYPE 1	Image: Specified bit is a specifie	ARE THE SAME OR SIMILAR ROVIDE BLINDS AS 6. DIMENSIONS NOTED AS "FIELD VERIFY" OR "V.I.F." OR "VIF" SHALL BE MEASURED AND CONFIRMED THE PROJECT SITE BY THE CONTRACTOR AND REVIEWED WITH THE ARCH. BEFORE INCORPORAT INTO THE WORK
1119 BOYS 3'-0" 6'-10" F 1 3/4" 1120 STORAGE 3'-0" 6'-10" F 1 3/4" 1121 CLASSROOM 01 3'-0" 6'-10" NV-1 1 3/4"	"SCPL PLAM 001 HM PAINTED G-21/A-832 07/A-832 02/A-832 38.0 "SCPL PLAM 001 HM PAINTED H-21/A-832 07/A-832 02/A-832 19.0 "SCPL PLAM HM PAINTED F-21/A-832 07/A-832 02/A-832 19.0	1123 15'-0" 7'-0" TYPE 1	Image: Provide the system Image: Providet the system Image: Providet the system <th< td=""><td> Diministroions noted as celear inside regulated include a contained anotal and anotal disciplines and or manufacturers ROVIDE BLINDS AS 8. REFER TO PARTITION TYPES ON A801 SERIES SHEETS 9. ALL INTERIOR PARTITIONS THIS SHEET, EXCEPT FOR FURR-OUT PARTITIONS, SHALL BE PARTITIO </td></th<>	 Diministroions noted as celear inside regulated include a contained anotal and anotal disciplines and or manufacturers ROVIDE BLINDS AS 8. REFER TO PARTITION TYPES ON A801 SERIES SHEETS 9. ALL INTERIOR PARTITIONS THIS SHEET, EXCEPT FOR FURR-OUT PARTITIONS, SHALL BE PARTITIO
1122 CLASSROOM 02 3'-0" 6'-10" NV-1 1 3/4" 1123 CLASSROOM 03 3'-0" 6'-10" NV-1 1 3/4" 1124 CLASSROOM 04 3'-0" 6'-10" NV-1 1 3/4" 1125 CLASSROOM 05 3'-0" 6'-10" NV-1 1 3/4"	SCPL PLAM HM PAINTED F-21/A-832 07/A-832 02/A-832 29.0 "SCPL PLAM HM PAINTED F-21/A-832 07/A-832 02/A-832 29.0	1124 15'-0" 7'-0" TYPE 1 1125A 15'-0" 7'-0" TYPE 1	SPECIFIED	10. ALL INTERIOR FURR-OUT PARTITIONS THIS SHEET SHALL BE PARTITION TYPE S5 U.N.O. 11. ALIGN FINISHED FACE OF WALLS WHERE WALL PARTITIONS OF DIFFERING THICKNESS ABUT AND
1127 CORRIDOR 7'-0" 6'-10" G-2 1 3/4" 1128 FDC 3'-0" 6'-10" F 1 3/4"	" SCPL CLR ANO. AL CLR ANO. 02/A-831 08/A-831 14/A-831 2.0 CARD READER " HM PAINTED 001 HM PAINTED 01/A-831 07/A-831 13/A-831 29.0 " SCPL PLAM 001 HM PAINTED G-21/A-832 07/A-832 02/A-832 17.0		13 AL CLR. ANOD. 17/A-831 12/A-831 SIM 03/A-831 SIM PROVIDE 14 MIL SECURITY FILM ON EXTERIOR AND INTERIOR	ABUT AND OR ADJOIN MASONRY WALL PARTITIONS IN THE SAME PLANE 13. ALL INTERIOR CMU OUTSIDE CORNERS SHALL HAVE BULLNOSE U.N.O. 14. ALL DOORS SHALL BE SET 6 INCHES OFF THE ADJACENT PERPENDICULAR WALL ON THE HINGE SI
1129 CORRIDOR 3'-0" 6'-10" F 1 3/4" 1164 LIFE SKILLS 3'-0" 6'-10" F 1 3/4" A1015 CORRIDOR 6'-0" 6'-10" F 1 3/4"				OF THE DOOR U.N.O., NOTIFY ARCH. OF ANY DOOR-RELATED CONFLICTS, INCLUDING BUT NOT LIMITED TO CONFLICTS CONCERNING ACCESSIBILITY STANDARDS 15. ALL DOOR THRESHOLDS AT ALL EXTERIOR DOORS SHALL BE SET IN FULL BED OF SEALANT 16. COORD. ALL ROOF DRAIN LEADER LOCATIONS WITH FLOOR PLAN PRIOR TO FLOOR SLAB CONSTRUCTION
				 17. ALL FLOOR SLOPES TO FLOOR DRAINS SHALL NOT EXCEED 1:48 18. PROVIDE AND INSTALL SELF-LEVELING UNDERLAYMENT WHERE UNEVEN FLOOR SLAB EXISTS PF TO INSTALLATION OF FLOOR FINISHES 19. COORD. HOUSEKEEPING PAD LOCATIONS AND DIMENSIONS WITH EQUIPMENT TO BE INSTALLED
<u>5/A-702</u> B-1 B-2 B-4	B-5 B-7 B-9 B-10			 20. ALL FLOOR FINISH CHANGES SHALL OCCUR AT THE CENTERLINE OF DOORS U.N.O. 21. ALL FLOOR FINISH MATERIAL CHANGES SHALL HAVE REDUCER STRIPS 22. ALL REQUIRED ACCESSIBLE CLEARANCES FOR ALL ITEMS, INCLUDING BUT NOT LIMITED TO ALL COUNTER TOPS, ALL PLUMBING FIXTURES, ALL DRINKING FOUNTAINS, ALL ELECTRIC WATER
4 A-623	0701			COOLERS, ALL LAVATORIES, ALL URINALS, ALL TOILETS SHALL BE STRICTLY ENFORCED 23. APPLY BITUMINOUS COATING TO ALL CONCEALED STRUCTURAL STEEL MEMBERS AT ALL EXTERIO CANOPY LOCATIONS 24. REFER TO OTHER DISCIPLINE DOCUMENTS FOR ADDITIONAL SCOPE OF WORK 25. PROVIDE PLYWOOD IN METAL STUD WALL PARTITION FOR SUPPORT OF ALL TV LOCATIONS.
	4' TB/ 1013			KEYNOTE LEGEND
B-C 1204 24	6-23/8			NUMBER DESCRIPTION 0701 PROVIDE EXPANSION JOINT W/ COVER 1001 WALL MOUNTED MARKERBOARD; RE: SPECS
(B-D)	(1115A) C.G. C.G.			1001 WALL MOUNTED MARKERBOARD, RE. SPECS 1013 WALL MOUNTED TACKBOARD; RE: SPECS 1028 FIRE EXTINGUISHER 1113 FUME EXHAUST HOOD; RE: SPECS
SCIENCE CLASSROOM 01 ↓ (1115A) ■ (1115) .				1114 EMERGENCY EYEWASH / EYEWASH STATION; RE: MEPT 1116 INDUSTRIAL METAL SHELVING; RE: SPECS 1122 SMART SCREEN, PROVIDE BLOCKING, O.F.C.I
3 A-624 				1204 TYPICAL TEACHER WARDROBE CABINET; RE: 27/A5-13
A-624	2'-8 1/2" CORRIDOR 1 1160C	CLASSROOM 2 3114	CLASSROOM 3 CLASSROOM 4 CLASSROOM 5 3113 3109 3108	CLASSROOM 6 3107
1'-8" 2'-10 3/8" 27'-5 1/4"				
	1115B C.G. C.G. C.G. C.G. C.G. C.G. C.G.			
(B-F)				
B-G				
	1) 30 1114 C.G.			
		}		
	2'-8 1/2" BECHANICAL ROOM	APPLIED SKILLS 1166	APPLIED SKILLS 1162 ISO ISO ISO ISO ISO INURSE	OFFICE
	3'-2 7/8" 2'-8 1/2"			99
B-H				
SCIENCE 2'-2" SCIENCE CLASSROOM 02			RR RR I BOS ICEREF. NURSE STORAGE	
02/A-402	6 A-623		STORAGE	
		1164	STOPACE STOPACE	
	<u>4'TB</u> <u>C.G</u> <u>8</u> <u>7</u> <u>7</u> <u>7</u> <u>7</u> <u>7</u> <u>7</u> <u>7</u> <u>7</u> <u>7</u> <u>7</u>	RAGE ST	STORAGE 1163	
		LIFE SKILLS 1164 CORRIDOR	MEDIC AL FRAGILE 1161 16' MB	
	1118 C.G. 1118 C.G. In PLACE CONC. CURB, REF. STRUCT. DWGS.	CORRIDOR 1100		CIPAL
			RR 270 SECR	ETARY 17
(B-K)				– – – – – (B-K)
5'-7 5/8" <u>5'-7 5/8"</u> <u>3/A-710</u> 29'-9 5/8" (1127)	8'-9 3/8" 1'-6 7/8" 20'-2 1/4" 1'-6 1/2" 30'-4 1/2" 1'-8 1/2" TYP.	- 25'-11 1/2" 7'-0 1/2"	1028 28'-5 5/8" 1129 STORAGE	<u>A-702</u>
		<u>2/A-710</u> TYP.		
B-L 6'-6 3/8" SIM STAIR	4'TB (\$5) 1001	4'TB	4'TB	
		30'-10 3/4"	31'-5 3/4" 1'-5 1/2" 31'-0 3/4"	
B-M STOR		CLASSROOM 03	CLASSROOM 04 1122 1122 1122 1122 1122 1122 1122 1122 1122 1122 1122 1125	
			(1124)	
<u>02/A-420</u> <u>4</u> <u>6</u>	17'-9 5/8" 15'-0" 15'-6" 15'-0"	15'-0" 15'-6"	15'-0" 15'-6 1/2"	
B-1 A-625 B-3 A-625 B-3 A-625 B-3 A-625 B-3 A-625 B-3 A-625	B-6 B-8 B-9 B-12 B-12	A-624 B-13	(B-14) (B-15)	
UO 1/8" = 1'-0"				


File

CHECKED BY: Checker DRAWN BY: Author Plot Stamp: 1/15/2025 10:53:45 AM

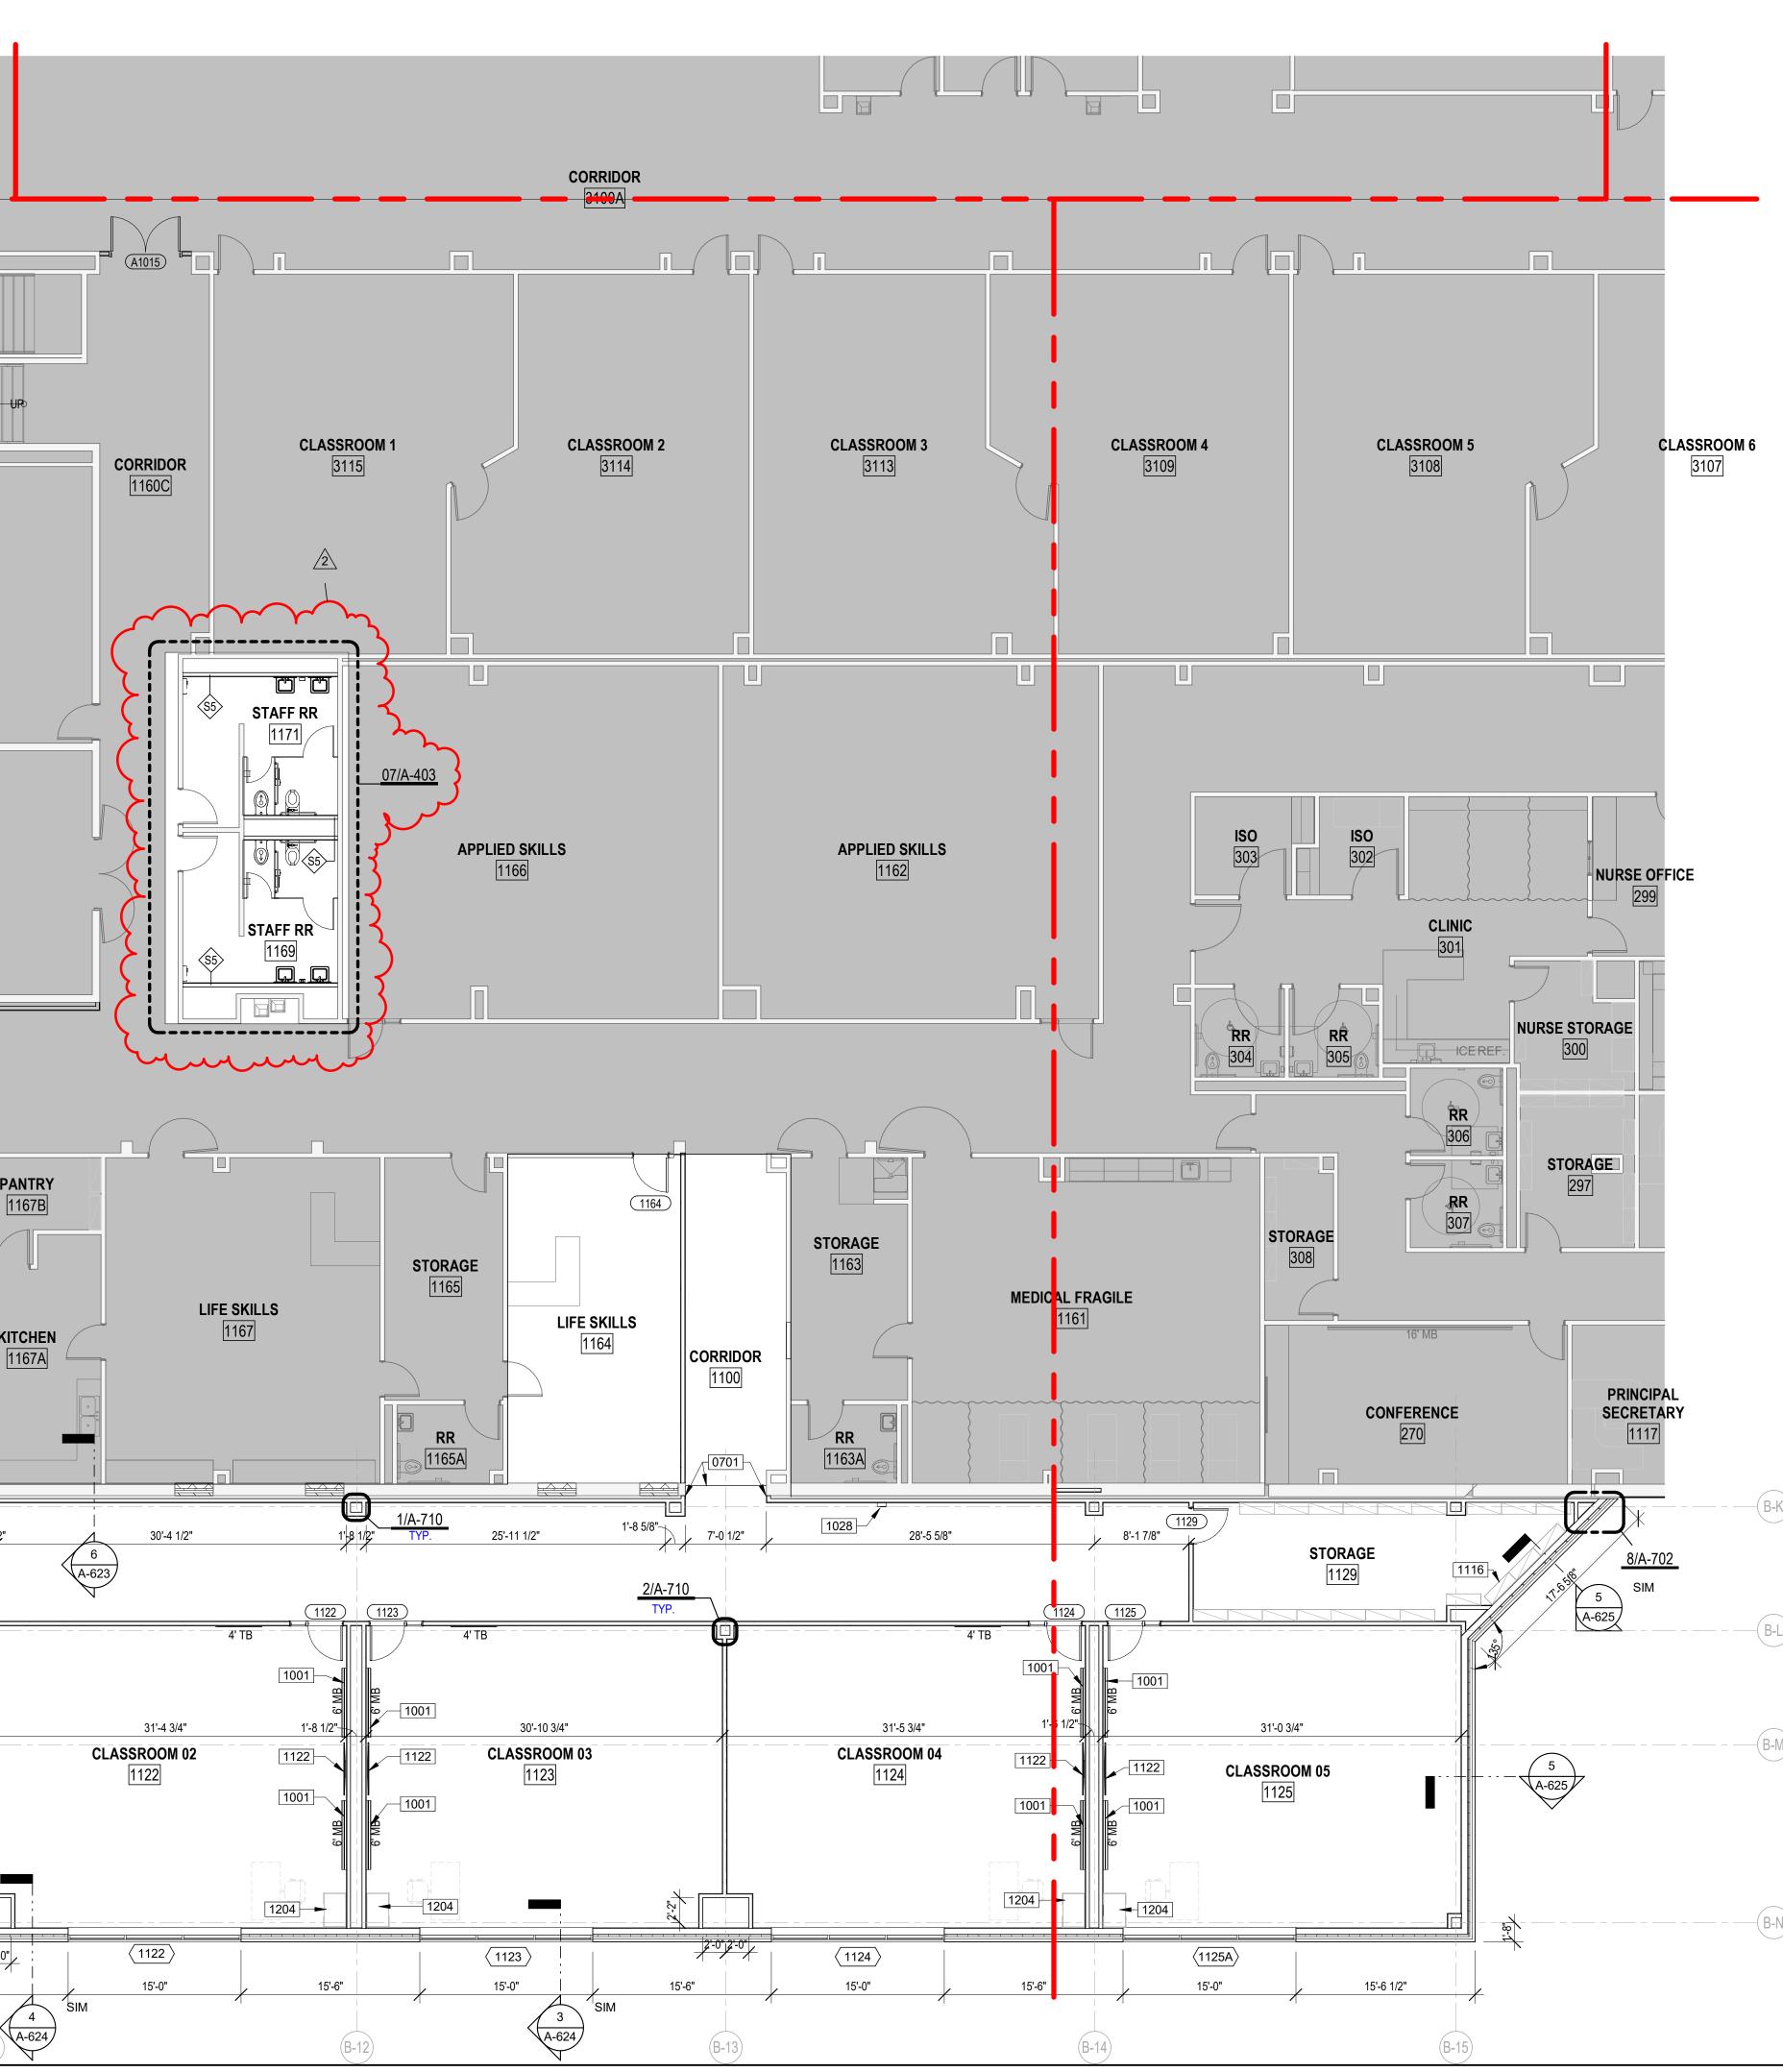

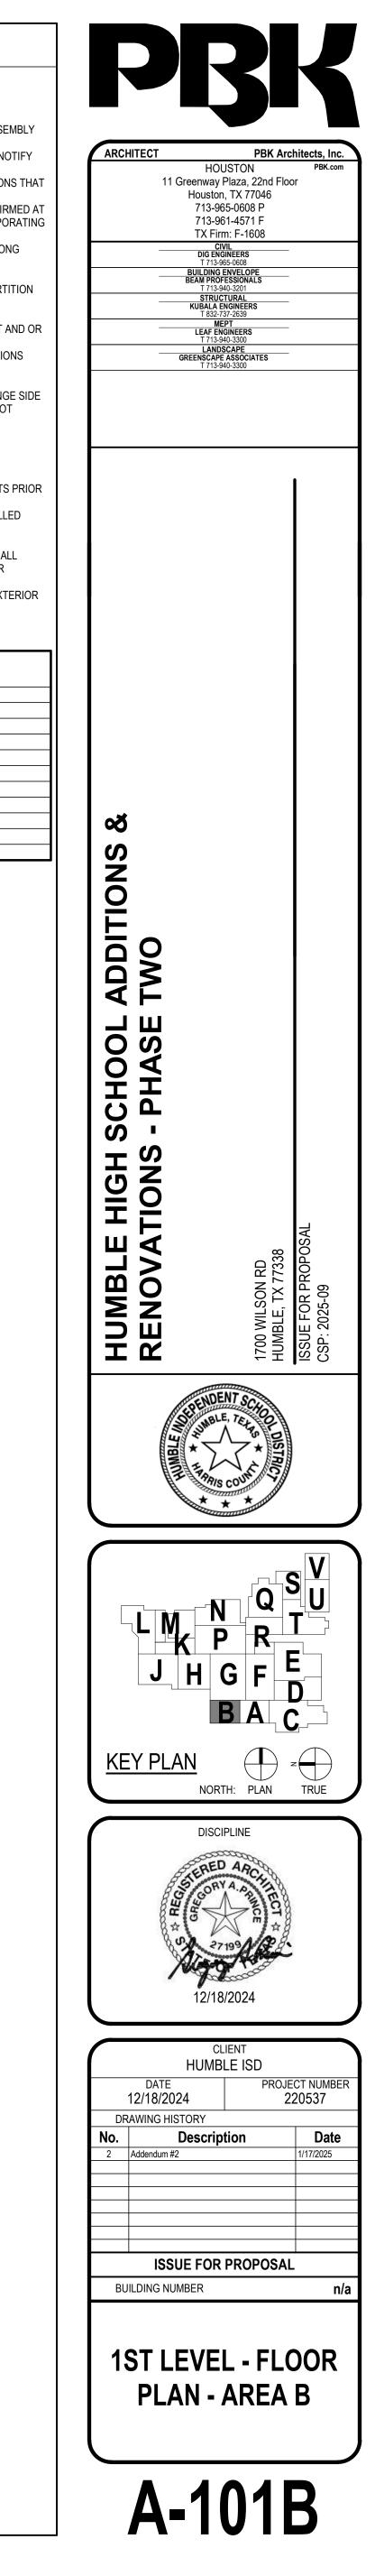



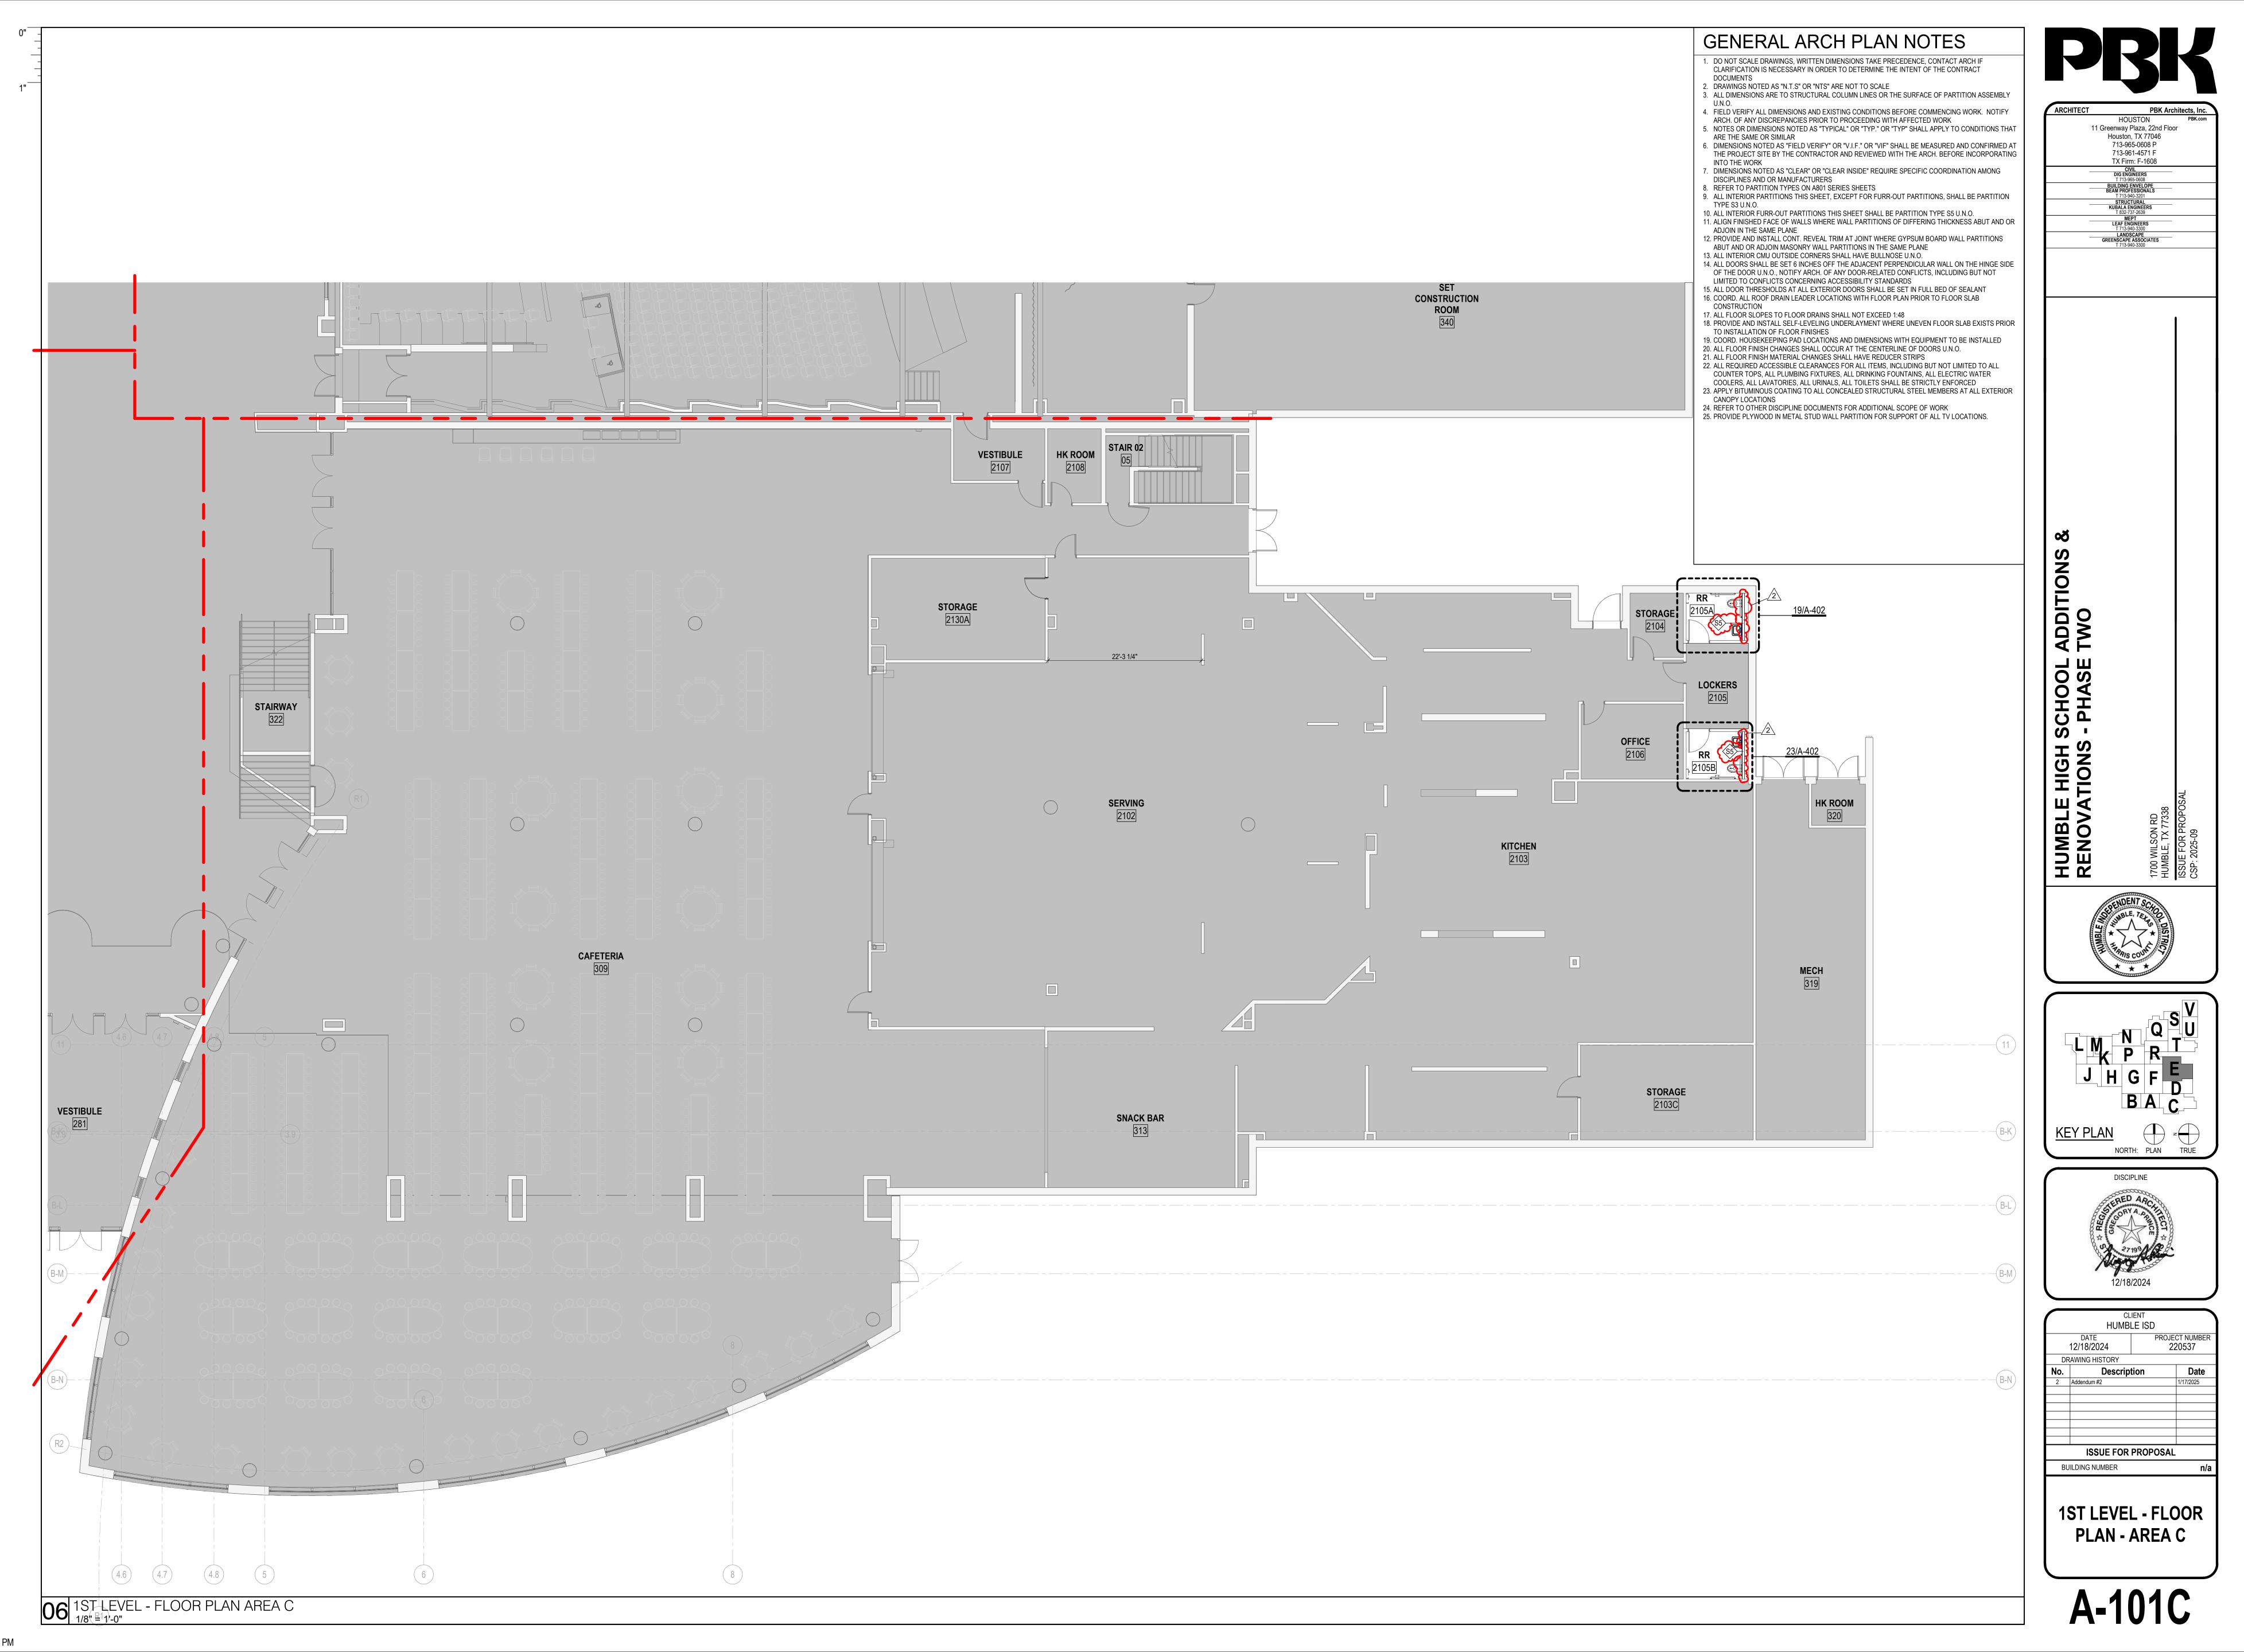


CHECKED BY: Checker DRAWN BY: Author Plot Stamp: 1/15/2025 7:11:37 PM

<mark>"</mark> —


	DATA				ANEL					FRAME
- MARK 2161A (NAME CUSTODIAL STORAGE	WIDTH 3'-0"	HEIGHT 6'-10"	ELEVATION F	THK 1 3/4"	MATERIAL SCPL	FINISH PLAM	TYPE 001	MATERIAL EXISTING TO REMA	Finish In Painted
					· · · ·					
			<u>_</u>				· ·	· · · ·		
							ИВ			
							16' MB			
]]			4' TB
]				
			10			 				
						Ī				
							-			
						i I				
							CC	DLLAB. 371	-	
									-	
						l I				
						l I				
										LIBF
										RR 378
						ſ	_			
1	1ST LEVEL - F 1/8" = 1'-0"	LOOR PLA	N AF	REAE		-				


CHECKE Checker DRAWN I Author


Plot Stam 1/14/2025 1:49:59 PM

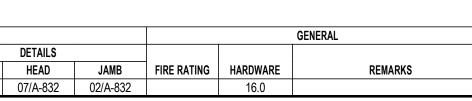




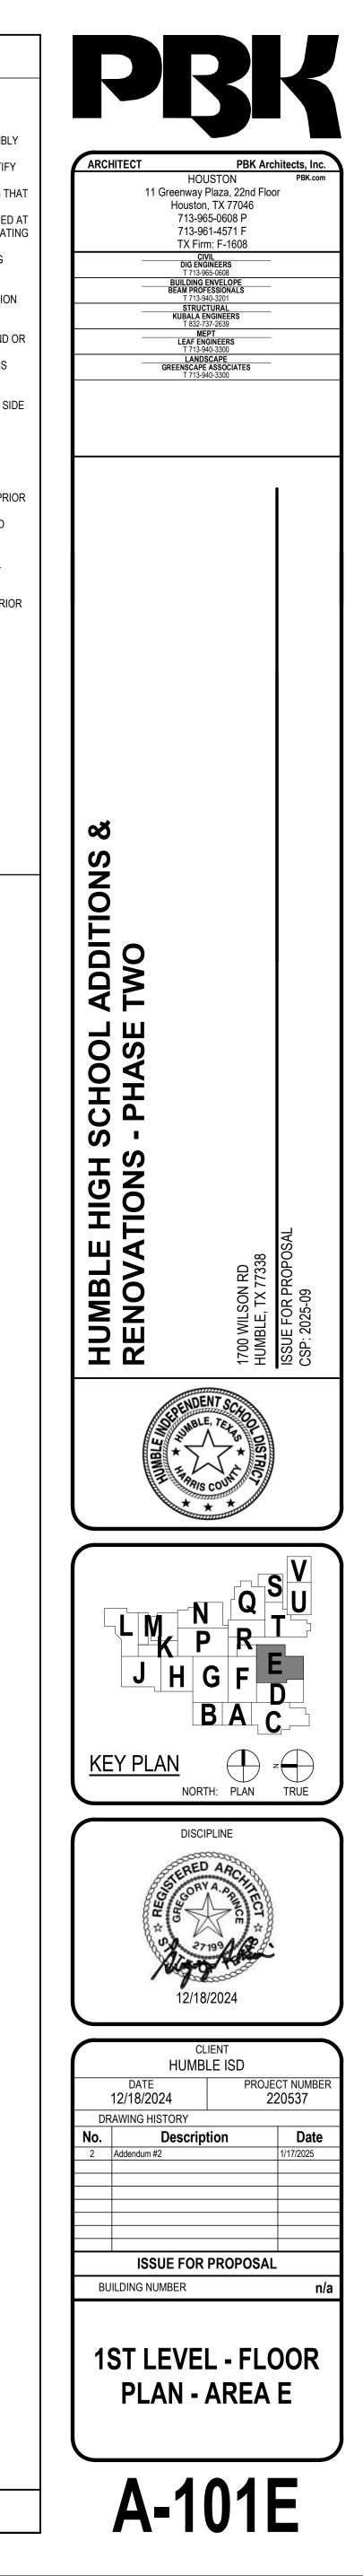

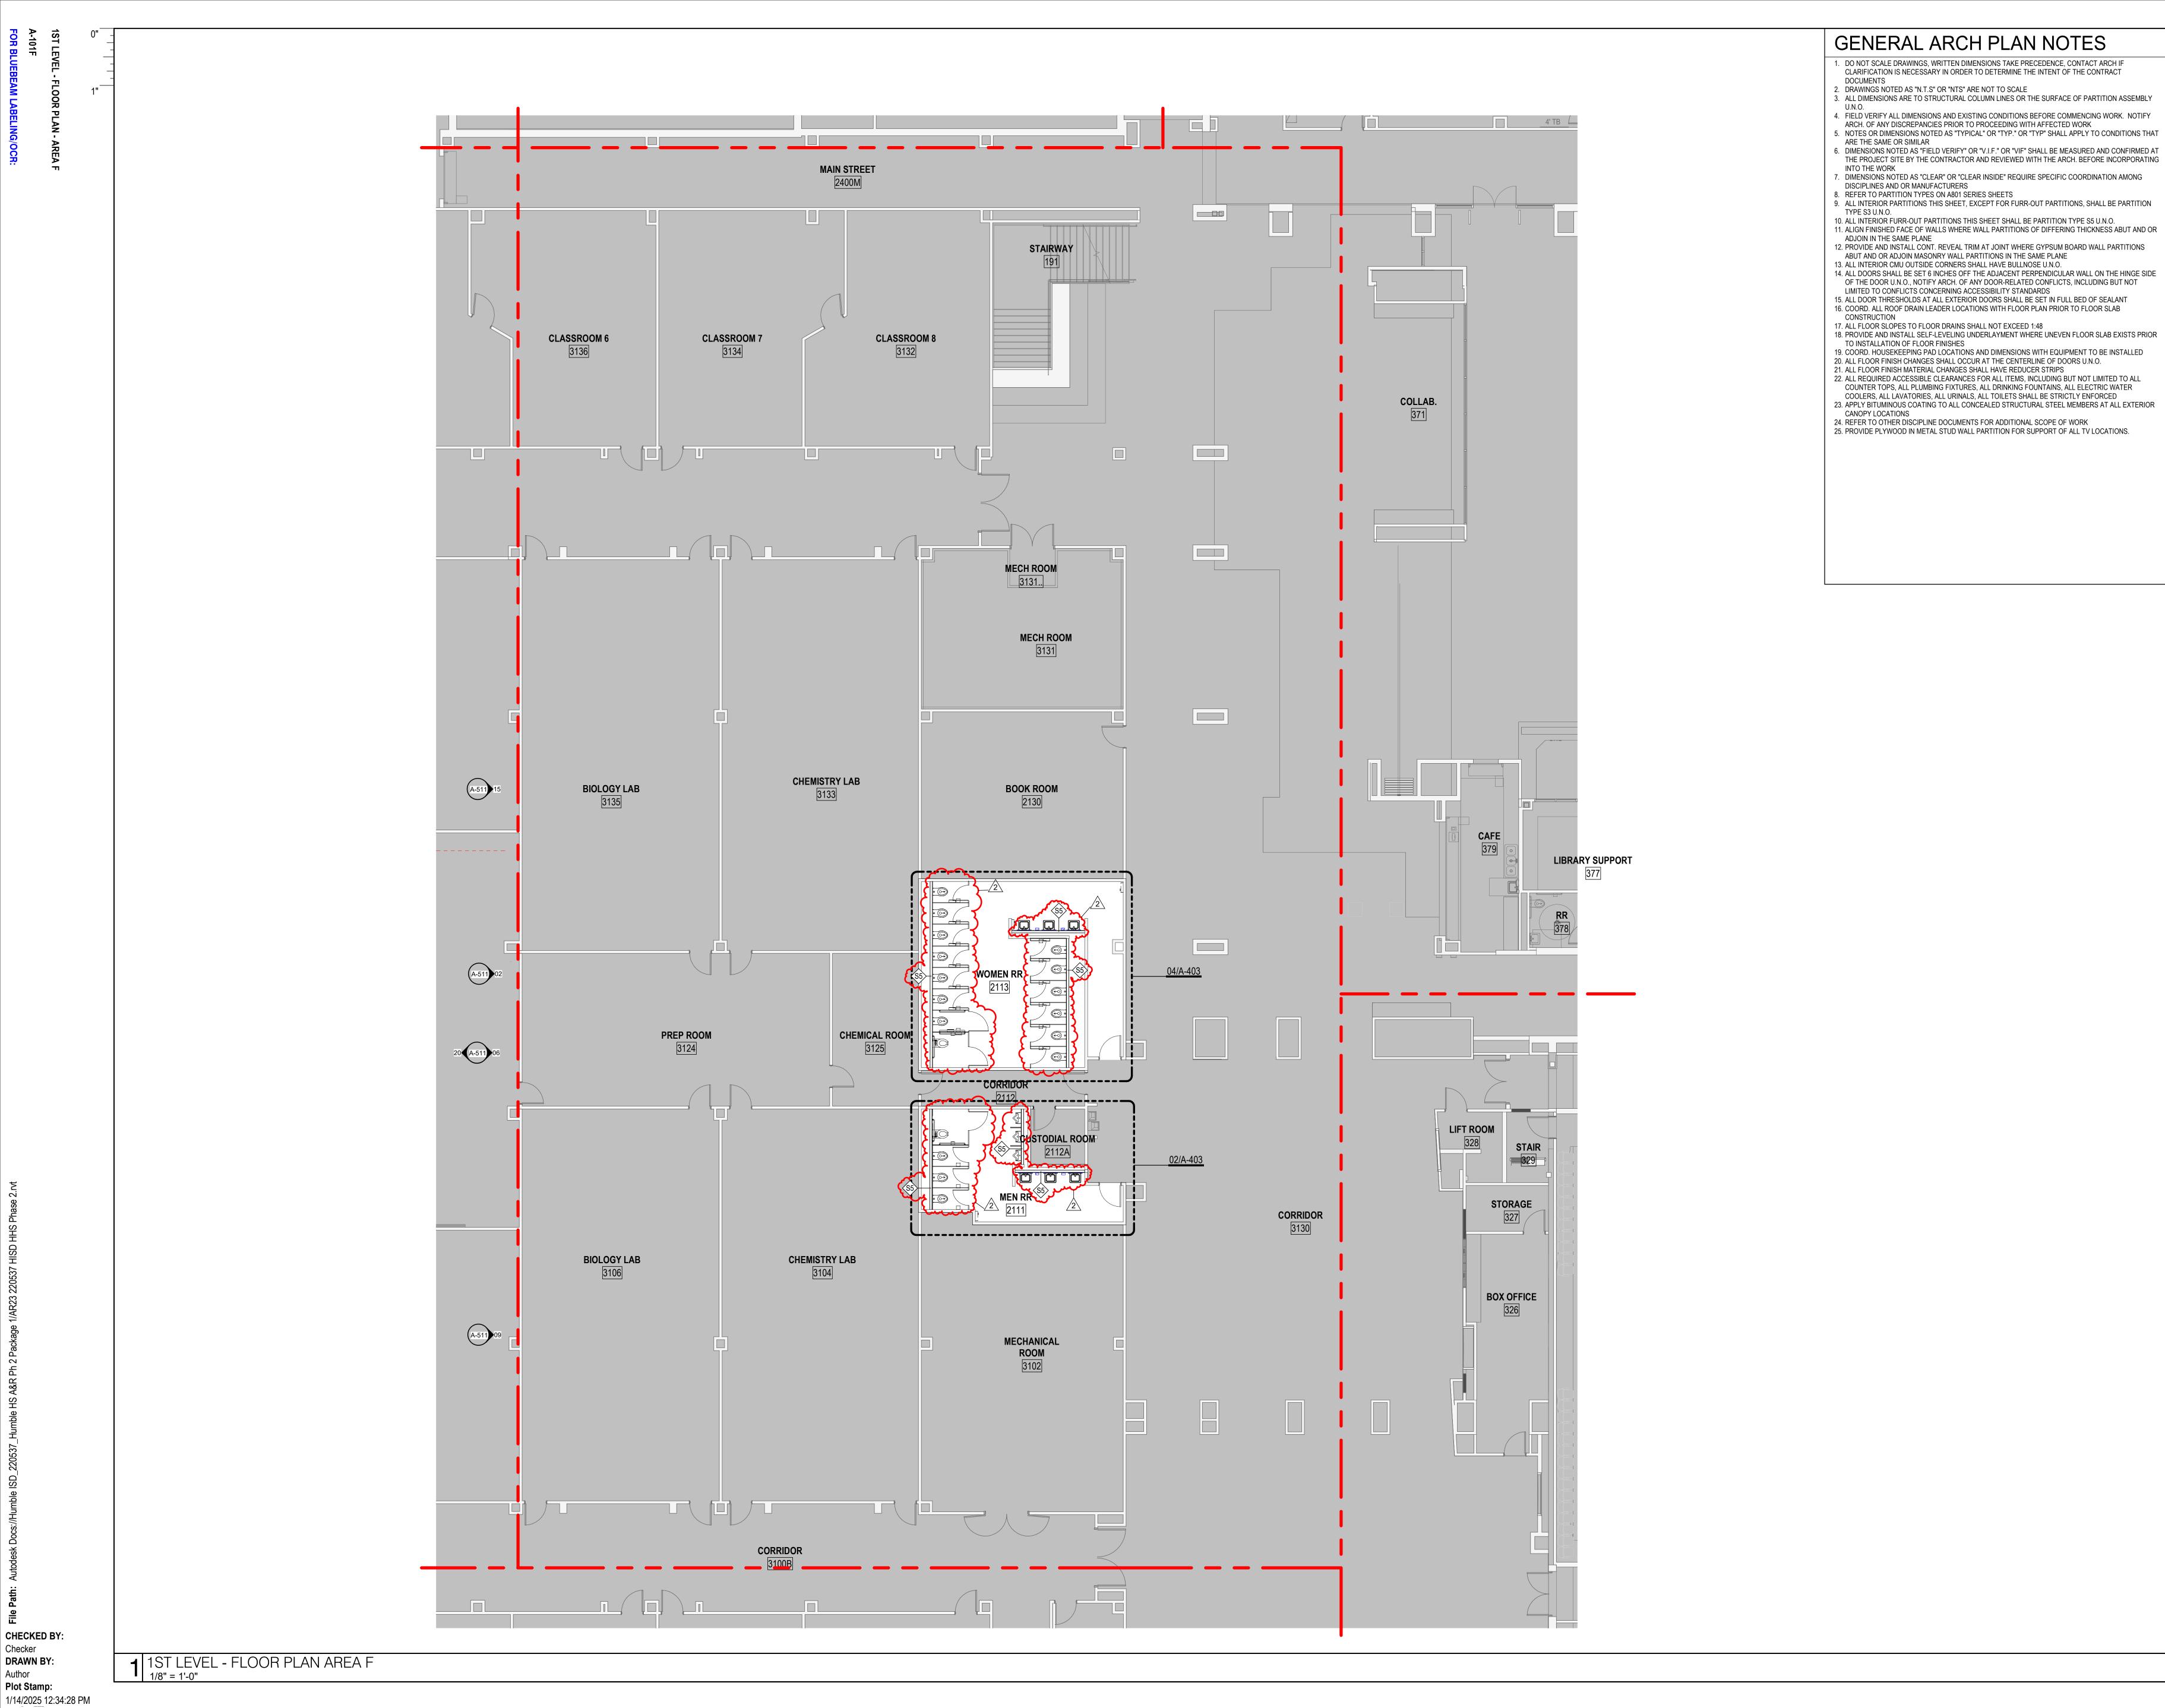

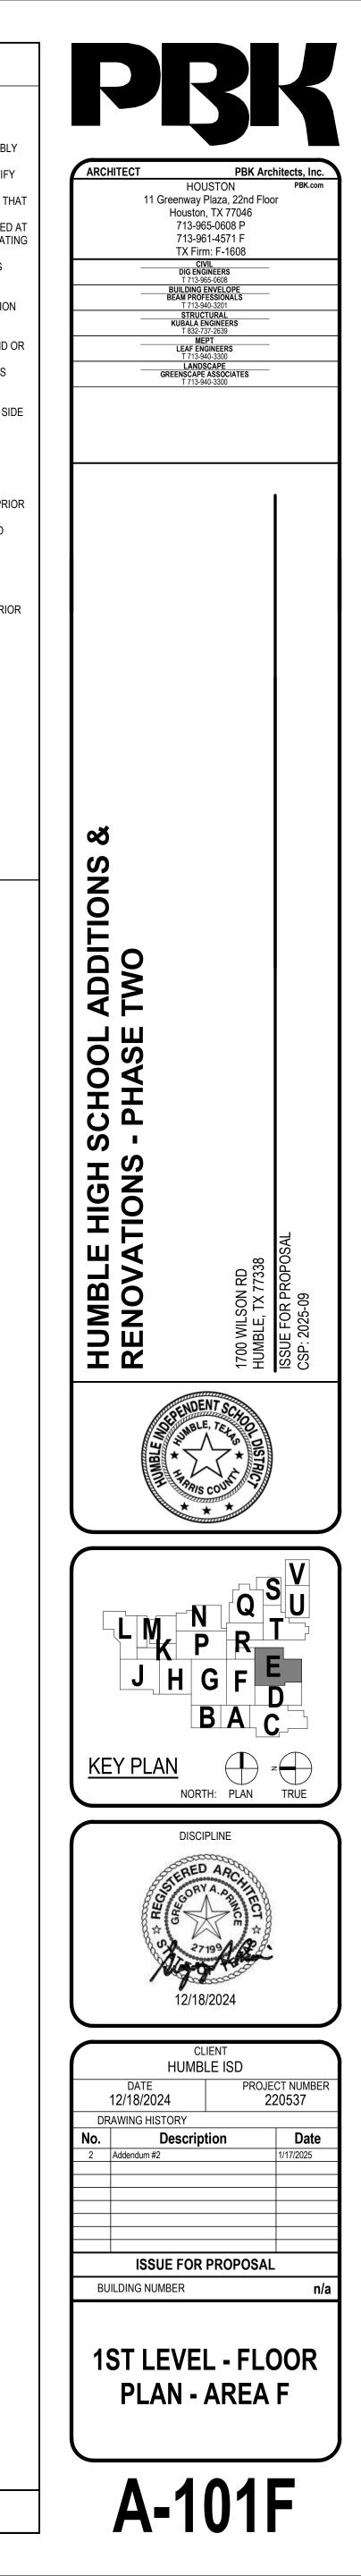

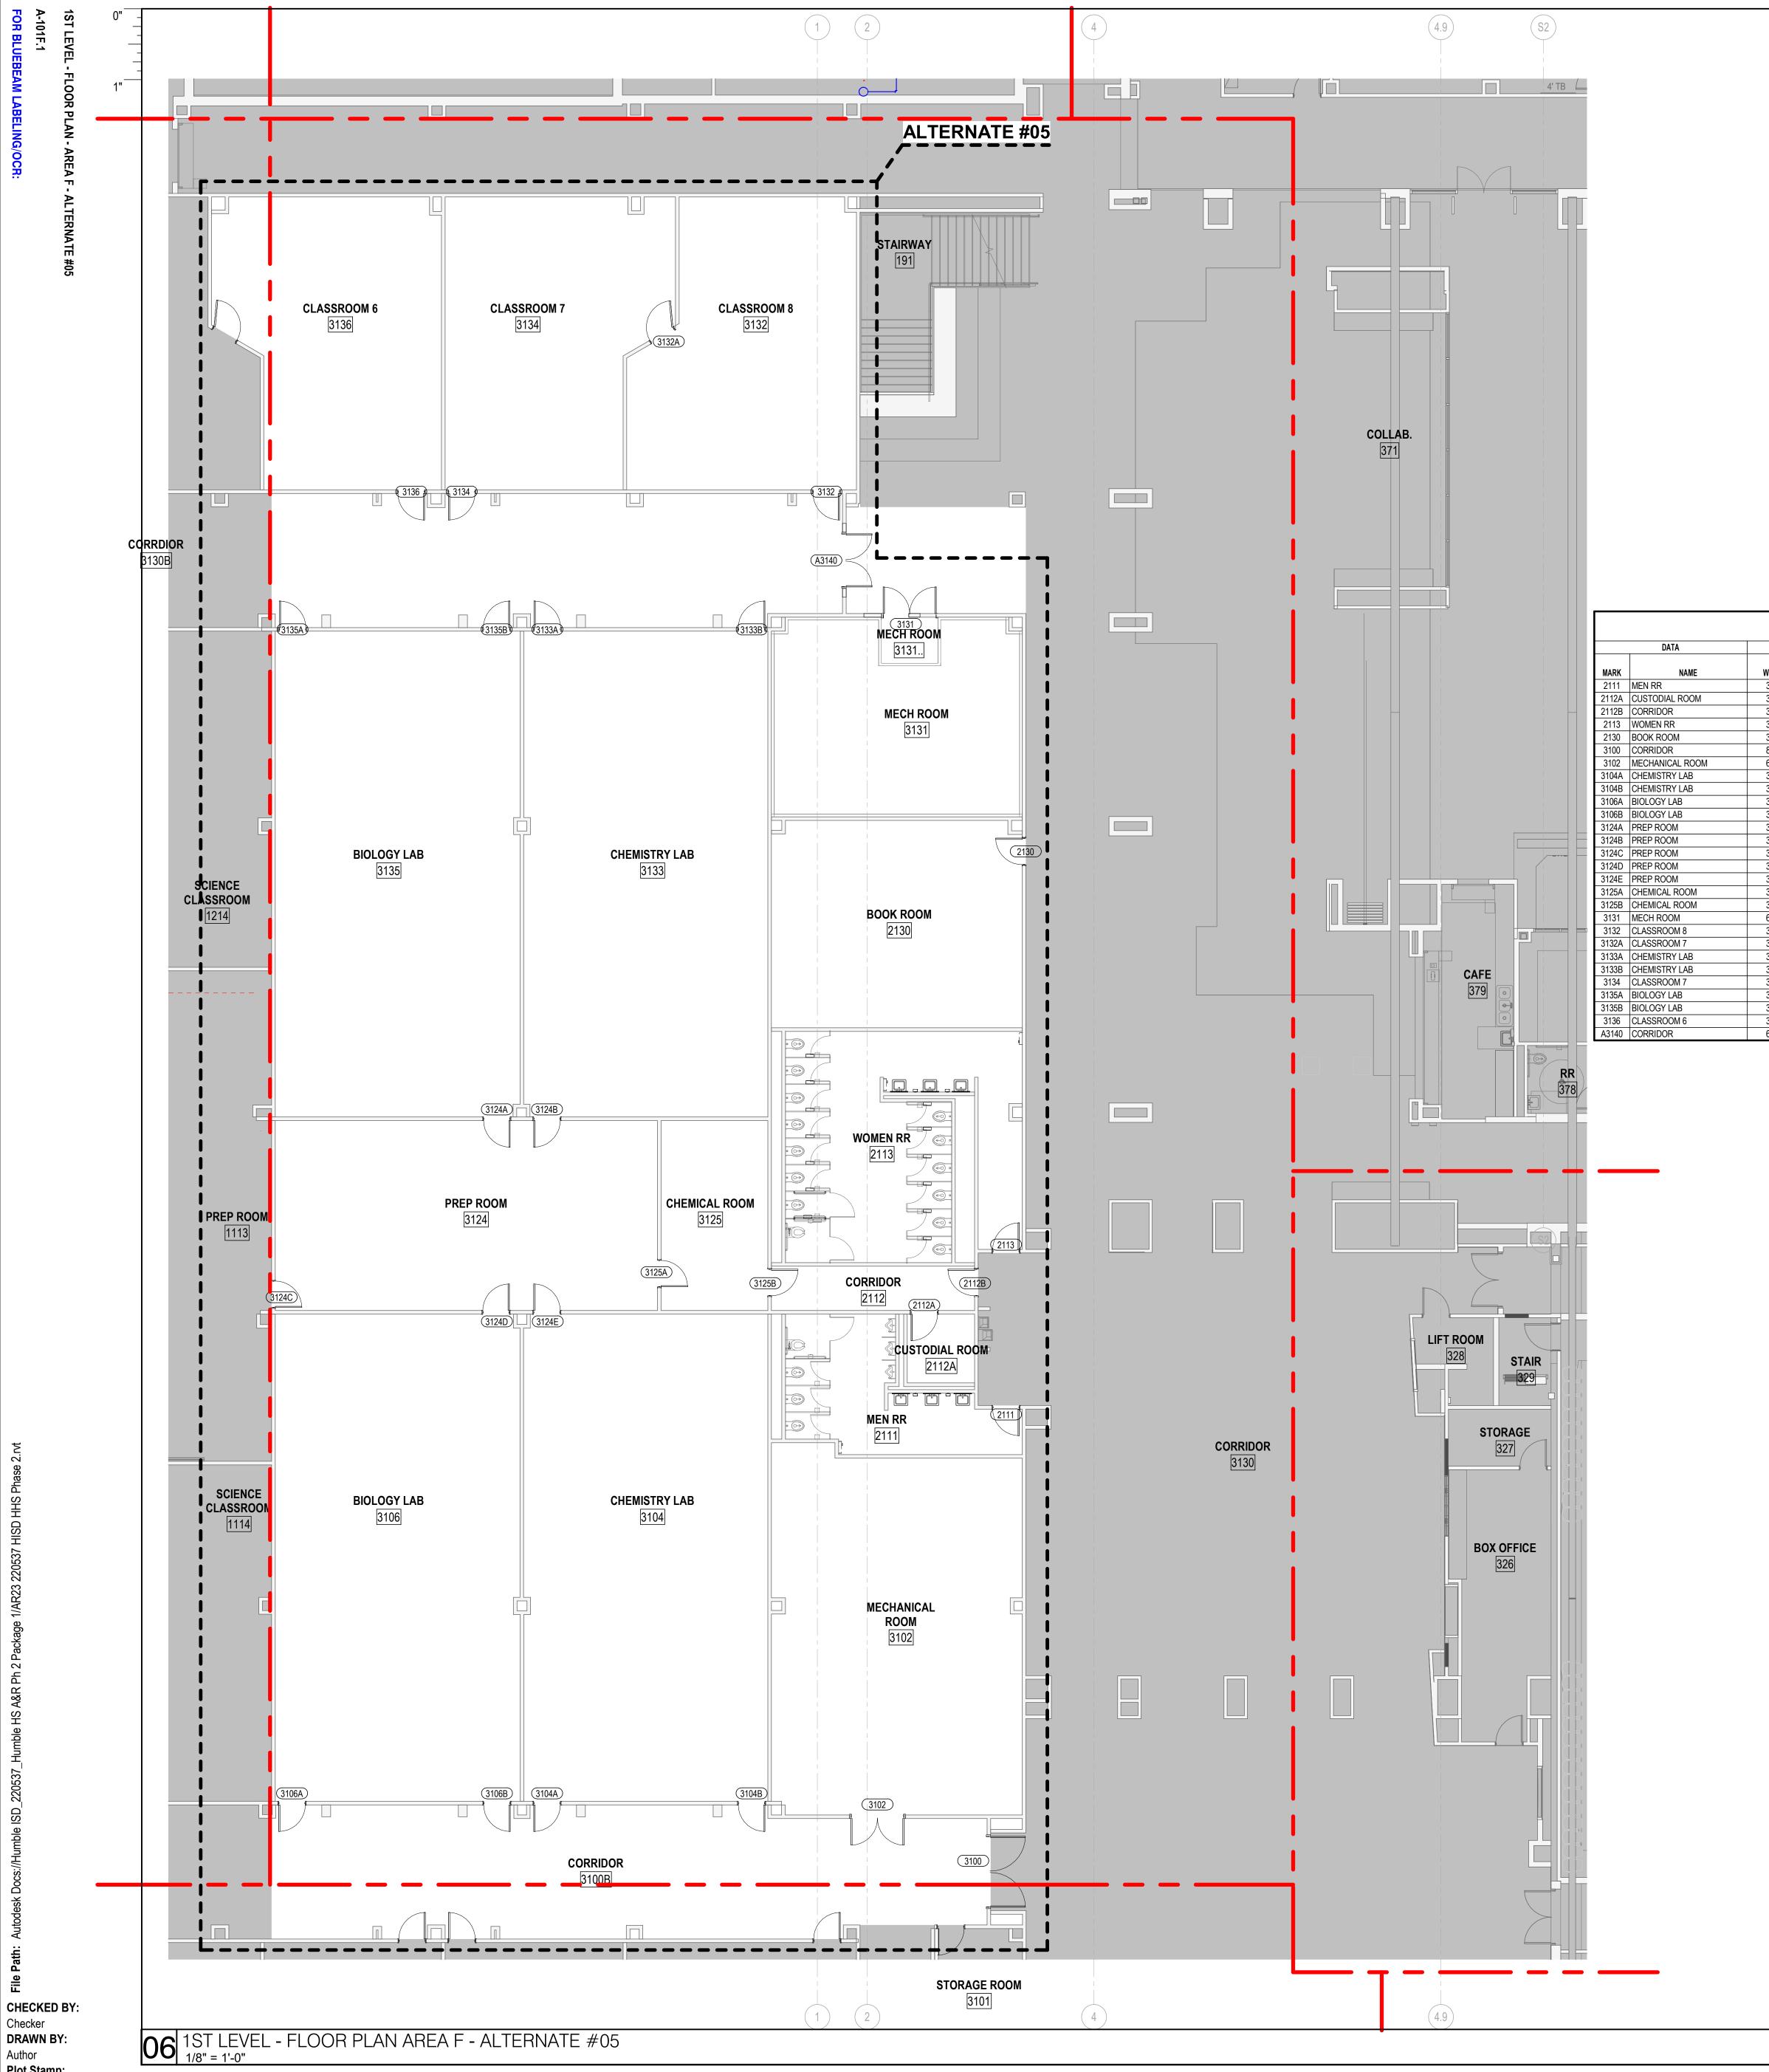

Author Plot Stamp: 1/10/2025 11:30:59 AM


GENERAL ARCH PLAN NOTES

. DO NOT SCALE DRAWINGS, WRITTEN DIMENSIONS TAKE PRECEDENCE, CONTACT ARCH IF CLARIFICATION IS NECESSARY IN ORDER TO DETERMINE THE INTENT OF THE CONTRACT

- DOCUMENTS 2. DRAWINGS NOTED AS "N.T.S" OR "NTS" ARE NOT TO SCALE
- 3. ALL DIMENSIONS ARE TO STRUCTURAL COLUMN LINES OR THE SURFACE OF PARTITION ASSEMBLY U.N.O.
- 4. FIELD VERIFY ALL DIMENSIONS AND EXISTING CONDITIONS BEFORE COMMENCING WORK. NOTIFY ARCH. OF ANY DISCREPANCIES PRIOR TO PROCEEDING WITH AFFECTED WORK 5. NOTES OR DIMENSIONS NOTED AS "TYPICAL" OR "TYP." OR "TYP" SHALL APPLY TO CONDITIONS THAT
- ARE THE SAME OR SIMILAR 6. DIMENSIONS NOTED AS "FIELD VERIFY" OR "V.I.F." OR "VIF" SHALL BE MEASURED AND CONFIRMED AT
- THE PROJECT SITE BY THE CONTRACTOR AND REVIEWED WITH THE ARCH. BEFORE INCORPORATING INTO THE WORK . DIMENSIONS NOTED AS "CLEAR" OR "CLEAR INSIDE" REQUIRE SPECIFIC COORDINATION AMONG
- DISCIPLINES AND OR MANUFACTURERS 8. REFER TO PARTITION TYPES ON A801 SERIES SHEETS
- 9. ALL INTERIOR PARTITIONS THIS SHEET, EXCEPT FOR FURR-OUT PARTITIONS, SHALL BE PARTITION TYPE S3 U.N.O. 10. ALL INTERIOR FURR-OUT PARTITIONS THIS SHEET SHALL BE PARTITION TYPE S5 U.N.O.
- 11. ALIGN FINISHED FACE OF WALLS WHERE WALL PARTITIONS OF DIFFERING THICKNESS ABUT AND OR ADJOIN IN THE SAME PLANE 12. PROVIDE AND INSTALL CONT. REVEAL TRIM AT JOINT WHERE GYPSUM BOARD WALL PARTITIONS ABUT AND OR ADJOIN MASONRY WALL PARTITIONS IN THE SAME PLANE
- 13. ALL INTERIOR CMU OUTSIDE CORNERS SHALL HAVE BULLNOSE U.N.O.
- 14. ALL DOORS SHALL BE SET 6 INCHES OFF THE ADJACENT PERPENDICULAR WALL ON THE HINGE SIDE OF THE DOOR U.N.O., NOTIFY ARCH. OF ANY DOOR-RELATED CONFLICTS, INCLUDING BUT NOT LIMITED TO CONFLICTS CONCERNING ACCESSIBILITY STANDARDS 15. ALL DOOR THRESHOLDS AT ALL EXTERIOR DOORS SHALL BE SET IN FULL BED OF SEALANT
- 16. COORD. ALL ROOF DRAIN LEADER LOCATIONS WITH FLOOR PLAN PRIOR TO FLOOR SLAB CONSTRUCTION 17. ALL FLOOR SLOPES TO FLOOR DRAINS SHALL NOT EXCEED 1:48
- 18. PROVIDE AND INSTALL SELF-LEVELING UNDERLAYMENT WHERE UNEVEN FLOOR SLAB EXISTS PRIOR TO INSTALLATION OF FLOOR FINISHES 19. COORD. HOUSEKEEPING PAD LOCATIONS AND DIMENSIONS WITH EQUIPMENT TO BE INSTALLED 20. ALL FLOOR FINISH CHANGES SHALL OCCUR AT THE CENTERLINE OF DOORS U.N.O.
- 21. ALL FLOOR FINISH MATERIAL CHANGES SHALL HAVE REDUCER STRIPS 22. ALL REQUIRED ACCESSIBLE CLEARANCES FOR ALL ITEMS, INCLUDING BUT NOT LIMITED TO ALL COUNTER TOPS, ALL PLUMBING FIXTURES, ALL DRINKING FOUNTAINS, ALL ELECTRIC WATER COOLERS, ALL LAVATORIES, ALL URINALS, ALL TOILETS SHALL BE STRICTLY ENFORCED
- 23. APPLY BITUMINOUS COATING TO ALL CONCEALED STRUCTURAL STEEL MEMBERS AT ALL EXTERIOR CANOPY LOCATIONS
- 24. REFER TO OTHER DISCIPLINE DOCUMENTS FOR ADDITIONAL SCOPE OF WORK 25. PROVIDE PLYWOOD IN METAL STUD WALL PARTITION FOR SUPPORT OF ALL TV LOCATIONS.


DOOR SCHEDULE AREA F (ALTERNATE #05)


		PAI	NEL					FR	RAME				GENERAL		
										DETAILS		FIRE			
WIDTH	HEIGHT	ELEVATION	ТНК	MATERIAL	FINISH	TYPE	MATERIAL	FINISH	SILL	HEAD	JAMB	RATING	HARDWARE	REMARKS	
3'-0"	6'-11 1/2"	F	1 3/4"	SCPL	PLAM	001	EXISTING TO REMAIN	PAINTED	G-21/A-832	EXIST. TO REMAIN	EXIST. TO REMAIN		38.0	VERIFY EXISTING DOOR IN FI	
3'-0"	6'-11 1/2"	F	1 3/4"	SCPL	PLAM	001	EXISTING TO REMAIN	PAINTED	B-21/A-832	EXIST. TO REMAIN	EXIST. TO REMAIN		22.0	VERIFY EXISTING DOOR IN FI	
3'-0"	6'-11 1/2"	F	1 3/4"	SCPL	PLAM	001	EXISTING TO REMAIN	PAINTED	G-21/A-832	EXIST. TO REMAIN	EXIST. TO REMAIN		19.0	VERIFY EXISTING DOOR IN FI	
3'-0"	6'-11 1/2"	F	1 3/4"	SCPL	PLAM	001	EXISTING TO REMAIN	PAINTED	G-21/A-832	EXIST. TO REMAIN	EXIST. TO REMAIN		38.0	VERIFY EXISTING DOOR IN FI	
3'-0"	6'-11 1/2"	F	1 3/4"	SCPL	PLAM	001	EXISTING TO REMAIN	PAINTED	J-21/A-832	EXIST. TO REMAIN	EXIST. TO REMAIN		19.0	VERIFY EXISTING DOOR IN FI	
8'-0"	6'-11 1/2"	F	1 3/4"	SCPL	PLAM	001	EXISTING TO REMAIN	PAINTED	G-21/A-832	EXIST. TO REMAIN	EXIST. TO REMAIN		12.0	VERIFY EXISTING DOOR IN FI	
6'-0"	6'-11 1/2"	F	1 3/4"	SCPL	PLAM	001	EXISTING TO REMAIN	PAINTED	B-21/A-832	EXIST. TO REMAIN	EXIST. TO REMAIN	45 MINS	9.0	VERIFY EXISTING DOOR IN FI	
3'-0"	6'-11 1/2"	NV-1	1 3/4"	SCPL	PLAM	001	EXISTING TO REMAIN	PAINTED	H-21/A-832	EXIST. TO REMAIN	EXIST. TO REMAIN		26.0	VERIFY EXISTING DOOR IN FI	
3'-0"	6'-11 1/2"	NV-1	1 3/4"	SCPL	PLAM	001	EXISTING TO REMAIN	PAINTED	H-21/A-832	EXIST. TO REMAIN	EXIST. TO REMAIN		26.0	VERIFY EXISTING DOOR IN FI	
3'-0"	6'-11 1/2"	NV-1	1 3/4"	SCPL	PLAM	001	EXISTING TO REMAIN	PAINTED	H-21/A-832	EXIST. TO REMAIN	EXIST. TO REMAIN		26.0	VERIFY EXISTING DOOR IN FI	
7			ス												
		く~													
	\checkmark 1		2											\	
			<u> </u>												

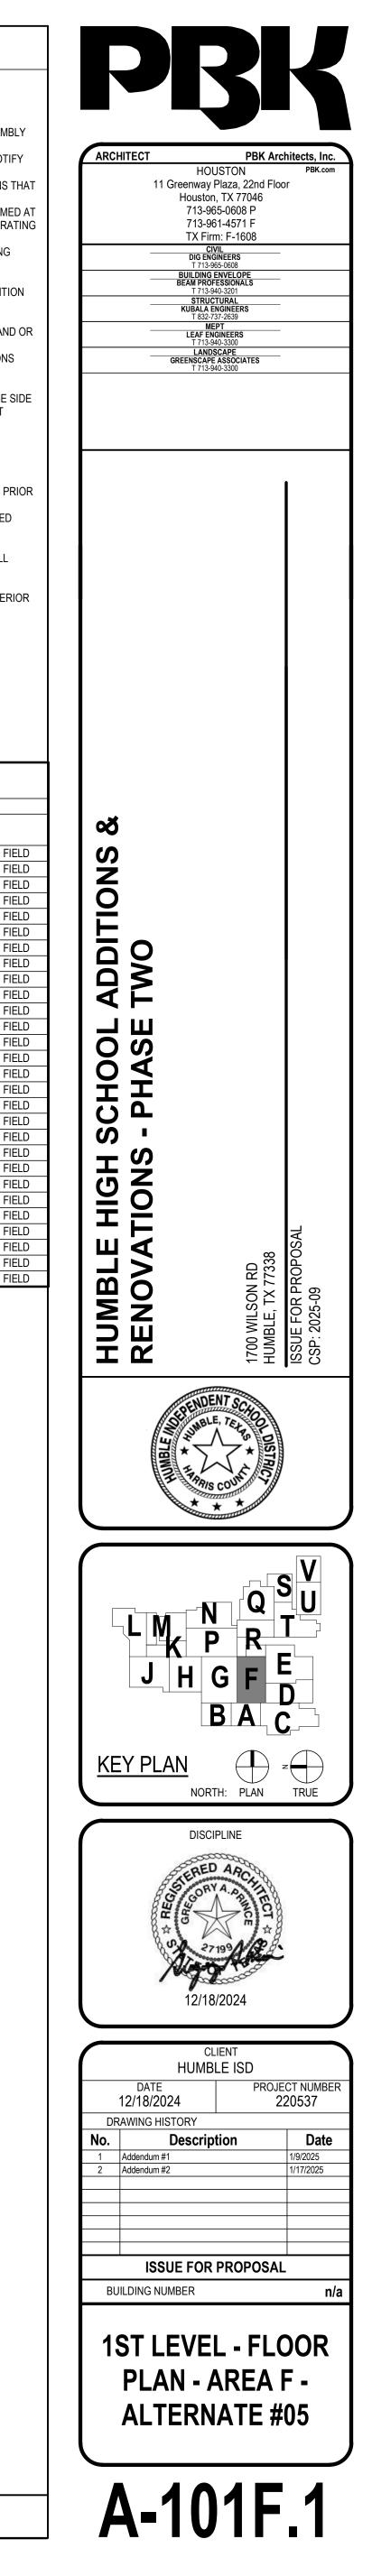


∕1∖

A-101G FOR BL	1ST LI	0"				=					DOOF	R SCH	IEDI	JLE	ARE		
A-101G FOR BLUEBEAM LABELING/OCR:	1ST LEVEL - FLOOR PLAN - AREA G		MARK A1021 COP	DA	NAME		WIDTH 6'-0"	HEIGHT 6'-10"	PA Elevation F	NEL THK 1 3/4"	MATERIAL	FINISH Plam	TYPE 001	MATERIAL	Finish Painte		DETAIL HEAD 07/A-83
LABELING/	OR PLAN - <i>I</i>																
OCR:	AREA G]	
																	E
]	
															FE	EEX EBARNI 4 #COOA	NG
																	A-527 07
Phase 2.rvt																	
2 HISD HHS																	
AR23 22053																	
Package 1//																	
IS A&R Ph 2														(B-A)		BA	
7_Humble F																	
e ISD_22053														(B-C)		B-C	
ocs://Humble														ARE			
File Path: Autodesk Docs://Humble ISD_220537_Humble HS A&R Ph 2 Package 1/AR23 220537 HISD HHS Phase 2.rvt														B-D		B-D	
File Path:																	
CHECKE Checker DRAWN I			06 ¹	ST L	EVEL	- FLO	OR PL	_AN Af	REA G								
Author Plot Stan 1/15/2025	1p: 7:16:29 Pf	M		/8" = 1	'-0"												

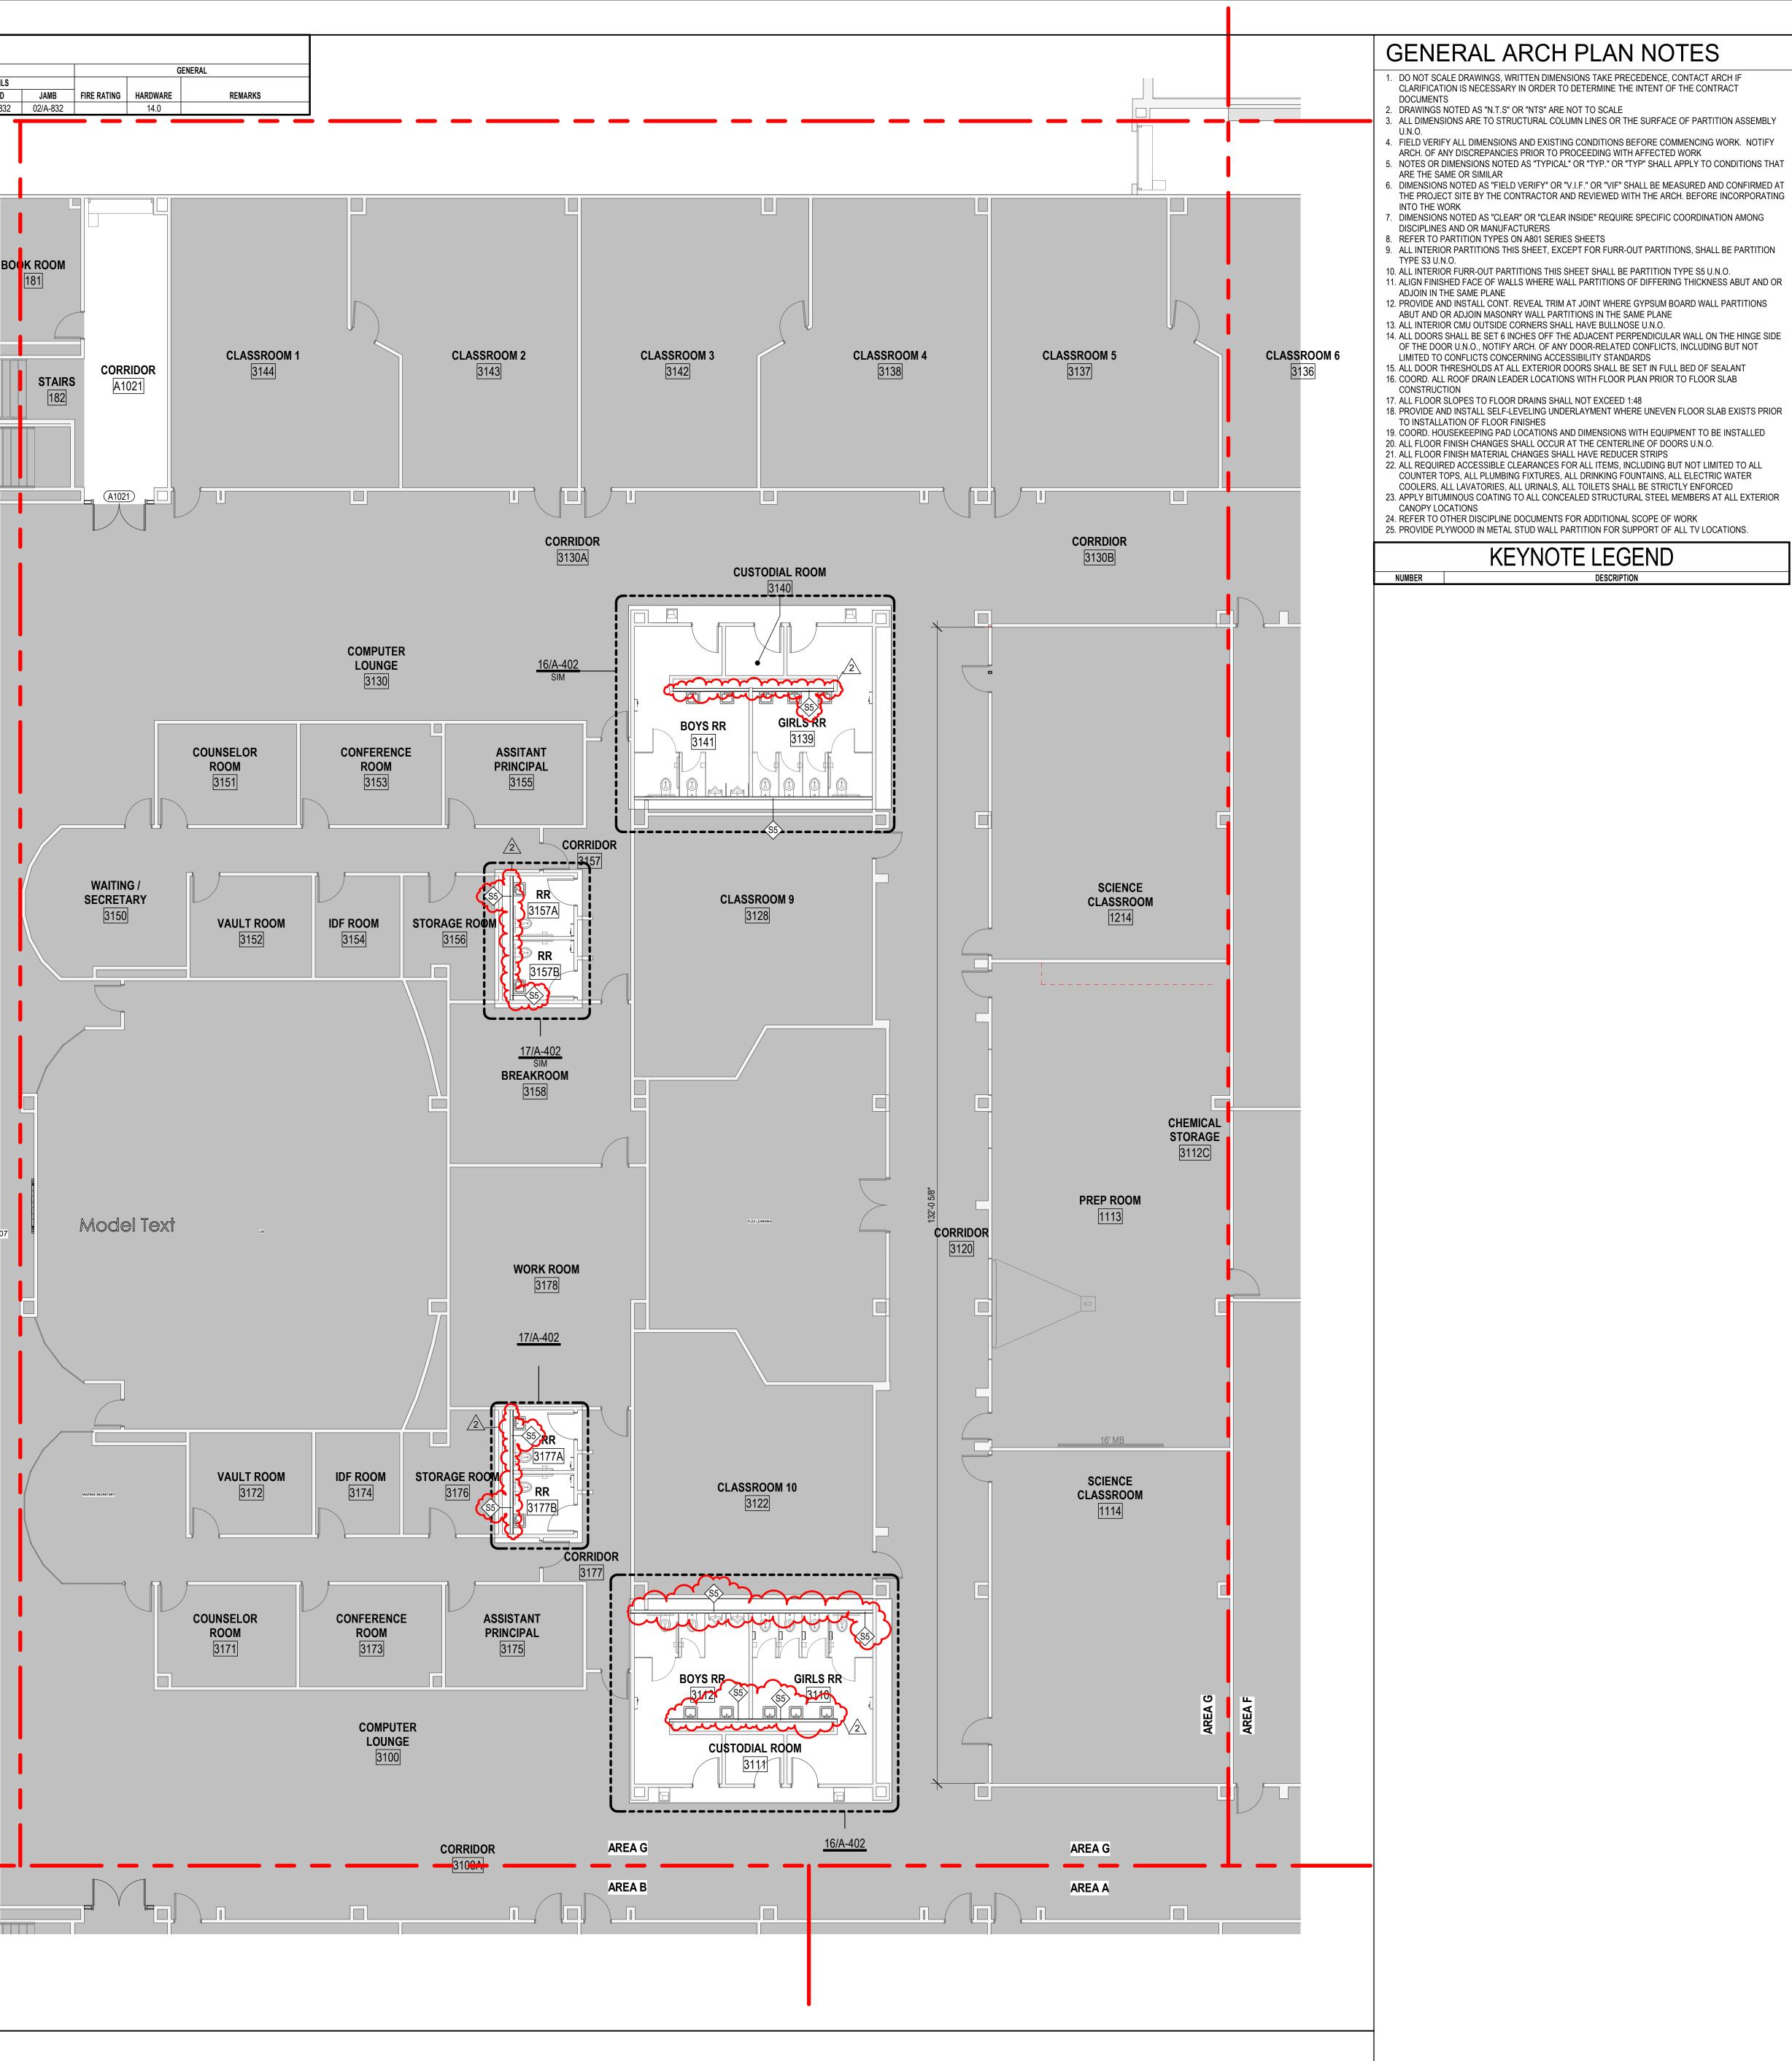

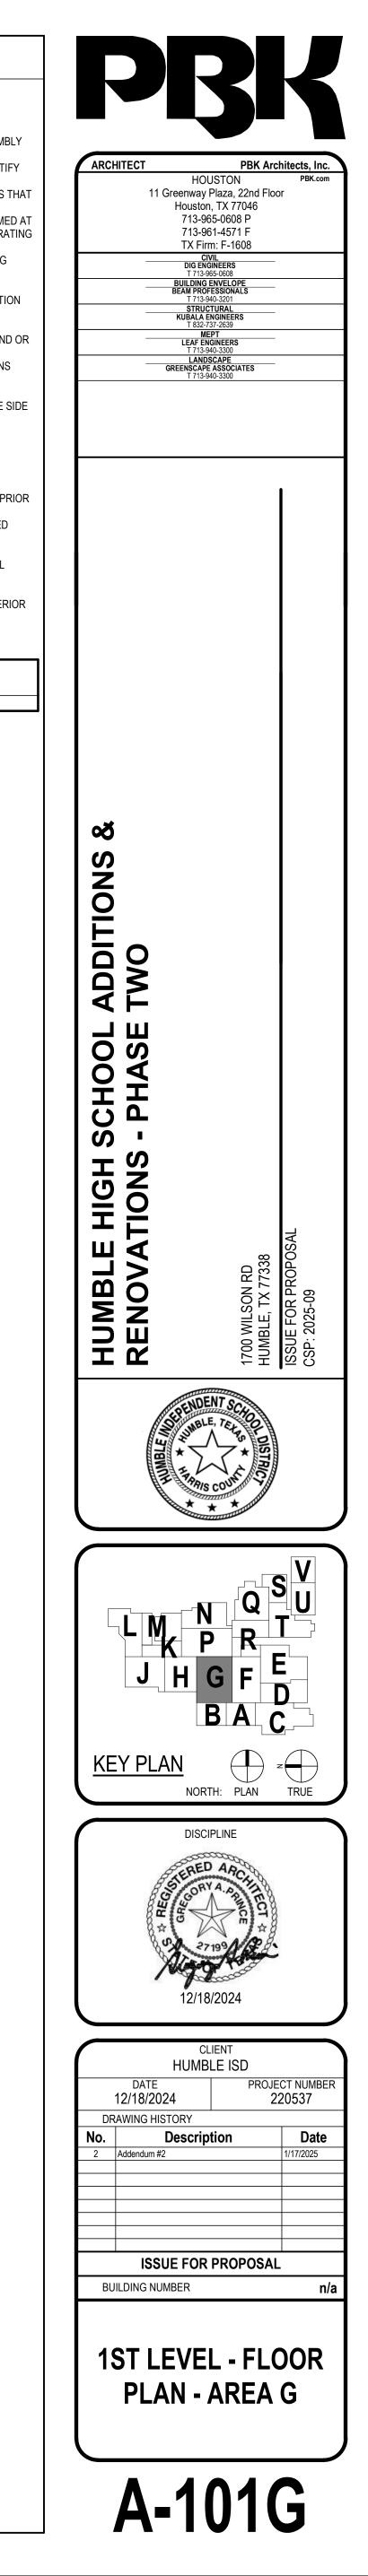

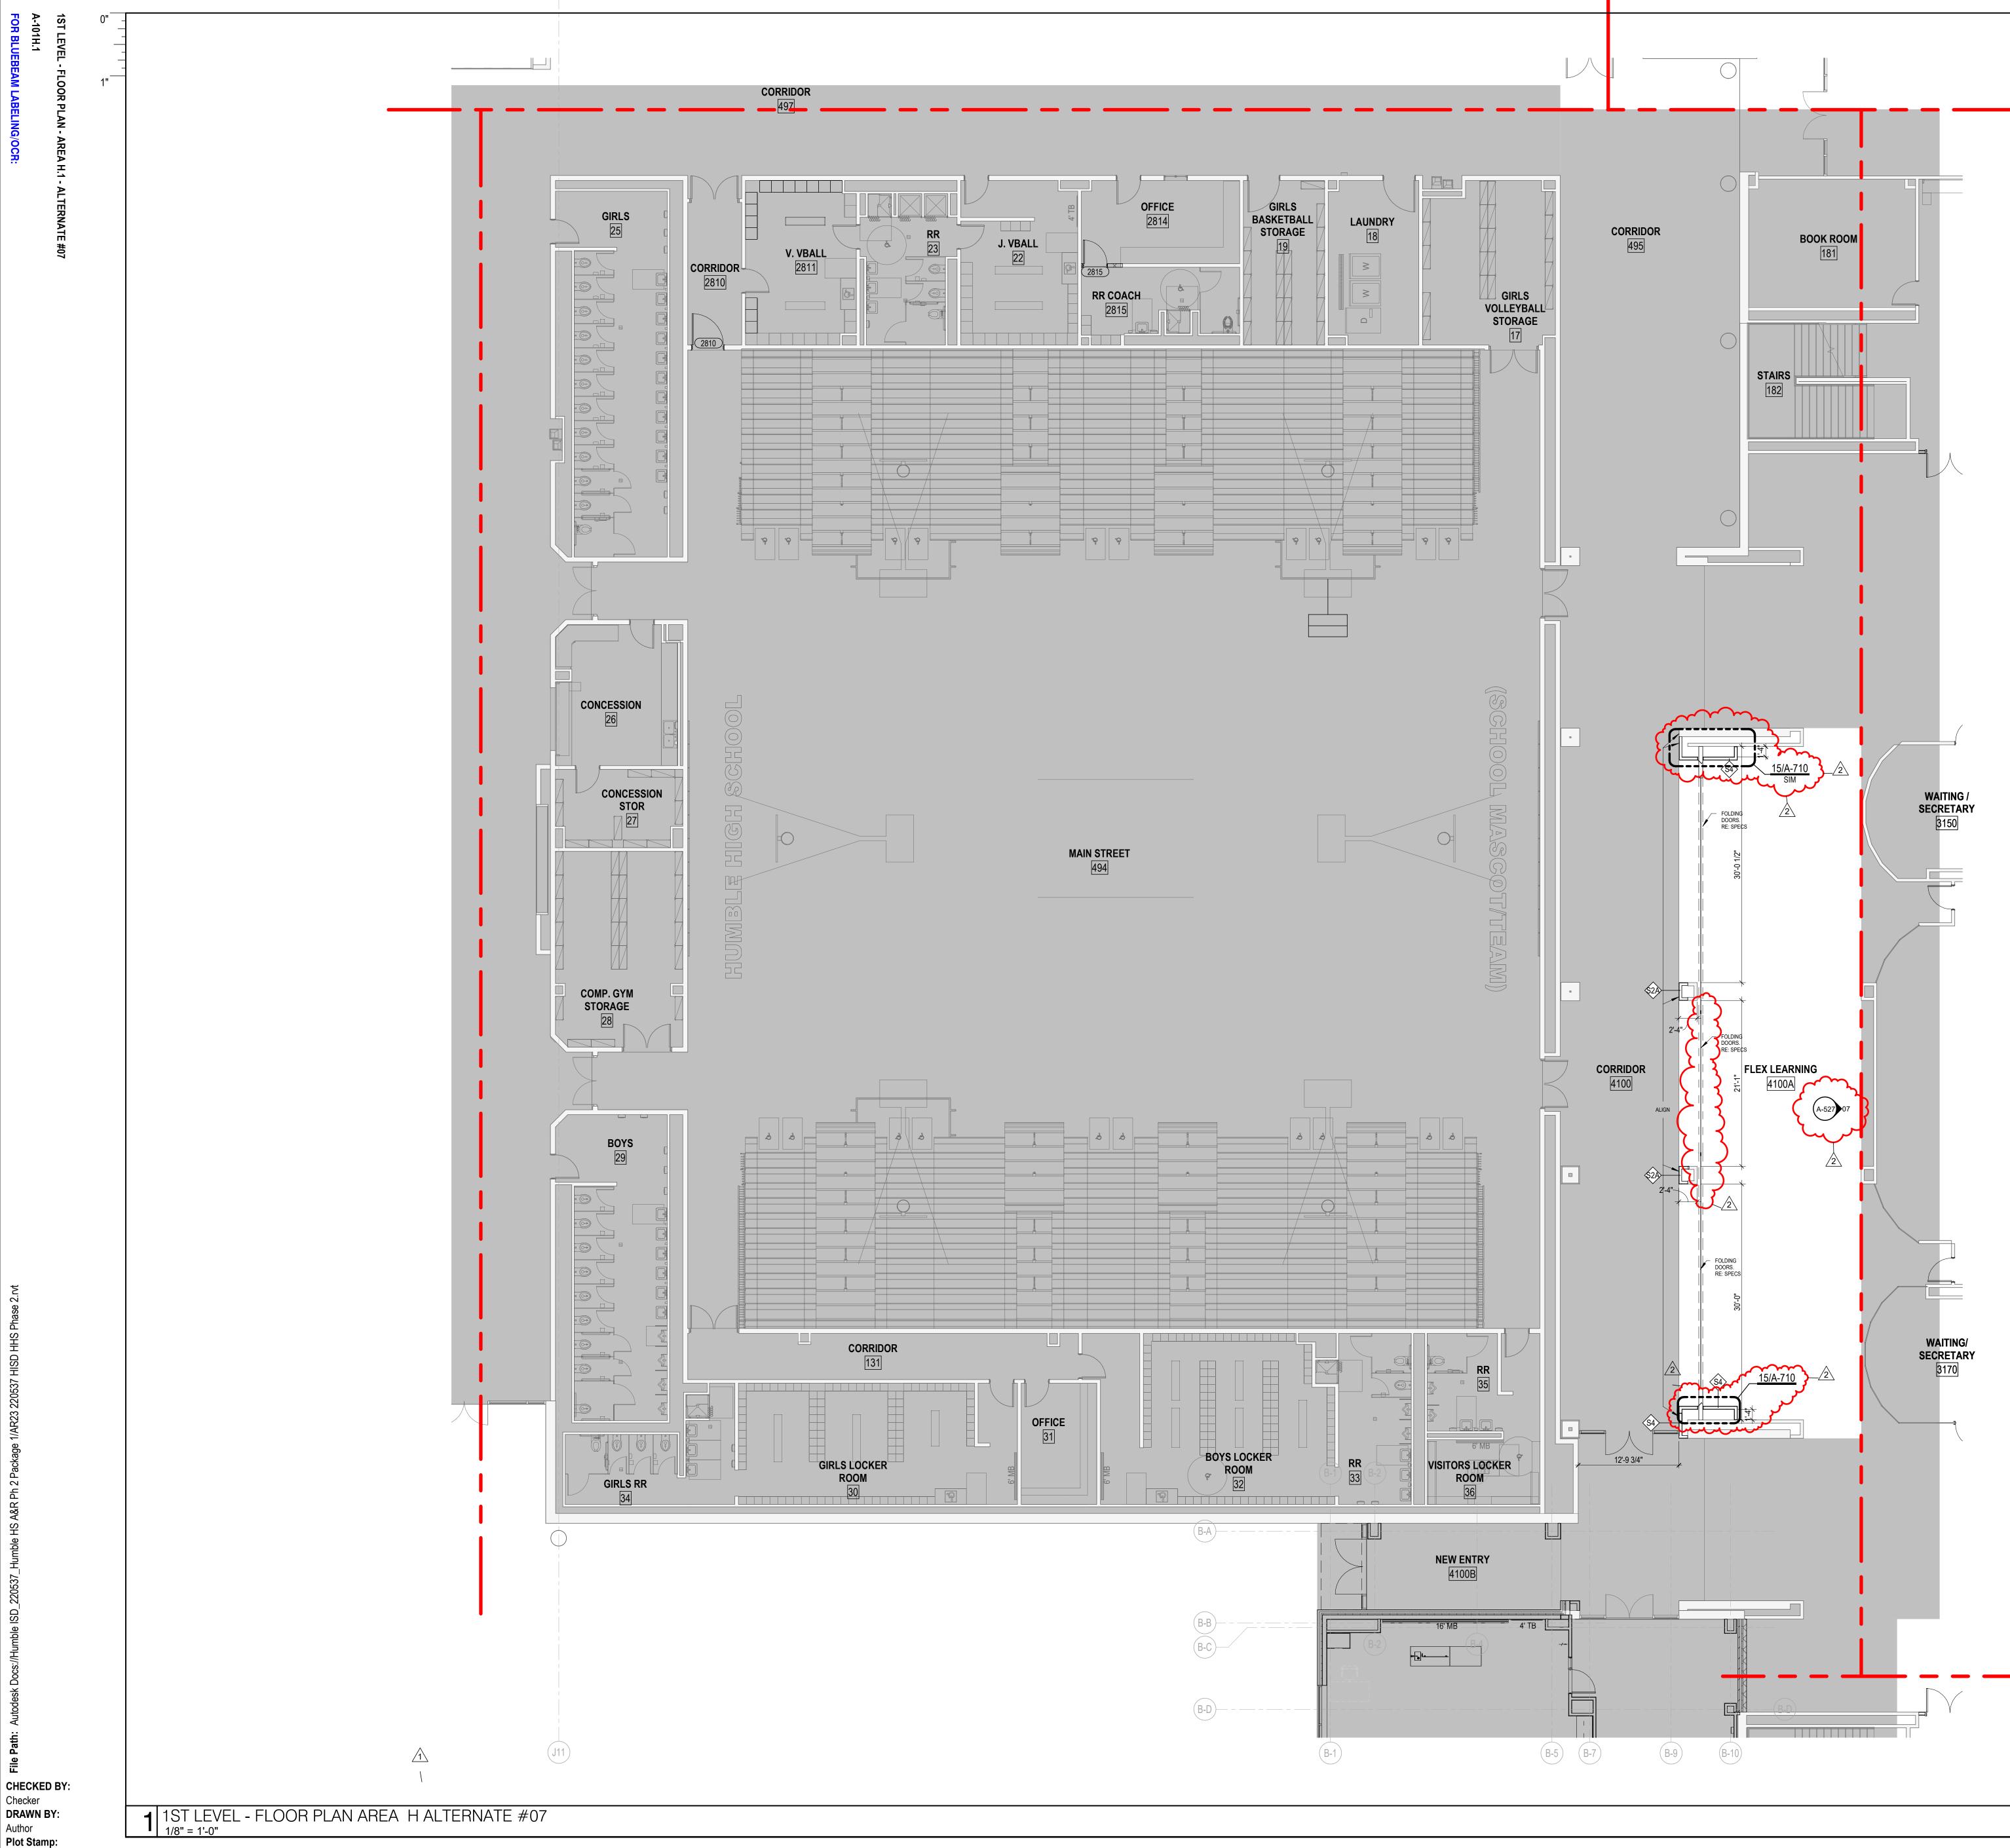


Author Plot Stamp: 1/10/2025 2:45:46 PM

GENERAL ARCH PLAN NOTES

- I. DO NOT SCALE DRAWINGS, WRITTEN DIMENSIONS TAKE PRECEDENCE, CONTACT ARCH IF CLARIFICATION IS NECESSARY IN ORDER TO DETERMINE THE INTENT OF THE CONTRACT DOCUMENTS
- 2. DRAWINGS NOTED AS "N.T.S" OR "NTS" ARE NOT TO SCALE 3. ALL DIMENSIONS ARE TO STRUCTURAL COLUMN LINES OR THE SURFACE OF PARTITION ASSEMBLY U.N.O. FIELD VERIFY ALL DIMENSIONS AND EXISTING CONDITIONS BEFORE COMMENCING WORK. NOTIFY
- ARCH. OF ANY DISCREPANCIES PRIOR TO PROCEEDING WITH AFFECTED WORK 5. NOTES OR DIMENSIONS NOTED AS "TYPICAL" OR "TYP." OR "TYP" SHALL APPLY TO CONDITIONS THAT
- ARE THE SAME OR SIMILAR 6. DIMENSIONS NOTED AS "FIELD VERIFY" OR "V.I.F." OR "VIF" SHALL BE MEASURED AND CONFIRMED AT THE PROJECT SITE BY THE CONTRACTOR AND REVIEWED WITH THE ARCH. BEFORE INCORPORATING
- INTO THE WORK DIMENSIONS NOTED AS "CLEAR" OR "CLEAR INSIDE" REQUIRE SPECIFIC COORDINATION AMONG
- DISCIPLINES AND OR MANUFACTURERS 3. REFER TO PARTITION TYPES ON A801 SERIES SHEETS 9. ALL INTERIOR PARTITIONS THIS SHEET, EXCEPT FOR FURR-OUT PARTITIONS, SHALL BE PARTITION
- TYPE S3 U.N.O. 10. ALL INTERIOR FURR-OUT PARTITIONS THIS SHEET SHALL BE PARTITION TYPE S5 U.N.O. 11. ALIGN FINISHED FACE OF WALLS WHERE WALL PARTITIONS OF DIFFERING THICKNESS ABUT AND OR ADJOIN IN THE SAME PLANE
- 12. PROVIDE AND INSTALL CONT. REVEAL TRIM AT JOINT WHERE GYPSUM BOARD WALL PARTITIONS ABUT AND OR ADJOIN MASONRY WALL PARTITIONS IN THE SAME PLANE 13. ALL INTERIOR CMU OUTSIDE CORNERS SHALL HAVE BULLNOSE U.N.O.
- 14. ALL DOORS SHALL BE SET 6 INCHES OFF THE ADJACENT PERPENDICULAR WALL ON THE HINGE SIDE OF THE DOOR U.N.O., NOTIFY ARCH. OF ANY DOOR-RELATED CONFLICTS, INCLUDING BUT NOT LIMITED TO CONFLICTS CONCERNING ACCESSIBILITY STANDARDS 15. ALL DOOR THRESHOLDS AT ALL EXTERIOR DOORS SHALL BE SET IN FULL BED OF SEALANT
- 16. COORD. ALL ROOF DRAIN LEADER LOCATIONS WITH FLOOR PLAN PRIOR TO FLOOR SLAB CONSTRUCTION 17. ALL FLOOR SLOPES TO FLOOR DRAINS SHALL NOT EXCEED 1:48
- 18. PROVIDE AND INSTALL SELF-LEVELING UNDERLAYMENT WHERE UNEVEN FLOOR SLAB EXISTS PRIOR TO INSTALLATION OF FLOOR FINISHES 19. COORD. HOUSEKEEPING PAD LOCATIONS AND DIMENSIONS WITH EQUIPMENT TO BE INSTALLED 20. ALL FLOOR FINISH CHANGES SHALL OCCUR AT THE CENTERLINE OF DOORS U.N.O.
- 21. ALL FLOOR FINISH MATERIAL CHANGES SHALL HAVE REDUCER STRIPS 22. ALL REQUIRED ACCESSIBLE CLEARANCES FOR ALL ITEMS, INCLUDING BUT NOT LIMITED TO ALL COUNTER TOPS, ALL PLUMBING FIXTURES, ALL DRINKING FOUNTAINS, ALL ELECTRIC WATER
- COOLERS, ALL LAVATORIES, ALL URINALS, ALL TOILETS SHALL BE STRICTLY ENFORCED 23. APPLY BITUMINOUS COATING TO ALL CONCEALED STRUCTURAL STEEL MEMBERS AT ALL EXTERIOR CANOPY LOCATIONS
- 24. REFER TO OTHER DISCIPLINE DOCUMENTS FOR ADDITIONAL SCOPE OF WORK 25. PROVIDE PLYWOOD IN METAL STUD WALL PARTITION FOR SUPPORT OF ALL TV LOCATIONS.


NUMBER

KEYNOTE LEGEND DESCRIPTION

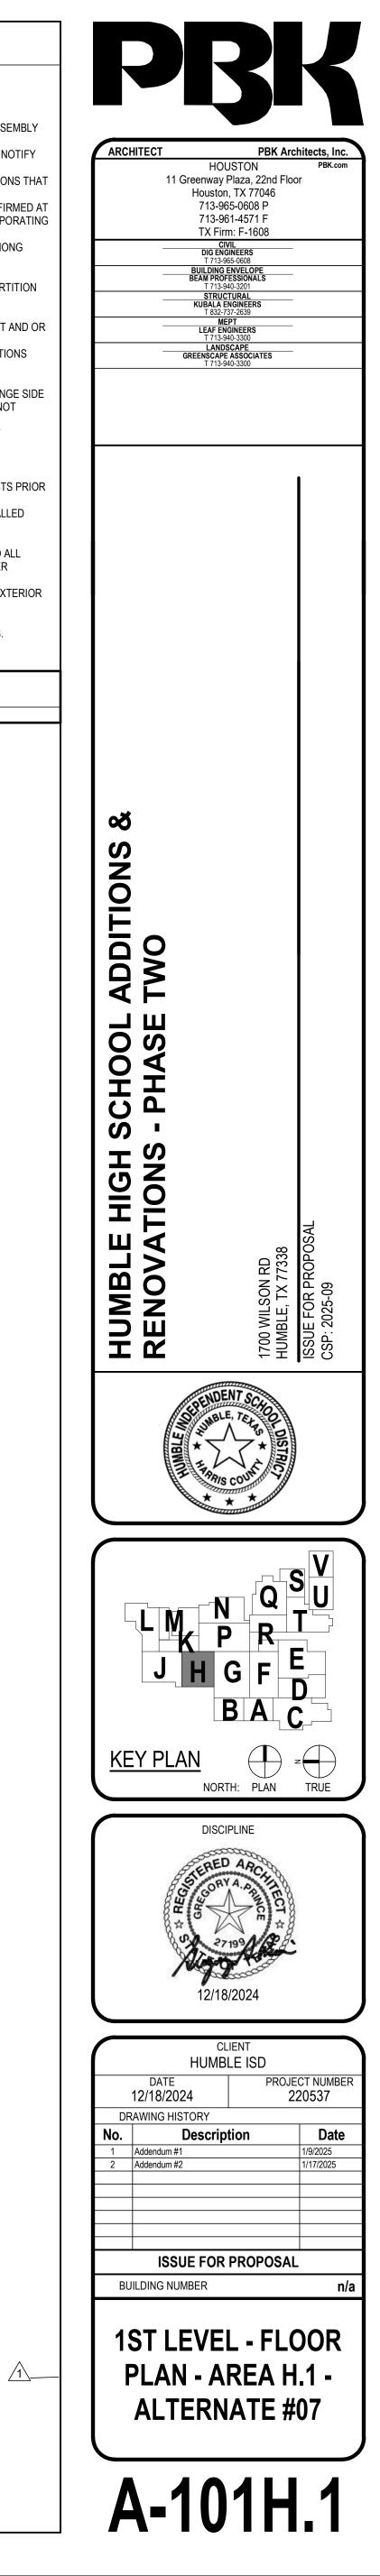

A-101K FOR BLUEBEAM LABELING/OCR:

-	DOOR SCHEDULE AREA K															
-	DATA			PAN	EL					FR/	AME					GENERAL
_												DETAILS	i			
MARK	NAME	WIDTH	HEIGHT	ELEVATION	THK	MATERIAL	FINISH	TYPE	MATERIAL	FINISH	SILL	HEAD	JAMB	FIRE RATING	HARDWARE	REMARKS
2841	COACH RR	3'-0"	6'-10"	F	1 3/4"	SCPL	PLAM	001	HM	PAINTED	H-21/A-832	23/A-832	22/A-832		38.0	
4141	BOYS TENNIS, WRESTLING, JROTC	3'-0"	6'-10"	F	1 3/4"	SCPL	PLAM	001	HM	PAINTED	01/A-832	23/A-832	22/A-832		38.0	
4142A1	VESTIBULE	3'-0"	6'-10"	F	1 3/4"	SCPL	PLAM	001	HM	PAINTED	H-21/A-832	23/A-832	22/A-832		39.0	
4142A2	BOYS TENNIS, WRESTLING, JROTC	3'-0"	6'-10"	F	1 3/4"	SCPL	PLAM	001	HM	PAINTED	01/A-832	23/A-832	22/A-832		38.0	
4142B1	VESTIBULE	3'-0"	6'-10"	F	1 3/4"	SCPL	PLAM	001	HM	PAINTED	H-21/A-832	23/A-832	22/A-832		39.0	
4142B2	BOYS TENNIS, WRESTLING, JROTC	3'-0"	6'-10"	F	1 3/4"	SCPL	PLAM	001	HM	PAINTED	01/A-832	23/A-832	22/A-832		38.0	
4148	RR	3'-0"	6'-10"	F	1 3/4"	SCPL	PLAM	001	HM	PAINTED	01/A-832	23/A-832	22/A-832		38.0	
A129B	OUTDOOR WORKOUT	3'-0"	6'-10"	F	1 3/4"	HM	PAINTED	001	HM	PAINTED	01/A-831	07/A-831	13/A-831		6.0	

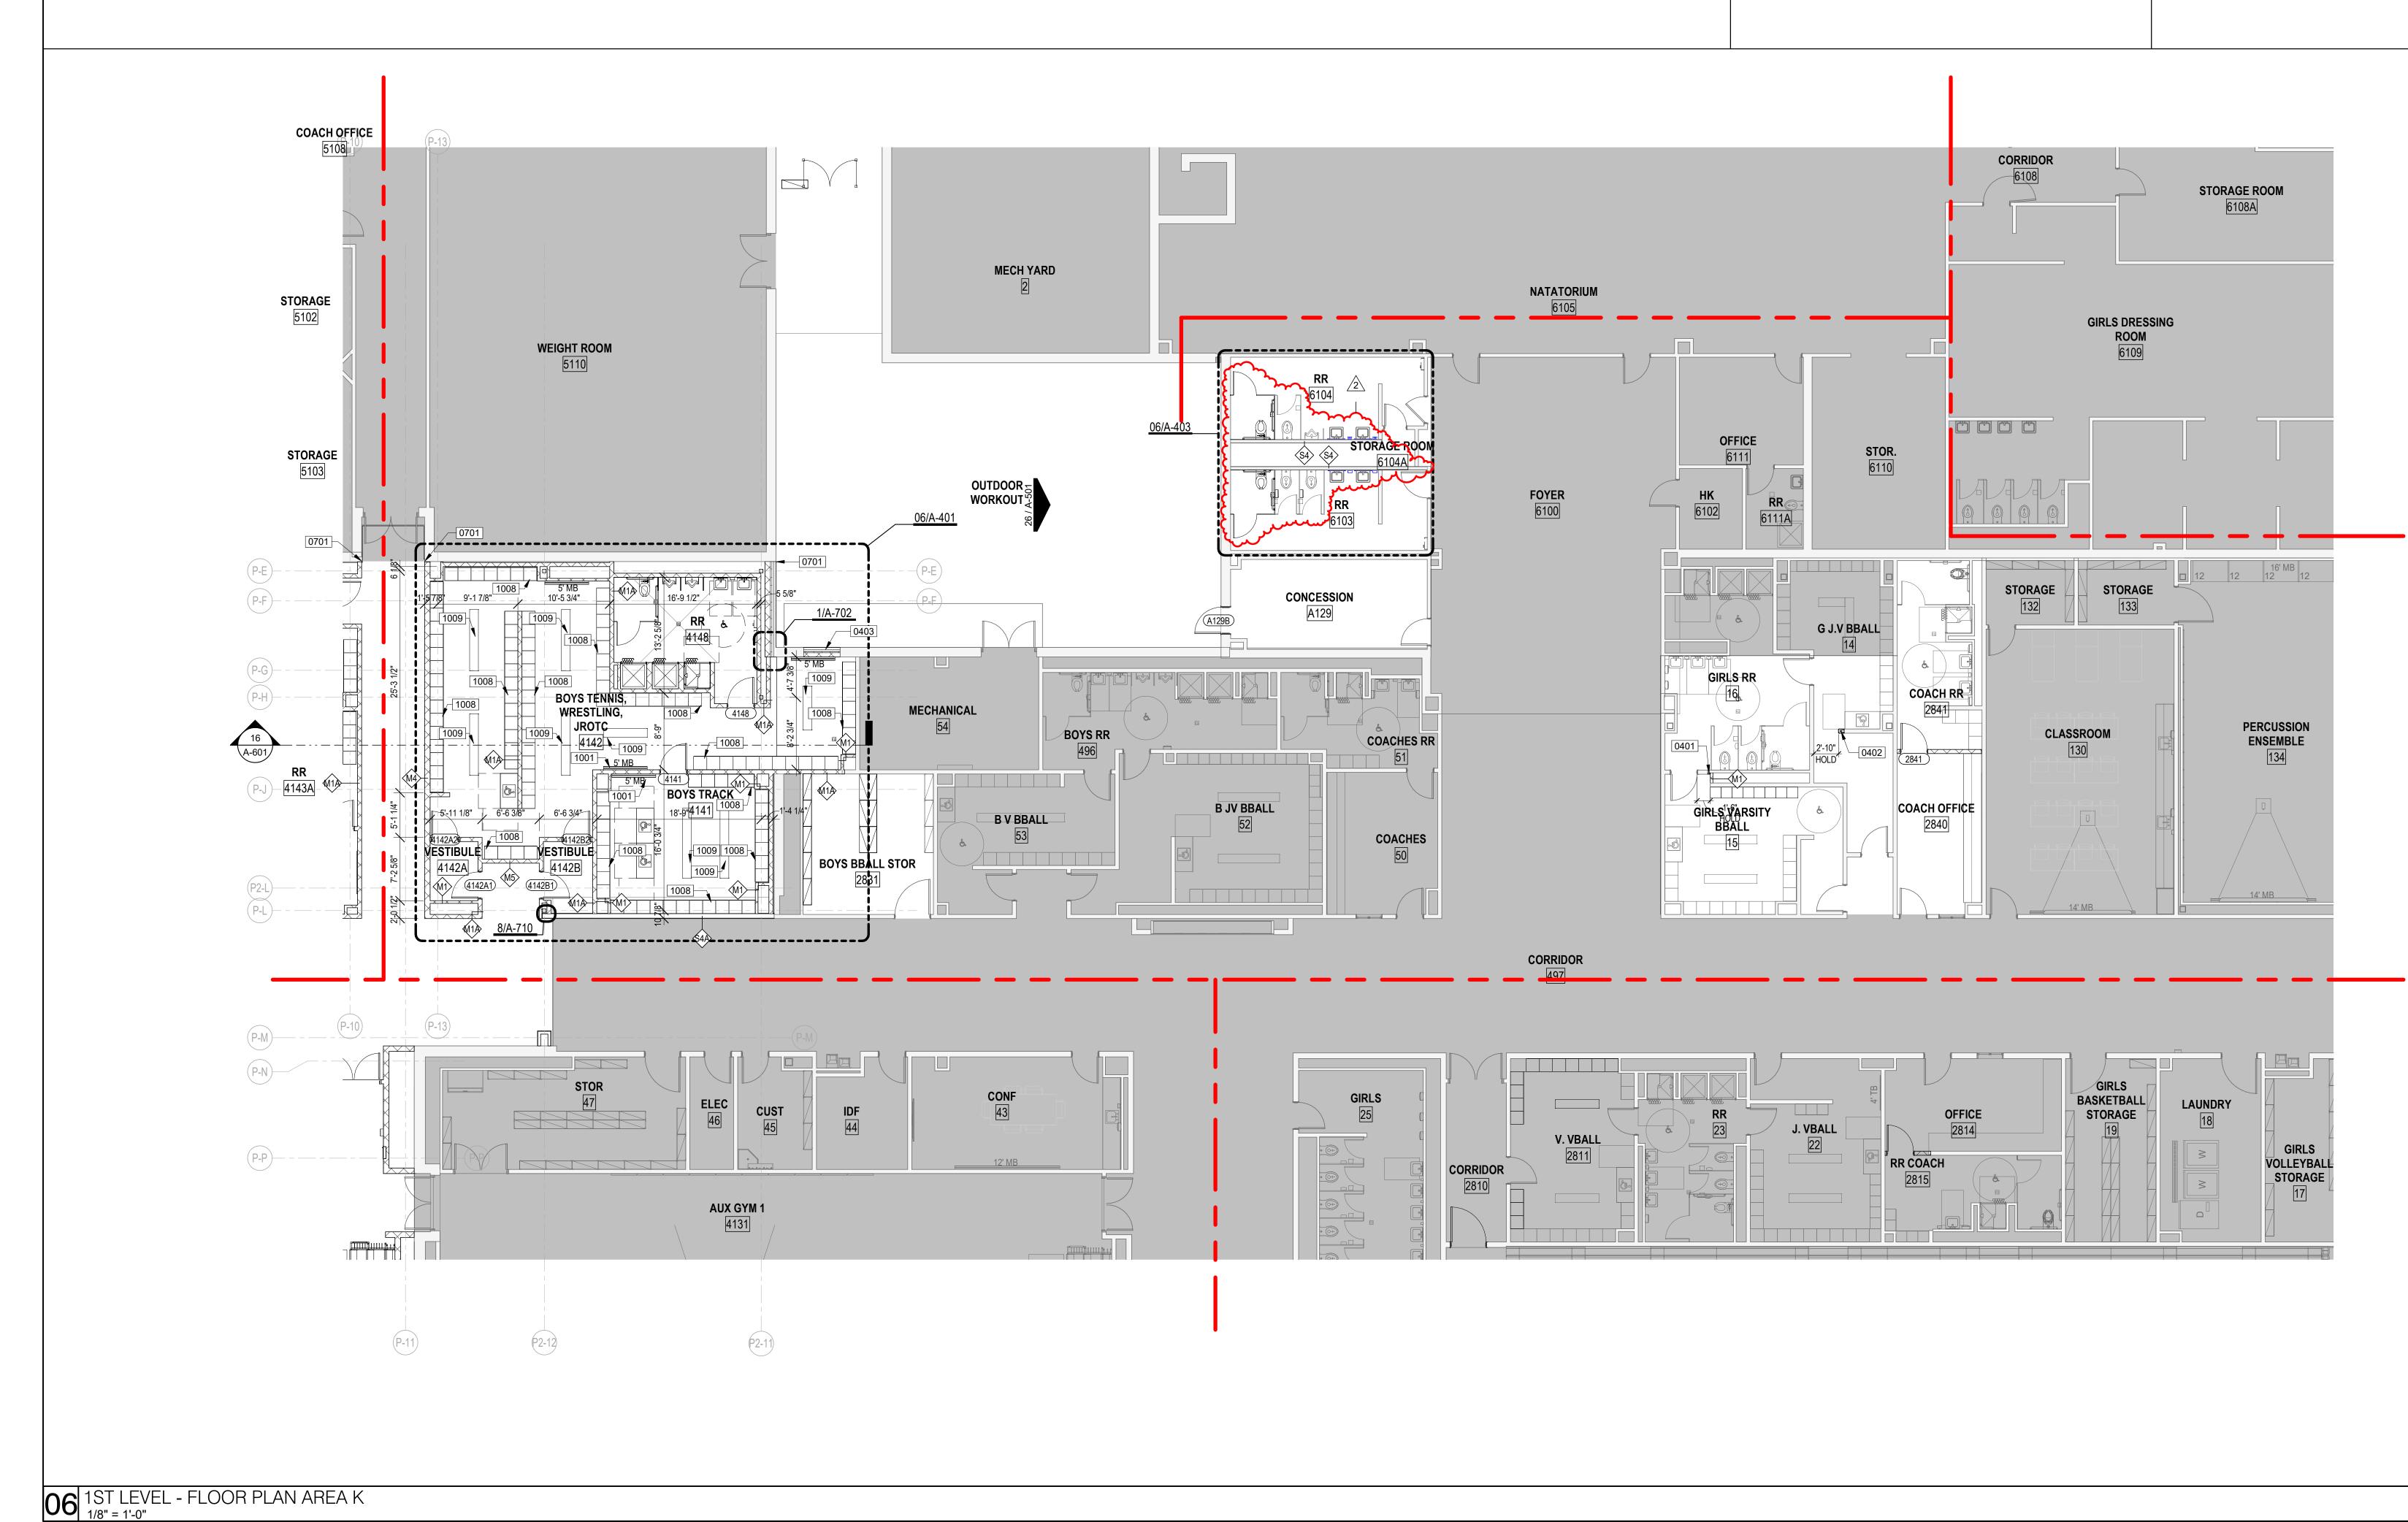

 HISD H

 File Path:
 Autodesk Docs://Humble ISD_220537_Humble HS A&R Ph 2 Package 1/AR23 220537 HISD H


 CHECKED BY:
 CHECKED BY:


 Checker
 DRAWN BY:

 Vature
 Plot Stamb:

 1/14/5052 57:15:02 bM


GENERAL ARCH PLAN NOTES		KEYNOTE LEGEND
1. DO NOT SCALE DRAWINGS, WRITTEN DIMENSIONS TAKE PRECEDENCE, CONTACT ARCH IF	NUMBER	DESCRIPTION
CLARIFICATION IS NECESSARY IN ORDER TO DETERMINE THE INTENT OF THE CONTRACT		
DOCUMENTS	0401	PROVIDE 2" NOM. SOLID CMU INFILL. PAINT TO MATCH EXISTING WALL
DRAWINGS NOTED AS "N.T.S" OR "NTS" ARE NOT TO SCALE ALL DIMENSIONS ARE TO STRUCTURAL COLUMN LINES OR THE SURFACE OF PARTITION ASSEMBLY	0402	PROVIDE 6"X8" NOM. CMU BOND BEAM WITH BULLNOSE CORNERS AS INDICATED. R TO STRUCT. DWGS. FOR ADDITONAL INFORMATION
N.O. ELD VERIFY ALL DIMENSIONS AND EXISTING CONDITIONS BEFORE COMMENCING WORK. NOTIFY RCH. OF ANY DISCREPANCIES PRIOR TO PROCEEDING WITH AFFECTED WORK	0403	INFILL WITH EXTERIOR BRICK WALL ON 6" CMU BACK-UP. BRICK SIZE, TYPE AND CO MATCH EXISTING. PROVIDE MOISTURE BARRIER AT EXTERIOR FACE OF CMU. PROV 2"THICK RIGID INSULATION OVER MOISUTRE BARRIER.
OTES OR DIMENSIONS NOTED AS "TYPICAL" OR "TYP." OR "TYP" SHALL APPLY TO CONDITIONS THAT	0701	PROVIDE EXPANSION JOINT W/ COVER
ARE THE SAME OR SIMILAR	1001	WALL MOUNTED MARKERBOARD; RE: SPECS
DIMENSIONS NOTED AS "FIELD VERIFY" OR "V.I.F." OR "VIF" SHALL BE MEASURED AND CONFIRMED AT	1008	LOCKERS, TYP; RE: PLAN AND 24/A-401 FOR TYPE; RE: SPECS
THE PROJECT SITE BY THE CONTRACTOR AND REVIEWED WITH THE ARCH. BEFORE INCORPORATING INTO THE WORK	1009	LOCKER ROOM BENCH; RE: SPECS
IENSIONS NOTED AS "CLEAR" OR "CLEAR INSIDE" REQUIRE SPECIFIC COORDINATION AMONG		
ISCIPLINES AND OR MANUFACTURERS		
REFER TO PARTITION TYPES ON A801 SERIES SHEETS		
ALL INTERIOR PARTITIONS THIS SHEET, EXCEPT FOR FURR-OUT PARTITIONS, SHALL BE PARTITION		
TYPE S3 U.N.O.		
ALL INTERIOR FURR-OUT PARTITIONS THIS SHEET SHALL BE PARTITION TYPE S5 U.N.O. ALIGN FINISHED FACE OF WALLS WHERE WALL PARTITIONS OF DIFFERING THICKNESS ABUT AND OR		
ADJOIN IN THE SAME PLANE		
PROVIDE AND INSTALL CONT. REVEAL TRIM AT JOINT WHERE GYPSUM BOARD WALL PARTITIONS		
ABUT AND OR ADJOIN MASONRY WALL PARTITIONS IN THE SAME PLANE		
ALL INTERIOR CMU OUTSIDE CORNERS SHALL HAVE BULLNOSE U.N.O.		
ALL DOORS SHALL BE SET 6 INCHES OFF THE ADJACENT PERPENDICULAR WALL ON THE HINGE SIDE DF THE DOOR U.N.O., NOTIFY ARCH. OF ANY DOOR-RELATED CONFLICTS, INCLUDING BUT NOT		
IMITED TO CONFLICTS CONCERNING ACCESSIBILITY STANDARDS		
5. ALL DOOR THRESHOLDS AT ALL EXTERIOR DOORS SHALL BE SET IN FULL BED OF SEALANT 5. COORD. ALL ROOF DRAIN LEADER LOCATIONS WITH FLOOR PLAN PRIOR TO FLOOR SLAB		
CONSTRUCTION		
. ALL FLOOR SLOPES TO FLOOR DRAINS SHALL NOT EXCEED 1:48		
3. PROVIDE AND INSTALL SELF-LEVELING UNDERLAYMENT WHERE UNEVEN FLOOR SLAB EXISTS PRIOR TO INSTALLATION OF FLOOR FINISHES		
COORD. HOUSEKEEPING PAD LOCATIONS AND DIMENSIONS WITH EQUIPMENT TO BE INSTALLED		
0. ALL FLOOR FINISH CHANGES SHALL OCCUR AT THE CENTERLINE OF DOORS U.N.O.		
1. ALL FLOOR FINISH MATERIAL CHANGES SHALL HAVE REDUCER STRIPS		
2. ALL REQUIRED ACCESSIBLE CLEARANCES FOR ALL ITEMS, INCLUDING BUT NOT LIMITED TO ALL		
COUNTER TOPS, ALL PLUMBING FIXTURES, ALL DRINKING FOUNTAINS, ALL ELECTRIC WATER		
COOLERS, ALL LAVATORIES, ALL URINALS, ALL TOILETS SHALL BE STRICTLY ENFORCED 3. APPLY BITUMINOUS COATING TO ALL CONCEALED STRUCTURAL STEEL MEMBERS AT ALL EXTERIOR		
CANOPY LOCATIONS		
24. REFER TO OTHER DISCIPLINE DOCUMENTS FOR ADDITIONAL SCOPE OF WORK		
5. PROVIDE PLYWOOD IN METAL STUD WALL PARTITION FOR SUPPORT OF ALL TV LOCATIONS.		

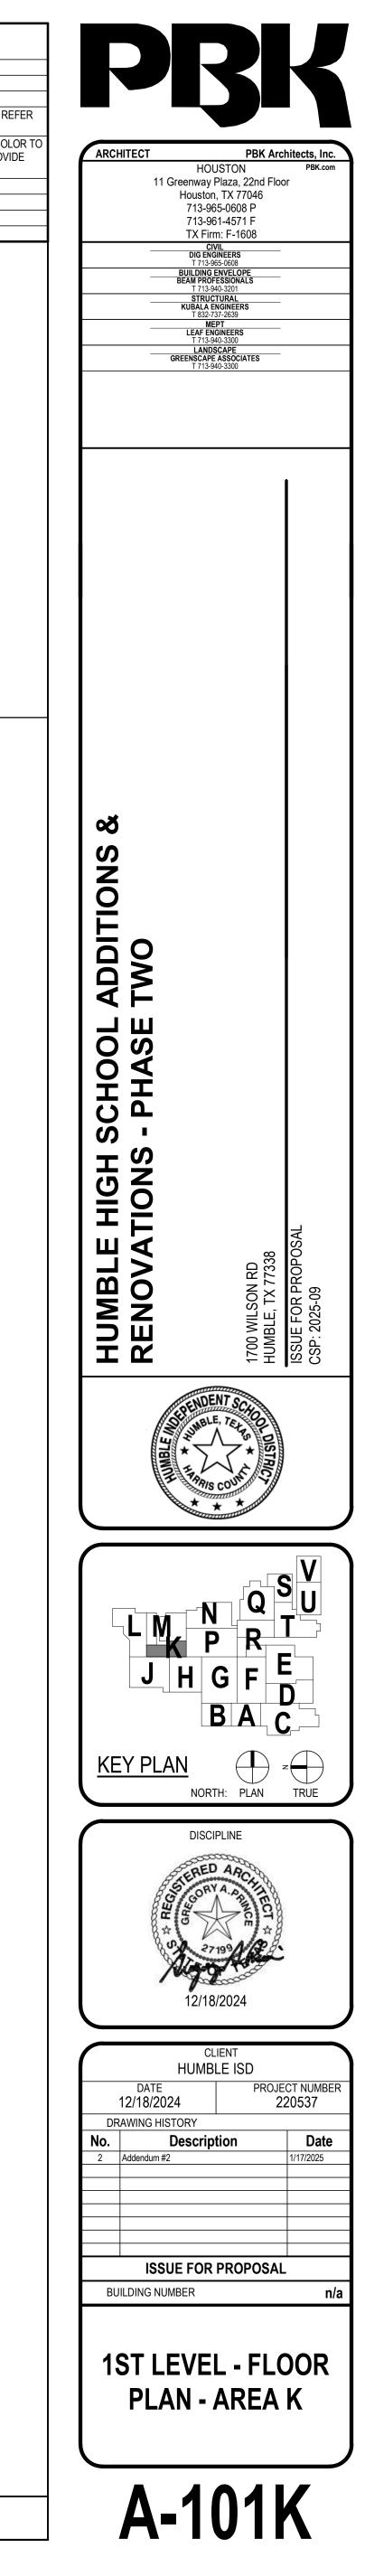


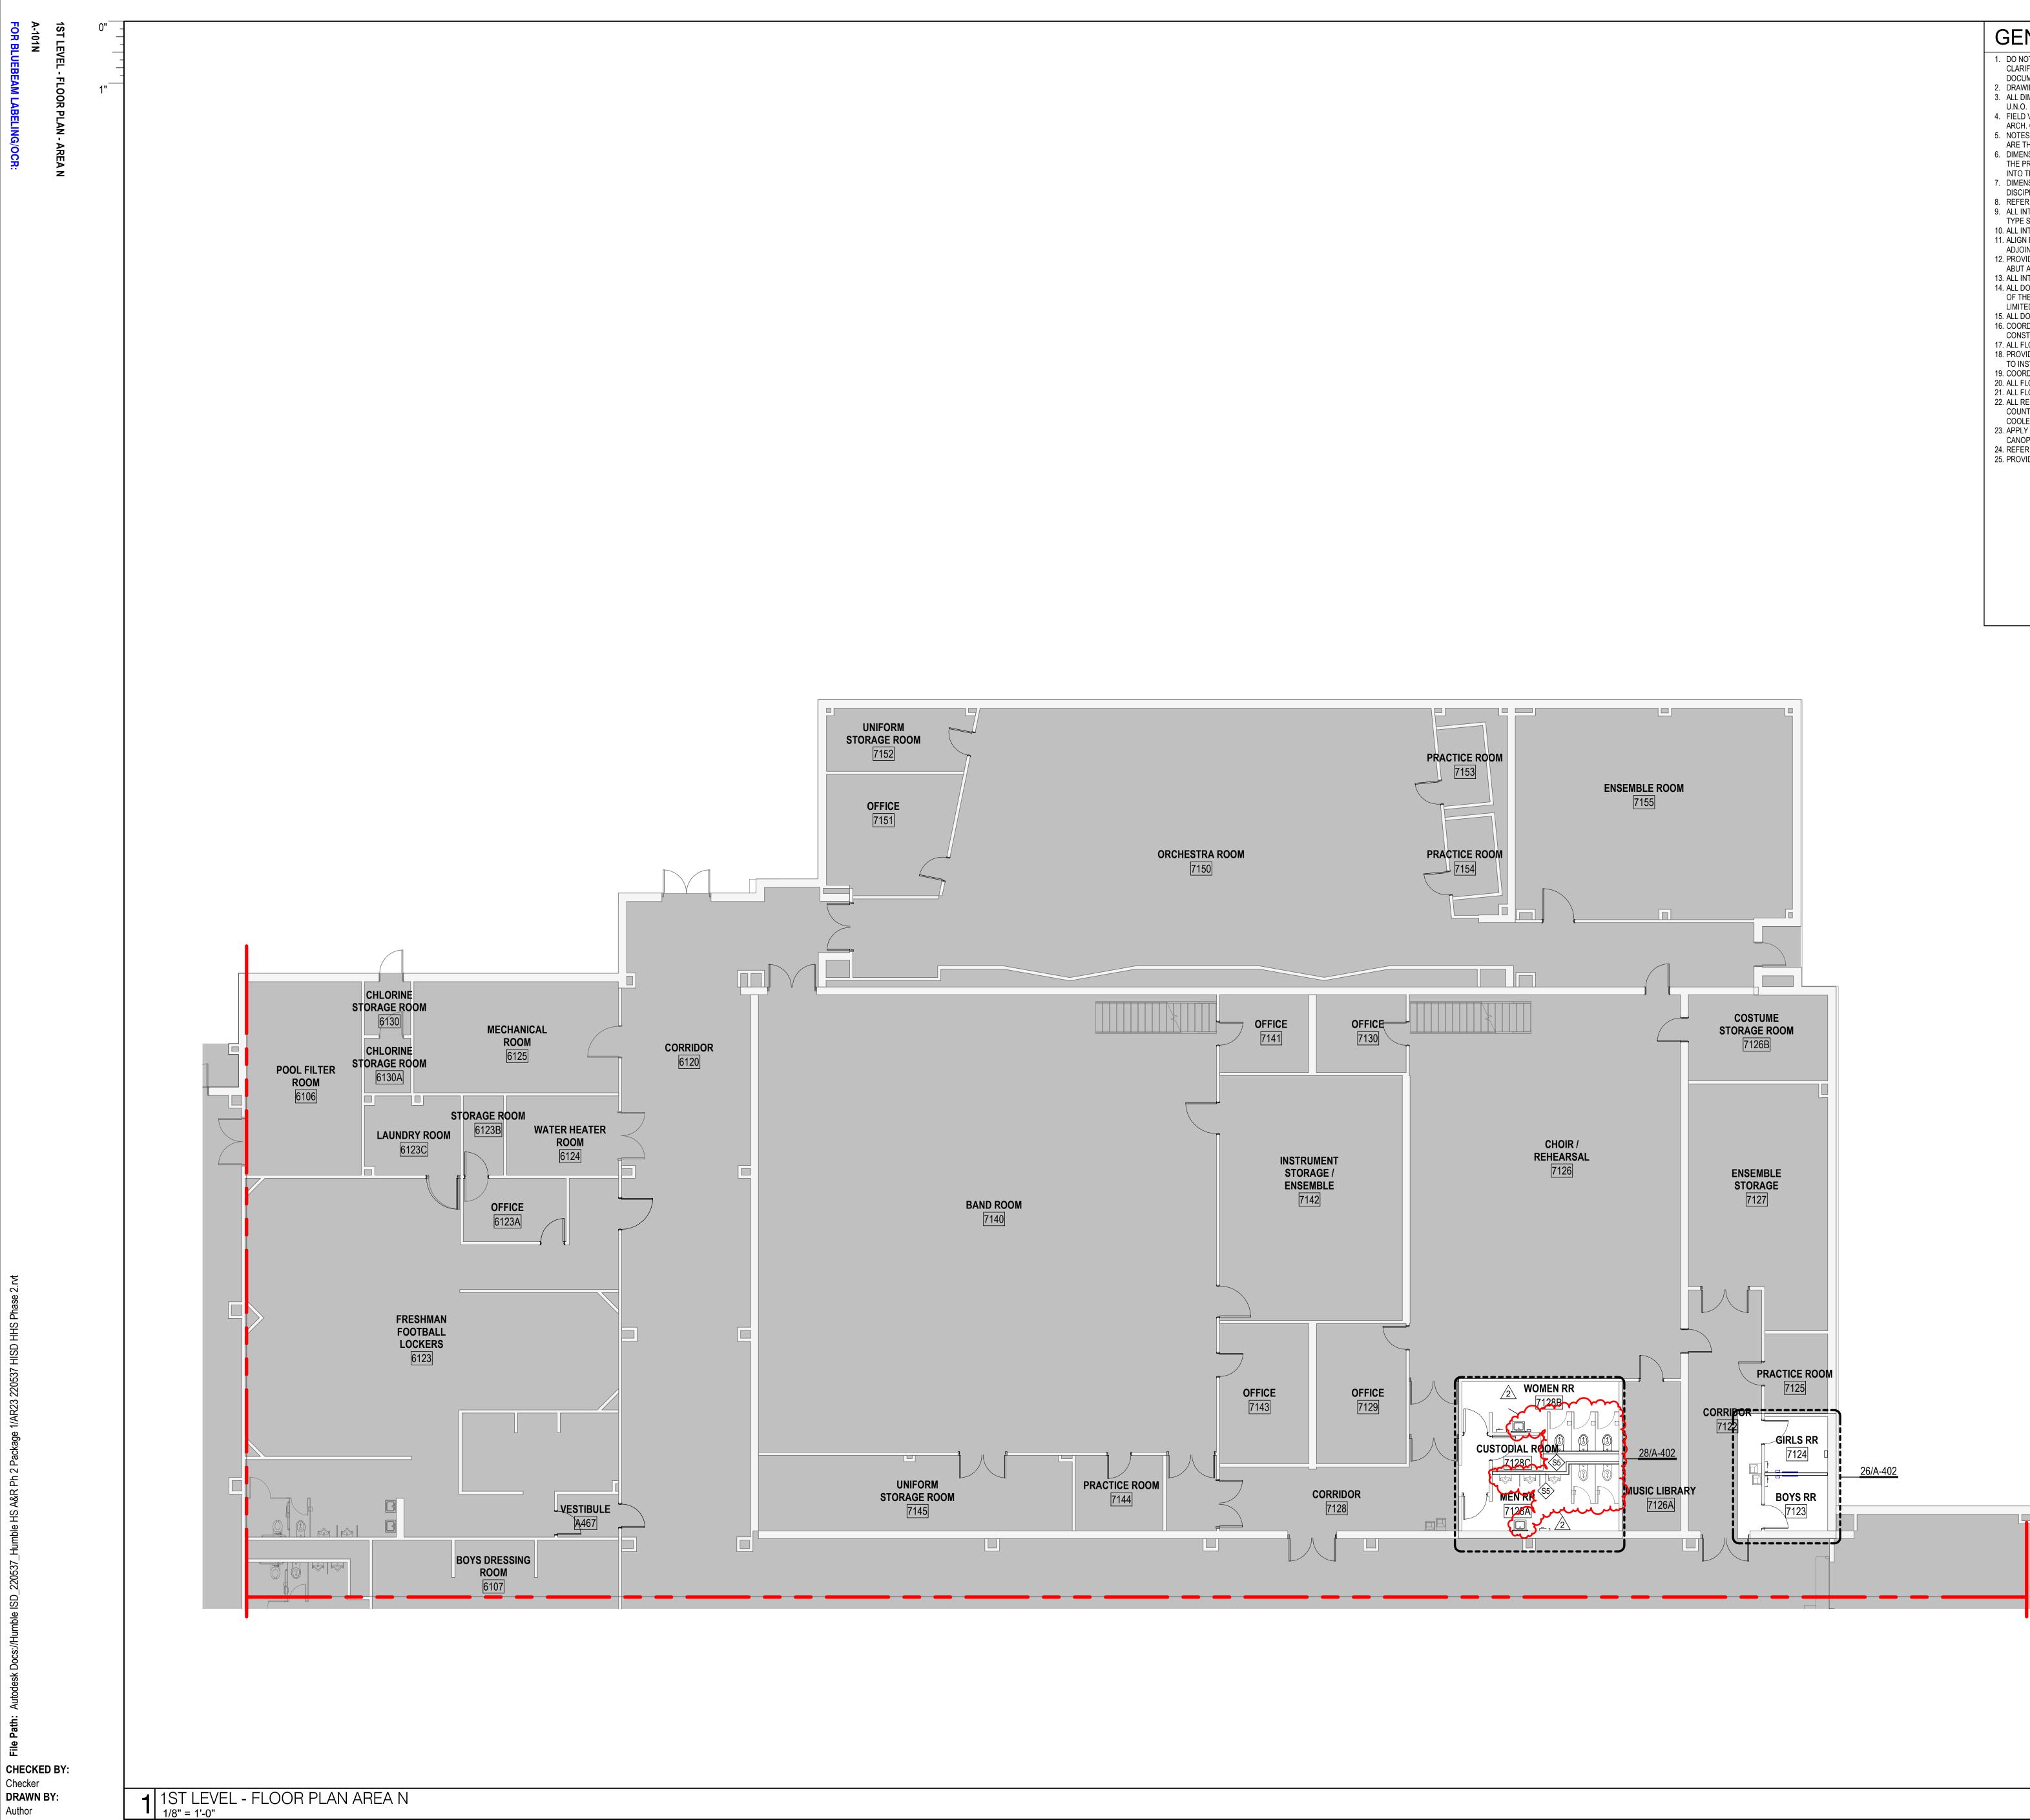

Author Plot Stamp: 1/14/2025 2:51:54 PM

GENERAL ARCH PLAN NOTES 1. DO NOT SCALE DRAWINGS, WRITTEN DIMENSIONS TAKE PRECEDENCE, CONTACT ARCH IF CLARIFICATION IS NECESSARY IN ORDER TO DETERMINE THE INTENT OF THE CONTRACT DOCUMENTS 2. DRAWINGS NOTED AS "N.T.S" OR "NTS" ARE NOT TO SCALE 3. ALL DIMENSIONS ARE TO STRUCTURAL COLUMN LINES OR THE SURFACE OF PARTITION ASSEMBLY U.N.O. 4. FIELD VERIFY ALL DIMENSIONS AND EXISTING CONDITIONS BEFORE COMMENCING WORK. NOTIFY ARCH. OF ANY DISCREPANCIES PRIOR TO PROCEEDING WITH AFFECTED WORK 5. NOTES OR DIMENSIONS NOTED AS "TYPICAL" OR "TYP." OR "TYP" SHALL APPLY TO CONDITIONS THAT ARE THE SAME OR SIMILAR 6. DIMENSIONS NOTED AS "FIELD VERIFY" OR "V.I.F." OR "VIF" SHALL BE MEASURED AND CONFIRMED AT THE PROJECT SITE BY THE CONTRACTOR AND REVIEWED WITH THE ARCH. BEFORE INCORPORATING INTO THE WORK . DIMENSIONS NOTED AS "CLEAR" OR "CLEAR INSIDE" REQUIRE SPECIFIC COORDINATION AMONG DISCIPLINES AND OR MANUFACTURERS 8. REFER TO PARTITION TYPES ON A801 SERIES SHEETS 9. ALL INTERIOR PARTITIONS THIS SHEET, EXCEPT FOR FURR-OUT PARTITIONS, SHALL BE PARTITION TYPE S3 U.N.O. 10. ALL INTERIOR FURR-OUT PARTITIONS THIS SHEET SHALL BE PARTITION TYPE S5 U.N.O. 11. ALIGN FINISHED FACE OF WALLS WHERE WALL PARTITIONS OF DIFFERING THICKNESS ABUT AND OR ADJOIN IN THE SAME PLANE 12. PROVIDE AND INSTALL CONT. REVEAL TRIM AT JOINT WHERE GYPSUM BOARD WALL PARTITIONS ABUT AND OR ADJOIN MASONRY WALL PARTITIONS IN THE SAME PLANE 13. ALL INTERIOR CMU OUTSIDE CORNERS SHALL HAVE BULLNOSE U.N.O. 14. ALL DOORS SHALL BE SET 6 INCHES OFF THE ADJACENT PERPENDICULAR WALL ON THE HINGE SIDE OF THE DOOR U.N.O., NOTIFY ARCH. OF ANY DOOR-RELATED CONFLICTS, INCLUDING BUT NOT LIMITED TO CONFLICTS CONCERNING ACCESSIBILITY STANDARDS 15. ALL DOOR THRESHOLDS AT ALL EXTERIOR DOORS SHALL BE SET IN FULL BED OF SEALANT 16. COORD. ALL ROOF DRAIN LEADER LOCATIONS WITH FLOOR PLAN PRIOR TO FLOOR SLAB CONSTRUCTION 17. ALL FLOOR SLOPES TO FLOOR DRAINS SHALL NOT EXCEED 1:48 18. PROVIDE AND INSTALL SELF-LEVELING UNDERLAYMENT WHERE UNEVEN FLOOR SLAB EXISTS PRIOR TO INSTALLATION OF FLOOR FINISHES 19. COORD. HOUSEKEEPING PAD LOCATIONS AND DIMENSIONS WITH EQUIPMENT TO BE INSTALLED 20. ALL FLOOR FINISH CHANGES SHALL OCCUR AT THE CENTERLINE OF DOORS U.N.O. 21. ALL FLOOR FINISH MATERIAL CHANGES SHALL HAVE REDUCER STRIPS 22. ALL REQUIRED ACCESSIBLE CLEARANCES FOR ALL ITEMS, INCLUDING BUT NOT LIMITED TO ALL COUNTER TOPS, ALL PLUMBING FIXTURES, ALL DRINKING FOUNTAINS, ALL ELECTRIC WATER COOLERS, ALL LAVATORIES, ALL URINALS, ALL TOILETS SHALL BE STRICTLY ENFORCED 23. APPLY BITUMINOUS COATING TO ALL CONCEALED STRUCTURAL STEEL MEMBERS AT ALL EXTERIOR CANOPY LOCATIONS 24. REFER TO OTHER DISCIPLINE DOCUMENTS FOR ADDITIONAL SCOPE OF WORK 25. PROVIDE PLYWOOD IN METAL STUD WALL PARTITION FOR SUPPORT OF ALL TV LOCATIONS.

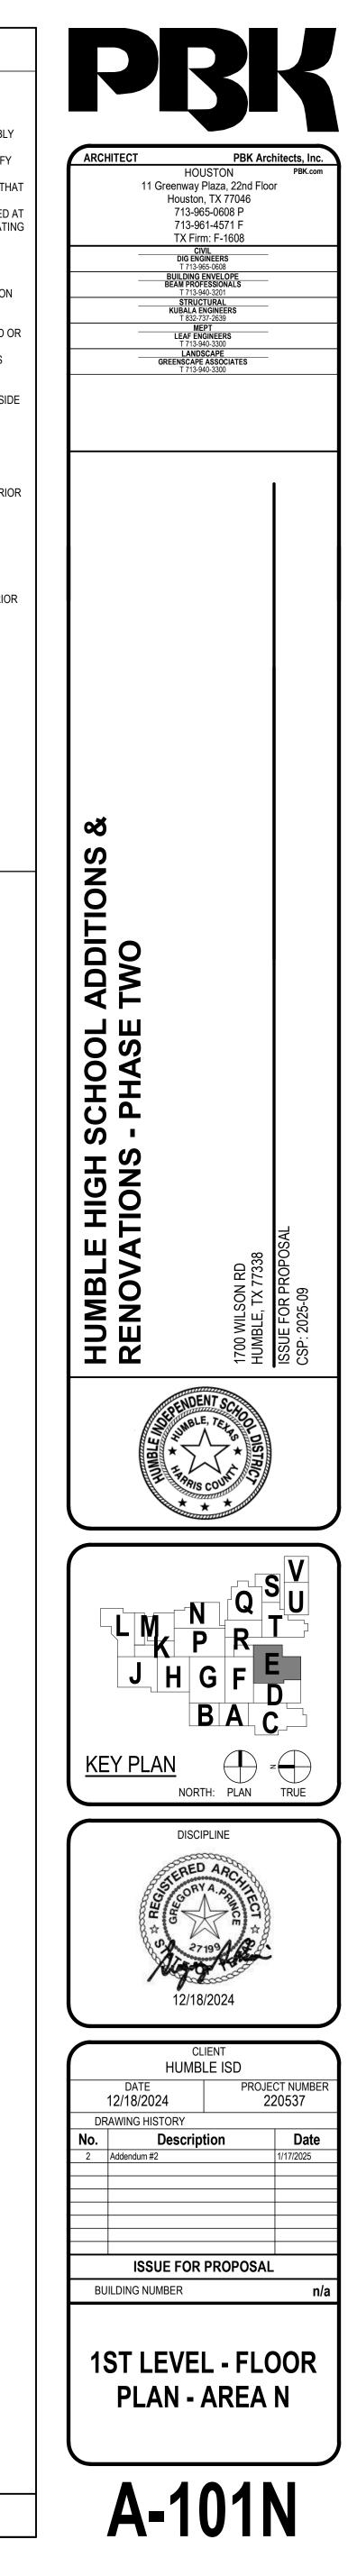

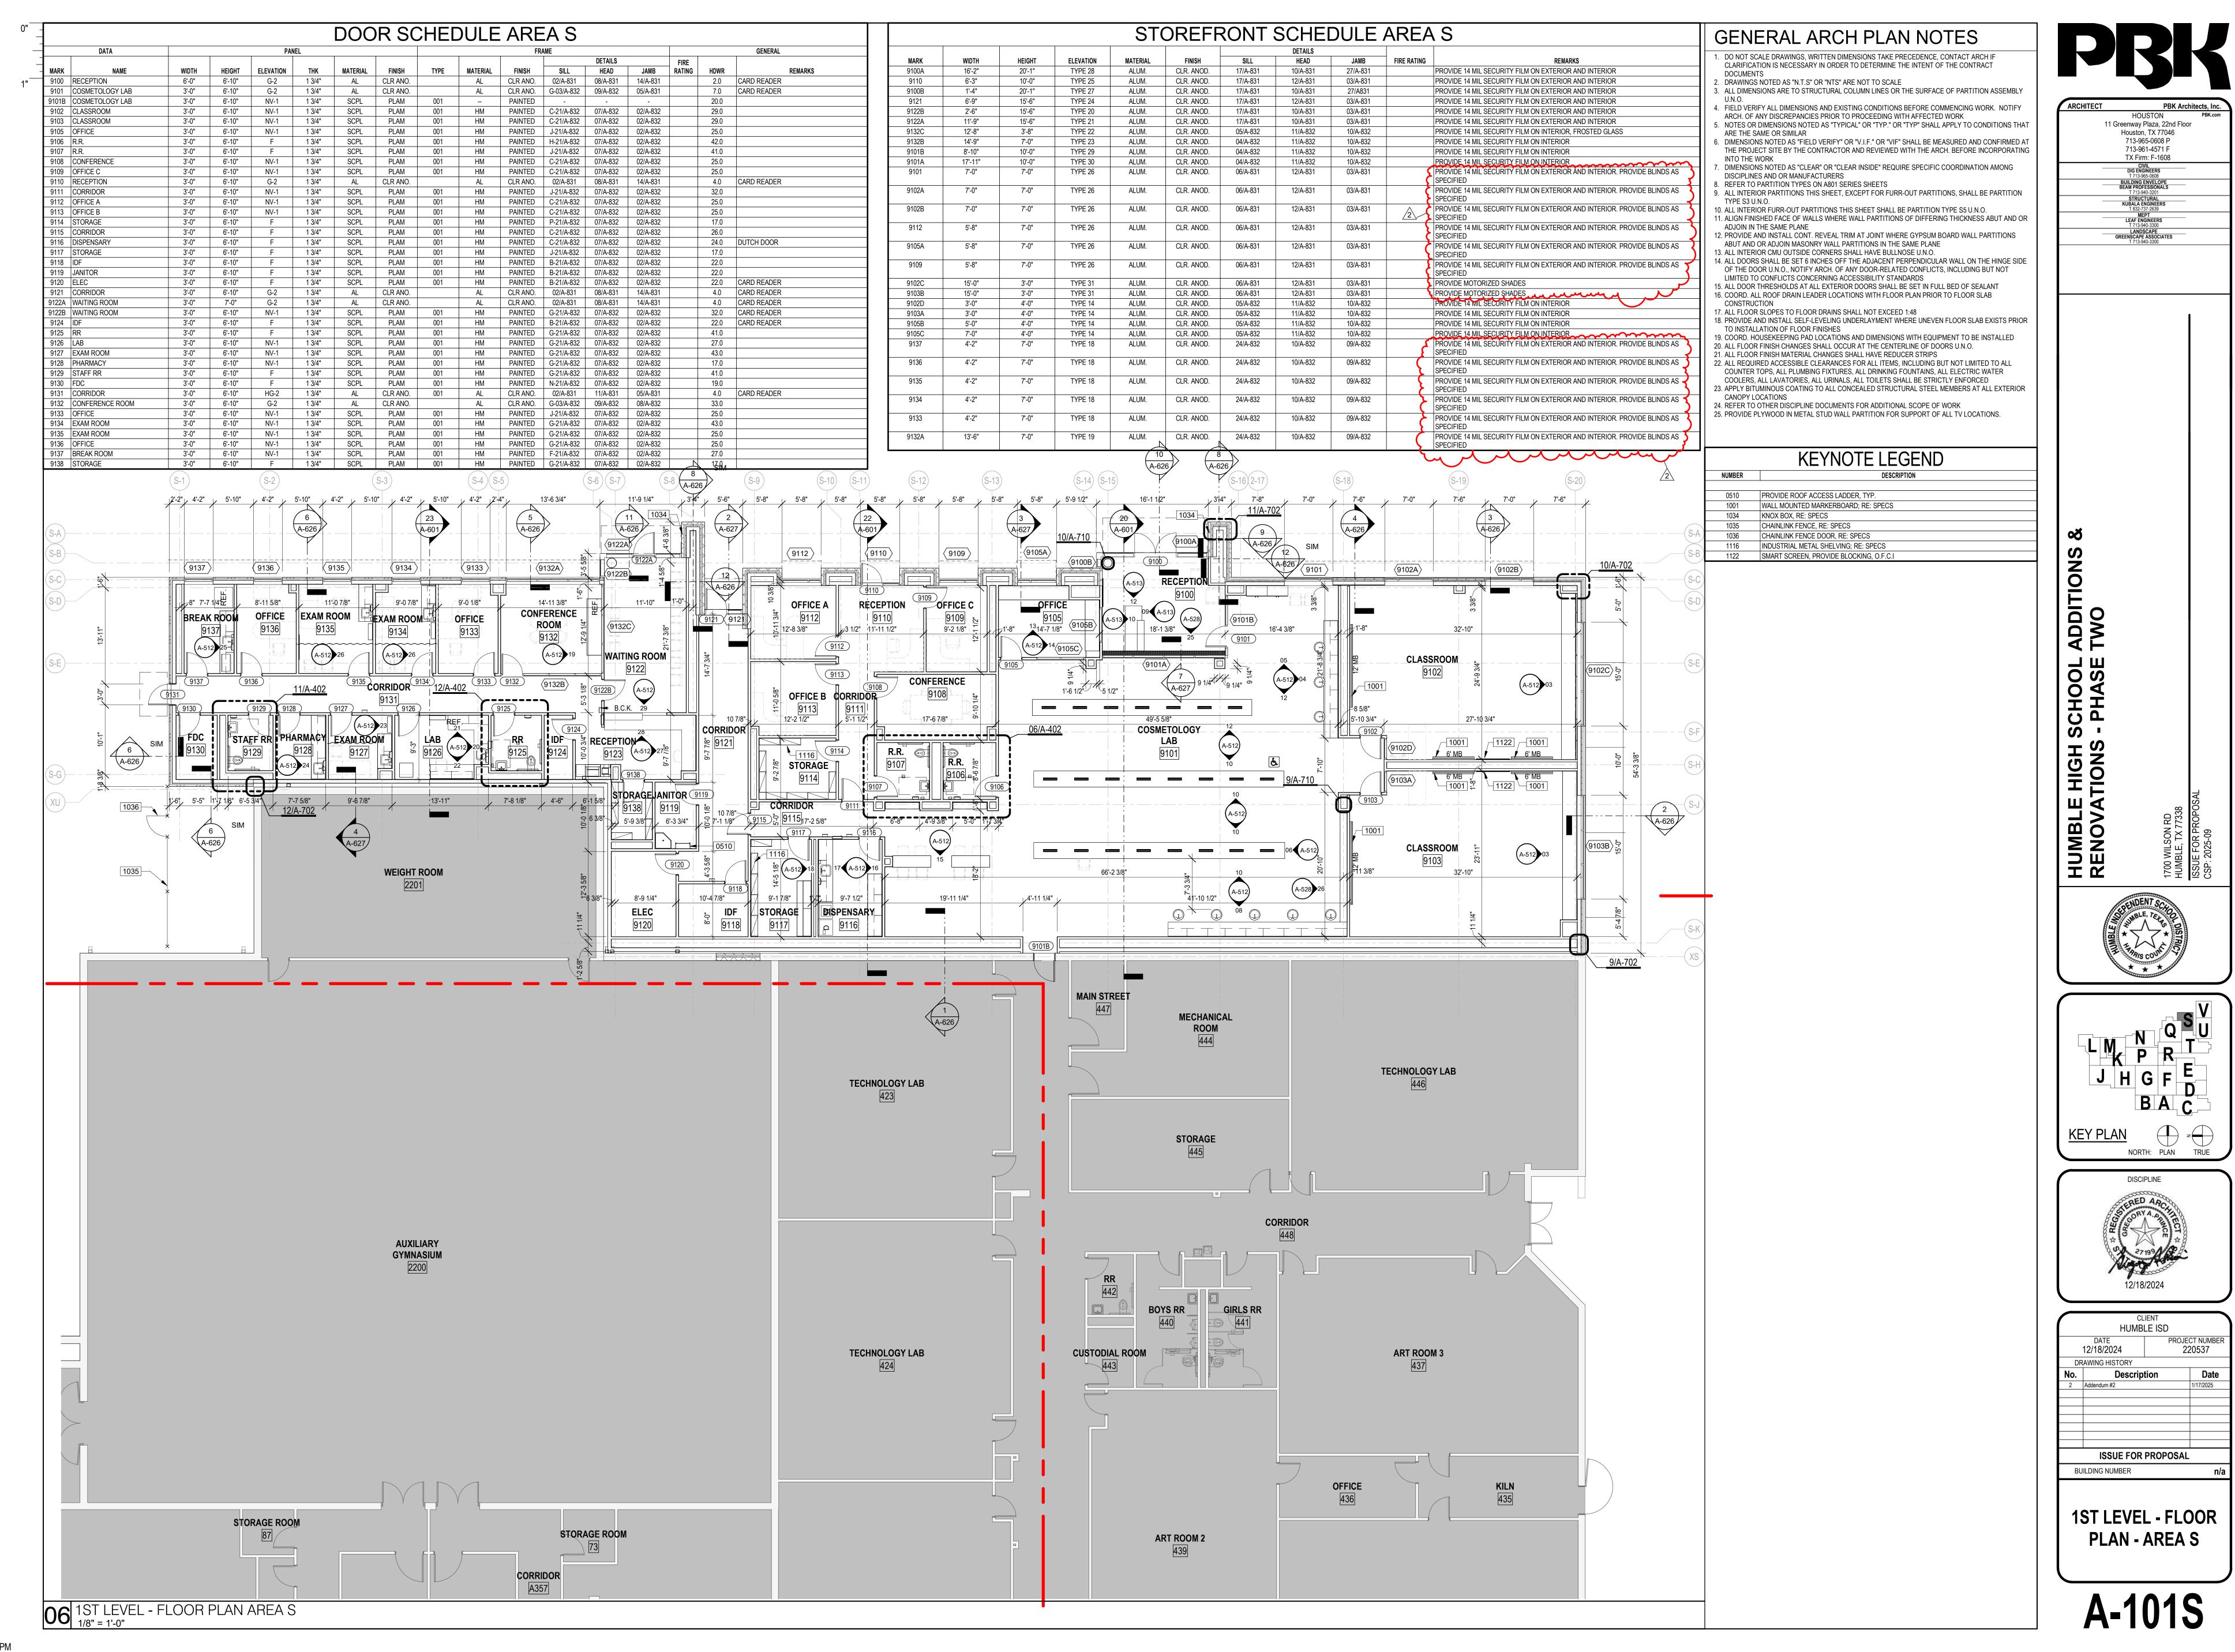


101S DR BLUEBEAM LABELING/OCR:


File Path: Autodesk Docs://Humble ISD_220537_Humble HS A&R Ph 2 Package 1/AR23 220537 HISD HHS Pha: A may a may a make the second secon

Author Plot Stamp: 1/8/2025 4:28:33 PM



			STO	OREFF	RONT	SCHE	DULE	AREA	4		GENERAL ARCH PLAN NOTES
-	MARK 1213A 1213B	WIDTH HEIGHT 3'-4" 5'-0" 3'-4" 5'-0"	ELEVATION TYPE 34 TYPE 34	MATERIAL AL AL	FINISH CLR. ANOD. CLR. ANOD.		DETAIL HEAD 26/A-831 26/A-831	JAMB 21/A-831 21/A-831		REMARKS	 DO NOT SCALE DRAWINGS, WRITTEN DIMENSIONS TAKE PRECEDENCE, CONTACT ARCH IF CLARIFICATION IS NECESSARY IN ORDER TO DETERMINE THE INTENT OF THE CONTRACT DOCUMENTS DRAWINGS NOTED AS "N.T.S" OR "NTS" ARE NOT TO SCALE
											 ALL DIMENSIONS ARE TO STRUCTURAL COLUMN LINES OR THE SURFACE OF PARTITION ASSEM U.N.O. FIELD VERIFY ALL DIMENSIONS AND EXISTING CONDITIONS BEFORE COMMENCING WORK. NOT ARCH. OF ANY DISCREPANCIES PRIOR TO PROCEEDING WITH AFFECTED WORK NOTES OR DIMENSIONS NOTED AS "TYPICAL" OR "TYP." OR "TYP" SHALL APPLY TO CONDITIONS ARE THE SAME OR SIMILAR DIMENSIONS NOTED AS "FIELD VERIFY" OR "V.I.F." OR "VIF" SHALL BE MEASURED AND CONFIRM THE PROJECT SITE BY THE CONTRACTOR AND REVIEWED WITH THE ARCH. BEFORE INCORPOR. INTO THE WORK DIMENSIONS NOTED AS "CLEAR" OR "CLEAR INSIDE" REQUIRE SPECIFIC COORDINATION AMONG DISCIPLINES AND OR MANUFACTURERS
											 REFER TO PARTITION TYPES ON A801 SERIES SHEETS ALL INTERIOR PARTITIONS THIS SHEET, EXCEPT FOR FURR-OUT PARTITIONS, SHALL BE PARTIT TYPE S3 U.N.O. ALL INTERIOR FURR-OUT PARTITIONS THIS SHEET SHALL BE PARTITION TYPE S5 U.N.O. ALL INTERIOR FURR-OUT PARTITIONS THIS SHEET SHALL BE PARTITION TYPE S5 U.N.O. ALI GN FINISHED FACE OF WALLS WHERE WALL PARTITIONS OF DIFFERING THICKNESS ABUT AN ADJOIN IN THE SAME PLANE PROVIDE AND INSTALL CONT. REVEAL TRIM AT JOINT WHERE GYPSUM BOARD WALL PARTITION ABUT AND OR ADJOIN MASONRY WALL PARTITIONS IN THE SAME PLANE ALL INTERIOR CMU OUTSIDE CORNERS SHALL HAVE BULLNOSE U.N.O. ALL DOORS SHALL BE SET 6 INCHES OFF THE ADJACENT PERPENDICULAR WALL ON THE HINGE
					0						 OF THE DOOR U.N.O., NOTIFY ARCH. OF ANY DOOR-RELATED CONFLICTS, INCLUDING BUT NOT LIMITED TO CONFLICTS CONCERNING ACCESSIBILITY STANDARDS 15. ALL DOOR THRESHOLDS AT ALL EXTERIOR DOORS SHALL BE SET IN FULL BED OF SEALANT 16. COORD. ALL ROOF DRAIN LEADER LOCATIONS WITH FLOOR PLAN PRIOR TO FLOOR SLAB CONSTRUCTION 17. ALL FLOOR SLOPES TO FLOOR DRAINS SHALL NOT EXCEED 1:48 18. PROVIDE AND INSTALL SELF-LEVELING UNDERLAYMENT WHERE UNEVEN FLOOR SLAB EXISTS F TO INSTALLATION OF FLOOR FINISHES 19. COORD. HOUSEKEEPING PAD LOCATIONS AND DIMENSIONS WITH EQUIPMENT TO BE INSTALLED 20. ALL FLOOR FINISH CHANGES SHALL OCCUR AT THE CENTERLINE OF DOORS U.N.O.
					0						 ALL FLOOR FINISH MATERIAL CHANGES SHALL HAVE REDUCER STRIPS ALL REQUIRED ACCESSIBLE CLEARANCES FOR ALL ITEMS, INCLUDING BUT NOT LIMITED TO ALL COUNTER TOPS, ALL PLUMBING FIXTURES, ALL DRINKING FOUNTAINS, ALL ELECTRIC WATER COOLERS, ALL LAVATORIES, ALL URINALS, ALL TOILETS SHALL BE STRICTLY ENFORCED APPLY BITUMINOUS COATING TO ALL CONCEALED STRUCTURAL STEEL MEMBERS AT ALL EXTER CANOPY LOCATIONS REFER TO OTHER DISCIPLINE DOCUMENTS FOR ADDITIONAL SCOPE OF WORK PROVIDE PLYWOOD IN METAL STUD WALL PARTITION FOR SUPPORT OF ALL TV LOCATIONS.
		L									KEYNOTE LEGEND NUMBER DESCRIPTION 2203 NEW DRINKING FOUNTAIN, RE:PLUMBING
						R1)				
				-9/2							
		11					(11)				
							– – – (B-K)				
							– – – <u>B-L</u>				
							— — — (B-N)				
) (3.8)		R1 4.6	4.7	4.8	5		R2				

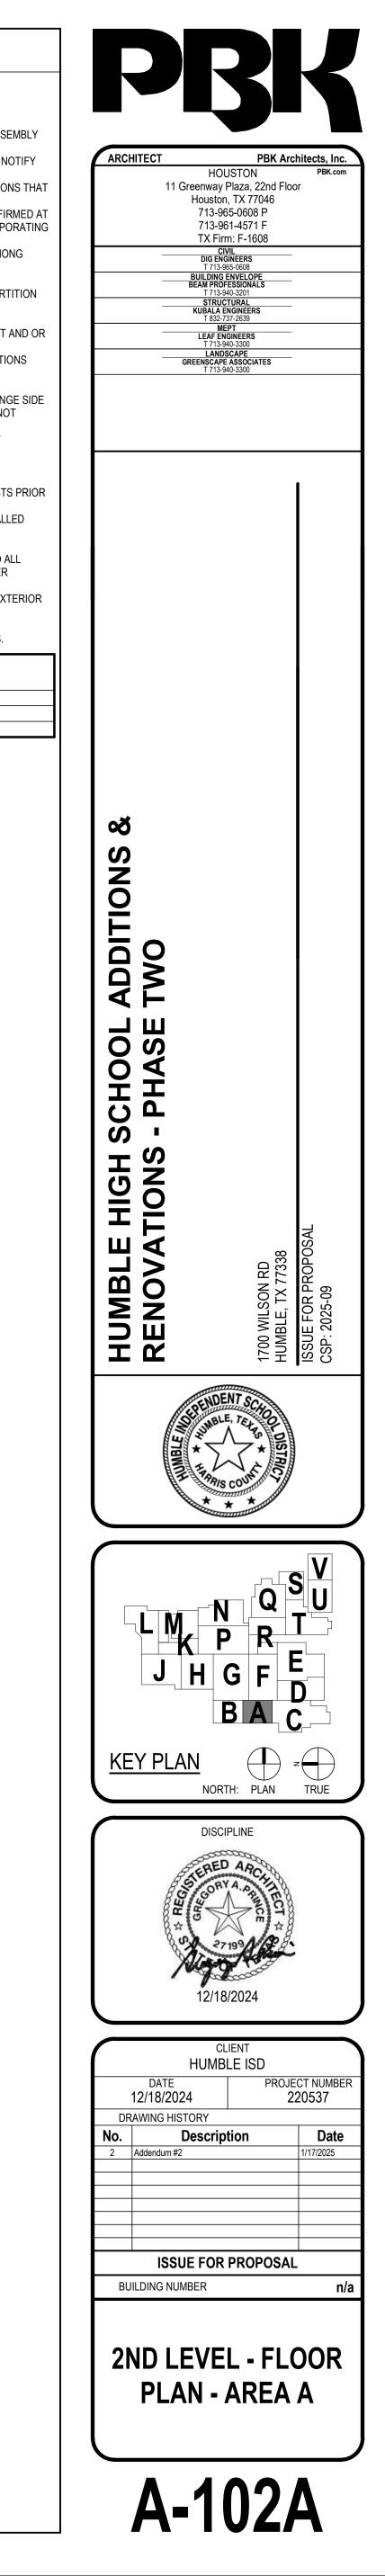

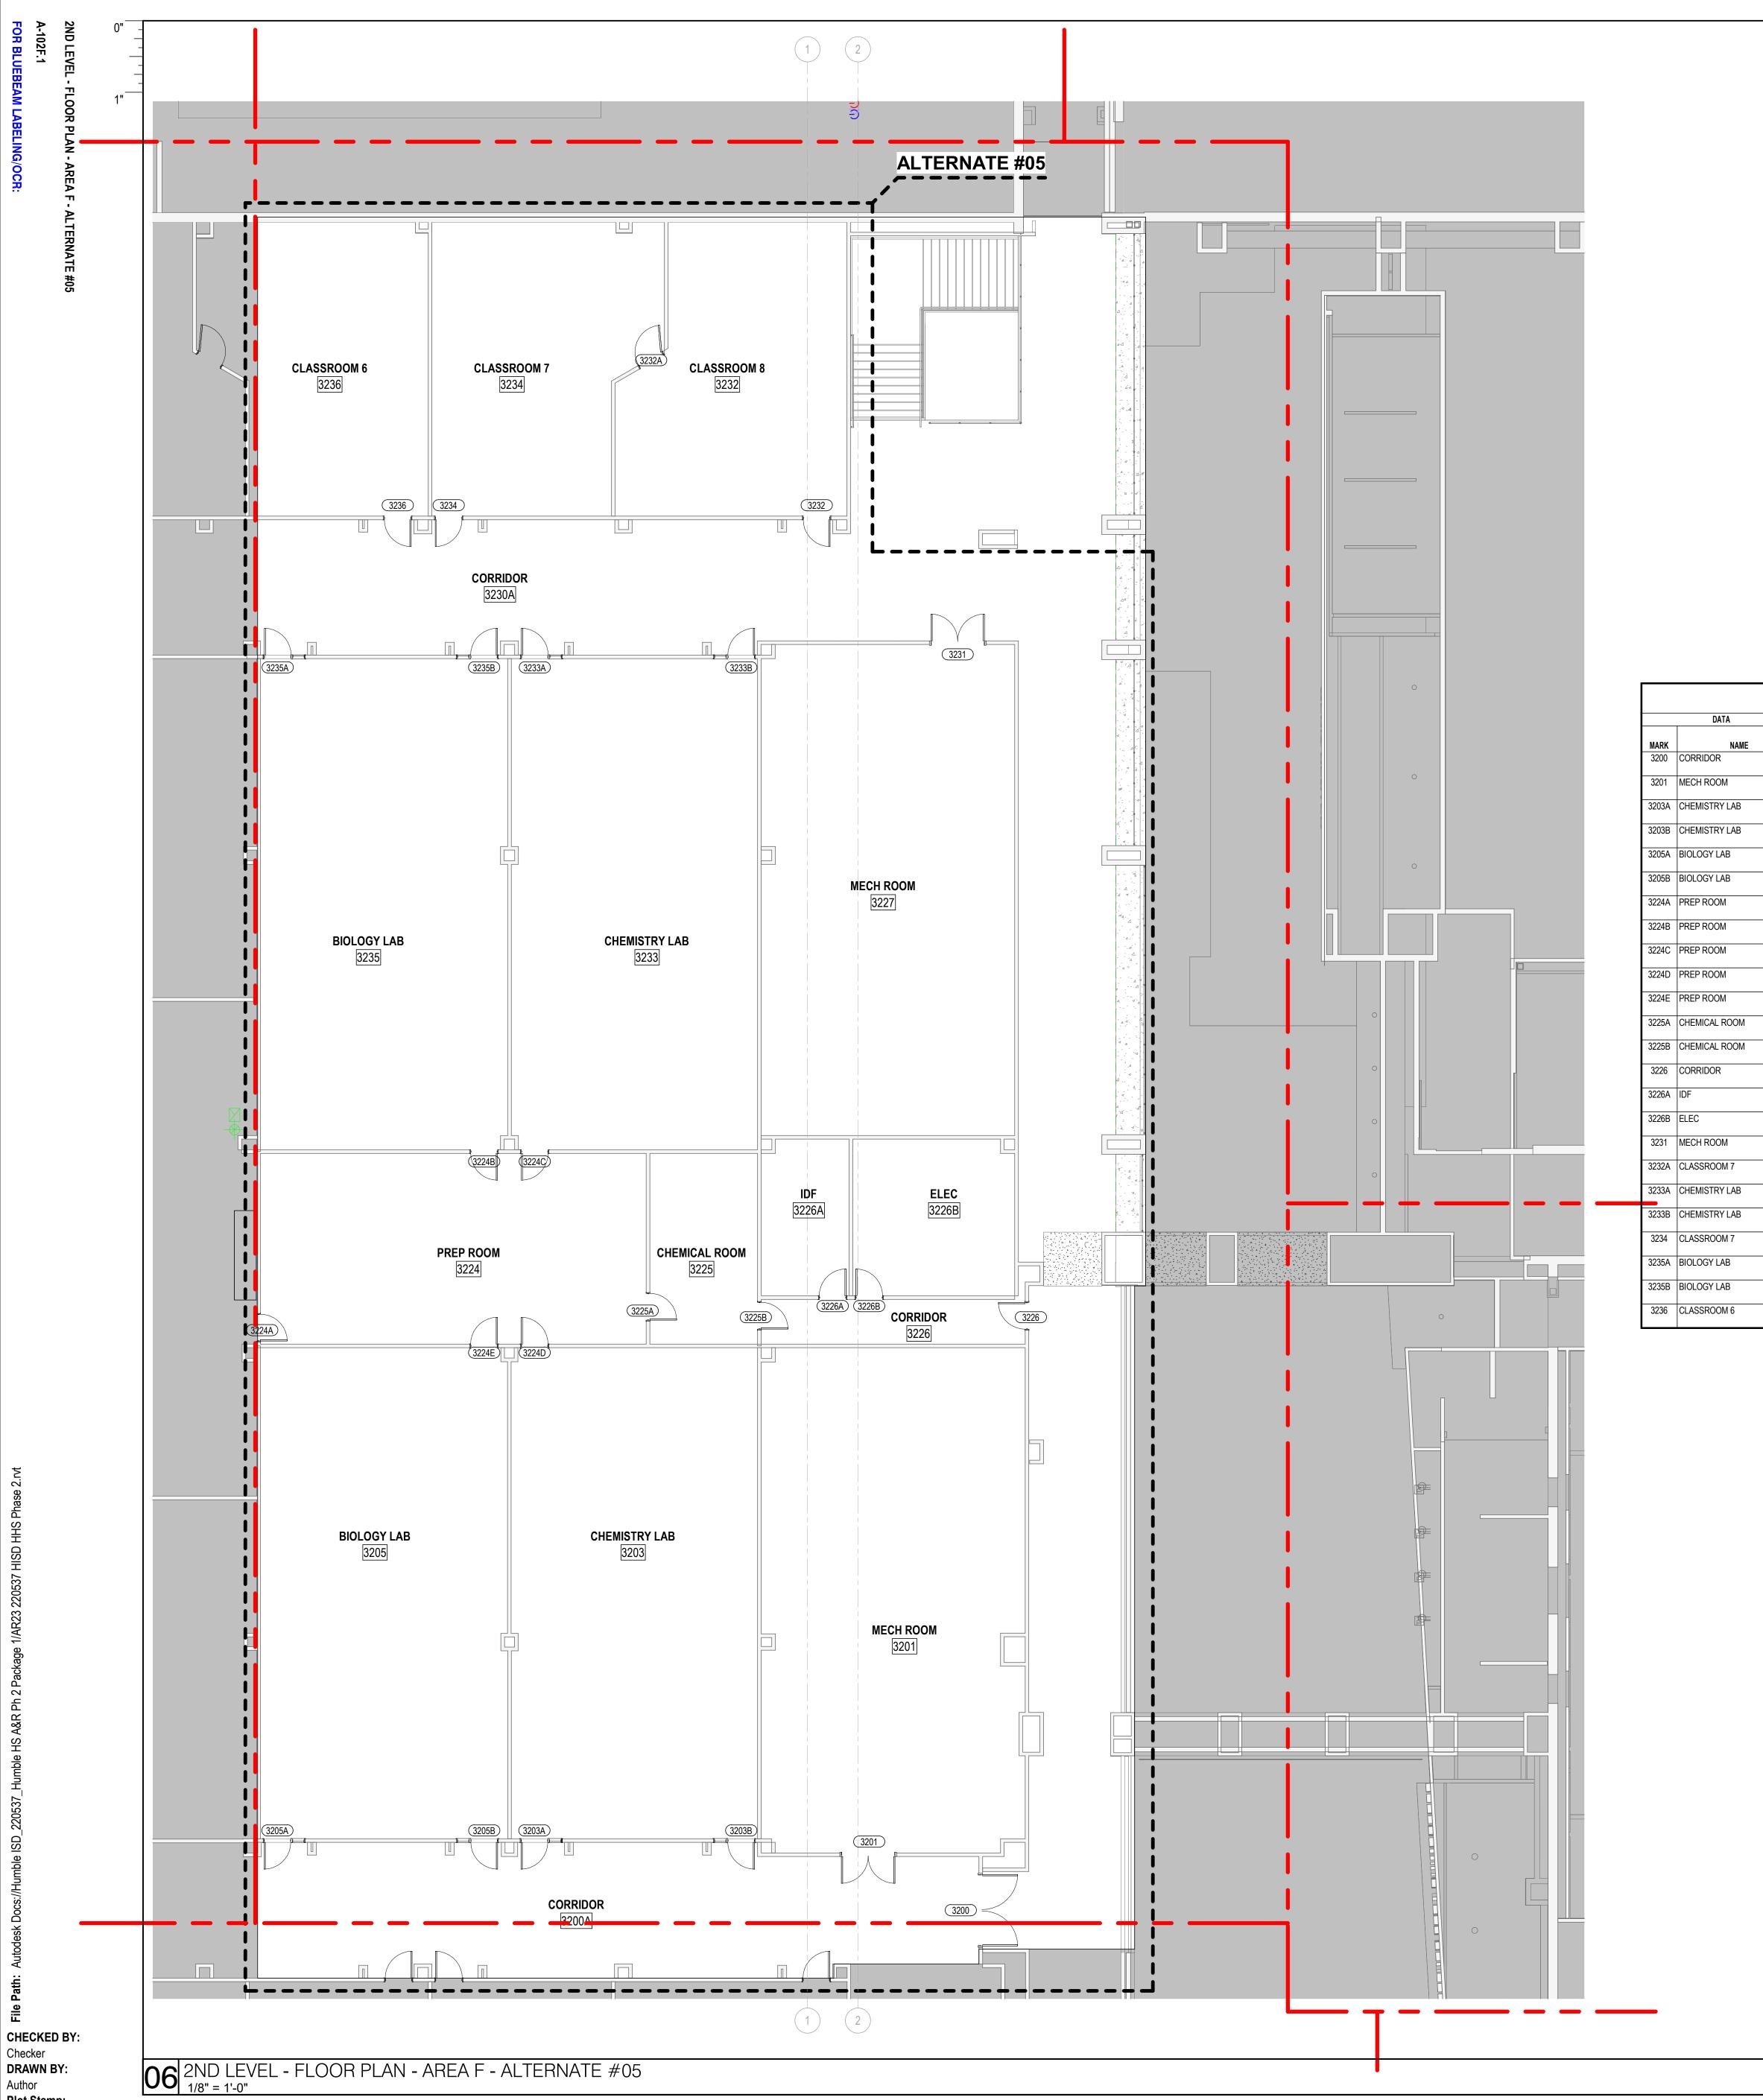

Author Plot Stamp: 1/10/2025 11:31:01 AM


GENERAL ARCH PLAN NOTES


I. DO NOT SCALE DRAWINGS, WRITTEN DIMENSIONS TAKE PRECEDENCE, CONTACT ARCH IF CLARIFICATION IS NECESSARY IN ORDER TO DETERMINE THE INTENT OF THE CONTRACT

- DOCUMENTS 2. DRAWINGS NOTED AS "N.T.S" OR "NTS" ARE NOT TO SCALE
- 3. ALL DIMENSIONS ARE TO STRUCTURAL COLUMN LINES OR THE SURFACE OF PARTITION ASSEMBLY U.N.O.
- 4. FIELD VERIFY ALL DIMENSIONS AND EXISTING CONDITIONS BEFORE COMMENCING WORK. NOTIFY ARCH. OF ANY DISCREPANCIES PRIOR TO PROCEEDING WITH AFFECTED WORK 5. NOTES OR DIMENSIONS NOTED AS "TYPICAL" OR "TYP." OR "TYP" SHALL APPLY TO CONDITIONS THAT
- ARE THE SAME OR SIMILAR 6. DIMENSIONS NOTED AS "FIELD VERIFY" OR "V.I.F." OR "VIF" SHALL BE MEASURED AND CONFIRMED AT
- THE PROJECT SITE BY THE CONTRACTOR AND REVIEWED WITH THE ARCH. BEFORE INCORPORATING INTO THE WORK
- . DIMENSIONS NOTED AS "CLEAR" OR "CLEAR INSIDE" REQUIRE SPECIFIC COORDINATION AMONG DISCIPLINES AND OR MANUFACTURERS 8. REFER TO PARTITION TYPES ON A801 SERIES SHEETS
- 9. ALL INTERIOR PARTITIONS THIS SHEET, EXCEPT FOR FURR-OUT PARTITIONS, SHALL BE PARTITION TYPE S3 U.N.O.
- 10. ALL INTERIOR FURR-OUT PARTITIONS THIS SHEET SHALL BE PARTITION TYPE S5 U.N.O. 11. ALIGN FINISHED FACE OF WALLS WHERE WALL PARTITIONS OF DIFFERING THICKNESS ABUT AND OR ADJOIN IN THE SAME PLANE 12. PROVIDE AND INSTALL CONT. REVEAL TRIM AT JOINT WHERE GYPSUM BOARD WALL PARTITIONS
- ABUT AND OR ADJOIN MASONRY WALL PARTITIONS IN THE SAME PLANE 13. ALL INTERIOR CMU OUTSIDE CORNERS SHALL HAVE BULLNOSE U.N.O.
- 14. ALL DOORS SHALL BE SET 6 INCHES OFF THE ADJACENT PERPENDICULAR WALL ON THE HINGE SIDE OF THE DOOR U.N.O., NOTIFY ARCH. OF ANY DOOR-RELATED CONFLICTS, INCLUDING BUT NOT LIMITED TO CONFLICTS CONCERNING ACCESSIBILITY STANDARDS
- 15. ALL DOOR THRESHOLDS AT ALL EXTERIOR DOORS SHALL BE SET IN FULL BED OF SEALANT 16. COORD. ALL ROOF DRAIN LEADER LOCATIONS WITH FLOOR PLAN PRIOR TO FLOOR SLAB CONSTRUCTION 17. ALL FLOOR SLOPES TO FLOOR DRAINS SHALL NOT EXCEED 1:48
- 18. PROVIDE AND INSTALL SELF-LEVELING UNDERLAYMENT WHERE UNEVEN FLOOR SLAB EXISTS PRIOR TO INSTALLATION OF FLOOR FINISHES 19. COORD. HOUSEKEEPING PAD LOCATIONS AND DIMENSIONS WITH EQUIPMENT TO BE INSTALLED 20. ALL FLOOR FINISH CHANGES SHALL OCCUR AT THE CENTERLINE OF DOORS U.N.O.
- 21. ALL FLOOR FINISH MATERIAL CHANGES SHALL HAVE REDUCER STRIPS 22. ALL REQUIRED ACCESSIBLE CLEARANCES FOR ALL ITEMS, INCLUDING BUT NOT LIMITED TO ALL COUNTER TOPS, ALL PLUMBING FIXTURES, ALL DRINKING FOUNTAINS, ALL ELECTRIC WATER
- COOLERS, ALL LAVATORIES, ALL URINALS, ALL TOILETS SHALL BE STRICTLY ENFORCED 23. APPLY BITUMINOUS COATING TO ALL CONCEALED STRUCTURAL STEEL MEMBERS AT ALL EXTERIOR CANOPY LOCATIONS
- 24. REFER TO OTHER DISCIPLINE DOCUMENTS FOR ADDITIONAL SCOPE OF WORK 25. PROVIDE PLYWOOD IN METAL STUD WALL PARTITION FOR SUPPORT OF ALL TV LOCATIONS.

		DOC	RS	CHI	EDU	LE /	AREA F (A	LTÉI	RNA	ΓE #()5)				
PANEL							FRAME					GENERAL			
WIDTH	HEIGHT			MATERI	FINISH	TYPE	MATERIAL	FINISH	SILL	DETAILS HEAD	JAMB	FIRE RATING		REMARKS	
 WIDTH 8'-0'	7'-0"	ELEVATION NV-1	THK 1 3/4"	AL SCPL	PLAM	001	EXISTING TO REMAIN	PAINTED	G-21/A-832	EXIST. TO REMAIN	EXIST. TO REMAIN	FIRE RATING	HARDWARE 8.0	VERIFY EXISTING DOOR IN FI	
6'-0"	6'-11 /2"		1 3/4"	SCPL	PLAM	001	E011TING TO REMAIN	PAINTED	B-21/A-832	EXIST. TO REMAIN	EXIST. TO REMAIN	45 MINS.	9.0	VERIFY EXISTING DOOR IN FI	
3'-0"	6'-11 1/2"	NV-1	1 3/4"	SCPL	PLAM		E011 E011TING TO REMAIN	PAINTED	H-21/A-832	EXIST. TO REMAIN	EXIST. TO REMAIN		26.0	VERIFY EXISTING DOOR IN FI	
3'-0"	6'-11 1/2"	NV-1	1 3/4"	SCPL	PLAM		011 EAISTING TO REMAIN	PAINTED	H-21/A-832	EXIST. TO REMAIN	EXIST. TO REMAIN		26.0	VERIFY EXISTING DOOR IN FI	
3'-0"	6'-11 1/2"	NV-1	1 3/4"	SCPL	PLAM		EXISTING TO REMAIN	PAINTED	H-21/A-832	EXIST. TO REMAIN	EXIST. TO REMAIN		26.0	VERIFY EXISTING DOOR IN FI	
3'-0"	6'-11 1/2"	NV-1	1 3/4"	SCPL	PLAM		EXISTING TO REMAIN	PAINTED	H-21/A-832	EXIST. TO REMAIN	EXIST. TO REMAIN		26.0	VERIFY EXISTING DOOR IN FI	
3'-0"	6'-11 1/2"	F	1 3/4"	SCPL	PLAM	001	EXISTING TO REMAIN	PAINTED	J-21/A-832	EXIST. TO REMAIN	EXIST. TO REMAIN		19.0	VERIFY EXISTING DOOR IN FI	
3'-0"	6'-11 1/2"	F	1 3/4"	SCPL	PLAM	001	EXISTING TO REMAIN	PAINTED	01/A-832	EXIST. TO REMAIN	EXIST. TO REMAIN		19.0	VERIFY EXISTING DOOR IN FI	
3'-0"	6'-11 1/2"	F	1 3/4"	SCPL	PLAM	001	EXISTING TO REMAIN	PAINTED	01/A-832	EXIST. TO REMAIN	EXIST. TO REMAIN		35.0	VERIFY EXISTING DOOR IN FI	
3'-0"	6'-11 1/2"	NV-1	1 3/4"	SCPL	PLAM		EXISTING TO REMAIN	PAINTED	H-21/A-832	EXIST. TO REMAIN	EXIST. TO REMAIN		26.0	VERIFY EXISTING DOOR IN FI	
3'-0"	6'-11 1/2"	NV-1	1 3/4"	SCPL	PLAM		EXISTING TO REMAIN	PAINTED	H-21/A-832	EXIST. TO REMAIN	EXIST. TO REMAIN		26.0	VERIFY EXISTING DOOR IN FI	
3'-0"	6'-11 1/2"	F	1 3/4"	WD	WD-"X"	001	EXISTING TO REMAIN	PAINTED	J-21/A-832	EXIST. TO REMAIN	EXIST. TO REMAIN		29.0	VERIFY EXISTING DOOR IN FI	

2

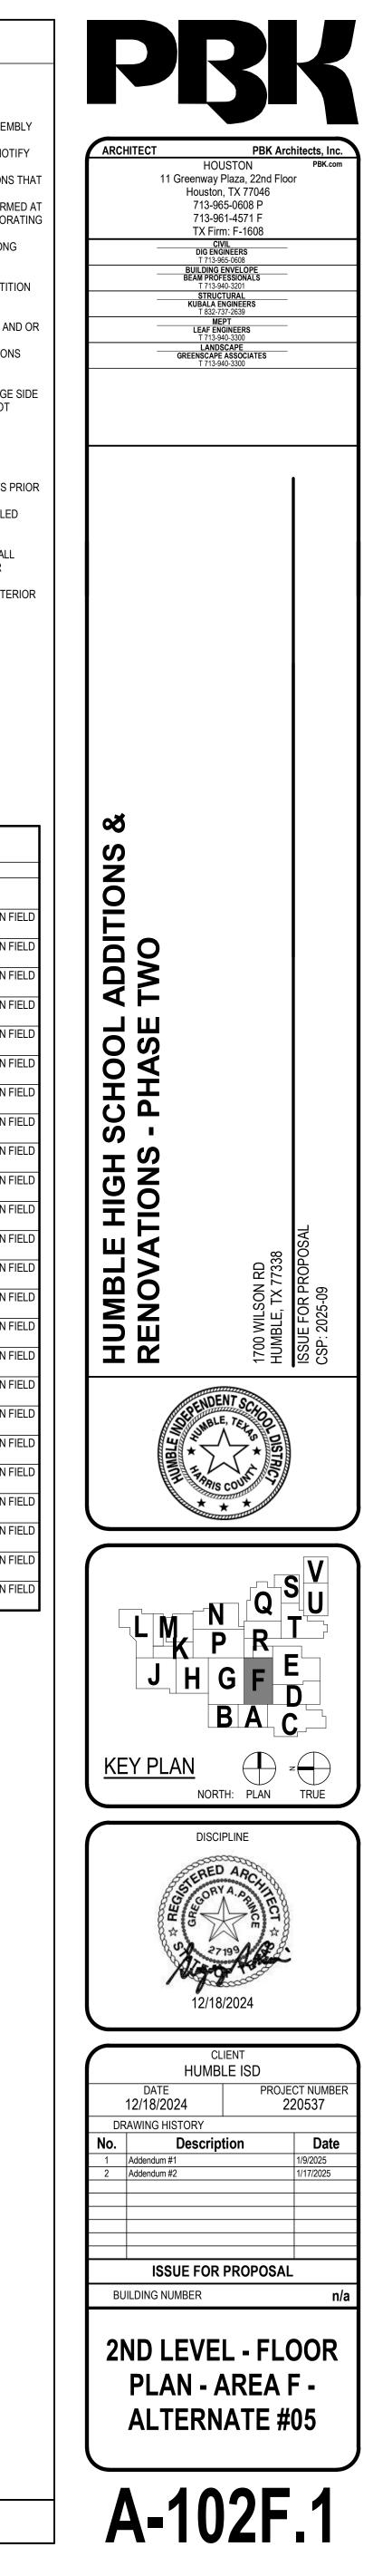

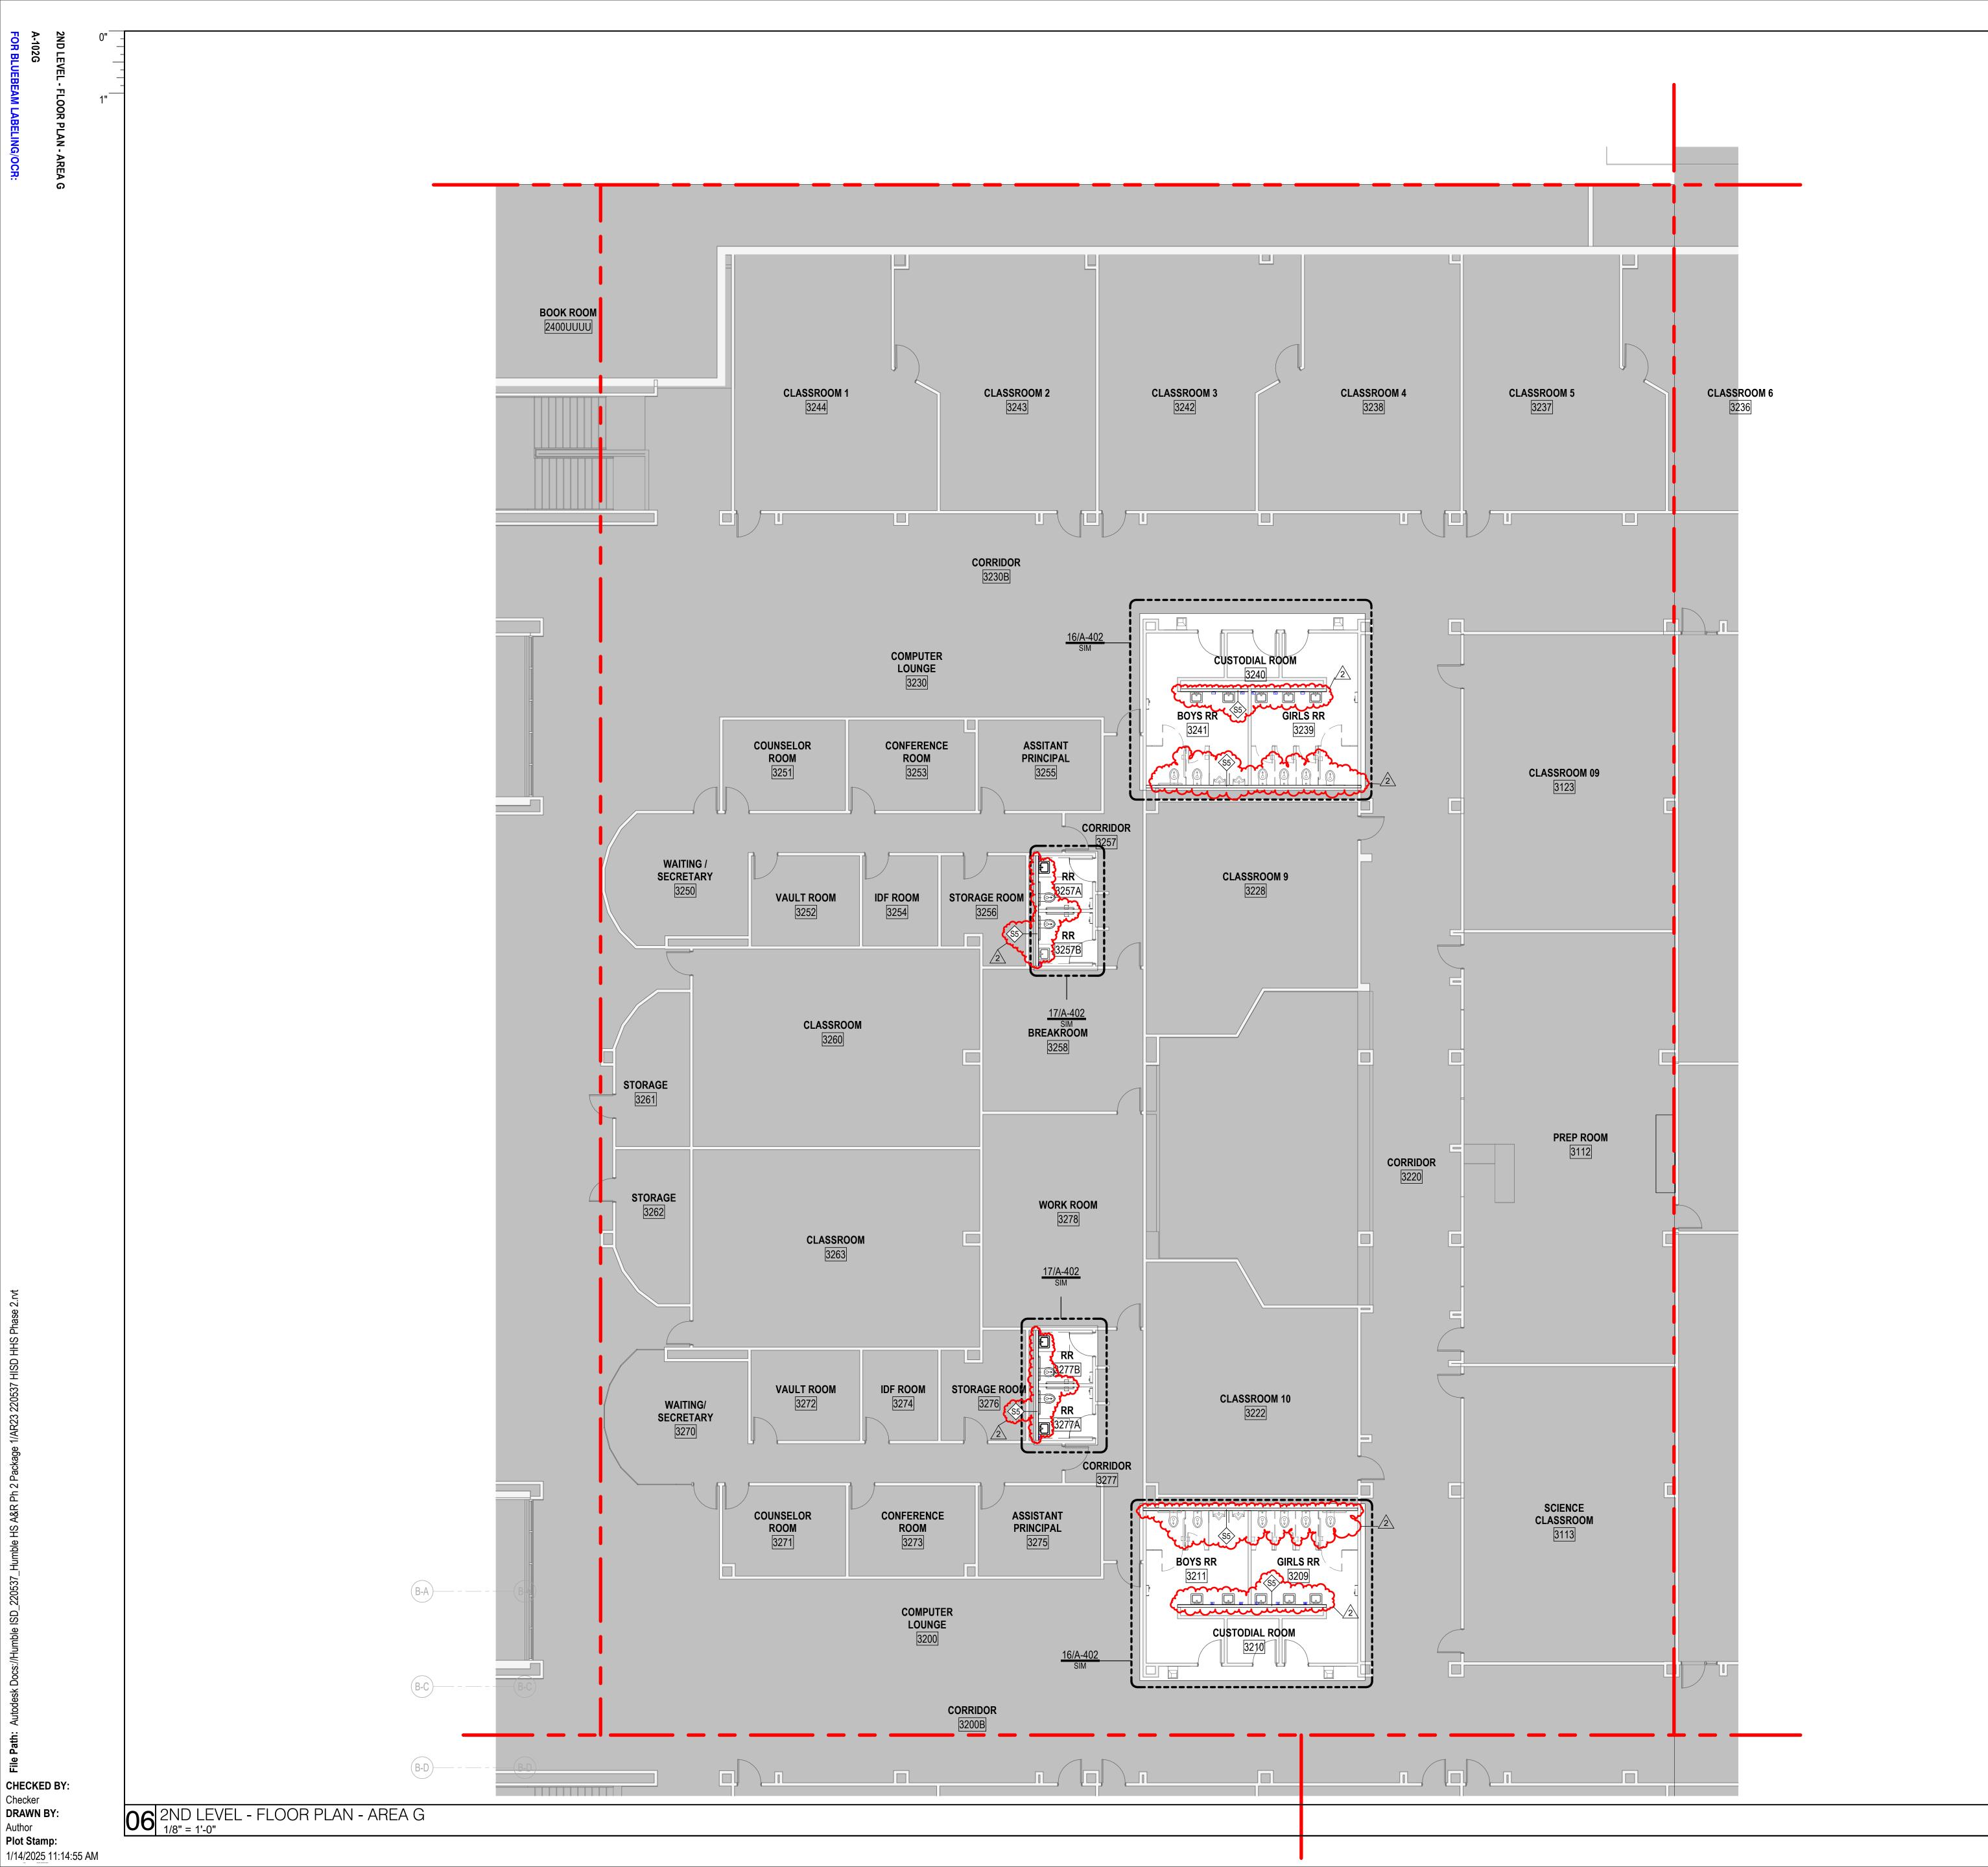


GENERAL ARCH PLAN NOTES

1. DO NOT SCALE DRAWINGS, WRITTEN DIMENSIONS TAKE PRECEDENCE, CONTACT ARCH IF CLARIFICATION IS NECESSARY IN ORDER TO DETERMINE THE INTENT OF THE CONTRACT DOCUMENTS

- DRAWINGS NOTED AS "N.T.S" OR "NTS" ARE NOT TO SCALE
 ALL DIMENSIONS ARE TO STRUCTURAL COLUMN LINES OR THE SURFACE OF PARTITION ASSEMBLY
- U.N.O.
 4. FIELD VERIFY ALL DIMENSIONS AND EXISTING CONDITIONS BEFORE COMMENCING WORK. NOTIFY ARCH. OF ANY DISCREPANCIES PRIOR TO PROCEEDING WITH AFFECTED WORK
- 5. NOTES OR DIMENSIONS NOTED AS "TYPICAL" OR "TYP." OR "TYP" SHALL APPLY TO CONDITIONS THAT ARE THE SAME OR SIMILAR
- 6. DIMENSIONS NOTED AS "FIELD VERIFY" OR "V.I.F." OR "VIF" SHALL BE MEASURED AND CONFIRMED AT THE PROJECT SITE BY THE CONTRACTOR AND REVIEWED WITH THE ARCH. BEFORE INCORPORATING INTO THE WORK
- 7. DIMENSIONS NOTED AS "CLEAR" OR "CLEAR INSIDE" REQUIRE SPECIFIC COORDINATION AMONG DISCIPLINES AND OR MANUFACTURERS
- REFER TO PARTITION TYPES ON A801 SERIES SHEETS
 ALL INTERIOR PARTITIONS THIS SHEET, EXCEPT FOR FURR-OUT PARTITIONS, SHALL BE PARTITION TYPE S3 U.N.O.
- ALL INTERIOR FURR-OUT PARTITIONS THIS SHEET SHALL BE PARTITION TYPE S5 U.N.O.
 ALIGN FINISHED FACE OF WALLS WHERE WALL PARTITIONS OF DIFFERING THICKNESS ABUT AND OR ADJOIN IN THE SAME PLANE
 PROVIDE AND INSTALL CONT. REVEAL TRIM AT JOINT WHERE GYPSUM BOARD WALL PARTITIONS
- ABUT AND OR ADJOIN MASONRY WALL PARTITIONS IN THE SAME PLANE 13. ALL INTERIOR CMU OUTSIDE CORNERS SHALL HAVE BULLNOSE U.N.O.
- ALL DOORS SHALL BE SET 6 INCHES OFF THE ADJACENT PERPENDICULAR WALL ON THE HINGE SIDE OF THE DOOR U.N.O., NOTIFY ARCH. OF ANY DOOR-RELATED CONFLICTS, INCLUDING BUT NOT LIMITED TO CONFLICTS CONCERNING ACCESSIBILITY STANDARDS
 ALL DOOR THRESHOLDS AT ALL EXTERIOR DOORS SHALL BE SET IN FULL BED OF SEALANT
- COORD. ALL ROOF DRAIN LEADER LOCATIONS WITH FLOOR PLAN PRIOR TO FLOOR SLAB CONSTRUCTION
 ALL FLOOR SLOPES TO FLOOR DRAINS SHALL NOT EXCEED 1:48
- PROVIDE AND INSTALL SELF-LEVELING UNDERLAYMENT WHERE UNEVEN FLOOR SLAB EXISTS PRIOR TO INSTALLATION OF FLOOR FINISHES
 COORD. HOUSEKEEPING PAD LOCATIONS AND DIMENSIONS WITH EQUIPMENT TO BE INSTALLED
 ALL FLOOR FINISH CHANGES SHALL OCCUR AT THE CENTERLINE OF DOORS U.N.O.
- 21. ALL FLOOR FINISH MATERIAL CHANGES SHALL HAVE REDUCER STRIPS 22. ALL REQUIRED ACCESSIBLE CLEARANCES FOR ALL ITEMS, INCLUDING BUT NOT LIMITED TO ALL
- COUNTER TOPS, ALL PLUMBING FIXTURES, ALL DRINKING FOUNTAINS, ALL ELECTRIC WATER COOLERS, ALL LAVATORIES, ALL URINALS, ALL TOILETS SHALL BE STRICTLY ENFORCED 23. APPLY BITUMINOUS COATING TO ALL CONCEALED STRUCTURAL STEEL MEMBERS AT ALL EXTERIOR
- CANOPY LOCATIONS 24. REFER TO OTHER DISCIPLINE DOCUMENTS FOR ADDITIONAL SCOPE OF WORK 25. PROVIDE PLYWOOD IN METAL STUD WALL PARTITION FOR SUPPORT OF ALL TV LOCATIONS.

NUMBER

KEYNOTE LEGEND

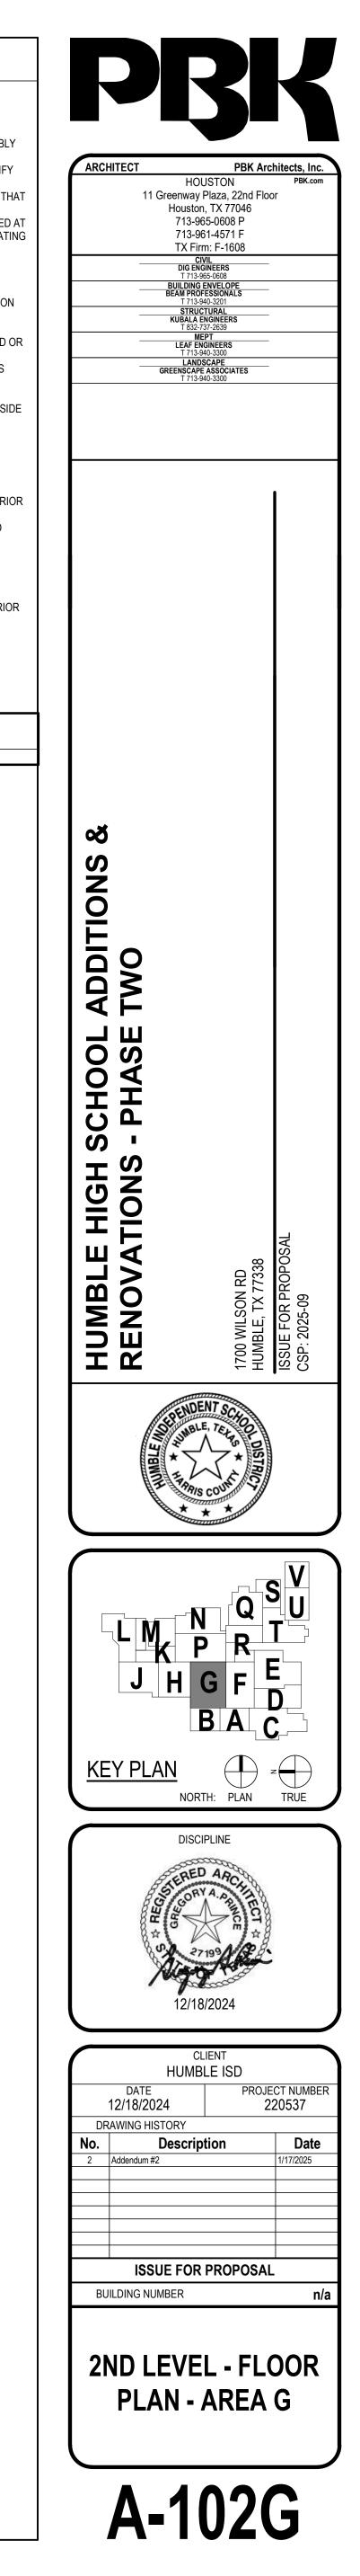


ENLARGED - FLOOR PLANS A-403 FOR BLUEBEAM LABELING/OCR:	
File Path: Autodesk Docs://Humble ISD_220537_Humble HS A&R Ph 2 Package 1/AR23 220537 HISD HHS Phase 2.rvt EXEMPLE To the second state of the seco	


06 RESTROOMS 6103 & 6104

DRAWN BY:

Author Plot Stamp: 1/15/2025 11:38:47 AM


Checker

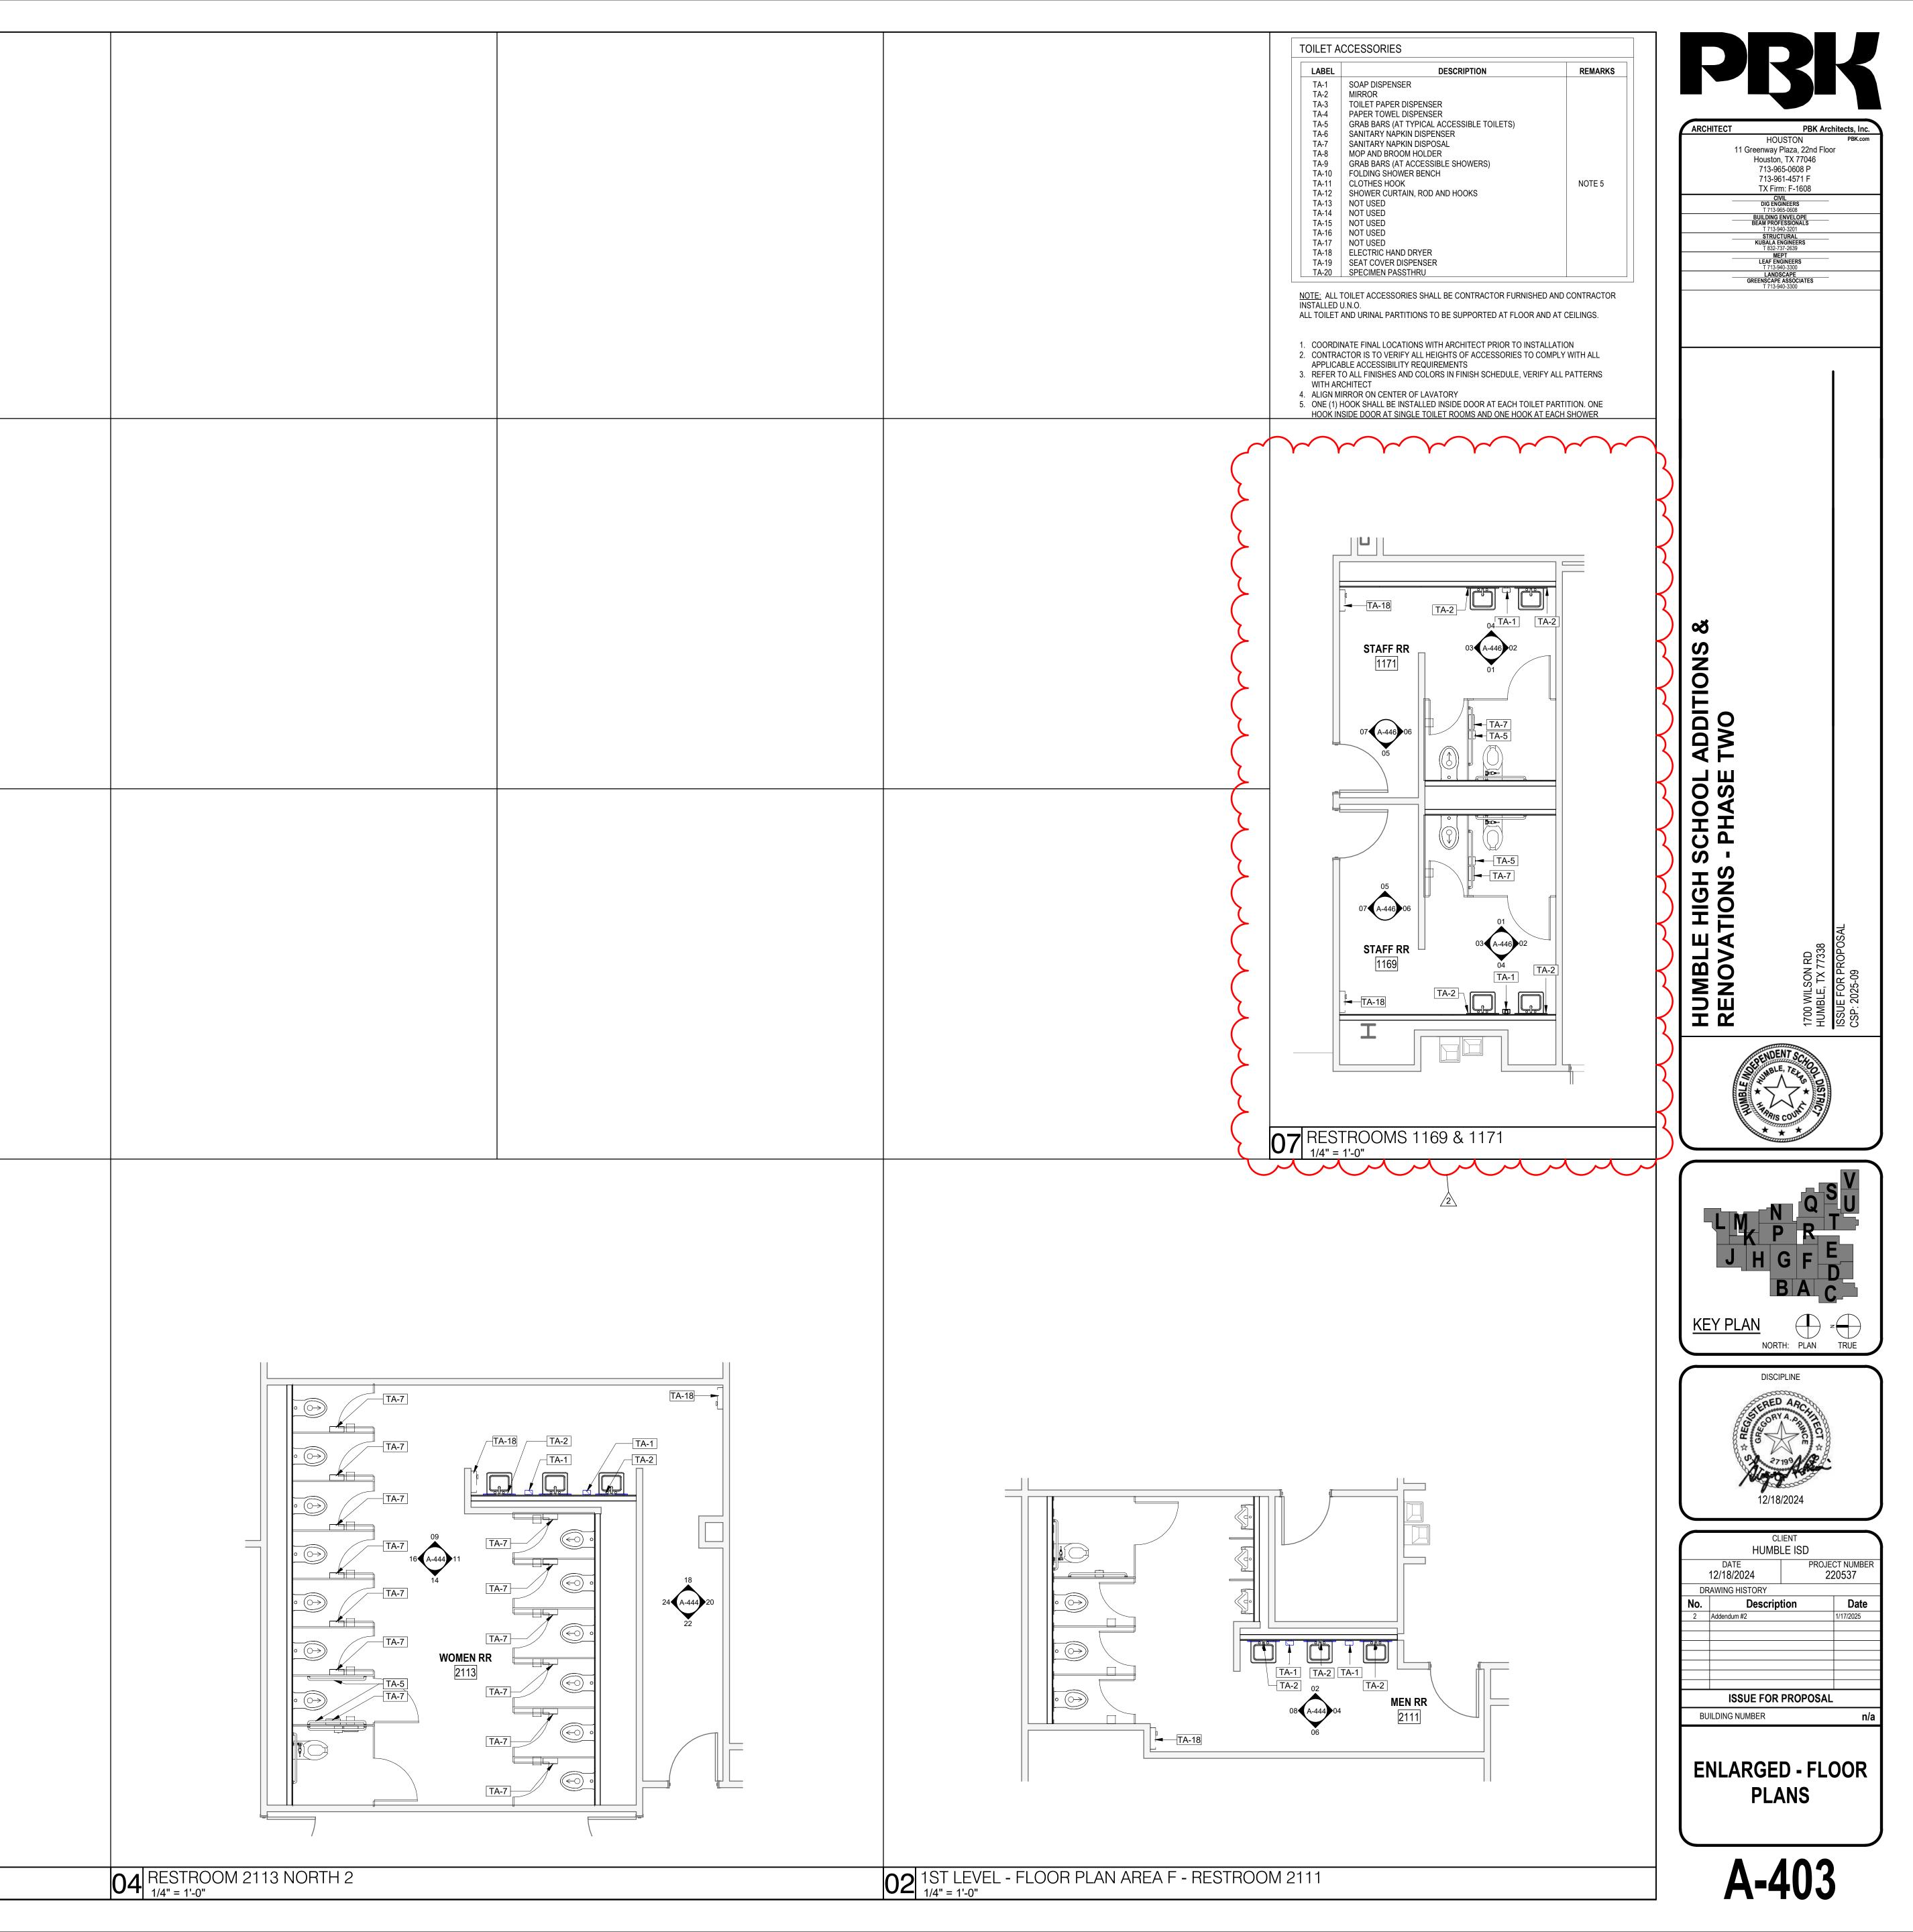

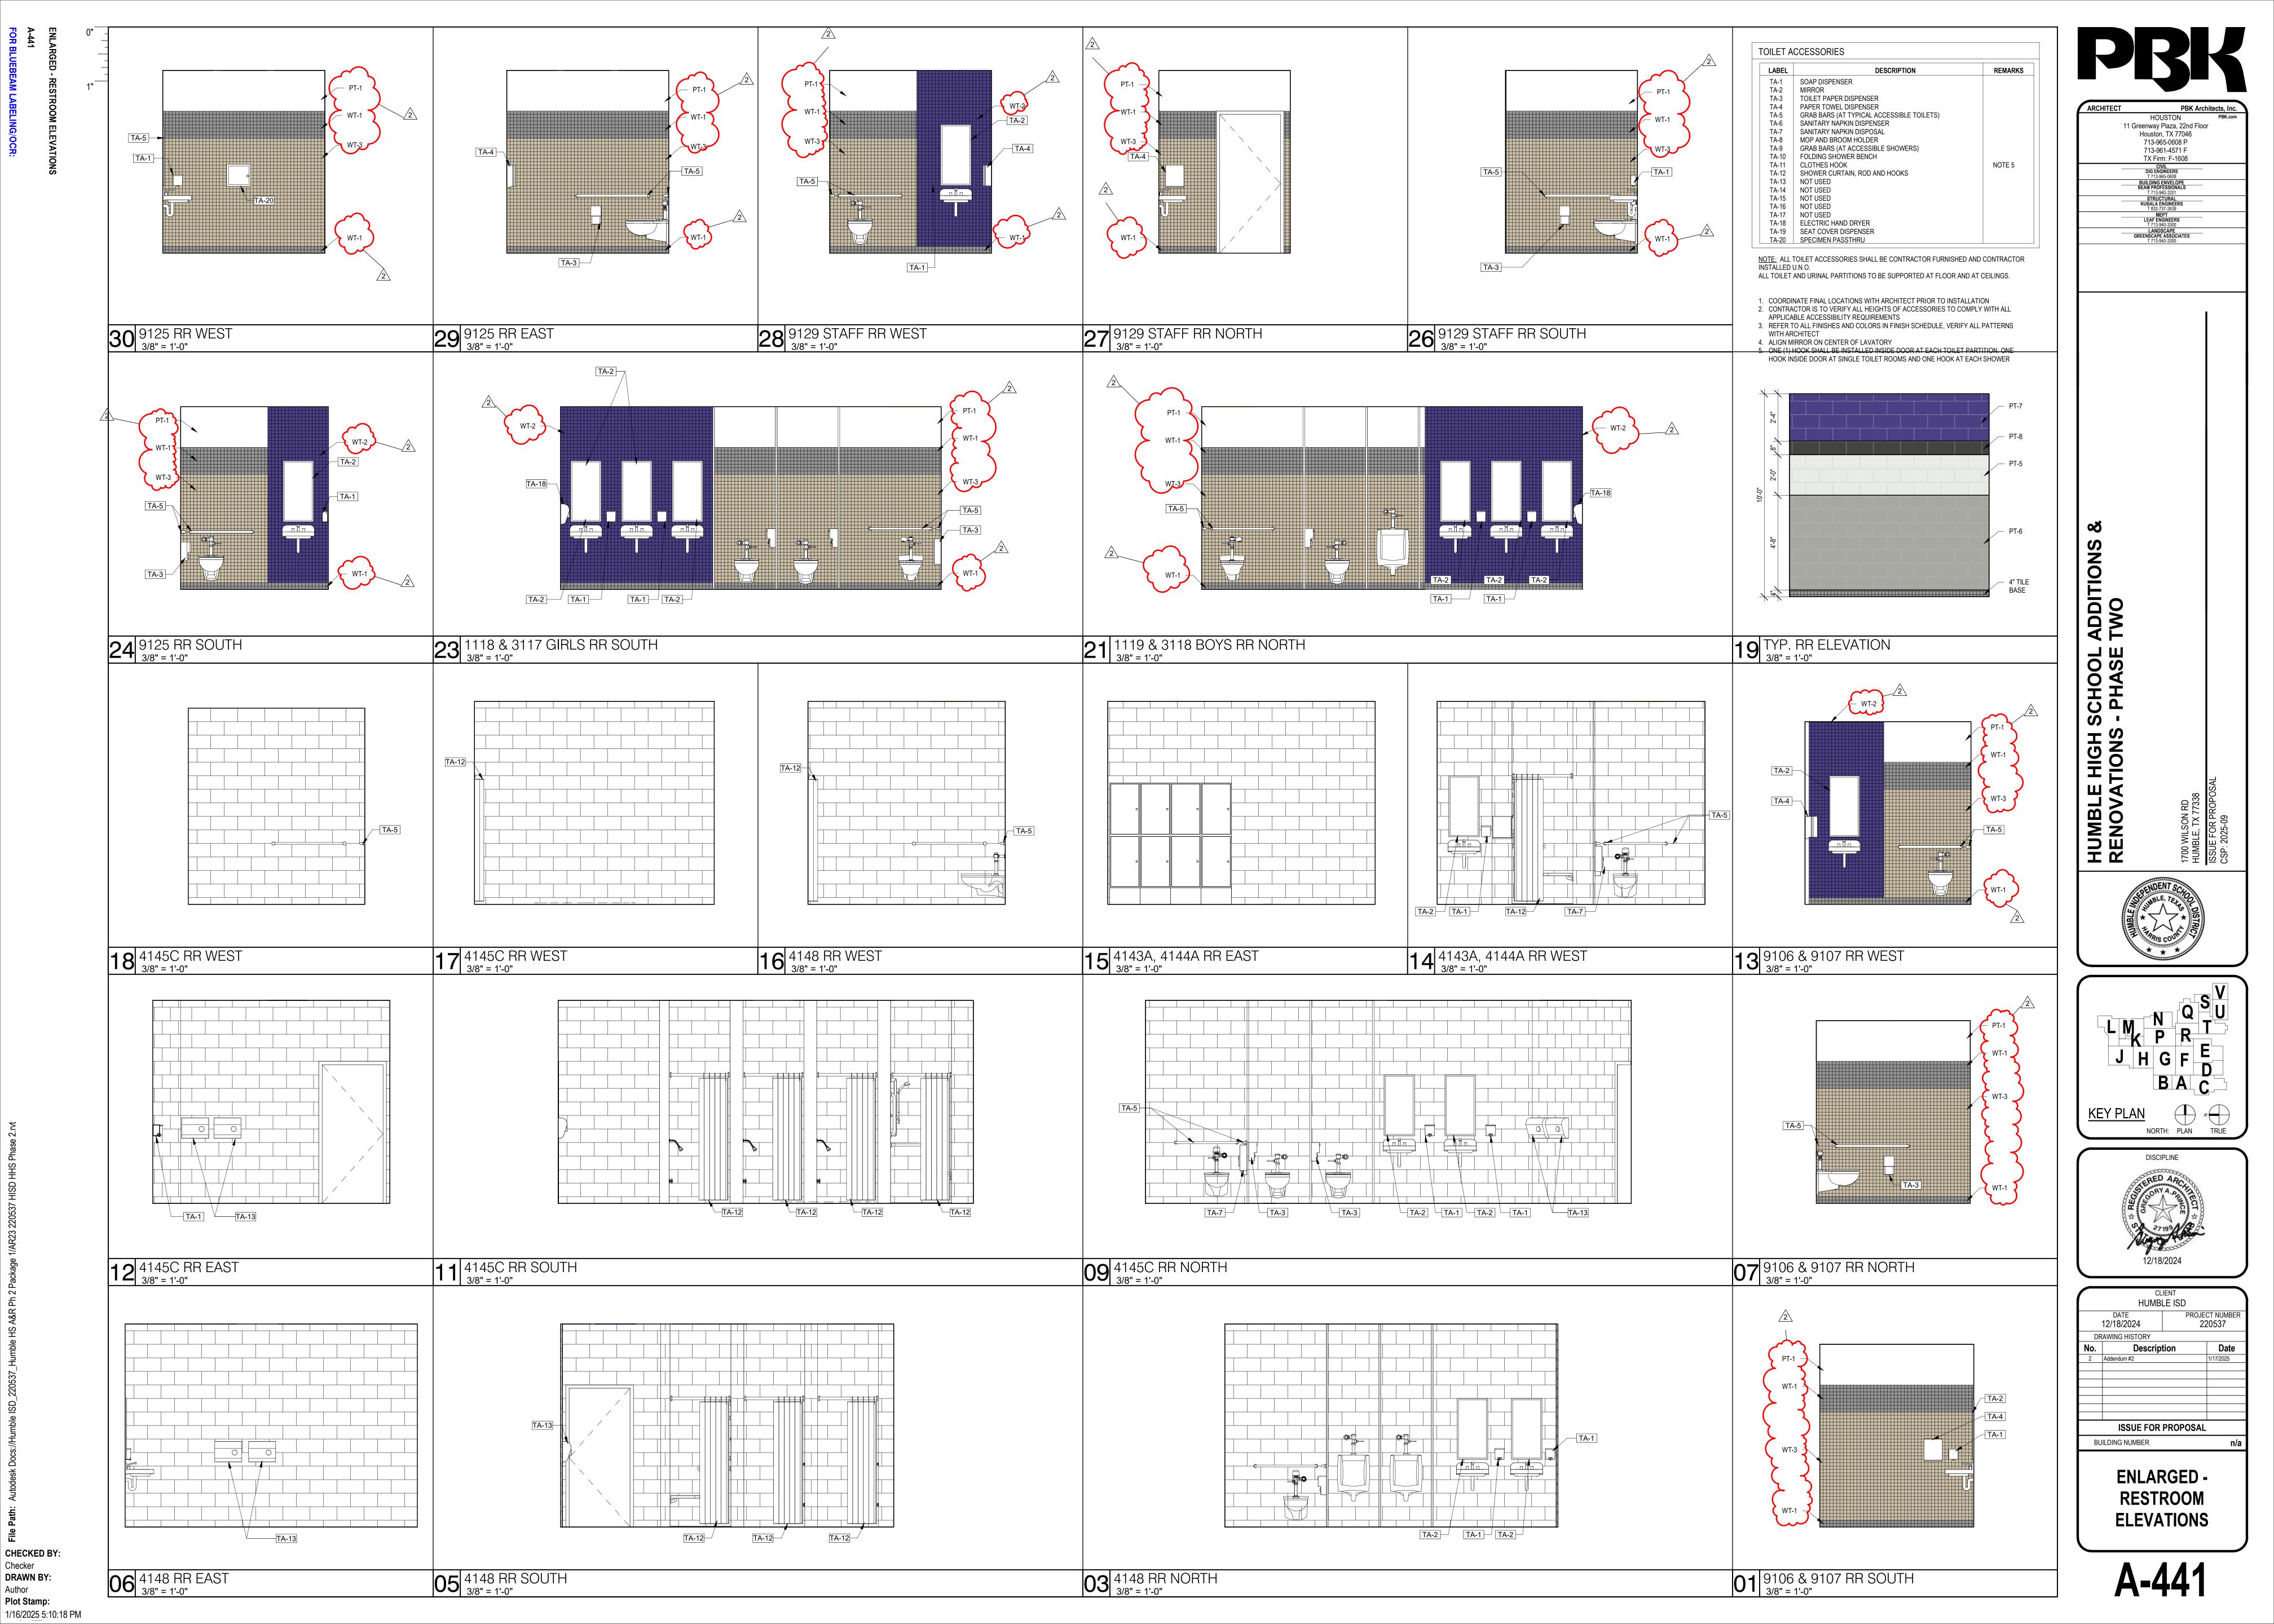


-44 0R

Checker Author

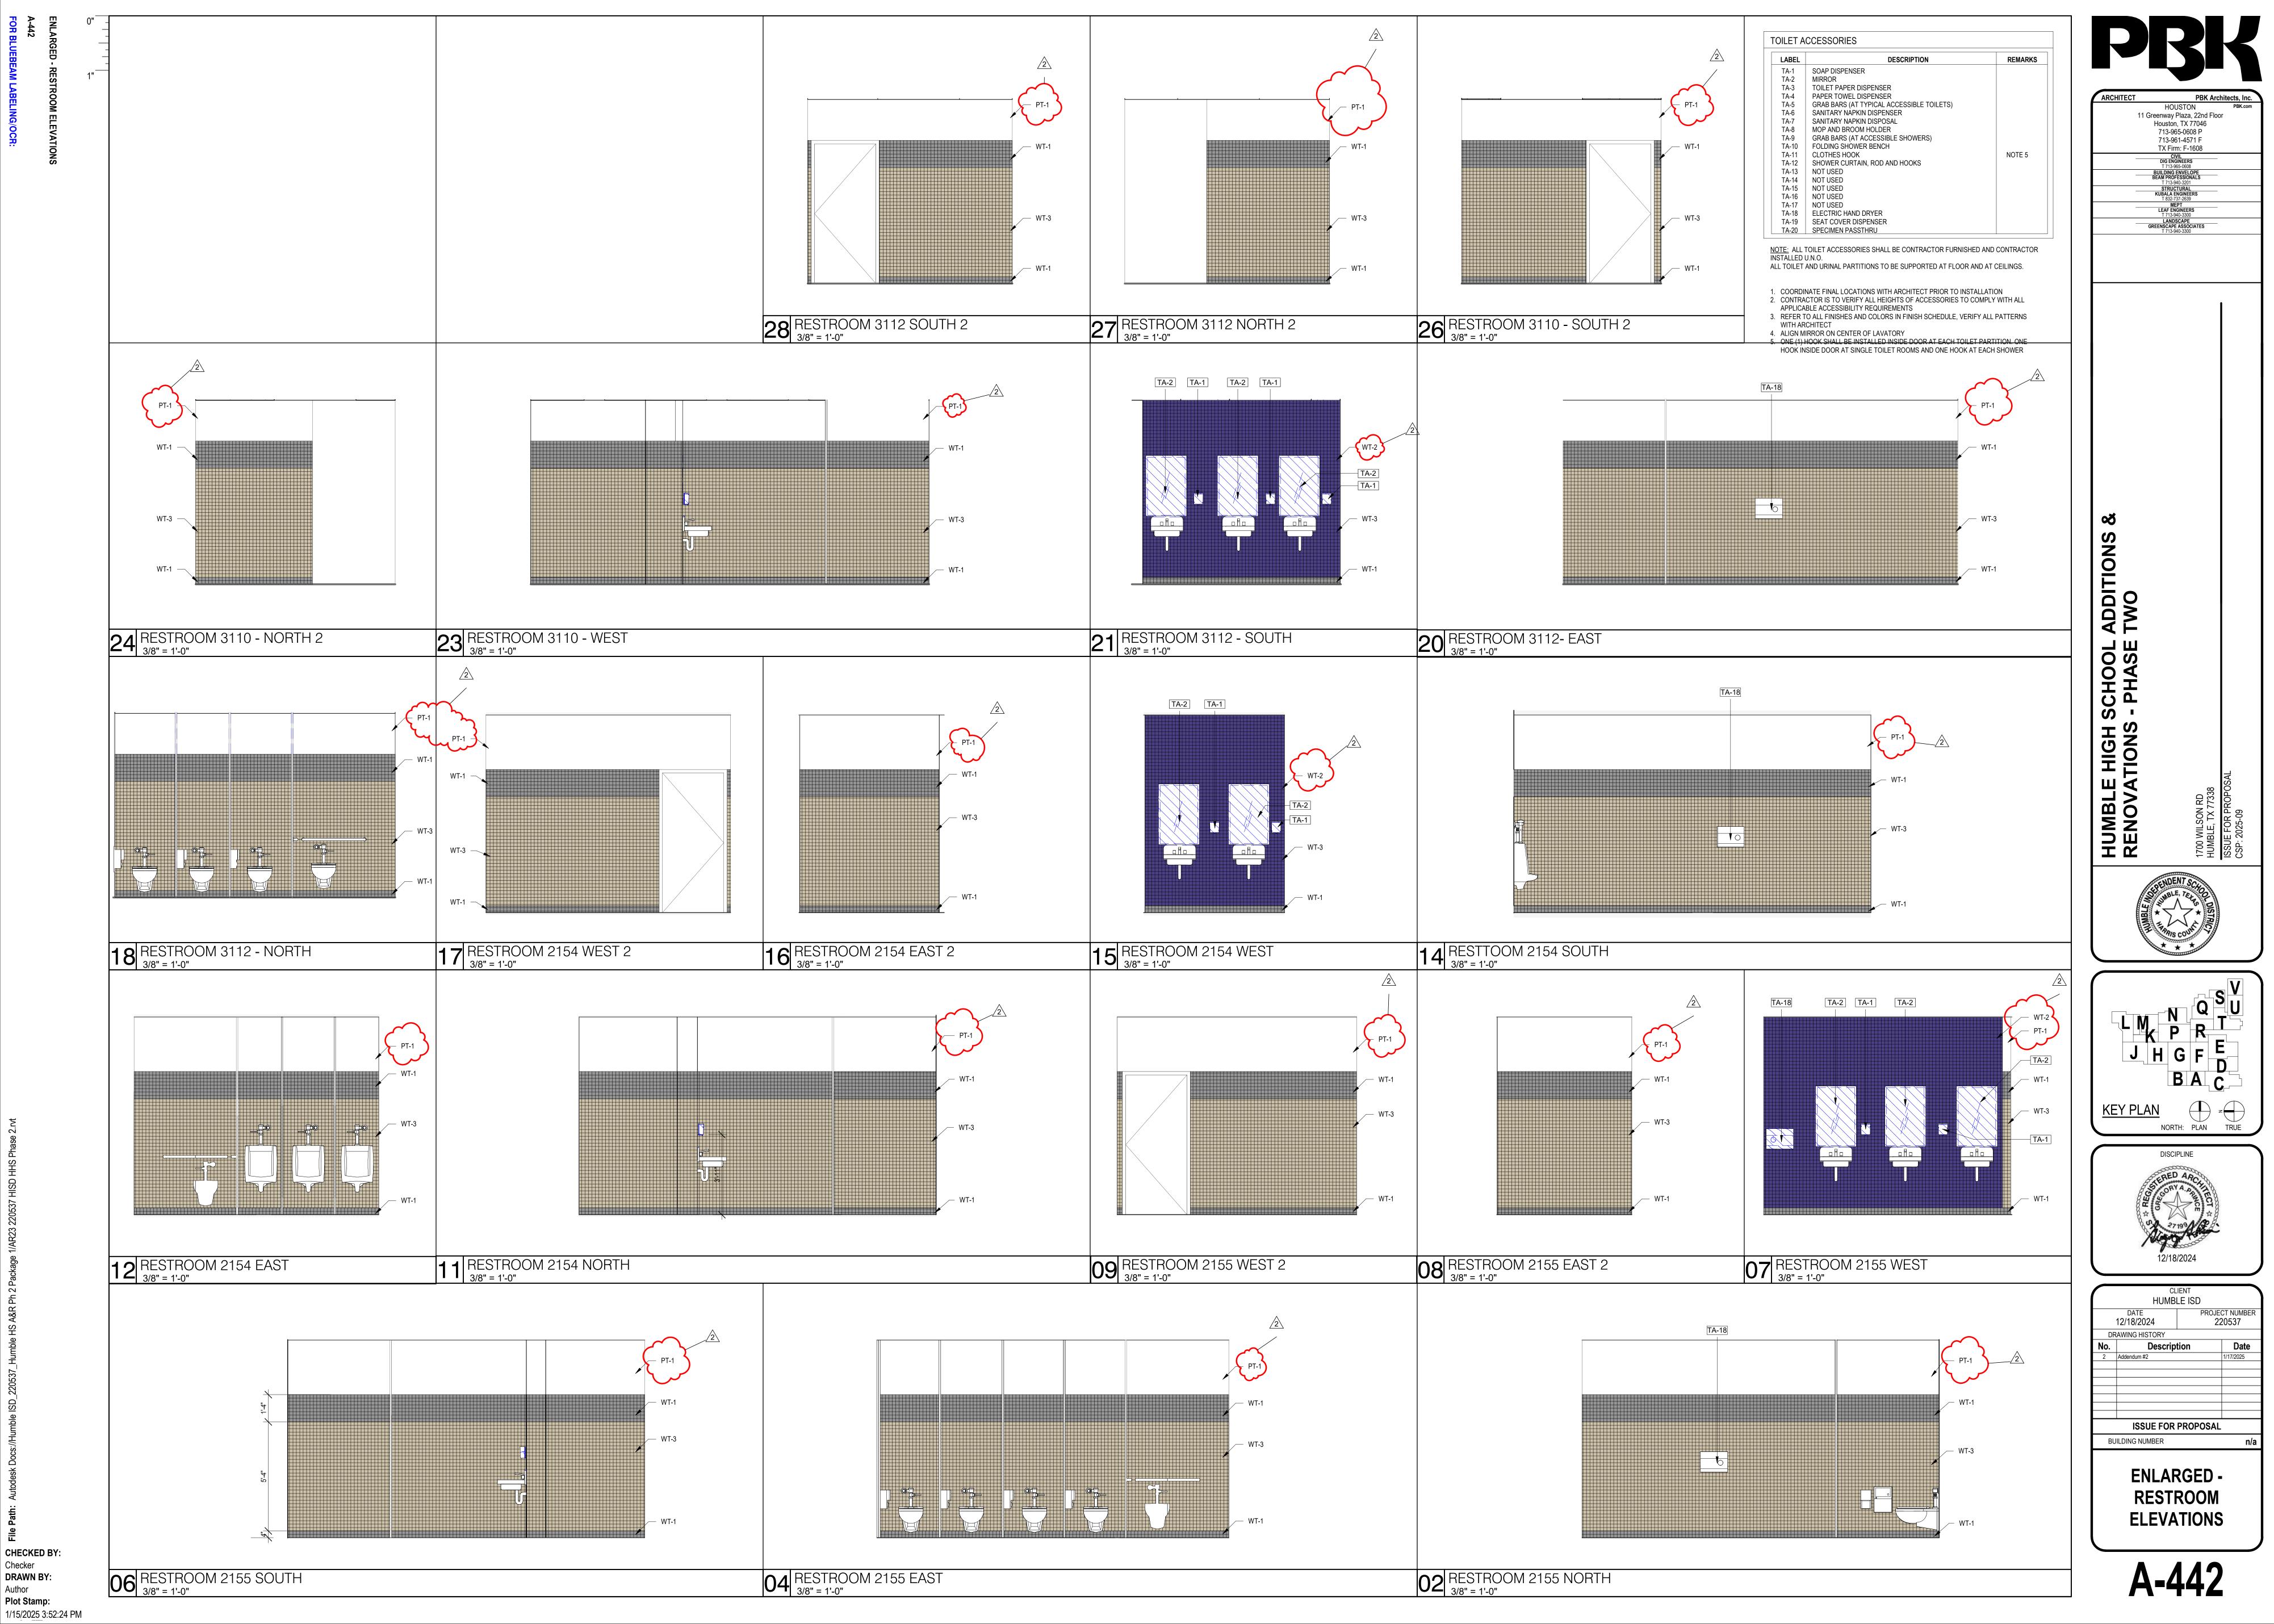

-442 OR

CHECKED BY: Checker DRAWN BY: Author Plot Stamp:

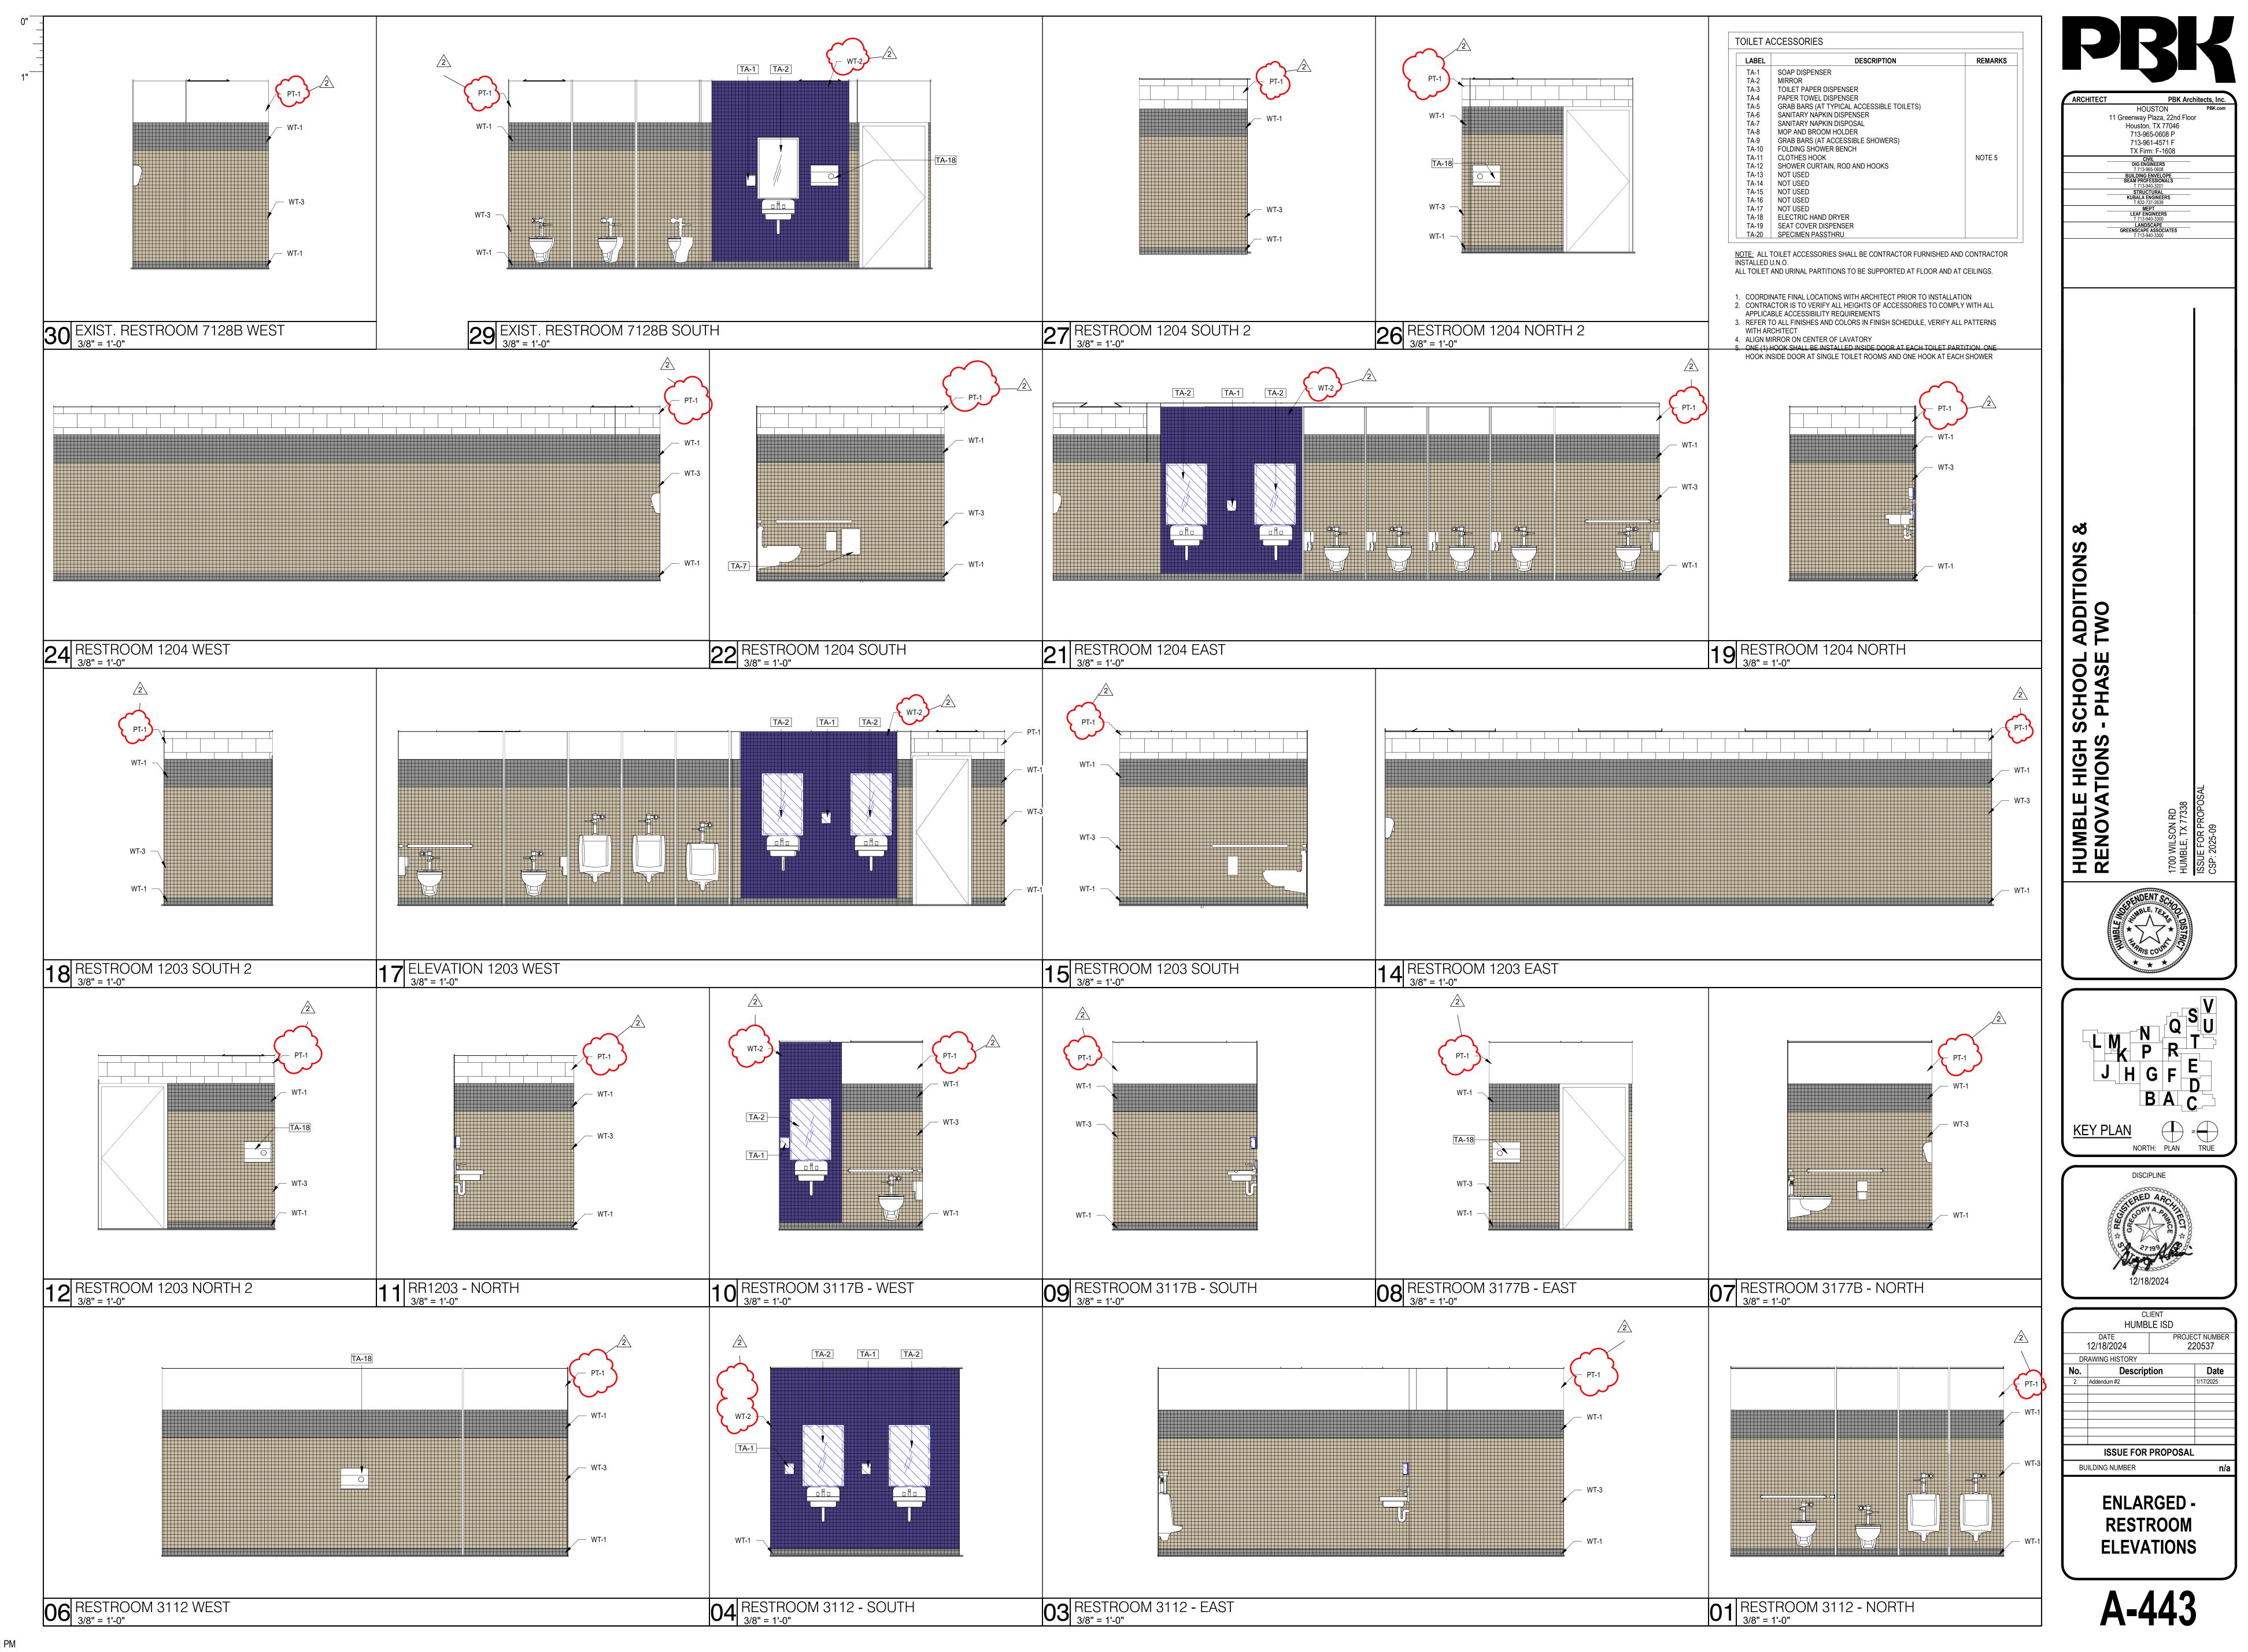

-443 Dr Bluebeam Labeling/ocr:

 File Path:
 Autodesk Docs://Humble ISD_220537_Humble HS A&R Ph 2 Package 1/AR23 220537 HISD HHS Phase 1

 Appendix History
 Autodesk Docs://Humble ISD_220537_Humble HS A&R Ph 2 Package 1/AR23 220537 HISD HHS Phase 1

 Appendix History
 Autodesk Docs://Humble ISD_220537_Humble HS A&R Phase 1

 Appendix History
 Autodesk Docs://Humble ISD_220537_Humble HS A&R Phase 1

 Appendix History
 Autodesk Docs://Humble ISD_220537_Humble HS A&R Phase 1


 Appendix History
 Autodesk Docs://Humble ISD_220537_Humble HS A&R Phase 1

 Appendix History
 Autodesk Docs://Humble ISD_220537_Humble HS A&R Phase 1


 Appendix History
 Autodesk Docs://Humble ISD_220537_Humble HS A&R Phase 1

 Appendix History
 Autodesk Docs://Humble ISD_220537_Humble ISD_220537_Humble ISD_220537_Humble ISD_220537_Humble ISD_220537_Humble ISD_220537_Humble ISD_220537_Humble IS

Author Plot Stamp: 1/15/2025 2:24:31 PM

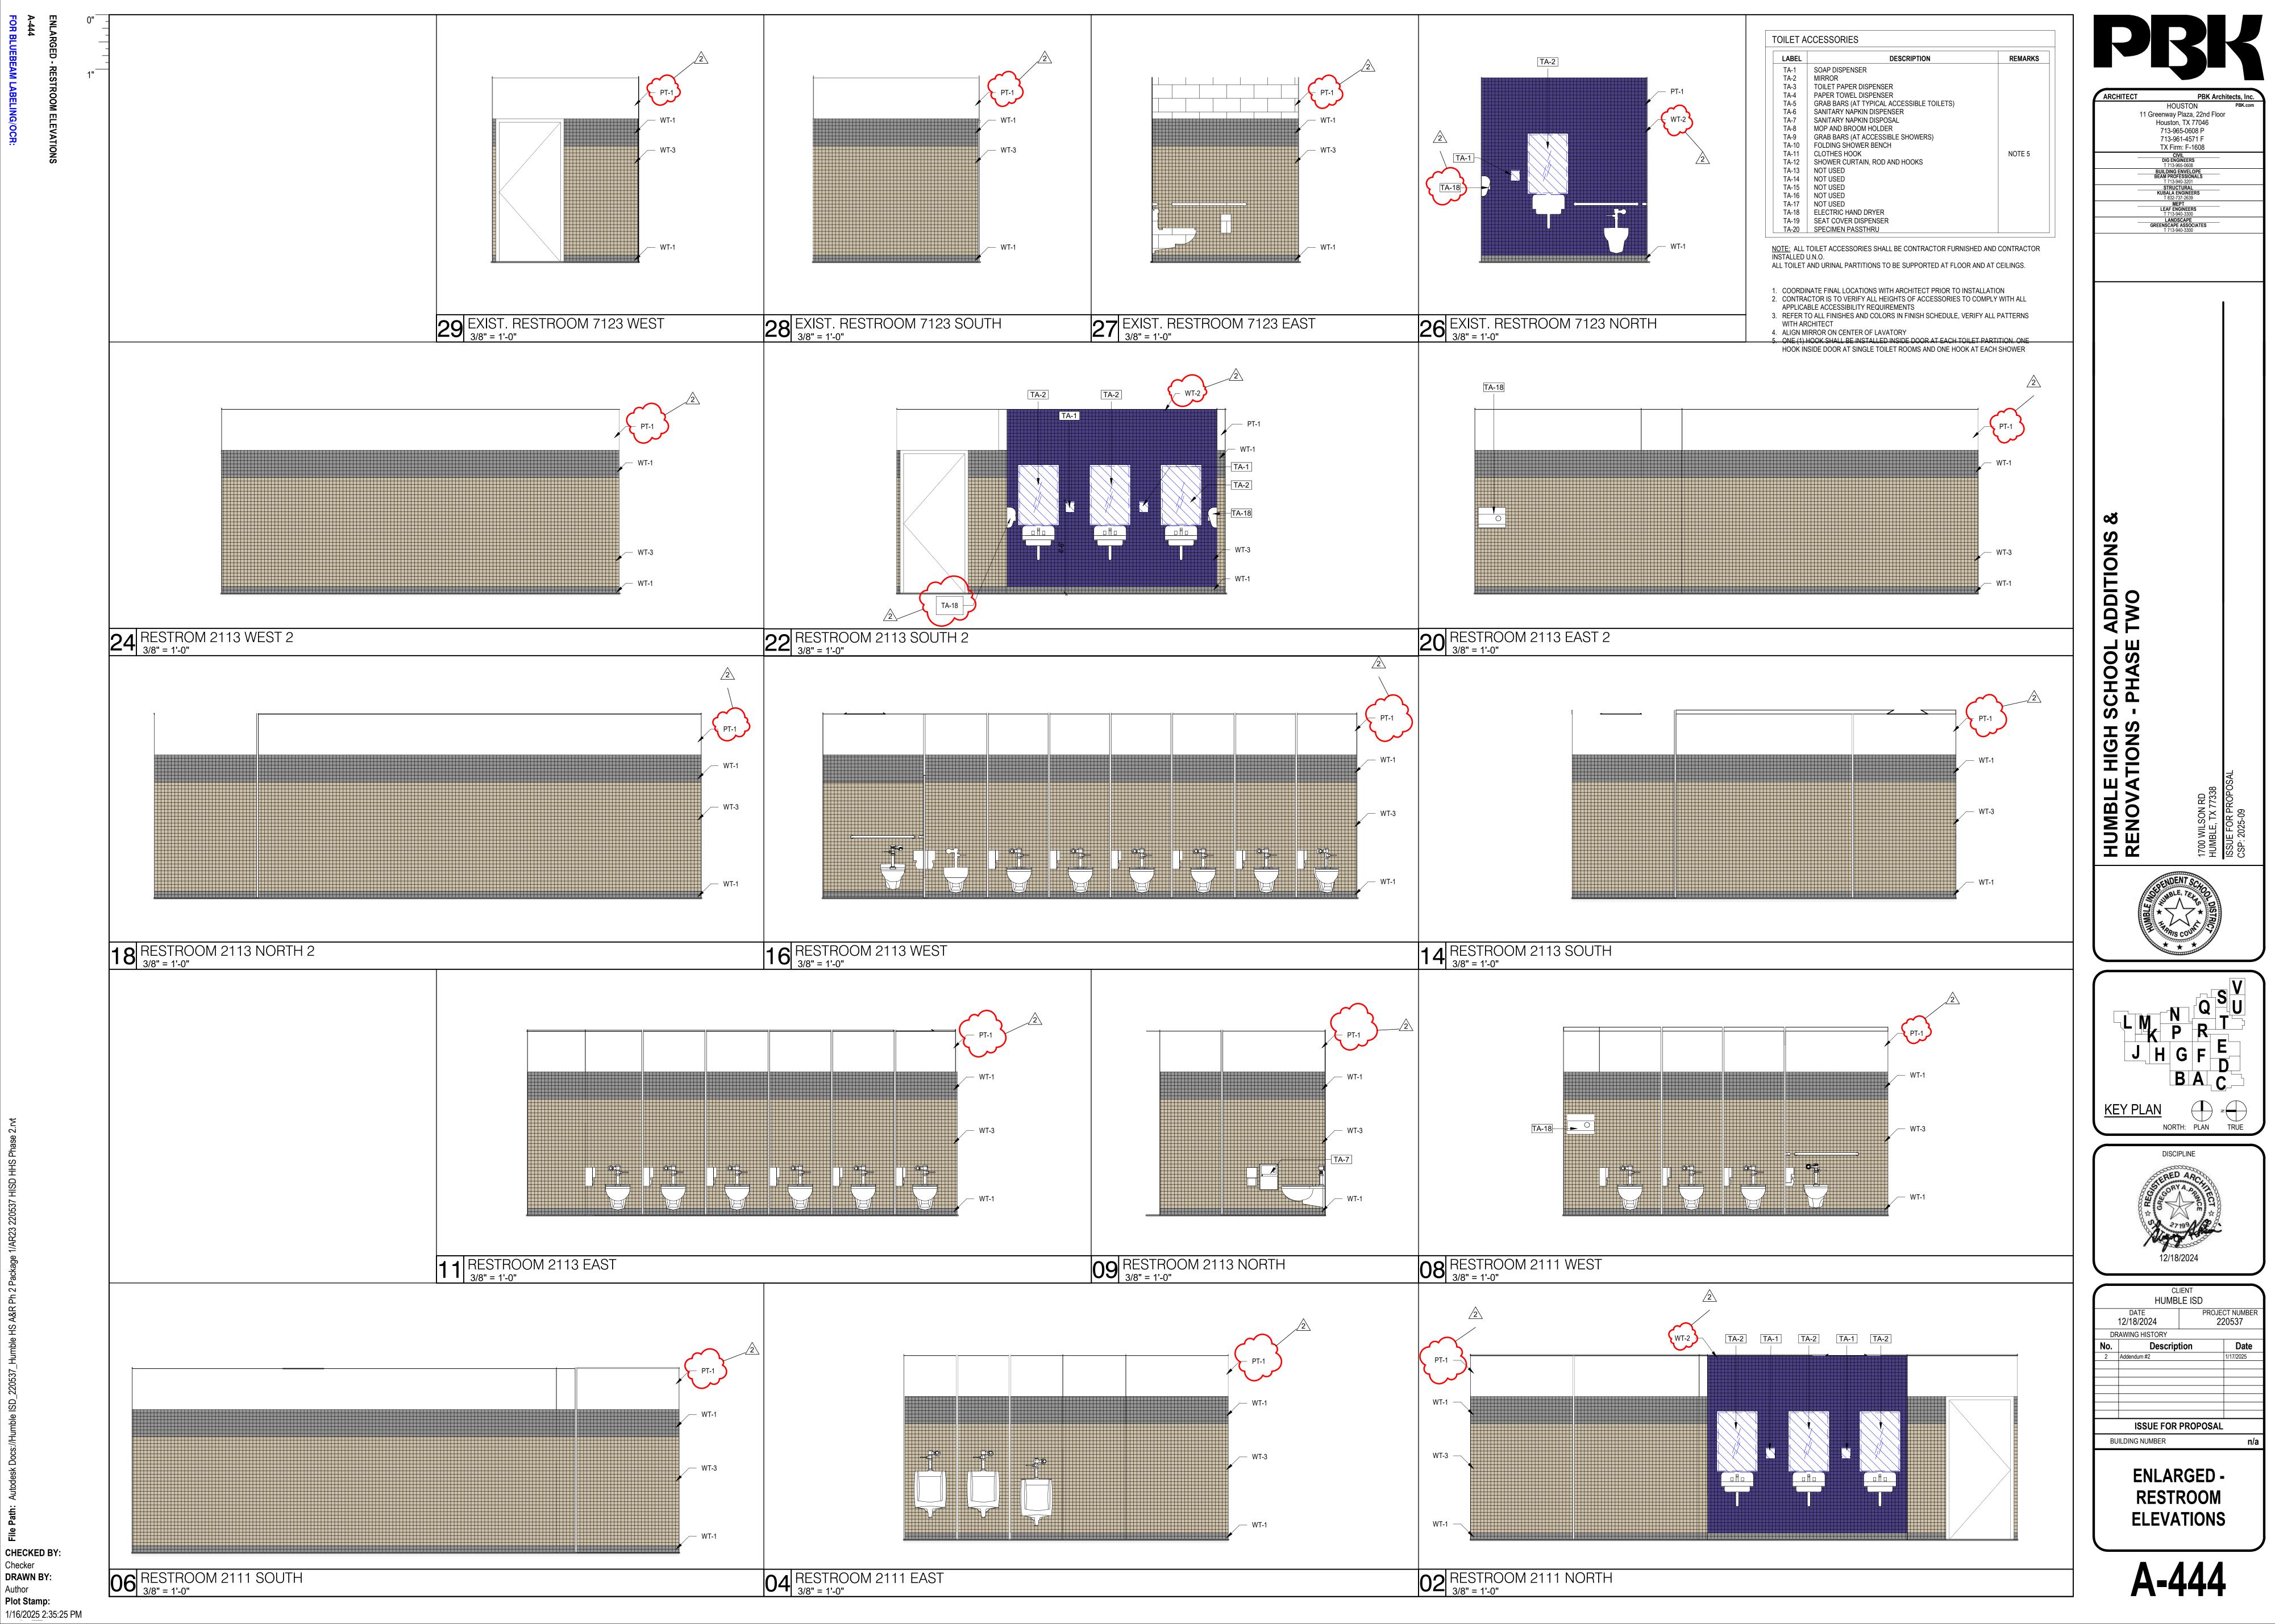

445 Dr Bluebeam Labeling/ocr:

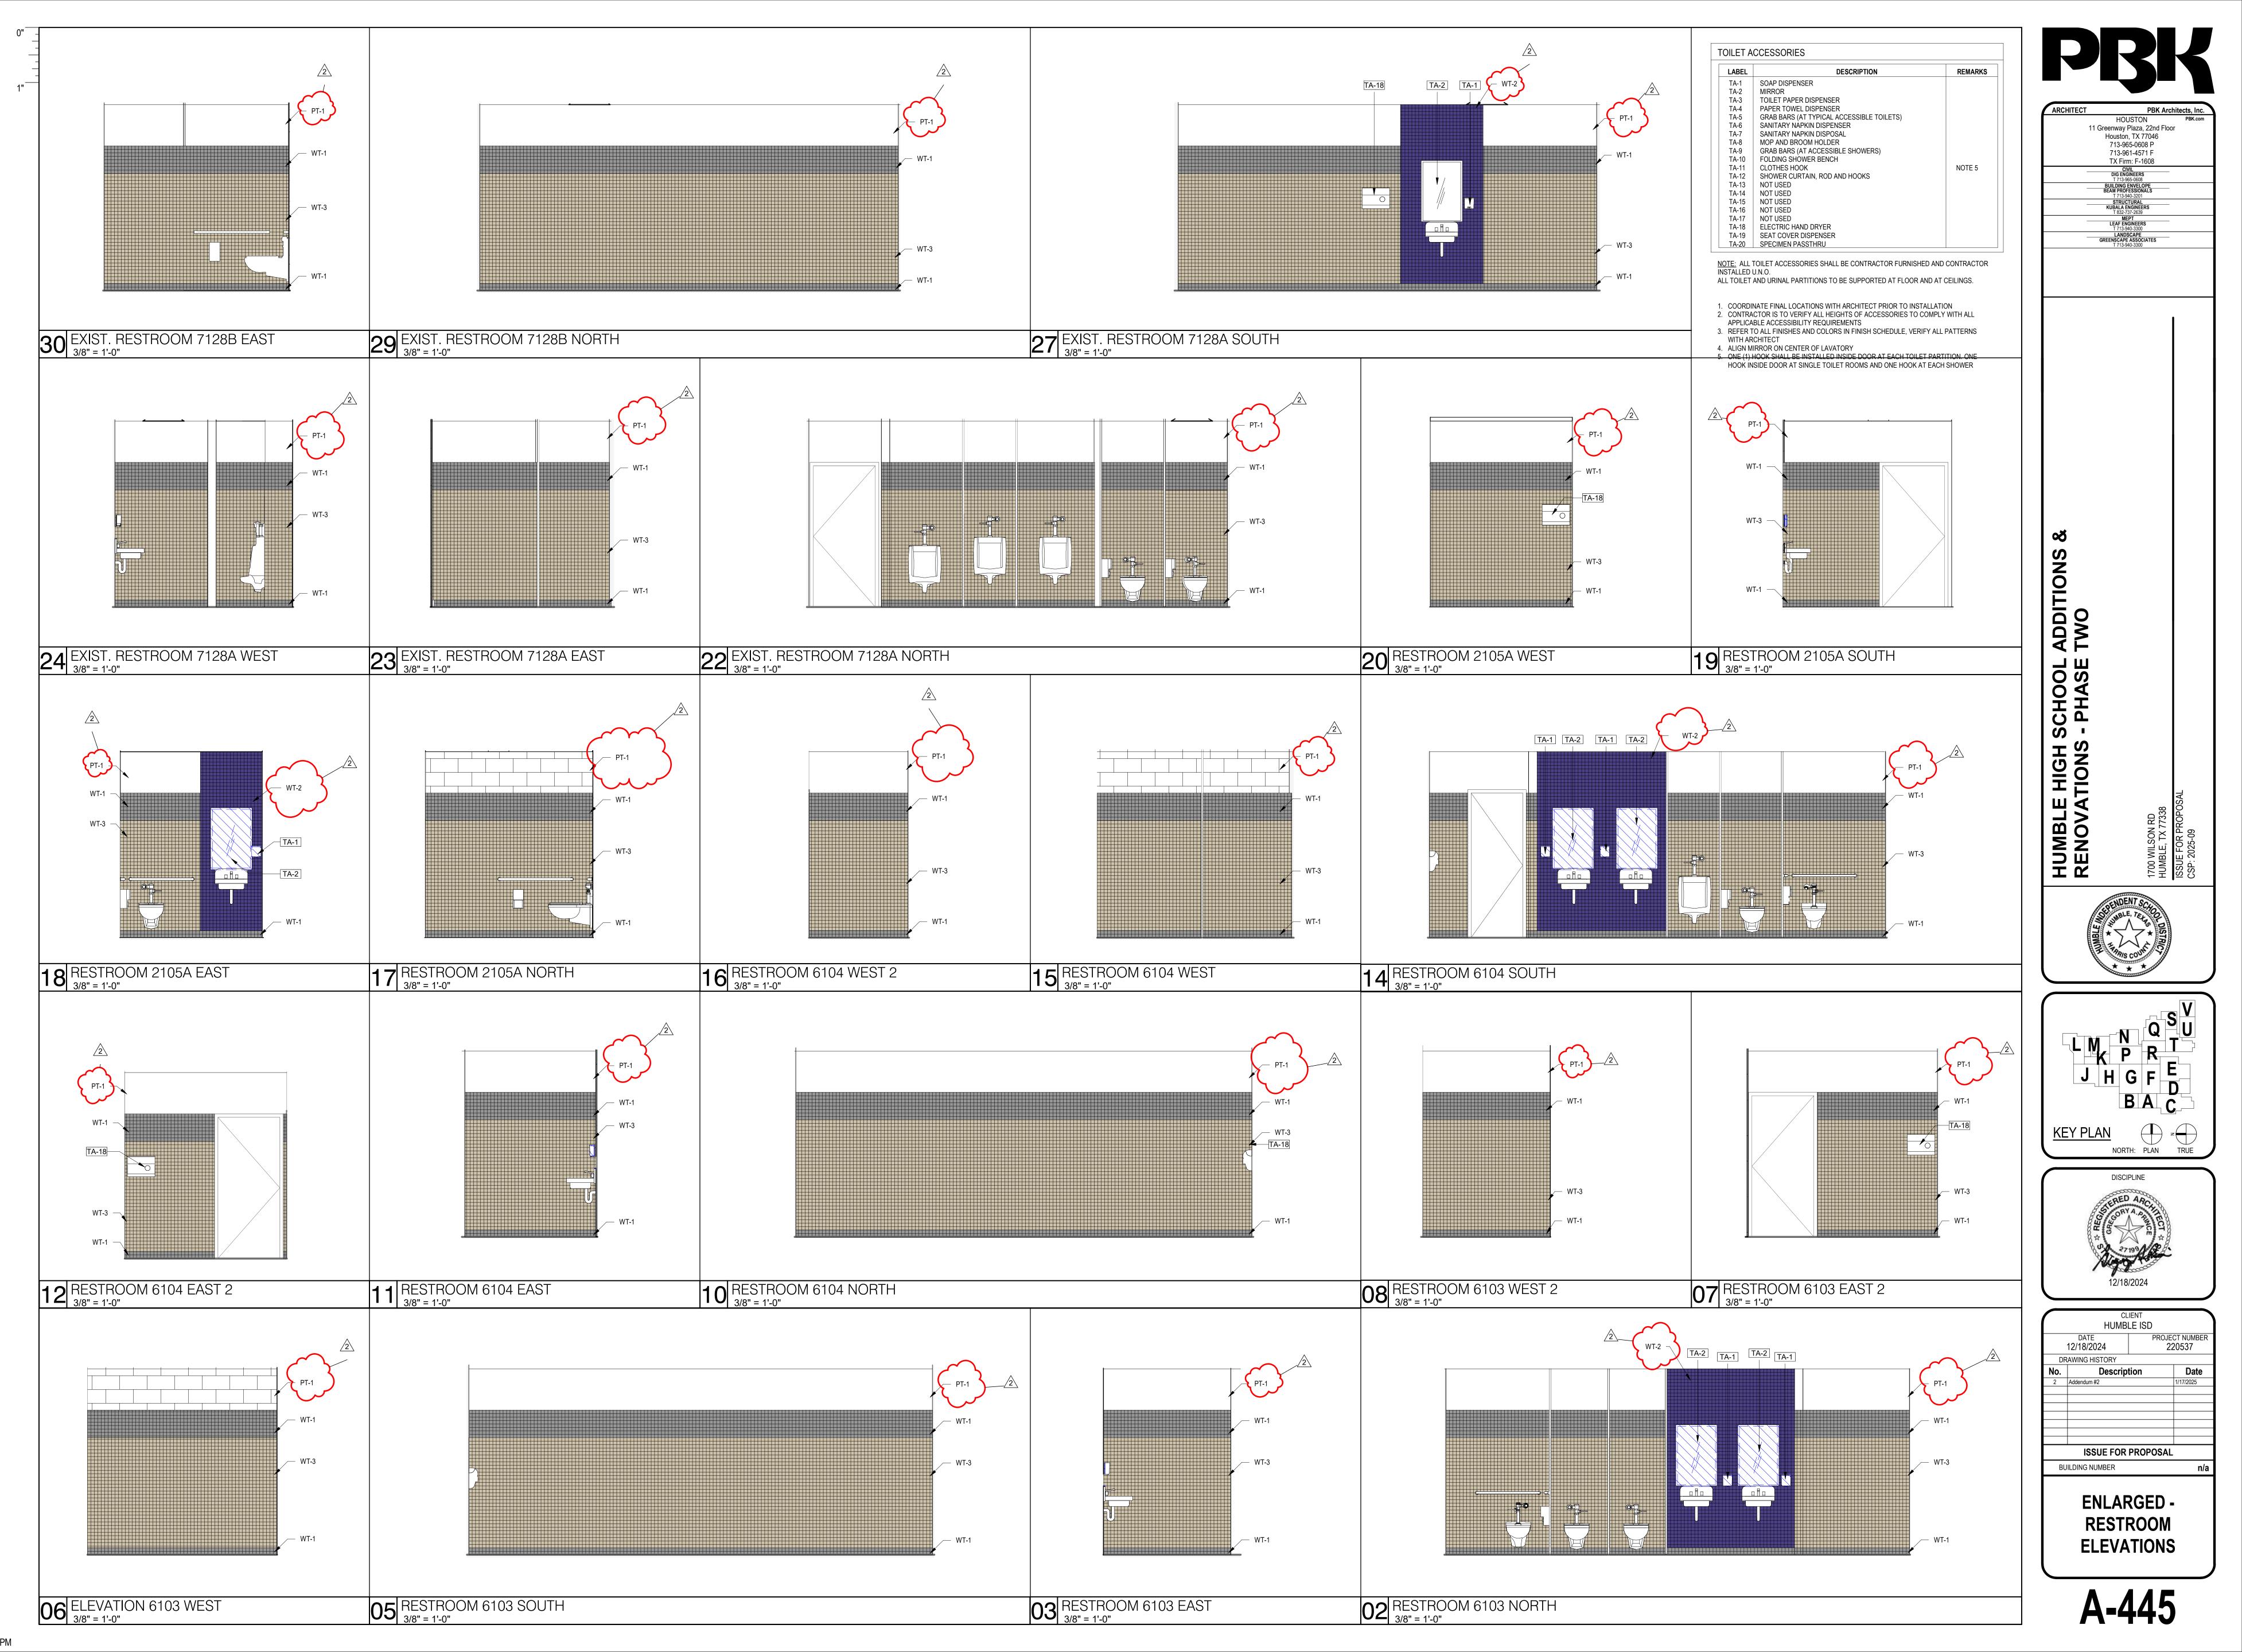


File Path: Autodesk Docs://Humble ISD_220537_Humble HS A&R Ph 2 Package 1/AR23 220537 HISD HHS Phatmache States and the second states and the second states and the second states and the second states are second states and second states are second states and second states are second states and second states are second are second states are second states

Author Plot Stamp: 1/15/2025 3:30:42 PM

A-446 FOR BLUEBEAM LABELING/OCR:	ENLARGED - RESTROOM ELEVATIONS	0"	4	
JEBEAM	ED - RES	 		
LABELI	STROON			
NG/OC	I ELEVA			
<i>.</i> ч	TIONS			
e 2.rvt				
HS Phas				
H QSIH .				
3 220537				
je 1/AR2;				
2 Packaç				
A&R Ph				
mble HS			PT-1	PT-1
1537_Hur				
Autodesk Docs://Humble ISD_220537_Humble HS A&R Ph 2 Package 1/AR23 220537 HISD HHS Phase 2.rvt			WT-1	WT-1
/Humble			WT-3	WT-3
sk Docs:/			WT-3	WT-3
File Path:			WT-1	WT-1
CHECKE	D BY:			
Checker DRAWN I Author	BY:		06 RESTROOM 1169 EAST 2	05 RESTROOM 1169 NORTH 2 3/8" = 1'-0"

Plot Stamp: 1/15/2025 1:55:36 PM

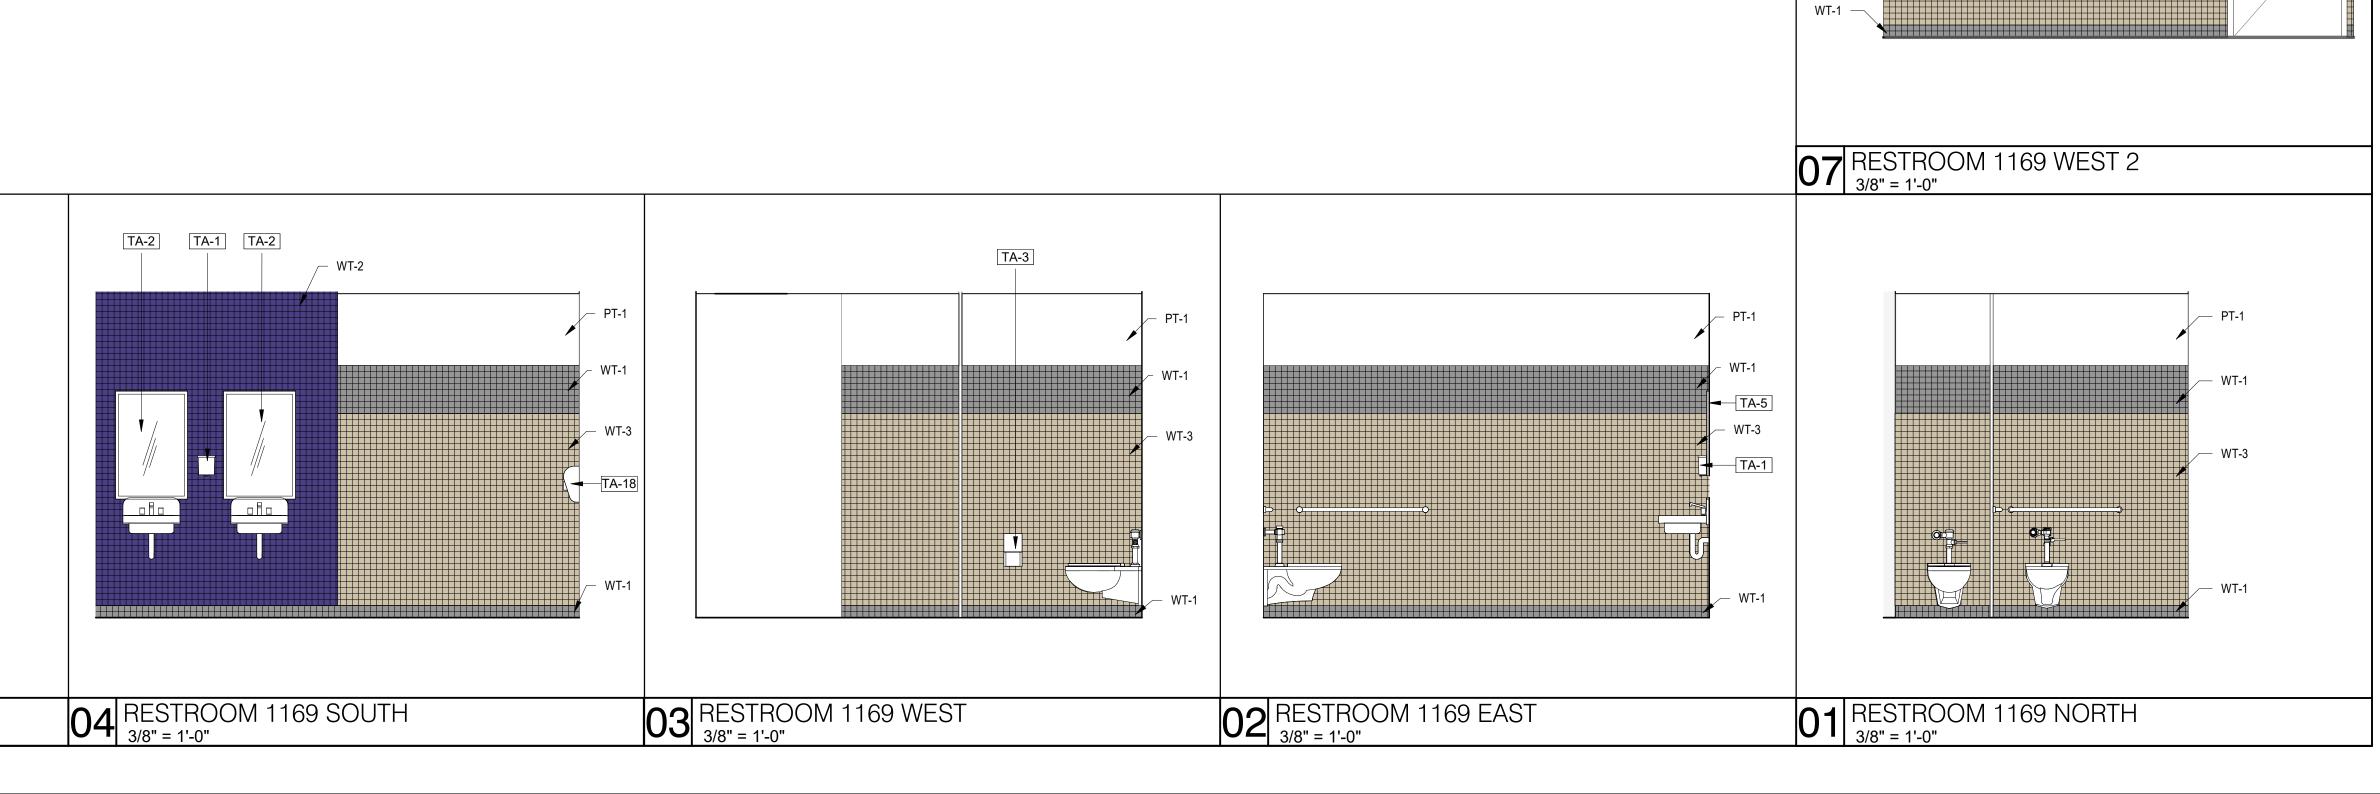


PT-1 -

WT-1 —


TA-18


WT-3 —

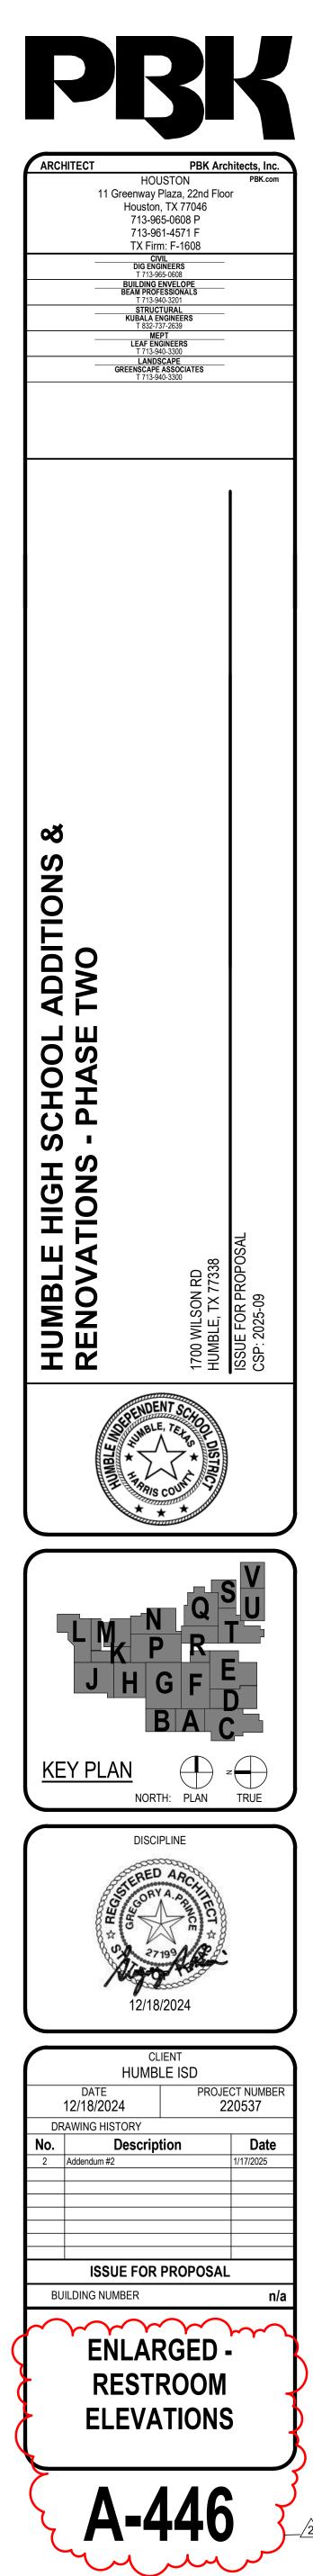




Plot Stamp: 1/16/2025 5:18:34 PM

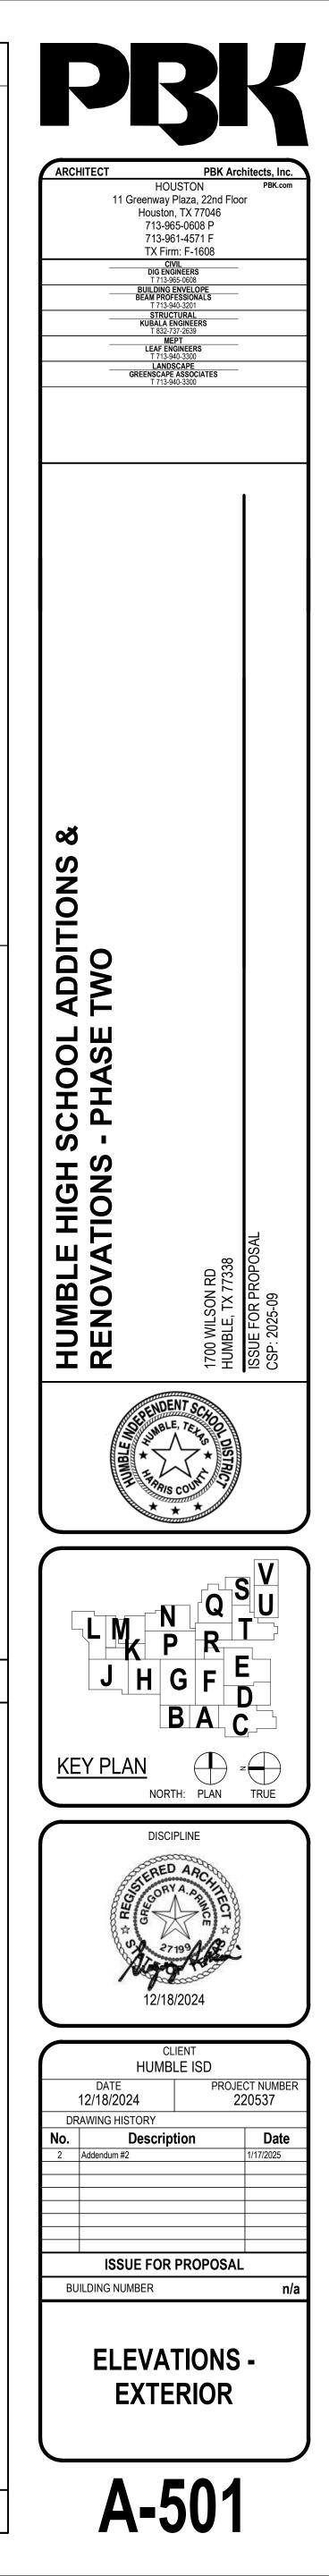


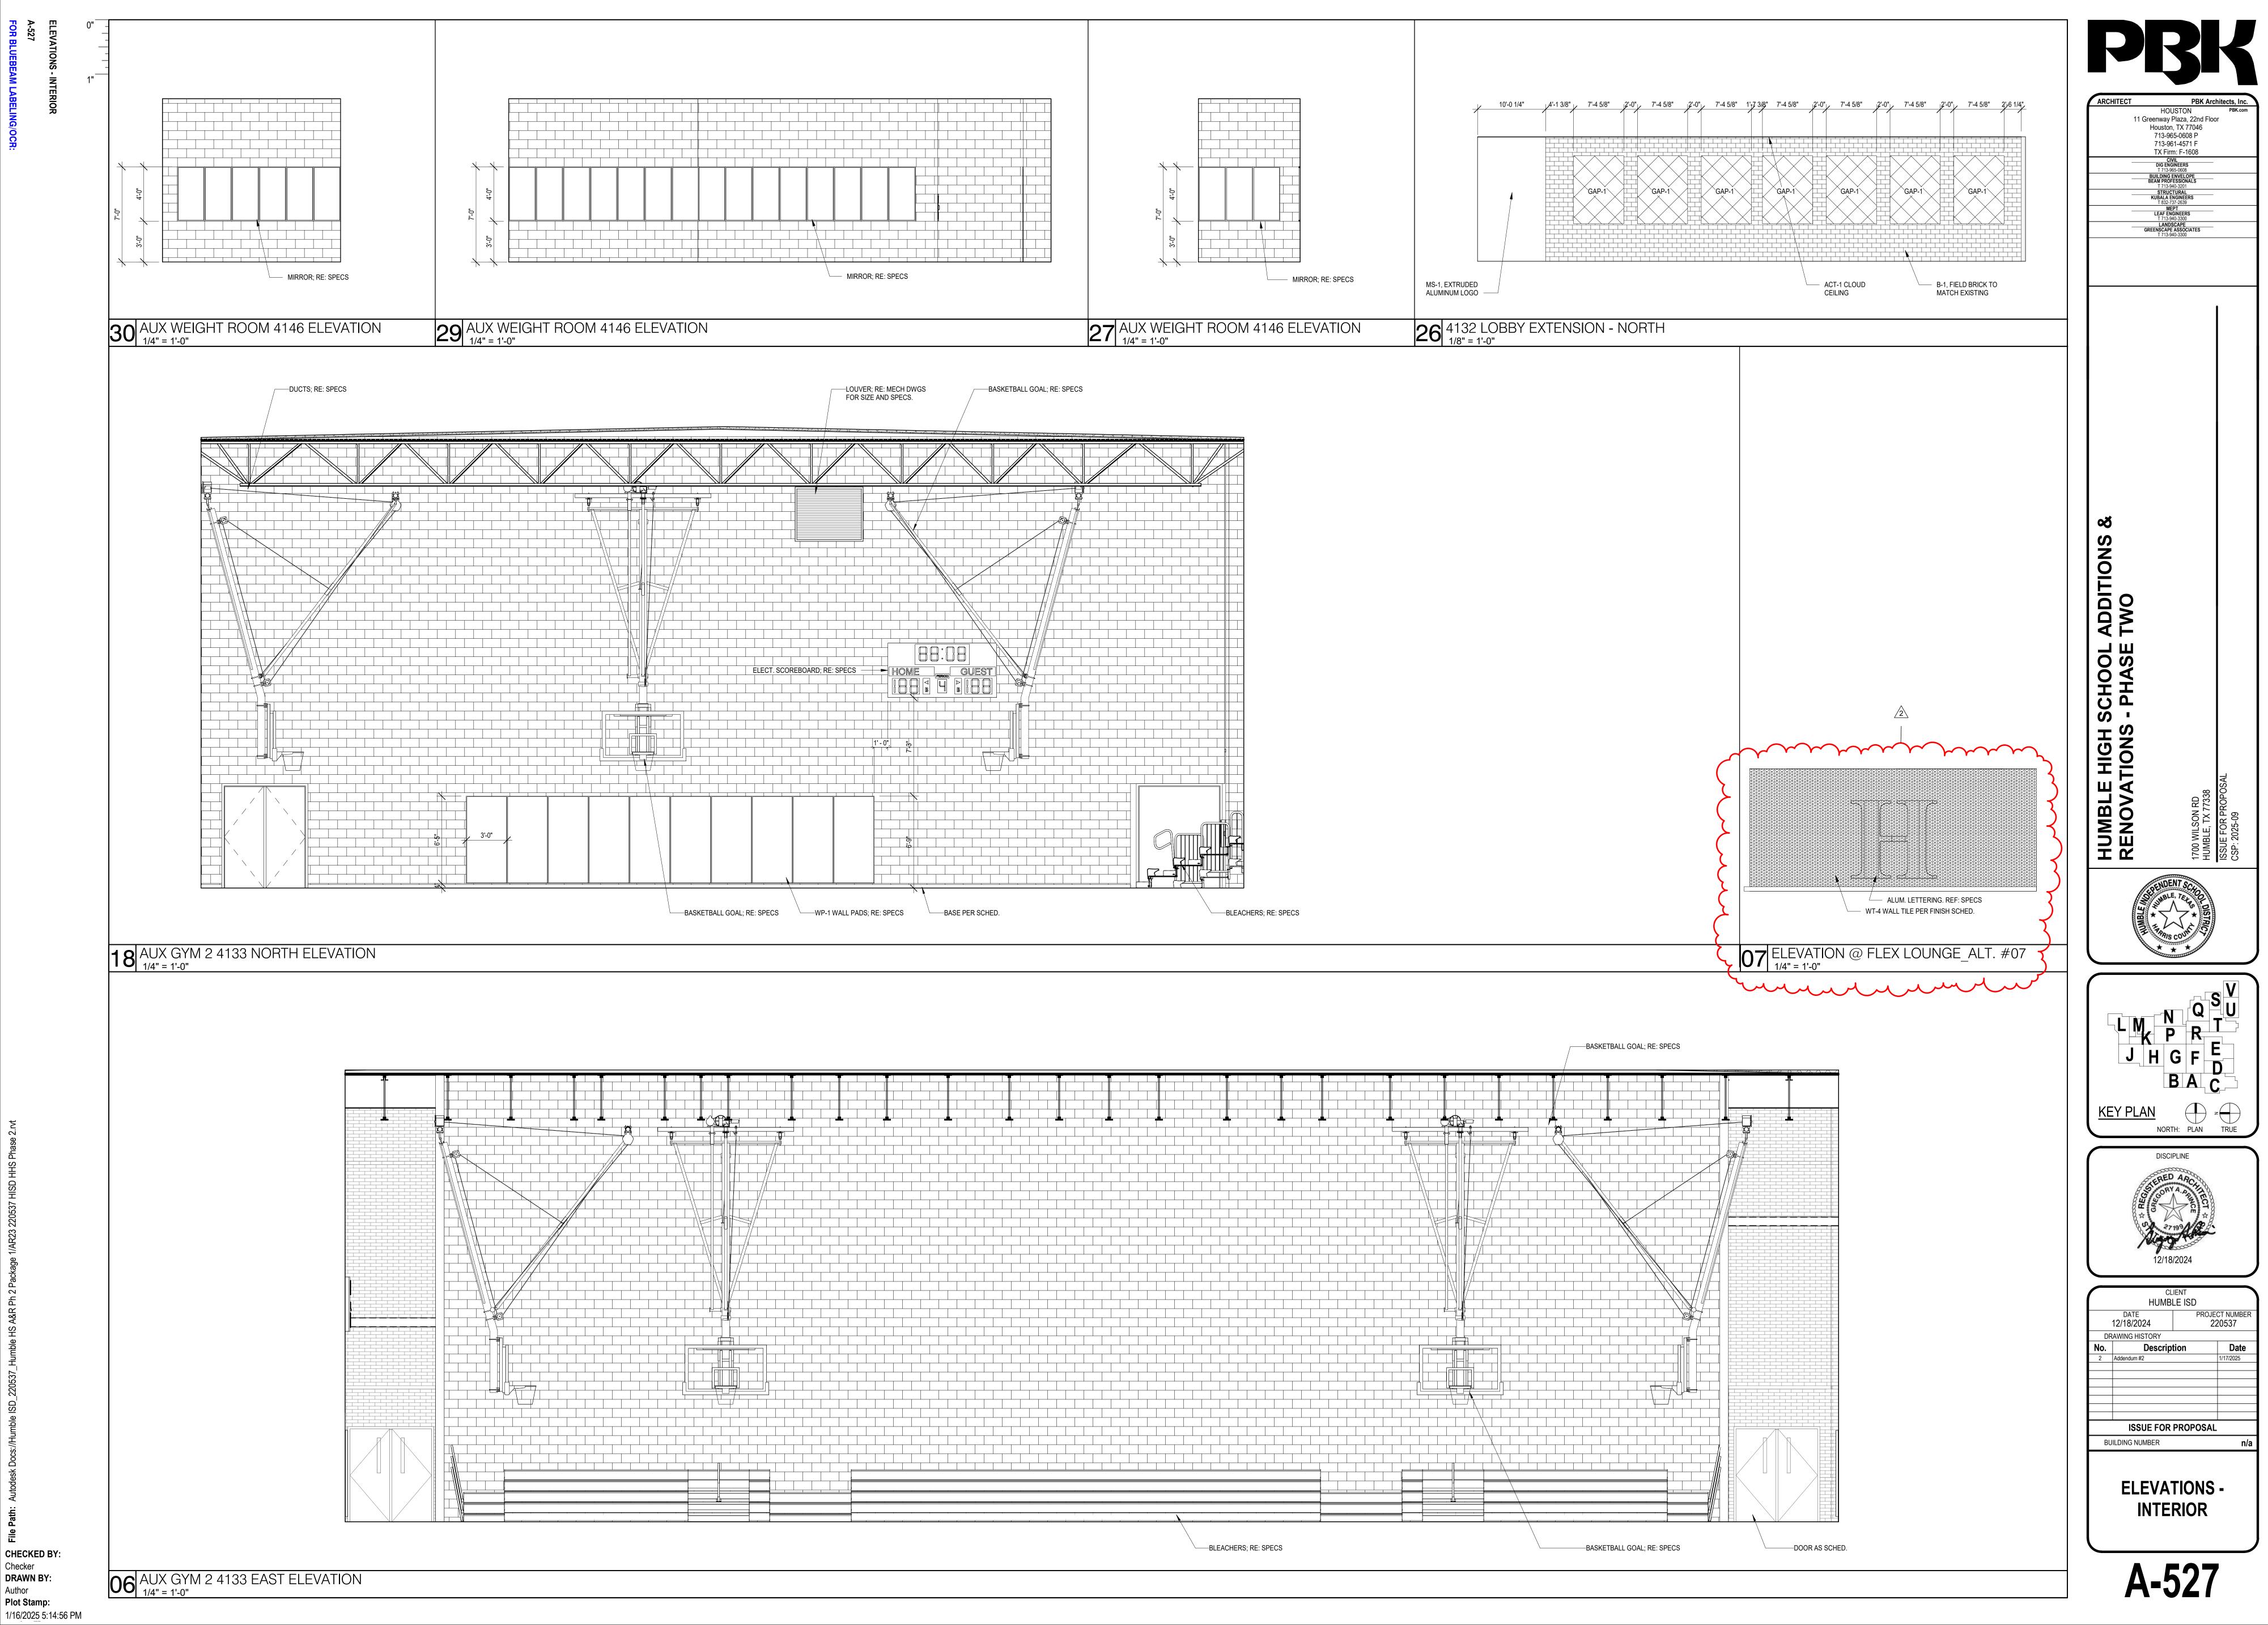

File

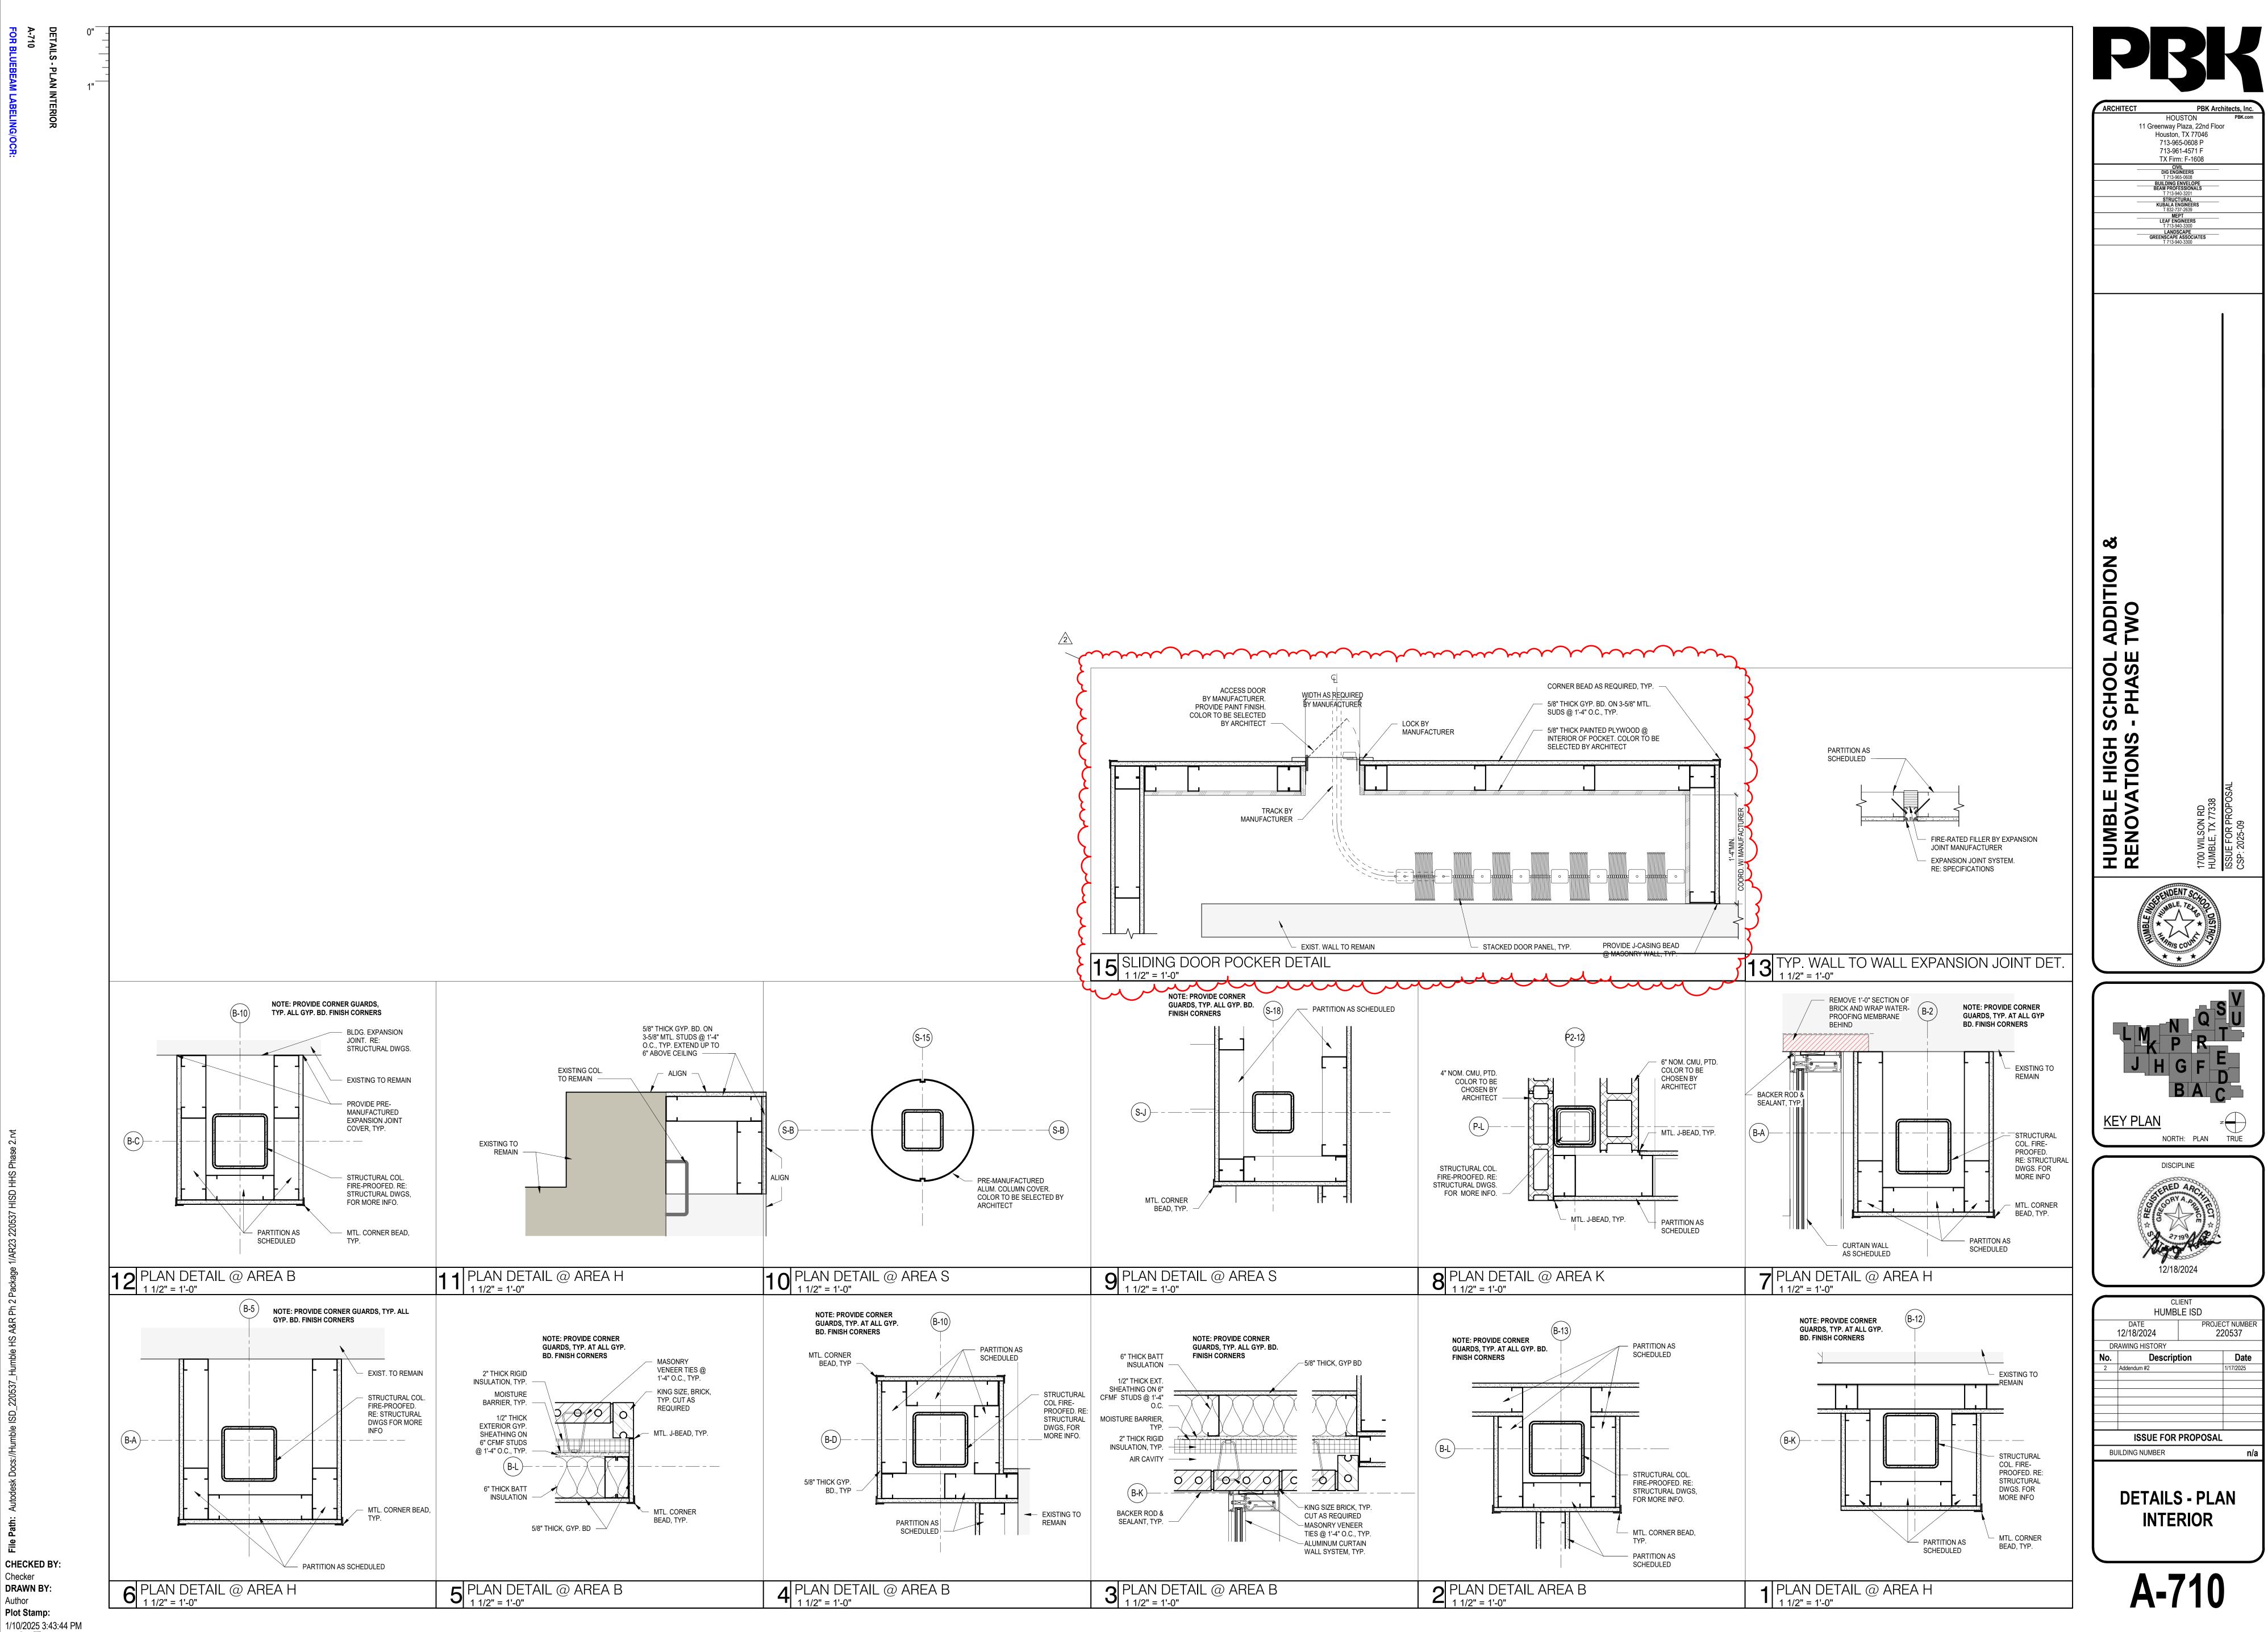

ROOM DATA				WALL FINISHES				CEILINGS	
N⁰	NAME	FLOOR FINISH	BASE FINISH	NORTH	EAST	SOUTH	WEST	FINISH	COMMENTS
			1	1			I	1	
1043	MECH	CS-1	RB-1	PT-1	PT-1	PT-1	PT-1	EXPOSED STRUCTURE	
1100	CORRIDOR	PFT-1/ PFT-2	RB-1	PT-1	PT-1	PT-1	PT-1	ACT-1	PT-1 TO TOP OF DOOR FRAMES
1115	SCIENCE CLASSROOM 01	RF-1	RB-1	PT-1	PT-1	PT-1	PT-1	ACT-1	
1116	PREP	RF-1	RB-1	PT-1	PT-1	PT-1	PT-1	ACT-1	
1116C	CHEMICAL STORAGE	RF-1	RB-1	PT-1	PT-1	PT-1	PT-1	ACT-1	
1117	SCIENCE CLASSROOM 02	RF-1	RB-1	PT-1	PT-1	PT-1	PT-1	ACT-1	
1118	GIRLS	PFT-5	WT-1/WT-2/WT-3	WT-1/WT-2/WT-3	WT-1/ WT-2/ WT-3	WT-1/ WT-2/ WT-3	WT-1/ WT-2/ WT-3	GWB-1	
1119	BOYS	PFT-5	WT-1/WT-2/WT-3	WT-1/WT-2/WT-3	WT-1/ WT-2/ WT-3	WT-1/ WT-2/ WT-3	WT-1/WT-2/WT-3	GWB-1	
1120	STORAGE	2 CPT-2	RB-1	PT-1	PT-1	PT-1	PT-1	ACT-1	
1121	CLASSROOM 01	CPT-1	RB-1	PT-1	PT-1	PT-1	PT-1	ACT-1	
1122	CLASSROOM 02	CPT-1	RB-1	PT-1	PT-1	PT-1	PT-1	ACT-1	
1123	CLASSROOM 03	CPT-1	RB-1	PT-1	PT-1	PT-1	PT-1	ACT-1	
1124	CLASSROOM 04	CPT-1	RB-1	PT-1	PT-1	PT-1	PT-1	ACT-1	
1125	CLASSROOM 05								
1126	STAIR	PFT-1	RB-1	PT-1	PT-1	PT-1	PT-1	ACT-1	
1128	FDC	CS-1	RB-1	PT-1	PT-1	PT-1	PT-1	EXPOSED STRUCTURE	
1129	STORAGE								
1164	LIFE SKILLS	CPT-1	RB-1	PT-1	PT-1	PT-1	PT-1	ACT-1	

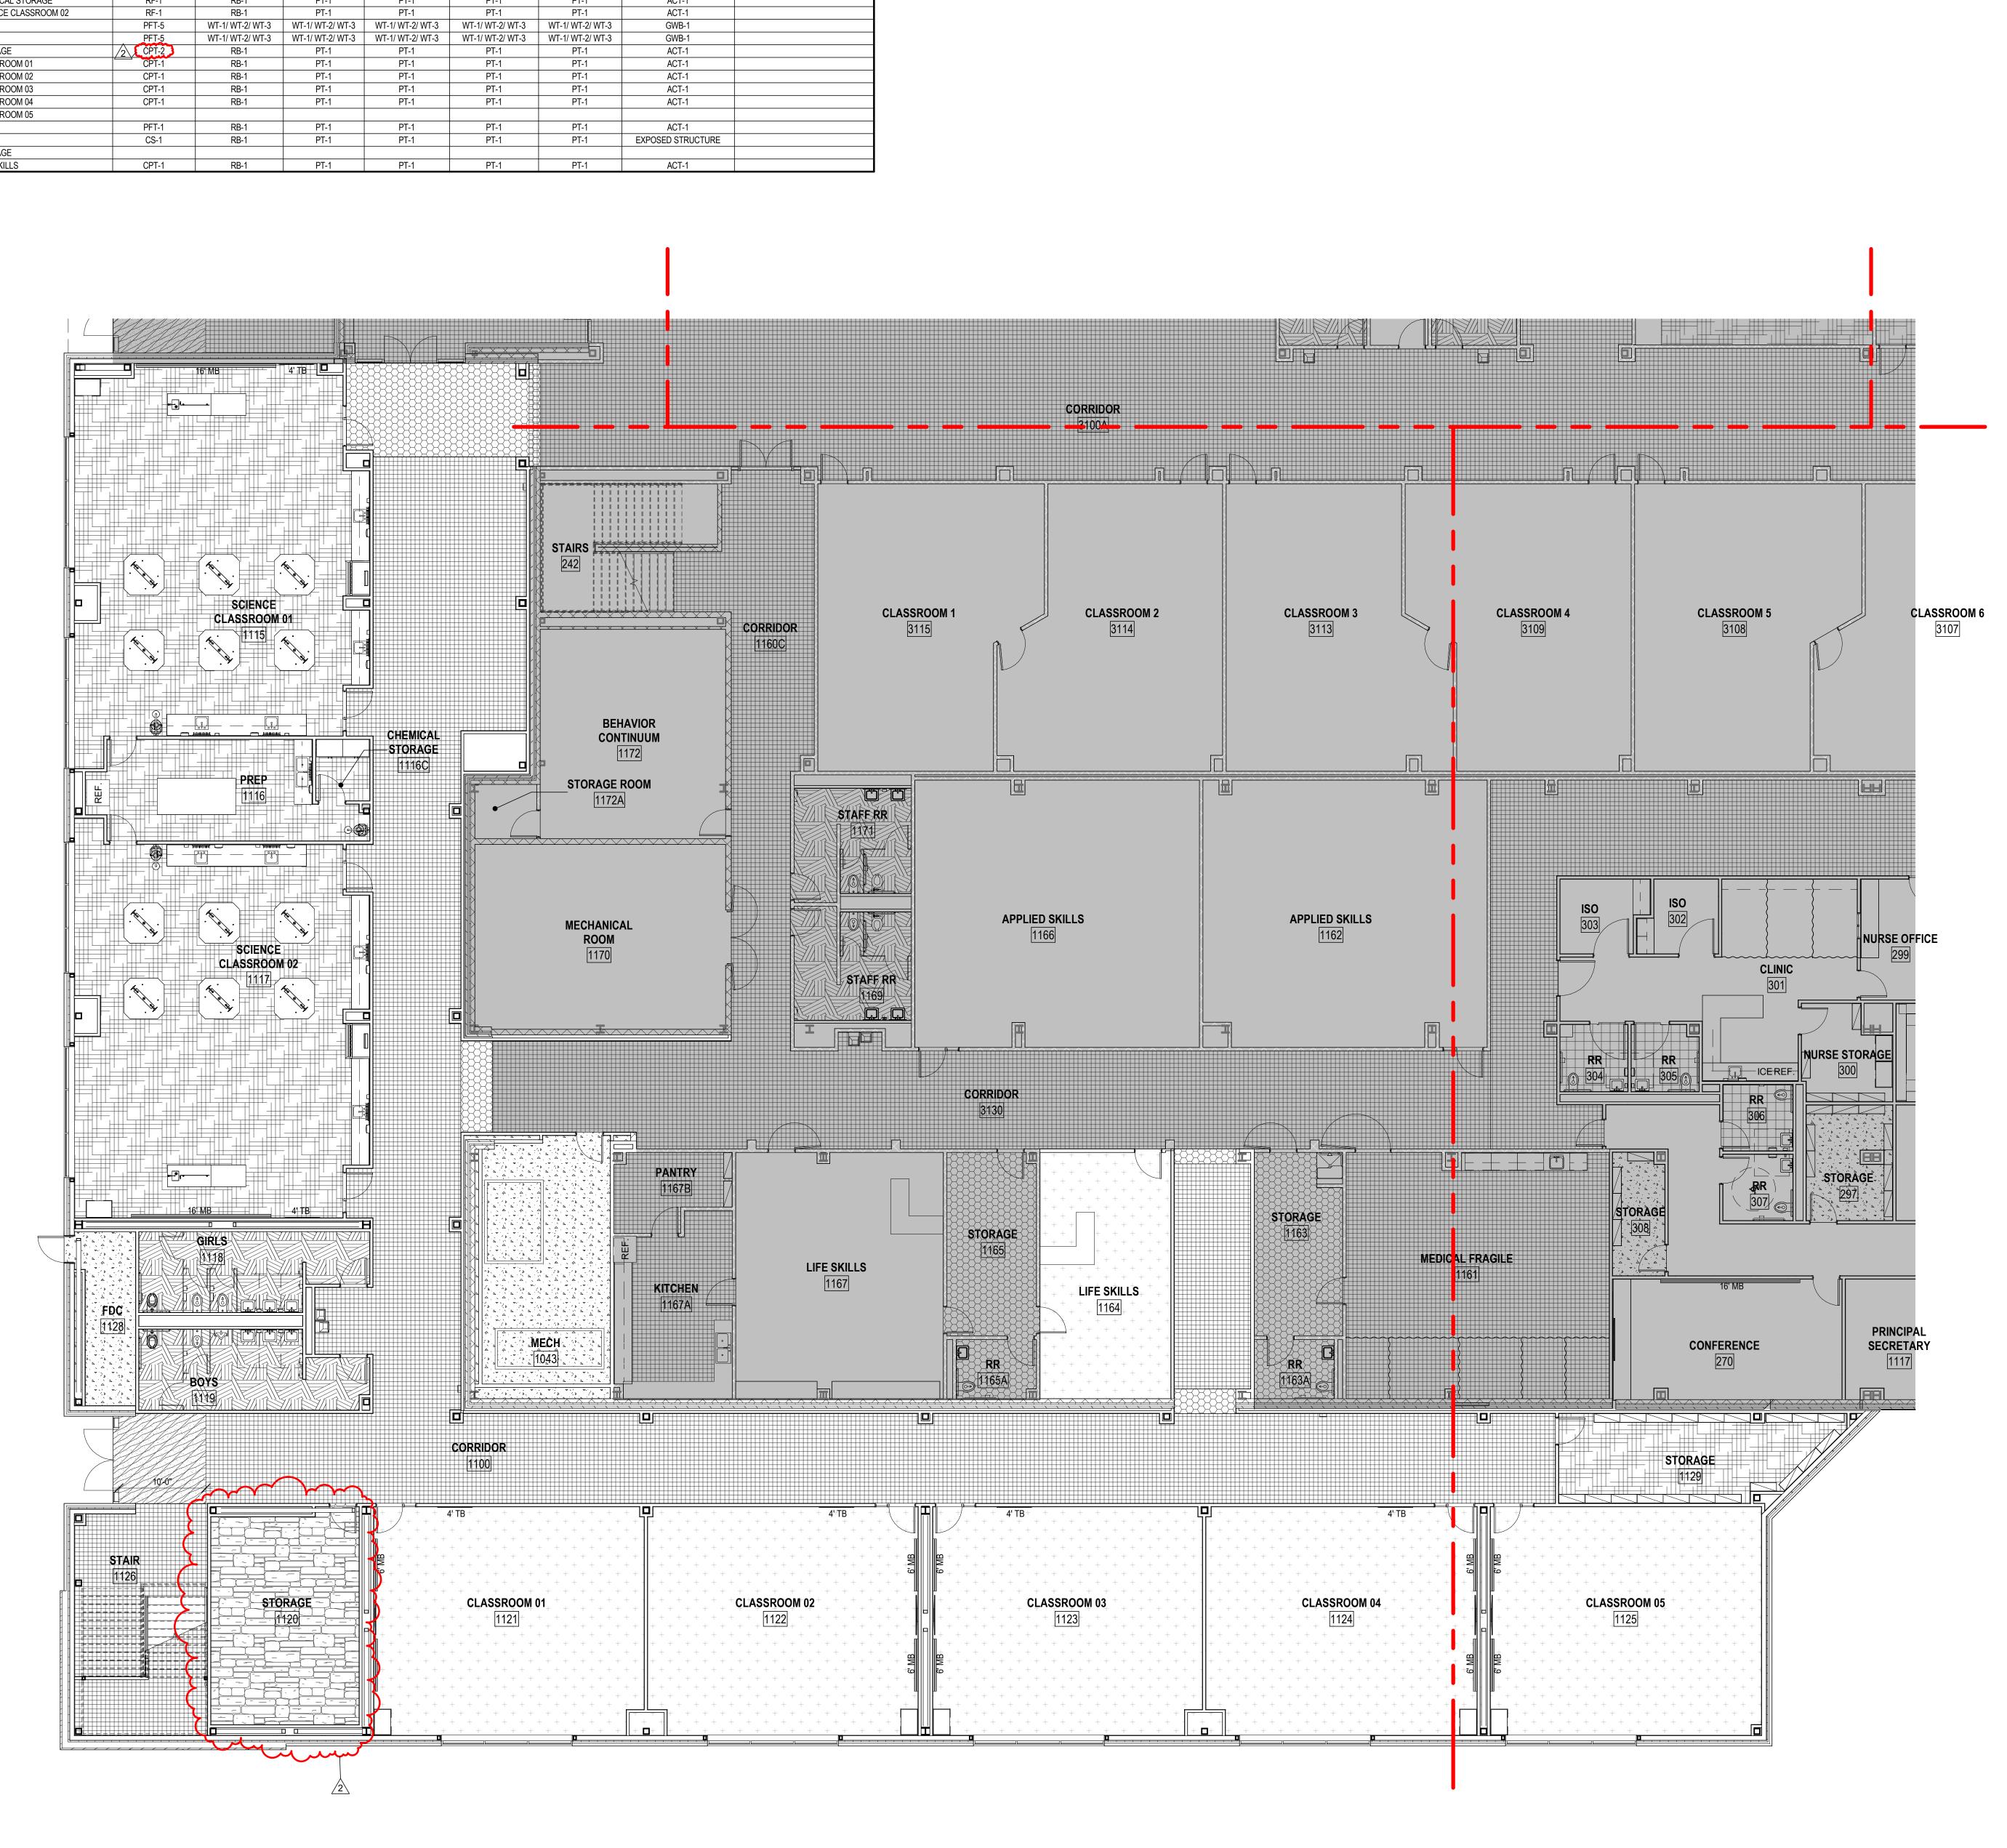

CHECKED BY: Checker DRAWN BY:

Author Plot Stamp: 1/16/2025 10:34:04 AM 06 1ST LEVEL - FINISH PLAN - AREA B

GENERAL FINISH LEGEND NOTES

- 1. ALL FINISH MATERIALS SHALL MEET THE FLAME SPREAD RATINGS PER THE BUILDING CODE. 2. REFER TO INTERIOR ELEVATIONS FOR SPECIFIC MATERIAL LOCATIONS. 3. PAINT ALL EXPOSED STRUCT. MEMBERS, STRUCT. DECK, DUCTWORK, DIFFUSERS, PIPING, CONDUIT, EQUIP. HOUSINGS, LIGHT FIXTURE HOUSINGS, CABLE SUPPORTS, CABLE TRAYS, EQUIP. SUPPORTS,
- HANGERS, ETC. TO MATCH ADJACENT SURFACES. 4. PAINT ALL NON-FACTORY FINISHED EXPOSED METAL. 5. REFER TO TYPICAL FLOORING TRANSITION DETAILS FOR FLOORING MATERIAL TRANSITIONS.
- 6. ALL FLOORING TRANSITIONS AT DOORS SHALL BE LOCATED UNDER THE DOOR IN THE CLOSED POSITION, U.N.O. 7. PROTECT ALL FINISHED FLOORING SURFACES FROM DAMAGE DURING ALL CONSTRUCTION PHASES.
- 8. PROVIDE AND INSTALL BULLNOSE TRIM AT ALL TRANSITIONS FROM CERAMIC WALL TILE TO OTHER MATERIAL U.N.O.
- 9. REFER TO REFLECTED CEILING PLANS FOR CEILING HEIGHTS. 10. ALL ELECTRICAL DEVICE COVERS ARE TO BE WHITE U.N.O.
- 11. ALL CARPET PATTERNS TO RUN PARALLEL TO CORRIDOR, U.N.O. 12. PAINT ALL HOLLOW METAL DOOR FRAMES TO MATCH ADJACENT WALL COLOR U.N.O.

FINISH SCHEDULE REMARKS

ALL SCHEDULED DIRECTIONS (NORTH, EAST, SOUTH, WEST) ARE PER PLAN DIRECTIONS, NOT TRUE COMPASS DIRECTIONS.

ALL SCHEDULED CEILING HEIGHTS ARE FROM THE PRIMARY FLOOR LEVEL WITHIN THE ROOM AND OR SPACE, AND ARE NOT FROM AN ELEVATED FLOOR LEVEL, AND ARE NOT FROM A RECESSED FLOOR LEVEL.

ALL FINISH MATERIALS SHALL MEET FLAME SPREAD RATINGS PER THE BUILDING CODE.

PROTECT ALL FINISHED FLOORING SURFACES FROM DAMAGE DURING ALL CONSTRUCTION PHASES. CARPET PATTERNS SHALL RUN PARALLEL TO CORRIDOR U.N.O.

PROVIDE AND INSTALL BULLNOSE TRIM AT ALL TRANSITIONS FROM CERAMIC WALL TILE TO OTHER MATERIALS U.N.O.


PAINT ALL NEW NON-FACTORY FINISHED EXPOSED METAL.


- PAINT ALL NEW H.M. DOORS U.N.O. . REFER TO FLOOR PATTERN PLANS
- 2. REFER TO INTERIOR ELEVATIONS 3. REFER TO CEILING PLANS

- 4. 48"H STAINLESS STEEL WAINSCOT AT MOP SINK. EXTEND 24" EACH SIDE BEYOND SINK EDGES 5. PAINT ALL EXPOSED CEILING-RELATED ITEMS, INCLUDING BUT NOT LIMITED TO, STRUCT, MEMBERS, STRUCT. DECK, DUCTWORK, DIFFUSERS, PIPING, CONDUIT, EQUIP. HOUSINGS, LIGHT FIXTURE
- HOUSINGS, CABLE SUPPORTS, CABLE TRAYS, EQUIP. SUPPORTS, HANGERS . PAINT ALL EXPOSED CEILING-RELATED ITEMS FLAT BLACK, INCLUDING BUT NOT LIMITED TO, STRUCT.
- MEMBERS, STRUCT. DECK, DUCTWORK, DIFFUSERS, PIPING, CONDUIT, EQUIP. HOUSINGS, LIGHT FIXTUR HOUSINGS, CABLE SUPPORTS, CABLE TRAYS, EQUIP. SUPPORTS, HANGERS 2. PAINT ALL EXPOSED CEILING-RELATED ITEMS WHITE, INCLUDING BUT NOT LIMITED TO, STRUCT.
- MEMBERS, STRUCT. DECK, DUCTWORK, DIFFUSERS, PIPING, CONDUIT, EQUIP. HOUSINGS, LIGHT FIXTUR HOUSINGS, CABLE SUPPORTS, CABLE TRAYS, EQUIP. SUPPORTS, HANGERS
- . HOLD-DOWN CLIPS AT SUSP. LAY-IN CEILING SYSTEM WITHIN 8'-0" MIN. ANY DIRECTION FROM AN EXTERIOR DOOR LOCATION

FINISH	I FLOOR LEGEND
	CS-1, SEALED CONCRETE RE: FINISH SCHEDULE
	SC-1, STAINED CONCRETE RE: FINISH SCHEDULE
	WF-1, GYM WOOD FLOORING RE: FINISH SCHEDULE
$\begin{array}{ c c c c c c c c c c c c c c c c c c c$	CPT-1, CARPET TYPE 1 RE: FINISH SCHEDULE
	CPT-2, CARPET TYPE 2 RE: FINISH SCHEDULE
	CPT-3, WALK OFF CARPET RE: FINISH SCHEDULE
	PFT-1 PORCELAIN FLOOR TILE RE: FINISH SCHEDULE
	PFT-2 PORCELAIN FLOOR TILE RE: FINISH SCHEDULE
	PFT-3 PORCELAIN FLOOR TILE RE: FINISH SCHEDULE
	PFT-4 PORCELAIN FLOOR TILE RE: FINISH SCHEDULE
	PFT-5 PORCELAIN FLOOR TILE RE: FINISH SCHEDULE
	PFT-6 PORCELAIN FLOOR TILE RE: FINISH SCHEDULE
	PFT-7 PORCELAIN FLOOR TILE RE: FINISH SCHEDULE
	PFT-8 PORCELAIN FLOOR TILE RE: FINISH SCHEDULE
	PFT-9 PORCELAIN FLOOR TILE RE: FINISH SCHEDULE
	PFT-10 PORCELAIN FLOOR TILE RE: FINISH SCHEDULE
	RF-1 RUBBER FLOORING RE: FINISH SCHEDULE
	RSF-1 SPORTS FLOORING - ROLLED RE: FINISH SCHEDULE
	EXISTING TO REMAIN

* REFER TO SHEET AF100 FOR SCHEDULE OF FINISHES

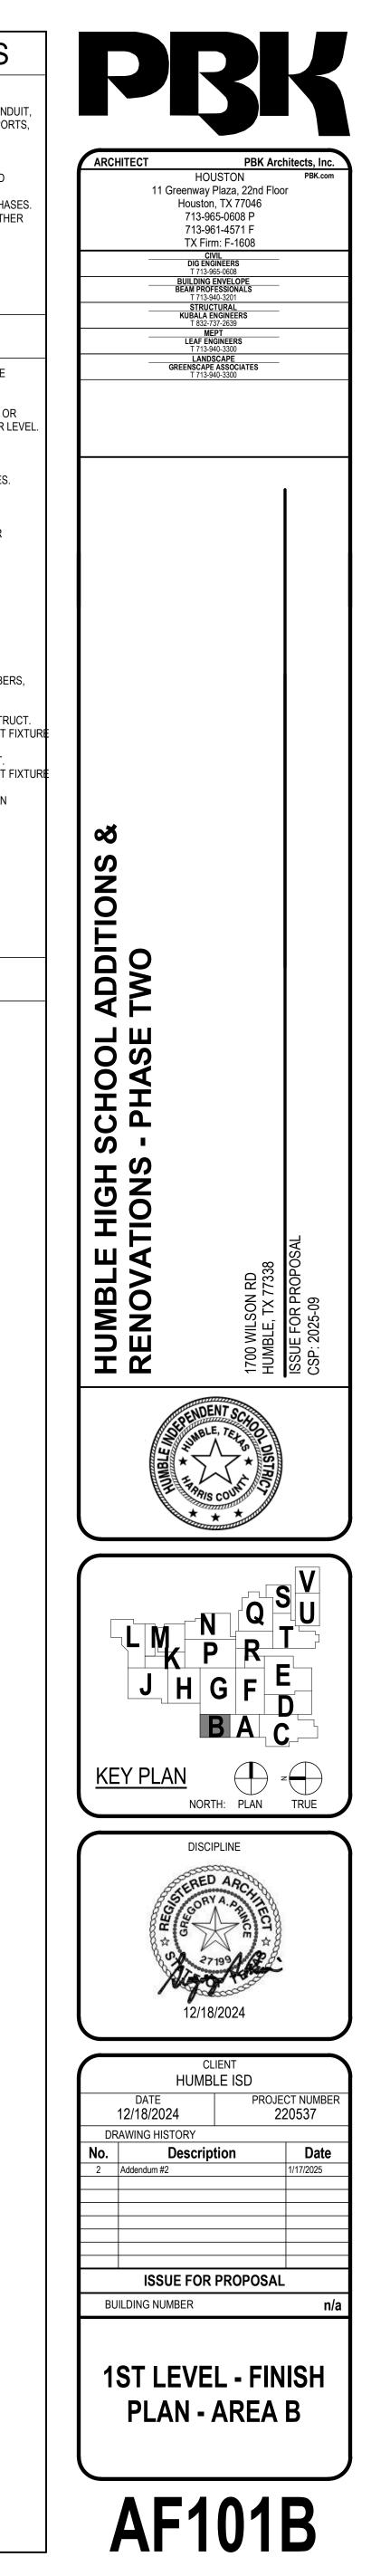

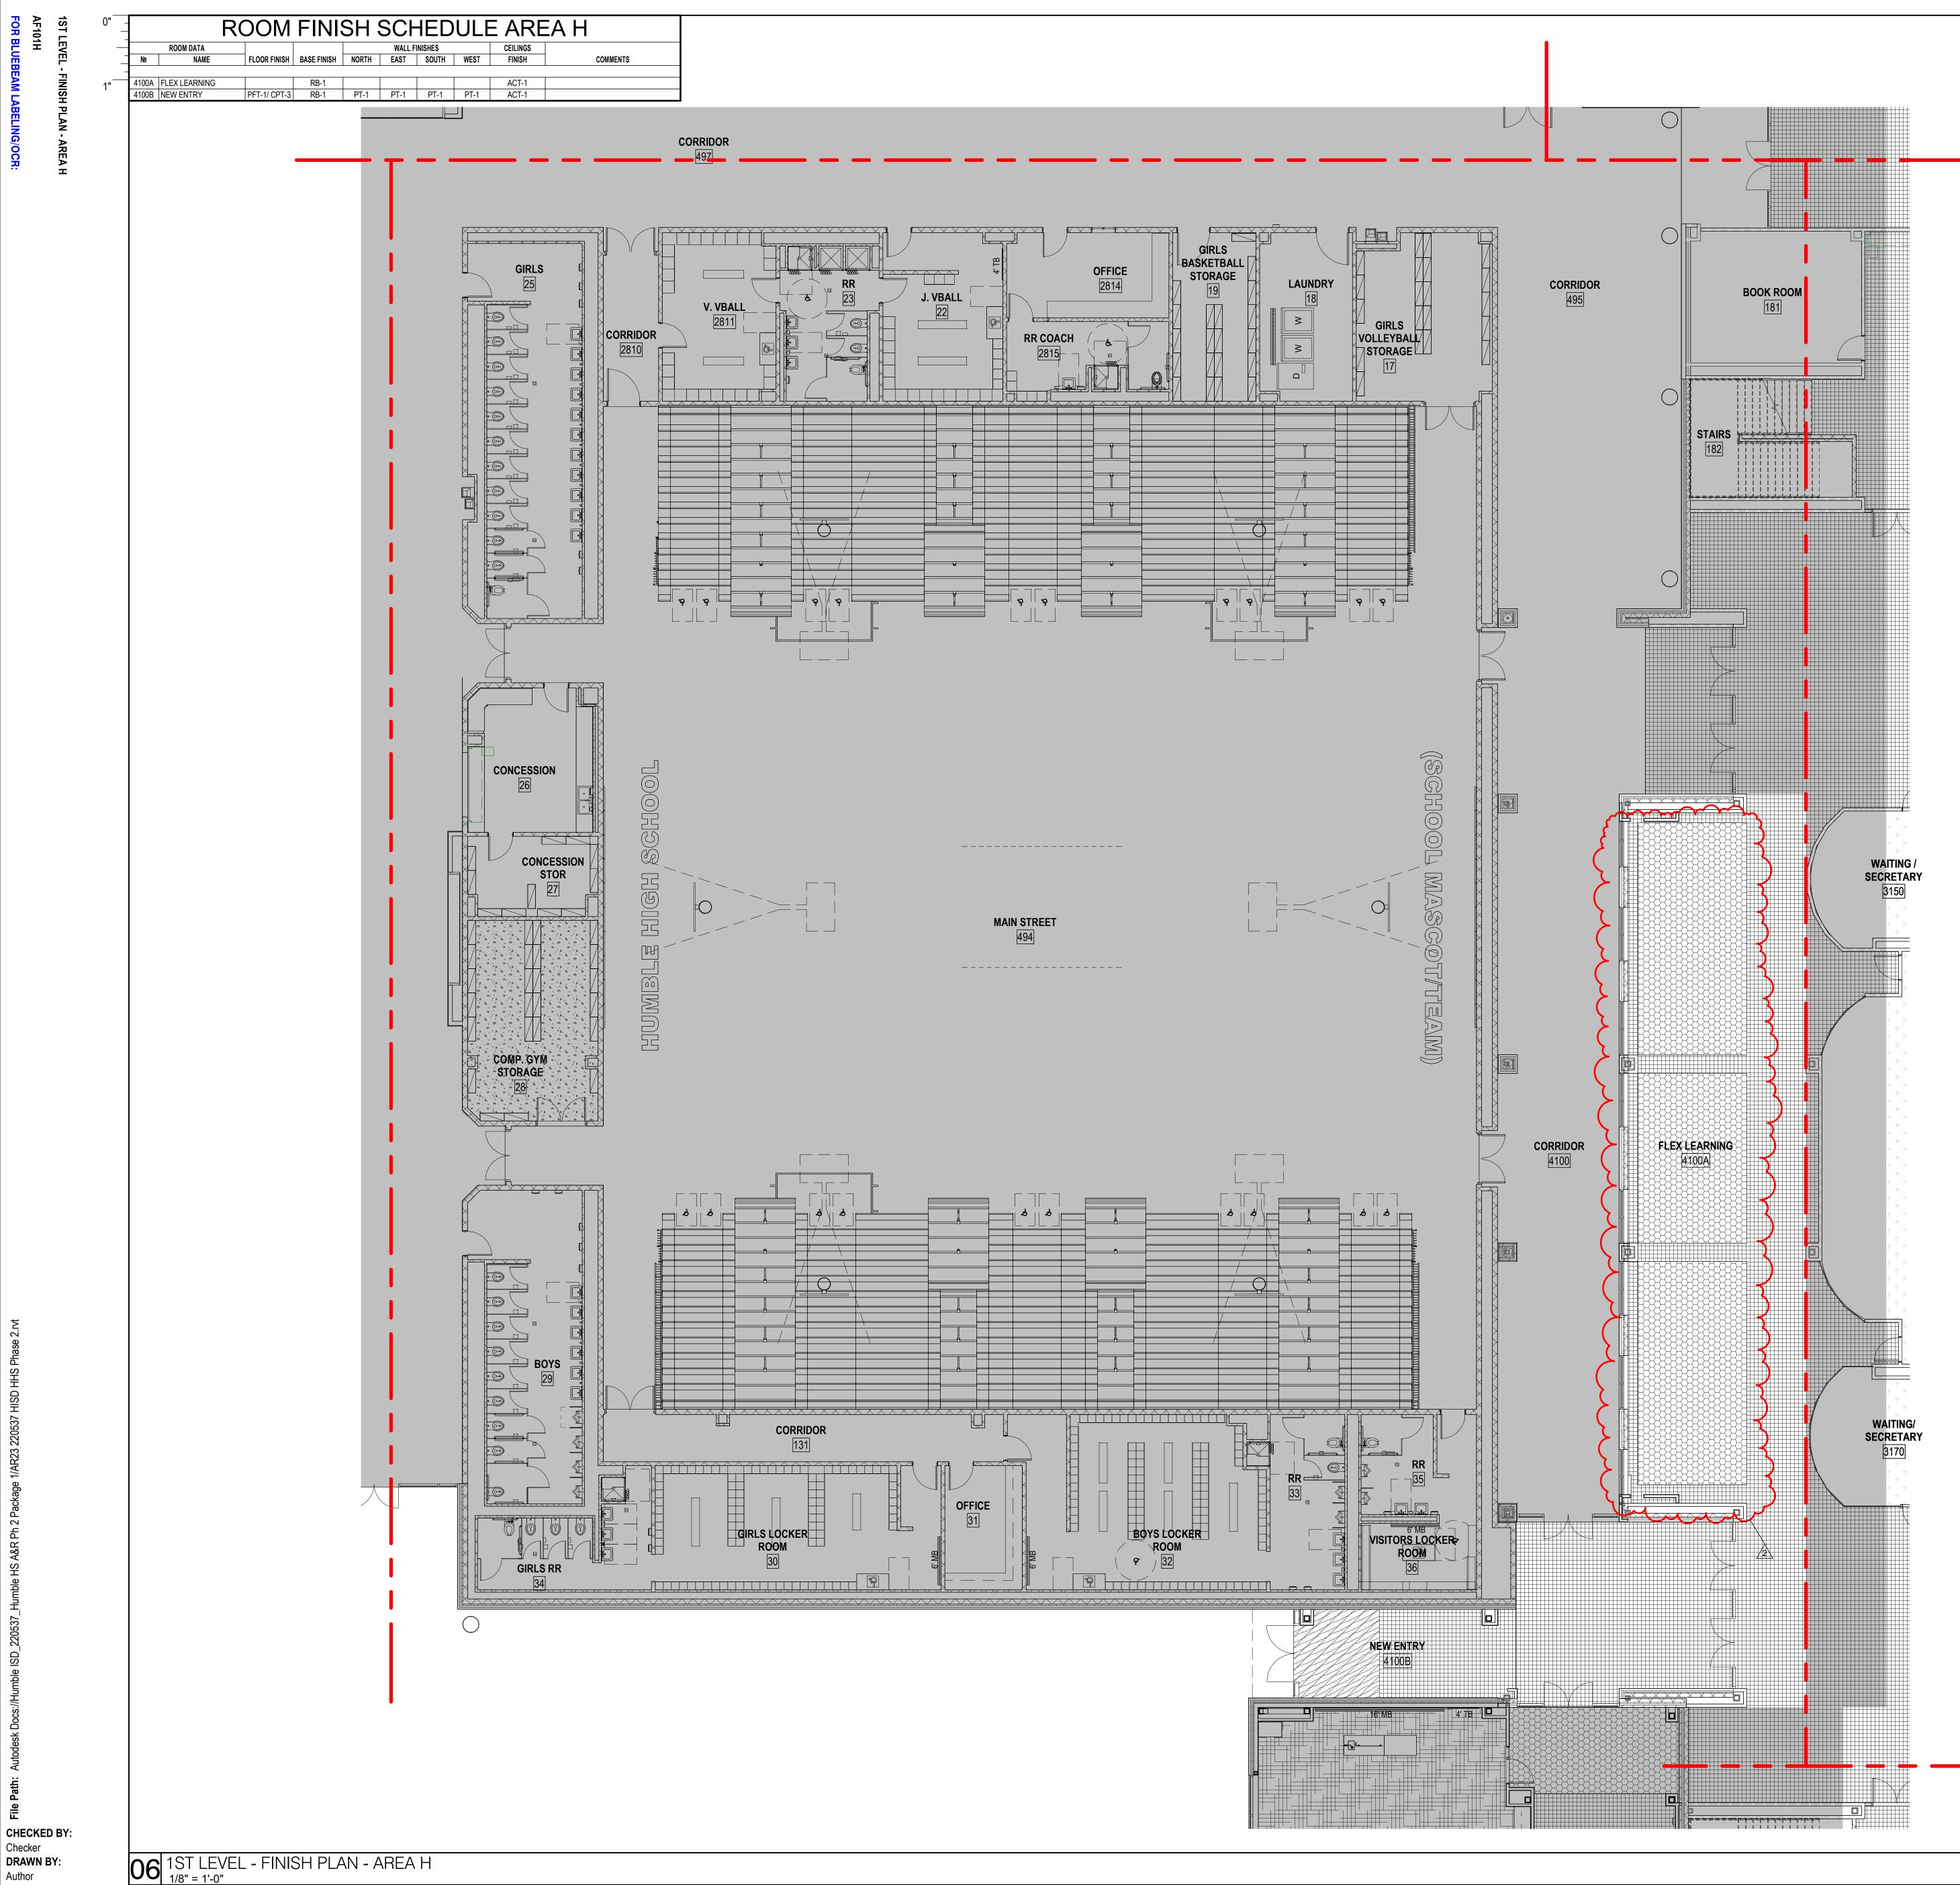

Author Plot Stamp: 1/10/2025 1:01:37 PM

GENERAL FINISH LEGEND NOTES

- 1. ALL FINISH MATERIALS SHALL MEET THE FLAME SPREAD RATINGS PER THE BUILDING CODE. 2. REFER TO INTERIOR ELEVATIONS FOR SPECIFIC MATERIAL LOCATIONS. 3. PAINT ALL EXPOSED STRUCT. MEMBERS, STRUCT. DECK, DUCTWORK, DIFFUSERS, PIPING, CONDUIT, EQUIP. HOUSINGS, LIGHT FIXTURE HOUSINGS, CABLE SUPPORTS, CABLE TRAYS, EQUIP. SUPPORTS, HANGERS, ETC. TO MATCH ADJACENT SURFACES.
- 4. PAINT ALL NON-FACTORY FINISHED EXPOSED METAL. 5. REFER TO TYPICAL FLOORING TRANSITION DETAILS FOR FLOORING MATERIAL TRANSITIONS.
- 6. ALL FLOORING TRANSITIONS AT DOORS SHALL BE LOCATED UNDER THE DOOR IN THE CLOSED POSITION, U.N.O. 7. PROTECT ALL FINISHED FLOORING SURFACES FROM DAMAGE DURING ALL CONSTRUCTION PHASES.
- 8. PROVIDE AND INSTALL BULLNOSE TRIM AT ALL TRANSITIONS FROM CERAMIC WALL TILE TO OTHER MATERIAL U.N.O.
- 9. REFER TO REFLECTED CEILING PLANS FOR CEILING HEIGHTS. 10. ALL ELECTRICAL DEVICE COVERS ARE TO BE WHITE U.N.O. 11. ALL CARPET PATTERNS TO RUN PARALLEL TO CORRIDOR, U.N.O.
- 12. PAINT ALL HOLLOW METAL DOOR FRAMES TO MATCH ADJACENT WALL COLOR U.N.O.

FINISH SCHEDULE REMARKS

ALL SCHEDULED DIRECTIONS (NORTH, EAST, SOUTH, WEST) ARE PER PLAN DIRECTIONS, NOT TRUE COMPASS DIRECTIONS.

ALL SCHEDULED CEILING HEIGHTS ARE FROM THE PRIMARY FLOOR LEVEL WITHIN THE ROOM AND OR SPACE, AND ARE NOT FROM AN ELEVATED FLOOR LEVEL, AND ARE NOT FROM A RECESSED FLOOR LEVEL

ALL FINISH MATERIALS SHALL MEET FLAME SPREAD RATINGS PER THE BUILDING CODE. PROTECT ALL FINISHED FLOORING SURFACES FROM DAMAGE DURING ALL CONSTRUCTION PHASES.

CARPET PATTERNS SHALL RUN PARALLEL TO CORRIDOR U.N.O.

PROVIDE AND INSTALL BULLNOSE TRIM AT ALL TRANSITIONS FROM CERAMIC WALL TILE TO OTHER MATERIALS U.N.O.


PAINT ALL NEW NON-FACTORY FINISHED EXPOSED METAL.

- PAINT ALL NEW H.M. DOORS U.N.O. . REFER TO FLOOR PATTERN PLANS
- 2. REFER TO INTERIOR ELEVATIONS 3. REFER TO CEILING PLANS
- 4. 48"H STAINLESS STEEL WAINSCOT AT MOP SINK, EXTEND 24" EACH SIDE BEYOND SINK EDGES 5. PAINT ALL EXPOSED CEILING-RELATED ITEMS, INCLUDING BUT NOT LIMITED TO, STRUCT. MEMBERS, STRUCT. DECK, DUCTWORK, DIFFUSERS, PIPING, CONDUIT, EQUIP. HOUSINGS, LIGHT FIXTURE
- HOUSINGS, CABLE SUPPORTS, CABLE TRAYS, EQUIP. SUPPORTS, HANGERS . PAINT ALL EXPOSED CEILING-RELATED ITEMS FLAT BLACK, INCLUDING BUT NOT LIMITED TO, STRUCT.
- MEMBERS, STRUCT. DECK, DUCTWORK, DIFFUSERS, PIPING, CONDUIT, EQUIP. HOUSINGS, LIGHT FIXTUR HOUSINGS, CABLE SUPPORTS, CABLE TRAYS, EQUIP. SUPPORTS, HANGERS 2. PAINT ALL EXPOSED CEILING-RELATED ITEMS WHITE, INCLUDING BUT NOT LIMITED TO, STRUCT.
- MEMBERS, STRUCT. DECK, DUCTWORK, DIFFUSERS, PIPING, CONDUIT, EQUIP. HOUSINGS, LIGHT FIXTUR HOUSINGS, CABLE SUPPORTS, CABLE TRAYS, EQUIP. SUPPORTS, HANGERS
- 8. HOLD-DOWN CLIPS AT SUSP. LAY-IN CEILING SYSTEM WITHIN 8'-0" MIN. ANY DIRECTION FROM AN EXTERIOR DOOR LOCATION

FINISH FLOOR LEGEND


	CS-1, SEALED CONCRETE RE: FINISH SCHEDULE
	SC-1, STAINED CONCRETE RE: FINISH SCHEDULE
	WF-1, GYM WOOD FLOORING RE: FINISH SCHEDULE
+ + + - + + - + + + + + + + + - + +	CPT-1, CARPET TYPE 1 RE: FINISH SCHEDULE
	CPT-2, CARPET TYPE 2 RE: FINISH SCHEDULE
	CPT-3, WALK OFF CARPET RE: FINISH SCHEDULE
	PFT-1 PORCELAIN FLOOR TILE RE: FINISH SCHEDULE
	PFT-2 PORCELAIN FLOOR TILE RE: FINISH SCHEDULE
	PFT-3 PORCELAIN FLOOR TILE RE: FINISH SCHEDULE
	PFT-4 PORCELAIN FLOOR TILE RE: FINISH SCHEDULE
	PFT-5 PORCELAIN FLOOR TILE RE: FINISH SCHEDULE
	PFT-6 PORCELAIN FLOOR TILE RE: FINISH SCHEDULE
	PFT-7 PORCELAIN FLOOR TILE RE: FINISH SCHEDULE
	PFT-8 PORCELAIN FLOOR TILE RE: FINISH SCHEDULE
	PFT-9 PORCELAIN FLOOR TILE RE: FINISH SCHEDULE
	PFT-10 PORCELAIN FLOOR TILE RE: FINISH SCHEDULE
	RF-1 RUBBER FLOORING RE: FINISH SCHEDULE
	RSF-1 SPORTS FLOORING - ROLLED RE: FINISH SCHEDULE
	EXISTING TO REMAIN

* REFER TO SHEET AF100 FOR SCHEDULE OF FINISHES

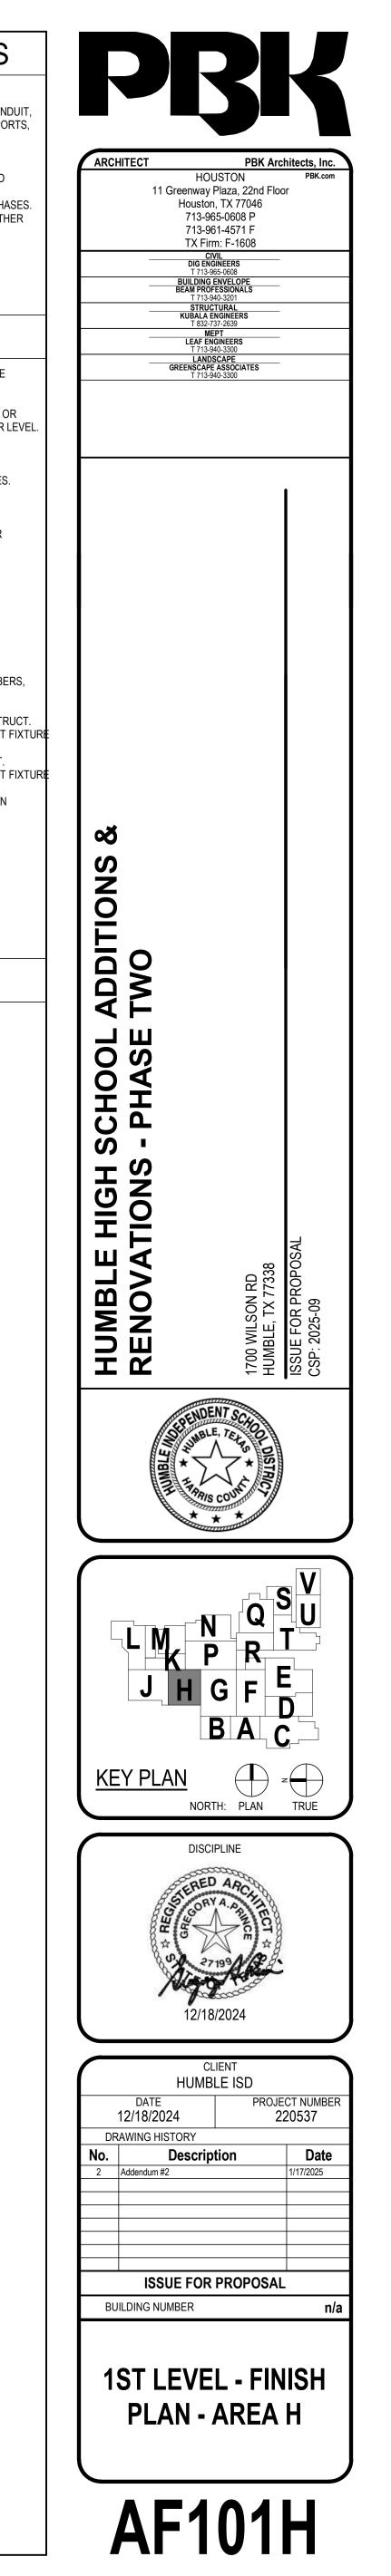

0"					ROOM FINISH SCHEDULE AREA J					
	-	ROOM DATA			WALL FINISHES				CEILINGS	
-	Nº	NAME	FLOOR FINISH	BASE FINISH	NORTH	EAST	SOUTH	WEST	FINISH	
-	-			•		•		•		
1"	4132	LOBBY EXTENSION	PFT-1/ PFT-2/ PFT-7/ PFT-8	NONE	B-1/ GAP-1	CSMU-1	CSMU-1	CSMU-1	ACT-1/ PT-9	
I	4133	AUX GYM 2	WF-1	RB-1	PT-1	PT-1	PT-1	PT-1	EXPOSED PAINTED STRUCTURE	
	4134	ELEC	SC-1	RB-1	PT-1	PT-1	PT-1	PT-1	EXPOSED STRUCTURE	
	4135	STOR	SC-1	RB-1	PT-1	PT-1	PT-1	PT-1	ACT-1	
	4136	STOR	SC-1	RB-1	PT-1	PT-1	PT-1	PT-1	ACT-1	
	4137	STOR	SC-1	RB-1	PT-1	PT-1	PT-1	PT-1	ACT-1	
	4138	STOR	SC-1	RB-1	PT-1	PT-1	PT-1	PT-1	ACT-1	
	4139	STOR	SC-1	RB-1	PT-1	PT-1	PT-1	PT-1	ACT-1	
	4149	CORRIDOR	PFT-1/ CPT-3	TB-1	PT-1	PT-1	PT-1	PT-1	ACT-1	



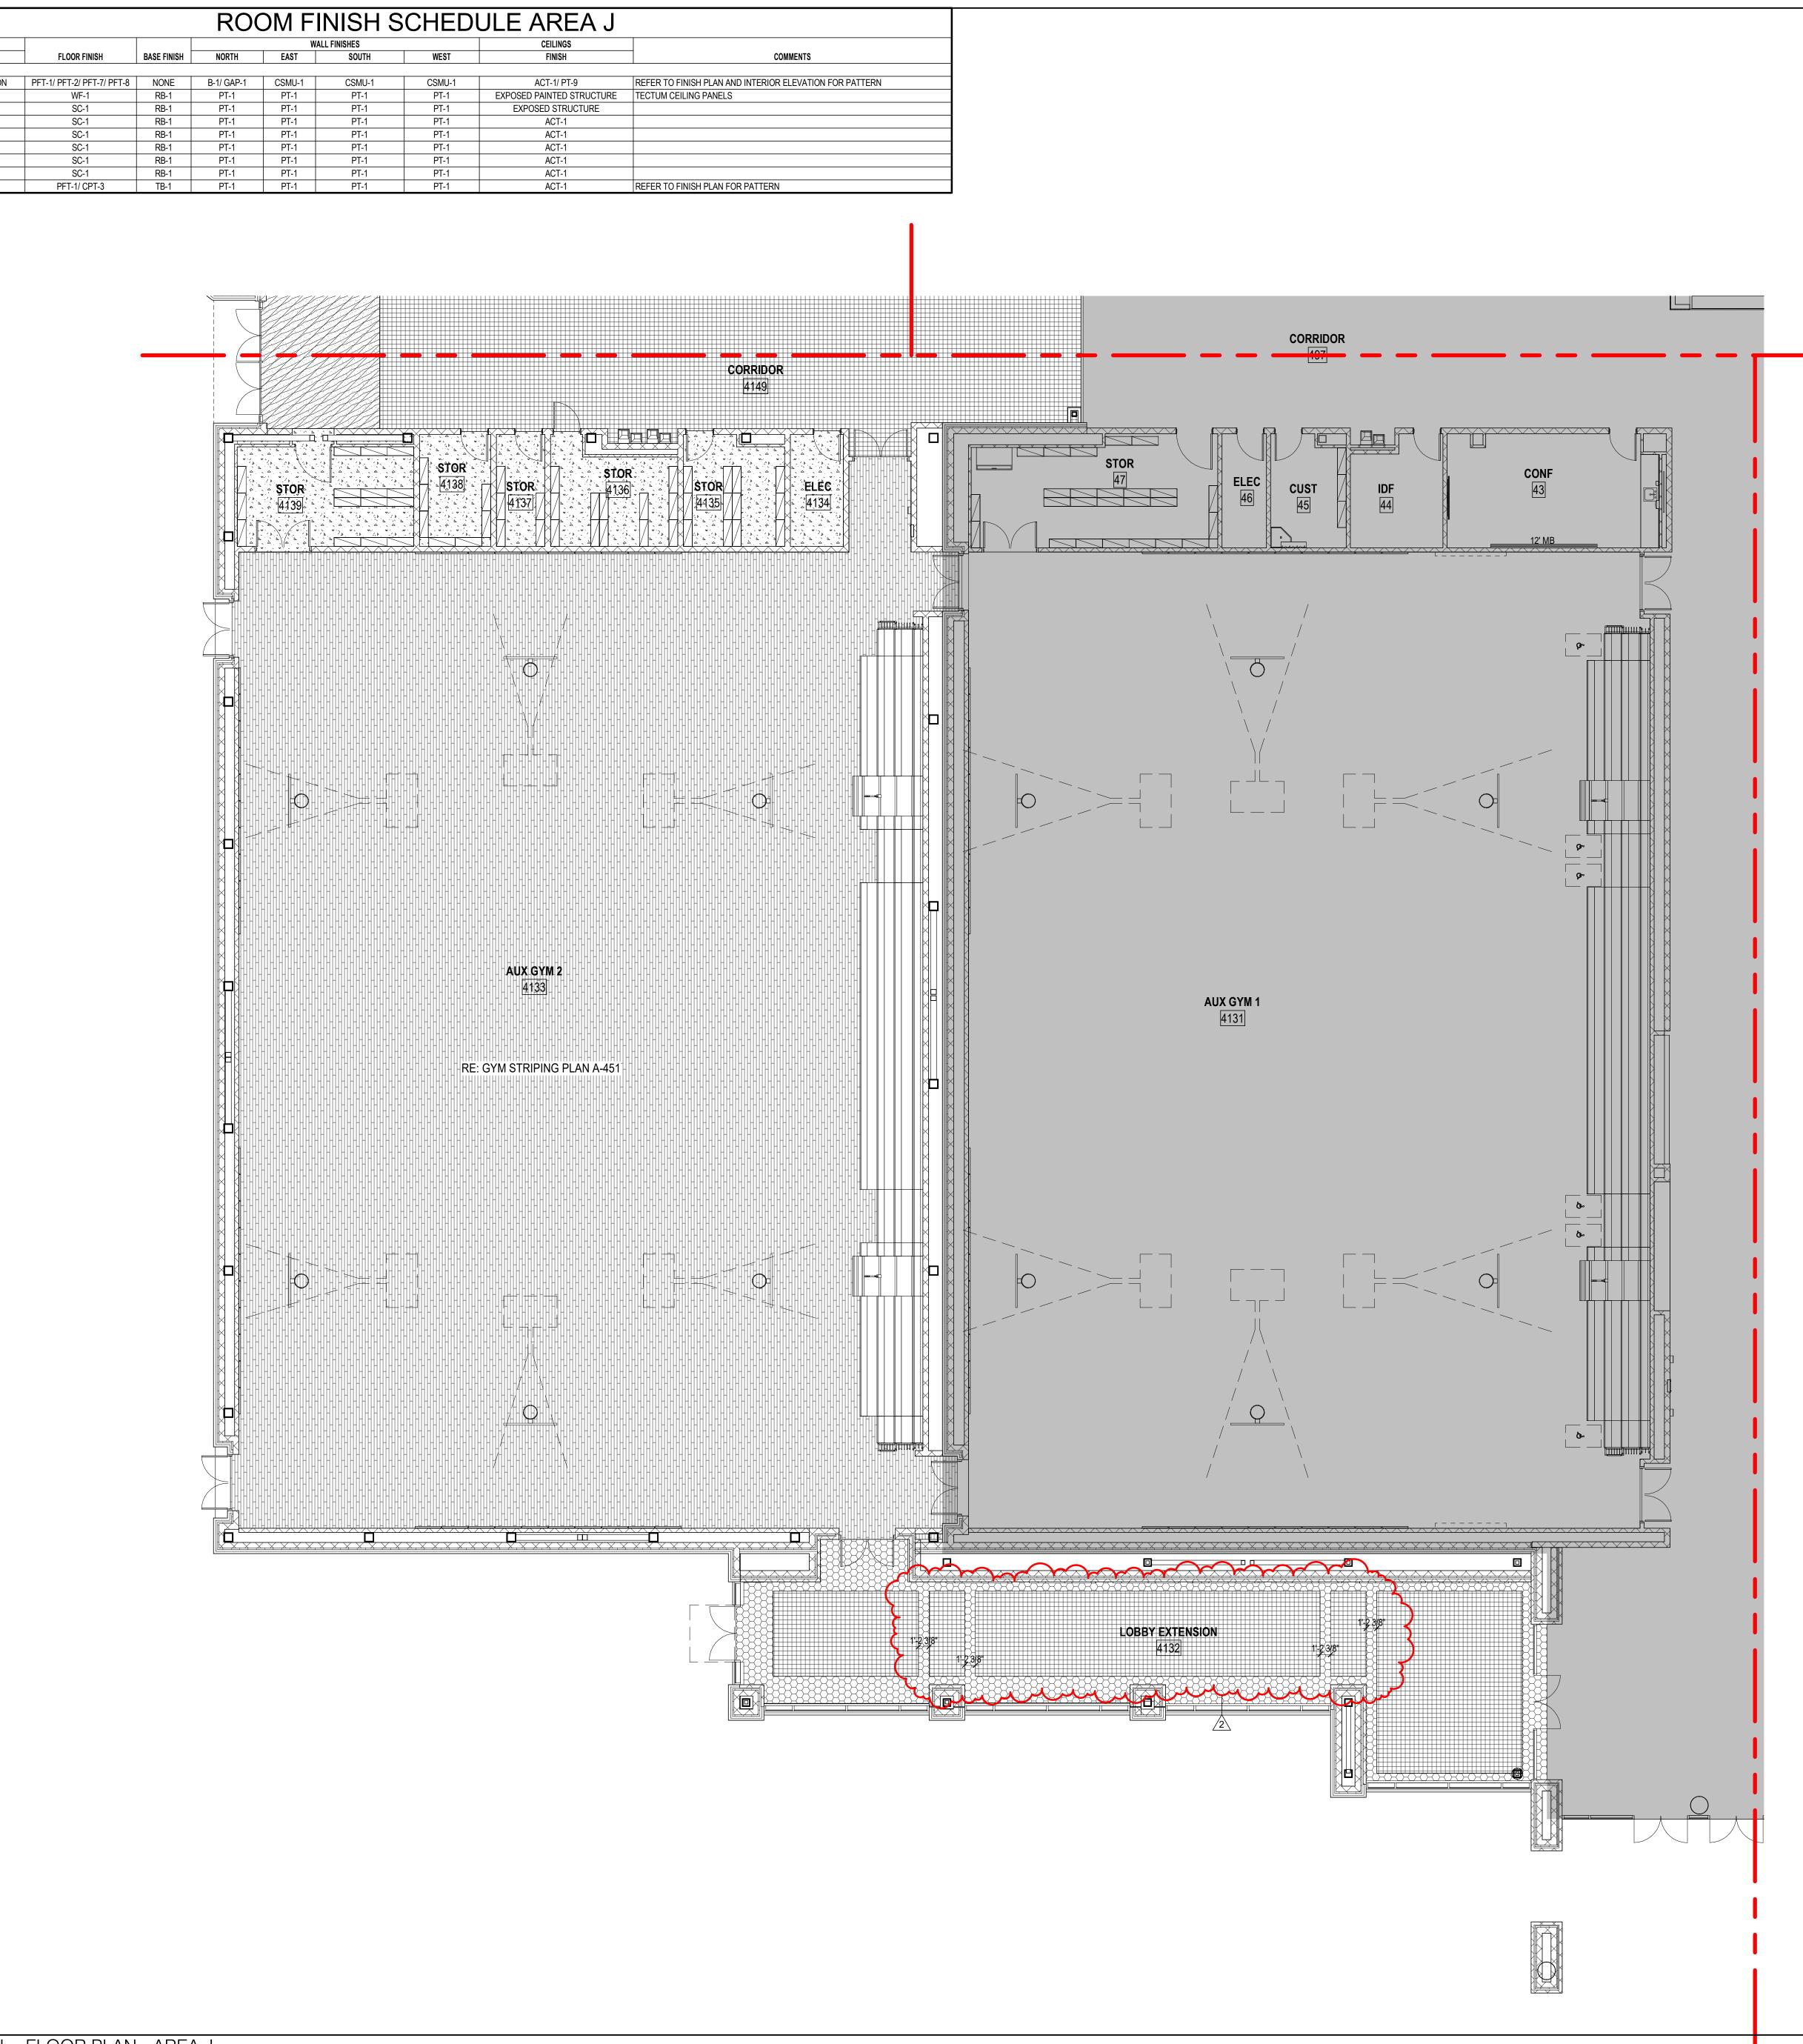

CHECKED BY: RM DRAWN BY: NE Plot Stamp: 1/10/2025 12:43:55 PM

GENERAL FINISH LEGEND NOTES

- ALL FINISH MATERIALS SHALL MEET THE FLAME SPREAD RATINGS PER THE BUILDING CODE.
 REFER TO INTERIOR ELEVATIONS FOR SPECIFIC MATERIAL LOCATIONS. 3. PAINT ALL EXPOSED STRUCT. MEMBERS, STRUCT. DECK, DUCTWORK, DIFFUSERS, PIPING, CONDUIT, EQUIP. HOUSINGS, LIGHT FIXTURE HOUSINGS, CABLE SUPPORTS, CABLE TRAYS, EQUIP. SUPPORTS,
- HANGERS, ETC. TO MATCH ADJACENT SURFACES. 4. PAINT ALL NON-FACTORY FINISHED EXPOSED METAL.
- 5. REFER TO TYPICAL FLOORING TRANSITION DETAILS FOR FLOORING MATERIAL TRANSITIONS. 6. ALL FLOORING TRANSITIONS AT DOORS SHALL BE LOCATED UNDER THE DOOR IN THE CLOSED POSITION, U.N.O.
- 7. PROTECT ALL FINISHED FLOORING SURFACES FROM DAMAGE DURING ALL CONSTRUCTION PHASES. 8. PROVIDE AND INSTALL BULLNOSE TRIM AT ALL TRANSITIONS FROM CERAMIC WALL TILE TO OTHER
- MATERIAL U.N.O. 9. REFER TO REFLECTED CEILING PLANS FOR CEILING HEIGHTS.
- 10. ALL ELECTRICAL DEVICE COVERS ARE TO BE WHITE U.N.O. 11. ALL CARPET PATTERNS TO RUN PARALLEL TO CORRIDOR, U.N.O.
- 12. PAINT ALL HOLLOW METAL DOOR FRAMES TO MATCH ADJACENT WALL COLOR U.N.O.

FINISH SCHEDULE REMARKS

ALL SCHEDULED DIRECTIONS (NORTH, EAST, SOUTH, WEST) ARE PER PLAN DIRECTIONS, NOT TRUE COMPASS DIRECTIONS.

ALL SCHEDULED CEILING HEIGHTS ARE FROM THE PRIMARY FLOOR LEVEL WITHIN THE ROOM AND OR SPACE, AND ARE NOT FROM AN ELEVATED FLOOR LEVEL, AND ARE NOT FROM A RECESSED FLOOR LEVEL.

ALL FINISH MATERIALS SHALL MEET FLAME SPREAD RATINGS PER THE BUILDING CODE. PROTECT ALL FINISHED FLOORING SURFACES FROM DAMAGE DURING ALL CONSTRUCTION PHASES.

CARPET PATTERNS SHALL RUN PARALLEL TO CORRIDOR U.N.O.

PROVIDE AND INSTALL BULLNOSE TRIM AT ALL TRANSITIONS FROM CERAMIC WALL TILE TO OTHER MATERIALS U.N.O.


PAINT ALL NEW NON-FACTORY FINISHED EXPOSED METAL.

- PAINT ALL NEW H.M. DOORS U.N.O.
- . REFER TO FLOOR PATTERN PLANS 2. REFER TO INTERIOR ELEVATIONS 3. REFER TO CEILING PLANS
- 4. 48"H STAINLESS STEEL WAINSCOT AT MOP SINK, EXTEND 24" EACH SIDE BEYOND SINK EDGES 5. PAINT ALL EXPOSED CEILING-RELATED ITEMS, INCLUDING BUT NOT LIMITED TO, STRUCT. MEMBERS,
- STRUCT. DECK, DUCTWORK, DIFFUSERS, PIPING, CONDUIT, EQUIP. HOUSINGS, LIGHT FIXTURE HOUSINGS, CABLE SUPPORTS, CABLE TRAYS, EQUIP. SUPPORTS, HANGERS 6. PAINT ALL EXPOSED CEILING-RELATED ITEMS FLAT BLACK, INCLUDING BUT NOT LIMITED TO, STRUCT.
- MEMBERS, STRUCT. DECK, DUCTWORK, DIFFUSERS, PIPING, CONDUIT, EQUIP. HOUSINGS, LIGHT FIXTUR HOUSINGS, CABLE SUPPORTS, CABLE TRAYS, EQUIP. SUPPORTS, HANGERS
- 7. PAINT ALL EXPOSED CEILING-RELATED ITEMS WHITE, INCLUDING BUT NOT LIMITED TO, STRUCT. MEMBERS, STRUCT. DECK, DUCTWORK, DIFFUSERS, PIPING, CONDUIT, EQUIP. HOUSINGS, LIGHT FIXTUR
- HOUSINGS, CABLE SUPPORTS, CABLE TRAYS, EQUIP. SUPPORTS, HANGERS 8. HOLD-DOWN CLIPS AT SUSP. LAY-IN CEILING SYSTEM WITHIN 8'-0" MIN. ANY DIRECTION FROM AN EXTERIOR DOOR LOCATION

FINISH FLOOR LEGEND


	TEOUREEOEND
	CS-1, SEALED CONCRETE RE: FINISH SCHEDULE
	SC-1, STAINED CONCRETE RE: FINISH SCHEDULE
	WF-1, GYM WOOD FLOORING RE: FINISH SCHEDULE
+ + + + + + + + + + + + + + + + + + +	CPT-1, CARPET TYPE 1 RE: FINISH SCHEDULE
	CPT-2, CARPET TYPE 2 RE: FINISH SCHEDULE
	CPT-3, WALK OFF CARPET RE: FINISH SCHEDULE
	PFT-1 PORCELAIN FLOOR TILE RE: FINISH SCHEDULE
	PFT-2 PORCELAIN FLOOR TILE RE: FINISH SCHEDULE
	PFT-3 PORCELAIN FLOOR TILE RE: FINISH SCHEDULE
	PFT-4 PORCELAIN FLOOR TILE RE: FINISH SCHEDULE
	PFT-5 PORCELAIN FLOOR TILE RE: FINISH SCHEDULE
	PFT-6 PORCELAIN FLOOR TILE RE: FINISH SCHEDULE
	PFT-7 PORCELAIN FLOOR TILE RE: FINISH SCHEDULE
	PFT-8 PORCELAIN FLOOR TILE RE: FINISH SCHEDULE
	PFT-9 PORCELAIN FLOOR TILE RE: FINISH SCHEDULE
	PFT-10 PORCELAIN FLOOR TILE RE: FINISH SCHEDULE
	RF-1 RUBBER FLOORING RE: FINISH SCHEDULE
	RSF-1 SPORTS FLOORING - ROLLED RE: FINISH SCHEDULE
	EXISTING TO REMAIN

* REFER TO SHEET AF100 FOR SCHEDULE OF FINISHES

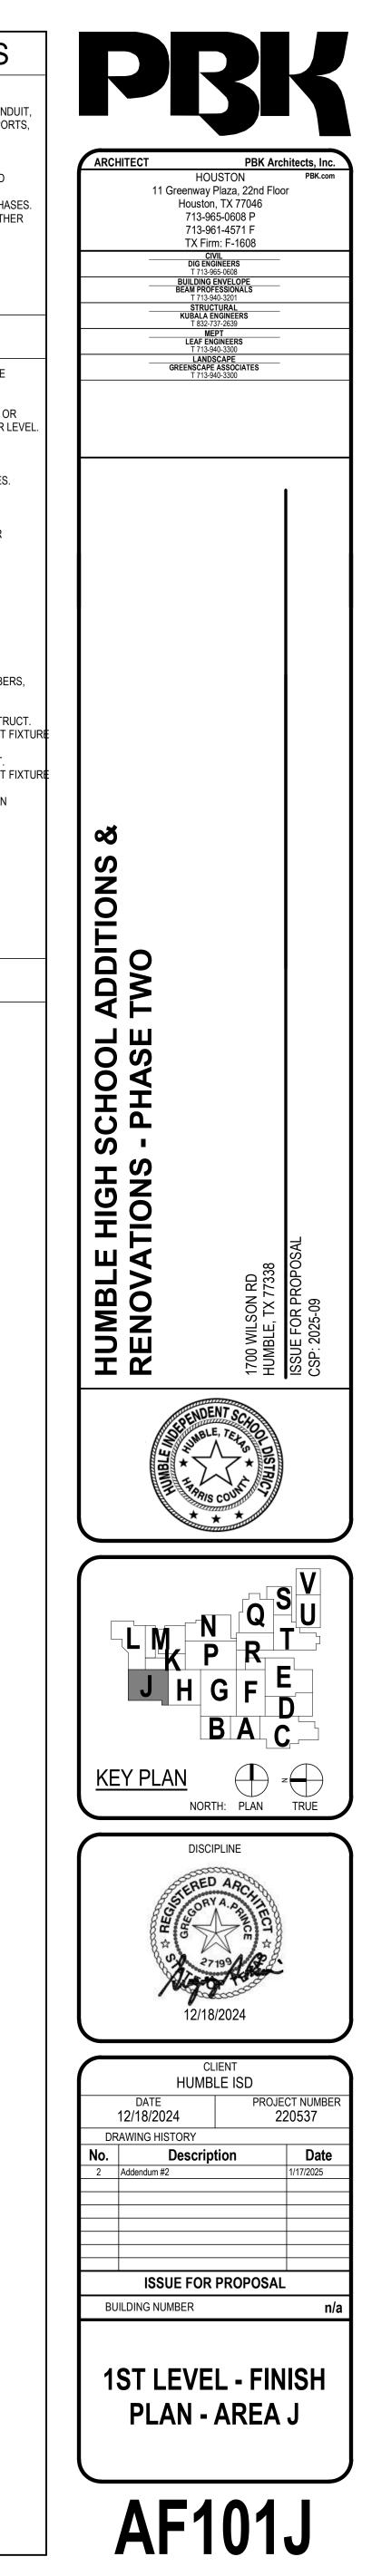


<u>,</u> ► Ż


0" _			F		SH SCH	HEDUL	E ARE	ΑK	
		ROOM DATA				CEILINGS			
	N⁰	NAME	FLOOR FINISH	BASE FINISH	NORTH	EAST	SOUTH	WEST	FINISH
-	\sim		<u> </u>		\sim	\sim	$ \ \ \ \ \ \ \ \ $	\sim	
1"[2814	OFFICE	PFT-5	WT-1	-	-	PT-10	-	-
· [2815	RR COACH	PFT-5	WT-1	PT-10		CERAMIC TILE	معمقه الم	مسرين
	2831	BOYS BBALL STOR	CS-1	RB-1	PI-1	PT-1	PT-1	PT-1	ACT-1
	2841	COACH RR	PFT-5	WT-1/ WT-2/ WT-3	WT-1/ WT-2/ WT-3	-	-	-	-
	4141	BOYS TRACK	PFT-5	WT-1/ WT-2/ WT-3	WT-1/WT-2/WT-3	WT-1/WT-2/WT-3	WT-1/ WT-2/ WT-3	WT-1/ WT-2/ WT-3	ACT-1
	4142	BOYS TENNIS, WRESTLING, JROTC	PFT-5	WT-1/ WT-2/ WT-3	WT-1/ WT-2/ WT-3	WT-1/ WT-2/ WT-3	WT-1/ WT-2/ WT-3	WT-1/ WT-2/ WT-3	ACT-1
ſ	4142A	VESTIBULE	PFT-5	WT-1/ WT-2/ WT-3	WT-1/ WT-2/ WT-3	WT-1/WT-2/WT-3	WT-1/ WT-2/ WT-3	WT-1/ WT-2/ WT-3	ACT-1
	4142B	VESTIBULE	PFT-5	WT-1/ WT-2/ WT-3	WT-1/ WT-2/ WT-3	WT-1/WT-2/WT-3	WT-1/ WT-2/ WT-3	WT-1/ WT-2/ WT-3	ACT-1
	4148	RR	PFT-5	WT-1/ WT-2/ WT-3	WT-1/WT-2/WT-3	WT-1/WT-2/WT-3	WT-1/ WT-2/ WT-3	WT-1/ WT-2/ WT-3	GWB-1

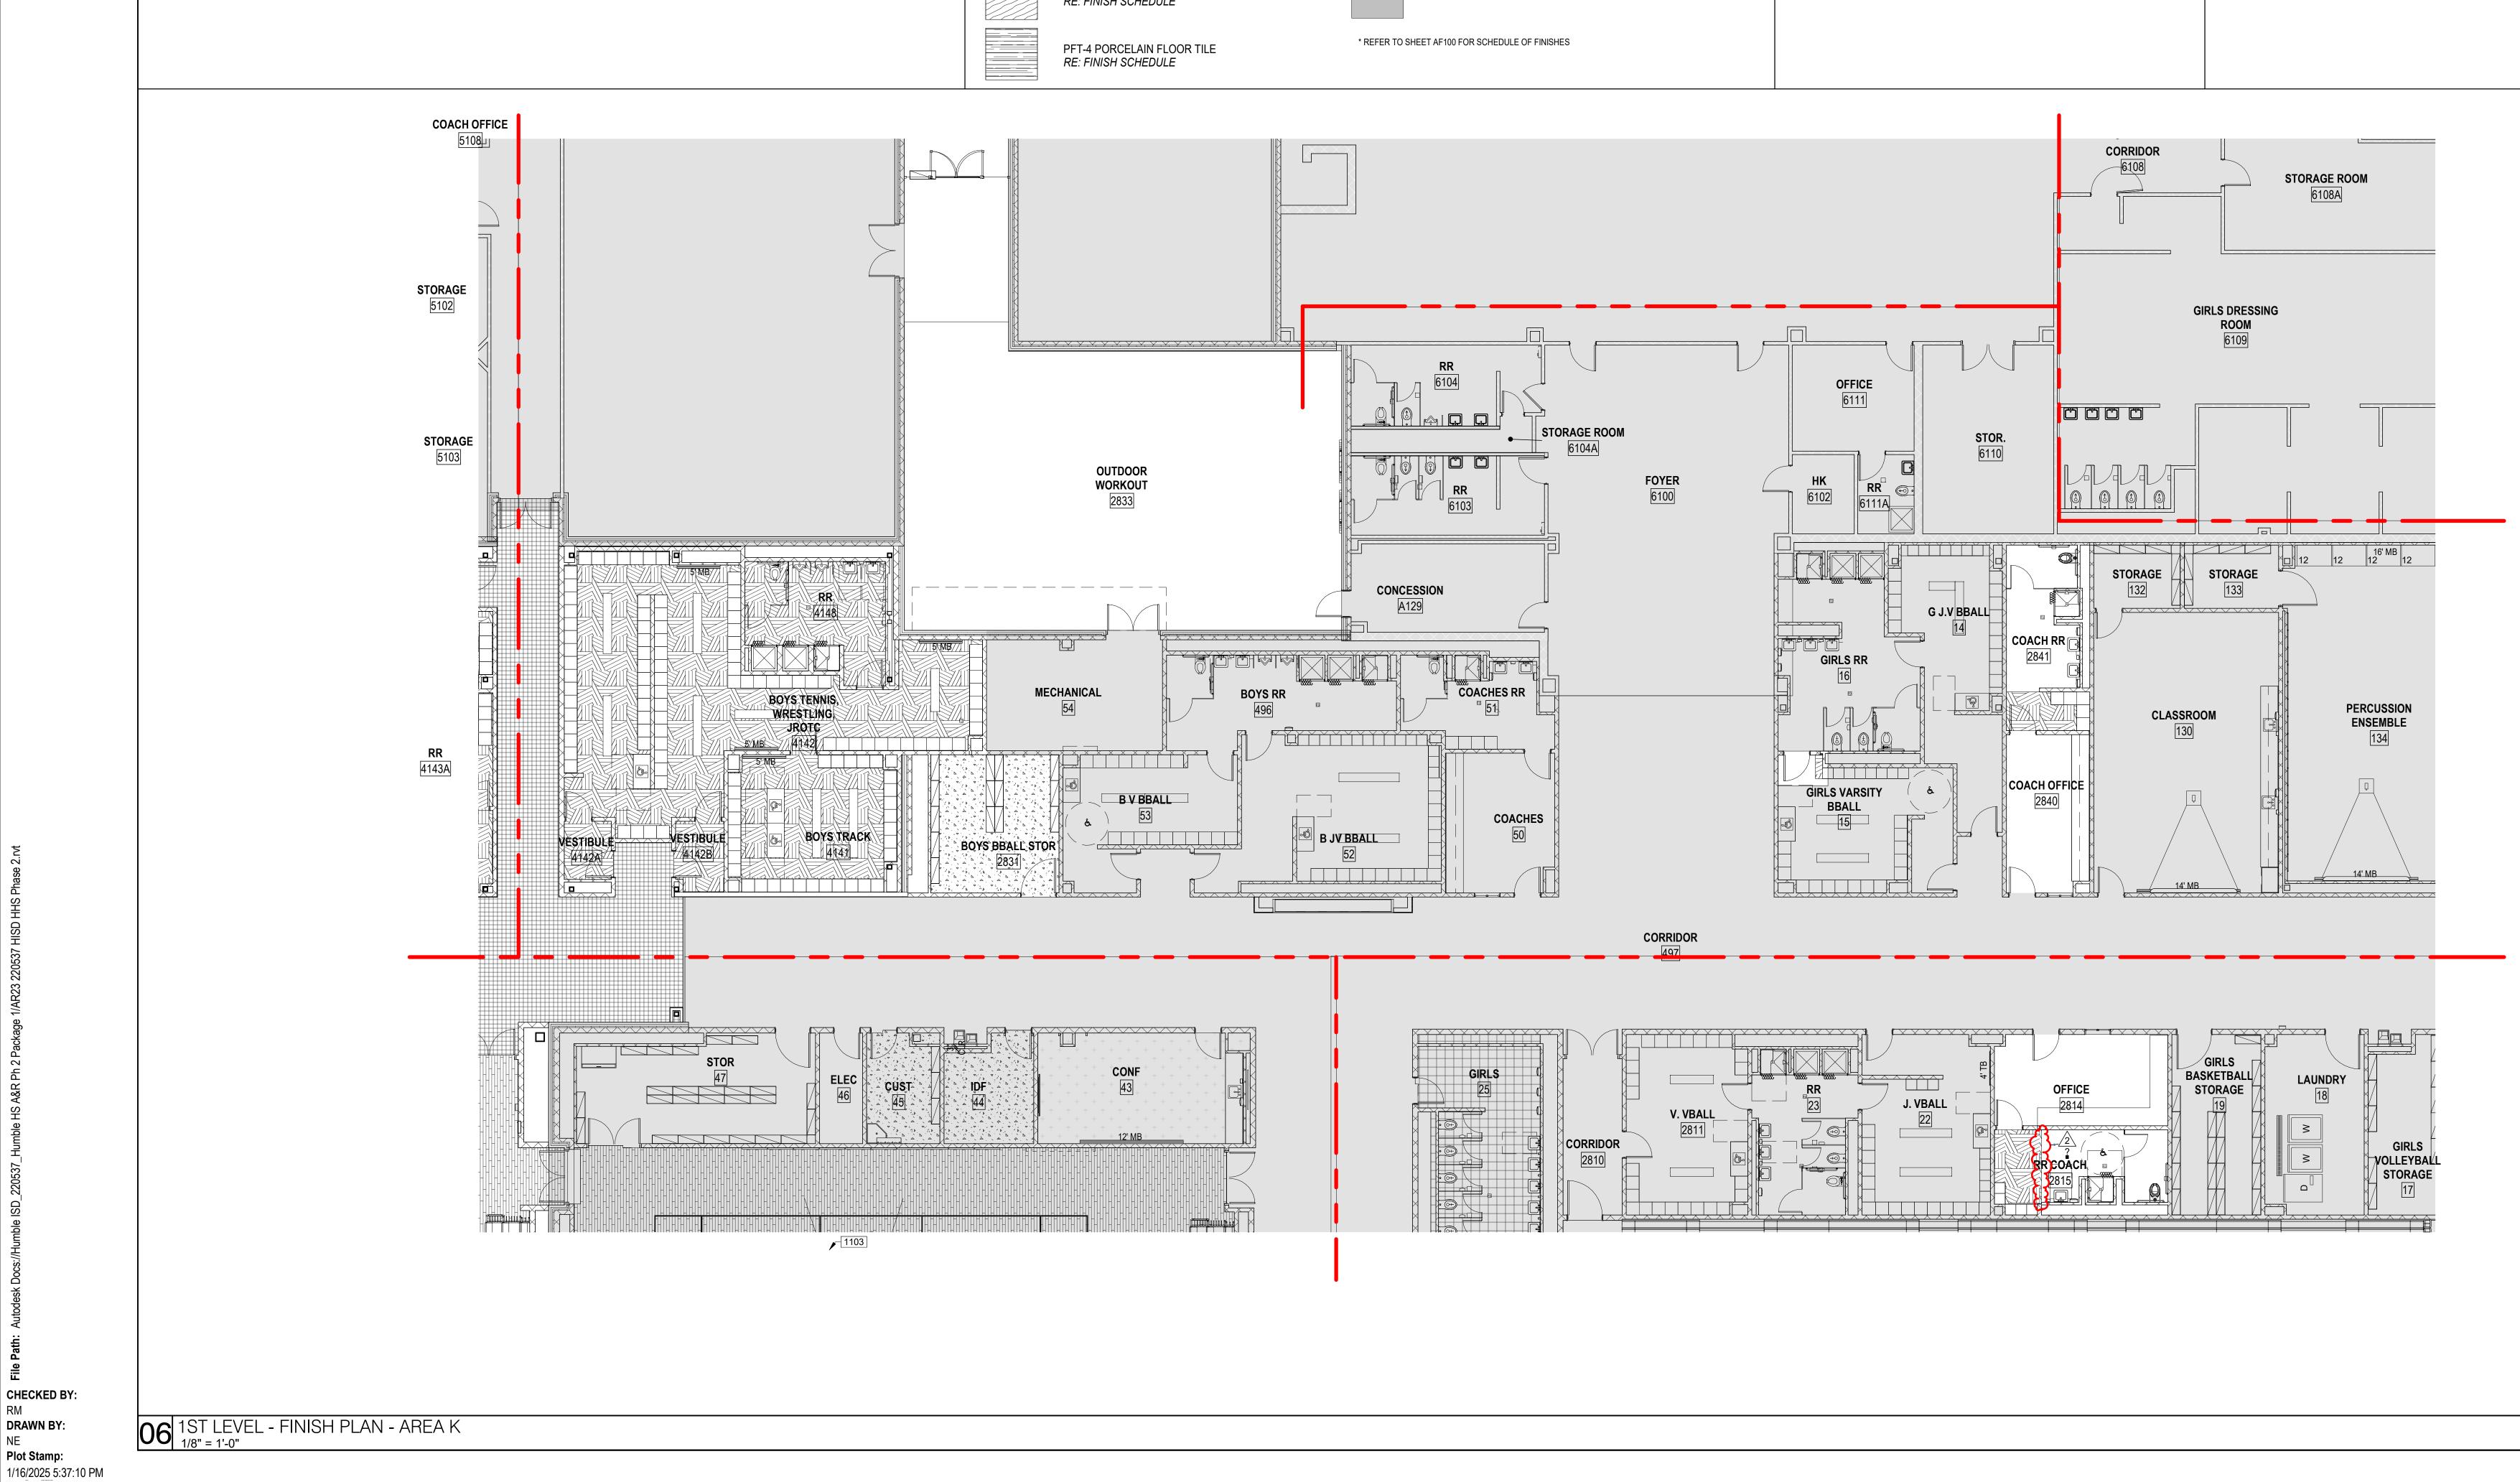


CHECKED BY: RM DRAWN BY: NE

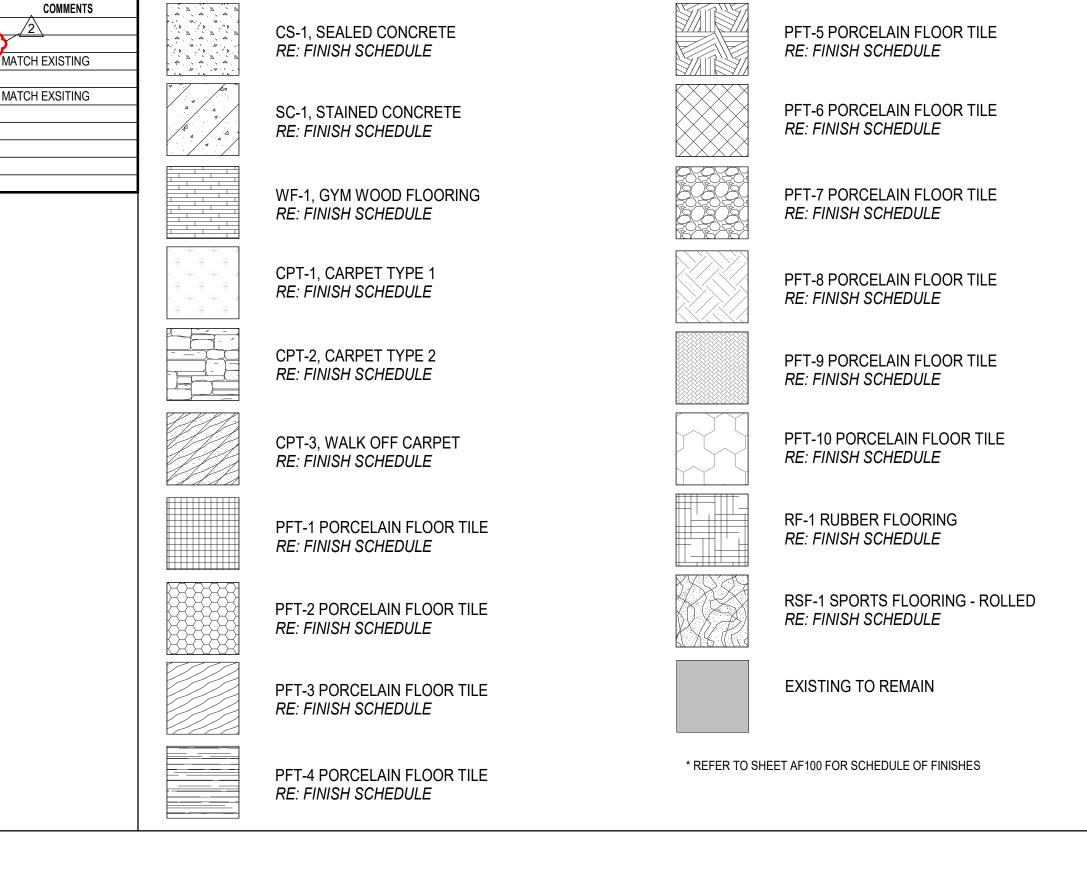


FINISH FLOOR LEGEND

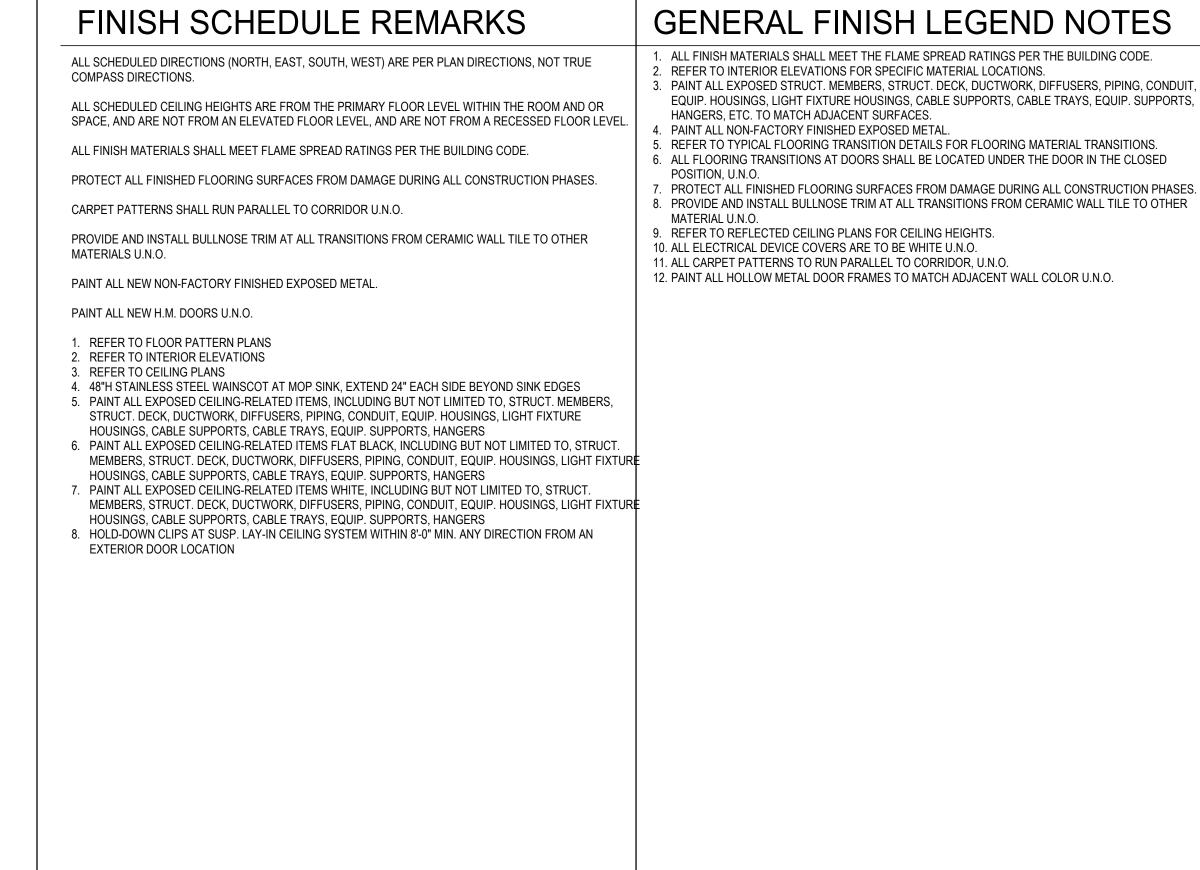

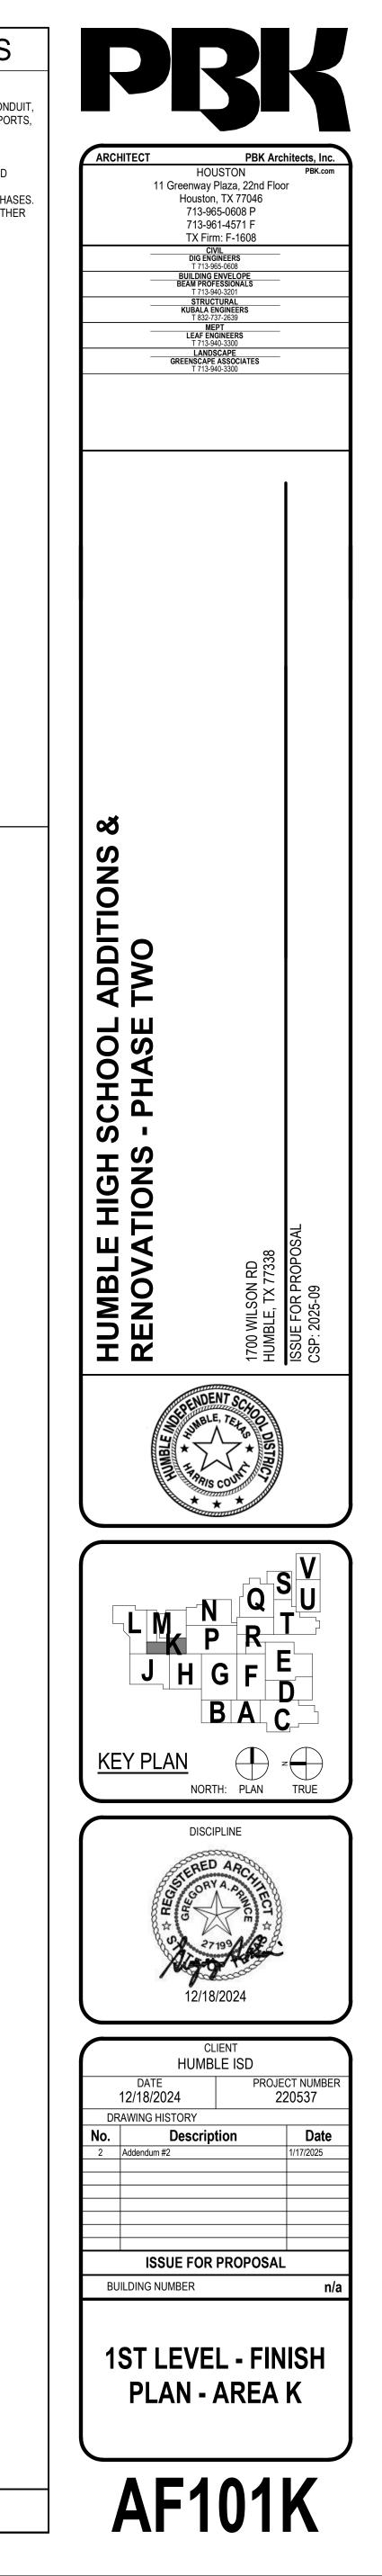




1ST L OCR:

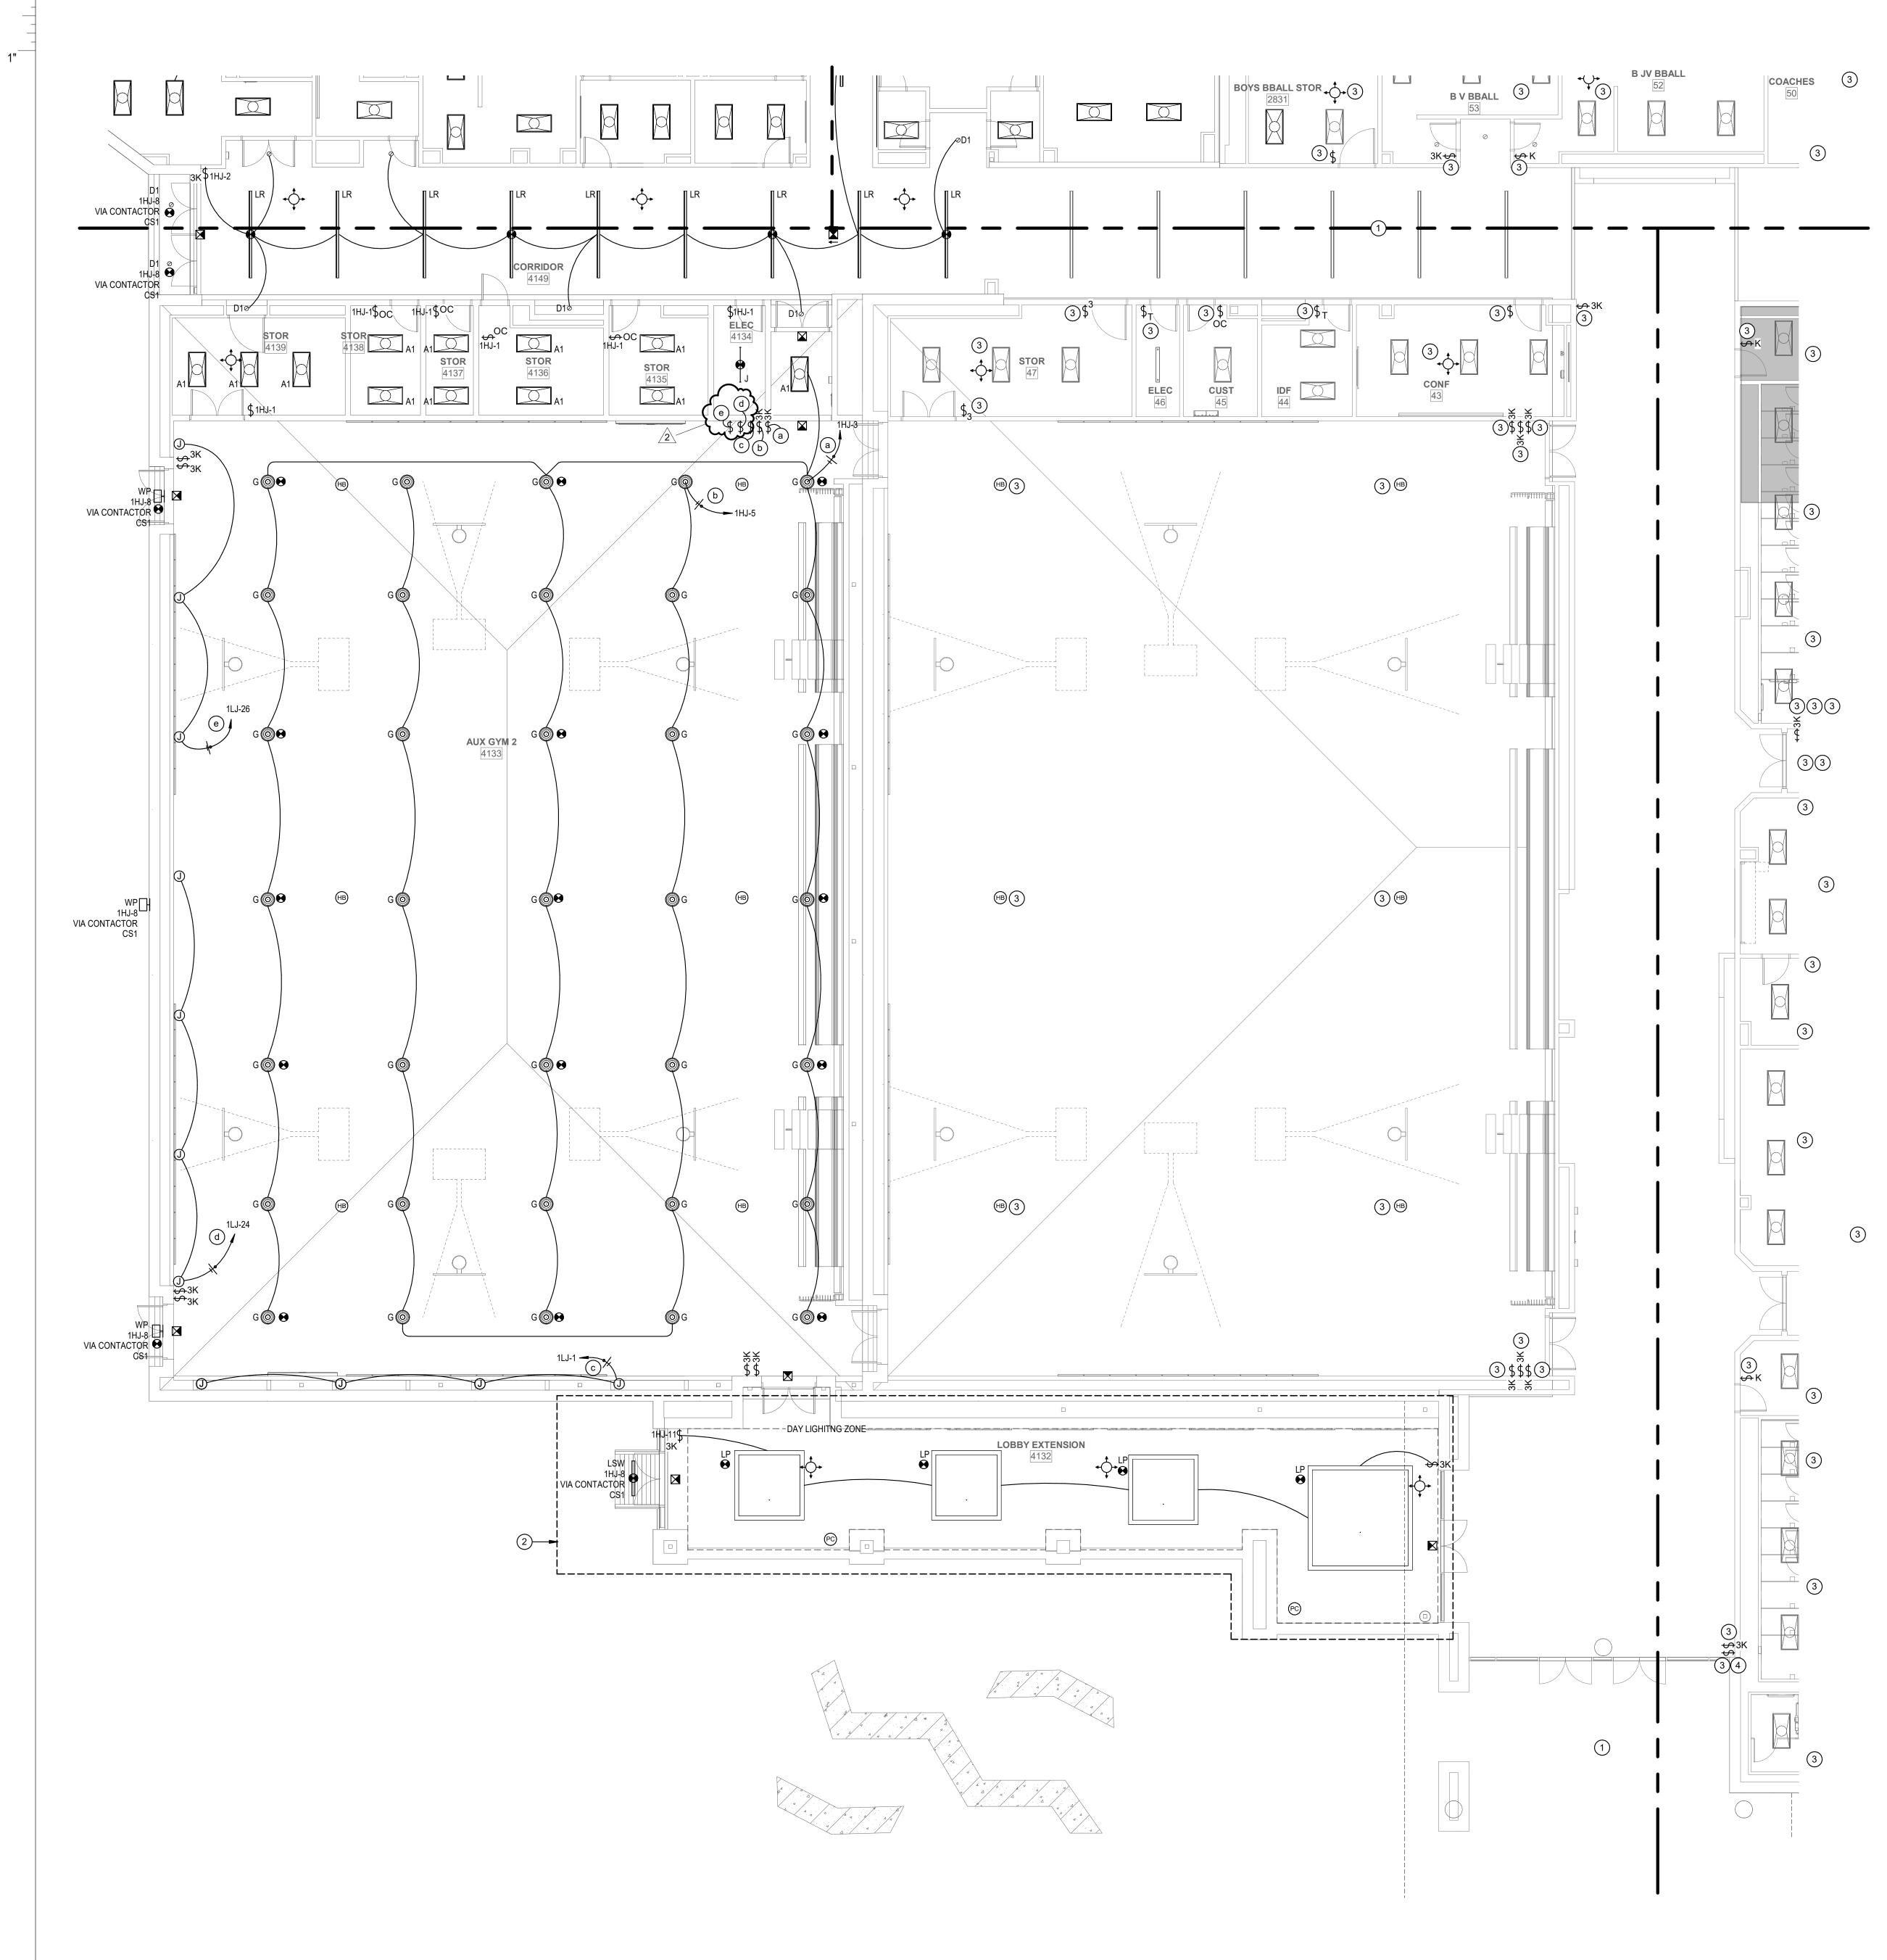


CHECKED BY: DON RICHARDS DRAWN BY: TLG Plot Stamp: 1/17/2025 9:54:31 AM


	LIGHTING PLAN GENERAL NOTES
	1. REFER TO ARCHITECT'S REFLECTED CEILING PLAN FOR EXACT LOCATIONS OF ALL LIGHTING FIXTURES.
	2. UNLESS OTHERWISE NOTED, ALL 2X4'S ARE TYPE "A", ALL EXIT SIGNS ARE TYPE "X".
	3. PROVIDE 20A EMERGENCY LIGHTING BRANCH CIRCUIT(S), 2#10, 1#10G, 3/4"C FROM EMERGENC PANEL. PROVIDE CONNECTION TO ALL 277V FIXTURES DESIGNATED FOR USE AS EMERGENCY THIS AREA. PROVIDE EMERGENCY AUTOMATIC TRANSFER DEVICES FOR ALL LIGHT FIXTURES SHOWN TO BE ON EMERGENCY. PROVIDE 20A UNSWITCHED BRANCH CIRCUIT (2#12, 1#12G, 3/4 FROM EMERGENCY PANEL TO ALL EXIT SIGNS IN THIS AREA, SEE PANEL SCHEDULE FOR CIRCU NUMBER(S).
	4. UNLESS OTHERWISE NOTED, TWO SWITCHES SIDE-BY-SIDE INDICATES MULTI-LEVEL SWITCHIN PROVIDE ONE-PIECE COVER PLATE FOR LIGHT SWITCHES. DESIGNATION NEXT TO SWITCHES INDICATES BRANCH CIRCUIT NUMBER. PROVIDE CONNECTION TO ALL FIXTURES IN THE ROOM.
	 PROVIDE A COMPLETE AND OPERATIONAL SYSTEM OF OCCUPANCY SENSORS FOR ON/OFF CONTROL OF ALL LIGHT FIXTURES INCLUDING BUT NOT LIMITED TO POWER PACKS, WIRING, ET RE: DIVISION 26 SPECIFICATIONS FOR ADDITIONAL INFORMATION.
	6. REFER TO ARCHITECTURAL SHEETS FOR ADDITIONAL DETAILS REGARDING AREAS OF SCOPE. THE ARCHITECTURAL SHEETS SHALL TAKE PRECEDENCE OVER ELECTRICAL SHEETS SHOULD ANY DISCREPANCIES BE FOUND.
	 NEW LIGHTING CONTROLS TO BE PROVIDED SHALL MATCH THE OWNER SUPPLIED LIGHTING CONTROLS SHOWN ON SHEET E-601 WITH NO EXCEPTIONS.
	LIGHTING PLAN KEYED NOTES:
	1 NOT IN SCOPE OF WORK.
	2 SCOPE OF WORK SHALL BE PROVIDED AS PART OF ALTERNATE #8.
	(3) LIGHTING AND BRANCH CIRCUITRY IN THIS ROOM ARE EXISTING TO REMAIN. CONTRACTOR SH INSTALL NEW CONTROLS AS INDICATED. NEW CONTROLS SHALL BE PROVIDED FROM OWNER STOCK. NEW LIGHITNG CONTROLS SHALL BE CONNECTED TO EXISTING LIGHITNG AND BRANC CIRCUITRY CURRENTLY SERVING THIS AREA. REFER TO SHEET E-601 FOR A LIST OF OWNER SUPPLIED LIGHTING CONTROLS.
	4 BMCS OVERRIDE SWITCH TO CONTROL CONTACTOR CONTROLLED INTERIOR LIGHTING. LOCA ADJACENT TO SECURITY KEYPAD. OVERRIDE SHALL BE PROVIDED FROM OWNERS STOCK. RE TO SHEET E-601 FOR A LIST OF OWNER SUPPLIED LIGHTING CONTROLS.
ļ	

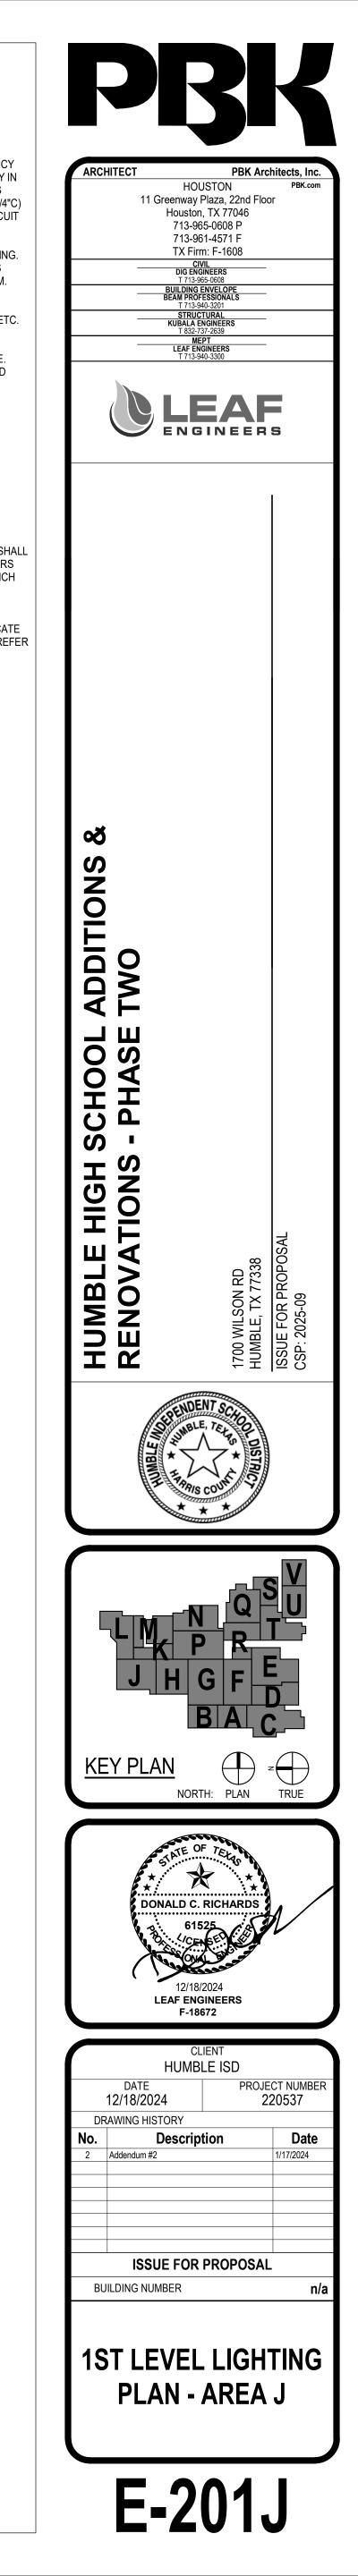



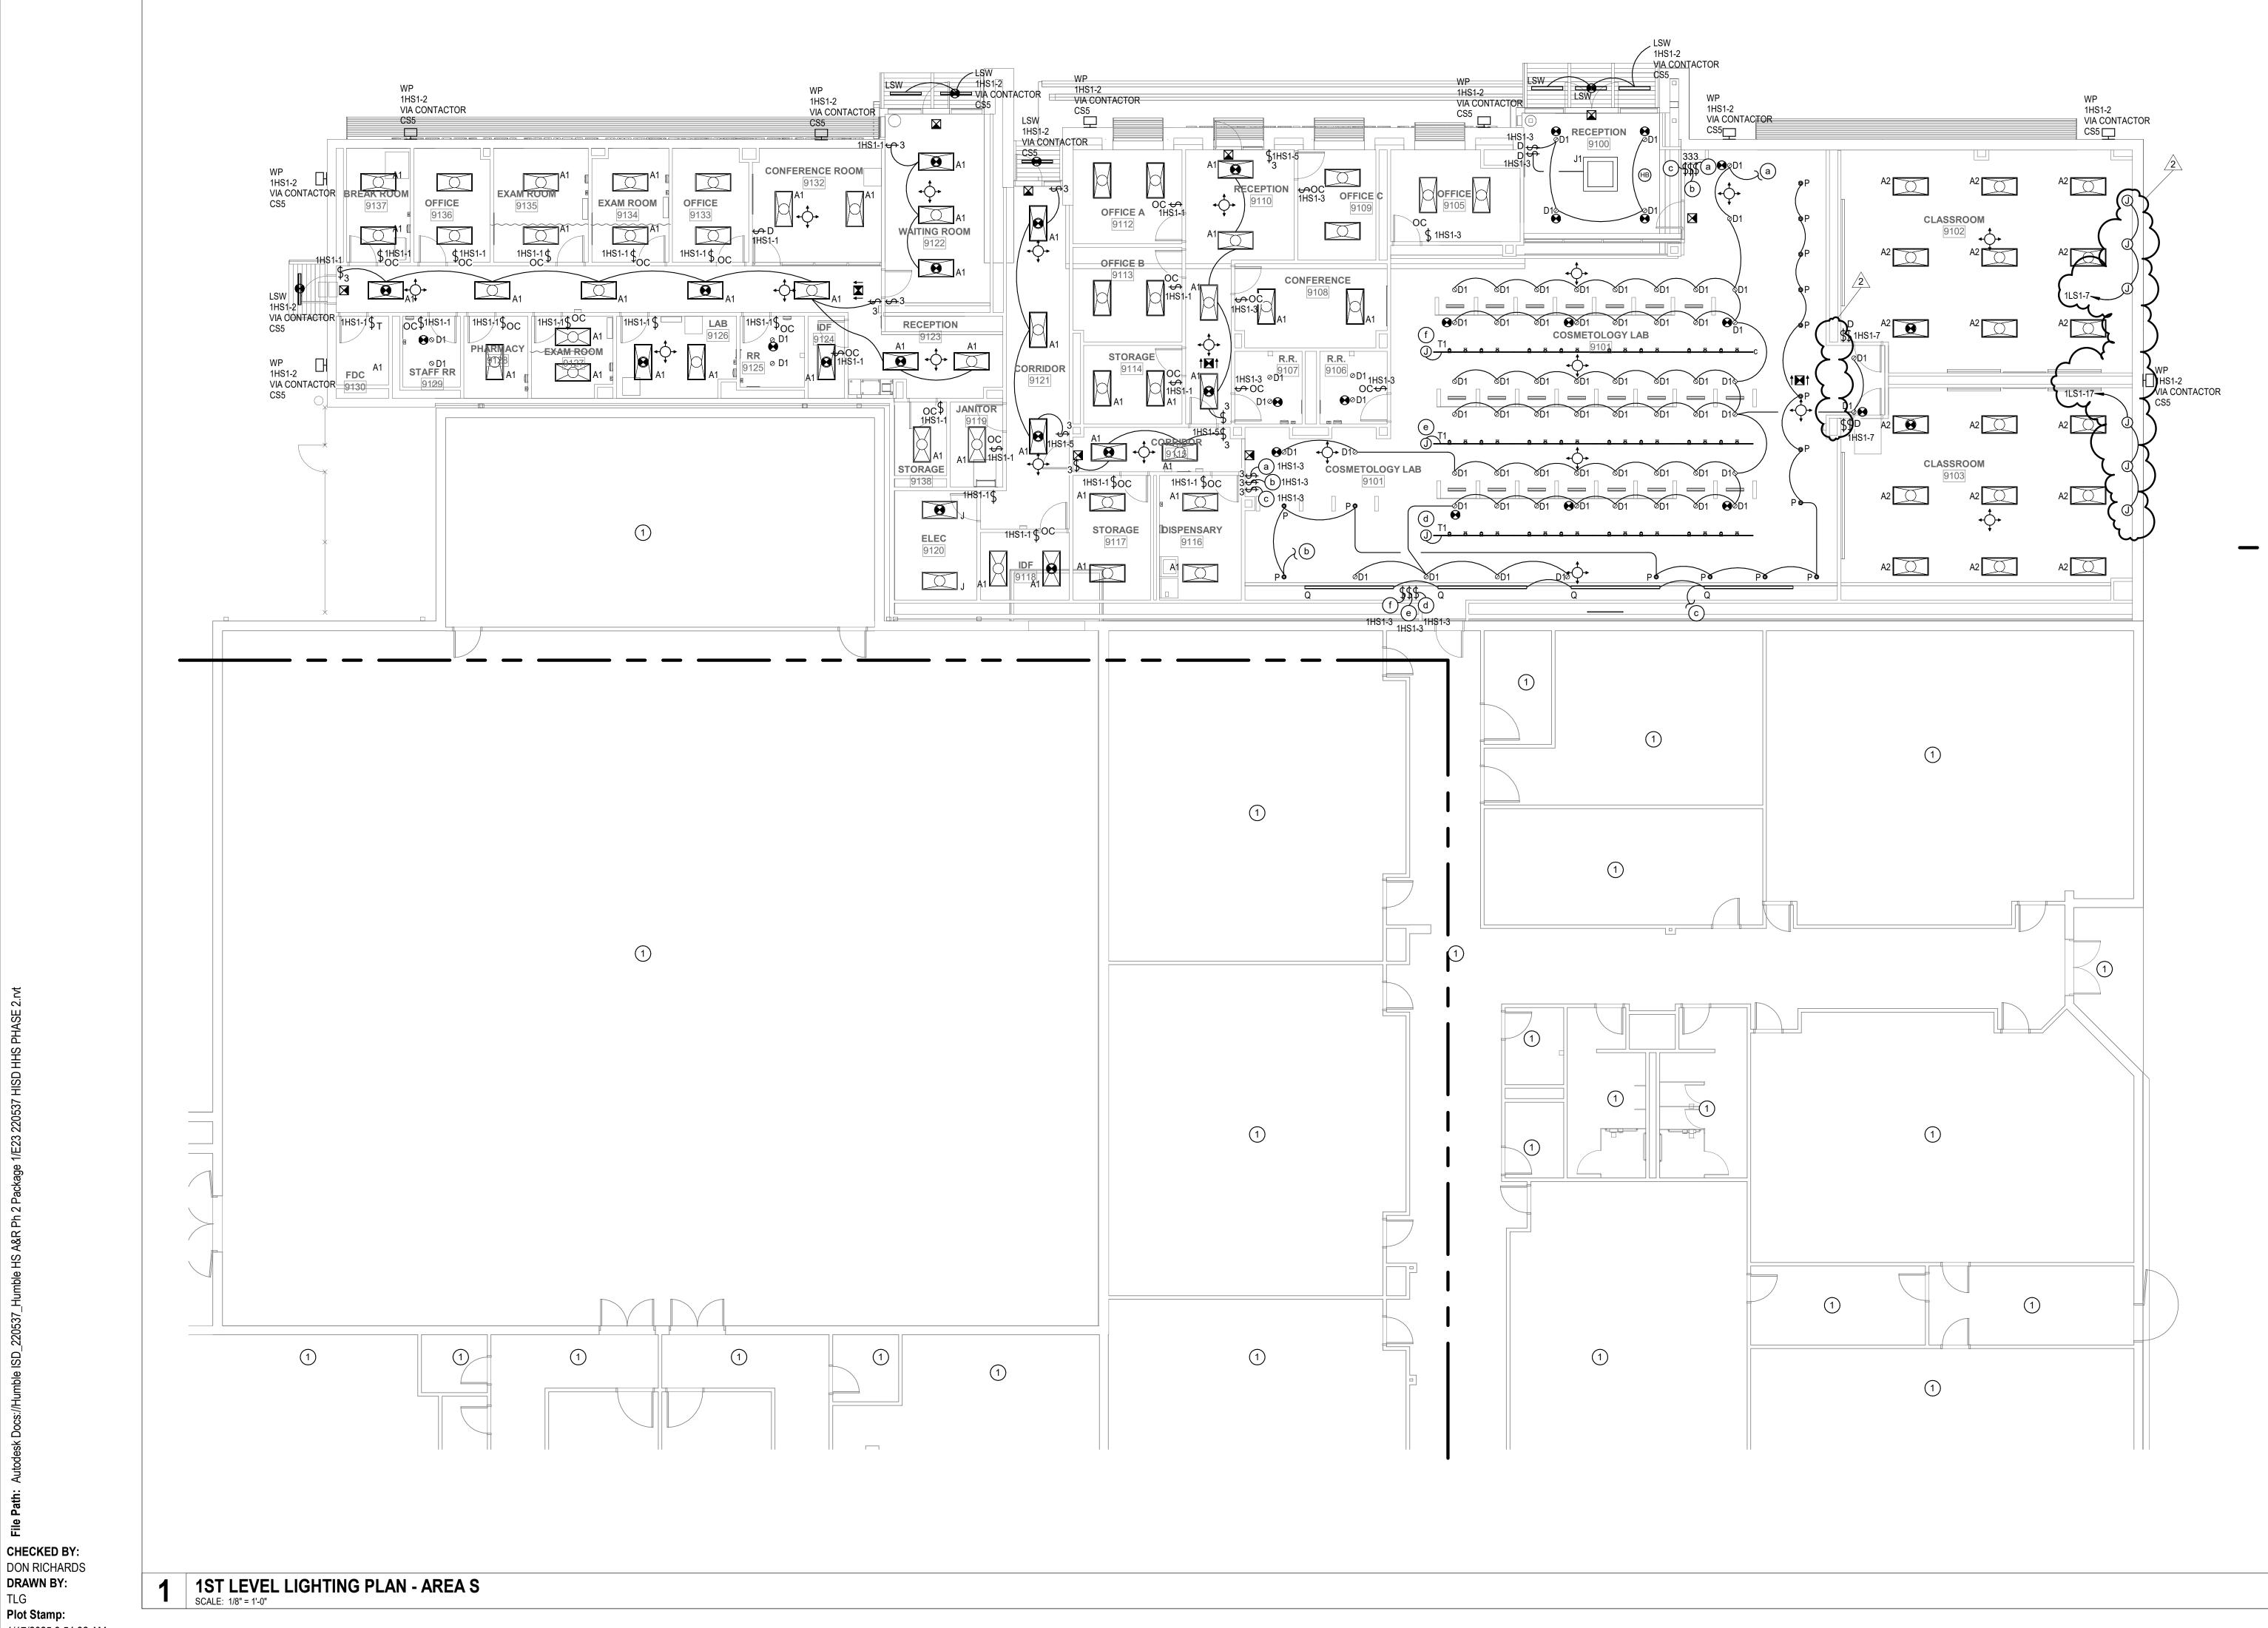


TLG Plot Stamp: 1/17/2025 9:54:32 AM

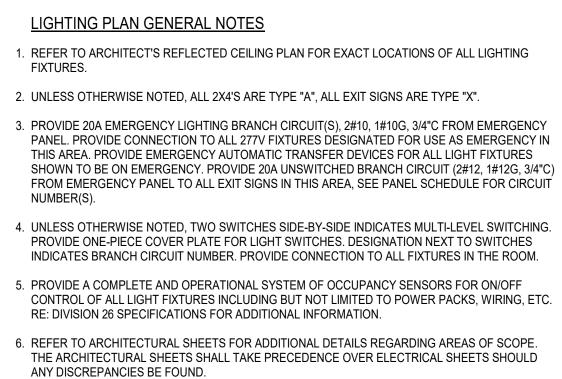

7. NEW LIGHTING CONTROLS TO BE PROVIDED SHALL MATCH THE OWNER SUPPLIED LIGHTING CONTROLS SHOWN ON SHEET E-601 WITH NO EXCEPTIONS.

LIGHTING PLAN KEYED NOTES:

1 NOT IN SCOPE OF WORK.

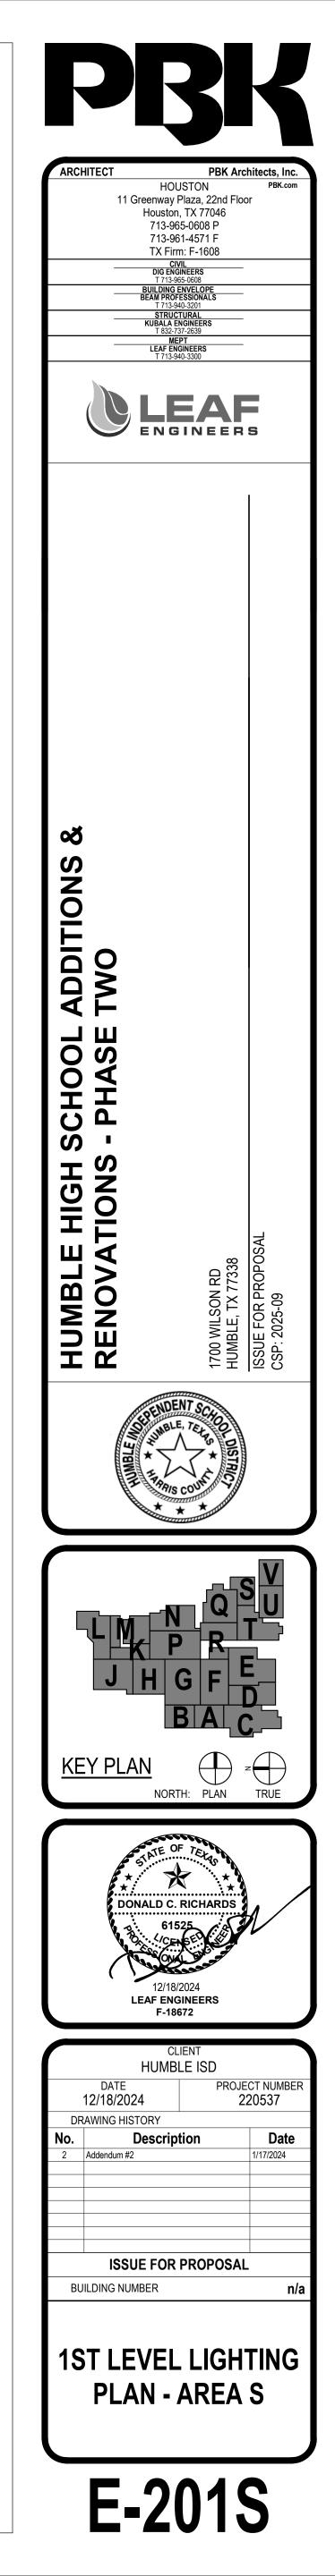

:-703

DRAWN BY: TLG Plot Stamp: 1/17/2025 9:54:32 AM

ept Motor	Heat	Cool	Other	Kitchen	S/S 0.00 0.00 0.00 0.00 0.00	LIGHI LIGHI CORR CLASS SPACI
Ppt Motor	Heat		Other	Kitchen	0.00 0.00 0.00 0.00 0.00	LIGHIT CORR CLASS
					0.00 0.00 0.00 0.00	LIGHI ⁻ CORR CLASS
					0.00 0.00 0.00	CORR CLASS
					0.00 0.00	CLASS
					0.00	-
						SPACI
					0.00	SPAC
					0.00	SPACI
					0.00	SPAC
					0.00	SPAC
					0.00	SPAC
					0.00	SPACI
					0.00	SPACI
					0.00	SPAC
					0.00	SPAC
					0.00	SPACI
					0.00	SPACI
						SPACI
						SPACI
0 1508	1100	0	3957	800		XFMR
						-
						-
50 4523	3300	0	11870	2400	0.00	TOTAI
						7
nt Motor	-	1	Other	Kitchen	\$/\$	 Descri
·						Conne
						*Desig
8 84.0	89.3	0.0	35.2	1.6	0.0	Desig
	0 1508 0 1508 i0 4523 pt Motor 7 84.0 1.00	0 1508 1100 0 1508 1100 0 4523 3300 LOAD S pt Motor Heat 7 84.0 89.3 1.00 1.00	0 1508 1100 0 0 1508 1100 0 1508 3300 0 LOAD SUMMARY pt Motor Heat Cool 7 84.0 89.3 0.0 1.00 1.00 1.00	0 1508 1100 0 3957 0 1508 1100 0 3957 00 1508 1100 0 3957 00 4523 3300 0 11870 LOAD SUMMARY pt Motor Heat Cool Other 7 84.0 89.3 0.0 35.2 1.00 1.00 1.00 1.00 1.00	0 1508 1100 0 3957 800 0 1508 1100 0 3957 800 00 1508 1100 0 3957 800 00 4523 3300 0 11870 2400 LOAD SUMMARY pt Motor Heat Cool Other Kitchen 7 84.0 89.3 0.0 35.2 2.4 1.00 1.00 1.00 1.00 0.65	Image: Constraint of the system 0.00 0.00 0.00 0.00 0.00 0.1508 1100 0 3957 800 0.00 0 1508 1100 0 3957 800 0.00 0 1508 1100 0 3957 800 0.00 0 1508 1100 0 3957 800 0.00 0 1508 1100 0 3957 800 0.00 0 4523 3300 0 11870 2400 0.00 LOAD SUMMARY LOAD SUMMARY Teat Cool Other Kitchen S/S 7 84.0 89.3 0.0 35.2 2.4 0.0 1.00 1.00 1.00 0.65 0.50 0.50

