Addendum No. 3 Page 1 of 2

#### ADDENDUM NO. 3

For: Elementary School # 38 522 Brookewater Boulevard Rosenberg, TX 77471 for LAMAR CISD 3911 Avenue I Rosenberg, TX 77471

#### STERED ARCHING BUSCH Ralegistin BUSCH RA

#### TO: DRAWINGS AND SPECIFICATIONS DATED: December 12, 2024

#### PREPARED BY: PFLUGER ARCHITECTS, L.P.

ADDENDUM DATE: January 13, 2025

#### PROJECT NO: 24-028

This addendum shall be considered part of the Bid Documents for the above named project as though it had been issued at the same time and shall be incorporated integrally therewith. Where provisions of the following supplementary data differ from those of the original Bid Documents, this Addendum shall govern and take precedence.

Bidders are hereby notified that they shall make any necessary adjustments in their estimates as a result of this Addendum. It will be construed that each bidder's proposal is submitted with full knowledge of all modifications and supplemental data specified herein.

Addendum No.3 consists of the following: ADD. NO. 3 - Pfluger Narrative ADD. NO. 3 - Specifications ADD. NO. 3 - Drawings ADD. NO.3 - Bid Log

#### GENERAL:

The Bid Documents are modified and clarified as follows:

Reference to Specification or Detail modifications in this Addendum are to attached documents. Including the following attached narratives

Addendum 3 Architectural Narrative - 2 pages Addendum 3 MEPT Narrative - 2 pages. Addendum 3 Structural Narrative - 2 pages Addendum 3 Civil Narrative - 1 pages. Addendum 3 Specs - 26 pages Addendum 3 Sheets - 23 pages RFI Log - 8 pages

| ITEM | SHEET | DESCRIPTION  |
|------|-------|--|
| G0-1 |       | RFI Log Attached at the end of this Addendum   |
| G0-2 |       | Specification Section 00 11 00 REQUEST FOR COMPETITIVE SEALED PROPOSALS pages 24 and 25 TEXAS STATUTORY PERFORMANCE BOND and TEXAS STATUTORY PAYMENT BOND forms will only be executed when there is a contract in place. |
| G0-3 |       | Confirmation was received from Centerpoint on January 14, 2025, that the transformer had been ordered. The expected delivery of the transformer is in 55 weeks from this date.   |

GENERAL:

DATE: 1/14/25

#### SPECIFICATIONS:

| ITEM | SECTION    | DESCRIPTION  |  |
|------|------------|--|--|
| S3-1 | 00 01 01   | Table of Contents is REVISED to reflect sections issued as part of this Addendum           |  |
| S3-2 | 00 01 01.1 | Architect Table of Contents is REVISED to reflect sections issued as part of this Addendum |  |
| S3-3 | 00 20 00   | Paragraph 1.13.B is ADDED  |  |
| S3-4 | 09 84 13   | Paragraph 2.01.A.5 is REVISED  |  |
| S3-5 | 32 31 19   | is section is REISSUED in its entirety   |  |

#### DRAWINGS:

| ITEM  | SHEET  | DESCRIPTION   |  |
|-------|--------|---|--|
| D3-1  | A1.06  | Adjusted dimensioning on detail 2   |  |
| D3-2  | A9.00A | Adjusted material schedule for AWP - 1, AWP - 2, AWP - 3                          |  |
| D3-3  | A9.00B | Updated remarks on material schedule for gym C107                                 |  |
| D3-4  | A9.00B | Changed floor type to sealed concrete on rooms B127, E130, and A125               |  |
| D3-4  | A9.01A | Moved weapon rack In A115   |  |
| D3-5  | A9.01A | odified library casework schedule   |  |
| D3-6  | A9.01A | pdated Floor in room A125   |  |
| D3-7  | A9.01A | Removed wall clocks in rooms A106, A108, A109, A121, A122, A123, A124.            |  |
| D3-8  | A9.01B | Updated Floor in room B127  |  |
| D3-9  | A9.01E | pdated Floor in room E130   |  |
| D3-10 | A9.10  | Nodified casework and added Weapon rack to elevation 16                           |  |
| D3-11 | A9.12  | Added note regarding high impact wall acoustical wall panels in elevation 2 and 3 |  |
|       |        |   |  |

END OF ADDENDUM 3



# **Civil Narrative**

Lamar CISD Elementary School No. 38 Addendum 3 January 14, 2025

Below is a summary of the sheet revisions for Addendum 3.

# C2.00 DEMOLITION PLAN

- Added linework for existing steel casing.
- Added linework to remove or relocate existing steel casing.

# C3.01 SCHOOL ZONE SIGNAGE PLAN

- Added linework for existing steel casing.
- Added linework to remove or relocate existing steel casing.
- Added two (2) school zone flashers on Future Brookewater Boulevard (keynote G1).
- Added No Parking Sign locations to plans (keynotes G5, G6, G7).

# **C5.00 STORM SEWER UTILITY PLAN**

- Revised proposed storm piping within future Brookewater Boulevard from HDPE to RCP (add alternate).
- Revised layout of 54" RCP within future Brookewater Boulevard to match the intended ultimate outfall into the existing detention pond (add alternate)
- Added proposed storm inlet within future Brookwater Boulevard (add alternate)

# C5.01 SANITARY AND WATER UTILITY PLAN

• Background update for proposed storm revisions within future Brookewater Boulevard.

#### C7.00 DRAINAGE PLAN

• Background update for proposed storm revisions within future Brookewater Boulevard.

# C15.00 MISCELLANEOUS DETAILS

• Added artificial turf detail.

If you have any questions, please contact us at (713) 337-8881.

Thank you,

Fred Dally, P.E. Dally + Associates, Inc.



#### ADDENDUM NO. 3

For: Elementary School # 38 522 Brookewater Boulevard Rosenberg, TX 77471 for LAMAR CISD 3911 Avenue I Rosenberg, TX 77471

#### TO: DRAWINGS AND SPECIFICATIONS DATED: December 12, 2024

PREPARED BY: PFLUGER ARCHITECTS, L.P.

#### ADDENDUM DATE: January 14, 2025

#### PROJECT NO: 24-028

This addendum shall be considered part of the Bid Documents for the above named project as though it had been issued at the same time and shall be incorporated integrally therewith. Where provisions of the following supplementary data differ from those of the original Bid Documents, this Addendum shall govern and take precedence.

Bidders are hereby notified that they shall make any necessary adjustments in their estimates as a result of this Addendum. It will be construed that each bidder's proposal is submitted with full knowledge of all modifications and supplemental data specified herein.

Addendum No.3 consists of t ADD. NO. 3 - Pfluger Narrative

ADD. NO. 3 - Phager Narrativ ADD. NO. 3 - Specifications ADD. NO. 3 - Drawings ADD. NO.3 - Bid Log

#### GENERAL:

The Bid Documents are modified and clarified as follows:

Reference to Specification or Detail modifications in this Addendum are to attached documents. Including the following attached narratives

Addendum 3 Architectural Narrative - 2 pages Addendum 3 MEPT Narrative - 2 pages. Addendum 3 Structural Narrative - 2 pages Addendum 3 Civil Narrative - 1 page Addendum 3 Specs - 26 pages Addendum 3 Sheets - 23 pages RFI Log - 8 pages

#### GENERAL:

| ITEM | SHEET | # | DESCRIPTION |
|------|-------|---|-------------|
| G1-1 |       |   |             |
| G1-2 |       |   |             |

#### SPECIFICATIONS:

| ITEM | SECTION | # | DESCRIPTION |  |
|------|---------|---|-------------|--|
| S1-1 |         |   |             |  |
| S1-2 |         |   |             |  |

DRAWINGS:

| ITEM | SHEET | # | DESCRIPTION               |
|------|-------|---|---------------------------|
| D1-1 | S3.02 |   | Detail 14/S3.02 is added. |



| D1-2 | S6.01 | Detail 13/S6.01 is revised to call out base connection at window support at hollowcore plank slabs. |
|------|-------|---|
|      |       |   |

END OF ADDENDUM 3

# ADDENDUM NO. 3

For: Elementary School # 38 522 Brookewater Boulevard Rosenberg, TX 77471 for LAMAR CISD 3911 Avenue I Rosenberg, TX 77471



#### TO: DRAWINGS AND SPECIFICATIONS DATED: December 12, 2024

PREPARED BY: PFLUGER ARCHITECTS, L.P.

ADDENDUM DATE: January 14, 2025

#### PROJECT NO: 24-028

This addendum shall be considered part of the Bid Documents for the above named project as though it had been issued at the same time and shall be incorporated integrally therewith. Where provisions of the following supplementary data differ from those of the original Bid Documents, this Addendum shall govern and take precedence.

Bidders are hereby notified that they shall make any necessary adjustments in their estimates as a result of this Addendum. It will be construed that each bidder's proposal is submitted with full knowledge of all modifications and supplemental data specified herein.

Addendum No.3 consists of the following: ADD. NO. 3 - Pfluger Narrative ADD. NO. 3 - Specifications ADD. NO. 3 - Drawings ADD. NO.3 - Bid Log

#### GENERAL:

The Bid Documents are modified and clarified as follows:

Reference to Specification or Detail modifications in this Addendum are to attached documents. Including the following attached narratives

Addendum 3 Architectural Narrative - 2 pages Addendum 3 MEPT Narrative - 2 pages. Addendum 3 Structural Narrative - 2 pages Addendum 3 Civil Narrative - 1 page Addendum 3 Specs - 26 pages Addendum 3 Sheets - 23 pages RFI Log - 8 pages

| GENERAL: |       |   |             |  |  |  |
|----------|-------|---|-------------|--|--|--|
| ITEM     | SHEET | # | DESCRIPTION |  |  |  |
| G3-1     |       |   | N/A         |  |  |  |

| SPECIFICATIONS: |         |   |   |  |  |  |
|-----------------|---------|---|---|--|--|--|
| ITEM            | SECTION | # | DESCRIPTION                               |  |  |  |
| S3-1            |         |   | N/A                                       |  |  |  |
|                 |         |   |   |  |  |  |
| DRAWING         | SS:     |   |   |  |  |  |
| ITEM            | SHEET   | # | DESCRIPTION                               |  |  |  |
| D3-1            | M2.01F  |   | Revise condensate pipe routing for DMS-5. |  |  |  |

| D3-2  | M2.01F | Storage F132, add 6x4 return air path.  |  |
|-------|--------|---|--|
| D3-3  | M2.01F | Replace sheet in its entirety.  |  |
| D3-4  | E2.01A | Library A132, revise fixture type P1-D to type P1-B.  |  |
| D3-5  | E2.01A | Parents Volunteer, revise fixture type P1-E to type P1-C.   |  |
| D3-6  | E2.01A | Revise note for fixture type M8 to the following: "SIGNAGE PRIOR TO ORDERING. (TYPICAL OF 12)"                        |  |
|       |        |   |  |
| D3-7  | E3.01D | Add keyed note 7, note shall read: "PROVIDE JUNCTION BOX FOR WALL MOUNTED CLOCKS, COORDINATE EXACT                    |  |
|       |        | LOACTION WITH T-SERIES (TECHNOLOGY) DRAWINGS AND MAKE FINAL CONNECTION."  |  |
| D3-8  | E3.01D | Revise keyed note at column BE/19 to keyed note 7.  |  |
| D3-9  | E3.01D | Column EA/D2, add a junction box via keyed note 7 for wall mounted clock. Connect to circuit LB-61 with 2#12, 1#12G., |  |
|       |        | 3/4"C.  |  |
| D3-10 | P4.02  | Add water to fill faucets in kitchen.   |  |
| D3-11 | P4.03  | Add water to fill faucets in kitchen and show floor drain.  |  |
| D3-12 | P5.01  | Revise grease trap sizing calculation detail.   |  |
| D3-13 | T2.00  | Add Card reader at mechanical yard door S007  |  |
| D3-14 | T2.01D | Add double faced clock in corrido D100  |  |
| D3-15 | T4.03  | Add ACS Door Connection Detail  |  |

END OF ADDENDUM 3

# TABLE OF CONTENTS

# VOLUME 1 of 2

# **INFORMATION**

 Table of Contents [REVISED: ADDENDUM #3]

 Design Team Seals Pages [REVISED: ADDENDUM #3]

# **DIVISION 00 00 00 - PROCUREMENT AND CONTRACTING REQUIREMENTS**

00 11 00 - REQUEST FOR COMPETITIVE SEALED PROPOSALS [REVISED: ADDENDUM #1] 00 20 00 - INSTRUCTIONS TO OFFERORS [REVISED: ADDENDUM #3] 00 40 01 - PROPOSAL BOND 00 40 12 - LIST OF SUBCONTRACTORS 00 40 13 - AFFIDAVIT OF NON-DISCRIMINATORY EMPLOYMENT 00 40 14 - AFFIDAVIT OF NON-ASBESTOS, LEAD, AND PCB USE IN PROJECT 00 40 17 - CRIMINAL HISTORY RECORD INFORMATION 00 65 00 - EVALUATION CRITERIA 00 65 01 - PROPOSAL EVALUATION FORM 00 72 00 - CONTRACT DOCUMENTS 00 73 00 - A201 LCISD SUPPLEMENTARY CONDITIONS 00 73 19 - SAFETY REQUIREMENTS 00 73 50 - 2022 HOUSTON PREVAILING WAGE RATES **DIVISION 01 00 00 - GENERAL REQUIREMENTS** 01 10 00 - MISCELLANEOUS REQUIREMENTS 01 21 00 - ALLOWANCES [REVISED: ADDENDUM #1] 01 22 00 - UNIT PRICES 01 23 00 - ALTERNATES [REVISED: ADDENDUM #1] 01 25 13 - PRODUCT SUBSTITUTION PROCEDURES 01 26 00 - CONTRACT MODIFICATION PROCEDURES 01 29 00 - SCHEDULE OF VALUES & PAYMENT PROCEDURES 01 31 00 - PROJECT MANAGEMENT AND COORDINATION 01 31 15 - PROJECT MANAGEMENT COMMUNICATIONS - CONTRACTOR 01 31 19 - PROJECT MEETINGS 01 32 00 - SCHEDULES, REPORTS AND PAYMENTS 01 32 16 - CONSTRUCTION SCHEDULE 01 33 01 - SUBMITTAL PROCEDURES 01 35 23 - OWNER SAFETY REQUIREMENTS

- 01 35 23.2 BADGING VERSION 6.0
- 01 35 23.2 BADGING VERSION 7.0
- 01 35 43 ENVIRONMENTAL PROCEDURES
- 01 40 00 QUALITY REQUIREMENTS
- 01 42 00 OWNER REQUIREMENTS
- 01 42 01 GUIDELINES FOR 4S SAFETY PLAN IMPLEMENTATION V4
- 01 42 19 REFERENCE STANDARDS AND DEFINITIONS
- 01 45 29 TESTING LABORATORY SERVICES
- 01 50 00 TEMPORARY FACILITIES AND CONTROLS
- 01 57 13 EROSION AND SEDIMENTATION CONTROL
- 01 60 00 PRODUCT REQUIREMENTS
- 01 73 29 CUTTING AND PATCHING
- 01 74 23 FINAL CLEANING
- 01 77 00 CLOSEOUT PROCEDURES
- 01 77 01 CLOSEOUT FORMS A-D

01 77 02 - WAIVER AND RELEASE OF LIENS 01 78 36 - WARRANTIES AND GUARANTEES 01 78 39 - PROJECT RECORD DOCUMENTS 01 91 13 - GENERAL COMMISSIONING

#### **DIVISION 02 00 00 - EXISTING CONDITIONS**

02 32 00 - GEOTECHNICAL DATA 02 32 00.1 - GEOTECHNICAL REPORT 02 41 17 - DEMOLITION

# DIVISION 03 00 00 - CONCRETE

03 05 16 - UNDERSLAB VAPOR BARRIER 03 10 00 - CONCRETE FORMING AND ACCESSORIES 03 21 00 - SITE CONCRETE REINFORCEMENT 03 30 00 - CAST-IN-PLACE CONCRETE 03 41 13 - PRECAST CONCRETE HOLLOW CORE PLANKS 03 52 16 - LIGHTWEIGHT INSULATING CONCRETE)

# **DIVISION 04 00 00 - MASONRY**

04 20 00 - UNIT MASONRY

# DIVISION 05 00 00 - METALS

05 12 00 - STRUCTURAL STEEL 05 21 00 - STEEL JOIST FRAMING 05 31 00 - STEEL DECKING 05 40 00 -COLD-FORMED METAL FRAMING 05 50 00 - METAL FABRICATIONS 05 52 13 - PIPE AND TUBE RAILINGS

# **DIVISION 06 00 00 - WOOD, PLASTICS & COMPOSITES**

06 10 00 - ROUGH CARPENTRY 06 20 00 - MILLWORK AND FINISH CARPENTRY 06 61 16 - SOLID SURFACING FABRICATIONS

# **DIVISION 07 00 00 - THERMAL AND MOISTURE PROTECTION**

07 11 13 - BITIMINOUS DAMPPROOFING 07 21 00 - BUILDING INSULATION 07 21 19 - FOAMED-IN-PLACE INSULATION 07 26 00 - FLUID APPLIED AIR BARRIER 07 42 13 - PREFORMED METAL WALL PANELS [REVISED: ADDENDUM #2] 07 42 13.1 - INSULATED METAL WALL PANELS 07 42 15 - PREFORMED METAL SOFFIT PANELS 07 52 19 - MOD BIT ROOFING SYSTEM 07 62 00 - ROOF RELATED SHEET METAL-ADD 2 07 65 00 - FLEXIBLE FLASHING 07 65 26 - MEMBRANE THROUGH-WALL FLASHING 07 72 00 - ROOF ACCESSORIES-ADD 3 07 72 33 - ROOF HATCH 07 84 00 - FIRESTOPPING 07 90 00 - JOINT PROTECTION 07 95 13 - EXPANSION JOINT COVER ASSEMBLIES

# **DIVISION 08 00 00 - OPENINGS**

08 11 00 - HOLLOW METAL DOORS & FRAMES 08 15 13 - PLASTIC LAMINATE FACED WOOD DOORS 08 31 13 - ACCESS DOORS AND FRAMES 08 33 00 - ROLLING GRILLES 08 33 02 - ROLLING COUNTER SHUTTERS 08 41 13 - ALUMINUM ENTRANCES AND STOREFRONTS [REVISED: ADDENDUM #2] 08 44 13 - ALUMINUM CURTAIN WALL SYSTEM [REVISED: ADDENDUM #2] 08 71 00 – DOOR HARDWARE [REVISED: ADDENDUM #2] 08 80 00 - GLASS AND GLAZING 08-88-53 - SECURITY GLAZING

# **DIVISION 09 00 00 - FINISHES**

09 21 16 - GYPSUM BOARD ASSEMBLIES
09 30 00 - TILING
09 51 00 - SUSPENDED ACOUSTICAL CEILINGS
09 54 23 - LINEAR METAL CEILINGS
09 64 55 - RESILIENT WOOD FLOOR-STAINED SURFACE
09 65 00 - RESILIENT FLOORING
09 65 13 - RESILIENT BASE
09 65 25 - VINYL TILE\_PLANK FLOORING (LVT)
09 66 13 - PORTLAND CEMENT TERRAZZO FLOORING
09 67 23 - RESINOUS FLOORING
09 68 16 - CARPET
09 72 00 - PRESENTATON DRY-ERASE WALLCOVERING
09 72 00 - WALL COVERING
09 84 13 - FABRIC COVERED ACOUSTICAL PANELS [REVISED: ADDENDUM #3]
09 90 00 - PAINTING AND COATING

#### **DIVISION 10 00 00 - SPECIALTIES**

10 05 00 - MISCELLANEOUS SPECIALTIES 10 11 00 - VISUAL DISPLAY BOARDS 10 14 00 - ARCHITECTURAL SIGNAGE 10 14 64 - ELECTRONIC MESSAGE SIGNAGE *[ISSUED: ADDENDUM #2]* 10 21 16 - SOLID PLASTIC TOILET PARTITIONS 10 21 23 - CUBICLE CURTAINS AND TRACK 10 22 26 - OPERABLE PARTITIONS 10 26 13 - CORNER GUARDS 10 28 00 - TOILET AND BATH ACCESSORIES *[REVISED: ADDENDUM #2]* 10 44 13 - FIRE EXTINGUISHERS AND CABINETS 10 51 13 - WEAPONS RACK 10 56 13 - METAL STORAGE SHELVING 10 73 00 - PROTECTIVE COVERS

10 75 16 - FLAGPOLE

#### **DIVISION 11 00 00 – EQUIPMENT**

11 16 19 - RAPID ENTRY SYSTEM (FIREMAN LOCK BOX)
11 31 13 - RESIDENTIAL APPLIANCES
11 40 00 - FOOD SERVICE EQUIPMENT
11 52 13 - PROJECTION SCREENS
11 61 43 - STAGE CURTAINS
11 66 00 - ATHLETIC EQUIPMENT
11 72 00 - AUTOMATED EXTERNAL DEFIBRILLATORS

# **DIVISION 12 00 00 - FURNISHINGS**

12 21 13 - METAL HORIZONTAL LOUVER BLINDS 12 24 13 - MOTORIZED ROLLER WINDOW SHADES 12 24 15 - MANUALLY OPERATED ROLLER WINDOW SHADES 12 32 16 - MANUFACTURED PLASTIC LAMINATE CLAD CASEWORK 12 56 00 - LIBRARY FURNITURE 12 93 13 - BICYCLE RACKS

# DIVISION 13 00 00 THROUGH 20 00 00 - NOT USED

# VOLUME 2 of 2

# INFORMATION

TABLE OF CONTENTS DESIGN TEAM SEALS PAGES

# **DIVISION 21 00 00 - FIRE SUPRESSION**

21 01 00 - FIRE PROTECTION OPERATING & MAINTENANCE MANUALS 21 05 00 - FIRE PROTECTION GENERAL PROVISIONS 21 05 10 - FIRE PROTECTION CONTRACT QUALITY CONTROL 21 05 12 - FIRE PROTECTIONSHOP DRAWINGS, COORD DRAWINGS, PROD DATA 21 05 13 - ELECTRICAL PROVISIONS OF FIRE PROTECTION WORK 21 10 00 - FIRE SPRINKLER SYSTEM

# **DIVISION 22 – PLUMBING**

22 01 00 - PLUMBING OPERATING & MAINTENANCE MANUALS 22 05 00 - PLUMBING GENERAL PROVISIONS 22 05 10 - PLUMBING CONTRACT QUALITY CONTROL 22 05 11 - UNDER SLAB PIPE VOID SYSTEM [ISSUED: ADDENDUM #2] 22 05 12 - SHOP DRAWINGS, COORD.DRAWINGS & PRODUCT DATA 22 05 13 - ELECTRICAL PROVISIONS OF PLUMBING WORK 22 05 15 - PLUMBING EARTHWORK 22 05 16 - EXC, BACKFILLING & COMPACT FOR UTILITIES 22 05 17 - PLUMBING ACCESS DOORS 22 05 19 - PRESS & TEMP INSTRU FOR PLUMBING PIPING 22 05 23 - VALVES, STRAINERS & VENTS 22 05 33 - PIPE HEAT TRACING 22 07 19 - PLUMBING PIPING INSULATION 22 08 00 - PLUMBING COMMISSIONING 22 11 16 - DOMESTIC WATER PIPING & APPURTENANCES 22 11 19 - PIPING & APPUR FOR COLD-WATER MAKE-UP 22 11 23 - DOMESTIC WATER PUMPS 22 11 25 - DOMESTIC WATER BOOSTER PUMP (IN-LINE VERTICAL) 22 13 16 - SOIL WASTE & SANITARY DRAIN PIPING 22 14 13 - ROOF DRAINAGE PIPING & APPURTENANCES [ISSUED: ADDENDUM #2] 22 20 00 - PLUMBING PIPE & FITTINGS - GENERAL

- 22 33 33 ELECTRIC WATER HEATER (COMMER. ASME)
- 22 34 32 GAS DOMESTIC WATER HEATER (CYCLONE)
- 22 40 00 PLBG FIXTURES & FIXTURE CARRIERS
- 22 63 11 GAS PIPING & APPURTENANCES

# **DIVISION 23 00 00 – HEATING, VENTILATING AND AIR CONDITIONING**

23 01 00 - HVAC O&M MANUALS 23 05 00 - MECH GENERAL PROVISIONS 23 05 10 - HVAC CONTRACT QUALITY CONTROL 23 05 12 - HVAC SHOP DRAWINGS 23 05 13 - ELECTRICAL PROVISIONS OF HVAC WORK 23 05 14 - HVAC CONDENSATE DRAIN PIPING 23 05 17 - MECH ACCESS DOORS 23 05 18 - VARIABLE FREQUENCY INVERTER 23 05 19 - PRESSURE & TEMPERATURE INSTRUMENTS 23 05 23 - HVAC VALVES STRAINERS & VENTS 23 05 33 - HVAC PIPE HEAT TRACING 23 05 48 - VIBRATION ISOLATION 23 05 93 - TAB 23 05 94 - COORDINATION OF TAB 23 07 13 - EXTERNAL DUCT INSULATION 23 07 16 - VESSEL INSULATION 23 07 19 - HVAC PIPING INSULATION 23 08 00 - MECHANICAL COMMISSIONING 23 09 33 - BMCS 23 09 34 - COORDINATION OF BMCS 23 20 00 - MECH PIPE & FITTINGS - GENERAL 23 21 13 - HW & CW PIPE VALVES & APPURTENANCES 23 21 23 - HVAC PUMPS 23 23 00 - REFRIGERANT PIPING & APPURTENANCES 23 25 13 - CIRCULATING WATER SYSTEM CHEMICAL TREATMENT 23 31 13 - DUCTWORK 23 34 16 - FANS 23 36 16 - VARIABLE VOLUME TERMINAL UNITS 23 36 17 - DUAL DUCT VARIABLE VOLUME TERMINAL UNITS 23 37 13 - AIR DEVICES 23 41 00 - AIR FILTRATION 23 52 35 - GAS MODULATING HOT WATER BOILER CONDENSING 23 63 00 - AIR COOLED CONDENSING UNIT 23 65 28 - AIR COOLED VARIABLE SPEED ROTARY SCREW CHILLER 23 73 13 - AIR HANDLING UNITS 23 82 16 - HEATING & COOLING COILS 23 82 18 - DUCTLESS MINI SPLITS 23 82 19 - FAN COIL UNITS 23 82 39 - ELECTRIC UNIT HEATERS 23 82 41 - ELECTRIC DUCT HEATERS

#### DIVISION 24 00 00 THROUGH 25 00 00 - NOT USED

# **DIVISION 26 00 00 – ELECTRICAL**

26 01 05 - ELEC O&M MANUALS 26 05 00 - ELEC GENERAL PROVISIONS 26 05 08 - TELECOM CATV VOICE DATA VIDEO UTILITY COORD & SERVICE ENTRANCE 26 05 09 - ELEC UTILITY COORDINATION & SERVICE ENTRANCE 26 05 10 - CONTRACT QUALITY CONTROL 26 05 11 - UNDER SLAB PIPE VOID SYSTEM-ELECTRICAL *[ISSUED: ADDENDUM #2]* 26 05 12 - ELEC SHOP AND COORDINATION DRAWINGS 26 05 16 - EXCAV-COMPACTING-BACKFIL FOR ELECTRICAL 26 05 19 - CONDUCTORS AND CONNECTORS

- 26 05 26 ELECTRICAL GROUNDING
- 26 05 33 CONDUIT SYSTEMS
- 26 05 35 ELECTRICAL CONNECTIONS FOR EQUIPMENT
- 26 05 37 ELECTRICAL BOXES AND FITTINGS
- 26 05 38 ELECTRICAL FLOOR BOXES AND FITTINGS.DOCX
- 26 05 40 ELECTRICAL GUTTERS & WIREWAYS
- 26 05 50 FIRESTOPS
- 26 08 00 ELECTRICAL COMMISSIONING
- 26 09 25 ELECTRICAL CONTACTORS
- 26 09 29 DIGITAL LIGHTING CONTROL SYSTEM
- 26 12 16 ENERGY EFF DRY-TYPE HARM MITIGATING TRANSFORMERS
- 26 19 13 COMBINATION MOTOR CONTROLLERS
- 26 24 13 SWITCHBOARDS
- 26 24 16 PANELBOARDS ENCLOSURES
- 26 24 25 ENCLOSED SWITCHES
- 26 24 30 FUSES
- 26 27 73 LINE VOLTAGE WIRING DEVICES
- 26 32 13 NATURAL GAS STANDBY GEN SETS WITH TRANSFER SWITCH
- 26 32 16 DUAL PURPOSE MANUAL TRANSFER SWITCH
- 26 43 00 SURGE PROTECTION DEVICES
- 26 51 13 LIGHTING FIXTURES
- 26 55 61 ELEM THEATRICAL LIGHTING SYSTEM\_NO DEALER
- 26 56 00 SITE LIGHTING

# **DIVISION 27 00 00 – COMMUNICATIONS**

- 27 01 00 ELECTRONIC COMMUNICATIONS O&M MANUALS
- 27 05 00 COMMUNICATIONS GENERAL PROVISIONS
- 27 05 07 COMMUNICATIONS SHOP DRAWINGS
- 27 05 09 CONTRACT QUALITY CONTROL
- 27 10 00 STRUCTURED CABLING SYSTEMS
- 27 51 23 SCHOOL COMMUNICATIONS SYSTEMS
- 27 51 24 LOCAL SOUND DISTRIBUTION SYSTEM
- 27 61 00 INTEGRATED AUDIO-VIDEO SYSTEMS AND EQUIPMENT FOR INSTRUCTIONAL SPACES -FRONTROW TRIO
- 27 61 05 AUDIO VIDEO SYSTEMS AND EQUIPMENT

# **DIVISION 28 00 00 – ELECTRONIC SAFETY AND SECURITY**

- 28 01 00 SAFETY & SECURITY O&M MANUALS
- 28 05 00 SAFETY & SECURITY GENERAL PROVISIONS
- 28 05 07 SAFETY & SECURITY SHOP DRAWINGS
- 28 05 10 CONTRACT QUALITY CONTROL
- 28 10 00 ACCESS CONTROL SYSTEM
- 28 15 00 INTRUSION DETECTION
- 28 20 00 VIDEO SURVEILLANCE
- 28 46 00 FIRE DETECTION & ALARM SYSTEM
- 28 55 00 RF SURVEY

#### Division 31 00 00 - Earthwork

- 31 00 00 SITE EARTHWORK
- 31 11 00 CLEARING AND GRUBBING
- 31 23 00 GRADING EXCAVATION AND FILL
- 31 25 00 EROSION AND SEDIMENTATION CONTROL
- 31 63 29 DRILLED CONCRETE PIERS AND SHAFTS

# **DIVISION 32 00 00 – EXTERIOR IMPROVEMENTS**

32 12 16 - ASPHALTIC CONCRETE PAVEMENT
32 13 13 - PORTLAND CEMENT CONCRETE PAVING
32 13 19 - CONCRETE PAVEMENT JOINTS
32 13 73.19 - SITEWORK CAST-IN-PLACE CONCRETE
32 16 13 - CONCRETE CURBS AND CURB AND GUTTER
32 31 15 - CHAIN LINK FENCING AND GATES
32 31 19 - ORNAMENTAL FENCE SYSTEM [REISSUED: ADDENDUM #3]
32 84 00 - LANDSCAPE IRRIGATION
32 90 00 - LANDSCAPE PLANTING
32 90 30 - EXTERIOR LANDSCAPE MAINTENANCE
32 91 00 - TOPSOIL, PLACEMENT AND GRADING
32 92 00 - LAWN SODDING & HYDROMULCH

# DIVISION 33 00 00 - UTILITIES

33 05 16 - UTILITY STRUCTURES 33 05 28 - TRENCHING AND BACKFILL FOR UTILITIES 33 11 00 - WATER DISTRIBUTION SYSTEMS 33 16 53 - TRAFFIC PAINT STRIPING 33 31 00 - SANITARY UTILITY SEWERAGE PIPING 33 41 00 - STORM SEWAGE SYSTEMS

# END OF TABLE OF CONTENTS

00 01 01.1 TABLE OF CONTENTS: ARCHITECT Page 1 of 3 ADDENDUM #3

TABLE OF CONTENTS: ARCHITECT


SECTION 00 01 01.1

List of Specifications, As Prepared by:



2 Greenway Plaza, Suite 460 Houston, Texas 77046 P: 713.222.1141

# **DIVISION 01 00 00 - GENERAL REQUIREMENTS**

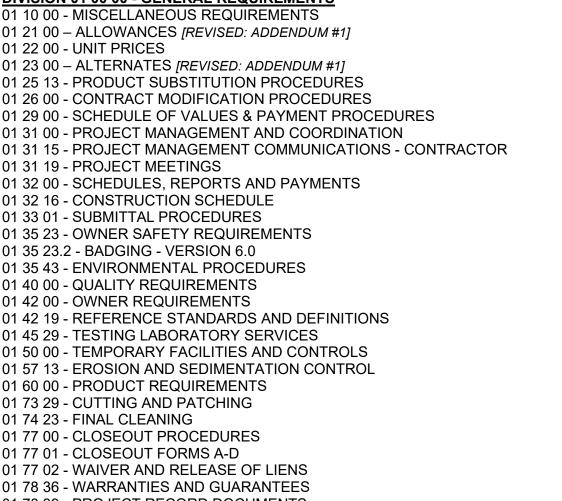

01 78 39 - PROJECT RECORD DOCUMENTS

# DIVISION 02 00 00 - EXISTING CONDITIONS [DELETED: ADDENDUM #2]

02 32 00 - GEOTECHNICAL DATA [DELETED: ADDENDUM #2] 02 32 00.1 - GEOTECHNICAL REPORT [DELETED: ADDENDUM #2]

DIVISION 03 00 00 – CONCRETE 03 52 16 - LIGHTWEIGHT INSULATING CONCRETE



12-12-2024

# DIVISION 04 00 00 - MASONRY

04 20 00 - UNIT MASONRY

# DIVISION 05 00 00 – METALS

05 50 00 - METAL FABRICATIONS 05 52 13 - PIPE AND TUBE RAILINGS

# **DIVISION 06 00 00 - WOOD, PLASTICS & COMPOSITES**

06 10 00 - ROUGH CARPENTRY 06 20 00 - MILLWORK AND FINISH CARPENTRY 06 61 16 - SOLID SURFACING FABRICATIONS

# **DIVISION 07 00 00 - THERMAL AND MOISTURE PROTECTION**

07 11 13 - BITIMINOUS DAMPPROOFING 07 21 00 - BUILDING INSULATION 07 21 19 - FOAMED-IN-PLACE INSULATION 07 26 00 - FLUID APPLIED AIR BARRIER 07 42 13 - PREFORMED METAL WALL PANELS [REVISED: ADDENDUM #2] 07 42 13.1 - INSULATED METAL WALL PANELS 07 42 15 - PREFORMED METAL SOFFIT PANELS 07 52 19 - MOD BIT ROOFING SYSTEM 07 62 00 - ROOF RELATED SHEET METAL-ADD 2 07 65 00 - FLEXIBLE FLASHING 07 65 26 - MEMBRANE THROUGH-WALL FLASHING 07 72 00 - ROOF ACCESSORIES-ADD 3 07 72 33 - ROOF HATCH 07 84 00 - FIRESTOPPING 07 90 00 - JOINT PROTECTION 07 95 13 - EXPANSION JOINT COVER ASSEMBLIES

# **DIVISION 08 00 00 - OPENINGS**

08 11 00 - HOLLOW METAL DOORS & FRAMES 08 15 13 - PLASTIC LAMINATE FACED WOOD DOORS 08 31 13 - ACCESS DOORS AND FRAMES 08 33 00 - ROLLING GRILLES 08 33 02 - ROLLING COUNTER SHUTTERS 08 41 13 - ALUMINUM ENTRANCES AND STOREFRONTS [REVISED: ADDENDUM #2] 08 44 13 - ALUMINUM CURTAIN WALL SYSTEM [REVISED: ADDENDUM #2] 08 71 00 - DOOR HARDWARE [REVISED: ADDENDUM #2] 08 80 00 - GLASS AND GLAZING 08-88-53 - SECURITY GLAZING

#### **DIVISION 09 00 00 - FINISHES**

09 21 16 - GYPSUM BOARD ASSEMBLIES 09 30 00 - TILING 09 51 00 - SUSPENDED ACOUSTICAL CEILINGS 09 54 23 - LINEAR METAL CEILINGS 09 64 55 - RESILIENT WOOD FLOOR-STAINED SURFACE 09 65 00 - RESILIENT FLOORING 09 65 13 - RESILIENT BASE

09 65 25 - VINYL TILE\_PLANK FLOORING (LVT) 09 66 13 - PORTLAND CEMENT TERRAZZO FLOORING 09 67 23 - RESINOUS FLOORING 09 68 16 - CARPET 09 72 00 - PRESENTATON DRY-ERASE WALLCOVERING

09 72 00 - WALL COVERING

09 84 13 - FABRIC COVERED ACOUSTICAL PANELS [REVISED: ADDENDUM #3]

09 90 00 - PAINTING AND COATING

# **DIVISION 10 00 00 - SPECIALTIES**

10 05 00 - MISCELLANEOUS SPECIALTIES
10 11 00 - VISUAL DISPLAY BOARDS
10 14 00 - ARCHITECTURAL SIGNAGE
10 14 64 - ELECTRONIC MESSAGE SIGNAGE *[ISSUED: ADDENDUM #2]*10 21 16 - SOLID PLASTIC TOILET PARTITIONS
10 21 23 - CUBICLE CURTAINS AND TRACK
10 22 26 - OPERABLE PARTITIONS
10 26 13 - CORNER GUARDS
10 28 00 - TOILET AND BATH ACCESSORIES *[REVISED: ADDENDUM #2]*10 44 13 - FIRE EXTINGUISHERS AND CABINETS
10 51 13 - WEAPONS RACK
10 56 13 - METAL STORAGE SHELVING

10 73 00 - PROTECTIVE COVERS

10 75 16 - FLAGPOLE

# DIVISION 11 00 00 - EQUIPMENT

11 16 19 - RAPID ENTRY SYSTEM (FIREMAN LOCK BOX)

11 31 13 - RESIDENTIAL APPLIANCES

11 40 00 - FOOD SERVICE EQUIPMENT

11 52 13 - PROJECTION SCREENS

11 61 43 - STAGE CURTAINS

11 66 00 - ATHLETIC EQUIPMENT

11 72 00 -AUTOMATED EXTERNAL DEFIBRILLATORS

# **DIVISION 12 00 00 - FURNISHINGS**

12 21 13 - METAL HORIZONTAL LOUVER BLINDS

12 24 13 - MOTORIZED ROLLER WINDOW SHADES

12 24 15 - MANUALLY OPERATED ROLLER WINDOW SHADES

12 32 16 - MANUFACTURED PLASTIC LAMINATE CLAD CASEWORK

12 56 00 - LIBRARY FURNITURE

12 93 13 - BICYCLE RACKS

# **DIVISION 32 00 00 – EXTERIOR IMPROVEMENTS**

32 31 15 - CHAIN LINK FENCING AND GATES

32 31 19 - ORNAMENTAL FENCE SYSTEM [REISSUED: ADDENDUM #3]

# END OF SECTION 00 01 10.1

#### SECTION 00 20 00 INSTRUCTIONS TO OFFERORS

#### 1.01 QUALIFIED OFFERORS

- A. Competitive Sealed Proposals will be accepted from qualified Offerors (General Contractors) only for the entire scope of work described in the Contract Documents. As a prerequisite to an Offeror's qualifying for the award of contract on this work, the Offeror must complete each item of the Contractor's Qualification Statement (AIA Document A305). The Statement forms may be obtained from the Houston Chapter of the American Institute of Architects, 315 Capitol, Suite 120, Houston, Texas 77002, (713) 520-0155. In addition to the information contained in the Statement form, offerors shall also address the selection criteria issues listed under the paragraph below for Determination of Successful Respondent and Award of Contract. Submit to Architect via email
- B. The primary purposes of the evaluation process will beto:
  - 1. Gather information for the Owner's evaluation procedure.
  - 2. Enable the Owner and/or Architect to evaluate the Offeror's qualifications.
- C. After review of Proposals and Contractor's qualifications evaluation the Owner will make his decision and each Offeror will be notified.
- D. In arriving at his opinion concerning the Offeror's qualifications, the Architect will use the same criteria that the Owner will use in determination of the successful Offeror as detailed hereinafter.
- E. In the event a proposed Offeror fails to submit the specified Contractor's Qualification Statement at time of receipt for Proposals, such noncompliance shall be considered by both the Owner and Architect as a negative factor in the determination of the successful Offeror.

# 1.02 OFFEROR'S PRESENTATION

- A. Each Offeror by making his Proposal represents that:
  - 1. He has read and understands the Proposal Documents and his Proposal is made in accordance therewith.
  - 2. He has thoroughly familiarized themselves with Division 01 General Requirements as they are applicable to subsequent specification sections.
  - 3. He has visited the site, has familiarized himself with the local conditions under which the work is to be performed and has correlated his observations with the requirements of the proposed Contract Documents.
  - 4. He agrees to comply with the requirements of the following paragraph. Any Offeror who subsequently does not agree to comply with these requirements will automatically disqualify himself from proposing or receiving award of the contract.
- B. He agrees that:
  - 1. Work on the project will begin immediately upon receipt of signed Contract or Notice to Proceed.
  - 2. Offeror will participate as a team member in cooperation with the Project Architect, Engineers, Owner, and Owners agents and/or consultants.
  - 3. The Offeror will assign a competent full-time superintendent, to the project, and that superintendent shall be maintained on the project for the duration of the project, subject only to his continuous employment.
  - 4. The Offeror will furnish and pay for a proposal bond in the amount of ten percent (10%) of the contract amount.
  - 5. If awarded, the Offeror shall furnish and pay for a Performance Bond and a Payment Bond each in the full contractamount.

- 6. Offeror shall carry and keep in full force for the duration of the Project, insurance coverage for builder's risk, workmen's compensation, comprehensive general liability, and automobile liability as required by the General Conditions and/or Supplementary General Conditions of the Specifications.
- 7. Each Offeror by making his Proposal represents that his Proposal includes only material and equipment specified in the Proposal Documents and supplemented, if necessary, for a complete and operating system.
- 8. Where subcontract work is involved and where Acceptable Subcontractors are designated for particular sections or phases of the Work, each Offeror by making his Proposal represents that his Proposal includes only firms designated as Acceptable Subcontractors.
- 9. That no asbestos PCBs or lead building materials shall be used, and that each Offeror (and sub-offeror or supplier submitting a proposal to an Offeror) shall submit an affidavit at Project Close-out stating that no asbestos, PCB's or lead building materials has been used on the Project.

# 1.03 PROPOSAL DOCUMENTS

- A. Proposal Documents include the Competitive Sealed Proposal, Noticed Package, Instructions to Offerors, and the proposed Contract Documents, including any Addenda issued prior to receipt of proposals.
- B. Contract Documents for the work consist of the Owner-Contractor Agreement, the Conditions of the Contract (General, Supplementary and other Conditions), the Drawings, the Specifications, and all Addenda issued prior to receipt of proposals.

# 1.04 PROPOSAL PROCEDURES

- A. A proposal is invalid if it has not been received at the designated location prior to the time and date for receipt of proposals indicated in the Request for Competitive Sealed Proposals, or prior to any extension thereof issued to the Offerors by Addenda.
- B. All requested Alternates shall be proposed. If no change in the Base Proposal is required, enter "No Change".
- C. Prior to the receipt of Proposals, Addenda will be forwarded by the Architect and will be available for inspection wherever the proposal documents are kept available for thatpurpose.

Proposals will be received in duplicate only on the Owner's Form of Proposal for the work as indicated by the Proposal Documents, filled in, and enclosed in a sealed envelope addressed as follows:

#### Name of Offeror (General Contractor) Prototype #2 - Elementary School #38 Lamar Consolidated Independent School District CSP # 03-2025 Attn: Ms. Brandi Pittman, Director of Purchasing & Materials Management

- E. The Proposal Bond Form (attached to section 00 40 01), must be accompanied by Proposal Bondor Certified Check in the amount of 10% of the proposal.
- F. All proposals must be delivered sealed to the following address at or before the time and date set. <u>Proposals will be received at no other place. If Proposal is sent by U.S. Mail, it must be sent Registered</u> <u>Mail.</u>

# LCISD Service Center 4901 Avenue I, Rosenberg, Texas 77471

G. A proposal may be withdrawn only upon request by the Offeror or hisduly authorized representative, provided such request is received by the Owner at the place designated for receipt of proposals and prior to the time fixed for the opening of proposals. A withdrawal of a proposal shall not be effective unless a written confirmation of the withdrawal is received by the Owner at said place within 48 hours before the time fixed for the opening of proposals. The Proposal Bond will be returned with the proposals if withdrawn in accordance with the above. The withdrawal of a proposal does not prejudice the right of the Offeror to file a new proposal at the time and place stated. No proposal may be withdrawn after the time fixed for the opening of proposals for a period of 30 days.

# 1.05 INTERPRETATION OF PROPOSAL DOCUMENTS

- A. Offerors and sub-offerors requiring clarification or interpretation of the Proposal Documents shall make a written or verbal request which shall reach the Architect at least ten (10) days prior to the date for receipt of proposals.
- B. Any interpretation, correction or change of the Proposal Documents will be made by Addendum. Interpretations, corrections, or changes of the Proposal Documents made in any other manner will not be binding.

# 1.06 SUBSTITUTIONS OF MATERIALS AND EQUIPMENT

- A. The materials, products and equipment described in the Proposal Documents establish a standard of required function, dimension, appearance and quality to be met by any proposed substitution. The materials and equipment named in, and the procedures covered by these specifications have been selected as a standard because of quality, particular suitability or record of satisfactory performance. It is not intended to preclude the use of equal or better materials or equipment provided that same meets the requirements of the particular project and is approved in an addendum as a substitution prior to the submission of proposals.
- B. No substitution will be considered prior to receipt of proposals unless written request for approval has been received by the Architect at least seven (7) days prior to the date for receipt of proposals as described in Section 01 25 00 – Products Substitution Procedures. Each such request shall include the name of the material or equipment for which it is to be substituted and a complete description of the proposed substitute including drawings, cuts, performance and test data and any other information necessary for an evaluation. The Architect's decision of approval or disapproval of a proposed substitution shall be final.
- C. If the Architect approves any proposed substitution prior to receipt of proposals, such approval will be set forth in an Addendum. Offerors shall not rely upon approvals made in any other manner.
- D. <u>No substitutions will be considered after the Contractaward</u>.

# 1.07 REJECTION OF PROPOSALS

- A. The Owner shall have the right to reject any or all proposals and to reject a proposal not accompanied by any required proposal security, or by other data required by the Proposal Documents, or to reject a proposal which is in any way incomplete orirregular.
- B. The Owner reserves the right to reject any or all proposals and to waive any formalities or irregularities and to make the award of the contract in the best interest of the Owner.

- C. The Owner reserves the right to reject any proposal if the evidence submitted by, or investigation of, such offeror fails to satisfy the Owner that such offeror is properly qualified to carry out the obligations of the contract and to complete the work therein. Award may be made to other than the low- dollar offeror and given the one offering the "best value" to the school district, in addition to the purchase price, based on the published selection criteria and on its ranking evaluation.
- D. Do not submit voluntary alternates. The Owner reserves the right to reject any proposal which is accompanied by conditional or qualifying statements, or "voluntary alternates".

#### 1.08 INSURANCE

A. Each Offeror shall include in his proposal the complete cost and shall carry and keep in full force for the duration of the project, insurance coverage required under the General Conditions and Document 00 73 00 – LCISD Supplementary Conditions.

#### 1.09 PERFORMANCE BOND AND PAYMENTBOND

A. Each Offeror shall include in this proposal the premium costs for 100% Performance Bond and 100% Payment Bond. These bonds shall cover the faithful performance of the contract and payment of all obligations arising thereunder in such form as the Owner may prescribe. The bonding companies must be acceptable to the Owner. The selected Offeror shall deliver the required bonds to the Owner not later than the date of execution of theContract.

#### 1.10 PROPOSAL SECURITY

A. No proposal will be considered unless it is accompanied by a Certified or Cashier's Check or Proposal Bond executed on the Proposal Bond Form (attached to Section 00 40 01) In either case the amount shall be not less than ten percent (10%) of the greatest amount proposed (considering alternates, if any). The proposal security shall insure the execution of the contract and the furnishing of an acceptable Performance Bond and Payment Bond by the successful Offeror within ten (10) days after notification of award to such Offeror and that this proposal will not be withdrawn within 30 days after date of opening of proposals without the consent of the Owner. Proposal Bond shall be prepared in the identical form of AIA Document A310 or the formattached.

#### 1.11 SUBMISSION OF POST PROPOSAL INFORMATION

- A. The apparent Selected Offeror shall within three (3) days after proposals are received submit the following:
  - 1. A designation of the work to be performed by the Offeror with his own forces.
  - 2. An experience profile of the selected Offeror's superintendent scheduled to work on this project. In addition, the apparent selected Offeror shall cooperate with the Owner, supplying requested information to substantiate the qualifications of the superintendent. If, in the opinion of the Owner, the superintendent does not qualify, the Owner may request the submission of another superintendent and more information. The Owner reserves the right to reject the apparent selected Offeror if an acceptable superintendent is not presented.
- B. The Selected Offeror shall within five (5) days thereafter submit the following:
  - 1. A statement of costs for each major item of work included in the proposal as described in Section 01 29 00 Payment Procedures. Each section of specifications will be considered a major item of work and shall be shown as a separate cost item.

#### 1.12 AWARD OF CONTRACT

A. The Offeror to whom the award is made will be promptly notified. If an Offeror (a) withdraws his proposal within 60 days after the date of time fixed for the opening of proposals in the Request for Competitive Sealed Proposals, or (b) fails or refuses to execute the Agreement, or other required forms within ten (10) days after the same are presented to him for signature, or (c) fails or refuses to

furnish properly executed Performance Bond and Certification of Required Insurance within 15 calendar days of execution date of the Agreement, the Owner may award the work to another Offeror or Offerors or may call for newproposals.

- B. The Offeror will be required to (a) submit his Proposal and Proposal Bond, (b) execute Contract and Performance and Payment Bonds, and (c) submit Certification of required insurances, all using the Owner's own forms for such respective purposes.
- C. Proposal Bond is forfeited if proposal is withdrawn after the proposal opening, or Contract Documents are not executed in accordance with the above.

# 1.13 NOTICE TO PROCEED

- A. The Offeror shall not commence work under this Contract until he receives the written Notice to Proceed, or the Contract is duly signed by the Owner.
- B. Access to the site will be granted 45 days after the Owner's formal "Notice-To-Proceed" issue date.

#### 1.14 COMPLETION TIME

- A. Offerors shall familiarize themselves with the Owners requirements concerning the project schedule as described in Section 01 32 16 of this Project Manual. There will be no extension of time due to weather.
- B. Having thoroughly familiarized himself with the conditions as they exist at the building sites and acquainted himself with the labor supply and the material market, the Offeror will state in his proposal that he agrees to be substantially complete with the work by the date stated above.
- C. It is therefore expressly agreed as a part of the consideration inducing the Owner to execute this contract that the Owner may deduct liquidated damages from the final payment made to the Contractor for each and every calendar day beyond the agreed date which the Contractor shall require for Substantial Completion of the work included in this contract. It is expressly understood that the said sum per day is agreed upon as a fair estimate of the pecuniary damages which will be sustained by the Owner in the event that the work is not completed within the agreed time, or within the legally extended time, if any, otherwise provided for herein. Said sum shall be considered as liquidated damages only and in no sense shall be considered a penalty, said damage being caused by additional compensation to personnel, for loss of interest on money and other miscellaneous increased costs, all of which are difficult of exact ascertainment. Also, any disruption of Owner's use of the existing facilities or newly completed facilities will also be subject to liquidated damages. Refer to Section 01 32 00 for additional requirements. Delays, disruption of use, failures to complete, and liquidated damages are fully described under Article 8.3 of the Supplementary Conditions.

The definition of Substantial Completion is found in Article 9.8.1 of the AIA General Conditions and Supplementary Conditions bound herein.

#### 1.15 FELONY CONVICTION NOTIFICATION

A. Section 44.034, of the Texas Education Code requires a person or business entity that enters into a contract with a school district must give advance notice to the district if the person or an owner or operator of the business entity has been convicted of a felony. The notice must include a general description of the conduct resulting in the conviction of a felony. Subsection (b) states "a school district may terminate a contract with a person or business entity if the district determines that the person or business entity failed to give notice as required by Subsection (a) or misrepresented the conduct resulting in the conviction. The district must compensate the person or business entity for services performed before the termination of the contract." Subsection (c) states "this section does not apply to a publicly held corporation."

# 1.16 AFFIDAVIT OF NON-DISCRIMINATORY EMPLOYMENT

- A. The Offeror, and sub-offerors, shall agree to refrain from discrimination in terms and conditions of employment to the basis of race, color, religion, sex, or national origin, and agrees to take affirmative action as required by Federal Statutes and Rules and Regulations issued in order to maintain and insure non-discriminatory employment practices.
- B. The Offerors <u>must</u> execute, Affidavit of Non-Discriminatory Employment (attached to Section 00 40 13) and submit with Proposal. The sub-offerors shall execute, Affidavit of Non-Discriminatory Employment (attached to Section 00 40 13) before commencing work on this Project. Offerors and sub-offerors who have not executed this document will not be eligible to work on this project.

# 1.17 LIST OF SUBCONTRACTORS

- A. The Offeror shall supply a list of their subcontractors.
- B. The Offeror <u>must</u> execute, List of Subcontractors (attached to Section 00 40 12) and submit <u>24 hours</u> after submission of Proposal to Architect viaemail.

# 1.18 AFFIDAVIT OF NON-ASBESTOS, LEAD, AND PCB USE IN PROJECT

- A. The use of any construction process or the installation of any asbestos, lead and PCBs or material containing asbestos, lead and PCBs is strictly prohibited for thisProject.
- B. Prior to submitting a proposal, Offerors shall notify the Architect, in writing, of any materials in these specifications which are known to contain or are likely to contain asbestos, lead or PCBs.
- C. The Offeror, and sub-offerors shall agree to refrain from using products which are known to contain asbestos, lead, and PCB containing materials as applicable to the project. They shall also affirm that lead or lead bearing materials have not been incorporated into potable water systems, and that lead sheet flashing used in through roof plumbing penetration applications is the only lead on the Project.
- D. The Selected Offeror (Contractor) <u>must</u> execute Affidavit of Non-Asbestos, Lead, and PCB Use (attached to Section 00 40 14) and submit at Project Closeout. The Subcontractors to the Contractor <u>must</u> execute Close-out Form "D", Subcontractors Hazardous Material Certificate (attached to section 01 77 01), and submit at ProjectCloseout.

#### 1.19 **PROPOSAL EVALUATION WAIVER**

- A. By submitting a proposal, each offeror agrees to waive any claim it has or may have against the District and its respective employees, the Program Manager and their respective employees, the Architect/Engineer and consultants, and their respective employees, arising out of or in connection with the administration, evaluation, or recommendation of any proposal; waiver of any requirements under the Proposal Documents, acceptance or rejection of any proposals; and award of the contract.
- B. All Offeror's **must** execute Proposal Evaluation Waiver (attached to 00 65 01) and submit with their Proposal.

#### 1.20 CONFLICT OF INTEREST QUESTIONNAIRE

- A. According to Local Government Code, Chapter 176, a person or an agent of a person who contracts or seeks to contract for the sale or purchase of property, goods, or services with any government agency must file a completed Conflict of Interest Questionnaire with the records administrator of the local government not later than the seventh business day after the date that the person begins contract discussions or negotiations with the District or submits to the District an application, response to a request for proposals or bids, correspondence, or another writing related to a potential agreement with the District.
- B. All Offeror's and sub-offeror's proposing to do work with the District **must** execute the Conflict of Interest Questionnaire (attached to Section 00 11 00) and submit with their Competitive Sealed Proposal Notice package.

# 1.21 CRIMINAL HISTORY RECORDS

- A. Prior to commencing any work on this Project, the Selected Contractor shall certify, on the form provided Criminal History Record Information (attached to Section 00 40 17), for each of its employee who will have direct contact with students, the Selected Contractor has obtained, as required by Texas Education Code Section 22.0834:
  - 1. National criminal history record information from a law enforcement or criminal justice agency for each employee of the Selected Contractor hired before January 1, 2008 who will have direct contact with students; and
  - 2. National criminal history record information from the Texas Department of Safety for each employee of the Selected Contractor hired on or after January 1, 2008 who will have direct contact with students; Fingerprinting is required and shall be provided by the contractor (applicant) and administered through FAST (Fingerprint Applicant Services of Texas) which will be recorded by the District in the FACT (Fingerprint-based Applicant Clearinghouse of Texas). Currently applicant must obtain fingerprinting from L-1 Identity Solutions Company, (888) 467-2080, or schedule an appointment online at: <u>https://tx.ibtfingerprint.com/</u>.
- B. Any personnel who will have direct contact with students must not have been convicted of an offense identified in Texas Education Code Section 22.085.
- C. At this time, Senate Bill 9 applies only to contractors with direct contracts with the District. This requirement does not apply to sub-contractors of the Contractor, material suppliers, or a one-time service provider such as a service technician, delivery person, testing agent, code official, or similar personnel. However, changes to these requirements are anticipated and may require the acquisition and submittal of additional background checks to the District during the course of the Work.
- D. The Selected Contractor shall execute and submit, Certification of Criminal History Record Information (attached to Section 00 40 17), Review by Contractor-Employer along with required list documenting proposed employees/ contractor personnel to be working on site, within 10 days after receipt of Notice To Proceed and prior to commencement ofWork.
- E. Furthermore, an updated list employees/ contractor personnel shall be submitted weekly to the District indicating changes to contractor personnel with accompanying certifications and criminal history records. Any fingerprinting and photographing required by the aforementioned code will be the responsibility of the Contractor-Employer.

# 1.22 AVAILABILITY OF MATERIALS AND SYSTEMS

A. A serious effort has been made to select only materials that are systems that are readily available. As far as is known at proposal time all items are either available "off the shelf" or within a relatively short period of time. If during the proposal period, an Offeror becomes aware of an availability or delivery problem with any of the specified systems or materials, he should notify the Architect immediately. The Architect will promptly explore possibilities for selecting other systems or materials which would circumvent the problem and notify Offerors of any changes in an addendum, otherwise it will be understood that only specified systems and materials that are readily available are included in the proposals.

#### 1.23 DETERMINATION OF SUCCESSFUL RESPONDENT AND AWARD OF CONTRACT

- A. In determining the Selected Offeror, the Owner will evaluate the information submitted on the Proposal Form (attached to Section 00 11 00).
- B. The Selection Committee consisting of LCISD administrators, architects, and other staff will make an initial evaluation of the proposals. The committee's recommendation will be considered by the LCISD Board of Trustees ("Board"). The final decision-making authority on the proposals rests with the full Board. Decision-making authority has not been delegated to any person or entity other than the Board.

- C. The District will make such investigations as it deems necessary to determine the ability of the offeror to perform the Work, and the offeror shall furnish all such information and data for this purpose as may be requested. The District reserves the right to reject any proposal if the evidence submitted by, or investigation of, such offeror fails to satisfy the District that such offeror is properly qualified to carry out the obligations of the Contract and to complete the Work contemplatedtherein.
- D. The District reserves the right to reject any or all proposals and to waive any formalities or irregularities and to make the award of the contract in the best interest of the District.
- E. A decision regarding determination of the successful Offeror will be made by the District as soon as practical.

# 1.24 USE OF ASBESTOS FREE MATERIALS, PRODUCTS AND SYSTEMS

- A. The Offeror is reminded to refer to the Paragraph below for requirements during the Proposal period and the following requirements during performance of the Work regarding the use of asbestos free materials, products and systems in the Project.
  - 1. Since many materials, products and systems are proprietary, it is not possible to know all of the materials or components which go into producing such material, product or system without the manufacturer divulging trade secrets or patent information. Every effort has been made to specify materials, products or systems, which either as an "off the shelf" material, product or system or as a custom material, product or system do not containasbestos.
  - 2. It is the Contractor's responsibility to submit an affidavit from the manufacturer to ascertain that every material, product or system used in the Project does not contain asbestos. In the event the material, product or system is found to contain asbestos, the Contractor shall offer for the Architect's consideration a substitution which he knows does not contain asbestos.
  - 3. Even though a material, product or system is specified or a specification is based on a particular material, product or system, the Contractor will not be relieved from the responsibility to ascertain that materials, products and systems used in the Project do not contain asbestos. Under no circumstances shall a material, product or system which is known, suspected or found to contain asbestos be used on the Project.
  - 4. If a material, product or system containing asbestos is used, the Contractor shall remove and replace the material, product or system with one which is asbestos free at no additional expense to the Owner, including removal and replacement of other materials affected by the removal of the asbestos bearing material, product or system, i.e. gypsum wallboard removed, replaced, and repainted on account of insulation being removed, etc.

# END OF SECTION 00 20 00

# **SECTION 09 84 13**

# FABRIC COVERED ACOUSTIC PANELS

#### PART 1 - GENERAL

- 1.01 SCOPE
  - A. The Contractor shall furnish and install complete acoustical wall panels as shown on plan and called for herein.
  - B. Provide all labor, equipment, supplies, accessories, and material necessary for the proper installation of acoustical wall panels.
- 1.02 SITE INSPECTION
  - A. The Contractor shall visit and examine the site and verify all existing items and familiarize himself with existing work conditions and understand the conditions which affect performance of the work before submitting shop drawings. He shall notify the Architect of any special or existing conditions which may affect the work to be performed.
  - B. Field Measurements: Check actual wall surfaces by accurate field measurements before fabrication and show recorded measurements on final shop drawings.

#### 1.03 GENERAL REQUIREMENTS/QUALITY ASSURANCE

- A. Manufacturer: Shall be a company specializing in manufacturing commercial acoustical wall panels.
- 1.04 CODES AND REGULATIONS:
  - A. Comply with the requirements of Occupational Safety and Health Act (OSHA) and all other applicable federal, state, fire, and local codes. All codes and standards shall be per the latest edition with all supplements and official interpretations included.
  - B. Should the Contractor perform any work that does not comply with the requirements of the applicable building codes, state laws, local ordinances, and industry standards, he shall bear all costs arising in correcting the deficiencies as approved by the school district.

#### 1.05 FIRE PERFORMANCE CHARACTERISTICS

- A. Provide test reports verifying flame/fuel/smoke ratings of acoustical wall panels. All materials shall meet or exceed the requirements of and shall be approved by the fire authority having jurisdiction for this location. Unless exceeded by the local fire authority, the minimum requirements of surface-burning characteristics shall be as indicated below and shall be as determined by testing assembled materials composed of facings and backings identical to be used on this project per ASTM-84-81a, by a testing organization acceptable to the authorities having jurisdiction:
  - 1. Flame Spread: Class 1 (25 or less)
  - 2. Smoke Developed: 450 or less
- B. All equipment and material shall be rated and U.L. listed.

#### 1.06 NOISE REDUCTION

- A. Noise reduction coefficient (N.R.C.) shall be a minimum of 1.00 when tested in accordance with ASTM C423.
- 1.07 DELIVERY, STORAGE, AND HANDLING
  - A. Protect acoustical wall panel material from excessive moisture in shipment, storage, and handling. Deliver in unopened bundles and store in a dry place with adequate air circulation.
- PART 2 MATERIALS
- 2.01 PRODUCTS
  - A. Acoustical Wall Panels Construction and Fabrication:
    - 1. Description:
      - a. Content: 100% Polyester
      - b. Reduced Environmental Impact: Single Source Fiber Content, NSF 336 Compliant, GREENGUARD Certified
      - c. Railroaded: No
      - d. Dye: Piece
      - e. Backing: None
      - f. Finish: PFAS-Free Stain Resistant
      - g. Durability: 115,000 \* D.R.
      - h. Flame Resistance: CA Bulletin 117 2013, UFAC Class 1, NFPA 260 Class 1, ASTM E84
      - i. Width: 56"
      - j. Color Fastness: A4 AATCC 16 opt 3, CLASS 4
      - k. Weight: 1.23 lb
      - m. Maintenance: WS Water-Based Cleaning Agents or Foam
    - 2. Finish: Panels shall be covered on front face and have all edges wrapped with manufacturer's standard 100% polyester woven fabric (basis of design = Guilford of Maine). See drawings for location of impact resistant fabric covering; colors to be selected by Architect (multiple colors may be selected). No seams permitted in fabric covering or exposed faces and edges. Covering material shall be adhered to front surface and bonded on all four edges and rear of panel. Material returned on rear of panel shall be a minimum of 1-1/2". Backing shall be fiberglass scrim (without foil).
    - 3. Mounting: Panels shall be internally reinforced as required for mounting system. Mounting and suspension system and fasteners shall be of types and sizes recommended by the manufacturer for installations indicated.
    - 4. Mounting System: Mechanical system using metal wall track, panel clips, and leveling angle at bottom as required. Provide continuous closure trim to conceal all gaps between panel and wall on bottom and sides of panels. Hook and loop, impaling clips, and magnetic fasteners are not permitted.
    - 5. Dimensions: The panel thickness shall be minimum 2" thick or 2-1/8" thick. The 2-1/8" thick panel will be a high impact panel. Refer to drawings for locations.

#### 2.02 MANUFACTURER

- A. Product/Manufacturer Basis of Design: Momentum Textiles and Wallcoverings <u>Momentum</u>
  - 1. Patterns/Colors: Refer to Material Schedule on drawing sheet A9.00
- B. The following are also approved manufacturers:

Acoustical Resources, Inc. P.O. Box 200504 Austin, Texas 78720 (512) 259-5858

Designer Acoustics, Inc. 2070 Five Mile Line Road Penfield, NY 14526 (716) 385-3320

Lamvin, Inc. 7992 Miramar Road San Diego, CA 92126-4212 (800) 446-6239

AVL SYSTEMS www.avlonline.com 800-228-7842 USG Interiors, Inc. 14643 Dallas Parkway, #575 Dallas, Texas 75240 (972) 490-0355

Sound Concepts 5.99 Henry Ave. Winnepeg Manitoba, Canada, R3A0V1 (612) 473-1334

Decoustics 15 Webster Street North Tonawanda, NY 14120-5874 (716) 692-6332

#### 2.03 MOUNTING ACCESSORIES:

- A. Wall panels shall be back mounted with concealed metal panel clips designed to allow for panel removal with clips of number and size recommended by the manufacturer to adequately support wall panels.
- B. Two-part metal clip system shall consist of one clip part mechanically attached to the back of panel and the other to the wall. Clip shall be designed to support panels laterally.
- C. Furnish and install manufacturer and owner-approved metal wall anchors to anchor wall clips to CMU walls, gyp. bd. walls, etc.
- D. Provide fabric-covered closure trim (to match wall panel finish) to conceal all gaps around perimeter of panels at wall.

#### PART 3 - EXECUTION

#### 3.01 EXAMINATION

A. Examine substrates and blocking, with installer present, for compliance with requirements for installation tolerances and other conditions affecting fabric covered tack board performance. Proceed with installation only after unsatisfactory conditions have been corrected.

- B. Installation shall not begin until all wet work (plastering, concrete, etc.) is completed and dry. Building shall be properly enclosed and under standard occupancy prior to installation. Maintain humidity and temperature conditions as recommended by the manufacturer for the particular panel finish(es).
- C. The contractor shall be responsible for the examination and acceptance of all surfaces and conditions prior to the acoustical panel installation.

#### 3.02 INSTALLATION

- A. General: Perform installation in accordance with manufacturer's recommendations and instructions, except where more stringent requirements are shown or specified, and except where project conditions require extra precautions or provisions to ensure satisfactory performance of the work.
- B. Install work in accordance with approved shop Drawings.
- C. Install fabric covered tack boards in locations indicated with vertical surfaces and edges plumb, top edges level and in alignment with other panels, and ascribed to fit adjoining work accurately at borders and at penetrations. Comply with panel manufacturer's written instructions for installation of panels using type of mounting accessories indicated or, if not indicated, as recommended by manufacturer.
- D. Construction Tolerances: As follows:
  - 1. Variation from Plumb and Level: Plus or minus 1/32 inch.
  - 2. Variations of Joints from Hairline: Not more than 1/32 inch.
- E. Cut units to be at least fifty percent (50%) of unit width with facing material extended over cut edge to match uncut edge. Scribe acoustical wall panels to fit adjacent work; butt joints tightly.
- F. Panels shall not twist, warp, bow, or bend after installation. Defective panels shall be replaced at no charge.

# 3.03 CLEANING

- A. Clip loose threads; remove pills and extraneous materials.
- B. Clean panels with fabric facing, on completion of installation, to remove dust and other foreign materials according to manufacturer's written instructions.
- C. Remove surplus materials, rubbish, and debris resulting from fabric covered tack board installation, on completion of the Work, and leave areas of installation in a neat and clean condition.
- 3.04 PROTECTION
  - A. Provide final protection and maintain conditions, in a manner acceptable to manufacturer and installer, that ensure fabric covered tack boards are without damage or deterioration at time of Substantial Completion.
  - B. Replace panels that cannot be cleaned and repaired, in a manner approved by Architect, before time of Substantial Completion.

# END OF SECTION 09 84 13

# SECTION 32 31 19

# **ORNAMENTAL FENCE SYSTEM**

PART 1 - GENERAL

1.01 WORK INCLUDED

A. The contractor shall provide all labor, materials and appurtenances necessary for installation of the welded ornamental steel fence system defined herein.

1.02 QUALITY ASSURANCE

A. The contractor shall provide laborers and supervisors who are thoroughly familiar with the type of construction involved and materials and techniques specified.

#### 1.03 REFERENCES

- A. ASTM A653/A653M Standard Specification for Steel Sheet, Zinc-Coated (Galvanized) or Zinc-Iron Alloy Coated (Galvannealed) by the Hot-Dip Process.
- B. ASTM B117 Practice for Operating Salt-Spray (Fog) Apparatus.
- C. ASTM D523 Test Method for Specular Gloss
- D. ASTM D714 Test Method for Evaluating Degree of Blistering in Paint.
- E. ASTM D822 Practice for Conducting Tests on Paint and Related Coatings and Materials using Filtered Open-Flame Carbon-Arc Light and Water Exposure Apparatus.
- F. ASTM D1654 Test Method for Evaluation of Painted or Coated Specimens Subjected to Corrosive Environments.
- G. ASTM D2244 Test Method for Calculation of Color Differences from Instrumentally Measured Color Coordinates.
- H. ASTM D2794 Test Method for Resistance of Organic Coatings to the Effects of Rapid Deformation (Impact).
- I. ASTM D3359 Test Method for Measuring Adhesion by Tape Test.
- J. ASTM F2408 Ornamental Fences Employing Galvanized Steel Tubular Pickets.

#### 1.04 SUBMITTAL

- A. Product Data:
  - 1. Manufacturer's specifications and other data needed to prove compliance with specified requirements.
  - 2. Manufacturer's installation instructions.

#### B. Shop Drawings:

- 1. Show locations of footings, sizes of members, and construction details.
- 2. Indicate post, foundation, and gate hinge details for the specific installation.

#### 1.05 PRODUCT HANDLING AND STORAGE

A. Upon receipt at the job site, all materials shall be checked to ensure that no damage occurred during shipping or handling. Materials shall be stored in such a manner to ensure proper ventilation and drainage, and to protect against damage, weather, vandalism and theft.

#### 1.06 PRODUCT WARRANTY

- A. All structural fence components (i.e. rails, pickets, and posts) shall be warranted within specified limitations, by the manufacturer for a period of 20 years from date of original purchase. Warranty shall cover any defects in material finish, including cracking, peeling, chipping, blistering or corroding.
- B. Reimbursement for labor necessary to restore or replace components that have been found to be defective under the terms of manufactures warranty shall be guaranteed for five (5) years from date of original purchase.

# PART 2 - MATERIALS

2.01 MANUFACTURER - BASIS OF DESIGN

A. AMERISTAR; <u>www.ameristarperimeter.com</u>

- 1. Fence System Description:
  - a. Montage Plus Majestic; 3 rail panel system
  - b. 6'-0" tall
  - c. 2-1/2" square post
- B. Substitutions: Refer to section 01 25 13.

# 2.02 MATERIAL

- A. Steel material for fence panels and posts shall conform to the requirements of ASTM A653/A653M, with a minimum yield strength of 45,000 psi (310 MPa) and a minimum zinc (hot-dip galvanized) coating weight of 0.60 oz/ft<sup>2</sup> (184 g/m<sup>2</sup>), Coating Designation G-60.
- B. Material for pickets shall be 3/4" square x 18 Ga. tubing. The rails shall be steel channel, 1.5" x 1.4375" x 14 Ga. Picket holes in the rail shall be spaced 3.500" o.c. for 3" air space. Fence posts and gate posts shall meet the minimum size requirements of Table 1.

# 2.03 FABRICATION

- A. Pickets, rails and posts shall be pre-cut to specified lengths. Rails shall be pre-punched to accept pickets.
- B. Pickets shall be inserted into the pre-punched holes in the rails and shall be aligned to standard spacing using a specially calibrated alignment fixture. The aligned pickets and rails shall be joined at each picket-to-rail intersection by Ameristar's proprietary fusion welding process, thus completing the rigid panel assembly (Note: The process produces a virtually seamless, spatter-free good-neighbor appearance, equally attractive from either side of the panel).
- C. The manufactured panels and posts shall be subjected to an inline electrode position coating (E-Coat) process consisting of a multi-stage pretreatment/wash, followed by a duplex application of an epoxy primer and an acrylic topcoat. The minimum cumulative coating thickness of epoxy and acrylic shall be 2 mils (0.058 mm). The color shall be Black. The coated panels and posts shall be capable of meeting the performance requirements for each quality characteristic shown in Table 2 (Note: The requirements in Table 2 meet or exceed the coating performance criteria of ASTM F2408).
- D. The manufactured fence system shall be capable of meeting the vertical load, horizontal load, and infill performance requirements for Commercial weight fences under ASTM F2408.
- E. Fence and components meet applicable requirements of the IBC. Panel, post and bracket assemblies shall be subjected to structural performance testing according to Chapter 17 Structural Tests and Special Inspections International Building Code (IBC). Physical testing to be completed by accredited third party testing facility. Completed assembly shall demonstrate loading capacity of 2.5 times prescribed design loads found in section 1607.8.1, 1607.8.1.1 and 1607.8.1.2 of IBC 2018 for Handrails and Guards. IBC compliant fence system requirements detailed within Table 4.
- F. Gates with an out-to-out leaf dimension less than and including 72 inches shall be fabricated using Montage Plus ornamental panel material and 1-3/4" sq. x 14ga. gate ends. Gate leafs greater than 72 inches shall be fabricated using ForeRunner rails, 17 gauge pickets, intermediate uprights, gussets and 1-3/4" sq. x 14ga. gate ends. All rail and upright intersections shall be joined by welding. All picket and rail intersections shall also be joined by welding.

# PART 3 - EXECUTION

#### 3.01 PREPARATION

A. All new installation shall be laid out by the contractor in accordance with the construction plans.

#### 3.02 INSTALLATION

A. Fence post shall be spaced according to Table 3, plus or minus ¼". For installations that must be raked to follow sloping grades, the post spacing dimension must be measured along the grade. Fence panels shall be attached to posts with brackets supplied by the manufacturer. Posts shall be set in concrete footers having a minimum depth of 36" (Note: In some cases, local restrictions of freezing weather conditions may require a greater depth). The "Earthwork" and "Concrete" sections of this specification shall govern material requirements for the concrete footer. Posts setting by other methods such as plated posts or grouted core-drilled footers are permissible only if shown by engineering analysis to be sufficient in strength for the intended application.

#### 3.03 FENCE INSTALLATION MAINTENANCE

A. When cutting/drilling rails or posts adhere to the following steps to seal the exposed steel surfaces; 1) Remove all metal shavings from cut area. 2) Apply zinc-rich primer to thoroughly cover cut edge and/or drilled hole; let dry. 3) Apply 2 coats of custom finish paint matching fence color. Failure to seal exposed surfaces per steps 1-3 above will negate warranty. Ameristar spray cans or paint pens shall be used to prime and finish exposed surfaces; it is recommended that paint pens be used to prevent overspray. Use of non-Ameristar parts or components will negate the manufactures' warranty.

# 3.04 GATE INSTALLATION

A. Gate posts shall be spaced according to the manufacturers' gate drawings, dependent on standard out-to-out gate leaf dimensions and gate hardware selected. Type and quantity of gate hinges shall be based on the application; weight, height, and number of gate cycles. The manufacturers' gate drawings shall identify the necessary gate hardware required for the application. Gate hardware shall be provided by the manufacture of the gate and shall be installed per manufacturer's recommendations.

# 3.05 CLEANING

A. The contractor shall clean the jobsite of excess materials; post-hole excavations shall be scattered uniformly away from posts.


|                  | Table 1 – Minimum Sizes for Montage Plus Posts |                              |  |  |  |  |
|------------------|--|------------------------------|--|--|--|--|
| Fence Posts      | Panel Height                                   |                              |  |  |  |  |
| 2-1/2" x 16 Ga.  | Up to & Including 6' Height                    |                              |  |  |  |  |
| Catalast         |  | Gate Height                  |  |  |  |  |
| <u>Gate Leaf</u> | Up to & Including 4'                           | Over 4' Up to & Including 6' |  |  |  |  |
| Up to 4'         | 2-1/2" x 16 Ga.                                | 2-1/2" x 14 Ga.              |  |  |  |  |
| 4'1" to 6'       | 3" x 12 Ga.                                    | 3" x 12 Ga.                  |  |  |  |  |
| 6'1" to 10'      | 4" x 11 Ga.                                    | 4" x 11 Ga.                  |  |  |  |  |
| 10'1" to 16'     | 6" x 3/16" wall                                | 6" x 3/16" wall              |  |  |  |  |


|                         | Table 2 – Coating Performance Requirements |   |  |  |  |  |
|-------------------------|--|---|--|--|--|--|
| Quality Characteristics | ASTM Test Method                           | Performance Requirements  |  |  |  |  |
| Adhesion                | D3359 – Method B                           | Adhesion (Retention of Coating) over 90% of test area (Tape and knife test).  |  |  |  |  |
| Corrosion Resistance    | B117, D714 & D1654                         | Corrosion Resistance over 1,500 hours (Scribed per D1654; failure mode is accumulation of 1/8" coating loss from scribe or medium #8 blisters). |  |  |  |  |
| Impact Resistance       | D2794                                      | Impact Resistance over 60-inch lb. (Forward impact using 0.625" ball).  |  |  |  |  |
| Weathering Resistance   | D822 D2244, D523 (60° Method)              | Weathering Resistance over 1,000 hours (Failure mode is 60% loss of gloss or color variance of more than 3 delta-E color units).                |  |  |  |  |


|                              | lac   | ole 3 – Montage Plus – Pos            | t Spacing By B | racket Type              |                                    |          |  |
|------------------------------|---|---------------------------------------|----------------|--------------------------|------------------------------------|----------|--|
| Span                         | For CLASSIC, GENESIS, M<br>8' Nominal (91.95" Rail) | IAJESTIC, & WARRIOR                   |                |                          |                                    |          |  |
| Post Size                    | 2-1/2"  | 2-1/2"                                | 2-1/2"         | 3"                       | 2-1/2"                             | 3"       |  |
| Bracket Type                 | Montage Plus<br>Universal<br>(BB112)                | Montage Plus<br>Line Blvd.<br>(BB114) | Flat           | ge Plus<br>Mount<br>111) | Montage Plus<br>Swivel<br>(BB113)* |          |  |
| Post Settings<br>± 1/4" O.C. | 95"   | 95"                                   | 95"            | 95-1/2"                  | *95"                               | *95-1/2" |  |

|   | Table 4 –                     | Montage Plus – IBC Com                                       | pliant System Requirements  |   |  |  |
|---|-------------------------------|--|---|---|--|--|
| Par                                     | nel Options                   | P  | Post Options  | Brackets Options  |  |  |
| Styles                                  | Rail Configuration            | Steel Post Options   | Post Plate Options (anchorage<br>by others)   | Line Boulevard Brackets   |  |  |
| Classic                                 | 3-Rail & 4-Rail               | 2.5" SQ x 14ga   | 8" x 8" x 3/8" – for 2.5" posts   | End Boulevard Brackets  |  |  |
| Majestic                                |                               | 3" SQ x 12ga   | 10" x 10" x 3/8" – for 3" posts   | Corner Boulevard Brackets   |  |  |
| Genesis                                 |                               | 4" SQ x 12ga   |   | *Flat Mount Brackets  |  |  |
| Warrior                                 |                               |  |   | *Note: Flat Mount Brackets<br>require a thru-bolt<br>installation |  |  |
| Special Inspections<br>Completed assemb | - International Building Code | e (IBC) 2018. Physical testir<br>capacity of 2.5 times presc | nance testing according to Chapter 17<br>ng to be completed by accredited thirc<br>ribed design loads found in section 16 | party testing facility.   |  |  |

END OF SECTION

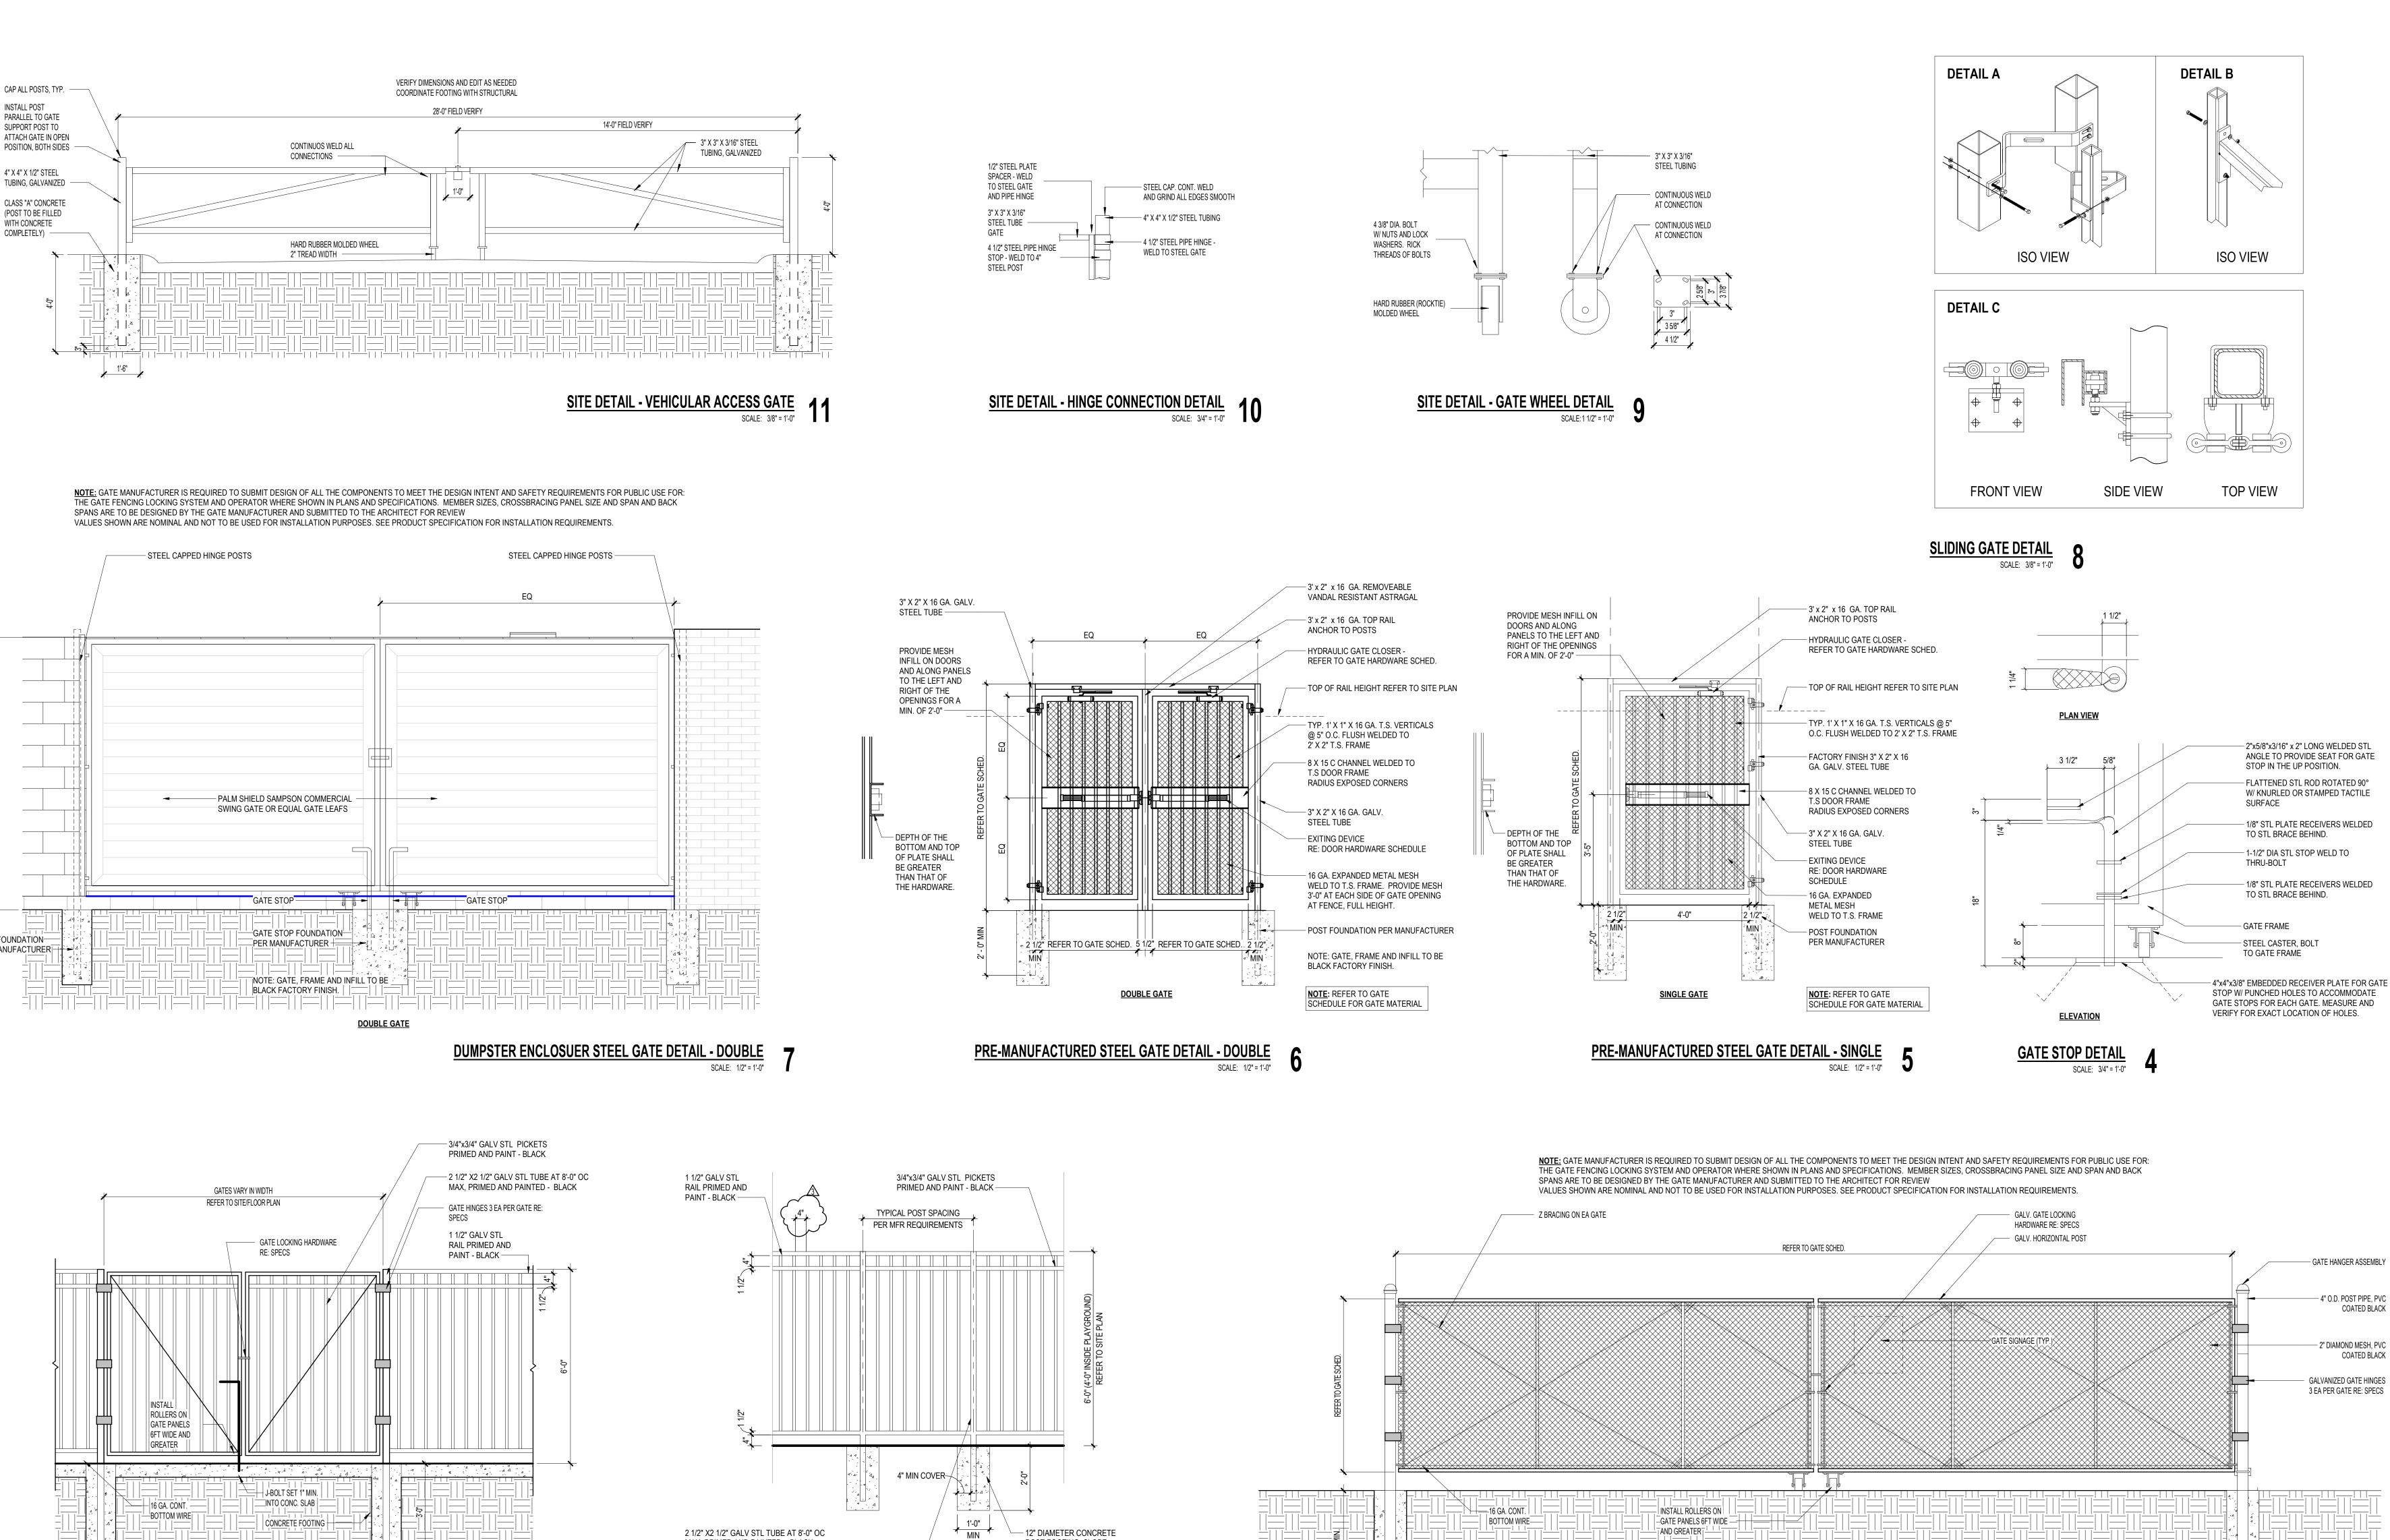

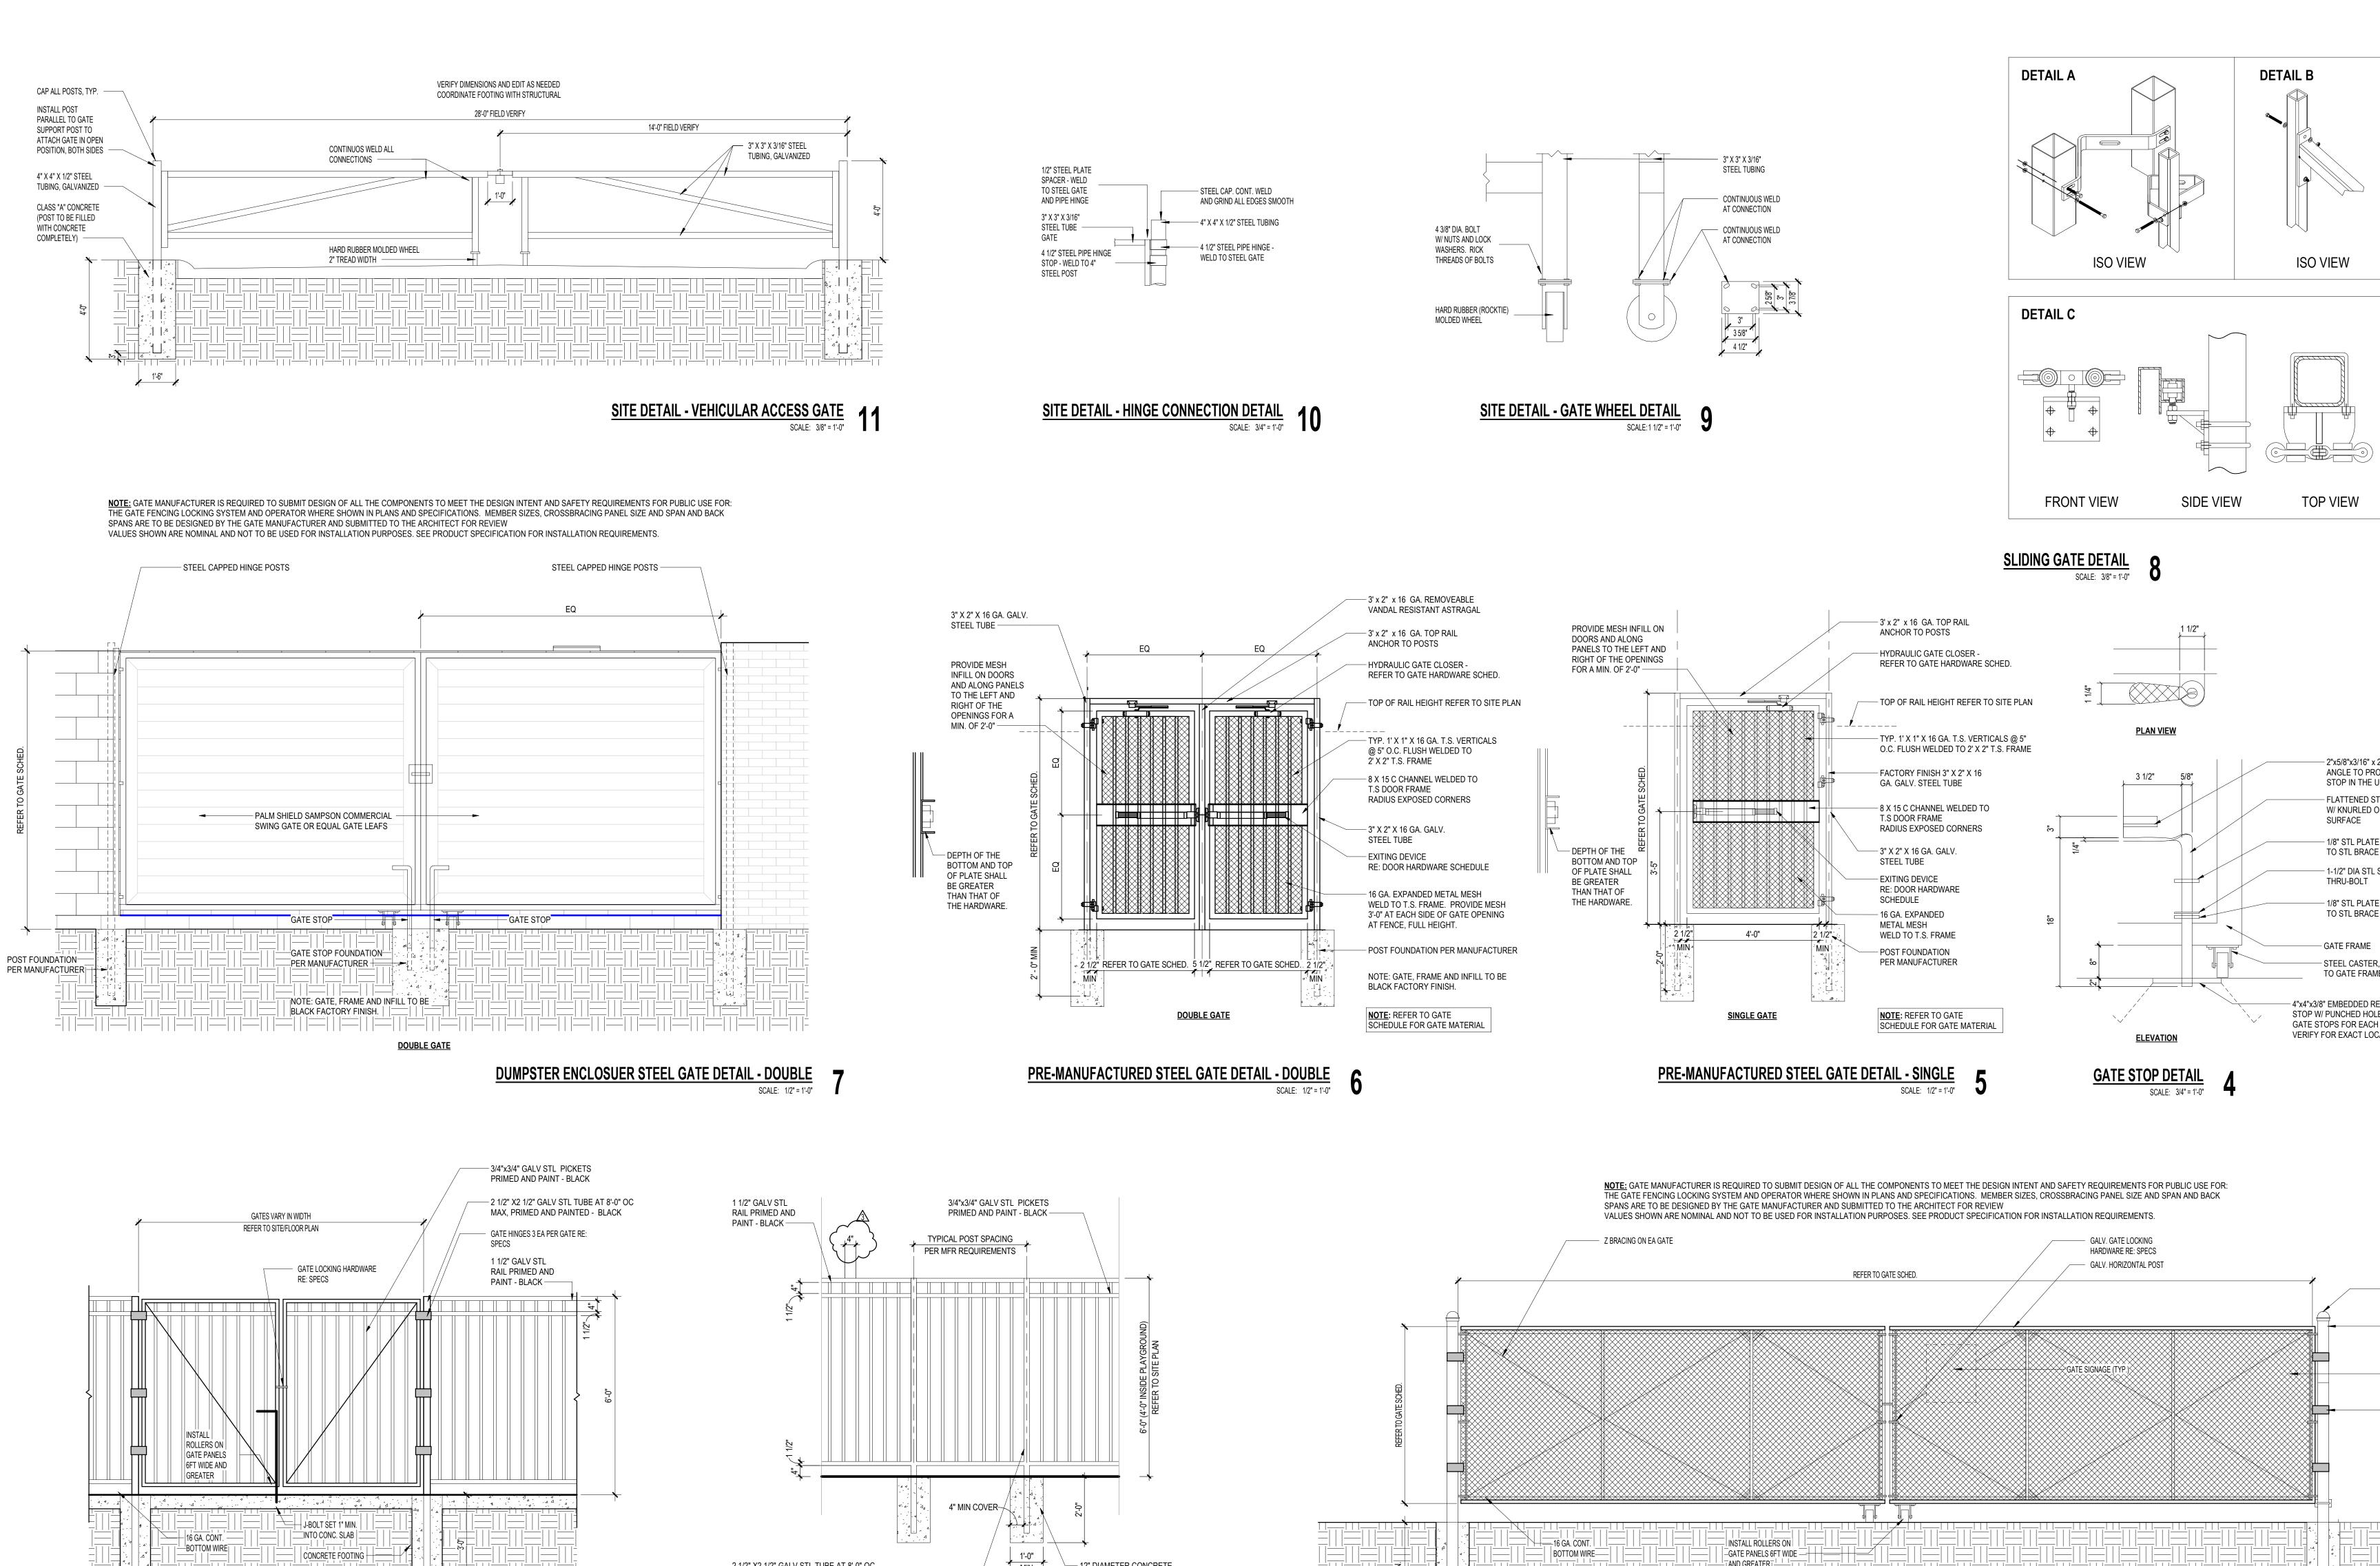

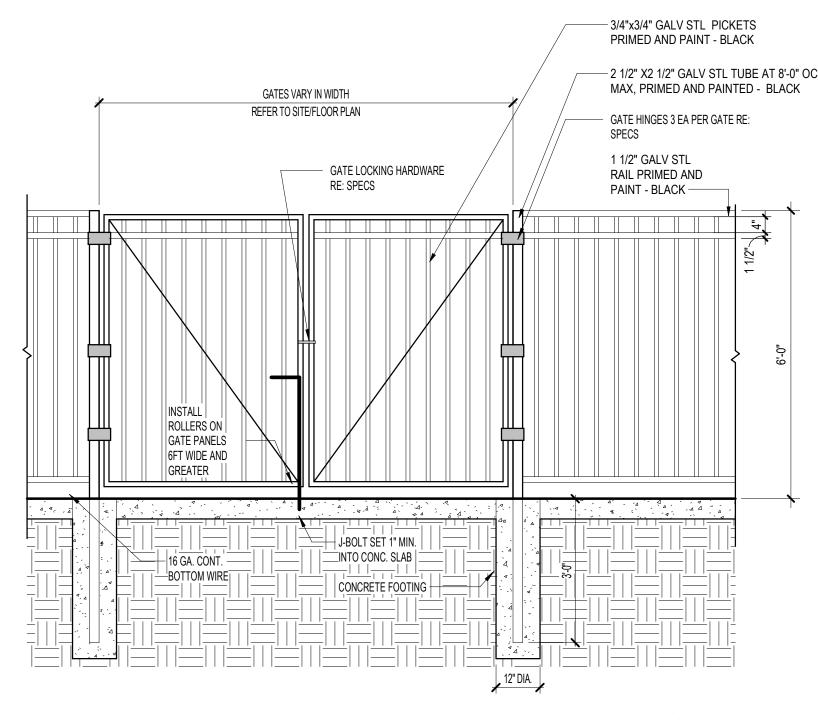

SITE DETAIL - DECORATIVE STEEL GATE DETAIL SCALE: 1/2" = 1'-0"

DECORATIVE STEEL FENCE ELEVATION SCALE: 1/2" = 1'-0"

POST FOOTING, SLOPE TOP AWAY FROM POST

─N≐

MAX, PRIMED AND PAINTED - BLACK -

PREMANUFACTURED STEEL SLIDING GATE - PLAN, ELEVATION AND SECTION1 SCALE: 1/2" = 1'-0"

| <u>-       </u><br> |  |
|---------------------|--|
|                     |  |
| <br>                |  |
|                     |  |
| <u>-   </u>         |  |

- 2" DIAMOND MESH, PVC COATED BLACK - GALVANIZED GATE HINGES 3 EA PER GATE RE: SPECS

- 4" O.D. POST PIPE, PVC COATED BLACK

- GATE HANGER ASSEMBLY

1/8" STL PLATE RECEIVERS WELDED

1/8" STL PLATE RECEIVERS WELDED

- 2"x5/8"x3/16" x 2" LONG WELDED STL ANGLE TO PROVIDE SEAT FOR GATE - FLATTENED STL ROD ROTATED 90°

Ο O  $\mathbf{\mathcal{L}}$ BROOKEWATE Ζ #38 747 CHO רי S ARY BLVD Ъ EMENT/ ш 522 77471 \_ ¥ AVENUE ENBERG, 3911 ROSI ED AR

OF

1/14/2025

CHECKED BY: CHK

Description

DATE: 1/14/2025

PROJECT NO.

DRAWN BY: DRW

Date

3 01/13/2025 ADDEMDUM #3

100% CONSTRUCTION DOCUMENTS

A1.06 SITE DETAILS

DATE:

<u>\_No.</u>

REVISIONS:

| GENERAL NOTES - FURNISHING AND EQUIPMENT:   | <b>GENERAL NOTES - INTERIOR FINISH AND COLOR SCHEDULE:</b>   |
|---|--|
| 1. MODEL NUMBERS/MFR'S ARE LISTED ON CASEWORK ELEVATIONS SO THAT A MINIMUM DESIGN BASIS MAY BE ESTABLISHED. THE DIMENSIONS SHOWN (WXHXD) MAY DIFFER FROM THE SELECTED MFR'S STANDARD DIMENSIONS FOR THE LISTED MODEL NUMBERS. | 1. MANUFACTURERS NAMES AND IDENTIFICATION NUMBERS ARE LISTED AS A MEANS OF ESTABLISHING A STANDARD OF TYPE, FUNCTION, COLO<br>QUALITY. REFER TO PROJECT MANUAL FOR ADDITIONAL MANUFACTURERS & PROCEDURES.  |
| 2. PROVIDE SIDE, TOP, AND BOTTOM FILLER PIECES AS REQ'D TO COMPLETE CASEWORK INDICATED ON PLANS.  | 2. THE CONTRACTOR SHALL SUBMIT TO THE ARCHITECT A SAMPLE OF ALL FINISH MATERIALS FOR APPROVAL BEFORE MATERIALS ARE APPLIED   |
| 3. ALL FLOOR MOUNTED FIXTURES ARE TO HAVE THE SAME FINISH FACE MATERIAL AS THE ROOM IN WHICH THEY ARE LOCATED.  | 3. VERIFY ALL VINYL WALL GRAPHICS WITH THE ARCHITECT BEFORE PAINTING. GRAPHICS MAY NEED TO BE ADJUSTED AFTER ENLARGING TO R  |
| 4. BLIND CABINETS, AT CORNERS, ARE TO BE LEFT OR RIGHT HAND AS REQ'D PER PLAN.  | SAME COMPOSITION AS ON THE DRAWINGS.   |
| 5. ALL CABINETS TO HAVE PLASTIC LAMINATE THROUGHOUT, INCLUDING ALL EXPOSED SUFACES INSIDE AND OUT.  | 4. IF REQUESTED THE ARCHITECT WILL PROVIDE 8 1/2" X 11" CLEAR ACETATE OR MYLAR OF DETAILED MURAL GRAPHICS FOR PROJECTION ON V  |
| 6. PROVIDE PLASTIC LAMINATE FINISHED END PANELS AT EXPOSED CABINET ENDS INCLUDING KNEESPACES (TYP).   | 5. TERMINATE ALL ACCENT PAINTS & VINYL WALL COVERING ON INSIDE CORNERS ONLY UNLESS OTHERWISE INDICATED.  |
| 7. FIELD VERIFY DIMENSIONS PRIOR TO FABRICATION AND INSTALLATION OF ANY FIXTURES.   | 6. PAINT ALL INTERIOR & EXTERIOR EXPOSED PIPING. VERIFY COLOR W/ ARCHITECT.  |
| 8. BOOKCASES AND SHELVES TO HAVE FRONT FACING SURFACE OF BACK PANEL TO WATCH FINISH OF REMAINDER OF BOOKCASE.   | 7. PAINT ANY VENTS, GRILLES, PIPING, ETC. SAME COLOR AS ADJACENT WALL.   |
| 9. COUNTERTOPS TO HAVE PLASTIC LAMINATE SURFACE W/ 4" HIGH BACKSPLASH TYP, UON.   | 8. UNDESIGNATED PAINTED GYPSUM BOARD WALLS TO BE MARK "P-1".   |
| 10. PROVIDE KEYED LOCKS AT CABINET DOORS AND DRAWERS, WHERE INDICATED.  | 9. UNDESIGNATED PAINTED CMU WALLS TO BE MARK "P-1".  |
| 11. KNEESPACE UNITS NOT RECEIVING SINKS SHALL RECEIVE GROMMETS CENTERED ON THE UNIT, 3" FROM THE BACK EDGE OF THE KNEESPACE UNIT (UON).   | 10. ALL INTERIOR HOLLOW METAL DOOR AND WINDOW FRAMES SHALL BE PAINTED TO MATCH MARK "P-1" (U.O.N.). ALL VISION PANEL FRAMES IN DOORS TO MATCH MARK P-2.  |
| 12. KNEESPACE UNITS IN THE ADMINISTRATION AREA TO HAVE MFR'S STANDARD COMPUTER KEYBOARD DRAWER (UON).   | 11. ALL INTERIOR HOLLOW METAL DOORS SHALL BE PAINTED TO MATCH MARK "P-1".  |
| 13. PROVIDE MFR'S STANDARD PENCIL DRAWER INSERT AT KNEESPACE UNITS W/ STANDARD DRAWERS (NOT KEYBOARD DRAWERS (UON).   | 12. ALL INTERIOR WOOD DOORS & UNASSIGNED WOOD TRIM PIECES SHALL BE MARK "PL-1".  |
| 14. PROVIDE SNAP ON PVC CORNER GUARDS FROM TOP OF BASE TO TOP OF DOOR FRAME ALL OUTSIDE CORNERS (NON CMU WALLS) IN HIGH TRAFFIC AREAS, INCLUDING PARTITIONS WITH VWC.   | 13. ALL METAL HANDRAIL (INTERIOR) SHALL BE PAINTED STEEL RAILING, UON. ALL METAL HANDRAIL (EXTERIOR) SHALL BE GALVANIZED STEEL RAILING, UON. ALL METAL HANDRAIL (EXTERIOR) SHALL BE GALVANIZED STEEL RAI |
| 15. PROVIDE STAINLESS STEEL CORNER GUARDS, 4" AT KITCHEN AREA AND SURROUNDING SPACES.   | PRIMED, FIELD PAINTED, UON.  |
| 16. SHELVES SHALL BE ADJUSTABLE, UON. SHELVES OVER 36" IN LENGTH SHALL BE 1" THICK.   | 14. ALL BOY'S AND GIRL'S TOILET PARTITIONS SHALL BE AS SPECIFIED.  |
| 17. PROVIDE 7/8" WORK TOPS WITH PLASTIC LAMINATE FINISH AT CASEWORK SHELVING UNITS UNDER 48".   | 15. ALL BASE CABINETS, WALL CABINETS, AND MISC. CASE WORK IN CLASSROOM/ ACADEMIC AREA SHALL BE MARK "PL-1". UON. ALL BASE CABINE<br>CABINETS, AND MISC. CASE WORK IN ADMIN SUITE SHALL BE MARK "PL-1". UON.  |
| 18. PROVIDE 4' -0" TALL TACKBOARDS (TB), AND MARKERBOARDS (MB), UON. BOARDS SHALL BE IN THE SAME FRAME WHEN ADJACENT.   | 16. ALL COUNTERTOPS IN CLASSROOM SHALL BE MARKED "PL-3". UON. ALL COUNTERTOPS IN ADMIN SUITE SHALL BE MARKED "PL-3". UON.  |
| 19. MB, AND TB TO HAVE CONT TACKSTRIPS AND PEN TROUGHS (UON). TACKSTRIPS TO HAVE MAP HOOKS, UON.  | 17. PROVIDE MATCHING COLOR FOR ALL EDGE BANDING AT ALL COUNTERS  |
| 20. PROJECTION SCREENS: SPRING-ROLLER OPERATED, WALL MOUNTED, 72"X72" W/ 70"X70" VIEWING AREA, UON.   | 18. RECEPTION COUNTERTOPS SHALL BE MARKED "SS-1".  |
| 21. PROVIDE ROLLER SHADES (RS) AT INTERIOR WINDOWS U.O.N., REFER TO A9.01A - A9.02D SERIES FOR LOCATIONS.   | 19. ALL PLASTIC LAMINATE WALL PANELS TO BE AS NOTED ON SHEETS A9.10 - A9.16.   |
| 22. PROVIDE HORIZONTAL LOUVER BLINDS (HLB) AT EXTERIOR WINDOWS U.O.N., REFER TO A9.01A - A9.02D SERIES FOR LOCATIONS  | 20. ALL RESTROOM TILE, KITCHEN, OR ANY OTHER WET AREA SHALL RECEIVE EPOXY GROUT, PREFER MATERIAL & FINISH SCHEDULE FOR SPECI<br>COLOR.   |
|   | 21. ALL EXPOSED STRUCTURAL STEEL INCLUDING ROOF DECK, JOISTS, GIRDERS, BEAMS AND ANY MISC. STEEL SHALL BE PAINTED MARK "P-1". D<br>DIFFUSERS AND AIR HANDLING UNITS SHALL BE GALVANIZED METAL.   |
|   | 22. PATTERNS AND COLORS FOR AREAS SCHEDULED TO RECEIVE LVT SHALL BE AS REPRESENTED ON SHEETS A9.01A THRU A9.01D.   |
|   | 23. LOW PROFILE TRANSITION STRIPS TO BE PLACED AT ANY FLOORING MATERIAL CHANGE.  |
|   | 24. METAL LOW PROFILE TRANSITION STRIPS TO BE PLACED AT ANY FLOORING MATERIAL CHANGE ADJACENT TO CT.   |

| LIGH<br>01 FLOOR FINISH  |   |   |   |
|--|---|---|---|
|  | MARK  | MATERIAL  | MANUFAC   |
|  |   |   |   |
| 01 FLOOR FINISH  | CPT-1   | POWERBOND CARPET  | TARKETT   |
| 01 FLOOR FINISH  | CPT-2   | POWERBOND CARPET  | TARKETT   |
| 01 FLOOR FINISH  | EPF-1   | EPOXY RESINOUS FLOORING   | STONHARD  |
| 01 FLOOR FINISH  | LVT-1   | LUXURY VINYL TILE   | TARKETT   |
| 01 FLOOR FINISH  | SC-1  | SEALED CONCRETE   |   |
| 01 FLOOR FINISH  | T-1   | TERRAZZO  | TM SUPPLY, THICK SET  |
| 01 FLOOR FINISH  | T-2   | TERRAZZO  | TM SUPPLY, THICK SET  |
| 01 FLOOR FINISH  | VCT-1   | VINYL COMPOSITION TILE  | ARMSTRONG   |
| 01 FLOOR FINISH  | VCT-2   | VINYL COMPOSITION TILE  | ARMSTRONG   |
| 01 FLOOR FINISH  | VCT-2   | VINYL COMPOSITION TILE  | ARMSTRONG   |
| 01 FLOOR FINISH  | VCT-4   | VINYL COMPOSITION TILE  | ARMSTRONG   |
| 01 FLOOR FINISH  | WD-1  | STAINED WOOD  |   |
| 01 FLOOR FINISH  | WF-1  | WALK -OFF   | TARKETT   |
| 02 BASE  |   |   |   |
| 02 BASE  | EPB   | EPOXY BASE  | STONHARD  |
| 02 BASE  | RB-1  | RUBBER BASE   | TARKETT/JOHNSONITE  |
| 02 BASE  | RB-2  | RUBBER BASE   | TARKETT/JOHNSONITE  |
| 03 WALL FINISH   |   |   |   |
| 03 WALL FINISH   | P-1   | PAINT   | SHERWIN WILLIAMS  |
| 03 WALL FINISH   | P-2   | PAINT   | SHERWIN WILLIAMS  |
| 03 WALL FINISH   | P-3   | PAINT   | SHERWIN WILLIAMS  |
| 03 WALL FINISH   | P-4   | PAINT   | SHERWIN WILLIAMS  |
| 03 WALL FINISH   | P-5   | PAINT   | SHERWIN WILLIAMS  |
| 03 WALL FINISH   | VWC-1   | TYPE 2 VINYL WALL COVERING  | MOMENTUM  |
| 03 WALL FINISH   | VWC-2   | VINYL WALLCOVERING  | MOMENTUM  |
| 03 WALL FINISH   | VWC-3   | VINYL WALLCOVERING  | KOROSEAL  |
| 03 WALL FINISH   | VWC-4   | VINYL WALLCOVERING  | KOROSEAL  |
| 03 WALL FINISH   | WS-1  | WRITABLE SURFACE  | KOROSEAL  |
| 03 WALL FINISH   | WT-1  | WALL TILE   | DALTILE   |
| 03 WALL FINISH   | WT-2  | WALL TILE   | DALTILE   |
| 03 WALL FINISH   | WT-3  | WALL TILE   | CROSSVILLE  |
| 03 WALL FINISH   | WT-4  | WALL TILE   | CROSSVILLE  |
| 04 CEILING   |   |   |   |
| 04 CEILING   | AWC   | ACOUSTICAL WOOD CEILING   | CERTAINTEED   |
| 04 CEILING   | EXP   | EXPOSED CEILING   |   |
| 04 CEILING   | GYP   | GYPBOARD CEILING  |   |
| 04 CEILING   | SAP-1   | SUSPENDED ACOUSTIC CEILING  | ARMSTRONG   |
| 04 CEILING   | SAP-2   | SUSPENDED ACOUSTIC VINYL TILE   | CERTAINTEED   |
| 04 CEILING   | SAP-3   | SUSPENDED ACOUSTICAL TILE/BLACK   |   |
| 05 MISC FINISHES   |   |   |   |
| 05 MISC FINISHES   |   | OPERABLE PARTITION SYSTEM   | BOD: MODERNFOLD   |
| 05 MISC FINISHES   | AWP-1   | FABRIC WRAPPED PANEL  | MOMENTUM  |
|  |   | FABRIC WRAPPED PANEL  |   |
| 05 MISC FINISHES   | AWP-2   |   | MOMENTUM  |
|  | AWP-2<br>AWP-3  | FABRIC WRAPPED PANEL  | MOMENTUM  |
| 05 MISC FINISHES   | AWP-3   | FABRIC WRAPPED PANEL  | MOMENTUM  |
| 05 MISC FINISHES<br>05 MISC FINISHES   | AWP-3<br>CG-1   | FABRIC WRAPPED PANEL CORNER GUARDS  | MOMENTUM<br>WALLANDCORNERGUARD.CC   |
| 05 MISC FINISHES<br>05 MISC FINISHES<br>05 MISC FINISHES   | AWP-3<br>CG-1<br>GC-2   | FABRIC WRAPPED PANEL<br>CORNER GUARDS<br>CORNER GUARDS  | MOMENTUM<br>WALLANDCORNERGUARD.CC<br>KOROSEAL   |
| 05 MISC FINISHES<br>05 MISC FINISHES<br>05 MISC FINISHES<br>05 MISC FINISHES   | AWP-3<br>CG-1<br>GC-2<br>PL-1   | FABRIC WRAPPED PANEL<br>CORNER GUARDS<br>CORNER GUARDS<br>PLASTIC LAMINATE  | MOMENTUM<br>WALLANDCORNERGUARD.CO<br>KOROSEAL<br>WILSONART  |
| 05 MISC FINISHES<br>05 MISC FINISHES<br>05 MISC FINISHES<br>05 MISC FINISHES<br>05 MISC FINISHES   | AWP-3<br>CG-1<br>GC-2<br>PL-1<br>PL-2   | FABRIC WRAPPED PANEL<br>CORNER GUARDS<br>CORNER GUARDS<br>PLASTIC LAMINATE<br>PLASTIC LAMINATE  | MOMENTUM<br>WALLANDCORNERGUARD.CC<br>KOROSEAL<br>WILSONART<br>WILSONART   |
| 05 MISC FINISHES<br>05 MISC FINISHES<br>05 MISC FINISHES<br>05 MISC FINISHES<br>05 MISC FINISHES<br>05 MISC FINISHES   | AWP-3<br>CG-1<br>GC-2<br>PL-1<br>PL-2<br>PL-3   | FABRIC WRAPPED PANEL         CORNER GUARDS         CORNER GUARDS         PLASTIC LAMINATE         PLASTIC LAMINATE         PLASTIC LAMINATE   | MOMENTUM<br>WALLANDCORNERGUARD.CO<br>KOROSEAL<br>WILSONART<br>WILSONART<br>WILSONART  |
| 05 MISC FINISHES<br>05 MISC FINISHES<br>05 MISC FINISHES<br>05 MISC FINISHES<br>05 MISC FINISHES<br>05 MISC FINISHES<br>05 MISC FINISHES   | AWP-3<br>CG-1<br>GC-2<br>PL-1<br>PL-2<br>PL-3<br>SS-1   | FABRIC WRAPPED PANEL         CORNER GUARDS         CORNER GUARDS         PLASTIC LAMINATE         PLASTIC LAMINATE         PLASTIC LAMINATE         SOLID SURFACE   | MOMENTUM<br>WALLANDCORNERGUARD.CO<br>KOROSEAL<br>WILSONART<br>WILSONART<br>WILSONART<br>WILSONART   |
| 05 MISC FINISHES<br>05 MISC FINISHES   | AWP-3           CG-1           GC-2           PL-1           PL-2           PL-3           SS-1           STG   | FABRIC WRAPPED PANEL         CORNER GUARDS         CORNER GUARDS         PLASTIC LAMINATE         PLASTIC LAMINATE         PLASTIC LAMINATE         PLASTIC LAMINATE         SOLID SURFACE         STAGE CURTAIN  | MOMENTUM<br>WALLANDCORNERGUARD.CO<br>KOROSEAL<br>WILSONART<br>WILSONART<br>WILSONART<br>WILSONART<br>KM FABRICS   |
| 05 MISC FINISHES<br>05 MISC FINISHES   | AWP-3<br>CG-1<br>GC-2<br>PL-1<br>PL-2<br>PL-3<br>SS-1   | FABRIC WRAPPED PANEL         CORNER GUARDS         CORNER GUARDS         PLASTIC LAMINATE         PLASTIC LAMINATE         PLASTIC LAMINATE         SOLID SURFACE   | MOMENTUM<br>WALLANDCORNERGUARD.CO<br>KOROSEAL<br>WILSONART<br>WILSONART<br>WILSONART<br>WILSONART   |
| 05 MISC FINISHES<br>05 MISC FINISHES   | AWP-3           CG-1           GC-2           PL-1           PL-2           PL-3           SS-1           STG           TP  | FABRIC WRAPPED PANEL         CORNER GUARDS         CORNER GUARDS         PLASTIC LAMINATE         PLASTIC LAMINATE         PLASTIC LAMINATE         SOLID SURFACE         STAGE CURTAIN         TOLIET PARTITIONS   | MOMENTUM<br>WALLANDCORNERGUARD.CO<br>KOROSEAL<br>WILSONART<br>WILSONART<br>WILSONART<br>WILSONART<br>KM FABRICS<br>ASI  |
| 05 MISC FINISHES<br>05 MISC FINISHES<br>07 EXTERIOR<br>07 EXTERIOR   | AWP-3           CG-1           GC-2           PL-1           PL-2           PL-3           SS-1           STG           TP  | FABRIC WRAPPED PANEL         CORNER GUARDS         CORNER GUARDS         PLASTIC LAMINATE         PLASTIC LAMINATE         PLASTIC LAMINATE         SOLID SURFACE         STAGE CURTAIN         TOLIET PARTITIONS   | MOMENTUM<br>WALLANDCORNERGUARD.CO<br>KOROSEAL<br>WILSONART<br>WILSONART<br>WILSONART<br>WILSONART<br>KM FABRICS<br>ASI<br>KAWNEER   |
| 05 MISC FINISHES<br>05 MISC FINISHES<br>07 EXTERIOR<br>07 EXTERIOR<br>07 EXTERIOR  | AWP-3           CG-1           GC-2           PL-1           PL-2           PL-3           SS-1           STG           TP           ALUM           BK-1  | FABRIC WRAPPED PANEL         CORNER GUARDS         CORNER GUARDS         PLASTIC LAMINATE         PLASTIC LAMINATE         PLASTIC LAMINATE         SOLID SURFACE         STAGE CURTAIN         TOLIET PARTITIONS         STOREFRONT AND CURTAIN WALL         BRICK   | MOMENTUM<br>WALLANDCORNERGUARD.CC<br>KOROSEAL<br>WILSONART<br>WILSONART<br>WILSONART<br>WILSONART<br>KM FABRICS<br>ASI<br>KAWNEER<br>UPCHURCH KIMBROUGH /CLC  |
| 05 MISC FINISHES<br>05 MISC FINISHES<br>07 EXTERIOR<br>07 EXTERIOR<br>07 EXTERIOR<br>07 EXTERIOR   | AWP-3           CG-1           GC-2           PL-1           PL-2           PL-3           SS-1           STG           TP           ALUM           BK-1           BK-2   | FABRIC WRAPPED PANEL         CORNER GUARDS         CORNER GUARDS         PLASTIC LAMINATE         PLASTIC LAMINATE         PLASTIC LAMINATE         SOLID SURFACE         STAGE CURTAIN         TOLIET PARTITIONS         STOREFRONT AND CURTAIN WALL         BRICK   | MOMENTUM<br>WALLANDCORNERGUARD.CC<br>KOROSEAL<br>WILSONART<br>WILSONART<br>WILSONART<br>WILSONART<br>KM FABRICS<br>ASI<br>KAWNEER<br>UPCHURCH KIMBROUGH /CLC  |
| 05 MISC FINISHES<br>05 MISC FINISHES<br>07 EXTERIOR<br>07 EXTERIOR<br>07 EXTERIOR<br>07 EXTERIOR<br>07 EXTERIOR  | AWP-3           CG-1           GC-2           PL-1           PL-2           PL-3           SS-1           STG           TP           ALUM           BK-1           BK-2           BK-3  | FABRIC WRAPPED PANEL         CORNER GUARDS         CORNER GUARDS         PLASTIC LAMINATE         PLASTIC LAMINATE         PLASTIC LAMINATE         SOLID SURFACE         STAGE CURTAIN         TOLIET PARTITIONS         STOREFRONT AND CURTAIN WALL         BRICK         BRICK   | MOMENTUM<br>WALLANDCORNERGUARD.CO<br>KOROSEAL<br>WILSONART<br>WILSONART<br>WILSONART<br>WILSONART<br>KM FABRICS<br>ASI<br>KAWNEER<br>UPCHURCH KIMBROUGH /CLO<br>UPCHURCH KIMBROUGH /CLO   |
| 05 MISC FINISHES<br>05 MISC FINISHES<br>07 EXTERIOR<br>07 EXTERIOR<br>07 EXTERIOR<br>07 EXTERIOR<br>07 EXTERIOR<br>07 EXTERIOR<br>07 EXTERIOR  | AWP-3           CG-1           GC-2           PL-1           PL-2           PL-3           SS-1           STG           TP           ALUM           BK-1           BK-2           BK-3           GL-1   | FABRIC WRAPPED PANEL         FABRIC WRAPPED PANEL         CORNER GUARDS         CORNER GUARDS         PLASTIC LAMINATE         PLASTIC LAMINATE         PLASTIC LAMINATE         SOLID SURFACE         STAGE CURTAIN         TOLIET PARTITIONS         STOREFRONT AND CURTAIN WALL         BRICK         BRICK         GLAZING  | MOMENTUM<br>WALLANDCORNERGUARD.CC<br>KOROSEAL<br>WILSONART<br>WILSONART<br>WILSONART<br>WILSONART<br>KM FABRICS<br>ASI<br>KAWNEER<br>UPCHURCH KIMBROUGH /CLC<br>UPCHURCH KIMBROUGH /CLC<br>UPCHURCH KIMBROUGH /CLC  |
| 05 MISC FINISHES<br>05 MISC FINISHES<br>07 EXTERIOR<br>07 EXTERIOR<br>07 EXTERIOR<br>07 EXTERIOR<br>07 EXTERIOR<br>07 EXTERIOR<br>07 EXTERIOR<br>07 EXTERIOR   | AWP-3           CG-1           GC-2           PL-1           PL-2           PL-3           SS-1           STG           TP           ALUM           BK-1           BK-2           BK-3           GL-1           GL-2  | FABRIC WRAPPED PANEL         FABRIC WRAPPED PANEL         CORNER GUARDS         CORNER GUARDS         PLASTIC LAMINATE         PLASTIC LAMINATE         PLASTIC LAMINATE         SOLID SURFACE         STAGE CURTAIN         TOLIET PARTITIONS         STOREFRONT AND CURTAIN WALL         BRICK         BRICK         GLAZING         GLAZING  | MOMENTUM WALLANDCORNERGUARD.CC KOROSEAL WILSONART WILSONART WILSONART WILSONART KM FABRICS ASI KAWNEER UPCHURCH KIMBROUGH /CLC UPCHURCH KIMBROUGH /CLC UPCHURCH KIMBROUGH /CLC INSULATTED TINTED SAFETY INS. CHILDGARD GLAZING (TE  |
| 05 MISC FINISHES<br>05 MISC FINISHES<br>07 EXTERIOR<br>07 EXTERIOR<br>07 EXTERIOR<br>07 EXTERIOR<br>07 EXTERIOR<br>07 EXTERIOR<br>07 EXTERIOR<br>07 EXTERIOR<br>07 EXTERIOR  | AWP-3           CG-1           GC-2           PL-1           PL-2           PL-3           SS-1           STG           TP           ALUM           BK-1           BK-2           BK-3           GL-1           GL-2A   | FABRIC WRAPPED PANEL         FABRIC WRAPPED PANEL         CORNER GUARDS         CORNER GUARDS         PLASTIC LAMINATE         PLASTIC LAMINATE         PLASTIC LAMINATE         SOLID SURFACE         STAGE CURTAIN         TOLIET PARTITIONS         STOREFRONT AND CURTAIN WALL         BRICK         BRICK         GLAZING         GLAZING  | MOMENTUM<br>WALLANDCORNERGUARD.CO<br>KOROSEAL<br>WILSONART<br>WILSONART<br>WILSONART<br>WILSONART<br>KM FABRICS<br>ASI<br>KAWNEER<br>UPCHURCH KIMBROUGH /CLO<br>UPCHURCH KIMBROUGH /CLO<br>UPCHURCH KIMBROUGH /CLO<br>INSULATTED TINTED SAFETY<br>INS. CHILDGARD GLAZING (TE<br>INS. CHILDGARD GLAZING (TE  |
| 05 MISC FINISHES<br>05 MISC FINISHES<br>07 EXTERIOR<br>07 EXTERIOR  | AWP-3           CG-1           GC-2           PL-1           PL-2           PL-3           SS-1           STG           TP           ALUM           BK-1           BK-2           BK-3           GL-1           GL-2A           GL-3  | FABRIC WRAPPED PANEL         CORNER GUARDS         CORNER GUARDS         PLASTIC LAMINATE         PLASTIC LAMINATE         PLASTIC LAMINATE         PLASTIC LAMINATE         SOLID SURFACE         STAGE CURTAIN         TOLIET PARTITIONS         STOREFRONT AND CURTAIN WALL         BRICK         BRICK         GLAZING         GLAZING         GLAZING  | MOMENTUM<br>WALLANDCORNERGUARD.CO<br>KOROSEAL<br>WILSONART<br>WILSONART<br>WILSONART<br>WILSONART<br>KM FABRICS<br>ASI<br>KAWNEER<br>UPCHURCH KIMBROUGH /CLC<br>UPCHURCH KIMBROUGH /CLC<br>UPCHURCH KIMBROUGH /CLC<br>UPCHURCH KIMBROUGH /CLC<br>INSULATTED TINTED SAFETY<br>INS. CHILDGARD GLAZING (TE<br>INS. CHILDGARD GLAZING (TE<br>CLEAR SAFETY (TEMPERED)  |
| 05 MISC FINISHES<br>05 MISC FINISHES<br>07 EXTERIOR<br>07 EXTERIOR  | AWP-3           CG-1           GC-2           PL-1           PL-2           PL-3           SS-1           STG           TP           ALUM           BK-1           BK-2           BK-3           GL-1           GL-2           GL-3           GL-4                                | FABRIC WRAPPED PANEL         FABRIC WRAPPED PANEL         CORNER GUARDS         CORNER GUARDS         PLASTIC LAMINATE         PLASTIC LAMINATE         PLASTIC LAMINATE         SOLID SURFACE         STAGE CURTAIN         TOLIET PARTITIONS         STOREFRONT AND CURTAIN WALL         BRICK         BRICK         GLAZING         GLAZING  | MOMENTUM<br>WALLANDCORNERGUARD.CO<br>KOROSEAL<br>WILSONART<br>WILSONART<br>WILSONART<br>WILSONART<br>KM FABRICS<br>ASI<br>KAWNEER<br>UPCHURCH KIMBROUGH /CLO<br>UPCHURCH KIMBROUGH /CLO<br>UPCHURCH KIMBROUGH /CLO<br>INSULATTED TINTED SAFETY<br>INS. CHILDGARD GLAZING (TE<br>INS. CHILDGARD GLAZING (TE  |
| 05 MISC FINISHES<br>05 MISC FINISHES<br>07 EXTERIOR<br>07 EXTERIOR  | AWP-3           CG-1           GC-2           PL-1           PL-2           PL-3           SS-1           STG           TP           ALUM           BK-1           BK-2           BK-3           GL-1           GL-2           GL-3           GL-4           GL-5                 | FABRIC WRAPPED PANEL         FABRIC WRAPPED PANEL         CORNER GUARDS         CORNER GUARDS         PLASTIC LAMINATE         PLASTIC LAMINATE         PLASTIC LAMINATE         SOLID SURFACE         STAGE CURTAIN         TOLIET PARTITIONS         STOREFRONT AND CURTAIN WALL         BRICK         BRICK         GLAZING         GLAZING         GLAZING         GLAZING         GLAZING         GLAZING         GLAZING         GLAZING  | MOMENTUM<br>WALLANDCORNERGUARD.CC<br>KOROSEAL<br>WILSONART<br>WILSONART<br>WILSONART<br>WILSONART<br>WILSONART<br>KM FABRICS<br>ASI<br>KAWNEER<br>UPCHURCH KIMBROUGH /CLC<br>UPCHURCH KIMBROUGH /CLC<br>UPCHURCH KIMBROUGH /CLC<br>UPCHURCH KIMBROUGH /CLC<br>UPCHURCH KIMBROUGH /CLC<br>INSULATTED TINTED SAFETY<br>INS. CHILDGARD GLAZING (TE<br>CLEAR SAFETY (TEMPERED)<br>CHILDGARD GLAZING   |
| 05 MISC FINISHES<br>05 MISC FINISHES<br>07 EXTERIOR<br>07 EXTERIOR  | AWP-3           CG-1           GC-2           PL-1           PL-2           PL-3           SS-1           STG           TP           ALUM           BK-1           BK-2           BK-3           GL-1           GL-2           GL-3           GL-4                                | FABRIC WRAPPED PANEL         FABRIC WRAPPED PANEL         CORNER GUARDS         CORNER GUARDS         PLASTIC LAMINATE         PLASTIC LAMINATE         PLASTIC LAMINATE         SOLID SURFACE         STAGE CURTAIN         TOLIET PARTITIONS         STOREFRONT AND CURTAIN WALL         BRICK         BRICK         GLAZING         GLAZING         GLAZING         GLAZING         GLAZING  | MOMENTUM<br>WALLANDCORNERGUARD.CC<br>KOROSEAL<br>WILSONART<br>WILSONART<br>WILSONART<br>WILSONART<br>WILSONART<br>KM FABRICS<br>ASI<br>KAWNEER<br>UPCHURCH KIMBROUGH /CLC<br>UPCHURCH KIMBROUGH /CLC<br>UPCHURCH KIMBROUGH /CLC<br>UPCHURCH KIMBROUGH /CLC<br>UPCHURCH KIMBROUGH /CLC<br>INSULATTED TINTED SAFETY<br>INS. CHILDGARD GLAZING (TE<br>CLEAR SAFETY (TEMPERED)<br>CHILDGARD GLAZING   |
| 05 MISC FINISHES<br>05 MISC FINISHES<br>07 EXTERIOR<br>07 EXTERIOR  | AWP-3           CG-1           GC-2           PL-1           PL-2           PL-3           SS-1           STG           TP           ALUM           BK-1           BK-2           BK-3           GL-1           GL-2           GL-3           GL-4           GL-5                 | FABRIC WRAPPED PANEL         FABRIC WRAPPED PANEL         CORNER GUARDS         CORNER GUARDS         PLASTIC LAMINATE         PLASTIC LAMINATE         PLASTIC LAMINATE         SOLID SURFACE         STAGE CURTAIN         TOLIET PARTITIONS         STOREFRONT AND CURTAIN WALL         BRICK         BRICK         GLAZING         GLAZING         GLAZING         GLAZING         GLAZING         GLAZING         GLAZING         GLAZING  | MOMENTUM<br>WALLANDCORNERGUARD.CC<br>KOROSEAL<br>WILSONART<br>WILSONART<br>WILSONART<br>WILSONART<br>WILSONART<br>KM FABRICS<br>ASI<br>KAWNEER<br>UPCHURCH KIMBROUGH /CLC<br>UPCHURCH KIMBROUGH /CLC<br>UPCHURCH KIMBROUGH /CLC<br>UPCHURCH KIMBROUGH /CLC<br>UPCHURCH KIMBROUGH /CLC<br>INSULATTED TINTED SAFETY<br>INS. CHILDGARD GLAZING (TE<br>CLEAR SAFETY (TEMPERED)<br>CHILDGARD GLAZING   |
| 05 MISC FINISHES<br>05 MISC FINISHES<br>07 EXTERIOR<br>07 EXTERIOR | AWP-3           CG-1           GC-2           PL-1           PL-2           PL-3           SS-1           STG           TP           ALUM           BK-1           BK-2           BK-3           GL-1           GL-2A           GL-3           GL-4           GL-5           GL-6 | FABRIC WRAPPED PANEL         FABRIC WRAPPED PANEL         CORNER GUARDS         CORNER GUARDS         PLASTIC LAMINATE         PLASTIC LAMINATE         PLASTIC LAMINATE         SOLID SURFACE         STAGE CURTAIN         TOLIET PARTITIONS         STOREFRONT AND CURTAIN WALL         BRICK         BRICK         BRICK         GLAZING  | MOMENTUM<br>WALLANDCORNERGUARD.CO<br>KOROSEAL<br>WILSONART<br>WILSONART<br>WILSONART<br>WILSONART<br>KM FABRICS<br>ASI<br>KAWNEER<br>UPCHURCH KIMBROUGH /CLC<br>UPCHURCH KIMBROUGH /CLC<br>UPCHURCH KIMBROUGH /CLC<br>UPCHURCH KIMBROUGH /CLC<br>INSULATTED TINTED SAFETY<br>INS. CHILDGARD GLAZING (TE<br>INS. CHILDGARD GLAZING (TE<br>CLEAR SAFETY (TEMPERED)<br>CHILDGARD GLAZING<br>SHADOWBOX - INS. TENTED S                          |
| 05 MISC FINISHES<br>05 MISC FINISHES<br>07 EXTERIOR<br>07 EXTERIOR  | AWP-3           CG-1           GC-2           PL-1           PL-2           PL-3           SS-1           STG           TP           ALUM           BK-1           BK-2           BK-3           GL-1           GL-2           GL-3           GL-5           GL-6           MP-1  | FABRIC WRAPPED PANEL         CORNER GUARDS         CORNER GUARDS         PLASTIC LAMINATE         PLASTIC LAMINATE         PLASTIC LAMINATE         SOLID SURFACE         STAGE CURTAIN         TOLIET PARTITIONS         STOREFRONT AND CURTAIN WALL         BRICK         BRICK         GLAZING         GLAZING | MOMENTUM<br>WALLANDCORNERGUARD.CO<br>KOROSEAL<br>WILSONART<br>WILSONART<br>WILSONART<br>WILSONART<br>WILSONART<br>KM FABRICS<br>ASI<br>KAWNEER<br>UPCHURCH KIMBROUGH /CLC<br>UPCHURCH KIMBROUGH /CLC<br>UPCHURCH KIMBROUGH /CLC<br>UPCHURCH KIMBROUGH /CLC<br>INSULATTED TINTED SAFETY<br>INS. CHILDGARD GLAZING (TE<br>INS. CHILDGARD GLAZING (TE<br>CLEAR SAFETY (TEMPERED)<br>CHILDGARD GLAZING<br>SHADOWBOX - INS. TENTED S<br>BERRIDGE |


- 25. REFER TO FINISH SCHEDULE FOR CT GROUT TYPE IN ALL BATHROOM AND KITCHEN AREAS. 26. ALL WALLS TO RECEIVE DRY ERASE WALLCOVERING TO BE LEVEL 5 FINISH. INSTALL ALUMINUM J TRIM AT PERIMETER. DRY ERASE WALLCOVERING SHOULD BE WRITABLE AND PROJECTABLE.
- 27. ALL FINE FISSURED CEILING TO BE 0.70 NRC

|    |  | MATERIAL  |   |   |   |
|----|--|---|---|---|---|
|    | MANUFACTURER   | STYLE   | COLOR   | SPECS   | REMARKS   |
|    |  |   |   |   |   |
|    | TARKETT  | TEXTURE MAP   | COLOR:42802 PICTOGRAM                                 | POWERBOND                                     | ADMINISTRATION, LIBRARY, COLLABORATION AND CLASSROOMS   |
|    | TARKETT  | SQUAREDUP II  | COLOR: CUSTOM 11537991-10                             | POWERBOND                                     | ACCENT  |
|    | STONHARD   | STONSHIELD  | COLOR: GLACIER  | MEDIUM TEXTURE                                | KITCHEN AND RESTROOM FLOORING   |
|    | TARKETT  | EVENT ABSTRACT  | COLOR: 11194 CHANTILLY                                | 12" X 24"                                     | WHERE APPLICABLE  |
|    |  |   |   |   | MEZZANINE, STAIRS   |
|    | TM SUPPLY, THICK SET                                       | CEMENT TERRAZZO   | COLOR: REFER TO CONTROL SAMPLE                        | THICK SET                                     | MAIN CORRIDORS  |
|    | TM SUPPLY, THICK SET                                       | CEMENT TERRAZZO   | COLOR: REFER TO CONTROL SAMPLE                        | THICK SET                                     | ACCENT AT CORRIDORS   |
|    | ARMSTRONG  | STANDARD EXCELON IMPERIAL TEXTURE                                   | COLOR: SOFT WARM GRAY                                 | 12" X 12"                                     | FIELD VCT, NEUTRAL  |
|    | ARMSTRONG  |   |   | 12" X 12"                                     | ACCENT VCT, ACCENT BLUE   |
|    | ARMSTRONG  | STANDARD EXCELON IMPERIAL TEXTURE STANDARD EXCELON IMPERIAL TEXTURE | COLOR: CLASSIC BLACK COLOR: MID GRAYED BLUE           | 12" X 12"<br>12" X 12"                        | BLACK VCT<br>ACCENT SQUARES AT GYM  |
|    |  | SPECIES: MAPLE  | TO BE STAINED   |   | STAGE STEPS   |
|    | TARKETT  | ASSERTIVE ACTION  | COLOR: STEELWORK                                      |   | MAIN EXITS/ENTRANCE, DRINKING FOUNTAINS   |
|    | 1  |   |   |   |   |
|    |  |   |   |   | Τ   |
|    | STONHARD<br>TARKETT/JOHNSONITE                             | STONSHIELD<br>4" HEIGHT, TRADITIONAL                                | COLOR: GLACIER<br>COLOR:48 GREY                       | MEDIUM TEXTURE                                | FIELD RUBBER BASE   |
|    | TARKETT/JOHNSONITE   | 4" HEIGHT, TRADITIONAL<br>4" HEIGHT, TRADITIONAL                    | COLOR:40 BLACK  |   | AT STAGE  |
|    |  |   |   |   |   |
|    |  |   |   |   |   |
|    | SHERWIN WILLIAMS   |   | SW7648 BIG CHILL                                      |   | FIELD PAINT   |
|    | SHERWIN WILLIAMS<br>SHERWIN WILLIAMS                       |   | SW7652 MINERAL DEPOSIT<br>SW7019 GAUNTLET GRAY        |   | ACCENT<br>DOOR FRAMES   |
|    | SHERWIN WILLIAMS<br>SHERWIN WILLIAMS                       |   | SW/019 GAUNTLET GRAY<br>SW6487 CLOUDBURST             |   | BLUE  |
|    | SHERWIN WILLIAMS   |   | SW6278 TRICORN BLACK                                  |   | ACCENT, AT STAGE & RAMP   |
|    | MOMENTUM   | WALLCOVERING UPPERCASE  | COLOR: EDITION  |   | ACCENT AT LIBRARY, RECEPTION ACCENT   |
|    | MOMENTUM   | WALLCOVERING UPPERCASE  | COLOR: SYNTAX   |   | RECEPTION FIELD   |
|    | KOROSEAL   | DESERT SAND   | COLOR: GRAY ANGORA                                    |   | FIELD AT CLASSROOMS AND MAIN CORRIDORS  |
|    | KOROSEAL   | DESERT SAND   | COLOR: CUSTOM COLOR, KIP#49581                        | CUSTOM MATCHES P-4                            | TEACHING WALLS AT CLASSROOM   |
|    | KOROSEAL   | WALL TALKERS/MAG-RITE   | COLOR: WHITE  |   | WHERE APPLICABLE, TEACHING WALLS  |
|    | DALTILE  | FABRIC ART MODERN LINEAR  | COLOR: ML63 MEDIUM GRAY                               | 12" X 24"                                     | CORRIDOR WAINSCOT, AT 4' AFF  |
|    | DALTILE  | COLOR WHEEL LINEAR  | COLOR: DESERT GRAY                                    | 8" X 24"                                      | RESTROOM WALLS FIELD, SERVING LINE FIELD  |
|    | CROSSVILLE   | GLASS BLOX  | COLOR:VIVID TEAL                                      | 2" X 4" MOSAIC                                | RESTROOM ACCENT (BLUE) GLASS TILE   |
|    | CROSSVILLE   | GLASS BLOX  | COLOR:AQUA GLEAM                                      | 2" X 4" MOSAIC                                | SERVING COUNTER ACCENT  |
|    |  |   |   |   |   |
|    | CERTAINTEED  | BOX SERIES  | FINISH:8475 LIGHT PECAN                               |   | LIBRARY AND COLLABORATION   |
|    |  |   | COLOR: SW6258 TRICORN BLACK                           |   | PAINTED   |
|    |  |   |   |   | PAINTED   |
|    | ARMSTRONG  | FINE FISSURED   | WHITE   | 24" X 24"                                     | CLASSROOMS, REFER TO RCP  |
| СК | CERTAINTEED  | VINYL FACED GYPSUM BOARD  | WHITE   | 24" X 24"                                     | RESTROOMS, KITCHEN AND SERVING LINE<br>STAGE /PLATFORM  |
|    |  |   |   |   |   |
|    |  |   |   |   |   |
|    | BOD: MODERNFOLD  | ACOUSTI-SEAL PREMIER/ELECTRIC PARTITION 9334E                       | FINISH: PREMIUM VINYL                                 |   | CUSTOM FINISH PER ARCHITEGT<br>MAIN CORRIDOR, LIBRARY, DINING AND GYM, ALL PANELS TO BE 2" THIC |
|    | MOMENTUM   | FELTRO  | COLOR: CLOUD  |   | MAIN CORRIDOR, LIBRARY, DINING AND GYM, ALL PANELS TO BE 2" THIC<br>UNLESS OTHERWISE NOTED      |
|    | MOMENTUM   | FELTRO  | COLOR: SLATE  |   | MAIN CORRIDOR, LIBRARY, DINING AND GYM, ALL PANELS TO BE 2" THIC                                |
|    |  |   |   |   | UNLESS OTHERWISE NOTED  |
|    | MOMENTUM   | FELTRO  | COLOR: SPA  |   | MAIN CORRIDOR, LIBRARY, DINING AND GYM, ALL PANELS TO BE 2" THIC                                |
|    |  |   |   | Č   | UNLESS OTHERWISE NOTED  |
|    | WALLANDCORNERGUARD.COM<br>KOROSEAL                         | THE INVISIBLE CORNERGUARD<br>KOROGARD SERIES GS40                   | COLOR: CLEAR<br>FINISH: STAINLESS STEEL, MATTE FINISH |   | AT KITCHEN ONLY   |
|    | WILSONART  | STANDARD LAMINATE   | COLOR: 7986-38 PASADENA OAK                           | FINE VELVET FINISH                            | CASE WORK, DOORS  |
|    | WILSONART  |   | COLOR:Y0835-60, RENDEZVOUS                            | MATTE FINISH                                  | ACCENT PLAM   |
|    | WILSONART  | STANDARD LAMINATE   | COLOR: 4942-38, CRISP LINEN                           | FINE VELVET FINISH                            | COUNTERTOPS   |
|    | WILSONART  | SOLID SURFACE   | COLOR: CALMING WAVES                                  |   | COUNTERTOPS WHERE APPLICABLE  |
|    | KM FABRICS   | MEMORABLE   | COLOR: TBD  |   | STAGE   |
|    | ASI  | SOLID PLASTICS, HDPE  | COLOR: CHARCOAL                                       | PEBBLE GRAINED TEXTURE                        | RESTROOMS   |
|    |  |   |   |   |   |
|    | KAWNEER  |   | CHAMPAGNE   |   | 379A1455 PERMADIZE  |
|    | UPCHURCH KIMBROUGH /CLOUD CERAMICS                         |   | ASH GRAY  | KING SIZE, VELOUR                             | FILLED  |
|    | UPCHURCH KIMBROUGH /CLOUD CERAMICS                         |   | CORONADO  | KING SIZE, VELOUR                             | STACKED BOND  |
|    | UPCHURCH KIMBROUGH /CLOUD CERAMICS                         |   | GREY BLEND  | KING SIZE, VELOUR                             | STRIPES   |
|    | INSULATTED TINTED SAFETY (TEMPERED)                        |   |   |   |   |
|    | INS. CHILDGARD GLAZING (TEMPERED)                          |   |   |   |   |
|    | INS. CHILDGARD GLAZING (TEMPERED) FROSTED                  |   |   |   |   |
|    |  |   |   |   |   |
|    | CHILDGARD GLAZING<br>SHADOWBOX - INS. TENTED SAFETY (TEMP) |   |   |   |   |
|    | UIRDUWDUR - INU. IEINIEU ORFEIT (IEINP)                    |   |   |   |   |
| S  | BERRIDGE   | HS-8, HS-12, HR-4, HR-16  | CHAMPAGNE   |   | KYNAR 500   |
|    | KINGSPAN   | QUADCORE OPTIMO SMOOTH  | DARK BRONZE - PREMIUM COLOR                           |   | SHERWIN-WILLIAMS® FLUROPON® CLASSIC - 70% PVDF METALLIC COL                                     |
|    | CERTAINTEED  | BOX SERIES - EXTERIOR   | FINISH:8475 LIGHT PECAN                               | LAMINATE FILM, WOOD FINISH                    | AT SOFFIT   |
|    | UPCHURCH KIMBOROUGH  | FINNEY VALLEY CHOPPED STONE BLEND COURSED                           | ASHLAR PATTERN  | 3-5" THICK X 4" SAWN HEIGHTS X RANDOM LENGTHS |   |

FINNEY VALLEY CHOPPED STONE BLEND COURSED

ASHLAR PATTERN

3-5" THICK X 4" SAWN HEIGHTS X RANDOM LENGTHS AT LIBRARY

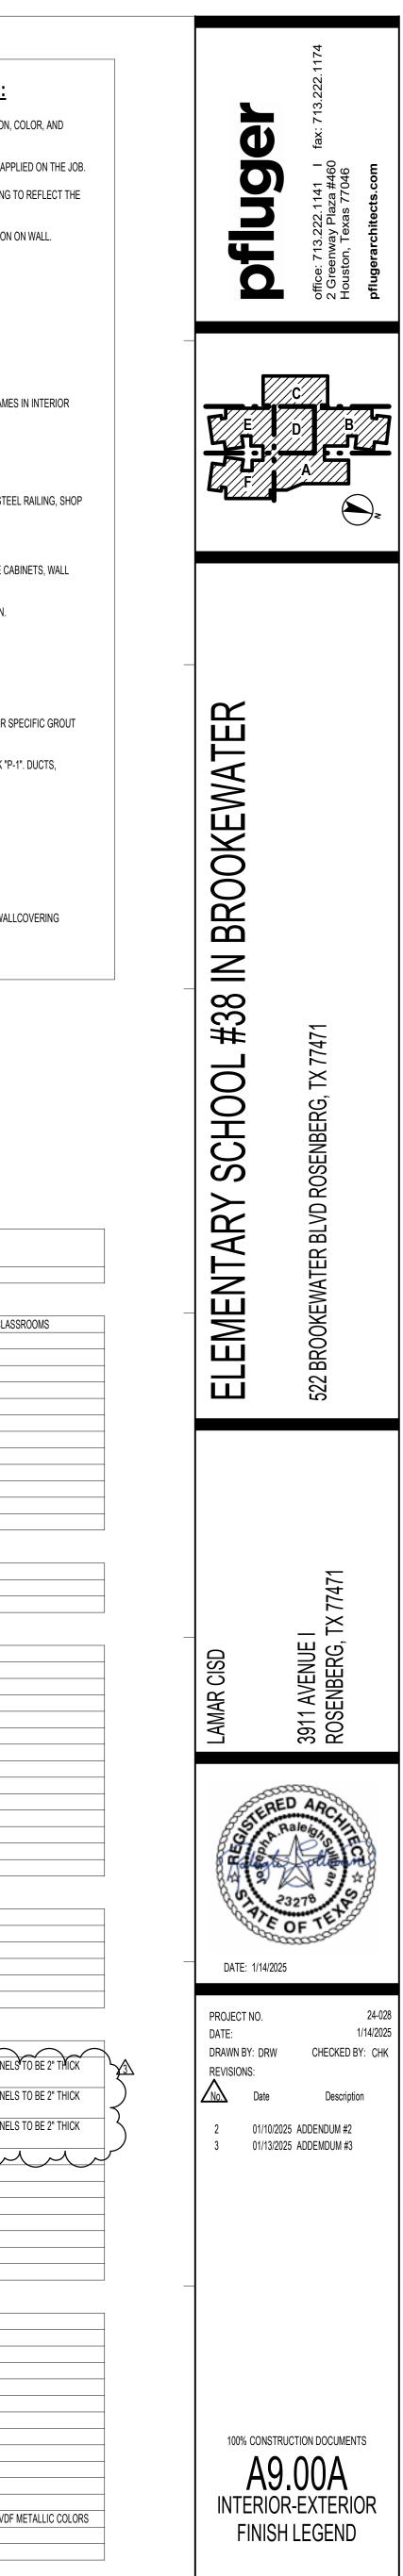

|                       |                                   |                                |              |                                    |                             |                         | T FLOOR - AREA                           | Α                        |   |                       |                                      |                                |              | ROOM                     | FINISH SCHE                          | DULE - FIRST I                   | FLOOR - ARE                          | A D                  |   |
|-----------------------|-----------------------------------|--------------------------------|--------------|------------------------------------|-----------------------------|-------------------------|--|--------------------------|---|-----------------------|--------------------------------------|--------------------------------|--------------|--------------------------|--------------------------------------|----------------------------------|--------------------------------------|----------------------|---|
|                       |                                   |                                |              |                                    | WALI                        |                         |  |                          |   |                       |                                      |                                |              |                          | WA                                   | -                                |                                      | CEILING              |   |
| <b>ROOM #</b><br>A100 | ROOM NAME<br>VESTIBULE            | FLOOR     WF-1                 | BASE<br>RB-1 | <b>NORTH</b><br>GLAZING            | EAST<br>WT-1/GRAPHIC ABOVE  | <b>SOUTH</b><br>GLAZING | WEST<br>VWC-1                            | CEILIING<br>SAP-1        | REMARKS VWC-1 FLOOR TO CEILING ON WEST WALL   | <b>ROOM #</b><br>D100 | CORRIDOR                             | FLOOR<br>T-2, WF-1             | BASE         | P-1                      | P-1                                  | <b>SOUTH</b><br>WT-1, VWC-3, P-1 | P-1                                  | FINISH<br>SAP-1, GYP | REMARKS           SEE INT. ELEVATION  |
| A100A<br>A101         | RR VESTIBULE<br>PARENTS VOLUNTEER | WF-1<br>R CPT-2                | -<br>RB-1    | WT-1, P-1<br>VWC-3/DIGITAL GRAPHIC | -<br>VWC-3, P-1             | WT-1, P-1<br>GLAZING    | WT-1, P-1<br>VWC-3, P-1                  | SAP-1<br>AWC. GYP        | VWC-3 UP TO 8', AWP ON EAST & WEST WALLS, MOTORIZED ROLLER SHADES AT EXTERIOR WALL  | D100A<br>D101         | TLT VESTIBULE<br>CORRIDOR            | EPF-1                          | EPB          | WT-3<br>WT-1, VWC-3, P-1 | WT-2, P-4                            | WT-2, P-4<br>WT-1, VWC-3, P-1-   | WT-2, P-4                            | GYP<br>SAP-1         | SEE INT. ELEVATION, TILE TO ALIGN WITH TOP OF DOOR, SEE ELEVATIONS<br>SEE INT. ELEVATION                        |
| A102                  | RR                                | EPF-1                          | EPB          | WT-3                               | WT-2                        | WT-2                    | WT-2                                     | SAP-2                    | WALL TILE FLOOR TO CEILING  | D102                  | CUSTODIAN OFFICE                     | VCT-1                          | RB-1         | P-1                      | P-1                                  | P-1                              | P-1                                  | SAP-1                |   |
| A103<br>A104          | CORRIDOR<br>RECEPTION             | T-1, T-2, CPT-1, WF-1<br>CPT-1 | -<br>RB-1    | -<br>VWC-2                         | WT-1, WVC-3, P-1<br>VWC-2   | GLAZING<br>P-1          | REFER TO ELEVATION<br>VWC-2              | SAP-1, GYP<br>SAP-1, GYP | AWP ON WALLS REFER TO INTERIOR ELEVATIONS FOR TILE \$ VWC-3 LOCATIONS           NO WALLCOVERING AT EXTERIOR WALL, REFER TO INTERIOR ELEVATIONS FOR CASEWORK         | D103<br>D104          | IDF<br>RESOURCE                      | SC-1<br>LVT-1                  | RB-1<br>RB-1 | P-1<br>VWC-3, CASEWORK   | P-1<br>VWC-4                         | P-1<br>VWC-3                     | P-1<br>VWC-3                         | SAP-1<br>SAP-1       | REFER TO ELEVATIONS FOR CASEWORK AND TEACHING WALL  |
| A105<br>A106          | SECRETARY<br>A. PRINCIPAL         | CPT-1<br>CPT-1                 | RB-1<br>RB-1 | VWC-3<br>VWC-3                     | VWC-3<br>VWC-3              | P-1<br>P-1              |  | SAP1<br>SAP-1            | NO WALLCOVERING AT EXTERIOR WALL, REFER TO INTERIOR ELEVATIONS FOR CASEWORK<br>NO WALLCOVERING AT EXTERIOR WALL, REFER TO INTERIOR ELEVATIONS FOR CASEWORK          | D105<br>D106          | RR                                   | EPF-1<br>EPF-1                 | EPB<br>EFB   | WT-2<br>WT-2             | WT-2<br>WT-3                         | WT-2<br>WT-2                     | WT-3<br>WT-2                         | SAP-2<br>SAP-2       | WALL TILE FLOOR TO CEILING<br>WALL TILE FLOOR TO CEILING  |
| 107                   | CONFERENCE                        | CPT-1                          | RB-1         | VWC-3                              | VWC-3                       | P-1                     | VWC-3                                    | SAP-1                    | NO WALLCOVERING AT EXTERIOR WALL, REFER TO INTERIOR ELEVATIONS FOR CASEWORK   | D107                  | STAIR                                | SC-1                           | RB-1         | P-1                      | P-1                                  | P-1                              | P-1                                  | EXP                  |   |
| A108<br>A109          | PRINCIPAL<br>CLINIC               | CPT-1<br>LVT-1                 | RB-1<br>RB-1 | VWC-3<br>VWC-3                     | P-1<br>VWC-4                | P-1<br>VWC-3            |  | SAP-1<br>SAP-1           | NO WALLCOVERING AT EXTERIOR WALL, REFER TO INTERIOR ELEVATIONS FOR CASEWORK<br>REFER TO ELEVATIONS FOR CASEWORK   | D108<br>D109          | SPEECH<br>SPED                       | CPT-2<br>LVT-1                 | RB-1<br>RB-1 | VWC-3<br>VWC-4           | VWC-3<br>VWC-3                       | VWC-3<br>VWC-3                   | VWC-3<br>VWC-3                       | SAP-1<br>SAP-1       | REFER TO ELEVATIONS FOR CASEWORK           REFER TO ELEVATIONS FOR CASEWORK AND TEACHING WALL                   |
| A110<br>A111          | RR<br>STO.                        | EPF-1<br>VCT-1                 | EPB<br>RB-1  | WT-2<br>P-1                        | WT-3/WT-2<br>P-1            | WT-2<br>P-1             |  | SAP-2<br>SAP-1           | WALL TILE FLOOR TO CEILING<br>MS-3 SHELVES IN THIS LOCATION   | D110<br>D111          | RR<br>MAINTENANCE STORAGE            | EPF-1<br>VCT-1                 | EPB<br>RB-1  | WT-2<br>P-1              | WT-2<br>P-1                          | WT-3<br>P-1                      | WT-2<br>P-1                          | SAP-2<br>SAP-1       | WALL TILE FLOOR TO CEILING  |
| A112                  | EXAM/ISO                          | LVT-1                          | RB-1         | VWC-3                              | VWC-4                       | VWC-3                   | VWC-3                                    | SAP-1                    |   | D112                  | SPED OFFICE                          | CPT-2                          | RB-1         | VWC-3                    | VWC-3                                | VWC-3                            | VWC-3                                | SAP-1                | REFER TO ELEVATIONS FOR CASEWORK  |
| A113<br>A114          | COT<br>CORRIDOR                   | LVT-1<br>CPT-1, WF-1           | RB-1<br>RB-1 | VWC-3<br>VWC-3                     | VWC-4<br>VWC-3              | VWC-3<br>VWC-3          | VWC-3<br>VWC-3                           | SAP-1<br>SAP-1, GYP      | REFER TO ELEVATIONS FOR CASEWORK  | D113<br>D114          | SPED OFFICE<br>SPED                  | CPT-2<br>LVT-1                 | RB-1<br>RB-1 | VWC-3<br>VWC-3           | VWC-3<br>VWC-3                       | VWC-3<br>VWC-4                   | VWC-3<br>VWC-3                       | SAP-1<br>SAP-1       | REFER TO ELEVATIONS FOR CASEWORK<br>REFER TO ELEVATIONS FOR CASEWORK AND TEACHING WALL                          |
| 115<br>116            | SECURITY                          | CPT-1<br>EPF-1                 | RB-1<br>EPB  | VWC-3<br>WT-2                      | VWC-3<br>WT-3               | VWC-3<br>WT-2           | VWC-3<br>WT-2                            | SAP-1<br>SAP-2           | REFER TO ELEVATIONS FOR CASEWORK. WEAPON RACK IN THIS ROOM<br>WALL TILE FLOOR TO CEILING  | D115<br>D116          | SPED<br>ESL COACH                    | LVT-1<br>CPT-2                 | RB-1<br>RB-1 | VWC-3<br>VWC-3           | VWC-3<br>VWC-3                       | VWC-4<br>VWC-3                   | VWC-3<br>VWC-3                       | SAP-1<br>SAP-1       | REFER TO ELEVATIONS FOR CASEWORK AND TEACHING WALL<br>REFER TO ELEVATIONS FOR CASEWORK                          |
| 117                   | RR                                | EPF-1                          | EPB          | WT-2<br>P-1                        | WT-2<br>P-1                 | WT-2<br>P-1             | WT-3                                     | SAP-2                    | WALL TILE FLOOR TO CEILING  | D117                  | RR                                   | EPF-1                          | EPB          | WT-2                     | WT-2                                 | WT-2                             | WT-3                                 | SAP-2                | WALL TILE FLOOR TO CEILING  |
| 118<br>119            | VAULT / FILES<br>STORAGE          | VCT-1<br>VCT-1                 | RB-1<br>RB-1 | P-1<br>P-1                         | P-1<br>P-1                  | P-1<br>P-1              | P-1<br>P-1                               | SAP-1<br>SAP-1           | VAULT, MS-2 & 3 IN THIS ROOM  | D118<br>D119          | SPED VEST<br>STO.                    | VCT-1<br>VCT-1                 | RB-1<br>RB-1 | VWC-3<br>P-1             | VWC-3<br>P-1                         | VWC-3<br>P-1                     | VWC-3<br>P-1                         | SAP-1<br>SAP-1       |   |
| 120<br>121            | MDF<br>LOUNGE                     | SC-1<br>LVT-1                  | RB-1<br>RB-1 | P-1<br>P-1                         | P-1<br>P-1                  | P-1<br>VWC-3            | P-1<br>VWC-3                             | EXP<br>SAP-1             | NO WALLCOVERING AT EXTERIOR WALL, REFER TO INTERIOR ELEVATIONS FOR CASEWORK   | D120<br>D121          | ESL COACH<br>RR                      | CPT-2<br>EPF-1                 | RB-1<br>EPB  | VWC-3<br>WT-2            | VWC-3<br>WT-2                        | VWC-3<br>WT-3                    | VWC-3<br>WT-2                        | SAP-1<br>SAP-2       | REFER TO ELEVATIONS FOR CASEWORK<br>WALL TILE FLOOR TO CEILING  |
| 122                   | WORKROOM                          | LVT-1                          | RB-1         | P-1                                | VWC-3                       | VWC-3                   | VWC-3                                    | SAP-1                    | NO WALLCOVERING AT EXTERIOR WALL, REFER TO INTERIOR ELEVATIONS FOR CASEWORK   | D122<br>D123          | SPED                                 | LVT-1                          | RB-1         | VWC-4                    | VWC-3                                | VWC-3                            | VWC-3                                | SAP-1                | REFER TO ELEVATIONS FOR CASEWORK AND TEACHING WALL  |
| 23<br>24              | COUNSELOR<br>COUNSELOR            | CPT-1                          | RB-1<br>RB-1 | VWC-3                              | VWC-3<br>VWC-3              | VWC-3<br>VWC-3          | VWC-3<br>VWC-3                           | SAP-1<br>SAP-1           | NO WALLCOVERING AT EXTERIOR WALL, REFER TO INTERIOR ELEVATIONS FOR CASEWORK<br>REFER TO ELEVATIONS FOR CASEWORK   | D123                  | SPED                                 | LVI-1                          | KB-1         | VWC-4                    | VWC-3                                | VWC-3                            | VWC-3                                | SAP-1                | REFER TO ELEVATIONS FOR CASEWORK AND TEACHING WALL  |
| 25<br>26              | ELEC<br>ART                       | (SEALED CONCRETE )             | RB-1<br>RB-1 | P1<br>VWC-4                        | P1<br>P-1                   | P1<br>VWC-3             | 11                                       | EXP<br>SAP-1             | REFER TO ELEVATION FOR TEACHING WALL & CASEWORK, NO WALL COVERING AT EXTERIOR   |                       |                                      |                                |              |                          |                                      |                                  |                                      |                      |   |
| 27                    | CORRIDOR                          | T-2                            | -            | WT-1, VWC-3, P-1                   | -                           | WT-1, VWC-3, P-1        | -  | SAP-1                    | WALL<br>REFER TO ELEVATIONS   |                       |                                      |                                |              | ROOM                     | FINISH SCHE                          | DULE - FIRST I                   | FLOOR - ARE                          | AE                   |   |
| 8                     | FLEX                              | CPT-2                          | RB-1         | VWC-3                              | VWC-3                       | VWC-3                   | VWC-4                                    | SAP-1, GYP               | REFER TO TEACHING WALL ELEVATION  |                       |                                      |                                |              | · -                      | WA                                   |                                  |                                      | CEILING              |   |
| 29<br>30              | KIVA<br>LARGE GROUP               | CPT-2<br>CPT-2                 | RB-1<br>RB-1 | VWC-4<br>VWC-4                     | VWC-3<br>VWC-3              | VWC-3<br>VWC-3          |  | SAP-1, GYP<br>SAP-1, GYP | REFER TO ELEVATION FOR TEACHING WALL         REFER TO ELEVATION FOR TEACHING WALL   | ROOM #                | ROOM NAME                            | FLOOR                          | BASE         | NORTH                    | EAST                                 | SOUTH                            | WEST                                 | FINISH               | REMARKS   |
| 31<br>32              | FLEX                              | CPT-2<br>CPT-1                 | RB-1<br>RB-1 | WC-3<br>REFER TO ELEVATION         | VWC-4<br>REFER TO ELEVATION | VWC-3<br>P-1            | VWC-3<br>REFER TO ELEVATION              | SAP-1, GYP               | REFER TO ELEVATION FOR TEACHING WALL<br>MOTORIZED ROLLER SHADES AT EXTERIOR WALL  | E100<br>E100          | CORRIDOR<br>CORRIDOR                 | T-1, T-2                       | -            | P-1                      | WT-1, VWC-3, P-1                     | -                                | WT-1, VWC-3, P-1                     | SAP-1, GYP           | SEE INT. ELEVATION  |
| 33                    | COMP STO.                         | VCT-1                          | RB-1         | P-1                                | P-1                         | P-1                     | P-1                                      | SAP-1                    |   | E100<br>E101<br>E102  | CORRIDOR                             | CPT-1, CPT-2. WF-1<br>CPT-2    | RB-1<br>RB-1 | WT-1, VWC-3, P-1         | WT-1, VWC-3, P-1<br>VWC-4            | WT-1, VWC-3, P-1                 | WT-1, VWC-3, P-1<br>VWC-4            | SAP-1, AWC, G        | P SEE INT. ELEVATION<br>SEE INT. ELEVATIONS   |
| 4<br>5                | AV STO.<br>COMPUTER LAB           | VCT-1<br>CPT-1                 | RB-1<br>RB-1 | P-1<br>VWC-4                       | P-1<br>VWC-3                | P-1<br>P-1              | P-1<br>VWC-3                             | SAP-1<br>SAP-1           | REFER TO ELEVATION FOR TEACHING WALL, MOTORIZED ROLLER SHADES AT EXTERIOR WALL  | E103                  | 5TH GRADE                            | CPT-1                          | RB-1         | -<br>P-4                 | VWC-3                                | -<br>VWC-3                       | P-1                                  | SAP-1                | REFER TO ELEVATIONS FOR CASEWORK AND TEACHING WALL  |
| 6                     | OFFICE                            | CPT-1/LVT-1                    | RB-1         | VWC-1                              | VWC-1                       | VWC-1                   | VWC-1                                    | SAP-1                    |   | E104<br>E105          | 4TH GRADE<br>4TH GRADE               | CPT-1<br>CPT-1                 | RB-1<br>RB-1 | VWC-3<br>VWC-3           | VWC-3<br>VWC-3                       | VWC-4<br>P-4                     | P-1<br>P-1                           | SAP-1                | REFER TO ELEVATIONS FOR CASEWORK AND TEACHING WALL<br>REFER TO ELEVATIONS FOR CASEWORK AND TEACHING WALL        |
|                       |                                   |                                |              |                                    |                             |                         |  |                          |   | E106<br>E107          | 4TH GRADE<br>4TH GRADE               | CPT-1<br>CPT-1                 | RB-1<br>RB-1 | P-4                      | VWC-3                                | P-1                              | VWC-3                                | SAP-1                | REFER TO ELEVATIONS FOR CASEWORK AND TEACHING WALL<br>REFER TO ELEVATIONS FOR CASEWORK AND TEACHING WALL        |
|                       |                                   |                                |              |                                    | ROOM FINISH S               | CHEDULE - FIRS          | T FLOOR - AREA                           | В                        |   | E108                  | 4TH GRADE                            | CPT-1                          | RB-1         | VWC-3<br>VWC-3           | VWC-4<br>VWC-3                       | P-1<br>VWC-3                     | VWC-3<br>VWC-4                       | SAP-1<br>SAP-1       | REFER TO ELEVATIONS FOR CASEWORK AND TEACHING WALL  |
|                       |                                   |                                |              |                                    | WAL                         |                         |  |                          |   | E109<br>E110          | 4TH GRADE<br>SCIENCE STO.            | CPT-1<br>VCT-1                 | RB-1<br>RB-1 | VWC-3<br>P-1             | VWC-4<br>P-1                         | VWC-3<br>P-1                     | VWC-3<br>P-1                         | SAP-1<br>SAP-1       | REFER TO ELEVATIONS FOR CASEWORK AND TEACHING WALL  |
| M #                   | ROOM NAME                         | FLOOR                          | BASE         | NORTH                              | EAST                        | SOUTH                   | WEST                                     | CEILING<br>FINISH        | REMARKS   | E111                  | CUSTODIAN STO.                       | SC-1                           | RB-1         | P-1                      | P-1                                  | P-1<br>P-1                       | P-1                                  | SAP-1                |   |
| 100                   | CORRIDOR                          | T-1, T-2<br>EPF-1              | -<br>EPB     | -<br>WT-2, P-4                     | SEE INT. ELEVATION          | -<br>REFER TO ELEVATION | SEE INT. ELEVATION<br>WT-2. P-4          | SAP-1, GYP               | WALL TILE UP TO TOP OF DOOR, REFER TO ELEVATIONS<br>WALL TILE UP TO TOP OF DOOR, REFER TO ELEVATIONS  | E112<br>E113          | BOOK ROOM<br>ELECTRICAL              | SC-1<br>SC-1                   | RB-1<br>RB-1 | P-1<br>P-1               | P-1<br>P-1                           | P-1                              | P-1<br>P-1                           | SAP-1<br>EXP         |   |
| 101                   | CORRIDOR                          | CPT-1, CPT-2, WF-1             | RB-1         | WT-2, F-4<br>WT-1, VWC-3           | WT-1, VWC-3                 | WT-1, VWC-3             | WT-1, VWC-3                              | SAP-1, GYP, AV           | WALL TILE UP TO TOP OF DOOR, REFER TO ELEVATIONS  | E114<br>E115          | TEACHER PREP<br>CUST. STO.           | VCT-1<br>SC-1                  | RB-1<br>RB-1 | VWC-3<br>P-1             | VWC-3<br>P-1                         | VWC-3<br>P-1                     | VWC-3<br>P-1                         | SAP-1 ZZ<br>SAP-2    |   |
| 102<br>02A            | COLLABORATION<br>COLLABORATION    | CPT-2<br>CPT-2, WF-1           | RB-1<br>RB-1 | -<br>SEE INT. ELEVATION            | SEE INT. ELEVATION          | -                       | SEE INT. ELEVATION<br>SEE INT. ELEVATION | AWC<br>AWC               | REFER TO ELEVATION FOR TEACHING WALL MARKER WALL AT THIS LOCATION   | E116<br>E117          | 5TH GRADE<br>5TH GRADE               | CPT-1<br>CPT-1                 | RB-1<br>RB-1 | P-1                      | VWC-4<br>VWC-4                       | VWC-3<br>VWC-3                   | VWC-3<br>VWC-3                       | SAP-1<br>SAP-1       | REFER TO ELEVATIONS FOR CASEWORK AND TEACHING WALL<br>REFER TO ELEVATIONS FOR CASEWORK AND TEACHING WALL        |
| 02A<br>103            | COLLABORATION<br>BOOK ROOM        | CPT-2, WF-1                    | RB-1<br>RB-1 | SEE INT. ELEVATION<br>P-1          | -<br>P-1                    | -<br>P-1                | SEE INT. ELEVATION<br>P-1                | AWC                      |   | E118                  | 5TH GRADE                            | CPT-1                          | RB-1         | P-1                      | VWC-3                                | VWC-3                            | VWC-4                                | SAP-1                | REFER TO ELEVATIONS FOR CASEWORK AND TEACHING WALL  |
| 104                   | DIAG.                             | CPT-1<br>SC-1                  | RB-1<br>RB-1 | VWC-3                              | VWC-3                       | VWC-3                   | VWC-3                                    | SAP-1                    | REFER TO ELEVATIONS FOR CASEWORK  | E119<br>E120          | 5TH GRADE<br>5TH GRADE               | CPT-1<br>CPT-1                 | RB-1<br>RB-1 | P-1<br>P-1               | VWC-4<br>VWC-3                       | VWC-3<br>VWC-3                   | VWC-3<br>VWC-4                       | SAP-1<br>SAP-1       | REFER TO ELEVATIONS FOR CASEWORK AND TEACHING WALL           REFER TO ELEVATIONS FOR CASEWORK AND TEACHING WALL |
| 105<br>106            | CUSTDODIAN STO.<br>ART STO.       | LVT-1                          | RB-1<br>RB-1 | P-1<br>P-1                         | P-1<br>P-1                  | P-1<br>P-1              | P-1<br>P-1                               | SAP-2<br>SAP-1           | REFER TO ELEVATIONS FOR CASEWORK  | E121<br>E121A         | TLT<br>TLT VEST                      | EPF-1<br>FPF-1                 | EPB<br>EPB   | WT-2<br>WT-3             | WT-2<br>WT-2,P-4                     | WT-2<br>WT-2,P-4                 | WT-3<br>WT-2, P-4                    | SAP-2                | WALL TILE FLOOR TO CEILING<br>WALL TILE UP TO TOP OF DOOR, REFER TO ELEVATIONS                                  |
| 107                   | 1ST GRADE                         | CPT-1                          | RB-1         | VWC-3                              | VWC-3                       | P-1                     | VWC-4                                    | SAP-1                    | NO WALLCOVERING AT EXTERIOR WALLS. REFER TO ELEVATIONS FOR CASEWORK AND TEACHING WALL   | E122                  | TLT                                  | EPF-1                          | EPB          | WT-2                     | WT-3                                 | WT-2                             | WT-2                                 | SAP-2                | WALL TILE FLOOR TO CEILING  |
| 108                   | 1ST GRADE                         | CPT-1                          | RB-1         | VWC-3                              | VWC-3                       | P-1                     | VWC-4                                    | SAP-1                    | NO WALLCOVERING AT EXTERIOR WALLS. REFER TO ELEVATIONS FOR CASEWORK AND TEACHING WALL   | E123<br>E123A         | TLT<br>TLT VEST                      | EPF-1<br>EPF-1                 | EPB<br>EPB   | WT-2<br>WT-2, P-4        | WT-2<br>WT-2, P-4                    | WT-2<br>WT-3                     | WT-3<br>WT-2, P-4                    | SAP-2<br>GYP         | WALL TILE FLOOR TO CEILING<br>WALL TILE UP TO TOP OF DOOR, REFER TO ELEVATIONS                                  |
| 109                   | 1ST GRADE                         | CPT-1                          | RB-1         | VWC-3                              | VWC-4                       | P-1                     | P-1                                      | SAP-1                    | NO WALLCOVERING AT EXTERIOR WALLS. REFER TO ELEVATIONS FOR CASEWORK AND TEACHING WALL   | E124<br>E125          | TLT<br>TI T                          | EPF-1<br>EPF-1                 | EPB<br>EPB   | WT-2<br>WT-2             | WT-3<br>WT-2                         | WT-2<br>WT-3                     | WT-2<br>WT-2                         | SAP-2<br>SAP-2       | WALL TILE FLOOR TO CEILING<br>WALL TILE FLOOR TO CEILING  |
| 110                   | 1ST GRADE                         | CPT-1                          | RB-1         | VWC-3                              | VWC-3                       | P-1                     | VWC-4                                    | SAP-1                    | NO WALLCOVERING AT EXTERIOR WALLS. REFER TO ELEVATIONS FOR CASEWORK AND<br>TEACHING WALL  | E126<br>E127          | TLT<br>CUST                          | EPF-1                          | EPB<br>RB-1  | WT-3                     | WT-2<br>P-1                          | WT-2<br>P-1                      | WT-2                                 | SAP-2<br>SAP-2       | WALL TILE FLOOR TO CEILING  |
| 11                    | 1ST GRADE                         | CPT-1                          | RB-1         | VWC-3                              | P-1                         | VWC-4                   | VWC-3                                    | SAP-1                    | NO WALLCOVERING AT EXTERIOR WALLS. REFER TO ELEVATIONS FOR CASEWORK AND   | E129                  | BOOK ROOM                            | SC-1                           | RB-1         | P-1<br>P-1               | P-1<br>P-1                           | P-1<br>P-1                       | P-1<br>P-1                           | SAP-2<br>SAP-1       | 2   |
| 112                   | 1ST GRADE                         | CPT-1                          | RB-1         | VWC-3                              | P-1                         | VWC-4                   | VWC-3                                    | SAP-1                    | TEACHING WALL NO WALLCOVERING AT EXTERIOR WALLS. REFER TO ELEVATIONS FOR CASEWORK AND   | E130<br>E131          | IDF<br>STORAGE                       | SEALED CONCRETE                | RB-1         | P-1<br>P-1               | P-1<br>P-1                           | P-1<br>P-1                       | P-1<br>P-1                           | SAP-1                |   |
| 113                   | KINDERGARTEN                      | CPT-1, LVT-1                   | RB1          | VWC-3                              | P-1                         | VWC-4                   | VWC-3                                    | SAP-1                    | TEACHING WALL<br>NO WALLCOVERING AT EXTERIOR WALLS. REFER TO ELEVATIONS FOR CASEWORK AND  |                       |                                      |                                |              |                          |                                      |                                  |                                      |                      |   |
| 14                    | KINDERGARTEN                      | CPT-1, LVT-1                   | RB-1         | VWC-4                              | P-1                         | VWC-3                   | VWC-3                                    | SAP-1                    | TEACHING WALL<br>NO WALLCOVERING AT EXTERIOR WALLS. REFER TO ELEVATIONS FOR CASEWORK AND  |                       |                                      |                                |              | ROOM                     | FINISH SCHE                          | DULE - FIRST I                   | FLOOR - ARE                          | A F                  |   |
|                       |                                   | CPT-1, LVT-1                   | RB-1         |                                    | P-1                         |                         |  | SAP-1                    | TEACHING WALL NO WALLCOVERING AT EXTERIOR WALLS. REFER TO ELEVATIONS FOR CASEWORK AND   |                       |                                      |                                |              |                          |                                      | ALLS                             |                                      | CEILING              |   |
| 115                   | KINDERGARTEN                      |                                |              | P-4                                | 1 - 1                       | VWC-3                   | VWC-3                                    | -                        | NO WALLCOVERING AT EXTERIOR WALLS. REFER TO ELEVATIONS FOR CASEWORK AND<br>TEACHING WALL<br>NO WALLCOVERING AT EXTERIOR WALLS. REFER TO ELEVATIONS FOR CASEWORK AND | ROOM #                | ROOM NAME                            | FLOOR                          | BASE         | NORTH                    | EAST                                 | SOUTH                            | WEST                                 | FINISH               | REMARKS   |
| 116                   | KINDERGARTEN                      | CPT-1, LVT-1                   | RB-1         | P-1                                | VWC-3                       | VWC-3                   | VWC-4                                    | SAP-1                    | TEACHING WALL   | F100<br>F101          | CORRIDOR<br>CORRIDOR                 | T-1, T-2<br>CPT-1, CPT-2, WF-1 | -<br>RB-1    | -<br>WT-1, VWC-3, P-1    | WT-1, VWC-3, P-1<br>WT-1, VWC-3, P-1 | -<br>WT-1, VWC-3, P-1            | WT-1, VWC-3, P-1<br>WT-1, VWC-3, P-1 |                      | SEE INT. ELEVATION       'P     SEE INT. ELEVATION  |
| 17                    | KINDERGARTEN                      | CPT-1, LVT-1                   | RB-1         | P-1                                | VWC-4                       | VWC-3                   | VWC-3                                    | SAP-1                    | NO WALLCOVERING AT EXTERIOR WALLS. REFER TO ELEVATIONS FOR CASEWORK AND TEACHING WALL   | F103<br>F104          | 3RD GRADE<br>3RD GRADE               | CPT-1<br>CPT-1                 | RB-1<br>RB-1 | VWC-4<br>VWC-4           | VWC-3<br>VWC-3                       | VWC-3<br>VWC-3                   | P-1<br>P-1                           | SAP-1                | REFER TO ELEVATIONS FOR CASEWORK AND TEACHING WALL         REFER TO ELEVATIONS FOR CASEWORK AND TEACHING WALL   |
| 18                    | KINDERGARTEN                      | CPT-1, LVT-1                   | RB-1         | VWC-3                              | VWC-3                       | P-1                     | VWC-4                                    | SAP-1                    | NO WALLCOVERING AT EXTERIOR WALLS. REFER TO ELEVATIONS FOR CASEWORK AND TEACHING WALL   | F105                  | 2ND GRADE                            | CPT-1                          | RB-1         | VWC-3                    | VWC-3                                | VWC-4                            | P-1                                  | SAP-1<br>SAP-1       | REFER TO ELEVATIONS FOR CASEWORK AND TEACHING WALL  |
| 19                    | PRE-K                             | CPT-1,LVT-1                    | RB-1         | P-1                                | VWC-3                       | VWC-3                   | VWC-4                                    | SAP-1                    | NO WALLCOVERING AT EXTERIOR WALLS. REFER TO ELEVATIONS FOR CASEWORK AND TEACHING WALL   | F106<br>F107          | 2ND GRADE<br>2ND GRADE               | CPT-1<br>CPT-1                 | RB-1<br>RB-1 | VWC-3<br>VWC-3           | VWC-3<br>VWC-4                       | P-1<br>P-1                       | VWC-4<br>VWC-4                       | SAP-1<br>SAP-1       | REFER TO ELEVATIONS FOR CASEWORK AND TEACHING WALL           REFER TO ELEVATIONS FOR CASEWORK AND TEACHING WALL |
| 20                    | RR<br>PRE-K                       | EPF-1<br>CPT-1, LVT-1          | EPB<br>RB-1  | WT-2<br>P-1                        | WT-2<br>VWC-4               | WT-2<br>VWC-3           | WT-3<br>VWC-3                            | SAP-2<br>SAP-1           | WALL TILE FLOOR TO CEILING<br>REFER TO ELEVATIONS FOR CASEWORK AND TEACHING WALL  | F108<br>F109          | 2ND GRADE<br>2ND GRADE               | CPT-1<br>CPT-1                 | RB-1<br>RB-1 | VWC-3<br>VWC-3           | VWC-4<br>VWC-3                       | P-1<br>P-1                       | VWC-3<br>VWC-4                       | SAP-1                | REFER TO ELEVATIONS FOR CASEWORK AND TEACHING WALL<br>REFER TO ELEVATIONS FOR CASEWORK AND TEACHING WALL        |
| 21<br>22              | RR                                | EPF-1                          | EPB          | WT-2                               | WT-3                        | WT-2                    | WT-2                                     | SAP-2                    | WALL TILE FLOOR TO CEILING  | F110                  | 2ND GRADE                            | CPT-1                          | RB-1         | VWC-3                    | VWC-4                                | P-1                              | VWC-3                                | SAP-1                | REFER TO ELEVATIONS FOR CASEWORK AND TEACHING WALL<br>REFER TO ELEVATIONS FOR CASEWORK AND TEACHING WALL        |
| 23<br>24              | LIT LIB<br>MATH STOR              | VCT-1<br>VCT-1                 | RB-1<br>RB-1 | P-1<br>P-1                         | P-1<br>P-1                  | P-1<br>P-1              | P-1<br>P-1                               | SAP-1<br>SAP-1           |   | F111<br>F112          | ELEC<br>IDF                          | SC-1<br>SC-1                   | RB-1<br>RB-1 | P-1<br>P-1               | P-1<br>P-1                           | P-1<br>P-1                       | P-1<br>P-1                           | EXP<br>SAP-1         |   |
| 25<br>26              | ELECTRICAL<br>BOOK ROOM           | SC-1                           | RB-1         | P-1                                | P-1                         | P-1<br>P-1              | P-1                                      | EXP<br>SAP-1             |   | F113<br>F114          | INSTRUCTIONAL COACH<br>COLLABORATION | CPT-1<br>CPT-2                 | RB-1<br>RB-1 | VWC-3<br>VWC-3           | VWC-3<br>VWC-3                       | VWC-3<br>VWC-3                   | VWC-3<br>VWC-4                       | SAP-1<br>SAP-1       | REFER TO ELEVATIONS FOR CASEWORK  |
| 27                    | IDF                               | VCT-1<br>SEALED CONCRETE       | RB-1<br>RB-1 | P-1                                | P-1<br>P-1                  | P-1<br>P-1              | P-1                                      | SAP-1                    |   | F115                  | INSTRUCTIONAL COACH                  | CPT-1                          | RB-1         | VWC-3                    | VWC-3                                | VWC-3                            | VWC-4<br>VWC-3                       | SAP-1                | REFER TO ELEVATIONS FOR CASEWORK  |
| 28<br>30              | CUST<br>TLT                       | EPF-1                          | RB-1<br>EPB  | P-1<br>WT-2                        | P-1<br>WT-2                 | P-1<br>WT-3             | P-1<br>WT-2                              | SAP-2<br>SAP-2           | WALL TILE FLOOR TO CEILING  | F116<br>F117          | SCIENCE<br>3RD GRADE                 | LVT-1<br>CPT-1                 | RB-1<br>RB-1 | VWC-3<br>VWC-3           | VWC-4<br>VWC-4                       | VWC-3<br>VWC-3                   | P-1<br>VWC-3                         | SAP-1<br>SAP-1       | REFER TO ELEVATIONS FOR CASEWORK           REFER TO ELEVATIONS FOR CASEWORK AND TEACHING WALL                   |
| 31<br>32              | TLT<br>TLT                        | EPF-1<br>EPF-1                 | EPB<br>EPB   | WT-3<br>WT-2                       | WT-2<br>WT-2                | WT-2<br>WT-2            | WT-2<br>WT-3                             | SAP-2<br>SAP-2           | WALL TILE FLOOR TO CEILING<br>WALL TILE FLOOR TO CEILING  | F118<br>F119          | 3RD GRADE<br>3RD GRADE               | CPT-1<br>CPT-1                 | RB-1<br>RB-1 | P-1<br>P-1               | VWC-3<br>VWC-4                       | VWC-3<br>VWC-3                   | VWC-4<br>VWC-3                       | SAP-1<br>SAP-1       | REFER TO ELEVATIONS FOR CASEWORK AND TEACHING WALL<br>REFER TO ELEVATIONS FOR CASEWORK AND TEACHING WALL        |
| 2A                    | TLT VEST                          |                                |              |                                    |                             |                         |  |                          |   | F120                  | 3RD GRADE                            | CPT-1                          | RB-1         | P-1                      | VWC-3                                | VWC-3                            | VWC-4                                | SAP-1                | REFER TO ELEVATIONS FOR CASEWORK AND TEACHING WALL  |
| 33<br>34              | TLT                               | EPF-1<br>EPF-1                 | EPB<br>EPB   | WT-2<br>WT-2                       | WT-3<br>WT-2                | WT-2<br>WT-2            | WT-2<br>WT-3                             | SAP-2<br>SAP-2           | WALL TILE FLOOR TO CEILING WALL TILE FLOOR TO CEILING   | F121<br>F121A         | TLT<br>TLT VEST                      | EPF-1<br>EPF-1                 | EPB<br>EPB   | WT-2<br>WT-2, P-4        | WT-2<br>WT-2, P-4                    | WT-2<br>WT-3                     | WT-3<br>WT-2, P-4                    | SAP-2<br>GYP         | WALL TILE FLOOR TO CEILING           WALL TILE UP TO TOP OF DOOR, REFER TO ELEVATIONS                           |
| 34A<br>35             | TLT VEST<br>TLT                   | EPF-1<br>EPF-1                 | EPB<br>EPB   | REFER TO ELEVATION<br>WT-2         | WT-2, P-4<br>WT-3           | WT-2,P-4<br>WT-2        | WT-2, P-4<br>WT-2                        | GYP<br>SAP-2             | WALL TILE UP TO TOP OF DOOR, REFER TO ELEVATIONS<br>WALL TILE UP TO TOP OF DOOR   | F122<br>F123          | TLT<br>TLT                           | EPF-1<br>EPF-1                 | EPB<br>EPB   | WT-2<br>WT-2             | WT-3<br>WT-2                         | WT-2<br>WT-2                     | WT-2<br>WT-3                         | SAP-2<br>SAP-2       | WALL TILE FLOOR TO CEILING<br>WALL TILE FLOOR TO CEILING  |
| 36                    | STORAGE                           | VCT-1                          | RB-1         | P-1                                | P-1                         | P-1                     | P-1                                      | SAP-2<br>SAP-1           |   | F123A                 | TLT VEST                             | EPF-1                          | EPB          | WT-3                     | WT-2, P-4                            | WT-2, P-4                        | WT-2, P-4                            | GYP                  | WALL TILE UP TO TOP OF DOOR, REFER TO ELEVATIONS  |
|                       |                                   |                                |              |                                    |                             |                         |  |                          |   | F124<br>F125          | TLT TLT                              | EPF-1<br>EPF-1                 | EPB<br>EPB   | WT-2<br>WT-2             | WT-3<br>WT-2                         | WT-2<br>WT-3                     | WT-2<br>WT-2                         | SAP-2<br>SAP-2       | WALL TILE FLOOR TO CEILING<br>WALL TILE FLOOR TO CEILING  |
|                       |                                   |                                |              |                                    | ROOM FINISH S               | CHEDULE - FIRS          | T FLOOR - AREA                           | С                        |   | F126<br>F127          | TLT<br>CUST.                         | EPF-1<br>SC-1                  | EPB<br>RB-1  | WT-3<br>P-1              | WT-2<br>P-1                          | WT-2<br>P-1                      | WT-2<br>P-1                          | SAP-2                |   |
|                       |                                   |                                |              |                                    | WALI                        |                         |  | CEILING                  |   | F129                  | BOOK RM                              | VCT-1                          | RB-1         | P-1                      | P-1                                  | P-1                              | P-1                                  | SAP-2<br>SAP-1       |   |
| <b>DM #</b>           |                                   | FLOOR                          | BASE         |                                    | EAST                        | SOUTH                   | WEST                                     | FINISH                   | REMARKS   | F130<br>F131          | BOOK RM<br>COLLABORATION             | VCT-1<br>CPT-2                 | RB-1<br>RB-1 | P-1                      | P-1<br>VWC-1                         | P-1                              | P-1<br>VWC-1                         | SAP-1<br>AWC         | REFER TO INTERIOR ELEVATIONS  |
| 00<br>01              | MUSIC<br>MUSIC STORAGE            | CPT-2<br>CPT-2                 | RB-1<br>RB-1 | VWC-4, P-1                         | P-1<br>P-1                  | P-1, CASEWORK<br>P-1    | P-1<br>P-1                               | SAP-1<br>SAP-1           | REFER TO ELEVATIONS FOR CASEWORK AND TEACHING WALL  | F132                  | STORAGE                              | VCT-1                          | RB-1         | P-1                      | P-1                                  | P-1                              | P-1                                  | SAP-1                |   |
| )2                    | PLATFORM                          | VCT-3                          |              | BLACK PAINT                        | BLACK PAINT                 | BLACK PAINT             | BLACK PAINT                              | SAP-3                    |   |                       |                                      |                                |              |                          |                                      |                                  |                                      |                      |   |

| ROOM NAME VESTIBULE RR VESTIBULE ARENTS VOLUNTEER CORRIDOR RECEPTION SECRETARY A. PRINCIPAL CONFERENCE PRINCIPAL CLINIC RR STO. EXAM/ISO COT CORRIDOR SECURITY RR CORRIDOR SECURITY RR VAULT / FILES STORAGE MDF LOUNGE WORKROOM COUNSELOR COUNSELOR COUNSELOR ELEC ART CORRIDOR FLEX KIVA  | FLOOR         WF-1         WF-1         CPT-2         EPF-1         T-1, T-2, CPT-1, WF-1         CPT-1         LVT-1         LVT-1         LVT-1         CPT-1, WF-1         CPT-1, WF-1         CPT-1, WF-1         CPT-1         VCT-1         VCT-1         VCT-1         VCT-1         VCT-1         VCT-1         VCT-1         SC-1         LVT-1         CPT-1         SEALED CONCRETE  | BASE<br>RB-1<br>-<br>RB-1<br>EPB<br>-<br>RB-1<br>RB-1<br>RB-1<br>RB-1<br>RB-1<br>R  | NORTH           GLAZING           WT-1, P-1           VWC-3/DIGITAL GRAPHIC           WT-3           -           VWC-3/DIGITAL GRAPHIC           WT-3           -           VWC-3           P-1  | WAL           EAST           WT-1/GRAPHIC ABOVE           -           VWC-3, P-1           WT-2           WT-1, WVC-3, P-1           VWC-2           VWC-3           VWC-3           VWC-3           WT-1           VWC-3           WWC-3           VWC-4           WT-3/WT-2           P-1           VWC-4           WWC-4           VWC-3           WWC-3           WWC-3           WT-2           P-1           P-1           VWC-3           WT-1           WT-2           P-1           P-1           WT-1           WT-2           P-1           P-1           WT-1           WT-2           P-1  |  | VWC-1         S           WT-1, P-1         S           VWC-3, P-1         A           WT-2         S           REFER TO ELEVATION         S           VWC-3         S           WT-2         S           VWC-3         S           WT-2         S           WT-2         S           WT-2         S           WT-3         S           WT-3         S           WT-3         S           WT-3         S           WT-3         S           WT-3         S <td< th=""><th>CEILIING       REMARKS         AP-1       VWC-1 FLOOR TO CEILING ON WEST WALL         AP-1       VWC-3 UP TO 8', AWP ON EAST &amp; WEST WALLS, MOTORIZED ROLLER SHADES AT EXTERIOR WALL         AP-2       WALL TILE FLOOR TO CEILING</th><th>ROOM #         D100         D100A         D101         D102         D103         D104         D105         D106         D107         D108         D109         D111         D112         D113         D114         D115         D114         D115         D114         D115         D116</th><th>ROOM NAME<br/>CORRIDOR<br/>TLT VESTIBULE<br/>CORRIDOR<br/>CUSTODIAN OFFICE<br/>IDF<br/>RESOURCE<br/>RR<br/>RR<br/>STAIR<br/>SPEECH<br/>SPED<br/>RR<br/>MAINTENANCE STORAGE<br/>SPED OFFICE<br/>SPED OFFICE</th><th>FLOOR           T-2, WF-1           EPF-1           T-2           VCT-1           SC-1           LVT-1           EPF-1           SC-1           LVT-1           EPF-1           EPF-1           EPF-1           SC-1           LVT-1           EPF-1           SC-1           VCT-1           CPT-2           LVT-1           EPF-1           CPT-2           LVT-1           EPF-1           CPT-2           LVT-1           EPF-1</th><th>RB-1<br/>RB-1</th><th>NORTH           P-1           WT-3           WT-1, VWC-3, P-1           P-1           P-1           VC-3, CASEWORK           WT-2           WT-2           P-1           VWC-3, CASEWORK           WT-2           WT-2           VWC-3           VWC-3           VWC-4           WT-2</th><th>WAL<br/>EAST<br/>P-1<br/>WT-2, P-4<br/>-<br/>P-1<br/>P-1<br/>VWC-4<br/>WT-2<br/>WT-3<br/>P-1<br/>VWC-3<br/>VWC-3<br/>VWC-3<br/>WT-2<br/>P-1</th><th>SOUTH           WT-1, VWC-3, P-1           WT-2, P-4           WT-1, VWC-3, P-1-           P-1           P-1           VWC-3           WT-2           P-1           VWT-2           P-1           VWC-3           WT-2           P-1           VWC-3           P-1           VWC-3           P-1           VWC-3           VWC-3           VWT-3           P-1</th><th>WEST           P-1           WT-2, P-4           -           P-1           P-1           WC-3           WT-2           P-1           VWC-3           WWC-3           WWC-3           WWC-3           WT-2           P-1           VWC-3           WWC-3           WT-2</th><th>CEILING<br/>FINISHREMARKSSAP-1, GYPSEE INT. ELEVATIONGYPSEE INT. ELEVATION, TILE TO ALIGN WITH TOP OF DOOR, SEE ELEVATIONSSAP-1SEE INT. ELEVATIONSAP-1SEE INT. ELEVATIONSAP-1SEE INT. ELEVATIONS FOR CASEWORK AND TEACHING WALLSAP-1REFER TO ELEVATIONS FOR CASEWORK AND TEACHING WALLSAP-2WALL TILE FLOOR TO CEILINGSAP-1REFER TO ELEVATIONS FOR CASEWORKSAP-1REFER TO ELEVATIONS FOR CASEWORKSAP-1REFER TO ELEVATIONS FOR CASEWORKSAP-1REFER TO ELEVATIONS FOR CASEWORKSAP-1REFER TO ELEVATIONS FOR CASEWORK AND TEACHING WALLSAP-1REFER TO ELEVATIONS FOR CASEWORK AND TEACHING WALL</th></td<> | CEILIING       REMARKS         AP-1       VWC-1 FLOOR TO CEILING ON WEST WALL         AP-1       VWC-3 UP TO 8', AWP ON EAST & WEST WALLS, MOTORIZED ROLLER SHADES AT EXTERIOR WALL         AP-2       WALL TILE FLOOR TO CEILING   | ROOM #         D100         D100A         D101         D102         D103         D104         D105         D106         D107         D108         D109         D111         D112         D113         D114         D115         D114         D115         D114         D115         D116  | ROOM NAME<br>CORRIDOR<br>TLT VESTIBULE<br>CORRIDOR<br>CUSTODIAN OFFICE<br>IDF<br>RESOURCE<br>RR<br>RR<br>STAIR<br>SPEECH<br>SPED<br>RR<br>MAINTENANCE STORAGE<br>SPED OFFICE<br>SPED OFFICE   | FLOOR           T-2, WF-1           EPF-1           T-2           VCT-1           SC-1           LVT-1           EPF-1           SC-1           LVT-1           EPF-1           EPF-1           EPF-1           SC-1           LVT-1           EPF-1           SC-1           VCT-1           CPT-2           LVT-1           EPF-1           CPT-2           LVT-1           EPF-1           CPT-2           LVT-1           EPF-1  | RB-1<br>RB-1   | NORTH           P-1           WT-3           WT-1, VWC-3, P-1           P-1           P-1           VC-3, CASEWORK           WT-2           WT-2           P-1           VWC-3, CASEWORK           WT-2           WT-2           VWC-3           VWC-3           VWC-4           WT-2   | WAL<br>EAST<br>P-1<br>WT-2, P-4<br>-<br>P-1<br>P-1<br>VWC-4<br>WT-2<br>WT-3<br>P-1<br>VWC-3<br>VWC-3<br>VWC-3<br>WT-2<br>P-1 | SOUTH           WT-1, VWC-3, P-1           WT-2, P-4           WT-1, VWC-3, P-1-           P-1           P-1           VWC-3           WT-2           P-1           VWT-2           P-1           VWC-3           WT-2           P-1           VWC-3           P-1           VWC-3           P-1           VWC-3           VWC-3           VWT-3           P-1  | WEST           P-1           WT-2, P-4           -           P-1           P-1           WC-3           WT-2           P-1           VWC-3           WWC-3           WWC-3           WWC-3           WT-2           P-1           VWC-3           WWC-3           WT-2   | CEILING<br>FINISHREMARKSSAP-1, GYPSEE INT. ELEVATIONGYPSEE INT. ELEVATION, TILE TO ALIGN WITH TOP OF DOOR, SEE ELEVATIONSSAP-1SEE INT. ELEVATIONSAP-1SEE INT. ELEVATIONSAP-1SEE INT. ELEVATIONS FOR CASEWORK AND TEACHING WALLSAP-1REFER TO ELEVATIONS FOR CASEWORK AND TEACHING WALLSAP-2WALL TILE FLOOR TO CEILINGSAP-1REFER TO ELEVATIONS FOR CASEWORKSAP-1REFER TO ELEVATIONS FOR CASEWORKSAP-1REFER TO ELEVATIONS FOR CASEWORKSAP-1REFER TO ELEVATIONS FOR CASEWORKSAP-1REFER TO ELEVATIONS FOR CASEWORK AND TEACHING WALLSAP-1REFER TO ELEVATIONS FOR CASEWORK AND TEACHING WALL  |
|---|---|---|--|---|--|---|---|---|---|--|--|---|--|---|--|--|
| VESTIBULE<br>RR VESTIBULE<br>PARENTS VOLUNTEER<br>RR<br>CORRIDOR<br>RECEPTION<br>SECRETARY<br>A. PRINCIPAL<br>CONFERENCE<br>PRINCIPAL<br>CLINIC<br>RR<br>STO.<br>EXAM/ISO<br>COT<br>CORRIDOR<br>SECURITY<br>RR<br>CORRIDOR<br>SECURITY<br>RR<br>RR<br>VAULT / FILES<br>STORAGE<br>MDF<br>LOUNGE<br>WORKROOM<br>COUNSELOR<br>COUNSELOR<br>COUNSELOR<br>ELEC<br>ART<br>CORRIDOR<br>FLEX<br>KIVA | WF-1           WF-1           CPT-2           EPF-1           T-1, T-2, CPT-1, WF-1           CPT-1           LVT-1           LVT-1           LVT-1           CPT-1, WF-1           CPT-1, WF-1           CPT-1, WF-1           CPT-1           EPF-1           EPF-1           VCT-1           VCT-1           VCT-1           SC-1           LVT-1           CPT-1           SEALED CONCRETE  | RB-1         RB-1         EPB         -         RB-1   | GLAZING           WT-1, P-1           VWC-3/DIGITAL GRAPHIC           WT-3           -           VWC-2           VWC-3           VWC-1           P-1   | EAST<br>WT-1/GRAPHIC ABOVE<br>-<br>VWC-3, P-1<br>WT-2<br>WT-1, WVC-3, P-1<br>VWC-2<br>VWC-3<br>VWC-3<br>VWC-3<br>VWC-3<br>VWC-3<br>VWC-4<br>WT-3/WT-2<br>P-1<br>VWC-4<br>VWC-4<br>VWC-4<br>VWC-4<br>VWC-4<br>VWC-4<br>VWC-3<br>WT-3<br>WT-3<br>WT-3<br>WT-3<br>WT-2<br>P-1<br>P-1<br>P-1<br>P-1<br>P-1<br>P-1<br>P-1<br>P-1   | SOUTH           GLAZING           WT-1, P-1           GLAZING           WT-2           GLAZING           P-1           P-1           P-1           P-1           P-1           P-1           P-1           P-1           VWC-3           VWC-3           VWC-3           VWC-3           VWC-3           WT-2           P-1           P-1  | VWC-1         S           WT-1, P-1         S           VWC-3, P-1         A           WT-2         S           REFER TO ELEVATION         S           VWC-3         S           WT-2         S           VWC-3         S           WT-2         S           WT-2         S           WT-2         S           WT-3         S           WT-3         S           WT-3         S           WT-3         S           WT-3         S           WT-3         S <td< th=""><th>AP-1       VWC-1 FLOOR TO CEILING ON WEST WALL         AP-1       WC, GYP         WC, GYP       WWC-3 UP TO 8', AWP ON EAST &amp; WEST WALLS, MOTORIZED ROLLER SHADES AT EXTERIOR WALL         AP-2       WALL TILE FLOOR TO CEILING         AP-1, GYP       AWP ON WALLS REFER TO INTERIOR ELEVATIONS FOR TILE \$ VWC-3 LOCATIONS         AP-1, GYP       NO WALLCOVERING AT EXTERIOR WALL, REFER TO INTERIOR ELEVATIONS FOR CASEWORK         AP1       NO WALLCOVERING AT EXTERIOR WALL, REFER TO INTERIOR ELEVATIONS FOR CASEWORK         AP-1       NO WALLCOVERING AT EXTERIOR WALL, REFER TO INTERIOR ELEVATIONS FOR CASEWORK         AP-1       NO WALLCOVERING AT EXTERIOR WALL, REFER TO INTERIOR ELEVATIONS FOR CASEWORK         AP-1       NO WALLCOVERING AT EXTERIOR WALL, REFER TO INTERIOR ELEVATIONS FOR CASEWORK         AP-1       NO WALLCOVERING AT EXTERIOR WALL, REFER TO INTERIOR ELEVATIONS FOR CASEWORK         AP-1       NO WALLCOVERING AT EXTERIOR WALL, REFER TO INTERIOR ELEVATIONS FOR CASEWORK         AP-1       NO WALLCOVERING AT EXTERIOR WALL, REFER TO INTERIOR ELEVATIONS FOR CASEWORK         AP-1       REFER TO ELEVATIONS FOR CASEWORK         AP-1       MS-3 SHELVES IN THIS LOCATION         AP-1       MS-3 SHELVES IN THIS LOCATION         AP-1       REFER TO ELEVATIONS FOR CASEWORK         AP-1       REFER TO ELEVATIONS FOR CASEWORK         AP-1       REFER TO ELEVATIONS</th><th>D100<br/>D100A<br/>D101<br/>D102<br/>D103<br/>D104<br/>D105<br/>D106<br/>D107<br/>D108<br/>D109<br/>D110<br/>D110<br/>D111<br/>D112<br/>D113<br/>D114<br/>D115</th><th>CORRIDOR<br/>TLT VESTIBULE<br/>CORRIDOR<br/>CUSTODIAN OFFICE<br/>IDF<br/>RESOURCE<br/>RR<br/>RR<br/>STAIR<br/>SPEECH<br/>SPED<br/>RR<br/>MAINTENANCE STORAGE<br/>SPED OFFICE</th><th>T-2, WF-1         EPF-1         T-2         VCT-1         SC-1         LVT-1         EPF-1         SC-1         CPT-2         LVT-1         PFF-1         SC-1         CPT-2         LVT-1         EPF-1         VCT-1</th><th>- EPB</th><th>P-1<br/>WT-3<br/>WT-1, VWC-3, P-1<br/>P-1<br/>P-1<br/>VWC-3, CASEWORK<br/>WT-2<br/>WT-2<br/>P-1<br/>VWC-3<br/>VWC-3<br/>VWC-4</th><th>EAST<br/>P-1<br/>WT-2, P-4<br/>-<br/>P-1<br/>P-1<br/>VWC-4<br/>WT-2<br/>WT-3<br/>P-1<br/>VWC-3<br/>VWC-3<br/>VWC-3<br/>WT-2</th><th>SOUTH           WT-1, VWC-3, P-1           WT-2, P-4           WT-1, VWC-3, P-1-           P-1           P-1           VWC-3           WT-2           P-1           VWT-2           P-1           VWC-3           WT-2           P-1           VWC-3           P-1           VWC-3           P-1           VWC-3           VWC-3           VWT-3           P-1</th><th>P-1<br/>WT-2, P-4<br/>-<br/>P-1<br/>P-1<br/>VWC-3<br/>WT-3<br/>WT-2<br/>P-1<br/>VWC-3<br/>VWC-3<br/>VWC-3<br/>WT-2</th><th>FINISHREMARKSSAP-1, GYPSEE INT. ELEVATIONGYPSEE INT. ELEVATION, TILE TO ALIGN WITH TOP OF DOOR, SEE ELEVATIONSSAP-1SEE INT. ELEVATIONSAP-1SEE INT. ELEVATIONS FOR CASEWORK AND TEACHING WALLSAP-2WALL TILE FLOOR TO CEILINGSAP-2WALL TILE FLOOR TO CEILINGSAP-1REFER TO ELEVATIONS FOR CASEWORKSAP-2WALL TILE FLOOR TO CEILINGSAP-2WALL TILE FLOOR TO CEILINGSAP-1REFER TO ELEVATIONS FOR CASEWORKSAP-1REFER TO ELEVATIONS FOR CASEWORK AND TEACHING WALLSAP-1REFER TO ELEVATIONS FOR CASEWORK AND TEACHING WALLSAP-2WALL TILE FLOOR TO CEILING</th></td<>   | AP-1       VWC-1 FLOOR TO CEILING ON WEST WALL         AP-1       WC, GYP         WC, GYP       WWC-3 UP TO 8', AWP ON EAST & WEST WALLS, MOTORIZED ROLLER SHADES AT EXTERIOR WALL         AP-2       WALL TILE FLOOR TO CEILING         AP-1, GYP       AWP ON WALLS REFER TO INTERIOR ELEVATIONS FOR TILE \$ VWC-3 LOCATIONS         AP-1, GYP       NO WALLCOVERING AT EXTERIOR WALL, REFER TO INTERIOR ELEVATIONS FOR CASEWORK         AP1       NO WALLCOVERING AT EXTERIOR WALL, REFER TO INTERIOR ELEVATIONS FOR CASEWORK         AP-1       NO WALLCOVERING AT EXTERIOR WALL, REFER TO INTERIOR ELEVATIONS FOR CASEWORK         AP-1       NO WALLCOVERING AT EXTERIOR WALL, REFER TO INTERIOR ELEVATIONS FOR CASEWORK         AP-1       NO WALLCOVERING AT EXTERIOR WALL, REFER TO INTERIOR ELEVATIONS FOR CASEWORK         AP-1       NO WALLCOVERING AT EXTERIOR WALL, REFER TO INTERIOR ELEVATIONS FOR CASEWORK         AP-1       NO WALLCOVERING AT EXTERIOR WALL, REFER TO INTERIOR ELEVATIONS FOR CASEWORK         AP-1       NO WALLCOVERING AT EXTERIOR WALL, REFER TO INTERIOR ELEVATIONS FOR CASEWORK         AP-1       REFER TO ELEVATIONS FOR CASEWORK         AP-1       MS-3 SHELVES IN THIS LOCATION         AP-1       MS-3 SHELVES IN THIS LOCATION         AP-1       REFER TO ELEVATIONS FOR CASEWORK         AP-1       REFER TO ELEVATIONS FOR CASEWORK         AP-1       REFER TO ELEVATIONS                     | D100<br>D100A<br>D101<br>D102<br>D103<br>D104<br>D105<br>D106<br>D107<br>D108<br>D109<br>D110<br>D110<br>D111<br>D112<br>D113<br>D114<br>D115   | CORRIDOR<br>TLT VESTIBULE<br>CORRIDOR<br>CUSTODIAN OFFICE<br>IDF<br>RESOURCE<br>RR<br>RR<br>STAIR<br>SPEECH<br>SPED<br>RR<br>MAINTENANCE STORAGE<br>SPED OFFICE   | T-2, WF-1         EPF-1         T-2         VCT-1         SC-1         LVT-1         EPF-1         SC-1         CPT-2         LVT-1         PFF-1         SC-1         CPT-2         LVT-1         EPF-1         VCT-1   | - EPB  | P-1<br>WT-3<br>WT-1, VWC-3, P-1<br>P-1<br>P-1<br>VWC-3, CASEWORK<br>WT-2<br>WT-2<br>P-1<br>VWC-3<br>VWC-3<br>VWC-4  | EAST<br>P-1<br>WT-2, P-4<br>-<br>P-1<br>P-1<br>VWC-4<br>WT-2<br>WT-3<br>P-1<br>VWC-3<br>VWC-3<br>VWC-3<br>WT-2               | SOUTH           WT-1, VWC-3, P-1           WT-2, P-4           WT-1, VWC-3, P-1-           P-1           P-1           VWC-3           WT-2           P-1           VWT-2           P-1           VWC-3           WT-2           P-1           VWC-3           P-1           VWC-3           P-1           VWC-3           VWC-3           VWT-3           P-1  | P-1<br>WT-2, P-4<br>-<br>P-1<br>P-1<br>VWC-3<br>WT-3<br>WT-2<br>P-1<br>VWC-3<br>VWC-3<br>VWC-3<br>WT-2   | FINISHREMARKSSAP-1, GYPSEE INT. ELEVATIONGYPSEE INT. ELEVATION, TILE TO ALIGN WITH TOP OF DOOR, SEE ELEVATIONSSAP-1SEE INT. ELEVATIONSAP-1SEE INT. ELEVATIONS FOR CASEWORK AND TEACHING WALLSAP-2WALL TILE FLOOR TO CEILINGSAP-2WALL TILE FLOOR TO CEILINGSAP-1REFER TO ELEVATIONS FOR CASEWORKSAP-2WALL TILE FLOOR TO CEILINGSAP-2WALL TILE FLOOR TO CEILINGSAP-1REFER TO ELEVATIONS FOR CASEWORKSAP-1REFER TO ELEVATIONS FOR CASEWORK AND TEACHING WALLSAP-1REFER TO ELEVATIONS FOR CASEWORK AND TEACHING WALLSAP-2WALL TILE FLOOR TO CEILING  |
| RR VESTIBULE PARENTS VOLUNTEER RR CORRIDOR RECEPTION SECRETARY A. PRINCIPAL CONFERENCE PRINCIPAL CLINIC RR STO. EXAM/ISO COT CORRIDOR SECURITY RR RR VAULT / FILES STORAGE MDF LOUNGE WORKROOM COUNSELOR COUNSELOR ELEC ART CORRIDOR FLEX KIVA  | WF-1           WF-1           CPT-2           EPF-1           T-1, T-2, CPT-1, WF-1           CPT-1           LVT-1           EPF-1           VCT-1           LVT-1           EPF-1           CPT-1           EPF-1           EPF-1           EPF-1           VCT-1           VCT-1           VCT-1           CPT-1           SEALED CONCRETE   | - RB-1 EPB - RB-1 RB-1 RB-1 RB-1 RB-1 RB-1 RB-1 R   | WT-1, P-1         VWC-3/DIGITAL GRAPHIC         WT-3         -         VWC-2         VWC-3         VWC-3         VWC-3         VWC-3         VWC-3         VWC-3         VWC-3         VWC-3         VWC-3         WT-2         P-1         VWC-3         VWC-3         VWC-3         VWC-3         VWC-3         VWC-3         VWC-3         P-1  | -<br>VWC-3, P-1<br>WT-2<br>WT-1, WVC-3, P-1<br>VWC-2<br>VWC-3<br>VWC-3<br>VWC-3<br>VWC-3<br>P-1<br>VWC-4<br>WT-3/WT-2<br>P-1<br>VWC-4<br>VWC-4<br>VWC-4<br>VWC-4<br>VWC-4<br>VWC-3<br>WT-3<br>WT-3<br>WT-3<br>WT-2<br>P-1<br>P-1<br>P-1<br>P-1<br>P-1<br>P-1<br>P-1<br>P-1  | WT-1, P-1           GLAZING           WT-2           GLAZING           P-1           P-1           P-1           P-1           P-1           P-1           P-1           P-1           VWC-3           VWC-3           VWC-3           VWC-3           VWC-3           WT-2           P-1           P-1           P-1  | WT-1, P-1         S           VWC-3, P-1         A           WT-2         S           REFER TO ELEVATION         S           VWC-2         S           VWC-3         S           WT-2         S           WT-2         S           WT-3         S <t< th=""><th>AP-1       WC, GYP       VWC-3 UP TO 8', AWP ON EAST &amp; WEST WALLS, MOTORIZED ROLLER SHADES AT EXTERIOR WALL         AP-2       WALL TILE FLOOR TO CEILING         AP-1, GYP       AWP ON WALLS REFER TO INTERIOR ELEVATIONS FOR TILE \$ WWC-3 LOCATIONS         AP-1, GYP       NO WALLCOVERING AT EXTERIOR WALL, REFER TO INTERIOR ELEVATIONS FOR CASEWORK         AP1       NO WALLCOVERING AT EXTERIOR WALL, REFER TO INTERIOR ELEVATIONS FOR CASEWORK         AP-1       NO WALLCOVERING AT EXTERIOR WALL, REFER TO INTERIOR ELEVATIONS FOR CASEWORK         AP-1       NO WALLCOVERING AT EXTERIOR WALL, REFER TO INTERIOR ELEVATIONS FOR CASEWORK         AP-1       NO WALLCOVERING AT EXTERIOR WALL, REFER TO INTERIOR ELEVATIONS FOR CASEWORK         AP-1       NO WALLCOVERING AT EXTERIOR WALL, REFER TO INTERIOR ELEVATIONS FOR CASEWORK         AP-1       NO WALLCOVERING AT EXTERIOR WALL, REFER TO INTERIOR ELEVATIONS FOR CASEWORK         AP-1       NO WALLCOVERING AT EXTERIOR WALL, REFER TO INTERIOR ELEVATIONS FOR CASEWORK         AP-1       REFER TO ELEVATIONS FOR CASEWORK         AP-1       REFER TO ELEVATIONS FOR CASEWORK         AP-1       MS-3 SHELVES IN THIS LOCATION         AP-1       MS-3 SHELVES IN THIS LOCATION         AP-1       REFER TO ELEVATIONS FOR CASEWORK         AP-1       REFER TO ELEVATIONS FOR CASEWORK         AP-1       REFER TO ELEVATIONS FOR CASEWORK. WEAPON RACK IN THIS ROOM</th><th>D100A<br/>D101<br/>D102<br/>D103<br/>D104<br/>D105<br/>D106<br/>D107<br/>D108<br/>D109<br/>D110<br/>D111<br/>D112<br/>D113<br/>D114<br/>D115</th><th>TLT VESTIBULE<br/>CORRIDOR<br/>CUSTODIAN OFFICE<br/>IDF<br/>RESOURCE<br/>RR<br/>RR<br/>STAIR<br/>SPEECH<br/>SPED<br/>RR<br/>MAINTENANCE STORAGE<br/>SPED OFFICE</th><th>EPF-1           T-2           VCT-1           SC-1           LVT-1           EPF-1           SC-1           CPT-2           LVT-1           EPF-1           SC-1           VCT-1</th><th>EPB</th><th>WT-3           WT-1, VWC-3, P-1           P-1           P-1           VWC-3, CASEWORK           WT-2           WT-2           P-1           VWC-3           VWC-3</th><th>WT-2, P-4<br/><br/>P-1<br/>P-1<br/>VWC-4<br/>WT-2<br/>WT-3<br/>P-1<br/>VWC-3<br/>VWC-3<br/>VWC-3<br/>WT-2</th><th>WT-2, P-4           WT-1, VWC-3, P-1-           P-1           VWC-3           WT-2           WT-2           P-1           VWC-3           WT-2           P-1           VWC-3           WT-2           P-1           VWC-3           VWC-3           VWC-3           P-1           P-1</th><th>WT-2, P-4<br/>P-1<br/>P-1<br/>WC-3<br/>WT-3<br/>WT-2<br/>P-1<br/>VWC-3<br/>VWC-3<br/>WT-2<br/>WT-2<br/>WT-2</th><th>GYPSEE INT. ELEVATION, TILE TO ALIGN WITH TOP OF DOOR, SEE ELEVATIONSSAP-1SEE INT. ELEVATIONSAP-1SAP-1SAP-1REFER TO ELEVATIONS FOR CASEWORK AND TEACHING WALLSAP-2WALL TILE FLOOR TO CEILINGSAP-1REFER TO ELEVATIONS FOR CASEWORK AND TEACHING WALLSAP-2WALL TILE FLOOR TO CEILINGEXPSAP-1SAP-1REFER TO ELEVATIONS FOR CASEWORKSAP-1REFER TO ELEVATIONS FOR CASEWORKSAP-2WALL TILE FLOOR TO CEILINGEXPSAP-1SAP-1REFER TO ELEVATIONS FOR CASEWORK AND TEACHING WALLSAP-2WALL TILE FLOOR TO CEILING</th></t<>   | AP-1       WC, GYP       VWC-3 UP TO 8', AWP ON EAST & WEST WALLS, MOTORIZED ROLLER SHADES AT EXTERIOR WALL         AP-2       WALL TILE FLOOR TO CEILING         AP-1, GYP       AWP ON WALLS REFER TO INTERIOR ELEVATIONS FOR TILE \$ WWC-3 LOCATIONS         AP-1, GYP       NO WALLCOVERING AT EXTERIOR WALL, REFER TO INTERIOR ELEVATIONS FOR CASEWORK         AP1       NO WALLCOVERING AT EXTERIOR WALL, REFER TO INTERIOR ELEVATIONS FOR CASEWORK         AP-1       NO WALLCOVERING AT EXTERIOR WALL, REFER TO INTERIOR ELEVATIONS FOR CASEWORK         AP-1       NO WALLCOVERING AT EXTERIOR WALL, REFER TO INTERIOR ELEVATIONS FOR CASEWORK         AP-1       NO WALLCOVERING AT EXTERIOR WALL, REFER TO INTERIOR ELEVATIONS FOR CASEWORK         AP-1       NO WALLCOVERING AT EXTERIOR WALL, REFER TO INTERIOR ELEVATIONS FOR CASEWORK         AP-1       NO WALLCOVERING AT EXTERIOR WALL, REFER TO INTERIOR ELEVATIONS FOR CASEWORK         AP-1       NO WALLCOVERING AT EXTERIOR WALL, REFER TO INTERIOR ELEVATIONS FOR CASEWORK         AP-1       REFER TO ELEVATIONS FOR CASEWORK         AP-1       REFER TO ELEVATIONS FOR CASEWORK         AP-1       MS-3 SHELVES IN THIS LOCATION         AP-1       MS-3 SHELVES IN THIS LOCATION         AP-1       REFER TO ELEVATIONS FOR CASEWORK         AP-1       REFER TO ELEVATIONS FOR CASEWORK         AP-1       REFER TO ELEVATIONS FOR CASEWORK. WEAPON RACK IN THIS ROOM | D100A<br>D101<br>D102<br>D103<br>D104<br>D105<br>D106<br>D107<br>D108<br>D109<br>D110<br>D111<br>D112<br>D113<br>D114<br>D115   | TLT VESTIBULE<br>CORRIDOR<br>CUSTODIAN OFFICE<br>IDF<br>RESOURCE<br>RR<br>RR<br>STAIR<br>SPEECH<br>SPED<br>RR<br>MAINTENANCE STORAGE<br>SPED OFFICE   | EPF-1           T-2           VCT-1           SC-1           LVT-1           EPF-1           SC-1           CPT-2           LVT-1           EPF-1           SC-1           VCT-1   | EPB  | WT-3           WT-1, VWC-3, P-1           P-1           P-1           VWC-3, CASEWORK           WT-2           WT-2           P-1           VWC-3           VWC-3   | WT-2, P-4<br><br>P-1<br>P-1<br>VWC-4<br>WT-2<br>WT-3<br>P-1<br>VWC-3<br>VWC-3<br>VWC-3<br>WT-2                               | WT-2, P-4           WT-1, VWC-3, P-1-           P-1           VWC-3           WT-2           WT-2           P-1           VWC-3           WT-2           P-1           VWC-3           WT-2           P-1           VWC-3           VWC-3           VWC-3           P-1           P-1   | WT-2, P-4<br>P-1<br>P-1<br>WC-3<br>WT-3<br>WT-2<br>P-1<br>VWC-3<br>VWC-3<br>WT-2<br>WT-2<br>WT-2   | GYPSEE INT. ELEVATION, TILE TO ALIGN WITH TOP OF DOOR, SEE ELEVATIONSSAP-1SEE INT. ELEVATIONSAP-1SAP-1SAP-1REFER TO ELEVATIONS FOR CASEWORK AND TEACHING WALLSAP-2WALL TILE FLOOR TO CEILINGSAP-1REFER TO ELEVATIONS FOR CASEWORK AND TEACHING WALLSAP-2WALL TILE FLOOR TO CEILINGEXPSAP-1SAP-1REFER TO ELEVATIONS FOR CASEWORKSAP-1REFER TO ELEVATIONS FOR CASEWORKSAP-2WALL TILE FLOOR TO CEILINGEXPSAP-1SAP-1REFER TO ELEVATIONS FOR CASEWORK AND TEACHING WALLSAP-2WALL TILE FLOOR TO CEILING  |
| RR<br>CORRIDOR<br>RECEPTION<br>SECRETARY<br>A. PRINCIPAL<br>CONFERENCE<br>PRINCIPAL<br>CLINIC<br>RR<br>STO.<br>EXAM/ISO<br>COT<br>CORRIDOR<br>SECURITY<br>RR<br>CORRIDOR<br>SECURITY<br>RR<br>VAULT / FILES<br>STORAGE<br>MDF<br>LOUNGE<br>WORKROOM<br>COUNSELOR<br>COUNSELOR<br>COUNSELOR<br>ELEC<br>ART<br>CORRIDOR<br>FLEX<br>KIVA   | EPF-1           T-1, T-2, CPT-1, WF-1           CPT-1           CPT-1           CPT-1           CPT-1           CPT-1           CPT-1           CPT-1           LVT-1           EPF-1           VCT-1           LVT-1           EPF-1           CPT-1, WF-1           CPT-1, WF-1           CPT-1, WF-1           CPT-1           EPF-1           EPF-1           VCT-1           VCT-1           VCT-1           SC-1           LVT-1           CPT-1           SEALED CONCRETE  | EPB<br>-<br>RB-1<br>RB-1<br>RB-1<br>RB-1<br>RB-1<br>EPB<br>RB-1<br>RB-1<br>RB-1<br>RB-1<br>RB-1<br>EPB<br>EPB<br>RB-1<br>RB-1<br>RB-1<br>RB-1<br>RB-1<br>RB-1<br>RB-1<br>RB-  | WT-3         -         VWC-2         VWC-3         VWC-3         VWC-3         VWC-3         WT-2         P-1         VWC-3         VWC-3         WT-2         P-1         VWC-3         VWC-3         VWC-3         VWC-3         VWC-3         VWC-3         VWC-3         P-1   | WT-2           WT-1, WVC-3, P-1           VWC-2           VWC-3           VWC-3           P-1           VWC-4           WT-3/WT-2           P-1           VWC-4           WWC-3           WWC-4           WWC-3           WWC-4           WWC-3           WWC-4           WWC-3           WWC-3           WWC-3           WT-3           WT-1           P-1           P-1           P-1   | WT-2           GLAZING           P-1           P-1           P-1           P-1           P-1           P-1           P-1           P-1           VWC-3           VWC-3           VWC-3           VWC-3           VWC-3           VWC-3           VWC-3           VWC-3           VWC-3           P-1           P-1           P-1   | WT-2         S           REFER TO ELEVATION         S           VWC-2         S           VWC-3         S           WT-2         S           WT-2         S           WT-3         S           WT-3         S           P-1         S   | AP-2       WALL TILE FLOOR TO CEILING         AP-1, GYP       AWP ON WALLS REFER TO INTERIOR ELEVATIONS FOR TILE \$ VWC-3 LOCATIONS         AP-1, GYP       NO WALLCOVERING AT EXTERIOR WALL, REFER TO INTERIOR ELEVATIONS FOR CASEWORK         AP1       NO WALLCOVERING AT EXTERIOR WALL, REFER TO INTERIOR ELEVATIONS FOR CASEWORK         AP-1       NO WALLCOVERING AT EXTERIOR WALL, REFER TO INTERIOR ELEVATIONS FOR CASEWORK         AP-1       NO WALLCOVERING AT EXTERIOR WALL, REFER TO INTERIOR ELEVATIONS FOR CASEWORK         AP-1       NO WALLCOVERING AT EXTERIOR WALL, REFER TO INTERIOR ELEVATIONS FOR CASEWORK         AP-1       NO WALLCOVERING AT EXTERIOR WALL, REFER TO INTERIOR ELEVATIONS FOR CASEWORK         AP-1       NO WALLCOVERING AT EXTERIOR WALL, REFER TO INTERIOR ELEVATIONS FOR CASEWORK         AP-1       NO WALLCOVERING AT EXTERIOR WALL, REFER TO INTERIOR ELEVATIONS FOR CASEWORK         AP-1       REFER TO ELEVATIONS FOR CASEWORK         AP-2       WALL TILE FLOOR TO CEILING         AP-1       MS-3 SHELVES IN THIS LOCATION         AP-1       AP-1         AP-1       REFER TO ELEVATIONS FOR CASEWORK         AP-1       REFER TO ELEVATIONS FOR CASEWORK         AP-1       REFER TO ELEVATIONS FOR CASEWORK. WEAPON RACK IN THIS ROOM         AP-2       WALL TILE FLOOR TO CEILING  | D102<br>D103<br>D104<br>D105<br>D106<br>D107<br>D108<br>D109<br>D110<br>D111<br>D112<br>D113<br>D114<br>D115  | CUSTODIAN OFFICE<br>IDF<br>RESOURCE<br>RR<br>RR<br>STAIR<br>SPEECH<br>SPED<br>RR<br>MAINTENANCE STORAGE<br>SPED OFFICE  | VCT-1           SC-1           LVT-1           EPF-1           SC-1           CPT-2           LVT-1           EPF-1  | RB-1       RB-1       RB-1       EPB       EFB       RB-1       RB-1       RB-1       EPB  | P-1<br>P-1<br>VWC-3, CASEWORK<br>WT-2<br>WT-2<br>P-1<br>VWC-3<br>VWC-4  | WT-2<br>WT-3<br>P-1<br>VWC-3<br>VWC-3<br>WT-2  | P-1<br>P-1<br>VWC-3<br>WT-2<br>P-1<br>VWC-3<br>VWC-3<br>WT-3<br>P-1   | P-1<br>P-1<br>VWC-3<br>WT-3<br>WT-2<br>P-1<br>VWC-3<br>VWC-3<br>WT-2   | SAP-1SAP-1SAP-1REFER TO ELEVATIONS FOR CASEWORK AND TEACHING WALLSAP-2WALL TILE FLOOR TO CEILINGSAP-2WALL TILE FLOOR TO CEILINGEXPSAP-1REFER TO ELEVATIONS FOR CASEWORKSAP-1REFER TO ELEVATIONS FOR CASEWORK AND TEACHING WALLSAP-2WALL TILE FLOOR TO CEILING  |
| RECEPTION<br>SECRETARY<br>A. PRINCIPAL<br>CONFERENCE<br>PRINCIPAL<br>CLINIC<br>RR<br>STO.<br>EXAM/ISO<br>COT<br>CORRIDOR<br>SECURITY<br>RR<br>RR<br>VAULT / FILES<br>STORAGE<br>MDF<br>LOUNGE<br>WORKROOM<br>COUNSELOR<br>COUNSELOR<br>ELEC<br>ART<br>CORRIDOR<br>FLEX<br>KIVA  | CPT-1           CPT-1           CPT-1           CPT-1           CPT-1           CPT-1           LVT-1           EPF-1           VCT-1           LVT-1           EPF-1           VCT-1           EPF-1           CPT-1           EPF-1           VCT-1           EPF-1           VCT-1           VCT-1           VCT-1           SC-1           LVT-1           CPT-1           SEALED CONCRETE  | RB-1         RB-1         RB-1         RB-1         EPB         RB-1         RB-1 <tr< td=""><td>VWC-2           VWC-3           VWC-3           VWC-3           VWC-3           WT-2           P-1           VWC-3           P-1           P-1</td><td>VWC-2           VWC-3           VWC-3           P-1           VWC-4           WT-3/WT-2           P-1           VWC-4           VWC-4           VWC-4           VWC-3           WC-3           WWC-3           WWC-3           WWC-3           WT-3           WT-1           P-1           P-1</td><td>P-1         P-1         P-1         P-1         P-1         VWC-3         WT-2         P-1         VWC-3         VWC-3         VWC-3         VWC-3         WT-2         P-1         P-1</td><td>VWC-2         S           VWC-3         S           VWT-2         S           WT-3         S           P-1         S  </td><td>AP-1, GYPNO WALLCOVERING AT EXTERIOR WALL, REFER TO INTERIOR ELEVATIONS FOR CASEWORKAP1NO WALLCOVERING AT EXTERIOR WALL, REFER TO INTERIOR ELEVATIONS FOR CASEWORKAP-1NO WALLCOVERING AT EXTERIOR WALL, REFER TO INTERIOR ELEVATIONS FOR CASEWORKAP-1NO WALLCOVERING AT EXTERIOR WALL, REFER TO INTERIOR ELEVATIONS FOR CASEWORKAP-1NO WALLCOVERING AT EXTERIOR WALL, REFER TO INTERIOR ELEVATIONS FOR CASEWORKAP-1NO WALLCOVERING AT EXTERIOR WALL, REFER TO INTERIOR ELEVATIONS FOR CASEWORKAP-1REFER TO ELEVATIONS FOR CASEWORKAP-2WALL TILE FLOOR TO CEILINGAP-1MS-3 SHELVES IN THIS LOCATIONAP-1AP-1AP-1AP-1AP-1REFER TO ELEVATIONS FOR CASEWORKAP-1REFER TO ELEVATIONS FOR CASEWORKAP-1REFER TO ELEVATIONS FOR CASEWORKAP-1REFER TO ELEVATIONS FOR CASEWORKAP-2WALL TILE FLOOR TO CEILINGAP-2WALL TILE FLOOR TO CEILING</td><td>D104<br/>D105<br/>D106<br/>D107<br/>D108<br/>D109<br/>D110<br/>D111<br/>D112<br/>D113<br/>D114<br/>D115</td><td>RESOURCE<br/>RR<br/>RR<br/>STAIR<br/>SPEECH<br/>SPED<br/>RR<br/>MAINTENANCE STORAGE<br/>SPED OFFICE</td><td>LVT-1           EPF-1           EPF-1           SC-1           CPT-2           LVT-1           EPF-1           VCT-1</td><td>RB-1YEPBEFBRB-1RB-1RB-1EPB</td><td>WT-2<br/>WT-2<br/>P-1<br/>VWC-3<br/>VWC-4</td><td>WT-2<br/>WT-3<br/>P-1<br/>VWC-3<br/>VWC-3<br/>WT-2</td><td>VWC-3           WT-2           WT-2           P-1           VWC-3           VWC-3           WT-3           P-1</td><td>VWC-3<br/>WT-3<br/>WT-2<br/>P-1<br/>VWC-3<br/>VWC-3<br/>WT-2</td><td>SAP-1       REFER TO ELEVATIONS FOR CASEWORK AND TEACHING WALL         SAP-2       WALL TILE FLOOR TO CEILING         SAP-2       WALL TILE FLOOR TO CEILING         EXP       SAP-1         REFER TO ELEVATIONS FOR CASEWORK         SAP-1       REFER TO ELEVATIONS FOR CASEWORK AND TEACHING WALL         SAP-2       WALL TILE FLOOR TO CEILING</td></tr<>  | VWC-2           VWC-3           VWC-3           VWC-3           VWC-3           WT-2           P-1           VWC-3           P-1   | VWC-2           VWC-3           VWC-3           P-1           VWC-4           WT-3/WT-2           P-1           VWC-4           VWC-4           VWC-4           VWC-3           WC-3           WWC-3           WWC-3           WWC-3           WT-3           WT-1           P-1  | P-1         P-1         P-1         P-1         P-1         VWC-3         WT-2         P-1         VWC-3         VWC-3         VWC-3         VWC-3         WT-2         P-1  | VWC-2         S           VWC-3         S           VWT-2         S           WT-3         S           P-1         S  | AP-1, GYPNO WALLCOVERING AT EXTERIOR WALL, REFER TO INTERIOR ELEVATIONS FOR CASEWORKAP1NO WALLCOVERING AT EXTERIOR WALL, REFER TO INTERIOR ELEVATIONS FOR CASEWORKAP-1NO WALLCOVERING AT EXTERIOR WALL, REFER TO INTERIOR ELEVATIONS FOR CASEWORKAP-1NO WALLCOVERING AT EXTERIOR WALL, REFER TO INTERIOR ELEVATIONS FOR CASEWORKAP-1NO WALLCOVERING AT EXTERIOR WALL, REFER TO INTERIOR ELEVATIONS FOR CASEWORKAP-1NO WALLCOVERING AT EXTERIOR WALL, REFER TO INTERIOR ELEVATIONS FOR CASEWORKAP-1REFER TO ELEVATIONS FOR CASEWORKAP-2WALL TILE FLOOR TO CEILINGAP-1MS-3 SHELVES IN THIS LOCATIONAP-1AP-1AP-1AP-1AP-1REFER TO ELEVATIONS FOR CASEWORKAP-1REFER TO ELEVATIONS FOR CASEWORKAP-1REFER TO ELEVATIONS FOR CASEWORKAP-1REFER TO ELEVATIONS FOR CASEWORKAP-2WALL TILE FLOOR TO CEILINGAP-2WALL TILE FLOOR TO CEILING   | D104<br>D105<br>D106<br>D107<br>D108<br>D109<br>D110<br>D111<br>D112<br>D113<br>D114<br>D115  | RESOURCE<br>RR<br>RR<br>STAIR<br>SPEECH<br>SPED<br>RR<br>MAINTENANCE STORAGE<br>SPED OFFICE   | LVT-1           EPF-1           EPF-1           SC-1           CPT-2           LVT-1           EPF-1           VCT-1   | RB-1YEPBEFBRB-1RB-1RB-1EPB   | WT-2<br>WT-2<br>P-1<br>VWC-3<br>VWC-4   | WT-2<br>WT-3<br>P-1<br>VWC-3<br>VWC-3<br>WT-2  | VWC-3           WT-2           WT-2           P-1           VWC-3           VWC-3           WT-3           P-1  | VWC-3<br>WT-3<br>WT-2<br>P-1<br>VWC-3<br>VWC-3<br>WT-2   | SAP-1       REFER TO ELEVATIONS FOR CASEWORK AND TEACHING WALL         SAP-2       WALL TILE FLOOR TO CEILING         SAP-2       WALL TILE FLOOR TO CEILING         EXP       SAP-1         REFER TO ELEVATIONS FOR CASEWORK         SAP-1       REFER TO ELEVATIONS FOR CASEWORK AND TEACHING WALL         SAP-2       WALL TILE FLOOR TO CEILING  |
| A. PRINCIPAL<br>CONFERENCE<br>PRINCIPAL<br>CLINIC<br>RR<br>STO.<br>EXAM/ISO<br>COT<br>CORRIDOR<br>SECURITY<br>RR<br>RR<br>VAULT / FILES<br>STORAGE<br>MDF<br>LOUNGE<br>WORKROOM<br>COUNSELOR<br>COUNSELOR<br>ELEC<br>ART<br>CORRIDOR<br>FLEX<br>KIVA  | CPT-1           CPT-1           CPT-1           LVT-1           EPF-1           VCT-1           LVT-1           CPT-1, WF-1           CPT-1, WF-1           CPT-1           EPF-1           VCT-1           LVT-1           CPT-1, WF-1           CPT-1           EPF-1           VCT-1           VCT-1           VCT-1           VCT-1           VCT-1           SC-1           LVT-1           CPT-1           SEALED CONCRETE  | RB-1         RB-1         RB-1         EPB         RB-1         RB-1 <tr< td=""><td>VWC-3           VWC-3           VWC-3           WT-2           P-1           VWC-3           VWC-3           VWC-3           VWC-3           VWC-3           VWC-3           VWC-3           P-1           P-1</td><td>VWC-3           P-1           VWC-4           WT-3/WT-2           P-1           VWC-4           VWC-4           VWC-3           VWC-3           WT-3           WT-2           P-1           P-1</td><td>P-1<br/>P-1<br/>P-1<br/>VWC-3<br/>WT-2<br/>P-1<br/>VWC-3<br/>VWC-3<br/>VWC-3<br/>VWC-3<br/>VWC-3<br/>VWC-3<br/>WT-2<br/>WT-2<br/>P-1<br/>P-1<br/>P-1<br/>P-1</td><td>VWC-3         S           VWC-3         S           VWC-3         S           VWC-3         S           WT-2         S           P-1         S           VWC-3         S           WT-2         S           WT-3         S           WT-3         S           P-1         S</td><td>AP-1NO WALLCOVERING AT EXTERIOR WALL, REFER TO INTERIOR ELEVATIONS FOR CASEWORKAP-1NO WALLCOVERING AT EXTERIOR WALL, REFER TO INTERIOR ELEVATIONS FOR CASEWORKAP-1NO WALLCOVERING AT EXTERIOR WALL, REFER TO INTERIOR ELEVATIONS FOR CASEWORKAP-1REFER TO ELEVATIONS FOR CASEWORKAP-2WALL TILE FLOOR TO CEILINGAP-1MS-3 SHELVES IN THIS LOCATIONAP-1AP-1AP-1AP-1AP-1REFER TO ELEVATIONS FOR CASEWORKAP-1REFER TO ELEVATIONS FOR CASEWORKAP-2WALL TILE FLOOR TO CEILING</td><td>D106<br/>D107<br/>D108<br/>D109<br/>D110<br/>D111<br/>D112<br/>D113<br/>D114<br/>D115</td><td>RR<br/>STAIR<br/>SPEECH<br/>SPED<br/>RR<br/>MAINTENANCE STORAGE<br/>SPED OFFICE</td><td>EPF-1           SC-1           CPT-2           LVT-1           EPF-1           VCT-1</td><td>EFB RB-1 RB-1 RB-1 RB-1 EPB</td><td>WT-2<br/>P-1<br/>VWC-3<br/>VWC-4</td><td>WT-3<br/>P-1<br/>VWC-3<br/>VWC-3<br/>WT-2</td><td>WT-2           P-1           VWC-3           VWC-3           WT-3           P-1</td><td>WT-2<br/>P-1<br/>VWC-3<br/>VWC-3<br/>WT-2</td><td>SAP-2     WALL TILE FLOOR TO CEILING       EXP    </td></tr<>  | VWC-3           VWC-3           VWC-3           WT-2           P-1           VWC-3           VWC-3           VWC-3           VWC-3           VWC-3           VWC-3           VWC-3           P-1   | VWC-3           P-1           VWC-4           WT-3/WT-2           P-1           VWC-4           VWC-4           VWC-3           VWC-3           WT-3           WT-2           P-1           P-1   | P-1<br>P-1<br>P-1<br>VWC-3<br>WT-2<br>P-1<br>VWC-3<br>VWC-3<br>VWC-3<br>VWC-3<br>VWC-3<br>VWC-3<br>WT-2<br>WT-2<br>P-1<br>P-1<br>P-1<br>P-1  | VWC-3         S           VWC-3         S           VWC-3         S           VWC-3         S           WT-2         S           P-1         S           VWC-3         S           WT-2         S           WT-3         S           WT-3         S           P-1         S   | AP-1NO WALLCOVERING AT EXTERIOR WALL, REFER TO INTERIOR ELEVATIONS FOR CASEWORKAP-1NO WALLCOVERING AT EXTERIOR WALL, REFER TO INTERIOR ELEVATIONS FOR CASEWORKAP-1NO WALLCOVERING AT EXTERIOR WALL, REFER TO INTERIOR ELEVATIONS FOR CASEWORKAP-1REFER TO ELEVATIONS FOR CASEWORKAP-2WALL TILE FLOOR TO CEILINGAP-1MS-3 SHELVES IN THIS LOCATIONAP-1AP-1AP-1AP-1AP-1REFER TO ELEVATIONS FOR CASEWORKAP-1REFER TO ELEVATIONS FOR CASEWORKAP-2WALL TILE FLOOR TO CEILING  | D106<br>D107<br>D108<br>D109<br>D110<br>D111<br>D112<br>D113<br>D114<br>D115  | RR<br>STAIR<br>SPEECH<br>SPED<br>RR<br>MAINTENANCE STORAGE<br>SPED OFFICE   | EPF-1           SC-1           CPT-2           LVT-1           EPF-1           VCT-1   | EFB RB-1 RB-1 RB-1 RB-1 EPB  | WT-2<br>P-1<br>VWC-3<br>VWC-4   | WT-3<br>P-1<br>VWC-3<br>VWC-3<br>WT-2  | WT-2           P-1           VWC-3           VWC-3           WT-3           P-1   | WT-2<br>P-1<br>VWC-3<br>VWC-3<br>WT-2  | SAP-2     WALL TILE FLOOR TO CEILING       EXP   |
| PRINCIPAL<br>CLINIC<br>RR<br>STO.<br>EXAM/ISO<br>COT<br>CORRIDOR<br>SECURITY<br>RR<br>RR<br>VAULT / FILES<br>STORAGE<br>MDF<br>LOUNGE<br>WORKROOM<br>COUNSELOR<br>COUNSELOR<br>ELEC<br>ART<br>CORRIDOR<br>FLEX<br>KIVA  | CPT-1           LVT-1           EPF-1           VCT-1           LVT-1           LVT-1           CPT-1, WF-1           CPT-1           EPF-1           EPF-1           VCT-1           VCT-1           CPT-1           EPF-1           EPF-1           VCT-1           VCT-1           VCT-1           SC-1           LVT-1           CPT-1           SEALED CONCRETE  | RB-1         RB-1 <t< td=""><td>VWC-3           VWC-3           WT-2           P-1           VWC-3           VWC-3           VWC-3           WT-2           WT-2           P-1           P-1</td><td>P-1<br/>VWC-4<br/>WT-3/WT-2<br/>P-1<br/>VWC-4<br/>VWC-4<br/>VWC-3<br/>VWC-3<br/>WT-3<br/>WT-3<br/>WT-2<br/>P-1<br/>P-1<br/>P-1<br/>P-1<br/>P-1<br/>P-1</td><td>P-1<br/>P-1<br/>VWC-3<br/>WT-2<br/>P-1<br/>VWC-3<br/>VWC-3<br/>VWC-3<br/>VWC-3<br/>VWC-3<br/>WT-2<br/>WT-2<br/>P-1<br/>P-1<br/>P-1<br/>P-1</td><td>VWC-3         S           VWC-3         S           VWC-3         S           WT-2         S           P-1         S           VWC-3         S           WT-2         S           WT-2         S           WT-3         S           P-1         S</td><td>AP-1NO WALLCOVERING AT EXTERIOR WALL, REFER TO INTERIOR ELEVATIONS FOR CASEWORKAP-1NO WALLCOVERING AT EXTERIOR WALL, REFER TO INTERIOR ELEVATIONS FOR CASEWORKAP-1REFER TO ELEVATIONS FOR CASEWORKAP-2WALL TILE FLOOR TO CEILINGAP-1MS-3 SHELVES IN THIS LOCATIONAP-1AP-1AP-1AP-1AP-1REFER TO ELEVATIONS FOR CASEWORKAP-1REFER TO ELEVATIONS FOR CASEWORKAP-1REFER TO ELEVATIONS FOR CASEWORKAP-1REFER TO ELEVATIONS FOR CASEWORK. WEAPON RACK IN THIS ROOMAP-2WALL TILE FLOOR TO CEILING</td><td>D107<br/>D108<br/>D109<br/>D110<br/>D111<br/>D112<br/>D113<br/>D114<br/>D115</td><td>SPEECH<br/>SPED<br/>RR<br/>MAINTENANCE STORAGE<br/>SPED OFFICE</td><td>CPT-2<br/>LVT-1<br/>EPF-1<br/>VCT-1</td><td>RB-1<br/>RB-1<br/>EPB</td><td>VWC-3<br/>VWC-4</td><td>VWC-3<br/>VWC-3<br/>WT-2</td><td>VWC-3           VWC-3           WT-3           P-1</td><td>WC-3<br/>WC-3<br/>WT-2</td><td>SAP-1     REFER TO ELEVATIONS FOR CASEWORK       SAP-1     REFER TO ELEVATIONS FOR CASEWORK AND TEACHING WALL       SAP-2     WALL TILE FLOOR TO CEILING</td></t<>  | VWC-3           VWC-3           WT-2           P-1           VWC-3           VWC-3           VWC-3           WT-2           WT-2           P-1   | P-1<br>VWC-4<br>WT-3/WT-2<br>P-1<br>VWC-4<br>VWC-4<br>VWC-3<br>VWC-3<br>WT-3<br>WT-3<br>WT-2<br>P-1<br>P-1<br>P-1<br>P-1<br>P-1<br>P-1  | P-1<br>P-1<br>VWC-3<br>WT-2<br>P-1<br>VWC-3<br>VWC-3<br>VWC-3<br>VWC-3<br>VWC-3<br>WT-2<br>WT-2<br>P-1<br>P-1<br>P-1<br>P-1  | VWC-3         S           VWC-3         S           VWC-3         S           WT-2         S           P-1         S           VWC-3         S           WT-2         S           WT-2         S           WT-3         S           P-1         S   | AP-1NO WALLCOVERING AT EXTERIOR WALL, REFER TO INTERIOR ELEVATIONS FOR CASEWORKAP-1NO WALLCOVERING AT EXTERIOR WALL, REFER TO INTERIOR ELEVATIONS FOR CASEWORKAP-1REFER TO ELEVATIONS FOR CASEWORKAP-2WALL TILE FLOOR TO CEILINGAP-1MS-3 SHELVES IN THIS LOCATIONAP-1AP-1AP-1AP-1AP-1REFER TO ELEVATIONS FOR CASEWORKAP-1REFER TO ELEVATIONS FOR CASEWORKAP-1REFER TO ELEVATIONS FOR CASEWORKAP-1REFER TO ELEVATIONS FOR CASEWORK. WEAPON RACK IN THIS ROOMAP-2WALL TILE FLOOR TO CEILING   | D107<br>D108<br>D109<br>D110<br>D111<br>D112<br>D113<br>D114<br>D115  | SPEECH<br>SPED<br>RR<br>MAINTENANCE STORAGE<br>SPED OFFICE  | CPT-2<br>LVT-1<br>EPF-1<br>VCT-1   | RB-1<br>RB-1<br>EPB  | VWC-3<br>VWC-4  | VWC-3<br>VWC-3<br>WT-2   | VWC-3           VWC-3           WT-3           P-1  | WC-3<br>WC-3<br>WT-2   | SAP-1     REFER TO ELEVATIONS FOR CASEWORK       SAP-1     REFER TO ELEVATIONS FOR CASEWORK AND TEACHING WALL       SAP-2     WALL TILE FLOOR TO CEILING   |
| CLINIC<br>RR<br>STO.<br>EXAM/ISO<br>COT<br>CORRIDOR<br>SECURITY<br>RR<br>RR<br>VAULT / FILES<br>STORAGE<br>MDF<br>LOUNGE<br>WORKROOM<br>COUNSELOR<br>COUNSELOR<br>ELEC<br>ART<br>CORRIDOR<br>FLEX<br>KIVA   | LVT-1<br>EPF-1<br>VCT-1<br>LVT-1<br>LVT-1<br>CPT-1, WF-1<br>CPT-1<br>EPF-1<br>EPF-1<br>VCT-1<br>VCT-1<br>VCT-1<br>SC-1<br>LVT-1<br>LVT-1<br>LVT-1<br>CPT-1<br>SEALED CONCRETE   | RB-1         EPB         RB-1         RB-1         RB-1         RB-1         EPB         EPB         RB-1  | VWC-3           WT-2           P-1           VWC-3           VWC-3           VWC-3           WT-2           WT-2           P-1   | WT-3/WT-2           P-1           VWC-4           VWC-3           VWC-3           WT-3           WT-2           P-1           P-1           P-1           P-1   | VWC-3           WT-2           P-1           VWC-3           VWC-3           VWC-3           WT-2           WT-2           P-1           P-1           P-1   | VWC-3         S           WT-2         S           P-1         S           VWC-3         S           VWC-3         S           VWC-3         S           VWC-3         S           VWC-3         S           WT-2         S           WT-2         S           WT-3         S           P-1         S   | AP-1       REFER TO ELEVATIONS FOR CASEWORK         AP-2       WALL TILE FLOOR TO CEILING         AP-1       MS-3 SHELVES IN THIS LOCATION         AP-1       AP-1         AP-1       AP-1         AP-1       REFER TO ELEVATIONS FOR CASEWORK         AP-1, GYP       REFER TO ELEVATIONS FOR CASEWORK         AP-1       REFER TO ELEVATIONS FOR CASEWORK. WEAPON RACK IN THIS ROOM         AP-2       WALL TILE FLOOR TO CEILING   | D109<br>D110<br>D111<br>D112<br>D113<br>D114<br>D115  | SPED<br>RR<br>MAINTENANCE STORAGE<br>SPED OFFICE  | LVT-1<br>EPF-1<br>VCT-1  | RB-1<br>EPB  | VWC-4   | VWC-3<br>WT-2  | VWC-3<br>WT-3<br>P-1  | VWC-3<br>WT-2  | SAP-1         REFER TO ELEVATIONS FOR CASEWORK AND TEACHING WALL           SAP-2         WALL TILE FLOOR TO CEILING  |
| EXAM/ISO<br>COT<br>CORRIDOR<br>SECURITY<br>RR<br>RR<br>VAULT / FILES<br>STORAGE<br>MDF<br>LOUNGE<br>WORKROOM<br>COUNSELOR<br>COUNSELOR<br>ELEC<br>ART<br>CORRIDOR<br>FLEX<br>KIVA   | VCT-1<br>LVT-1<br>LVT-1<br>CPT-1, WF-1<br>CPT-1, WF-1<br>CPT-1<br>EPF-1<br>EPF-1<br>VCT-1<br>VCT-1<br>VCT-1<br>SC-1<br>LVT-1<br>LVT-1<br>CPT-1<br>SEALED CONCRETE   | RB-1         RB-1         RB-1         RB-1         EPB         EPB         RB-1   | P-1<br>VWC-3<br>VWC-3<br>VWC-3<br>VWC-3<br>WT-2<br>WT-2<br>WT-2<br>P-1<br>P-1<br>P-1<br>P-1<br>P-1<br>P-1<br>P-1<br>P-1<br>P-1<br>P-1  | P-1<br>VWC-4<br>VWC-3<br>VWC-3<br>VWC-3<br>WT-3<br>WT-2<br>P-1<br>P-1<br>P-1<br>P-1<br>P-1<br>P-1   | P-1<br>VWC-3<br>VWC-3<br>VWC-3<br>VWC-3<br>WT-2<br>WT-2<br>P-1<br>P-1<br>P-1<br>P-1  | P-1         S           VWC-3         S           VWC-3         S           VWC-3         S           VWC-3         S           VWC-3         S           WT-2         S           WT-3         S           P-1         S   | AP-1       MS-3 SHELVES IN THIS LOCATION         AP-1       AP-1         AP-1, GYP       REFER TO ELEVATIONS FOR CASEWORK         AP-1       REFER TO ELEVATIONS FOR CASEWORK. WEAPON RACK IN THIS ROOM         AP-2       WALL TILE FLOOR TO CEILING   | D111<br>D112<br>D113<br>D114<br>D115  | SPED OFFICE   | VCT-1  |  | WT-2  | =  | P-1   |  |  |
| COT<br>CORRIDOR<br>SECURITY<br>RR<br>RR<br>VAULT / FILES<br>STORAGE<br>MDF<br>LOUNGE<br>WORKROOM<br>COUNSELOR<br>COUNSELOR<br>ELEC<br>ART<br>CORRIDOR<br>FLEX<br>KIVA   | LVT-1<br>CPT-1, WF-1<br>CPT-1<br>EPF-1<br>EPF-1<br>VCT-1<br>VCT-1<br>VCT-1<br>SC-1<br>LVT-1<br>LVT-1<br>LVT-1<br>CPT-1<br>SEALED CONCRETE   | RB-1           RB-1           RB-1           EPB           RB-1   | VWC-3           VWC-3           VWC-3           WT-2           P-1   | VWC-4           VWC-3           VWC-3           WT-3           WT-2           P-1           P-1           P-1           P-1           P-1           P-1   | VWC-3           VWC-3           VWC-3           WT-2           WT-2           P-1           P-1           P-1  | VWC-3         S           VWC-3         S           VWC-3         S           WWC-3         S           WT-2         S           WT-3         S           P-1         S   | AP-1       AP-1, GYP       REFER TO ELEVATIONS FOR CASEWORK         AP-1       REFER TO ELEVATIONS FOR CASEWORK. WEAPON RACK IN THIS ROOM         AP-2       WALL TILE FLOOR TO CEILING   | D113<br>D114<br>D115  |   | CDT 2  |  | P-1   | 1 1  |   |  |  |
| SECURITY<br>RR<br>RR<br>VAULT / FILES<br>STORAGE<br>MDF<br>LOUNGE<br>WORKROOM<br>COUNSELOR<br>COUNSELOR<br>ELEC<br>ART<br>CORRIDOR<br>FLEX<br>KIVA  | CPT-1           EPF-1           EPF-1           VCT-1           VCT-1           SC-1           LVT-1           CPT-1           SC-1           SC-1           SC-1           SC-1           SC-1           SC-1           SC-1           SC-1           LVT-1           CPT-1           SEALED CONCRETE  | RB-1<br>EPB<br>EPB<br>RB-1<br>RB-1<br>RB-1<br>RB-1<br>RB-1<br>RB-1<br>RB-1<br>RB-   | VWC-3<br>WT-2<br>WT-2<br>P-1<br>P-1<br>P-1<br>P-1<br>P-1<br>P-1<br>P-1<br>P-1  | VWC-3<br>WT-3<br>WT-2<br>P-1<br>P-1<br>P-1<br>P-1<br>P-1  | VWC-3<br>WT-2<br>WT-2<br>P-1<br>P-1<br>P-1   | VWC-3         S           WT-2         S           WT-3         S           P-1         S   | AP-1         REFER TO ELEVATIONS FOR CASEWORK. WEAPON RACK IN THIS ROOM           AP-2         WALL TILE FLOOR TO CEILING   | D115  |   | CPT-2  | RB-1<br>RB-1   | VWC-3<br>VWC-3  | VWC-3<br>VWC-3   | VWC-3<br>VWC-3  |  | SAP-1         REFER TO ELEVATIONS FOR CASEWORK           SAP-1         REFER TO ELEVATIONS FOR CASEWORK  |
| RR<br>RR<br>VAULT / FILES<br>STORAGE<br>MDF<br>LOUNGE<br>WORKROOM<br>COUNSELOR<br>COUNSELOR<br>ELEC<br>ART<br>CORRIDOR<br>FLEX<br>KIVA  | EPF-1<br>EPF-1<br>VCT-1<br>VCT-1<br>SC-1<br>LVT-1<br>LVT-1<br>LVT-1<br>CPT-1<br>SEALED CONCRETE   | EPB<br>EPB<br>RB-1<br>RB-1<br>RB-1<br>RB-1<br>RB-1<br>RB-1<br>RB-1<br>RB-   | WT-2<br>WT-2<br>P-1<br>P-1<br>P-1<br>P-1<br>P-1<br>P-1<br>P-1  | WT-3<br>WT-2<br>P-1<br>P-1<br>P-1<br>P-1<br>P-1   | WT-2<br>WT-2<br>P-1<br>P-1<br>P-1  | WT-2         S           WT-3         S           P-1         S   | AP-2 WALL TILE FLOOR TO CEILING   |   | SPED<br>SPED  | LVT-1<br>LVT-1   | RB-1<br>RB-1   | VWC-3<br>VWC-3  | VWC-3<br>VWC-3   | VWC-4<br>VWC-4  |  | SAP-1         REFER TO ELEVATIONS FOR CASEWORK AND TEACHING WALL           SAP-1         REFER TO ELEVATIONS FOR CASEWORK AND TEACHING WALL  |
| STORAGE<br>MDF<br>LOUNGE<br>WORKROOM<br>COUNSELOR<br>COUNSELOR<br>ELEC<br>ART<br>CORRIDOR<br>FLEX<br>KIVA   | VCT-1<br>VCT-1<br>SC-1<br>LVT-1<br>LVT-1<br>CPT-1<br>SEALED CONCRETE  | RB-1<br>RB-1<br>RB-1<br>RB-1<br>RB-1<br>RB-1<br>RB-1<br>RB-1  | P-1<br>P-1<br>P-1<br>P-1<br>P-1<br>P-1<br>P-1  | P-1<br>P-1<br>P-1<br>P-1  | P-1<br>P-1<br>P-1  | P-1 S   |   | D110  | ESL COACH<br>BB   | CPT-2<br>EPF-1   | RB-1<br>EPB  | VWC-3<br>WT-2   | VWC-3<br>WT-2  | VWC-3<br>WT-2   |  | SAP-1     REFER TO ELEVATIONS FOR CASEWORK       SAP-2     WALL TILE FLOOR TO CEILING  |
| MDF<br>LOUNGE<br>WORKROOM<br>COUNSELOR<br>COUNSELOR<br>ELEC<br>ART<br>CORRIDOR<br>FLEX<br>KIVA  | SC-1<br>LVT-1<br>LVT-1<br>CPT-1<br>SEALED CONCRETE  | RB-1<br>RB-1<br>RB-1<br>RB-1<br>RB-1<br>RB-1<br>RB-1  | P-1<br>P-1<br>P-1<br>P-1<br>P-1  | P-1   | P-1  | P-1 IS  | AP-1 VAULT, MS-2 & 3 IN THIS ROOM   | D118  | SPED VEST   | VCT-1  | RB-1   | VWC-3   | VWC-3  | VWC-3   | VWC-3  | SAP-1  |
| WORKROOM<br>COUNSELOR<br>ELEC<br>ART<br>CORRIDOR<br>FLEX<br>KIVA  | LVT-1<br>CPT-1  | RB-1<br>RB-1<br>RB-1<br>RB-1  | P-1<br>P-1   | I - I   | \/\/\/2  | P-1 E   | AP-1<br>KP  | D119<br>D120  | STO.<br>ESL COACH   | VCT-1<br>CPT-2   | RB-1<br>RB-1   | P-1<br>VWC-3  | P-1<br>VWC-3   | P-1<br>VWC-3  | VWC-3  | SAP-1 REFER TO ELEVATIONS FOR CASEWORK   |
| COUNSELOR<br>ELEC<br>ART<br>CORRIDOR<br>FLEX<br>KIVA  | SEALED CONCRETE   | RB-1<br>RB-1  | 1 1  |   | VWC-3  |   | AP-1         NO WALLCOVERING AT EXTERIOR WALL, REFER TO INTERIOR ELEVATIONS FOR CASEWORK           AP-1         NO WALLCOVERING AT EXTERIOR WALL, REFER TO INTERIOR ELEVATIONS FOR CASEWORK   | D121<br>D122  | RR<br>SPED  | EPF-1<br>LVT-1   | EPB<br>RB-1  | WT-2<br>VWC-4   | WT-2<br>VWC-3  | WT-3<br>VWC-3   |  | SAP-2         WALL TILE FLOOR TO CEILING           SAP-1         REFER TO ELEVATIONS FOR CASEWORK AND TEACHING WALL  |
| ART<br>CORRIDOR<br>FLEX<br>KIVA   | SEALED CONCRETE   |   |  | VWC-3<br>VWC-3  | VWC-3<br>VWC-3   |   | AP-1         NO WALLCOVERING AT EXTERIOR WALL, REFER TO INTERIOR ELEVATIONS FOR CASEWORK           AP-1         REFER TO ELEVATIONS FOR CASEWORK  | D123  | SPED  | LVT-1  | RB-1   | VWC-4   | VWC-3  | VWC-3   | VWC-3  | SAP-1 REFER TO ELEVATIONS FOR CASEWORK AND TEACHING WALL   |
| FLEX<br>KIVA  |   | RB-1  | P1<br>VWC-4  | P1<br>P-1   | P1<br>VWC-3  | P1 E  | KP         REFER TO ELEVATION FOR TEACHING WALL & CASEWORK, NO WALL COVERING AT EXTERIOR  | -   |   |  |  |   |  |   |  |  |
| FLEX<br>KIVA  | T-2   |   | WT-1, VWC-3, P-1   |   | WT-1, VWC-3, P-1   |   | WALL AP-1 REFER TO ELEVATION FOR TEACHING WALL & CASEWORK, NO WALL COVERING AT EXTERIOR WALL AP-1 REFER TO ELEVATIONS   |   |   |  |  | ROOM F  | INISH SCHED  | ULE - FIRST FL  | OOR - AREA   | E  |
|   | CPT-2   | -<br>RB-1   | VWC-3  | -<br>VWC-3  | VWC-3  | VWC-4 S   | AP-1, GYP REFER TO TEACHING WALL ELEVATION  |   |   |  |  |   | WAL  |   | •  | CEILING  |
| LARGE GROUP   | CPT-2<br>CPT-2  | RB-1<br>RB-1  | VWC-4<br>VWC-4   | VWC-3<br>VWC-3  | VWC-3<br>VWC-3   | VWC-3 S   | AP-1, GYP     REFER TO ELEVATION FOR TEACHING WALL       AP-1, GYP     REFER TO ELEVATION FOR TEACHING WALL   | ROOM #  |   | FLOOR  | BASE   | NORTH   | EAST   | SOUTH   | WEST   | FINISH REMARKS   |
| FLEX<br>LIBRARY   | CPT-2<br>CPT-1  | RB-1<br>RB-1  | WC-3<br>REFER TO ELEVATION   | VWC-4<br>REFER TO ELEVATION   | VWC-3<br>P-1   | VWC-3 S<br>REFER TO ELEVATION S   | AP-1, GYP         REFER TO ELEVATION FOR TEACHING WALL           AP-1, GYP         MOTORIZED ROLLER SHADES AT EXTERIOR WALL   | E100<br>E100  | CORRIDOR  | T-1, T-2   | -  |   | WT-1, VWC-3, P-1   |   | ,,   | SAP-1, GYP SEE INT. ELEVATION  |
| COMP STO.<br>AV STO.  | VCT-1<br>VCT-1  | RB-1<br>RB-1  | P-1<br>P-1   | P-1<br>P-1  | P-1<br>P-1   |   | AP-1<br>AP-1  | E101<br>E102  | CORRIDOR<br>COLLABORATION   | CPT-1, CPT-2. WF-1<br>CPT-2  | RB-1<br>RB-1   | WT-1, VWC-3, P-1<br>-   | WT-1, VWC-3, P-1<br>VWC-4  | WT-1, VWC-3, P-1<br>-   |  | SAP-1, AWC, GYP     SEE INT. ELEVATION       AWC     SEE INT. ELEVATIONS   |
| COMPUTER LAB  | CPT-1   | RB-1<br>RB-1  | VWC-4<br>VWC-1   | VWC-3<br>VWC-1  | P-1<br>VWC-1   | VWC-3 S   | AP-1 REFER TO ELEVATION FOR TEACHING WALL, MOTORIZED ROLLER SHADES AT EXTERIOR WALL   | E103<br>E104  | 5TH GRADE<br>4TH GRADE  | CPT-1<br>CPT-1   | RB-1<br>RB-1   | P-4<br>VWC-3  | VWC-3<br>VWC-3   | VWC-3<br>VWC-4  |  | SAP-1REFER TO ELEVATIONS FOR CASEWORK AND TEACHING WALLSAP-1REFER TO ELEVATIONS FOR CASEWORK AND TEACHING WALL   |
| OFFICE  | OI 1-1/LV1-1  |   | VW0-1  | VVV0-1  | VVV0-1   | VVV0-10   |   | E105  | 4TH GRADE   | CPT-1  | RB-1   | VWC-3   | VWC-3  | P-4   |  | SAP-1         REFER TO ELEVATIONS FOR CASEWORK AND TEACHING WALL           SAP-1         REFER TO ELEVATIONS FOR CASEWORK AND TEACHING WALL  |
|   |   |   |  |   |  |   |   | E107  | 4TH GRADE   | CPT-1  | RB-1   | VWC-3   | VWC-4  | P-1   | VWC-3  | SAP-1 REFER TO ELEVATIONS FOR CASEWORK AND TEACHING WALL   |
|   |   |   | 1  |   |  | ST FLOOR - AREA E   |   | E109  | 4TH GRADE   | CPT-1  | RB-1   | VWC-3<br>VWC-3  | VWC-4  | VWC-3<br>VWC-3  | VWC-3  | SAP-1         REFER TO ELEVATIONS FOR CASEWORK AND TEACHING WALL           SAP-1         REFER TO ELEVATIONS FOR CASEWORK AND TEACHING WALL  |
|   | EL OOP  | BVSE  |  |   |  | WEST  |   | E110<br>E111  | SCIENCE STO.<br>CUSTODIAN STO.  | VCT-1<br>SC-1  | RB-1<br>RB-1   | P-1<br>P-1  | P-1<br>P-1   | P-1<br>P-1  |  | SAP-1 SAP-1  |
| CORRIDOR  | T-1, T-2  | -   | -  | SEE INT. ELEVATION  | -  | SEE INT. ELEVATION  | SAP-1, GYP WALL TILE UP TO TOP OF DOOR, REFER TO ELEVATIONS   | E112<br>E113  | BOOK ROOM<br>ELECTRICAL   | SC-1<br>SC-1   | RB-1<br>RB-1   | P-1   | P-1<br>P-1   | P-1<br>P-1  | P-1<br>P-1   | SAP-1 EXP  |
| CORRIDOR<br>CORRIDOR  | EPF-1<br>CPT-1, CPT-2, WF-1   | EPB<br>RB-1   | WT-2, P-4<br>WT-1, VWC-3   | WT-2<br>WT-1, VWC-3   | REFER TO ELEVATION<br>WT-1, VWC-3  | WT-1, VWC-3   |   | E114  | TEACHER PREP  | VCT-1  | RB-1   | VWC-3   | VWC-3  | VWC-3   | VWC-3  | SAP-1 A<br>SAP-2   |
| COLLABORATION<br>COLLABORATION  | CPT-2<br>CPT-2, WF-1  | RB-1<br>RB-1  | -<br>SEE INT. ELEVATION  | SEE INT. ELEVATION  | -  |   |   | E116  | 5TH GRADE   | CPT-1  | RB-1   | P-1   | VWC-4  | VWC-3   |  | SAP-1 REFER TO ELEVATIONS FOR CASEWORK AND TEACHING WALL   |
| COLLABORATION   | CPT-2, WF-1   | RB-1  | SEE INT. ELEVATION   | -<br>P.1  | -<br>P-1   |   | AWC   | – E118  | 5TH GRADE   | CPT-1  | RB-1   | P-1<br>P-1  | VWC-3  | VWC-3   | VWC-4  | SAP-1         REFER TO ELEVATIONS FOR CASEWORK AND TEACHING WALL           SAP-1         REFER TO ELEVATIONS FOR CASEWORK AND TEACHING WALL  |
| DIAG.   | CPT-1   | RB-1  | VWC-3  | VWC-3   | VWC-3  | VWC-3   | SAP-1 REFER TO ELEVATIONS FOR CASEWORK  | E120  | 5TH GRADE<br>5TH GRADE  | CPT-1<br>CPT-1   | RB-1<br>RB-1   | P-1<br>P-1  | VWC-4<br>VWC-3   | VWC-3<br>VWC-3  |  | SAP-1         REFER TO ELEVATIONS FOR CASEWORK AND TEACHING WALL           SAP-1         REFER TO ELEVATIONS FOR CASEWORK AND TEACHING WALL  |
| ART STO.  | LVT-1   | RB-1  | P-1  | P-1   | P-1  | P-1   | SAP-1 REFER TO ELEVATIONS FOR CASEWORK  | E121<br>E121A   | TLT<br>TLT VEST   | EPF-1<br>EPF-1   | EPB<br>EPB   | WT-2<br>WT-3  | WT-2<br>WT-2,P-4   | WT-2<br>WT-2,P-4  | -  | SAP-2     WALL TILE FLOOR TO CEILING       GYP     WALL TILE UP TO TOP OF DOOR, REFER TO ELEVATIONS  |
|   |   |   |  |   |  |   | TEACHING WALL   | E122<br>E123  | TLT<br>TI T   | EPF-1<br>EPF-1   | EPB<br>EPB   | WT-2  | WT-3<br>WT-2   | WT-2<br>WT-2  |  | SAP-2     WALL TILE FLOOR TO CEILING       SAP-2     WALL TILE FLOOR TO CEILING  |
|   |   |   |  |   |  |   | TEACHING WALL   | E123A   | TLT VEST  | EPF-1  | EPB  | WT-2, P-4   | WT-2, P-4  | WT-3  | WT-2, P-4  | GYP     WALL TILE UP TO TOP OF DOOR, REFER TO ELEVATIONS       SAP-2     WALL TILE FLOOR TO CEILING  |
|   |   |   |  |   |  |   | TEACHING WALL   | E125  | TLT   | EPF-1  | EPB  | WT-2<br>WT-2  | WT-2   | WT-2<br>WT-3  | WT-2   | SAP-2 WALL TILE FLOOR TO CEILING   |
|   |   |   |  |   |  |   | TEACHING WALL   | E127  | CUST  | SC-1   | RB-1   | P-1   | P-1  | P-1   | P-1  | SAP-2 WALL TILE FLOOR TO CEILING SAP-2   |
|   | -   |   |  |   |  |   | TEACHING WALL   | E130  | IDF   | SEALED CONCRETE  | RB-1<br>RB-1   | P-1<br>P-1  | P-1<br>P-1   | P-1<br>P-1  | 1 - 1  | SAP-1 <u>Z</u><br>SAP-1  |
|   |   |   |  |   |  |   | TEACHING WALL   | E131  | STORAGE   | VCIA   | RB-1   | P-1   | P-1  | P-1   | P-1  | SAP-1  |
|   |   |   |  |   |  |   | TEACHING WALL   |   |   |  |  |   |  |   |  | E  |
|   |   |   |  |   |  |   | TEACHING WALL   | _   |   |  |  |   |  |   | .UUR - AREA  |  |
|   |   |   | P-4  | P-1   |  |   | TEACHING WALL   | ROOM #  | ROOM NAME   | FLOOR  | BASE   | NORTH   | EAST   | SOUTH   | WEST   | CEILING<br>FINISH REMARKS  |
|   |   |   |  |   |  |   | TEACHING WALL   | F100<br>F101  | CORRIDOR<br>CORRIDOR  | T-1, T-2<br>CPT-1, CPT-2, WF-1   | -<br>RB-1  |   | WT-1, VWC-3, P-1<br>WT-1, VWC-3, P-1   |   |  | SAP-1         SEE INT. ELEVATION           SAP-1, AWC, GYP         SEE INT. ELEVATION  |
|   |   |   |  |   |  |   | TEACHING WALL   | F103  | 3RD GRADE   | CPT-1  | RB-1<br>RB-1   | VWC-4   | VWC-3  | VWC-3   | P-1  | SAP-1     REFER TO ELEVATIONS FOR CASEWORK AND TEACHING WALL       SAP-1     REFER TO ELEVATIONS FOR CASEWORK AND TEACHING WALL  |
|   |   |   |  |   | P-1  |   | TEACHING WALL   | F105  | 2ND GRADE   | CPT-1  | RB-1   | VWC-3   | VWC-3  | VWC-4   | P-1  | SAP-1 REFER TO ELEVATIONS FOR CASEWORK AND TEACHING WALL   |
| PRE-K   |   |   |  |   |  |   | TEACHING WALL   | F107  | 2ND GRADE   | CPT-1  | RB-1   | VWC-3   | VWC-4  | P-1   | VWC-4  | SAP-1         REFER TO ELEVATIONS FOR CASEWORK AND TEACHING WALL           SAP-1         REFER TO ELEVATIONS FOR CASEWORK AND TEACHING WALL  |
| RR<br>PRE-K   | EPF-1<br>CPT-1, LVT-1   | RB-1  | P-1  | VWC-4   | WT-2<br>VWC-3  | VWC-3   | SAP-1 REFER TO ELEVATIONS FOR CASEWORK AND TEACHING WALL  | F109  | 2ND GRADE   | CPT-1  | RB-1<br>RB-1   | VWC-3<br>VWC-3  | VWC-4<br>VWC-3   | P-1<br>P-1  | VWC-4  | SAP-1         REFER TO ELEVATIONS FOR CASEWORK AND TEACHING WALL           SAP-1         REFER TO ELEVATIONS FOR CASEWORK AND TEACHING WALL  |
| RR<br>LIT LIB   | EPF-1<br>VCT-1  | EPB<br>RB-1   | WT-2<br>P-1  | WT-3<br>P-1   | WT-2<br>P-1  |   |   | F110<br>F111  | 2ND GRADE<br>ELEC   | CPT-1<br>SC-1  | RB-1<br>RB-1   | VWC-3<br>P-1  | VWC-4<br>P-1   | P-1<br>P-1  |  | SAP-1         REFER TO ELEVATIONS FOR CASEWORK AND TEACHING WALL           EXP   |
| MATH STOR<br>ELECTRICAL   | VCT-1   | RB-1<br>RB-1  | P-1<br>P-1   | P-1<br>P-1  | P-1<br>P-1   |   |   | F112<br>F113  | IDF<br>INSTRUCTIONAL COACH  | SC-1<br>CPT-1  | RB-1<br>RB-1   | P-1<br>VWC-3  | P-1<br>VWC-3   | P-1<br>VWC-3  |  | SAP-1 REFER TO ELEVATIONS FOR CASEWORK   |
| BOOK ROOM   |   | RB-1<br>RB-1  | P-1  | P-1<br>P-1  | P-1  | P-1   | SAP-1   | F114  | COLLABORATION   | CPT-2  | RB-1   | VWC-3   | VWC-3  | VWC-3   | VWC-4  | SAP-1 REFER TO ELEVATIONS FOR CASEWORK   |
| CUST  | Uscr  | RB-1  | P-1  | P-1   | P-1  | P-1   | SAP-2   | F116  | SCIENCE   | LVT-1  | RB-1   | VWC-3   | VWC-4  | VWC-3   | P-1  | SAP-1         REFER TO ELEVATIONS FOR CASEWORK  |
| TLT   | EPF-1   | EPB   | WT-3   | WT-2  | WT-2   | WT-2  | SAP-2 WALL TILE FLOOR TO CEILING  | F118  | 3RD GRADE   | CPT-1  | RB-1   | P-1   | VWC-3  | VWC-3   | VWC-4  | SAP-1 REFER TO ELEVATIONS FOR CASEWORK AND TEACHING WALL   |
| TLT VEST  | EPF-1   | EPB   |  | WT-2  | WT-2   |   |   | F120  | 3RD GRADE<br>3RD GRADE  | CPT-1  | RB-1   | P-1<br>P-1  | VWC-3  | VWC-3   |  | SAP-1         REFER TO ELEVATIONS FOR CASEWORK AND TEACHING WALL           SAP-1         REFER TO ELEVATIONS FOR CASEWORK AND TEACHING WALL  |
| TLT<br>TLT  | EPF-1<br>EPF-1  | EPB<br>EPB  | WT-2<br>WT-2   | WT-3<br>WT-2  | WT-2<br>WT-2   |   |   | F121<br>F121A   | TLT<br>TLT VEST   | EPF-1<br>EPF-1   | EPB<br>EPB   | WT-2<br>WT-2, P-4   | WT-2<br>WT-2, P-4  | WT-2<br>WT-3  |  | SAP-2         WALL TILE FLOOR TO CEILING           GYP         WALL TILE UP TO TOP OF DOOR, REFER TO ELEVATIONS  |
| TLT VEST<br>TLT   | EPF-1   | EPB   | REFER TO ELEVATION   | WT-2, P-4   | WT-2,P-4   | WT-2, P-4   | GYP WALL TILE UP TO TOP OF DOOR, REFER TO ELEVATIONS  | F122  | TLT<br>TLT  | EPF-1  | EPB  | WT-2  | WT-3   | WT-2  | WT-2   | SAP-2     WALL TILE FLOOR TO CEILING       SAP-2     WALL TILE FLOOR TO CEILING  |
| STORAGE   | VCT-1   | RB-1  | P-1  | P-1   | P-1  |   |   | F123A   | TLT VEST  | EPF-1  | EPB  | WT-3  | WT-2, P-4  | WT-2, P-4   | WT-2, P-4  | GYP         WALL TILE UP TO TOP OF DOOR, REFER TO ELEVATIONS           SAP-2         WALL TILE FLOOR TO CEILING  |
|   |   |   |  |   |  |   |   | F125  |   | EPF-1  | EPB  | WT-2  | WT-2   | WT-3  | WT-2   | SAP-2 A WALL TILE FLOOR TO CEILING   |
|   |   |   | 1  |   |  | SI FLOOR - AREA C   |   | F127  | TLT<br>CUST.  | SC-1   | RB-1   | P-1   | WT-2<br>P-1  | P-1   |  | SAP-2     ZZX     REFER TO ELEVATION FOR TEACHING WALL       SAP-2     EPOXY PAINT   |
| <b>ΒΟΟΜ ΝΔΜΕ</b>  | FLOOR   | BASE  | NORTH  |   |  | WEST  | CEILING<br>FINISH REMARKS   | F130  | BOOK RM   | VCT-1  | RB-1   | P-1<br>P-1  | P-1<br>P-1   | P-1<br>P-1  |  | SAP-1 SAP-1  |
| MUSIC   | CPT-2   | RB-1  | VWC-4, P-1   | P-1   | P-1, CASEWORK  | P-1 ;   | AP-1 REFER TO ELEVATIONS FOR CASEWORK AND TEACHING WALL   | F131<br>F132  | COLLABORATION<br>STORAGE  | CPT-2<br>VCT-1   | RB-1<br>RB-1   | - P-1   | VWC-1<br>P-1   | - P-1   | VWC-1<br>P-1   | AWC REFER TO INTERIOR ELEVATIONS SAP-1   |
| PLATFORM  | CPT-2<br>VCT-3  | -   | P-1<br>BLACK PAINT   | P-1<br>BLACK PAINT  | P-1<br>BLACK PAINT   | BLACK PAINT   | SAP-3   |   |   | · ·  |  |   |  |   |  |  |
|   | COMPUTER LAB<br>OFFICE<br>OFFICE<br>ROOM NAME<br>CORRIDOR<br>CORRIDOR<br>CORRIDOR<br>CORRIDOR<br>COLLABORATION<br>COLLABORATION<br>COLLABORATION<br>COLLABORATION<br>BOOK ROOM<br>DIAG.<br>CUSTDODIAN STO.<br>ART STO.<br>1ST GRADE<br>1ST GRADE<br>KINDERGARTEN<br>KINDERGARTEN<br>KINDERGARTEN<br>KINDERGARTEN<br>KINDERGARTEN<br>KINDERGARTEN<br>KINDERGARTEN<br>KINDERGARTEN<br>KINDERGARTEN<br>KINDERGARTEN<br>KINDERGARTEN<br>KINDERGARTEN<br>KINDERGARTEN<br>KINDERGARTEN<br>KINDERGARTEN<br>KINDERGARTEN<br>KINDERGARTEN<br>KINDERGARTEN<br>KINDERGARTEN<br>KINDERGARTEN<br>KINDERGARTEN<br>KINDERGARTEN<br>KINDERGARTEN<br>KINDERGARTEN<br>KINDERGARTEN<br>KINDERGARTEN<br>KINDERGARTEN<br>KINDERGARTEN<br>KINDERGARTEN<br>KINDERGARTEN<br>KINDERGARTEN<br>KINDERGARTEN<br>KINDERGARTEN<br>KINDERGARTEN | COMPUTER LABCPT-1OFFICECPT-1/LVT-1OFFICECPT-1/LVT-1CORRIDORT-1, T-2CORRIDORCPT-1CORRIDORCPT-2, WF-1COLABORATIONCPT-2COLLABORATIONCPT-2, WF-1COLLABORATIONCPT-2, WF-1BOIK ROOMSC-1DIAG.CPT-1CUSTDODIAN STO.SC-1ART STO.LVT-11ST GRADECPT-11ST GRADECPT-11ST GRADECPT-11ST GRADECPT-1IST GRADECPT-1KINDERGARTENCPT-1, LVT-1KINDERGARTENCPT-1, LVT-1KINDERGARTENCPT-1, LVT-1KINDERGARTENCPT-1, LVT-1KINDERGARTENCPT-1, LVT-1KINDERGARTENCPT-1, LVT-1RREPF-1LIT LIBVCT-1PRE-KCPT-1, LVT-1RREPF-1LIT LIBVCT-1MATH STORVCT-1DIFSEALED CONCRETEODKSC4DIFSEALED CONCRETEDIFSEALED CONCRETETLTEPF-1TLTEPF-1TLTEPF-1TLTEPF-1TLTEPF-1TLTEPF-1TLTEPF-1TLTEPF-1TLTEPF-1TLTEPF-1TLTEPF-1TLTEPF-1TLTEPF-1TLTEPF-1TLTEPF-1TLTEPF-1 <td>COMPUTER LAB     CPT-1     RB-1       OFFICE     CPT-1/LVT-1     RB-1       OFFICE     CPT-1/LVT-1     RB-1       CORRIDOR     T-1, T-2     -       CORRIDOR     CPT-1, CPT-2, WF-1     EPB       CORRIDOR     CPT-1, CPT-2, WF-1     RB-1       COLLABORATION     CPT-2, WF-1     RB-1       COLLABORATION     CPT-2, WF-1     RB-1       COLLABORATION     CPT-2, WF-1     RB-1       COLLABORATION     CPT-2, WF-1     RB-1       DIAG     CPT-1     RB-1       BOOK ROOM     SC-1     RB-1       CUSTDODIAN STO.     SC-1     RB-1       1ST GRADE     CPT-1     RB-1       KINDERGARTEN     CPT-1, LVT-1     RB-1       RR     EPF-1     EPB       ULT UB     VCT-1     RB-1       RB-1     EPF-1     EPB</td> <td>COMPUTER LAB         OPT-1         RB-1         VWC-1           OFFICE         CPT-I/LVT-1         RB-1         VWC-1           OCREDOR         T-1,T-2         -         -           CORRIDOR         CPT-1, CPT-2, WF-1         RB-1         WT-2, P4           COLLABORATION         CPT-2, WF-1         RB-1         WT-1, WC-3           COLLABORATION         CPT-2, WF-1         RB-1         SEE INT. ELEVATION           BOOK ROOM         SC-1         RB-1         P-1           OLLABORATION         CPT-2, WF-1         RB-1         P-1           BOOK ROOM         SC-1         RB-1         P-1           BOOK ROOM         SC-1         RB-1         P-1           BAG         CPT-1         RB-1         P-1           ART STO.         LUT-1         RB-1         WC-3           IST GRADE         CPT-1         RB-1         WWC-3           IST GRADE         CPT-1         RB-1         WWC-3           IST GRADE         CPT-1         RB-1         WWC-3           IST GRADE         CPT-1, LVT-1         RB-1         VWC-3           INDERGARTEN         CPT-1, LVT-1         RB-1         P-1           KINDERGARTEN         C</td> <td>COMPUTER LAB         OPT-1         PB-1         WC-4         WC-3           OFFICE         CPT-14/UT-1         PB-1         WC-1         WC-3           OFFICE         CPT-14/UT-1         PB-1         WC-1         WC-4           ROOM NAME         FLOOR         BASE         WC-1         WC-1           CORRIDGE         T-1, T2         P-         -         SEE INT. ELEX/ITON           CORRIDGE         CFT-1, CFT-2         RB-1         WT-1, WC-3         WT-1, WC-3         WT-1, WC-3           CORRIDGE         CFT-2         RB-1         E-         SEE INT. ELEX/ITON         CELEX/ITON           COLLAGORATION         CPT-2, WF-1         RB-1         SEE INT. ELEX/ITON         ELEX/ITON           COLLAGORATION         CPT-2, WF-1         RB-1         SEE INT. ELEX/ITON         ELEX/ITON           COLLAGORATION         CPT-2, WF-1         RB-1         SEE INT. ELEX/ITON         ELEX/ITON           COLLAGORATION         CPT-1         RB-1         WC-3         WC-3           DAGE         CPT-1         RB-1         WC-3         WC-3           CUSTODIAN STO         LST         RB-1         WC-3         WC-3           IST GRADE         <thcpt-1< th="">         RB-1         WC-3&lt;</thcpt-1<></td> <td>COMPUTER LAB         OP1-1         R8-1         WIC-1         WIC-1</td> <td>COMPUTER LAB         OPF-1         RB-1         W/C-1         W/C-1</td> <td>OPERTINAL         CPA         Dial         Operation         EAL         Diff and Distance         <thdiff and="" distance<="" th="">         Diff and Distanc</thdiff></td> <td>CEL PETEL IN         PFT         B41         VOL1         VOL1</td> <td>Open Markel         Office         Bit         Open All         <th< td=""><td>στοριμήτη         στοριμ         στο</td><td>CHAPTER 1         CHAPTER 1         <t< td=""><td>M</td><td>NAME         Dial         No.4         Dial         <thdial< th="">         Dial         Dial         <thd< td=""><td>Math         Unit         Math         <th< td=""><td>Number         Provide         <th< td=""></th<></td></th<></td></thd<></thdial<></td></t<></td></th<></td> | COMPUTER LAB     CPT-1     RB-1       OFFICE     CPT-1/LVT-1     RB-1       OFFICE     CPT-1/LVT-1     RB-1       CORRIDOR     T-1, T-2     -       CORRIDOR     CPT-1, CPT-2, WF-1     EPB       CORRIDOR     CPT-1, CPT-2, WF-1     RB-1       COLLABORATION     CPT-2, WF-1     RB-1       COLLABORATION     CPT-2, WF-1     RB-1       COLLABORATION     CPT-2, WF-1     RB-1       COLLABORATION     CPT-2, WF-1     RB-1       DIAG     CPT-1     RB-1       BOOK ROOM     SC-1     RB-1       CUSTDODIAN STO.     SC-1     RB-1       1ST GRADE     CPT-1     RB-1       KINDERGARTEN     CPT-1, LVT-1     RB-1       RR     EPF-1     EPB       ULT UB     VCT-1     RB-1       RB-1     EPF-1     EPB | COMPUTER LAB         OPT-1         RB-1         VWC-1           OFFICE         CPT-I/LVT-1         RB-1         VWC-1           OCREDOR         T-1,T-2         -         -           CORRIDOR         CPT-1, CPT-2, WF-1         RB-1         WT-2, P4           COLLABORATION         CPT-2, WF-1         RB-1         WT-1, WC-3           COLLABORATION         CPT-2, WF-1         RB-1         SEE INT. ELEVATION           BOOK ROOM         SC-1         RB-1         P-1           OLLABORATION         CPT-2, WF-1         RB-1         P-1           BOOK ROOM         SC-1         RB-1         P-1           BOOK ROOM         SC-1         RB-1         P-1           BAG         CPT-1         RB-1         P-1           ART STO.         LUT-1         RB-1         WC-3           IST GRADE         CPT-1         RB-1         WWC-3           IST GRADE         CPT-1         RB-1         WWC-3           IST GRADE         CPT-1         RB-1         WWC-3           IST GRADE         CPT-1, LVT-1         RB-1         VWC-3           INDERGARTEN         CPT-1, LVT-1         RB-1         P-1           KINDERGARTEN         C | COMPUTER LAB         OPT-1         PB-1         WC-4         WC-3           OFFICE         CPT-14/UT-1         PB-1         WC-1         WC-3           OFFICE         CPT-14/UT-1         PB-1         WC-1         WC-4           ROOM NAME         FLOOR         BASE         WC-1         WC-1           CORRIDGE         T-1, T2         P-         -         SEE INT. ELEX/ITON           CORRIDGE         CFT-1, CFT-2         RB-1         WT-1, WC-3         WT-1, WC-3         WT-1, WC-3           CORRIDGE         CFT-2         RB-1         E-         SEE INT. ELEX/ITON         CELEX/ITON           COLLAGORATION         CPT-2, WF-1         RB-1         SEE INT. ELEX/ITON         ELEX/ITON           COLLAGORATION         CPT-2, WF-1         RB-1         SEE INT. ELEX/ITON         ELEX/ITON           COLLAGORATION         CPT-2, WF-1         RB-1         SEE INT. ELEX/ITON         ELEX/ITON           COLLAGORATION         CPT-1         RB-1         WC-3         WC-3           DAGE         CPT-1         RB-1         WC-3         WC-3           CUSTODIAN STO         LST         RB-1         WC-3         WC-3           IST GRADE <thcpt-1< th="">         RB-1         WC-3&lt;</thcpt-1<> | COMPUTER LAB         OP1-1         R8-1         WIC-1   | COMPUTER LAB         OPF-1         RB-1         W/C-1   | OPERTINAL         CPA         Dial         Operation         EAL         Diff and Distance         Diff and Distance <thdiff and="" distance<="" th="">         Diff and Distanc</thdiff> | CEL PETEL IN         PFT         B41         VOL1         VOL1 | Open Markel         Office         Bit         Open All         Open All <th< td=""><td>στοριμήτη         στοριμ         στο</td><td>CHAPTER 1         CHAPTER 1         <t< td=""><td>M</td><td>NAME         Dial         No.4         Dial         <thdial< th="">         Dial         Dial         <thd< td=""><td>Math         Unit         Math         <th< td=""><td>Number         Provide         <th< td=""></th<></td></th<></td></thd<></thdial<></td></t<></td></th<> | στοριμήτη         στοριμ         στο | CHAPTER 1         CHAPTER 1 <t< td=""><td>M</td><td>NAME         Dial         No.4         Dial         <thdial< th="">         Dial         Dial         <thd< td=""><td>Math         Unit         Math         <th< td=""><td>Number         Provide         <th< td=""></th<></td></th<></td></thd<></thdial<></td></t<> | M  | NAME         Dial         No.4         Dial         Dial <thdial< th="">         Dial         Dial         <thd< td=""><td>Math         Unit         Math         <th< td=""><td>Number         Provide         <th< td=""></th<></td></th<></td></thd<></thdial<> | Math         Unit         Math         Math <th< td=""><td>Number         Provide         <th< td=""></th<></td></th<> | Number         Provide         Provide <th< td=""></th<> |

|        |                 |                     |                     |             | <b>ROOM FINISH SO</b> | CHEDULE - FIR | ST FLOOR - AREA        | C                 |   |
|--------|-----------------|---------------------|---------------------|-------------|-----------------------|---------------|------------------------|-------------------|---|
|        |                 |                     |                     |             | WALL                  | S             |                        | CEILING           |   |
| ROOM # | ROOM NAME       | FLOOR               | BASE                | NORTH       | EAST                  | SOUTH         | WEST                   | FINISH            | REMARKS   |
| C100   | MUSIC           | CPT-2               | RB-1                | VWC-4, P-1  | P-1                   | P-1, CASEWORK | P-1                    | SAP-1             | REFER TO ELEVATIONS FOR CASEWORK AND TEACHING WALL                      |
| C101   | MUSIC STORAGE   | CPT-2               | RB-1                | P-1         | P-1                   | P-1           | P-1                    | SAP-1             |   |
| C102   | PLATFORM        | VCT-3               | -                   | BLACK PAINT | BLACK PAINT           | BLACK PAINT   | BLACK PAINT            | SAP-3             |   |
| C103   | PLATFORM STO.   | VCT-3               | RB-1                | P-1         | P-1                   | P-1           | P-1                    | SAP-1             |   |
| C104   | RAMP            | VCT-3               | RB-1                | BLACK PAINT | BLACK PAINT           | BLACK PAINT   | BLACK PAINT            | SAP-3             |   |
| C105   | GYM STORAGE     | VCT-2               | RB-1                | P-1         | P-1                   | P-1           | P-1                    | SAP-1             | <u>A</u>  |
| C106   | PE OFFICE       | CPT-1               | RB-1                | P-1         | P-1                   | P-1           | P-1, CASEWORK          | SAP-1             | BEFER TO EKEVATIONS FOR CASEWORK  |
| C107   | GYM             | VCT-1, VCT-2, VCT-4 | RB-1                | P-1         | OPERABLE PARTITION    | P-1           | P-4 REFER TO ELEVATION | SAP-1, SAP-3, GYF | P ﴿NORTH & SOUTH WALL TO HAVE HIGH IMPACT 2 1/8" ACOUSTICAL WALL PANELS |
| C108   | DINING          | VCT-1, VCT-2        | RB-1                | P-1         | P-1                   | P-1           | OPERABLE PARTITION     | SAP-1, SAP-3, GYF | NOBITH & SOLITH WALL TO HAVE ACOUSTICAL WALL PANELS                     |
| C108E  | STORAGE         | EPF-1               | RB-1                | P-1         | P-1                   | P-1           | P-1                    | SAP-1             |   |
| C109   | CHAIR STORAGE   | VCT-2               | RB1                 | P-1         | P-1                   | P-1           | P-1                    | SAP-1             |   |
| C110   | DRY STORAGE     | EPF-1               | EPB                 | P-1         | P-1                   | P-1           | P-1                    | SAP-2             |   |
| C111   | WAREWASH        | EPF-1               | EPB                 | P-1         | P-1                   | P-1           | P-1                    | SAP-2             |   |
| C112   | KITCHEN         | EPF-1               | EPB                 | WT-2, P-2   | P-2                   | WT-2, P-2     | P-2                    | SAP-2             | WT-4 AT SERVING LINE  |
| C113   | WALK INS        | EPF-1               | EPB                 | -           | -                     | -             | -                      | -                 |   |
| C114   | OFFICE          | VCT-1               | RB-1                | P-1         | P-1                   | P-1           | P-1                    | SAP-1             | SAFE IN THIS ROOM   |
| C115   | TEACHERS DINING | LVT-1               | RB-1                | P-1         | P-1, CASEWORK         | P-1           | P-1, CASEWORK          | SAP-1             | REFER TO ELEVATIONS FOR CASEWORK  |
| C116   | RR              | EPF-1               | EPB                 | WT-2        | WT-2                  | WT-2          | WT-3                   | SAP-2             | WALL TILE FLOOR TO CEILING  |
| C117   | LOCKERS         | EPF-1               | EPB                 | P-1         | P-1                   | P-1           | P-1                    | SAP-2             |   |
| C118   | CUST            | SC-1                | EPB                 | P-1         | P-1                   | P-1           | P-1                    | SAP-2             |   |
| C120   | CENTRAL PLANT   | SC-1                | REFER TO<br>REMARKS | P-1         | P-1                   | P-1           | P-1                    | -                 | FIRST COARSE OF CMU BLOCKS WILL BE FILLED                               |

|        |           |       |      | ROOM  | FINISH SCI | HEDL |  |  |
|--------|-----------|-------|------|-------|------------|------|--|--|
|        |           |       |      |       | WA         |      |  |  |
| ROOM # | ROOM NAME | FLOOR | BASE | NORTH | EAST       | SO   |  |  |
| D107   | STAIR     | SC-1  | RB-1 | P-1   | P-1        | F    |  |  |

|        | ROOM FINISH SCHEDULE - SECOND FLOOR - AREA D |       |               |       |      |       |      |         |         |  |  |  |  |  |
|--------|--|-------|---------------|-------|------|-------|------|---------|---------|--|--|--|--|--|
|        |  |       |               |       | WA   |       |      |         |         |  |  |  |  |  |
| ROOM # | <b>ROOM NAME</b>                             | FLOOR | BASE          | NORTH | EAST | SOUTH | WEST | CEILING | REMARKS |  |  |  |  |  |
| D201   | MEP MEZZANINE                                | SC-1  | CONCRETE CURB | P-1   | P-1  | P-1   | P-1  | EXP     |         |  |  |  |  |  |

# DULE - STAIRS SOUTH WEST P-1 CEILING REMARKS FXP


# FINISH SCHEDULE NOTES


# 1. REFER TO INTERIOR ELEVATIONS FOR LOCATION, SIZES & TYPES OF INTERIOR FINISHES.

- 2. PROVIDE FLOOR OR WALL PATTERNS. REFER TO INTERIOR PLANS (A9 SERIES) FOR DESIGN DETAILS.
- PROVIDE ACOUSTIC PANELS. REFER TO INTERIOR ELEVATIONS FOR SIZES & TYPES.
- REFER TO REFLECTED CEILING PLAN (<u>A10 SERIES DWGS</u>) FOR PAINTED GYP. BD. AND/OR SPECIALTY PORTIONS OF CEILING.
- SINK AT JANITOR CLOSETS. 6. PROVIDE CERAMIC TILE WAINSCOT TO 4'- 0"A.F.F. WITH TACKABLE VINYL WALL COVERING ABOVE.
- 7. PROVIDE ACCENT WALL. REFER TO INTERIOR PLANS AND ROOM FINISH SCHEDULES FOR ACCENT PAINT LOCATIONS AT CORRIDORS.
- AT MDF & IDF ROOMS, PROVIDE 8'-0"H, 3/4" PLYWOOD ON ALL WALL SURFACES. PAINT SIDES AND EDGES BLACK.

# **GENERAL NOTES**

- A. REFER TO REFLECTED CEILING PLAN (<u>A10 SERIES DWGS</u>) FOR CEILING HEIGHTS & ADDITIONAL INFORMATION.
- B. ALL FINISHES SUBJECT TO ARCHITECT'S APPROVAL.
- C. REFERENCE FOOD SERVICE DRAWINGS (<u>K SERIES</u>) FOR KITCHEN AND SERVING LINE EQUIPMENT & FINISH INFORMATION.

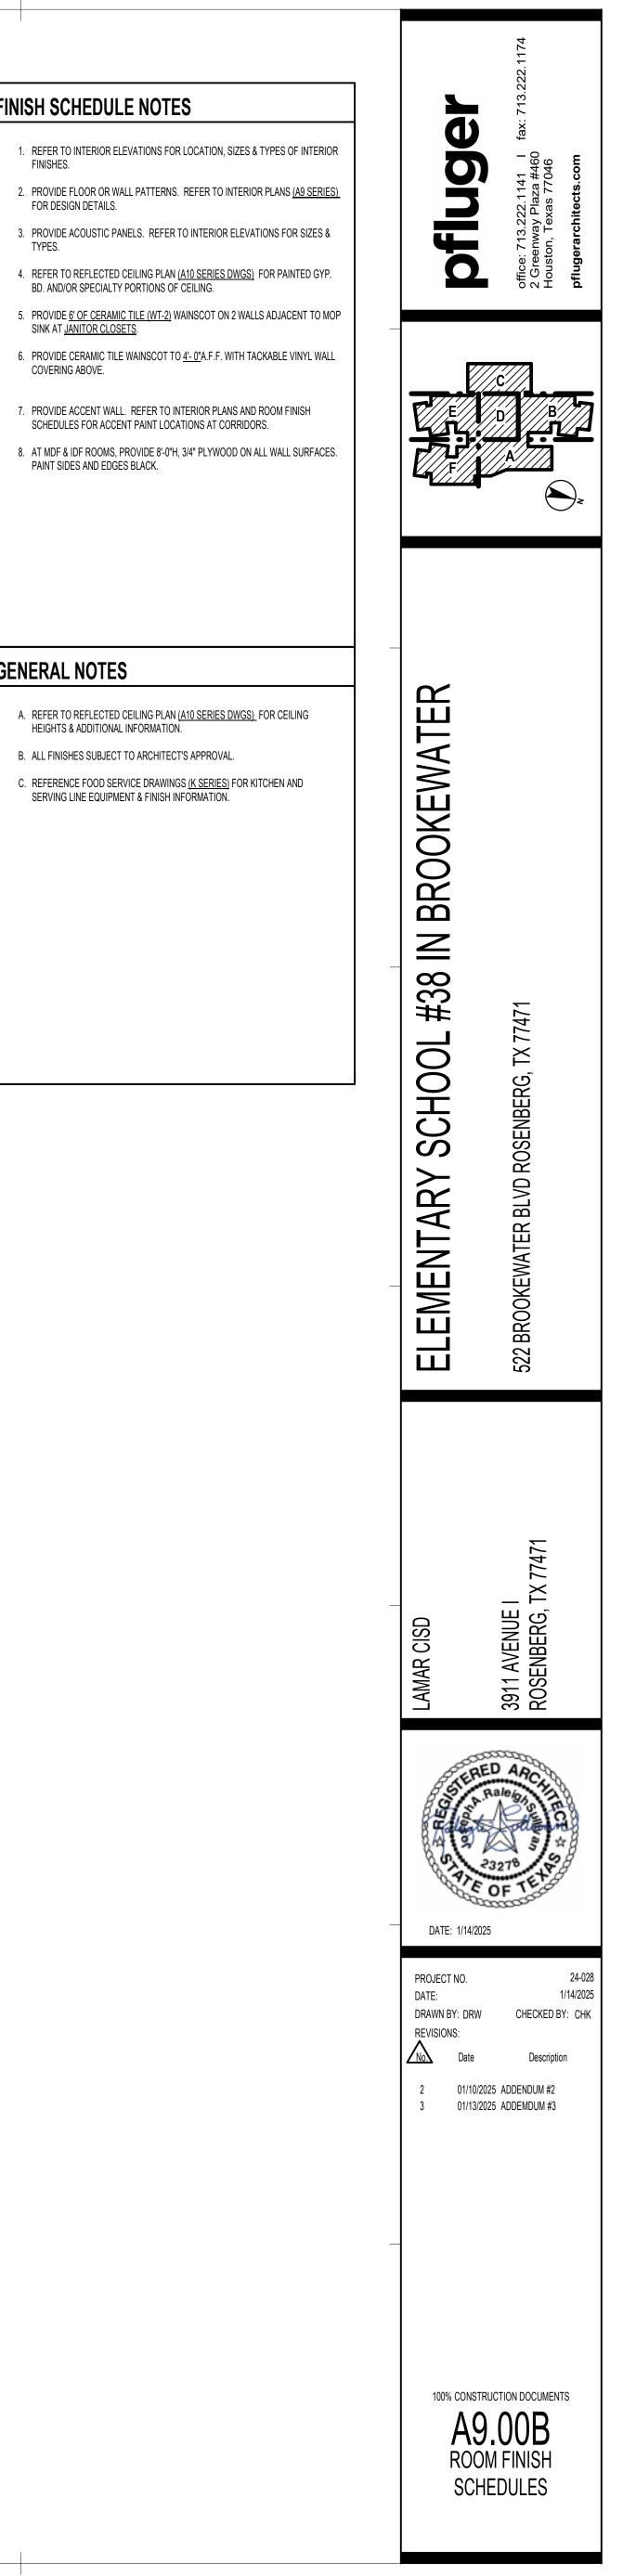

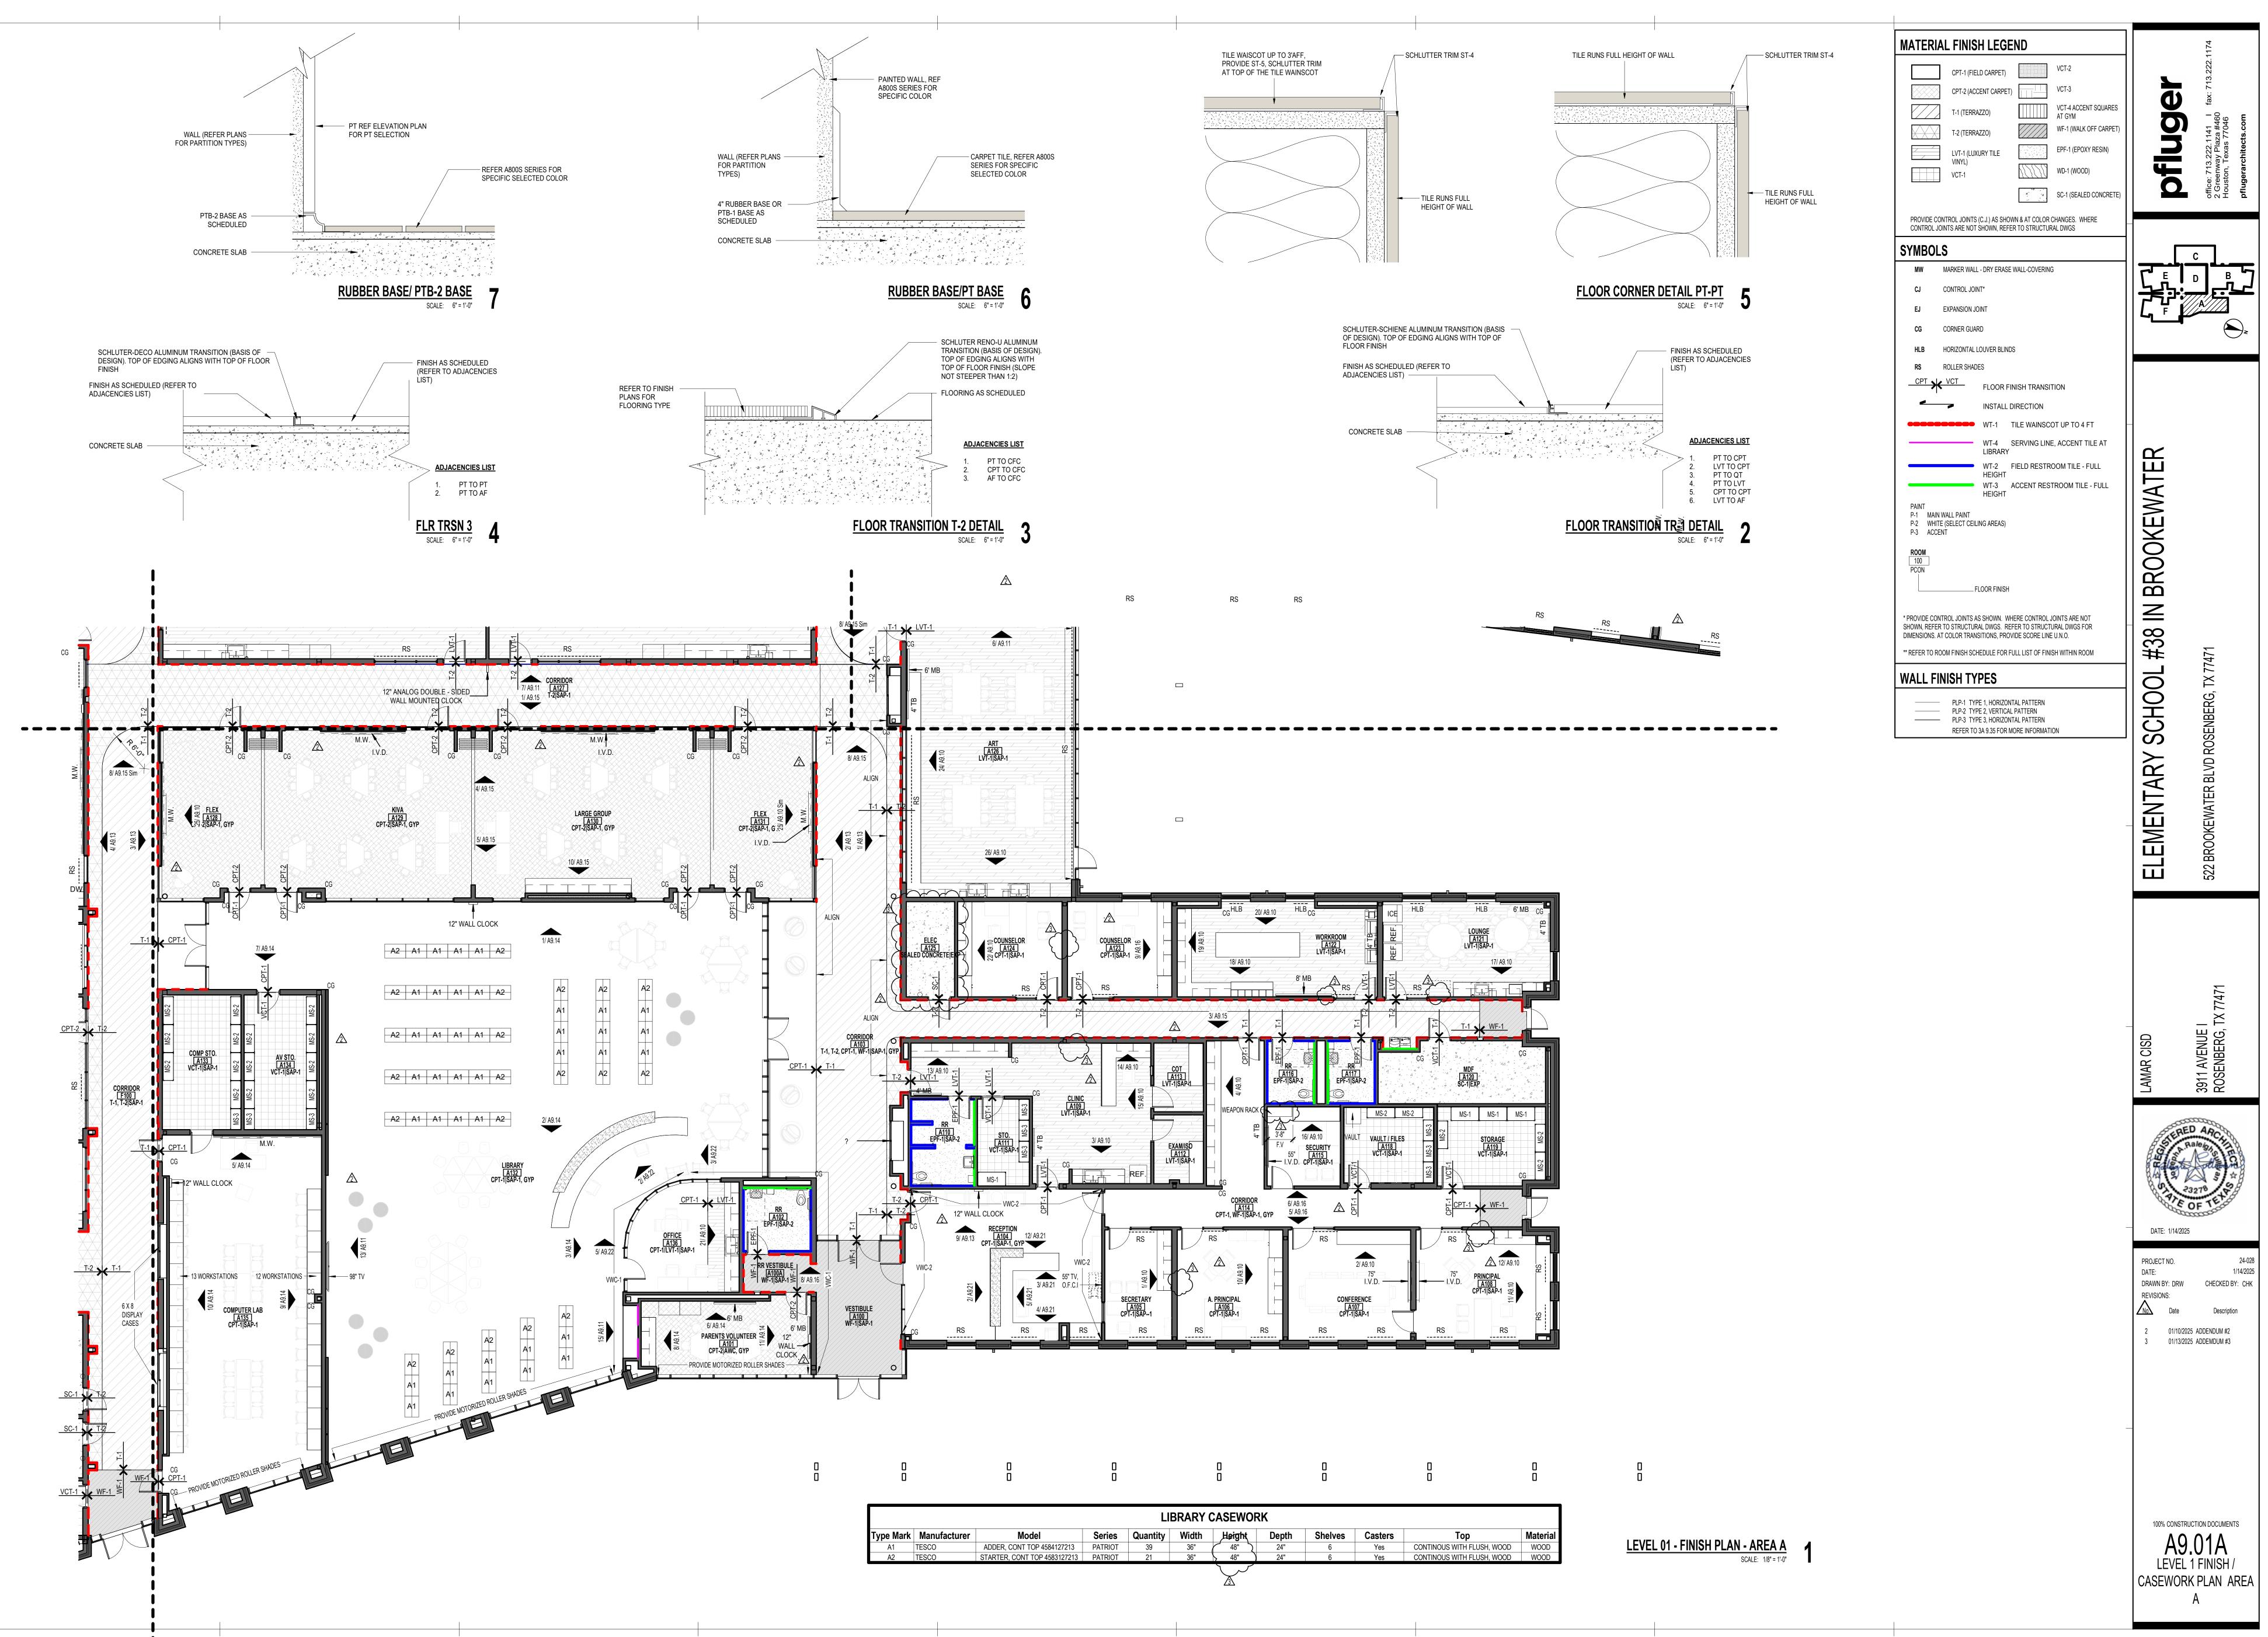


|         |                       | 0<br>0                         |
|---------|-----------------------|--------------------------------|
| Casters | Ton                   | Material                       |
|         |                       | WOOD                           |
| Yes     |                       | WOOD                           |
|         | Casters<br>Yes<br>Yes | Yes CONTINOUS WITH FLUSH, WOOD |




| Image: Strategy of the strateg |
|--|
| LEVEL 01 - FINISH PLAN - AREA B  |

LEVEL 01 - FINISH PLAN - AREA B SCALE: 1/8" = 1'-0"

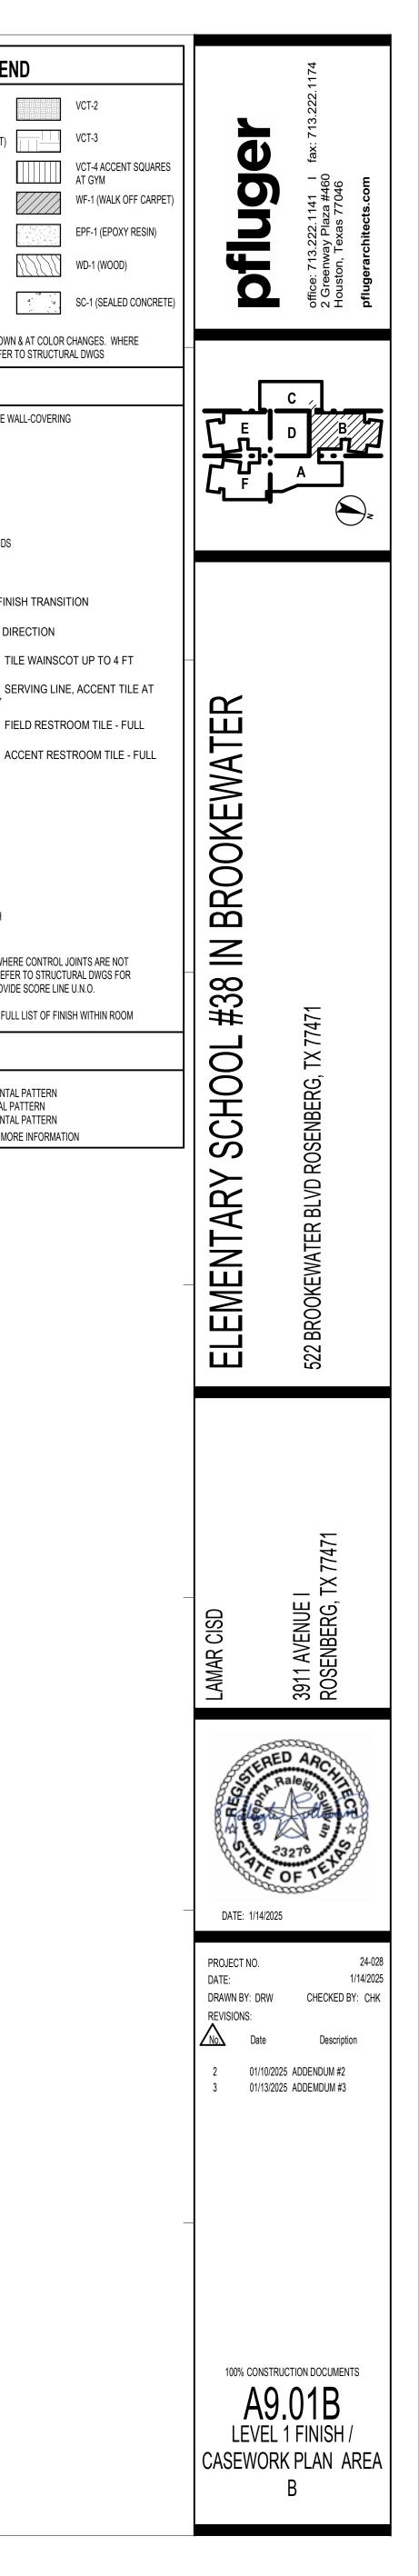








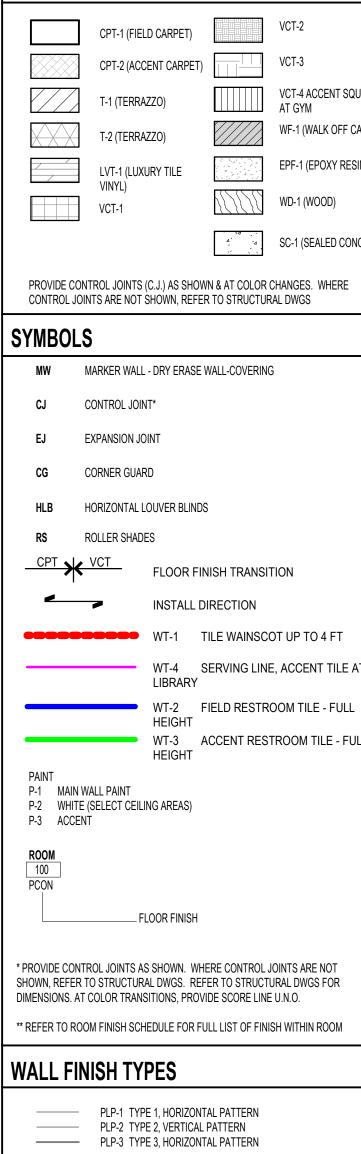


LEVEL 01 - FINISH PLAN - AREA E SCALE: 1/8" = 1'-0"

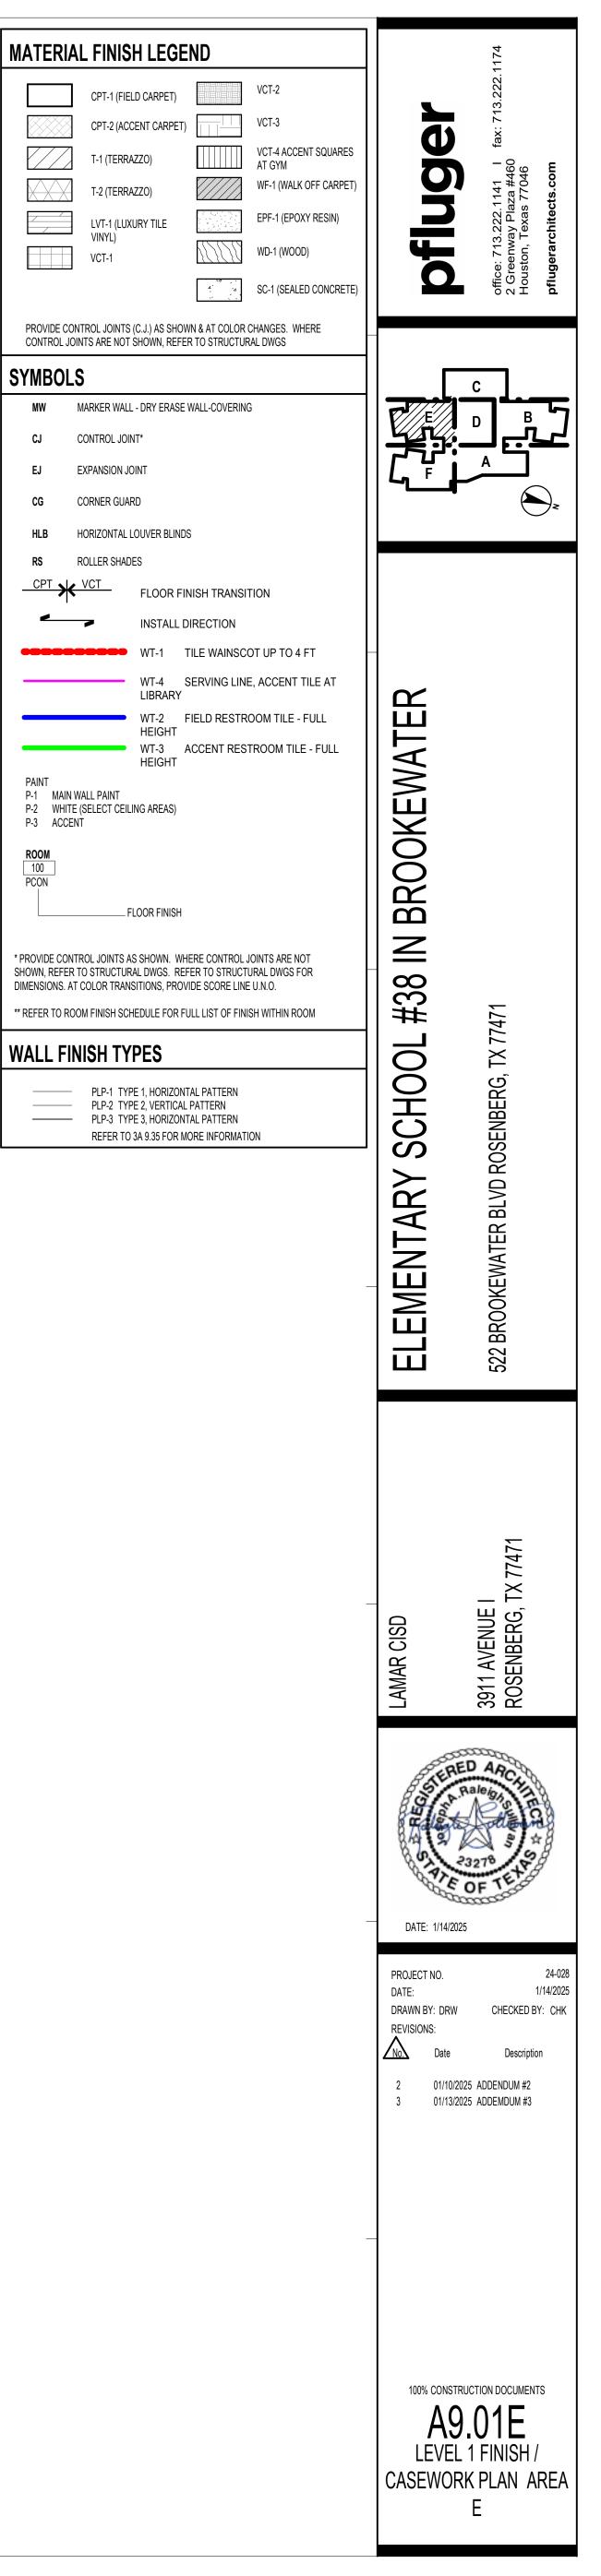

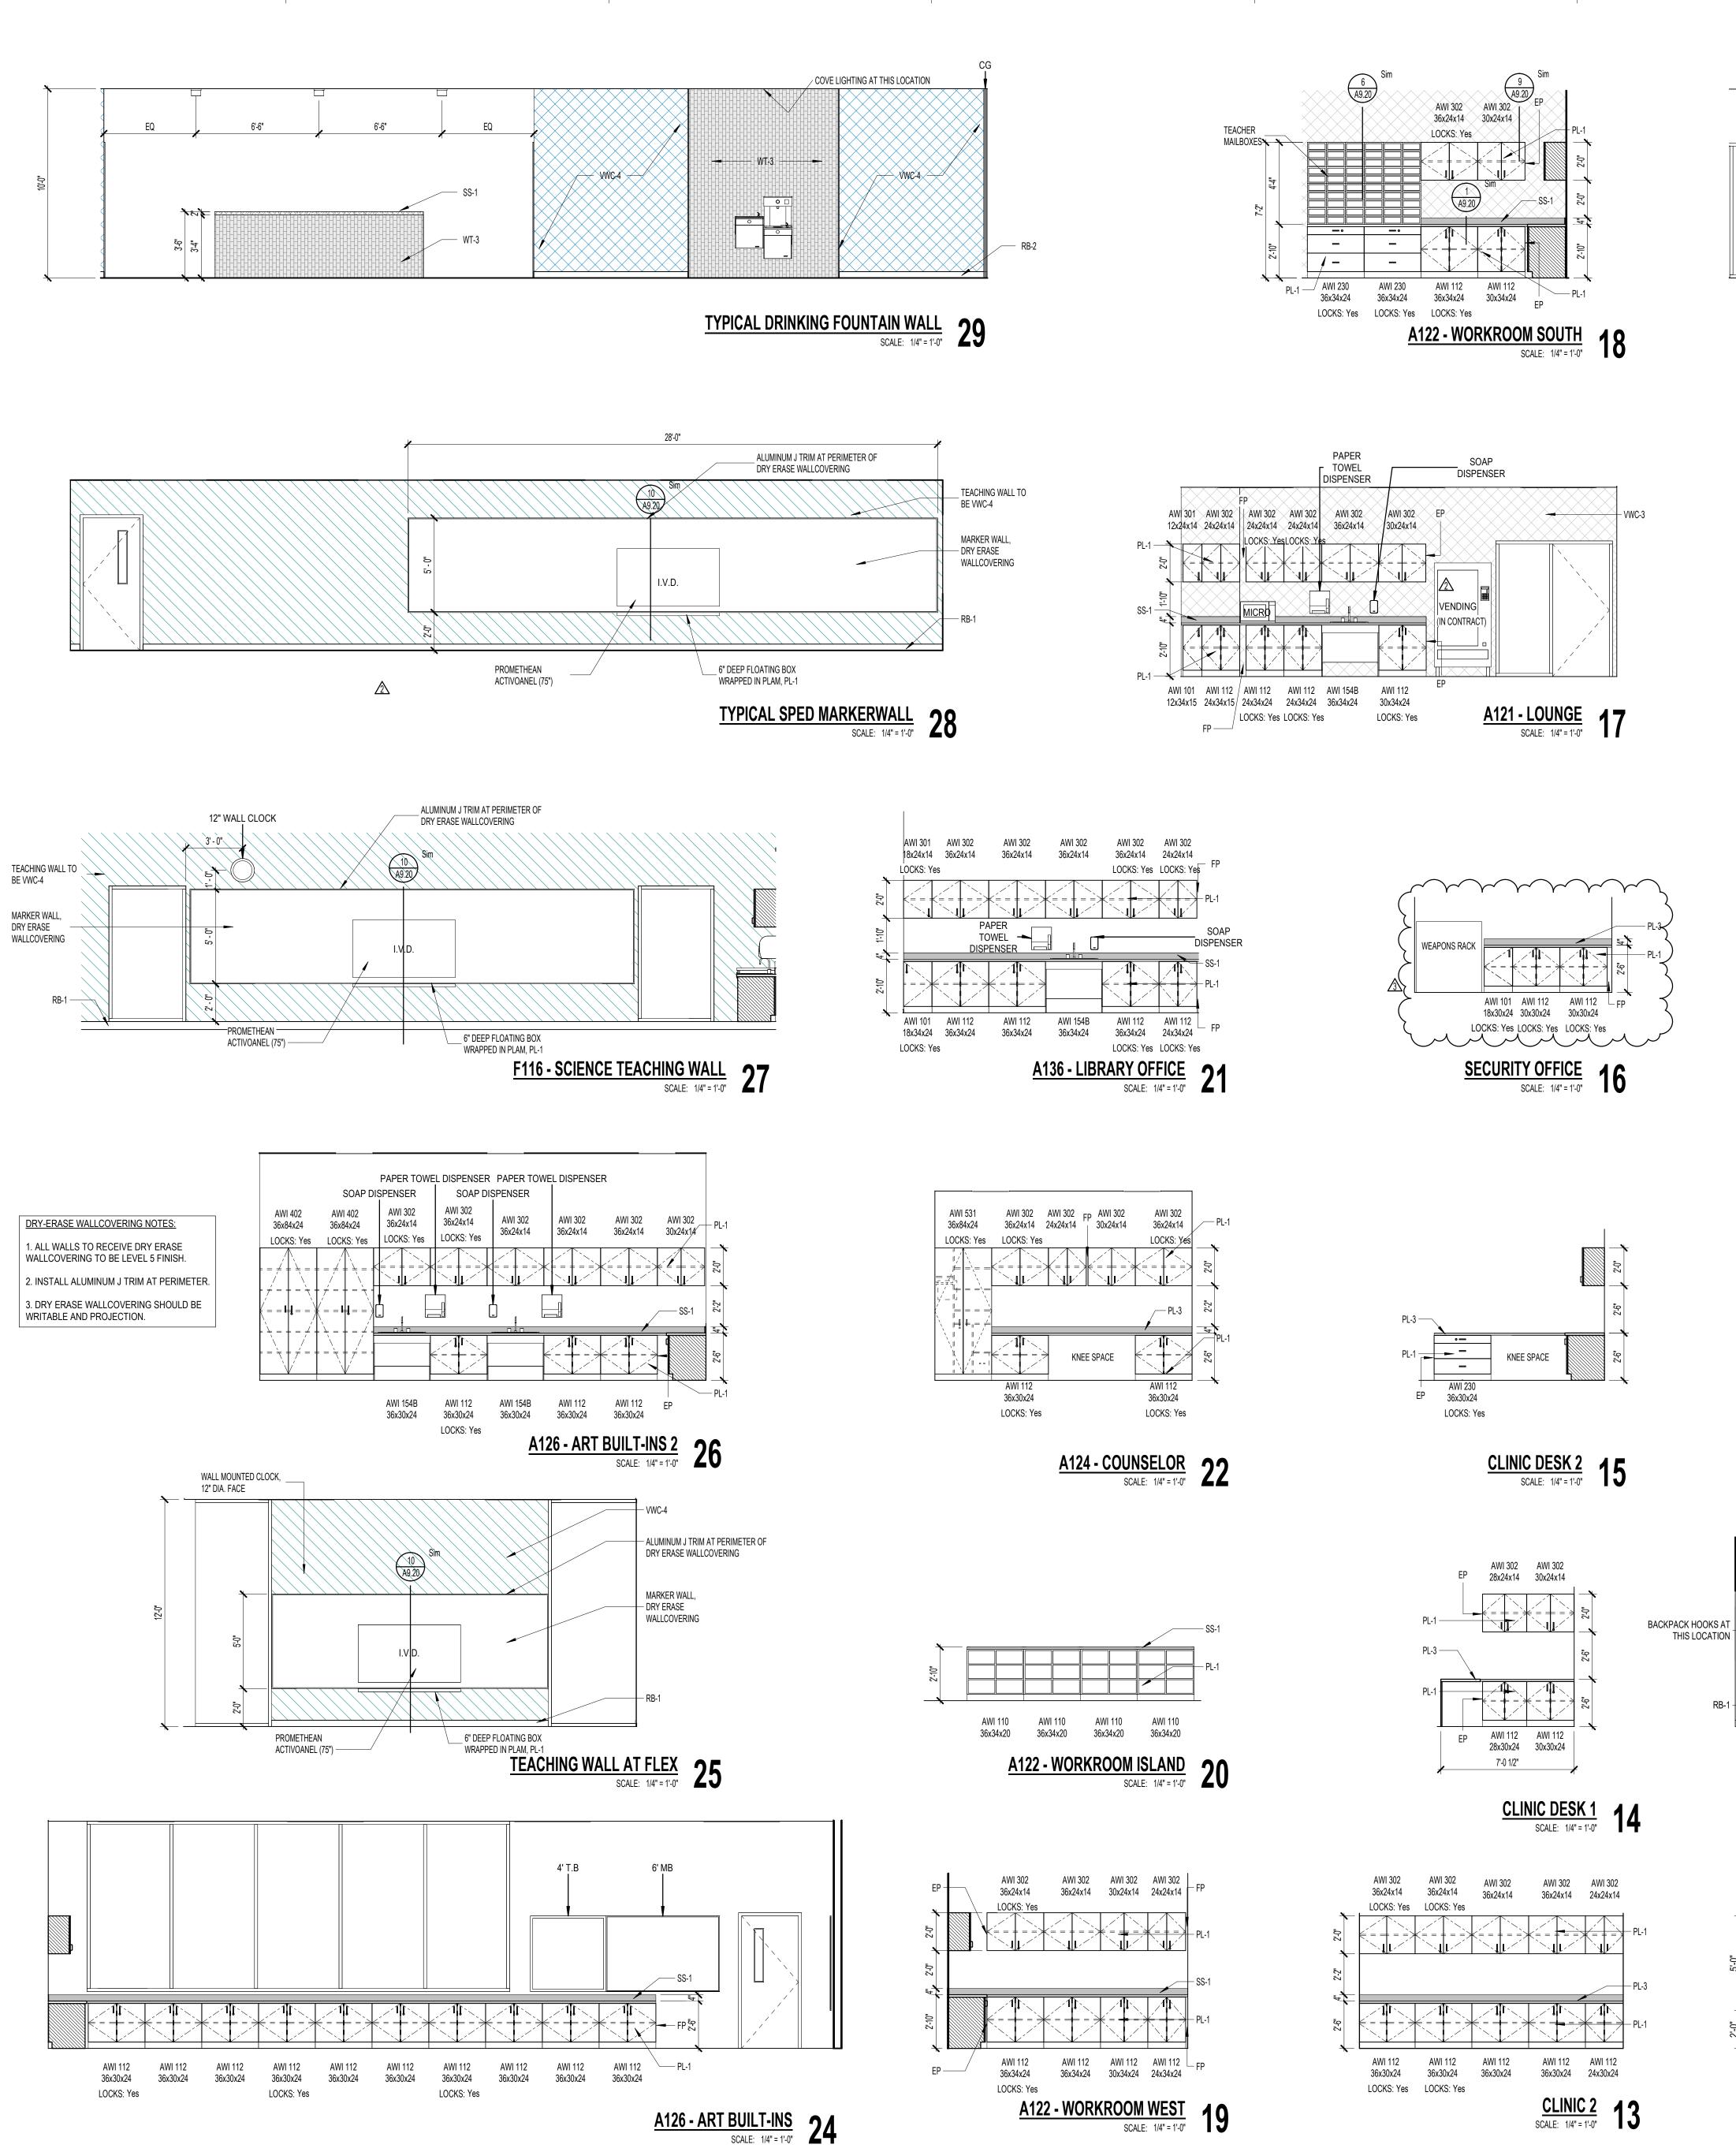

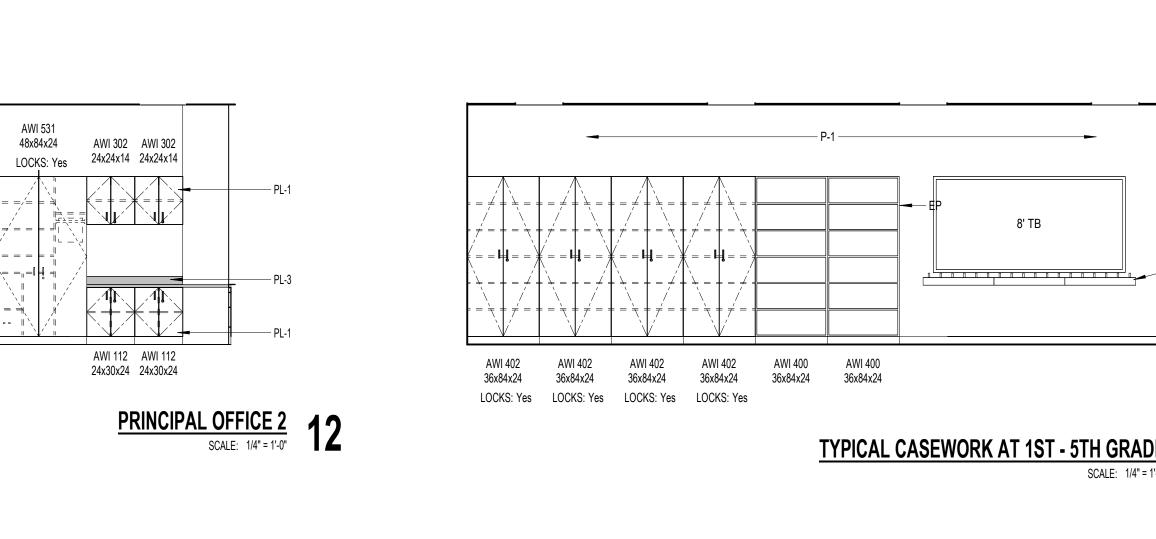

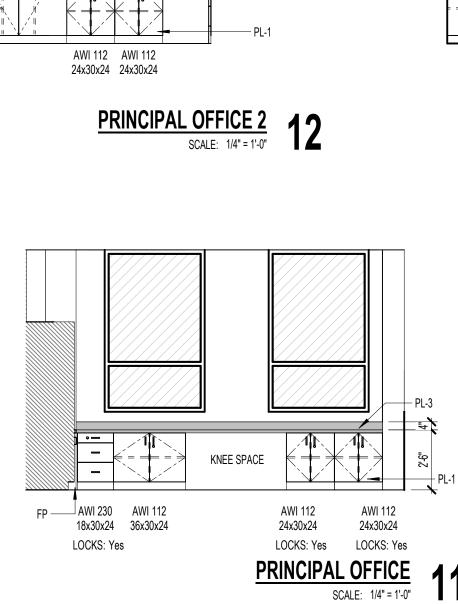


AWI 531


48x84x24

= = =

EP ——•

AWI 302 AWI 302

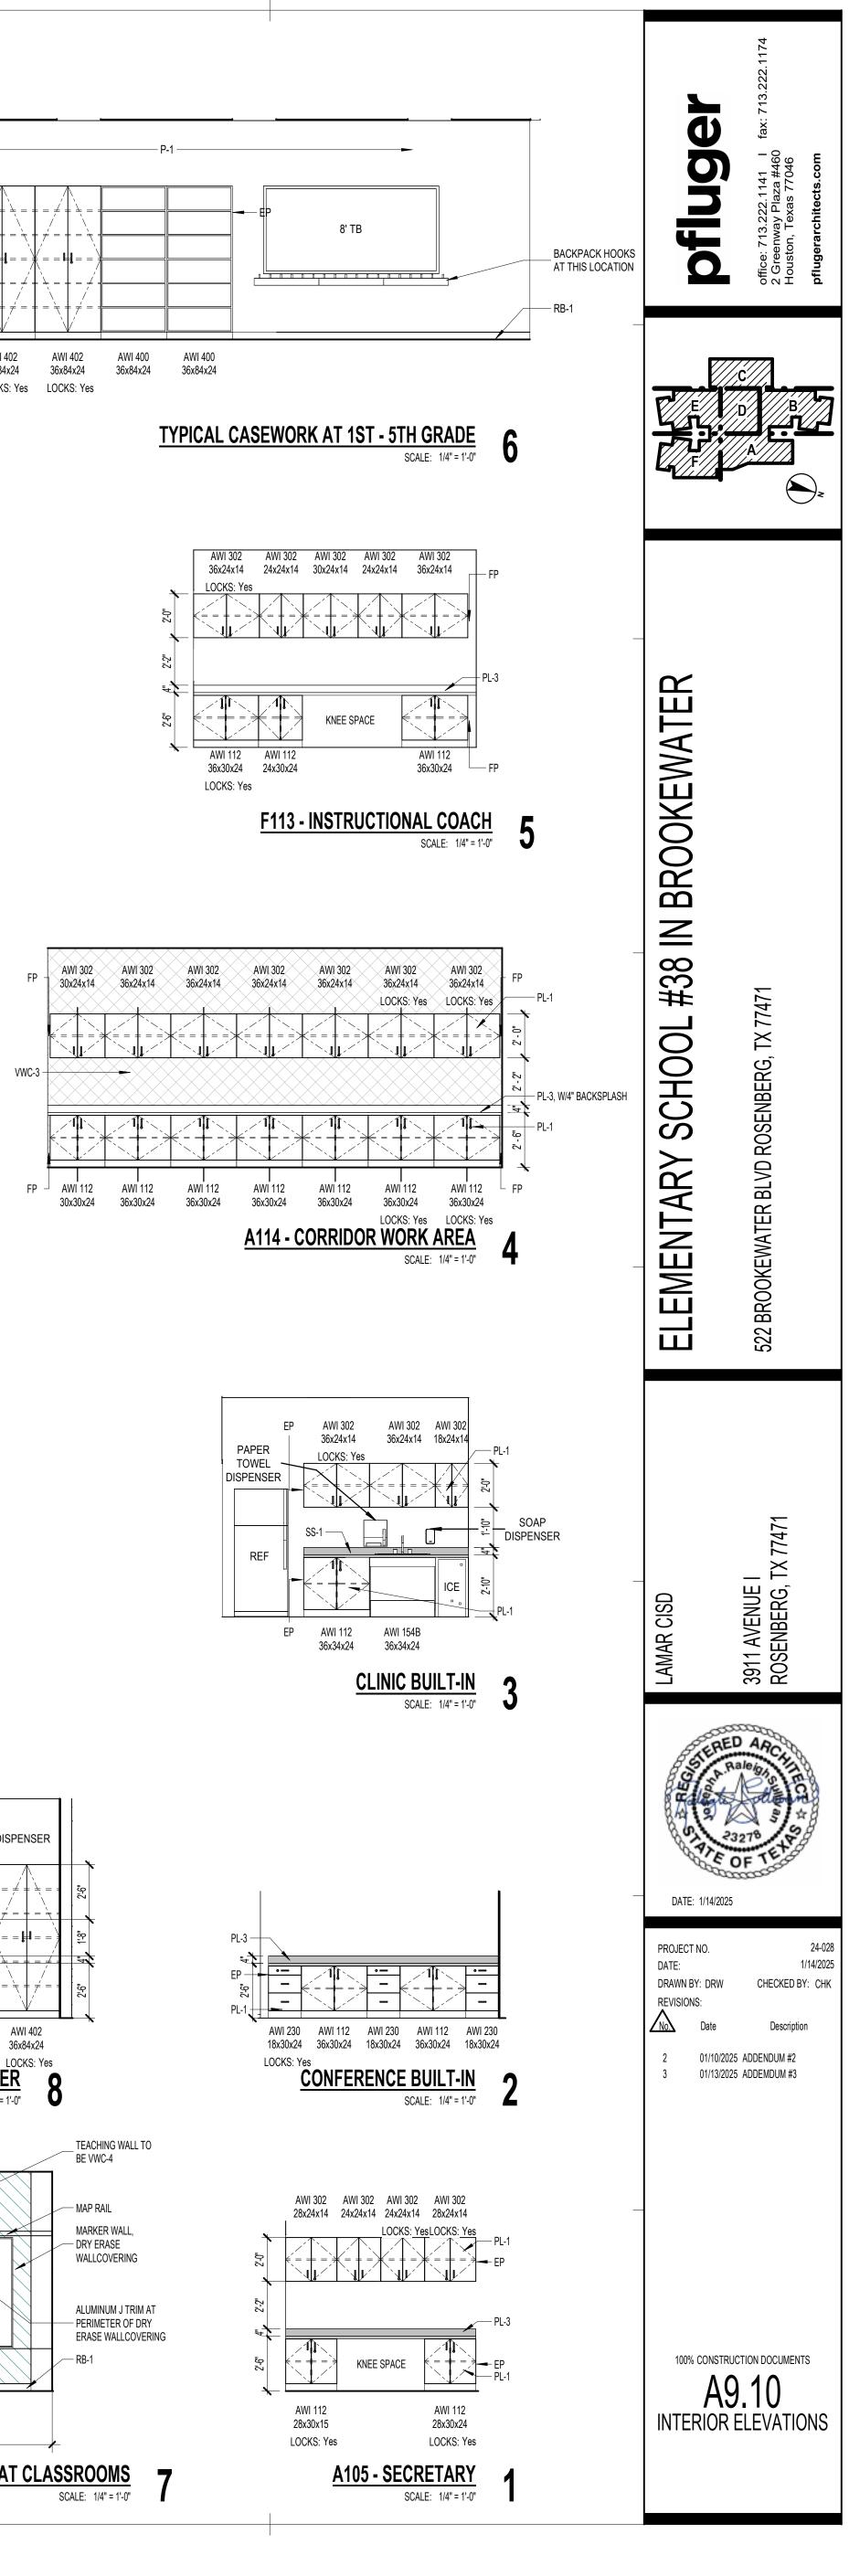

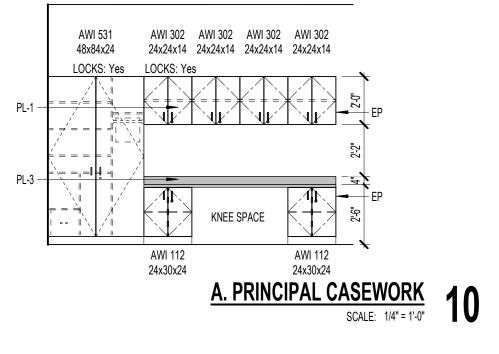

AWI 302

36x24x14

LOCKS: Yes

AWI 112


PL-3


PL-1 <del>| € ्=</del>


AWI 302


30x24x14 ED 30x24x14


KNEE SPACE

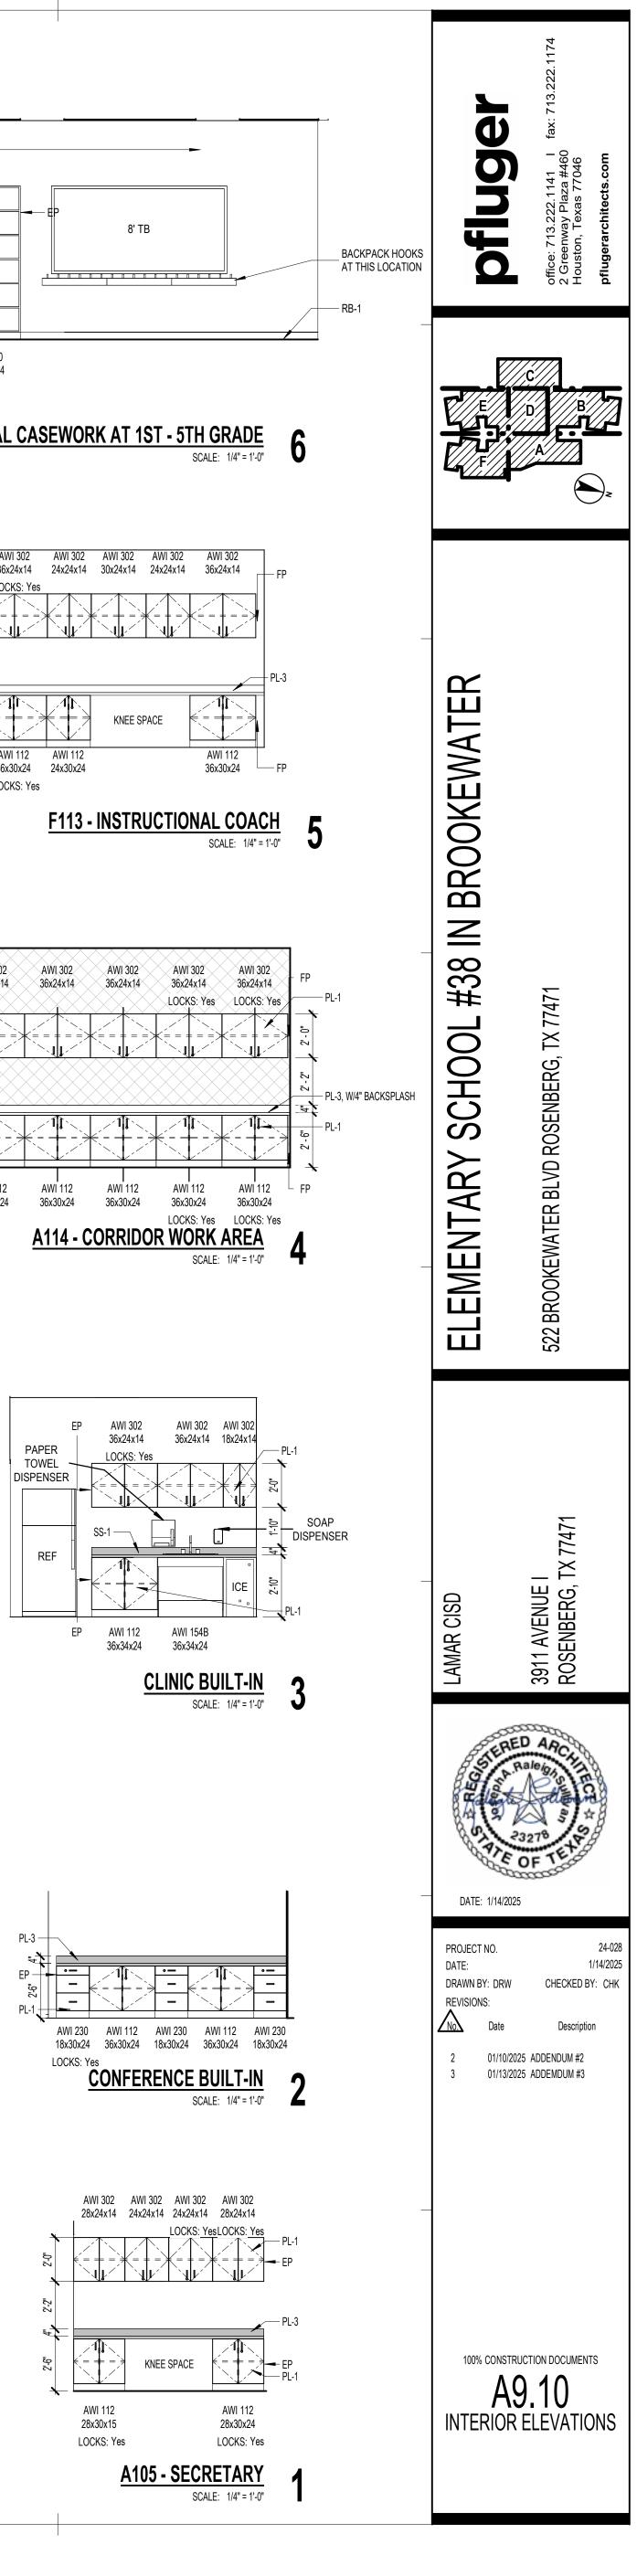

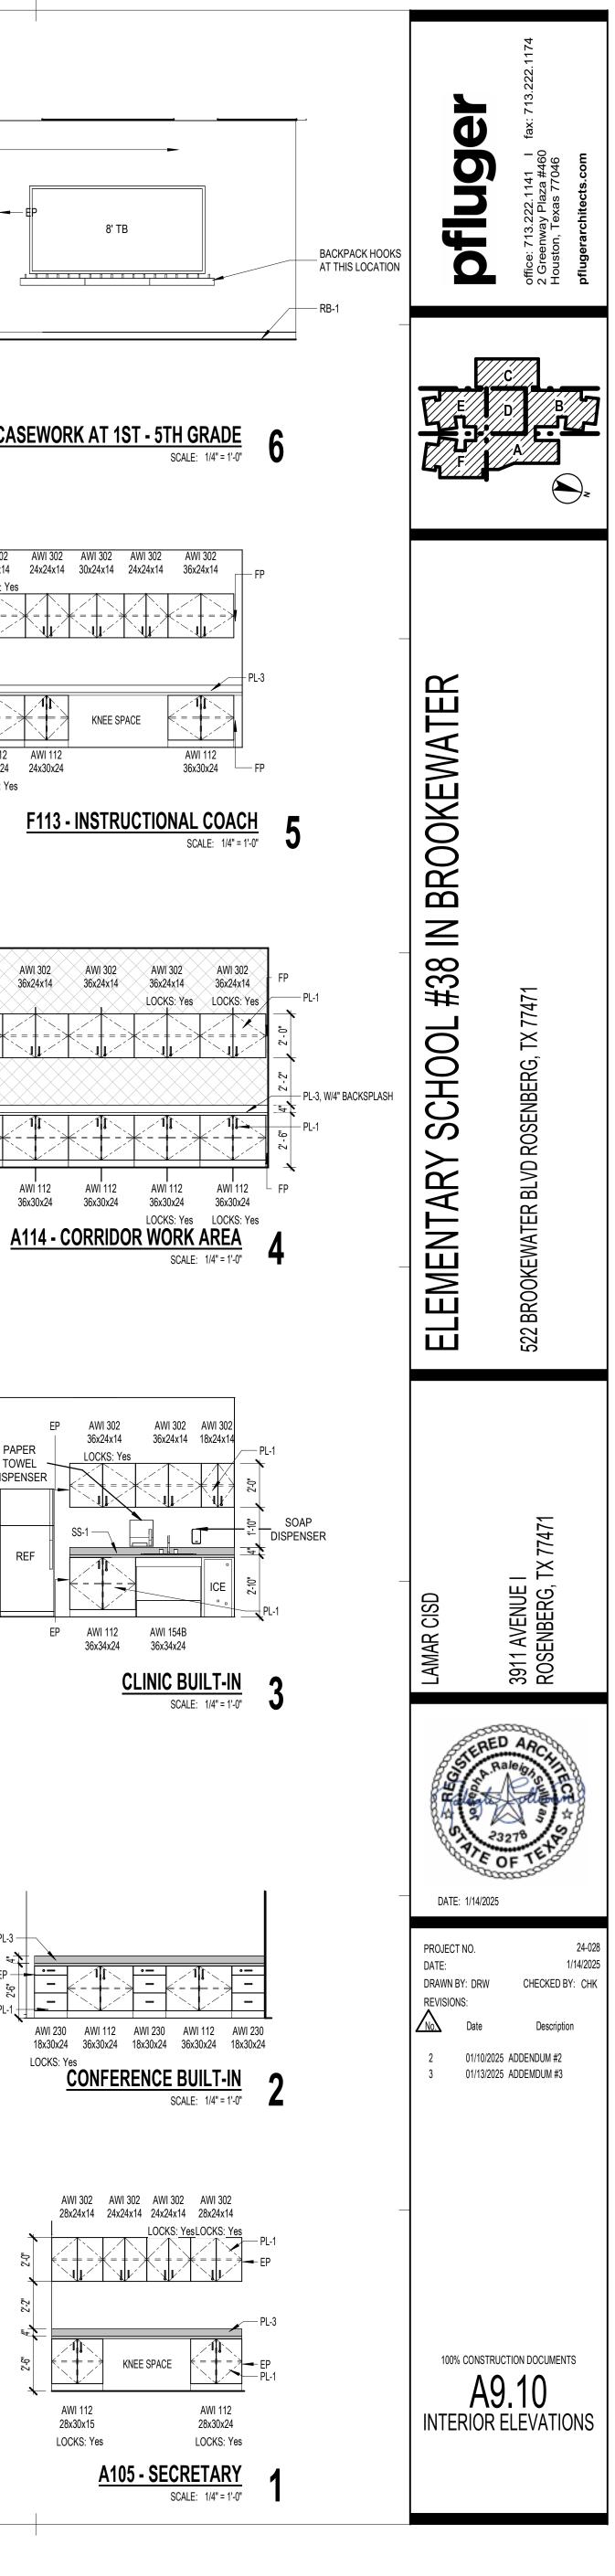

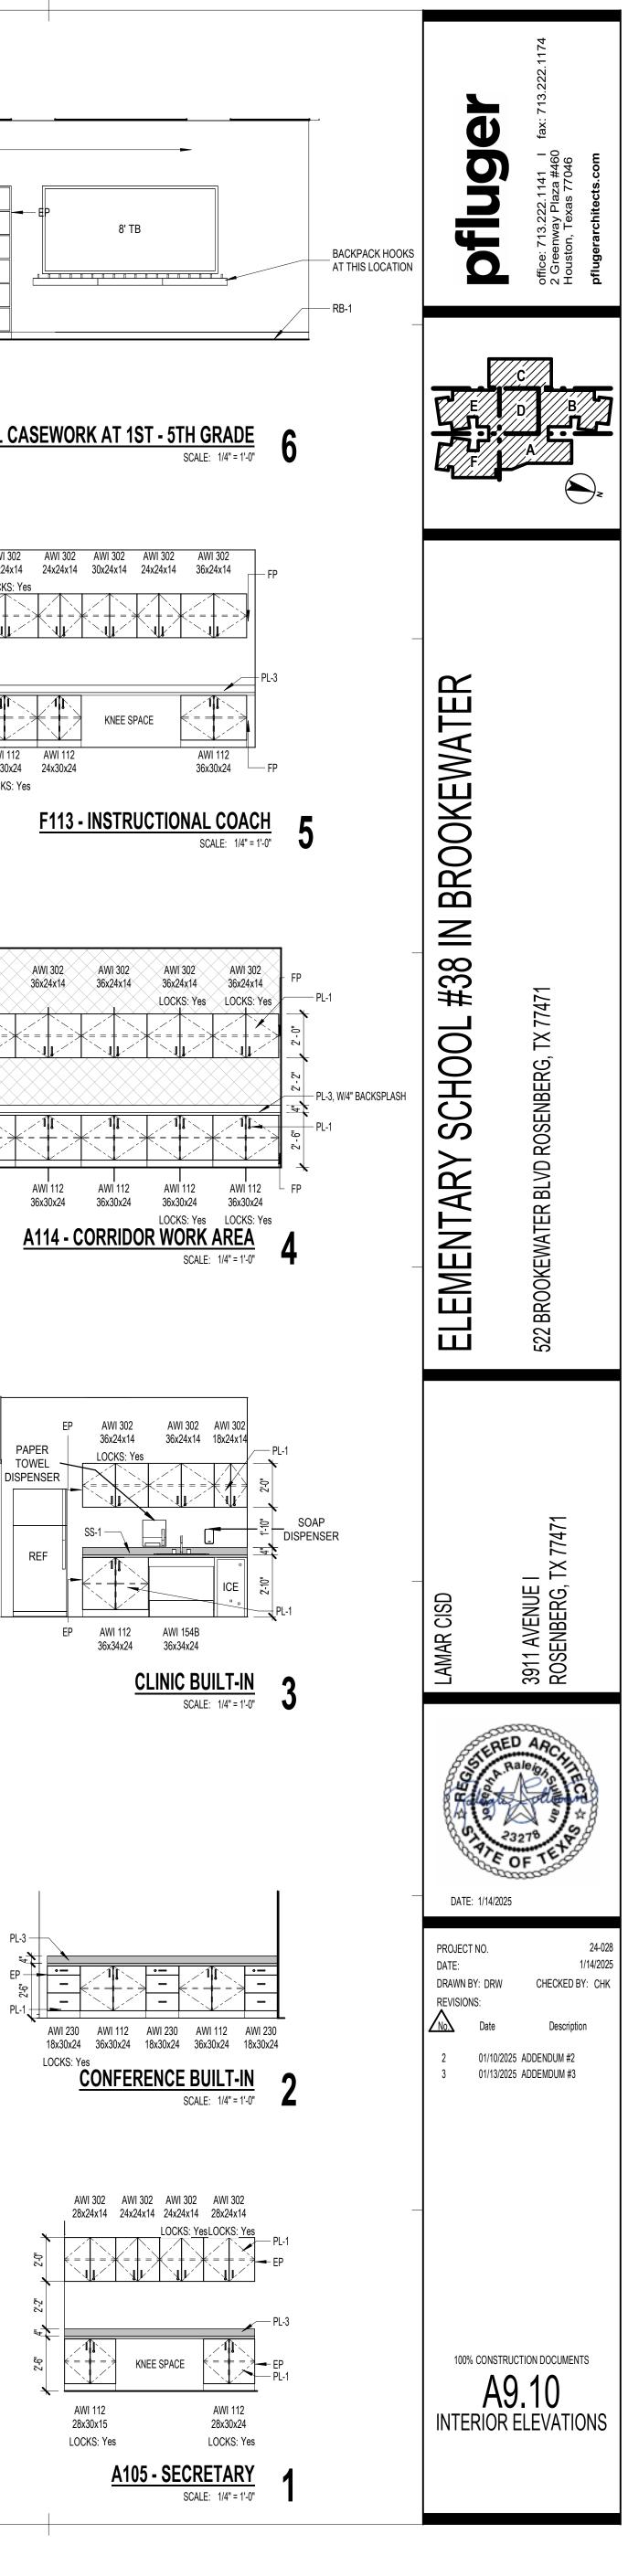

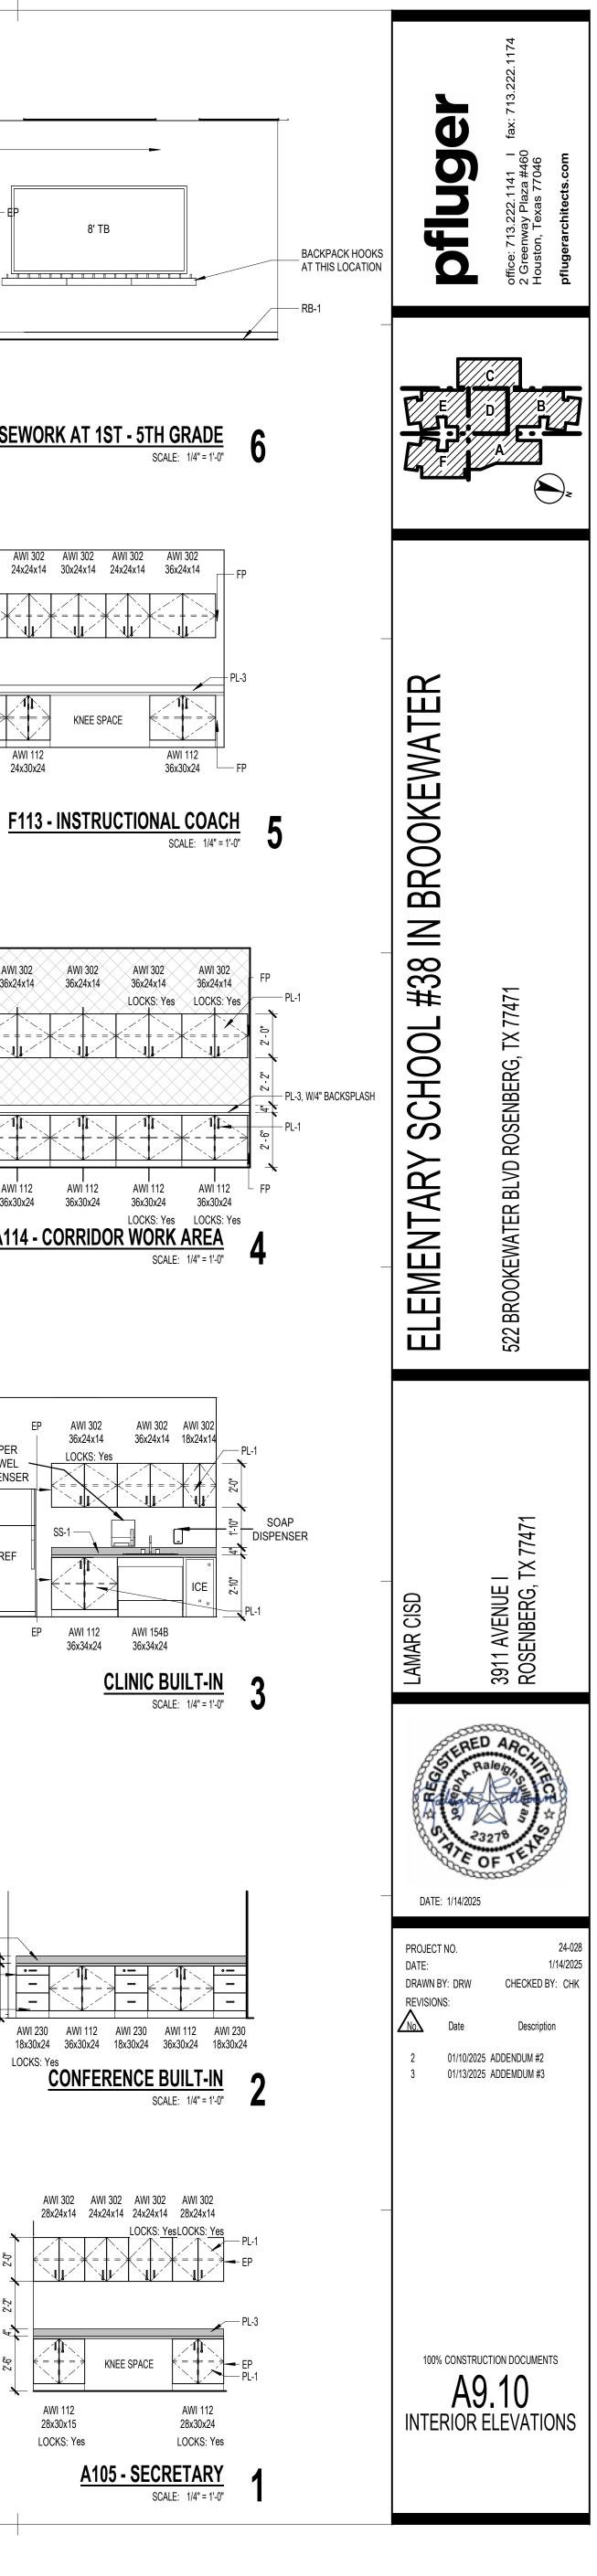

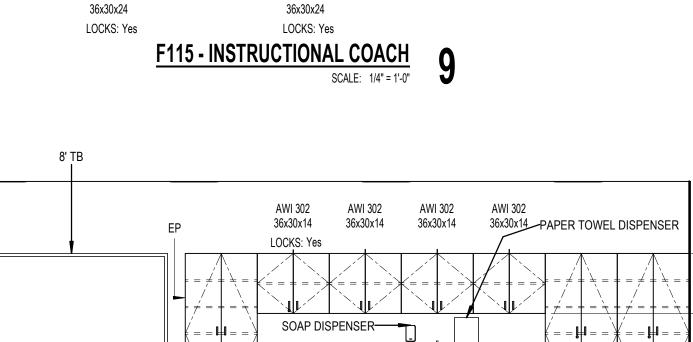

AWI 302

36x24x14


LOCKS: Y


\_

-


AWI 230

AWI 302

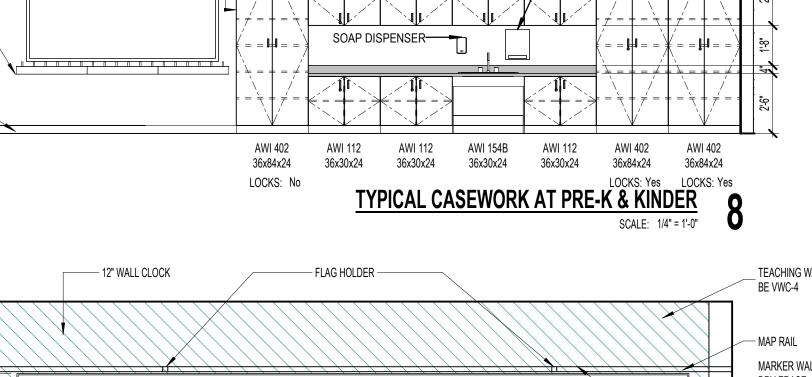

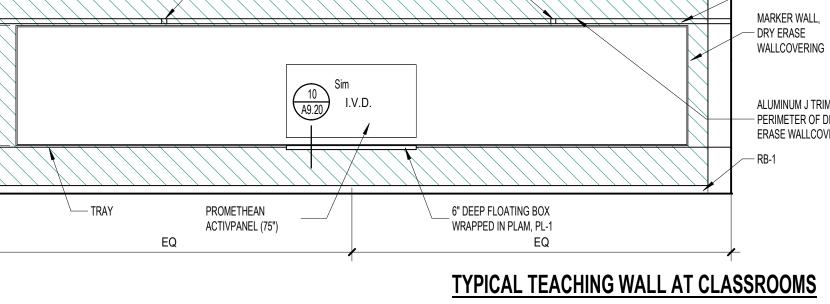



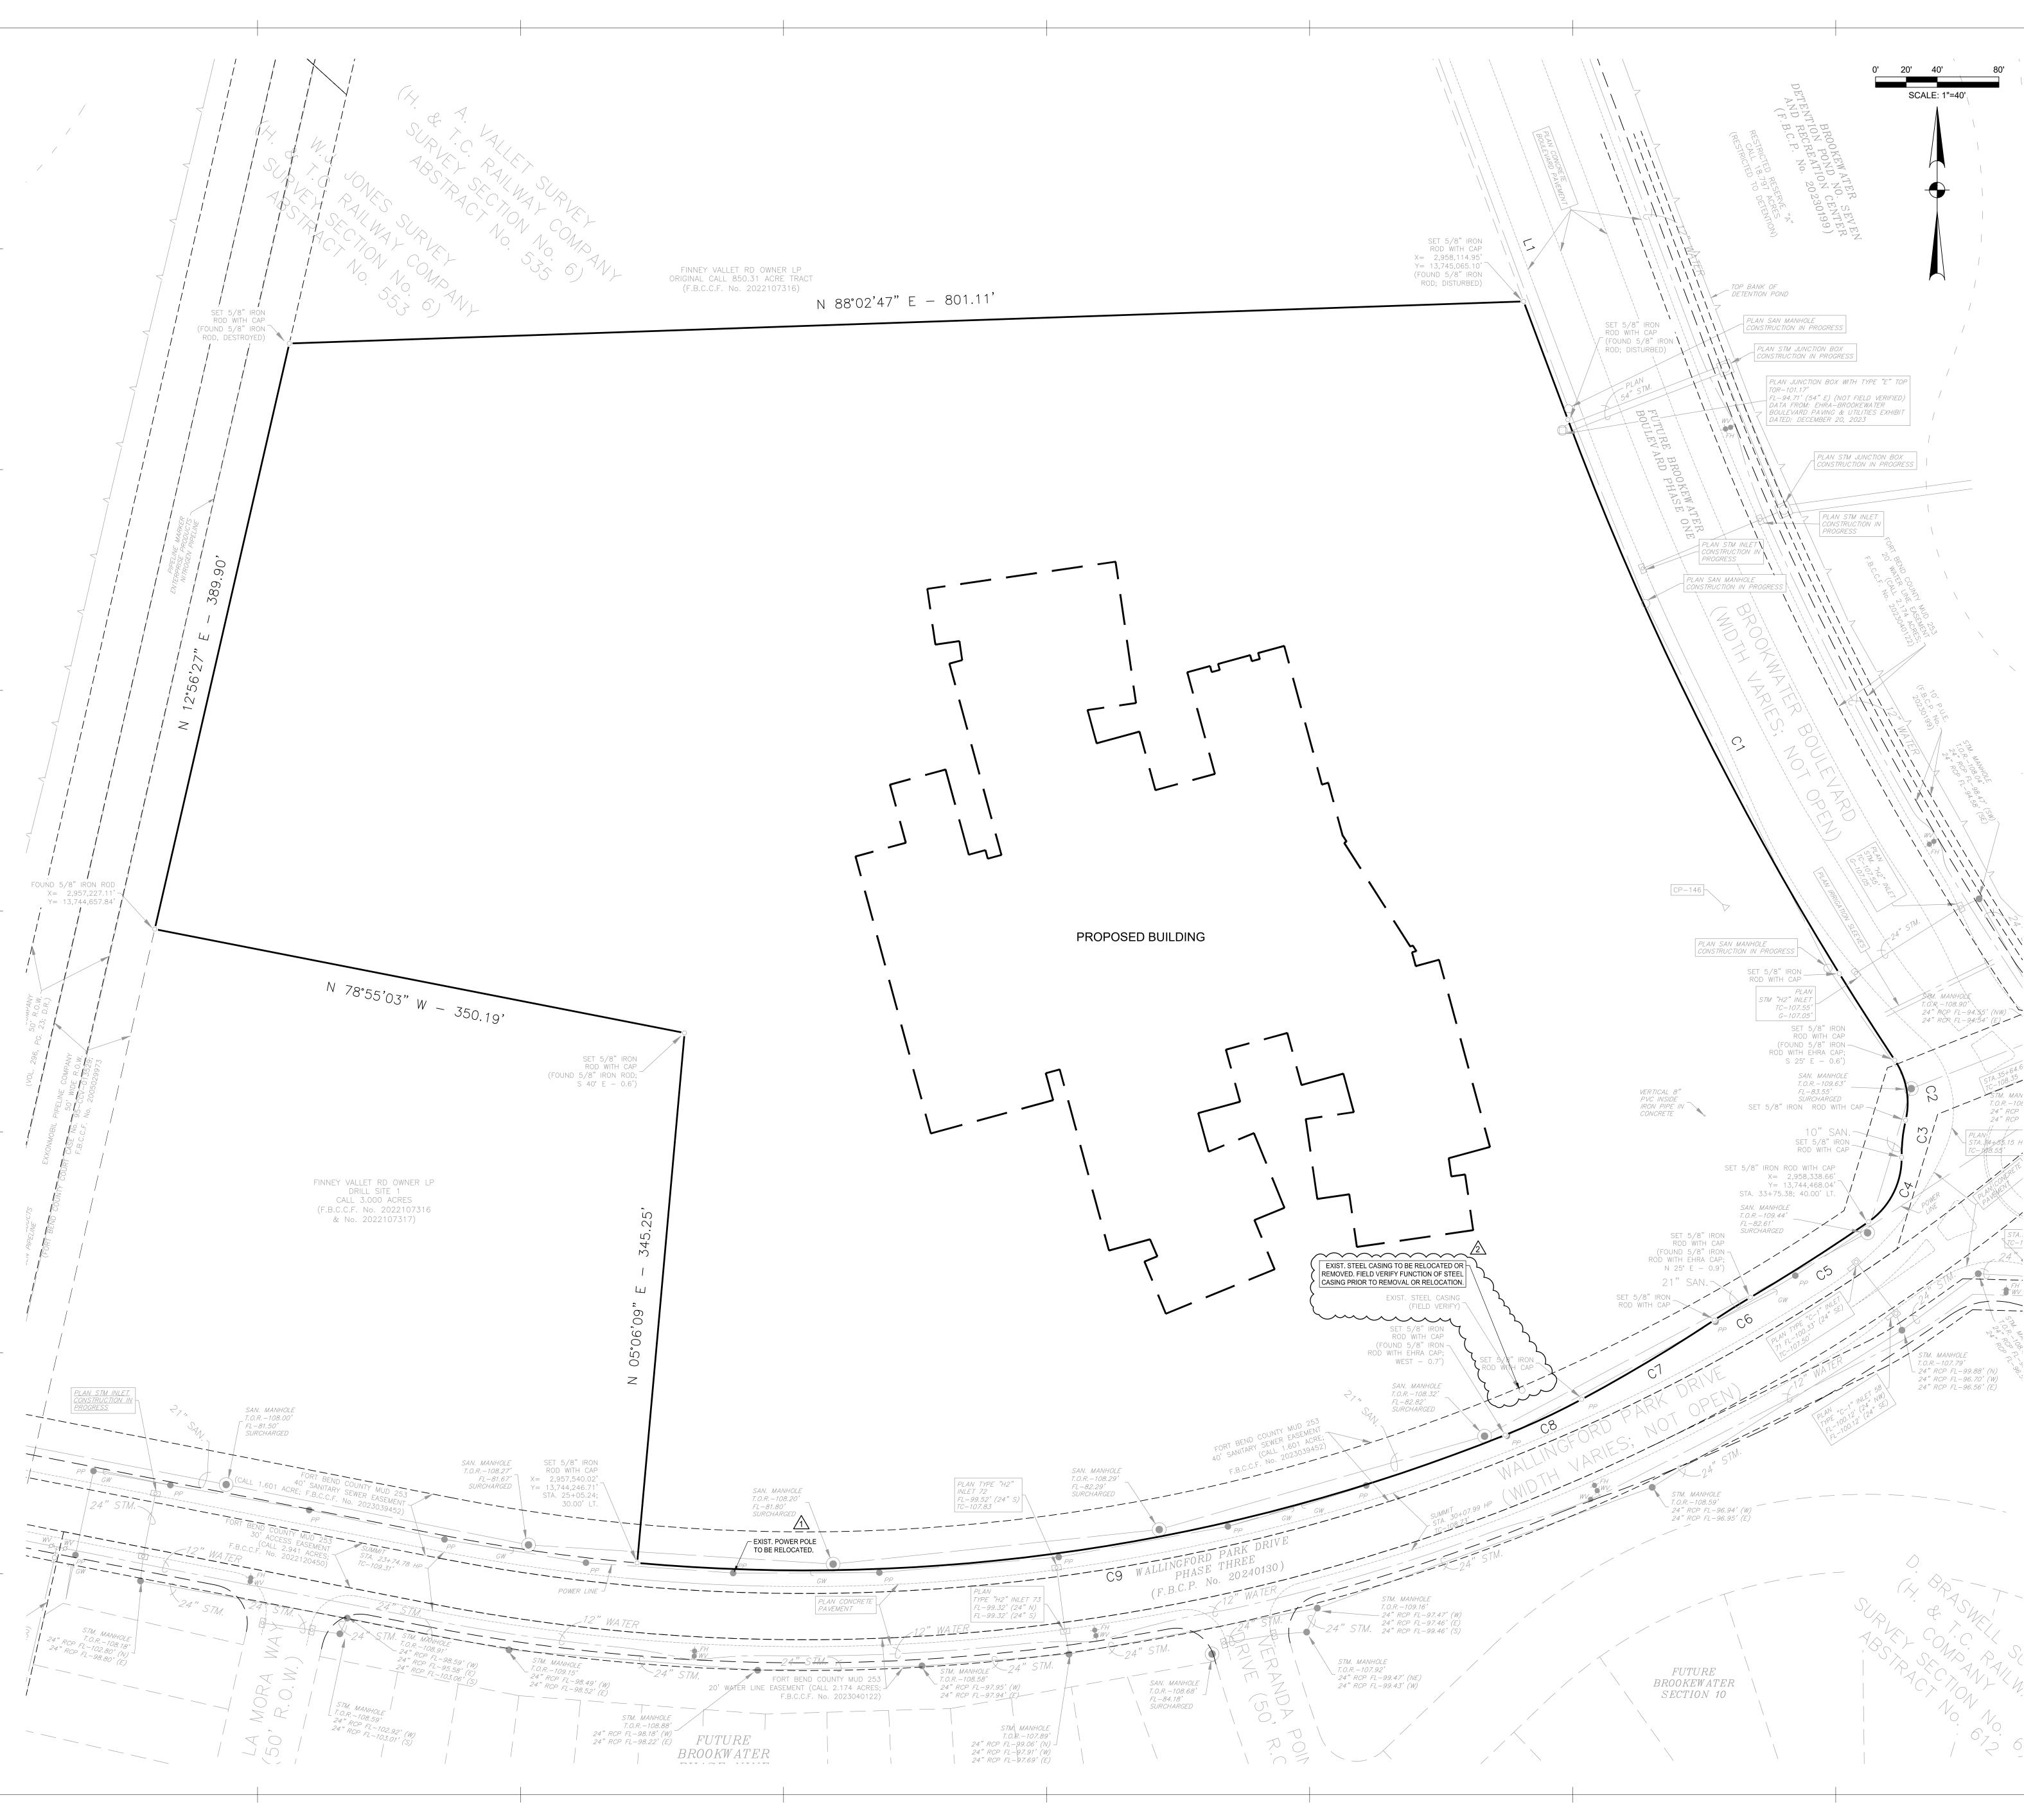


 $\Box$ C. ()C  $\Box$ 24 Ω Δd 4

|                         | LEGEND      |
|-------------------------|-------------|
|                         | PROPOSED BU |
|                         | PROPOSED SA |
| DEMOLITION NOTES TO CON | ITRACTOR:   |

- 1. THE CONTRACTOR AND OWNER SHALL COORDINATE WITH UTILITY SERVICE PROVIDERS FOR TERMINATION OF POWER AND GAS SERVICES TO THE SITE OR NEW SERVICES. THIS WORK SHALL BE PERFORMED BY THE UTILITY SERVICE PROVIDER AND SHALL BE SCHEDULED AS ONE OF THE FIRST ITEMS OF BUSINESS.
- 2. ALL SITE FEATURES NOT IDENTIFIED TO BE DEMOLISHED ARE TO REMAIN AND SHALL BE PROTECTED-IN-PLACE.
- 3. ALL ITEMS DESIGNATED TO BE REMOVED SHALL BECOME THE PROPERTY OF THE CONTRACTOR.
- 4. CONTRACTOR TO FOLLOW ALL RECOMMENDED SAFETY AND DISPOSAL PROCEDURES INCLUDING BUT NOT LIMITED TO EPA, TCEQ & OSHA. 5. CONTRACTOR SHALL REMOVE AND DISPOSE OF ALL DEBRIS OFFSITE.
- 6. BACKFILL ALL VOIDS FROM REMOVED ITEMS WITH STRUCTURAL FILL MATERIAL PLACED AND COMPACTED PER GEOTECHNICAL REPORT.
- 7. WHEN EXISTING SIDEWALK IS CLOSED FOR CONSTRUCTION, CONTRACTOR SHALL BARRICADE THAT AREA AND PROVIDE SAFE ALTERNATE PATH FOR PEDESTRIANS WITH PROPER SIGNAGE.
- 8. ALL TRAFFIC SIGNAGE WITHIN THE ROW SHALL BE PROTECTED IN PLACE AT ALL TIMES. ANY DAMAGE TO THESE DEVICES SHALL BE REPAIRED IMMEDIATELY.
- 9. CONTRACTOR SHALL REPAIR ANY ITEMS DAMAGED DURING CONSTRUCTION TO THEIR ORIGINAL CONDITION.
- 10. THE CONTRACTOR SHALL BE RESPONSIBLE FOR PROVIDING POSITIVE DRAINAGE ON SITE DURING ALL CONSTRUCTION ACTIVITIES.
- 11. THE CONTRACTOR SHALL ENTER AND EXIT THE SITE THROUGH EXISTING DRIVEWAY.
- 12. CONTRACTOR SHALL NOTE ALL UTILITY PLUG LOCATIONS ON FIELD RECORD DRAWINGS.

SAWCUT NOTES:

- 1. SAWCUT 2" MINIMUM DEPTH, EXPOSE AND CLEAN EXISTING REINFORCING STEEL.
- 2. IF NO REINFORCING STEEL EXISTS, #5 HORIZONTAL DOWELS, 24" LONG, GRADE 60, SHALL BE DRILLED AND EMBEDDED 12" INTO THE CENTER OF EXISTING CONCRETE WITH EPOXY.
- 3. ALL REINFORCING STEEL SHALL BE PLACED 3" CLEAR (2" ABSOLUTE MINIMUM) FROM EDGE OF CONCRETE.

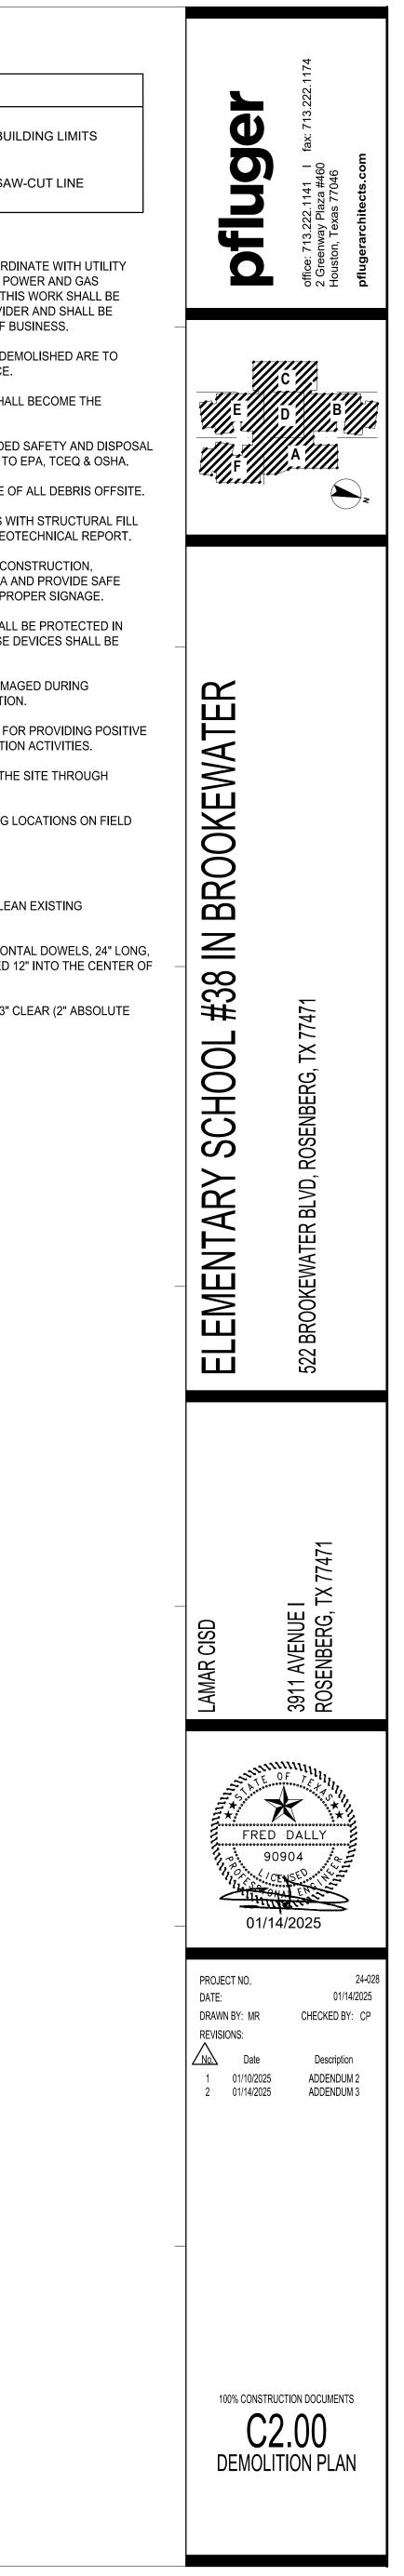



### 5. CONTRACTOR TO OBTAIN ALL PERMITS AND APPROVALS REQUIRED PRIOR TO STARTING CONSTRUCTION. 6. PRIOR TO CONSTRUCTION, THE CONTRACTOR SHALL COORDINATE STAGING AND TRAFFIC CONTROL PLANS WITH OWNER. 7. ALL DISTURBED AREAS NOT TO BE PAVED OR LANDSCAPED SHALL BE

- SODDED UPON COMPLETION.
- ACCORDANCE WITH TCEQ RULES AND REGULATIONS. 9. CONTRACTOR PERFORMING THE WORK SHALL BE RESPONSIBLE FOR SECURING ALL UTILITY PERMITS, PRIOR TO INSTALLATION OF ANY UTILITIES INCLUDING WATER, SEWER, ELECTRIC, CABLE TELEVISION AND
- 10. DOMESTIC WATER LINES LESS THAN 4" IN DIAMETER SHALL BE SCH 40 PVC AND HAVE A MINIMUM COVER OF 2 FEET. DOMESTIC WATER LINES 4 DIAMETER AND LARGER SHALL BE AWWA C-900 DR 14 PVC AND HAVE A MINIMUM COVER OF 4 FEET.
- 11. FIRE WATER SERVICE SHALL BE C-900 SELF-EXTINGUISHING PVC PIPE THAT BEARS UNDERWRITERS' LABORATORIES MARK OF APPROVAL AND IS ACCEPTABLE WITHOUT PENALTY TO TEXAS STATE FIRE INSURANCE COMMITTEE AND HAVE A MINIMUM COVER OF 4 FEET.
- 12. SANITARY SEWER PIPE SHALL BE SDR-26 PVC.

# TRAFFIC SIGNAGE KEY NOTES:

- (c1) PROPOSED S5-1 AND S7-1T WITH LED BEACONS (SCHOOL SPEED LIMIT 20 - CELL PHONE USE PROHIBITED UP TO \$200 FINE).
- (2) PROPOSED S5-2 AND R2-1 (END SCHOOL ZONE - SPEED LIMIT 35).
- G3 PROPOSED S1-1 AND W16-7P (SCHOOL CROSSING AND DIAG (SCHOOL CROSSING AND DIAGONAL ARROW SIGN LEFT).
- G4 PROPOSED S1-1 AND W16-9P (SCHOOL CROSSING AHEAD). (SCHOOL CROSSING - AHEAD).

PROPOSED BUILDING OUTLINE


LEGEND


1. ALL UNDERGROUND UTILITIES SHOWN ARE NOT GUARANTEED TO BE COMPLETE OR DEFINITE, BUT WERE OBTAINED FROM THE BEST

2. CONTRACTOR TO VERIFY ALL UNDERGROUND UTILITIES IN THE FIELD PRIOR TO CONSTRUCTION AND NOTIFY ENGINEER IF DISCREPANCIES

3. THE LOCATION OF ALL UTILITIES PRESENTED ON THESE DRAWINGS IS SHOWN IN AN APPROXIMATE WAY ONLY. THE CONTRACTOR SHALL DETERMINE THE EXACT LOCATION BEFORE COMMENCING WORK. HE AGREES TO BE FULLY RESPONSIBLE FOR ANY AND ALL DAMAGES WHICH MIGHT BE OCCASIONED BY HIS FAILURE TO EXACTLY LOCATE AND

4. CAUTION!!! THERE ARE OVERHEAD POWER LINES IN THE WORK AREA. CONTRACTOR SHALL FOLLOW CITY, STATE AND FEDERAL GUIDELINES

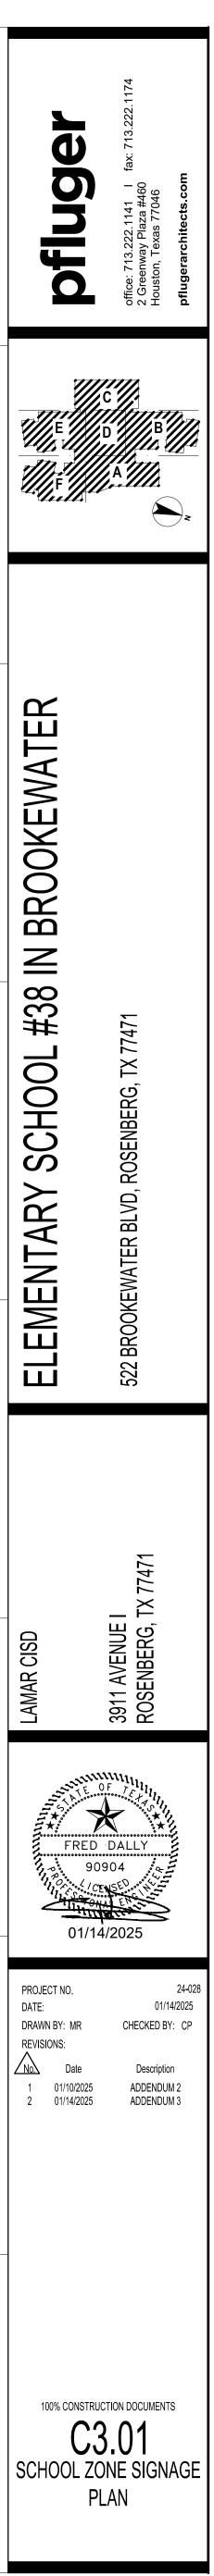

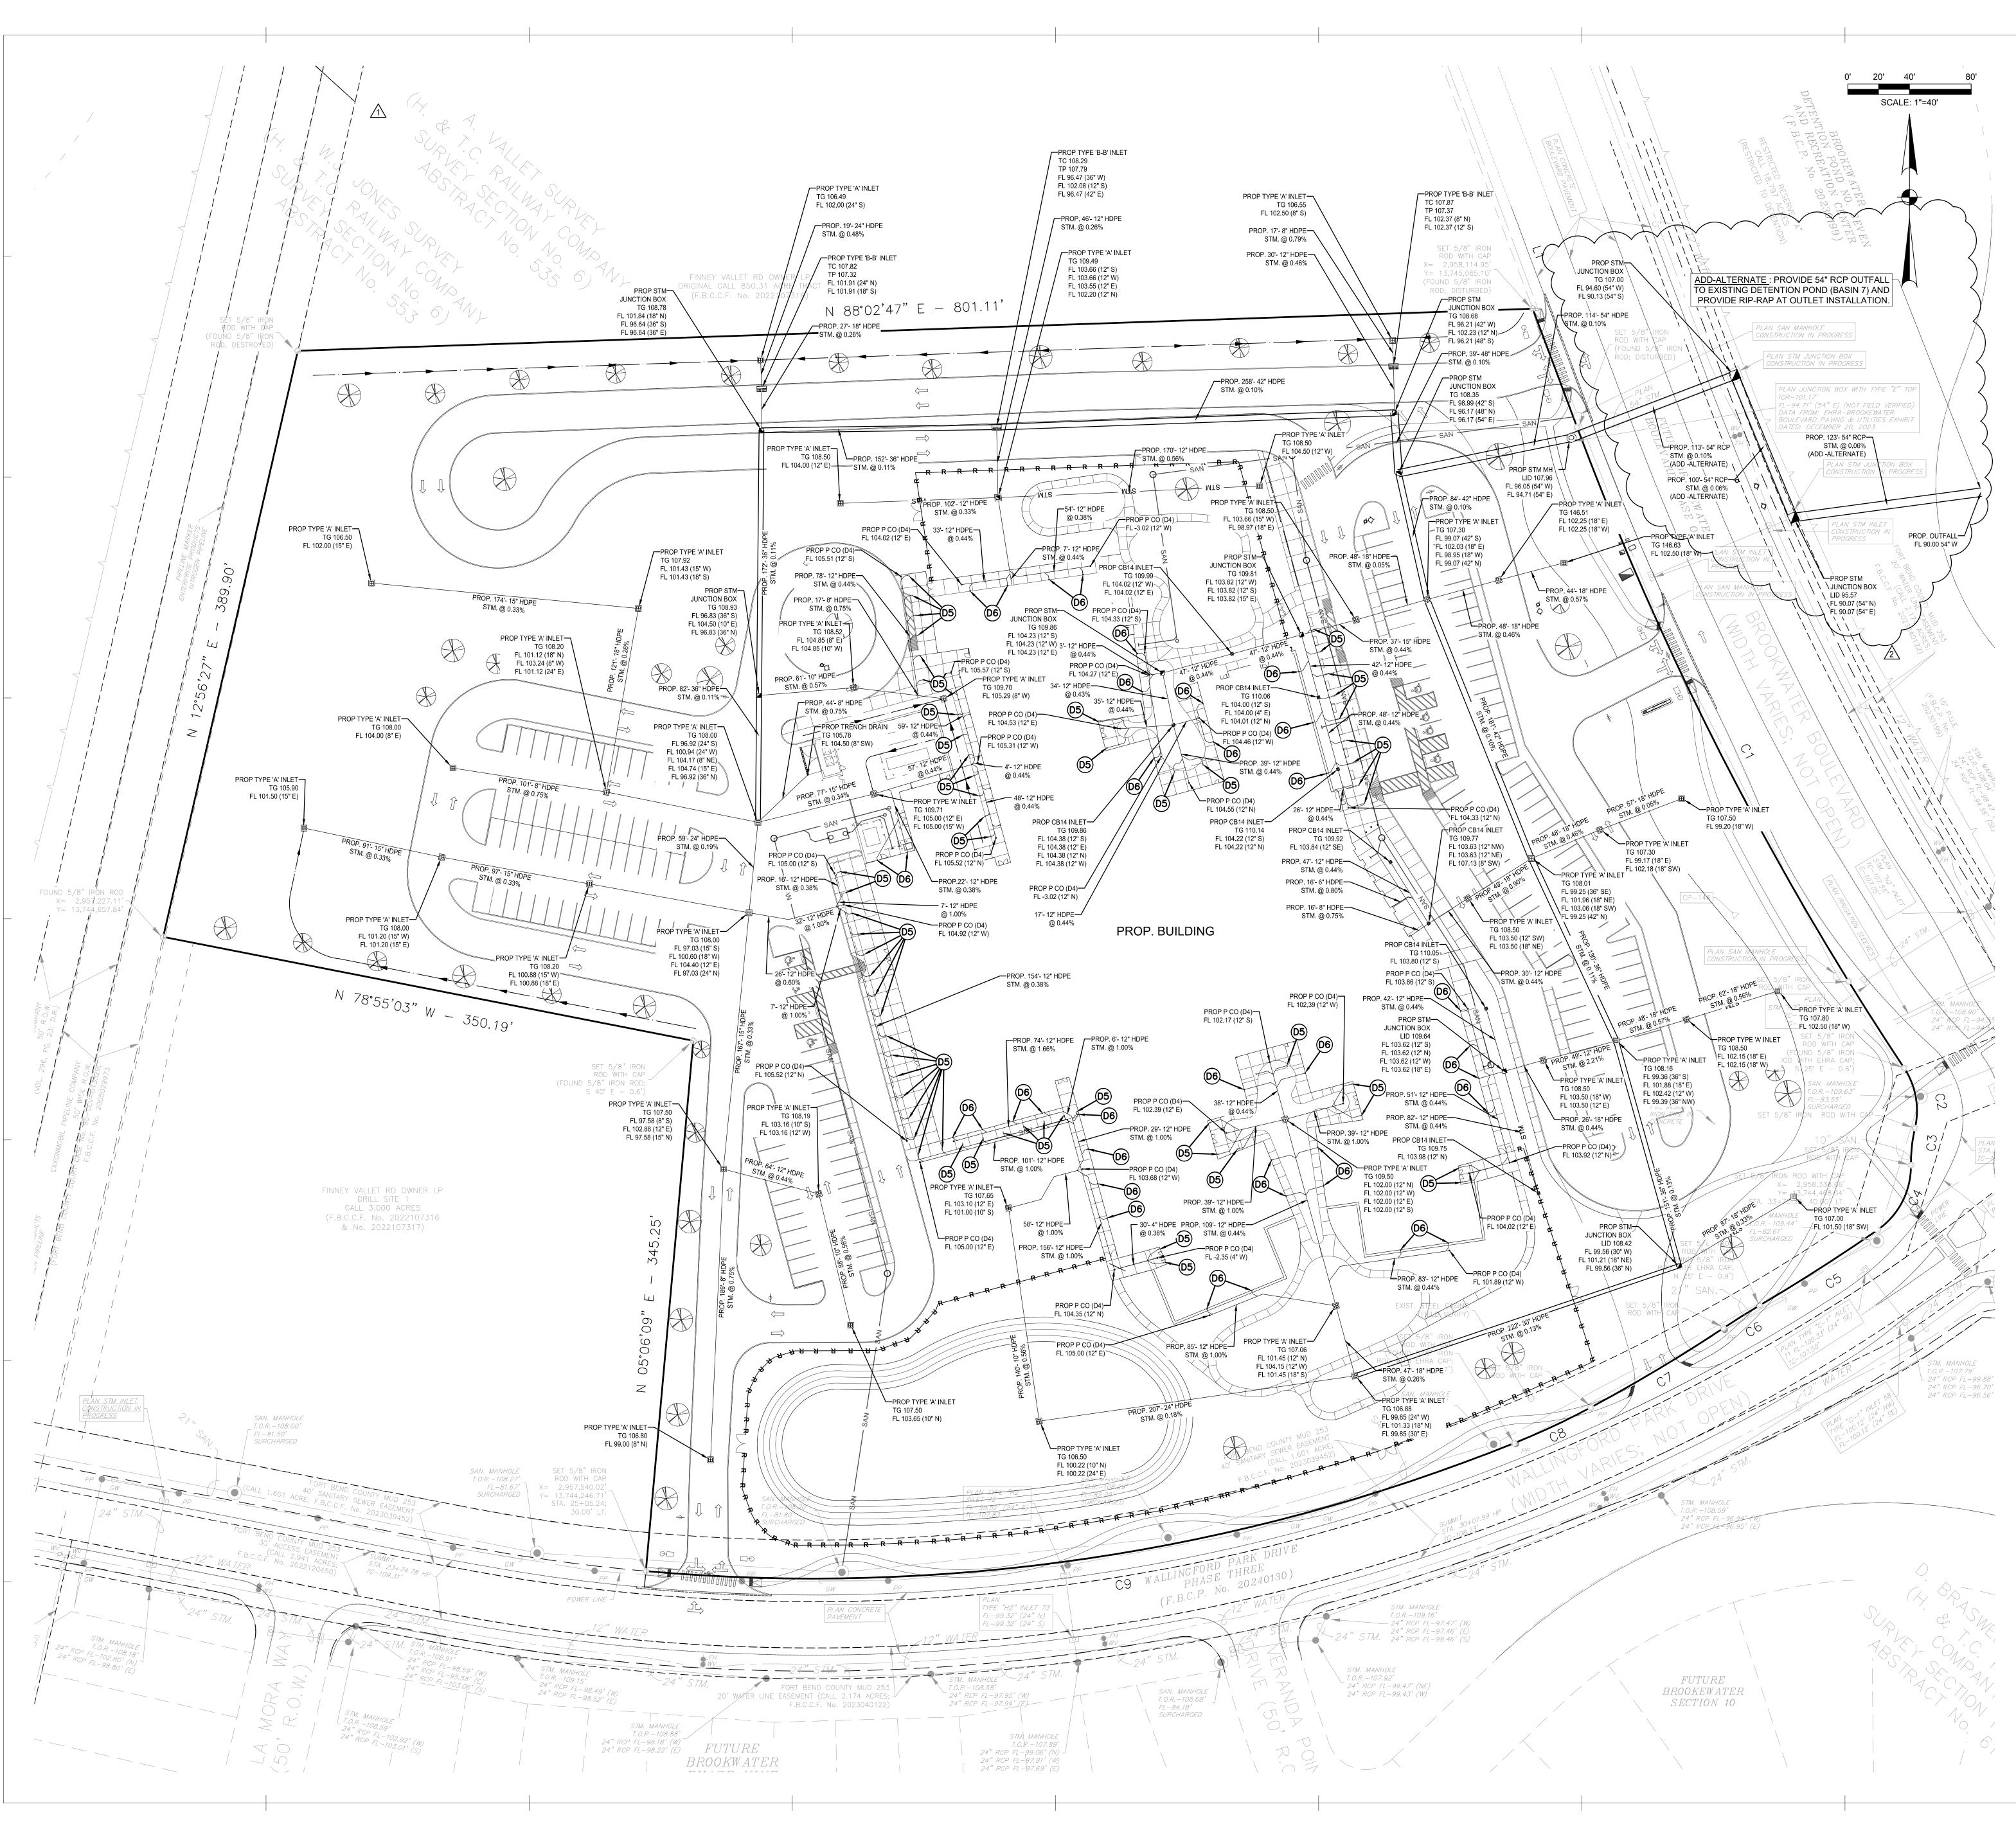

# LEGEND PROPOSED BUILDING OUTLINE


### GENERAL CONSTRUCTION NOTES


- 1. ALL UNDERGROUND UTILITIES SHOWN ARE NOT GUARANTEED TO BE COMPLETE OR DEFINITE, BUT WERE OBTAINED FROM THE BEST INFORMATION AVAILABLE.
- 2. CONTRACTOR TO VERIFY ALL UNDERGROUND UTILITIES IN THE FIELD PRIOR TO CONSTRUCTION AND NOTIFY ENGINEER IF DISCREPANCIES OCCUR.
- 3. THE LOCATION OF ALL UTILITIES PRESENTED ON THESE DRAWINGS IS SHOWN IN AN APPROXIMATE WAY ONLY. THE CONTRACTOR SHALL DETERMINE THE EXACT LOCATION BEFORE COMMENCING WORK. HE AGREES TO BE FULLY RESPONSIBLE FOR ANY AND ALL DAMAGES WHICH MIGHT BE OCCASIONED BY HIS FAILURE TO EXACTLY LOCATE AND PRESERVE THESE UNDERGROUND UTILITIES.
- 4. CAUTION!!! THERE ARE OVERHEAD POWER LINES IN THE WORK AREA. CONTRACTOR SHALL FOLLOW CITY, STATE AND FEDERAL GUIDELINES WHEN WORKING AROUND EXISTING POWER LINES.
- 5. CONTRACTOR TO OBTAIN ALL PERMITS AND APPROVALS REQUIRED PRIOR TO STARTING CONSTRUCTION.
- 6. PRIOR TO CONSTRUCTION, THE CONTRACTOR SHALL COORDINATE STAGING AND TRAFFIC CONTROL PLANS WITH OWNER.
- 7. ALL DISTURBED AREAS NOT TO BE PAVED OR LANDSCAPED SHALL BE SODDED UPON COMPLETION.
- WATER AND SEWER MAINS SHALL BE CONSTRUCTED AND TESTED IN
- CONTRACTOR PERFORMING THE WORK SHALL BE RESPONSIBLE FOR SECURING ALL UTILITY PERMITS, PRIOR TO INSTALLATION OF ANY UTILITIES INCLUDING WATER, SEWER, ELECTRIC, CABLE TELEVISION AND GAS.
- 10. DOMESTIC WATER LINES LESS THAN 4" IN DIAMETER SHALL BE SCH 40 PVC AND HAVE A MINIMUM COVER OF 2 FEET. DOMESTIC WATER LINES 4" DIAMETER AND LARGER SHALL BE AWWA C-900 DR 14 PVC AND HAVE A MINIMUM COVER OF 4 FEET.
- 11. FIRE WATER SERVICE SHALL BE C-900 SELF-EXTINGUISHING PVC PIPE THAT BEARS UNDERWRITERS' LABORATORIES MARK OF APPROVAL AND IS ACCEPTABLE WITHOUT PENALTY TO TEXAS STATE FIRE INSURANCE COMMITTEE AND HAVE A MINIMUM COVER OF 4 FEET.
- 12. SANITARY SEWER PIPE SHALL BE SDR-26 PVC.

BID ALTERNATE NO. 2: IF BROOKEWATER BOULEVARD IS NOT COMPLETED BY THE TIME THAT THE SCHOOL CONSTRUCTION IS FINISHED, PLEASE PROVIDE FOR THE CONSTRUCTION OF THE ULTIMATE RAINSTORM OUTFALL THAT WILL CONNECT TO THE EXISTING DETENTION AREA ACROSS BROOKEWATER BOULEVARD THIS SHOULD INCLUDE ALL NECESSARY FINAL CONNECTIONS TO THE PERMANENT OUTFALLS AND ANY ADDITIONAL WORK REQUIRED FOR COMPLETE FINALIZATION.

### DRAINAGE KEY NOTES:

- PROPOSED STORM SEWER CLEANOUT. CLEANOUTS IN PAVED AREAS SHALL HAVE TRAFFIC RATED LIDS. PROPOSED 4" ROOF DRAIN COLLECTOR AT 1.0 % MINIMUM SLOPE. REFER TO ARCH AND MEP PLANS FOR EXACT
- ROOF DRAIN LOCATIONS. PROPOSED 8" ROOF DRAIN COLLECTOR AT 0.7 % MINIMUM SLOPE. REFER TO ARCH AND MEP PLANS FOR EXACT ROOF DRAIN LOCATIONS.

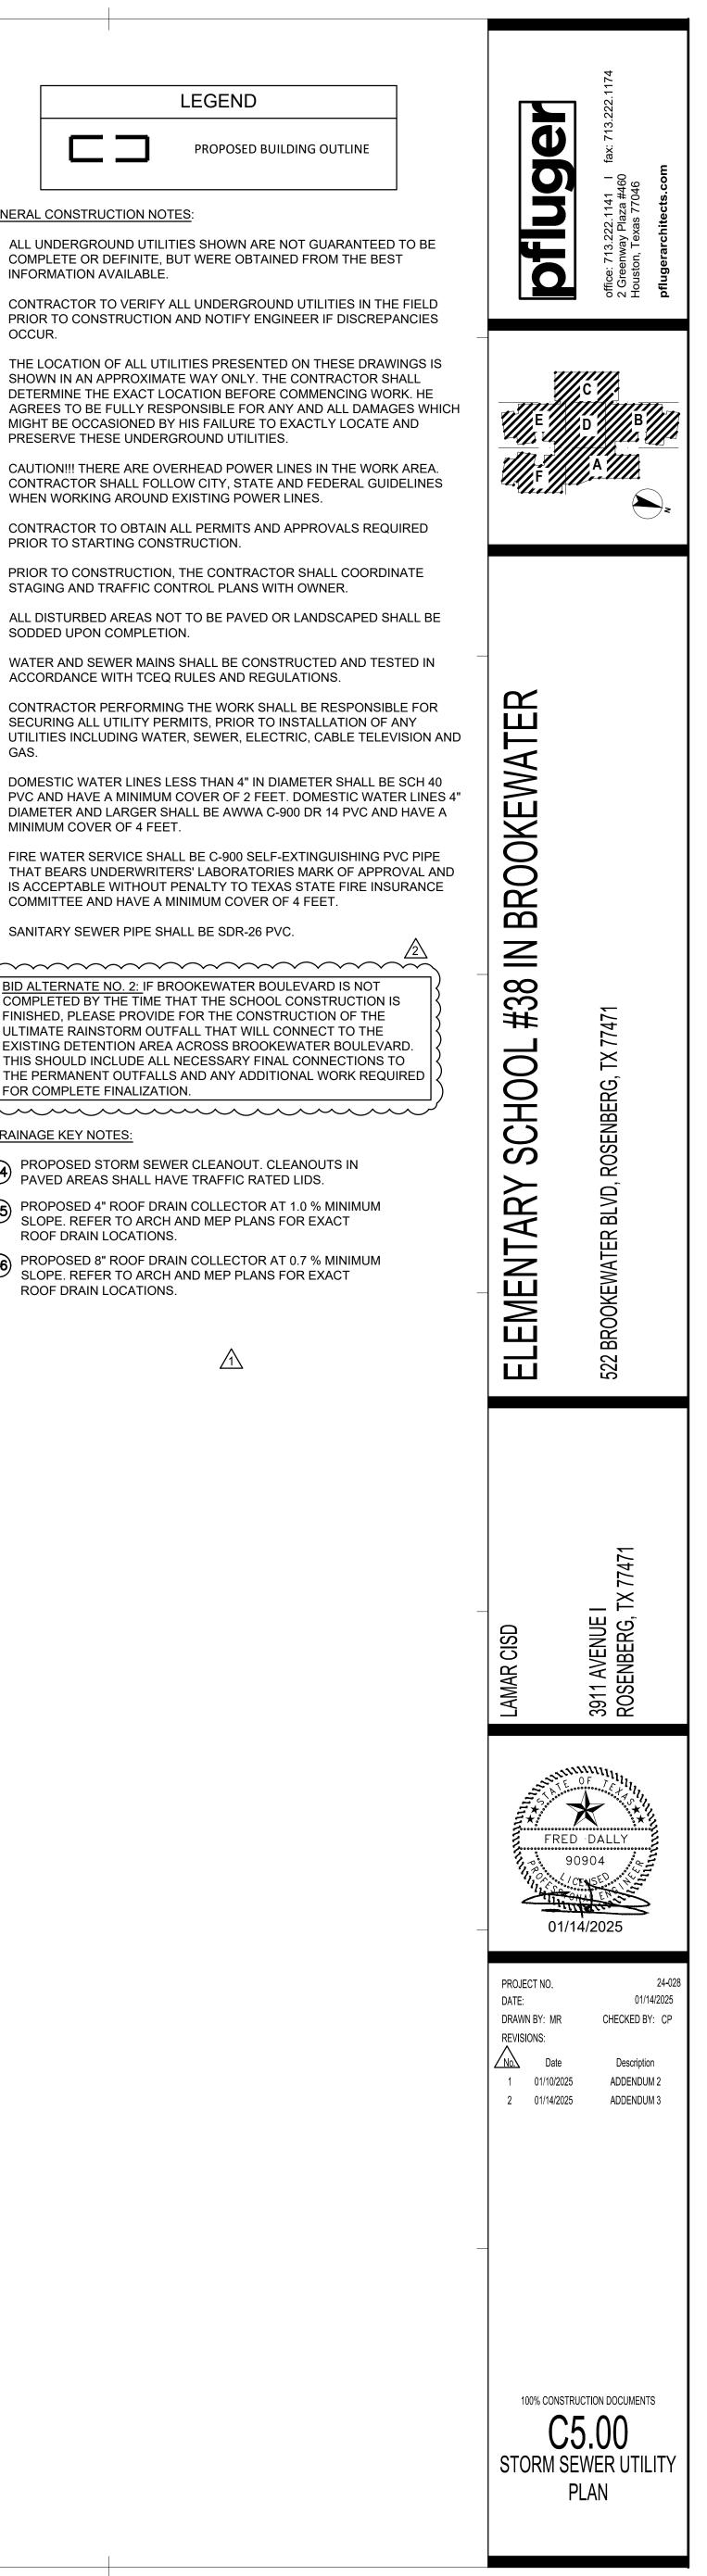

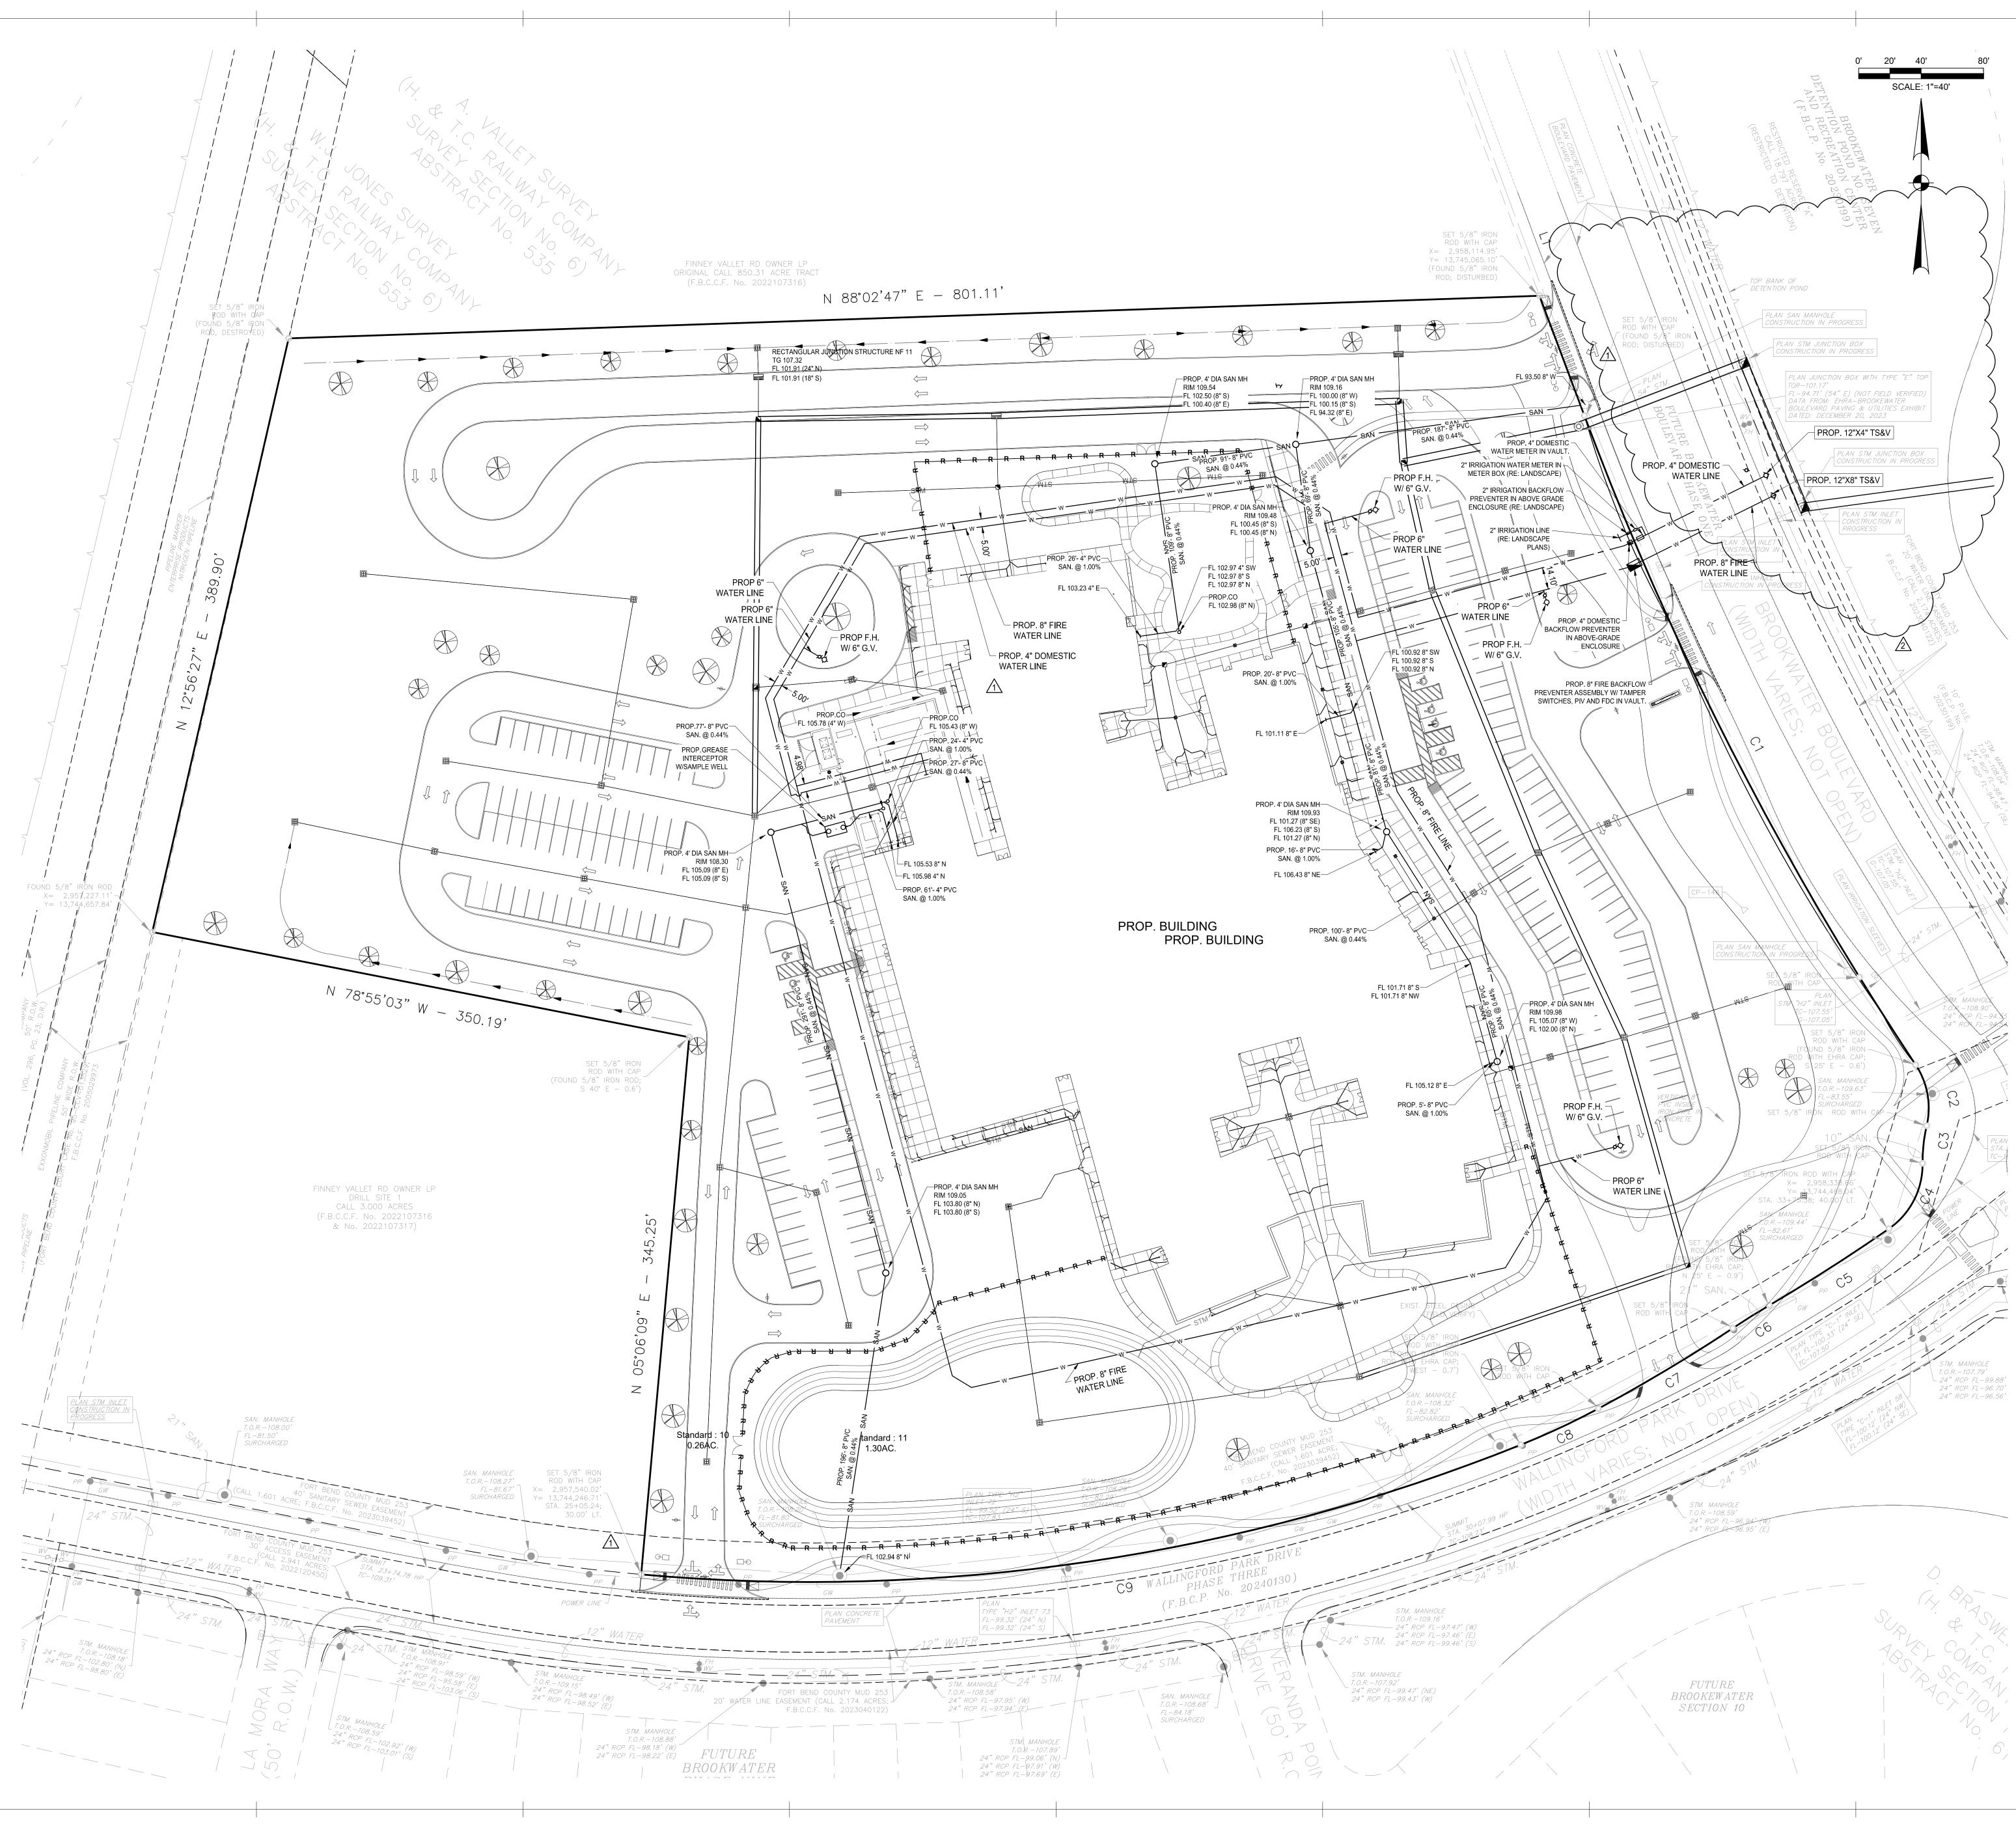

# LEGEND PROPOSED BUILDING OUTLINE


### GENERAL CONSTRUCTION NOTES:

- 1. ALL UNDERGROUND UTILITIES SHOWN ARE NOT GUARANTEED TO BE COMPLETE OR DEFINITE, BUT WERE OBTAINED FROM THE BEST INFORMATION AVAILABLE.
- 2. CONTRACTOR TO VERIFY ALL UNDERGROUND UTILITIES IN THE FIELD PRIOR TO CONSTRUCTION AND NOTIFY ENGINEER IF DISCREPANCIES OCCUR.
- 3. THE LOCATION OF ALL UTILITIES PRESENTED ON THESE DRAWINGS IS SHOWN IN AN APPROXIMATE WAY ONLY. THE CONTRACTOR SHALL DETERMINE THE EXACT LOCATION BEFORE COMMENCING WORK. HE AGREES TO BE FULLY RESPONSIBLE FOR ANY AND ALL DAMAGES WHICH MIGHT BE OCCASIONED BY HIS FAILURE TO EXACTLY LOCATE AND PRESERVE THESE UNDERGROUND UTILITIES.
- 4. CAUTION!!! THERE ARE OVERHEAD POWER LINES IN THE WORK AREA. CONTRACTOR SHALL FOLLOW CITY, STATE AND FEDERAL GUIDELINES WHEN WORKING AROUND EXISTING POWER LINES.
- 5. CONTRACTOR TO OBTAIN ALL PERMITS AND APPROVALS REQUIRED PRIOR TO STARTING CONSTRUCTION.
- 6. PRIOR TO CONSTRUCTION, THE CONTRACTOR SHALL COORDINATE STAGING AND TRAFFIC CONTROL PLANS WITH OWNER.
- 7. ALL DISTURBED AREAS NOT TO BE PAVED OR LANDSCAPED SHALL BE SODDED UPON COMPLETION.
- 8. WATER AND SEWER MAINS SHALL BE CONSTRUCTED AND TESTED IN
- 9. CONTRACTOR PERFORMING THE WORK SHALL BE RESPONSIBLE FOR SECURING ALL UTILITY PERMITS, PRIOR TO INSTALLATION OF ANY UTILITIES INCLUDING WATER, SEWER, ELECTRIC, CABLE TELEVISION AND GAS.
- 10. DOMESTIC WATER LINES LESS THAN 4" IN DIAMETER SHALL BE SCH 40 PVC AND HAVE A MINIMUM COVER OF 2 FEET. DOMESTIC WATER LINES 4" DIAMETER AND LARGER SHALL BE AWWA C-900 DR 14 PVC AND HAVE A MINIMUM COVER OF 4 FEET.
- 11. FIRE WATER SERVICE SHALL BE C-900 SELF-EXTINGUISHING PVC PIPE THAT BEARS UNDERWRITERS' LABORATORIES MARK OF APPROVAL AND IS ACCEPTABLE WITHOUT PENALTY TO TEXAS STATE FIRE INSURANCE COMMITTEE AND HAVE A MINIMUM COVER OF 4 FEET.

12. SANITARY SEWER PIPE SHALL BE SDR-26 PVC.

NOTE: PROVIDE TRACER WIRE FOR ALL SITE UTILITIES, INCLUDING GAS LINE, SANITARY SEWER, STORM SEWER, FIRE AND DOMESTIC WATER LINES.

ACCORDANCE WITH TCEQ RULES AND REGULATIONS.

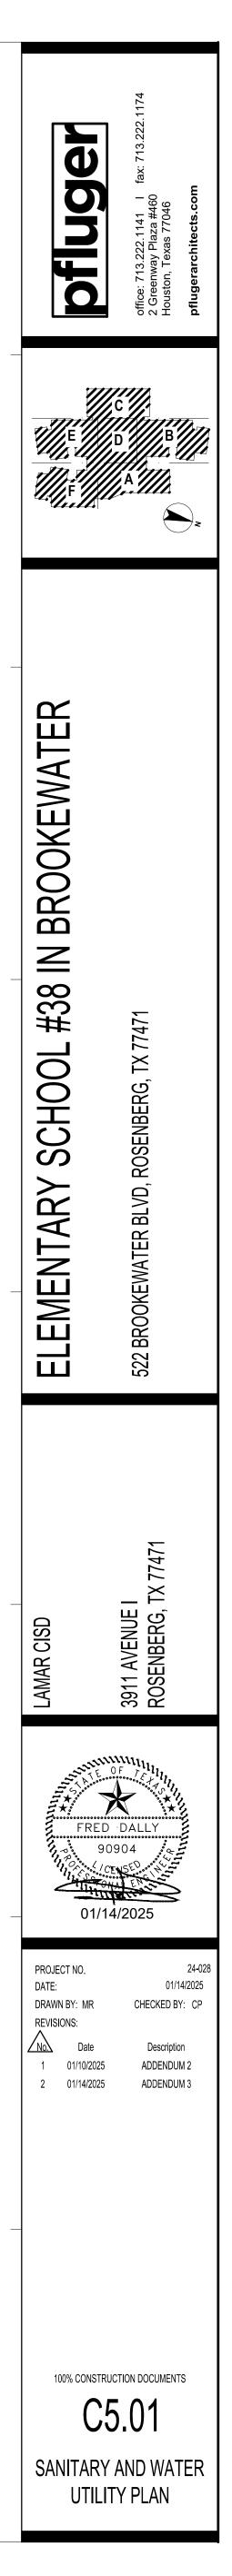




 $\Box$ 24 Ρ


|              | LEGEND   |
|--------------|--|
| SYMBOL       | DESCRIPTION                                    |
| XX<br>Y.YY   | DRAINAGE AREA DESIGNA<br>DRAINAGE AREA (ACRES) |
| OS<br>Y.YY   | OFFSITE DRAINAGE AREA<br>OFFSITE DRAINAGE AREA |
| X.XX<br>Y.YY | 3-YEAR FLOW (C.F.S.)<br>100-YEAR FLOW (C.F.S.) |
|              | DRAINAGE AREA BOUND                            |
|              | DRAINAGE SUB-AREA BO                           |
| (XX)         | MANHOLE OR INLET NUM                           |
|              | DRAINAGE PATTERN                               |
| <br>         | - PROPOSED SWALE LINE                          |


### GENERAL CONSTRUCTION NOTES:

- 1. ALL UNDERGROUND UTILITIES SHOWN ARE NOT GUARANTEED TO BE COMPLETE OR DEFINITE, BUT WERE OBTAINED FROM THE BEST INFORMATION AVAILABLE.
- 2. CONTRACTOR TO VERIFY ALL UNDERGROUND UTILITIES IN THE FIELD PRIOR TO CONSTRUCTION AND NOTIFY ENGINEER IF DISCREPANCIES OCCUR.
- 3. THE LOCATION OF ALL UTILITIES PRESENTED ON THESE DRAWINGS IS SHOWN IN AN APPROXIMATE WAY ONLY. THE CONTRACTOR SHALL DETERMINE THE EXACT LOCATION BEFORE COMMENCING WORK. HE AGREES TO BE FULLY RESPONSIBLE FOR ANY AND ALL DAMAGES WHICH MIGHT BE OCCASIONED BY HIS FAILURE TO EXACTLY LOCATE AND PRESERVE THESE UNDERGROUND UTILITIES.
- 4. CAUTION!!! THERE ARE OVERHEAD POWER LINES IN THE WORK AREA. CONTRACTOR SHALL FOLLOW CITY, STATE AND FEDERAL GUIDELINES WHEN WORKING AROUND EXISTING POWER LINES.
- 5. CONTRACTOR TO OBTAIN ALL PERMITS AND APPROVALS REQUIRED PRIOR TO STARTING CONSTRUCTION.
- 6. PRIOR TO CONSTRUCTION, THE CONTRACTOR SHALL COORDINATE STAGING AND TRAFFIC CONTROL PLANS WITH OWNER.
- 7. ALL DISTURBED AREAS NOT TO BE PAVED OR LANDSCAPED SHALL BE SODDED UPON COMPLETION.
- 8. WATER AND SEWER MAINS SHALL BE CONSTRUCTED AND TESTED IN ACCORDANCE WITH TCEQ RULES AND REGULATIONS. CONTRACTOR PERFORMING THE WORK SHALL BE RESPONSIBLE FOR SECURING ALL UTILITY PERMITS, PRIOR TO INSTALLATION OF ANY
- UTILITIES INCLUDING WATER, SEWER, ELECTRIC, CABLE TELEVISION AND GAS. DOMESTIC WATER LINES LESS THAN 4" IN DIAMETER SHALL BE SCH 40 10. PVC AND HAVE A MINIMUM COVER OF 2 FEET. DOMESTIC WATER LINES 4"
- DIAMETER AND LARGER SHALL BE AWWA C-900 DR 14 PVC AND HAVE A MINIMUM COVER OF 4 FEET. 11. FIRE WATER SERVICE SHALL BE C-900 SELF-EXTINGUISHING PVC PIPE
- THAT BEARS UNDERWRITERS' LABORATORIES MARK OF APPROVAL AND IS ACCEPTABLE WITHOUT PENALTY TO TEXAS STATE FIRE INSURANCE COMMITTEE AND HAVE A MINIMUM COVER OF 4 FEET.
- 12. SANITARY SEWER PIPE SHALL BE SDR-26 PVC.


SCALE: 1"=40

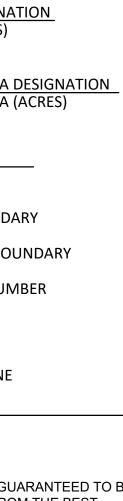

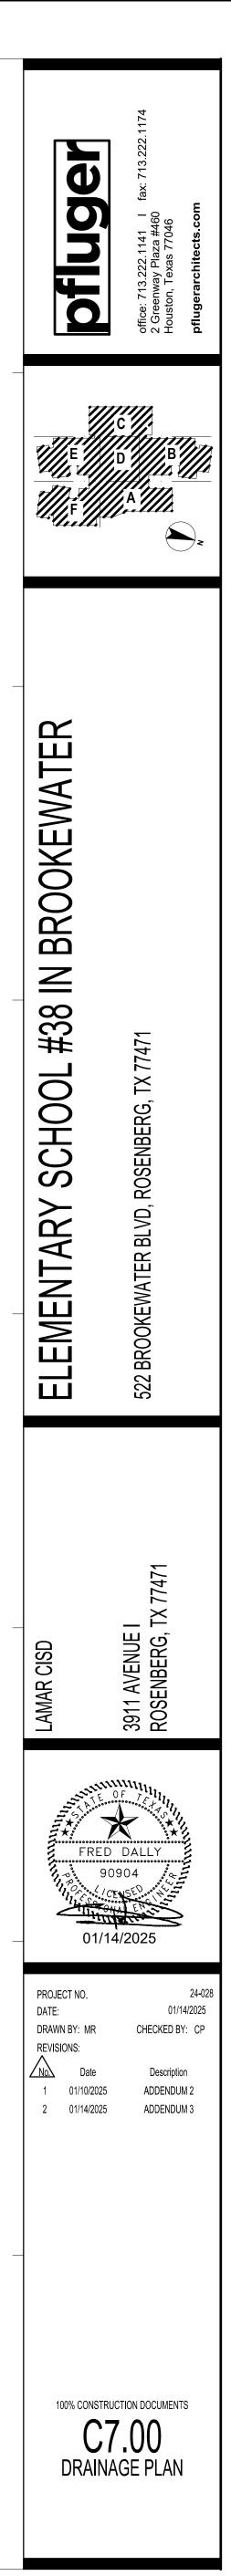


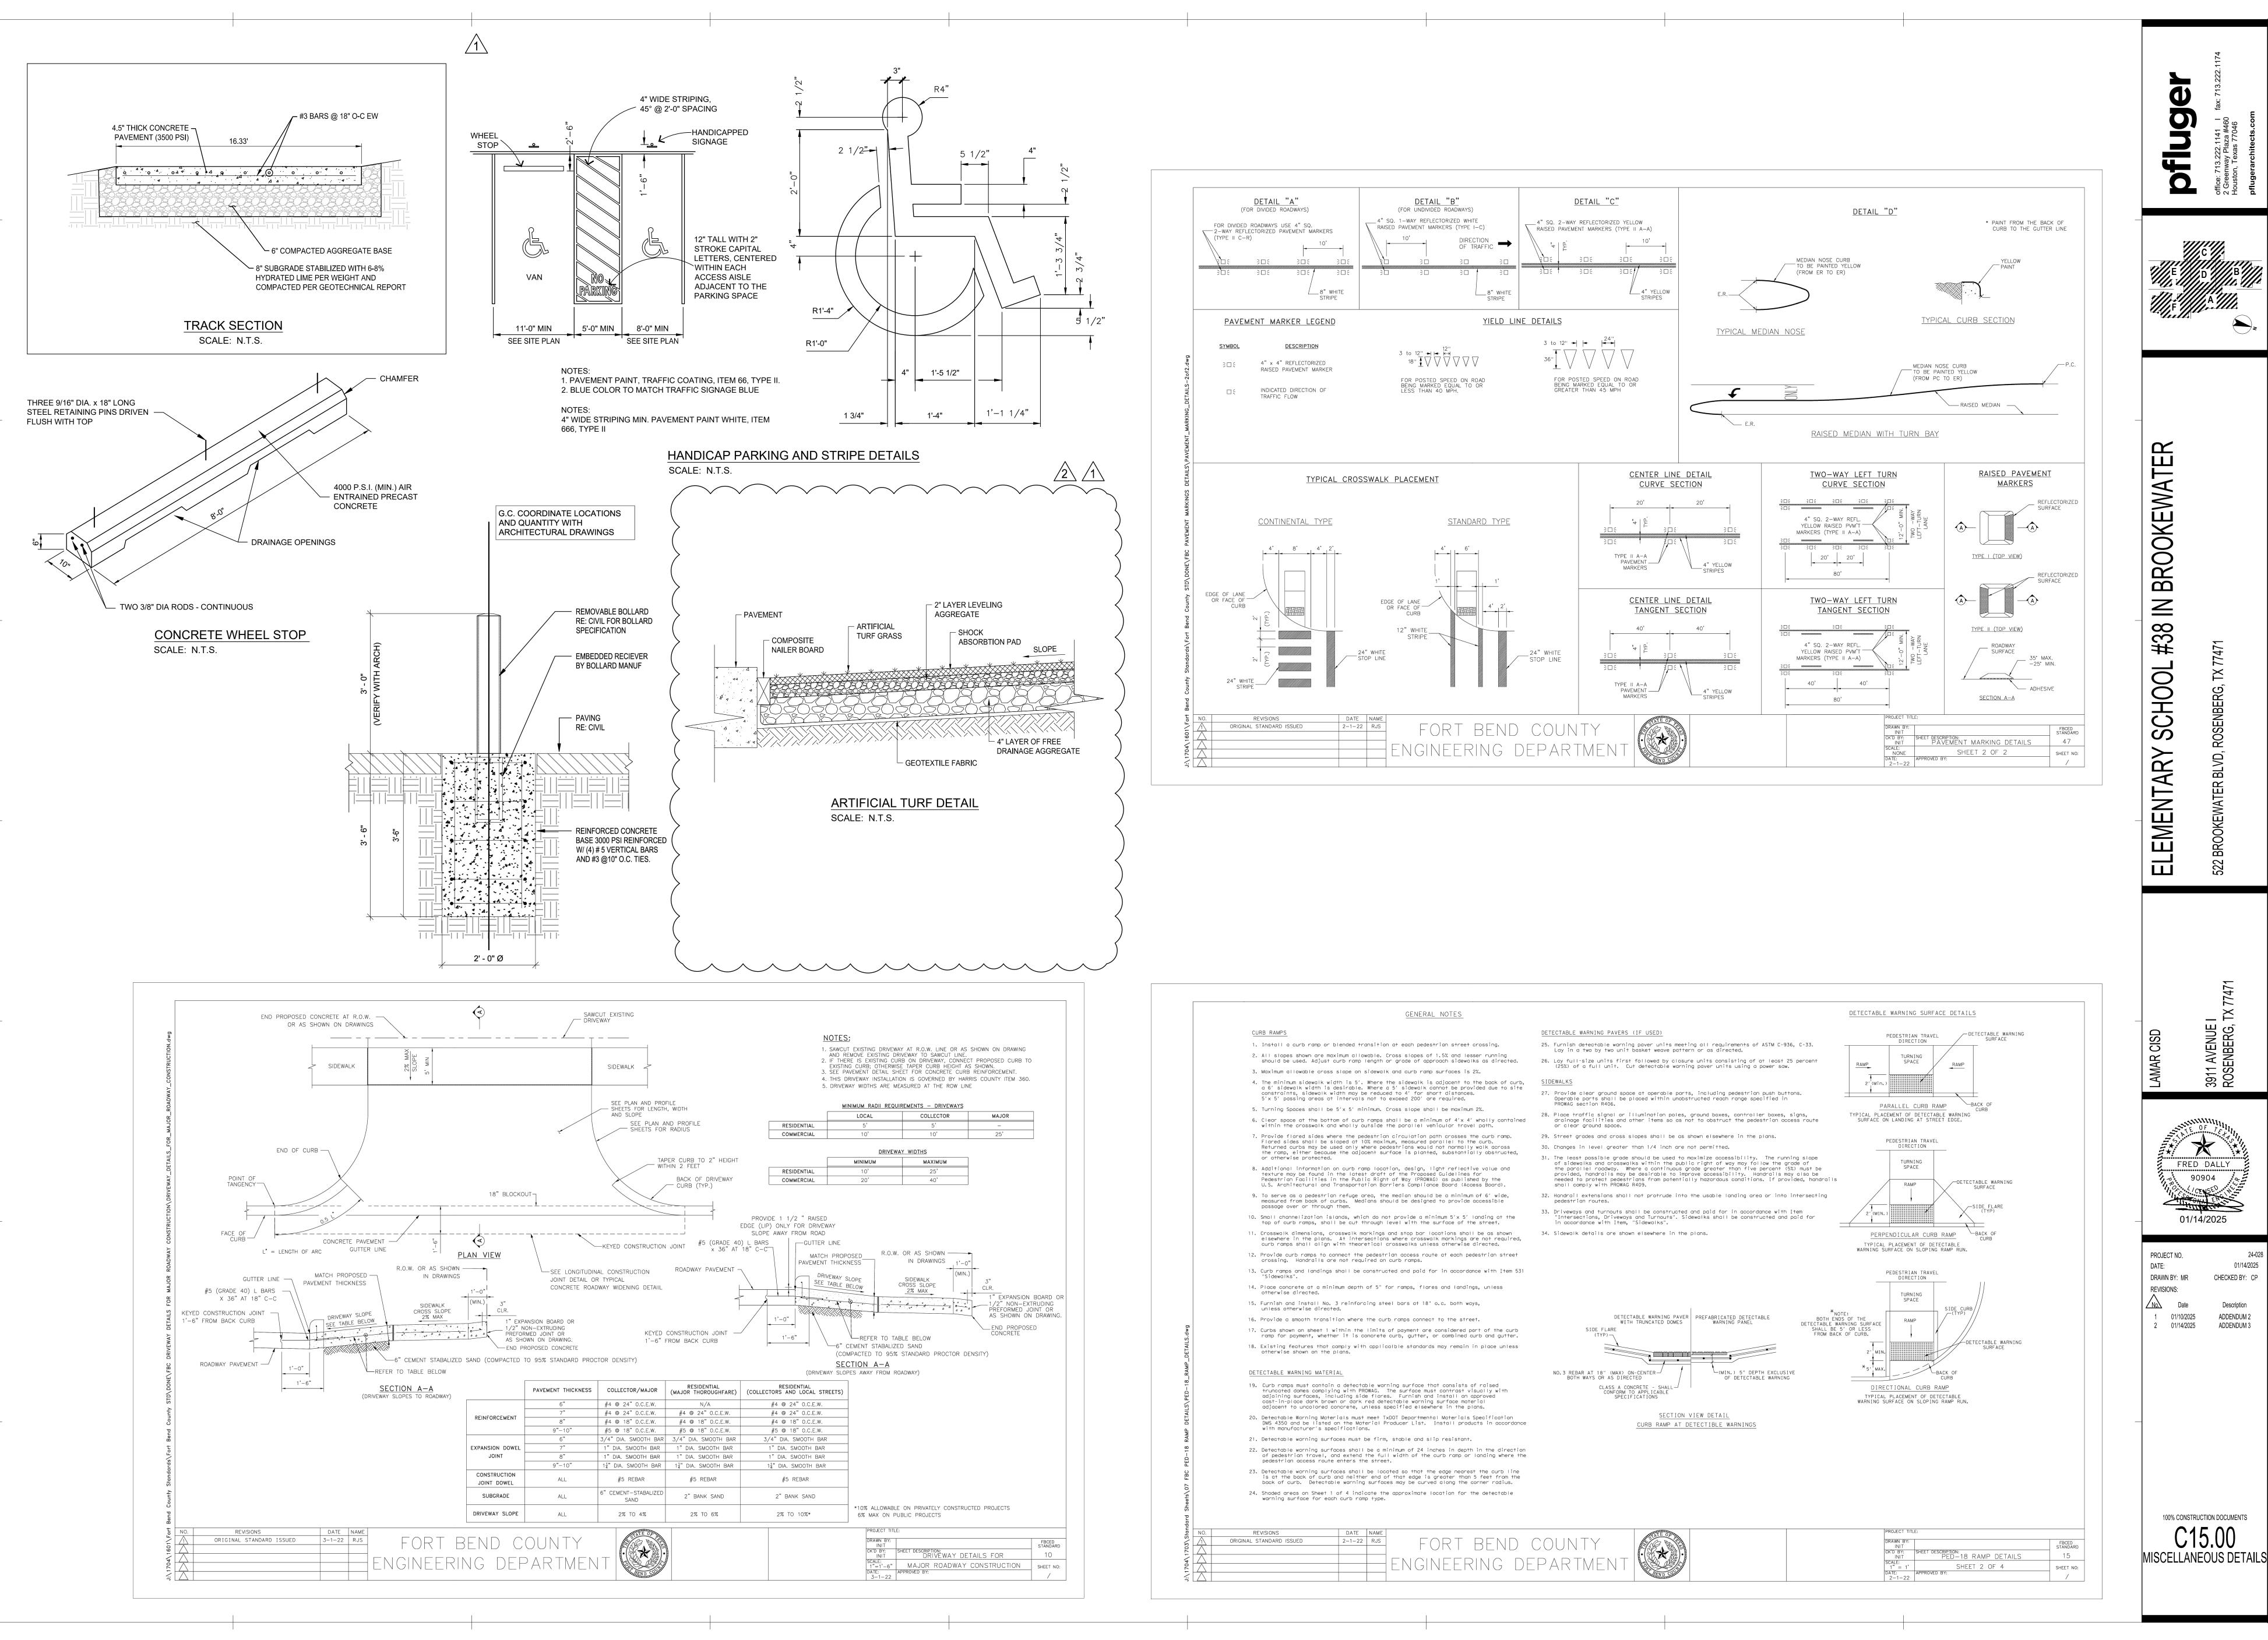


| PROJECT TITL      | E:  |
|-------------------|---|
| DRAWN BY:         |   |
| INIT              |   |
| CK'D BY:<br>INIT  | SHEET DESCRIPTION:<br>PED-18 RAMP DETAILS |
| SCALE:<br>1" = 1' | SHEET 2 OF 4                              |
| DATE:<br>2-1-22   | APPROVED BY:                              |

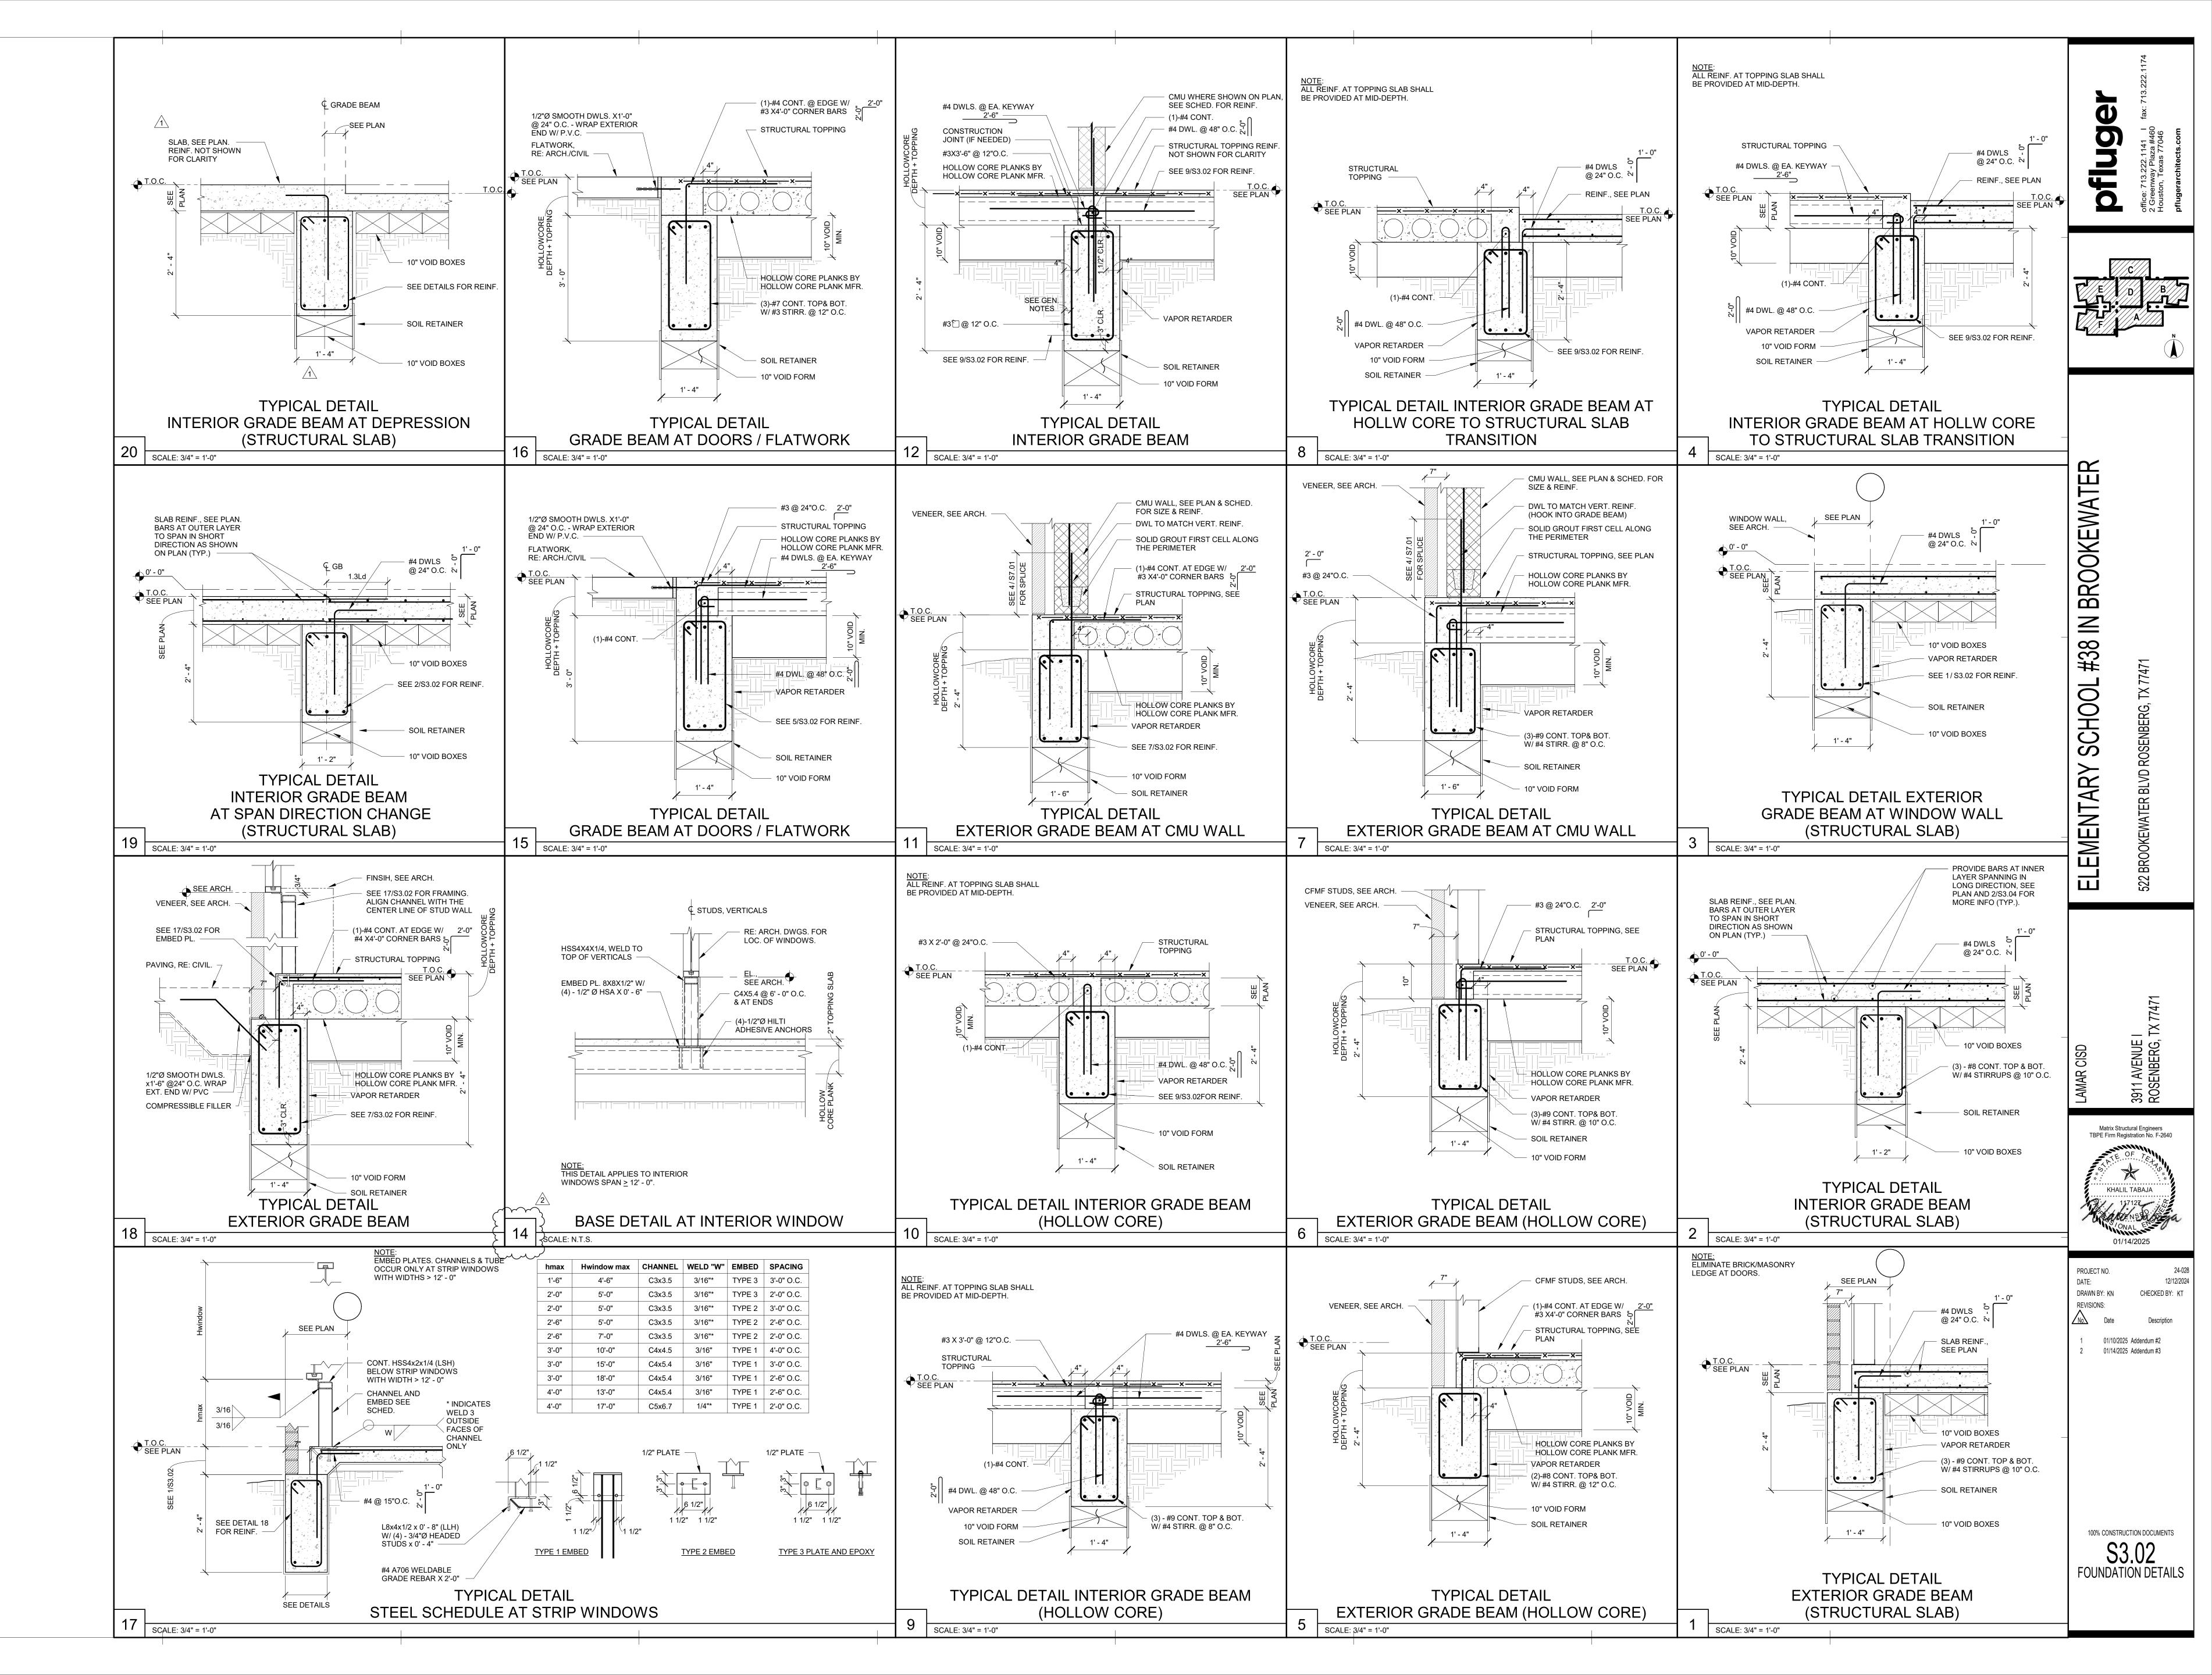

2025 9:35:38 PM Autodesk Docs://24-028 Lamar CISD - Elementary School #38 Brookewater/24064\_STRUCT\_LAMAR CISD\_ES38\_R24.rvt

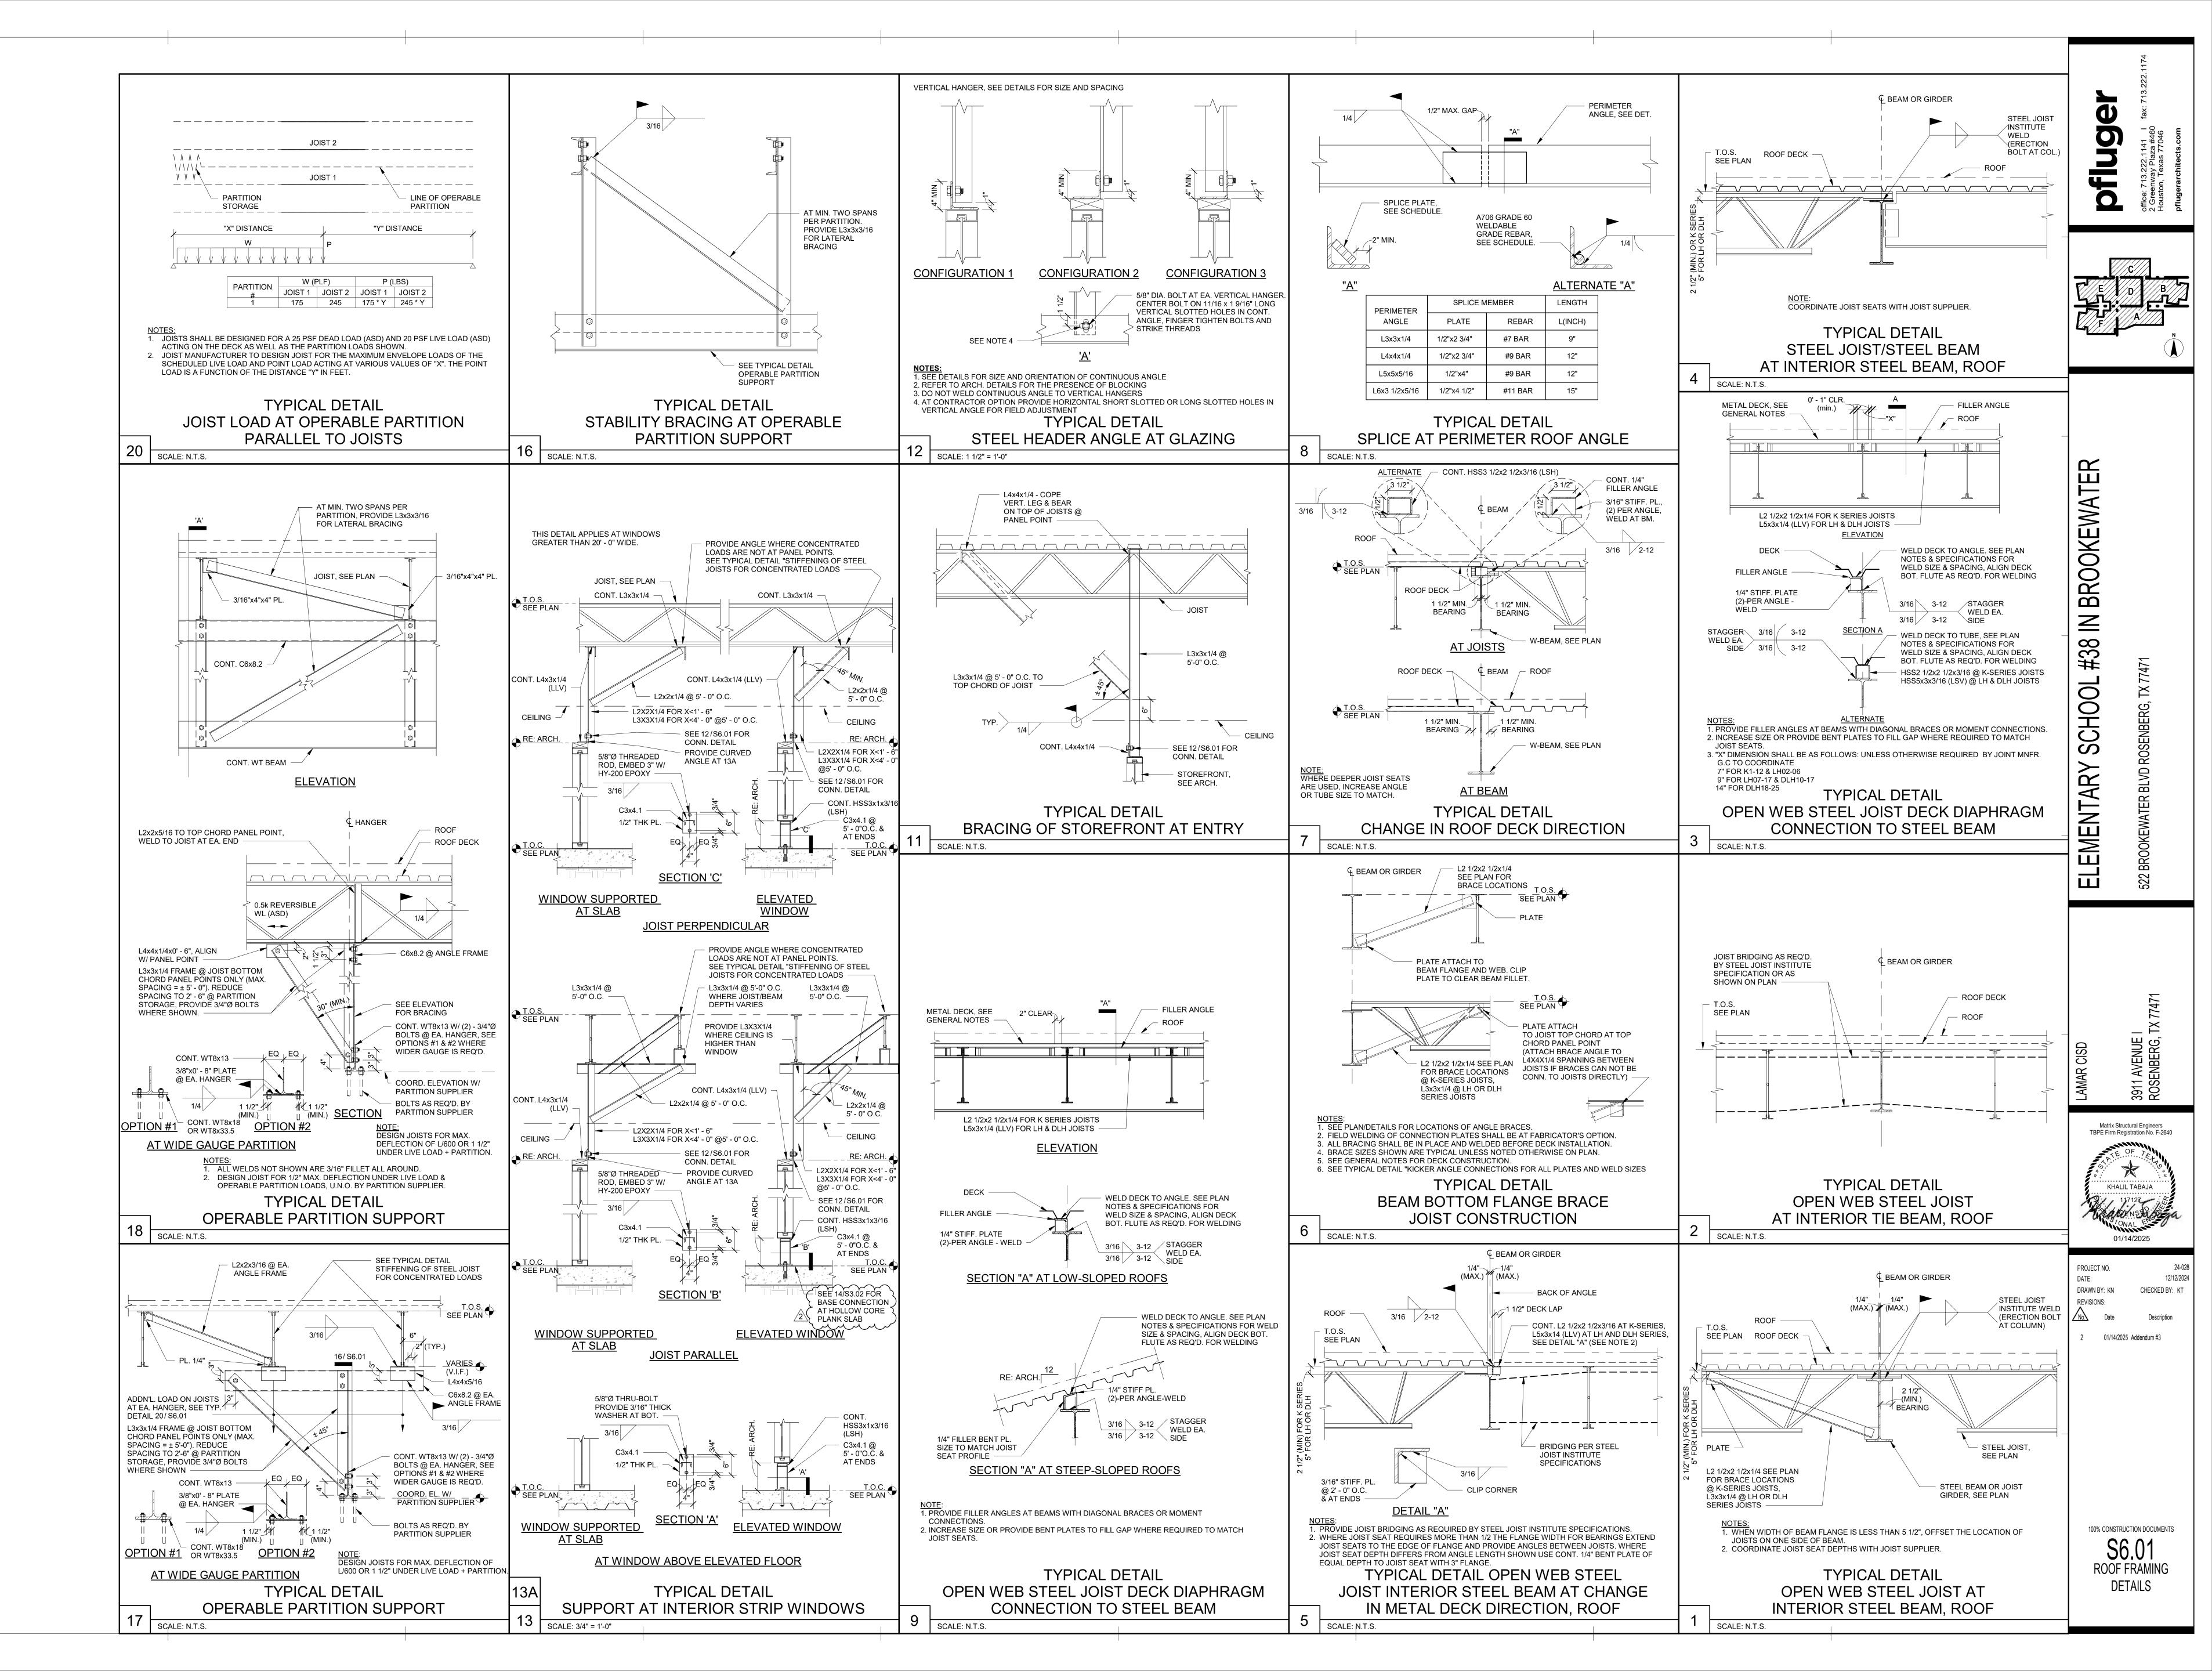

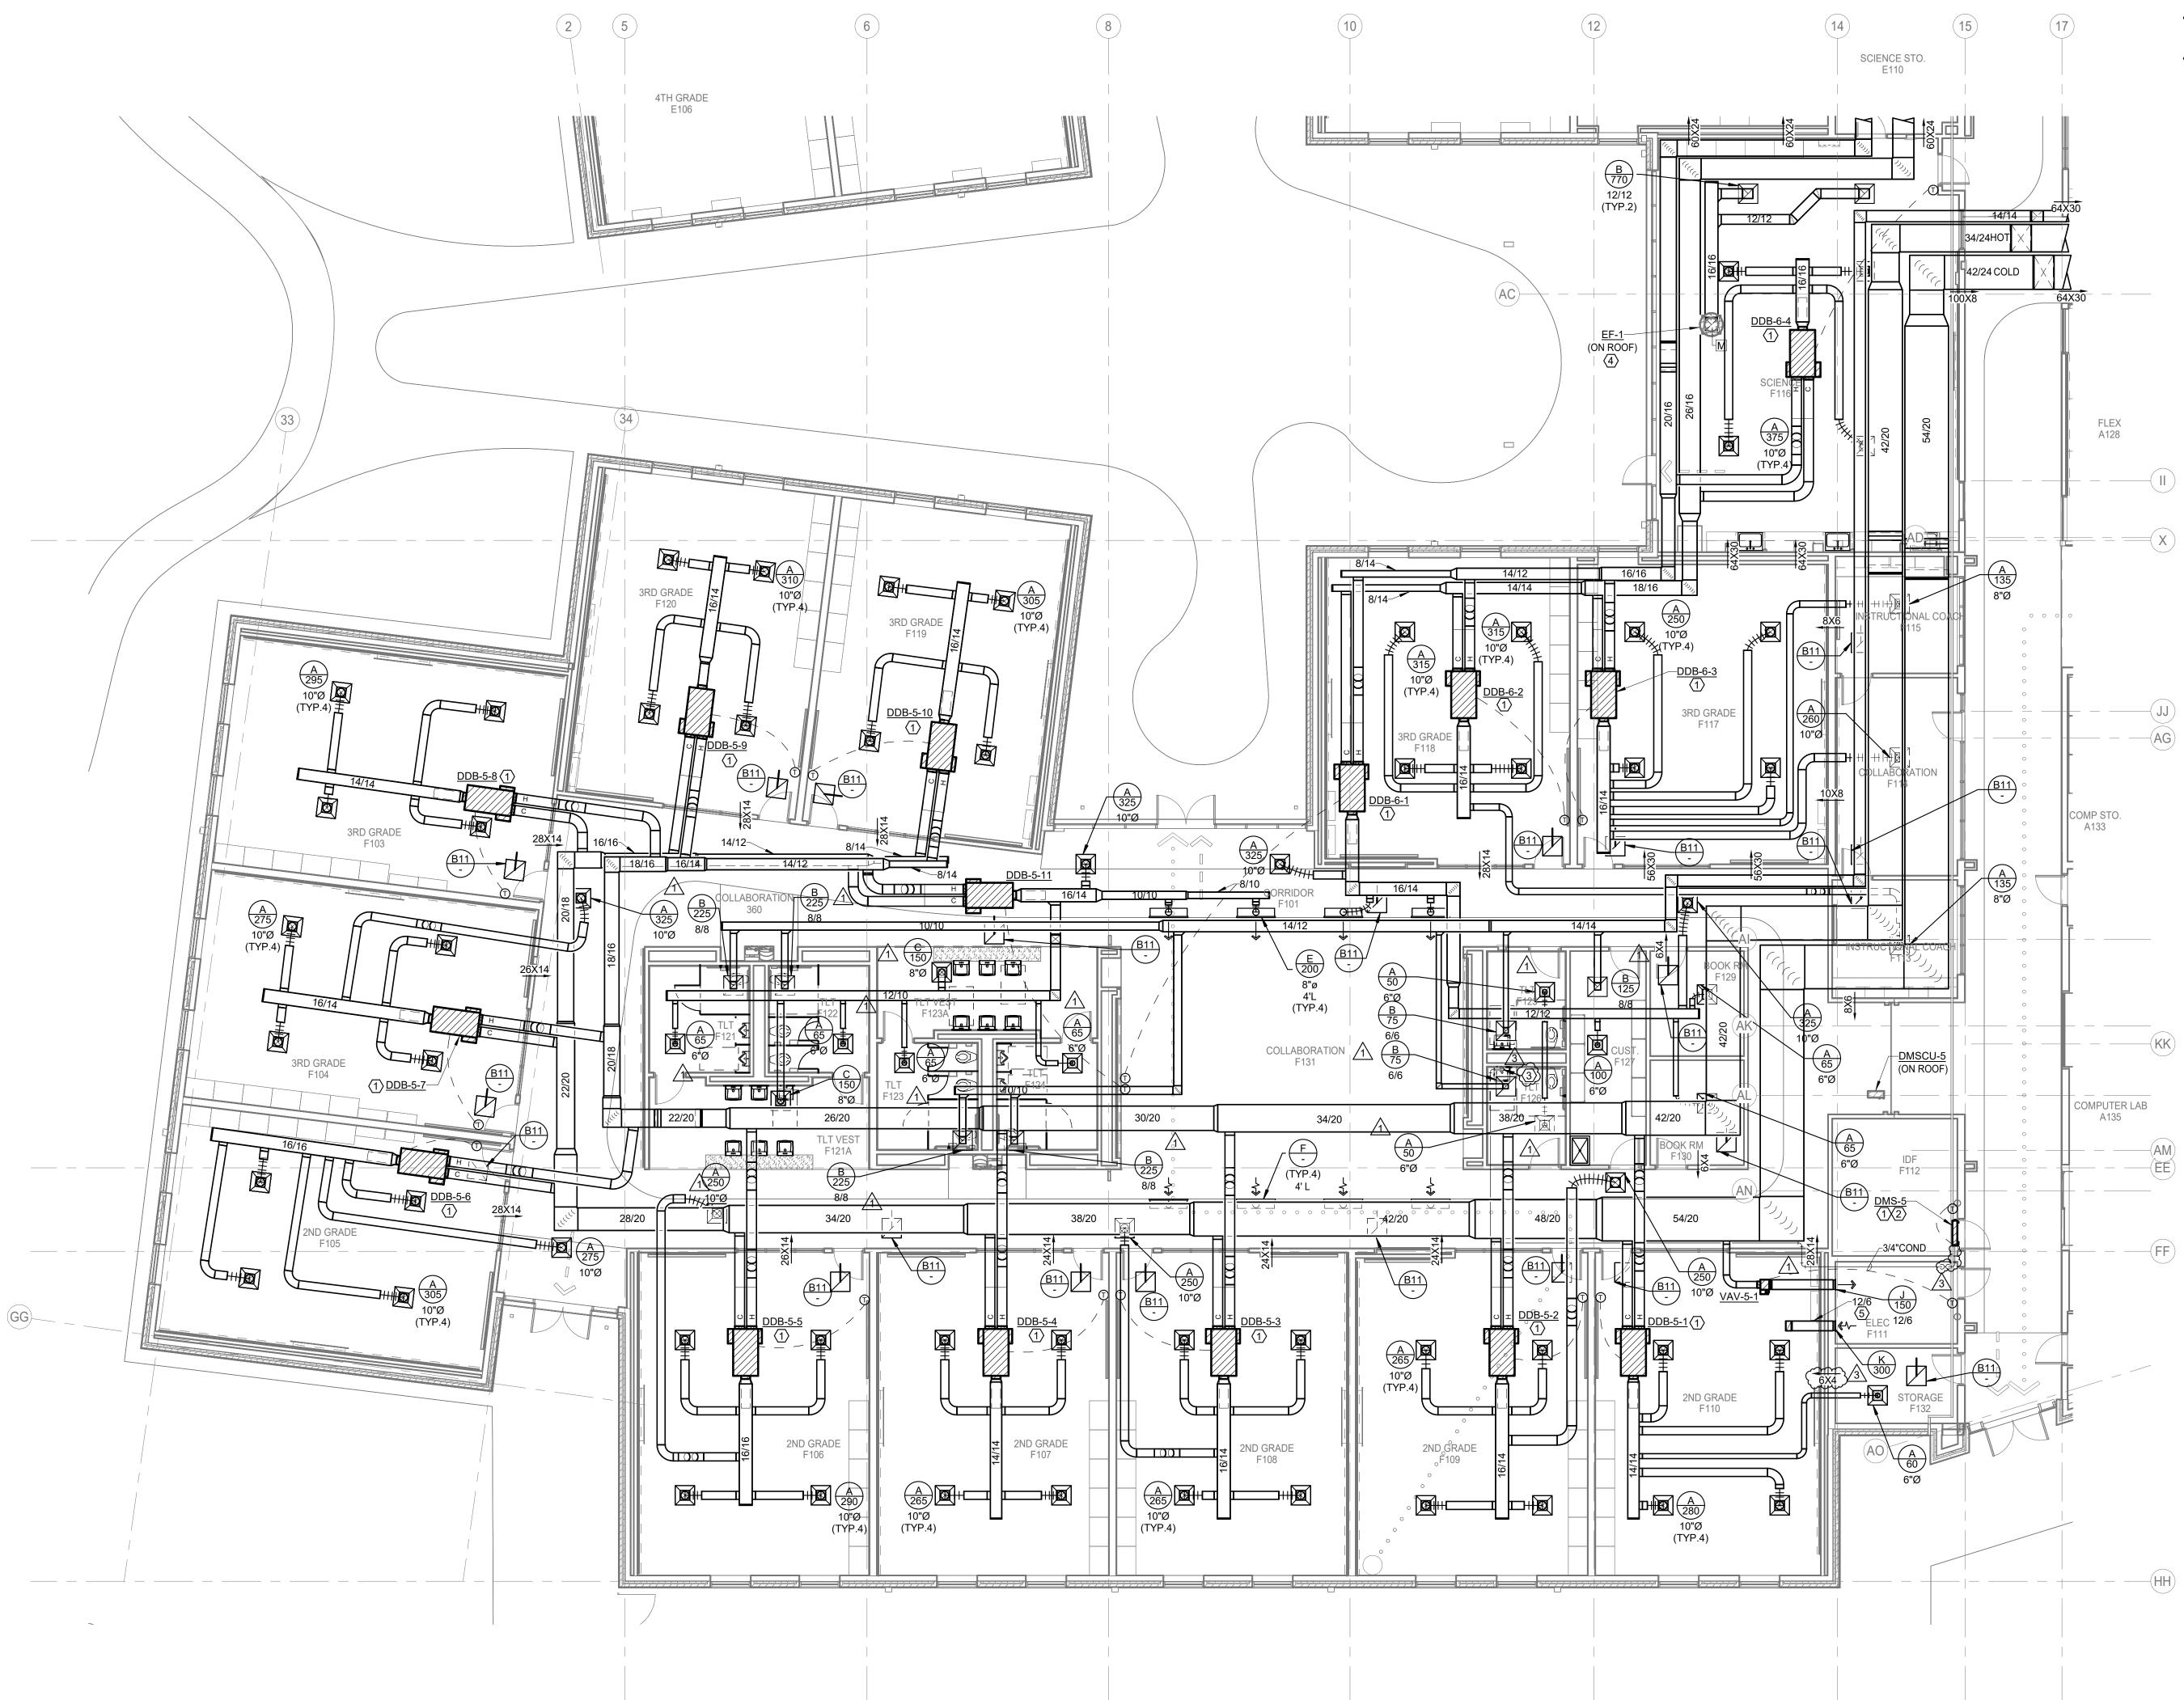



# N MECHANICAL 01 FLOOR PLAN - AREA F Scale: 1/8" = 1'-0"

# TRADES. FINISHED FLOOR). UNLESS OTHERWISE NOTED. THE ELECTRICAL CONTRACTOR FOR ALL ELECTRICAL POWER REQUIREMENTS. AND DO NOT NECESSARILY REFLECT ACTUAL DIMENSIONS. IT IS THE RESPONSIBILITY OF THE CONTRACTOR TO FIELD-VERIFY ALL DIMENSIONS AND COORDINATE PLACEMENT OF ALL EQUIPMENT AND ROUTING OF ALL PIPING AND/OR HVAC SYSTEMS. OBSTRUCT. RECOMMENDATION.


# **MECHANICAL GENERAL NOTES:** 1. COORDINATE IN THE FIELD THE EXACT LOCATION OF MECHANICAL EQUIPMENT WITH CONTRACTOR AND ALL 2. SENSORS SHALL BE MOUNTED AT +48" AFF (ABOVE 3. MECHANICAL CONTRACTOR SHALL COORDINATE WITH 4. THESE CONSTRUCTION DRAWINGS ARE DIAGRAMMATIC MECHANICAL KEYED NOTES (1) VERIFY SERVICE CLEARANCES WITH EQUIPMENT MANUFACTURER. COORDINATE WITH ALL TRADES NOT TO 2 ROUTE REFRIGERANT LINES TO ASSOCIATED CONDENSING UNIT ON ROOF. SIZE LINES PER MANUFACTURER'S $\langle 3 \rangle$ ROUTE CONDENSATE PIPE AT SIZE INDICATED TO WYE

- TAIL PIECE. REFER TO PLUMBING DRAWINGS. (4) ROUTE EXHAUST AIR DUCTWORK AT SIZE INDICATED UP TO EXHAUST FAN ON ROOF. TRANSITION AS REQUIRED TO CONNECT TO FAN ON ROOF.
- $\langle 5 \rangle$  PROVIDE INTERNALLY INSULATED RETURN AIR ELBOW.

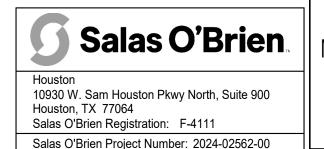

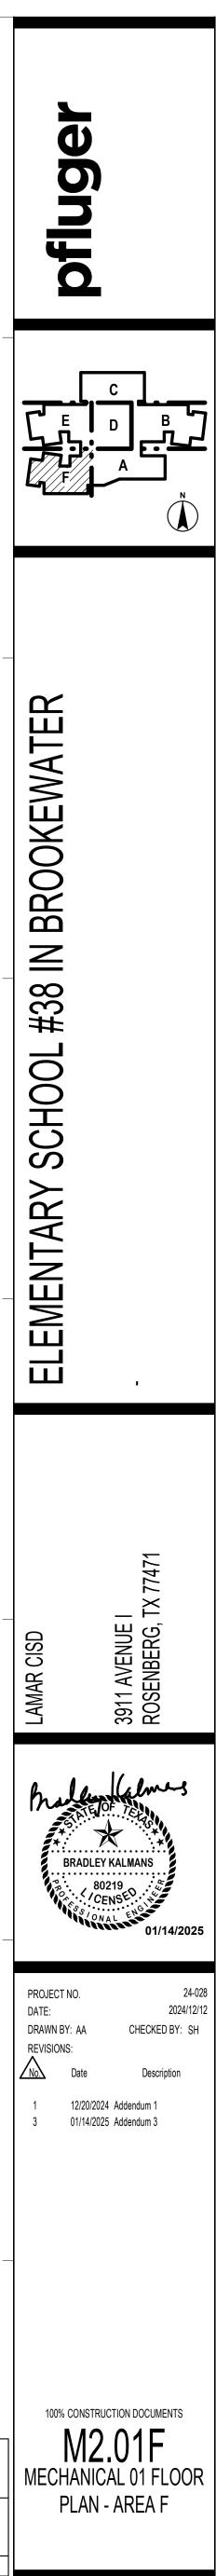


Salas O'Brien Project Number: 2024-02562-00

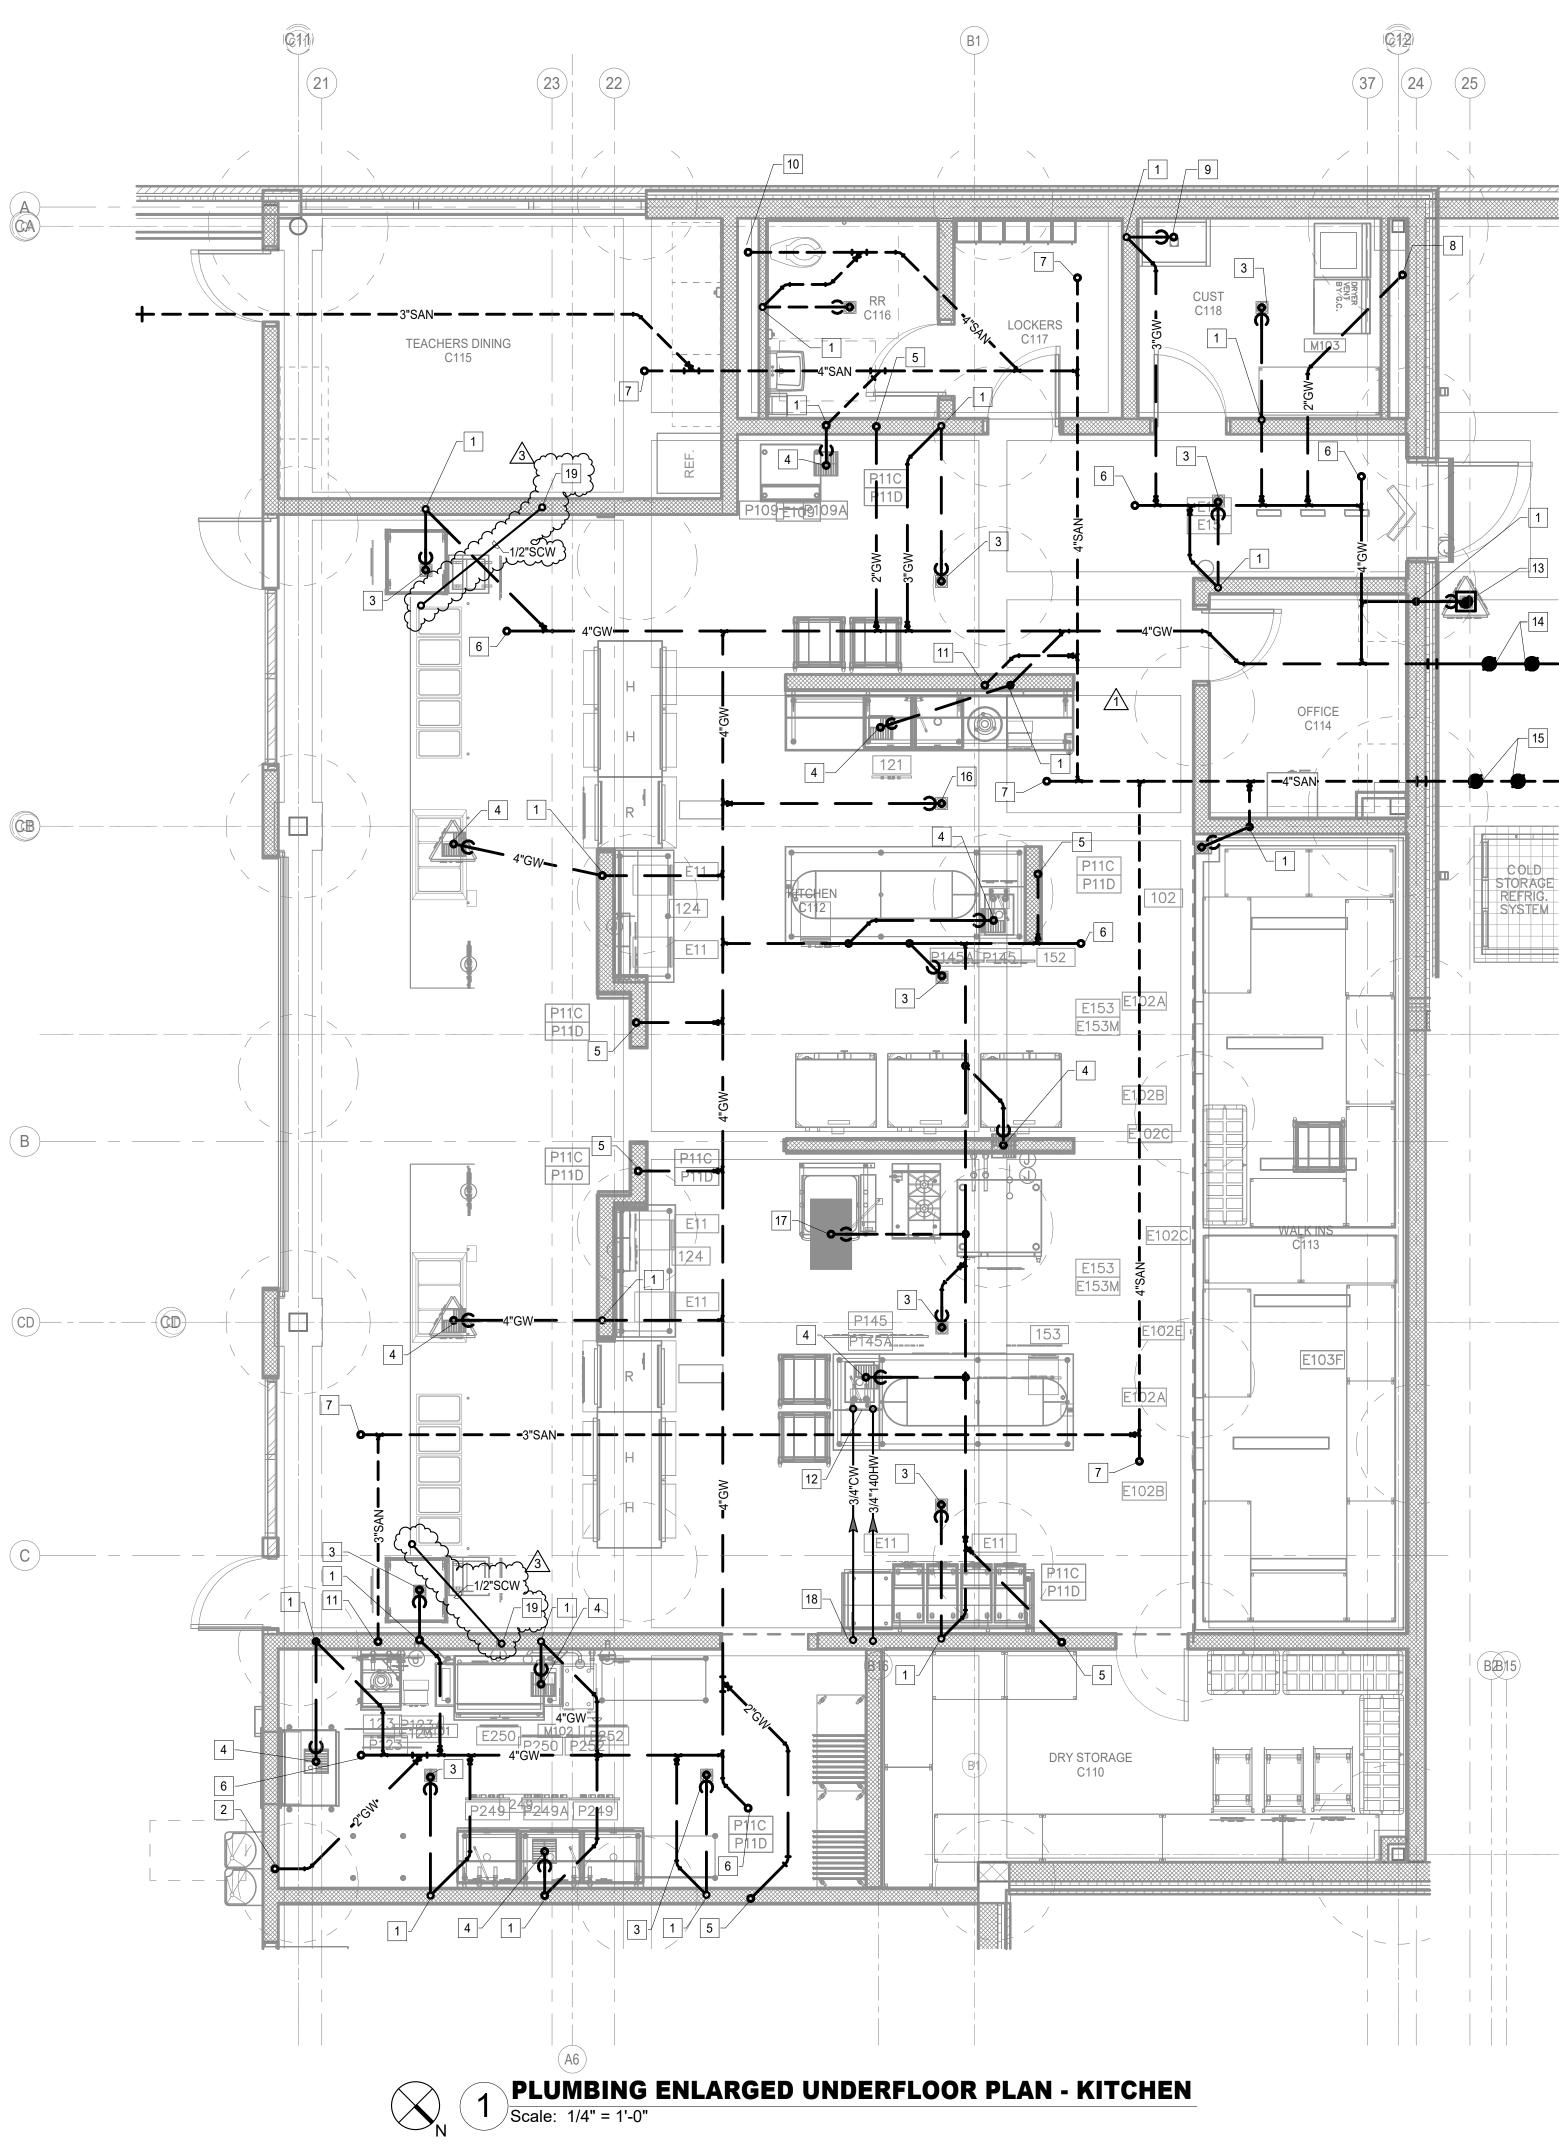


|         |           |                | REFER TO SHEET OF      | LEOR DUIN | RING COOP | DINATION NOTES   |
|---------|-----------|----------------|------------------------|-----------|-----------|--|
|         |           |                |                        |           |           |  |
| FDP PNO | FDP PSIZE | FDP PCONN      | FDP PSERVICE TO        | FDP PLOC  | FDP PAFF  | FDP PREMARKS   |
|         |           |                |                        |           |           | <varies></varies>  |
| P5      | 3/4"      | H & C WATER    | JANITOR SINK           | WALL      | 48"       | JANITOR SINK BY PLUMBER                                    |
| P6      | 4"        | FLOOR DRAIN    | JANITOR SINK           | FLOOR     | VERIFY    | JANITOR SINK BY PLUMBER                                    |
| P7      | 3/4"      | H & C WATER    | HOSE BIBB              | WALL      | 18"       | BTC  |
| P7A     | 3/4"      | H & C WATER    | FREEZE PROOF HOSE BIBB | WALL      | 48"       | BTC: PROVIDED BY DIV. 22                                   |
| P10     | VERIFY    | FLOOR DRAIN    | GENERAL AREA DRAIN     | FLOOR     | VERIFY    | LOCATE PER ENGINEER'S DRAWING                              |
| P11C    | 1/2"      | H & C WATER    | FAUCET                 | WALL      | 18"       | FURNISHED & INSTALLED BY DIV. 22                           |
| P11D    | 1 1/2"    | DIRECT DRAIN   | HAND SINK              | WALL      | 15"       | FURNISHED & INSTALLED BY DIV. 22                           |
| P12     |           | FLOOR SINK     | EQUIPMENT              | FLOOR     | 0"        | 3/4 GRATE  |
| P14     | 1/2"      | COLD WATER     | FILL FAUCET            | FLOOR     | 6"        | BTC; CAP FOR FUTURE  |
| P15     | 4"        | FLOOR DRAIN    | FUNNEL FLOOR DRAIN     | FLOOR     | 0"        | 446 ·  |
| P25A    | 3"        | FLOOR DRAIN    | CAN WASH               | FLOOR     | -1"       | LOCATE PER ENGINEER'S DRAWING                              |
| P109    | 3/4"      | COLD WATER     | WATER/ ICE             | WALL      | 60"       | BTC  |
| P109A   | 12" SQ.   | FLOOR SINK     | ICE MACHINE            | FLOOR     | 0"        | 3/4 GRATE  |
| P110    | 3/4"      | H & C WATER    | CLOTHES WASHER         | WALL      | 48"       | BTC: VALVE BOX   |
| P110A   | 2"        | INDIRECT DRAIN | CLOTHES WASHER         | WALL      | 48"       | VALVE BOX  |
| P121    | 3/4"      | H & C WATER    | FAUCET                 | WALL      | 13"       | BTC  |
| P121A   | 12" SQ.   | FLOOR SINK     | SINK                   | FLOOR     | 0"        | 3/4 GRATE  |
| P123    | 3/4"      | H & C WATER    | FAUCET / DISPOSER      | WALL      | 13"       | BTC  |
| P123A   | 2"        | DIRECT DRAIN   | DISPOSER               | WALL      | 10"       | BTC  |
| P145    | 3/4"      | H & C WATER    | FAUCET                 | FLOOR     | 10"       | BTC  |
| P145A   | 12" SQ.   | FLOOR SINK     | SINK                   | FLOOR     | 0"        | 3/4 GRATE  |
| P161    |           | NATURAL GAS    | CONVECTION OVEN        | WALL      | 18"/36"   | BTC: 60 MBTU/HR EACH                                       |
| P163    | 4"        | HUB DRAIN      | TRENCH LINER           | FLOOR     | -9"       | BTC: CRITICAL LOCATION                                     |
| P163A   | 3/4"      | NATURAL GAS    | TILT BRAISING PAN      | WALL      | 18"       | BTC: 104 MBTU/HR   |
| P163B   | 3/4"      | H & C WATER    | TILT BRAISING PAN      | WALL      | 36"       | BTC  |
| P165    | 1"        | NATURAL GAS    | RANGE                  | WALL      | 18"       | BTC: 90 MBTU/HR  |
| P165A   | 3/4"      | H & C WATER    | RANGE                  | WALL      | 18"       | BTC  |
| P172    | (2)3/4"   | COLD WATER     | COMBI OVEN             | WALL      | 24"/48"   | BTC: INTERCONNECT THRU FILTERS                             |
| P172A   | (2)3/4"   | COLD WATER     | COMBI OVEN             | WALL      | 24"/48"   | BTC  |
| P172B   | 12"SQ.    | FLOOR SINK     | EQUIPMENT              | FLOOR     | 0"        | 3/4 GRATE  |
| P172C   | (2)3/4"   | NATURAL GAS    | COMBI OVEN             | WALL      | 18"/36"   | BTC: 105 MBTU/HR EACH                                      |
| P249    | 3/4"      | H & C WATER    | FAUCET                 | WALL      | 13"       | BTC  |
| P249A   | 12" SQ.   | FLOOR SINK     | SINK                   | FLOOR     | 0"        | THREE QUARTER GRATE  |
| P250    | 12" SQ.   | FLOOR SINK     | BOOSTER / DISHMACHINE  | FLOOR     | 0"        | BTC  |
| P252    | 3/4"      | HOT WATER      | BOOSTER HEATER         | WALL      | 18"       | EXT. THRU W.FILTER TO BOOSTER / DISH MACHINE - 140DEG.MIN. |


-CA.9


CC

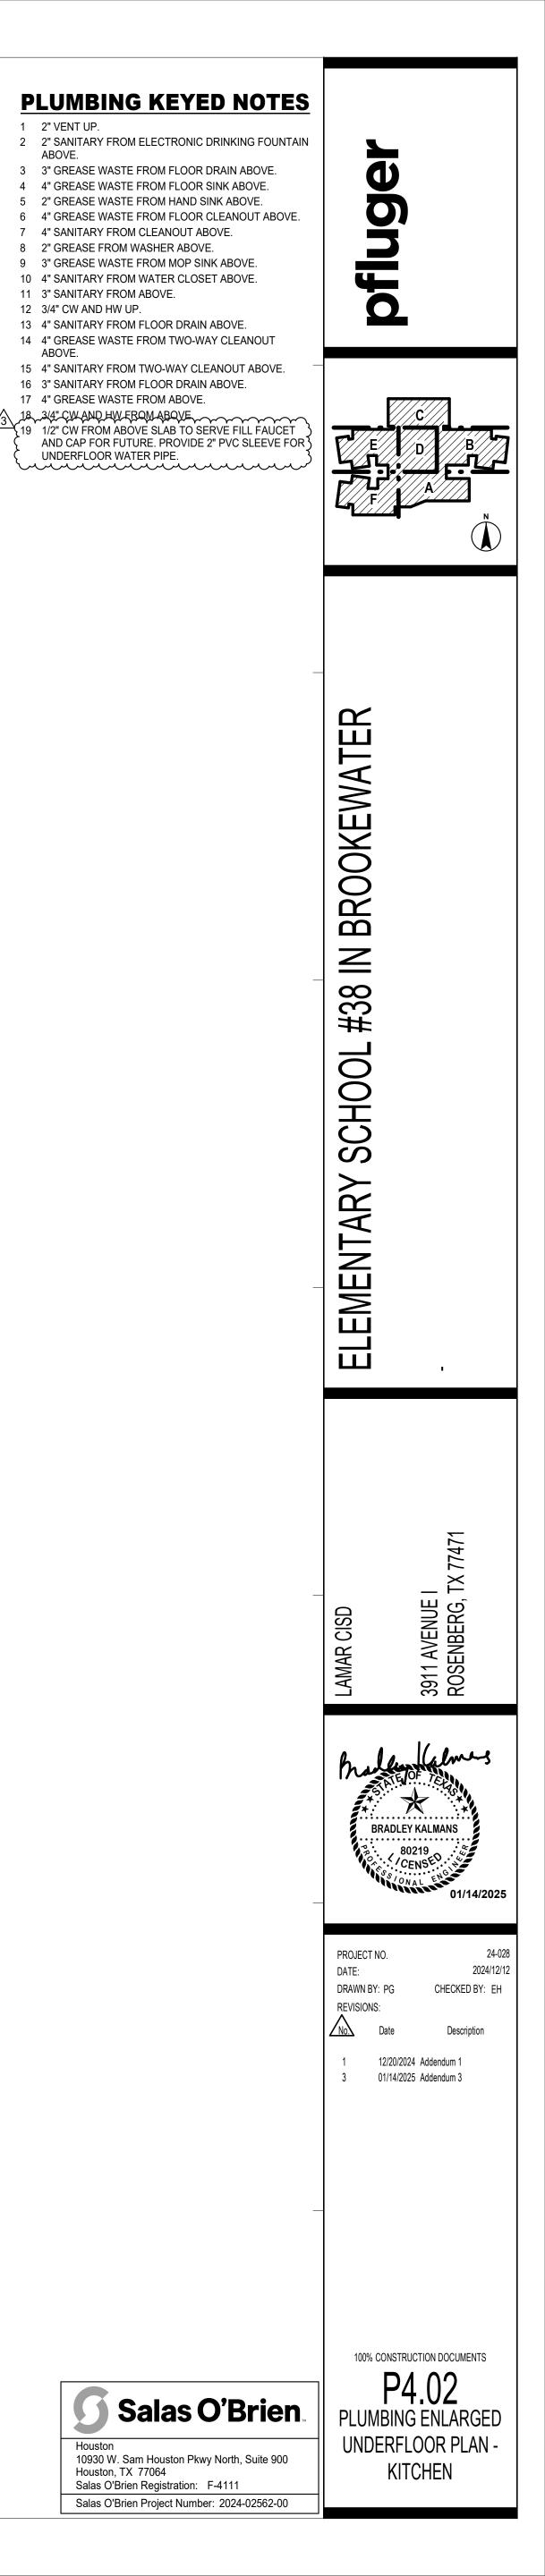


OF

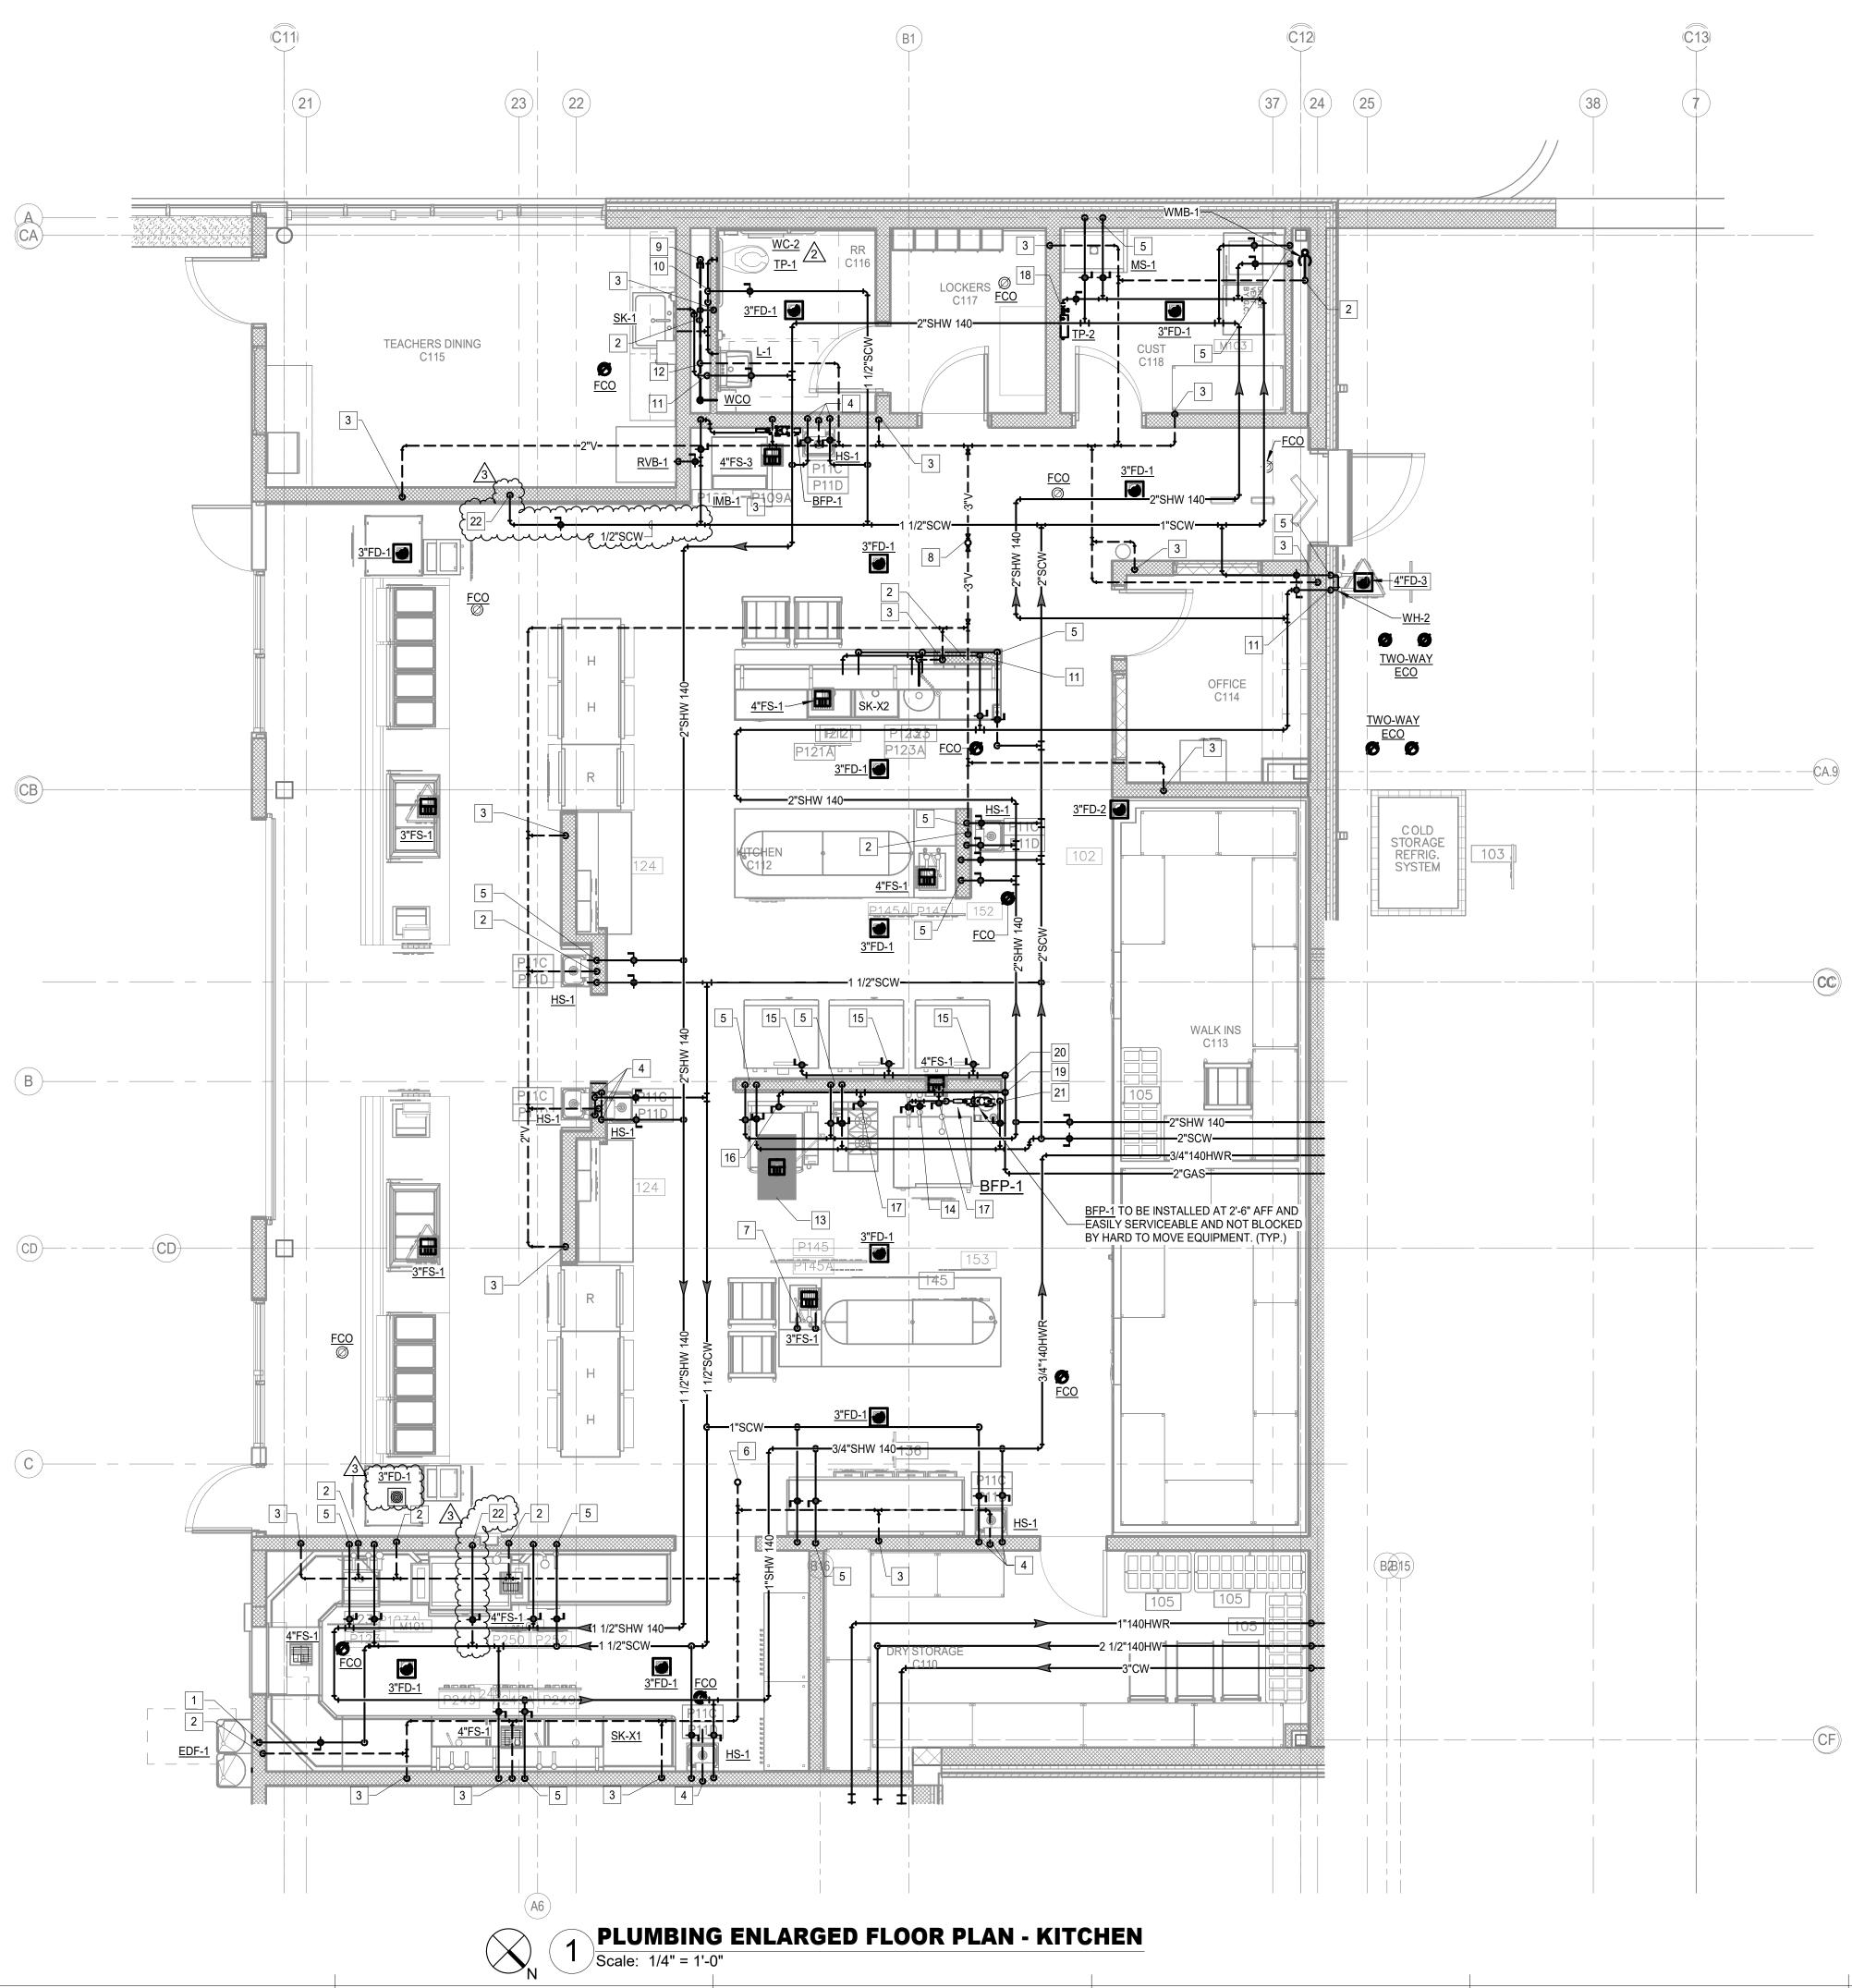


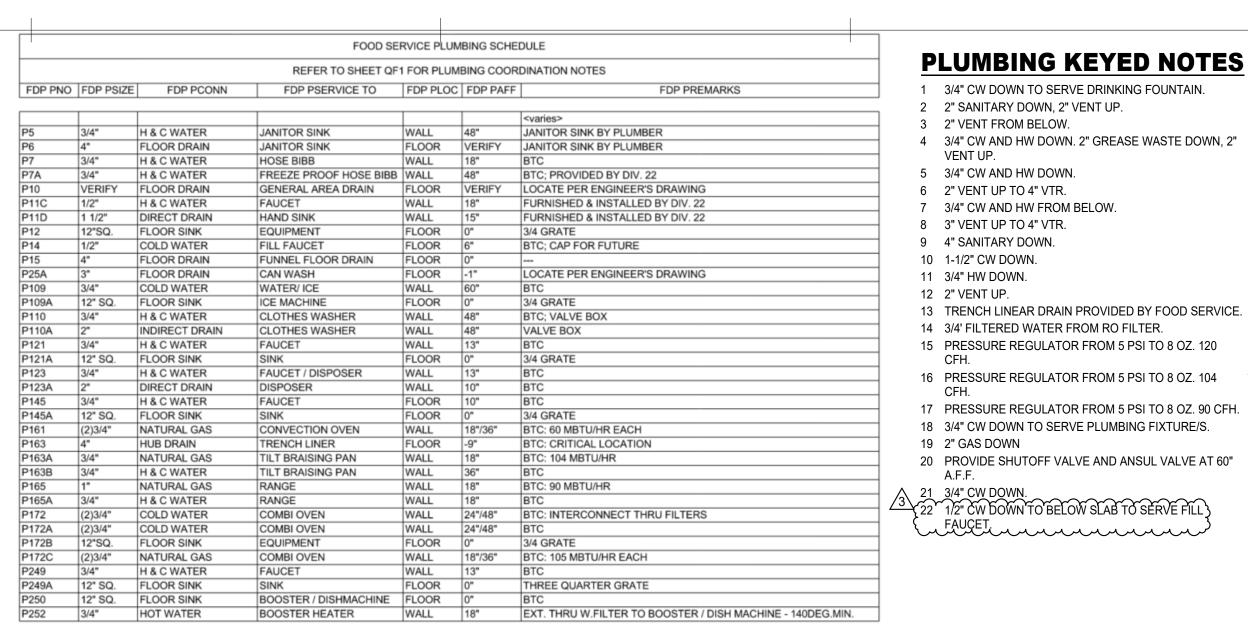


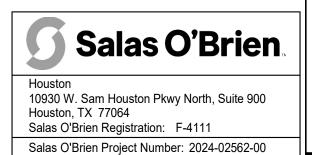





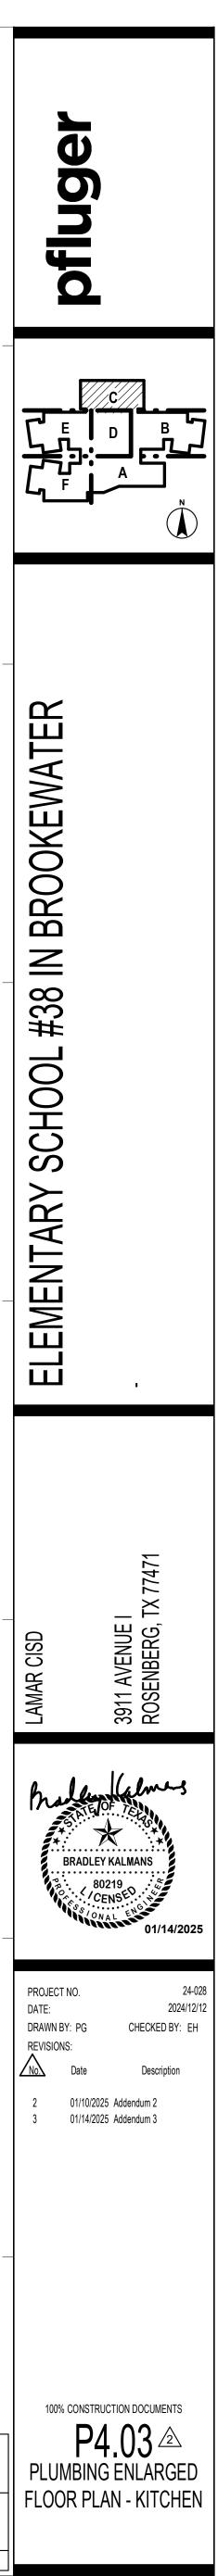


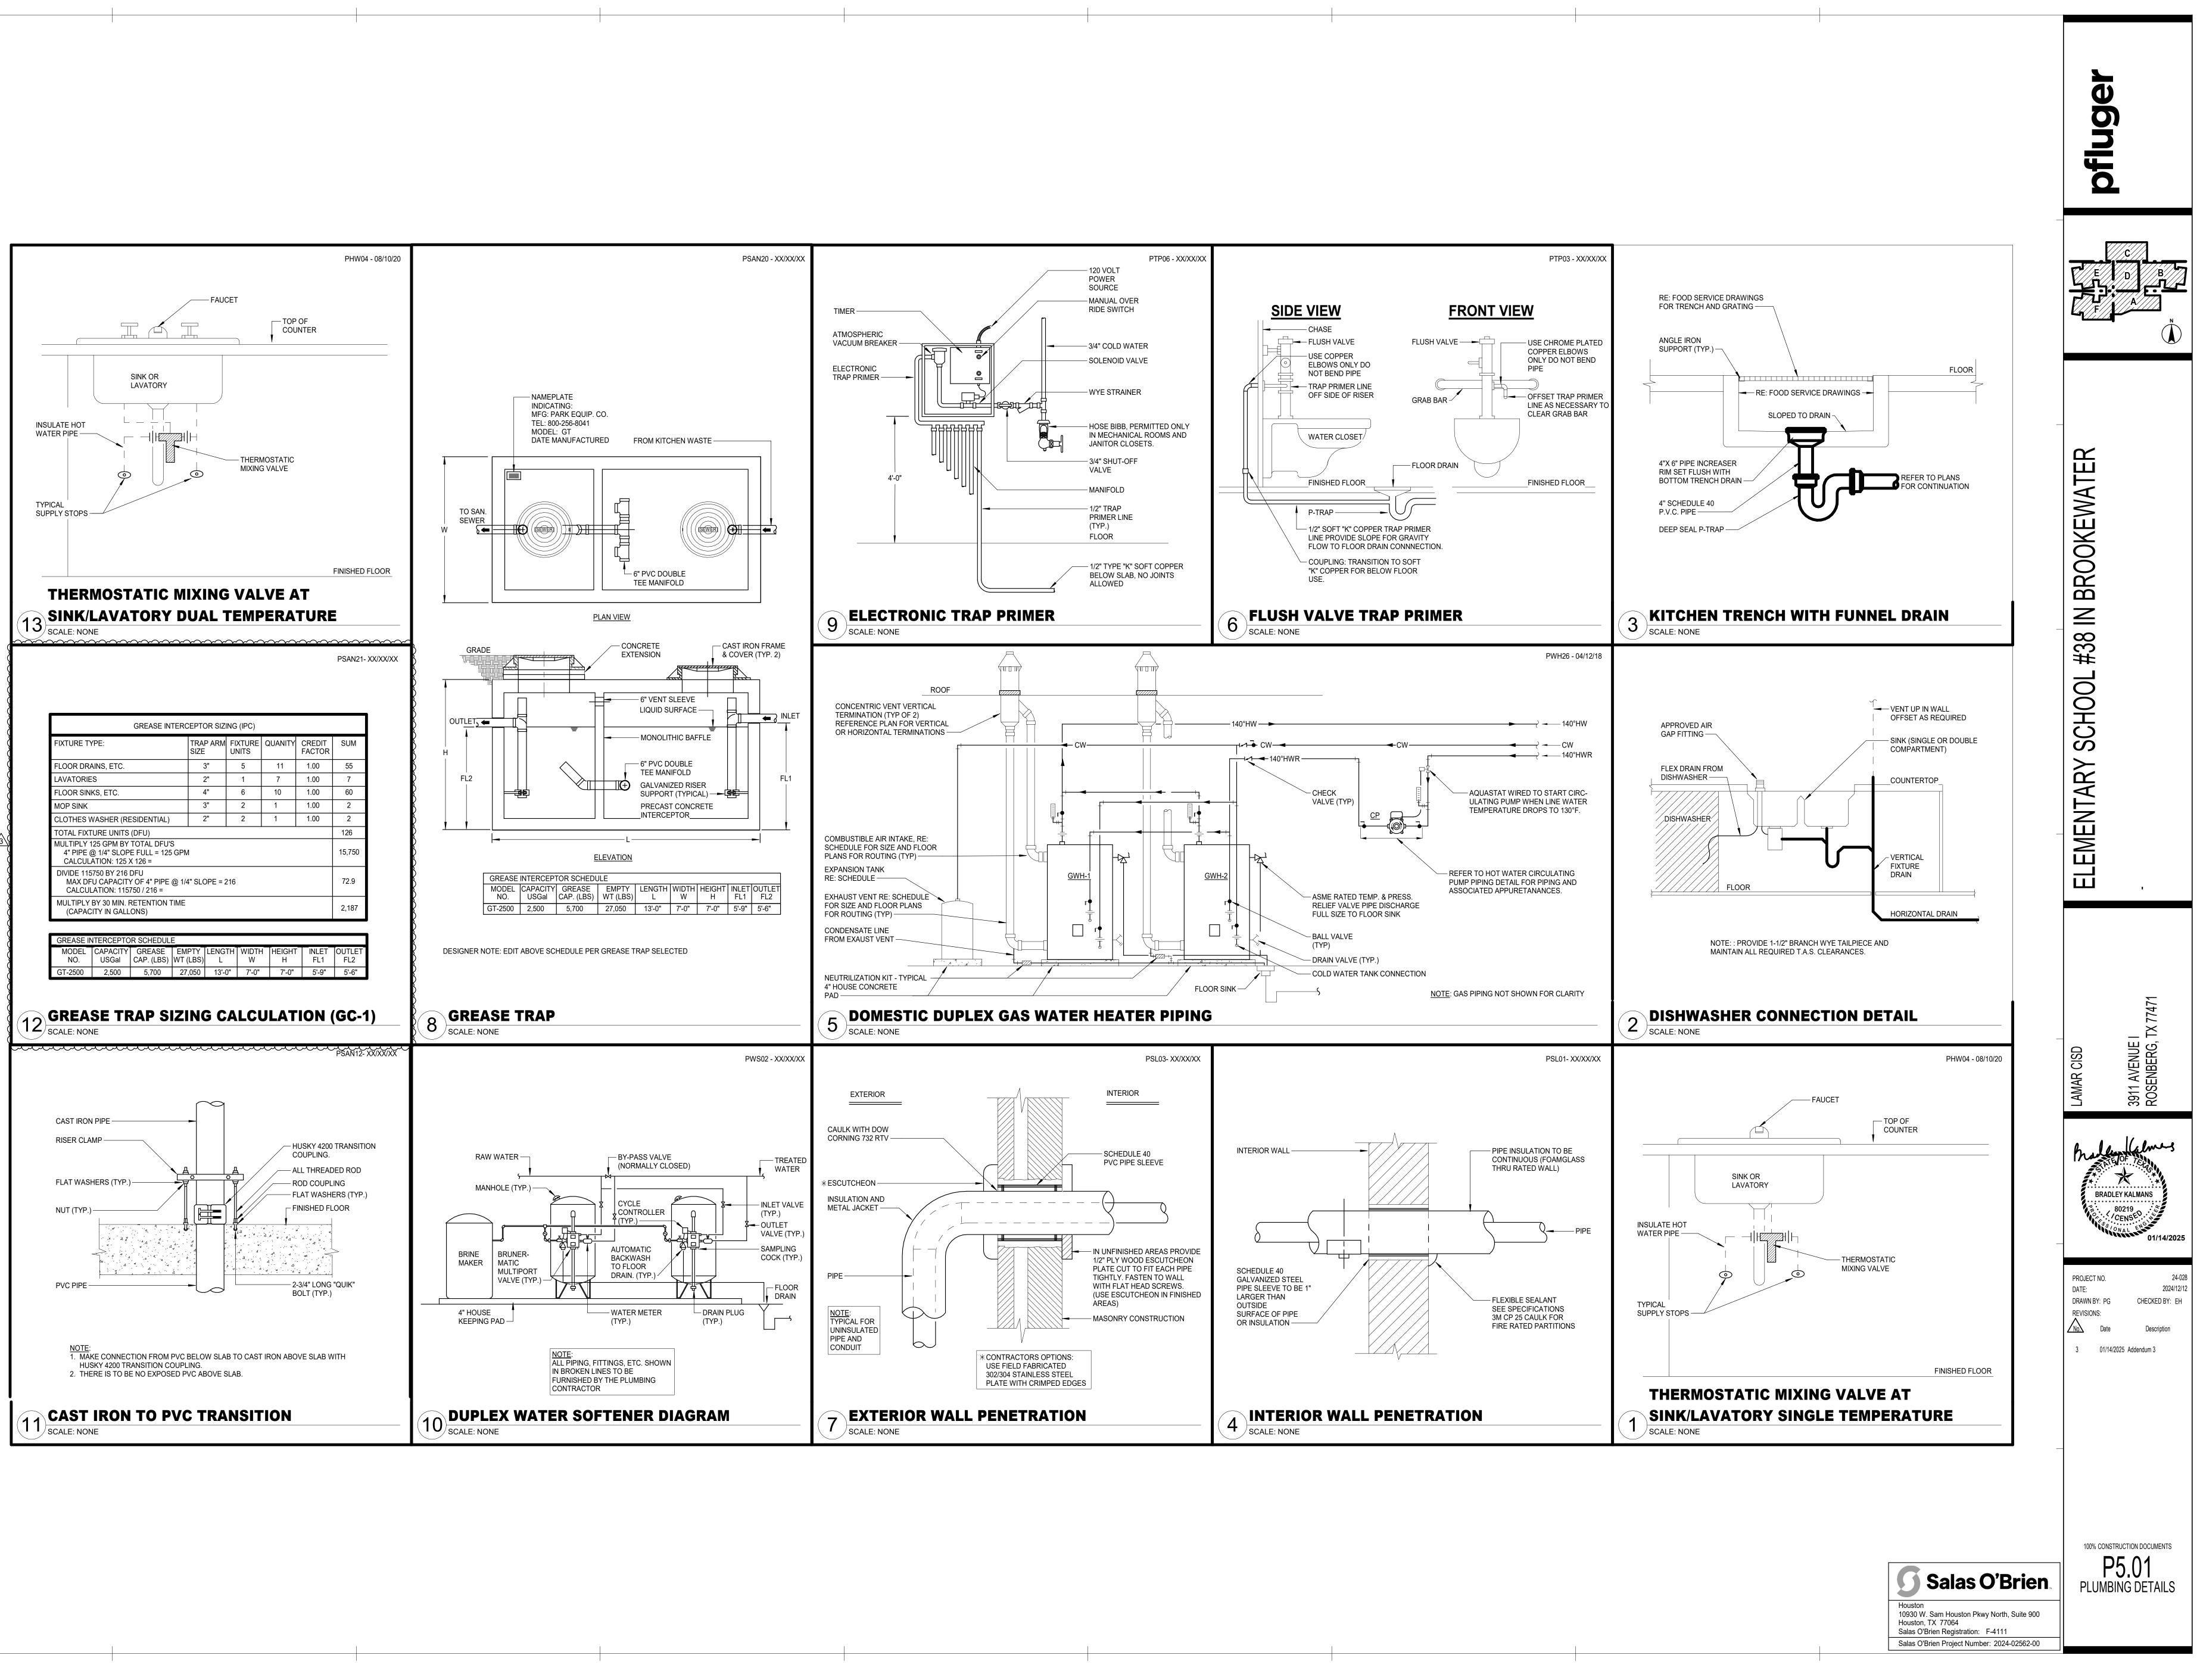


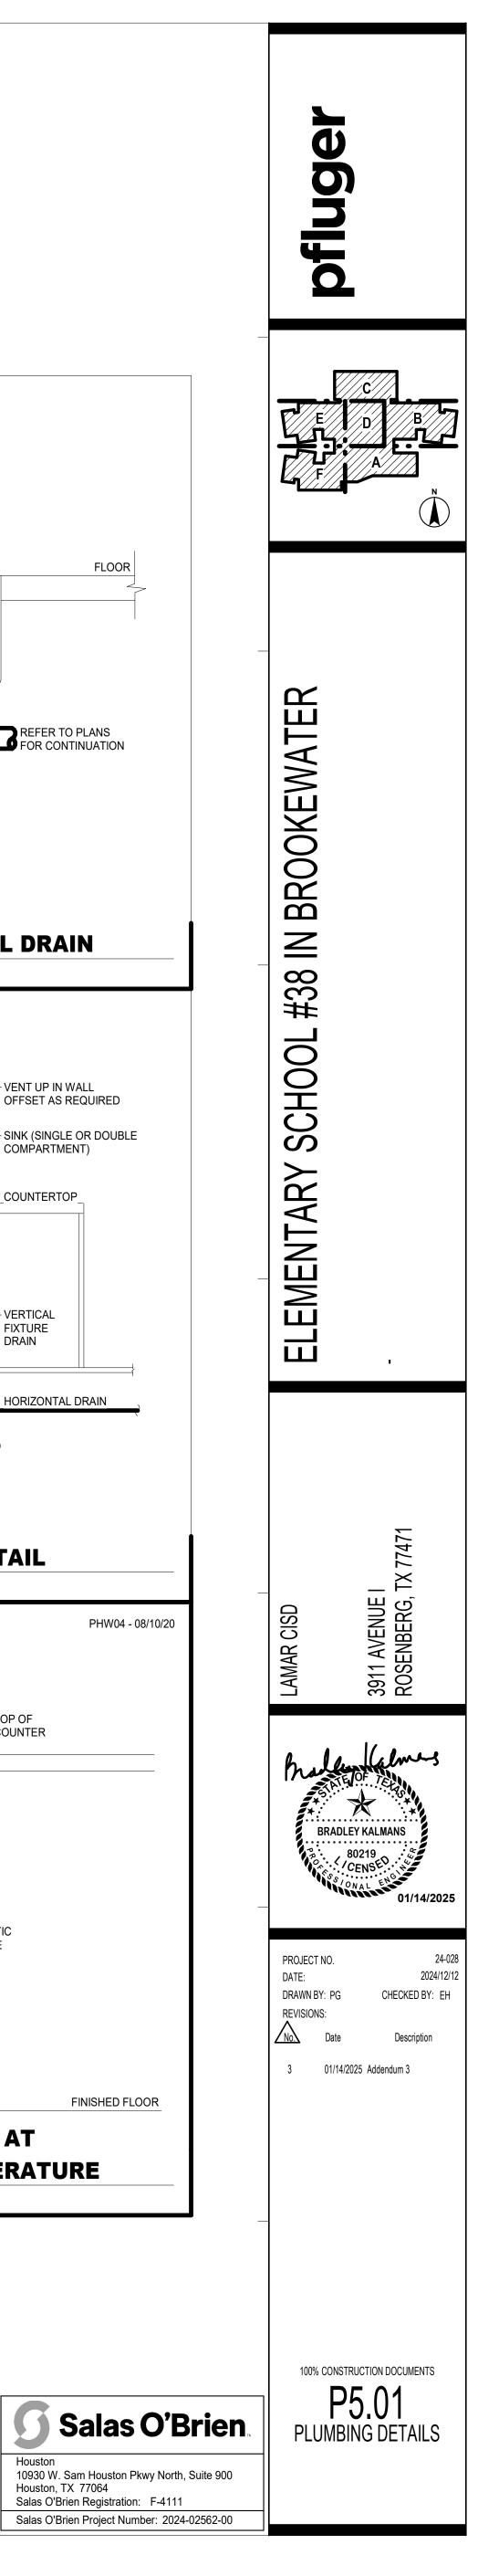

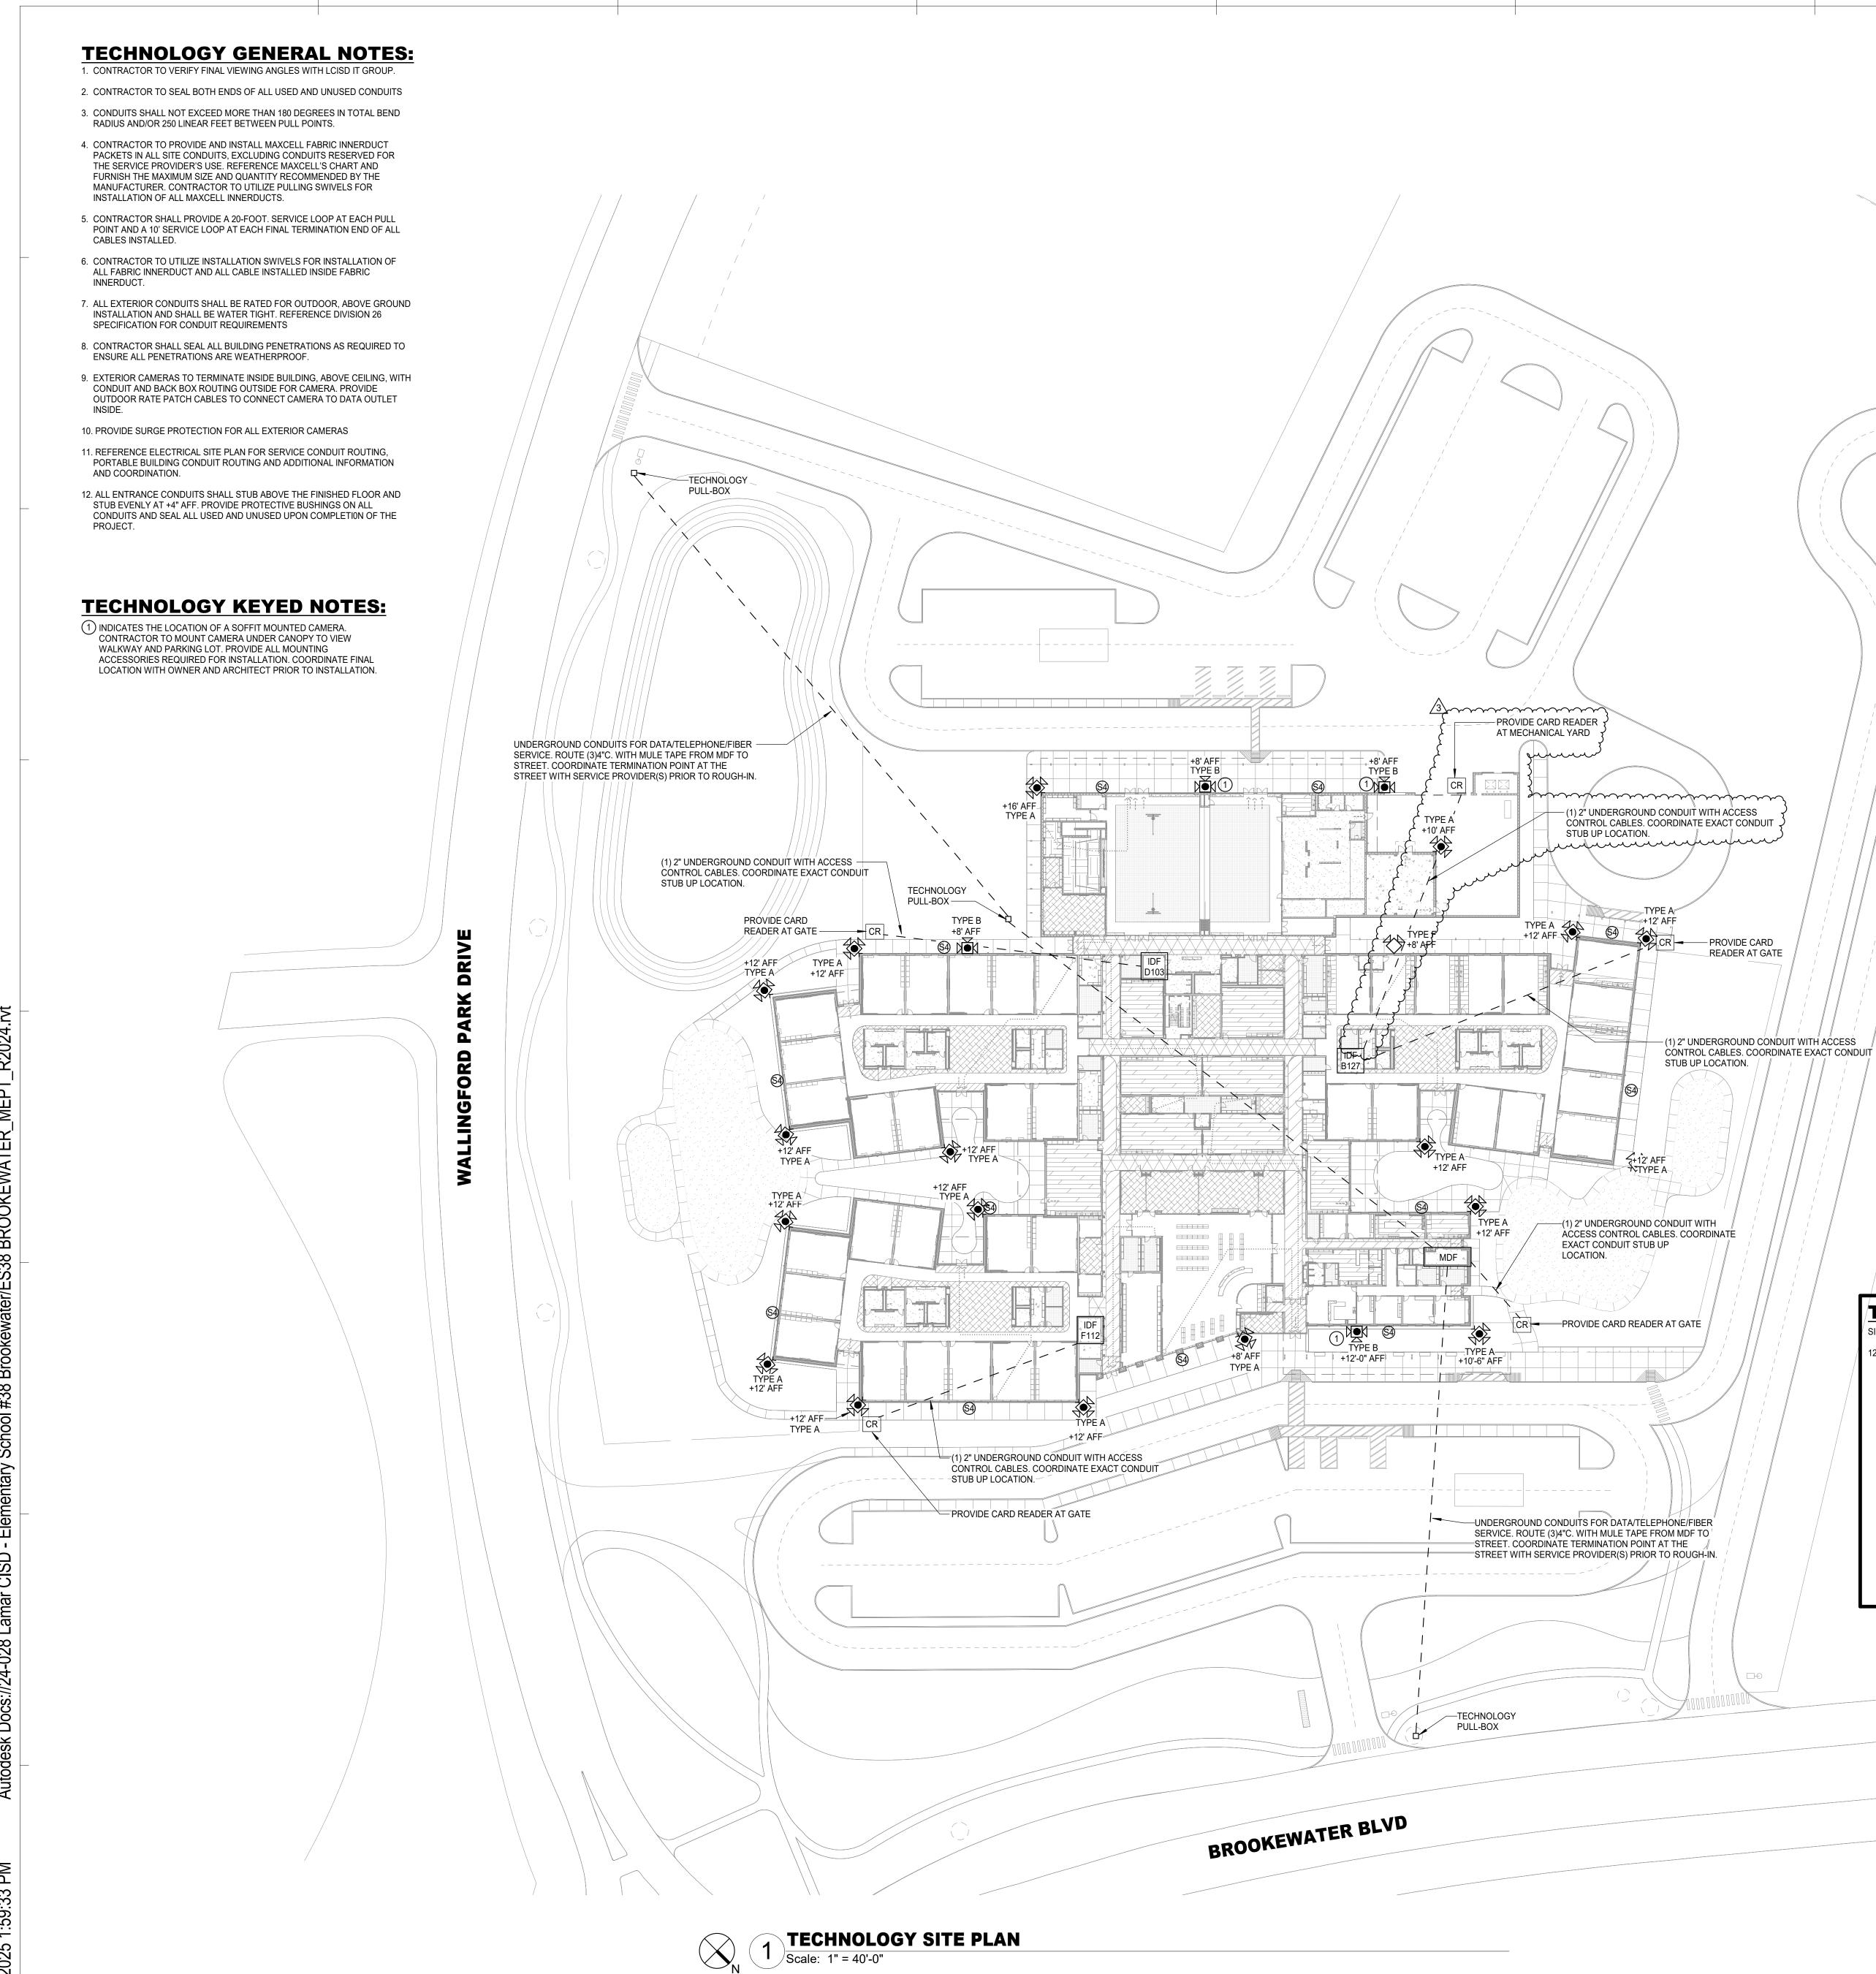


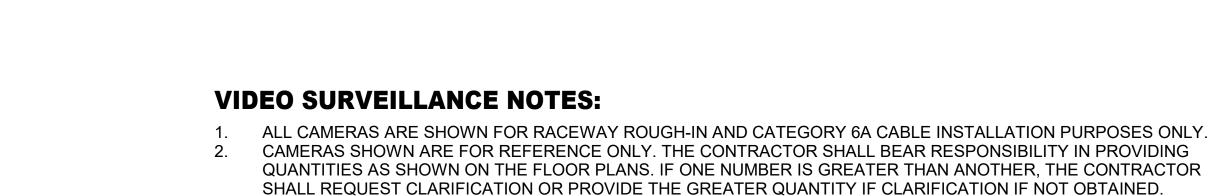

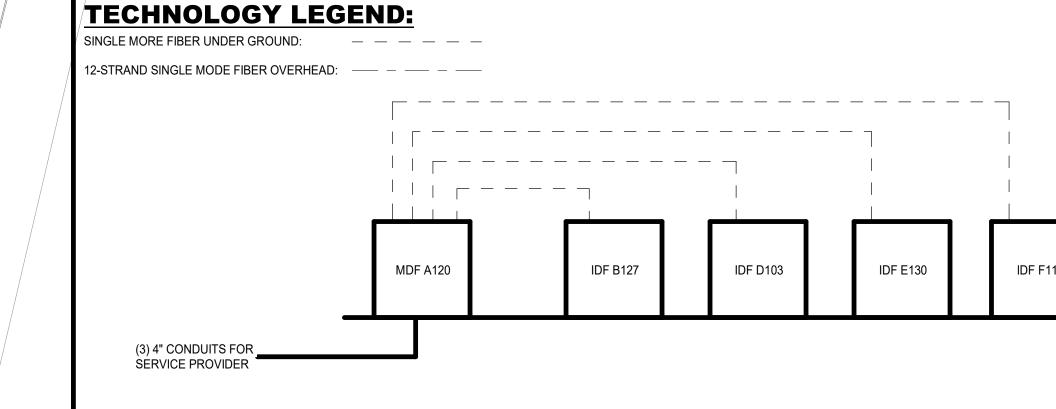

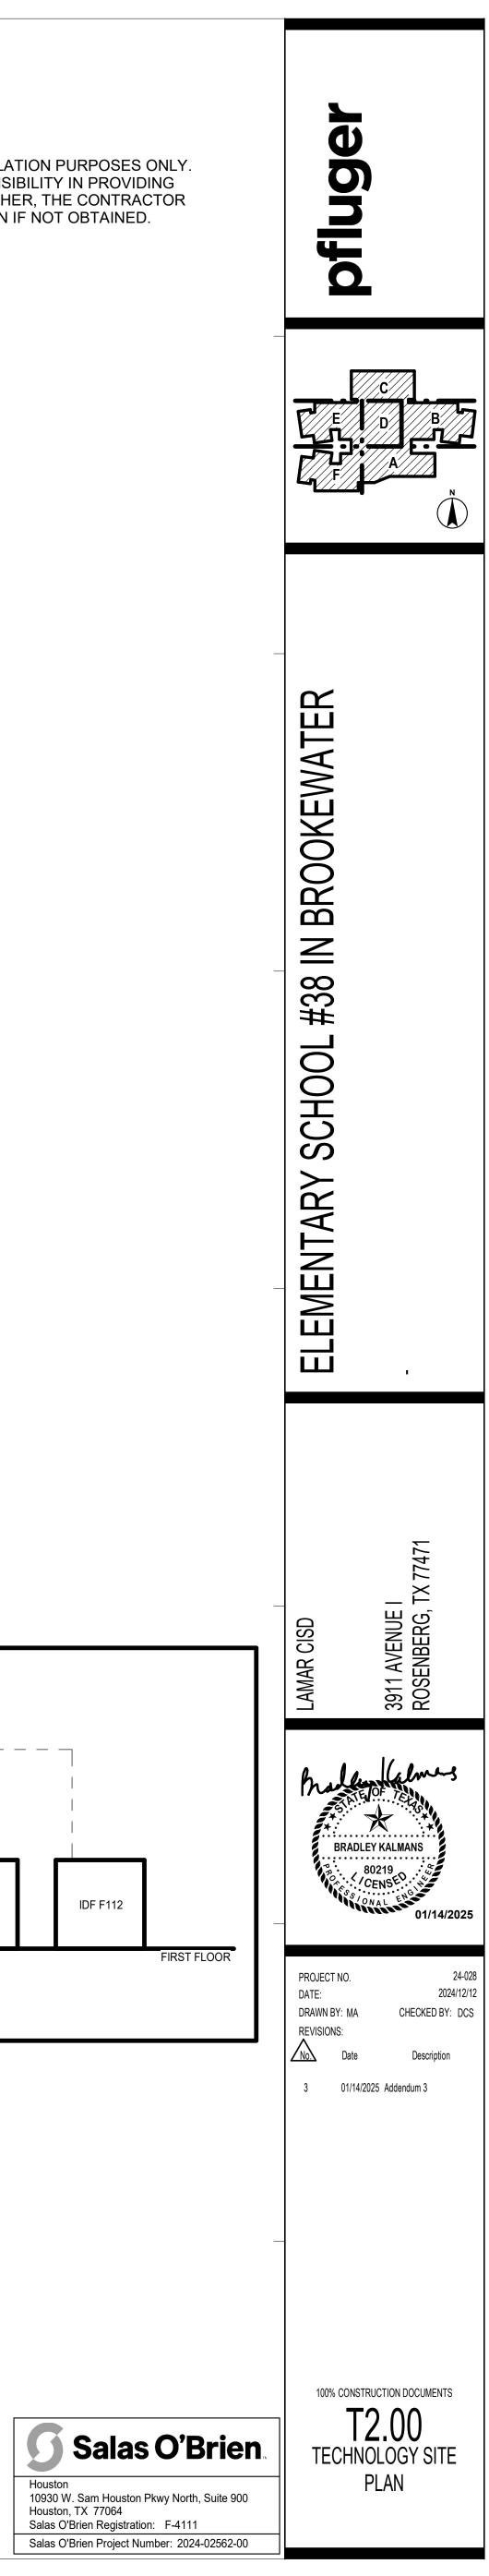

(EA)-+10'-0" AFF (TYP.) (DA)-(BD)-BE (BF)-----(DB)-TYPE B +10'-0" AFF (AB)-\_ \_ \_

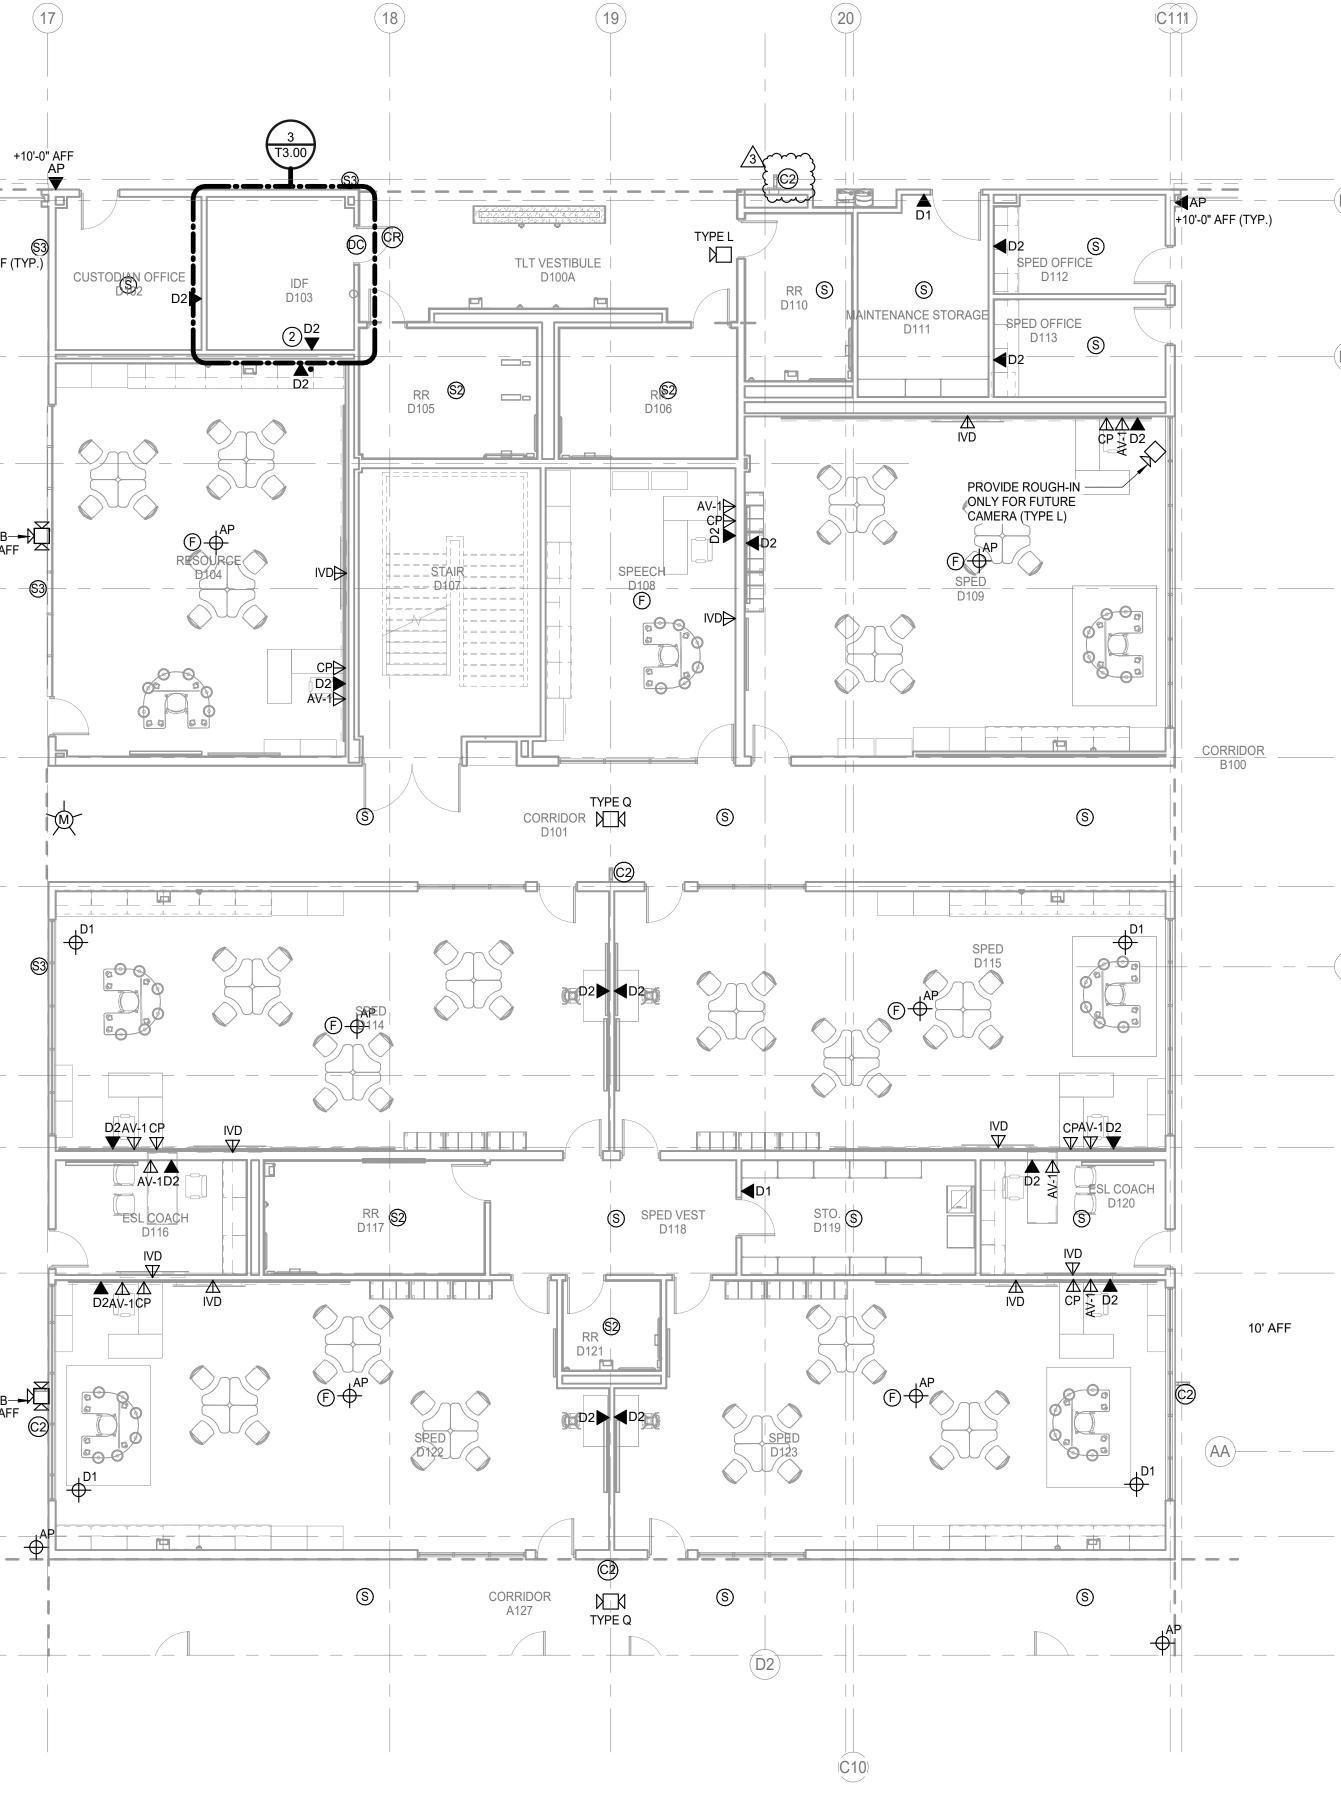

N TECHNOLOGY 01 FLOOR PLAN - AREA D Scale: 1/8" = 1'-0"

# **TECHNOLOGY GENERAL NOTES:** 1. CONTRACTOR TO ROUTE DATA ON THIS SHEET TO IDF ROOM D103.

# **TECHNOLOGY KEYED NOTES:** 1 COORDINATE BAS DATA OUTLET LOCATION WITH ELECTRICAL CONTRACTOR.


<sup>(2)</sup> COORDINATE ACCESS CONTROL PANEL DATA OUTLET WITH SECURITY CONTRACTOR.


|                | <u>CORRIDOR</u><br>B100 |    |  |  |
|----------------|-------------------------|----|--|--|
|                |                         |    |  |  |
| 00<br>00<br>00 | (I                      | BJ |  |  |
|                |                         |    |  |  |
|                | 10' AFF                 |    |  |  |

—(BA)


BB

**Salas O'Brien** 

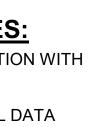


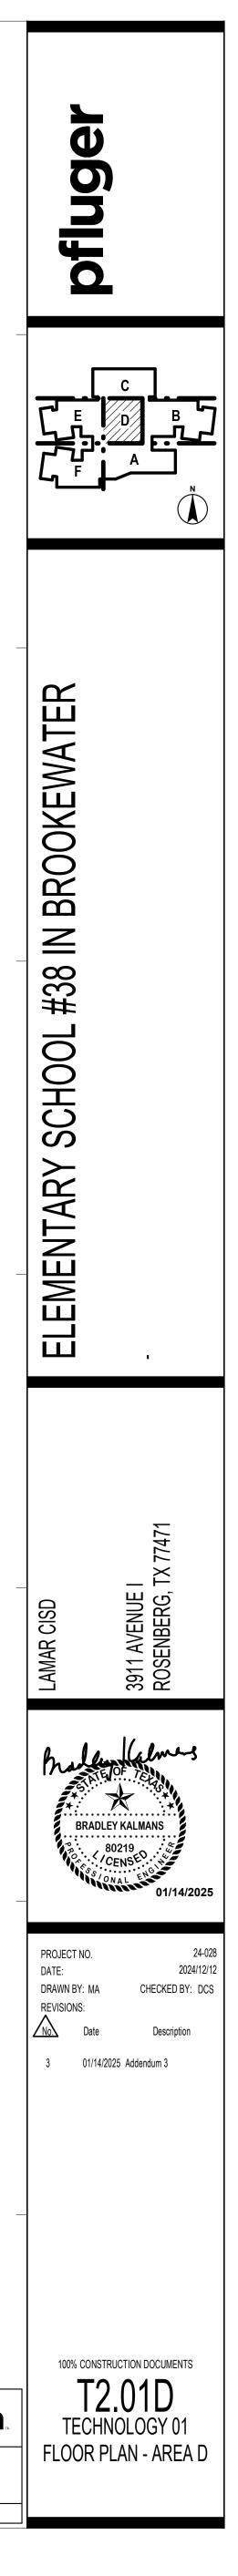


Houston 10930 W. Sam Houston Pkwy North, Suite 900 Houston, TX 77064 Salas O'Brien Registration: F-4111 Salas O'Brien Project Number: 2024-02562-00

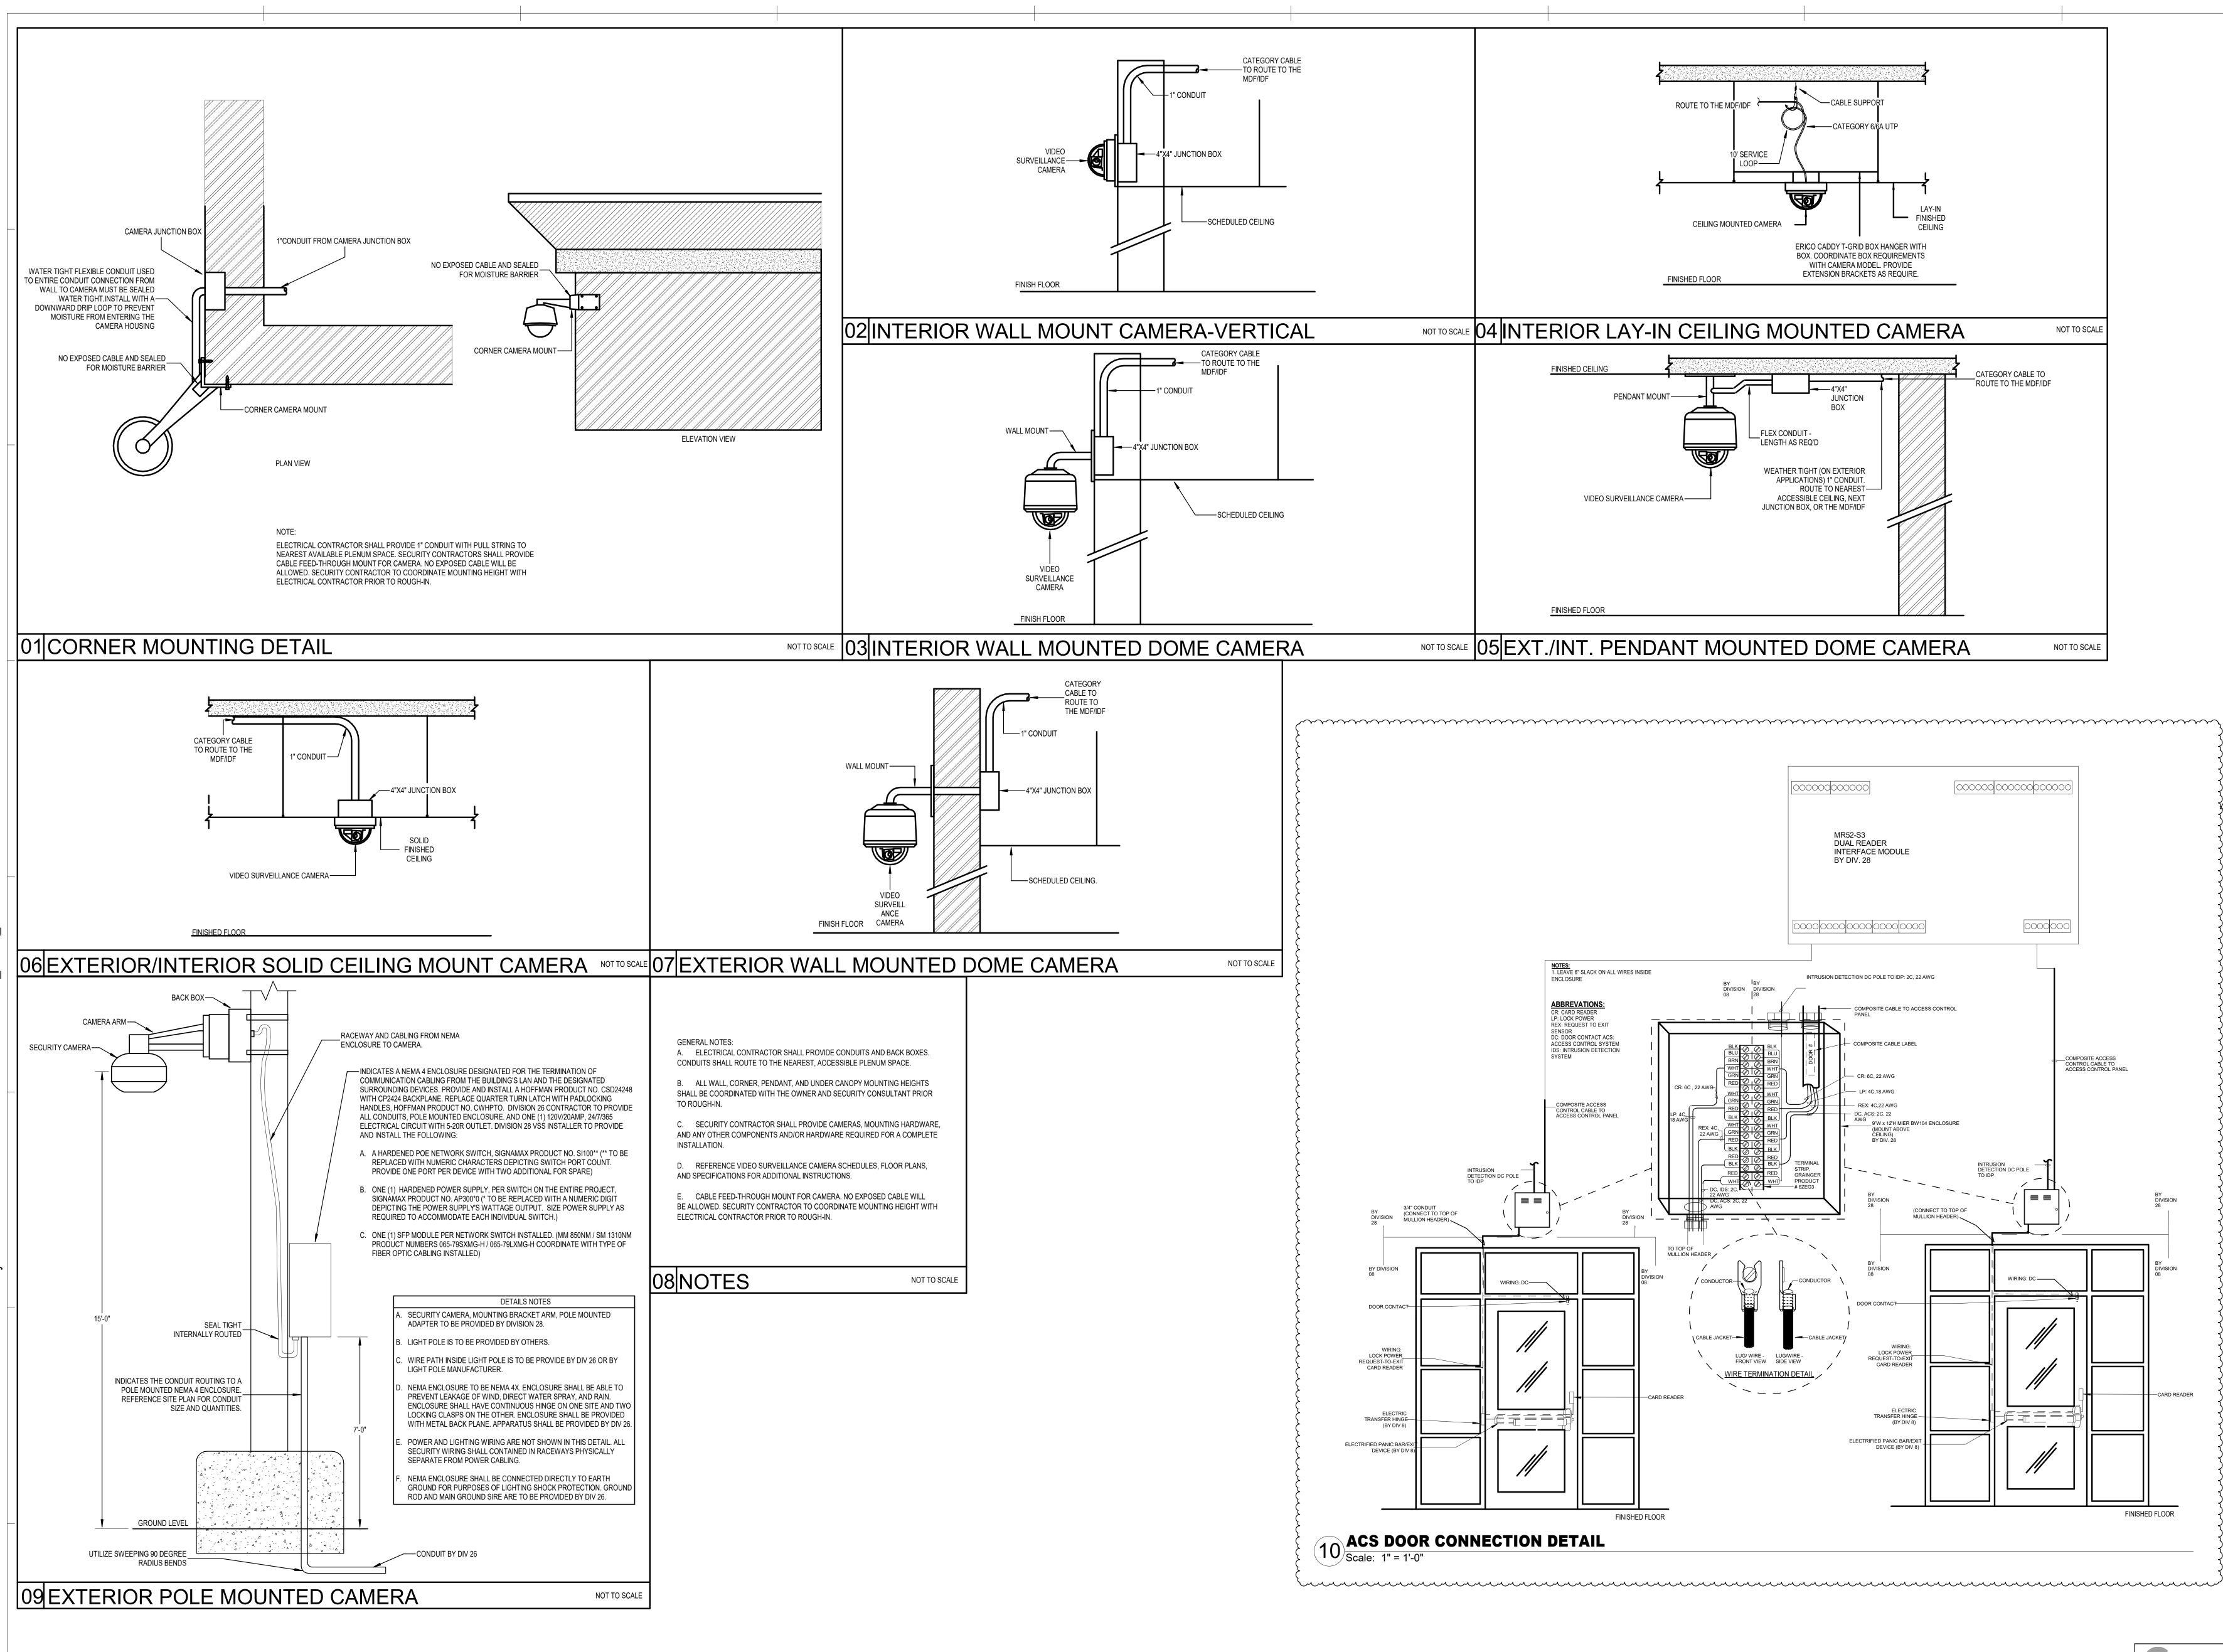

 $\mathbf{O}$ 

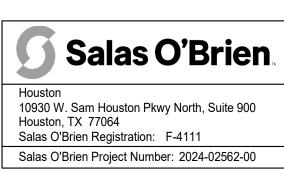

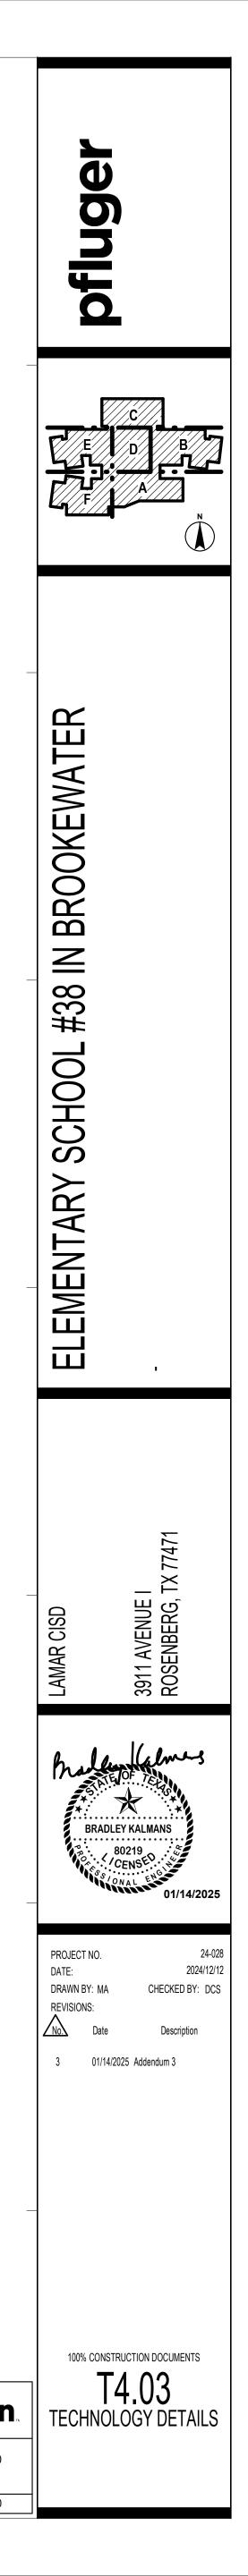

#### Project Number: 24-028 Project Name: New Elementary School #38 Owner: Lamar Consolidated ISD Date: 1/14/2025

#### Date SHEET / Date OUT for Date RFI NO. CONTRACTOR / SUBCONTRACTOR QUESTION DISCIPLINE RESPONSE Date Received RECEIVED SPEC. NO. RETURNED Review he date to turn in the qualifications package is Sunday January 12. Gamma Construction 01 12/20/2024 05 12 00 Is that going to be changed to the Friday or Monday after January Architectural Please refer to Addendum #1 12/20/2024 Section 012300 Alternates only list an alternate to change the date 12/20/2024 Gamma Construction 01 23 00 of substantial completion to 6/8 and the bid form list two different Architectural Please refer to Addendum #1 12/20/2024 02 alternates. Please clarify. Section 012100 Allowances list for the owner's contingency 03 12/20/2024 Gamma Construction 01 21 00 (\$400.000) allowance is different than the bid form (\$350.000). Architectural Please refer to Addendum #1 12/20/2024 Please clarify. The Geotechnical Report was included in the 12/20/2024 Gamma Construction Architectural 100% Contract Documents specifications issued 12/20/2024 04 Please provide the geo-tech report. for the proposal. Lamar CISD generally does not provide this information. Please refer to the standard 2017 12/20/2024 Gamma Construction Please provide a copy of the owner's contract AIA A101 and A201. 1/10/2025 05 Architectural version of A201. AIA 101 will be issued once the contract is awarded. Does Lamar CISD want a wet signature on only the Price Delivery Please ensure that all forms submitted on bid day 12/23/2024 Satterfield & Pontikes Construction, Inc. Information – CSP Form (bid form) or on all of the forms turned in on Architectural 1/10/2025 06 include a wet signature. bid dav? Refer to Sheet C4.00. Please clarify if the clouded sidewalk below is Plans have been revised to exclude the clouded Satterfield & Pontikes Construction, Inc. 07 12/24/2024 C4 00 to be part of the project as its past the Civil sidewalk from the project. Please refer to 1/10/2025 property line. Addendum #2. The BIM model will be provided to the general 08 12/24/2024 Satterfield & Pontikes Construction, Inc. Can we have access to the BIM Model? Architectural contractor who is awarded the project after they 1/10/2025 have signed the BIM model release form. Refer to sheet A1.00.Please clarify if there is a pole mounted sign in the median at the plan SW Driveway. Please refer to Addendum #2 for clarifications 12/24/2024 Satterfield & Pontikes Construction, Inc. A1.00 Architectural 1/10/2025 09 There looks to be one there but there is no callout. Below is a regarding site signage. screenshot with the sign in guestion clouded. Qualification (A305) and references are due on 1/12/2025 which is a Please refer to Addendum #1 for additional 12/30/2024 10 Sterling Structures, Inc. Architectural 1/10/2025 Sunday. Please advise if we can submit it on Monday January 13th. information For clarification on the lift path, please refer to Miscellaneous specifications include a barrier free lift, but I could not 12/30/2024 Sterling Structures, Inc. Architectural Addendum #2. The lift is shown on sheet 1/10/2025 11 find a lavout for the Barrier free lift. Please advise. A10.01D. Please confirm if the building permit is in the City of Rosenberg 12/30/2024 Architectural 1/10/2025 12 Sterling Structures, Inc. Fort Bend County. Jurisdiction or Fort Bend County. Please provide more clarification with regards to Allowance #2 -13 12/30/2024 Satterfield & Pontikes Construction, Inc. Network Equipment & Phone Allowance. Does this also include the MEP/T No, IP PA is part of the front row 1/10/2025 entire IP PA System? Refer to Sheet C9.00. Please clarify if a Stabilized Construction Stabilized construction entrance and concrete Entrance and Concrete Truck Washout will be truck washout areas have been added along the 14 12/30/2024 Satterfield & Pontikes Construction, Inc. Civil 1/10/2025 required as these items are currently not shown and they are usually future Brookewater Blvd and Wallingford Park required. Drive. Refer to Addendum #2. The display case detailed on page A9.30 states to reference the The display cases will be custom-built on-site. specifications for the Basis of Design. There is not a specification in 12/30/2024 Satterfield & Pontikes Construction, Inc. Architectural eliminating the need for a Basis of Design. This 1/10/2025 15 the Project Manual. Please provide the specifications or clarify the note has been revised in Addendum #2 Basis of Design. Please clarify if there is to be surfacing on the track. The detail on Sheet C15.00 shows a 0.5" Thick Walkway Surfacing but then has The track will be constructed of concrete us reference A1.03. Detail 12 on A1.03 only shows Concrete 12/30/2024 Satterfield & Pontikes Construction, Inc. Civil according to Lamar CISD standards. Please refer 1/10/2025 16 Sidewalk with with continuous painted lines. If there is to be track to the updated Civil Detail in Addendum #2. surfacing please provide more information and a specification

### pfluger

# pfluger

Project Number: 24-028 Project Name: New Elementary School #38 Owner: Lamar Consolidated ISD Date: 1/14/2025

| RFI NO. | Date<br>RECEIVED | CONTRACTOR / SUBCONTRACTOR                | SHEET /<br>SPEC. NO. | QUESTION   | DISCIPLINE    | RESPONSE  | Date OUT for<br>Review | Date Received | Date<br>RETURNED |
|---------|------------------|---|----------------------|--|---------------|---|------------------------|---------------|------------------|
| 17      | 12/30/2024       | Satterfield & Pontikes Construction, Inc. |                      | Refer to sheet A1.05. Please clarify who is to provide and install the<br>Electronic Message Board at the monument sign. Please provide a<br>specification if it will be the responibility of the contractor.  | Architectural | The electronic message board is part of the<br>contractor's scope. Specifications will be issued<br>in Addendum #2. |                        |               | 1/10/2025        |
| 18      | 1/3/2025         | Sterling Structures, Inc.                 |                      | There are alternates listed for the road and utilities, but no details<br>are provided. Will you issue revised civil drawings for the alternate<br>scope? There are multiple trades that will be affected by the<br>alternate and will help if drawings are issued for the alternates.   | Civil         | Asphalt pavement section is provided in sheet<br>C14.01 PAVING DETAILS 1  |                        |               | 1/10/2025        |
| 19      | 1/3/2025         | Sterling Structures, Inc.                 |                      | Can we turn in the alternates and unit prices @ 03:00 p.m.?  | Architectural | No, alternates and the base bid should be<br>submitted simultaneously, according to the bid<br>instructions.        |                        |               | 1/10/2025        |
| 20      | 1/7/2025         | Satterfield & Pontikes Construction, Inc. |                      | Refer to sheet A1.05. Please clarify if the Electronic message board<br>is to either be single or double sided. The<br>elevations (5 & 8/A1.05) look to show it as double sided while 1 &<br>7/A1.05 show it to be single sided.   | Architectural | The electronic message board is double-sided.<br>Please refer to Addendum #2 for more<br>information.               |                        |               | 1/10/2025        |
| 21      | 1/7/2025         | Satterfield & Pontikes Construction, Inc. |                      | Refer to sheet A2.01A. The Wall Section Callout Tag at Art A126 appears to be incorrect. Please clarify.   | Architectural | Clarification needed to answer question   |                        |               | 1/10/2025        |
| 22      | 1/7/2025         | Satterfield & Pontikes Construction, Inc. |                      | Ref. 9/A7.20. Please issue Specification for the Wood Flooring at the<br>Stage.  | Architectural | The specification was issued at 100% according to CDS Spec Section 09 64 55.  |                        |               | 1/10/2025        |
| 23      | 1/7/2025         | Satterfield & Pontikes Construction, Inc. |                      | With regards to the reserved parking signs, please clarify which<br>detail we are to go by. 1/A1.04 or what is<br>shown on C15.00?   | Architectural | Please refer to Detail 1/A1.04 in the architectural drawings and see Addendum #2 for additional information.        |                        |               | 1/10/2025        |
| 24      | 1/7/2025         | Drymalla                                  |                      | Are TA-3 Toilet Tissue Dispenses OFCI, or CFCI? 1.2 Summary has<br>them as OFCI, but 2.2 Accessories Schedule has them as CFCI   | Architectural | 10 28 00 Modified, Please refer to Addendum #2 for further information.   |                        |               | 1/10/2025        |
| 25      | 1/7/2025         | Drymalla                                  |                      | Accessories Schedule, M. Waste Receptacles. Are these required<br>on this project? Specs call for them at every OFCI Towel Dispenser<br>that is not located over a base cabinet, however none are shown on<br>plans, and they are not listed on the plan toilet acc schedule?<br>Furthermore if they are required do we need to quote them at the<br>Kitchen sinks where the towel dispenser is mounting above the sink? | Architectural | Waste Receptacles are N.I.C.  |                        |               | 1/10/2025        |
| 26      | 1/7/2025         | Sterling Structures, Inc.                 |                      | There are specifications for bike racks but none shown on the plans. Please advise.  | Architectural | Please see Addendum #2 for the specific<br>location.  |                        |               | 1/10/2025        |
| 27      | 1/7/2025         | Sterling Structures, Inc.                 |                      | Detail 5 on sheet A7.21 calls out for fire treated plywood and exterior<br>plywood. Please advise which is to be used. See attached.   | Architectural | Please refer to Addendum #2 for further information.  |                        |               | 1/10/2025        |
| 28      | 1/7/2025         | Gamma Construction                        |                      | There is a Metal Storage Shelving spec and drawings show boxes<br>that could be metal shelving in several rooms. These boxes are not<br>marked and could be shelving or millwork. Can Pfluger clarify?   | Architectural | Please refer to Addendum #2 for further information.  |                        |               | 1/10/2025        |
| 29      | 1/7/2025         | Gamma Construction                        |                      | The shutter in the warewash is duplicated in 114000 in item 254.<br>We would exclude this  | Food Service  | Correct.  |                        |               | 1/10/2025        |
| 30      | 1/7/2025         | Gamma Construction                        |                      | The door elevations on A800 have the type K units as solid doors,<br>but the specs call for open air grilles. Typically LCISD uses grilles<br>in the hallway and solid doors at the kitchen. Want to confirm what<br>they want here?   | Architectural | Please see Addendum #2 for the updated<br>information regarding door type K.  |                        |               | 1/10/2025        |

# pfluger

Project Number: 24-028 Project Name: New Elementary School #38 Owner: Lamar Consolidated ISD Date: 1/14/2025

| RFI NO. | Date<br>RECEIVED | CONTRACTOR / SUBCONTRACTOR                | SHEET /<br>SPEC. NO. | QUESTION   | DISCIPLINE    | RESPONSE   | Date OUT for<br>Review | Date Received | Date<br>RETURNED |
|---------|------------------|---|----------------------|--|---------------|--|------------------------|---------------|------------------|
| 31      | 1/7/2025         | Cadence McShane                           | 08 71 00             | Aluminum Door Hardware (Exit DT - Panic):<br>RFI : Please confirm if the 8800 series is the desired Exit DT – Panic<br>hardware and that it meets the impact design criteria indicated in the<br>Project Manual.<br>-Section 08.71.00 – 2.10 – B calls for SA 80 Series.<br>-Hardware Set 1.0 (per 08.71.00) calls for the 8810 SA model.<br>According to our Subcontractors, the 8800 series has not yet been<br>tested by Kawneer. The SA 8400 series have been tested by<br>Kawneer.<br>Curtain Wall versus Storefront – Finish:  | Architectural | LCISD is not a windstorm area, what has been<br>specified is suitable.LCISD is not located in a<br>windstorm-prone area, so the specified<br>requirements are adequate.                |                        |               | 1/10/2025        |
| 32      | 1/7/2025         | Cadence McShane                           |                      | Curtain Wall versus Storefront – Finish:<br>RFI: Please confirm that the curtainwall finish shall be clear<br>anodized and that the aluminum storefront finish shall be light<br>bronze. Please also confirm that the light bronze finish of the<br>aluminum storefront shall be painted.<br>-Section 08.44.13 – 2.07 – C calls for the curtain wall to be clear<br>anodized.<br>-Section 08.41.13 – 1.16 – B calls for the storefront to be clear<br>anodized – light brown.<br>Please note that Kawneer no longer offers light brown in an<br>anodized finish. it will need to be painted light brown. | Architectural | All curtain walls and storefronts should be color<br>"Champagne" according to the Material Legend<br>on sheet A9.00A.  |                        |               | 1/10/2025        |
| 33      | 1/7/2025         | Cadence McShane                           |                      | Metal Panel Warranty:<br>RFI: Please clarify the required warranty for the metal panel system.<br>-Section 07.42.13 – 1.08 WARRANITES:<br>-Section 07.42.13 – 3.02 – E Guarantees and Warranties:  | Architectural | Please see Addendum #2 for reference.  |                        |               | 1/10/2025        |
| 34      | 1/7/2025         | Cadence McShane                           |                      | Metal Panel (MP-1) Material:<br>RFI: Please clarify the material and thickness for the MP-1 panels.<br>-Section 07.42.13 Part 2 does not specify material or thickness.<br>Berridge offers 24g/22g steel or 0.032 aluminum options for the HS<br>series.   | Architectural | Please refer to Addendum #2. The metal panel<br>will be 24-gauge steel.  |                        |               | 1/10/2025        |
| 35      | 1/7/2025         | Drymalla                                  |                      | I see that A1.02, for most of the canopies, the soffits are designed to span left to right instead of up and down. Typically, the soffit mounting beams are positioned perpendicular to the gutter beams, with the soffits attached to those beams running up and down. If the soffits are installed in the opposite direction, it would create a hash pattern for the mounting beams, leading to higher material costs. Can we confirm if the spin directions are correct?  | Architectural | Please refer to Addendum #2 for the updated soffit spans.  |                        |               | 1/10/2025        |
| 36      | 1/8/2025         | Satterfield & Pontikes Construction, Inc. |                      | Please clarify the soffit finish for the canopy at Area A. 9/A1.02 calls<br>for metal soffit (MPC) while the callout on<br>Detail 8/A7.21 calls for suspended Aluminum Soffit (AWC).   | Architectural | Please refer to Addendum #2 for the updated note on detail 9/A1.02.  |                        |               | 1/10/2025        |
| 37      | 1/8/2025         | Satterfield & Pontikes Construction, Inc. |                      | Please clarify the metal soffit finish at the egress entrances. See<br>below for one area in question. Will this be<br>MPC?  | Architectural | Please refer to the note in the upper right corner<br>of sheet A1.02: "ALL CANOPY SOFFITS TO BE<br>EXTRUSION COATING SYSTEM 399X493<br>FLUROPON CLASSIC II CHAMPAGNE BRONZE<br>U.O.N." |                        |               | 1/10/2025        |
| 38      | 1/8/2025         | Gamma Construction                        |                      | Please reference plumbing page P301.C. I do not see the page<br>referenced for the Kitchen floor plan DNP4.03 detail 1. Its not<br>included with the proposal set or Addendum 1. We need this page<br>for bid.   | MEP/T         | Refer to Addendum #2 for location  |                        |               | 1/10/2025        |

#### Project Number: 24-028 Project Name: New Elementary School #38 Owner: Lamar Consolidated ISD Date: 1/14/2025

#### Date SHEET / Date OUT for Date RFI NO. CONTRACTOR / SUBCONTRACTOR QUESTION DISCIPLINE RESPONSE Date Received RECEIVED SPEC. NO. Review RETURNED C4.00 Paving plan – Do you know if any permits/reviews will be The developer has confirmed that easements will required by the developer or FBC for the sidewalks that go out of our Civil 39 1/8/2025 Drymalla not be required for sidewalks going outside of the 1/10/2025 property line? Its only a little at the cross walks along Brooke water site property line Blvd. Refer to Addendum 2. Grease trap and sample C5.01 and P1.01 show the grease trap and sample well in two Civil well locations have been updated to match the 1/10/2025 40 1/8/2025 Drymalla different locations. Can you clarify which is correct? plumbing plans. C9.00 SWPPP shows Filter Fabric Fence while 01 50 00 does not Civil Include filter fabric fence for SWPPP. 41 1/8/2025 Drymalla 1/10/2025 show filter fabric is required, can you clarify this for me? Refer to sheet E4.01 of bid documents for L1.02 shows the Irrigation controller location but this does not match receptacle to power irrigation controller and 1/8/2025 the location provided on A1.00. electrical drawing E4.01 does not MEP/T conduit to nearest grass area. Electrical is show 1/10/2025 42 Drymalla show the controller at all. in same general area as landscape. Contractor to coordinate final location in field. Please refer to Addendum #2 for clarifications A1.00 site plan only provides (1) post n panel sign, should we A1.00 43 1/8/2025 Drvmalla Architectural 1/10/25 account for the second entrance as well? regarding site signage. A1.00 shows to provide a standpipe in Area A and Area F while the Please see Addendum #2 for clarification Drymalla 44 1/8/2025 A1.00 floor plans do not reference these. A2.01E shows a Standpipe in the Architectural 1/10/25 regarding the standpipe location notes corridor E101 outside of room E120. A1.03 provides a detail of the walking track (#12) that shows The track will be constructed of concrete 45 1/8/2025 Drymalla A1.03 concrete track but C15.00 shows to provide track surfacing, could Architectural according to Lamar CISD standards. Please refer 1/10/2025 you clarify what will be required? (36 has track surfacing) to the updated Civil Detail in Addendum #2. A1.03 does not show that the CPE transformer will receive a The louver has been added. Please refer to 1/8/2025 A1.03 vent/louver in the CMU wall. We had to add one for 36 per CPE, can Architectural 1/10/2025 46 Drvmalla Addendum #2 for more details. we assume 38 will require this as well? A1.03 shows the bollards but only (1) is technically called out to be removeable at the chillers, can you clarify if all bollards around the The notes have been updated. Please refer to 1/8/2025 A1.03 Architectural 1/10/25 47 Drymalla chiller will be removeable? CPE will require their bollards around the Addendum #2 for further details. ransformer to be removeable, we will assume this is the case The gate S010 will be a double swing design. A1.03 shows gate S010 to be 'sliding' but detail 1/A1.06 shows A1.03 Please consult Addendum #2 for additional 1/8/2025 Architectural 1/10/25 48 Drymalla double swing, could you confirm this should be double swing? details. A2.01A – Reception A104 has a window behind the desk to see into Please see Addendum #2 for additional 49 1/8/2025 A2.01A Architectural 1/10/25 Drymalla Secretary A105 but it is not called out. information. A2.01A - Can you confirm the display case outside of Art A126 will Please see Addendum #2 for additional 50 1/8/2025 Drymalla A2.01A be 10' x 7' like the one outside of the Clinic RR? Or will it be 10' x 6' Architectural 1/10/25 information. per elevation 1/A9.13? A2.01C provides counter coiling door C108F but the elevation Please see Addendum #2 for additional 51 1/8/2025 Drvmalla A2.01C Architectural 1/10/25 (4A9.12) shows CMU here. We will assume this door remains. A2.01D – Sped rooms (D114, D115, D122) show what looks like information casework and when you go to the elevation (28/A9.10) it says The cubbies are categorized as FF&E (Furniture, "Student Cubies" - Are these F.F.&E, items? Or should we include Fixtures, and Equipment) and NIC (Not in A2.01D 1/8/2025 1/10/25 52 Drymalla Architectural these as casework? Also, room D123 has the same layout as the Contract). Please refer to Addendum #2 for more others but does not show these cubies, will they be required here as details. well? A3.00 – Detail 7 – Can you confirm this is the only RR that will 53 1/8/2025 Drymalla Architectural Correct. 1/10/25 receive a baby changing station? A5.00 shows a Building expansion joint but the details shown do not 54 1/8/2025 Drymalla Architectural Refer To Detail 4/A7.20 1/10/25 provide enough information Please see Addendum #2 for additional A5.00 – General Note 8 states to provide prefinished galvanized 55 1/8/2025 Drvmalla Architectural information. Downspouts should be galvanized 1/10/25 steel downspouts but 07 62 00 states Aluminum

### pfluger

pfluger

#### Project Number: 24-028 Project Name: New Elementary School #38 Owner: Lamar Consolidated ISD Date: 1/14/2025

#### Date SHEET / Date OUT for Date RFI NO. CONTRACTOR / SUBCONTRACTOR QUESTION DISCIPLINE RESPONSE Date Received RECEIVED SPEC. NO. Review RETURNED A6.01 – Detail 2 shows 1/A7.05 but this shows a window going down the floor, please confirm we should show detail 3/A7.03 here, which Please see Addendum #2 for additional 1/8/2025 A6.01 Architectural 1/10/25 56 Drymalla states to have a p-lam window sill. Can I assume all M2 windows will information. receive a p-lam sill? A6.01 – Detail 9 shows 4/A7.05 but this references a canopy, please Please see Addendum #2 for additional A6.01 confirm we should match detail 4/A7.04 which provides a metal soffit Architectural 57 1/8/2025 Drymalla 1/10/25 information. over this door. A7.20 detail 9 for the stage steps does not match detail 15 on S3.04, Please see Addendum #2 for additional 58 1/8/2025 Drymalla A7.20 Architectural 1/10/25 could you confirm we are to match structural? information. Please provide black paint for all elements above A9.00B Can I assume we should provide black paint above the cloud 1/8/2025 A9.00B the ceiling clouds in this area. Refer to 59 Drymalla Architectural 1/10/25 ceilings in the gym & café? (as we are doing at 36) Addendum #2 for additional information. A9.10 detail 17 shows a vending machine in the teachers lounge. The vending machine is in contract. Please refer 60 1/8/2025 A9.10 Architectural 1/10/25 Drymalla can I assume this is F.F.&E./OFOI? to Addendum #2 for more information. A10.01B - I see a spot at exit door C121 where the canopy does not Please see Addendum #2 for additional exactly extend to the door, can I assume we will have metal panel 1/8/2025 A10.01B Architectural 1/10/25 61 Drymalla information soffit here? How tall is the canopy here? We added this on 36 T2.00 shows CR's at gates, will S007 gate entering into the Central Provide Panic Hardware, Card Reader and Fire 62 1/8/2025 Drymalla MEP/T 1/10/25 Plant require CR & panic HW? Access Box. Refer to Addendum #2. 2.01B – Just want to confirm we are not providing time clocks in 63 1/8/2025 MEP/T Correct. 1/10/25 Drvmalla any of the pods. I do not see any. T2.01B Exit Door B101C does not show that we need to provide CR Door B101C needs a card reader. Please refer to 64 1/8/2025 Drymalla & DC, please confirm we do need these here. A8.00 does show to MEP/T 1/10/25 Addendum #2 provide CR for this door, FYI. A1.05 detail 07 has 9" h alum letters where the electronic messaging Please see Addendum #2 for additional 65 1/8/2025 Architectural 1/10/25 Gamma Construction board goes for south and north walls. Is this a mistake? information A1.05 Are north detail 5 and south detail 8 wall lettering and Please see Addendum #2 for additional 66 1/8/2025 Gamma Construction Architectural 1/10/25 messaging boards all on one side? information. A1.05 detail 4 east the letters are on both sides, is there also a 2 Please see Addendum #2 for additional 67 1/10/25 1/8/2025 Gamma Construction Architectural ided messaging board you don't see? information Please see Addendum #2 for additional 68 1/8/2025 Gamma Construction A1.05 detail 1 west-is the messaging board really one sided? Architectural 1/10/25 information. 69 1/8/2025 Gamma Construction A9.11 detail 14-vinyl on type II substrate-do I quote? Architectural Clarification needed to answer question 1/10/25 A9.11 detail 13 and A9.14 detail 7-digital graphics on type II 70 1/8/2025 Gamma Construction Architectural Clarification needed to answer question 1/10/25 substrate-do I quote? 71 1/8/2025 Gamma Construction A9.12 detail 3-graphics on 3 M film-you want the letters on vinyl? Architectural Clarification needed to answer question 1/10/25 72 1/8/2025 Gamma Construction A9.15 detail 8-graphic on vinyl II-same as digital graphics? Architectural Clarification needed to answer question 1/10/25 Allow for thirty-five (70) 16" high letters at front entry canopy. Allow for seventy (70) 12" high 1/8/2025 1/10/25 73 Gamma Construction Architectural Clarification needed to answer question letters, and seventy (70) 18" high letters to be used at roadway/entry signs.- A1.05 wall letters? All those letters are 6.5" h. Please clarify. Will there be a detail, or spec issued for the artificial turf in the courtyard, showing the base requirements, and turf type. Based on 1/9/2025 Drymalla Civil Refer to Addendum #3 74 civil not showing concrete I would assume it will have an aggregate base with a Nailer at the edge of pavement for attachment. 1/14/25

#### Project Number: 24-028 Project Name: New Elementary School #38 Owner: Lamar Consolidated ISD Date: 1/14/2025

## pfluger

| RFI NO. | Date<br>RECEIVED | CONTRACTOR / SUBCONTRACTOR | SHEET /<br>SPEC. NO. | QUESTION  | DISCIPLINE    | RESPONSE   | Date OUT for<br>Review | Date Received | Date<br>RETURNED |
|---------|------------------|----------------------------|----------------------|---|---------------|--|------------------------|---------------|------------------|
| 75      | 1/9/2025         | Drymalla                   |                      | Which detail should we follow for the track, the civil with surfacing, or<br>architectural with no surfacing.   |               | The track will be constructed of concrete<br>according to Lamar CISD standards. Please refer<br>to the updated Civil Detail in Addendum #2.  |                        |               | 1/10/25          |
| 76      | 1/9/2025         | Drymalla                   |                      | There is no specification for Roof Drainage piping and<br>Appurtenances, please have SOBE provide.  | MEP/T         | Please see Addendum #2 for additional<br>information.  |                        |               | 1/10/25          |
| 77      | 1/9/2025         | Drymalla                   |                      | IMB-1 is called out on the plumbing drawings, but is not on the<br>plumbing schedule. Please advise.  | MEP/T         | Please see Addendum #2 for additional<br>information.  |                        |               | 1/10/25          |
| 78      | 1/9/2025         | Drymalla                   |                      | L-2 is called out on the plumbing drawings but not on the plumbing schedule. Please advise.   | MEP/T         | Please see Addendum #2 for additional<br>information.  |                        |               | 1/10/25          |
| 79      | 1/9/2025         | Drymalla                   |                      | When Robin visited the site, she observed a steel casing, likely from<br>an irrigation well, located on the property, approximately located<br>across from Veranda Point Drive, near the track. I researched the<br>civil drawings and the survey, and nowhere is this addressed. How<br>should this be handled during bidding, or can an allowance be<br>established to plug and cap. I have pictures imbedded below for<br>your review.   | Civil         | Please see Addendum #3 for additional<br>information.  |                        |               | 1/14/25          |
| 80      | 1/9/2025         |                            |                      | I am submitting this question regarding the Lamar CISD Elementary<br>School #38 project to your email address in accordance with the bid<br>advertisement for this project: Can the construction documents be<br>revised as noted o'n Page 7 of the attached letter regarding a<br>plumbing code violation?   | Architectural | No action required.  |                        |               | 1/10/25          |
| 81      | 1/10/2025        | Sterling Structures, Inc.  |                      | Is SAP1 and SAP3 ceiling tile to be similar to Armstrong Fine<br>Fissured 1728 NRC .55 or Armstrong Fine Fissured 1713 NRC .70?   | Architectural | Refer to spec section 09 51 00, 2.01 B   |                        |               | 1/10/25          |
| 82      | 1/10/2025        | Sterling Structures, Inc.  |                      | RCP has SAP2 in rooms B105, B128, D118, E115, E127, and F127.<br>Finish Schedule has SAP1.<br>Please clarify.   | Architectural | Refer to Addendum #2   |                        |               | 1/10/25          |
| 83      | 1/10/2025        | Sterling Structures, Inc.  |                      | RCP does NOT indicate SAP2 in room C113 Walkin. Please clarify.   | Architectural | Refer to Addendum #2   |                        |               | 1/10/25          |
| 84      | 1/10/2025        | Sterling Structures, Inc.  |                      | Should C100 Music, D107 Gym, and D108 Cafe receive a hi nrc ceiling tile of .90 similar to Armstrong Optima 3150?   | Architectural | No, See Addendum #2 note regarding all fine<br>fissured ceiling  |                        |               | 1/10/25          |
| 85      | 1/10/2025        | Sterling Structures, Inc.  |                      | Division 98413 indicates 2" and 4" wall panels.<br>Where does each thickness occur at?  | Architectural | Refer to Addendum #3, all panels to be 2" per<br>note on finish legend on sheet A9.00A   |                        |               | 1/14/25          |
| 86      | 1/10/2025        | Sterling Structures, Inc.  |                      | Does room C107 Gym receive hi impact 1/8" wall panels?  | Architectural | See Addendum #3  |                        |               | 1/14/25          |
| 87      | 1/10/2025        | Cadence McShane            |                      | Part 2 of 07.42.13 does not specify the material or thickness of the<br>metal panels. Please clarify if the metal panels shall be<br>steel or aluminum as offered by Berridge.  | Architectural | See addendum 2   |                        |               | 1/10/25          |
| 88      | 1/10/2025        | Cadence McShane            |                      | include the note : RETURN THIS DOCUMENT IN<br>THE BID/PROPOSAL PACKAGE". To execute a signed and sealed<br>copy of the Texas Statutory Performance and<br>Payment Bond Forms require an executed contract. In addition,<br>Instructions to Offerors lists, "if awarded, the<br>Offeror shall furnish and pay for a Performance Bond and a Payment<br>Bond each in the full contract amount" and<br>"Offeror shall deliver the required bonds to the Owner not later than<br>the date of execution of the Contract." Please<br>clarify this requirement for submittal. | Architectural | Refer to Addendum #3 narrative, Specification<br>Section 00 11 00 REQUEST FOR COMPETITIVE<br>SEALED PROPOSALS pages 24 and 25 TEXAS<br>STATUTORY PERFORMANCE BOND and<br>TEXAS STATUTORY PAYMENT BOND forms<br>will only be executed when there is a contract in<br>place. |                        |               | 1/14/25          |

#### Project Number: 24-028 Project Name: New Elementary School #38 Owner: Lamar Consolidated ISD Date: 1/14/2025

## pfluger

| RFI NO. | Date<br>RECEIVED | CONTRACTOR / SUBCONTRACTOR                | SHEET /<br>SPEC. NO. | QUESTION  | DISCIPLINE    | RESPONSE   | Date OUT for<br>Review | Date Received | Date<br>RETURNED |
|---------|------------------|---|----------------------|---|---------------|--|------------------------|---------------|------------------|
| 89      | 1/10/2025        | Satterfield & Pontikes Construction, Inc. |                      | Is SAP1 and SAP3 ceiling tile to be similar to Armstrong Fine<br>Fissured 1728 NRC .55 or Armstrong Fine Fissured<br>1713 NRC .70?A9.00A does not indicate that, and specs indicate to<br>see drawings.   | Architectural | Refer to Addendum #2, note added calling for all<br>fine fissured ceiling to be .70 NRC  |                        |               | 1/14/25          |
| 90      | 1/10/2025        | Satterfield & Pontikes Construction, Inc. |                      | RCP has SAP2 in rooms B105, B128, D118, E115, E127, and F127.Finish Schedule has SAP1.Please clarify.   | Architectural | Refer to Addendum #2   |                        |               | 1/10/25          |
| 91      | 1/10/2025        | Satterfield & Pontikes Construction, Inc. |                      | Please clarify the ceiling type in the Walk-Ins C113. The RCP (Sheet<br>A10.01) does not show a ceiling type but the<br>Room Finish Schedule on Sheet A9.00B calls for SAP2.  | Architectural | Refer to Addendum #2   |                        |               | 1/10/25          |
| 92      | 1/10/2025        | Satterfield & Pontikes Construction, Inc. |                      | With regards to the Ceilings at Music (C100), Gym (D107), and<br>Cafeteria (D108), because these are areas with<br>higher noise, should these locations recieve a higher NRC Ceiling<br>Tille of. 90 similar to Armstrong Optima 3150?  | Architectural | No, See Addendum #2 note regarding all fine<br>fissured ceiling  |                        |               | 1/10/25          |
| 93      | 1/10/2025        | Satterfield & Pontikes Construction, Inc. |                      | Spec 09 84 13 indicates 2" and 4" wall panels. Please clarify where each of these thickness occur at.   | Architectural | Refer to Addendum #3, all panels to be 2" per<br>note on finish legend on sheet A9.00A   |                        |               | 1/14/25          |
| 94      | 1/10/2025        | Satterfield & Pontikes Construction, Inc. |                      | With regards to the Acoustical Wall Panels at the Gym (C107),<br>please clarify if this area is to receive hi impact<br>1/8" wall panels.   | Architectural | See Addendum #3  |                        |               | 1/14/25          |
| 95      | 1/10/2025        | Sterling Structures, Inc.                 |                      | Sheet C9.00 No stablized constructon entrance is shown.   | Civil         | Stabilized construction entrance and concrete<br>truck washout areas have been added along the<br>future Brookewater Blvd and Wallingford Park<br>Drive. Refer to Addendum #2.   |                        |               | 1/10/25          |
| 96      | 1/10/2025        | Sterling Structures, Inc.                 |                      | Sheet A1.05 monument sign details show a electronic message board but no specifications are issued.   | Architectural | See Addendum #2, 10 14 64.   |                        |               | 1/10/25          |
| 97      | 1/10/2025        | Sterling Structures, Inc.                 |                      | There are display case cabinets bulletin boards in corridor but no specifications are included.   | Architectural | Display case will be custom, no spec   |                        |               | 1/14/25          |
| 98      | 1/10/2025        | Sterling Structures, Inc.                 |                      | Dtail 17/A9.17 shows a motorized changing table. Please provide specifications if ths is CFCI.  | Architectural | See Addendum #2  |                        |               | 1/10/25          |
| 99      | 1/10/2025        | Sterling Structures, Inc.                 |                      | Sheet A8.0 door schedules list four (4) type K overhead doors. The<br>floor plans have one OH at corridor B100 but does not have a door #<br>on it.   | Architectural | See Addendum #1  |                        |               | 12/20/24         |
| 100     | 1/10/2025        | Drymalla                                  |                      | Ornamental iron fence specifications for this project? Spec 32 31 19<br>are calling for 1" picket and 2 rail fence panel, but the detail<br>elevation 2/A1.06 is calling for a ¾" picket and 3 rails. I know we are<br>using the ¾" & 3rail panels on LCISD #36 school. There is a<br>substantial price difference between the two. | Architectural | See Addendum #3  |                        |               | 1/14/25          |
| 101     | 1/10/2025        | Drymalla                                  |                      | Enlarged Kitchen Drawings are not in the published plan set.<br>Reference 1/DNP4.03   | MEP/T         | See Addendum #2  |                        |               | 1/10/25          |
| 102     | 1/10/2025        | Drymalla                                  |                      | Sheet P4.01 note #32 calls out on Enlarged Plans, but there is no text associated with the note.  | MEP/T         | See Addendum #2  |                        |               | 1/10/25          |
| 103     | 1/10/2025        | Sterling Structures, Inc.                 |                      | If the responding fire station is far, are there plans for a new fire station that is closer? What details are available?   | Architectural | From Developer: "No actual plans as of yet, but<br>we do have an agreement with the city to sell<br>them a fire station in our development at some<br>point in the future. I think that means there will be<br>one within our development, but that is not<br>guaranteed until it is on the ground." |                        |               | 1/14/25          |
| 104     | 1/10/2025        | Sterling Structures, Inc.                 |                      | When will the Brookewatwer Blvd. construction be complete and the street open?  | Architectural | From Developer: "December 2026."   |                        |               | 1/14/25          |
| 105     | 1/10/2025        | Sterling Structures, Inc.                 |                      | It looks like the MUD District is building a water plant. When will this<br>be complete and operational?  | Architectural | From Developer: "January/February 2025. Just need power."  |                        |               | 1/14/25          |
| 106     | 1/10/2025        | Sterling Structures, Inc.                 |                      | When will fire hydrants be installed and operational?   | Architectural | From Developer: "Installed and operational now"  |                        |               | 1/14/25          |

# pfluger

Project Number: 24-028 Project Name: New Elementary School #38 Owner: Lamar Consolidated ISD Date: 1/14/2025

| RFI NO. | Date<br>RECEIVED | CONTRACTOR / SUBCONTRACTOR | SHEET /<br>SPEC. NO. | QUESTION  | DISCIPLINE    | RESPONSE  | Date OUT for<br>Review | Date Received | Date<br>RETURNED |
|---------|------------------|----------------------------|----------------------|---|---------------|---|------------------------|---------------|------------------|
| 107     | 1/10/2025        | Sterling Structures, Inc.  |                      | Where will the hydrants be located by the project site? | Architectural | From Developer: "The hydrants are currently<br>existing on the East and South sides of the job<br>site" |                        |               | 1/14/25          |
|         |                  |                            |                      |   |               |   |                        |               |                  |